

THE TOWNHOMES OF CHAPEL RIDGE-2ND PLAT

LOTS 9-19 & TRACTS A-D STREET AND STORM CONSTRUCTION PLANS

Section 8, Township 48 North, Range 31 West
LEE'S SUMMIT, JACKSON COUNTY, MISSOURI

CONSTRUCTION AND DESIGN NOTES:

STREET & STORM SEWERS:

1 - STREET PAVEMENT SHALL CONSIST OF TYPE CG-2 CURBS WITH PAVEMENT PER TABLE LS-2 OF THE LEE'S SUMMIT DESIGN AND CONSTRUCTION MANUAL

RESIDENTIAL LOCAL STREET SEE BELOW FOR TYPICAL SECTION.

OPTION 1) 4" TYPE II ASPHALT BASE AND 2" TYPE III ASPHALT SURFACE OVER A 6" MoDOT TYPE 5 BASE AND A SUBGRADE MIXTURE OF 6" FLY ASH STABILIZED SUBGRADE IN ACCORDANCE WITH THE CITY OF LEE'S SUMMIT DESIGN AND CONSTRUCTION MANUAL.
OPTION 2) 4" TYPE II ASPHALT BASE AND 2" TYPE III ASPHALT SURFACE OVER 6" MoDOT TYPE 5 BASE OVERTOP A BIAXIAL GEOGRID MEETING THE REQUIREMENTS OF TABLE 2201.6-1

2 - STORM SEWER PIPE SHALL BE HIGH DENSITY POLYETHYLENE (HDPE) AS APPROVED BY CITY OF LEE'S SUMMIT DESIGN AND CONSTRUCTION MANUAL.

3 - JUNCTION BOXES SHALL BE PER CITY OF LEE'S SUMMIT STANDARD DRAWING NO. JB-1. FIELD INLETS SHALL BE PER CITY OF LEE'S SUMMIT STANDARD DRAWING FI-1. TOEWALLS SHALL BE PER CITY OF LEE'S SUMMIT STANDARD DRAWING NO. SD-35. STORM MANHOLES SHALL BE PER CITY OF LEE'S SUMMIT DETAIL SD-27. ROCK LINING AND RIP RAP SHALL BE PER CITY OF LEE'S SUMMIT.

GENERAL NOTES:

1 - ALL CONSTRUCTION SHALL CONFORM TO THE CITY OF LEE'S SUMMIT DESIGN AND CONSTRUCTION MANUAL AS ADOPTED BY ORDINANCE 5813.
2 - ALL REQUIRED EASEMENTS WITHIN THE BOUNDARY OF THIS PROJECT SHALL BE PROVIDED FOR ON THE FINAL PLAT.
3 - ANY REQUIRED EASEMENT LOCATED OUTSIDE OF THE BOUNDARY OF THIS PROJECT SHALL BE PROVIDED FOR BY SEPARATE INSTRUMENT PRIOR TO ISSUANCE OF CONSTRUCTION PERMITS.
4 - THE CONTRACTOR SHALL NOTIFY THE CITY OF LEE'S SUMMIT DEVELOPMENT ENGINEERING INSPECTION AT 816.969.1200 AT LEAST 48 HOURS PRIOR TO THE COMMENCEMENT OF ANY CONSTRUCTION.
5 - THE CONTRACTOR SHALL NOTIFY ENGINEERING SOLUTIONS AT 816.623.9888 OF ANY CONFLICT WITH THE IMPROVEMENTS PROPOSED BY THESE PLANS AND SITE CONDITIONS.
6 - THE CONTRACTOR SHALL NOTIFY THE CITY ENGINEER AND OBTAIN THE APPROPRIATE BLASTING PERMITS FOR A REQUIRED BLASTING. IF BLASTING IS ALLOWED, ALL BLASTING SHALL CONFORM TO STATE REGULATIONS AND LOCAL ORDINANCES.

UTILITY COMPANIES:

THE FOLLOWING LIST OF UTILITY COMPANIES IS PROVIDED FOR INFORMATION ONLY. WE DO NOT OFFER ANY GUARANTEE OR WARRANTY THAT THIS LIST IS COMPLETE OR ACCURATE. THE CONTRACTOR SHALL BE RESPONSIBLE FOR CONTACTING ALL UTILITY COMPANIES THAT MAY BE AFFECTED BY THE PROPOSED CONSTRUCTION AND VERIFYING THE ACTUAL LOCATION OF EACH UTILITY LINE. THE CONTRACTOR SHALL NOTIFY ENGINEERING SOLUTIONS AT 816.623.9888 OF ANY CONFLICT WITH PROPOSED IMPROVEMENTS.


EVERGY ~ 298-1196
MISSOURI GAS ENERGY ~ 756-5261
SOUTHWESTERN BELL TELEPHONE ~ 761-5011
COMCAST CABLE ~ 795-1100
WILLIAMS PIPELINE ~ 422-6300
CITY OF LEE'S SUMMIT PUBLIC WORKS ~ 969-1800
CITY OF LEE'S SUMMIT PUBLIC WORKS INSPECTIONS ~ 969-1800
CITY OF LEE'S SUMMIT WATER UTILITIES ~ 969-1900
MISSOURI ONE CALL (DIG RITE) ~ 1-800-344-7483

OIL - GAS WELLS

ACCORDING TO EDWARD ALTON MAY JR'S ENVIRONMENTAL IMPACT STUDY OF ABANDONED OIL AND GAS WELLS IN LEE'S SUMMIT, MISSOURI IN 1995, THERE ARE NOT OIL AND GAS WELLS WITHIN 185 FEET OF THE PROPERTY AS SURVEYED HEREON.

FLOOD INFORMATION:

The property is located in Zone "X" areas outside the 100 year flood plain per FEMA Map 29095C0430G, dated January 20, 2017

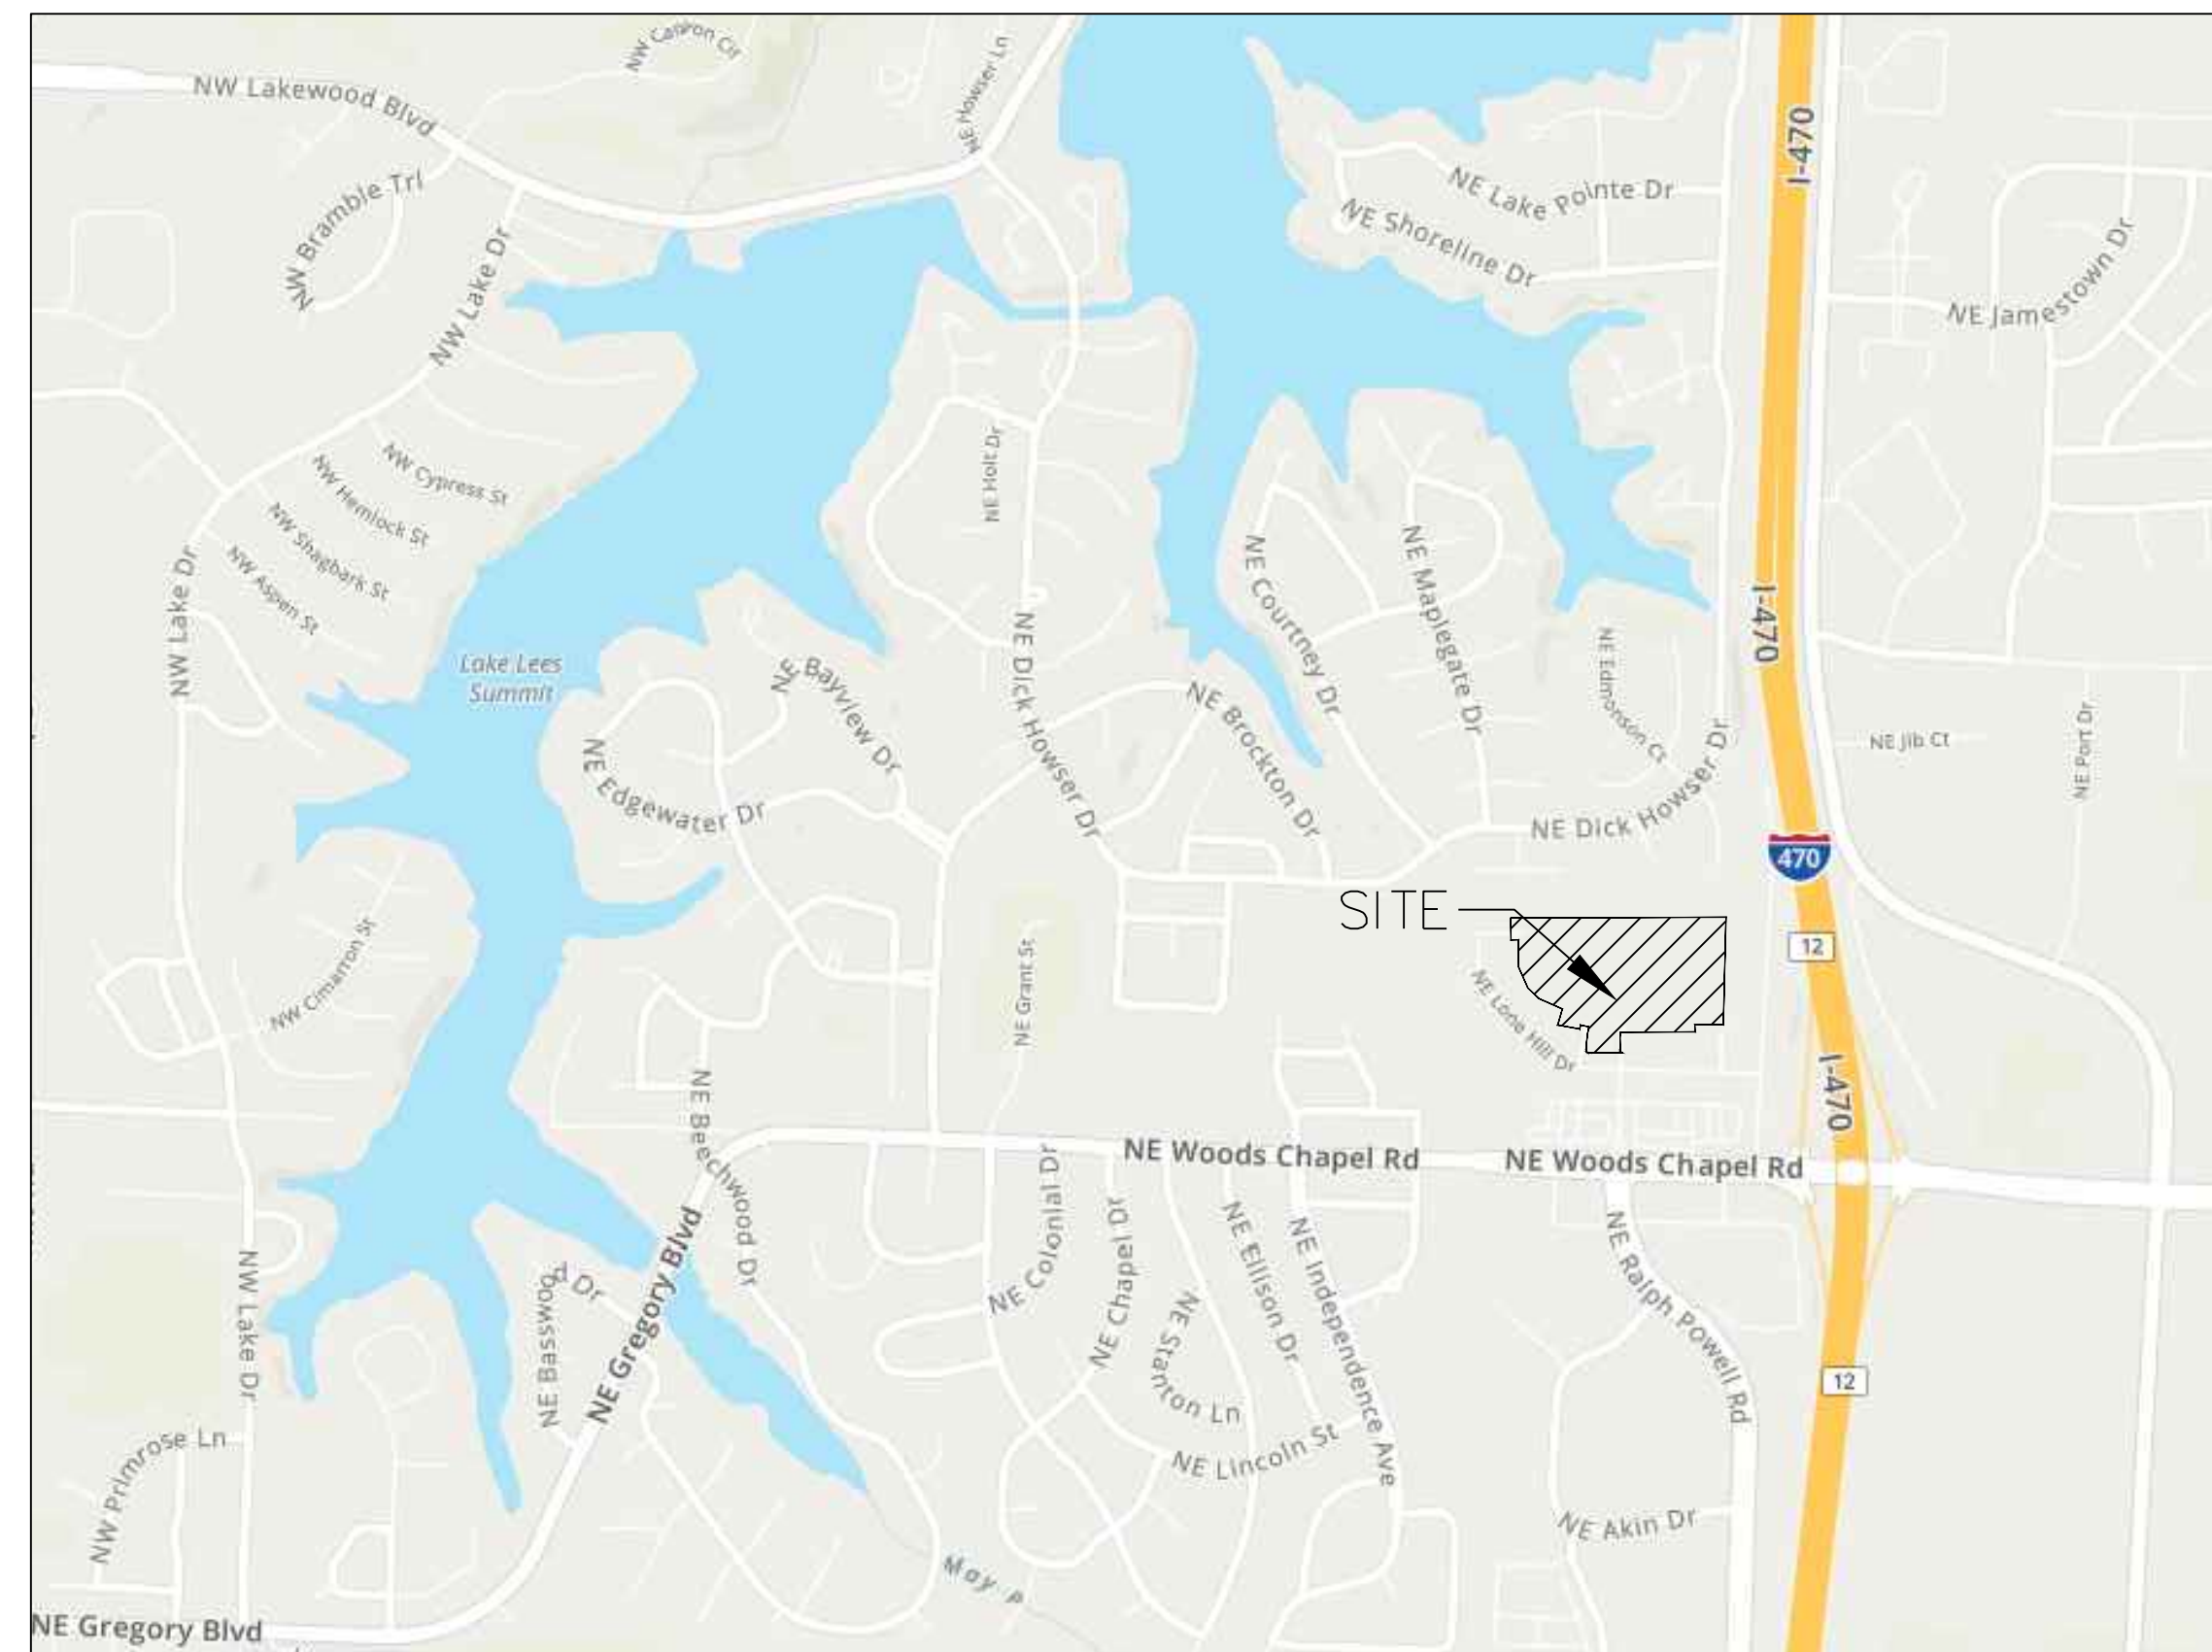


SITE LOCATION MAP

Summary of Quantities:

ITEM AND DESCRIPTION	UNIT	ESTIMATED QUANTITY
ASPHALT PAVING	S.Y.	3,430.98
CURBING	FT	2,343.62
5' SIDEWALK	S.F.	12,057.55
MoDOT Type 5 Base	S.Y.	3,702.68
GEOGRID	S.Y.	3,702.68
ADA SIDEWALK RAMP	UNIT	7
CLEARING, GRADING & GRUBBING	LS	1
SILT FENCE	FT	5,724.09
INLET PROTECTION	UNIT	44.00
SEEDING / MULCHING/ FERTILIZING	AC	18.83
CONST. ENTRANCE	UNIT	2.00
RIP RAP W/ FABRIC	S.Y.	35.00
DITCH CHECK	UNIT	3.00
STORM		
30" HDPE	FT	76.46
24" HDPE	FT	54.41
18" HDPE	FT	299.20
15" HDPE	FT	1,129.96
4' x 4' JUNCTION BOX	EA	2.00
18" HDPE END SECTION / TOE WALL	LS	2.00
30" HDPE END SECTION / TOE WALL	LS	2.00
DETENTION OUTLET CONTROL STRUCTURE	EA	1.00
4' x 4' STORM FIELD INLET	EA	6.00
5' x 4' STORM CURB INLET	EA	6.00

ENGINEER'S CERTIFICATION:

I HEREBY CERTIFY THAT THIS PROJECT HAS BEEN DESIGNED AND THESE PLANS PREPARED IN ACCORDANCE WITH THE CURRENT DESIGN CRITERIA OF THE CITY OF LEE'S SUMMIT, MISSOURI AND THE STATE OF MISSOURI. I FURTHER CERTIFY THAT THESE PLANS WERE DESIGNED IN ACCORDANCE TO AASHTO STANDARDS.


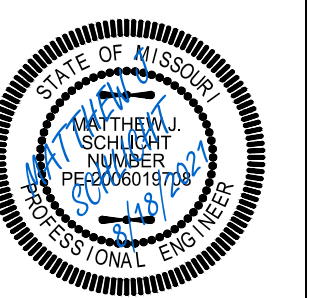


Matthew J. Schlicht
MO PE 000019708
KS PE 19071
OK PE 25226
NE PE E-14335

REVISIONS
6/25/2021 As-Built
8/18/2021 As-Built

"AS-BUILT"

900.10
~~900.00~~ Indicates data replaced with "As-Built" information. All other data is as designed and has not been field verified.

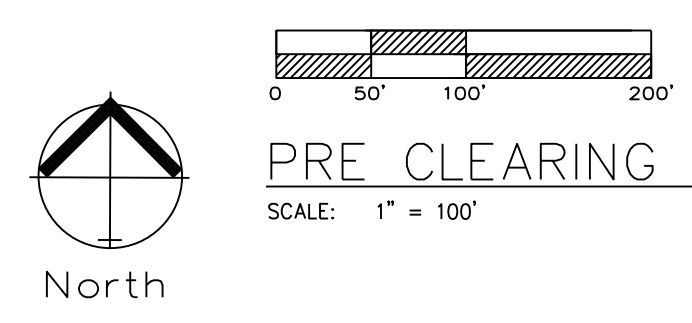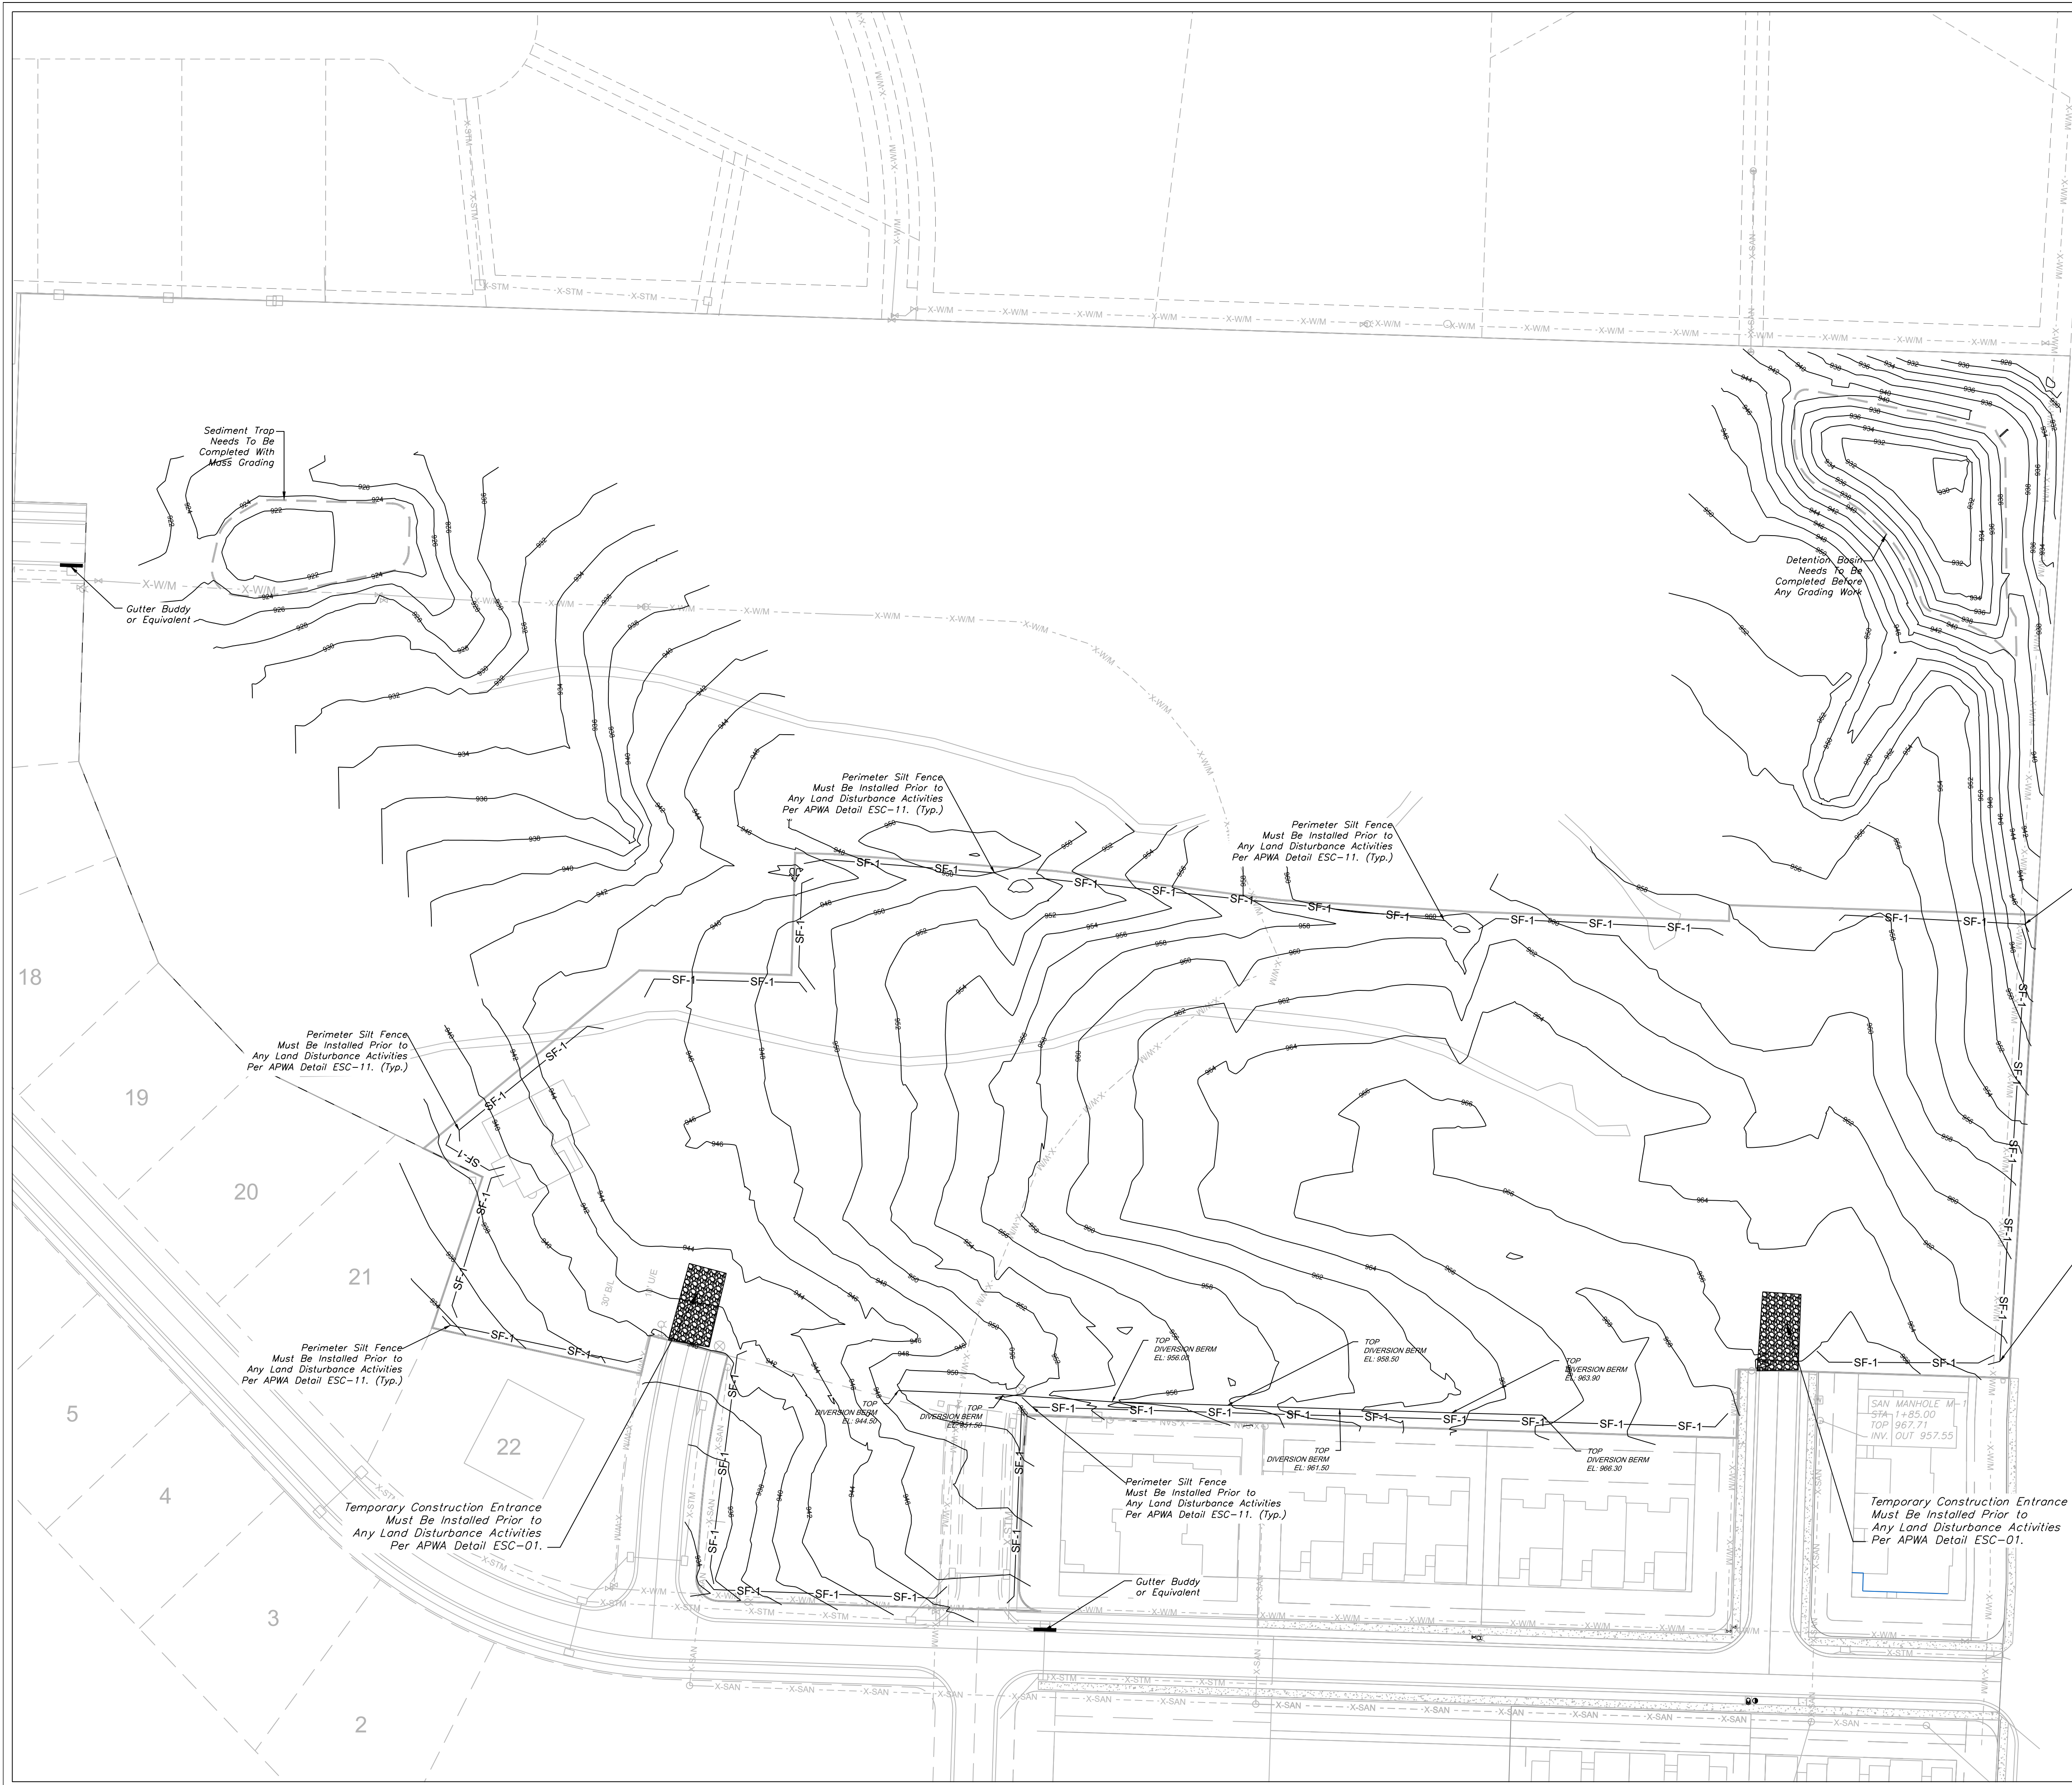

NOTES: The Land Disturbance Plans indicates the Final placement of erosion control devices. The contractor(s) may proceed with construction prior to the final placement of these devices by providing additional devices to control erosion on their items of work. These devices shall be maintained until the final devices are in place.

SILT FENCE PROTECTION TO BE MAINTAINED BY CONTRACTOR

LEGEND

PHASE 1 SILT FENCE	SF-1	SF-1
PHASE 2 SILT FENCE	SF-2	SF-2
INLET PROTECTION		


DURING ALL PHASES OF CONSTRUCTION, INACTIVE AREA STABILIZATION METHODS AS DESCRIBED IN APWA SECTION 5111.3 SHALL BE USED TO CONTROL EROSION AND SILTATION.

Professional Registration
 Missouri
 Engineering 2005002186-D
 Surveying 2005008319-D
 Kansas
 Engineering E-1685
 Surveying LS-218
 Oklahoma
 Engineering S254
 Nebraska
 Engineering CA2821

Project:
 VILLAGES OF CHAPEL RIDGE LSMD
 Issue Date:
 April 10, 2020

THE TOWNHOMES OF CHAPEL RIDGE-2ND PLAT
 LOTS 9-19 & TRACTS A-D
 Lee's Summit, Jackson County, Missouri



ESC PHASE 1 - Pre Clearing Plan
 Construction Plans for:
 THE TOWNHOMES OF CHAPEL RIDGE-2ND PLAT
 LOTS 9-19 & TRACTS A-D
 Lee's Summit, Jackson County, Missouri

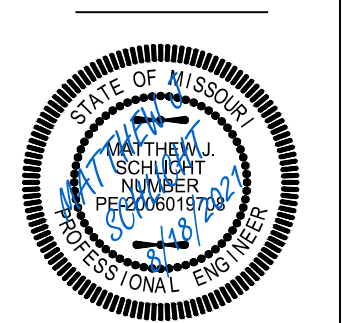

Matthew J. Schlicht
 MO PE 2006019708
 KS PE 19071
 OK PE 25226
 NE PE E-14335

REVISIONS
 6/25/2021 As-Built
 8/18/2021 As-Built

"AS-BUILT"
 900.10
 900.00 Indicates data replaced with "As-Built" information. All other data is as designed and has not been field verified.

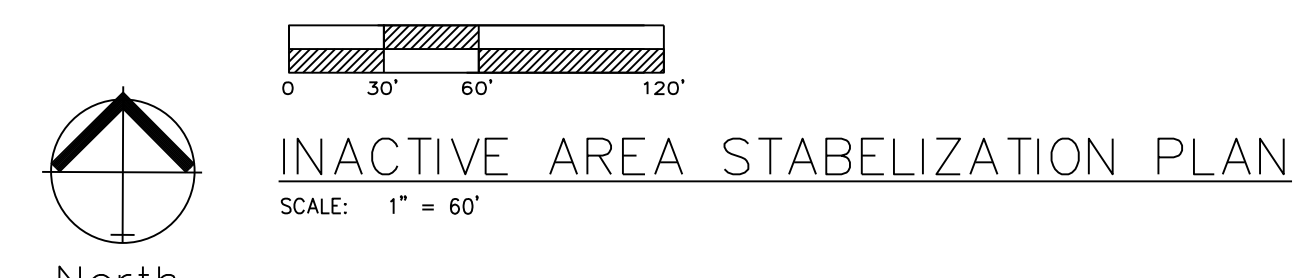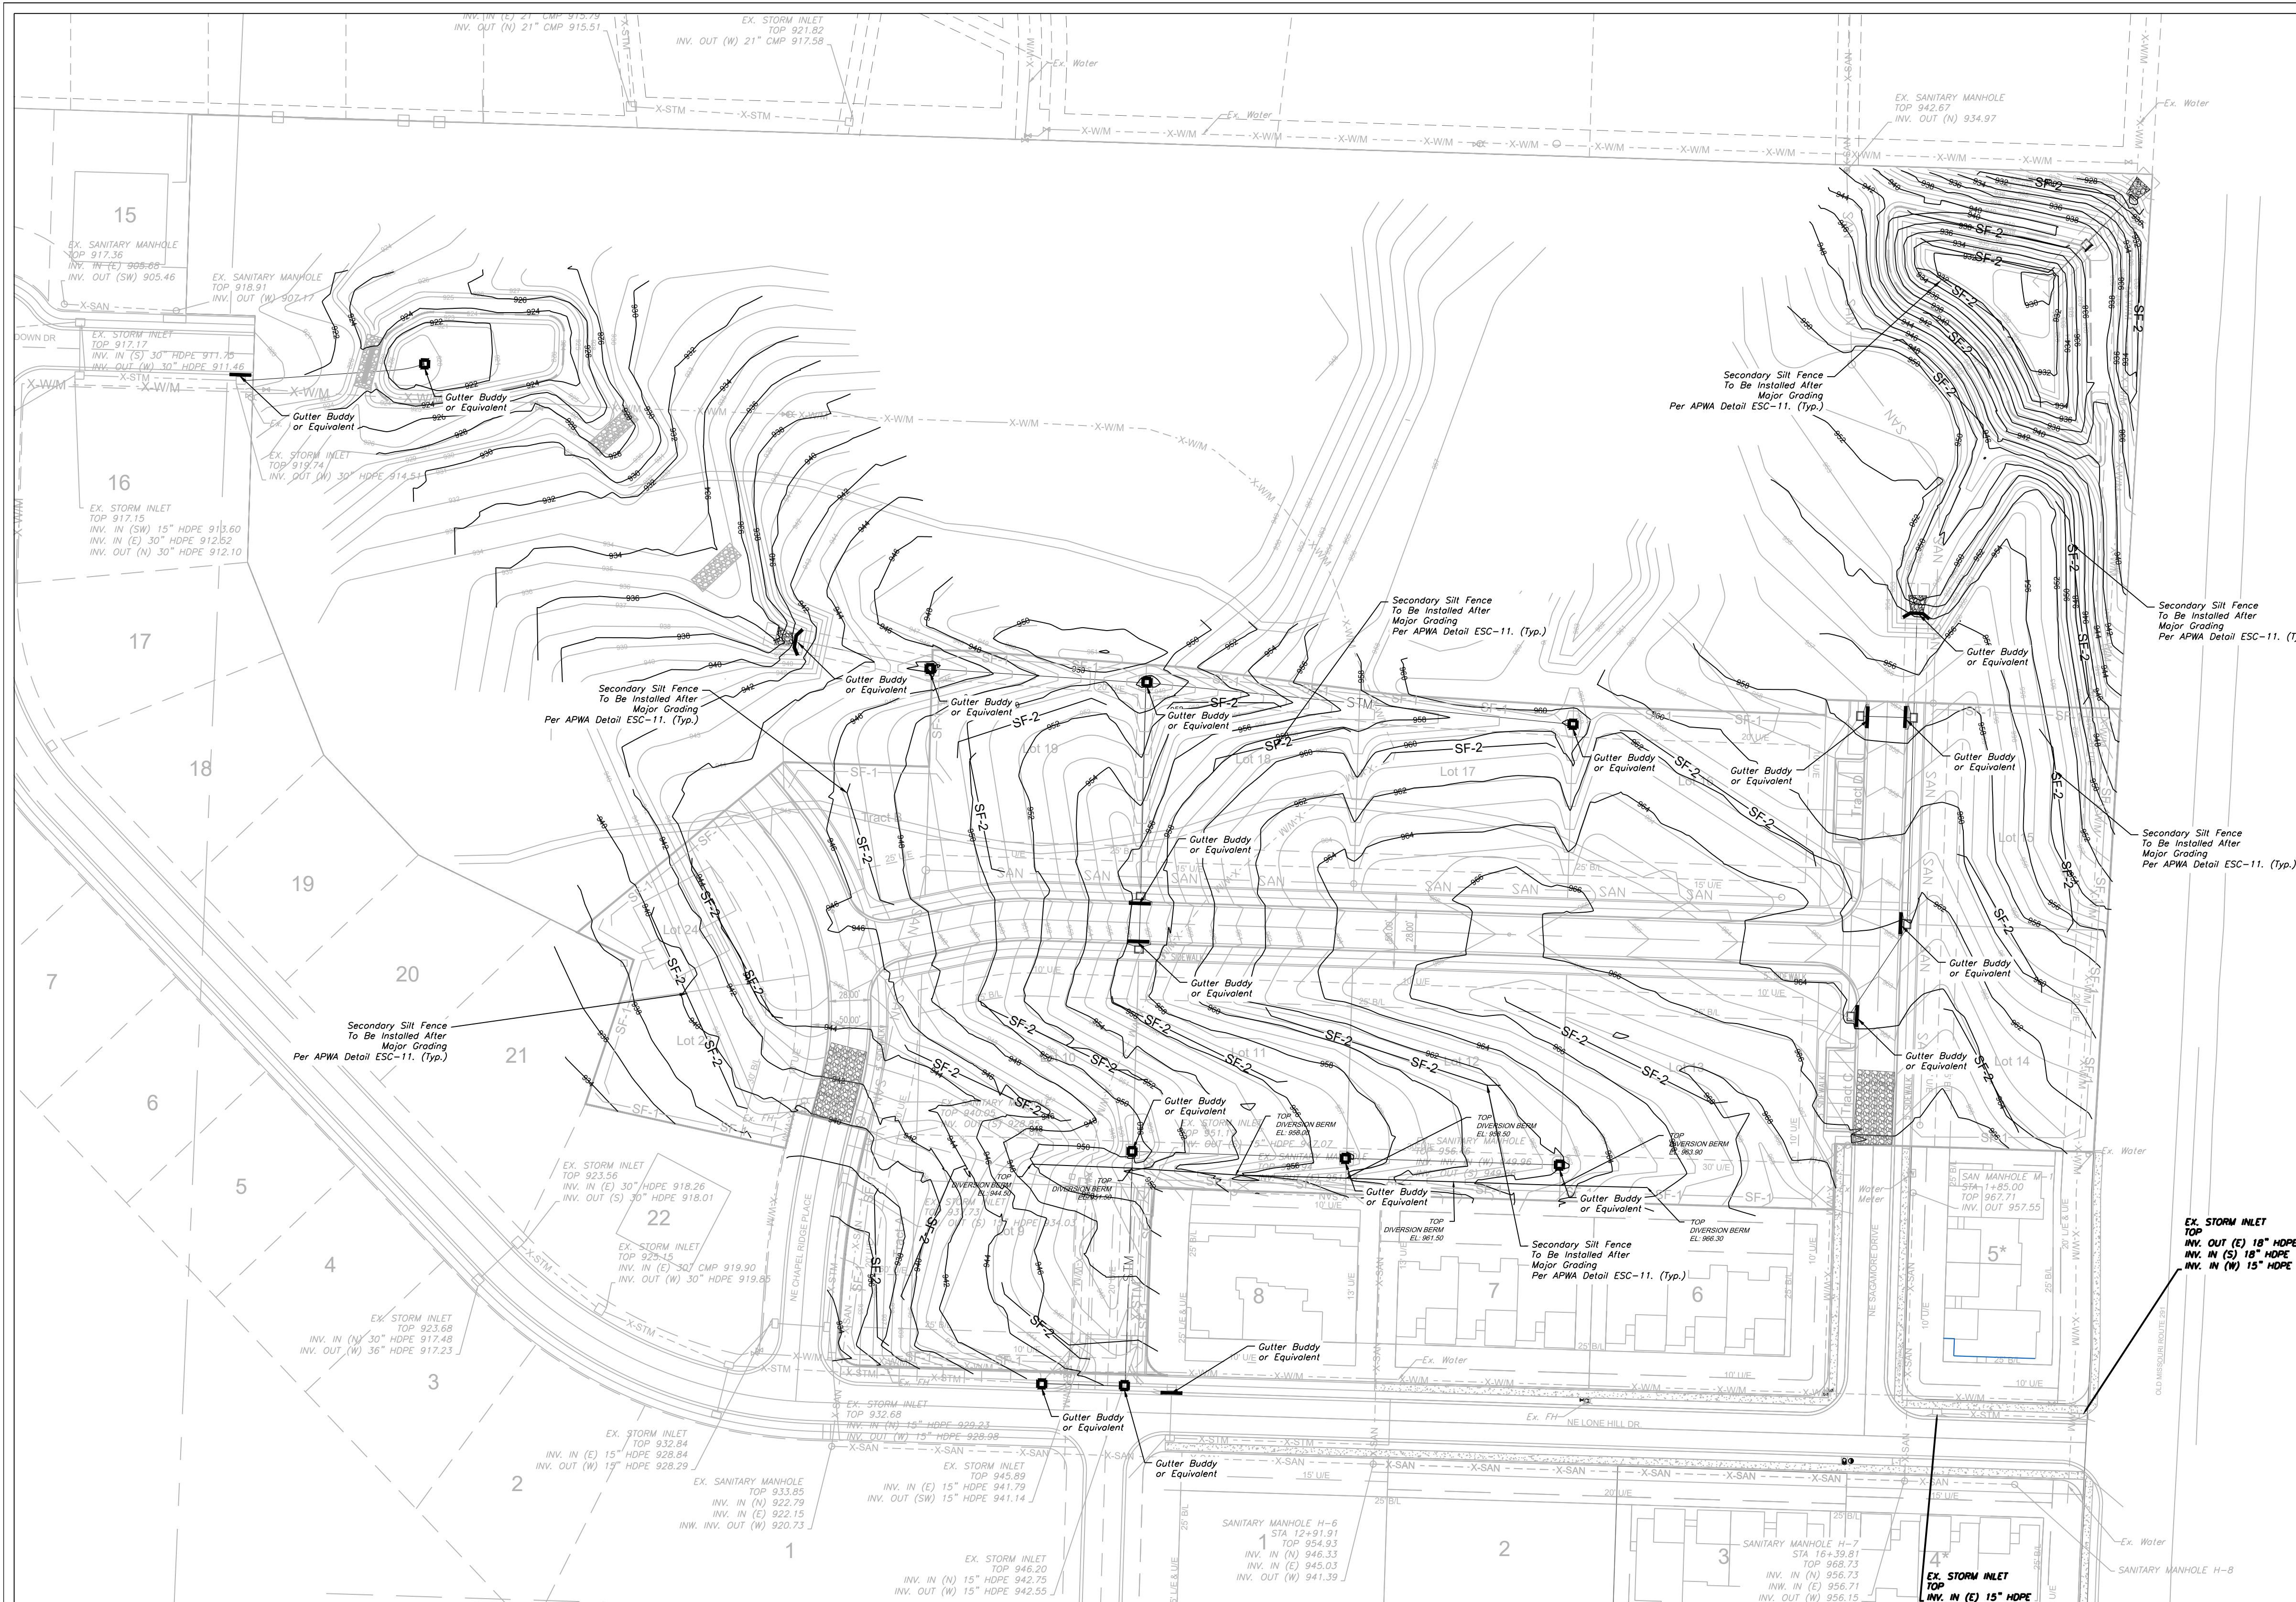

INACTIVE AREA STABILIZATION PLAN

SCALE: 1" = 60'

NOTES: The Land Disturbance Plans indicates the Final placement of erosion control devices. The contractor(s) may proceed with construction prior to the final placement of these devices by providing additional devices to control erosion on their items of work. These devices shall be maintained until the final devices are in place.

SILT FENCE PROTECTION TO BE MAINTAINED BY CONTRACTOR



DURING ALL PHASES OF CONSTRUCTION, INACTIVE AREA STABILIZATION METHODS AS DESCRIBED IN APWA SECTION 5111.3 SHALL BE USED TO CONTROL EROSION AND SILTATION.

MAINTENANCE:
 TO MAINTAIN THE EROSION AND SEDIMENT CONTROLS, THE FOLLOWING PROCEDURES WILL BE PERFORMED:
SEDIMENT CAPTURE DEVICES: SEDIMENT WILL BE REMOVED FROM THE UPSTREAM OR UPSLOPE SIDE OF THE FILTER FABRIC FENCES, WHEN THE DEPTH OF ACCUMULATED SEDIMENT REACHES ABOUT ONE-THIRD THE HEIGHT OF THE STRUCTURE.
STORM SEWER INLETS: ANY SEDIMENT IN THE STORM SEWER INLETS WILL BE REMOVED AND DISPOSED OF PROPERLY.
TEMPORARY CONTROLS: ALL TEMPORARY CONTROLS WILL BE REMOVED AFTER THE DISTURBED AREAS HAVE BEEN STABILIZED.

INSPECTION PROCEDURES:
 INSPECTIONS WILL BE DONE BY THE RESPONSIBLE PERSON(S) AT LEAST ONCE EVERY WEEK AND WITHIN 24 HOURS EACH STORM EVENT PRODUCING ANY AMOUNT OF RAINFALL. AREAS THAT HAVE BEEN RESEEDED WILL BE INSPECTED REGULARLY AFTER SEED GERMINATION TO ENSURE COMPLETE COVERAGE OF EXPOSED AREAS. DISTURBED AREAS THAT HAVE NOT BEEN FINALLY STABILIZED SHALL HAVE ALL POLLUTION CONTROL MEASURES INSPECTED FOR PROPER INSTALLATION, OPERATION AND MAINTENANCE. LOCATIONS WHERE STORM WATER LEAVES THE SITE SHALL BE INSPECTED FOR EVIDENCE OF EROSION OR SEDIMENT DEPOSITION. ANY DEFICIENCIES SHALL BE NOTED IN A REPORT OF THE INSPECTION AND CORRECTED WITHIN SEVEN CALENDAR DAYS OF THE INSPECTION. THE PERMITTEE SHALL PROMPTLY NOTIFY THE SITE CONTRACTORS RESPONSIBLE FOR OPERATION AND MAINTENANCE OF POLLUTION CONTROL DEVICES OF DEFICIENCIES.

IF THE EXISTING GROUND COVER IS NATURAL GRASS, DISTURBED AREAS SHALL BE TEMPORARILY SEEDED WITH WHEATGRASS AT A RATE OF 15 POUNDS PER 1000 SQUARE FEET. DISTURBED AREAS SHALL BE TEMPORARILY SEEDED WITH WHEATGRASS AT A RATE OF 15 POUNDS PER 1000 SQUARE FEET. PERMANENT SEEDED AREAS SHALL BE MULCHED AND WATERED TO MAINTAIN THE PROPER MOISTURE LEVEL OF THE SOIL TO ESTABLISH GRASS. NEW GRASS SHALL BE WATERED AND MAINTAINED UNTIL IT REACHES A HEIGHT OF 3 INCHES. ANY BARE AREAS SHALL BE RESEDED.

ALL EROSION CONTROL DEVICES SHALL BE REMOVED BY GENERAL CONTRACTOR AFTER SITE STABILIZATION IS COMPLETE AND APPROVED BY ENGINEER.

THE DEVELOPER WILL DESIGNATE A QUALIFIED PERSON OR PERSONS TO PERFORM THE FOLLOWING INSPECTIONS:
STABILIZATION MEASURES: DISTURBED AREAS AND AREAS USED FOR STORAGE OF MATERIALS THAT ARE EXPOSED TO PRECIPITATION WILL BE INSPECTED FOR EVIDENCE OF, OR THE POTENTIAL FOR, POLLUTANTS ENTERING THE DRAINAGE SYSTEM. AFTER A PORTION OF THE SITE IS FINALLY STABILIZED, INSPECTIONS WILL BE CONDUCTED AT LEAST ONCE EVERY MONTH THROUGHOUT THE LIFE OF THE PROJECT. CONTRACTOR CAN CONTACT ENGINEERING SOLUTIONS FOR COPIES OF THE INSPECTION FORM TO BE USED FOR STABILIZATION MEASURES.

STRUCTURAL CONTROLS: FILTER FABRIC FENCES AND ALL OTHER EROSION AND SEDIMENT CONTROL MEASURES IDENTIFIED IN THE PLAN WILL BE INSPECTED REGULARLY FOR PROPER POSITIONING, ANCHORING, AND EFFECTIVENESS IN TRAPPING SEDIMENTS. SEDIMENT WILL BE REMOVED FROM THE UPSTREAM OR UPSLOPE SIDE OF THE FILTER FABRIC. CONTRACTOR CAN CONTACT ENGINEERING SOLUTIONS FOR COPIES OF THE INSPECTION FORM TO BE USED FOR STABILIZATION MEASURES.
DISCHARGE POINTS: DISCHARGE POINTS OR LOCATIONS WILL BE INSPECTED TO DETERMINE WHETHER EROSION CONTROL MEASURES ARE EFFECTIVE IN PREVENTING SIGNIFICANT AMOUNTS OF POLLUTANTS FROM ENTERING RECEIVING WATERS.
CONSTRUCTION ENTRANCE: LOCATIONS WHERE VEHICLES ENTER OR EXIT THE SITE WILL BE INSPECTED FOR EVIDENCE OF OFF-SITE SEDIMENT TRACKING.

A LOG OF EACH INSPECTION SHALL BE KEPT. THE INSPECTION REPORT IS TO INCLUDE THE FOLLOWING MINIMUM INFORMATION: INSPECTOR'S NAME, DATE OF INSPECTION, OBSERVATIONS RELATIVE TO THE EFFECTIVENESS OF THE POLLUTION CONTROL DEVICES, ACTIONS TAKEN OR NECESSARY TO CORRECT DEFICIENCIES, AND LISTINGS OF AREAS WHERE LAND DISTURBANCE OPERATIONS HAVE PERMANENTLY OR TEMPORARILY STOPPED. THE INSPECTION REPORT SHALL BE SIGNED BY THE PERMITTEE OR BY THE PERSON PERFORMING THE INSPECTION IF DULY AUTHORIZED TO DO SO.

EROSION CONTROL DESCRIPTION:


- 1.) SILT FENCE SHALL BE PLACED AT THE PERIMETER OF THE GRADING AND AT INTERMEDIATE AREAS THROUGHOUT THE SITE AS SHOWN ON THE PLAN. INLET SEDIMENT TRAPS SHALL BE PLACED SURROUNDING ALL STORM INLETS
- 2.) INSTALL TEMPORARY CONSTRUCTION ENTRANCE AS SHOWN ON PLAN

EROSION CONTROL PROCEDURE:

- 1.) SILT FENCE AND TEMPORARY CONSTRUCTION ENTRANCE SHALL BE INSTALLED AT THE PERIMETER OF THE GRADED AREAS PRIOR TO BEGINNING OF CLEARING OR DEMOLITION OPERATIONS. THE CONTRACTOR SHALL INSTALL SILT FENCE AS SHOWN ON PLANS AS GRADING PROGRESSES.

TEMPORARY CONSTRUCTION ENTRANCE NOTES:

- A) INSTALLATION
- 1.) AVOID LOCATING ON STEEP SLOPES OR AT CURVES ON PUBLIC STREETS. IF POSSIBLE, LOCATE WHERE PERMANENT ROADS WILL EVENTUALLY BE CONSTRUCTED
 - 2.) REMOVE ALL VEGETATION AND OTHER UNSUITABLE MATERIAL FROM THE FOUNDATION AREA, GRADE AND CROWN FOR POSITIVE DRAINAGE
 - 3.) IF SLOPE TOWARDS THE PUBLIC ROAD EXCEED 2% CONSTRUCT A 6 TO 8 INCH HIGH RIDGE WITH 3H : 1V SIDE SLOPES ACROSS THE FOUNDATION APPROXIMATELY 15 FEET FROM THE EDGE OF THE PUBLIC ROAD TO DIVERT RUNOFF AWAY FROM IT.
 - 4.) INSTALL PIPE UNDER THE ENTRANCE IF NEEDED TO MAINTAIN DRAINAGE DITCHES ALONG PUBLIC ROADS
 - 5.) PLACE STONE TO DIMENSIONS AND GRADES AS SHOWN ON PLANS. LEAVE SURFACE SMOOTH AND SLOPED FOR DRAINAGE
 - 6.) DIVERT ALL SURFACE RUNOFF AND DRAINAGE FROM THE ENTRANCE TO A SEDIMENT CONTROL DEVICE
 - 7.) IF WET CONDITIONS ARE ANTICIPATED PLACE GEOTEXTILE FABRIC ON THE GRADED FOUNDATION TO IMPROVE STABILITY
- B) TROUBLESHOOTING
- 1.) CONSULT WITH A QUALIFIED DESIGN PROFESSIONAL IF ANY OF THE FOLLOWING OCCUR:
 - INADEQUATE RUNOFF CONTROLS TO THE EXTENT THAT SEDIMENT WASHES ONTO PUBLIC ROADS
 - INSTALL DIVERSIONS OR OTHER RUNOFF CONTROL MEASURES
 - SMALL STONE, THIN PAD, OR ABSENCE OF GEOTEXTILE FABRIC RESULTS IN RUTS AND MUDDY CONDITIONS AS STONE IS PRESSED INTO SOIL - INCREASE STONE SIZE OR PAD THICKNESS OR ADD GEOTEXTILE FABRIC
 - PAD TOO SHORT FOR HEAVY CONSTRUCTION TRAFFIC - EXTEND PAD BEYOND THE MINIMUM 50 FOOT LENGTH AS NECESSARY
- C) INSPECTION AND MAINTENANCE
- 1.) INSPECT STONE PAD AND SEDIMENT DISPOSAL AREA WEEKLY AND AFTER ANY RAIN EVENT
 - 2.) RESHAPE PAD AS NEEDED FOR PROPER DRAINAGE AND RUNOFF CONTROL
 - 3.) TOP DRESS WITH CLEAN 2 AND 3 INCH STONE AS NEEDED
 - 4.) IMMEDIATELY REMOVE MUD OR SEDIMENT TRACKED OR WASHED ONTO PUBLIC ROADWAY. REPAIR ANY BROKEN ROAD PAVEMENT IMMEDIATELY
 - 5.) REMOVE ALL TEMPORARY ROAD MATERIALS FROM AREAS WHERE PERMANENT VEGETATION WILL BE ESTABLISHED

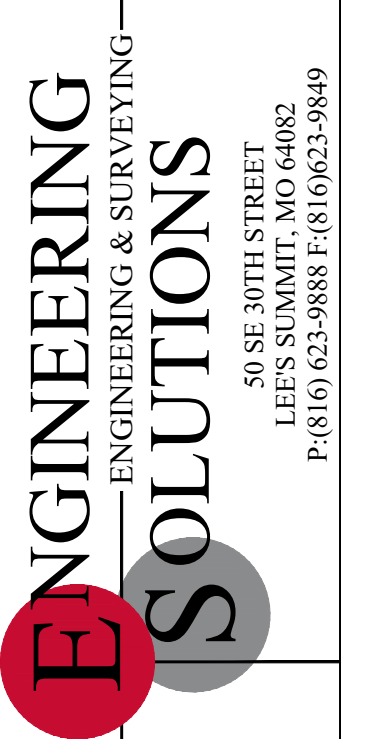


ENGINEERING & SURVEYING SOLUTIONS
 50 SE 30TH STREET
 LEE'S SUMMIT, MO 64082
 P: (816) 623-9888 F: (816) 623-9849

Professional Registration
 Missouri
 Engineering 2005002186-D
 Surveying 2005008319-D
 Kansas
 Engineering E-1685
 Surveying LS-218
 Oklahoma
 Engineering S254
 Nebraska
 Engineering CA2821

Project: THE TOWNHOMES OF CHAPEL RIDGE-2ND PLAT LOTS 9-19 & TRACTS A-D
 Issue Date: April 10, 2020




ESC PHASE 2 - Inactive Area Stabilization Plan
 Construction Plans for:
 THE TOWNHOMES OF CHAPEL RIDGE-2ND PLAT LOTS 9-19 & TRACTS A-D
 Lee's Summit, Jackson County, Missouri

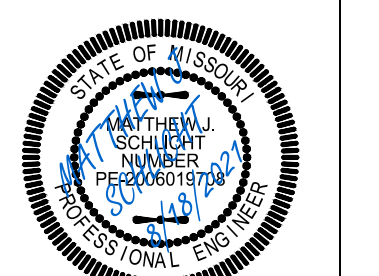

Matthew J. Schlicht
 MO PE 2006019708
 KS PE 19071
 OK PE 25226
 NE PE E-14335

REVISIONS
 6/25/2021 As-Built
 8/18/2021 As-Built

"AS-BUILT"
 900.10
~~900.00~~ Indicates data replaced with "As-Built" information. All other data is as designed and has not been field verified.

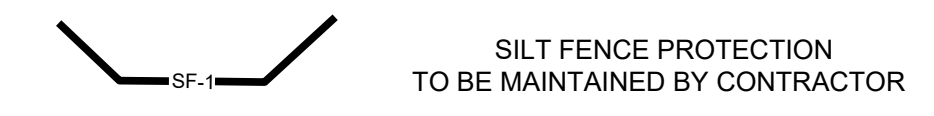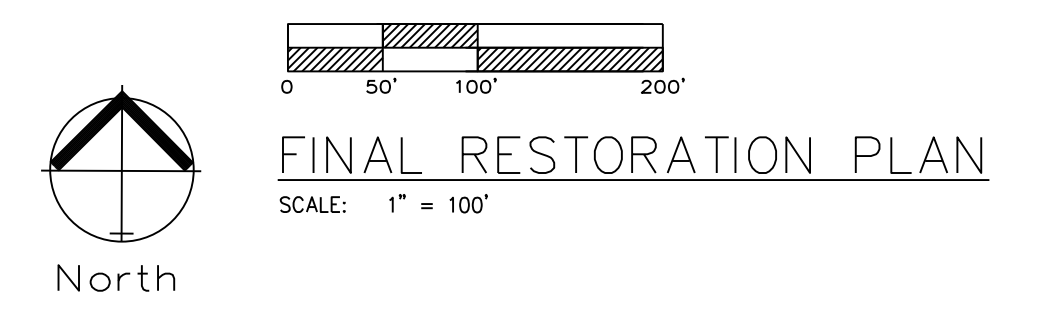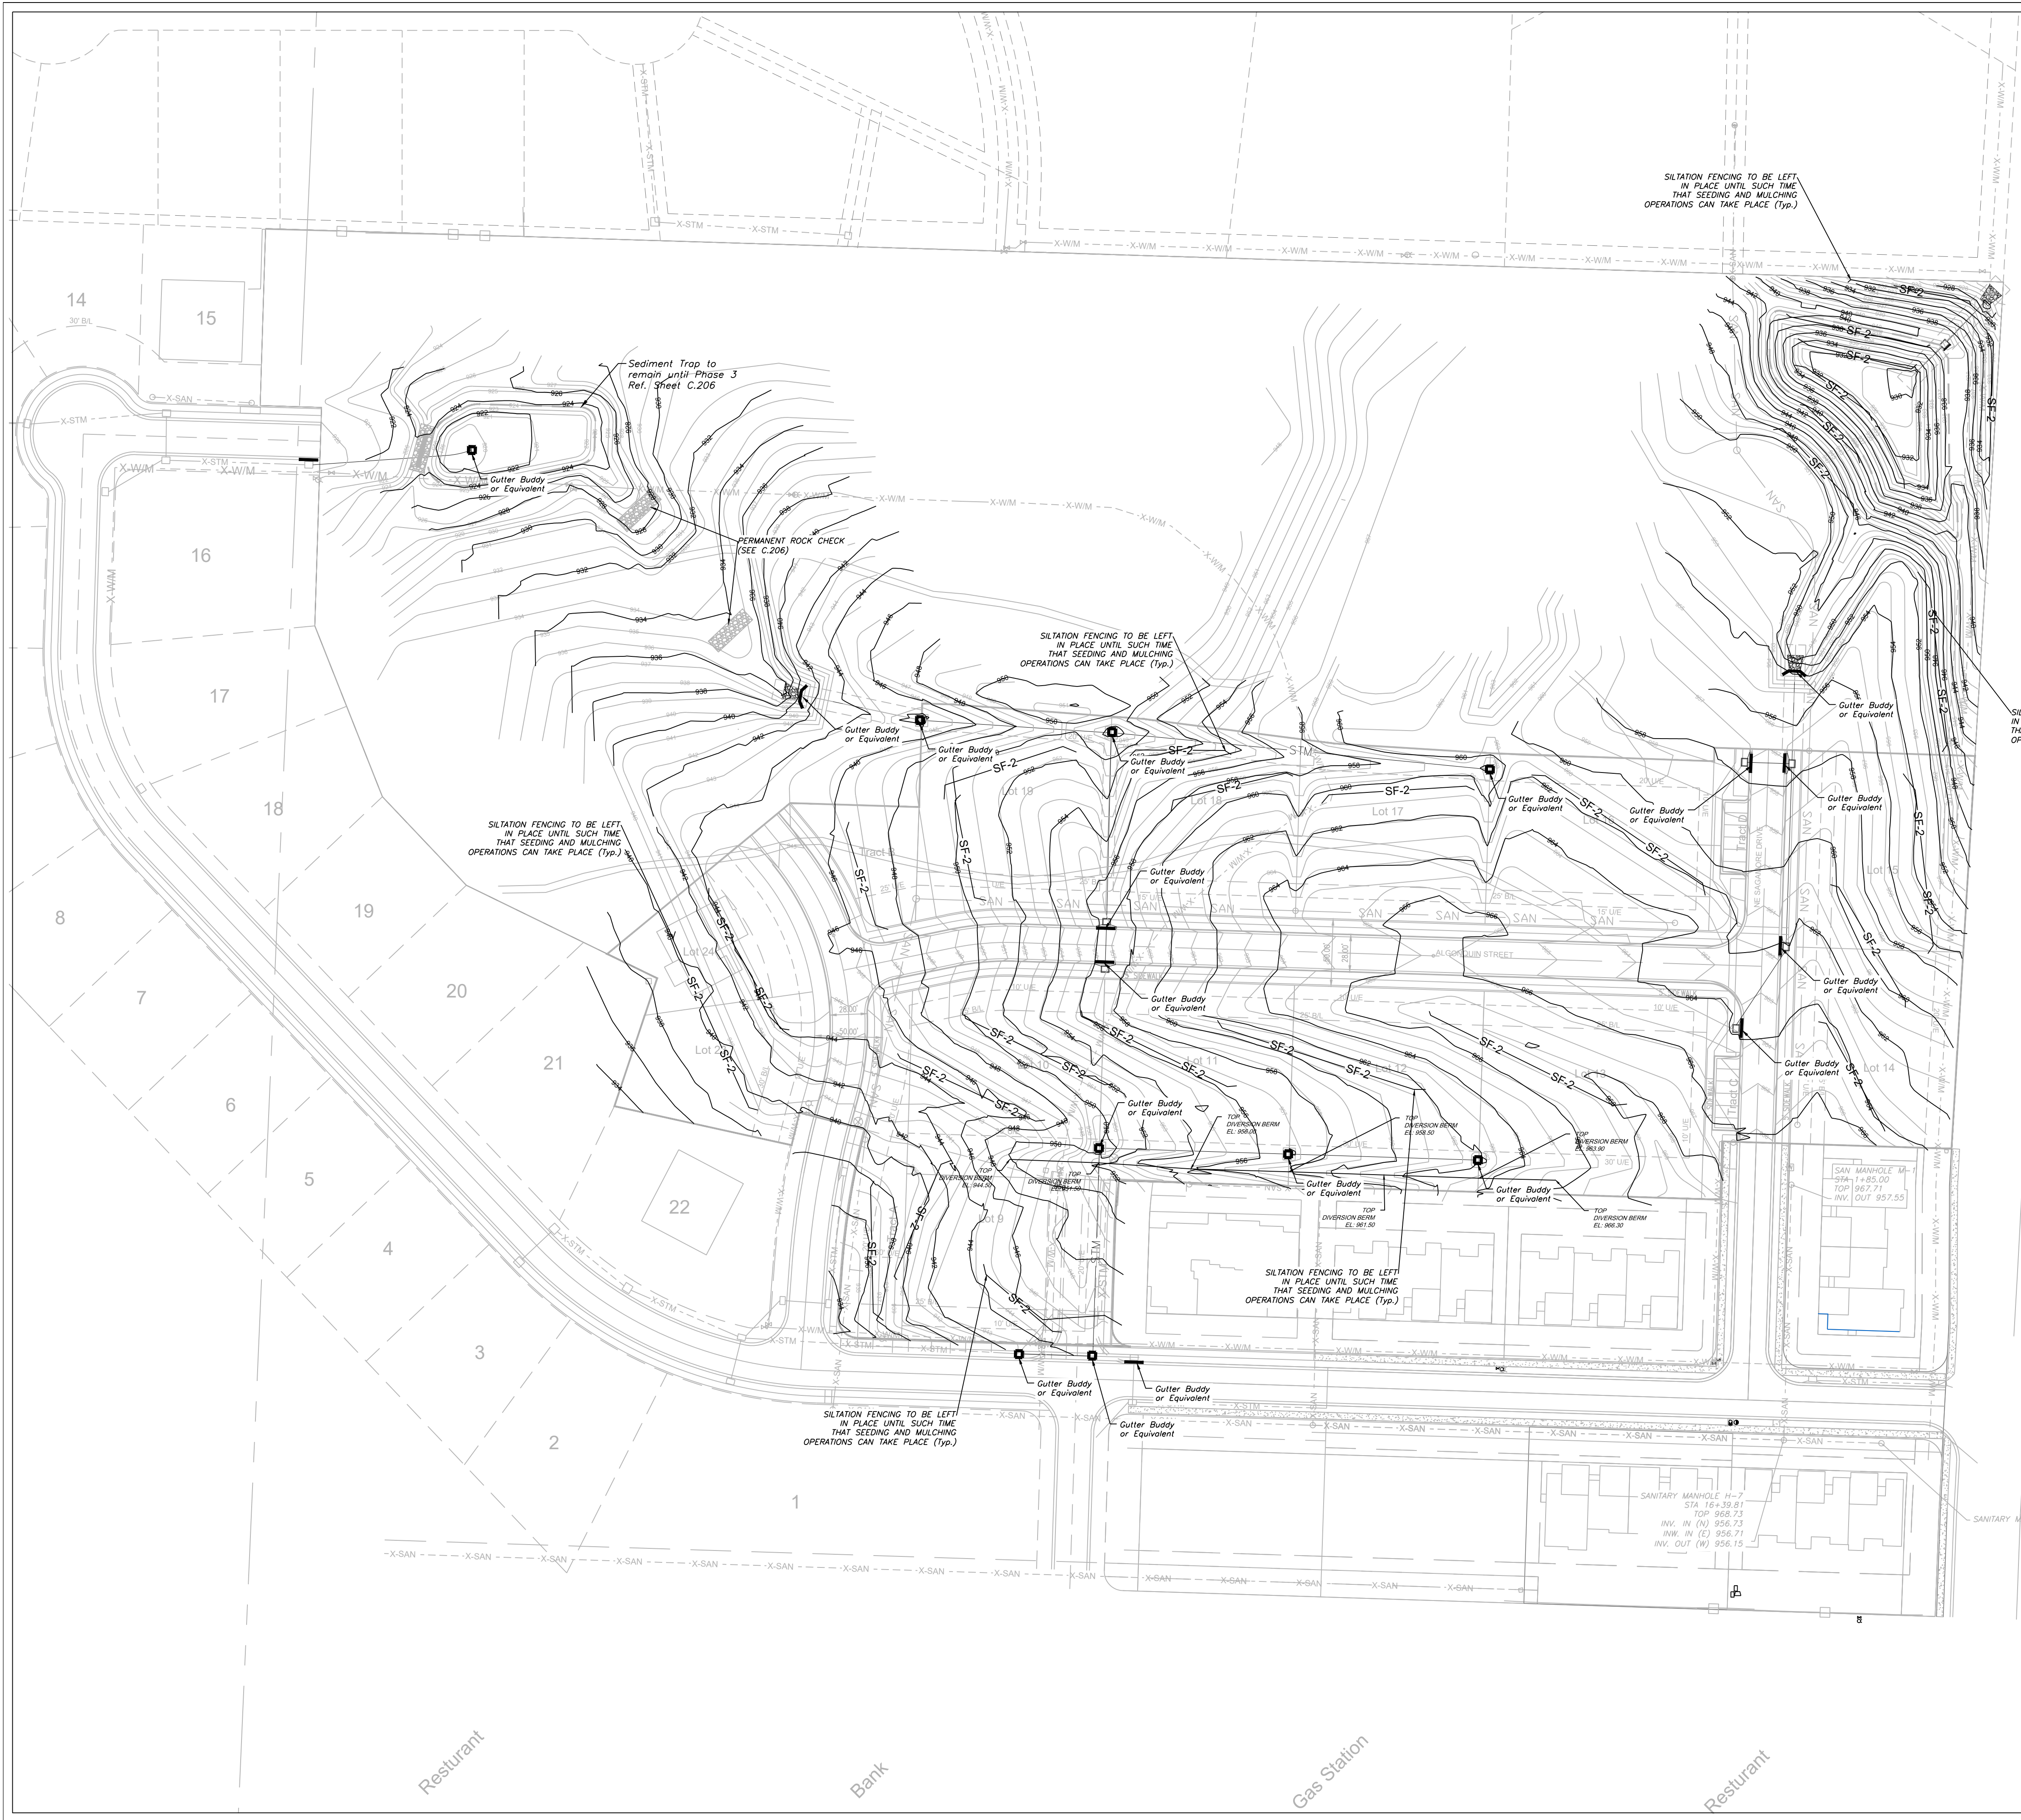

LEGEND

PHASE 1 SILT FENCE	— SF-1 —	SF-1
PHASE 2 SILT FENCE	— SF-2 —	SF-2
INLET PROTECTION	—	
GUTTER BUDDY OR EQUIVALENT	—	

DURING ALL PHASES OF CONSTRUCTION, INACTIVE AREA STABILIZATION METHODS AS DESCRIBED IN APWA SECTION 5111.3 SHALL BE USED TO CONTROL EROSION AND SILTATION.

NOTES: The Land Disturbance Plans indicates the Final placement of erosion control devices. The contractor(s) may proceed with construction prior to the final placement of these devices by providing additional devices to control erosion on their items of work. These devices shall be maintained until the final devices are in place.

SEED AND MULCH NOTES:


All areas disturbed by construction activities shall be seeded and mulched. Seeding shall be done before the proposed seedbed becomes eroded, crusted over, or dried out and shall not be done when the ground is frozen, or covered with snow. The seed shall comply with the requirements of the Missouri Seed Law and the Federal Seed Act. Also, it shall contain no seed of any plant on the Federal Noxious Weed List. Other weed seeds shall not exceed one percent by weight of mix.

Seed and Fertilizer Rate:
 Mix I - Rye Grass / Blue Grass — 100 lbs. per Acre
 Mix II - Tall Fescue / Blue Grass — 195 lbs. per Acre
 Lime — 2000 lbs per Acre (50 lbs. per 1000 sq. ft.)
 Fertilizer — 800 to 1200 lbs per Acre (25 lbs per 1000 sq. ft.)

During the dates December 15th through May 31 ALL lime fertilizer, seed and mulch shall be applied to finished slopes of disturbed areas. During the months of June, July, October and November 1st through December 15th, lime fertilizer, seed and mulch shall be applied at the following rates:
 Lime - 100% of specified quantity
 Fertilizer - 75% of the specified quantity
 Seed - 50% of the specified quantity
 Mulch - 100% of the specified quantity

Mulch shall be Vegetative type, cereal straw from stalks of oats, rye, or barley, or approved equal. The straw shall be free of prohibited weed seed and relatively free of all other noxious and undesirable seed. Mulch shall be applied at the rate of 2 tons per acre, (70 to 90 lbs per 1000 sq. ft.). Mulch shall be embedded by a mulch anchoring tool or disk type roller having flat serrated disks spaced not more than 10 inches apart and cleaning scrapers shall be provided

ONCE SITE IS 90% VEGETATED ALL ESC DEVICES SHALL BE REMOVED AND ANY DISTURBED AREAS SHALL BE RESTORED

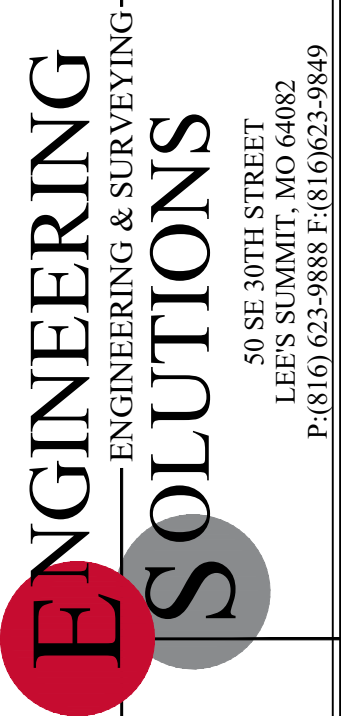

Professional Registration
 Missouri
 Engineering 2005002186-D
 Surveying 2005008319-D
 Kansas
 Engineering E-1685
 Surveying LS-218
 Oklahoma
 Engineering S254
 Nebraska
 Engineering CA2821

Project: THE TOWNHOMES OF CHAPEL RIDGE-2ND PLAT LOTS 9-19 & TRACTS A-D
 Lee's Summit, Jackson County, Missouri

Project: VILLAGES OF CHAPEL RIDGE-LSMO
 Issue Date: April 10, 2020


ESC PHASE 3 - Final Restoration Plan
 Construction Plans for:
 THE TOWNHOMES OF CHAPEL RIDGE-2ND PLAT LOTS 9-19 & TRACTS A-D
 Lee's Summit, Jackson County, Missouri




Matthew J. Schlicht
 MO PE 2006019708
 KS PE 19071
 OK PE 25226
 NE PE E-14335

REVISIONS
 6/25/2021 As-Built
 8/18/2021 As-Built


"AS-BUILT"
 900.10
 900.00 Indicates data replaced with "As-Built" information. All other data is as designed and has not been field verified.

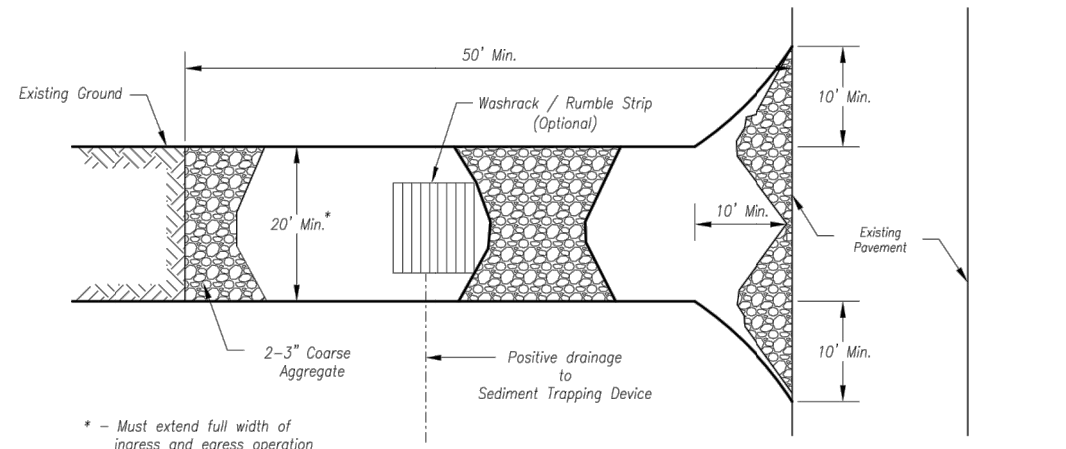

Plan View
Not to Scale

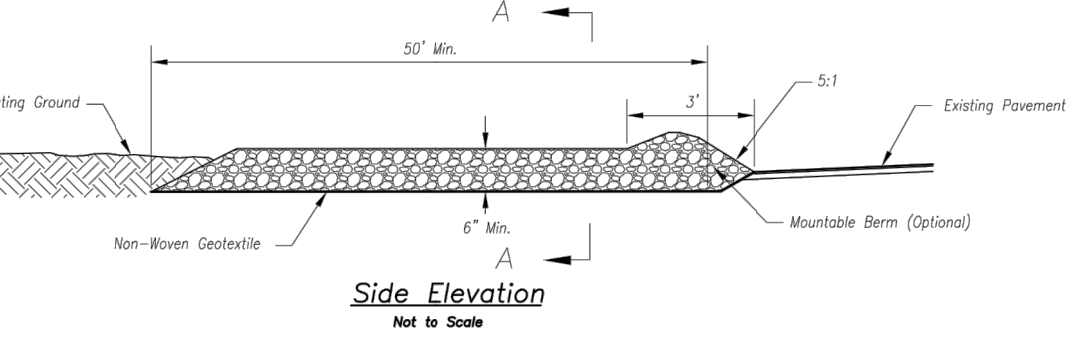

Side Elevation
Not to Scale

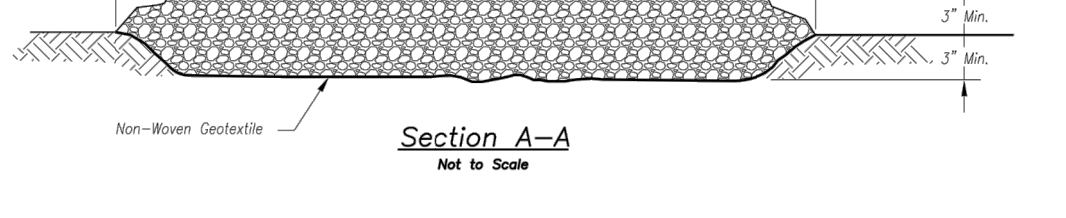

Section A-A
Not to Scale


- Notes for Concrete Washout:**
- Concrete washout area shall be installed prior to any concrete placement on site.
 - Concrete washout area shall include a filter subsurface all steel relative to the amount of concrete to be placed on site. The slopes leading out of the subsurface pit shall be 2:1. The vehicle tracking post shall be sloped towards the concrete washout area.
 - Vehicle tracking control is required at the access point to all concrete washout areas.
 - Signs shall be placed at the construction site entrance, washout area and elsewhere as necessary to clearly indicate the location(s) of the concrete washout area(s) to operators of concrete truck and pump rigs.
 - A one-piece impedance liner may be required along the bottom and sides of the subsurface pit in sandy or gravelly soils.

- Maintenance for Concrete Washout:**
- Concrete washout materials shall be removed once the materials have filled the washout to approximately 75% full.
 - Concrete washout areas shall be enlarged as necessary to maintain capacity for washed concrete.
 - Concrete washout water, wasted pieces of concrete and all other debris in the subsurface pit shall be transported from the job site in a water-tight container and disposed of properly.
 - Concrete washout areas shall remain in place until all concrete for the project is placed.
 - When concrete washout areas are removed, excavations shall be filled with suitable compacted backfill and topped with dispersed areas associated with the installation, maintenance, and/or removal of the concrete washout areas shall be established.

- Maintenance for Construction Entrance:**
- Reshape entrance as needed to maintain function and integrity of installation. Top areas with clean aggregate as needed.


- Notes for Construction Entrance:**
- Avoid locating on steep slopes, at curves on public roads, or adjacent to disturbed area.
 - Remove all vegetation and other unsuitable material from the foundation area, grade, and crown for positive drainage.
 - If slope favors the public road exceeds 2X, construct a 6" to 8-inch high ridge with 30:1V side slopes across the foundation approximately 15 feet from the edge of the public road to divert runoff from it.
 - Install pipe under the entrance if needed to maintain drainage ditches along public roads.
 - Place stone to dimensions and grade as shown on plans. Leave surface sloped for drainage.
 - Direct all surface runoff and drainage from the entrance to a sediment control device.
 - If conditions warrant, place geotextile fabric on the graded foundation to improve stability.

CONSTRUCTION ENTRANCE

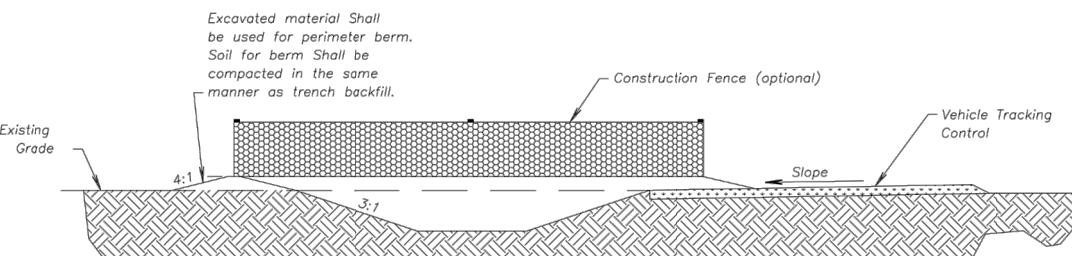

CONCRETE WASHOUT


AMERICAN PUBLIC WORKS ASSOCIATION
 KANSAS CITY METRO CHAPTER
 CONSTRUCTION ENTRANCE AND CONCRETE WASHOUT
 STANDARD DRAWING NUMBER ESC-01
 ADOPTED 10/24/2016

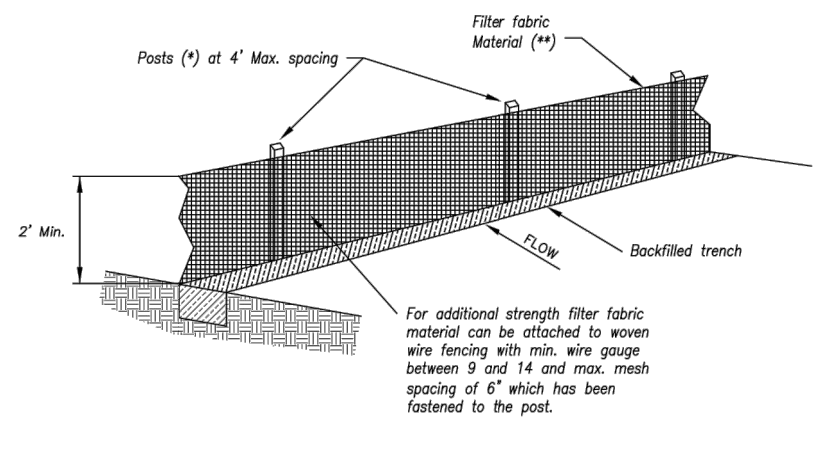


- (*) EOSTS**
- MIN LENGTH 4'
 - HARDWOOD 1 1/2" x 1 1/2"
 - NO.2 SOUTHERN PINE 2 1/2" x 2 1/2"
 - STEEL 1.33 LB/YT

(**) - Geotextile Fabric shall meet the requirements of AASHTO M288

SILT FENCE DETAILS


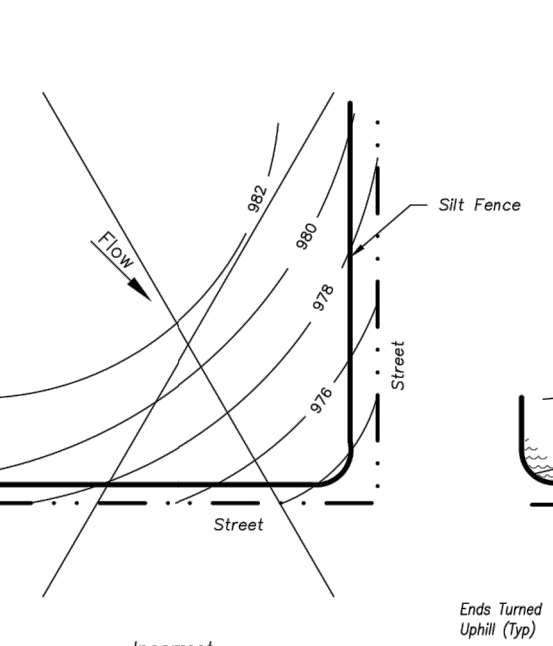


Incorrect

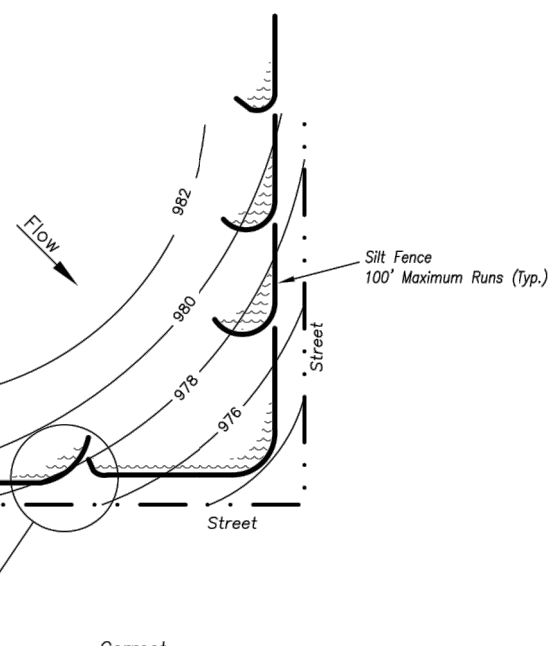

Correct

SILT FENCE LAYOUT

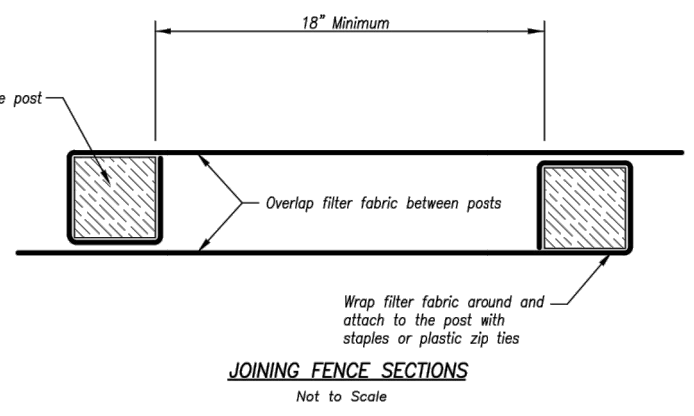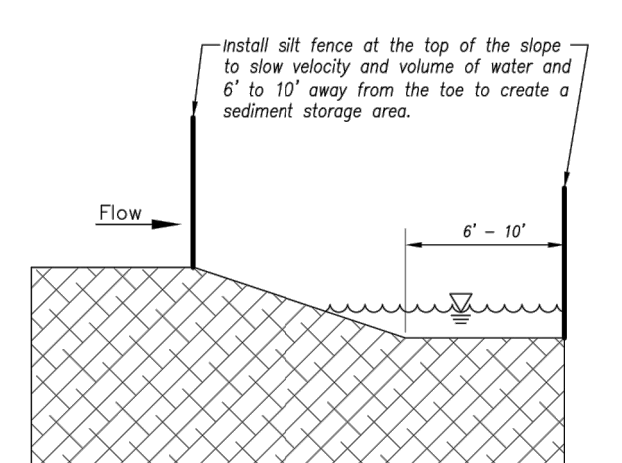

JOINING FENCE SECTIONS
Not to Scale


- Notes:**
- In order to contain water, the ends of the silt fence must be turned uphill (Figure A).
 - Long perimeter runs of silt fence must be limited to 100'. Runs should be broken up into several smaller segments to minimize water concentrations (Figure A).
 - Long slopes should be broken up with intermediate rows of silt fence to slow runoff velocities.
 - Attach fabric to upstream side of post.
 - Install posts a minimum of 2' into the ground.
 - Trenching will only be allowed for small or difficult installation, where slicing machine cannot be reasonably used.

Maintenance:


- Remove and dispose of sediment deposits when the deposit approaches 1/2 the height of silt fence.
- Repair as necessary to maintain function and structure.

AMERICAN PUBLIC WORKS ASSOCIATION
 KANSAS CITY METRO CHAPTER
 SILT FENCE
 STANDARD DRAWING NUMBER ESC-03
 ADOPTED 10/24/2016


Modified from 2015 Overland Park Standard Details for Erosion and Sediment Control.

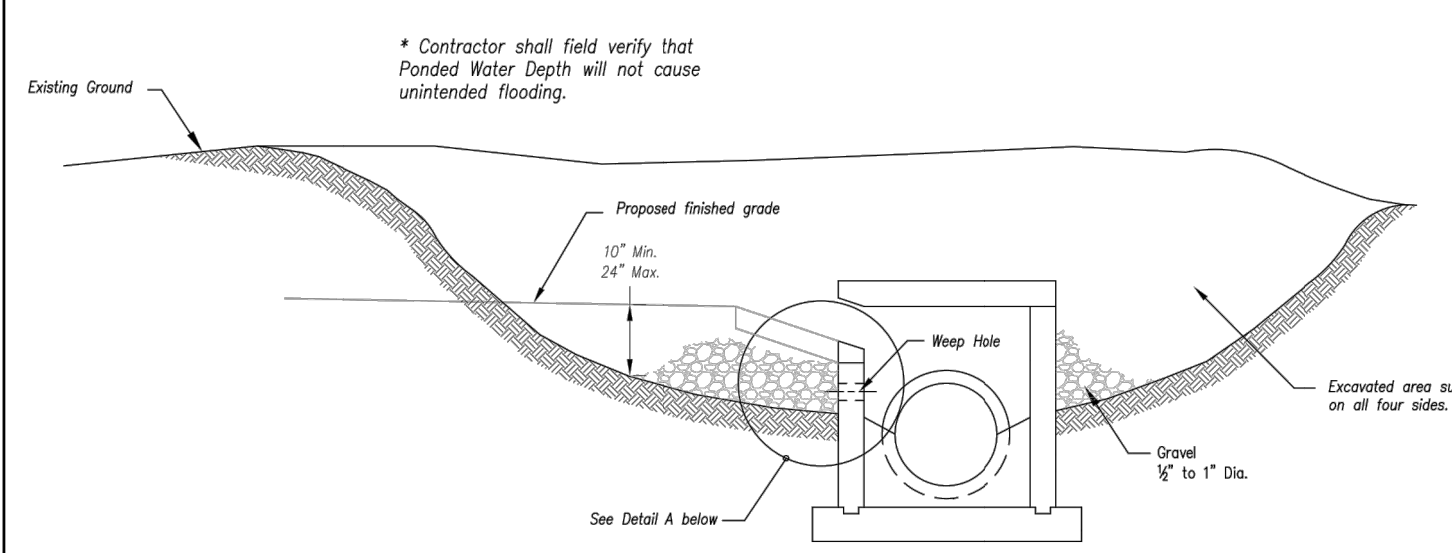

See Detail A below

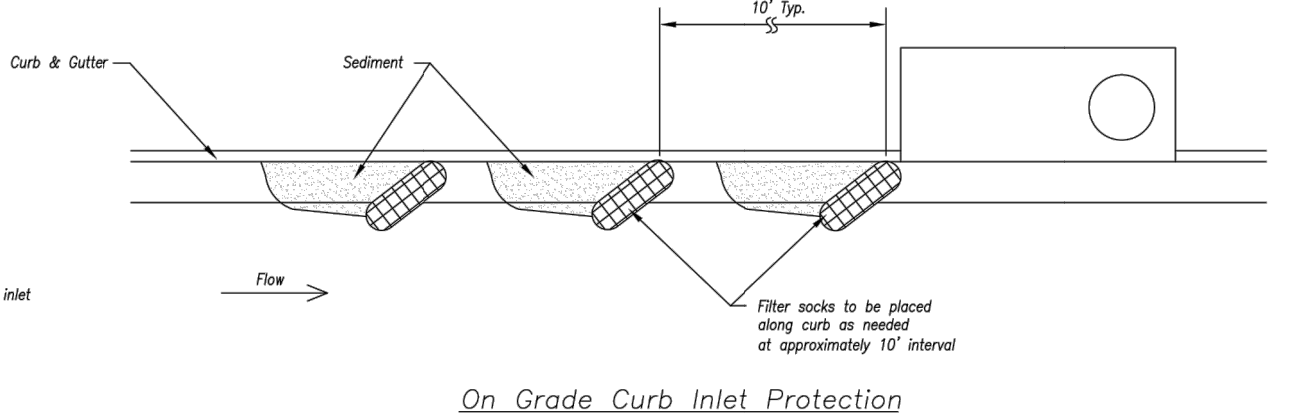

On Grade Curb Inlet Protection

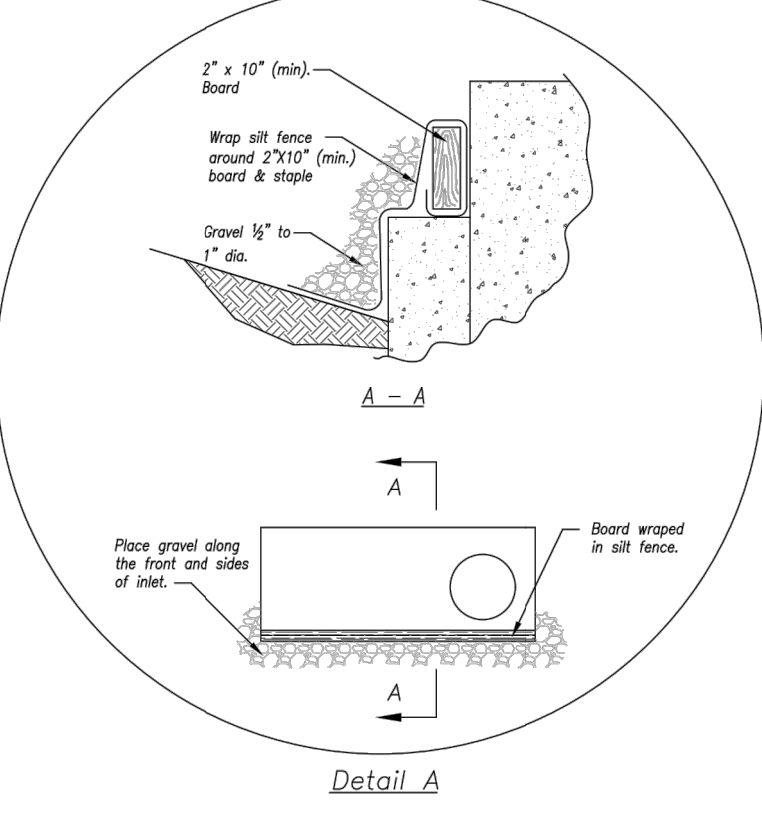


Detail A

Notes:

- Immediately following inlet construction and prior to construction of curb and inlet throat, protect inlet opening by installing 2" x 10" (min.) board wrapped in silt fence. Structures shall have excavated storage area on all four sides to allow settling of sediment (Early Stage Curb Inlet).
- When inlet is completed and curb poured, filter socks or approved equal should be used (Late Stage Curb Inlet). Straw within are not approved for curb inlet use.
- Continual to field verify pouring water shall not create a traffic hazard.

Maintenance:

- Remove deposited sediment from excavated storage areas when available storage has been reduced by 20%.
- Remove deposited sediment from filter socks or similar when any accumulation of sediment is visible.
- Repair or replace as necessary to maintain function and integrity of installation.

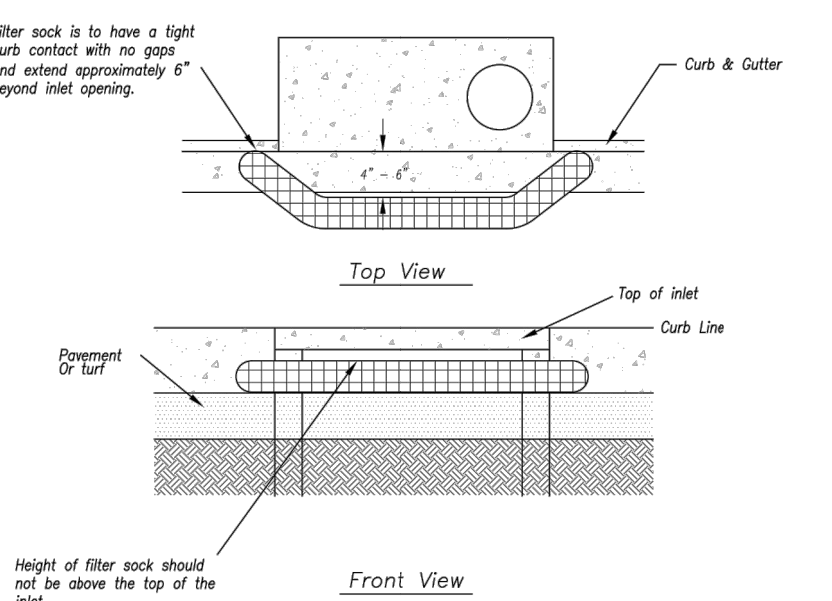


Sump Inlet Sediment Filter


LATE STAGE CURB INLET (After Pouring Curb and Inlet Throat)

AMERICAN PUBLIC WORKS ASSOCIATION
 KANSAS CITY METRO CHAPTER
 CURB INLET PROTECTION
 STANDARD DRAWING NUMBER ESC-06
 ADOPTED 10/24/2016

Modified from 2015 Overland Park Standard Details for Erosion and Sediment Control.

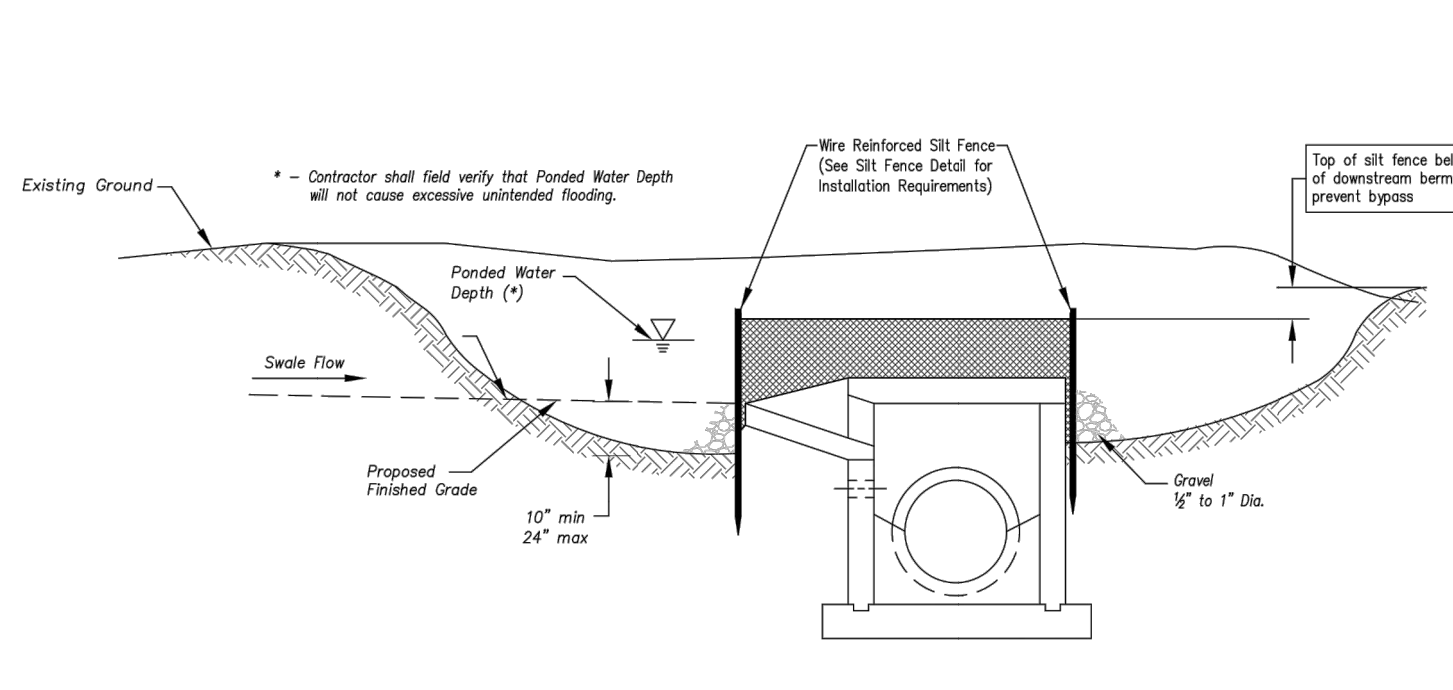

Section A-A
Not to Scale

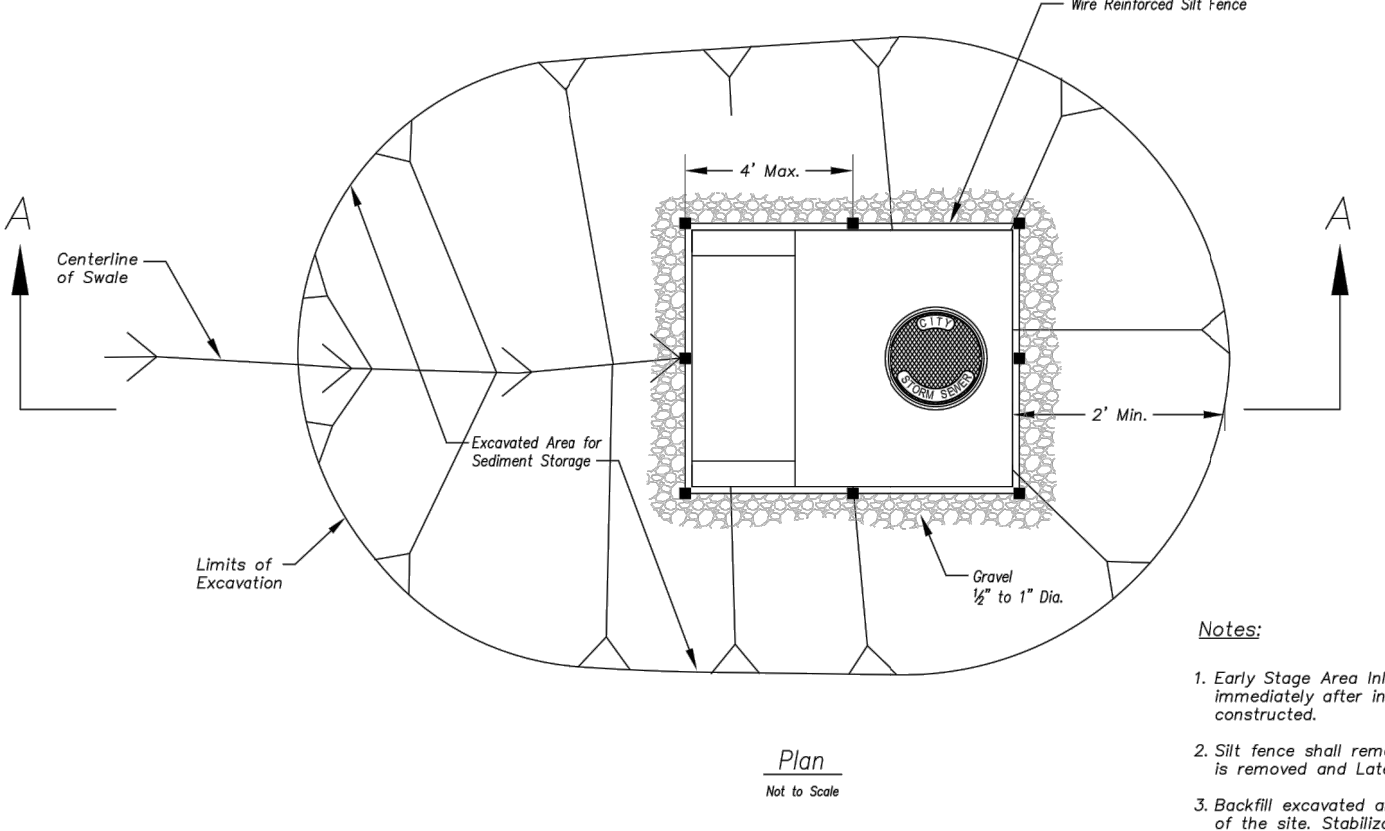


Plan
Not to Scale

EARLY STAGE AREA INLET (All open boxes and inlets not at final grade)

Notes:

- Early Stage Area Inlet Sediment Barrier to be installed immediately after inlet or junction box is constructed.
- Silt fence shall remain in place until excavated area is removed and Late Stage Area Inlet is being installed.
- Backfill excavated area ONLY after final grading of the site. Stabilization of the site is to immediately follow.
- Wire reinforced silt fence may be used in place of silt fence attached to wood frame.

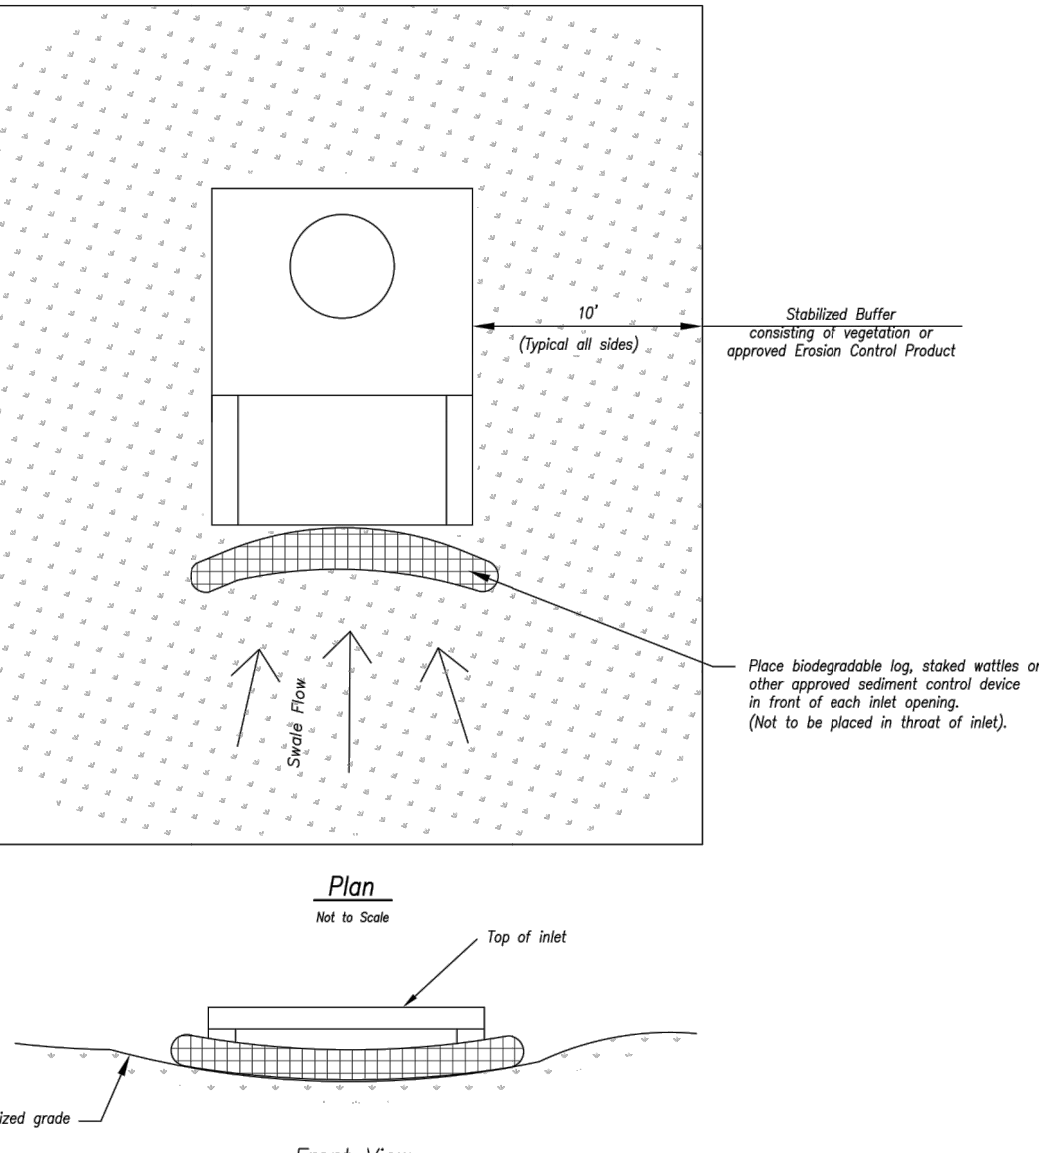


LATE STAGE AREA INLET (Area inlets at final grade and existing inlets)



Maintenance:

- Remove deposited sediment from excavated storage areas when available storage has been reduced by 20%.
- Remove deposited sediment from filter socks or similar when any accumulation of sediment is visible.
- Repair or replace as necessary to maintain function and integrity of installation.

AMERICAN PUBLIC WORKS ASSOCIATION
 KANSAS CITY METRO CHAPTER
 AREA INLET AND JUNCTION BOX PROTECTION
 STANDARD DRAWING NUMBER ESC-07
 ADOPTED 10/24/2016

Modified from 2015 Overland Park Standard Details for Erosion and Sediment Control.

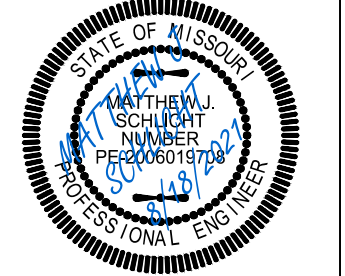

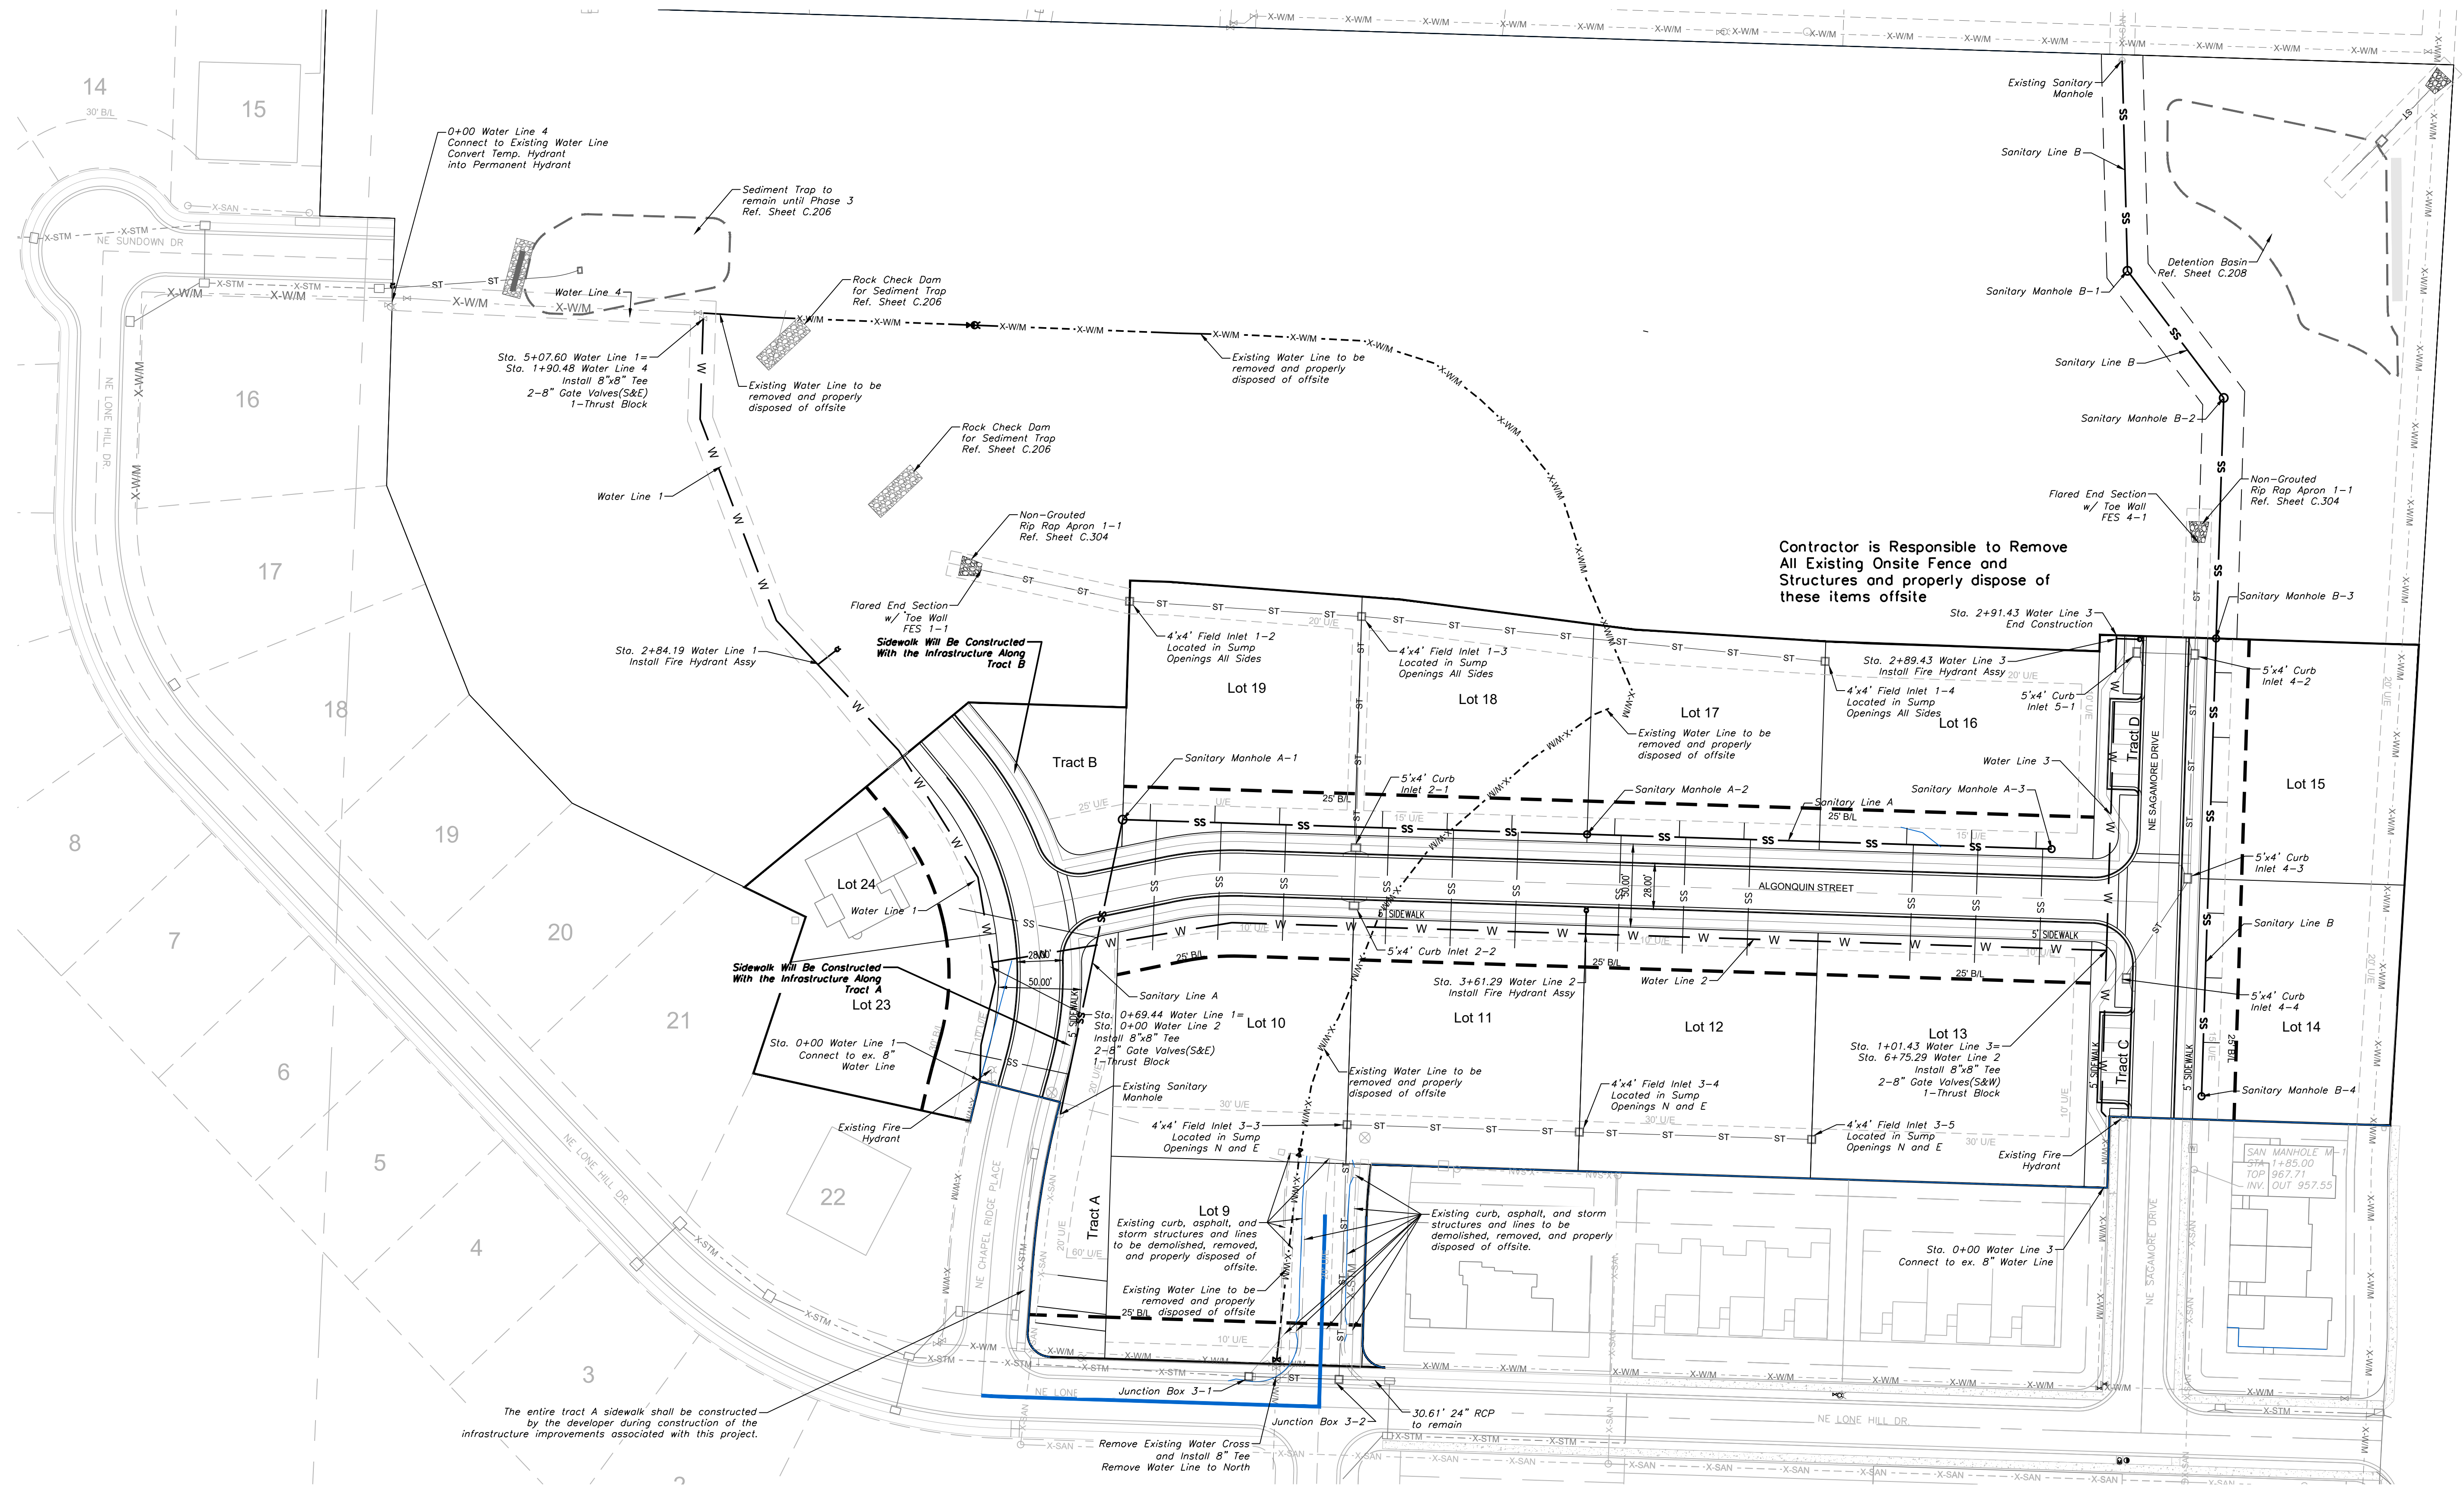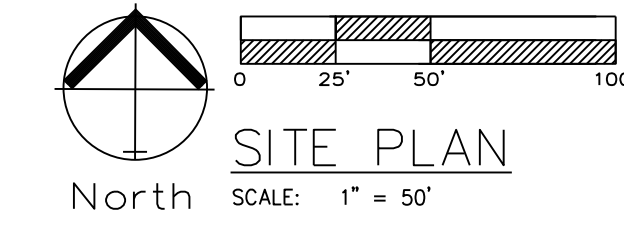


Professional Registration
 Missouri
 Engineering 2005002186-D
 Surveying 2005008319-D
 Kansas
 Engineering E-1695
 Surveying LS-218
 Oklahoma
 Engineering 6254
 Nebraska
 Engineering CA2821

**THE TOWNHOMES OF CHAPEL RIDGE-2ND PLAT
 LOTS 9-19 & TRACTS A-D**
 Lee's Summit, Jackson County, Missouri

Project: VILLAS OF CHAPEL RIDGE-2ND PLAT
 Issue Date: April 10, 2020

Site Plan
 Construction Plans for:
**THE TOWNHOMES OF CHAPEL RIDGE-2ND PLAT
 LOTS 9-19 & TRACTS A-D**
 Lee's Summit, Jackson County, Missouri

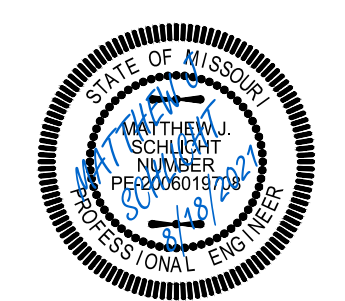

Matthew J. Schlicht
 MO PE 2006019708
 KS PE 19071
 OK PE 25226
 NE PE E-14335


REVISIONS
 6/25/2021 As-Built
 8/18/2021 As-Built

**Contractor is Responsible to Remove
 All Existing Onsite Fence and
 Structures and properly dispose of
 these items offsite**

"AS-BUILT"
 900.10
 9000.00 Indicates data replaced with "As-Built"
 information. All other data is as designed
 and has not been field verified.

All Grading Shown to be completed with this phase

NOTE: See Sheet C.201 for Swale Data.

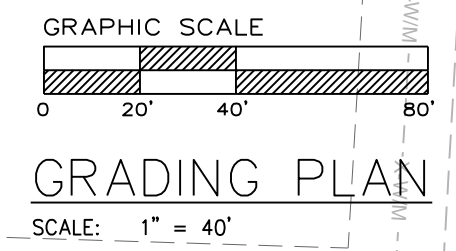

"AS-BUILT"


900.10
~~900.00~~ Indicates data replaced with "As-Built" information. All other data is as designed and has not been field verified.



Estimated Cut / Fill Quantities

Site Area	7.32 Acres
Cut Volume (Unadjusted)	29,628 c.y.
Fill Volume (Unadjusted)	30,922 c.y.
Street & Sidewalk Cut Volume	1,820 c.y.
Net Excess	3,114 c.y. (Unadjusted)(Cut)

- Notes
- Contractor is responsible for verifying all existing utility locations prior to excavation
 - There are no known natural or artificial water storage detention areas, or wetlands in the area designated for construction
 - No part of the project lies within the 100 year flood plain
 - All erosion and sediment control measures need to be implemented prior to construction
 - Additional erosion control may be required by the City Engineer, Design Engineer or Owner at any time problematic areas are noted in the field or existing measures are found to be ineffective
 - Soil Stabilization of disturbed areas shall be completed within 14 days of construction inactivity
 - Contractor responsible for all density testing of roadway subgrade and granular base.

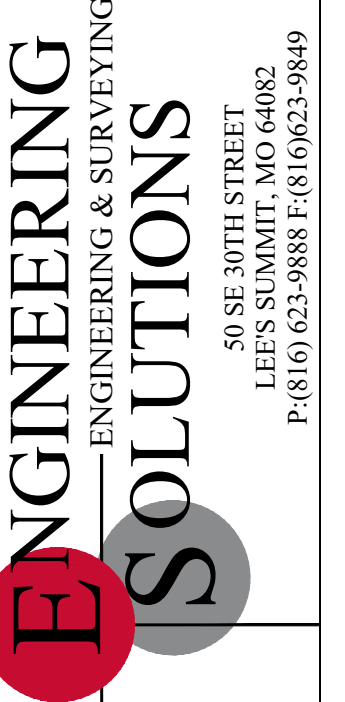


Professional Registration
 Missouri
 Engineering 2005002186-D
 Surveying 2005008319-D
 Kansas
 Engineering E-1685
 Surveying LS-218
 Oklahoma
 Engineering S254
 Nebraska
 Engineering CA2821

Project:
 VILLAGES OF CHAPEL RIDGE LSMD
 Issue Date:
 April 10, 2020


THE TOWNHOMES OF CHAPEL RIDGE-2ND PLAT
 LOTS 9-19 & TRACTS A-D
 Lee's Summit, Jackson County, Missouri

Master Drainage Plan 1 of 3:
 Grading Plan
 Construction Plans for:
 THE TOWNHOMES OF CHAPEL RIDGE-2ND PLAT
 LOTS 9-19 & TRACTS A-D
 Lee's Summit, Jackson County, Missouri

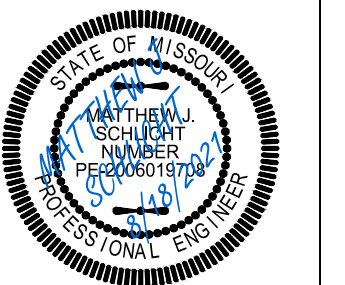

Matthew J. Schlicht
 MO PE 2006019708
 KS PE 19071
 OK PE 25226
 NE PE E-14335

REVISIONS
 6/25/2021 As-Built
 8/18/2021 As-Built

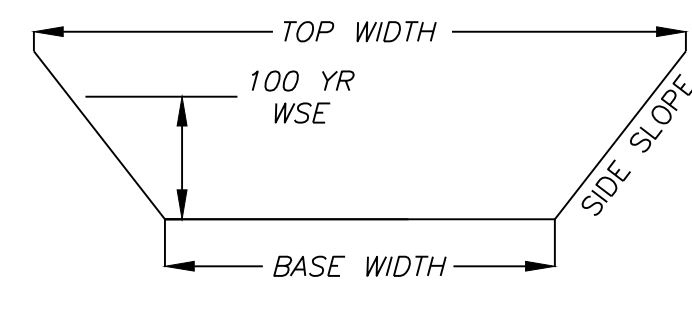


TYPICAL CHANNEL SECTION
SWALE DETAIL
Not To Scale


100 YEAR OVERFLOW SWALE SECTIONS									
Section	100 Yr. Runoff (c.f.s.)	Bed Slope (%)	Base Width (ft)	Side Slope (1:V)	100 Yr WSE (ft)	Sectional Area (f.p.s.)	Velocity 100Yr. (f.p.s.)	Hydraulic Radius (ft)	Shear Stress (p.s.f.)
A-A	1.35	6.67	4	5	0.11	0.50	2.70	0.10	0.42
B-B	2.37	6.67	6	5	0.13	0.86	2.74	0.12	0.49
C-C	3.60	6.67	4	5	0.20	1.00	3.60	0.17	0.69
D-D	2.50	6.67	6	5	0.13	0.86	2.89	0.12	0.49
E-E	3.60	2.72	6	5	0.21	1.48	2.43	0.18	0.31
F-F	1.03	6.67	6	5	0.08	0.51	2.01	0.08	0.31
G-G	3.00	5.00	5	3	0.18	1.00	3.01	0.16	0.51
H-H	3.73	4.16	5	5	0.21	1.27	2.94	0.18	0.46
I-I	3.37	4.00	5	3	0.20	1.12	3.01	0.18	0.45

NOTE: Swale sections extend the entire length between upstream and downstream structures with the exception of a transition at each structure.
NOTE: Swale should be lined with "Straw with Net" turf reinforcement (Curlex Blanket or Eqv.) . Per Table 5607-1 in APWA Manual

Townhomes Lot Number	Basement Type	MBOE Lt.	MBOE Rt.
9	Full	940.8	951.0
10	Daylight	951.2	940.8
11	Daylight	958.1	951.2
12	Daylight	963.9	958.1
13	Full	966.0	963.9
14	Daylight	957.4	964.9
15	Walkout	946.5	957.4
16	Walkout	960.3	960.0
17	Walkout	959.1	960.3
18	Walkout	950.2	959.1
19	Daylight	946.2	950.2
Estates 23	Walkout	935.0	939.3
24	Walkout	939.3	939.2

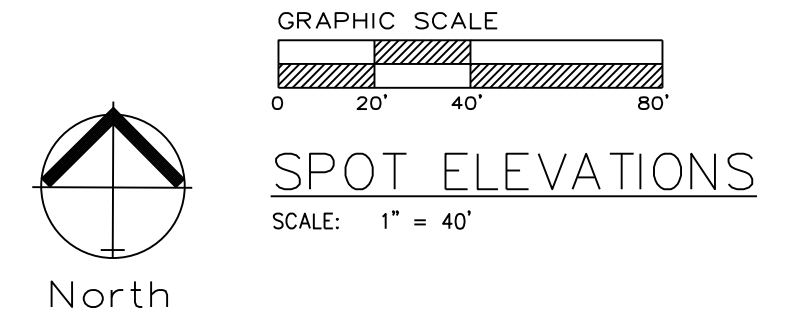

Note:
AS GRADED PLOT PLAN REQUIRED FOR EACH LOT.

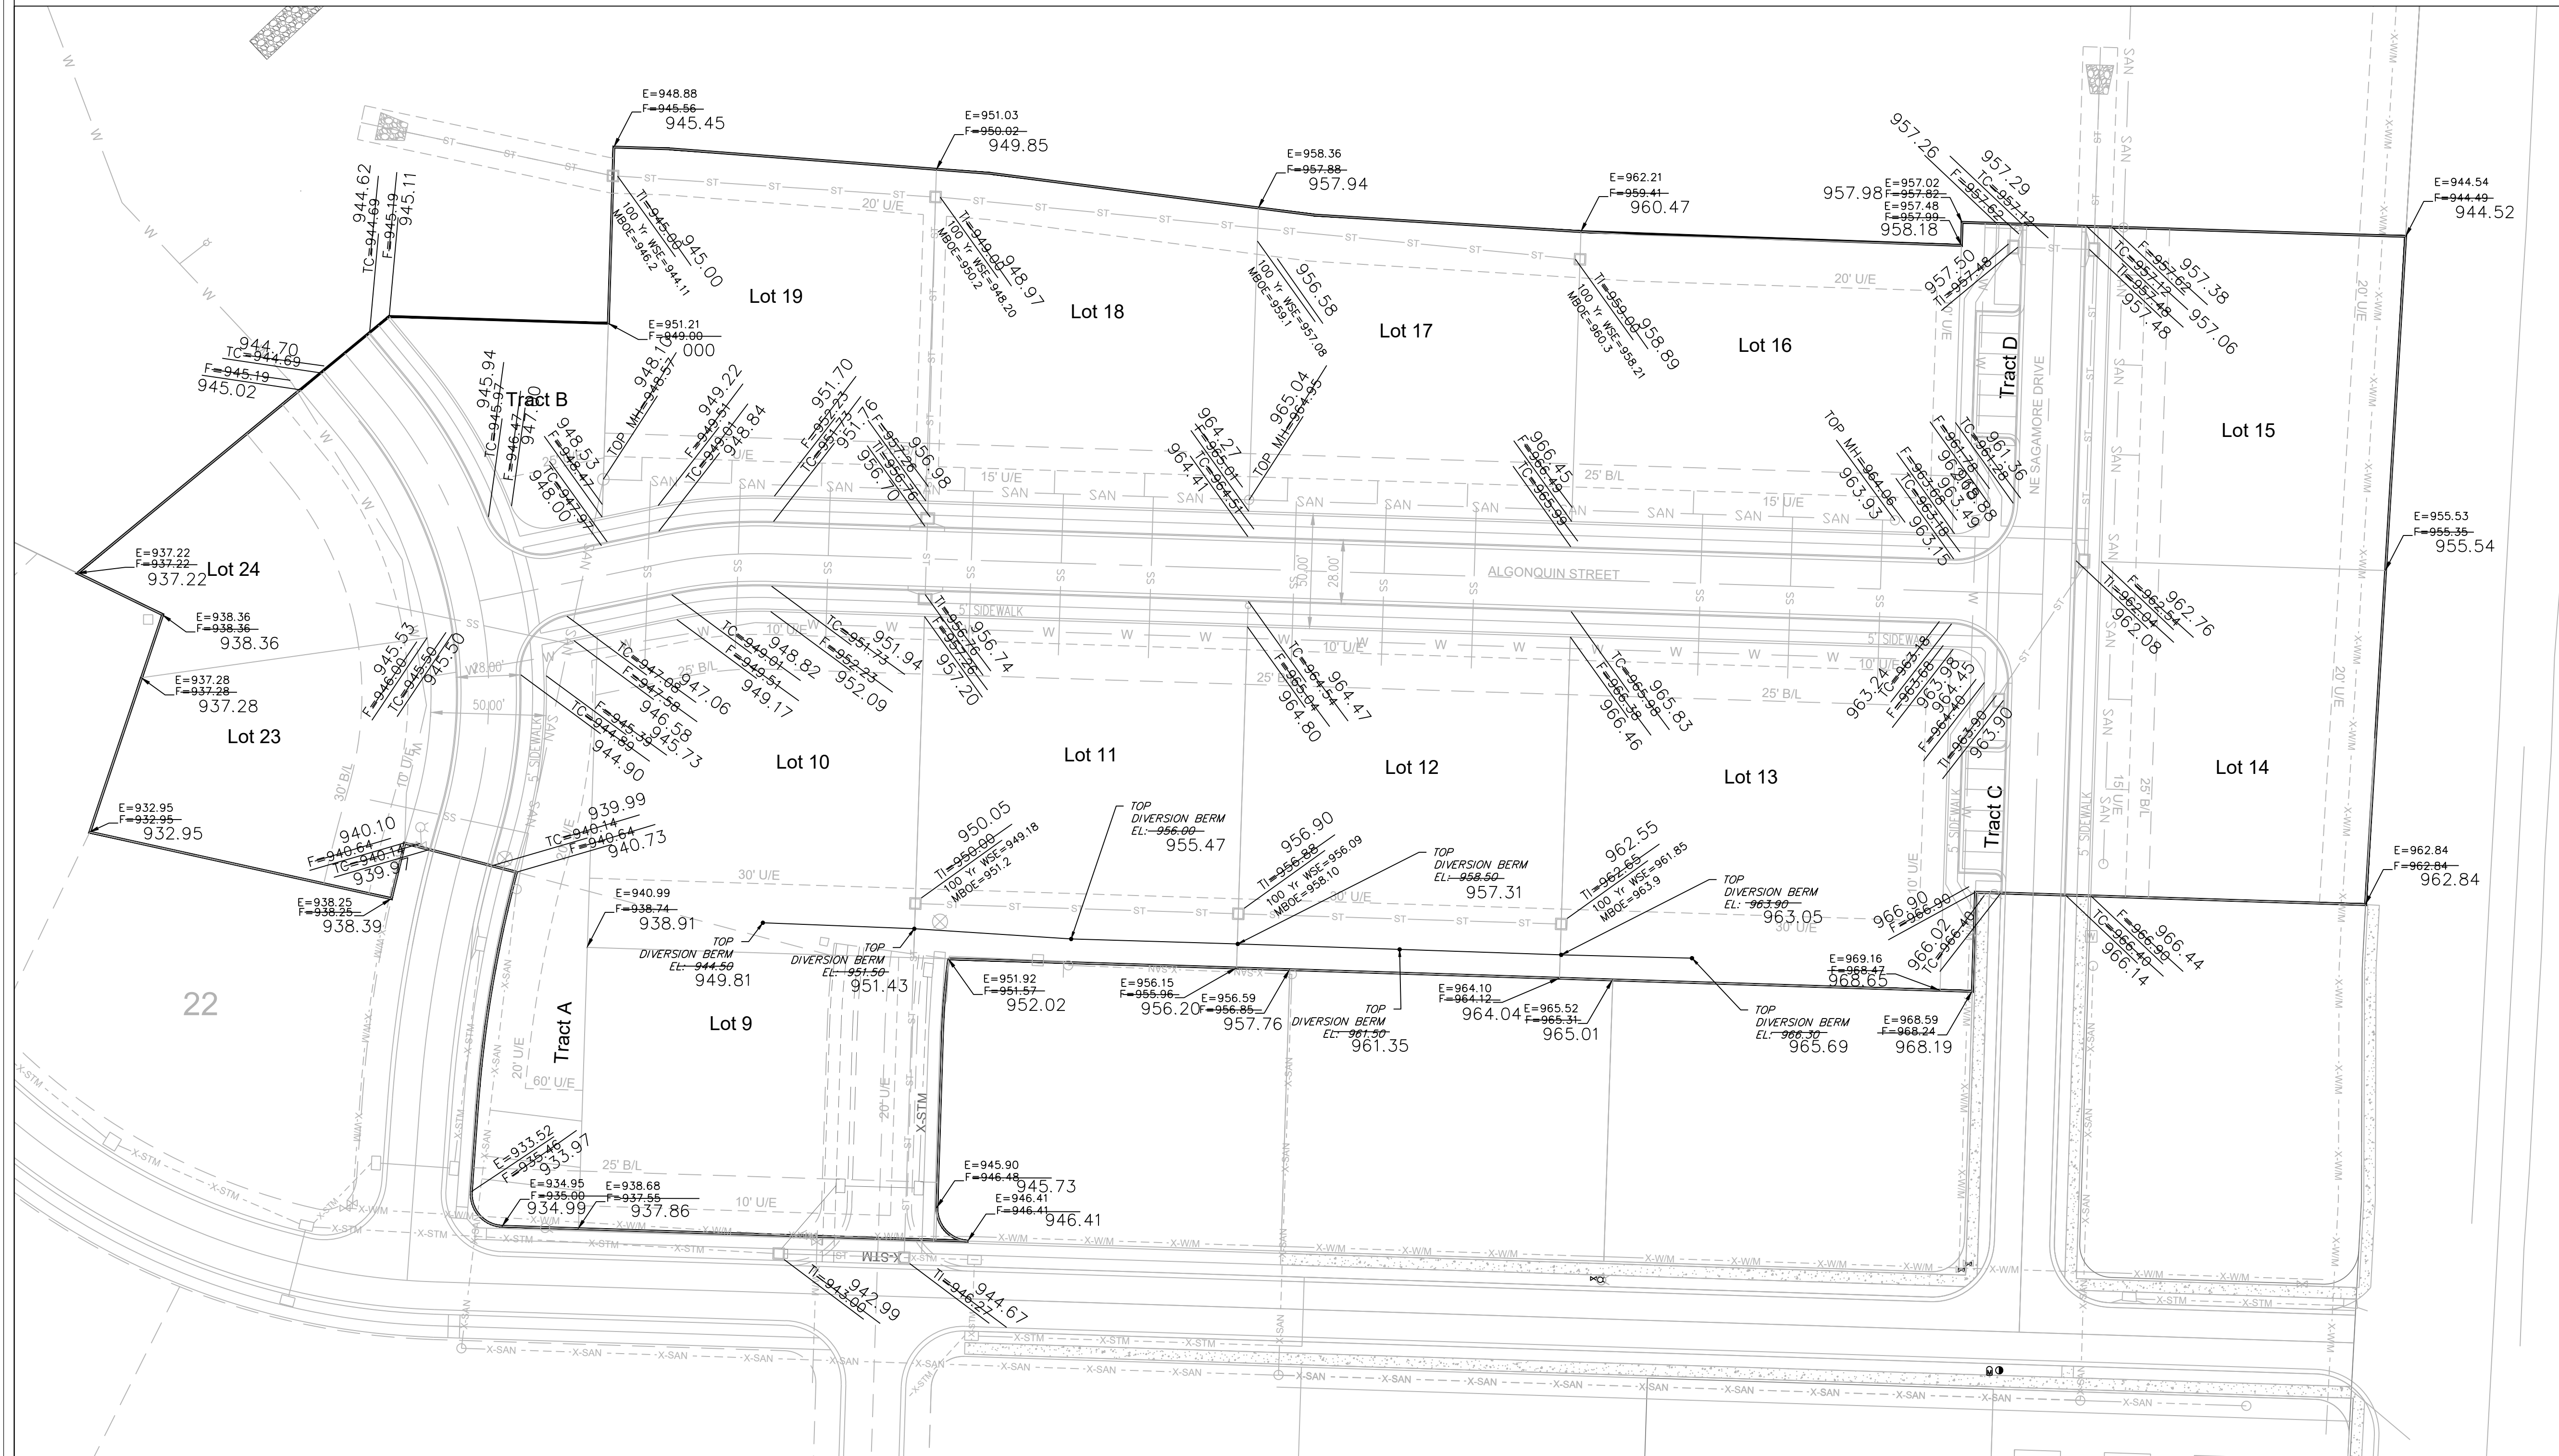

ENGINEERING SOLUTIONS
ENGINEERING & SURVEYING
50 SE 30TH STREET
LEE'S SUMMIT, MO 64082
P: (816) 623-9888 F: (816) 623-9849

Professional Registration
Missouri
Engineering 2005002186-D
Surveying 2005008319-D
Kansas
Engineering E-1685
Surveying LS-218
Oklahoma
Engineering 6254
Nebraska
Engineering CA2821

Project:
VILLAGES OF CHAPEL RIDGE LSMD
Issue Date:
April 10, 2020




Master Drainage Plan 2 of 3:
Spot Elevations
Construction Plans for:
THE TOWNHOMES OF CHAPEL RIDGE-2ND PLAT
LOTS 9-19 & TRACTS A-D
Lee's Summit, Jackson County, Missouri



Matthew J. Schlicht
MO PE 2006019708
KS PE 19071
OK PE 25226
NE PE E-14335

REVISIONS
6/25/2021 As-Built
8/18/2021 As-Built

"AS-BUILT"
900.10
900.00 Indicates data replaced with "As-Built" information. All other data is as designed and has not been field verified.

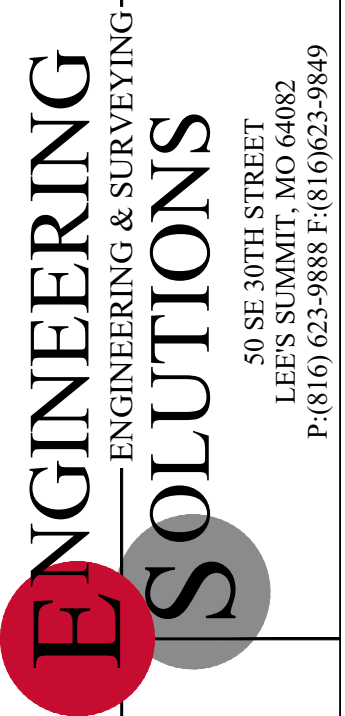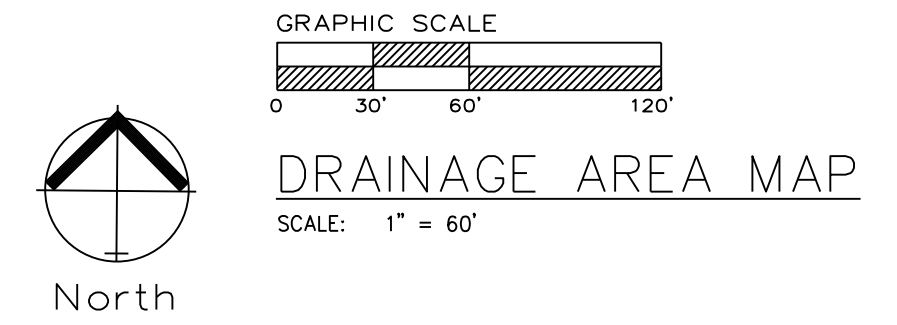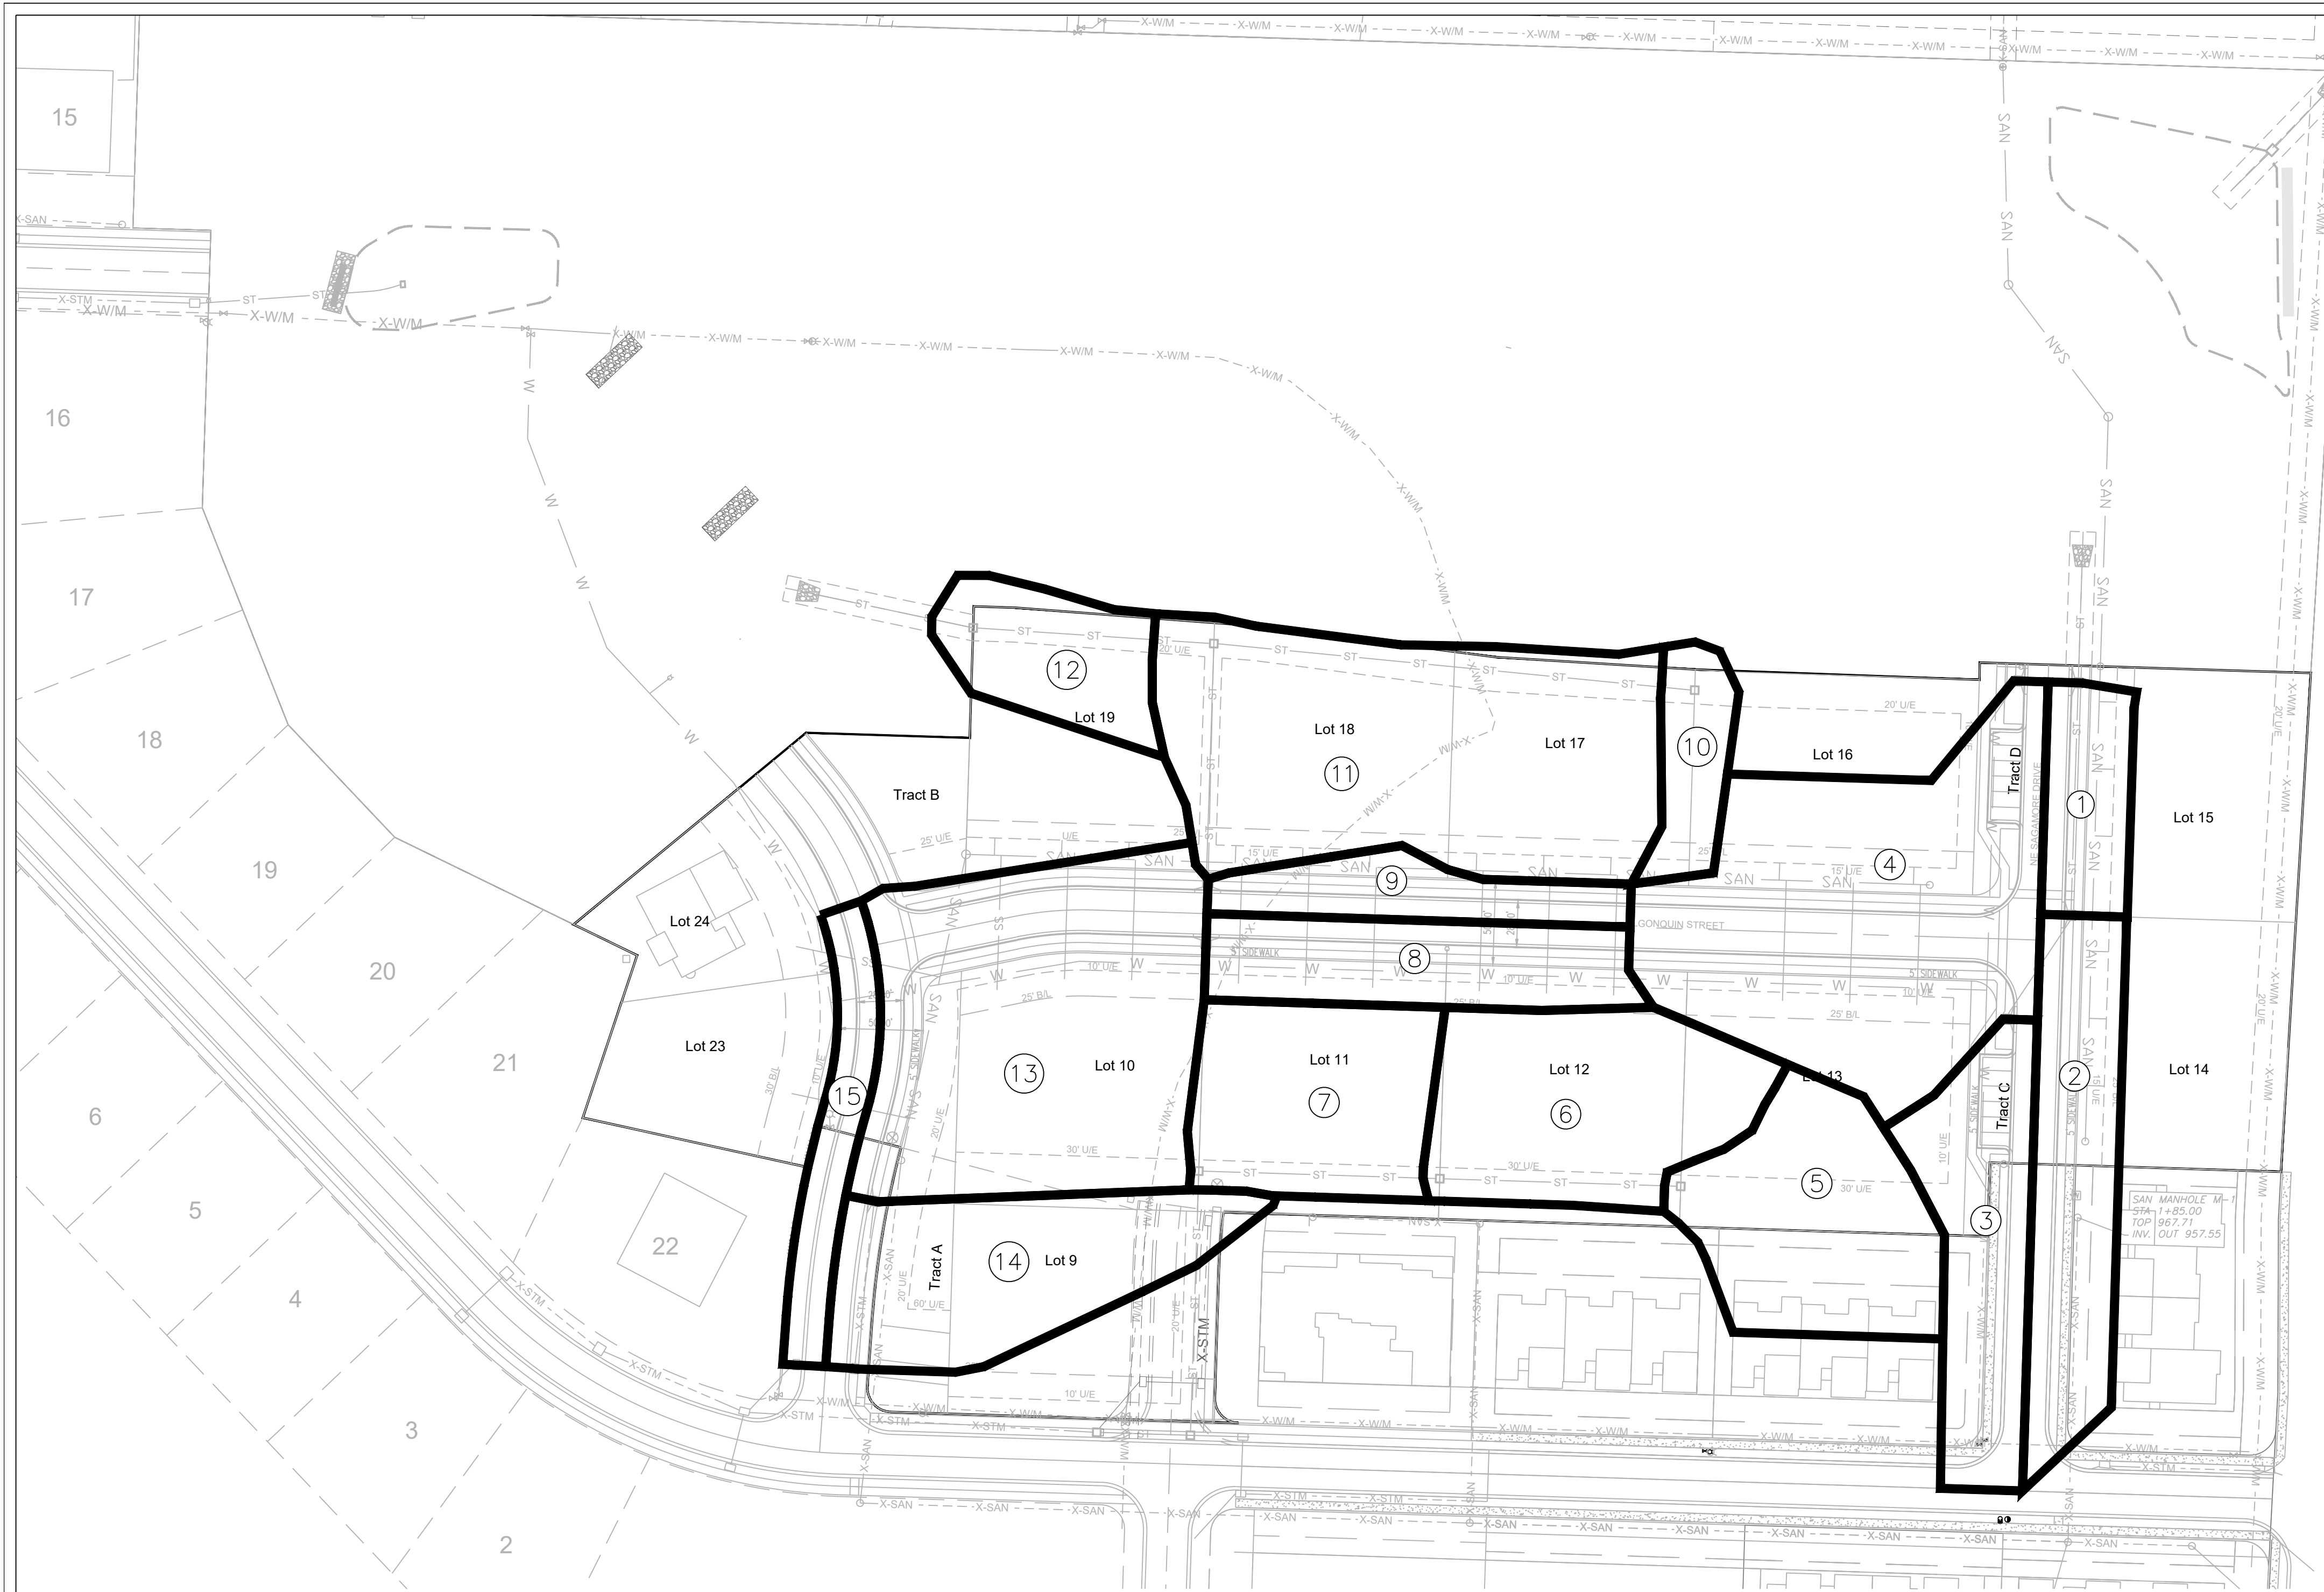

Professional Registration
 Missouri
 Engineering 2005002186-D
 Surveying 2005008319-D
 Kansas
 Engineering E-1685
 Surveying LS-218
 Oklahoma
 Engineering 6254
 Nebraska
 Engineering CA2821

Project:
 VILLAGES OF CHAPEL
 RIDGE, LSMD
 Issue Date:
 April 10, 2020

Master Drainage Map 3 of 3:
 Drainage Area Map
 Construction Plans for:
 THE TOWNHOMES OF CHAPEL RIDGE-2ND PLAT
 LOTS 9-19 & TRACTS A-D
 Lee's Summit, Jackson County, Missouri




Matthew J. Schlicht
 MO PE 2006019708
 KS PE 19071
 OK PE 25226
 NE PE E-14335

REVISIONS
 6/25/2021 As-Built
 8/18/2021 As-Built


APWA STORM DRAINAGE "TC" COMPUTATIONS FOR : VILLAGES OF CHAPEL RIDGE 2ND PLAT

AREA ID	TOTAL SQ.FT.	TOTAL ACRES	WTRSHD LENGTH	UP ELEV	DN ELEV	SURFACE CODE	SURFACE CODES				SLOPE %	SURFACE CODE	P=PAVED	U=UNPAVED	DN ELEV	SLOPE %	VELOCITY F/S	TC COMPUTATION				AREA ID	
							A	B	D	G								Flow T(I)	Used Min 5 Max 15 T(I)	Cal Channel One T(T)	Cal Channel Two T(T)		Total T@10
1	6734.45	0.15	171.71	962.75	956.48	M	0.66	36.7	962.8	962.00	2.0	P	135.0	962.0	956.5	4.09	4.1	3.8	5.0	0.5	0.0	5.5	1
2	15497.29	0.36	321.00	969.90	961.04	M	0.66	36.0	969.9	969.15	2.1	P	285.0	969.2	961.0	2.85	3.4	3.7	5.0	1.4	0.0	6.4	2
3	14565.88	0.33	115.82	968.20	962.90	M	0.66	60.5	968.2	966.00	3.6	P	55.4	966.0	962.9	5.60	4.8	4.0	5.0	0.2	0.0	5.2	3
4	38022.54	0.87	290.56	968.20	956.48	M	0.66	100.0	968.2	963.50	4.7	P	100.6	963.5	956.5	3.68	3.9	4.7	5.0	0.8	0.0	5.8	4
5	17621.66	0.40	168.61	970.50	961.65	M	0.66	100.0	970.5	967.15	3.4	U	68.6	967.2	961.7	8.02	4.6	5.3	5.3	0.3	0.0	5.5	5
6	19480.08	0.45	219.25	968.00	955.58	M	0.66	100.0	968.0	962.00	6.0	U	119.3	962.0	955.6	5.38	3.7	4.4	5.0	0.5	0.0	5.5	6
7	15534.05	0.36	183.86	964.00	949.00	M	0.66	100.0	964.0	955.00	9.0	U	83.9	955.0	949.0	7.15	4.3	3.8	5.0	0.3	0.0	5.3	7
8	12379.23	0.28	279.25	967.30	955.76	M	0.66	33.5	967.3	966.50	2.4	P	245.7	966.5	955.8	4.37	4.2	3.4	5.0	1.0	0.0	6.0	8
9	7326.23	0.17	257.20	966.50	955.76	M	0.66	11.5	966.5	966.20	2.6	P	245.7	966.2	955.8	4.25	4.2	2.0	5.0	1.0	0.0	6.0	9
10	5324.92	0.12	125.42	966.50	958.00	M	0.66	47.2	966.5	963.80	5.7	U	78.3	963.8	958.0	7.41	4.4	3.0	5.0	0.3	0.0	5.3	10
11	38079.28	0.87	354.14	966.50	948.00	M	0.66	100.0	966.5	960.50	6.0	U	254.1	960.5	948.0	4.92	3.6	4.4	5.0	1.2	0.0	6.2	11
12	9008.94	0.21	139.74	955.00	944.00	M	0.66	100.0	955.0	946.50	8.5	U	39.7	946.5	944.0	6.29	4.0	3.9	5.0	0.2	0.0	5.2	12
13	36460.35	0.84	346.50	957.50	939.00	M	0.66	36.5	957.5	956.50	2.7	P	310.0	956.5	939.0	5.65	4.8	3.4	5.0	1.1	0.0	6.1	13
14	18586.66	0.43	304.64	955.00	932.80	M	0.66	100.0	955.0	946.60	8.4	U	204.6	946.6	932.8	6.74	4.2	3.9	5.0	0.8	0.0	5.8	14
15	6741.28	0.15	280.50	946.50	932.50	M	0.66	11.5	946.5	946.20	2.6	P	269.0	946.2	932.5	5.09	4.6	2.0	5.0	1.0	0.0	6.0	15

"AS-BUILT"
 900.10
 900.00 Indicates data replaced with "As-Built" information. All other data is as designed and has not been field verified.


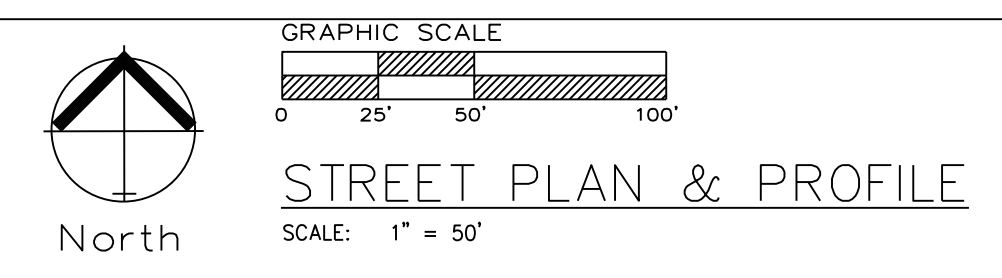


ALGONQUIN STREET

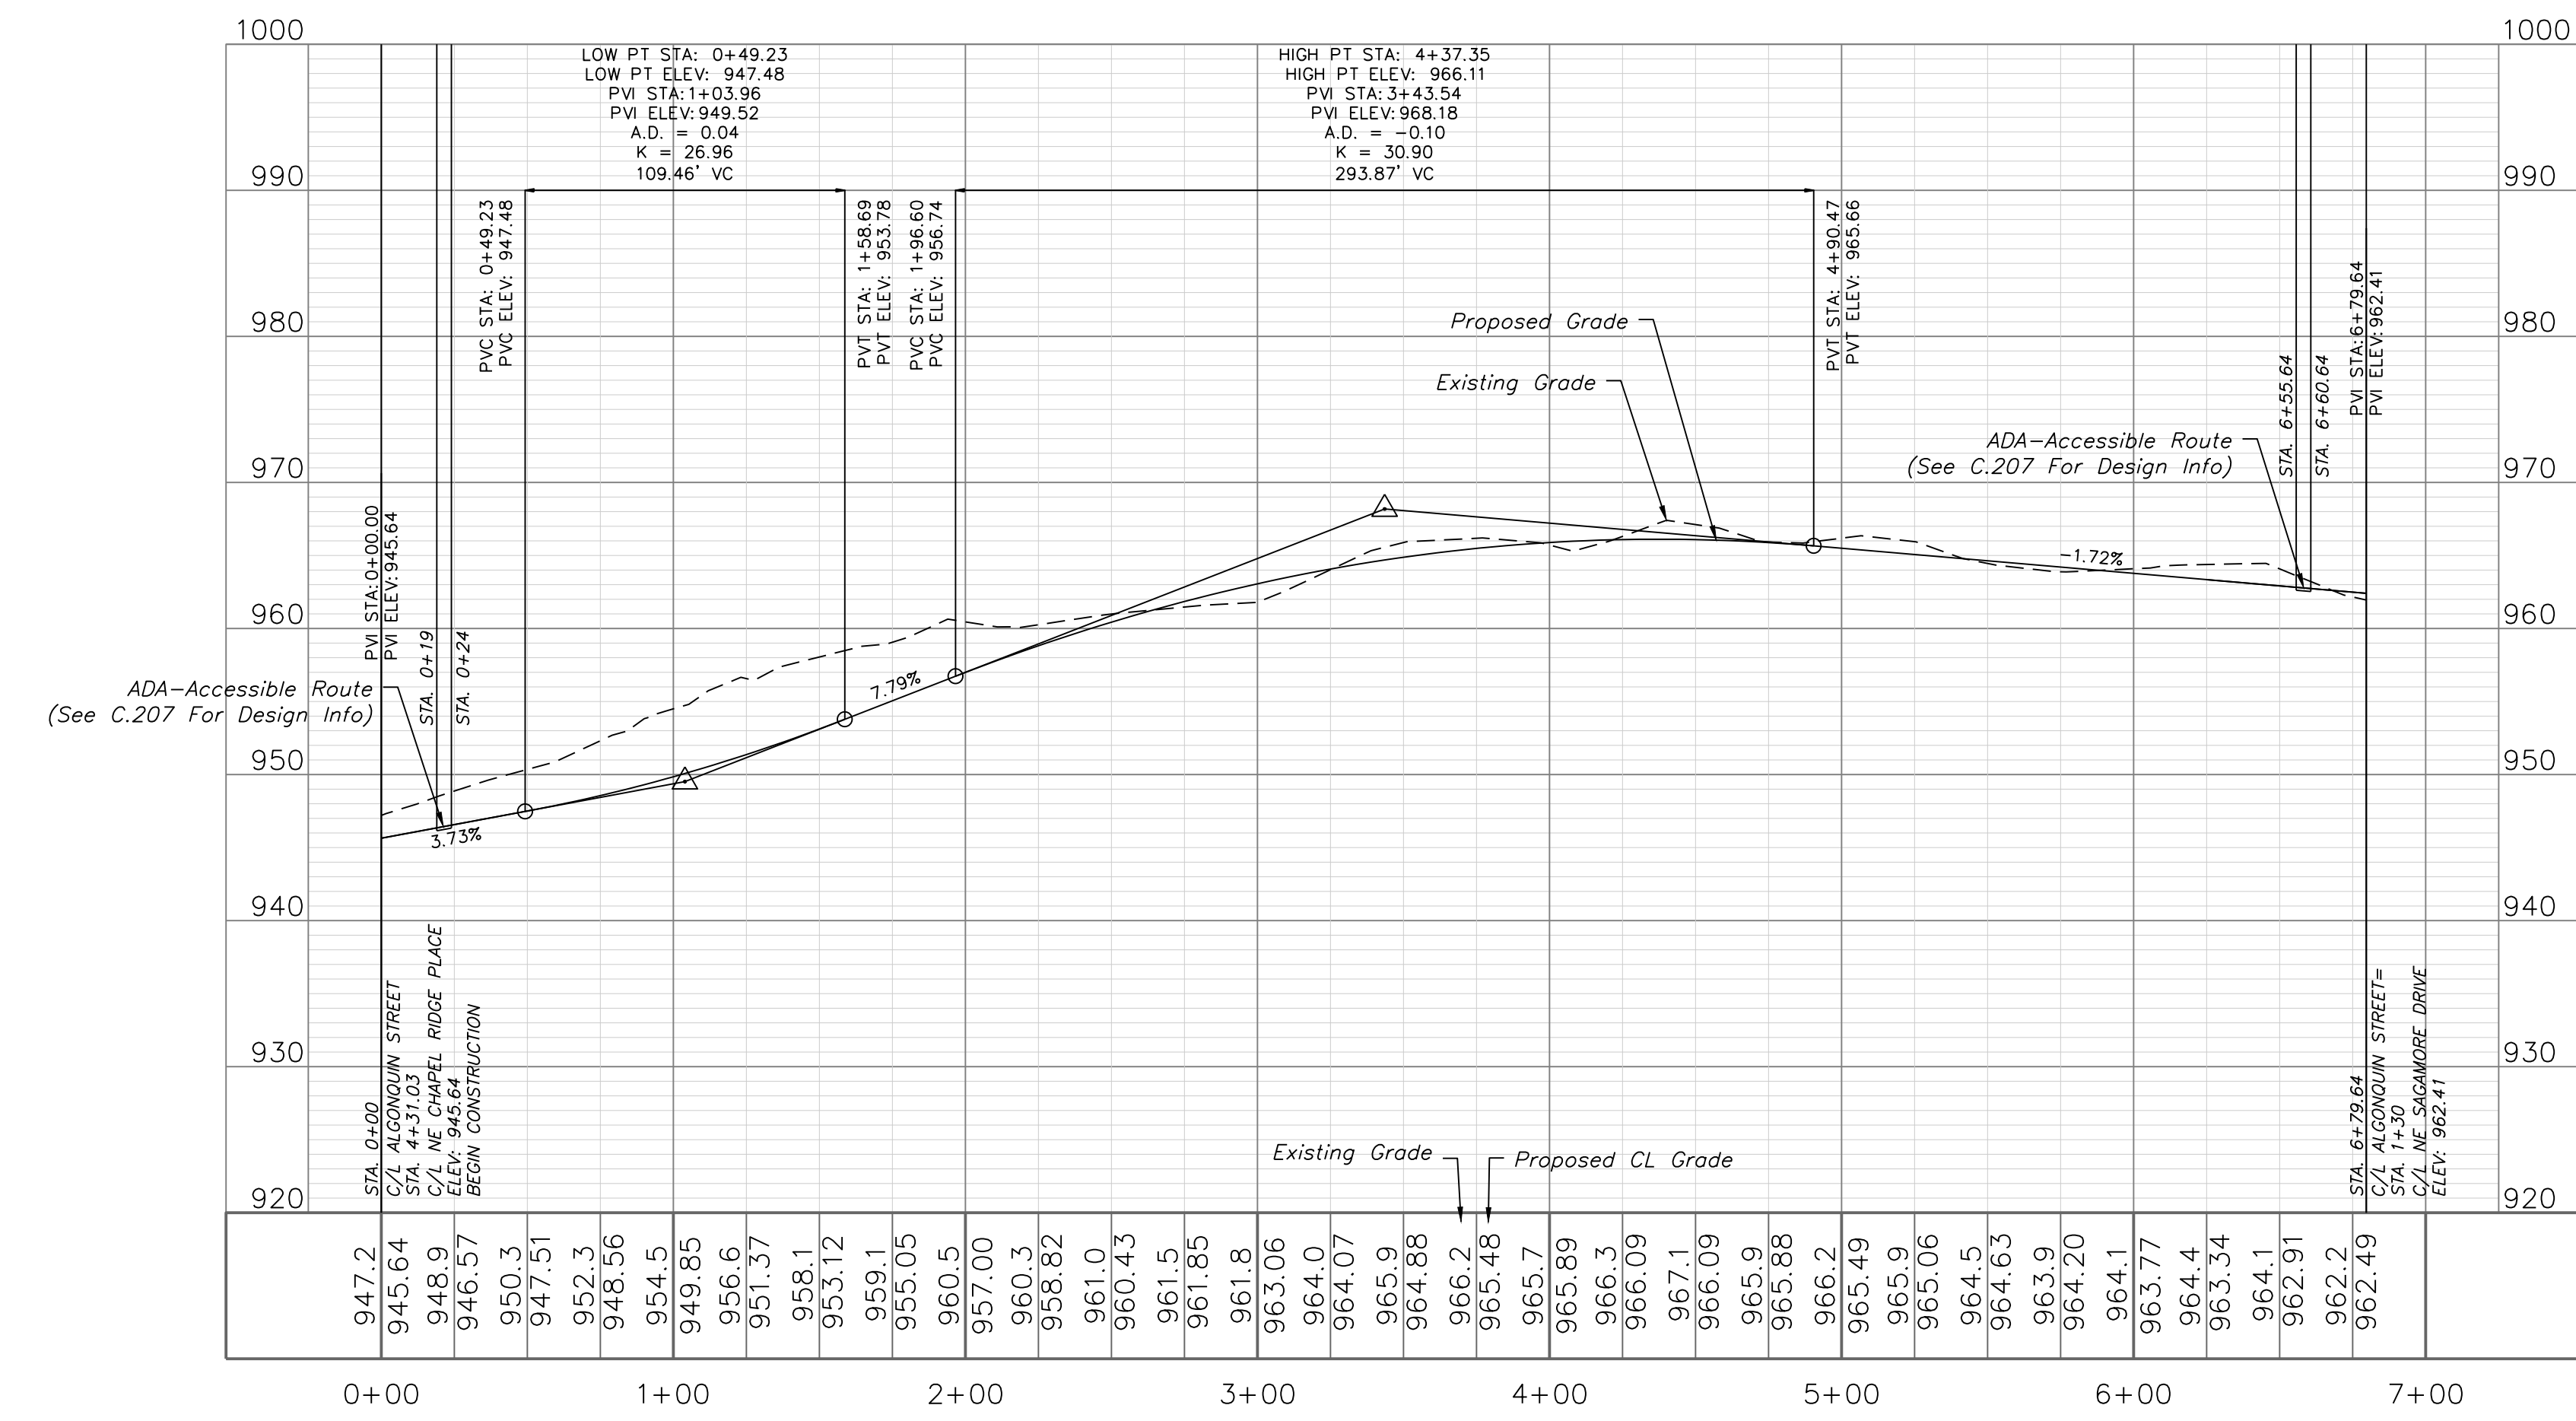

"AS-BUILT"

900.10
900.00 Indicates data replaced with "As-Built" information. All other data is as designed and has not been field verified.

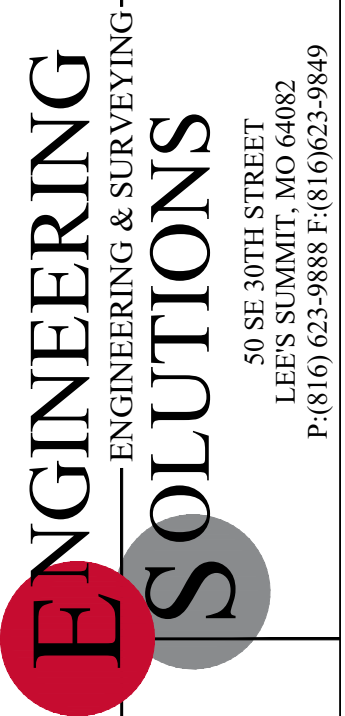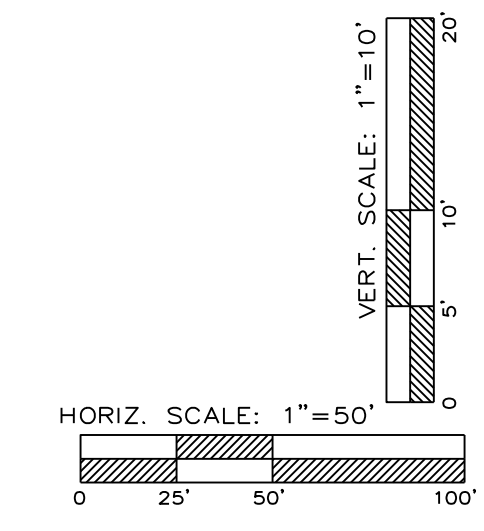

Professional Registration
Missouri
Engineering 2005002186-D
Surveying 2005008319-D
Kansas
Engineering E-1685
Surveying LS-218
Oklahoma
Engineering S254
Nebraska
Engineering CA2821

Project:
VILLAS OF CHAPEL RIDGE LSMD
Issue Date:
April 10, 2020



THE TOWNHOMES OF CHAPEL RIDGE-2ND PLAT
LOTS 9-19 & TRACTS A-D
Lee's Summit, Jackson County, Missouri

Street Plan and Profile
Construction Plans for:
THE TOWNHOMES OF CHAPEL RIDGE-2ND PLAT
LOTS 9-19 & TRACTS A-D
Lee's Summit, Jackson County, Missouri




Matthew J. Schlicht
MO PE 2006019708
KS PE 19071
OK PE 25226
NE PE E-14335

REVISIONS
6/25/2021 As-Built
8/18/2021 As-Built

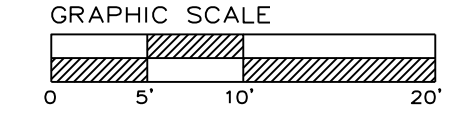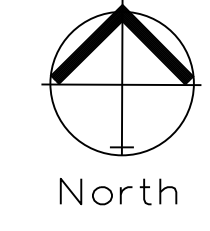

SEDIMENT TRAP GRADING PLAN


SCALE: 1" = 10'

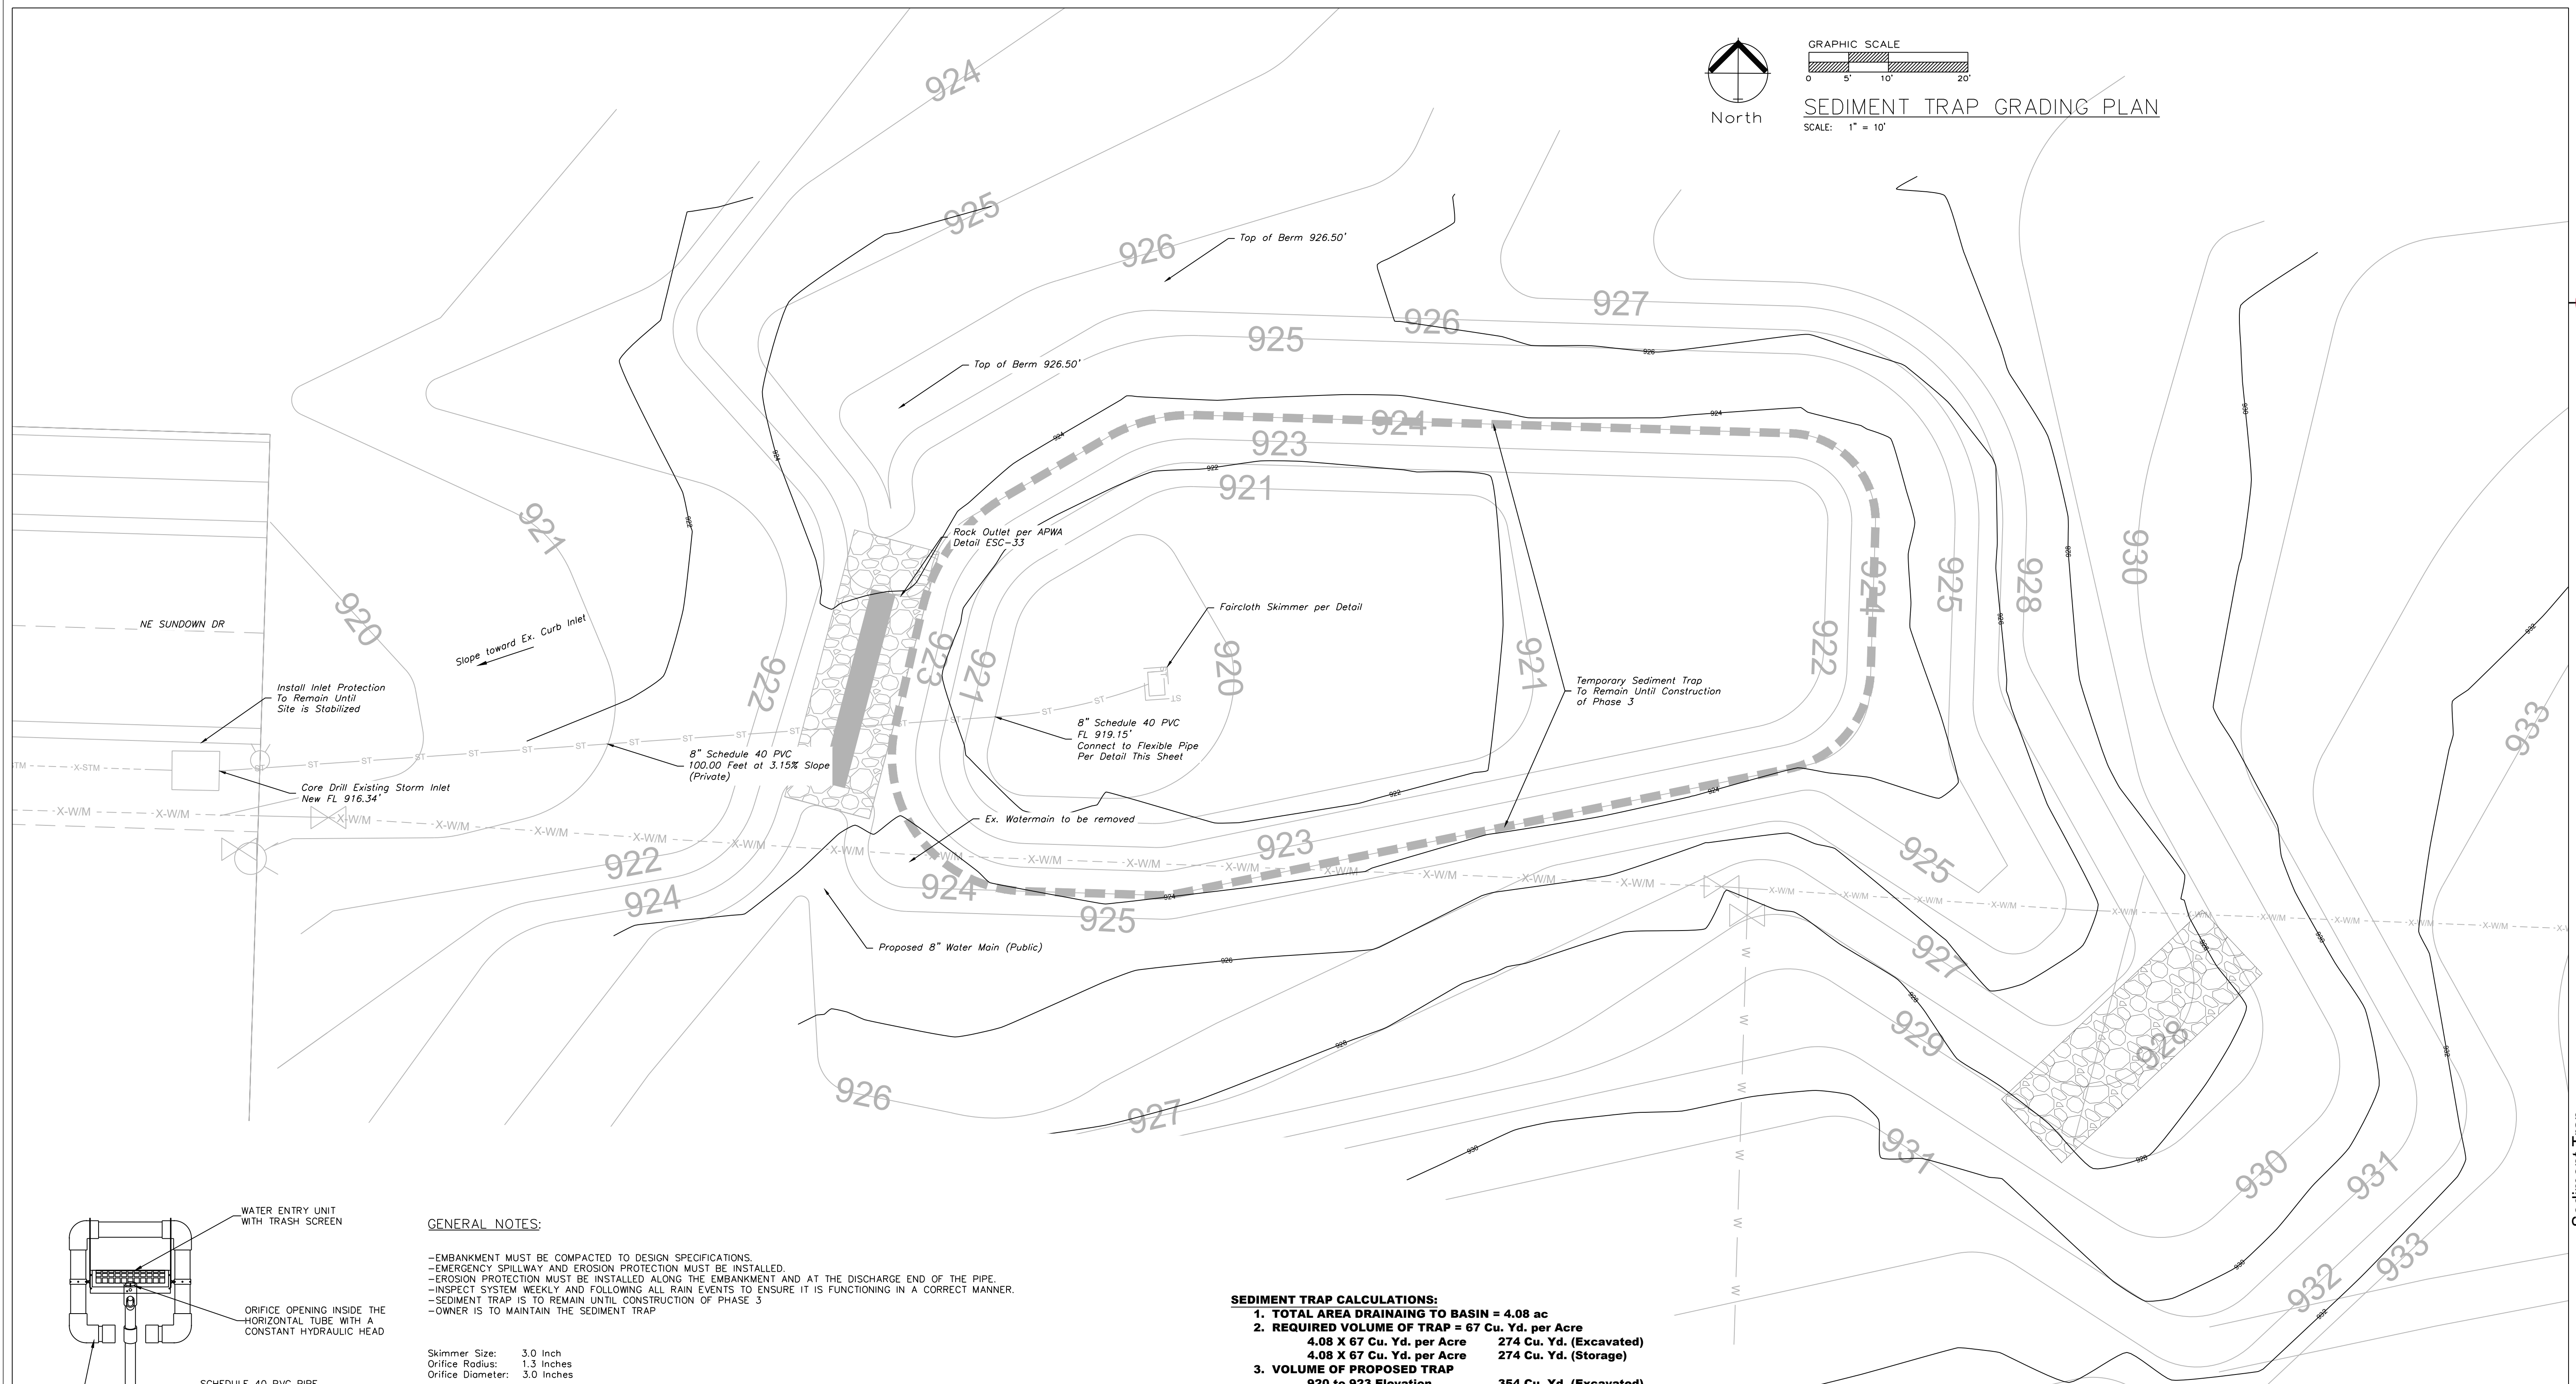

GENERAL NOTES:


- EMBANKMENT MUST BE COMPACTED TO DESIGN SPECIFICATIONS.
- EMERGENCY SPILLWAY AND EROSION PROTECTION MUST BE INSTALLED.
- EROSION PROTECTION MUST BE INSTALLED ALONG THE EMBANKMENT AND AT THE DISCHARGE END OF THE PIPE.
- INSPECT SYSTEM WEEKLY AND FOLLOWING ALL RAIN EVENTS TO ENSURE IT IS FUNCTIONING IN A CORRECT MANNER.
- SEDIMENT TRAP IS TO REMAIN UNTIL CONSTRUCTION OF PHASE 3
- OWNER IS TO MAINTAIN THE SEDIMENT TRAP

Skimmer Size: 3.0 Inch
 Orifice Radius: 1.3 inches
 Orifice Diameter: 3.0 inches

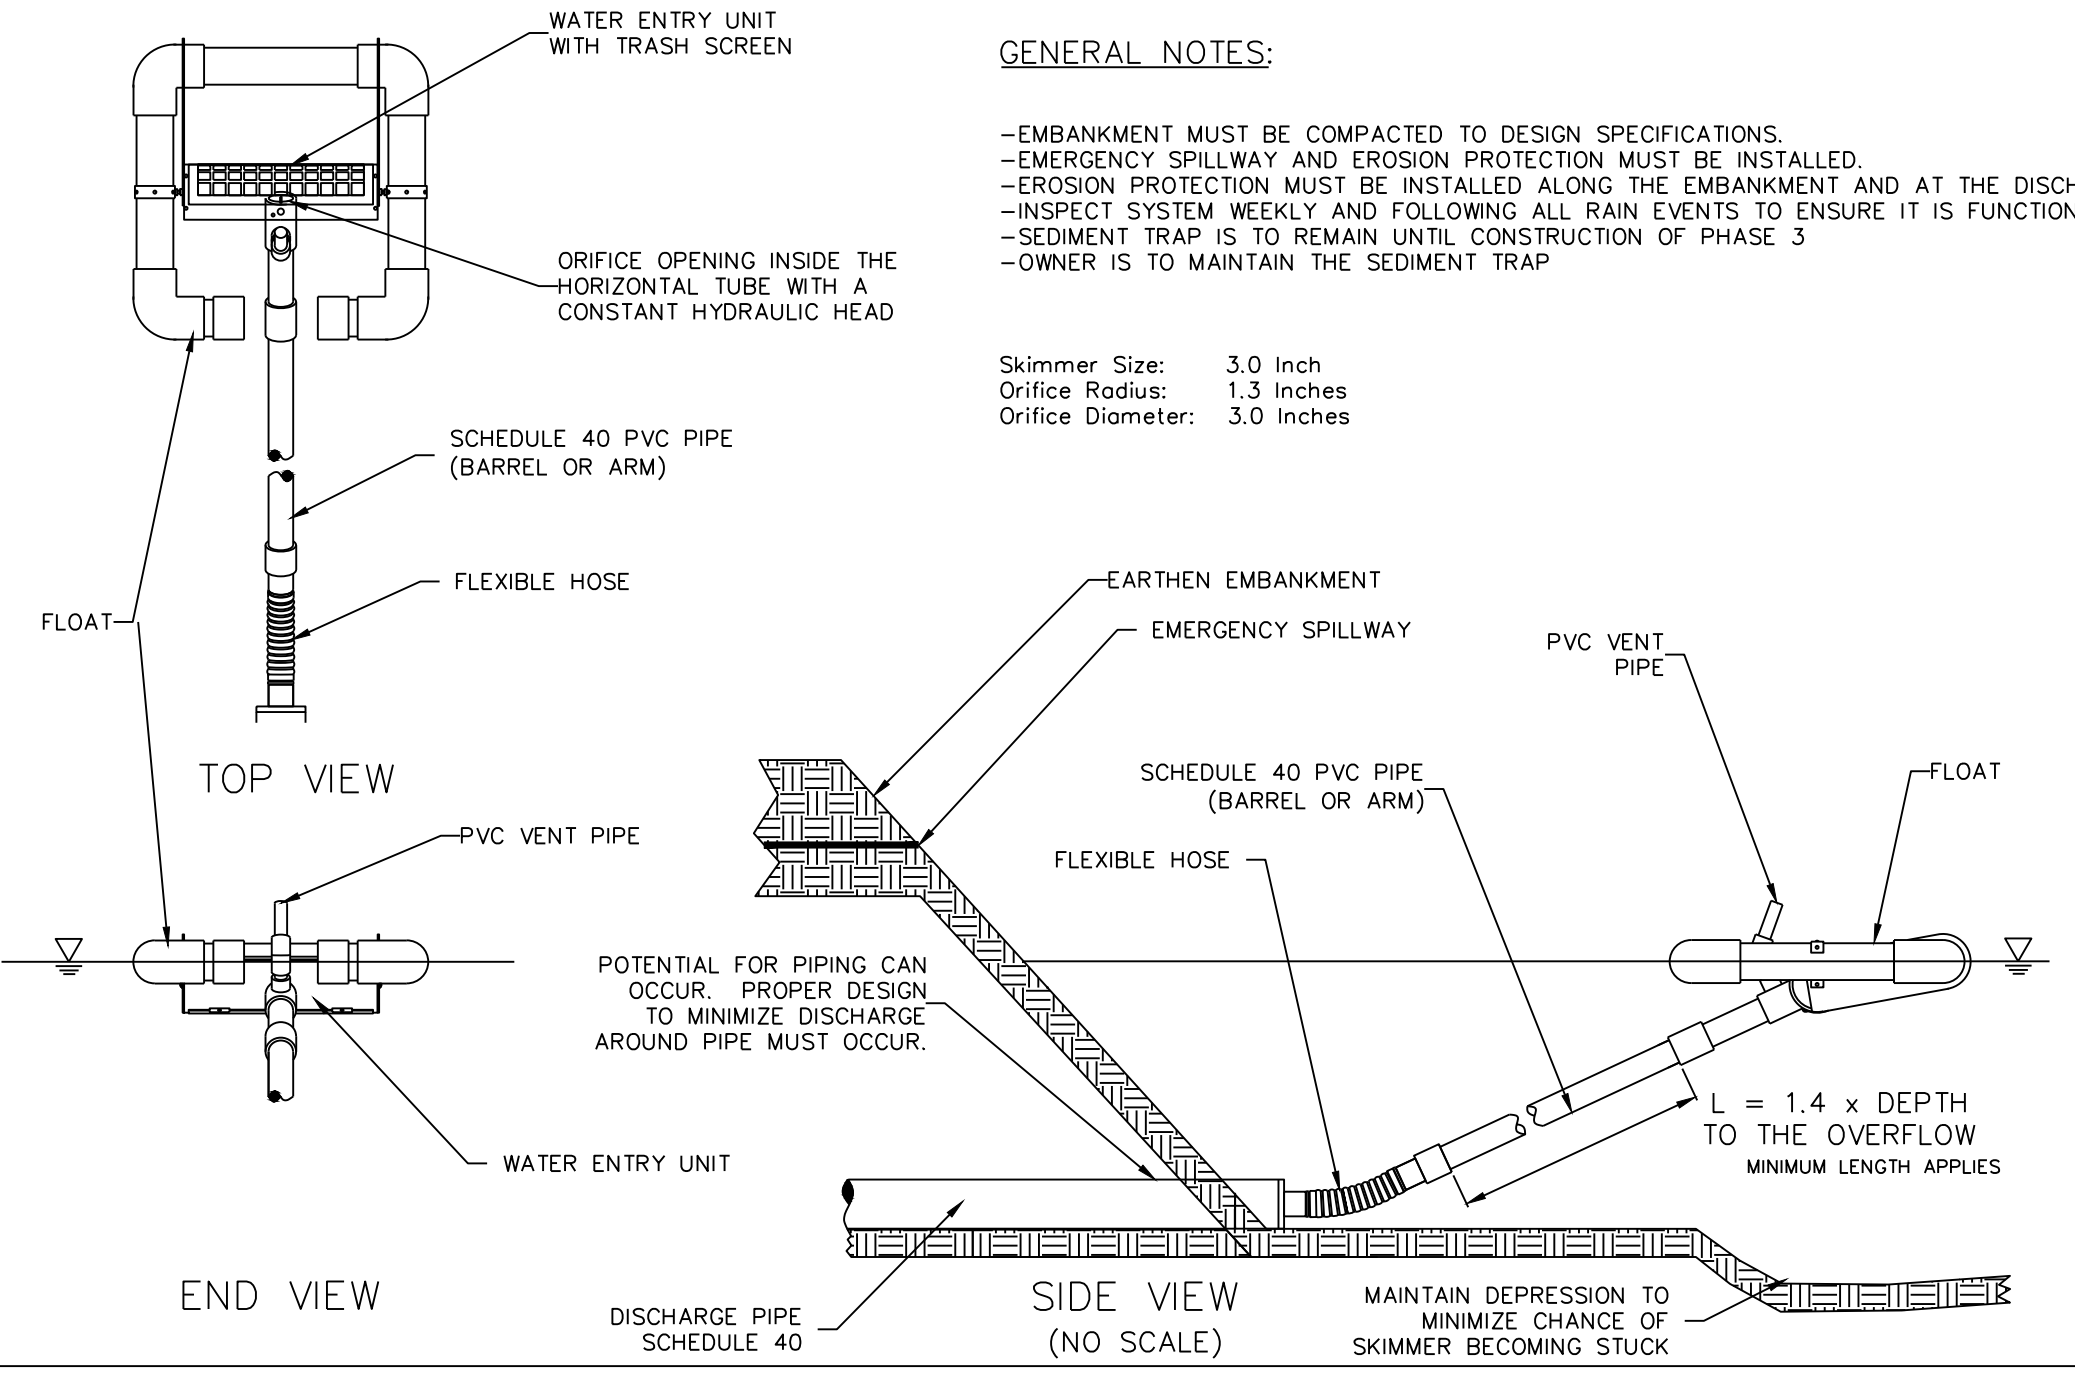


SEDIMENT TRAP CALCULATIONS:

- TOTAL AREA DRAINING TO BASIN = 4.08 ac**
- REQUIRED VOLUME OF TRAP = 67 Cu. Yd. per Acre**
 4.08 X 67 Cu. Yd. per Acre = 274 Cu. Yd. (Excavated)
 4.08 X 67 Cu. Yd. per Acre = 274 Cu. Yd. (Storage)
- VOLUME OF PROPOSED TRAP**
 920 to 923 Elevation = 354 Cu. Yd. (Excavated)
 923 to 925 Elevation = 476 Cu. Yd. (Storage)

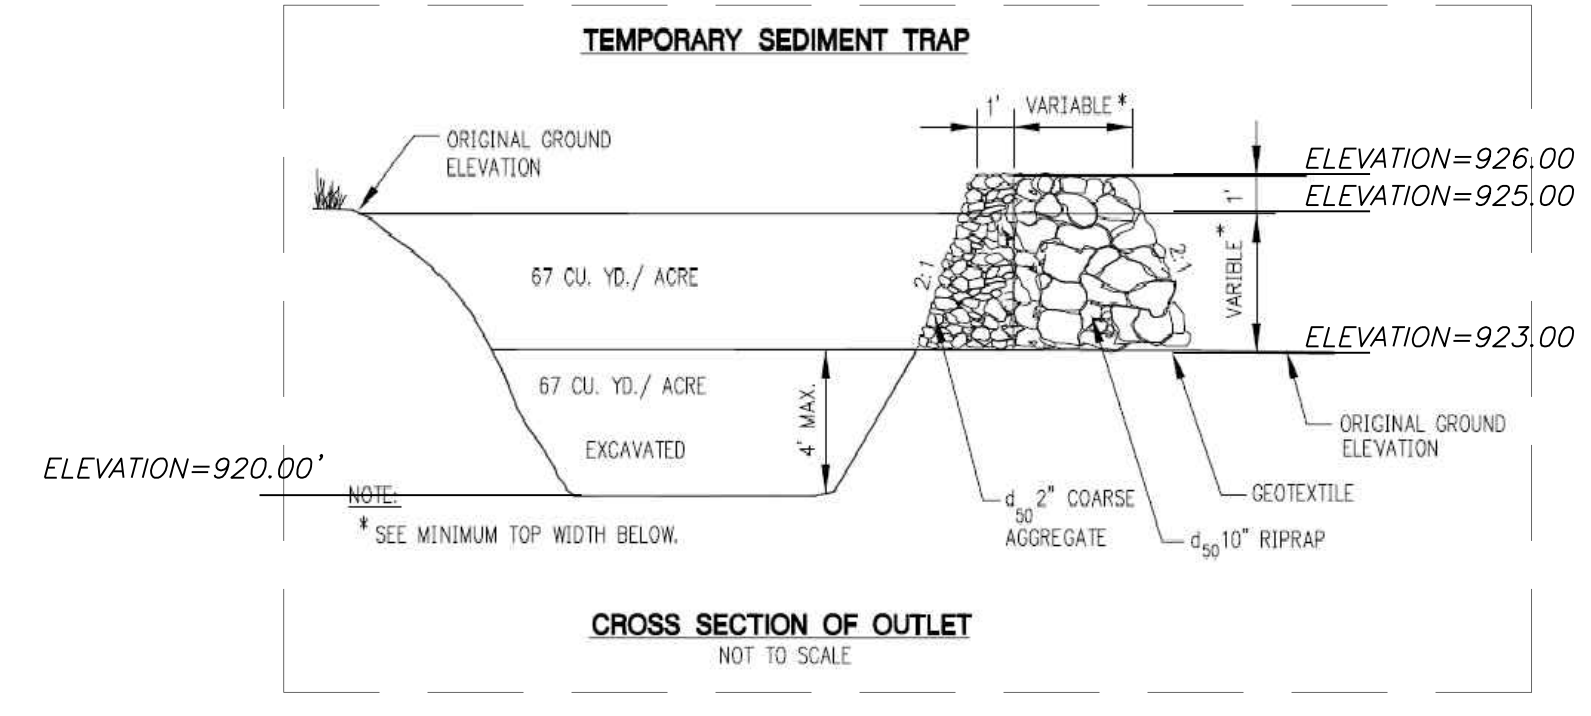

"AS-BUILT"
 900.10
 900.00 Indicates data replaced with "As-Built" information. All other data is as designed and has not been field verified.

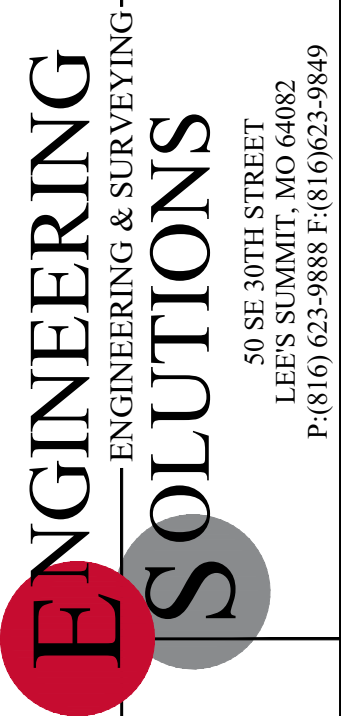

Professional Registration
 Missouri
 Engineering 2005002186-D
 Surveying 2005008319-D
 Kansas
 Engineering E-1685
 Surveying LS-218
 Oklahoma
 Engineering S254
 Nebraska
 Engineering CA2821

Project: THE TOWNHOMES OF CHAPEL RIDGE-2ND PLAT LOTS 9-19 & TRACTS A-D
 Lee's Summit, Jackson County, Missouri




Project: VILLAGES OF CHAPEL RIDGE-LS100
 Issue Date: April 10, 2020

Project: THE TOWNHOMES OF CHAPEL RIDGE-2ND PLAT LOTS 9-19 & TRACTS A-D
 Lee's Summit, Jackson County, Missouri



Matthew J. Schlicht
 MO PE 000019708
 KS PE 19071
 OK PE 25226
 NE PE E-14335




REVISIONS
 6/25/2021 As-Built
 8/18/2021 As-Built

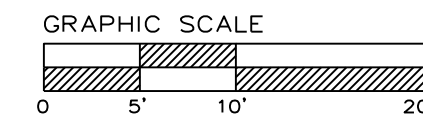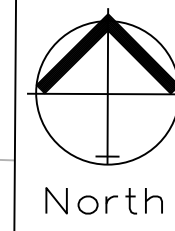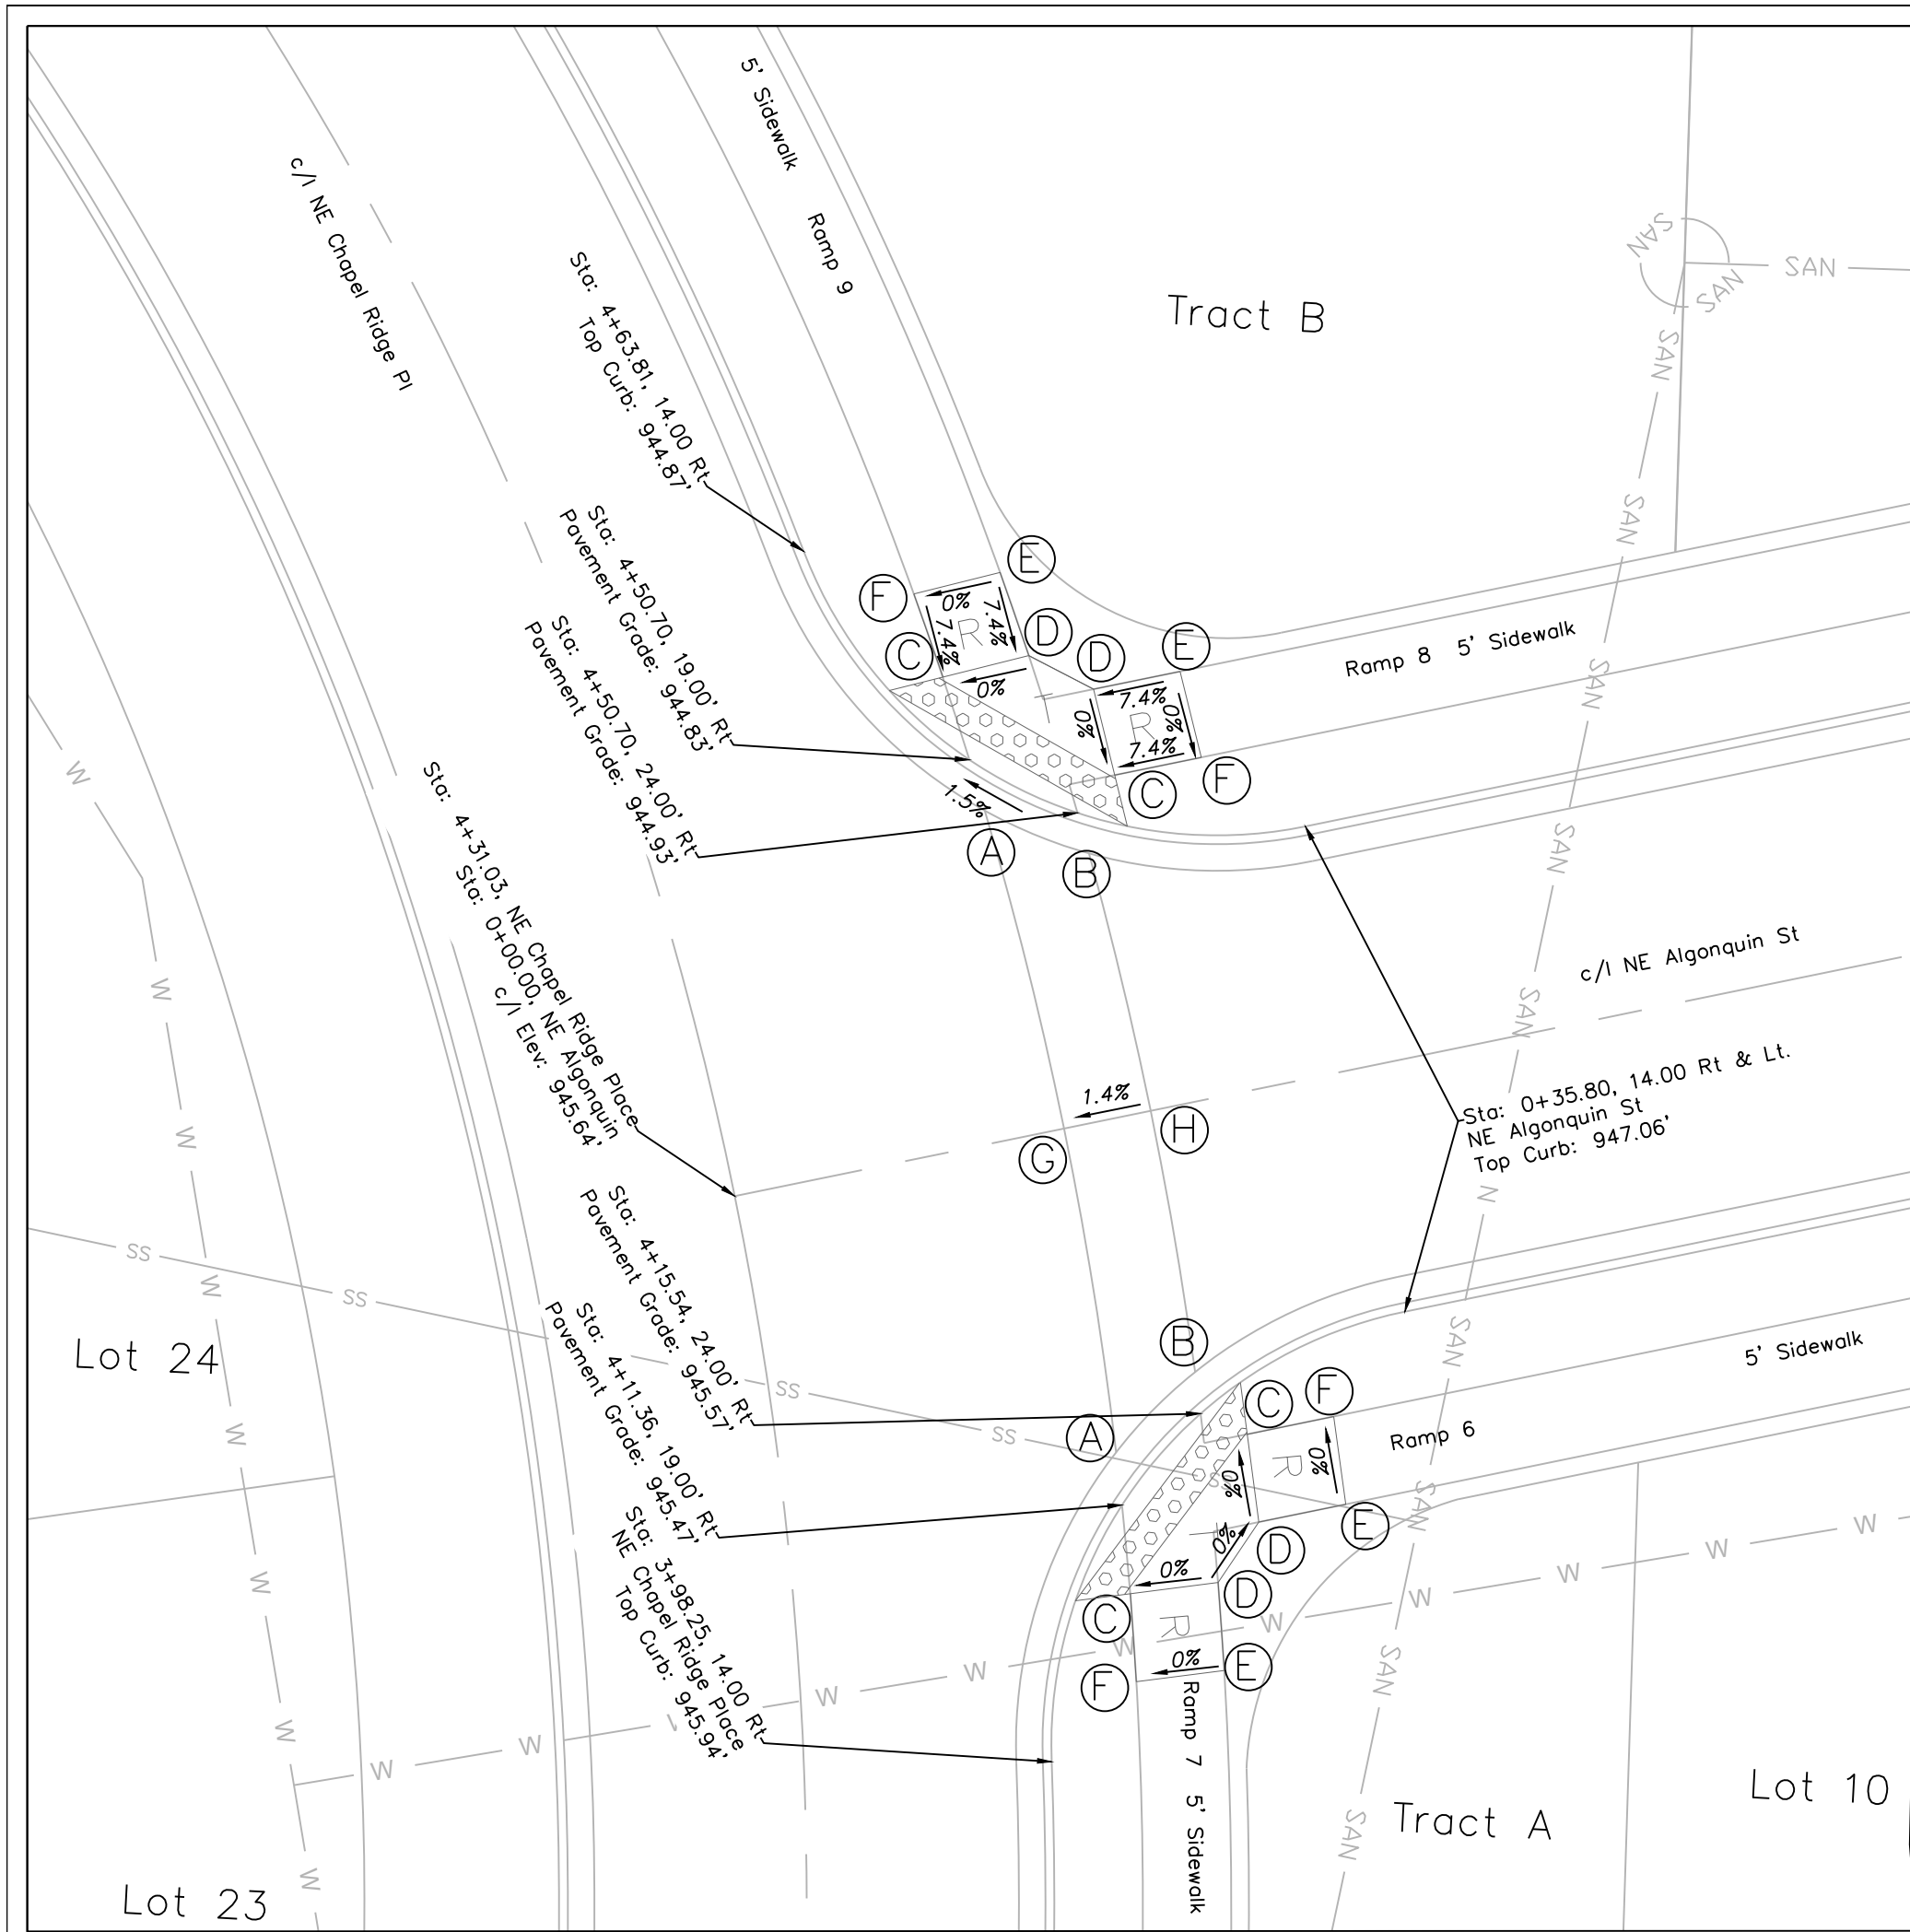



SIDWALK AND INTERSECTION PLAN
SCALE: 1" = 10'

Spot	Ramp 6 Elevation	Ramp 7 Elevation	Ramp 8 Elevation	Ramp 9 Elevation
A	945.47	945.47	944.83	944.83
B	945.57	945.57	944.93	944.93
C	945.62	945.52	944.98	944.88
D	945.62	945.62	944.98	944.98
E	945.99	945.99	945.35	945.35
F	945.99	945.99	945.35	945.35
G	945.18	945.18	945.18	945.18
H	945.25	945.25	945.25	945.25

NOTE:
ALL ADA ACCESSIBLE RAMPS TO BE CONSTRUCTED WITH STREET IMPROVEMENTS.

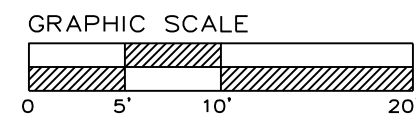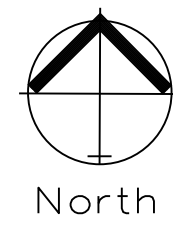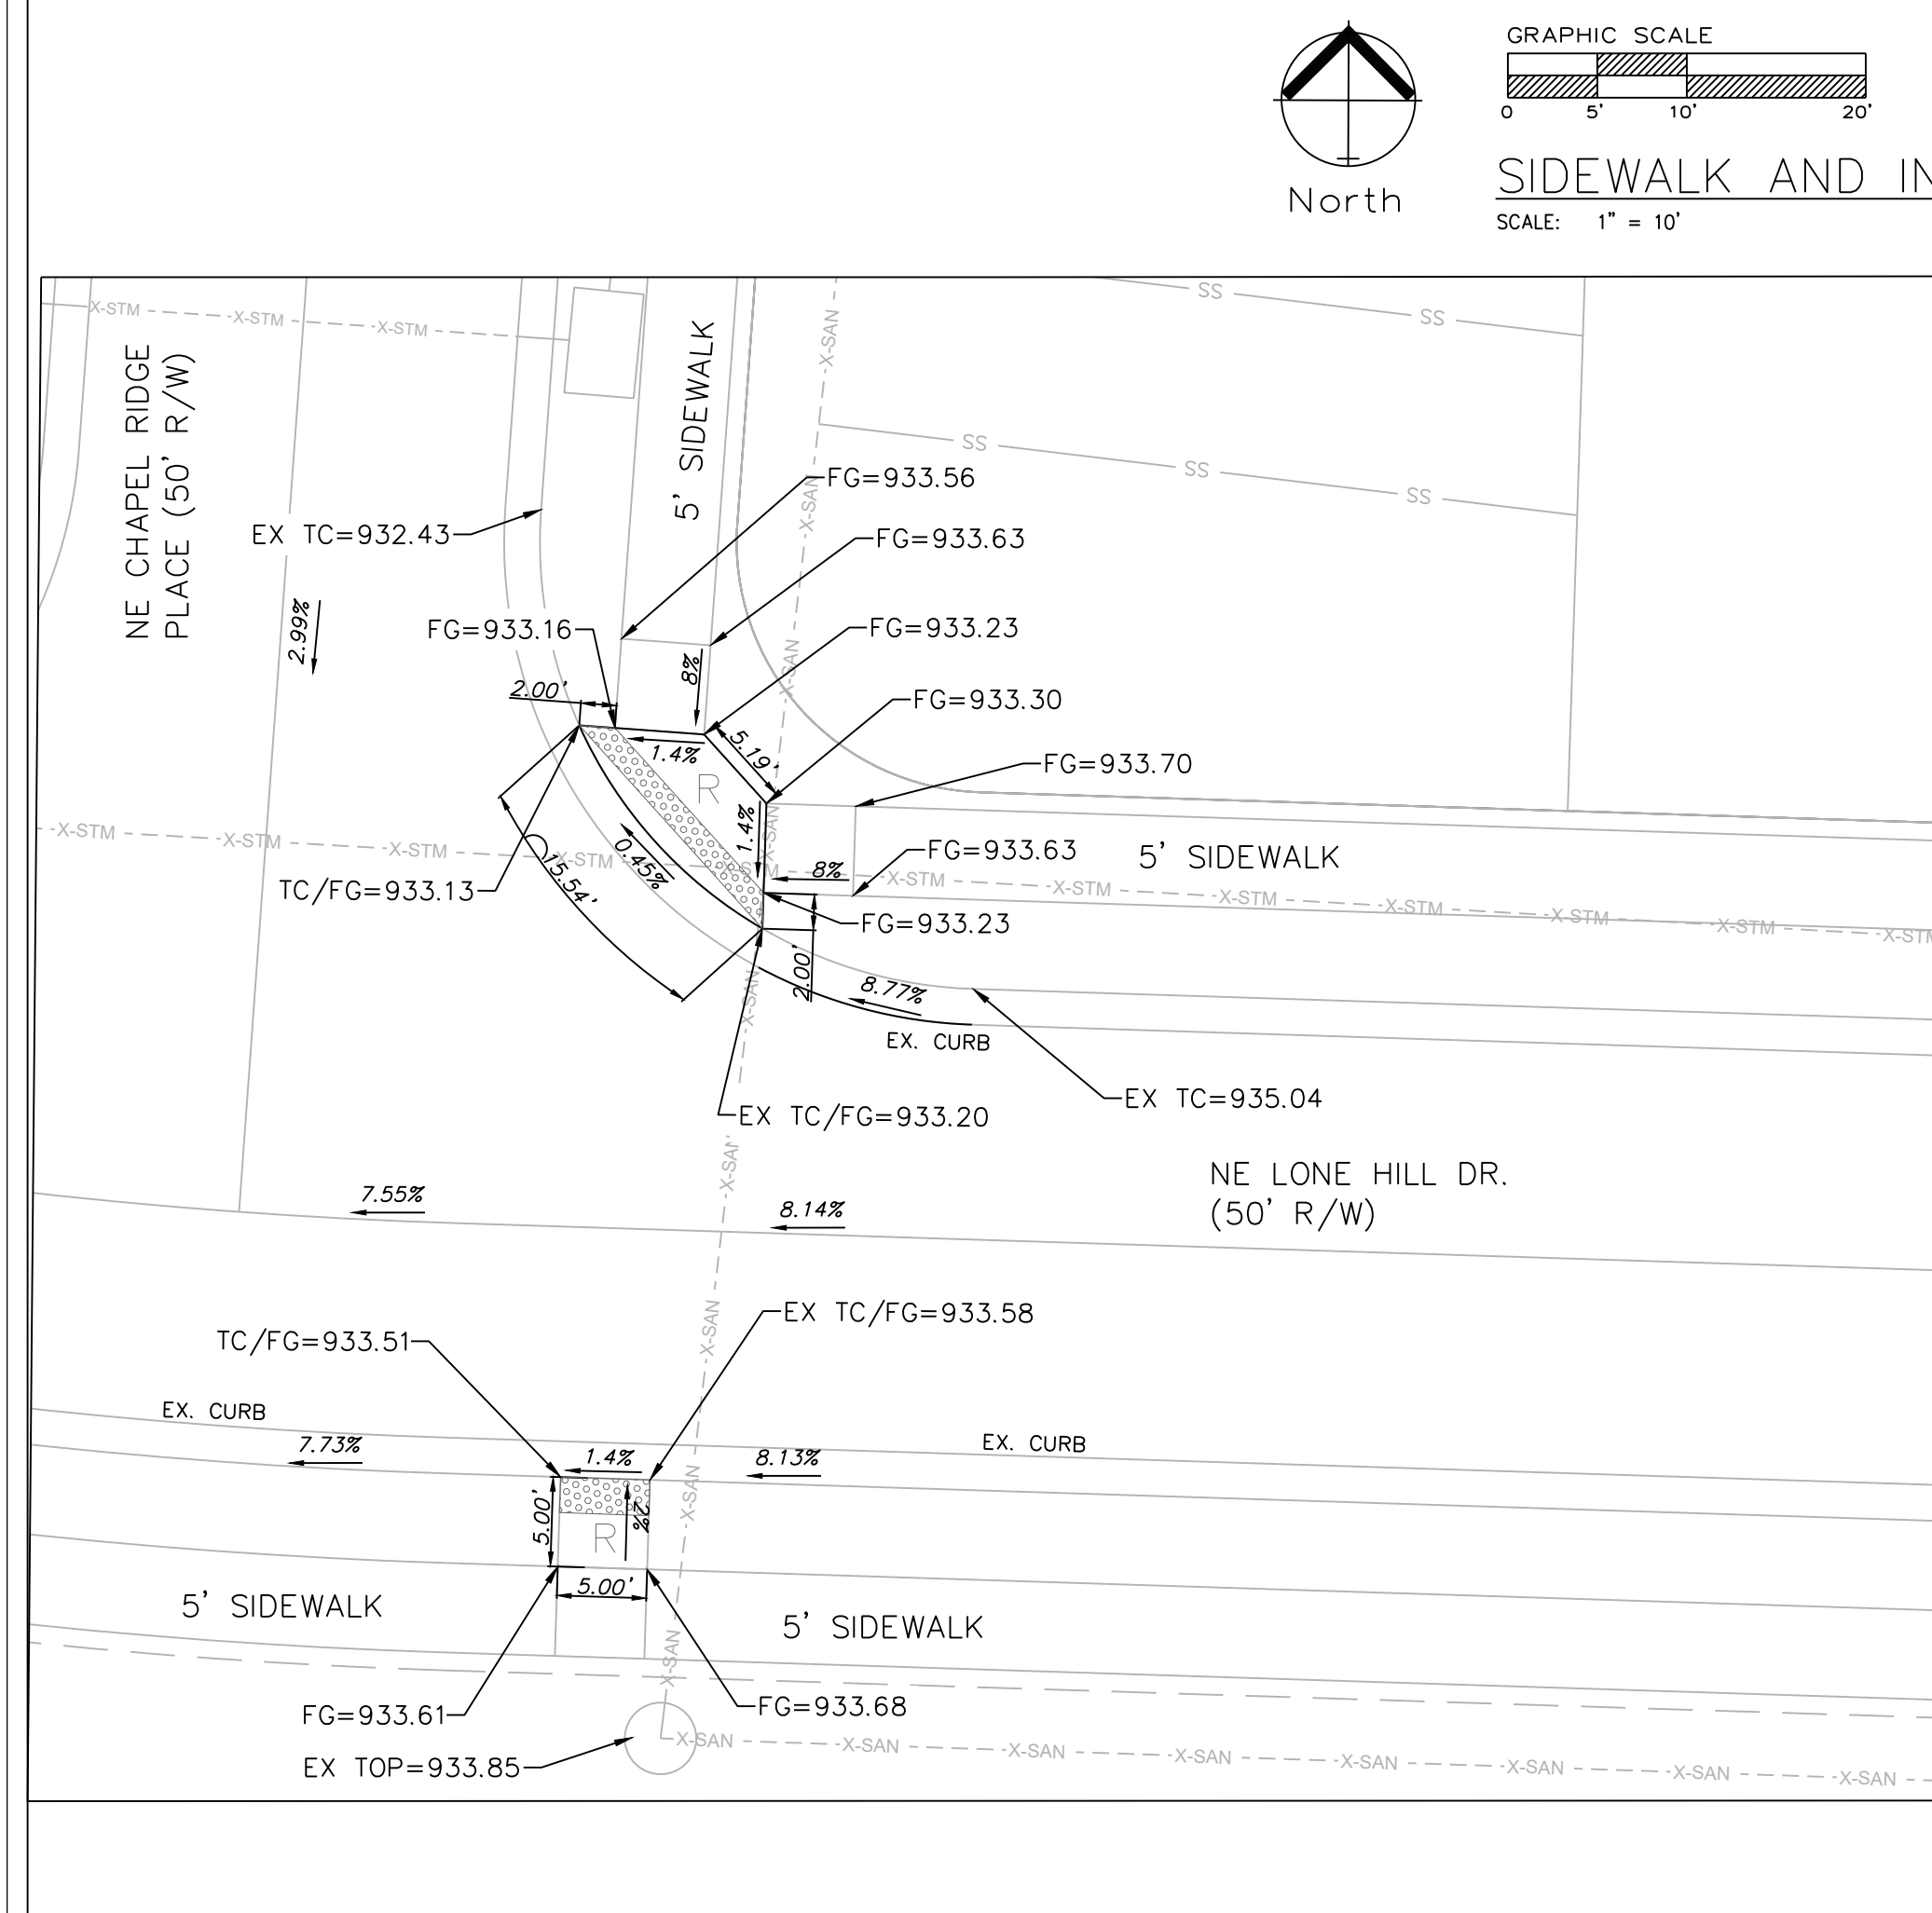


SIDWALK AND INTERSECTION PLAN
SCALE: 1" = 10'

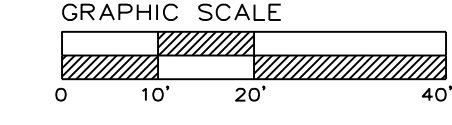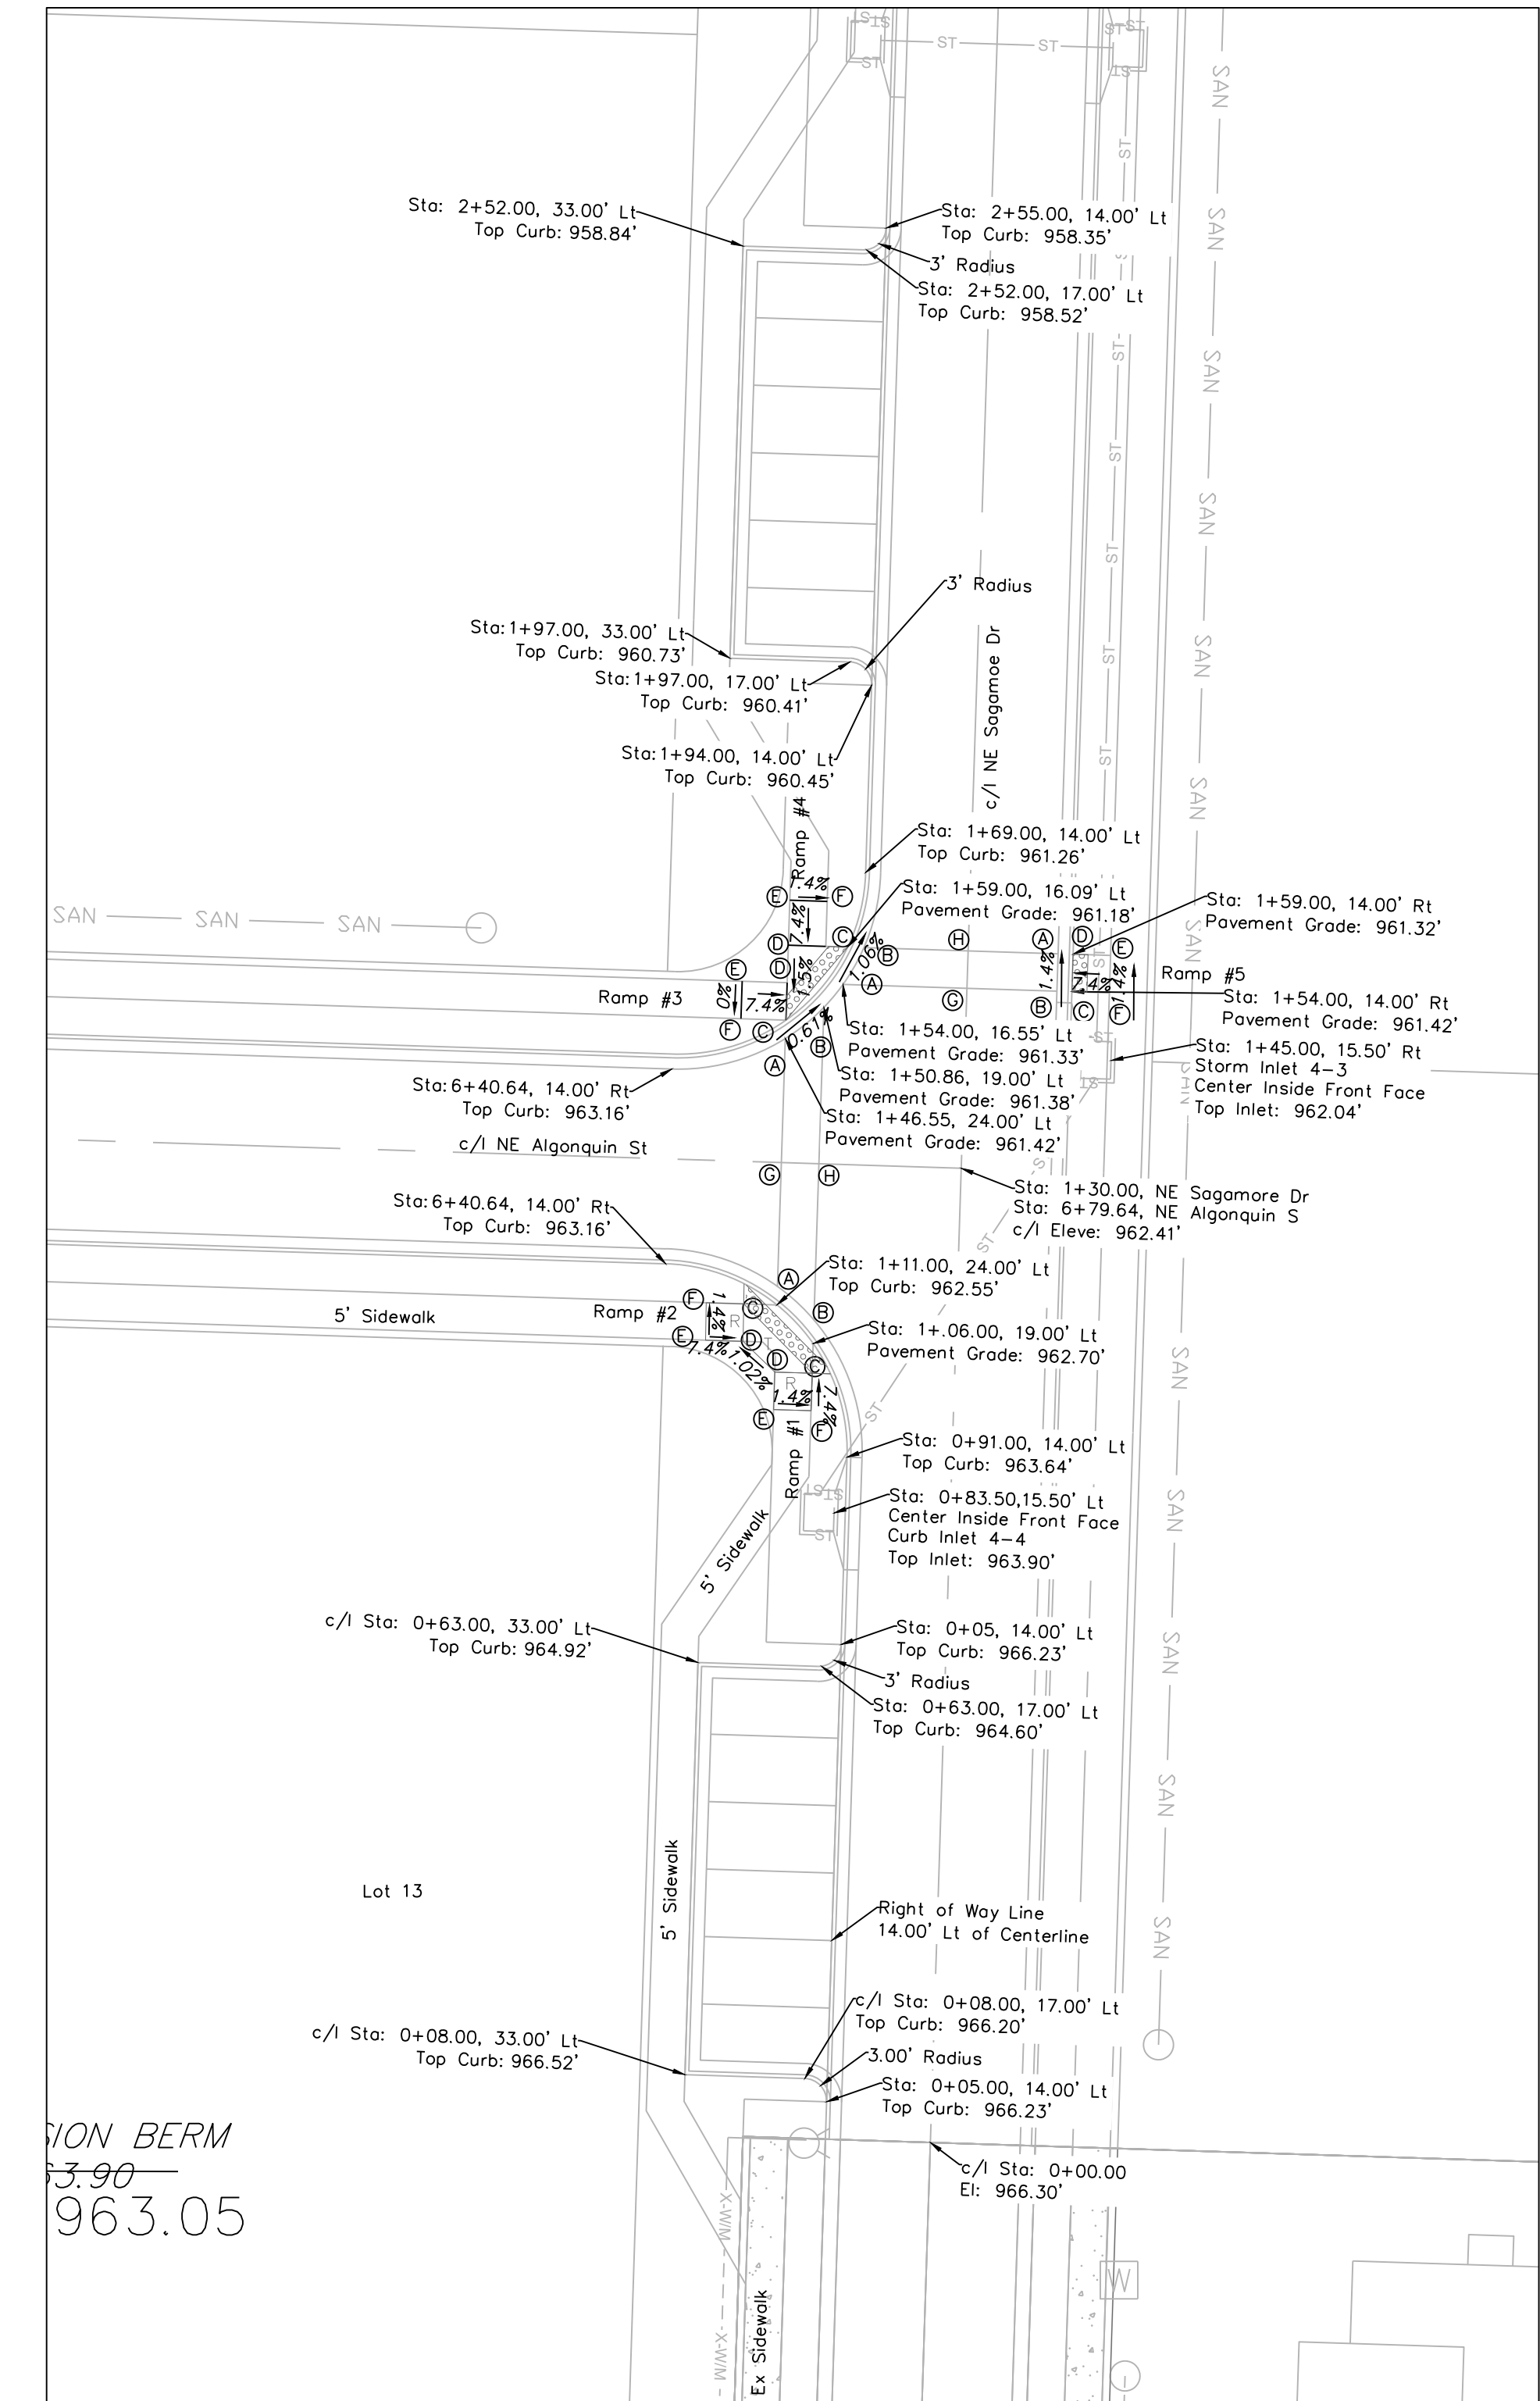

SIDWALK AND INTERSECTION PLAN
SCALE: 1" = 20'

Spot	Ramp 1 Elevation	Ramp 2 Elevation	Ramp 3 Elevation	Ramp 4 Elevation	Ramp 5 Elevation
A	962.55	962.55	961.42	961.33	961.35
B	962.70	962.70	961.38	961.27	961.42
C	962.75	962.69	961.45	961.30	961.45
D	962.82	962.76	961.45	961.37	961.38
E	963.19	963.13	961.90	961.81	961.75
F	963.12	963.06	961.90	961.74	961.82
G	961.99	961.99	961.99	961.38	961.38
H	961.92	961.92	961.92	961.31	961.31

"AS-BUILT"
900.00
900.00 Indicates data replaced with "As-Built" information. All other data is as designed and has not been field verified.

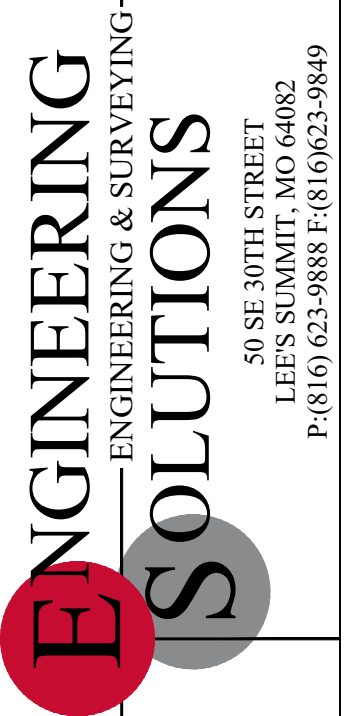

Professional Registration
Missouri
Engineering 2005002186-D
Surveying 200500319-D
Kansas
Engineering E-1685
Surveying LS-218
Oklahoma
Engineering S254
Nebraska
Engineering CA2821


Project:
VILLAS OF CHAPEL RIDGE LSMD
Issue Date:
April 10, 2020

Sidewalk and Intersection Plan
Construction Plans for:
THE TOWNHOMES OF CHAPEL RIDGE-2ND PLAT
LOTS 9-19 & TRACTS A-D
Lee's Summit, Jackson County, Missouri





Matthew J. Schlicht
MO PE 2006019708
KS PE 19071
OK PE 25226
NE PE E-14335

REVISIONS
6/25/2021 As-Built
8/18/2021 As-Built

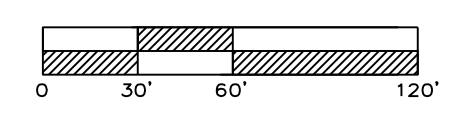

STORM SEWER GENERAL LAYOUT

SCALE: 1" = 60'

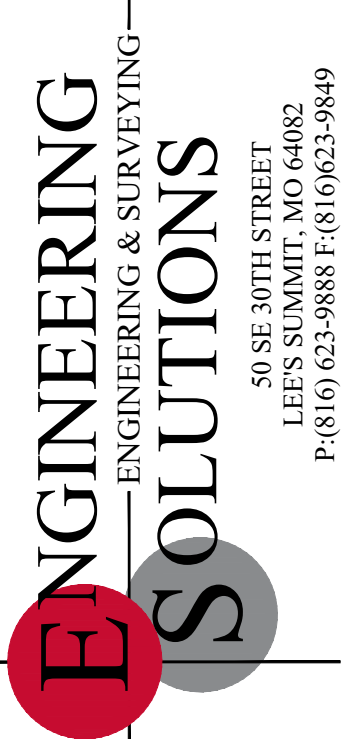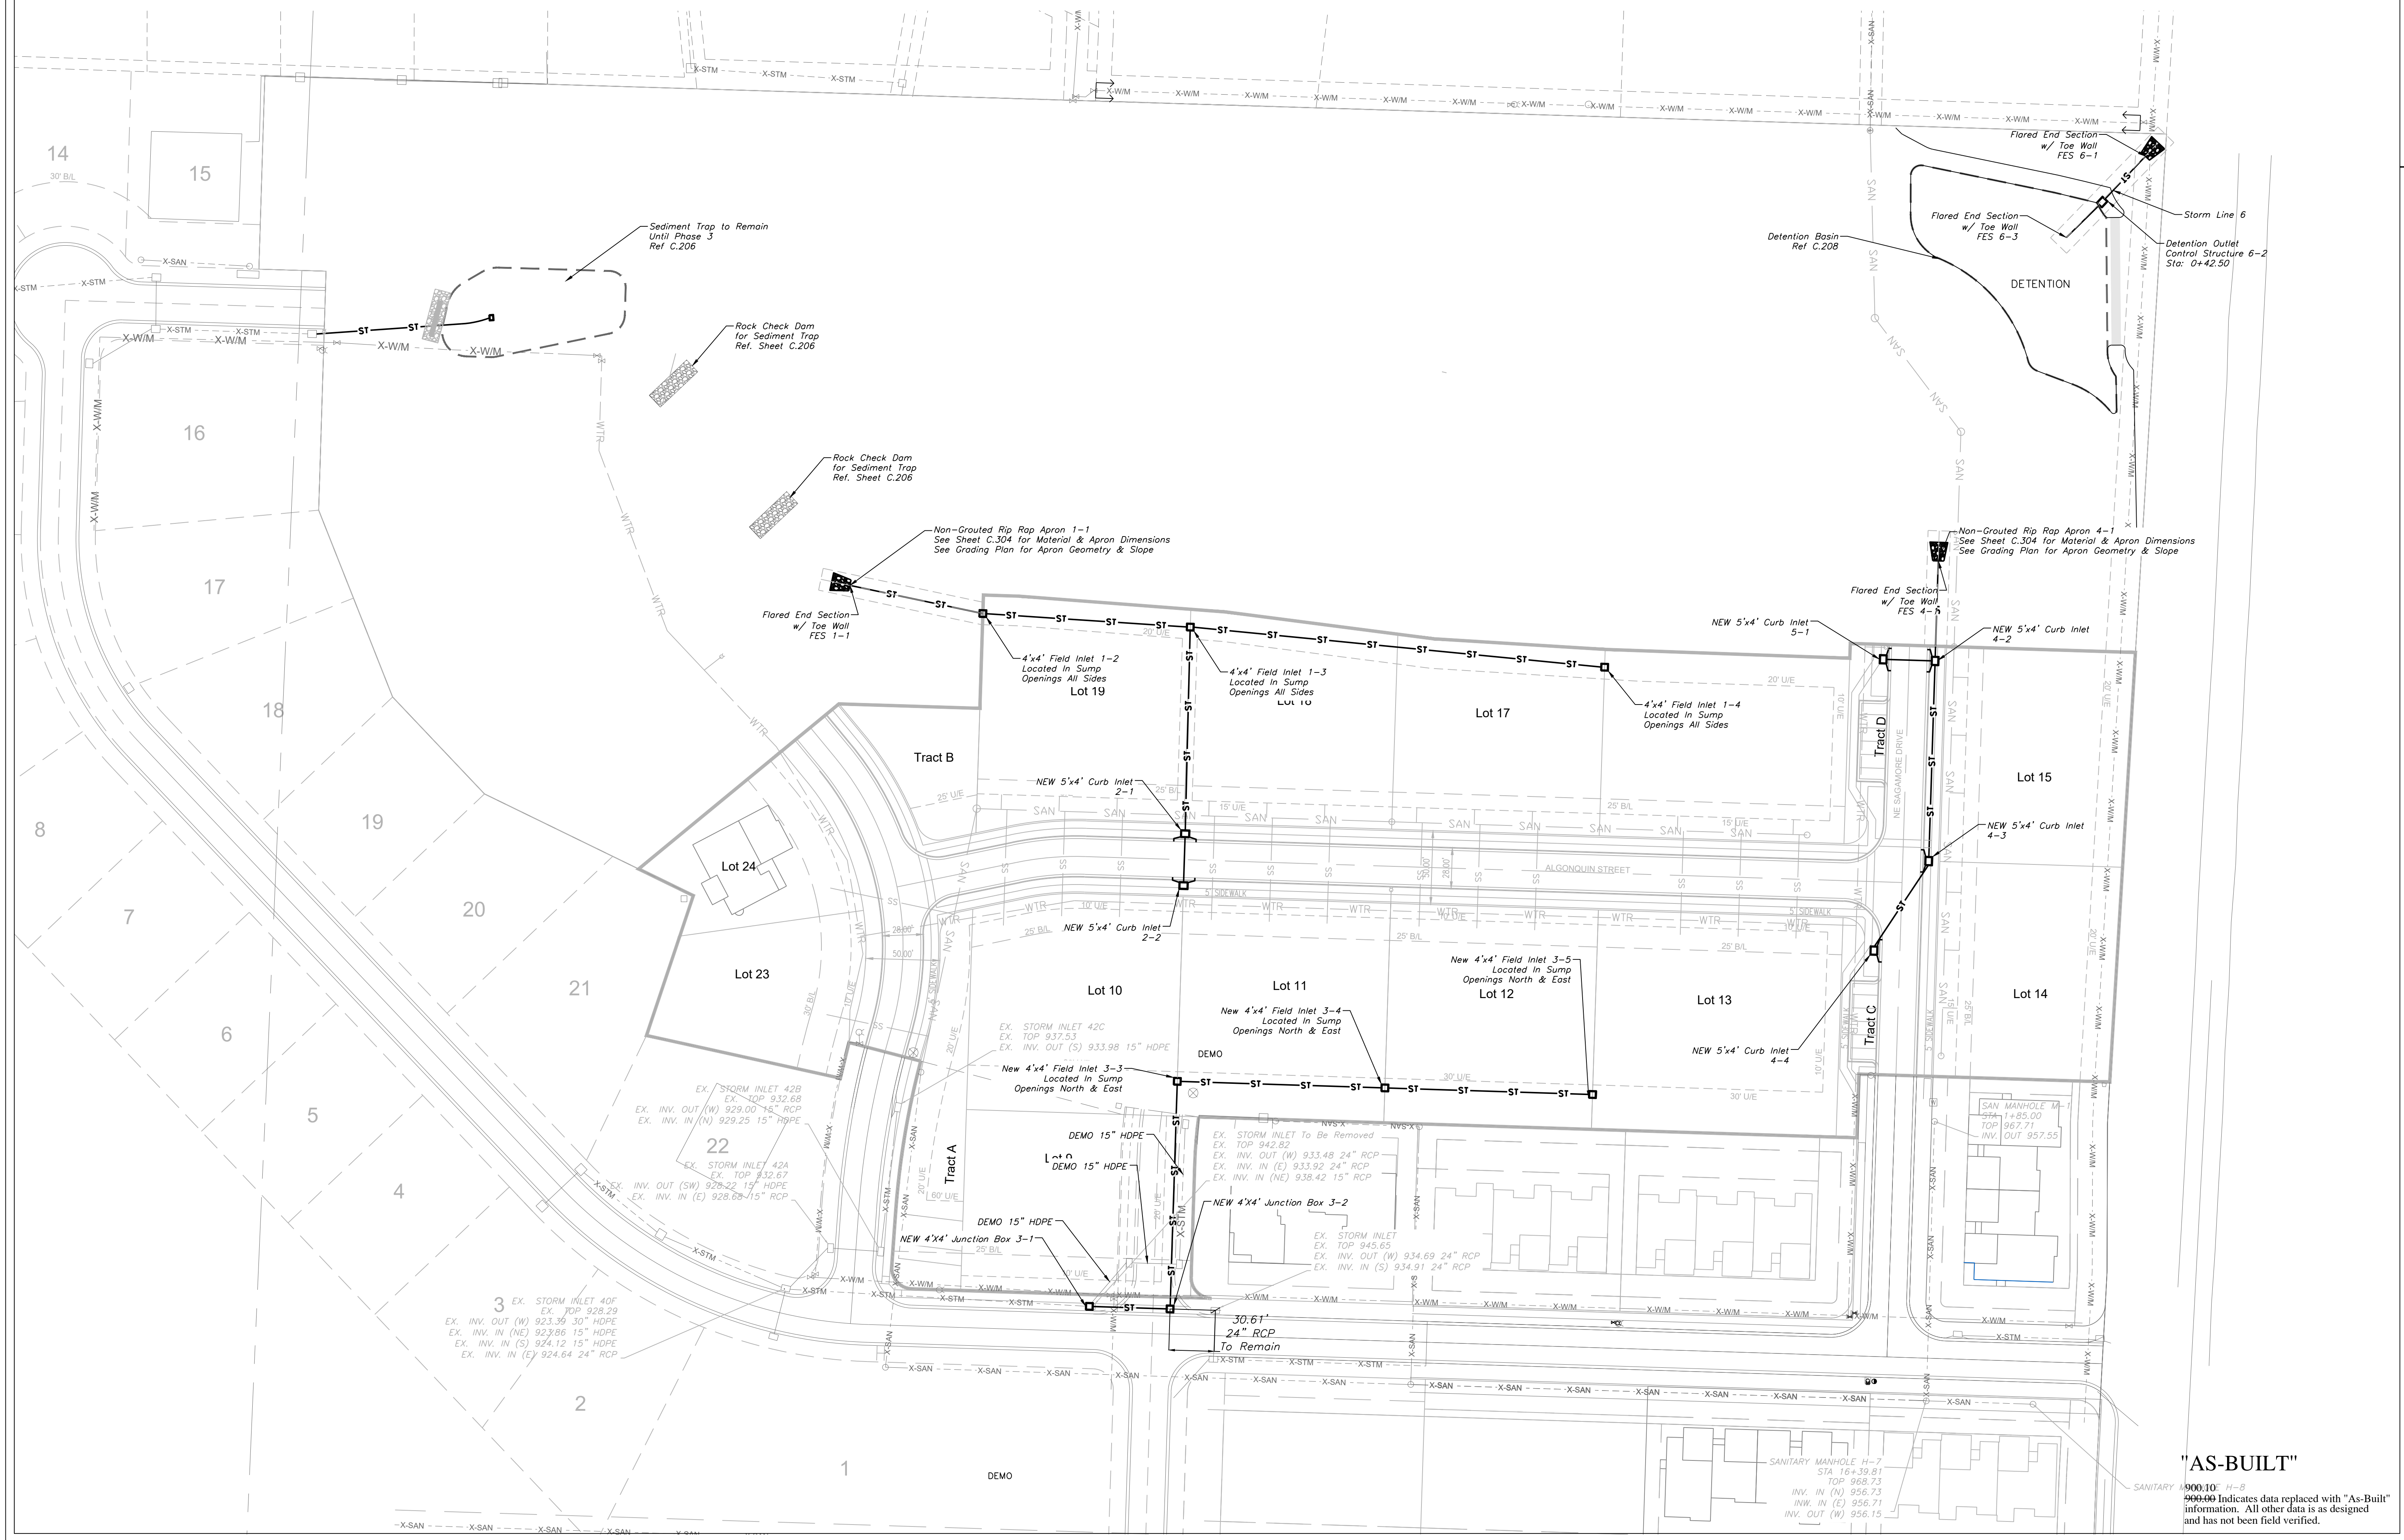

ENGINEERING SOLUTIONS
ENGINEERING & SURVEYING
50 SE 30TH STREET
LEES SUMMIT, MO 64082
P: (816) 623-9888 F: (816) 623-9849

Professional Registration
Missouri
Engineering 2005002186-D
Surveying 200500319-D
Kansas
Engineering E-1695
Surveying LS-218
Oklahoma
Engineering 6254
Nebraska
Engineering CA2821

Project:
VILLAGES OF CHAPEL
RIDGE LSMO
Issue Date:
April 10, 2020




Storm Sewer General Layout
Construction Plans for:
THE TOWNHOMES OF CHAPEL RIDGE-2ND PLAT
LOTS 9-19 & TRACTS A-D
Lee's Summit, Jackson County, Missouri




Matthew J. Schlicht
MO PE 2006019708
KS PE 19071
OK PE 25226
NE PE E-14335

REVISIONS
6/25/2021 As-Built
8/18/2021 As-Built


"AS-BUILT"
990.00 Indicates data replaced with "As-Built" information. All other data is as designed and has not been field verified.

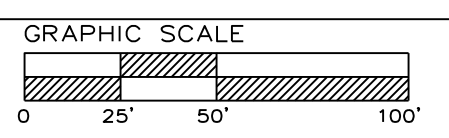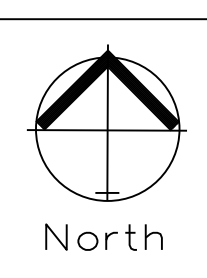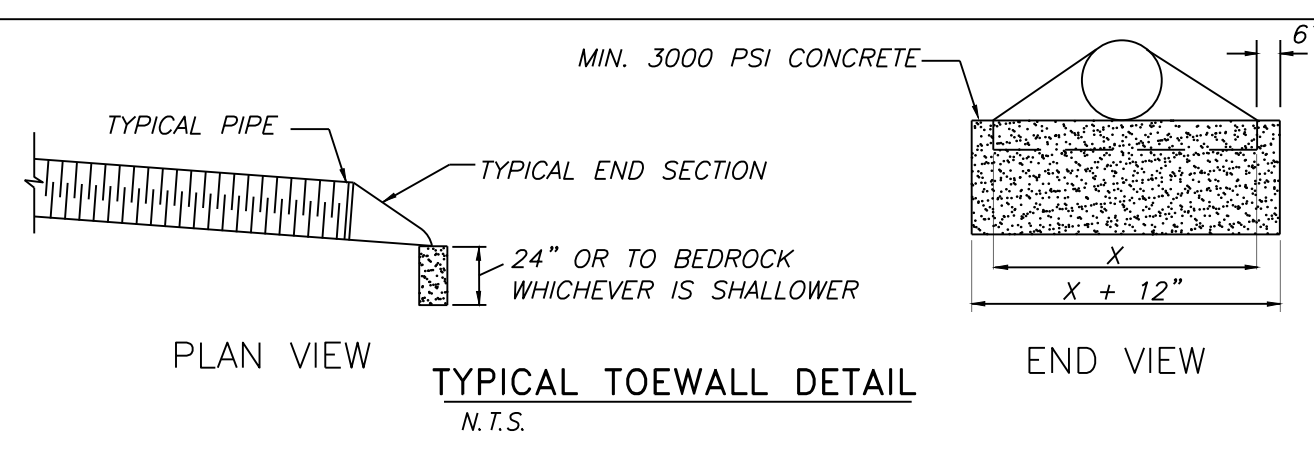


STORM SEWER PLAN & PROFILE
SCALE: 1" = 50'

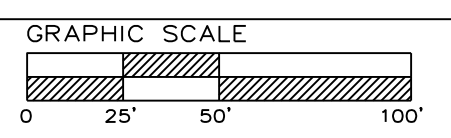



STORM SEWER PLAN & PROFILE
SCALE: 1" = 50'

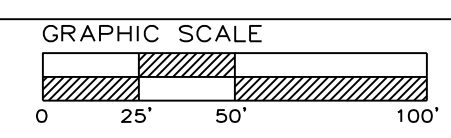



STORM SEWER PLAN & PROFILE
SCALE: 1" = 50'

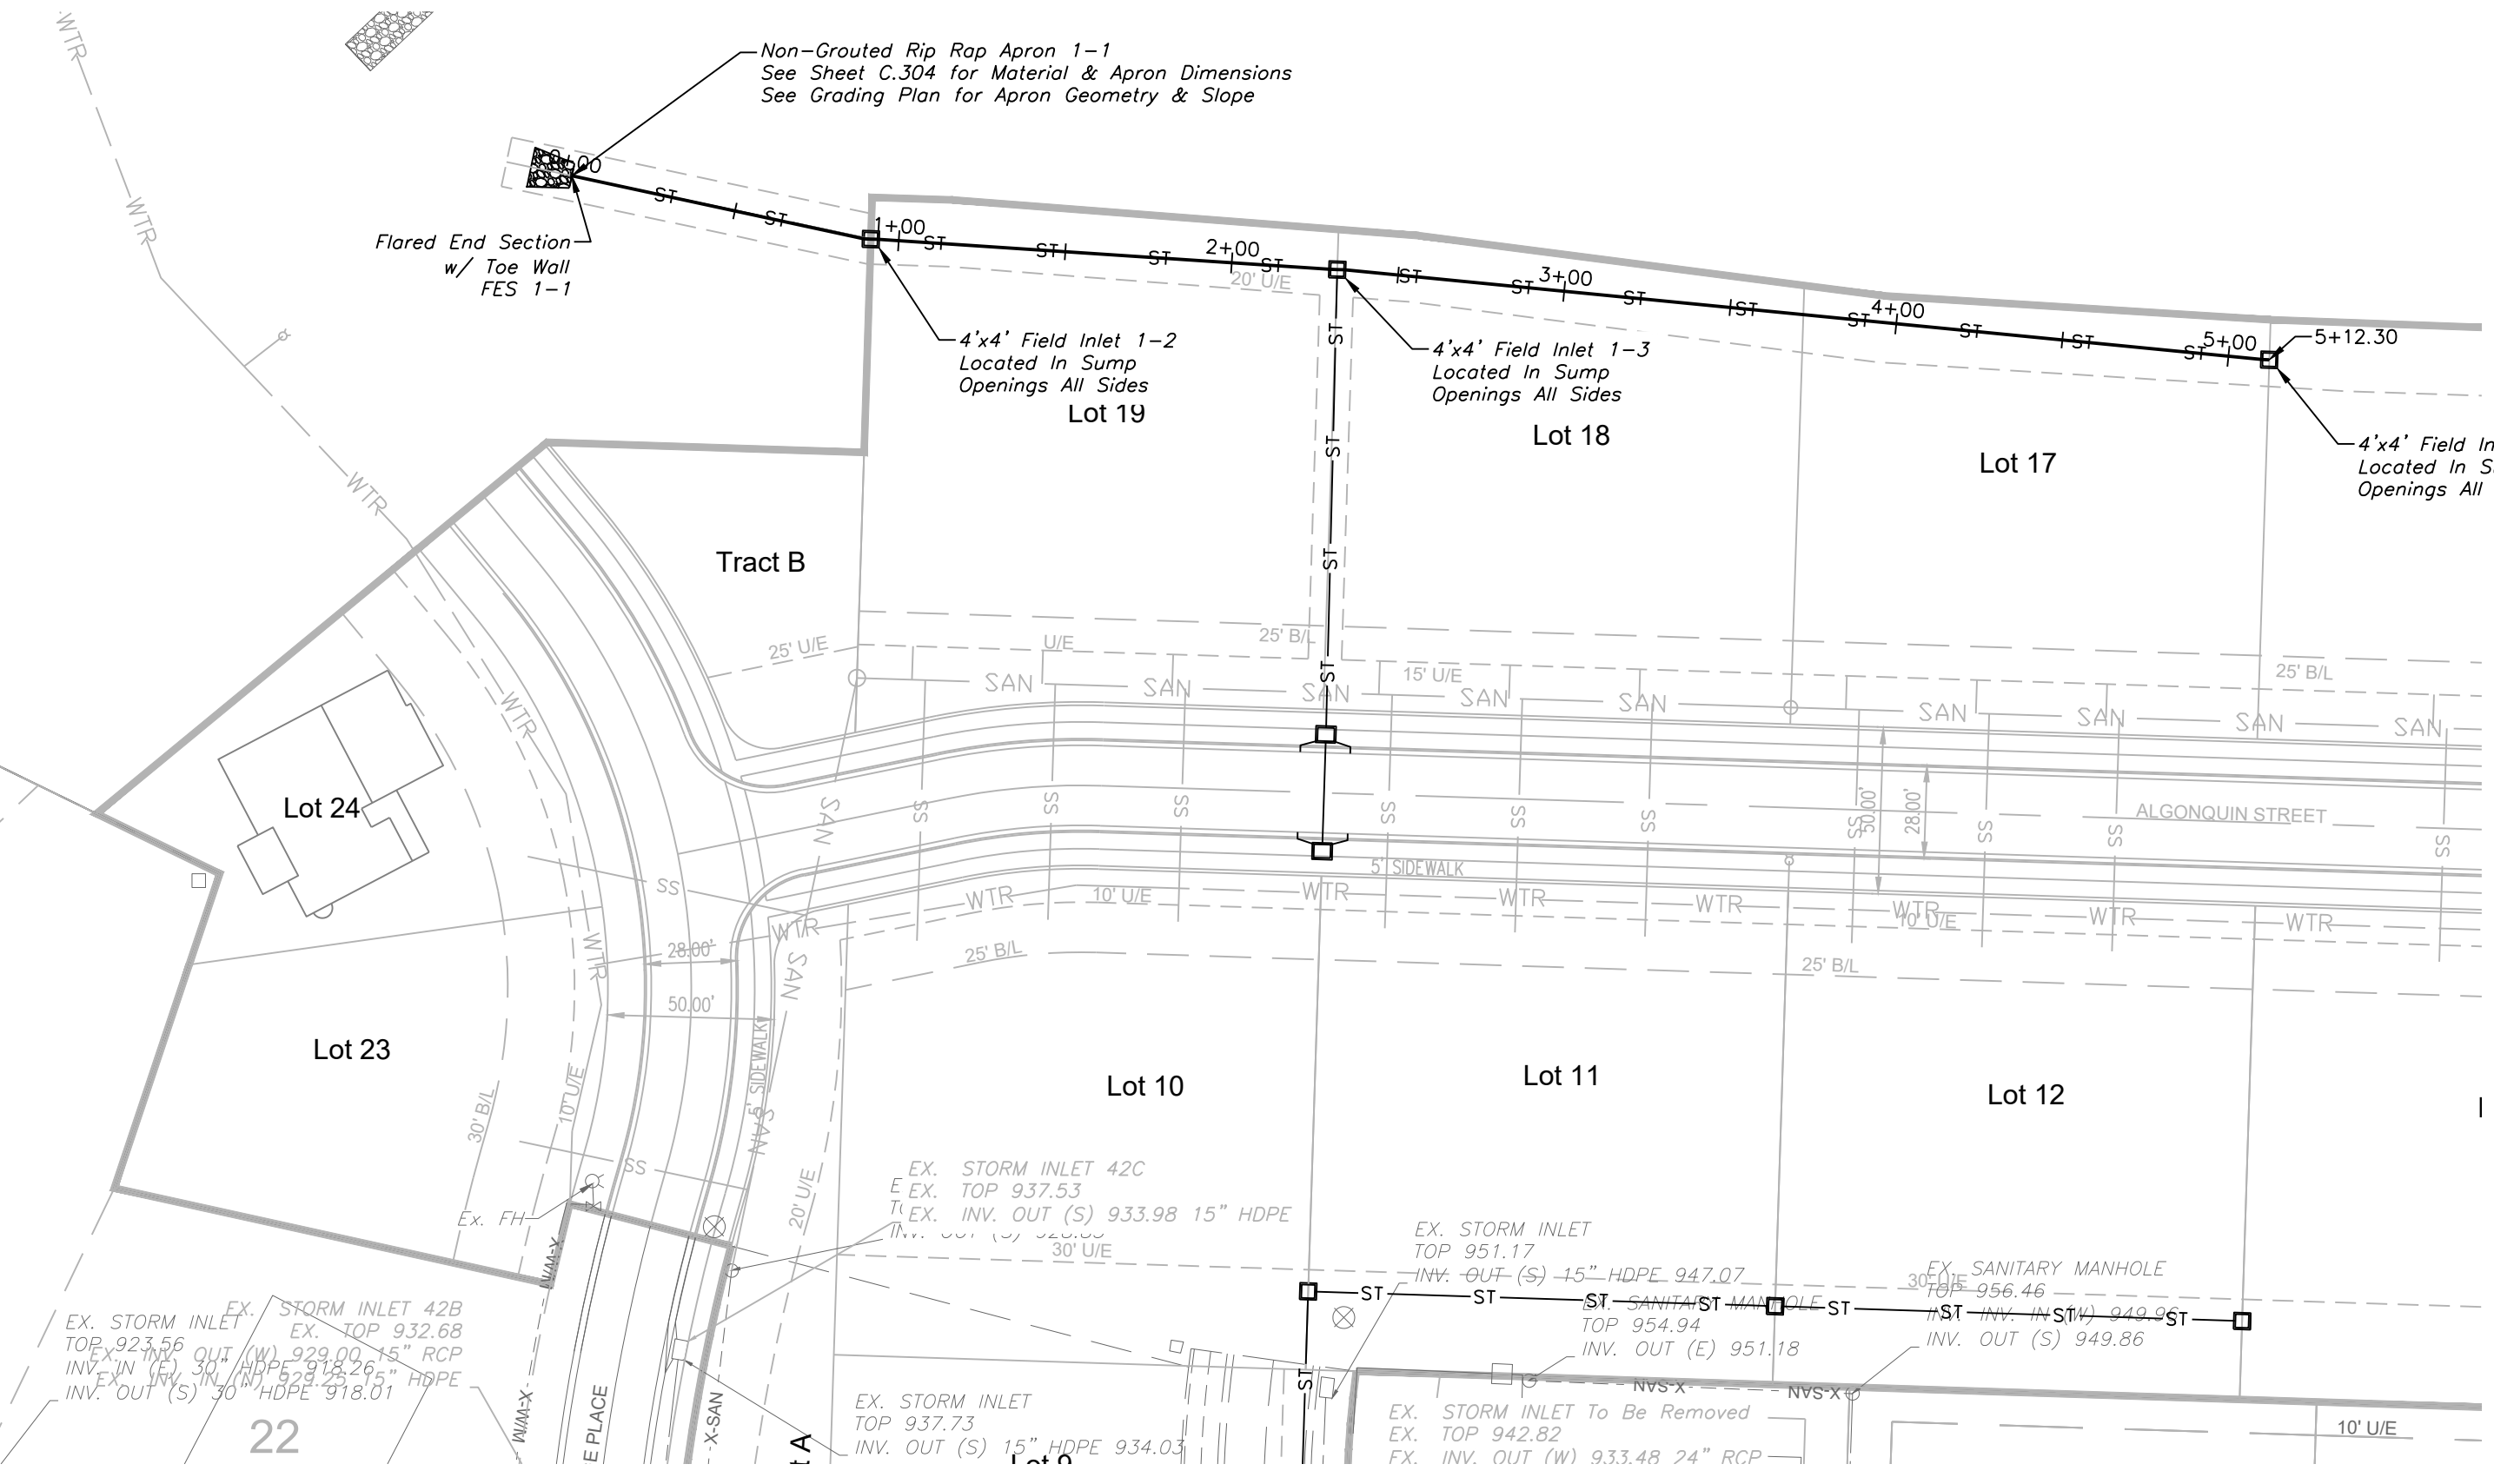



STORM LINE 1

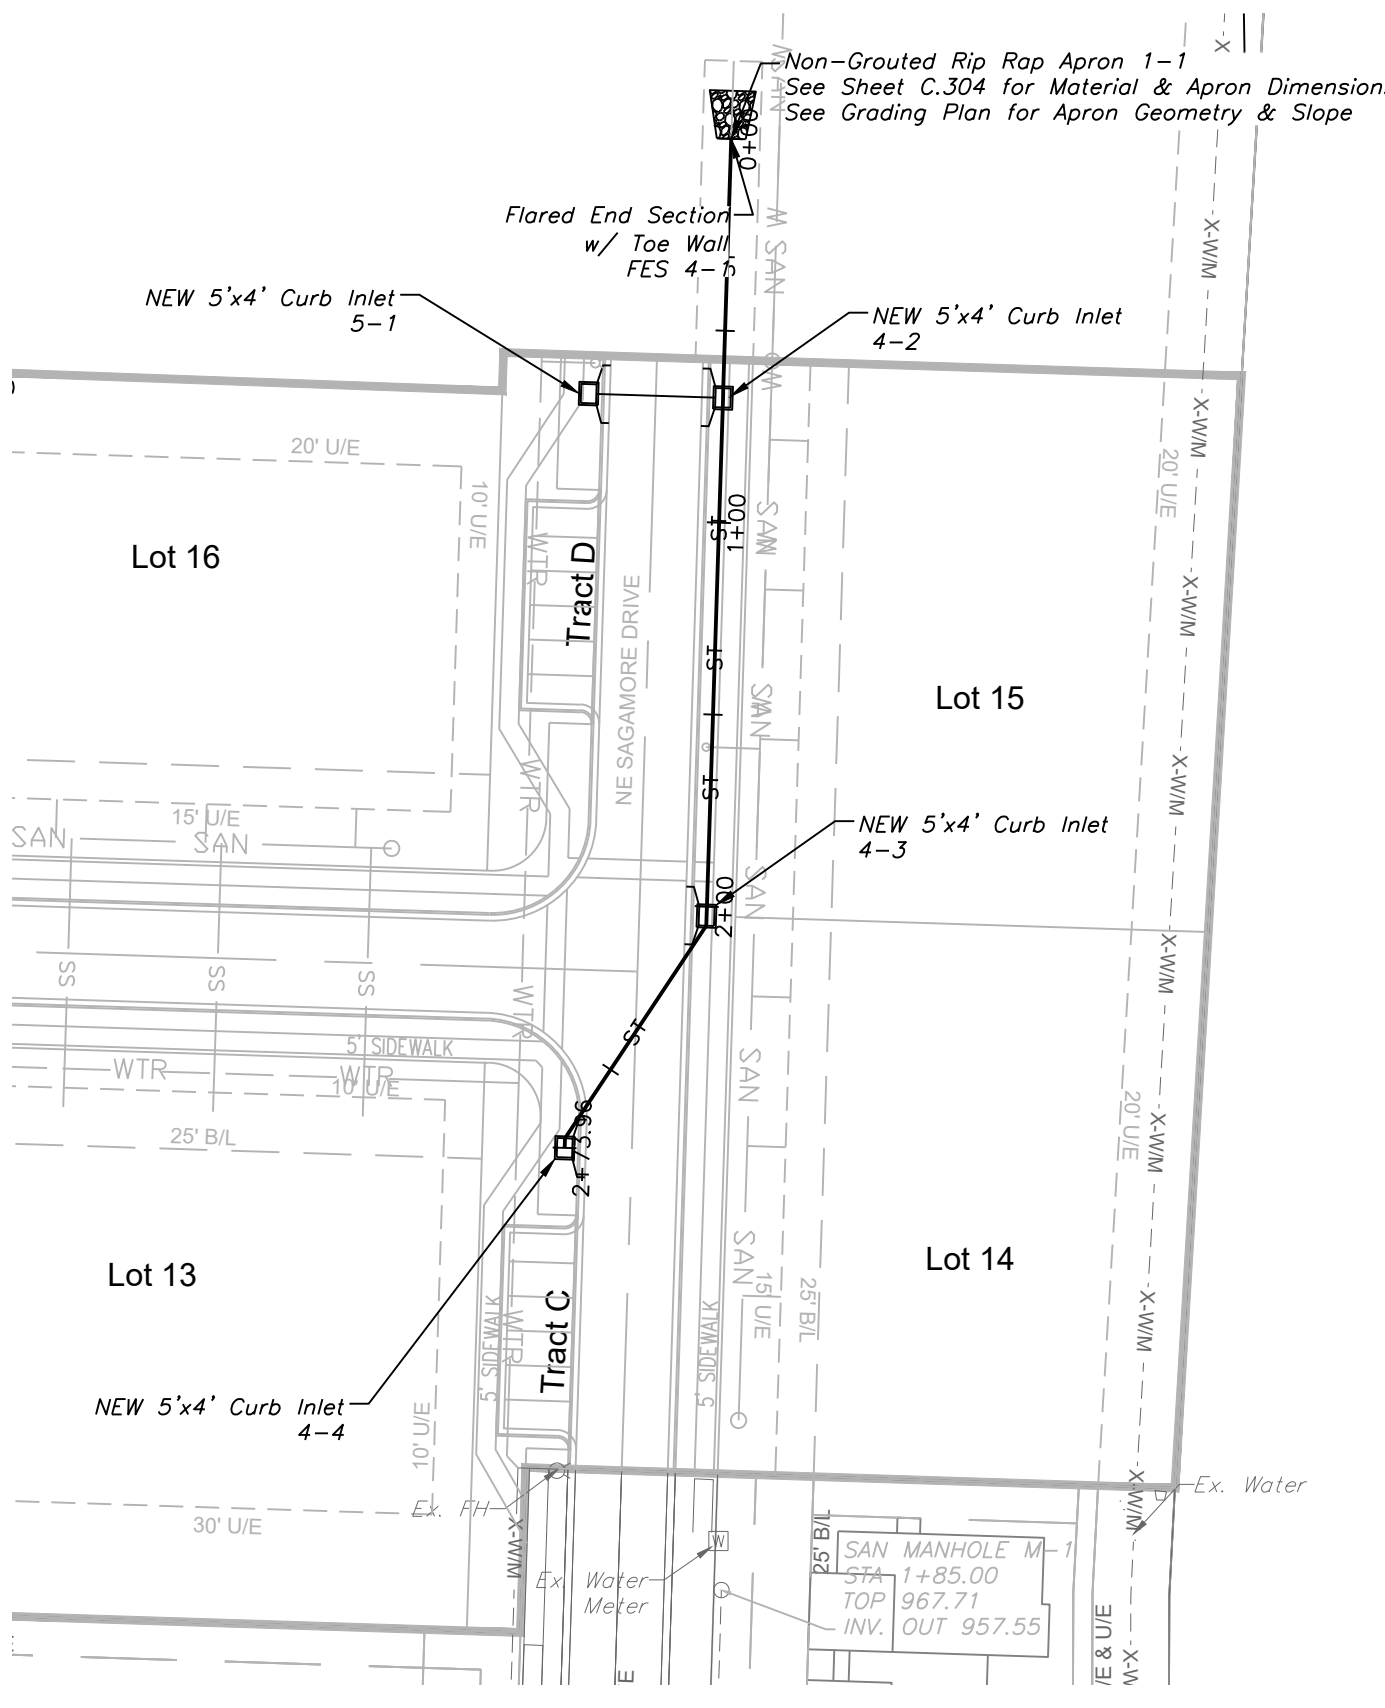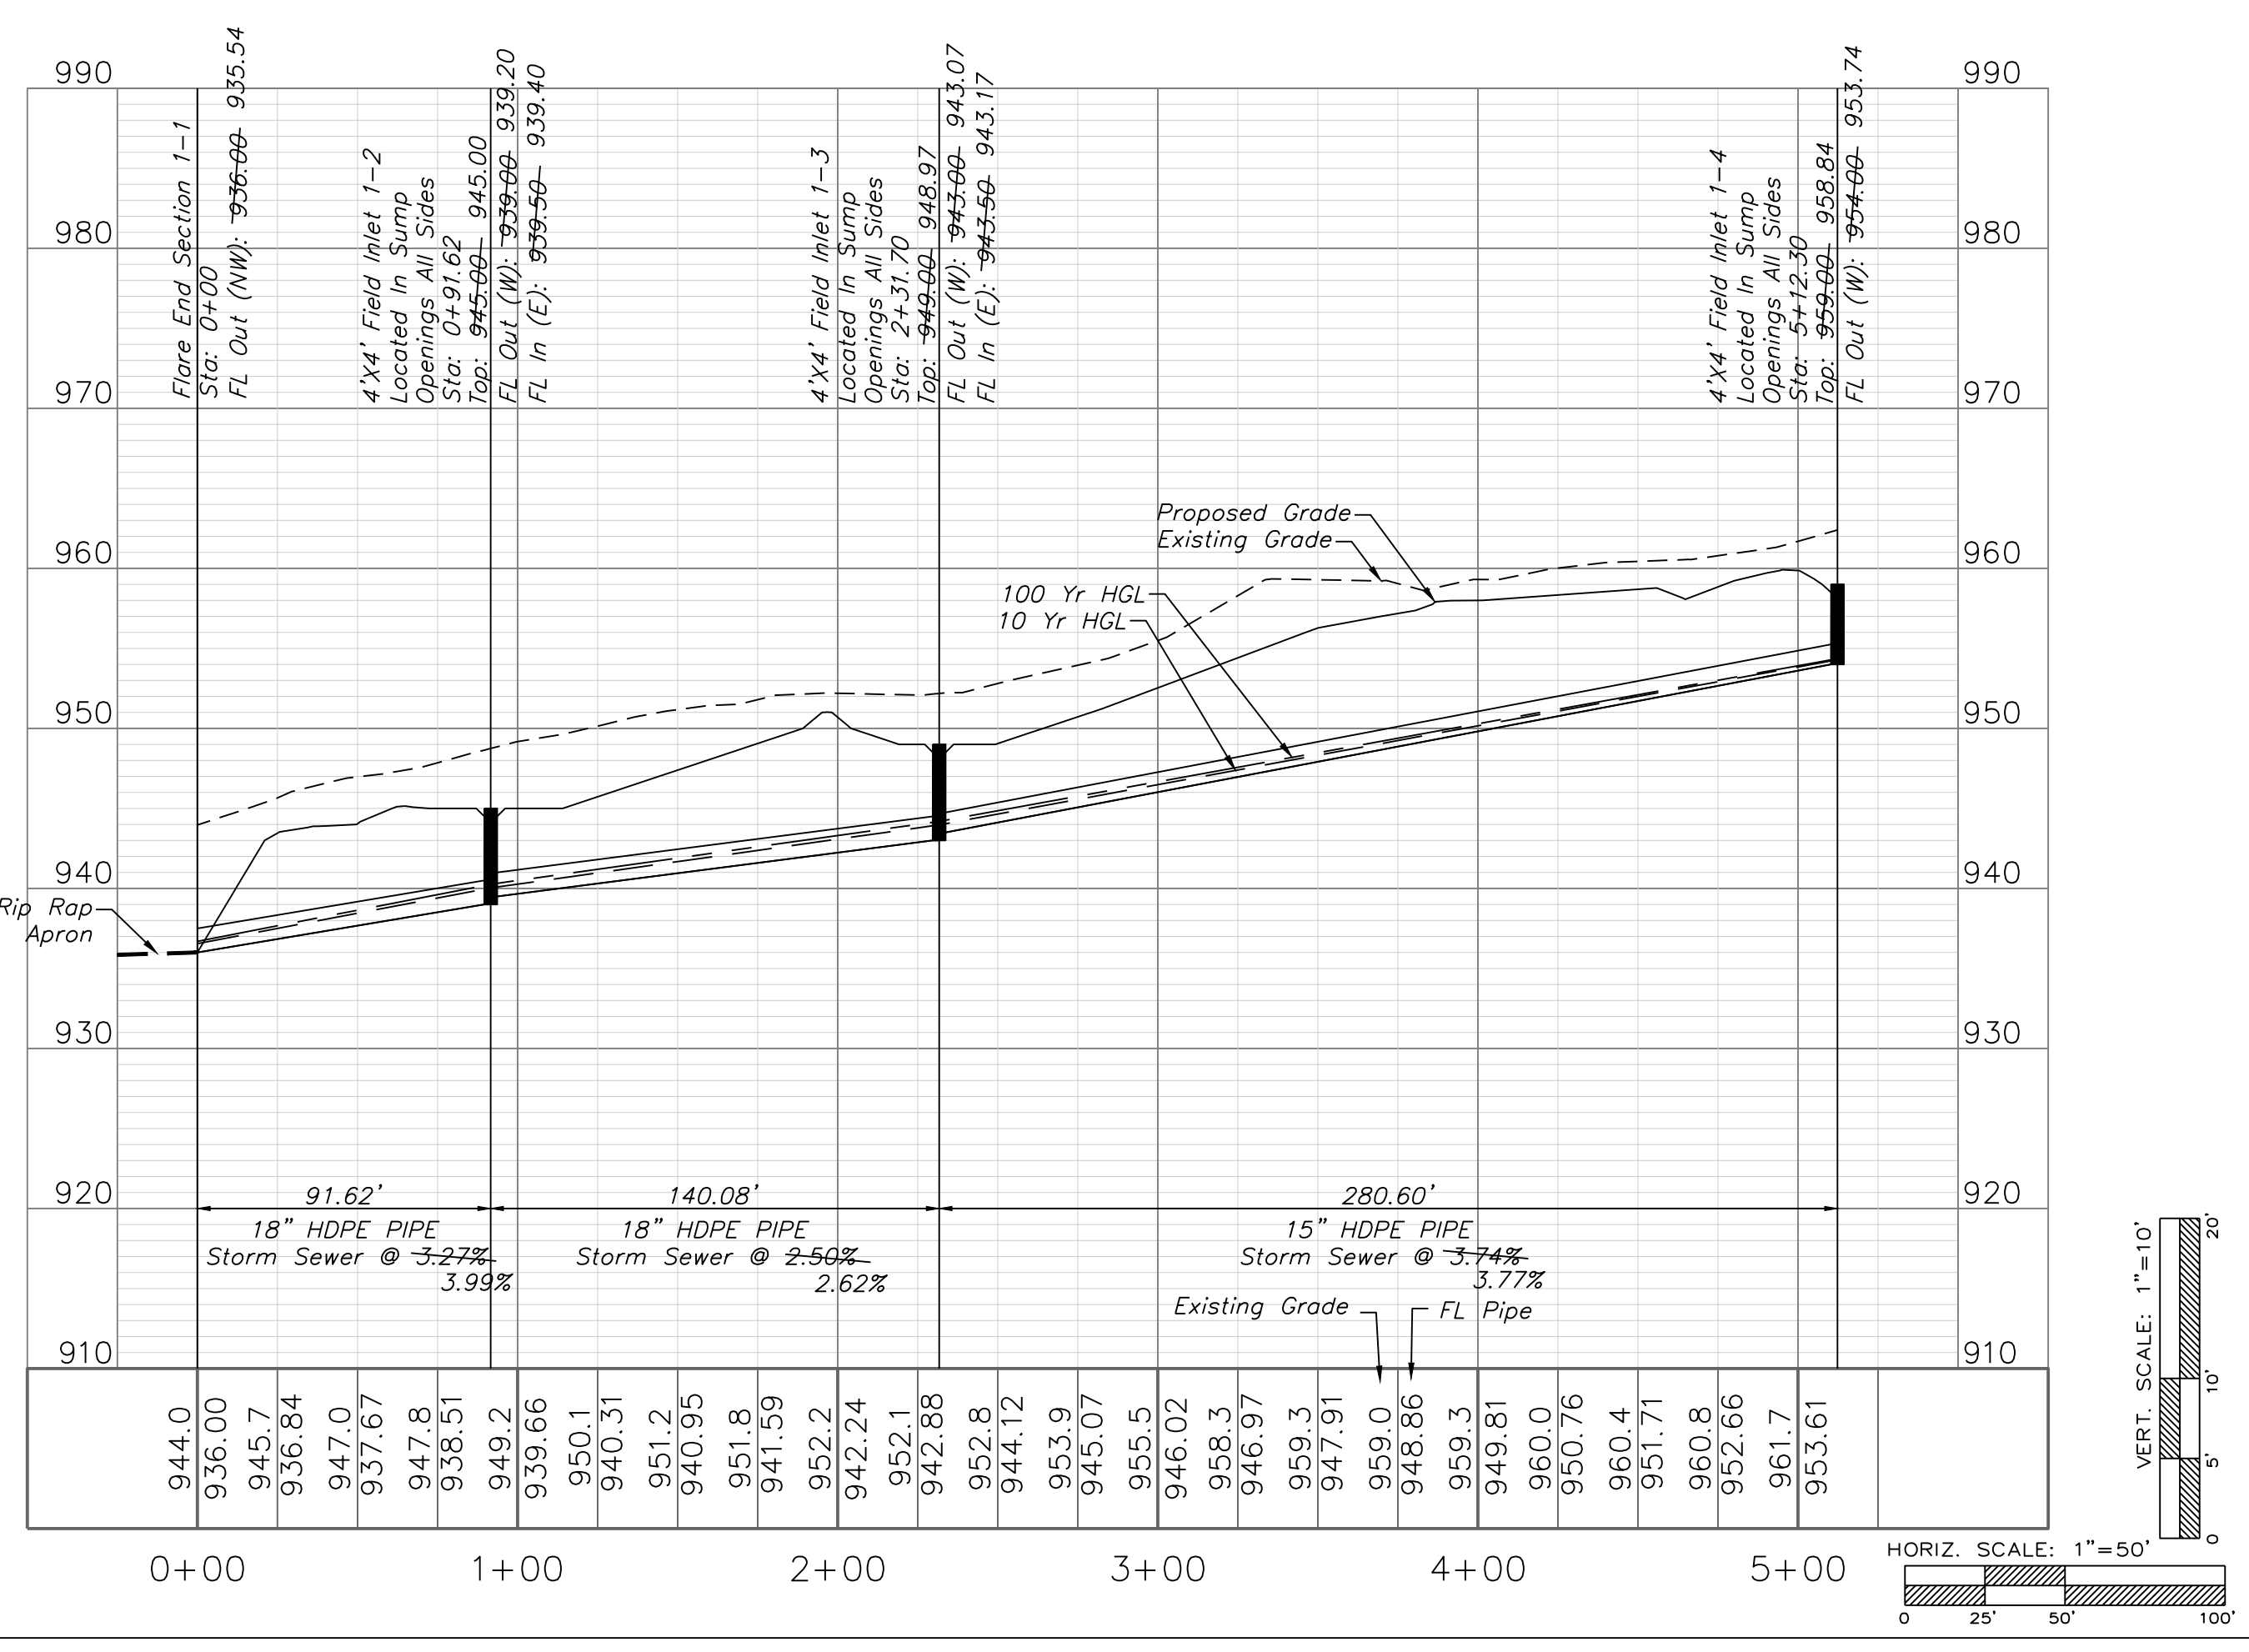

STORM LINE 4

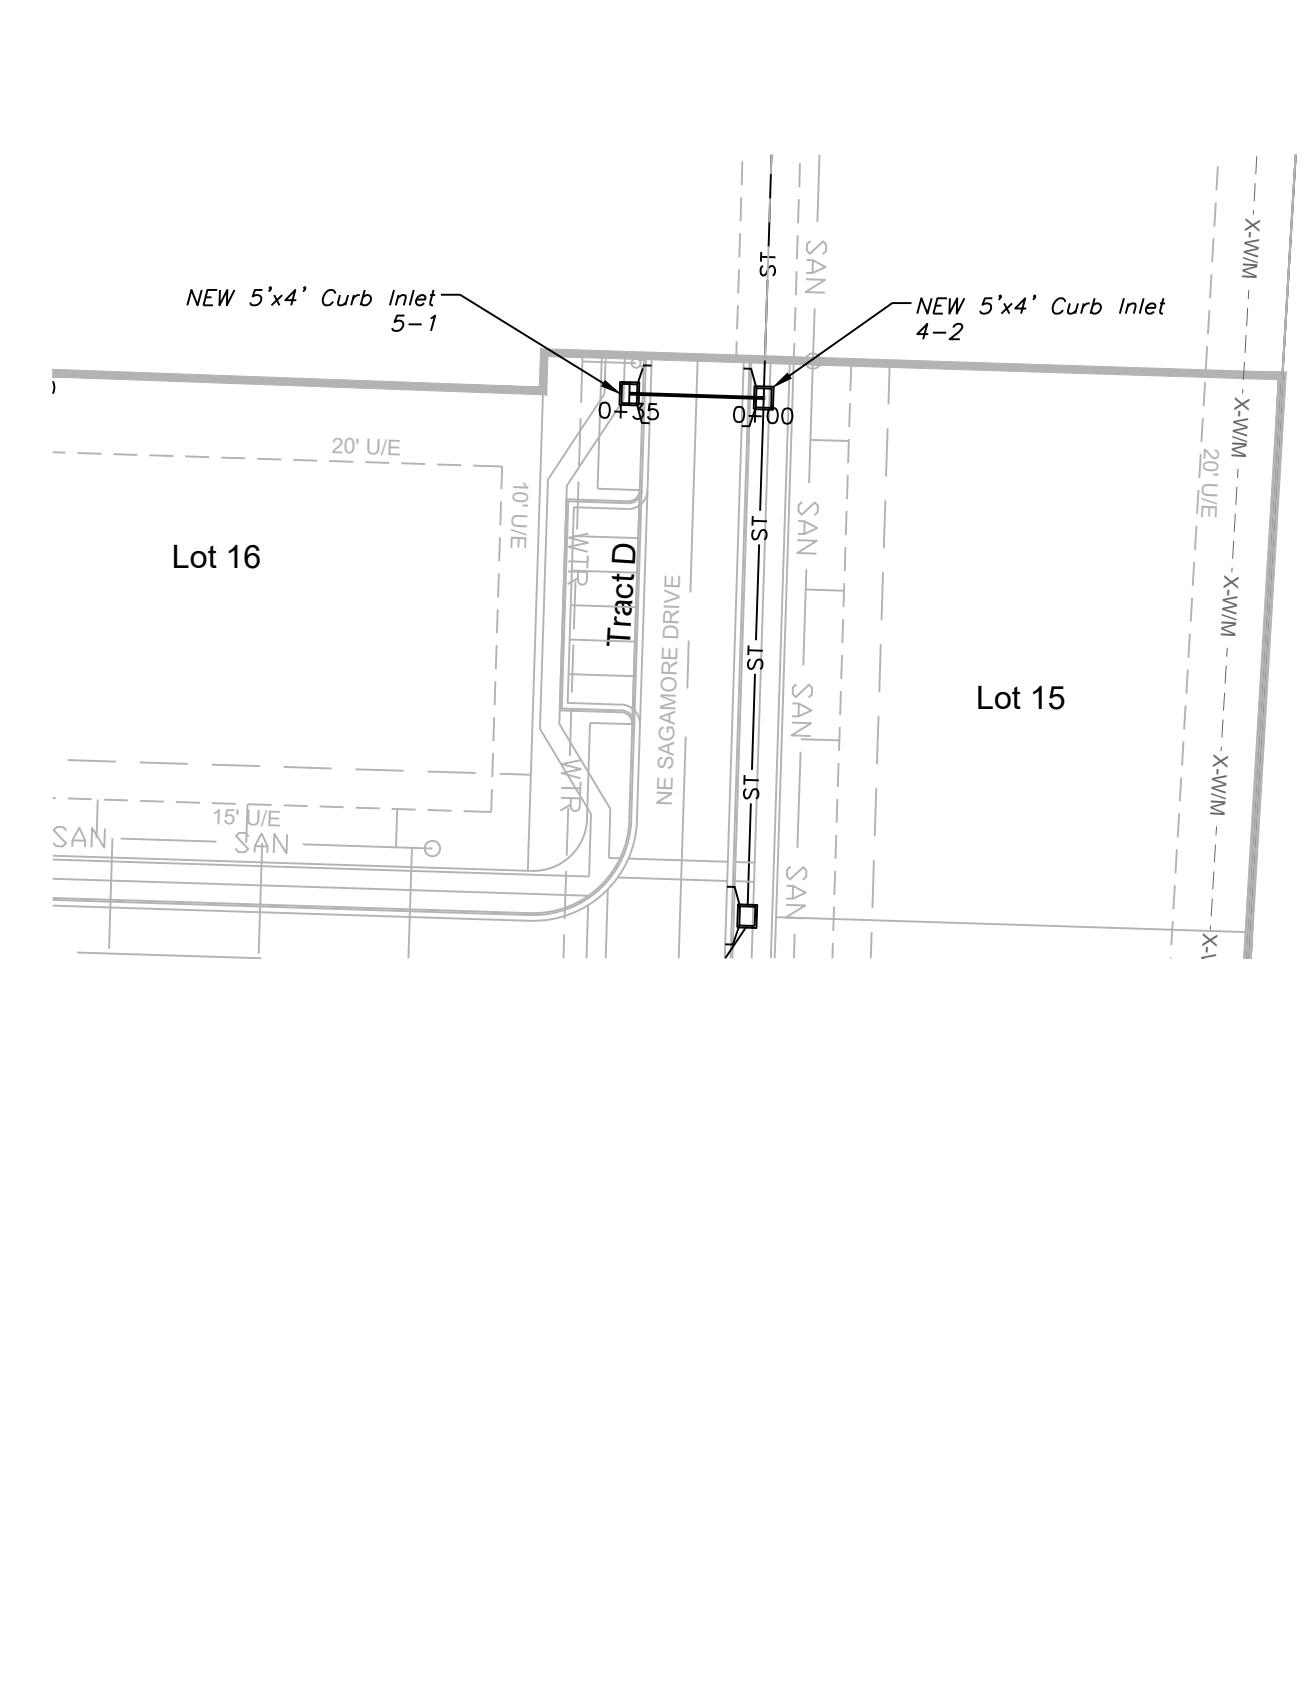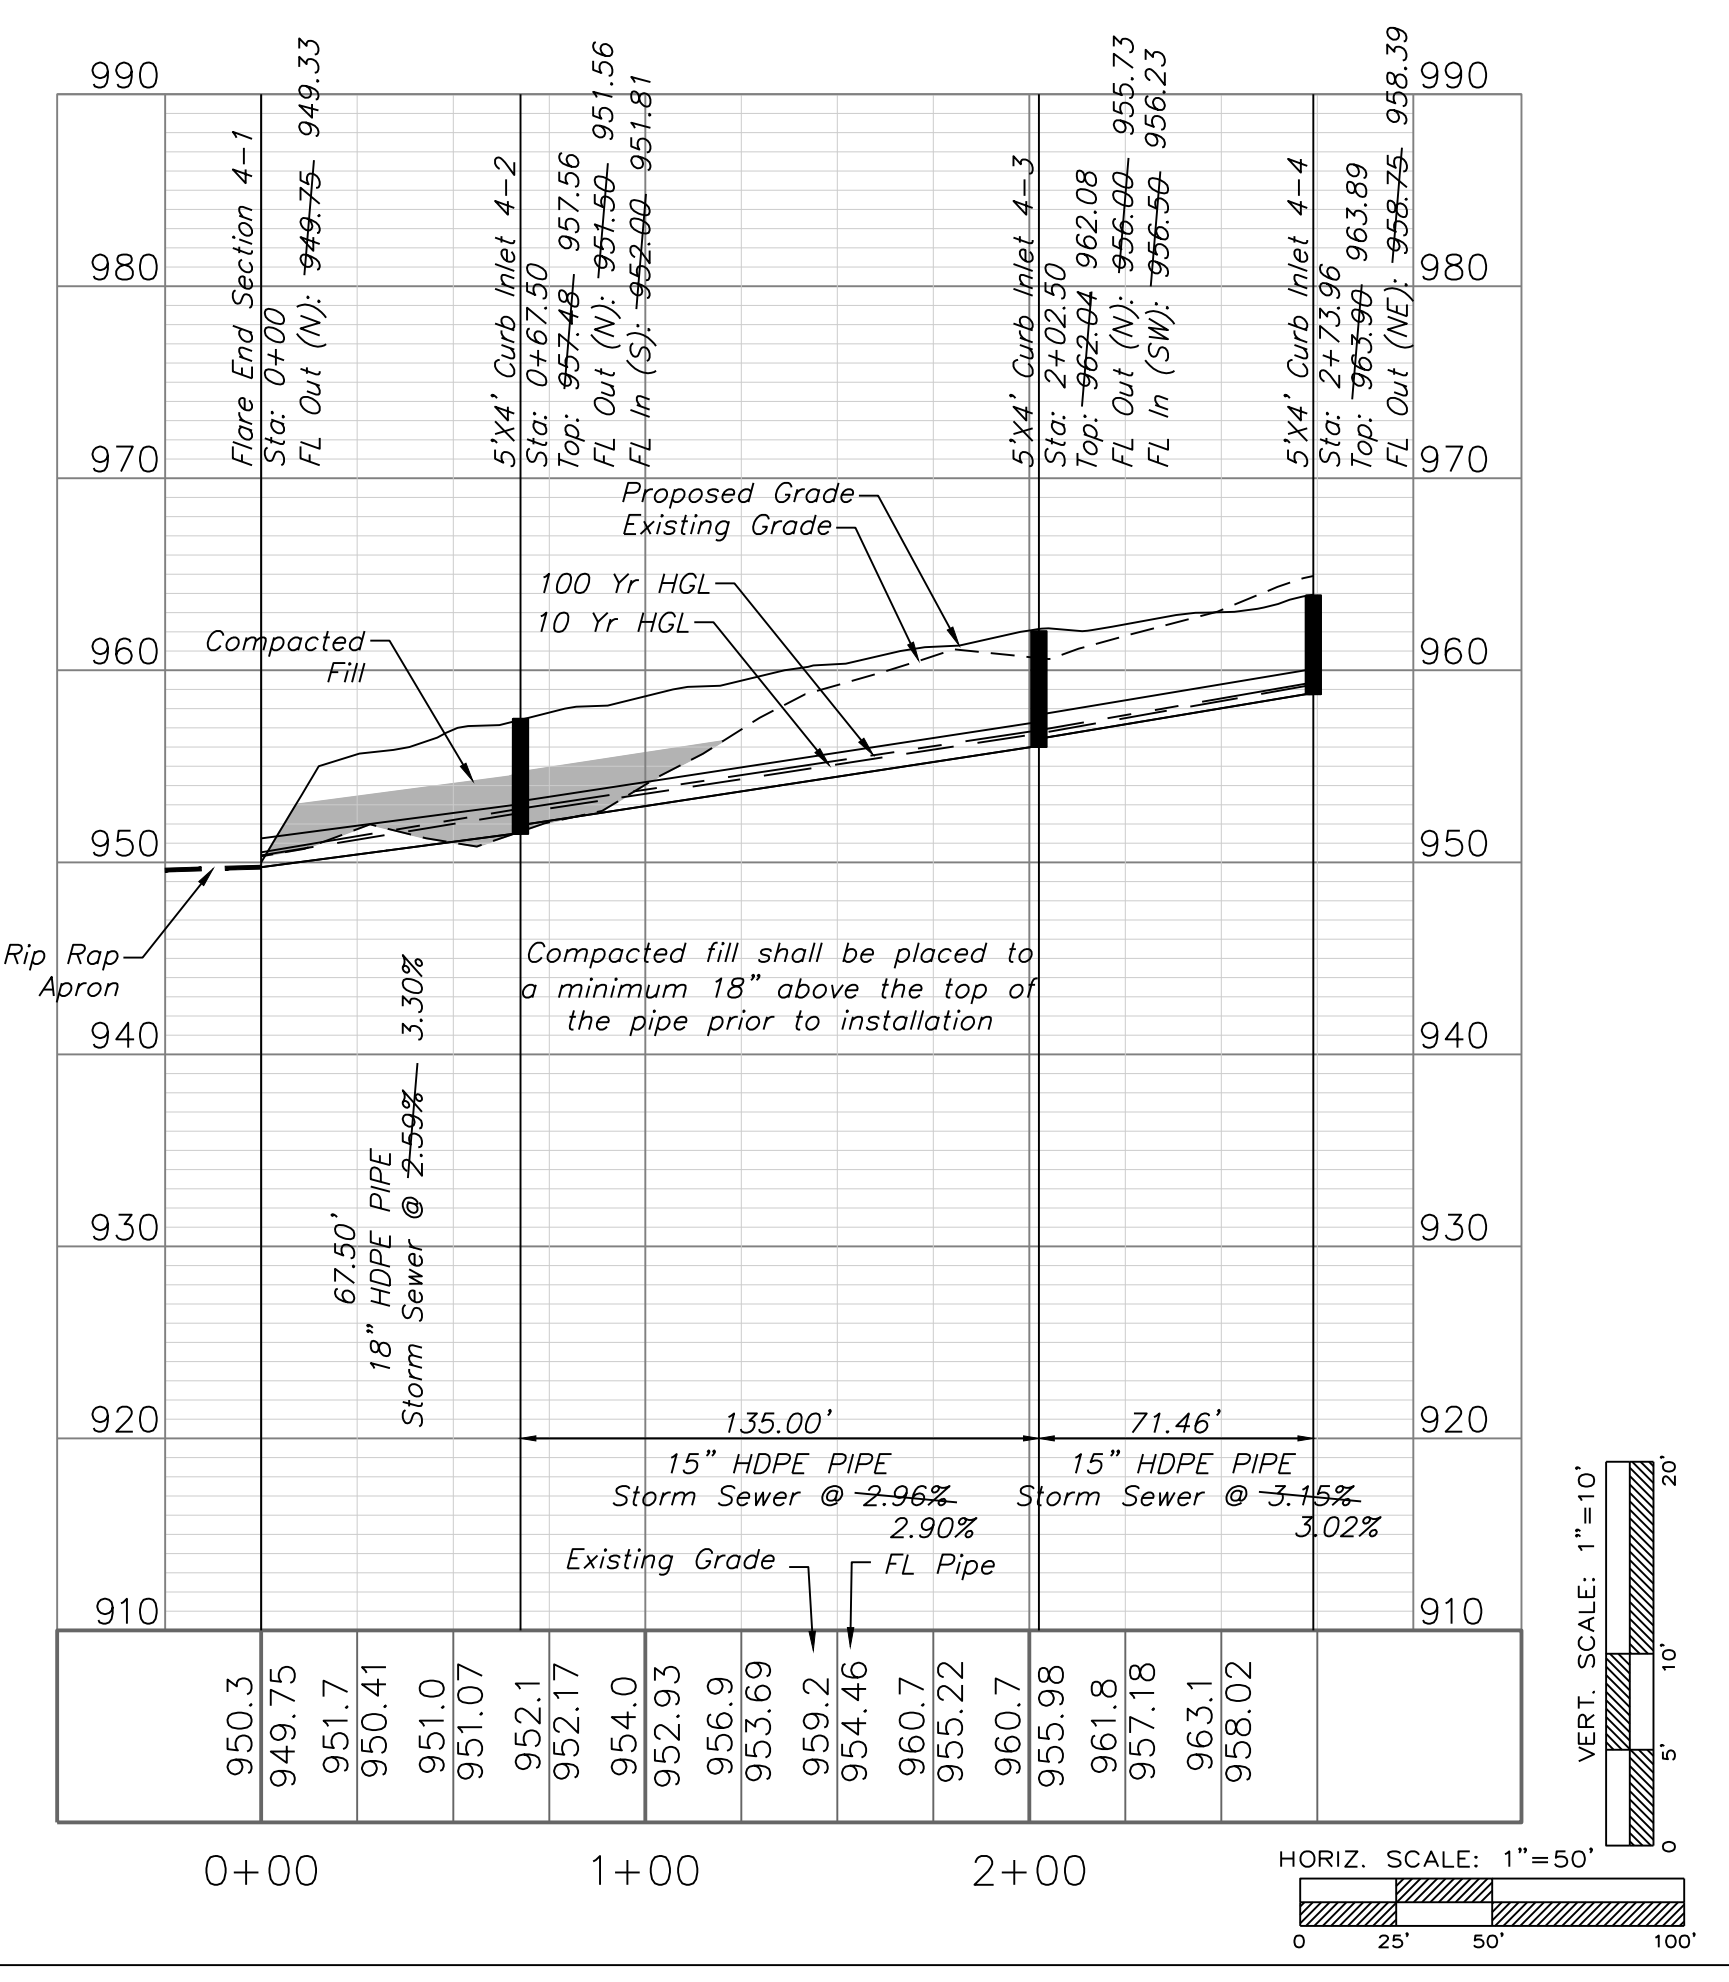

STORM LINE 5

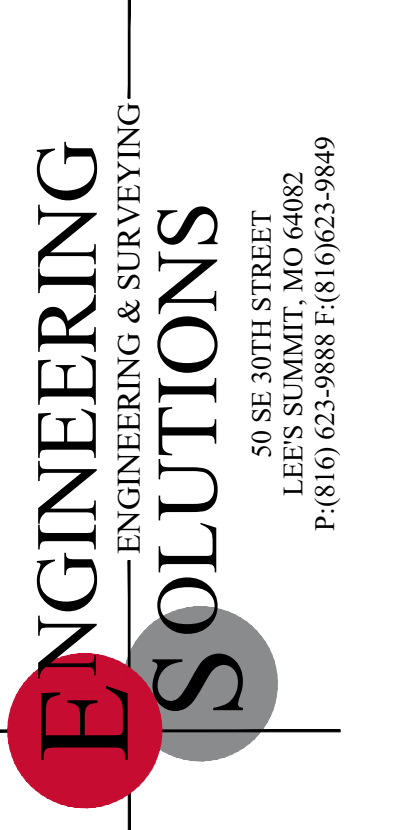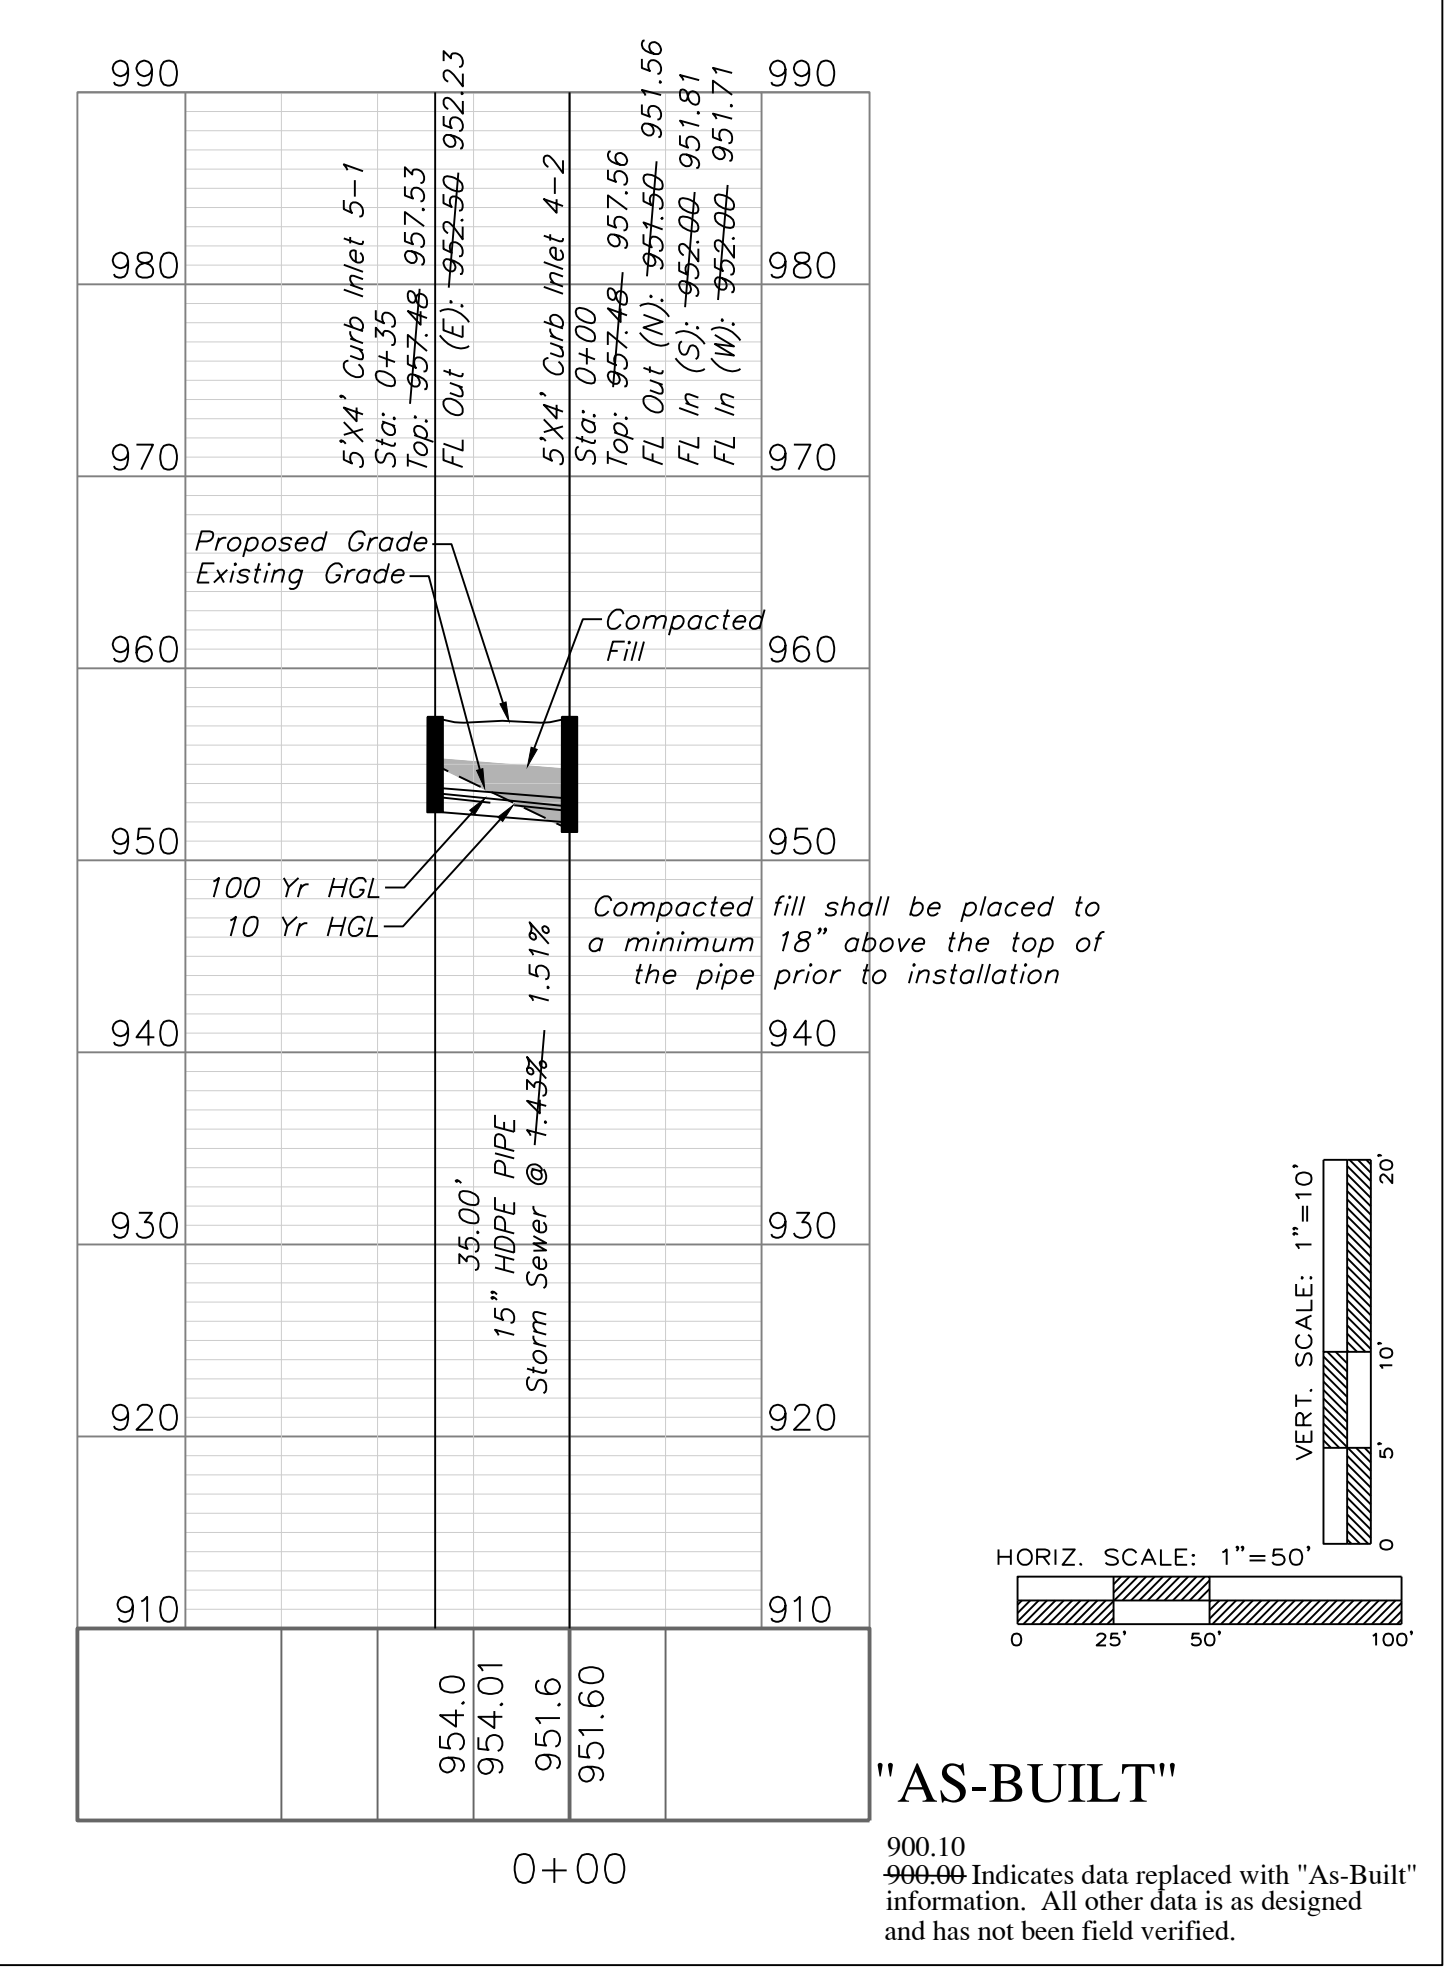


ENGINEERING SOLUTIONS
ENGINEERING & SURVEYING
50 SE 30TH STREET
LEES SUMMIT, MO 64082
P: (816) 623-9888 F: (816) 623-9849

Professional Registration
Missouri
Engineering 2005002186-D
Surveying 200500319-D
Kansas
Engineering E-1695
Surveying LS-218
Oklahoma
Engineering 6254
Nebraska
Engineering CA2821


Project:
VILLAGES OF CHAPEL
RIDGE LS/MO
Issue Date:
April 10, 2020

Storm Sewer Plan and Profile
Construction Plans for:
THE TOWNHOMES OF CHAPEL RIDGE-2ND PLAT
LOTS 9-19 & TRACTS A-D
Lee's Summit, Jackson County, Missouri

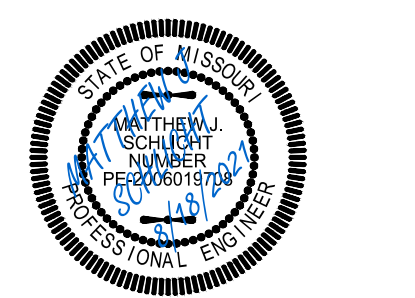


Matthew J. Schlicht
MO PE 2006019708
KS PE 19071
OK PE 25228
NE PE E-114335

REVISIONS
6/25/2021 As-Built
8/18/2021 As-Built


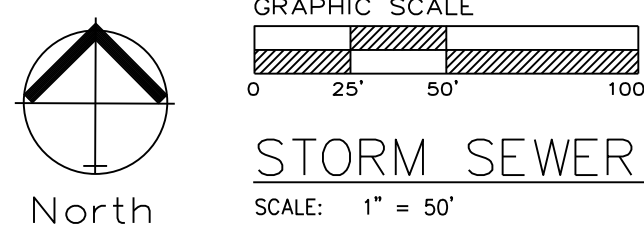


STORM SEWER PLAN & PROFILE


SCALE: 1" = 50'

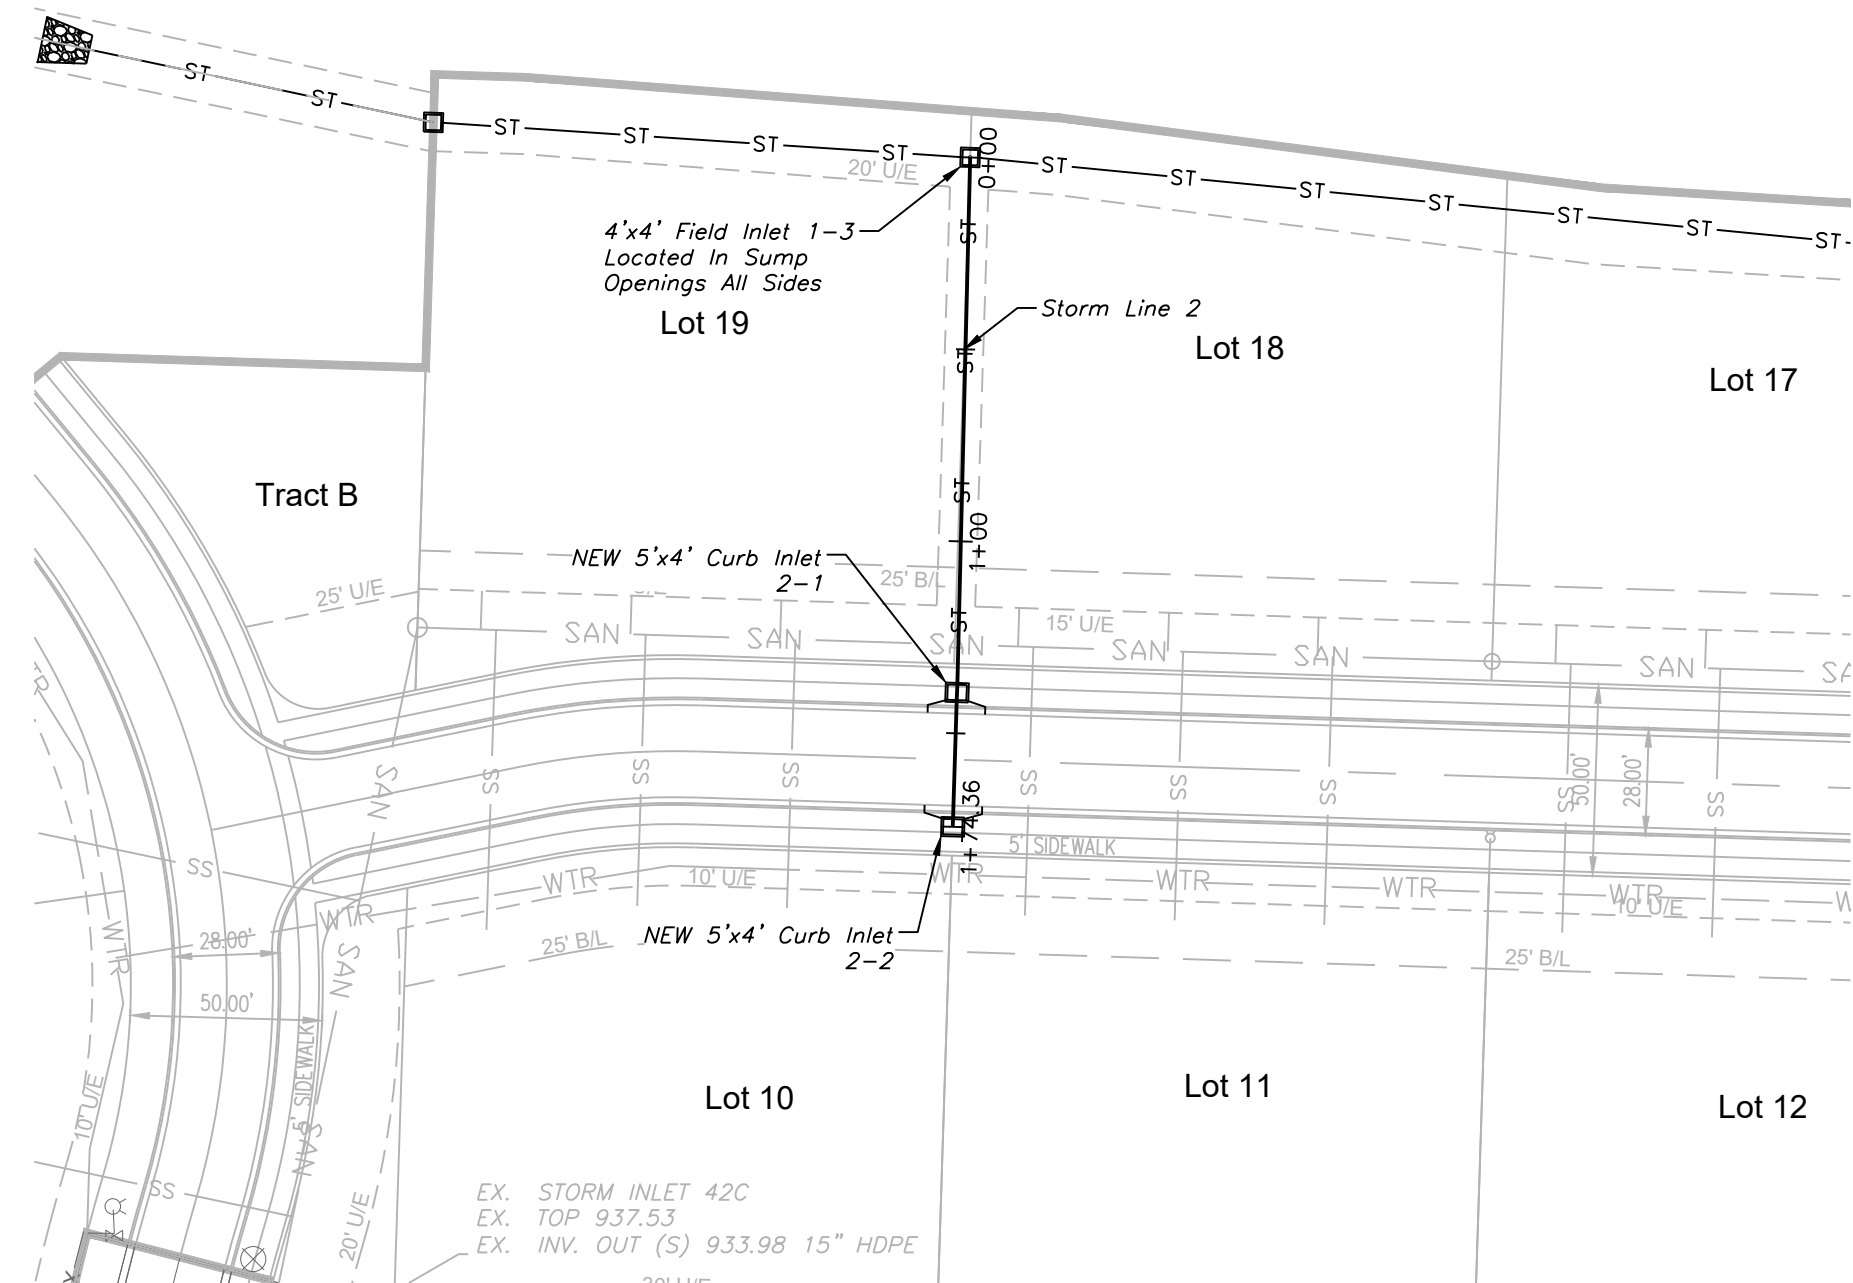

STORM LINE 2

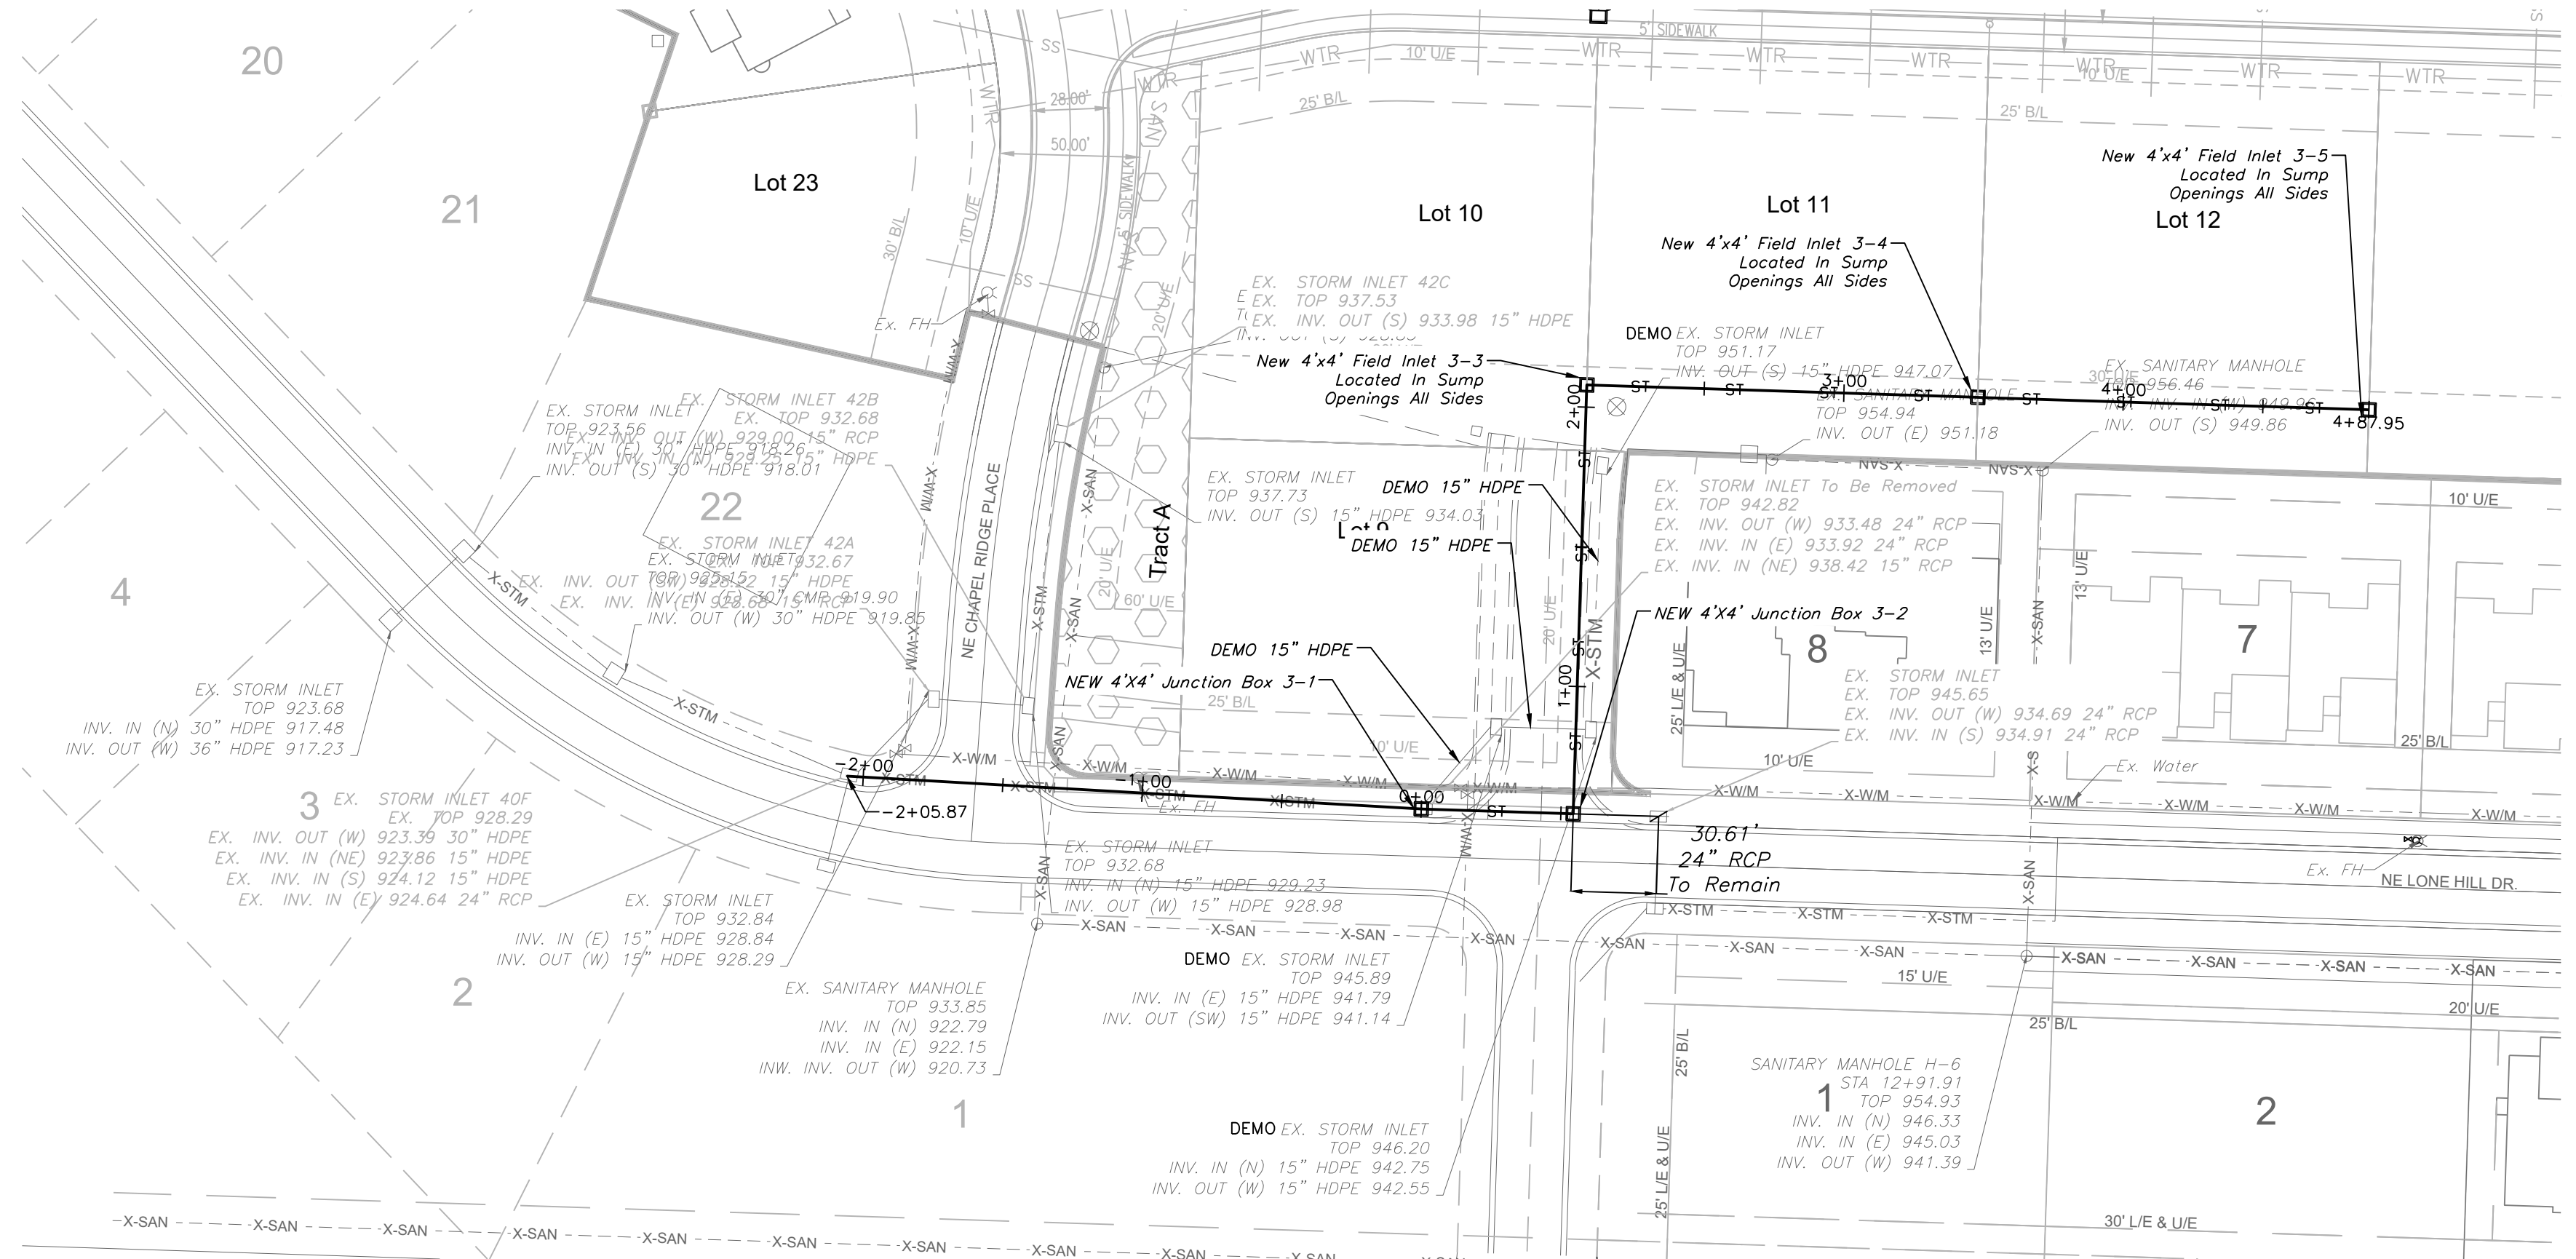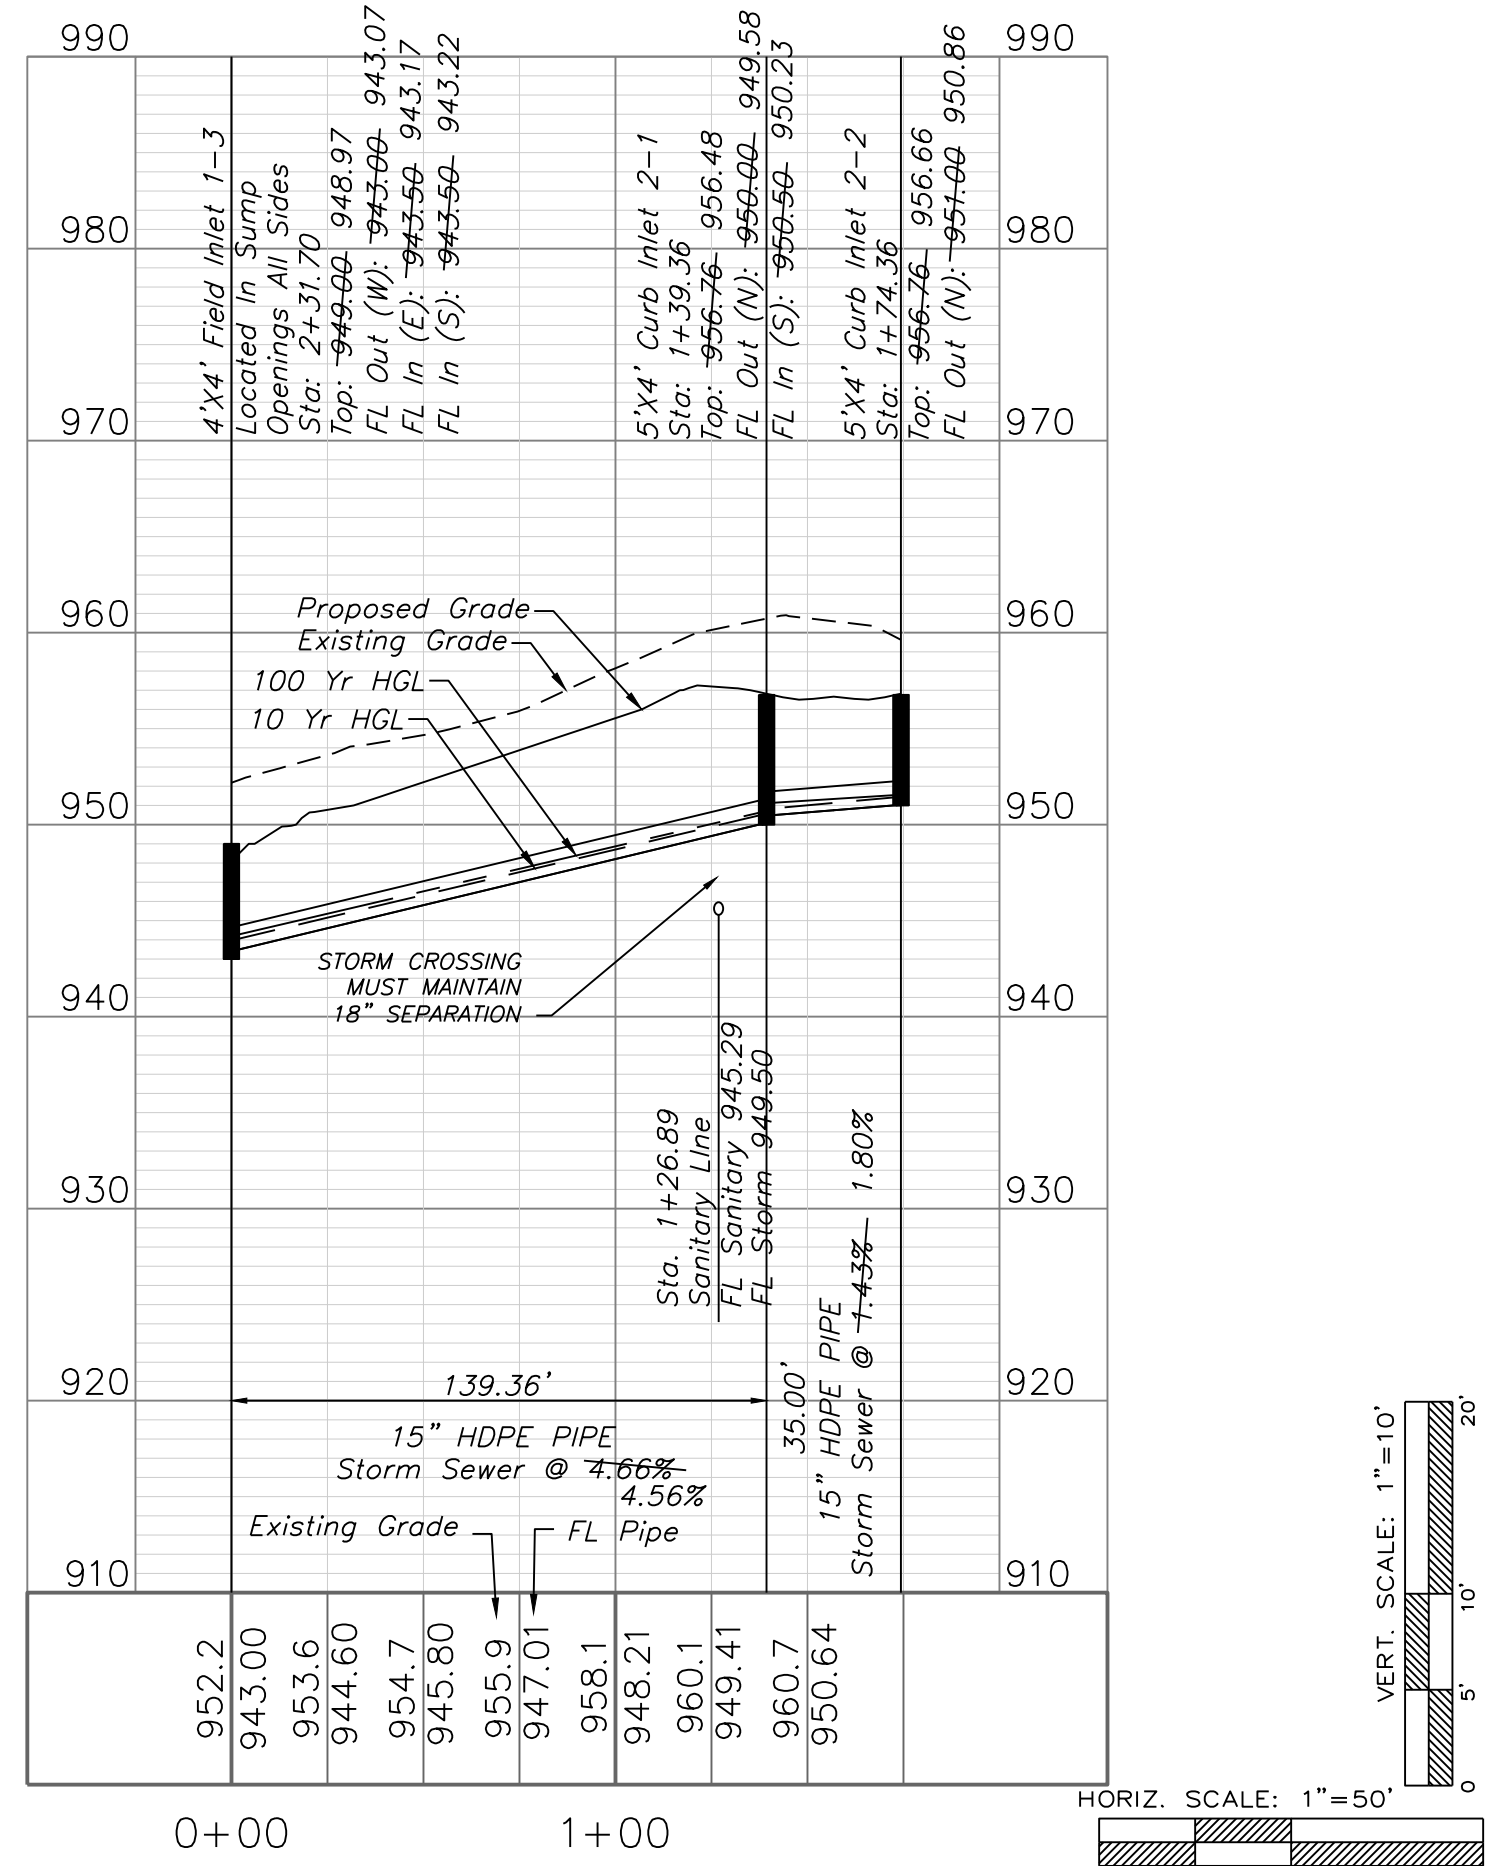

STORM LINE 3

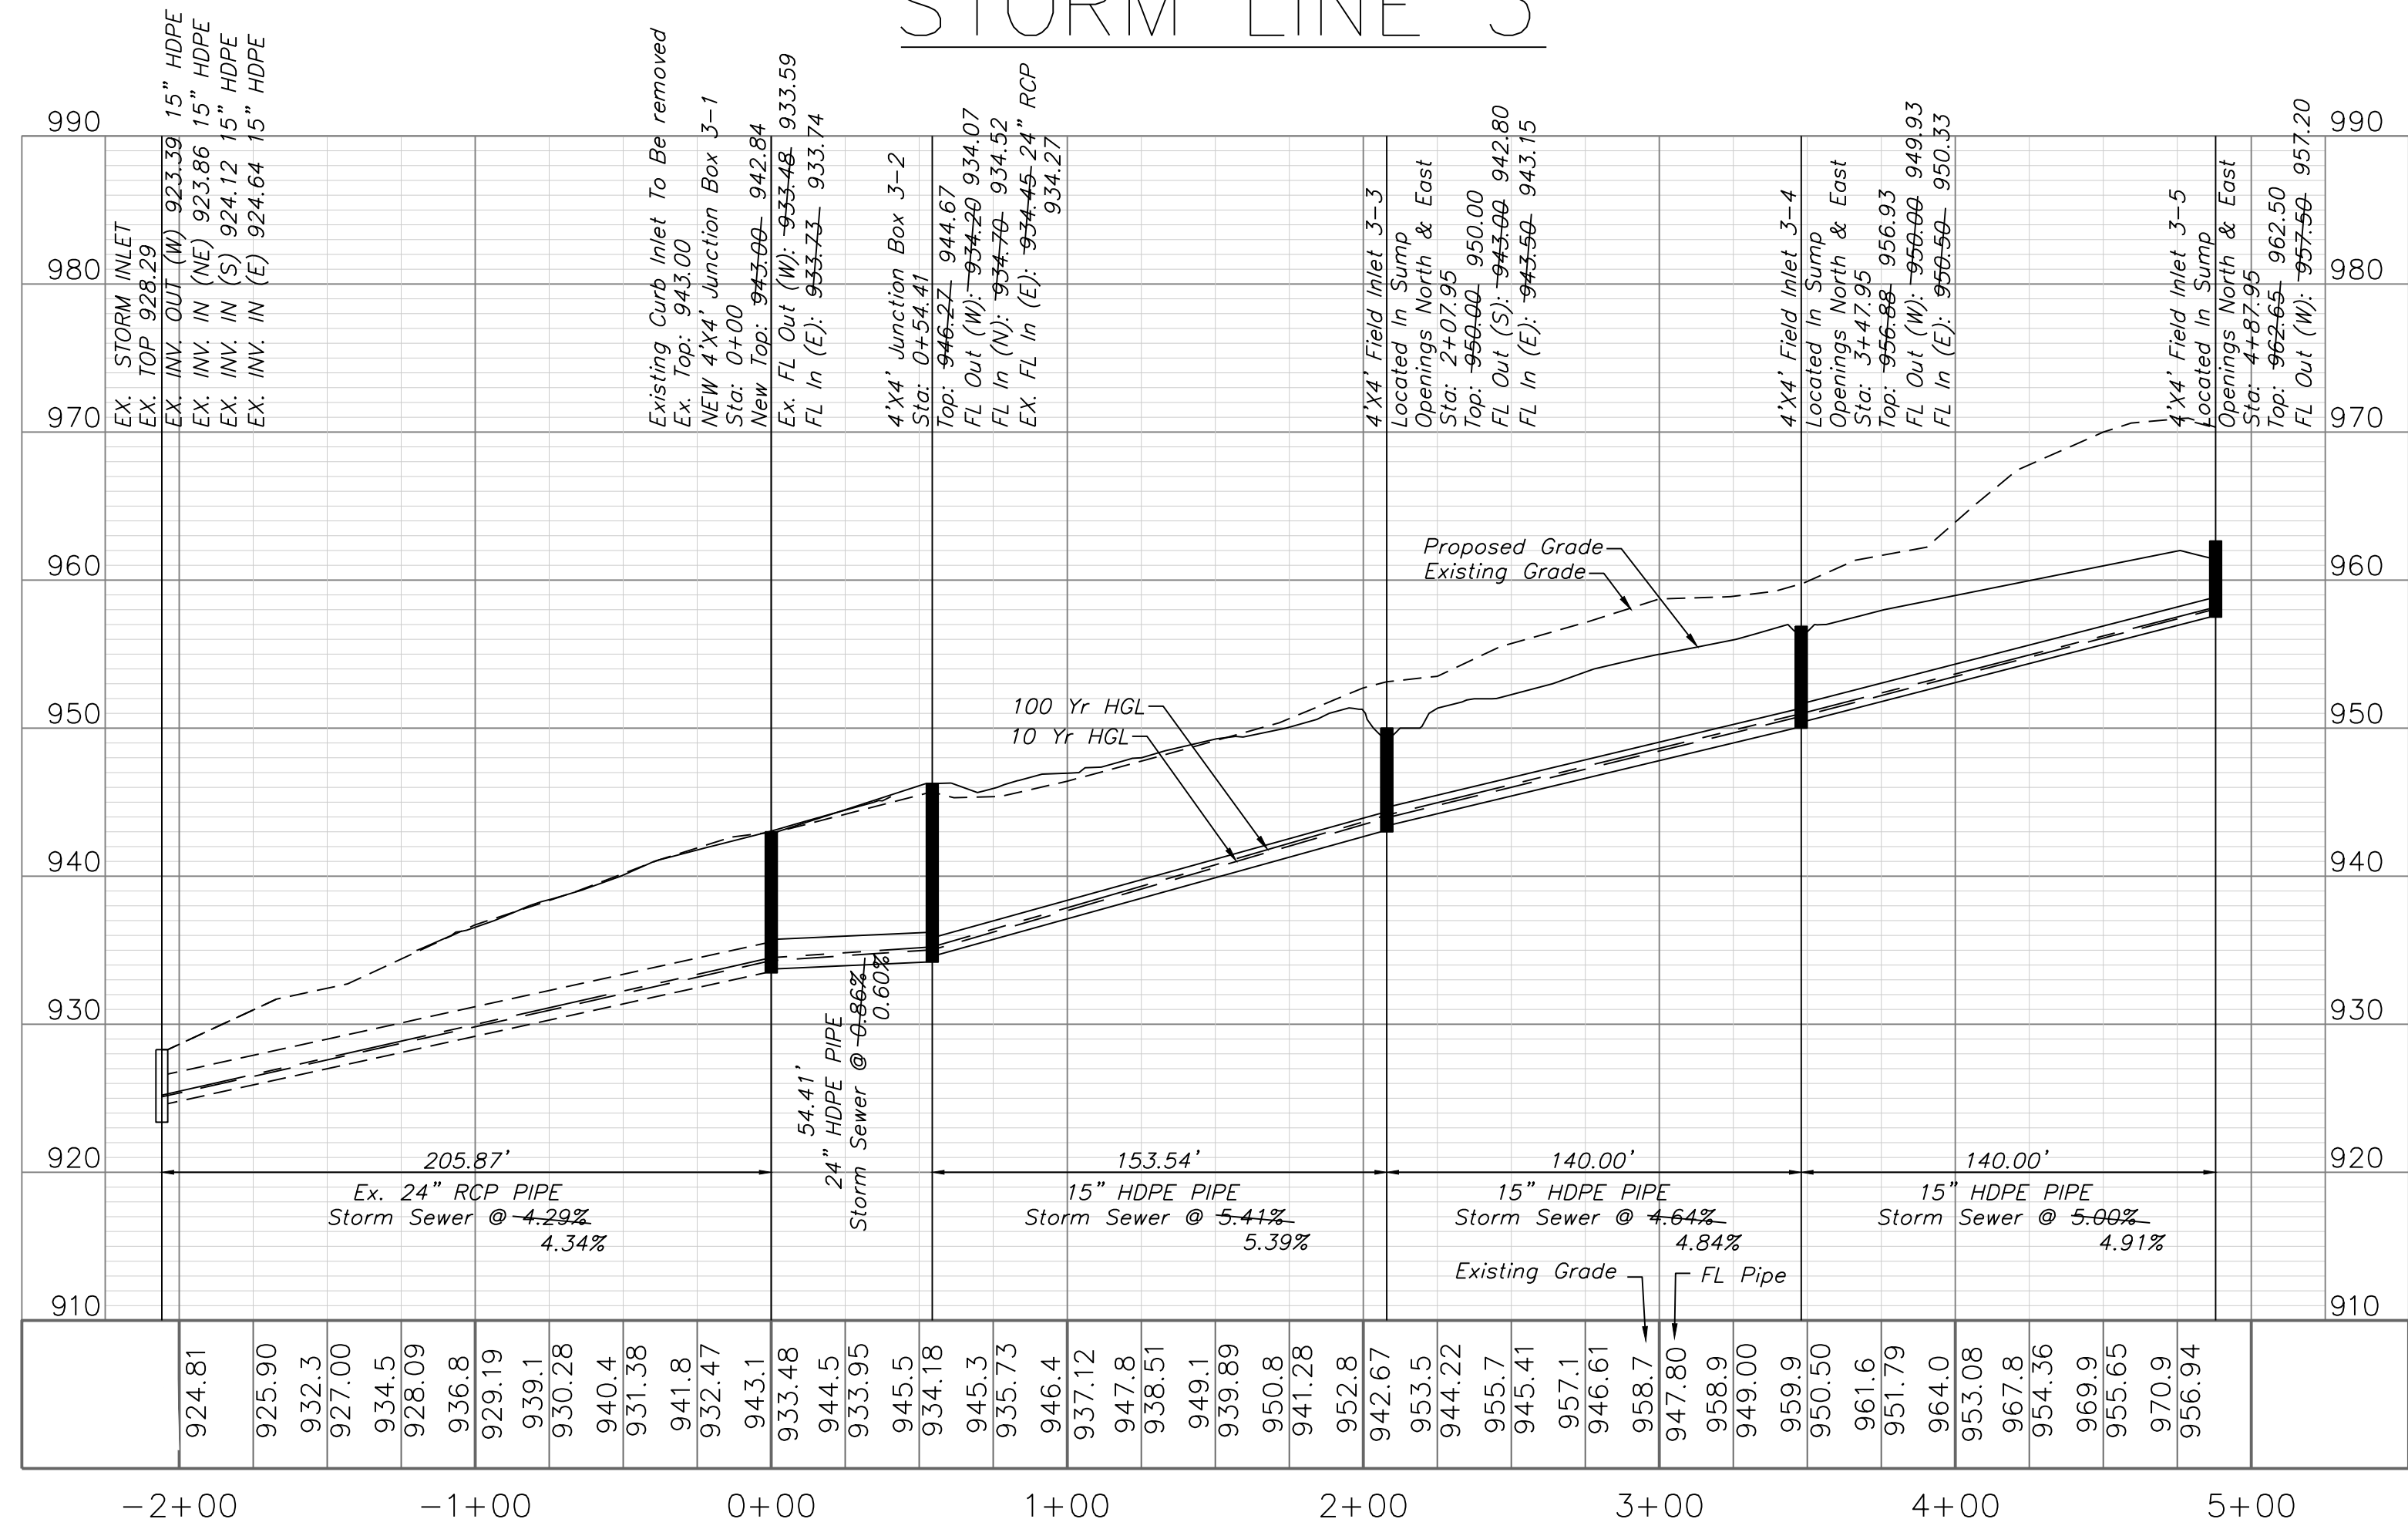

"AS-BUILT"
900.10
900.00 Indicates data replaced with "As-Built" information. All other data is as designed and has not been field verified.

ENGINEERING SOLUTIONS
ENGINEERING & SURVEYING
50 SE 30TH STREET
LEES SUMMIT, MO 64082
P: (816) 623-9888 F: (816) 623-9849

Professional Registration
Missouri
Engineering 2005002186-D
Surveying 200500319-D
Kansas
Engineering E-1695
Surveying LS-218
Oklahoma
Engineering 6254
Nebraska
Engineering CA2821

Project: THE TOWNHOMES OF CHAPEL RIDGE-2ND PLAT LOTS 9-19 & TRACTS A-D
Lee's Summit, Jackson County, Missouri

Issue Date: April 10, 2020



Storm Sewer Plan and Profile
Construction Plans for:
THE TOWNHOMES OF CHAPEL RIDGE-2ND PLAT LOTS 9-19 & TRACTS A-D
Lee's Summit, Jackson County, Missouri

STATE OF MISSOURI
MATTHEW J. SCHLICHT
REGISTERED PROFESSIONAL ENGINEER
No. 000000000


Matthew J. Schlicht
MO PE 2006019708
KS PE 19071
OK PE 25226
NE PE E-14335

REVISIONS
6/25/2021 As-Built
8/18/2021 As-Built



C.302

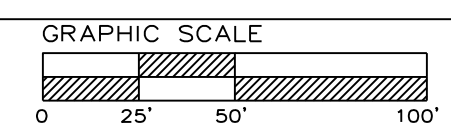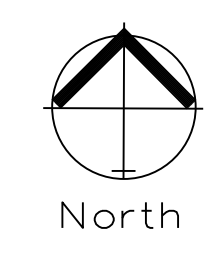


STORM SEWER PLAN & PROFILE
SCALE: 1" = 50'

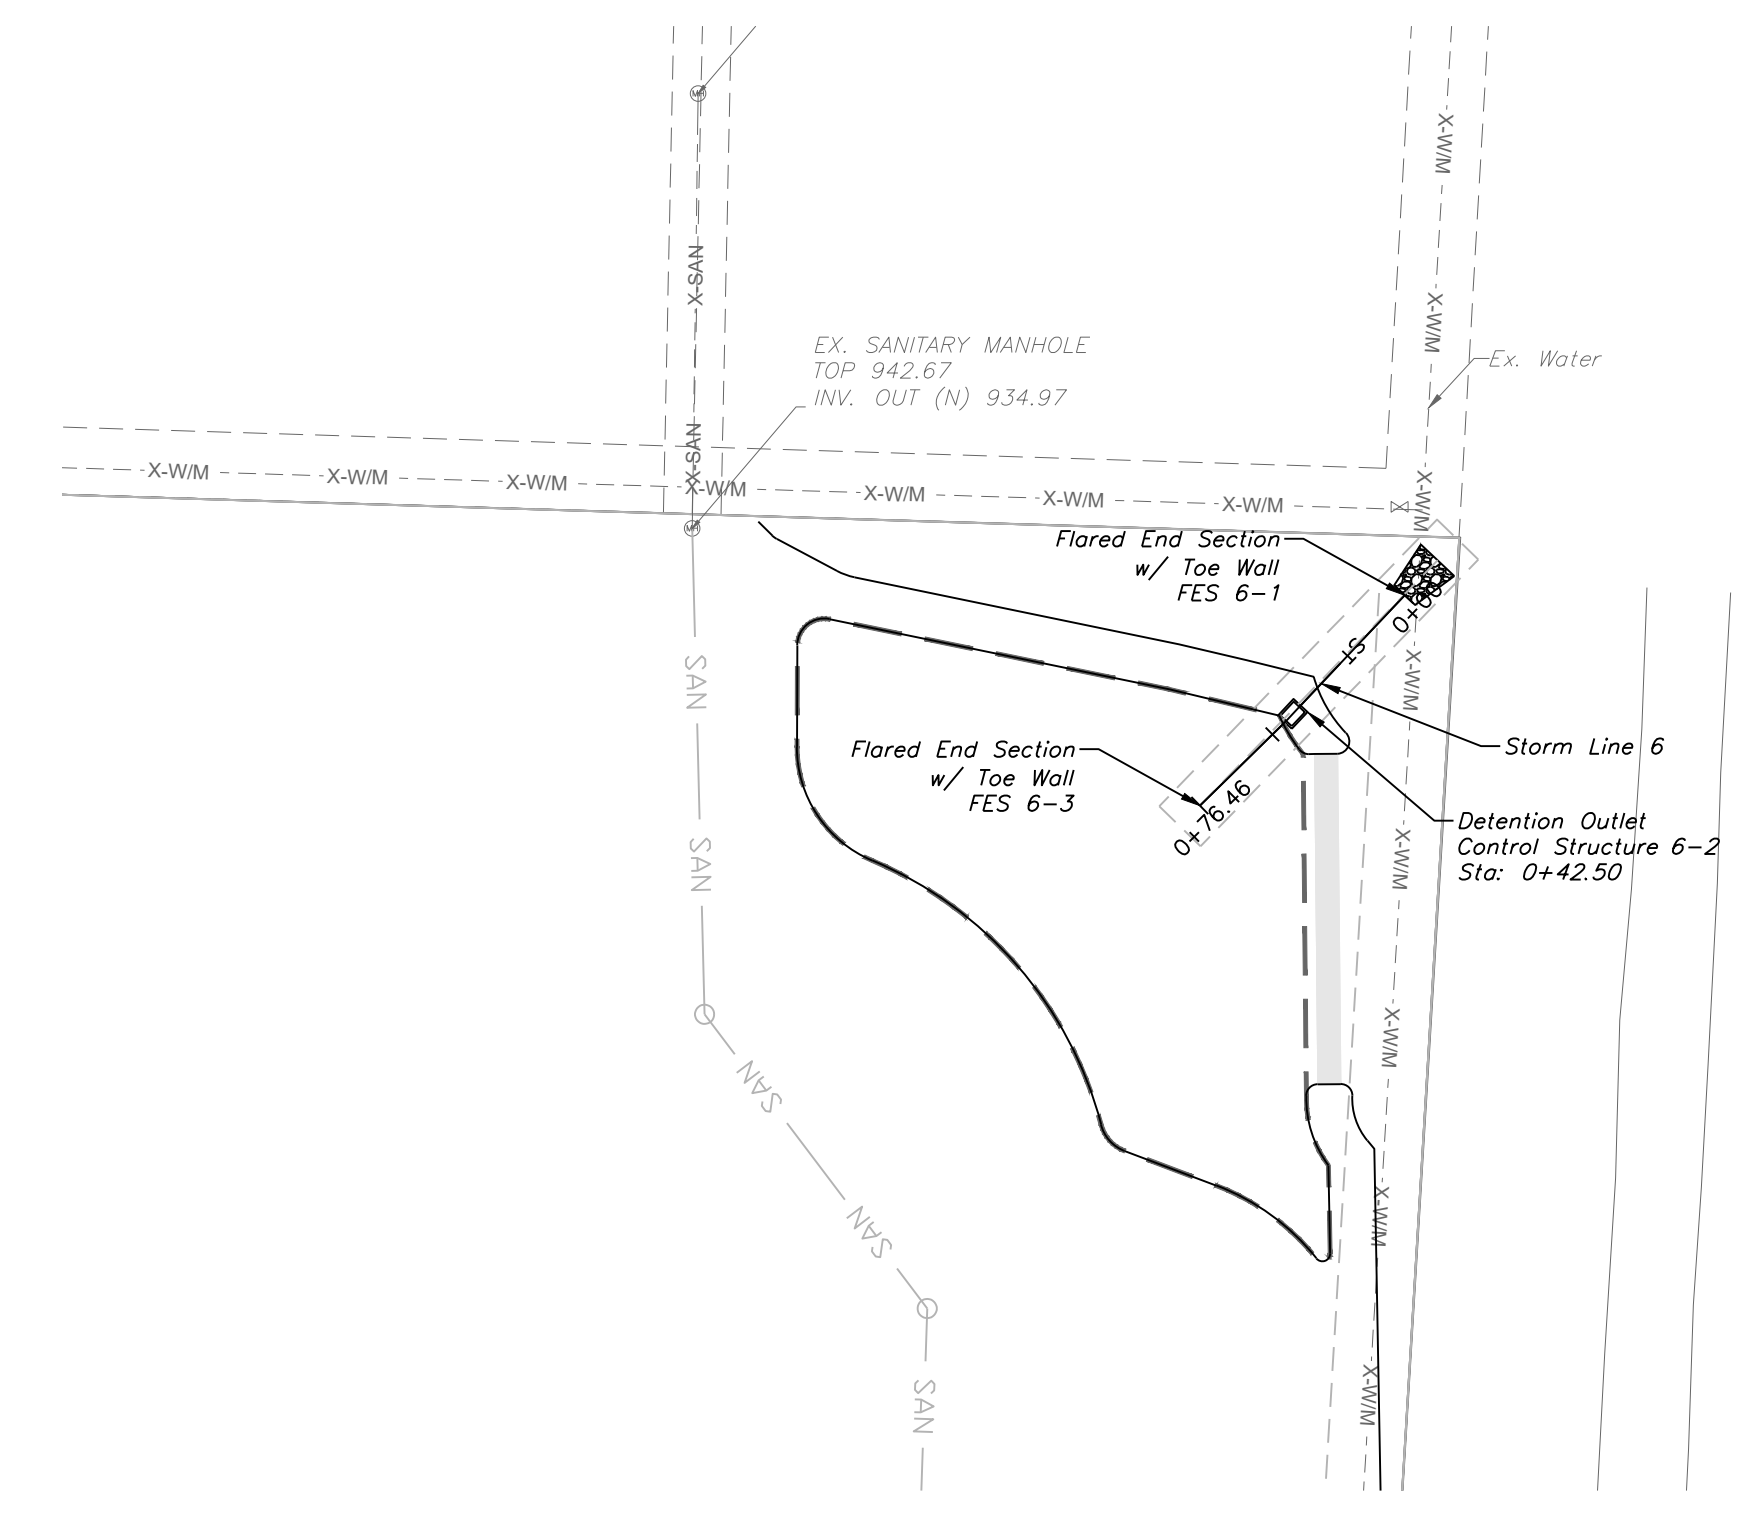

STORM LINE 6

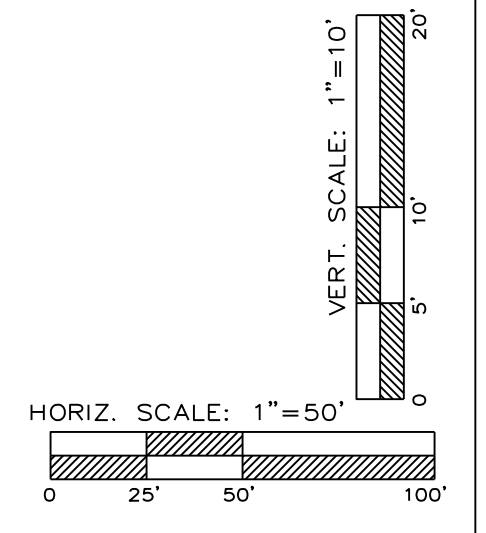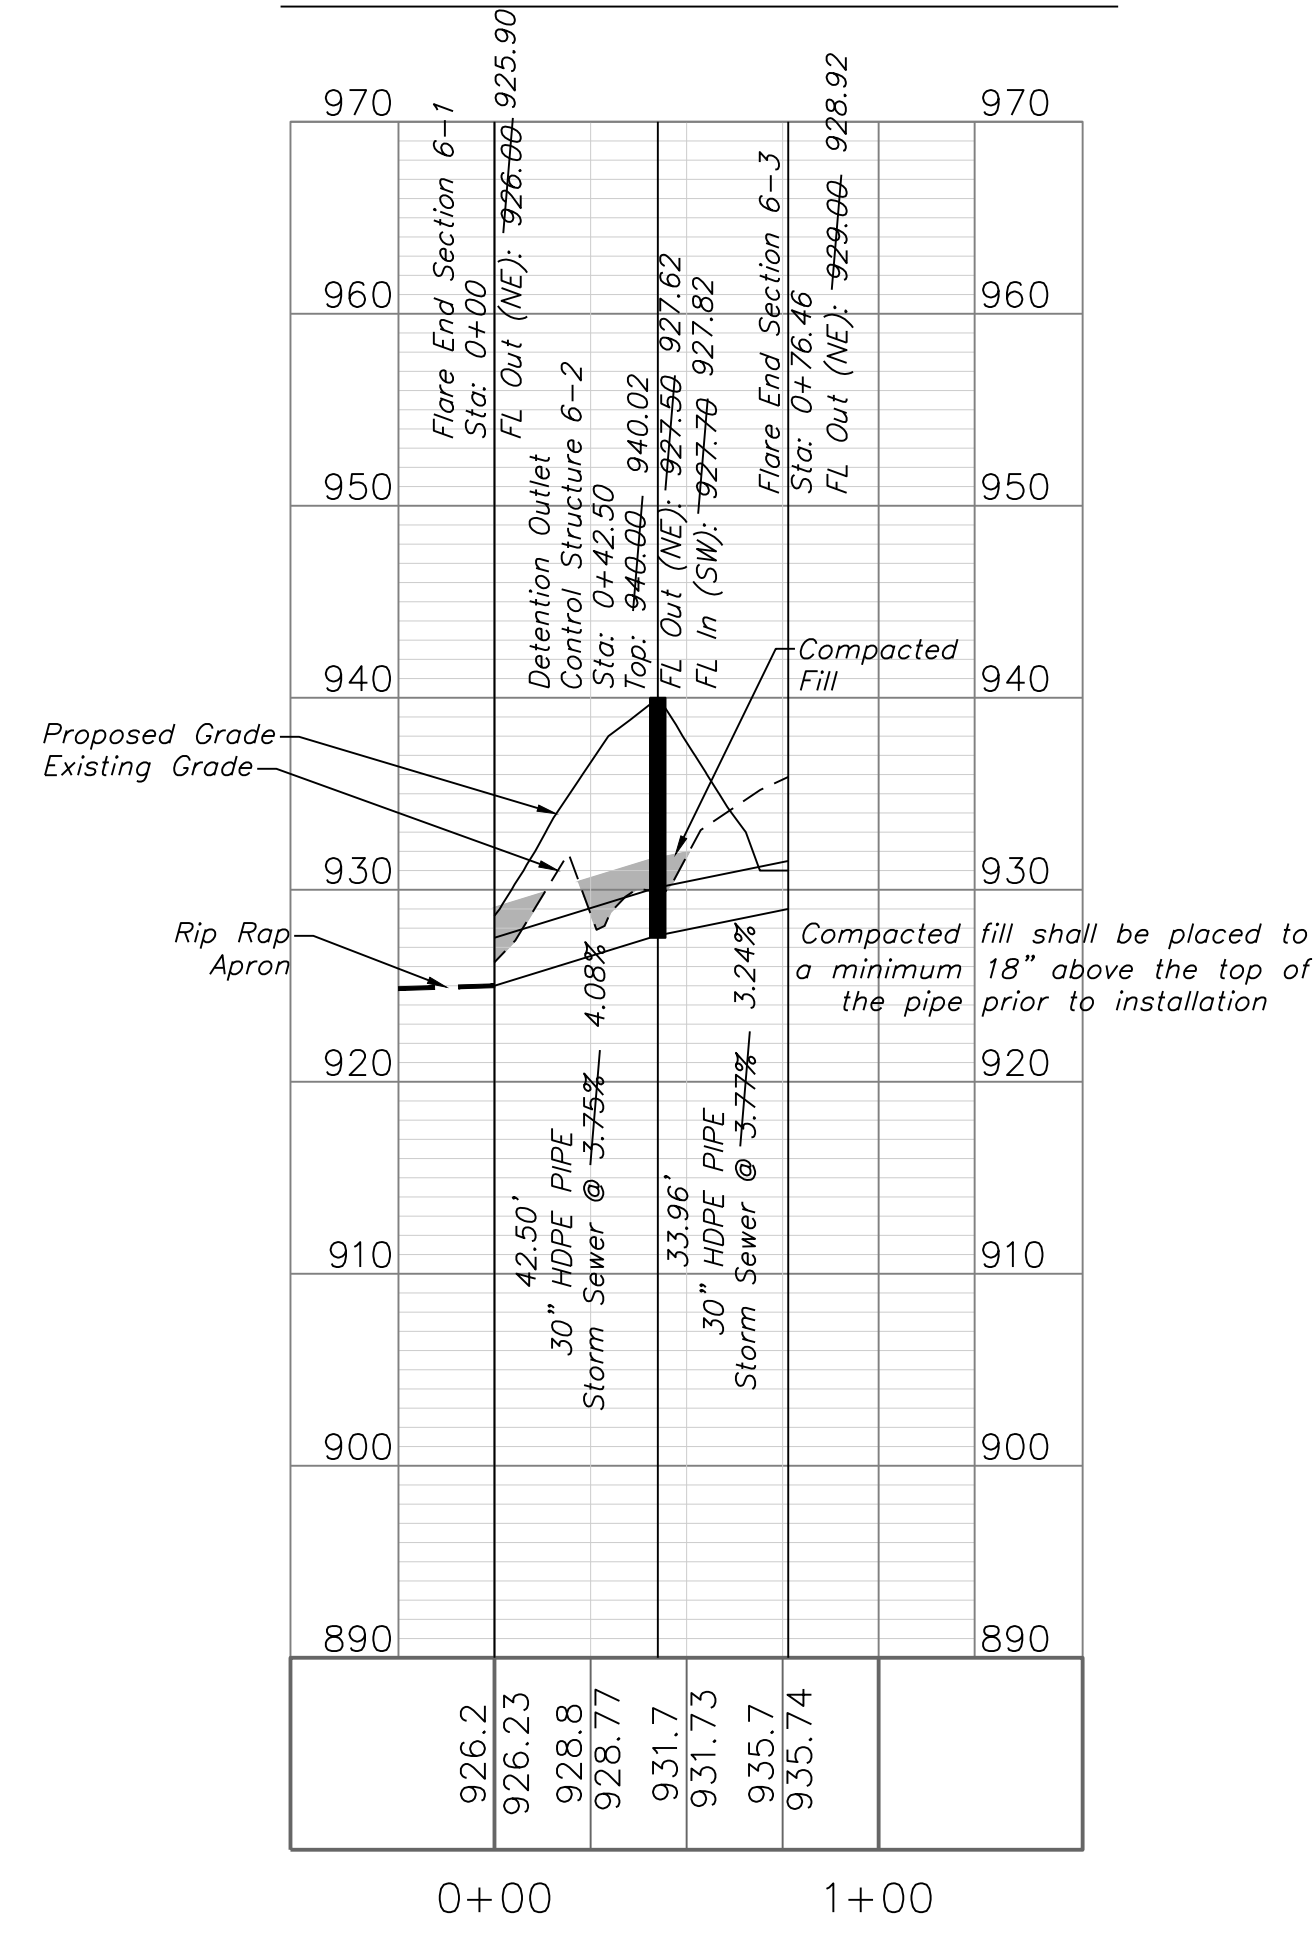

"AS-BUILT"
900.10
900.00 Indicates data replaced with "As-Built" information. All other data is as designed and has not been field verified.

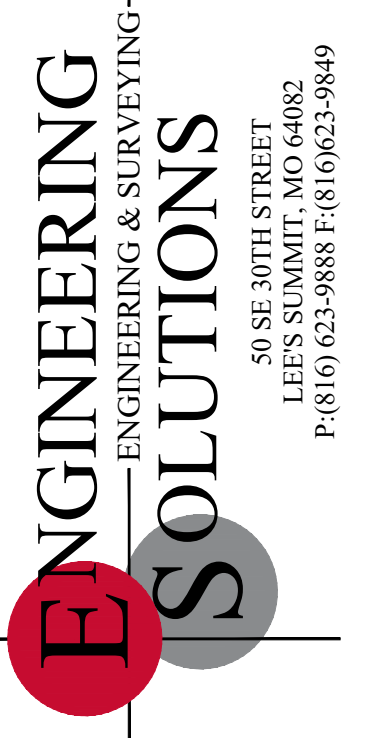


Professional Registration
Missouri
Engineering 2005002186-D
Surveying 2005008319-D
Kansas
Engineering E-1695
Surveying LS-218
Oklahoma
Engineering 6254
Nebraska
Engineering CA2821

Project:
VILLAGES OF CHAPEL RIDGE LSMO
Issue Date:
April 10, 2020

THE TOWNHOMES OF CHAPEL RIDGE-2ND PLAT
LOTS 9-19 & TRACTS A-D
Lee's Summit, Jackson County, Missouri

Storm Sewer Plan and Profile
Construction Plans for:
THE TOWNHOMES OF CHAPEL RIDGE-2ND PLAT
LOTS 9-19 & TRACTS A-D
Lee's Summit, Jackson County, Missouri

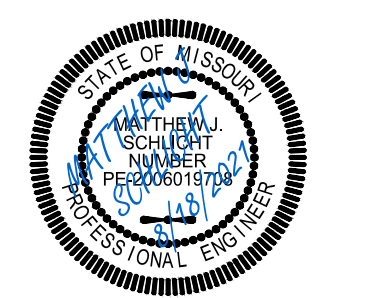

Matthew J. Schlicht
MO PE 2006019708
KS PE 19071
OK PE 25226
NE PE E-114335


REVISIONS
6/25/2021 As-Built
8/18/2021 As-Built

10 YEAR INLET																						
D.S. Str.	Str.	Area (ac)	InletTime (min)	Int. (in/hr)	RunoffCoeff. (C)	Q=CIA (cfs)	Q Carry-over (cfs)	Q Captured (cfs)	Q Bypassed (cfs)	JunctType	CurbHeight (in)	CurbLength (ft)	GutterSlope (ft/ft)	GutterWidth (ft)	CrossSlope, Sw (ft/ft)	CrossSlope, Sx (ft/ft)	InletDepth (ft)	BypassDepth (ft)	BypassSpread (ft)	GutterDepth (ft)	GutterSpread (ft)	Bypass Str.
1-1	1-2	0.21	5.20	7.21	0.66	1.00	0	1	0	Dp-Curb	6	16	Sag	0.02	0.02	0.08	n/a	n/a	0.08	3.78	Sag
1-2	1-3	0.87	6.20	6.94	0.66	3.99	0	3.99	0	Dp-Curb	6	16	Sag	0.02	0.02	0.19	n/a	n/a	0.19	9.51	Sag
1-3	1-4	0.12	5.30	7.18	0.66	0.57	0	0.57	0	Dp-Curb	6	16	Sag	0.02	0.02	0.05	n/a	n/a	0.05	2.6	Sag
1-3	2-1	0.17	6.00	7.00	0.66	0.78	0	0.3	0.49	Curb	10	5	0.078	2	0.05	0.02	0.11	0.1	1.9	0.11	2.66	EX 42A
2-1	2-2	0.28	6.00	7.00	0.66	1.29	0	0.39	0.9	Curb	10	5	0.078	2	0.05	0.02	0.13	0.12	2.94	0.13	3.74	EX 42C
EX 40F	3-1	0	0.00	0.00	0.00	0.00	JB
3-1	3-2	0	0.00	0.00	0.00	0.00	JB
3-2	3-3	0.36	5.30	7.18	0.66	1.71	0	1.71	0	Dp-Curb	6	16	Sag	0.02	0.02	0.11	n/a	n/a	0.11	5.4	Sag
3-3	3-4	0.45	5.50	7.13	0.66	2.12	0	2.12	0	Dp-Curb	6	16	Sag	0.02	0.02	0.12	n/a	n/a	0.12	6.24	Sag
3-4	3-5	0.4	5.50	7.13	0.66	1.88	0	1.88	0	Dp-Curb	6	16	Sag	0.02	0.02	0.12	n/a	n/a	0.12	5.76	Sag
EX 40F	EX 42A	0.15	6.00	7.00	0.66	0.69	5.79	1.15	5.33	Curb	10	5	0.03	2	0.05	0.02	0.26	0.25	9.35	0.26	10.13	EX 40F
EX 42A	EX 42B	0.43	5.80	7.05	0.66	2.00	0	0.63	1.37	Curb	10	5	0.03	2	0.05	0.02	0.18	0.16	5.04	0.18	6.07	EX 40F
EX 42B	EX 42C	0.84	6.10	6.97	0.66	3.86	0.9	0.84	3.93	Curb	10	5	0.059	2	0.05	0.02	0.21	0.2	7.08	0.21	7.71	EX 40F
4-1	4-2	0.15	5.50	7.13	0.66	0.71	1.07	0.57	1.21	Curb	10	5	0.036	2	0.05	0.02	0.17	0.15	4.5	0.17	5.49	Offsite
4-2	4-3	0.36	6.40	6.89	0.66	1.64	0	0.56	1.07	Curb	10	5	0.03	2	0.05	0.02	0.17	0.15	4.43	0.17	5.51	4-2
4-3	4-4	0.33	5.20	7.21	0.66	1.57	0	0.55	1.02	Curb	10	5	0.03	2	0.05	0.02	0.17	0.15	4.3	0.17	5.4	5-1
4-2	5-1	0.87	5.80	7.05	0.66	4.05	1.02	0.97	4.09	Curb	10	5	0.036	2	0.05	0.02	0.24	0.22	8.04	0.24	8.81	Offsite

10 YEAR PIPE																						
D.S. Str.	U.S. Str.	LineLength (ft)	Incr.Area (ac)	TotalArea (ac)	RunoffCoeff. (C)	IncrCx A	TotalCx A	InletTime (min)	TimeConc (min)	Rnfallnt (in/hr)	TotalRunoff (cfs)	TotalFlow (cfs)	CapacFull (cfs)	Veloc (ft/s)	PipeSize (in)	PipeSlope (%)	Inv ElevDn (ft)	Inv ElevUp (ft)	HGLDn (ft)	HGLUp (ft)	Grnd/RimDn (ft)	Grnd/RimUp (ft)
1-1	1-2	91.62	0.21	1.65	0.66	0.14	1.09	5.2	8	6.5	7.10	7.10	24.70	8.78	18	3.27	936.00	939.00	936.55	940.03	937.50	945.00
1-2	1-3	140.08	0.87	1.44	0.66	0.57	0.95	6.2	7.7	6.6	6.26	6.26	21.58	7.89	18	2.50	939.50	943.00	940.05	943.97	945.00	949.00
1-3	1-4	280.60	0.12	0.12	0.66	0.08	0.08	5.3	5.3	7.2	0.57	0.57	16.24	1.97	15	3.74	943.50	954.00	943.97	954.29	949.00	959.00
1-3	2-1	139.36	0.17	0.45	0.66	0.11	0.3	6	6.1	7	2.07	2.07	18.13	4.36	15	4.66	943.50	950.00	943.97	950.57	949.00	956.76
2-1	2-2	35.00	0.28	0.28	0.66	0.18	0.18	6	6	7	1.29	1.29	10.03	4.44	15	1.43	950.50	951.00	950.80	951.45	956.76	956.76
EX 40F	3-1	205.87	0.00	1.21	0	0	0.8	0	6.6	6.8	5.46	5.46	46.87	7.22	24	4.29	924.64	933.48	925.10	934.30	928.29	943.00
3-1	3-2	54.41	0.00	1.21	0	0	0.8	0	6.5	6.9	5.49	5.49	27.33	5.64	24	0.86	933.73	934.20	934.34	935.03	943.00	946.27
3-2	3-3	153.54	0.36	1.21	0.66	0.24	0.8	5.3	6.2	6.9	5.54	5.54	19.52	9.60	15	5.41	934.70	943.00	935.16	943.95	946.27	950.00
3-3	3-4	140.00	0.45	0.85	0.66	0.3	0.56	5.5	5.9	7	3.94	3.94	18.09	7.28	15	4.64	943.50	950.00	943.95	950.80	950.00	956.88
3-4	3-5	140.00	0.40	0.4	0.66	0.26	0.26	5.5	5.5	7.1	1.88	1.88	18.77	5.94	15	5.00	950.50	957.50	950.80	958.05	956.88	962.65
EX 40F	EX 42A	43.25	0.15	1.42	0.66	0.1	0.94	6	6.5	6.9	6.43	6.43	26.65	11.93	15	10.08	923.86	928.22	924.28	929.24	928.29	932.67
EX 42A	EX 42B	33.90	0.43	1.27	0.66	0.28	0.84	5.8	6.4	6.9	5.77	5.77	6.27	5.72	15	0.94	928.68	929.00	929.62	929.97	932.67	932.68
EX 42B	EX 42C	97.97	0.84	0.84	0.66	0.55	0.55	6.1	6.1	7	3.86	3.86	18.45	4.98	15	4.83	929.25	933.98	929.97	934.77	932.68	937.53
4-1	4-2	67.50	0.15	1.71	0.66	0.1	1.13	5.5	6.8	6.8	7.65	7.65	21.98	8.49	18	2.59	949.75	951.50	950.36	952.57	951.25	957.48
4-2	4-3	135.00	0.36	0.69	0.66	0.24	0.46	6.4	6.4	6.9	3.14	3.14	14.45	5.05	15	2.96	952.00	956.00	952.57	956.71	957.48	962.04
4-3	4-4	71.46	0.33	0.33	0.66	0.22	0.22	5.2	5.2	7.2	1.57	1.57	14.90	5.67	15	3.15	956.50	958.75	956.77	959.25	962.04	963.90
4-2	5-1	35.00	0.87	0.87	0.66	0.57	0.57	5.8	5.8	7	4.05	4.05	10.03	6.10	15	1.43	952.00	952.50	952.57	953.31	957.48	957.48

10 YEAR INLET																						
D.S. Str.	Str.	Area (ac)	InletTime (min)	Int. (in/hr)	RunoffCoeff. (C)	Q=CIA (cfs)	Q Carry-over (cfs)	Q Captured (cfs)	Q Bypassed (cfs)	JunctType	CurbHeight (in)	CurbLength (ft)	GutterSlope (ft/ft)	GutterWidth (ft)	CrossSlope, Sw (ft/ft)	CrossSlope, Sx (ft/ft)	InletDepth (ft)	BypassDepth (ft)	BypassSpread (ft)	GutterDepth (ft)	GutterSpread (ft)	Bypass Str.
1-1	1-2	0.21	5.20	10.91	0.66	1.51	0	1.51	0	Dp-Curb	6	16	Sag	0.02	0.02	0.1	n/a	n/a	0.1	4.98	Sag
1-2	1-3	0.87	6.20	10.50	0.66	6.03	0	6.03	0	Dp-Curb	6	16	Sag	0.02	0.02	0.25	n/a	n/a	0.25	12.54	Sag
1-3	1-4	0.12	5.30	10.87	0.66	0.86	0	0.86	0	Dp-Curb	6	16	Sag	0.02	0.02	0.07	n/a	n/a	0.07	3.42	Sag
1-3	2-1	0.17	6.00	10.58	0.66	1.19	0	0.38	0.81	Curb	10	5	0.078	2	0.05	0.02	0.13	0.11	2.73	0.13	3.55	EX 42A
2-1	2-2	0.28	6.00	10.58	0.66	1.96	0	0.49	1.46	Curb	10	5	0.078	2	0.05	0.02	0.15	0.14	4.02	0.15	4.73	EX 42C
EX 40F	3-1	0.00	0.00	0.00	0.00	0.00	MH
3-1	3-2	0.00	0.00	0.00	0.00	0.00	MH
3-2	3-3	0.36	5.30	10.87	0.66	2.58	0	2.58	0	Dp-Curb	6	16	Sag	0.02	0.02	0.14	n/a	n/a	0.14	7.12	Sag
3-3	3-4	0.45	5.50	10.79	0.66	3.20	0	3.2	0	Dp-Curb	6	16	Sag	0.02	0.02	0.16	n/a	n/a	0.16	8.22	Sag
3-4	3-5	0.40	5.50	10.79	0.66	2.85	0	2.85	0	Dp-Curb	6	16	Sag	0.02	0.02	0.15	n/a	n/a	0.15	7.6	Sag
EX 40F	EX 42A	0.15	6.00	10.58	0.66	1.05	9.33	1.46	8.91	Curb	10	5	0.03	2	0.05	0.02	0.31	0.29	11.53	0.31	12.26	EX 40F
EX 42A	EX 42B	0.43	5.80	10.66	0.66	3.03	0	0.78	2.25	Curb	10	5	0.03	2	0.05	0.02	0.21	0.19	6.41	0.21	7.33	EX 40F
EX 42B	EX 42C	0.84	6.10	10.54	0.66	5.85	1.46	1.04	6.27	Curb	10	5	0.059	2	0.05	0.02	0.25	0.23	8.68	0.25	9.26	EX 40F
4-1	4-2	0.15	5.50	10.79	0.66	1.07	1.78	0.72	2.12	Curb	10	5	0.036	2	0.05	0.02	0.2	0.18	5.97	0.2	6.84	Offsite
4-2	4-3	0.36	6.40	10.43	0.66	2.48	0	0.7	1.78	Curb	10	5	0.03	2	0.05	0.02	0.19	0.17	5.73	0.19	6.7	4-2
4-3	4-4	0.33	5.20	10.91	0.66	2.38	0	0.69	1.69	Curb	10	5	0.03	2	0.05	0.02	0.19	0.17	5.59	0.19	6.57	5-1
4-2	5-1	0.87	5.80	10.66	0.66	6.12	1.69	1.21	6.6	Curb	10	5	0.036	2	0.05	0.02	0.27	0.26	9.83	0.27	10.54	Offsite

10 YEAR PIPE																						
D.S. Str.	U.S. Str.	LineLength (ft)	Incr.Area (ac)	TotalArea (ac)	RunoffCoeff. (C)	IncrCx A	TotalCx A	InletTime (min)	TimeConc (min)	Rnfallnt (in/hr)	TotalRunoff (cfs)	TotalFlow (cfs)	CapacFull (cfs)	Veloc (ft/s)	PipeSize (in)	PipeSlope (%)	Inv ElevDn (ft)	Inv ElevUp (ft)	HGLDn (ft)	HGLUp (ft)	Grnd/RimDn (ft)	Grnd/RimUp (ft)
1-1	1-2	91.62	0.21	1.65	0.66	0.14	1.09	5.2	7.8	9.9	10.79	10.79	24.70	10.16	18	3.27	936.00	939.00	936.69	940.26	937.50	945.00
1-2	1-3	140.08	0.87	1.44	0.66	0.57	0.95	6.2	7.6	10	9.51	9.51	21.58	8.46	18	2.50	939.50	943.00	940.26	944.19	945.00	949.00
1-3	1-4	280.60	0.12	0.12	0.66	0.08	0.08	5.3	5.3	10.9	0.86	0.86	16.24	2.07	15	3.74	943.50	954.00	944.19	954.36	949.00	959.00
1-3	2-1	139.36	0.17	0.45	0.66	0.11	0.3	6	6.1	10.5	3.13	3.13	18.13	4.42	15	4.66	943.50	950.00	944.19	950.71	949.00	956.76
2-1	2-2	35.00	0.28	0.28	0.66	0.18	0.18															

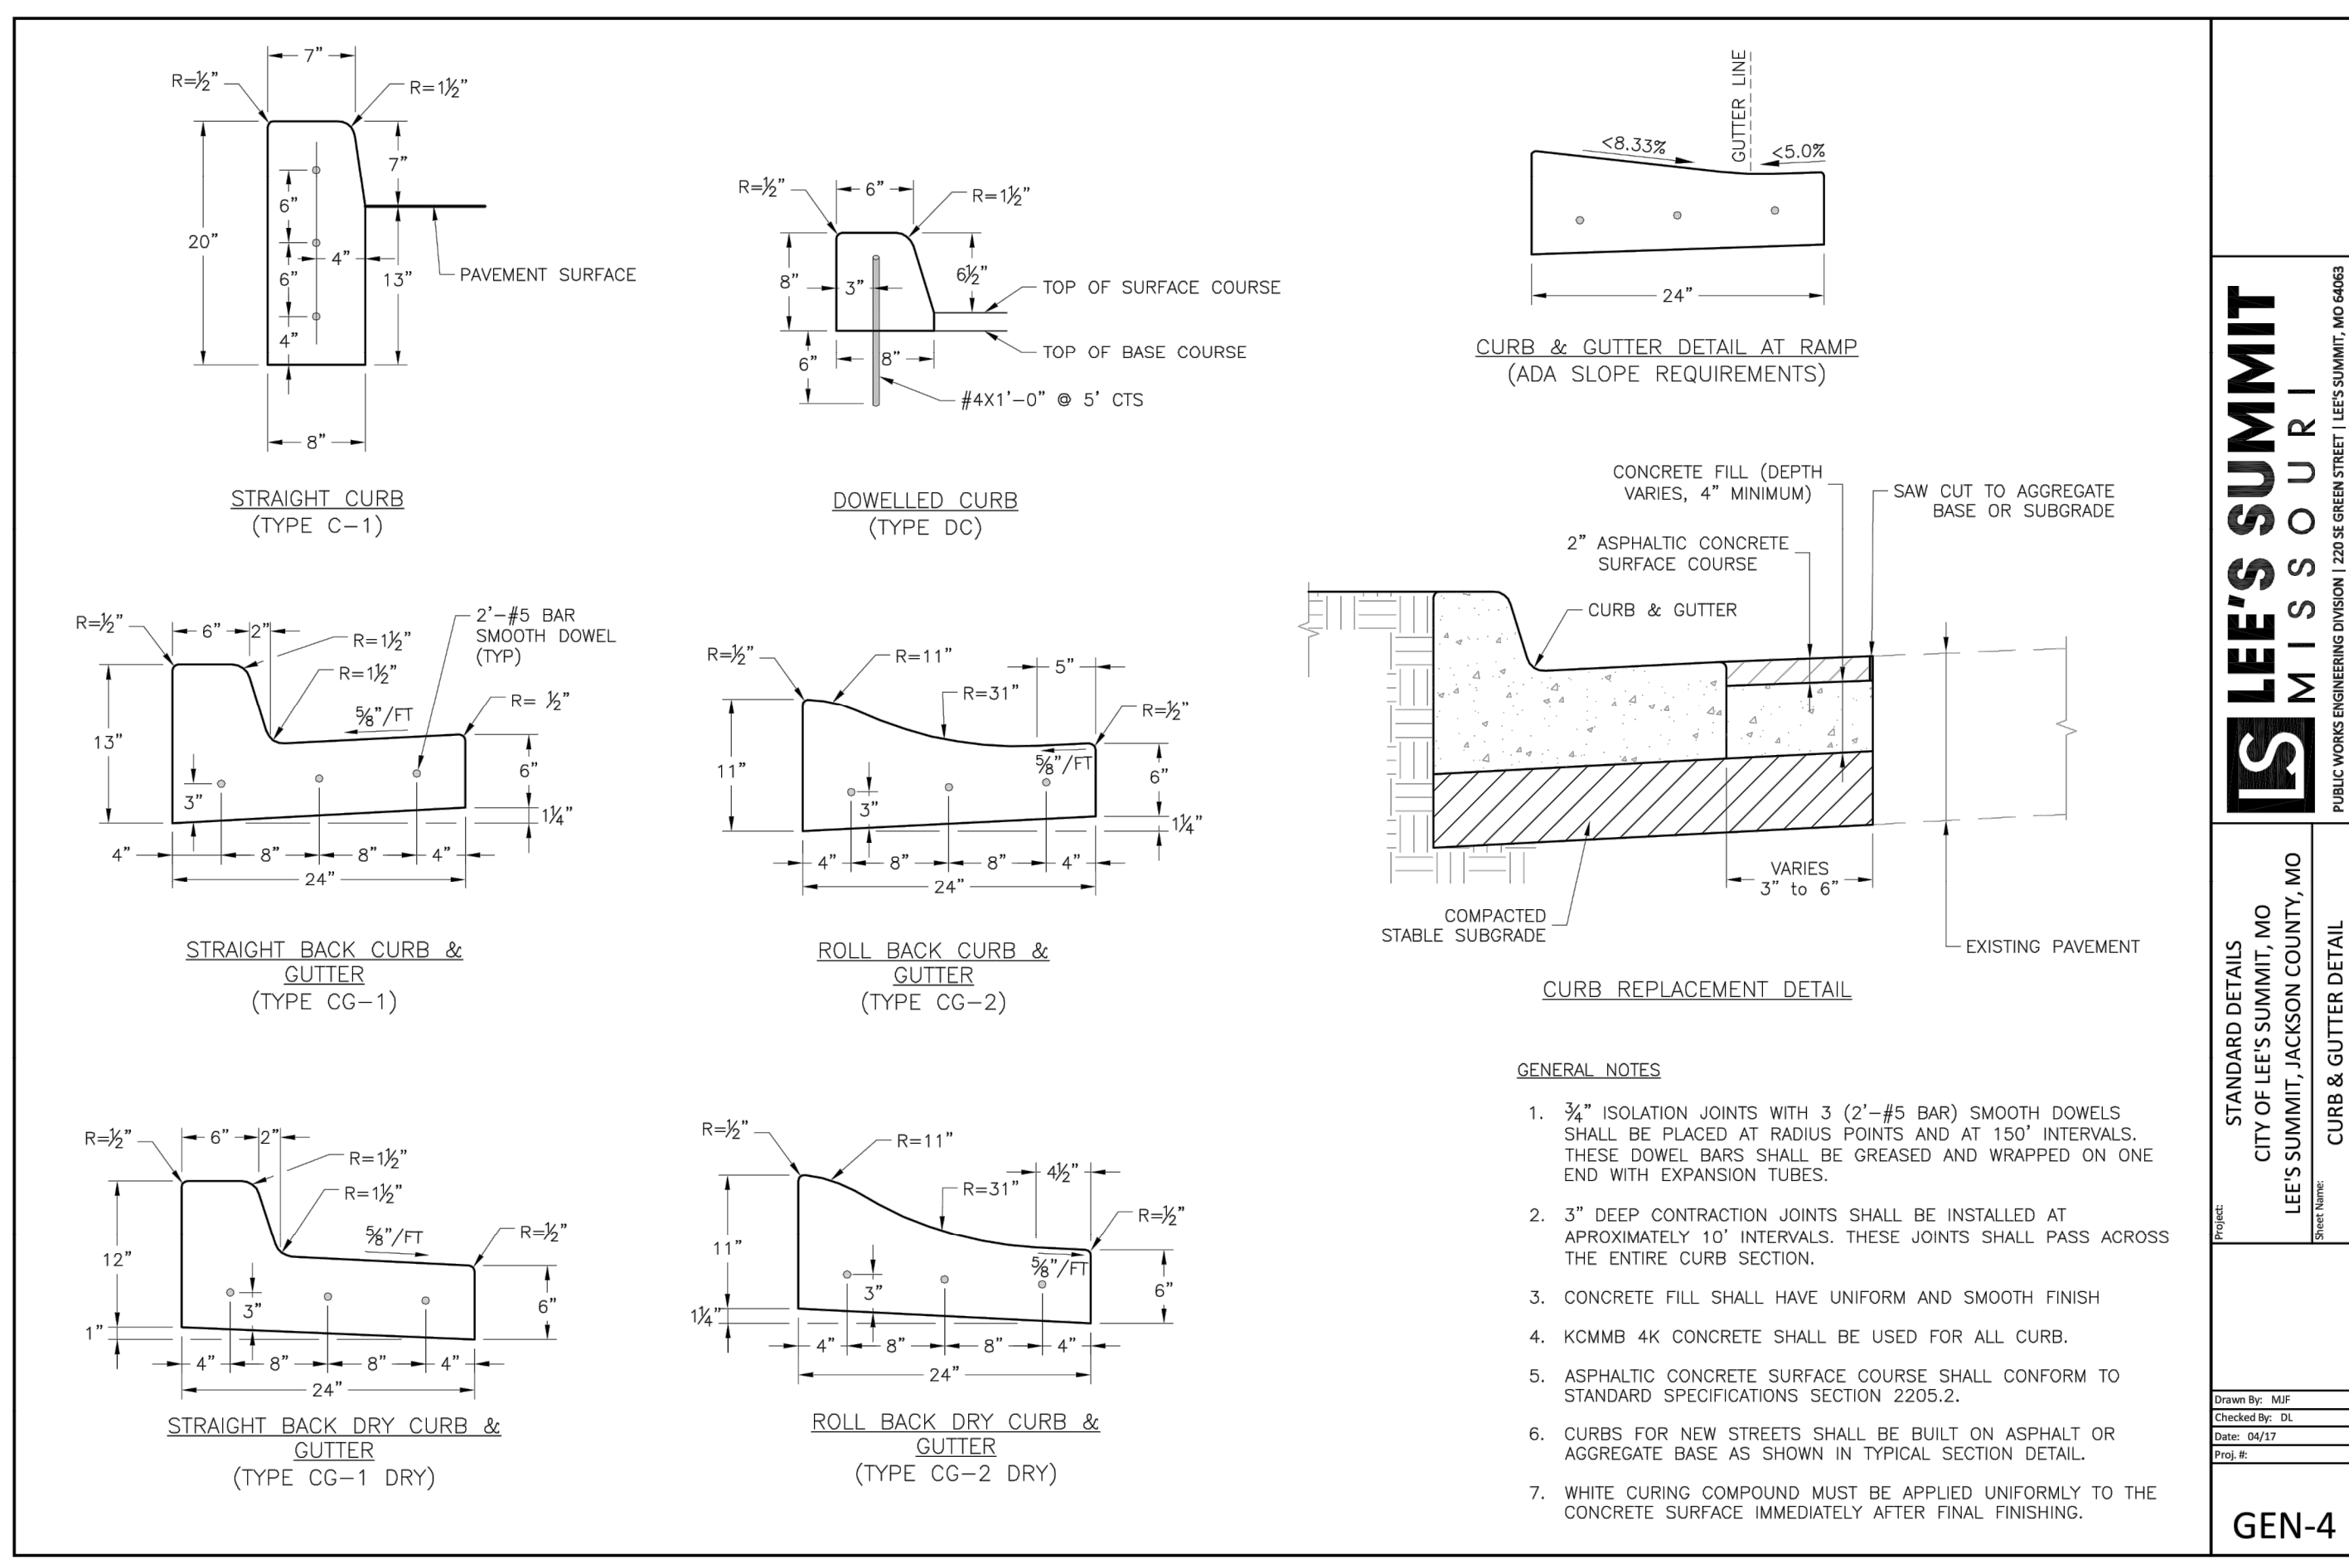


LEE'S SUMMIT MISSOURI

Public Works Engineering Division | 1205 S. GREEN STREET | LEE'S SUMMIT, MO 64083

STANDARD DETAILS
CITY OF LEE'S SUMMIT, MO
LEE'S SUMMIT, JACKSON COUNTY, MO

GEN-4

- GENERAL NOTES**
1. 3/4" ISOLATION JOINTS WITH 3 (2'-#5 BAR) SMOOTH DOWELS SHALL BE PLACED AT RADIUS POINTS AND AT 150' INTERVALS. THESE DOWEL BARS SHALL BE GREASED AND WRAPPED ON ONE END WITH EXPANSION TUBES.
 2. 3" DEEP CONTRACTION JOINTS SHALL BE INSTALLED AT APPROXIMATELY 10' INTERVALS. THESE JOINTS SHALL PASS ACROSS THE ENTIRE CURB SECTION.
 3. CONCRETE FILL SHALL HAVE UNIFORM AND SMOOTH FINISH
 4. KCMMB 4K CONCRETE SHALL BE USED FOR ALL CURB.
 5. ASPHALTIC CONCRETE SURFACE COURSE SHALL CONFORM TO STANDARD SPECIFICATIONS SECTION 2205.2.
 6. CURBS FOR NEW STREETS SHALL BE BUILT ON ASPHALT OR AGGREGATE BASE AS SHOWN IN TYPICAL SECTION DETAIL.
 7. WHITE CURING COMPOUND MUST BE APPLIED UNIFORMLY TO THE CONCRETE SURFACE IMMEDIATELY AFTER FINAL FINISHING.

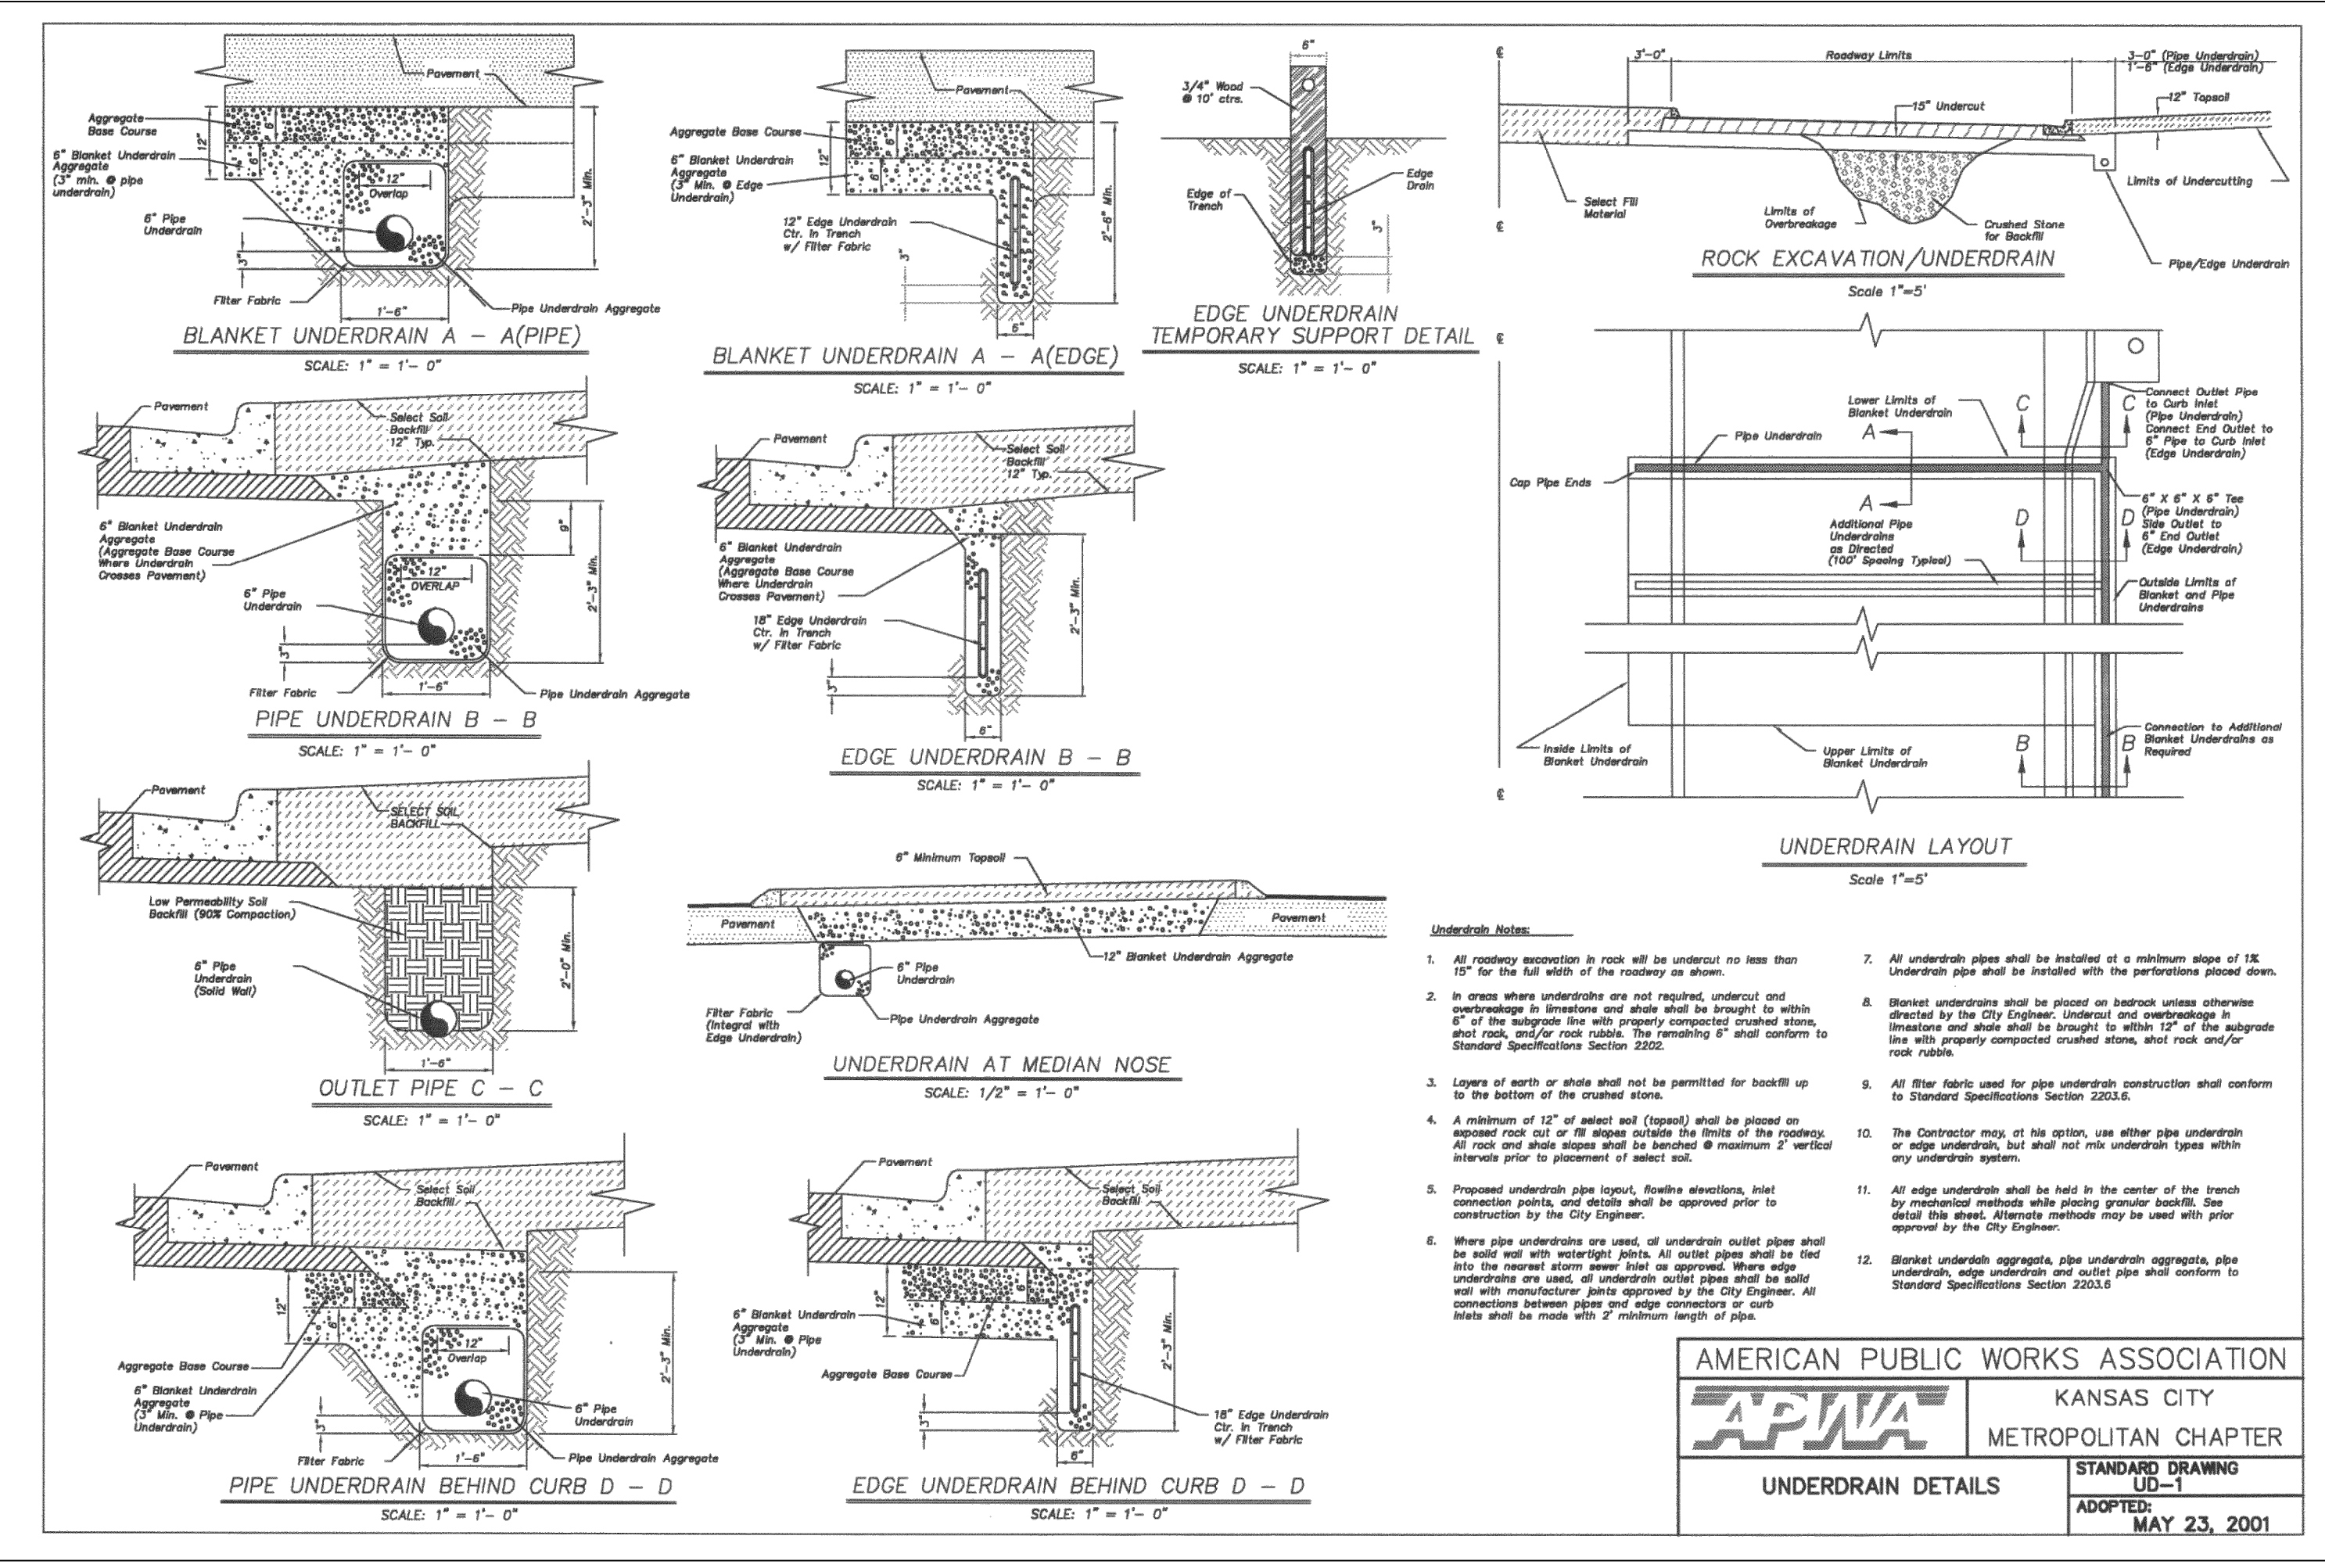

AMERICAN PUBLIC WORKS ASSOCIATION
APWA KANSAS CITY METROPOLITAN CHAPTER
STANDARD DRAWING
UNDERDRAIN DETAILS
AD-1
ADOPTED: MAY 23, 2001


GENERAL NOTE:
1 - ALL CONSTRUCTION SHALL CONFORM TO THE CITY OF LEE'S SUMMIT DESIGN AND CONSTRUCTION MANUAL AS ADOPTED BY ORDINANCE 5813.

Professional Registration
Missouri
Engineering 2005002186-D
Surveying 2005000319-D
Kansas
Engineering E-1695
Surveying LS-218
Oklahoma
Engineering 6254
Nebraska
Engineering CA2821

THE TOWNHOMES OF CHAPEL RIDGE-2ND PLAT
LOTS 9-19 & TRACTS A-D
Lee's Summit, Jackson County, Missouri

Project: VILLAS OF CHAPEL RIDGE, LSMO
Issue Date: April 10, 2020


Construction Details
Construction Plans for THE TOWNHOMES OF CHAPEL RIDGE-2ND PLAT
LOTS 9-19 & TRACTS A-D
Lee's Summit, Jackson County, Missouri

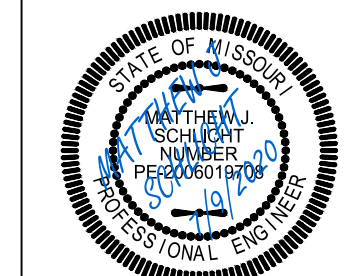

Matthew J. Schlicht
MO PE 2006019708
KS PE 19071
OK PE 25226
NE PE E-14335

REVISIONS

REV. 5/1/2020
REV. 5/12/2020
REV. 6/4/2020
REV. 7/9/2020

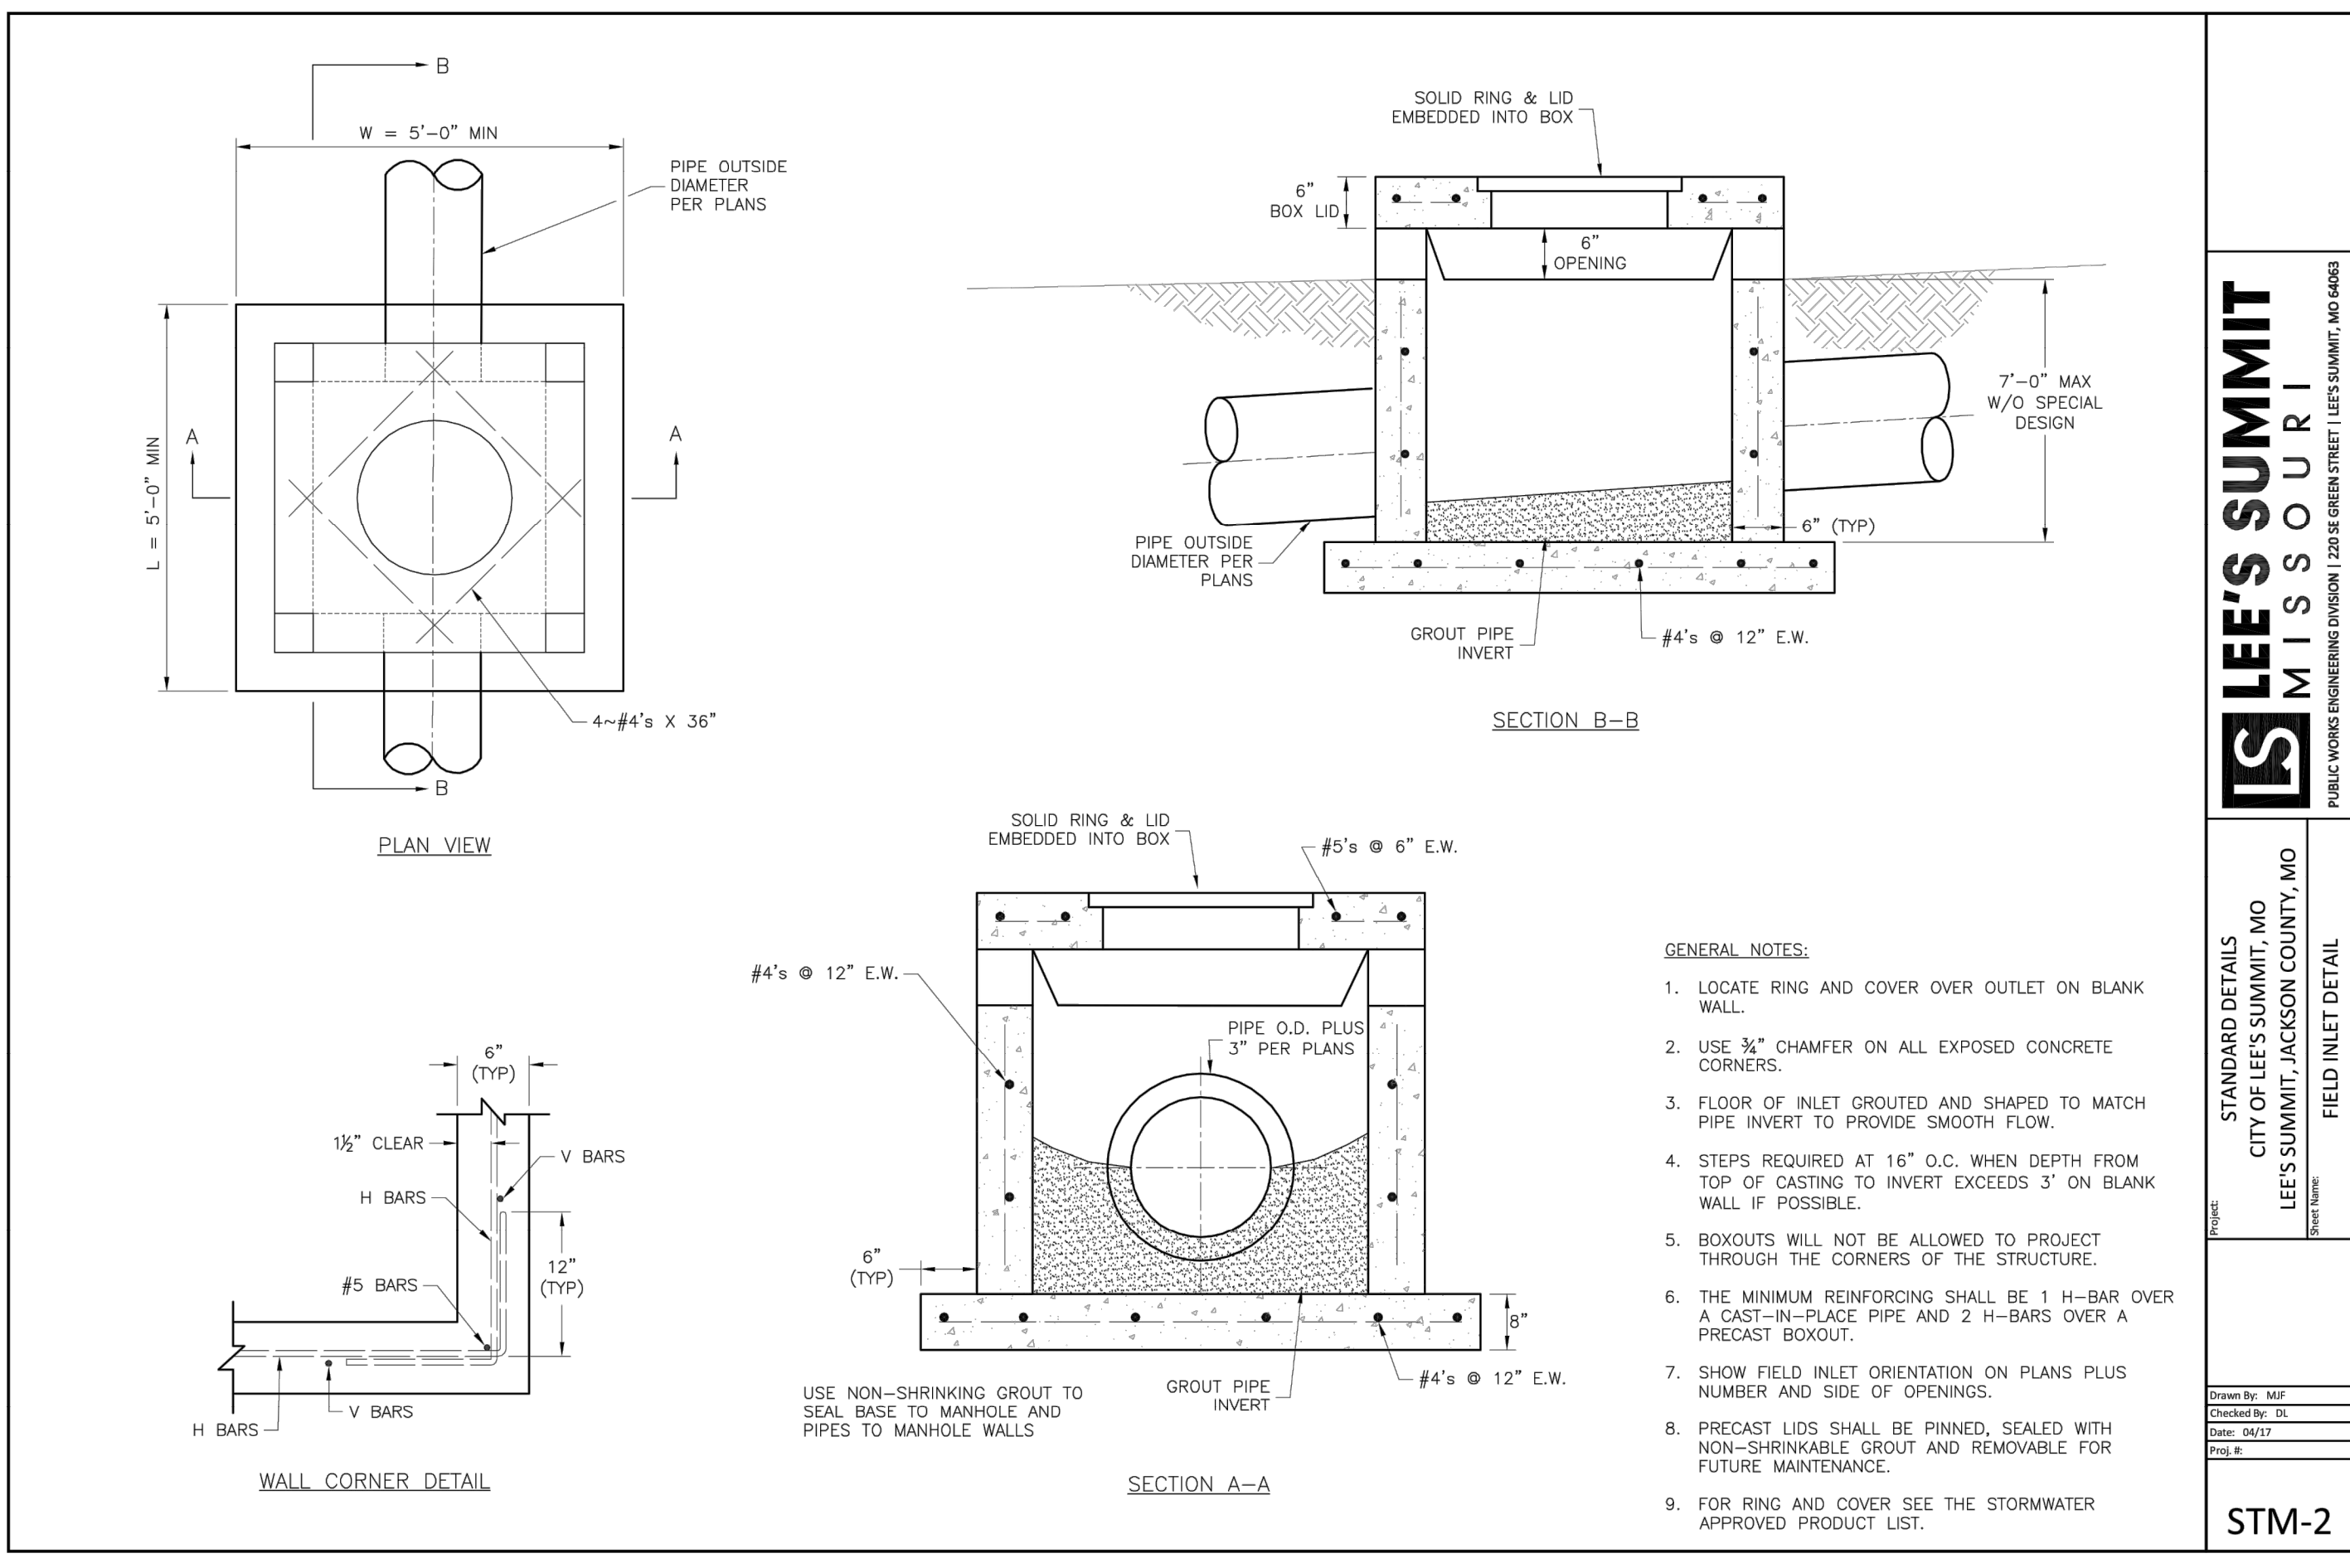

LEE'S SUMMIT MISSOURI
 PUBLIC WORKS ENGINEERING DIVISION | 220 SE GREEN STREET | LEE'S SUMMIT, MO 64083


STANDARD DETAILS
 CITY OF LEE'S SUMMIT, MO
 LEE'S SUMMIT, JACKSON COUNTY, MO

FIELD INLET DETAIL

Drawn By: MIF
 Checked By: DL
 Date: 04/17
 Title: STM-2
 Pkg. #

STM-2

- GENERAL NOTES:**
1. LOCATE RING AND COVER OVER OUTLET ON BLANK WALL.
 2. USE 3/8" CHAMFER ON ALL EXPOSED CONCRETE CORNERS.
 3. FLOOR OF INLET GROUTED AND SHAPED TO MATCH PIPE INVERT TO PROVIDE SMOOTH FLOW.
 4. STEPS REQUIRED AT 16" O.C. WHEN DEPTH FROM TOP OF CASTING TO INVERT EXCEEDS 3' ON BLANK WALL IF POSSIBLE.
 5. BOXOUTS WILL NOT BE ALLOWED TO PROJECT THROUGH THE CORNERS OF THE STRUCTURE.
 6. THE MINIMUM REINFORCING SHALL BE 1 H-BAR OVER A CAST-IN-PLACE PIPE AND 2 H-BARS OVER A PRECAST BOXOUT.
 7. SHOW FIELD INLET ORIENTATION ON PLANS PLUS NUMBER AND SIDE OF OPENINGS.
 8. PRECAST LIDS SHALL BE PINNED, SEALED WITH NON-SHRINKABLE GROUT AND REMOVABLE FOR FUTURE MAINTENANCE.
 9. FOR RING AND COVER SEE THE STORMWATER APPROVED PRODUCT LIST.

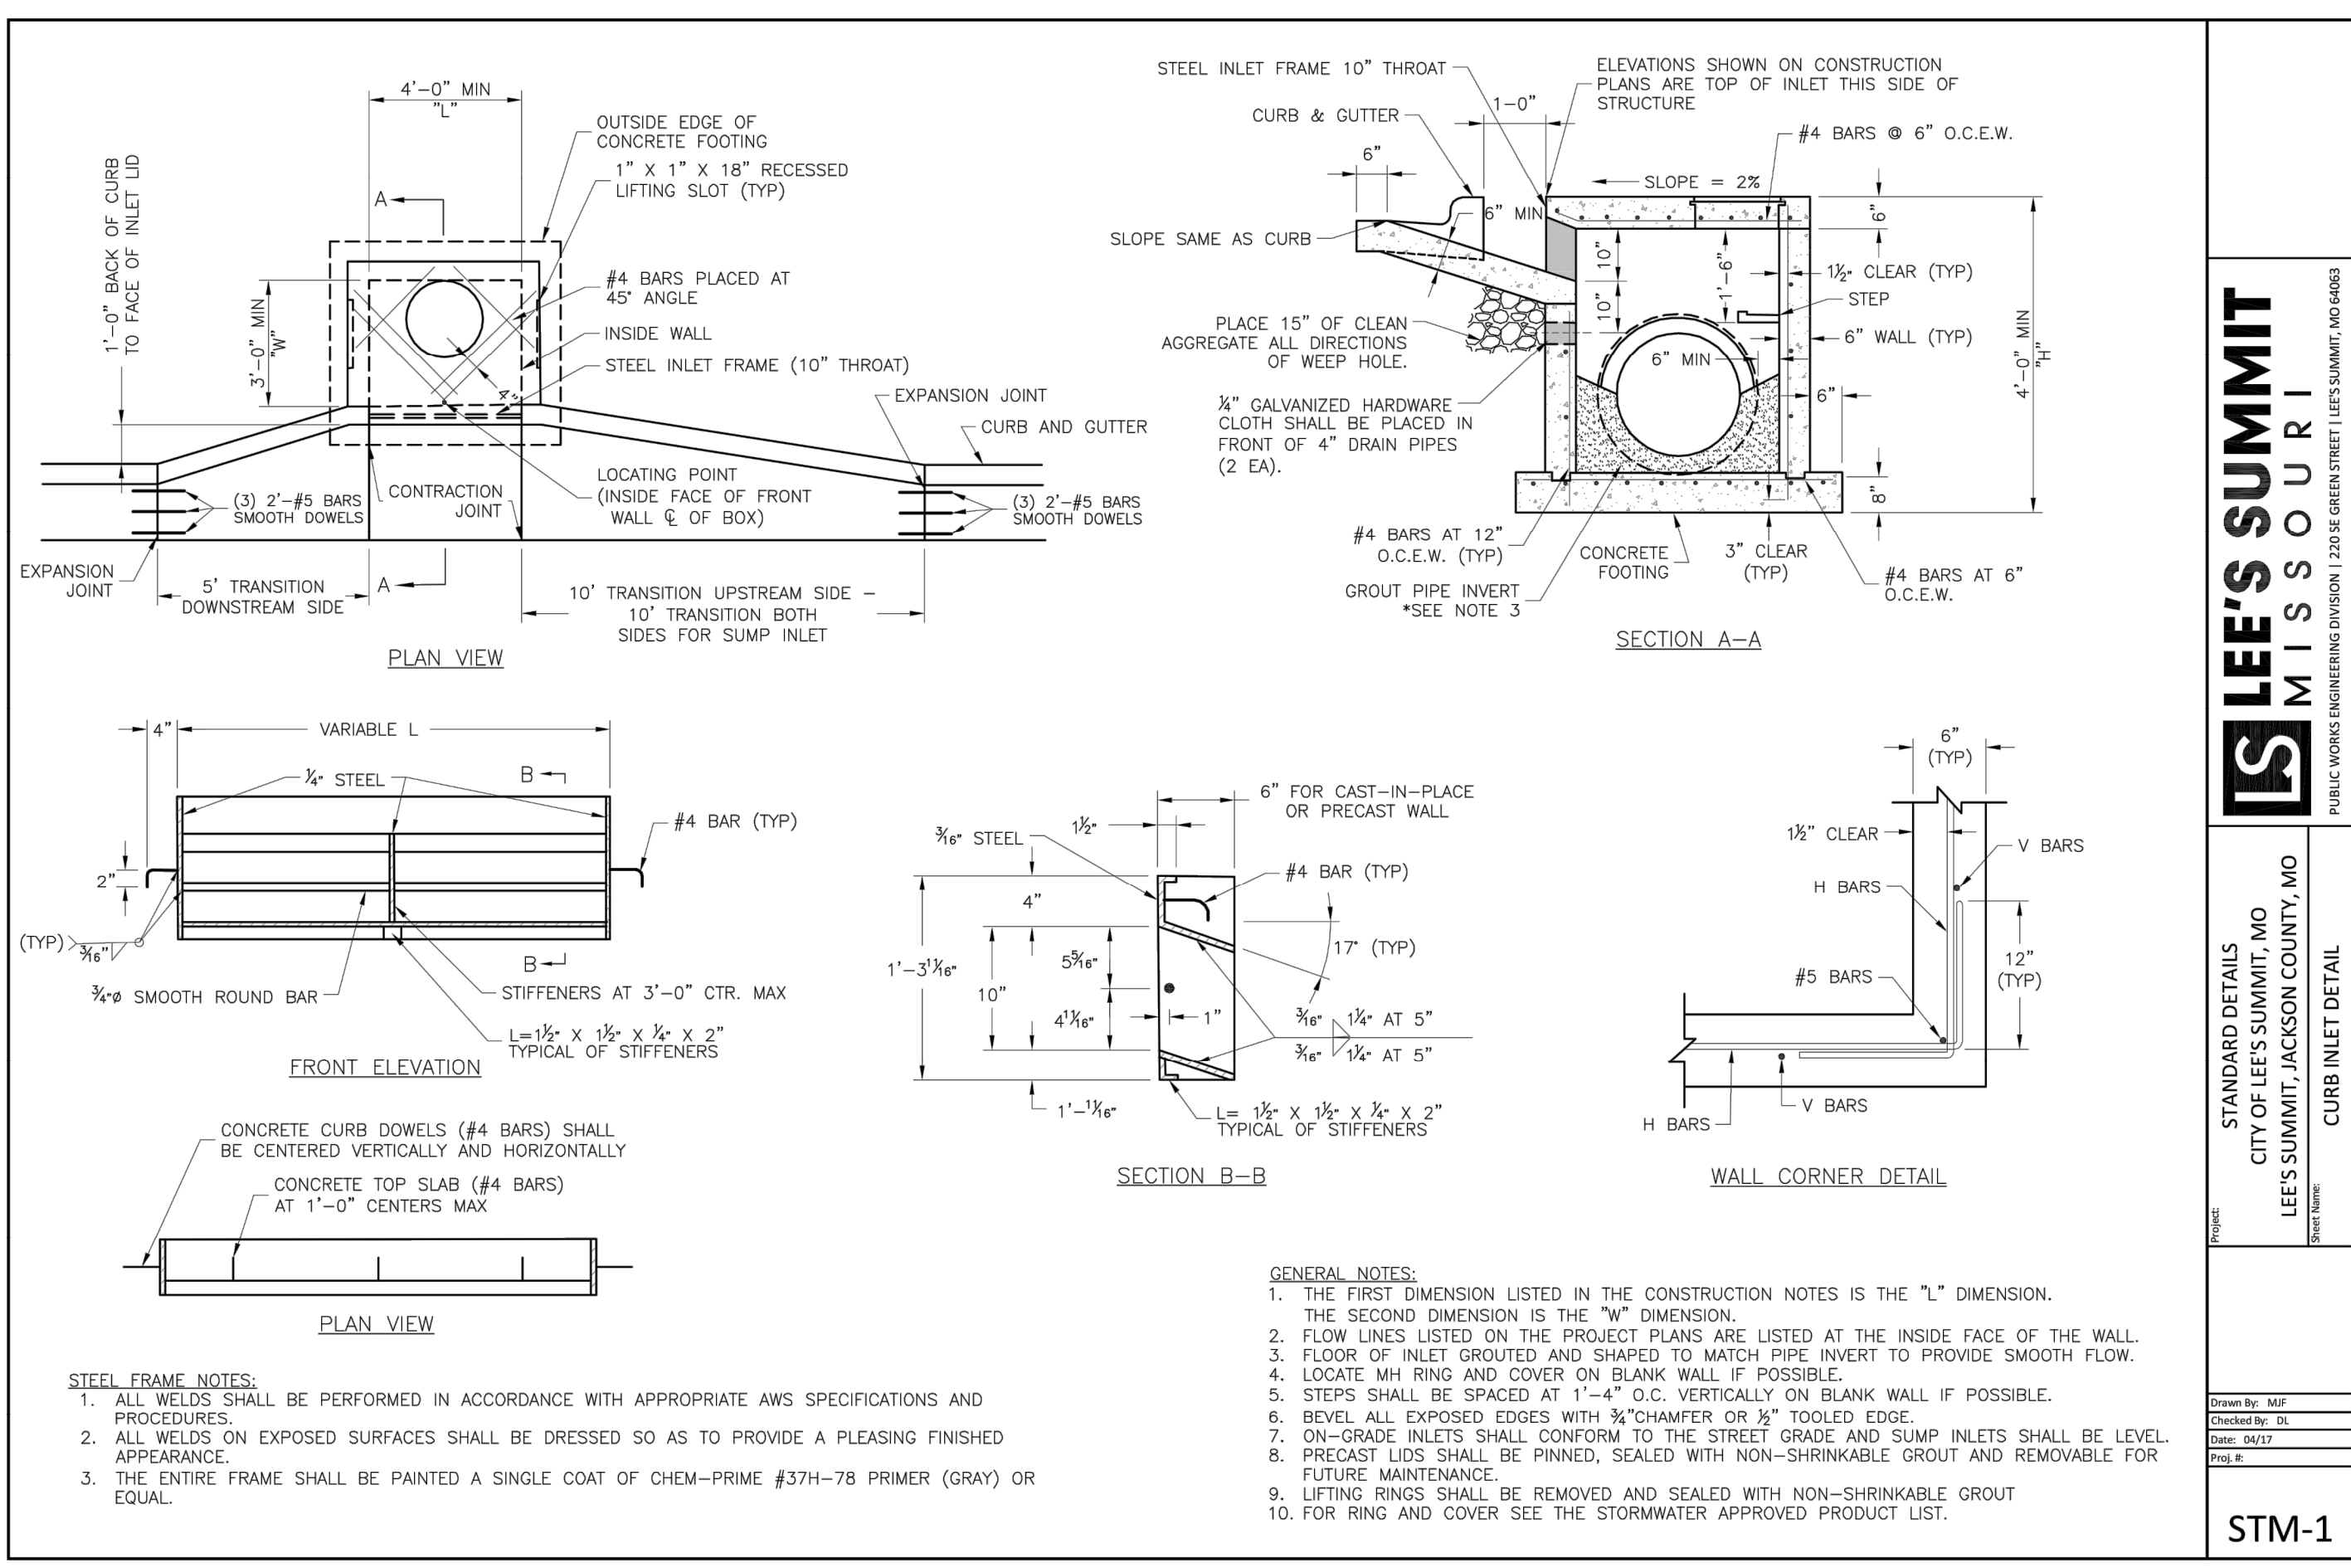

LEE'S SUMMIT MISSOURI
 PUBLIC WORKS ENGINEERING DIVISION | 220 SE GREEN STREET | LEE'S SUMMIT, MO 64083

STANDARD DETAILS
 CITY OF LEE'S SUMMIT, MO
 LEE'S SUMMIT, JACKSON COUNTY, MO

CURB INLET DETAIL

Drawn By: MIF
 Checked By: DL
 Date: 04/17
 Title: STM-1
 Pkg. #

STM-1



- GENERAL NOTES:**
1. THE FIRST DIMENSION LISTED IN THE CONSTRUCTION NOTES IS THE "L" DIMENSION. THE SECOND DIMENSION IS THE "W" DIMENSION.
 2. FLOW LINES LISTED ON THE PROJECT PLANS ARE LISTED AT THE INSIDE FACE OF THE WALL.
 3. FLOOR OF INLET GROUTED AND SHAPED TO MATCH PIPE INVERT TO PROVIDE SMOOTH FLOW.
 4. LOCATE MH RING AND COVER ON BLANK WALL IF POSSIBLE.
 5. STEPS SHALL BE SPACED AT 1'-4" O.C. VERTICALLY ON BLANK WALL IF POSSIBLE.
 6. BEVEL ALL EXPOSED EDGES WITH 3/8" CHAMFER OR 1/4" TOOLED EDGE.
 7. ON-GRADE INLETS SHALL CONFORM TO THE STREET GRADE AND SUMP INLETS SHALL BE LEVEL.
 8. PRECAST LIDS SHALL BE PINNED, SEALED WITH NON-SHRINKABLE GROUT AND REMOVABLE FOR FUTURE MAINTENANCE.
 9. LIFTING RINGS SHALL BE REMOVED AND SEALED WITH NON-SHRINKABLE GROUT.
 10. FOR RING AND COVER SEE THE STORMWATER APPROVED PRODUCT LIST.

- STEEL FRAME NOTES:**
1. ALL WELDS SHALL BE PERFORMED IN ACCORDANCE WITH APPROPRIATE AWS SPECIFICATIONS AND PROCEDURES.
 2. ALL WELDS ON EXPOSED SURFACES SHALL BE DRESSED SO AS TO PROVIDE A PLEASING FINISHED APPEARANCE.
 3. THE ENTIRE FRAME SHALL BE PAINTED A SINGLE COAT OF CHEM-PRIME #37H-78 PRIMER (GRAY) OR EQUAL.

CONCRETE CURB DOWELS (#4 BARS) SHALL BE CENTERED VERTICALLY AND HORIZONTALLY CONCRETE TOP SLAB (#4 BARS) AT 1'-0" CENTERS MAX

STIFFENERS AT 3'-0" CTR. MAX

L = 1/2" x 1/2" x 1/2" x 1/2" x 2" TYPICAL OF STIFFENERS

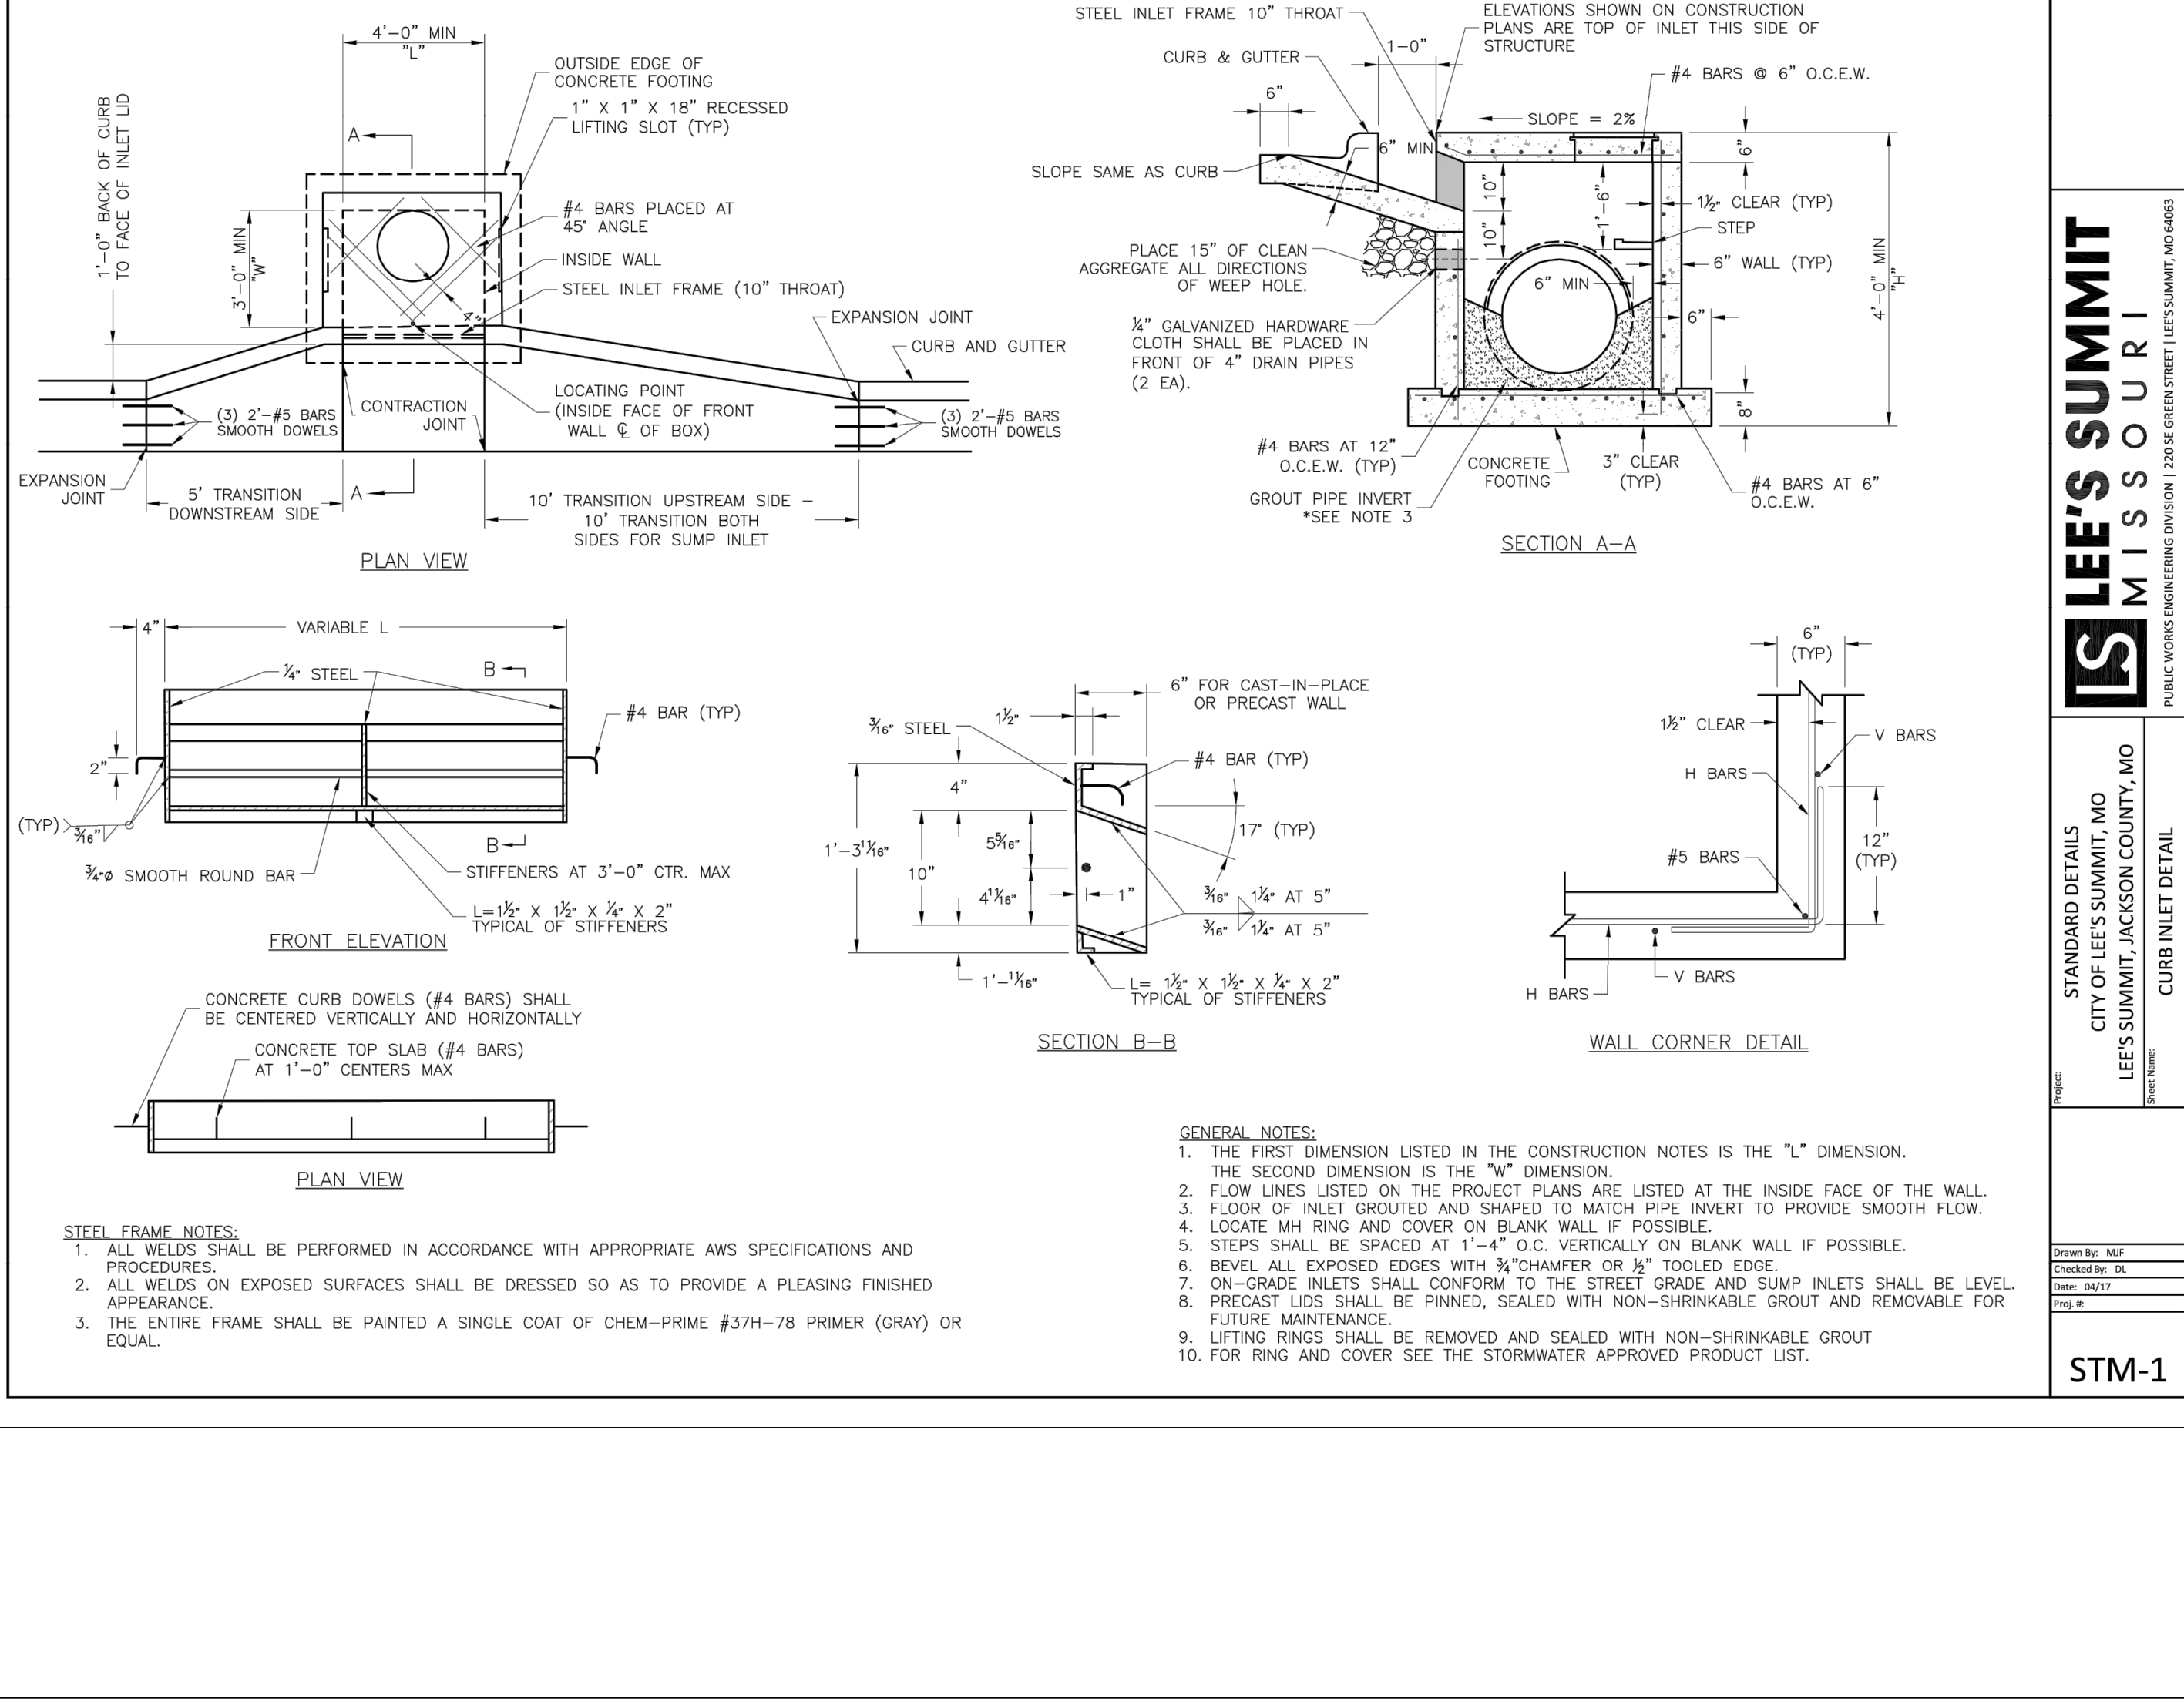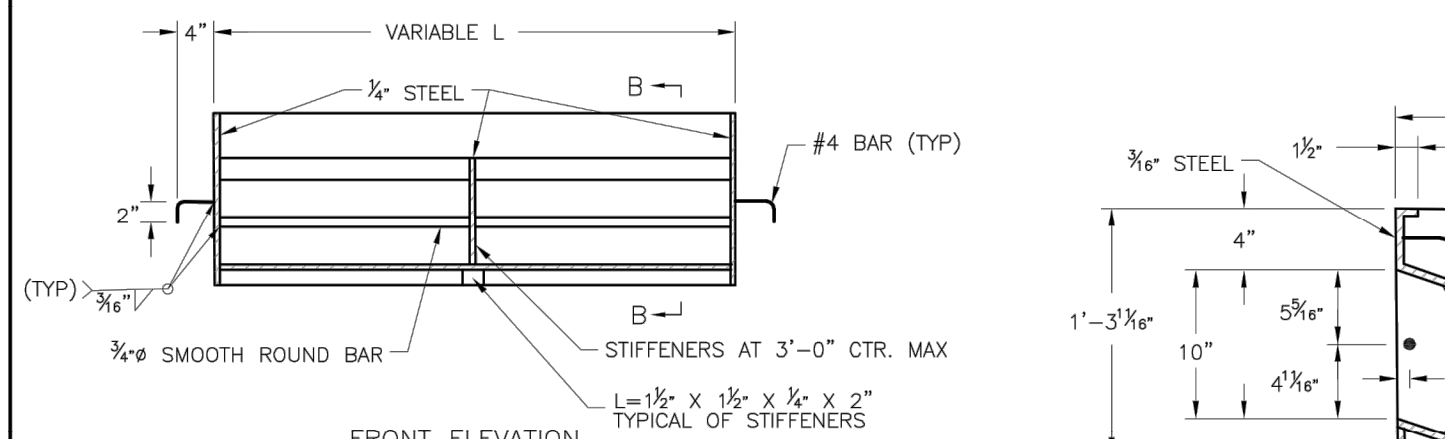


LEE'S SUMMIT MISSOURI
 PUBLIC WORKS ENGINEERING DIVISION | 220 SE GREEN STREET | LEE'S SUMMIT, MO 64083

FIELD INLET DETAIL

Drawn By: MIF
 Checked By: DL
 Date: 04/17
 Title: STM-3
 Pkg. #

STM-3

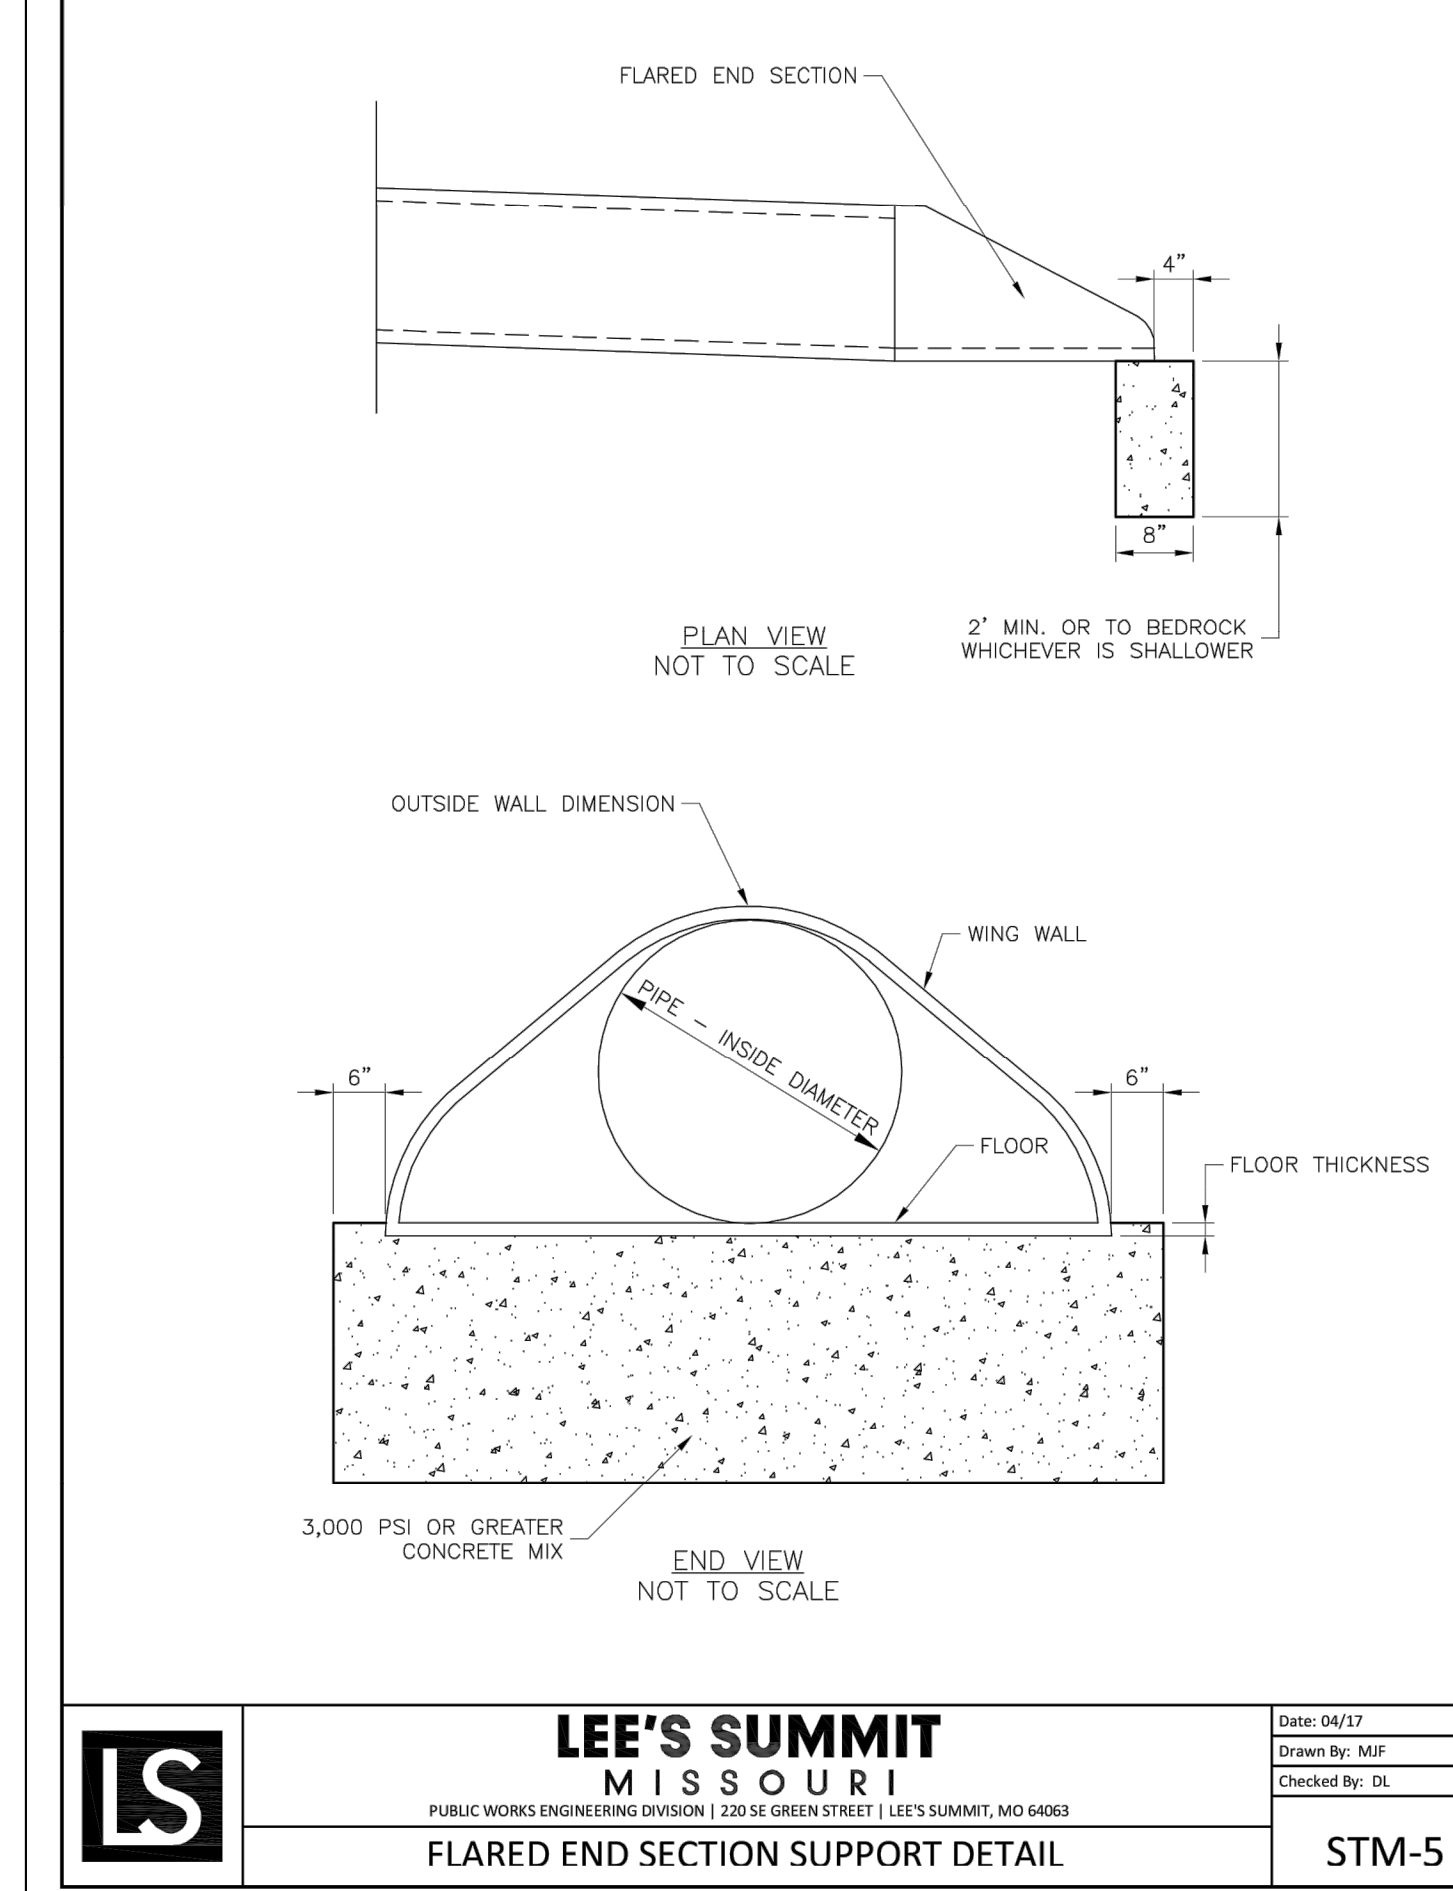


LEE'S SUMMIT MISSOURI
 PUBLIC WORKS ENGINEERING DIVISION | 220 SE GREEN STREET | LEE'S SUMMIT, MO 64083

FLARED END SECTION SUPPORT DETAIL

Drawn By: MIF
 Checked By: DL
 Date: 04/17
 Title: STM-5
 Pkg. #

STM-5

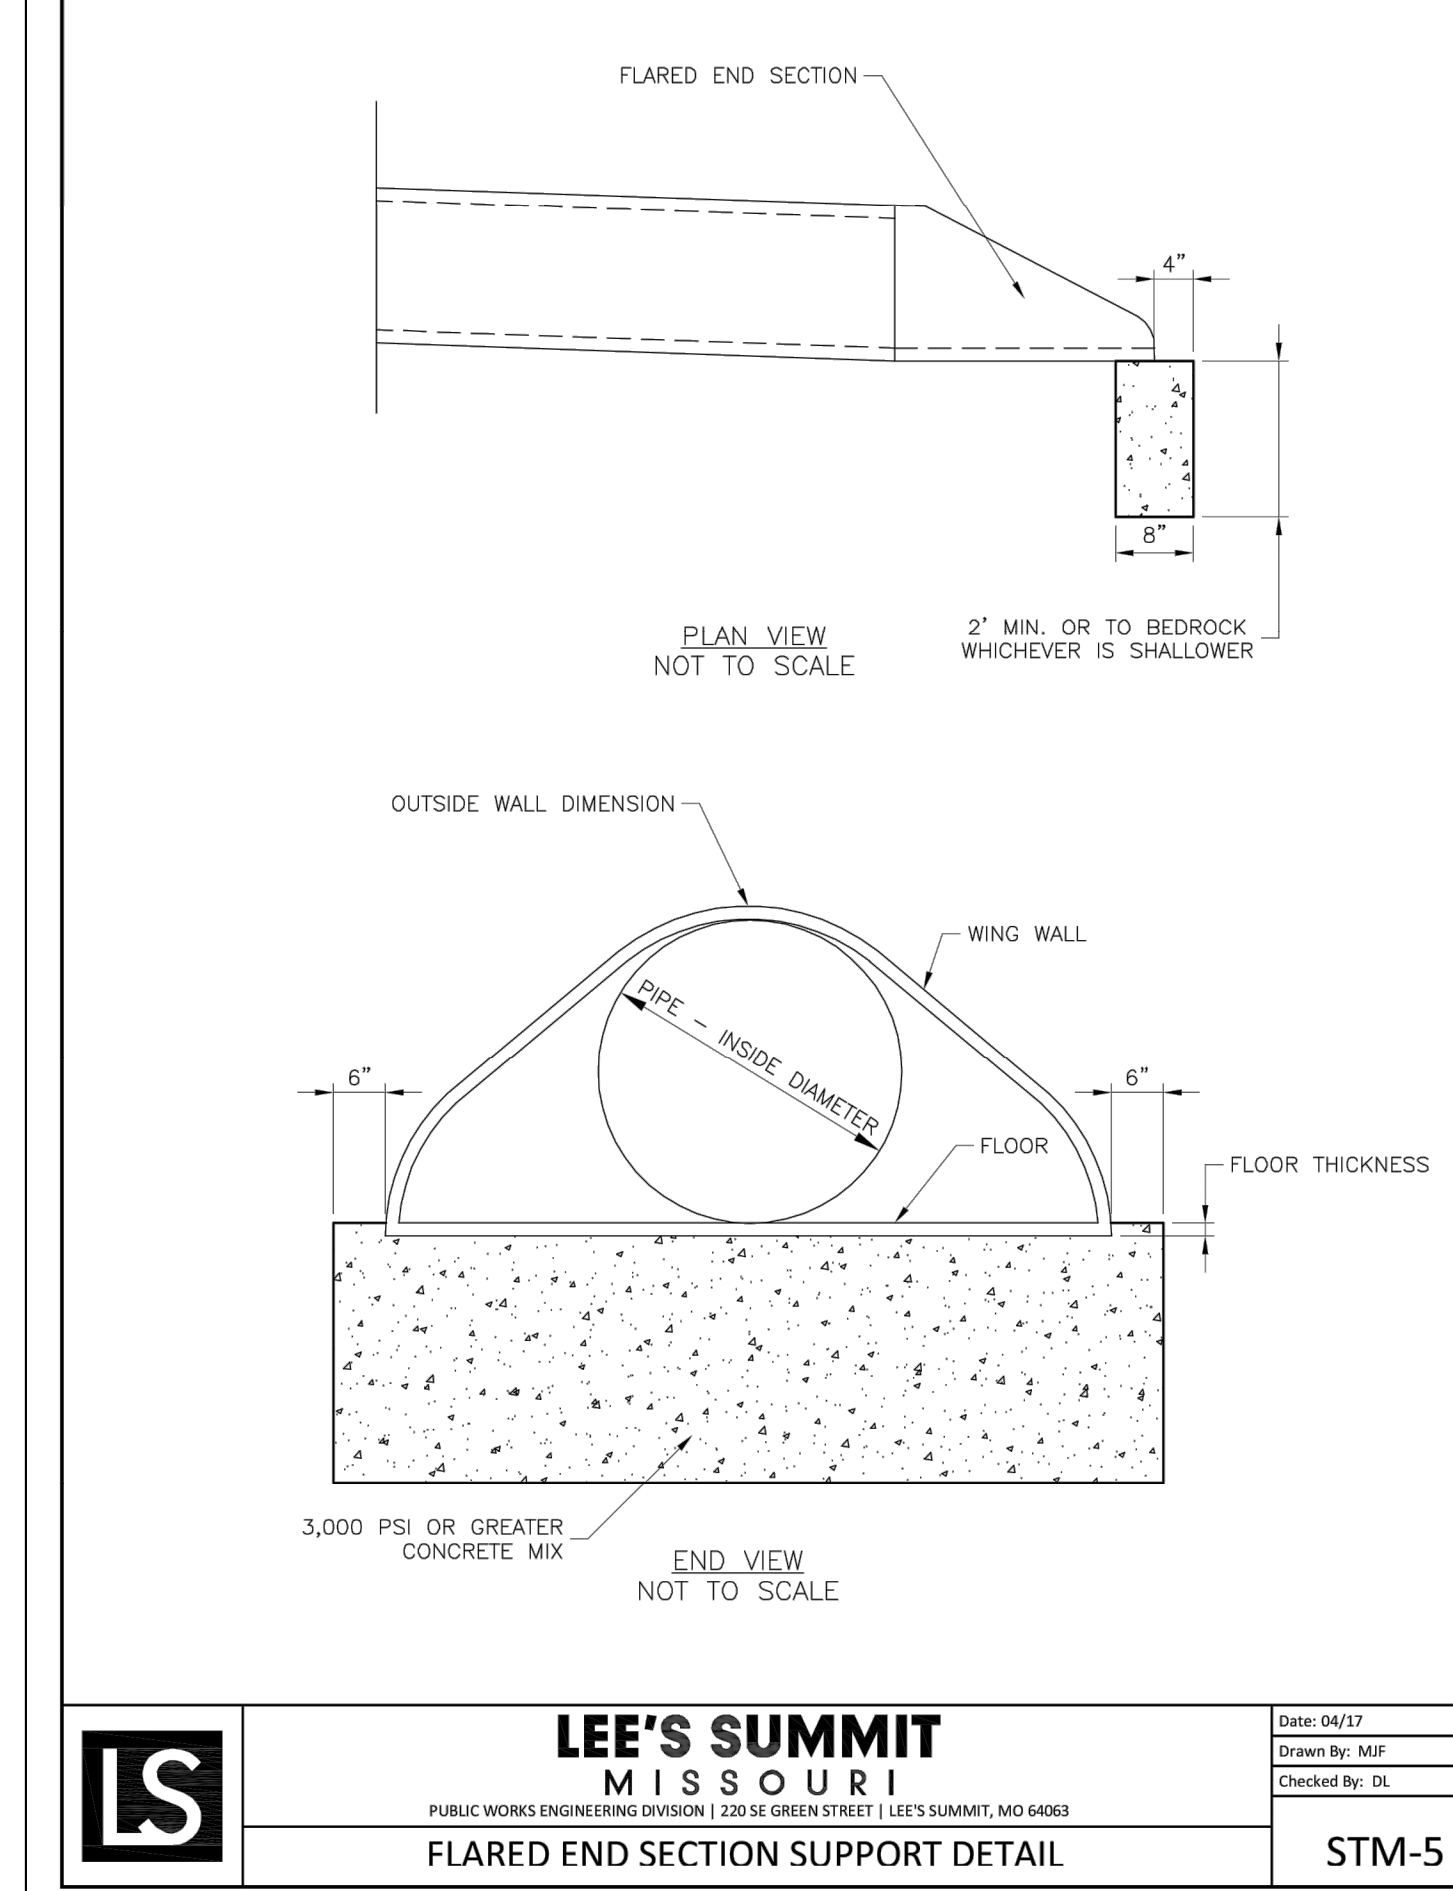


LEE'S SUMMIT MISSOURI
 PUBLIC WORKS ENGINEERING DIVISION | 220 SE GREEN STREET | LEE'S SUMMIT, MO 64083

STORM MANHOLE COVER DETAIL

Drawn By: MIF
 Checked By: DL
 Date: 04/17
 Title: STM-6
 Pkg. #

 STM-6




LEE'S SUMMIT MISSOURI
 PUBLIC WORKS ENGINEERING DIVISION | 220 SE GREEN STREET | LEE'S SUMMIT, MO 64083

STORM MANHOLE FRAME DETAIL

Drawn By: MIF
 Checked By: DL
 Date: 04/17
 Title: STM-7
 Pkg. #

STM-7

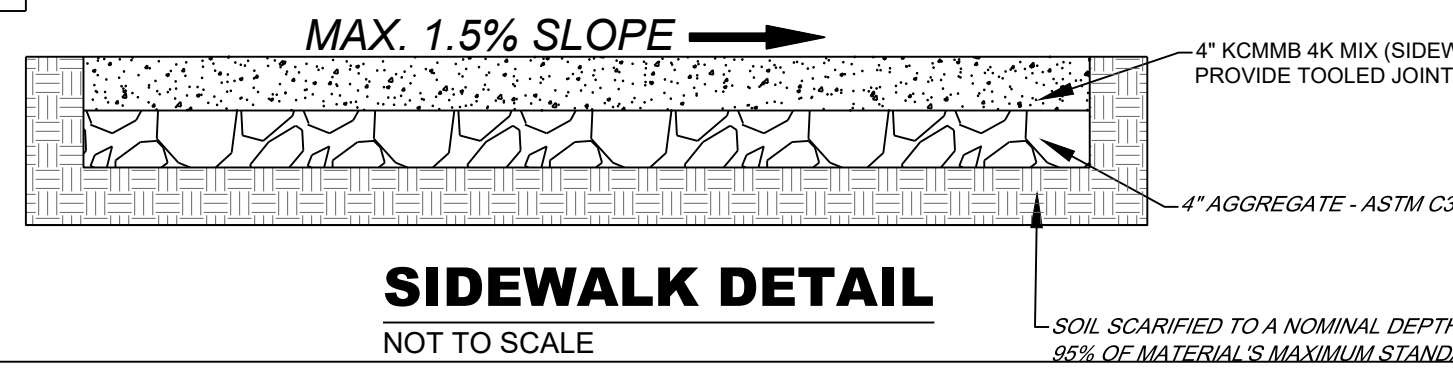


LEE'S SUMMIT MISSOURI
 PUBLIC WORKS ENGINEERING DIVISION | 220 SE GREEN STREET | LEE'S SUMMIT, MO 64083

FIELD INLET DETAIL

Drawn By: MIF
 Checked By: DL
 Date: 04/17
 Title: STM-8
 Pkg. #

STM-8

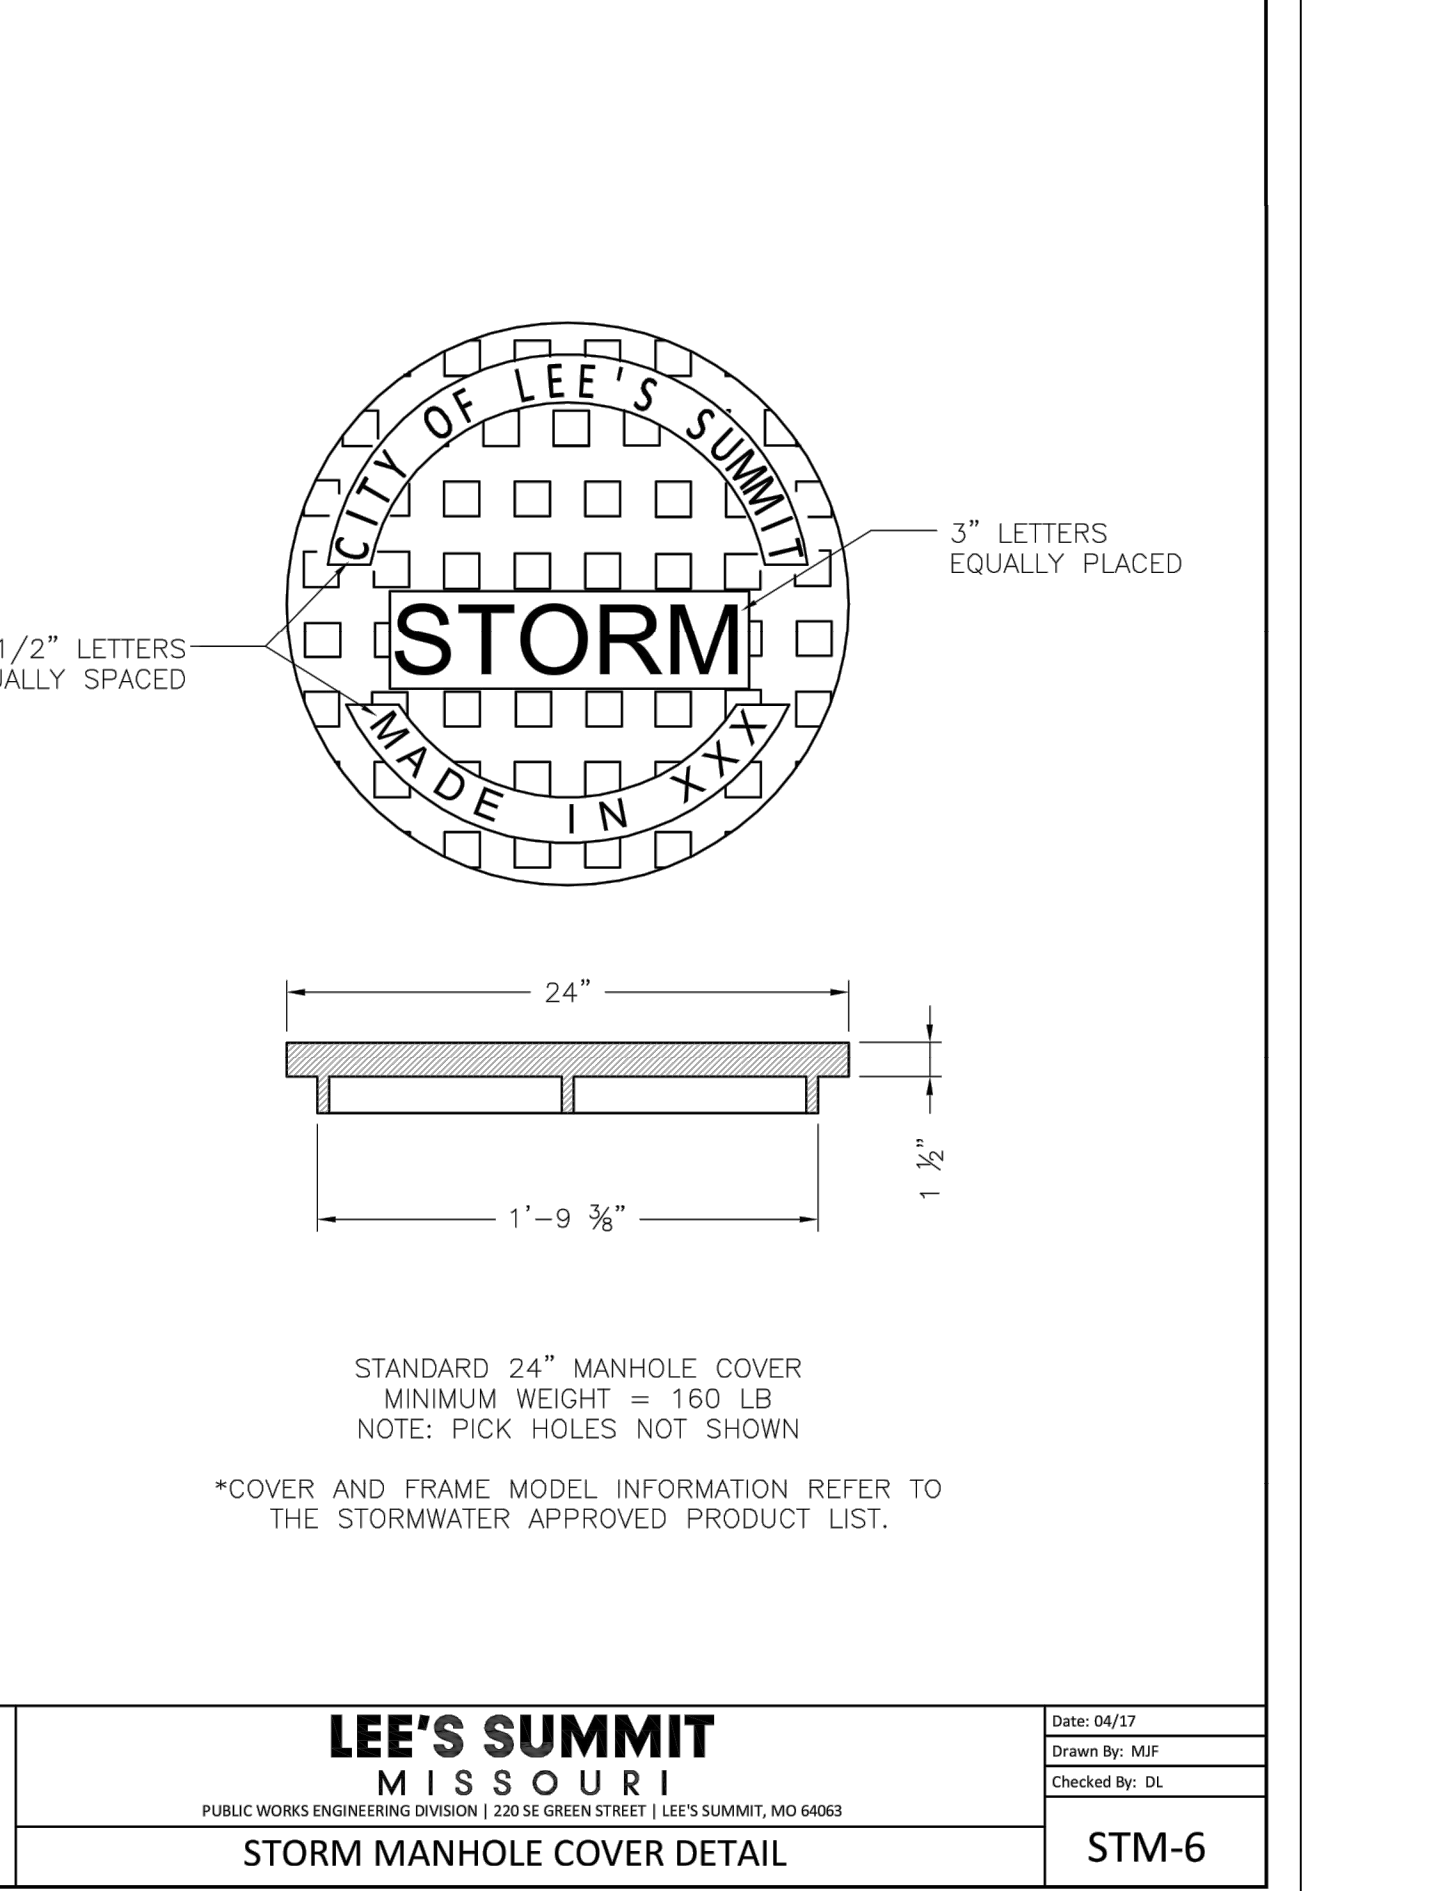


LEE'S SUMMIT MISSOURI
 PUBLIC WORKS ENGINEERING DIVISION | 220 SE GREEN STREET | LEE'S SUMMIT, MO 64083

STORM MANHOLE FRAME DETAIL

Drawn By: MIF
 Checked By: DL
 Date: 04/17
 Title: STM-9
 Pkg. #

STM-9

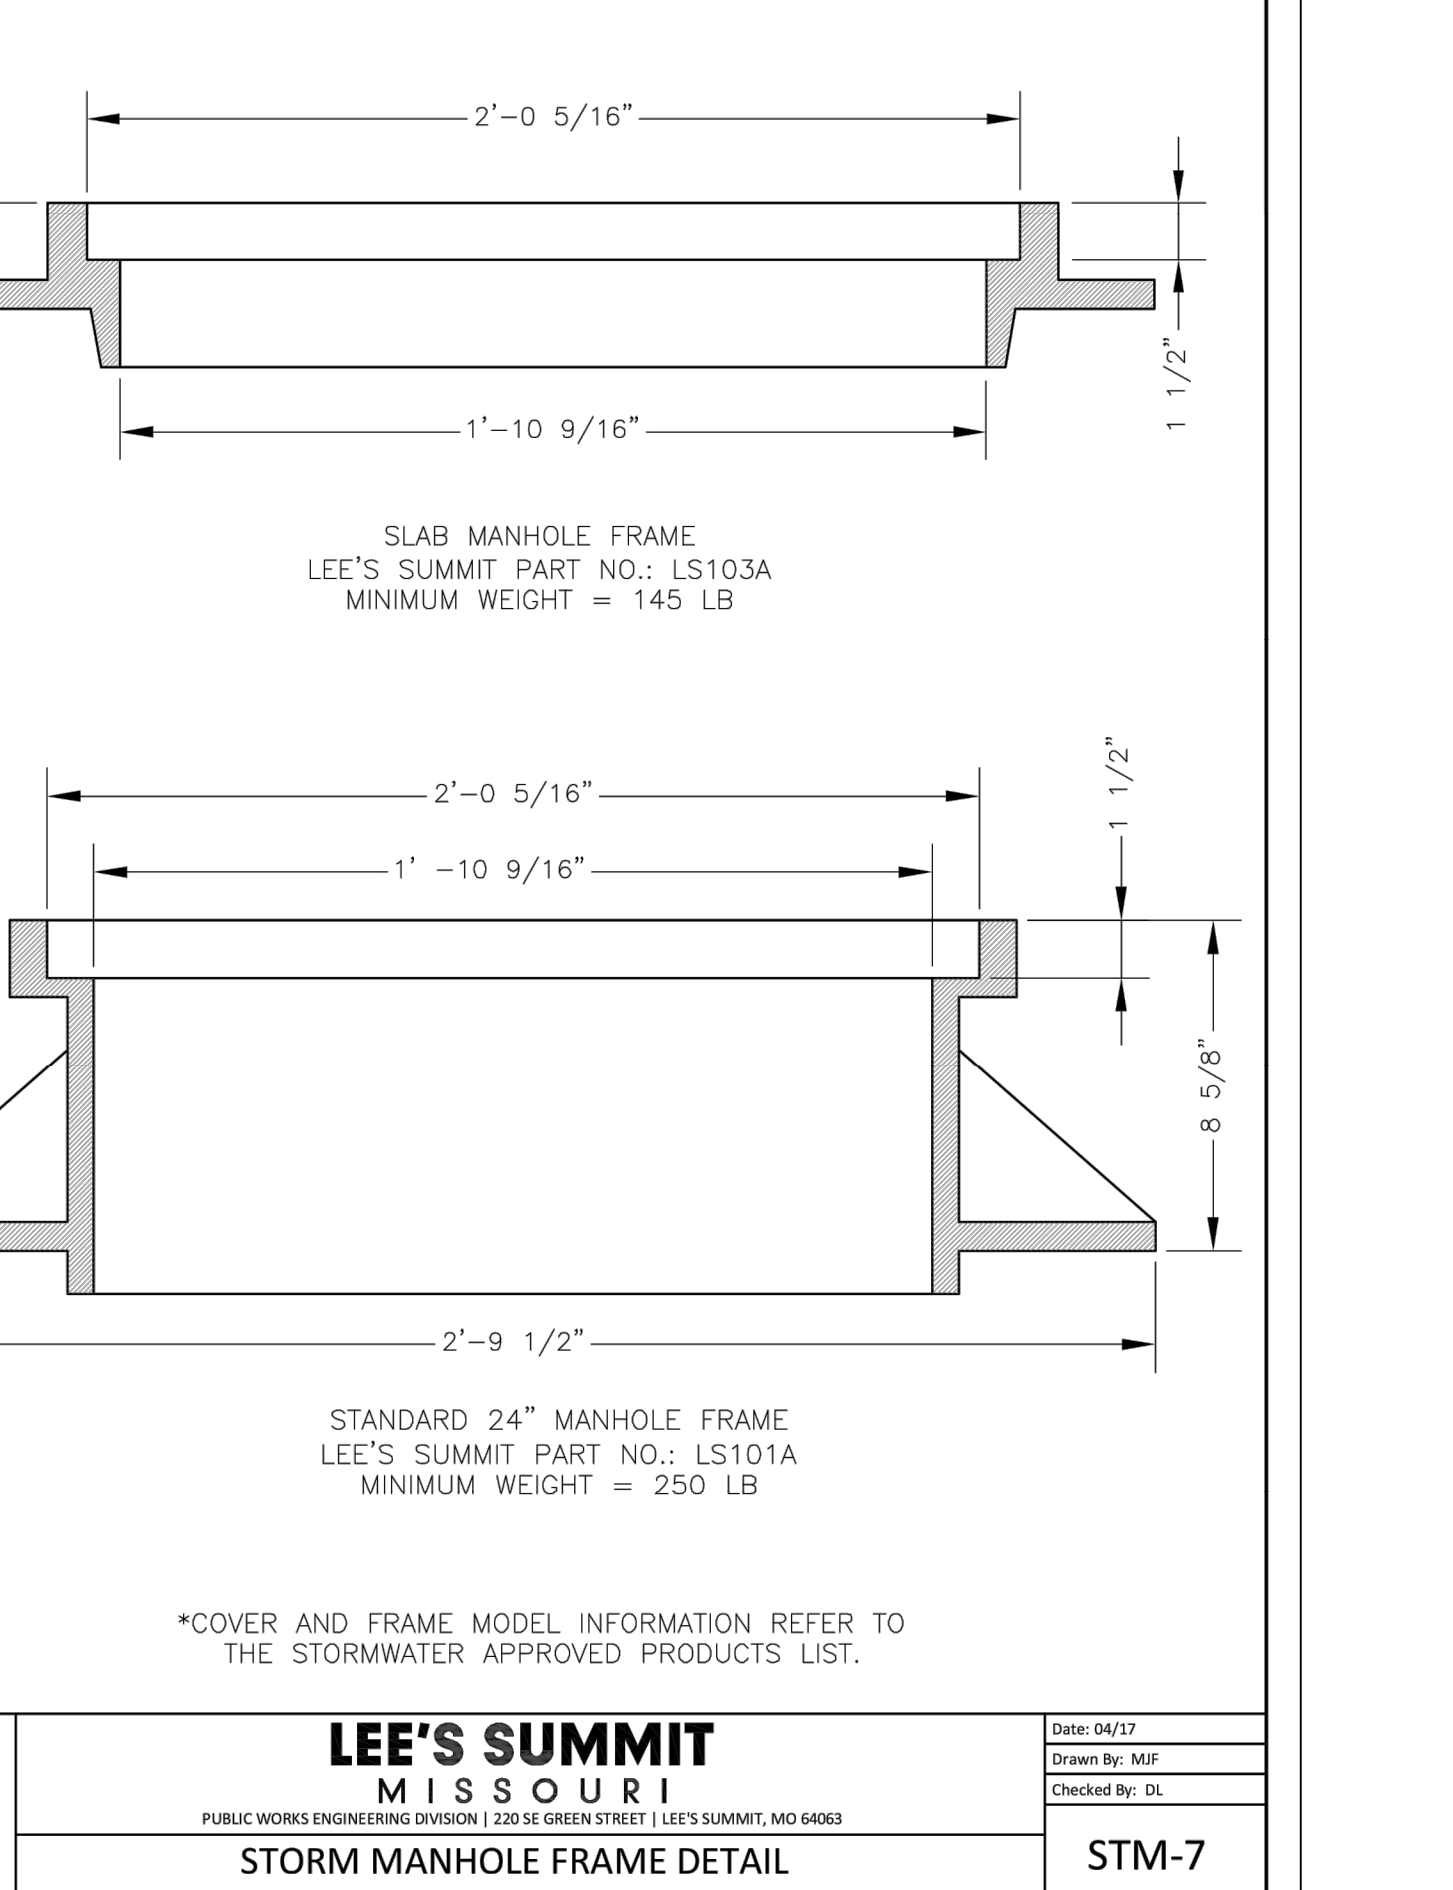


LEE'S SUMMIT MISSOURI
 PUBLIC WORKS ENGINEERING DIVISION | 220 SE GREEN STREET | LEE'S SUMMIT, MO 64083

FIELD INLET DETAIL

Drawn By: MIF
 Checked By: DL
 Date: 04/17
 Title: STM-10
 Pkg. #

STM-10

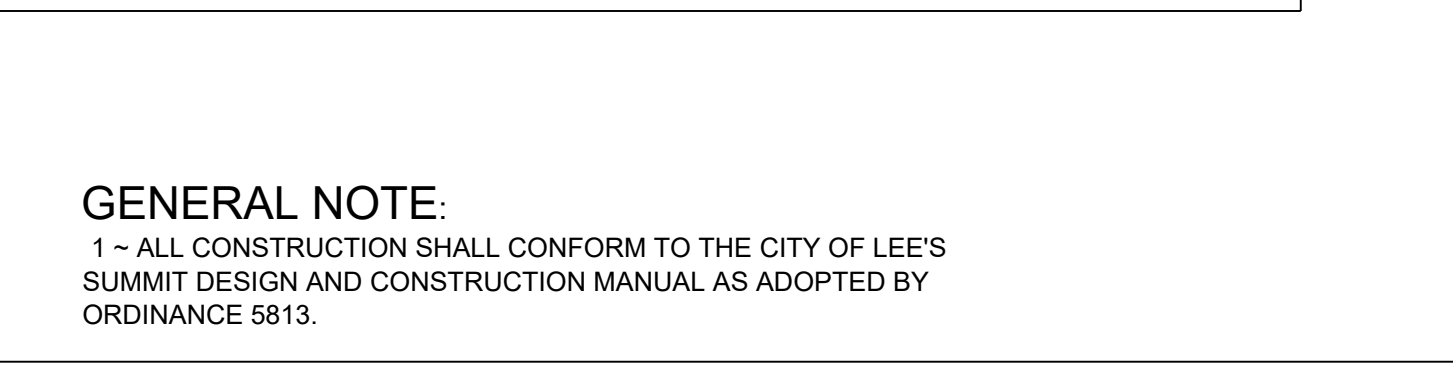

LEE'S SUMMIT MISSOURI
 PUBLIC WORKS ENGINEERING DIVISION | 220 SE GREEN STREET | LEE'S SUMMIT, MO 64083

FIELD INLET DETAIL

Drawn By: MIF
 Checked By: DL
 Date: 04/17
 Title: STM-11
 Pkg. #

STM-11