

LOT 7, BUILDING 31

420 SW Longview Blvd
Lee's Summit, MO 64081

PERMIT SET



GENERAL NOTES

- GENERAL CONTRACTOR AND ALL OTHER CONTRACTORS WORKING ON THIS CONSTRUCTION PROJECT SHALL MEET ALL APPLICABLE CODE REQUIREMENTS. ALL CONSTRUCTION AND MATERIALS SHALL COMPLY WITH ANY AND ALL APPLICABLE CODES, REGULATIONS, DIRECTIVES AND LAWS. CONTRACTOR SHALL BE KNOWLEDGEABLE OF ALL CITY REGULATIONS AND CODE ISSUES AND SHALL IMMEDIATELY NOTIFY THE ARCHITECT UPON DISCOVERY OF ANY DISCREPANCIES ON THE DOCUMENTS OR CONDITIONS OF THE PROJECT SITE.
- SUBSTANTIAL COMPLETION SHALL BE ESTABLISHED ON DELIVERY OF OCCUPANCY PERMIT. FINAL COMPLETION SHALL BE DEEMED COMPLETED WHEN ALL PUNCH LIST ITEMS ARE COMPLETED AND APPROVED. ALL SUPPORT EQUIPMENT INSTALLED AND COMPLETE. OWNER WILL DETERMINE FINAL COMPLETION.
- THE RESPONSIBILITIES CONCERNING THE PREPARATION AND REVIEW OF THE APPLICATION FOR PAYMENT AND PAYMENT SCHEDULE SHALL BE ADDRESSED IN THE AGREEMENTS BETWEEN THE OWNER, ARCHITECT, AND CONTRACTOR.
- THE ARCHITECT WILL BE AVAILABLE TO THE OWNER AND CONTRACTOR DURING CONSTRUCTION. THE ARCHITECT WILL ASSIST THE OWNER AND/OR CONTRACTOR IN OBTAINING A BUILDING PERMIT.
- THE CONTRACTOR IS SOLELY RESPONSIBLE FOR THE CONSTRUCTION PROCESS, MATERIAL VERIFICATION, AND WORKER SAFETY.
- THE CONTRACTOR SHALL VERIFY AND BE RESPONSIBLE FOR DETAILS AND ACCURACY, FOR CONFIRMING AND CORRELATING ALL QUANTITIES AND DIMENSIONS, AND FOR TECHNIQUES OF ASSEMBLY.
- ALL CUTTING AND PATCHING SHALL BE PERFORMED IN A NEAT AND WORKMAN LIKE MANNER. ANY EXISTING FINISHES DISTURBED OR DAMAGED BY THE CONTRACTOR OR TRADES UNDER CONTRACT DURING THE COURSE OF THE WORK SHALL BE REPAIRED TO MATCH EXISTING.
- NO SUBSTITUTES OF SPECIFIED CONSTRUCTION ITEMS, EQUIPMENT AND FINISHES WILL BE ALLOWED WITHOUT WRITTEN APPROVAL FROM THE OWNER AND ARCHITECT.
- ALL BIDDING CONTRACTOR(S) SHALL VISIT THE SITE OF THE PROPOSED WORK AND FULLY ACQUAINT THEMSELVES WITH THE EXISTING CONDITIONS OF THE PROJECT SITE, AS THEY CURRENTLY EXIST, SO THEY MAY FULLY UNDERSTAND THE FACILITIES, DIFFICULTIES AND RESTRICTIONS PRIOR TO SUBMITTING ANY BIDS.
- THE CONTRACTOR SHALL PROVIDE THE OWNER WITH SCHEDULING INFORMATION PRIOR TO CONSTRUCTION, WHICH WILL BE UPDATED IF THERE ARE ANY CHANGES.
- ALL REQUIRED COMMUNICATION SHALL BE THROUGH THE ARCHITECT AND OWNER.
- DO NOT SCALE DRAWINGS. THE CONTRACTOR SHALL VERIFY AND BE RESPONSIBLE FOR ALL DIMENSIONS AND CONDITIONS ON THE JOBSITE. INFORMATION CONTAINED IN THESE DRAWINGS IS GENERAL AND NOT BASED ON EXISTING DOCUMENTS AND FIELD MEASUREMENTS. THE INFORMATION CONTAINED HEREIN MAY REQUIRE ADJUSTMENTS OR MODIFICATIONS TO CONFORM TO EXISTING CONDITIONS AND DESIGN INTENT OF DOCUMENTS. THE CONTRACTOR MUST NOTIFY ARCHITECT OF ANY CONFLICTS AND/OR VARIATIONS.
- CONTRACTOR SHALL FURNISH & INSTALL ALL ITEMS SHOWN ON THE DRAWINGS UNLESS SPECIFICALLY NOTED OTHERWISE.
- ALL CONTRACTORS SHALL GUARANTEE ALL WORK EXECUTED UNDER THIS CONTRACT, BOTH AS TO MATERIAL AND WORKMANSHIP, FOR A PERIOD OF TWELVE MONTHS AFTER DATE OF SUBSTANTIAL COMPLETION. IN ADDITION, ANY DAMAGE TO ADJACENT AREAS/SURFACES CAUSED BY FAULTY MATERIALS OR WORKMANSHIP SHALL ALSO BE REPAIRED TO THE OWNER'S SATISFACTION AT NO ADDITIONAL COST.
- CONTRACTOR TO INSTALL ALL MATERIAL PER MANUFACTURERS' REQUIREMENTS, UL RATING REQUIREMENTS, SPECIFIC TRADE GUIDELINES, INDUSTRY STANDARDS, AND BUILDING CODES. ALL NEW FINISHES TO COMPLY WITH IBC CHAPTER 8.
- PROVIDE SIGNAGE MEETING ADA REQUIREMENTS AND LOCATIONS DICTATED BY THE CITY AND LOCAL CODES. DESIGN, CONTENT, AND LOCATIONS SHALL BE PROVIDED TO THE OWNER AND ARCHITECT PRIOR TO INSTALLATION.
- THE CONTRACTOR MUST SUBMIT TO OWNER AN INSURANCE CERTIFICATE WITH MINIMUM COVERAGE OF \$1,000,000 IN GENERAL LIABILITY OR EQUAL. THIS CERTIFICATE MUST NAME THE OWNER AS ADDITIONAL INSURED.
- ALL CHANGES, DEVIATIONS, MODIFICATIONS, ADDITIONS OR DELETIONS FROM THE CONTRACT OF CONSTRUCTION OF APPROVED ARCHITECTURAL PLANS SHALL BE APPROVED BY THE OWNER AND ARCHITECT.
- DIMENSIONS ARE FROM OUTSIDE FACE OF FULL BED MASONRY, OR FROM FACE OF MTL STUD ON ALL OTHER MATERIALS, UNLESS NOTED OTHERWISE. (THIN BRICK & THIN STONE VENEERS ARE DIMENSIONED TO FACE OF STUD).
- CONTRACTOR SHALL BE RESPONSIBLE FOR CLEANING ALL INTERIOR SURFACES AND EXTERIOR DEBRIS SPECIFIC TO CONSTRUCTION ACTIVITIES PRIOR TO OCCUPANCY OF THE SPACES BY THE OWNER. ADDITIONAL CLEANING FOLLOWING THE RECONCILIATION OF PUNCHLIST ITEMS SHALL ALSO BE INCLUDED. FINAL CLEANUP SHALL CONSIST OF THE FOLLOWING:
 - REMOVE ALL CONSTRUCTION DEBRIS, UNUSED MATERIALS, TOOLS, ETC.
 - CLEAN INTERIOR AND EXTERIOR SURFACES OF STOREFRONT GLASS AND FRAMES
 - CLEAN ALL FLOORS
 - REPLACE ALL FILTER MEDIA IN HVAC SYSTEMS

LOCATOR PLAN



DRAWING SYMBOLS

WALL SECTION		CONSTRUCTION KEYNOTE	
ELEVATION MARKS (EXTERIOR // INTERIOR)		GLAZING FRAME MARK	
ELEVATION MARKS (EXTERIOR // INTERIOR)		GLAZING MARK	
REVISION MARK + CLOUD		DOOR MARK	
ROOM TAG		WINDOW MARK	
ELEVATION MARK		WALL PARTITION TYPE	
		FLOOR TRANSITION	
		EXISTING PARTITION	
		NEW PARTITION	
		DEMOLITION PARTITION	

PROJECT TEAM


OWNER: BOX REAL ESTATE DEVELOPMENT 3175 SW Rockbridge Dr Lee's Summit, MO 64081 CONTACT: RUSSELL PEARSON P: 816 589 4415 E: russell@boxai-heartland.com	CONTRACTOR: TBD	ARCHITECTURAL: CLOCKWORK 423 DELAWARE ST, SUITE 102 KANSAS CITY, MO 64105 CONTACT: JEFF WINDMEYER P: 660 815 1316 E: jeff@clockwork-ad.com
MEP: JSC ENGINEERS 1901 NW Blue Pkwy tower-3rd floor Unity Village, MO 64065 CONTACT: JUSTIN SMOTHERS P: 816 273 5289 E: jsmothers@jscengineers.com	STRUCTURAL: STAND STRUCTURAL ENGINEERING, INC. 8234 ROBINSON ST OVERLAND PARK, KS 66204 CONTACT: JOHN FUNK P: 913 214 2169 E: jfunk@stand-sei.com	CIVIL: SCHLAGEL ASSOCIATES 14920 W. 107TH ST. LENEXA, KS 66215 CONTACT: JEFFREY SKIDMORE P: 913 492 2158 E: js@schlagelassociates.com

SHEET INDEX

GENERAL	TITLE SHEET
A000	TITLE SHEET
A001	CODE PLANS & ANALYSIS
CIVIL	
C1.0	SITE PLAN
C2.0	GRADING PLAN
C3.0	STORM SEWER PLAN & PROFILE
C4.0	SITE UTILITY PLAN
C5.0	EROSION CONTROL PLAN
C6.0	EROSION CONTROL DETAILS
C7.0	SIDEWALK & CURB DETAILS
C8.0	PAVEMENT DETAILS
C9.0	STORM SEWER DETAILS
C10.0	UTILITY DETAILS
LANDSCAPE	
L1.0	LANDSCAPE PLAN
ARCHITECTURAL	
A5100	ARCHITECTURAL SITE PLAN
A210	DOOR SCHEDULE & WALL TYPES
A101	FLOOR PLANS
A110	ROOF PLAN
A111	ROOF PLAN DETAILS
A200	EXTERIOR ELEVATIONS
A201	EXTERIOR ELEVATIONS
A210	EXTERIOR IMAGERY
A300	BUILDING SECTIONS
A400	WALL SECTIONS
A401	WALL SECTIONS
A410	WALL SECTION DETAILS
A411	SERVICE ENCLOSURE DETAILS
STRUCTURAL	
S001	STRUCTURAL GENERAL NOTES
S030	TYPICAL DETAILS - CONCRETE
S040	TYPICAL DETAILS - MASONRY
S050	TYPICAL DETAILS - STEEL
S055	TYPICAL DETAILS - COLD FORMED
S100	FOUNDATION PLAN / SECOND FLOOR FRAMING PLAN
S102	ROOF FRAMING PLAN
S400	BRACED FRAME ELEVATIONS
S401	BRACED FRAME DETAILS
S500	FOUNDATION DETAILS
S510	FLOOR FRAMING SECTIONS
S520	ROOF FRAMING SECTIONS

MECH / PLUMB	
MP001	MECHANICAL & PLUMBING SPECS & SYMBOLS
MP101	MECHANICAL & PLUMBING PLANS
MP102	PLUMBING PLANS - WATER & GAS

ELECTRICAL	
E001	ELECTRICAL SPECS & SYMBOLS
E101	ELECTRICAL PLAN - LIGHTING
E102	ELECTRICAL PLAN - POWER
E201	ELECTRICAL DIAGRAMS & SCHEDULES
E202	ELECTRICAL DIAGRAMS & SCHEDULES

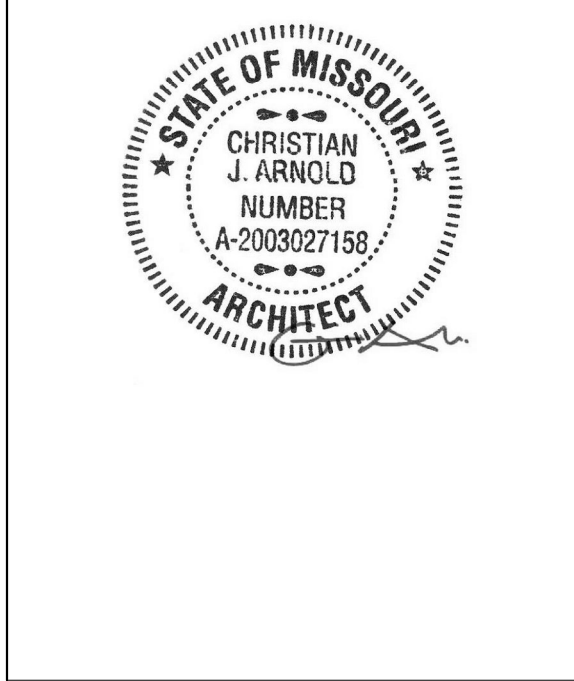


REV	ISSUE	DATE
2	Permit Submittal	05.17.2021
	Permit Review	08.19.2021

Design No. U419

May 28, 2020

Nonbearing Wall Ratings — 1, 2, 3 or 4 Hr (See Items 4 & 5 through 5K)

* Indicates such products shall bear the UL or cUL Certification Mark for jurisdictions employing the UL or cUL Certification (such as Canada), respectively.

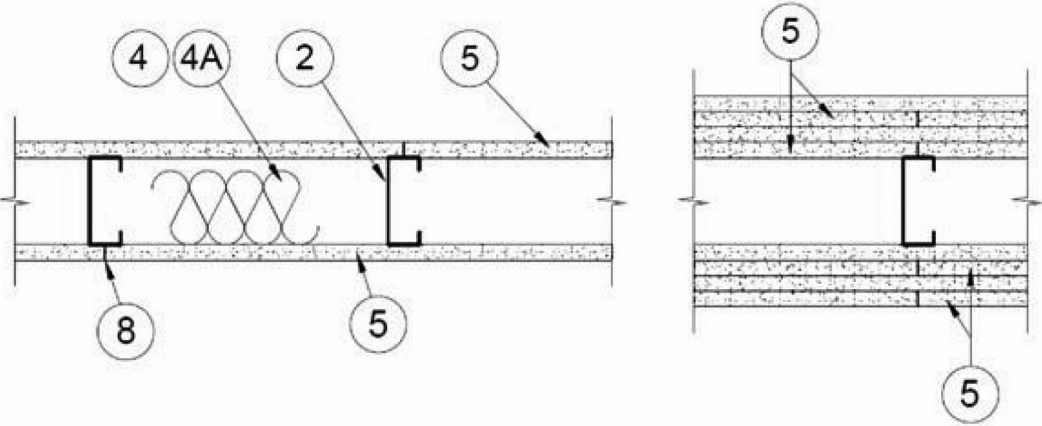

1. **Floor and Ceiling Runners** — (Not Shown) — For use with Item 2 — Channel shaped, fabricated from min 25 MSG corrosion-protected steel, min depth to accommodate stud size, with min 1-1/4 in. long legs, attached to floor and ceiling with fasteners 24 in. OC, max.

2. **Steel Studs** — Channel shaped, fabricated from min 25 MSG corrosion-protected steel, min depth as indicated in Item 5, spaced a max of 24 in. OC. Studs to be cut 3/8 to 3/4 in. less than assembly height.

3. **Wood Structural Panel Sheathing** — (Optional, For use with Item 5 Only) — (Not Shown) — 4 ft wide, 7/16 in. thick oriented strand board (OSB) or 15/32 in. (for structural 1 sheathing (plywood) complying with DCP P51 or P52, or APA Standard PRP-108, manufactured with exterior glue, applied horizontally or vertically to the steel studs. Vertical joints centered on studs, and staggered one stud space from wallboard joints. Attached to studs with flat-head self-drilling tapping screw with a min. head diam. of 0.292 in. at maximum 6 in. OC in the perimeter and 12 in. OC in the field. When used, gypsum panels attached over OSB or plywood panels and fastener lengths for gypsum panels increased by min. 1/2 in.

4. **Batts and Blankets*** — (Required as indicated under Item 5) — Mineral wool batts, friction fitted between studs and runners. Min nom thickness as indicated under Item 5.

4C. **Fiber, Sprayed*** — (Optional) and as an alternate to Batts and Blankets (Item 4B) where insulation is required - Spray applied granulated mineral fiber material. The fiber is applied with adhesives at a minimum density of 4.0 pcf to completely fill the wall cavity in accordance with the application instructions supplied with the product. See **Fiber, Sprayed** (CCAZ), **AMERICAN ROCKWOOL MANUFACTURING, LLC** — Type Rockwool Premium Plus

5. **Gypsum Board*** — Gypsum panels with beveled, square or tapered edges, applied vertically or horizontally. Vertical joints centered over studs and staggered one stud cavity on opposite sides of studs. Vertical joints in adjacent layers (multilayer systems) staggered one stud cavity. Horizontal joints need not be backed by steel framing. Horizontal edge joints and horizontal butt joints on opposite sides of studs need not be staggered. Horizontal edge joints and horizontal butt joints in adjacent layers (multilayer systems) staggered a min of 12 in. The thickness and number of layers for the 1 hr, 2 hr, 3 hr and 4 hr ratings are as follows:

Gypsum Board Protection on Each Side of Wall				
Rating, Hr	Min Stud Depth, in. Items 2, 2C, 2D, 2F, 2G, 2O	No. of Layers & Thickness of Panel	Min Thickness of Insulation (Item 4)	
1	3-1/2	1 layer, 5/8 in. thick	Optional	
1	2-1/2	1 layer, 1/2 in. thick	1-1/2 in.	
1	1-5/8	1 layer, 3/4 in. thick	Optional	
2	1-5/8	2 layers, 1/2 in. thick	Optional	
2	1-5/8	2 layers, 5/8 in. thick	Optional	
2	3-1/2	1 layer, 3/4 in. thick	3 in.	
3	1-5/8	3 layers, 1/2 in. thick	Optional	
3	1-5/8	2 layers, 3/4 in. thick	Optional	
3	1-5/8	3 layers, 5/8 in. thick	Optional	
4	1-5/8	4 layers, 5/8 in. thick	Optional	
4	1-5/8	4 layers, 1/2 in. thick	Optional	
4	2-1/2	2 layers, 3/4 in. thick	2 in.	

CGC INC — 1/2 in. thick Type C, IP-X2 or IPC-AR, WRC, 5/8 in. thick Type AR, C, IP-AR, IP-X1, IP-X2, IPC-AR, SCX, SHX, ULX, USGX or WRC, 3/4 in. thick Types IP-X3 or ULTRACODE

UNITED STATES GYPSUM CO — 1/2 in. thick Type C, IP-X2, IPC-AR, WRC, 5/8 in. thick Type AR, C, IP-AR, IP-X1, IP-X2, IPC-AR, SCX, SHX, ULX, USGX, WRC, FRX-C, IP-AR, IP-X2, IPC-AR, 3/4 in. thick Types IP-X3 or ULTRACODE

USG BORAL DRYWALL SFZ LLC — 1/2 in. Type C, 5/8 in. Types C, SCX, SGX, ULTRACODE

USG MEXICO S A DE CV — 1/2 in. thick Type C, IP-X2, IPC-AR or WRC, 5/8 in. thick Type AR, C, IP-AR, IP-X1, IP-X2, IPC-AR, SCX, SHX, WRC, WRX or 3/4 in. thick Types IP-X3 or ULTRACODE

When Item 7B, **Steel Framing Members*** is used, Nonbearing Wall Rating is limited to 1 Hr. Min stud depth is 3-1/2 in. min thickness of insulation (Item 4) is 3 in. and two layers of gypsum board panels (1/2 in. or 5/8 in. thick) shall be attached to furring channels as described in Item 6. One layer of gypsum board panels (1/2 in. or 5/8 in. thick) attached to opposite side of stud without furring channels as described in Item 6.

6. **Fasteners** — (Not Shown) — For use with Items 2 and 2F — Type 5 or 5-12 steel screws used to attach panels to studs (Item 2) or furring channels (Item 7). **Single layer systems:** 1 in. long for 1/2 and 5/8 in. thick panels or 1-1/4 in. long for 3/4 in. thick panels, spaced 8 in. OC when panels are applied horizontally, or 8 in. OC along vertical and bottom edges and 12 in. OC in the field when panels are applied vertically. **Two layer systems:** First layer: 1 in. long for 1/2 and 5/8 in. thick panels or 1-1/4 in. long for 3/4 in. thick panels, spaced 16 in. OC. Second layer: 1-5/8 in. long for 1/2 in., 5/8 in. thick panels or 2-1/4 in. long for 3/4 in. thick panels, spaced 16 in. OC with screws offset 8 in. from first layer. **Three layer systems:** First layer: 1 in. long for 1/2 in., 5/8 in. thick panels, spaced 24 in. OC. Second layer: 1-5/8 in. long for 1/2 in., 5/8 in. thick panels, spaced 24 in. OC. Third layer: 2-1/4 in. long for 1/2 in. thick panels or 2-5/8 in. long for 5/8 in. thick panels, spaced 24 in. OC. Fourth layer: 2-5/8 in. long for 1/2 in. thick panels or 3 in. long for 5/8 in. thick panels, spaced 12 in. OC. Screws offset min 6 in. from layer below. **Four layer systems:** First layer: 1 in. long for 1/2 in., 5/8 in. thick panels, spaced 24 in. OC. Second layer: 1-5/8 in. long for 1/2 in., 5/8 in. thick panels, spaced 24 in. OC. Third layer: 2-1/4 in. long for 1/2 in. thick panels or 2-5/8 in. long for 5/8 in. thick panels, spaced 24 in. OC. Fourth layer: 2-5/8 in. long for 1/2 in. thick panels or 3 in. long for 5/8 in. thick panels, spaced 12 in. OC. Screws offset min 6 in. from layer below.

7. **Furring Channels** — (Optional, Not Shown, for single or double layer systems) — Resilient furring channels fabricated from min 25 MSG corrosion-protected steel, spaced vertically a max of 24 in. OC. Flange portion attached to each intersecting stud with 1/2 in. long Type 5-12 steel screws. Not for use with Item 5A.

7A. **Framing Members*** — (Optional on one or both sides, not shown, for single or double layer systems) — As an alternate to Item 7, furring channels and Steel Framing Members as described below:
a. **Furring Channels** — Formed of No. 25 MSG galv steel, 2-9/16 in. or 2-23/32 in. wide by 7/8 in. deep, spaced max. 24 in. OC, perpendicular to studs. Channels secured to studs as described in Item b. Gypsum board attached to furring channels as described in Item 6. Not for use with Item 5A.

b. **Steel Framing Members*** — Used to attach furring channels (Item 7Aa) to studs (Item 2). Clips spaced max. 48 in. OC. RSIC-1 and RSIC-1 (2.75) clips secured to studs with No. 8 x 1-1/2 in. minimum self-drilling, 5-12 steel screw through the center grommet. RSIC-V and RSIC-V (2.75) clips secured to studs with No. 8 x 9/16 in. minimum self-drilling, 5-12 steel screw through the center hole. Furring channels are friction fitted into clips. RSIC-1 and RSIC-V clips for use with 2-9/16 in. wide furring channels. RSIC-1 (2.75) and RSIC-V (2.75) clips for use with 2-23/32 in. wide furring channels.

PAC INTERNATIONAL L L C — Types RSIC-1, RSIC-V, RSIC-1 (2.75), RSIC-V (2.75).

7B. **Framing Members*** — (Optional, Not Shown) — As an alternate to Item 7, for single or double layer systems, furring channels and Steel Framing Members on only one side of studs as described below:

a. **Furring Channels** — Formed of No. 25 MSG galv steel, spaced 24 in. OC, perpendicular to studs. Channels secured to studs as described in Item b. Batts and Blankets placed in stud cavity as described in Item 5. Two layers of gypsum board attached to furring channels as described in Item 5. Not for use with Item 5A.

7C. **Framing Members*** — (Optional on one or both sides, not shown, for single or double layer systems) — As an alternate to Item 7, furring channels and Steel Framing Members as described below:

a. **Furring Channels** — Formed of No. 25 MSG galv steel, 2-23/32 in. wide by 7/8 in. or 1-1/2 in. deep, spaced max. 24 in. OC, perpendicular to studs. Channels secured to studs as described in Item b. Gypsum board attached to furring channels as described in Item 6. Not for use with Item 5A.

b. **Steel Framing Members*** — Used to attach furring channels (Item 7Ca) to studs (Item 2). Clips spaced max. 48 in. OC. Clips secured to studs with No. 8 x 1-1/2 in. minimum self-drilling, 5-12 steel screw through the center hole. Furring channels are friction fitted into clips.
CLARKDIETRICH BUILDING SYSTEMS — Type ClarkDietrich Sound Clip

8. **Joint Tape and Compound** — Vinyl or casen, dry or premixed joint compound applied in two coats to joints and screw heads of outer layers. Paper tape, nom 2 in. wide, embedded in first layer of compound over all joints of outer layer panels. Paper tape and joint compound may be omitted when gypsum panels are supplied with a square edge.

9. **Siding, Brick or Stucco** — (Optional, Not Shown) — Aluminum, vinyl or steel siding, brick veneer or stucco, meeting the requirements of local code agencies, installed over gypsum panels. Brick veneer attached to studs with corrugated metal ties attached to each stud with steel screws, not more than each sixth course of brick.

10. **Caulking and Sealants*** — (Optional, Not Shown) — A bead of acoustical sealant applied around the partition perimeter for sound control.
UNITED STATES GYPSUM CO — Type AS


Design No. U415

July 12, 2018

Nonbearing Wall Ratings — 1, 2, 3 or 4 Hr

* Indicates such products shall bear the UL or cUL Certification Mark for jurisdictions employing the UL or cUL Certification (such as Canada), respectively.

System A — 1 Hr.

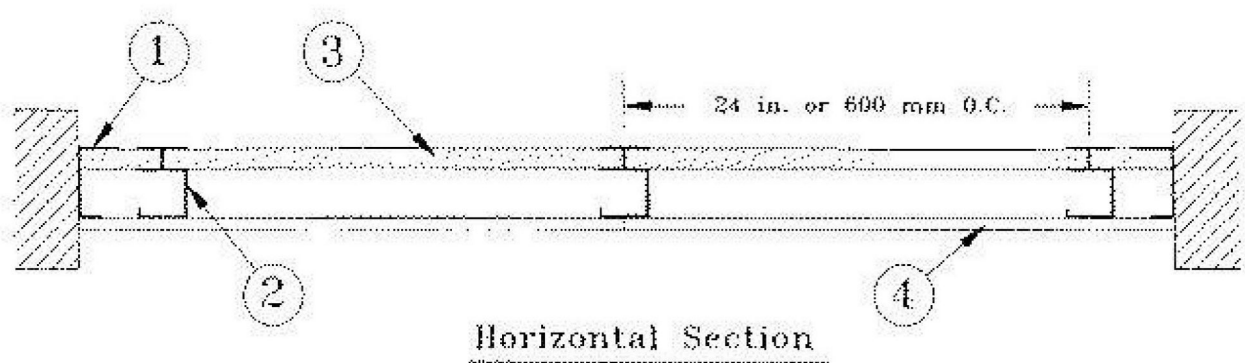

1. **Floor, Side and Ceiling Runners** — "J" - shaped runner, min 2-1/2 in. deep (min 4 in. deep when System C is used), with unequal legs of 1 in. and 2 in., fabricated from min 24 MSG (min 20 MSG when Item 4A, 4B, 4C, 4D or 7 are used) galv steel. Runners positioned with short leg toward finished side of wall. Runners attached to structural supports with steel fasteners located not greater than 2 in. from ends and not greater than 24 in. OC. "E" - shaped studs (Item 2A) may be used as side runners in place of "J" - shaped runners.

2. **Steel Studs** — "C" - shaped studs, min 2-1/2 in. deep (min 4 in. deep when System C is used), fabricated from min 25 MSG (min 20 MSG when Items 2B, 4A, 4B, 4C, 4D or 7 is used) galv steel. Cut to lengths 3/8 to 1/2 in. less than floor-to-ceiling height and spaced 24 in. or 600 mm OC (max 16 in. OC when Items 4A, 4B, 4C, or 4D are used).

3. **Gypsum Board*** — Gypsum liner panels, nom 1 in. thick, 24 in. or 600 mm (for metric spacing) wide. Panels cut 1 in. less in length than floor to ceiling height. Vertical edges inserted in "H" portion of "C" - shaped studs or the gap between the 3/4 in. legs of the "E" studs. Free edge of end panels attached to long leg of vertical "J" - runners with 1-5/8 in. long Type 5 steel screws spaced not greater than 12 in. OC. When wall height exceeds liner panel length, liner panel may be butt jointed to extend to the full height of the wall. Horizontal joints need not be backed by steel framing. In System 1, butt joints in liner panels are staggered min 36 in. Butt joints backed with 6 in. by 22 in. strips of 3/4 in. thick gypsum wallboard (Item 4). Wallboard strips centered over both joints and secured to liner panels with six 1-1/2 in. long Type 5 steel screws, three screws along the 22 in. dimension at the top and bottom of the strips.

CGC INC — Type SLX

UNITED STATES GYPSUM CO — Type SLX

USG BORAL DRYWALL SFZ LLC — Type SLX

USG MEXICO S A DE CV — Type SLX

4. **Gypsum Board*** —

System A — 1 Hr.

Gypsum panels, with beveled, square or tapered edges, nom 5/8 in. thick, 48 in. or 1200 mm wide, applied vertically or horizontally, attached to studs with 1 in. long Type 5 steel screws spaced 12 in. When installed vertically or 8 in OC when installed horizontally. Horizontal joints need not be backed by steel framing.

CGC INC — Types AR, C, IP-AR, IP-X1, IP-X2, IPC-AR, SCX, SHX, ULX, USGX, WRC, WRX

UNITED STATES GYPSUM CO — Types AR, C, FRX-G, IP-AR, IP-X1, IP-X2, IPC-AR, SCX, SGX, SHX, ULX, ULX, WRC, WRX, USGX. When ULX is used insulation, Item 5, **Batts and Blankets*** is required and minimum stud depth is 4 in.

USG BORAL DRYWALL SFZ LLC — Types C, SCX, SGX, USGX

USG MEXICO S A DE CV — Types AR, C, IP-AR, IP-X1, IP-X2, IPC-AR, SCX, SHX, ULX, USGX, WRC, WRX

Gypsum panels, with beveled, square or tapered edges, nom 3/4 in. thick, 4 ft wide (or 1200 mm for metric spacing), wallboard with square or tapered edges. Total of four layers to be used. First and second (inner) layers applied vertically or horizontally over the steel studs. Horizontal joints need not be backed by steel framing. When applied vertically, joints centered over studs and staggered min 12 in. When applied horizontally, all joints staggered min 12 in. First layer secured to studs with 1-1/4 in. long Type 5 self-drilling, self-tapping bugle-head steel screws spaced 24 in. OC. Second layer secured to studs with 2-1/4 in. long Type 5 self-drilling, self-tapping bugle-head steel screws spaced 12 in. OC. Third layer applied vertically over the furring channels (Item 2C) with a 1-1/4 in. long Type 5 self-drilling, self-tapping bugle-head steel screws spaced 12 in. OC. Fourth layer applied vertically or horizontally with 2-1/4 in. long Type 5 self-drilling, self-tapping bugle-head steel screws spaced 12 in. OC. When applied vertically, joints to be staggered min 24 in. from third layer, otherwise all joints staggered min 12 in.

CGC INC — Types IP-X3 or ULTRACODE

UNITED STATES GYPSUM CO — Types IP-X3 or ULTRACODE

USG BORAL DRYWALL SFZ LLC — Type ULTRACODE

USG MEXICO S A DE CV — Types IP-X3 or ULTRACODE

5. **Joint Tape and Compound** — (Not Shown)

Systems A, B, C, E, F, G, H, I

Joints on outer layers of gypsum boards (Item 4 and 4A) covered with paper tape and joint compound. Paper tape and joint compound may be omitted when gypsum boards are supplied with square edges. Exposed screw heads covered with joint compound.

6. **Batts and Blankets*** —

(Optional) — Mineral wool or glass fiber batts partially or completely filling stud cavity. Any mineral wool or glass fiber batt mineral bearing the UL Classification Marking as to Fire Resistance.

System A With Type ULIX Gypsum Boards

Placed in stud cavities, any min. 3-1/2 in. thick glass fiber insulation bearing the UL Classification Marking as to Surface Burning Characteristics and/or Fire Resistance. See **Batts and Blankets (BWN or BZJ) Categories** for names of Classified companies.

AER-09038

One Hour Corridor Ceiling or Underside Stair Applications. See Figure 8

1. A minimum 2-1/2 in. deep 24 gauge J-runner attached horizontally to perimeter or boundary walls with a power actuated fasteners.

2. Gypsum Wall Board:

a. For a one (1) hour assembly: Attach one (1) layer of 5/8-in thick SHEETROCK® Brand FIRECODE® Core Gypsum Panel (Type X), to the underside of the "Corridor Ceiling" of the C-H stud and the perimeter J-runners. Use 1-in long Type 6 screws that are spaced 12-in o.c. in the field and at the edges.

3. Install the C-H studs perpendicular to the J-runner spaced 24-in o.c. with the C-section of the C-H stud facing downward towards the corridor side of the assembly with two (2) screws a minimum 1/2-in long Type 5-12 screws, one on each side.

4. 1-in thick SHEETROCK® Brand Gypsum Liner Panel - Friction-fitted in "H" portion of C-H studs.

5. Roper Board:


a. Where the liner panel (Item 4) is cut short to be installed, gaps must be filled by using a strip of 1-in thick SHEETROCK® Brand Gypsum Liner Panel.

b. As an alternative you can use mineral fiber insulation to prevent exposure to the top leg of the J-runner that forms the ceiling.

c. Where the wall section extends above the corridor ceiling, above corridor height a rip of board must be used to cap the opening between studs and a strip of mineral fiber insulation as described in Item 6 must be used.

6. In order to prevent the passage of heat and gases, a 1/2-in long strip of mineral fiber insulation must be used to fill in the stud cavity of the walls.

1 Hour Corridor Assembly

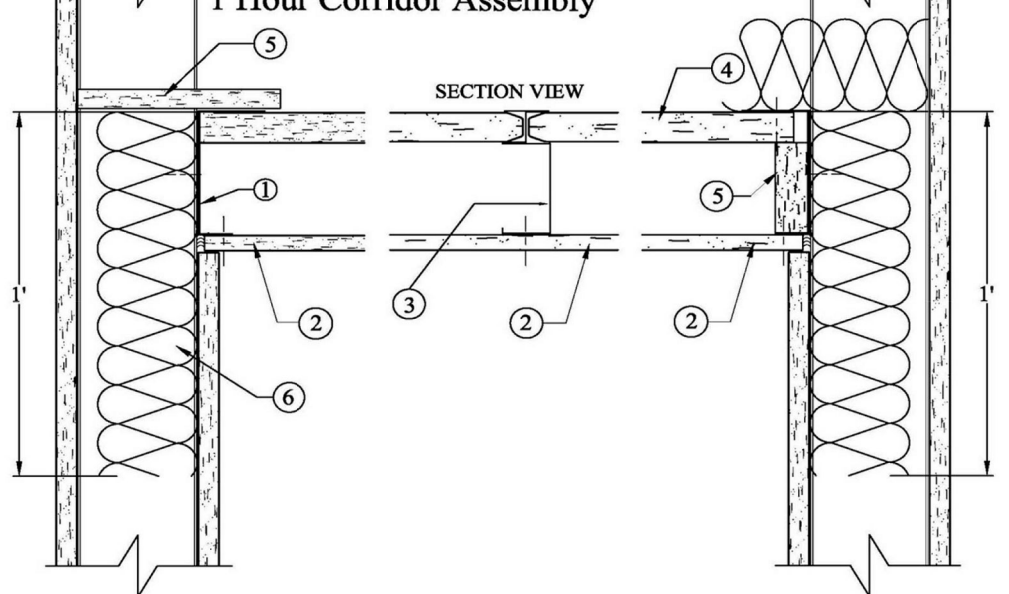

1-Hour Exit Corridor Ceiling and Stair Soffits*		
Single layer 5/8-in gypsum panels	Maximum Span	
212CH20-18"	8-ft - 6-in	
212CH20-34"	10-ft - 4-in	
400CH25-18"	8-ft - 3-in	
400CH20-34"	14-ft - 11-in	
600CH20-34"	20-ft - 10-in	

Notes:
1. Based on L/240 allowable deflection with studs at 24-in o.c. and JRD4 runner.
2. J-Runner connection to wall/soffit must meet or exceed 180-lbs capacity at every stud location (24-in o.c.).
3. J-Runner connection to wall/soffit must meet or exceed 360-lbs capacity at every stud location (24-in o.c.).

Figure 8 - One Hour Corridor Ceiling or Underside Stair Assembly and Limiting Spans

Page 8 of 11

Design No. U905


March 02, 2020

Bearing Wall Rating — 2 HR.

Nonbearing Wall Rating — 2 HR

This design was evaluated using a load design method other than the Limit States Design Method (e.g., Working Stress Design Method). For jurisdictions employing the Limit States Design Method, such as Canada, a load restriction factor shall be used — See Guide BXUV or BXUV7

* Indicates such products shall bear the UL or cUL Certification Mark for jurisdictions employing the UL or cUL Certification (such as Canada), respectively.

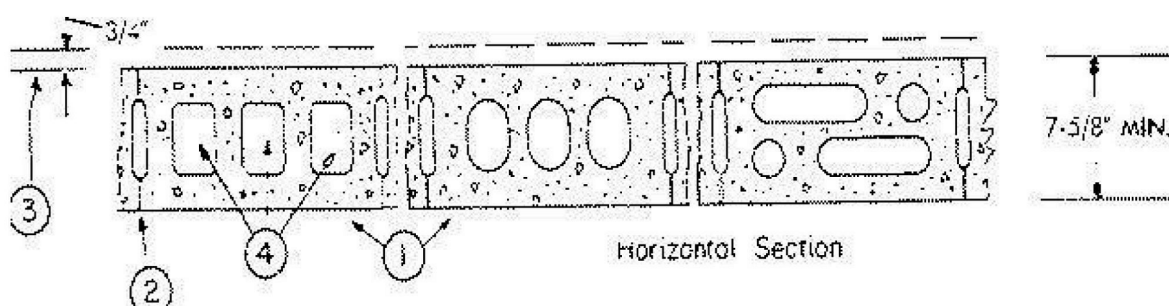

1. **Concrete Blocks*** — Various designs. Classification D-2 (2 hr).

See **Concrete Blocks** category for list of eligible manufacturers.

2. **Mortar** — Blocks laid in full bed of mortar, nom 3/8 in. thick, of not less than 2-1/4 and not more than 3-1/2 parts of clean sharp sand to 1 part Portland cement (proportioned by volume) and not more than 50 percent hydrated lime (by cement volume). Vertical joints staggered.

3. **Portland Cement Stucco or Gypsum Plaster** — Add 1/2 hr to classification if used. Where combustible members are framed in wall, plaster or stucco must be applied on the face opposite framing to achieve a max. Classification of 1-1/2 hr. Attached to concrete blocks (Item 1).

4. **Loose Masonry Fill** — If all core spaces are filled with loose dry expanded slag, expanded clay or shale (Rotary Kilm Process), water repellent vermiculite masonry fill insulation, or silicone treated perlite loose fill insulation add 2 hr to classification.

FLOOR-CEILING SYSTEMS, NONCOMBUSTIBLE

GA FILE NO. FC 1105


GENERIC

GYPSUM WALLBOARD, STEEL JOISTS, CONCRETE SLAB

One layer 1/2" type X gypsum wallboard or gypsum veneer base applied at right angles to 3/8" steel studs 24" o.c. with 1" Type S drywall screws 12" o.c. Studs were tied with double strand 15 gauge wire 8" o.c. to steel joists 24" o.c. supporting 3/8" re metal lath and 2 1/2" concrete slab. (One hour restrained and unrestrained.)

1 HOUR FIRE

50 to 54 STC SOUND

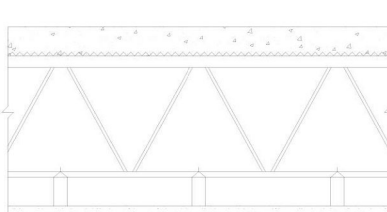

Approx. Ceiling Weight:
Fire Test:
Sound Test:

2 pcf
FM FC-134, 12-16-69
See FC-2030
(NSC 4075, 3-25-69)

CODE REVIEW

APPLICABLE CODES:
2018 International Building Code
2018 International Plumbing Code
2018 International Mechanical Code
2018 International Fire Code
2017 National Electrical Code
ICC/ANSI A117.1-2009, Accessible and Usable Buildings and Facilities

CHAPTER 3 USE AND OCCUPANCY CLASSIFICATION

BUSINESS, GROUP B

CHAPTER 5 GENERAL BUILDING HEIGHTS AND AREAS (TABLE 503)

GROUP: B
TYPE: IIB
ALLOWABLE HEIGHT: 55' ACTUAL: 34'
ALLOWABLE STORIES: 3 ACTUAL: 2
ALLOWABLE AREA: 23,000 ACTUAL: 6,175 SF

CHAPTER 6 TYPE OF CONSTRUCTION

IIB, UNPROTECTED

FIRE RESISTANCE RATING REQUIREMENTS FOR BUILDING ELEMENTS (IBC 601):

BUILDING ELEMENT	RATING
PRIMARY STRUCTURAL FRAME	0 HR
BEARING WALLS	
EXTERIOR	0 HR
INTERIOR	0 HR
NONBEARING WALLS	
EXTERIOR	0 HR
INTERIOR	0 HR
FLOOR CONSTRUCTION AND ASSOCIATED	0 HR
ROOF CONSTRUCTION AND ASSOCIATED	0 HR

FIRE RESISTANCE RATING REQUIREMENT FOR EXTERIOR WALLS BASED ON FIRE SEPARATION DISTANCE (IBC 602):
GROUP B X>30 0 HR

CHAPTER 7 FIRE AND SMOKE PROTECTION FEATURES

MAXIMUM AREA OF EXTERIOR OPENINGS (IBC 705.8)
FIRE SEPARATION DISTANCE DEGREE OF OPENING PROTECTION ALLOWABLE AREA
30' OR GREATER UNPROTECTED, NON-SPRINKLERED NO LIMIT

706 - FIRE WALLS:
706.1.1 PARTY WALLS, EXCEPTION 2:
PARTY WALLS ARE NOT REQUIRED WHERE THE COMBINED AREAS ON BOTH SIDES OF THE WALL ARE LESS THAN THE ALLOWABLE AREA BY CODE (IN THIS INSTANCE, THE WHOLE BUILDING FALLS UNDER THE ALLOWABLE AREA. THE INTENT IS TO HAVE SEPERATE OWNERSHIP OF EACH PORTION OF BUILDING).

CHAPTER 9 FIRE PROTECTION SYSTEMS

907 - FIRE ALARMS
907.2.2 GROUP B
FIRE ALARMS NOT REQUIRED AS THE BUILDING HAS FEWER THAN 500 TOTAL OCCUPANTS, AND THE LEVEL ABOVE HAS FEWER THAN 100 OCCUPANTS.

FIRE EXTINGUISHERS TO BE PROVIDED IN ACCORDANCE WITH THE IBC
NFPA 10 REQUIRED SMOKE DETECTORS TO BE PROVIDED
ALL PROVIDED AND INSTALLED BY GENERAL CONTRACTOR

CHAPTER 10 MEANS OF EGRESS

BUILDING AREAS AND OCCUPANT LOAD (IBC 1004):

BASED ON BUSINESS FUNCTION:
1 OCC PER 150 SF
ROOFTOP PATIO BASED ON ASSEMBLY WITHOUT FIXED SEATS
1 OCC PER 15 SF
AREAS AND OCCUPANCIES INDICATED ON PLAN

EXIT ANALYSIS:
GROUND LEVEL:
2 MEANS OF ACCESSIBLE EGRESS PROVIDED



1. CONTRACTOR TO COORDINATE ALL MEP AND STRUCTURAL REQUIREMENTS.
2. CONTRACTOR IS RESPONSIBLE FOR COORDINATING AND PROVIDING ALL
3. BLOCKING AS REQUIRED FOR KITCHEN EQUIPMENT, TENANT PROVIDED TV,
4. LIGHT FIXTURES, REFRIG. ROOM ACCESSORIES ETC.
5. CONFIRM DIMMERS AND SWITCHING WITH MEP
6. PROVIDE CONDUIT AND PULL STRING FOR IT/AV/SECURITY WORK AS
7. REQUIRED. COORDINATE WITH MEET AT 10:00 AM FOR SECURITY
8. WINDOWS ARE TO BE CENTERED UNLESS DIMENSIONED OTHERWISE.
9. EGRESS DOORS TO HAVE MINIMUM WIDTH 32" BETWEEN THE FACE OF
10. DOOR AND THE STOP WHEN OPEN 90°
11. ALL DIMENSIONS FROM FACE OF MASONRY UNIT WALLS, ARE FROM OUTER
12. FACE OF MASONRY. ALL DIMENSIONS FROM OTHER WALL TYPES, ARE FROM
13. FACE OF MLT STUD.



420 SW LONGVIEW BLVD
LEE'S SUMMIT, MO, 64081



EV	ISSUE	DATE
	Permit Submittal	05.17.2021
	Permit Review	08.19.2021

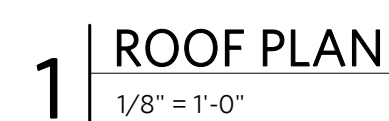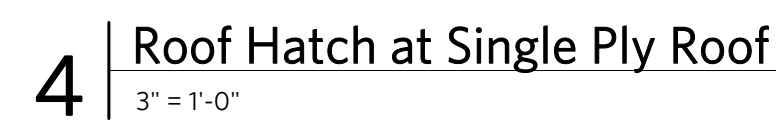

A. PROVIDE BOOTS AT ALL RTU'S AND SLEEVES AT ALL ROOF PENETRATIONS. INSTALL PER MANUFACTURERS INSTALLATION INSTRUCTIONS.

B. COORDINATE RTU CURB REINFORCEMENT WITH STRUCTURAL.

C. PROVIDE CRACK/LEAK (ISO OR EPS) AT HIGH SIDE OF ALL RTU'S.

D. PROVIDE MINIMUM INSULATION VALUES FOR CLIMATE ZONE PER GENERAL INFORMATION / CODE REVIEW.

E. AT PARAPET WALL CAP, PROVIDE ALUMINUM BRAKE METAL WALL CAP WITH CONTINUOUS 18 GAUGE ALUMINUM BRAKE ARCHITECTURAL SHEET METAL MANUFACTURE 2003 FIGURE 4A. COLOR PER EXTERIOR ELEVATIONS.

F. PROVIDE MINIMUM 48 MILS OF CONTACT GEL OR OTHER OR CORROSIVE SUBSTANCES. PROTECT AGAINST GALVANIC REACTION BY COATING CONTACT SURFACES WITH BUTYRUMICUS COATING.

G. PROVIDE 1/2" MINIMUM GAP BETWEEN SHEET METAL SEAM SEPARATION AS RECOMMENDED BY FABRICATOR OR MANUFACTURER OF DISMILLAR METALS.

H. PROVIDE INSTALLING MEMBRANE TO DIRECTLY ON CEMENTITIOUS OR WOOD SUBSTRATES. INSTALL A COURSE OF FELT UNDERLAYMENT AND COVER WITH A SLP SHEET OR INSTALL A POLYETHYLENE SHEET OVER THE FELT.

I. INSTALL SHEET METAL TRIM WITHOUT OIL CANNING, BUCKLING, AND TORN MARKS.

J. INSTALL SHEET METAL FLASHING AND TRIM TRUE TO LINE AND LEVELS INDICATED. PROVIDE UNIFORM, NEAT SEAMS WITH MINIMUM EXPOSURE OF SELDS. WELDS AND ELASTOMERIC SEALANT.


K. INSTALL SHEET METAL FLASHING AND TRIM TO FIT SUBSTRATE AND TO RESULT IN WATER TIGHT PERFORMANCE. VERIFY SHAPES AND DIMENSIONS OF SUBSTRATE TO BE COVERED BEFORE FABRICATING SHEET METAL.

420 SW LONGVIEW BLVD
LEE'S SUMMIT, MO, 64081




REV	ISSUE	DATE
	Permit Submittal	05.17.2021
	Permit Review	08.19.2021


A110

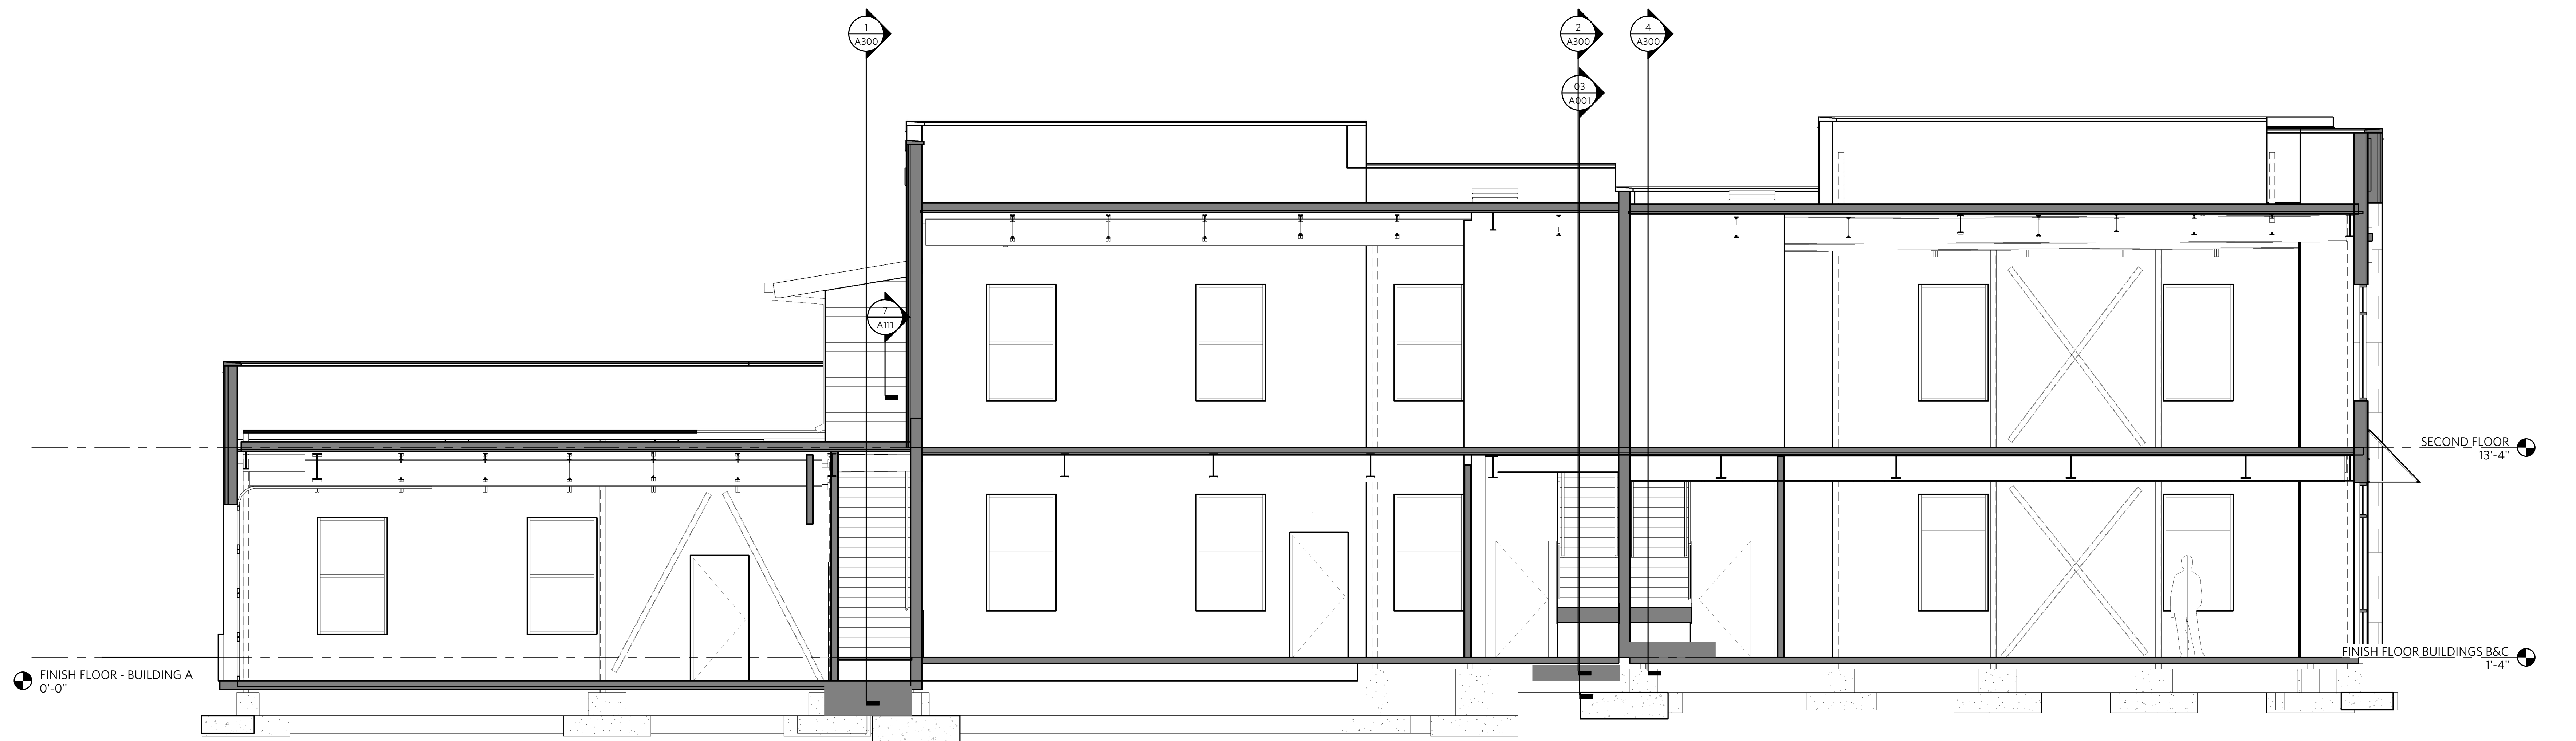


3 Section - Through Building
1/4" = 1'-0"

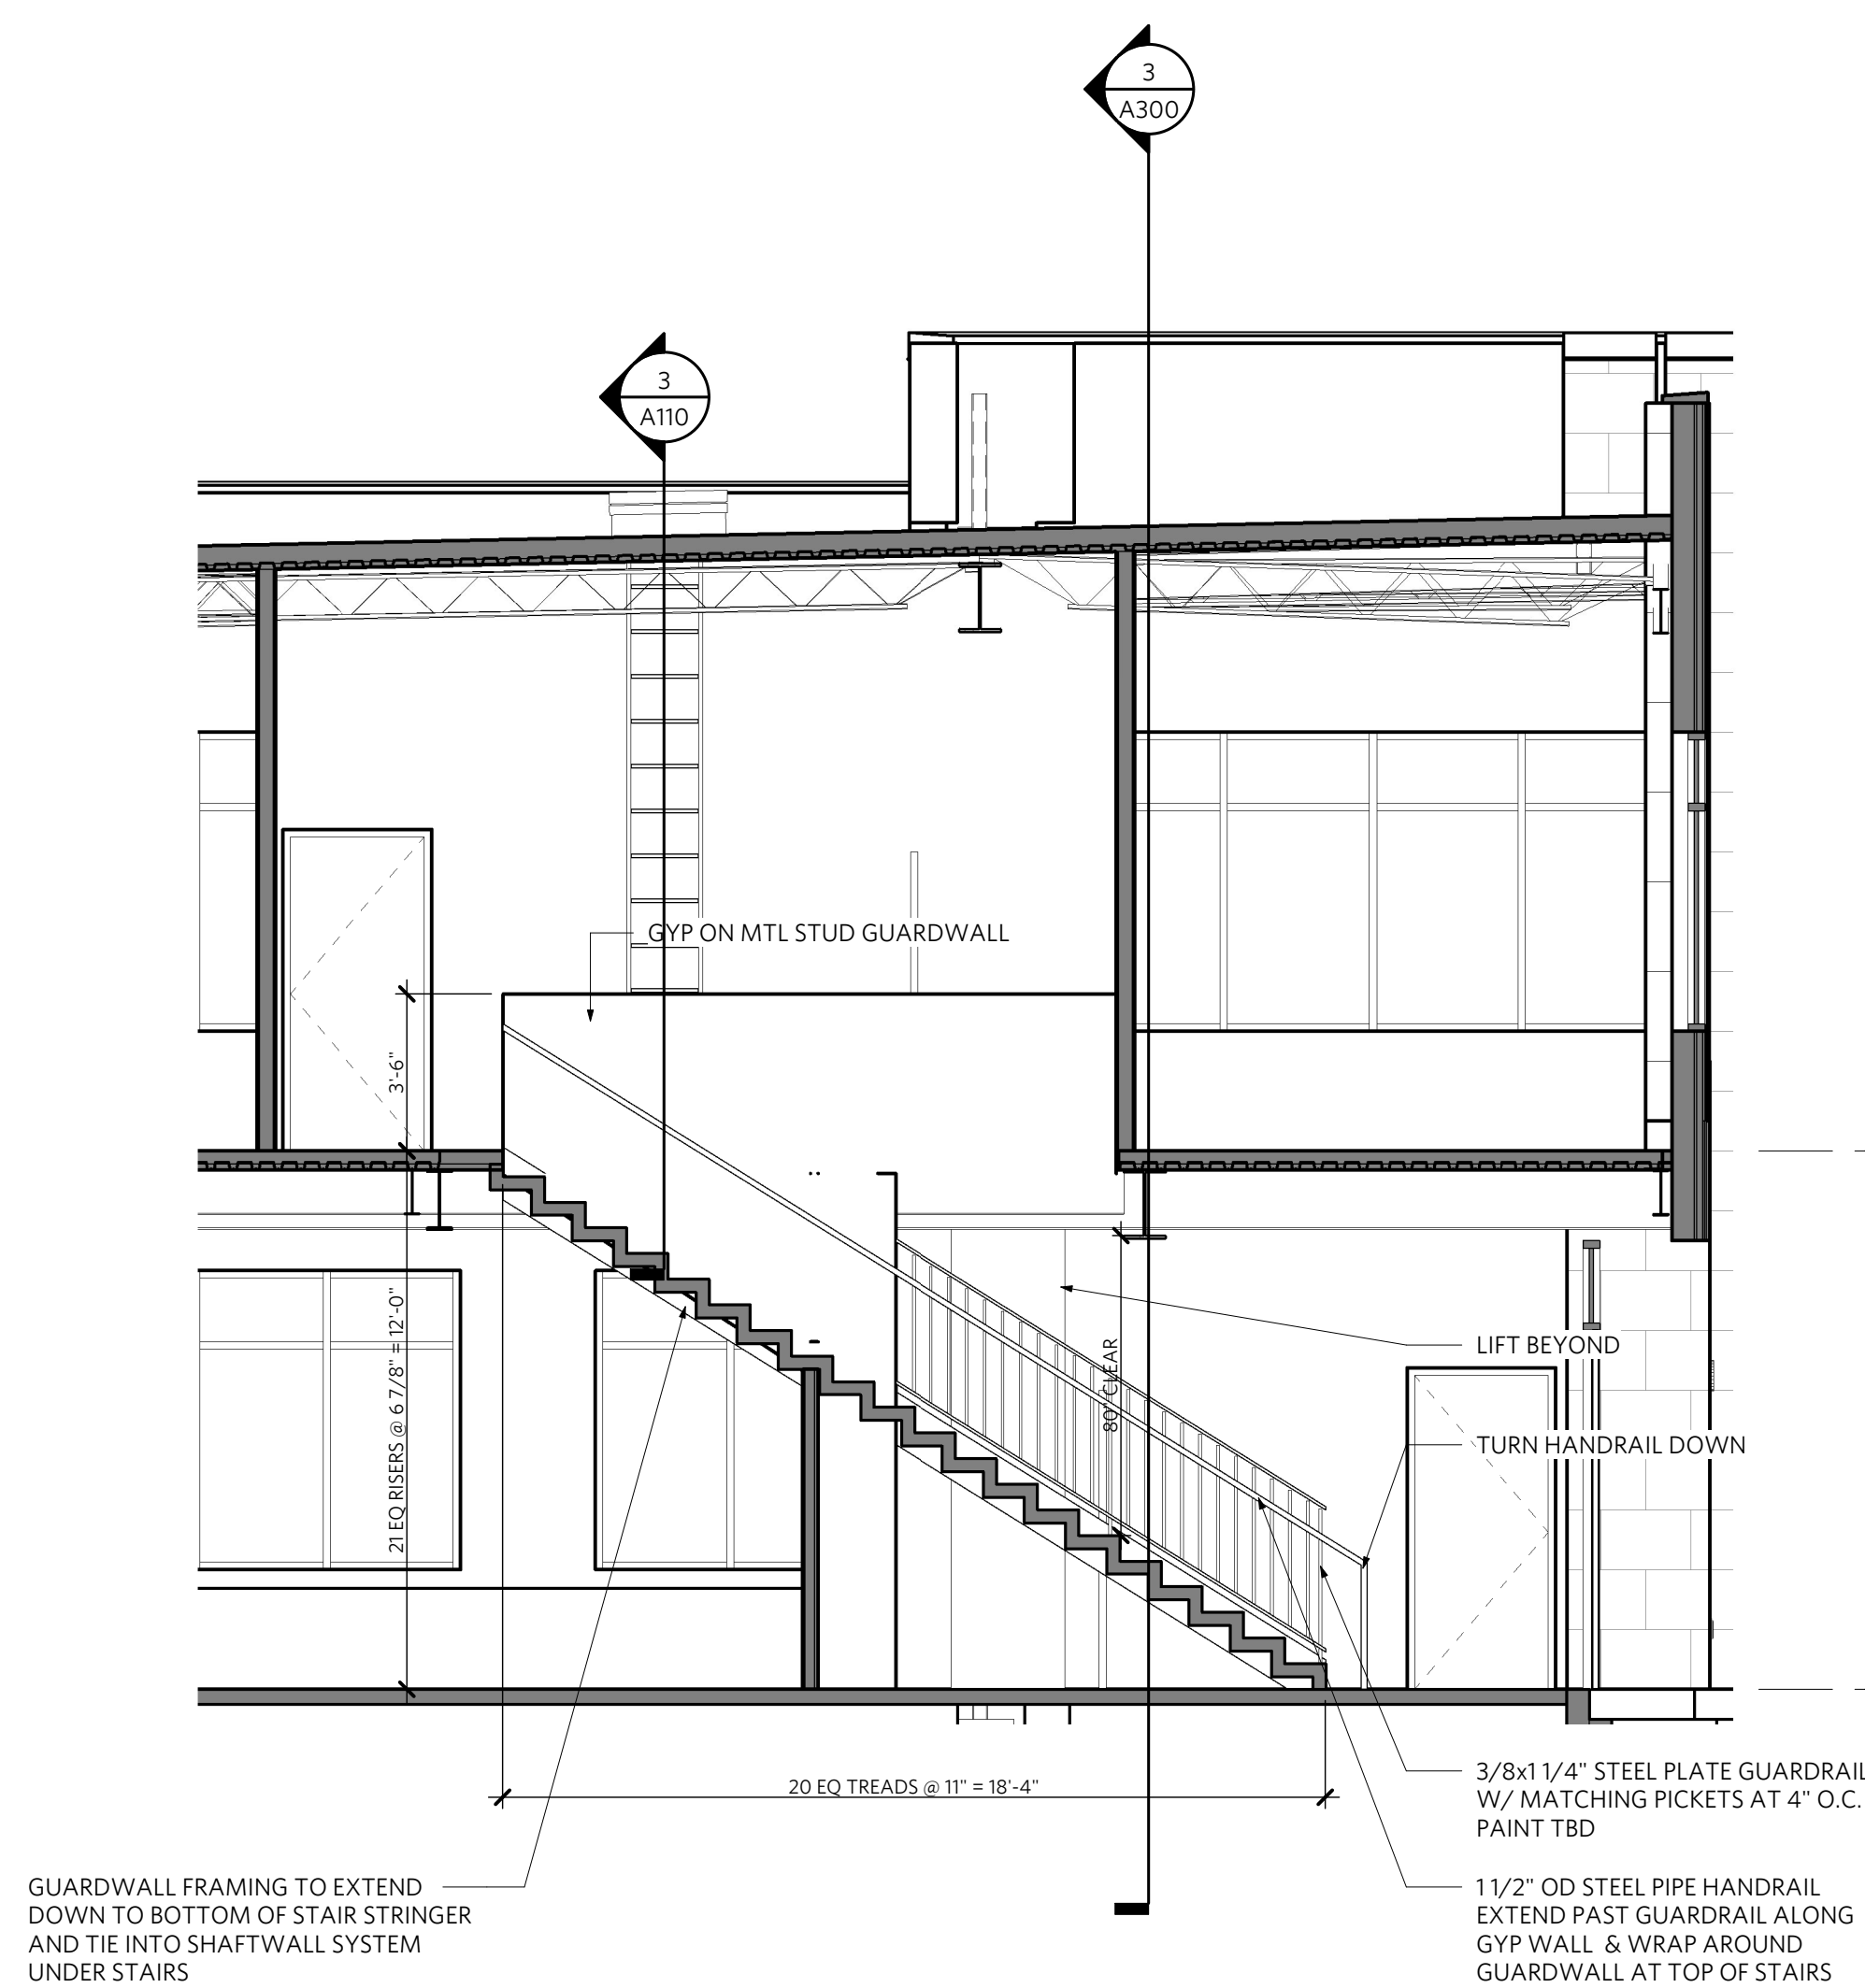

4 Section - Stair Access w/ Lift
1/4" = 1'-0"

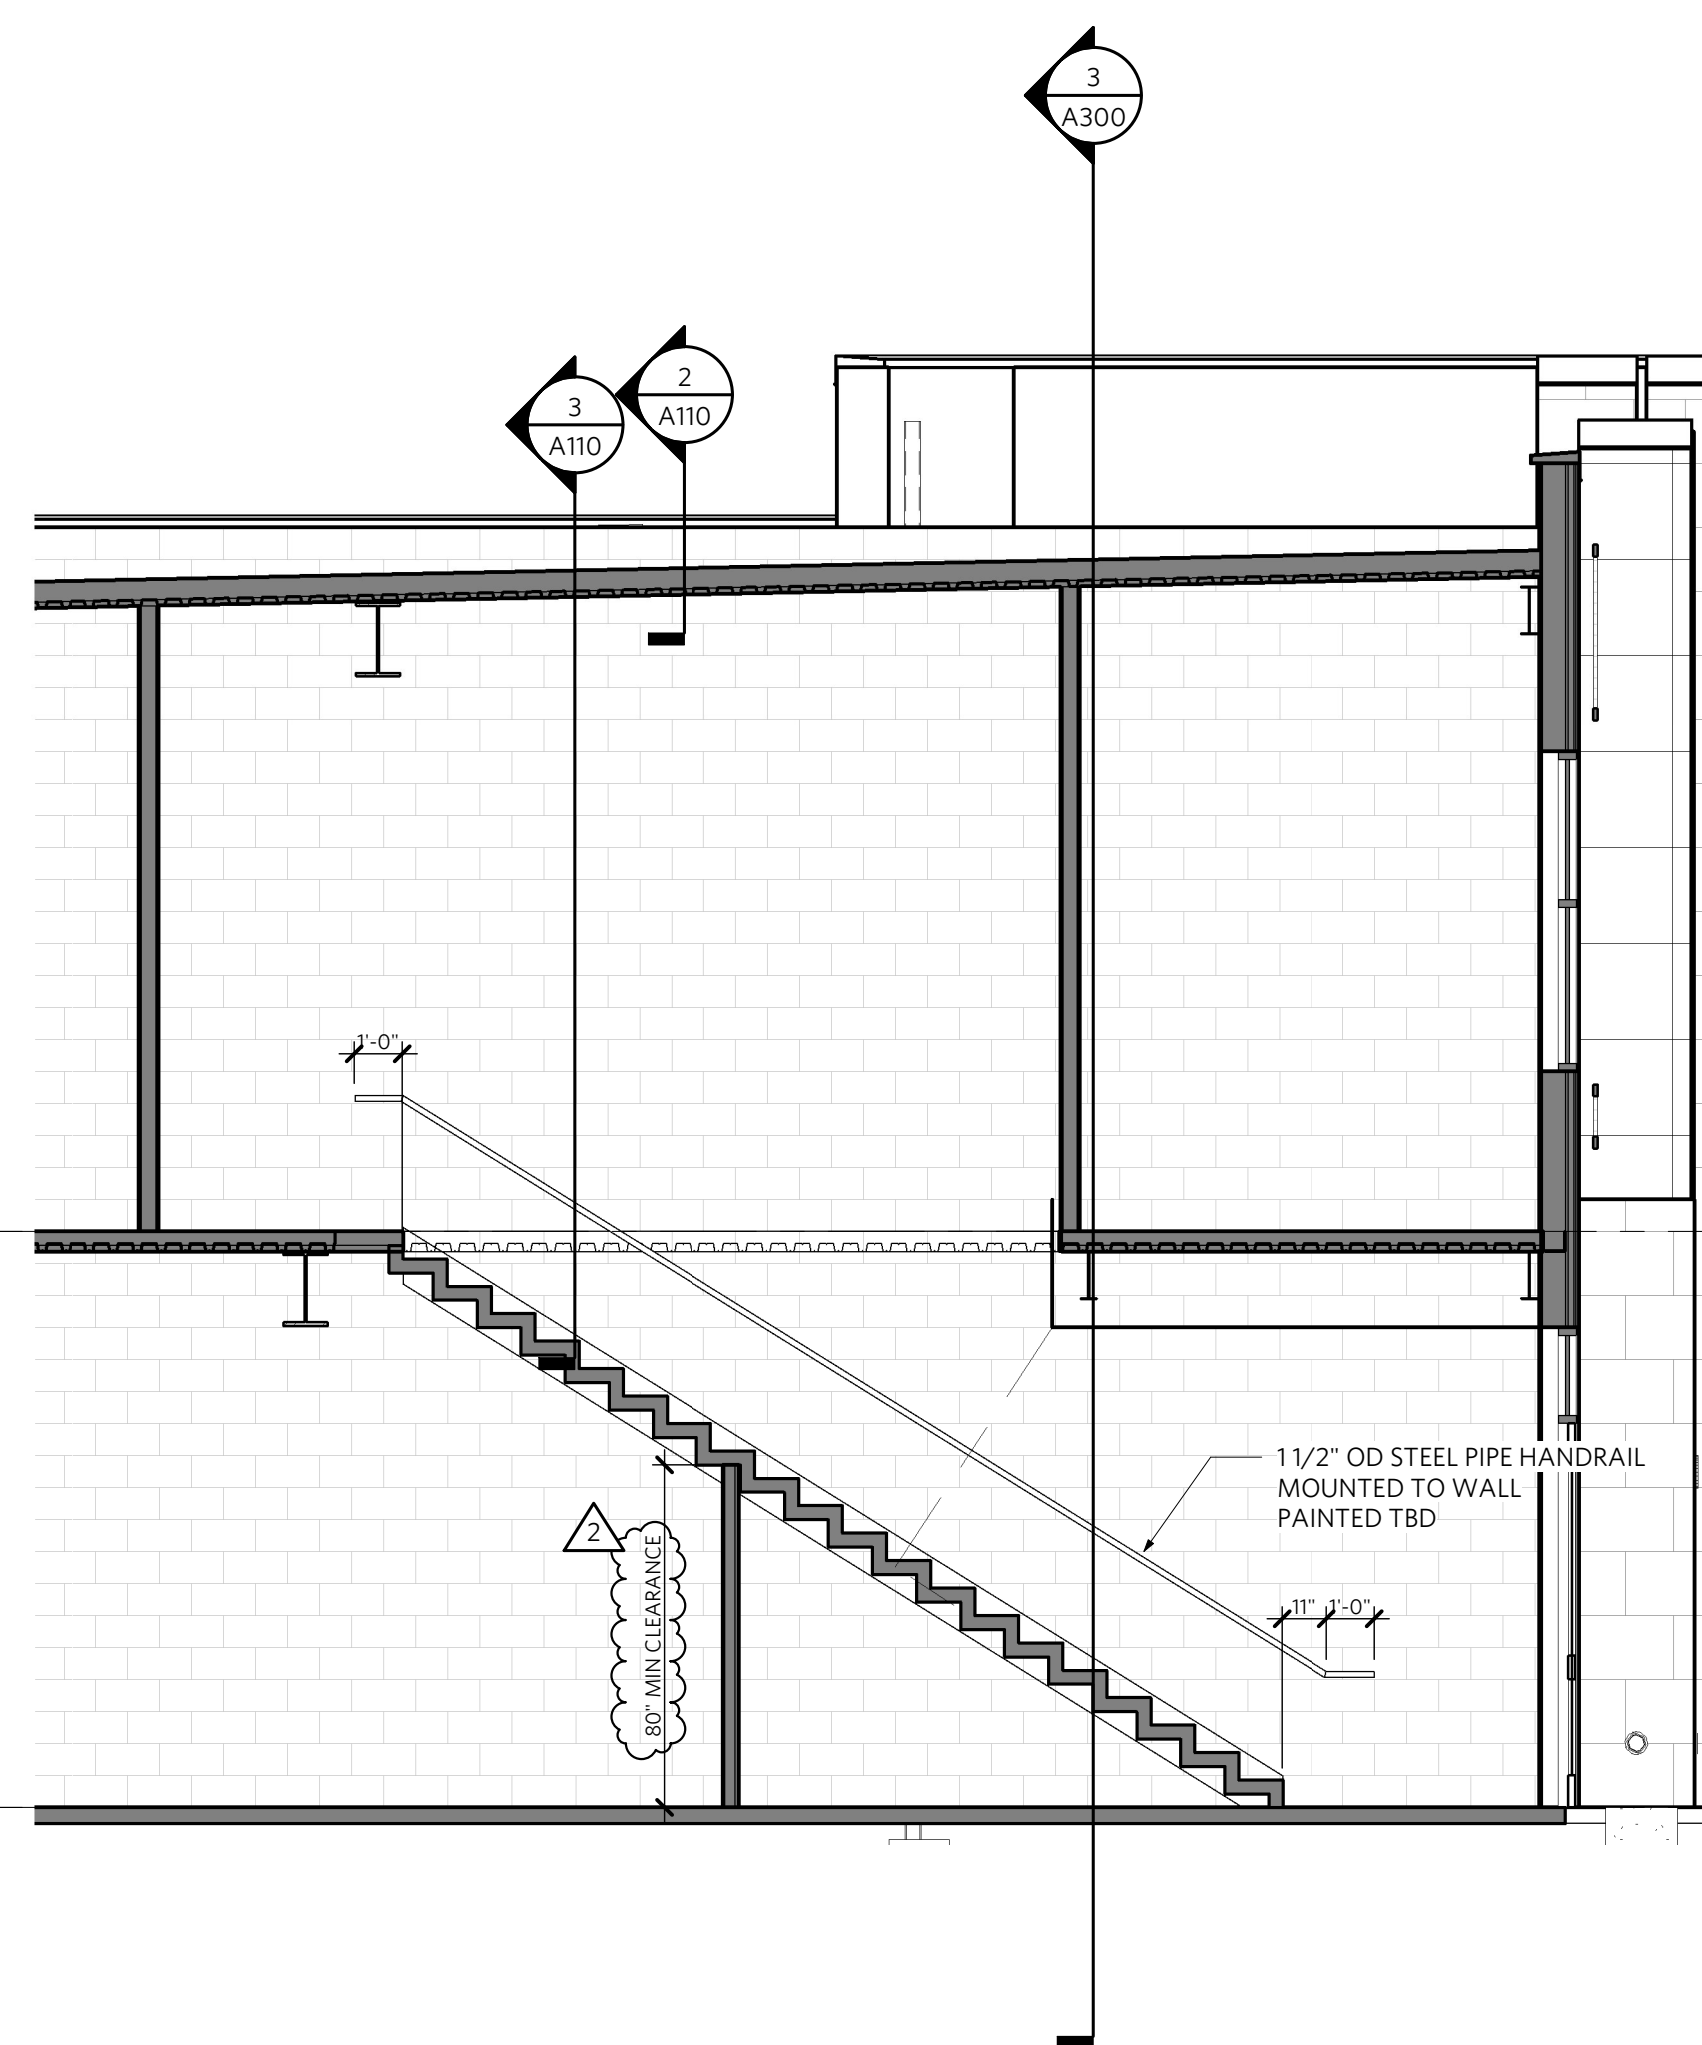

2 Section - Stair Access to 2nd Floor
1/4" = 1'-0"

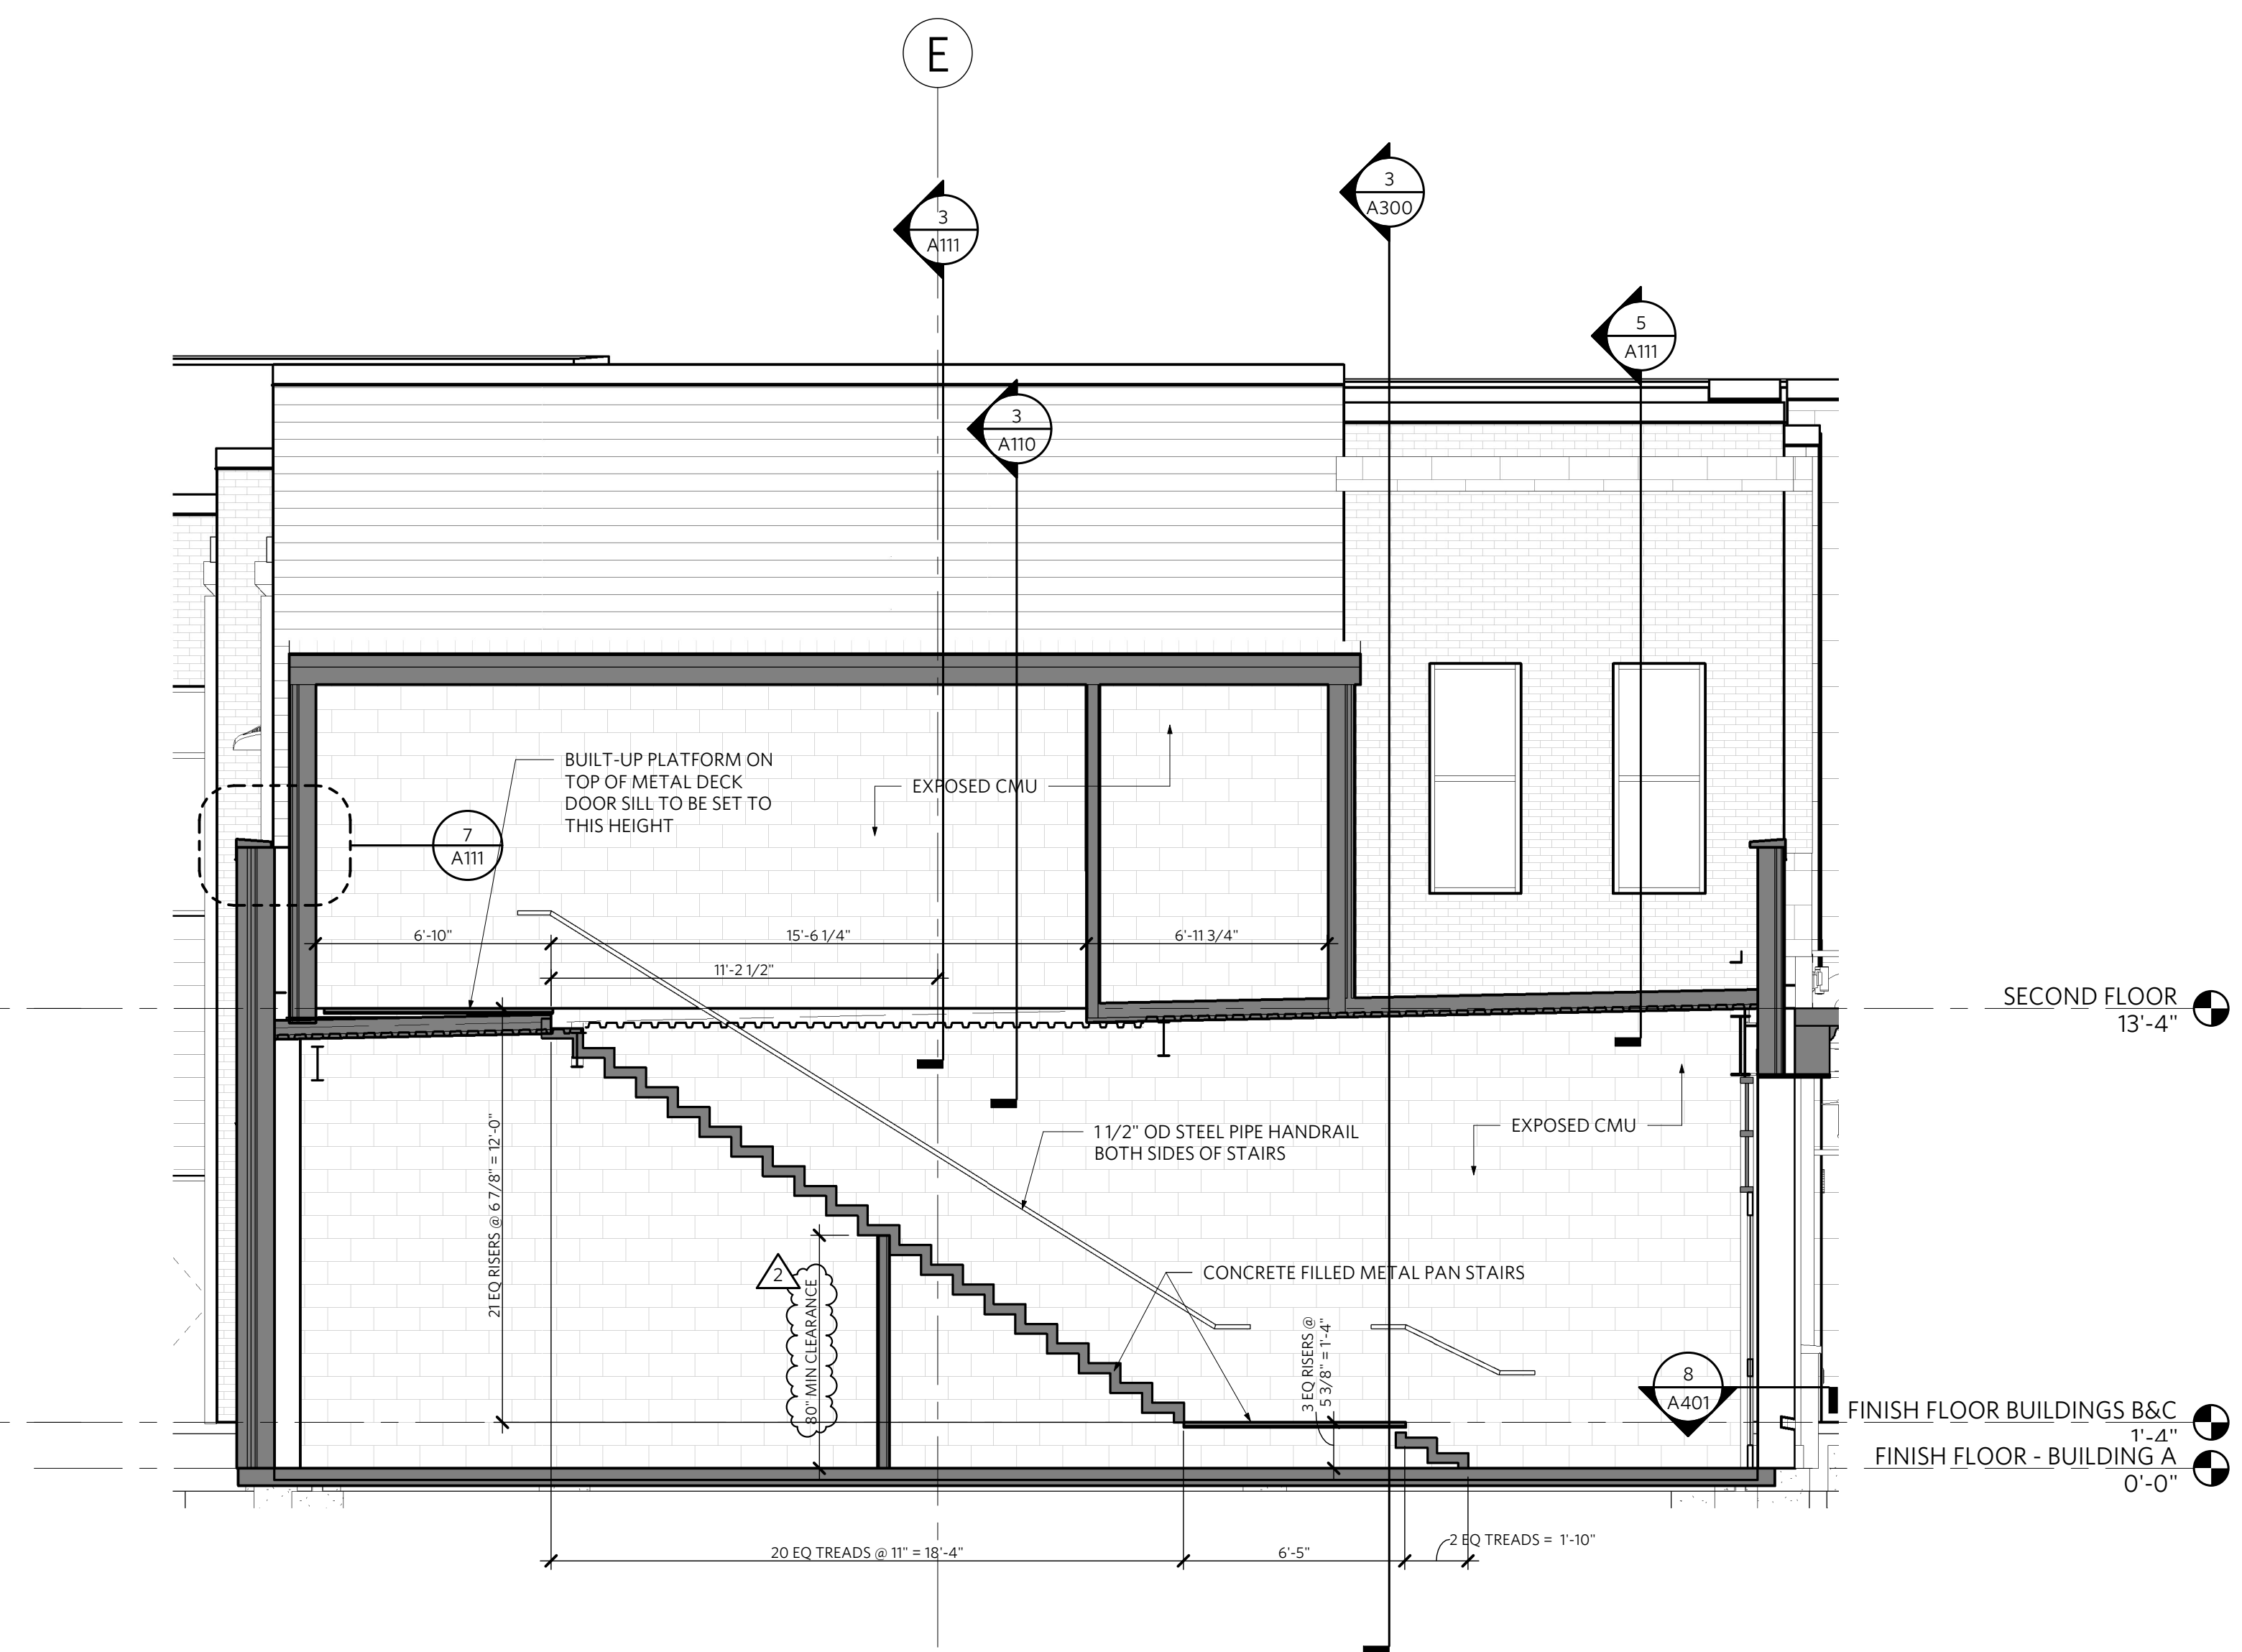

1 Section - Mechanical Access Stairs
1/4" = 1'-0"


LOT 7, BUILDING 31
420 SW LONGVIEW BLVD
LEES SUMMIT, MO, 64081



REV	ISSUE	DATE
2	Permit Review	08.19.2021
	Permit Submittal	05.17.2021

BUILDING SECTIONS

A300



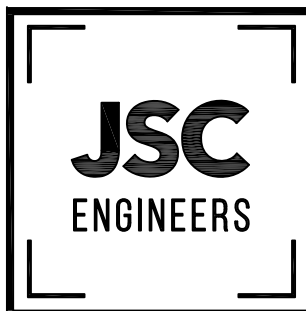


MECHANICAL & PLUMBING SPECIFICATIONS


1. GENERAL PROVISIONS:	
A. PROVIDE ALL LABOR, MATERIALS, AND EQUIPMENT NECESSARY FOR THE COMPLETE INSTALLATION OF THE PLUMBING AND MECHANICAL SYSTEMS OUTLINED.	
B. OBTAIN ALL PERMITS, FEES, LICENSES, INSPECTIONS, AND CERTIFICATIONS OF COMPLIANCE OR APPROVAL AS REQUIRED BY AUTHORITIES.	
C. ALL WORK SHALL BE PERFORMED IN ACCORDANCE WITH ALL APPLICABLE LAWS, CODES AND REGULATIONS OF THE GOVERNMENTAL BODIES HAVING JURISDICTION OVER THE SITE.	
D. ALL TESTING REQUIRED BY AUTHORITIES SHALL BE CONSIDERED PART OF THIS WORK.	
E. DURING CONSTRUCTION, ALL FIXTURES, EQUIPMENT, PIPE, DUCT, ETC. SHALL BE COVERED, PLUGGED, OR CAPPED AS REQUIRED TO KEEP CLEAN AND UNDamaged. ALL Damaged ITEMS SHALL BE RESTORED TO ORIGINAL CONDITION OR REPLACED. ALL PROTECTIVE COVERING SHALL BE REMOVED BEFORE FINAL ACCEPTANCE.	
F. PROVIDE ALL NECESSARY CUTTING AND PATCHING OF WALLS, FLOORS, CEILINGS, AND ROOFS AS NECESSARY. PATCH AROUND ALL OPENINGS SHALL MATCH ADJACENT AREA. COORDINATE ALL ROOFING WORK WITH OWNER OR RESPONSIBLE PARTY, SO THAT THE EXISTING ROOFING WARRANTY WILL BE MAINTAINED.	
G. CONTRACTOR SHALL GUARANTEE ALL WORK AND MATERIALS AGAINST DEFECT FOR A PERIOD OF ONE YEAR FROM FINAL ACCEPTANCE.	
H. INSPECTION OF THE SITE: THIS CONTRACTOR SHALL THOROUGHLY ACQUAINT HIMSELF WITH THE MEP DRAWINGS, SPECIFICATIONS, DETAIL, AND THE SITE. THIS CONTRACTOR SHALL NOTIFY THE ARCHITECT OF ANY SPECIAL OR UNUSUAL PROBLEMS, CONFLICTS, OR OBSTRUCTIONS THAT AFFECT HIS BID.	
I. FOR THE PURPOSE OF CLEARANCE AND LEGIBILITY, THE MECHANICAL AND PLUMBING DRAWINGS ARE ESSENTIALLY DIAGRAMMATIC AND DO NOT SHOW ALL OFFSETS AND FITTINGS REQUIRED FOR INSTALLATION. DO NOT SCALE DRAWINGS. THE SIZE AND LOCATION OF EQUIPMENT IS SHOWN TO SCALE WHEREVER POSSIBLE. THE CONTRACTOR SHALL VERIFY ALL CONDITIONS AND DATA AS INDICATED ON THE DRAWINGS AND IN THE SPECIFICATION SECTIONS WHERE MECHANICAL WORK INTERFACES WITH OTHER TRADES.	
J. IN THE EVENT OF A CONFLICT OR INCONSISTENCY BETWEEN ITEMS INDICATED ON THE PLANS OR WITH CODE REQUIREMENTS, THE NOTE OR CODE WHICH PRESCRIBES AND ESTABLISHES THE MORE COMPLETE JOB OR HIGHER STANDARD SHALL PREVAIL.	
K. INSTALL MATERIALS AND SYSTEMS IN ACCORDANCE WITH MANUFACTURER'S INSTRUCTIONS AND APPROVED SUBMITTALS. INSTALL MATERIALS IN PROPER RELATION WITH ADJACENT CONSTRUCTION AND WITH UNIFORM APPEARANCE FOR EXPOSED WORK. COORDINATE WITH WORK OF OTHER SECTIONS. COMPLY WITH APPLICABLE REGULATIONS AND CODE REQUIREMENTS. PROVIDE PROPER CLEARANCES FOR SERVING.	
L. INCLUDE ALL BASIC MATERIALS AND CONSTRUCTION METHODS INCLUDING PIPES, PIPE FITTINGS, AND SPECIALTIES AND SUPPORTING DEVICES, VALVES, PIPE AND VALVE IDENTIFICATION, PUMPS, VIBRATION ISOLATION, ETC.	
M. FURNISH ADEQUATE ACCESS PANELS AND DOORS TO ALLOW FOR FUTURE PIPING ALTERATIONS, REPLACEMENT, AND MAINTENANCE OF PIPING. PROPERLY IDENTIFY ALL ACCESS PANELS AND DOORS.	
2. OPERATION AND MAINTENANCE MANUALS:	
A. DURING THE COURSE OF CONSTRUCTION, COLLECT AND COMPILE OPERATING INSTRUCTIONS, WIRING DIAGRAMS, CATALOG OUTS, LUBRICATION AND PREVENTIVE MAINTENANCE INSTRUCTIONS, PARTS LISTS, ETC. FOR ALL EQUIPMENT FURNISHED UNDER THIS CONTRACT.	
B. ALL LITERATURE AND INSTRUCTIONS SHIPPED WITH THE EQUIPMENT SHALL BE SAVED FOR INCLUSION IN THE OPERATING AND MAINTENANCE MANUALS.	
C. ALL LITERATURE LISTED ABOVE AND ALL PAPERS LISTING WARRANTIES, ETC. SHALL BE BOUND IN A 3-RING BINDER AND LABELED WITH THE PROJECT NAME, ADDRESS, ARCHITECT, ENGINEER AND CONTRACTORS.	
3. MANUFACTURERS:	
A. MANUFACTURERS, MODEL NUMBERS, ETC. INDICATED OR SCHEDULED ON THE DRAWINGS SHALL BE INTERPRETED AS HAVING ESTABLISHED A STANDARD OF QUALITY AND SHALL NOT BE CONSTRUED AS LIMITING COMPETITION. ARTICLES, FIXTURES, ETC. OF EQUAL QUALITY BY MANUFACTURERS SHALL BE ACCEPTABLE, SUBJECT TO STRUCTURAL AND ELECTRICAL CONSTRAINTS OF THE PROJECT DESIGN.	
B. THE ELECTRICAL SYSTEM DESIGN IS BASED IN PART ON THE SPECIFIED EQUIPMENT. IT IS THE RESPONSIBILITY OF THE CONTRACTOR TO COORDINATE THE ELECTRICAL REQUIREMENTS OF THE EQUIPMENT BEING FURNISHED, ANY CHANGES TO THE ELECTRICAL SYSTEM DUE TO HVAC EQUIPMENT OTHER THAN THE SPECIFIED EQUIPMENT BEING FURNISHED SHALL BE PROVIDED AT NO ADDITIONAL COST TO THE OWNER.	
4. MOTORS:	
A. PROVIDE THERMAL OVERLOAD PROTECTION FOR EACH MOTOR PROVIDED BY THIS WORK.	
5. PLUMBING:	
A. PROVIDE AN APPROVED WATER HAMMER ARRESTOR FOR EACH PLUMBING FIXTURE SUPPLY AS REQUIRED BY FIXTURE MANUFACTURER.	
B. ALL EXPOSED PIPE IN FINISHED AREAS SHALL BE CHROME PLATED BRASS PIPE, NO FERROUS PIPE. PROVIDE CLEANOUTS AT EACH CHANGE IN DIRECTION AND AT 100 FOOT INTERVALS IN STRAIGHT RUNS.	
D. PROVIDE ACCESS PANELS FOR ALL CONCEALED VALVES AND TRAPS.	
E. CLEANOUTS:	
1. VINYL TILE FLOOR (FCO):JR SMITH #4140, OR EQUAL.	
2. QUARRY TILE FLOOR (FCO):JR SMITH #4200, OR EQUAL.	
3. CARPETED FLOOR (FCO):JR SMITH #4020-Y, OR EQUAL.	
4. UNFINISHED FLOOR (FCO):JR SMITH #4020-Y, OR EQUAL.	
5. WALL (WCO):JR SMITH #4472, OR EQUAL, 24" ABOVE THE FLOOR.	
6. GRADE (GCO):JR SMITH #4256, OR EQUAL, WITH HEAVY DUTY CAST IRON BODY AND COVER.	
F. ALL SEWER PIPING LOCATED INSIDE THE BUILDING SHALL BE INSTALLED WITH THE FOLLOWING SLOPES.	
1. INSTALL 2-1/2" AND SMALLER PIPE AT 1/4" PER FOOT FALL.	
2. INSTALL 3" AND LARGER PIPE AT 1/8" PER FOOT FALL.	
3. CONDENSATE DRAIN SHALL BE INSTALLED AT 1/8" PER FOOT FALL.	
G. PROVIDE DIELECTRIC UNIONS WITH APPROPRIATE END CONNECTION TO MATCH THE PIPE SYSTEM IN WHICH INSTALLED (ScrewED, SolderED, OR FLANGED). PROVIDE DIELECTRIC UNIONS ON ALL PIPING CONNECTIONS TO HOT WATER HEATERS AND EXPANSION JOINTS.	
H. ALL SEWER PIPING LOCATED EXTERIOR TO THE BUILDING SHALL BE INSTALLED WITH THE FOLLOWING SLOPES.	
1. INSTALL 4" AND SMALLER PIPE AT A MINIMUM OF 2% SLOPE.	
2. INSTALL 6" AND LARGER PIPE AT A MINIMUM OF 1% SLOPE.	
6. PIPING:	
A. DOMESTIC COLD WATER (ABOVEGROUND).	
1. TYPE L HARD DRAIN COPPER TUBING, ASTM B-88 WITH WROUGHT BRONZE SOLDERED FITTINGS.	
2. GATE VALVE: CRANE #428 OR EQUAL.	
3. GLOBE VALVE: CRANE #7 OR EQUAL.	
4. BALL VALVE: CRANE #632 OR EQUAL.	
B. DOMESTIC COLD WATER, 1"-3" (UNDERGROUND).	
1. TYPE K HARD OR SOFT DRAWN COPPER TUBING, ASTM B-88 WITH WROUGHT BRONZE SOLDERING FITTINGS.	
C. SANITARY SEWER AND VENTS (UNDERGROUND, INTERIOR TO BUILDING).	
1. WASTE, DRAIN, VENT PIPE, AND FITTINGS ABOVE GROUND INSIDE OF THE BUILDING SHALL BE SERVICE WEIGHT HUB-AND-SPOUT OR NO-HUB CAST IRON PIPE, SCHEDULE 40 DWV PVC SOLID PLASTIC PIPE MAY BE USED WHERE PERMITTED BY CODES. APPROVED PVC PIPING RUNNING IN RETURN AIR PLENUM SPACE SHALL BE INSTALLED WITH A 1-HOUR RATED COVERING OVER ALL PIPE, FITTINGS AND VALVES.	
4. SEWER LINES SHALL BE LOCATED IN GENERAL AS SHOWN ON THE DRAWINGS. THE EXACT LOCATIONS SHALL BE DETERMINED BY THE CONTRACTOR IN SUCH A MANNER AS TO MAINTAIN PROPER CLEARANCES AND SUFFICIENT SLOPE TO ENSURE DRAINAGE.	
5. VENT STACKS SHALL BE EXTENDED FULL SIZE THROUGH THE ROOF AND FLASHED WITH 4 POUND LEAD SHEETS TURNED DOWN INTO THE STACK AT LEAST 2" AND EXTENDED 12" IN ALL DIRECTIONS FROM THE PIPE AT THE ROOF LINE. VENTS THROUGH ROOF SHALL NOT BE LESS THAN 2". PVC PIPING SHALL NOT BE USED FOR VENT PIPING THROUGH THE ROOF WHERE APPLICABLE FOR ROOFING SYSTEM USED, PROVIDE FLASHING VIA PLEATED EPDM CONE IN LIEU OF LEAD. ALL VENT STACKS IN OR AT OUTSIDE WALLS SHALL BE OFFSET 1'-6" MINIMUM FROM OUTSIDE WALLS BEFORE GOING THROUGH THE ROOF, TO FACILITATE FLASHING.	
D. STORM SEWER, SANITARY SEWER, SAND-OIL WASTE AND VENTS (EXTERIOR TO BUILDING).	
1. SEE CIVIL PLANS.	
E. ALL PIPE HANGERS AND SUPPORTS SHALL BE STANDARD PRODUCTS OF GRINNELL, FEE AND MASON, OR ANVIL. HANGER SPACING SHALL BE IN ACCORDANCE WITH MSS-SP-69.	
F. SLEEVES	
1. PROVIDE, SET, AND PROPERLY LOCATE PIPE SLEEVES AS REQUIRED FOR THIS WORK. ALL SLEEVES SHALL BE OF SUFFICIENT SIZE TO PERMIT PIPE MOVEMENT DUE TO EXPANSION AND CONTRACTION AND TO ACCOMMODATE PIPE INSULATION.	
2. INTERIOR PARTITIONS: 16 GAUGE GALVANIZED STEEL, PACK BETWEEN PIPE AND SLEEVE WITH FIRE SAFING AND CAULK AT EACH END WITH FIRE RESISTANT SEALANT.	
3. ROOF: PROSET OR EQUAL, MANUFACTURED PVC SCHEDULE 40 PIPE SLEEVE WITH WATERPROOF SEAL, COORDINATE WITH ROOFING CONTRACTOR AND FLASH AS REQUIRED TO MAINTAIN ROOF WARRANTY.	
4. PLUMBING VENTS: FLASH ROOF VENT INTO ROOFING SYSTEM AS REQUIRED BY THE ROOFING CONTRACTOR TO MAINTAIN THE EXISTING ROOF WARRANTY. ALL PLUMBING VENT TERMINALS SHALL TERMINATE A MINIMUM OF 12" ABOVE ROOF OR EQUAL TO HEIGHT OF PARAPET, WHICHEVER IS GREATER.	
6. PROVIDE CHROME PLATED ESCUTCHEONS ON ALL PIPE ENTERING FINISHED AREAS.	
7. INSULATION AND DUCT LINING:	
A. ALL INSULATIONS AND ACCESSORIES SHALL HAVE A FIRE HAZARD CLASSIFICATION WITH A FLAME SPREAD RATING OF NOT OVER 25, A FUEL CONTRIBUTION RATING OF NOT OVER 50, AND A SMOKE DEVELOPMENT RATINGS OF NOT OVER 50, IN ACCORDANCE WITH NFPA.	
B. PIPE INSULATION (ABOVE GRADE).	
1. THE PIPE INSULATION USED SHALL HAVE A THERMAL CONDUCTIVITY OF 0.27 BTU PER IN/HR/INQ-FT/FT OR LESS.	
2. FLEXIBLE CLOSED CELL ELASTOMERIC THERMAL INSULATION, UNSUIT OR PRESUIT WITH PRESSURE SENSITIVE ADHESIVE SYSTEM FOR CLOSURE AND VAPOR SEALING, EQUAL TO ARMSTRONG AP ARMAFLEX OR ARMAFLEX 2000.	
3. FOR NON CIRCULATING SYSTEMS THE FIRST 8 FEET OF INLET AND OUTLET PIPING BETWEEN THE TANK AND HEAT TRAP (INCLUDING THE HEAT TRAP) MUST BE INSULATED.	
D. INSULATION SCHEDULE:	
a. DOMESTIC COLD WATER: 1/2"	
b. DOMESTIC HOT WATER: 1"	
8. TESTING, BALANCING AND CLEANING:	
A. ALL PIPING SHALL BE TESTED FOR LEAKS BEFORE BEING CONCEALED IN WALL CONSTRUCTION OR COVERED WITH INSULATION.	
B. SEWER AND VENT PIPING SHALL BE HYDROSTATICALLY TESTED WITH NO LESS THAN 10 FEET OF HEAD FOR A PERIOD OF NOT LESS THAN 15 MINUTES, PER THE LOCAL PLUMBING CODE, WITH NO LEAKS.	
C. DOMESTIC WATER PIPING SHALL BE HYDROSTATICALLY TESTED AT A PRESSURE OF NOT LESS THAN 1-1/2 TIMES THE OPERATING PRESSURE, BUT NOT LESS THAN 60 PSI, FOR A PERIOD OF NOT LESS THAN 2 HOURS, WITH NO LEAKS.	
D. BEFORE DOMESTIC WATER PIPING IS PLACED IN SERVICE, ALL DOMESTIC WATER DISTRIBUTION SYSTEMS, INCLUDING THOSE FOR COLD WATER AND HOT WATER SYSTEMS, SHALL BE FLUSHED, STERILIZED AND CHLORINATED IN ACCORDANCE WITH THE HEALTH DEPARTMENT REGULATIONS. THE SYSTEMS SHALL BE THOROUGHLY FLUSHED OF ALL DIRT AND FOREIGN MATTER, THEN FILLED WITH WATER TREATED WITH 50 PPM OF CHLORINE. DURING THE FILLING PROCESS, VALVES AND FAUCETS SHALL BE OPENED SEVERAL TIMES TO ASSURE TREATMENT OF THE ENTIRE SYSTEM. THE TREATED WATER SHALL BE LEFT IN THE SYSTEM FOR 24 HOURS AFTER WHICH TIME THE SYSTEM SHALL BE FLUSHED; IF THE RESIDUAL CHLORINE IS NOT LESS THAN 10 PPM, THE FLUSHING SHALL BE REPEATED. AFTER STERILIZATION SAMPLES OF WATER FROM THE SYSTEM SHALL BE APPROVED BY THE BOARD OF HEALTH.	
E. THE INSPECTION AUTHORITY HAVING JURISDICTION SHALL BE NOTIFIED AT LEAST 24 HOURS PRIOR TO PERFORMANCE OF ALL TESTS SO THAT THEY TESTS MAY BE WITNESSED IF DEEMED NECESSARY.	
F. DUCTWORK AND PIPING SHALL BE BALANCED BY QUALIFIED BALANCING PERSONNEL WHO HAVE PREVIOUS EXPERIENCE WITH BALANCING PROCEDURES AND ARE FAMILIAR WITH TESTING AND BALANCING PROCEDURES OF THE ASSOCIATED AIR BALANCE COUNCIL (AABC) OR NATIONAL ENVIRONMENTAL BALANCING BUREAU (NEBB).	
1. BALANCING SHALL INCLUDE THE BALANCING OF THE EQUIPMENT AND AIR DISTRIBUTION SYSTEMS TO PROVIDE DESIGN QUANTITIES INDICATED AND VERIFICATION PERFORMANCE OF ALL EQUIPMENT AND AUTOMATIC CONTROLS.	
2. WITH IN 30 DAYS OF THE COMPLETION OF THE TESTING AND BALANCING WORK, SUBMIT THE TEST AND BALANCING REPORT BEARING THE SIGNATURE OF THE TEST AND BALANCE ENGINEER. THE REPORTS SHALL BE CERTIFIED PROOF THAT THE SYSTEMS HAVE BEEN TESTED, ADJUSTED, AND BALANCED IN ACCORDANCE WITH THE REFERENCED STANDARDS; ARE AN ACCURATE REPRESENTATION OF HOW THE SYSTEMS HAVE BEEN INSTALLED AND ARE OPERATING. REPORTS SHALL BE BOUND IN A VINYL BINDER AND THE BINDER LABELED OR MAY BE AN ELECTRONIC PDF SUBMITAL.	
9. ELECTRIC WALL HEATERS	
A. UNIT SHALL INCLUDE ELECTRIC HEATING ELEMENTS WITH SAFETY AND DISCONNECT DEVICES AS REQUIRED BY NEC, INCLUDING RELAYS, CONTROLLERS AND REQUIRED EQUIPMENT TO FORM A COMPLETE AND FUNCTIONAL HEAT.	
B. ELEMENTS SHALL BE HEAVY DUTY ALUMINUM-FINNED, COPPER CLAD STEEL SHEATH, PROVIDE AUTOMATIC RESET THERMAL OVER-HEAT PROTECTION, THERMAL PROTECTOR SHALL BE LINEAR TYPE TO SENSE TEMPERATURES THE ENTIRE LENGTH OF HEATING ELEMENT.	
C. FANS SHALL BE DIRECT DRIVE USING PERMANENT SPLIT CAPACITOR TYPE MOTORS WITH BUILT-IN AUTOMATIC RESET MOTOR OVERLOAD PROTECTION.	
D. FURNISH INTEGRAL FAN DELAY SWITCH TO PREVENT DISCHARGE OF COLD AIR, BY DELAYING START-UP OF THE FAN MOTOR UNTIL HEATING ELEMENTS HAVE WARMED UP. FAN DELAY SWITCH SHALL MAINTAIN MOTOR OPERATION AFTER HEATING ELEMENTS HAVE BEEN DE-ENERGIZED TO DISSIPATE ANY RESIDUAL HEAT.	

MECHANICAL SYMBOLS

THIS IS A MASTER LEGEND AND NOT ALL SYMBOLS, ETC, ARE NECESSARILY USED ON THE DRAWINGS.

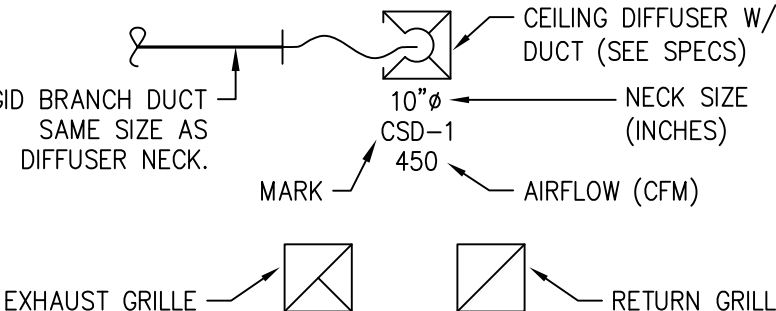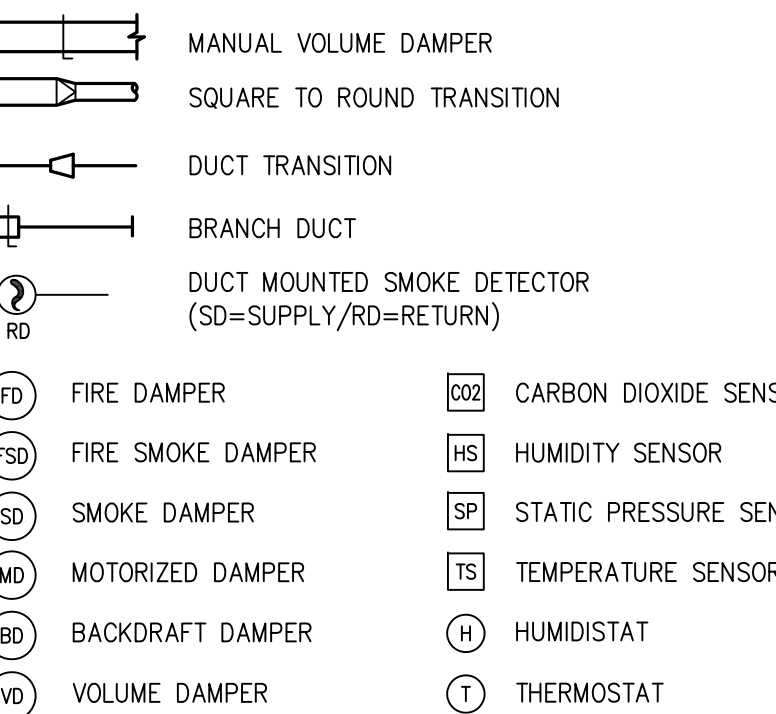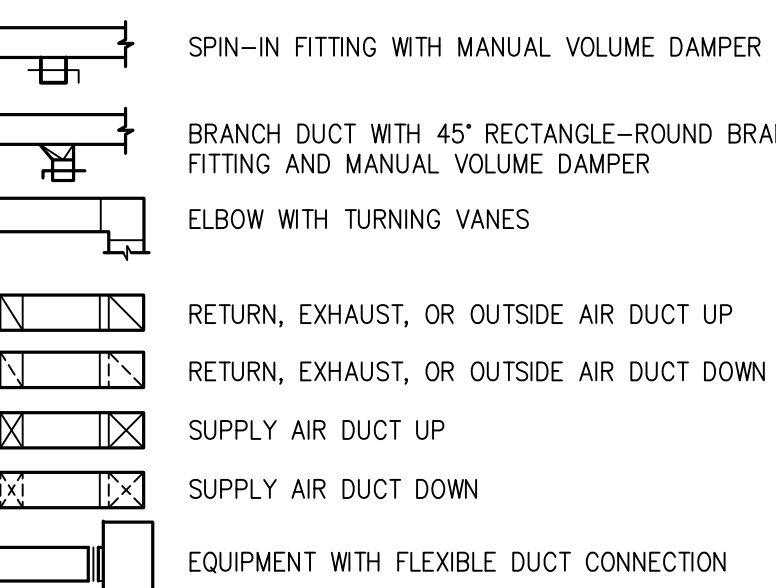

PLUMBING SYMBOLS

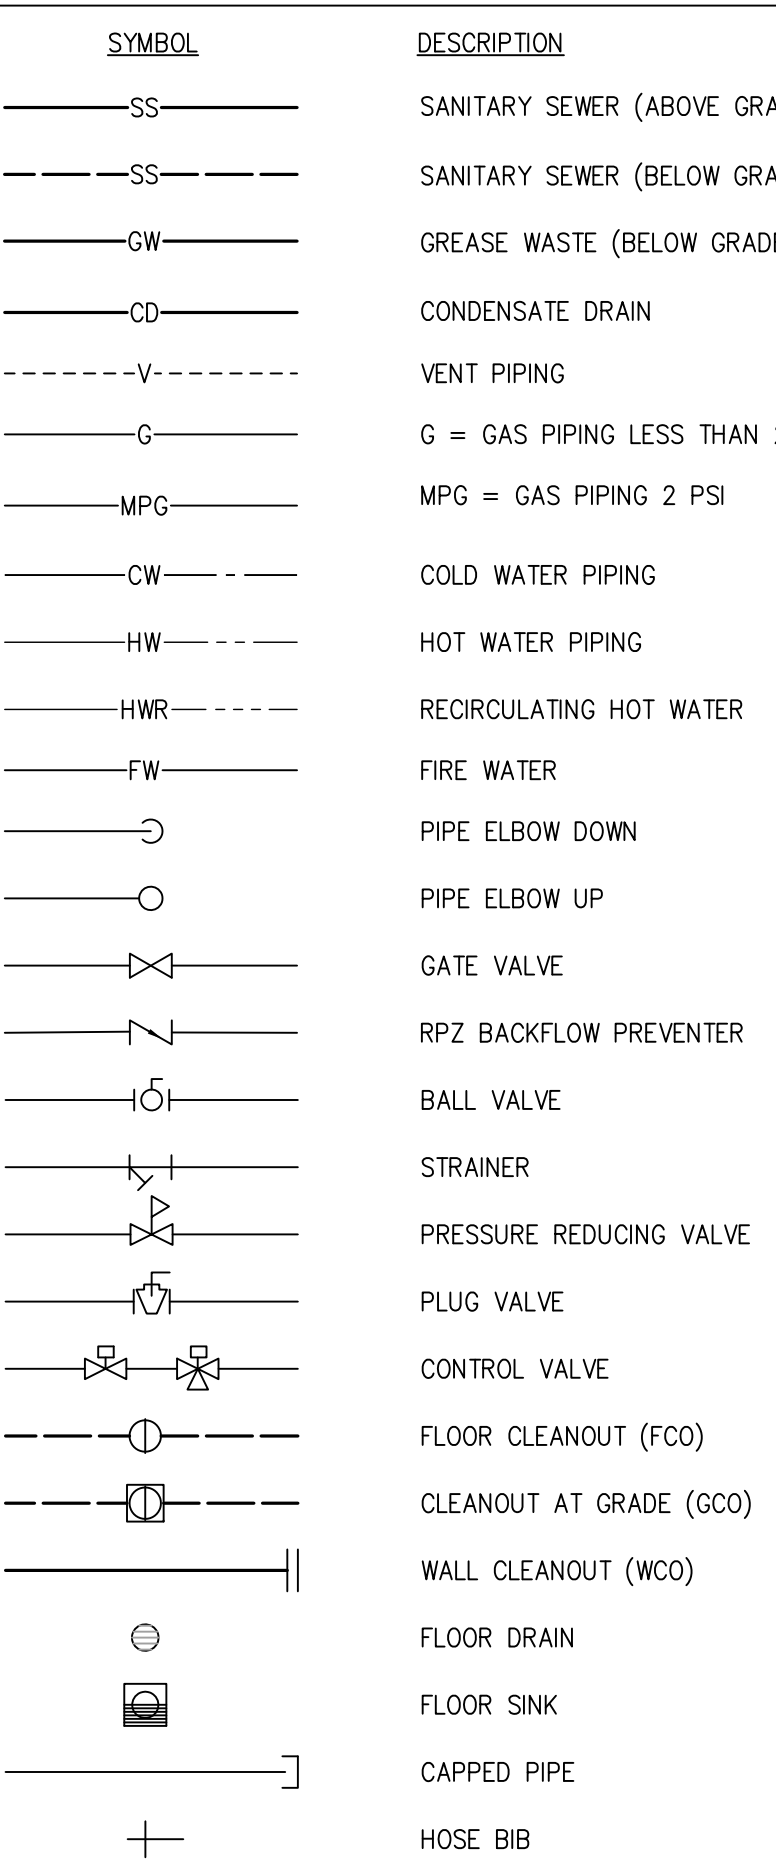

ABBREVIATIONS	
AFF ABOVE FINISHED FLOOR	MIN MINIMUM
AFG ABOVE FINISHED GRADE	N/C NORMALLY CLOSED
AHU AIR HANDLING UNIT	N/O NORMALLY OPEN
BFF BELOW FINISHED FLOOR	ORD OVERFLOW ROOF DRAIN
BFG BELOW FINISHED GRADE	PDI PLUMBING DRAINAGE INSTITUTE
BOP BOTTOM OF PIPE	PVC POLYVINYL CHLORIDE
BOS BOTTOM OF STRUCTURE	PRV PRESSURE REDUCING VALVE
BTU BRITISH THERMAL UNIT	RPM REVOLUTIONS PER MINUTE
CFM CUBIC FEET PER MINUTE	SF SQUARE FEET
CFH CUBIC FEET PER HOUR	TDH TOTAL DYNAMIC HEAD
DN DOWN	UL UNDERWATER LABORATORIES, INC.
DFU DRAINAGE FIXTURE UNIT	UNO UNLESS NOTED OTHERWISE
ETR EXISTING TO REMAIN	V VOL(TS)
FFD FLOOR DRAIN	VCP VITRIFIED CLAY PIPE
FFA FROM FLOOR ABOVE	VS VENT STACK
FFB FROM FLOOR BELOW	VTR VENT THROUGH ROOF
FF FINISHED FLOOR	W/ WITH
FLA FULL LOADS AMPS	W/O WITHOUT
FLR FLOOR	WC WATER COLUMN
CPM GALLON PER MINUTE	WE WATER STACK
IE INVERTED ELEVATION	WSFU WATER SUPPLY FIXTURE UNIT
WC INCHES OF WATER COLUMN	
KW KILOWATT	
MAX MAXIMUM	
MBH 1000 BTU PER HOUR	

ANNOTATION	
# PLAN WORK NOTE	
MECHANICAL EQUIPMENT DESIGNATION (CONTRACTOR FURNISHED AND INSTALLED UNLESS NOTED OTHERWISE)	
PLUMBING FIXTURE DESIGNATION	
CONNECTION POINT OF NEW WORK TO EXISTING	
DETAIL REFERENCE UPPER NUMBER INDICATED DETAIL NUMBER LOWER NUMBER INDICATES SHEET NUMBER	

UNIT HEATER SCHEDULE							
MARK	LOCATION	MANUFACTURER	MODEL	TYPE	ELECTRICAL		
					AMPS	VOLTS	PH
FWH-1	HOUSE CLOSET	QMARK	LFK151F	FAN FORCED	12.5	120	1
NOTES:							
A.	PROVIDE WALL MOUNT BRACKET.						
B.	PROVIDE WITH INTEGRAL BIMETALLIC THERMOSTAT.						

PLUMBING FIXTURE SCHEDULE	
FD	FLOOR DRAIN: JAY R. SMITH #206SL (-A), CAST IRON BODY AND CLAMPING COLLAR, ADJUSTABLE 6" ROUND NICKEL BRONZE STRAINER. PROVIDE WITH PROSET SYSTEMS "TRAP GUARD" INSERT FOR ACTUAL FLOOR DRAIN MODEL AND SIZE PROVIDED.
FPRH	ROOF HYDRANT: WOODFORD SRH, FREEZELESS ROOF HYDRANT WITH ANTI-SIPHON VACUUM BREAKER, 3/4" MALE HOSE THREAD, LEVER OPERATOR
RP21	REDUCED PRESSURE ZONE BACKFLOW PREVENTER: 1-1/2", WATTS # LF009QT, MEETING ASSE 1013, LEAD FREE CAST BRONZE BODY, QUARTER TURN TESTING COCKS, QUARTER TURN BALL VALVES, AND # 909AG AIR GAP FITTING.
RP22	REDUCED PRESSURE ZONE BACKFLOW PREVENTER: 1", WATTS # LF009QT, MEETING ASSE 1013, LEAD FREE CAST BRONZE BODY, QUARTER TURN TESTING COCKS, QUARTER TURN BALL VALVES, AND # 909AG AIR GAP FITTING.

System No. W-J-1020				
3. Firestop System — The hourly Ratings for the firestop systems are dependent upon the type and size of pipe, annular space, fill material thickness and fill material type as described in the table below. When the annular space in the table shows a range of diameters, the penetrating item may be installed either concentrically or eccentrically within the firestop system. The firestop systems shall consist of the following:				
A. Packing Material — Mineral wool batt insulation firmly packed into opening as a permanent form. As an option to the above, backer and/or foamed plastic backer material may be used. Packing material to be recessed from both surfaces of wall to accommodate the required thickness of fill material.				
B. Fill, Void or Cavity Material — Sealant — Applied within the annulus, flush with both surfaces of wall as shown in the table below:				
Pipe Type	Min Fill Mt Thkns In. (mm)	F Rating Hr.	T Rating Hr.	
2A	1/4 (6)	2	1/4	
2B	1/2 (13)	2	0	
HILTI CONSTRUCTION CHEMICALS, DIV OF HILTI INC — FS-One Sealant or FS-ONE MAX Intumescent Sealant				
* Indicates such products shall bear the UL or cUL Certification Mark for jurisdictions employing the UL or cUL Certification (such as Canada), respectively.				

HILTI Firestop Systems	
Reproduced by HILTI, Inc. Courtesy of Underwriters Laboratories, Inc. January 22, 2015	Page: 2 of 2

Classified by
Underwriters Laboratories, Inc.
in UL 1479 and CANULC S115

System No. W-J-1020

ANSI/UL 1479 (ASTM E814)	CANULC S115
F Rating — 0 and 1/4 Hr (See Item 3B)	F Rating — 2 Hr
L Rating At Ambient — Less Than 1 CFMsq ft	FT Rating — 0 and 1/4 Hr (See Item 3B)
L Rating At 400 F — 4 CFMsq ft	FH Rating — 2 Hr
	FTH Rating — 0 and 1/4 Hr (See Item 3B)
	L Rating At Ambient — Less Than 1 CFMsq ft
	L Rating At 400 F — 4 CFMsq ft

1. Wall Assembly — Min 5 in. (127 mm) thick reinforced lightweight or normal weight (100-150 pcf or 1600-2400 kg/m³) concrete. Wall may also be constructed of any UL Classified Concrete Block*. Max diam of opening is 8 in. (203 mm).

See Concrete Blocks (CAZT) category in the Fire Resistance Directory for names of manufacturers.

2. Through Penetrants — One metallic pipe, conduit or tubing to be installed either concentrically or eccentrically within the firestop system. Pipe, conduit or tubing to be rigidly supported on both sides of wall assembly. The annular space between pipe, conduit or tubing and periphery of opening shall be min 3/4 in. (19 mm) to max 3-1/2 in. (89 mm). The following types and sizes of metallic pipes, conduits or tubing may be used:

- A. Conduit — Nom 4 in. (102 mm) diam (or smaller) electrical metallic tubing or steel conduit.
- B. Copper Tubing — Nom 4 in. (102 mm) diam (or smaller) Type 1 (or heavier) copper tubing.
- C. Copper Pipe — Nom 4 in. (102 mm) diam (or smaller) Regular (or heavier) copper pipe.

Reproduced by HILTI, Inc. Courtesy of
Underwriters Laboratories, Inc.
January 22, 2015

Page: 1 of 2

Classified by
Underwriters Laboratories, Inc.
UL 1479 and CANULC S115

System No. W-L-1054

W-L-1054

ANSI/UL 1479 (ASTM E814)	CANULC S115	
F Ratings — 1 and 2 Hr (See Items 1 and 3)	F Ratings — 1 and 2 Hr (See Items 1 and 3)	
T Rating — 0 Hr	FT Rating — 0 Hr	
L Rating (Without Movement) at Ambient — Less Than 1 CFM/sq ft	FH Ratings — 1 and 2 Hr (See Items 1 and 3)	
L Rating (Without Movement) at 400°F — Less Than 1 CFM/sq ft	FTH Rating — 0 Hr	
M Rating (Movement) — See Table 1	FTH Rating — 0 Hr	
	L Rating at Ambient — Less Than 5.1 L/s/m ²	
	L Rating at 204°C — Less Than 5.1 L/s/m ²	

SECTION A-A

1. Wall Assembly — The 1 or 2 hr fire-rated gypsum wallboard/wall assembly shall be constructed of the materials and in the manner specified in the individual U300 or U400 Series Wall and Partition Designs in the UL Fire Resistance Directory and shall include the following construction features:

A. Studs — Wall framing may consist of either wood studs or steel channel studs. Wood studs to consist of nom 2 by 4 in. (51 by 102 mm) lumber spaced 16 in. (406 mm) OC. Steel studs to be min 2-1/2 in. (64 mm) wide and spaced max 24 in. (610 mm) OC. For M Rating, steel studs to be min 3-5/8 in. (92 mm) wide. When steel studs are used and the diam of opening exceeds the width of stud cavity, the opening shall be framed on all sides using lengths of steel stud installed between the vertical studs and screw-attached to the steel studs at each end. The framed opening in the wall shall be 4 to 6 in. (102 to 152 mm) wider and 4 to 6 in. (102 to 152 mm) higher than the diam of the penetrating item such that, when the penetrating item is installed in the opening, a 2 to 3 in. (51 to 76 mm) clearance is present between the penetrating item and the framing on all four sides.

B. Gypsum Board — 5/8 in. (16 mm) thick, 4 ft (122 cm) wide with square or tapered edges. The gypsum board type, thickness, number of layers, fastener type and sheet orientation shall be as specified in the individual U300 or U400 Series Design in the UL Fire Resistance Directory. Max diam of opening is 32-1/4 in. (819 mm) for steel stud walls. Max diam of opening is 14-1/4 in. (366 mm) for wood stud walls. The F and FH Ratings of the firestop-system are equal to the fire rating of the wall assembly. The M Rating is applicable only to 1 hr rated walls.

HILTI
Hilti Firestop Systems

Reproduced by HILTI, Inc. Courtesy of
Underwriters Laboratories, Inc.
January 21, 2020

Page: 1 of 2

System No. W-L-1054

W-L-1054

2. Through-Penetrants — One metallic pipe, conduit or tubing to be installed either concentrically or eccentrically within the firestop system. The annular space shall be min 0 in. to max 2-1/4 in. (57 mm). Pipe may be installed with continuous point contact. Pipe, conduit or tubing to be rigidly supported on both sides of wall assembly. The following types and sizes of metallic pipes, conduits or tubing may be used:

- A. Steel Pipe — Nom 30 in. (762 mm) diam (or smaller) Schedule 10 (or heavier) steel pipe.
- B. Iron Pipe — Nom 30 in. (762 mm) diam (or smaller) cast or ductile iron pipe.
- C. Conduit — Nom 4 in. (102 mm) diam (or smaller) steel electrical metallic tubing or 6 in. (152 mm) diam steel conduit.
- D. Copper Tubing — Nom 6 in. (152 mm) diam (or smaller) Type 1 (or heavier) copper tubing.
- E. Copper Pipe — Nom 6 in. (152 mm) diam (or smaller) regular (or heavier) copper pipe.

3. Fill, Void or Cavity Material — Sealant — Min 5/8 in. (16 mm) thickness of fill material applied within the annulus, flush with both surfaces of wall. At the point or continuous contact locations between pipe and wall, a min 1/2 in. (13 mm) diam bead of fill material shall be applied at the pipe wall interface on both surfaces of wall.

HILTI CONSTRUCTION CHEMICALS, DIV OF HILTI INC — FS-ONE MAX Intumescent Sealant

Movement Direction	Penetrant Item	Nominal Penetrant Diameter	Annular Space	Movement	Sealant Depth	F-Rating	L Rating with Movement
Y	2A, 2C*	2 in.	Max 2-1/4 in.	5%	5/8 in.	1 hr	N/A
Z	2A, 2C*	2 in.	2-1/4 in.	0.25 in.	5/8 in.	1 hr	N/A


Indicates those products shall bear the UL or cUL Certification Mark for jurisdictions employing the UL or cUL Certification (such as Canada), respectively.

Reproduced by HILTI, Inc. Courtesy of
Underwriters Laboratories, Inc.
January 21, 2020

Hilti Firestop Systems

Page 2 of 2

MEP ENGINEER

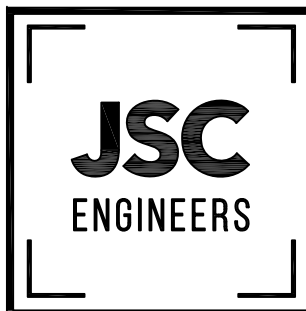

MO COA NO. 201200788 / KS COA NO. E-2815
7261 NW BLUE PARADISE, UNITY VILLAGE, MO 640
3rd FLOOR UNITY VILLAGE TOWER
phone: (316) 272-6268
email: jsmothers@scendeavors.com


A. DRAWINGS ARE DIAGRAMMATIC ONLY AND REPRESENT THE GENERAL SCOPE OF WORK. REVIEW THE GENERAL NOTES, SPECIFICATIONS AND PLANS FOR ADDITIONAL REQUIREMENTS THAT MAY NOT BE SPECIFICALLY CALLED OUT IN THE SECTION OF THE CONSTRUCTION DOCUMENTS. NOTIFY ARCHITECT, ENGINEER AND/OR OWNER OF CONFLICTS OR DISCREPANCIES PRIOR TO SUBMISSION OF BID.

B. PROVIDE THE ARCHITECT AND OWNER WITH A COPY OF THE INSPECTION REPORTS AND APPROVAL CERTIFICATES FROM LOCAL AND STATE INSPECTIONS.

C. EXACT LOCATION AND ELEVATIONS OF ALL EXISTING UTILITIES SHALL BE VERIFIED PRIOR TO ANY INSTALLATION OR CONNECTIONS THEREOF.


D. COORDINATE PIPE ROUTING AWAY FROM ELECTRICAL PANELS. DO NOT INSTALL PIPING OVER ELECTRICAL PANELS.

1. 4" WASTEWATER TO UTILITY SERVICE. CONTRACTOR SHALL WORK WITH LOCAL WASTE WATER AUTHORITY AND BEAR ALL COST FOR INSTALLATION OF A NEW SEWER LINE, CONNECTING TO THE SEWER MAIN FOR A COMPLETE SEWER LINE. AFTER CIVIL WORK IS COMPLETED, CONTRACTOR SHALL INVERT ELEVATION WITH EXISTING SITE UTILITIES PRIOR TO START OF WORK.
2. INSTALL 4" SANITARY SEWER SUB-OUT AND CAP FOR FUTURE TENANT CONNECTION. EXTEND 4" PVC UP 6" ABOVE FINISHED FLOOR. PRIOR TO START OF WORK COORDINATE SUB-OUT LOCATION WITH OWNER.
3. 4" SS RISER FROM BELOW GRADE UP TO CEILING FOR UTILITY SECOND FLOOR TENANT CONNECTION. CAP 12" BELOW CEILING.
4. 2" VENT TO 3" VENT THRU ROOF. LOCATE MINIMUM 3'-0" FROM EDGE OF ROOF AND 10'-0" FROM RTU OUTSIDE AIR INTAKE. COORDINATE PIPE PENETRATION WITH ROOFING CONTRACTOR SO NOT TO VOID ROOF WARRANTY. SEAL ROOF PENETRATION WEATHERTIGHT.
5. 2"V RISER FROM FIRST FLOOR FIXTURES.

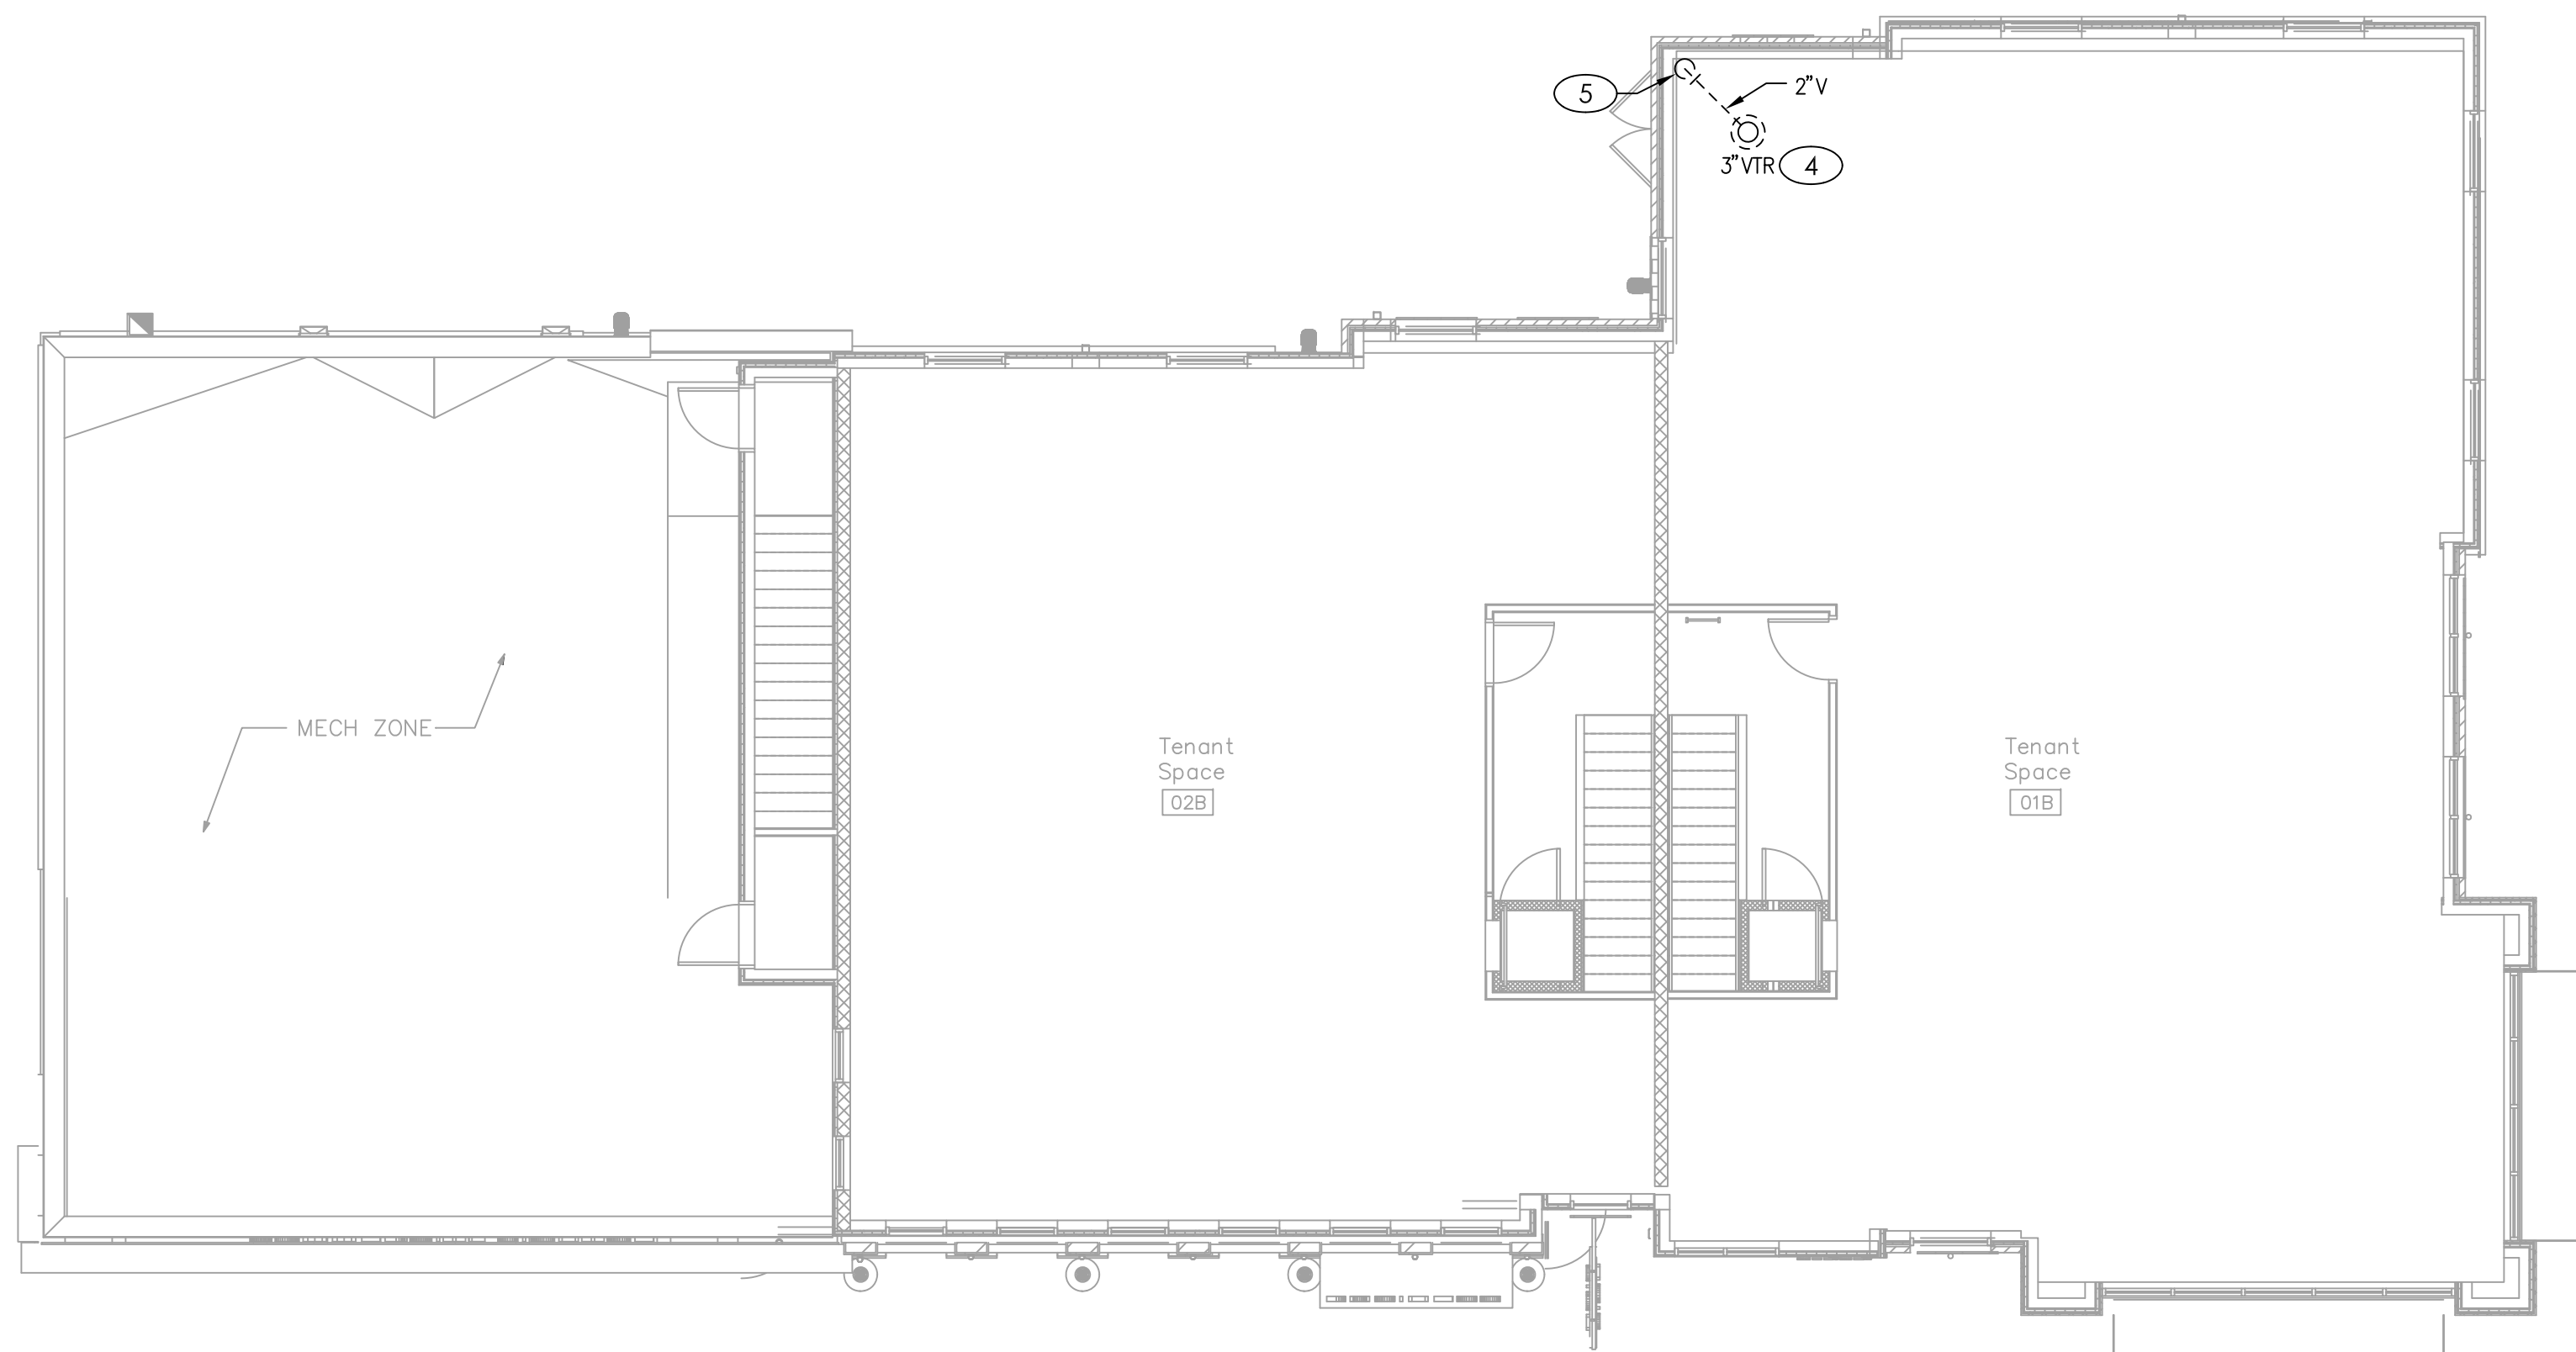

SCALE : 1/8" = 1'-0"

2

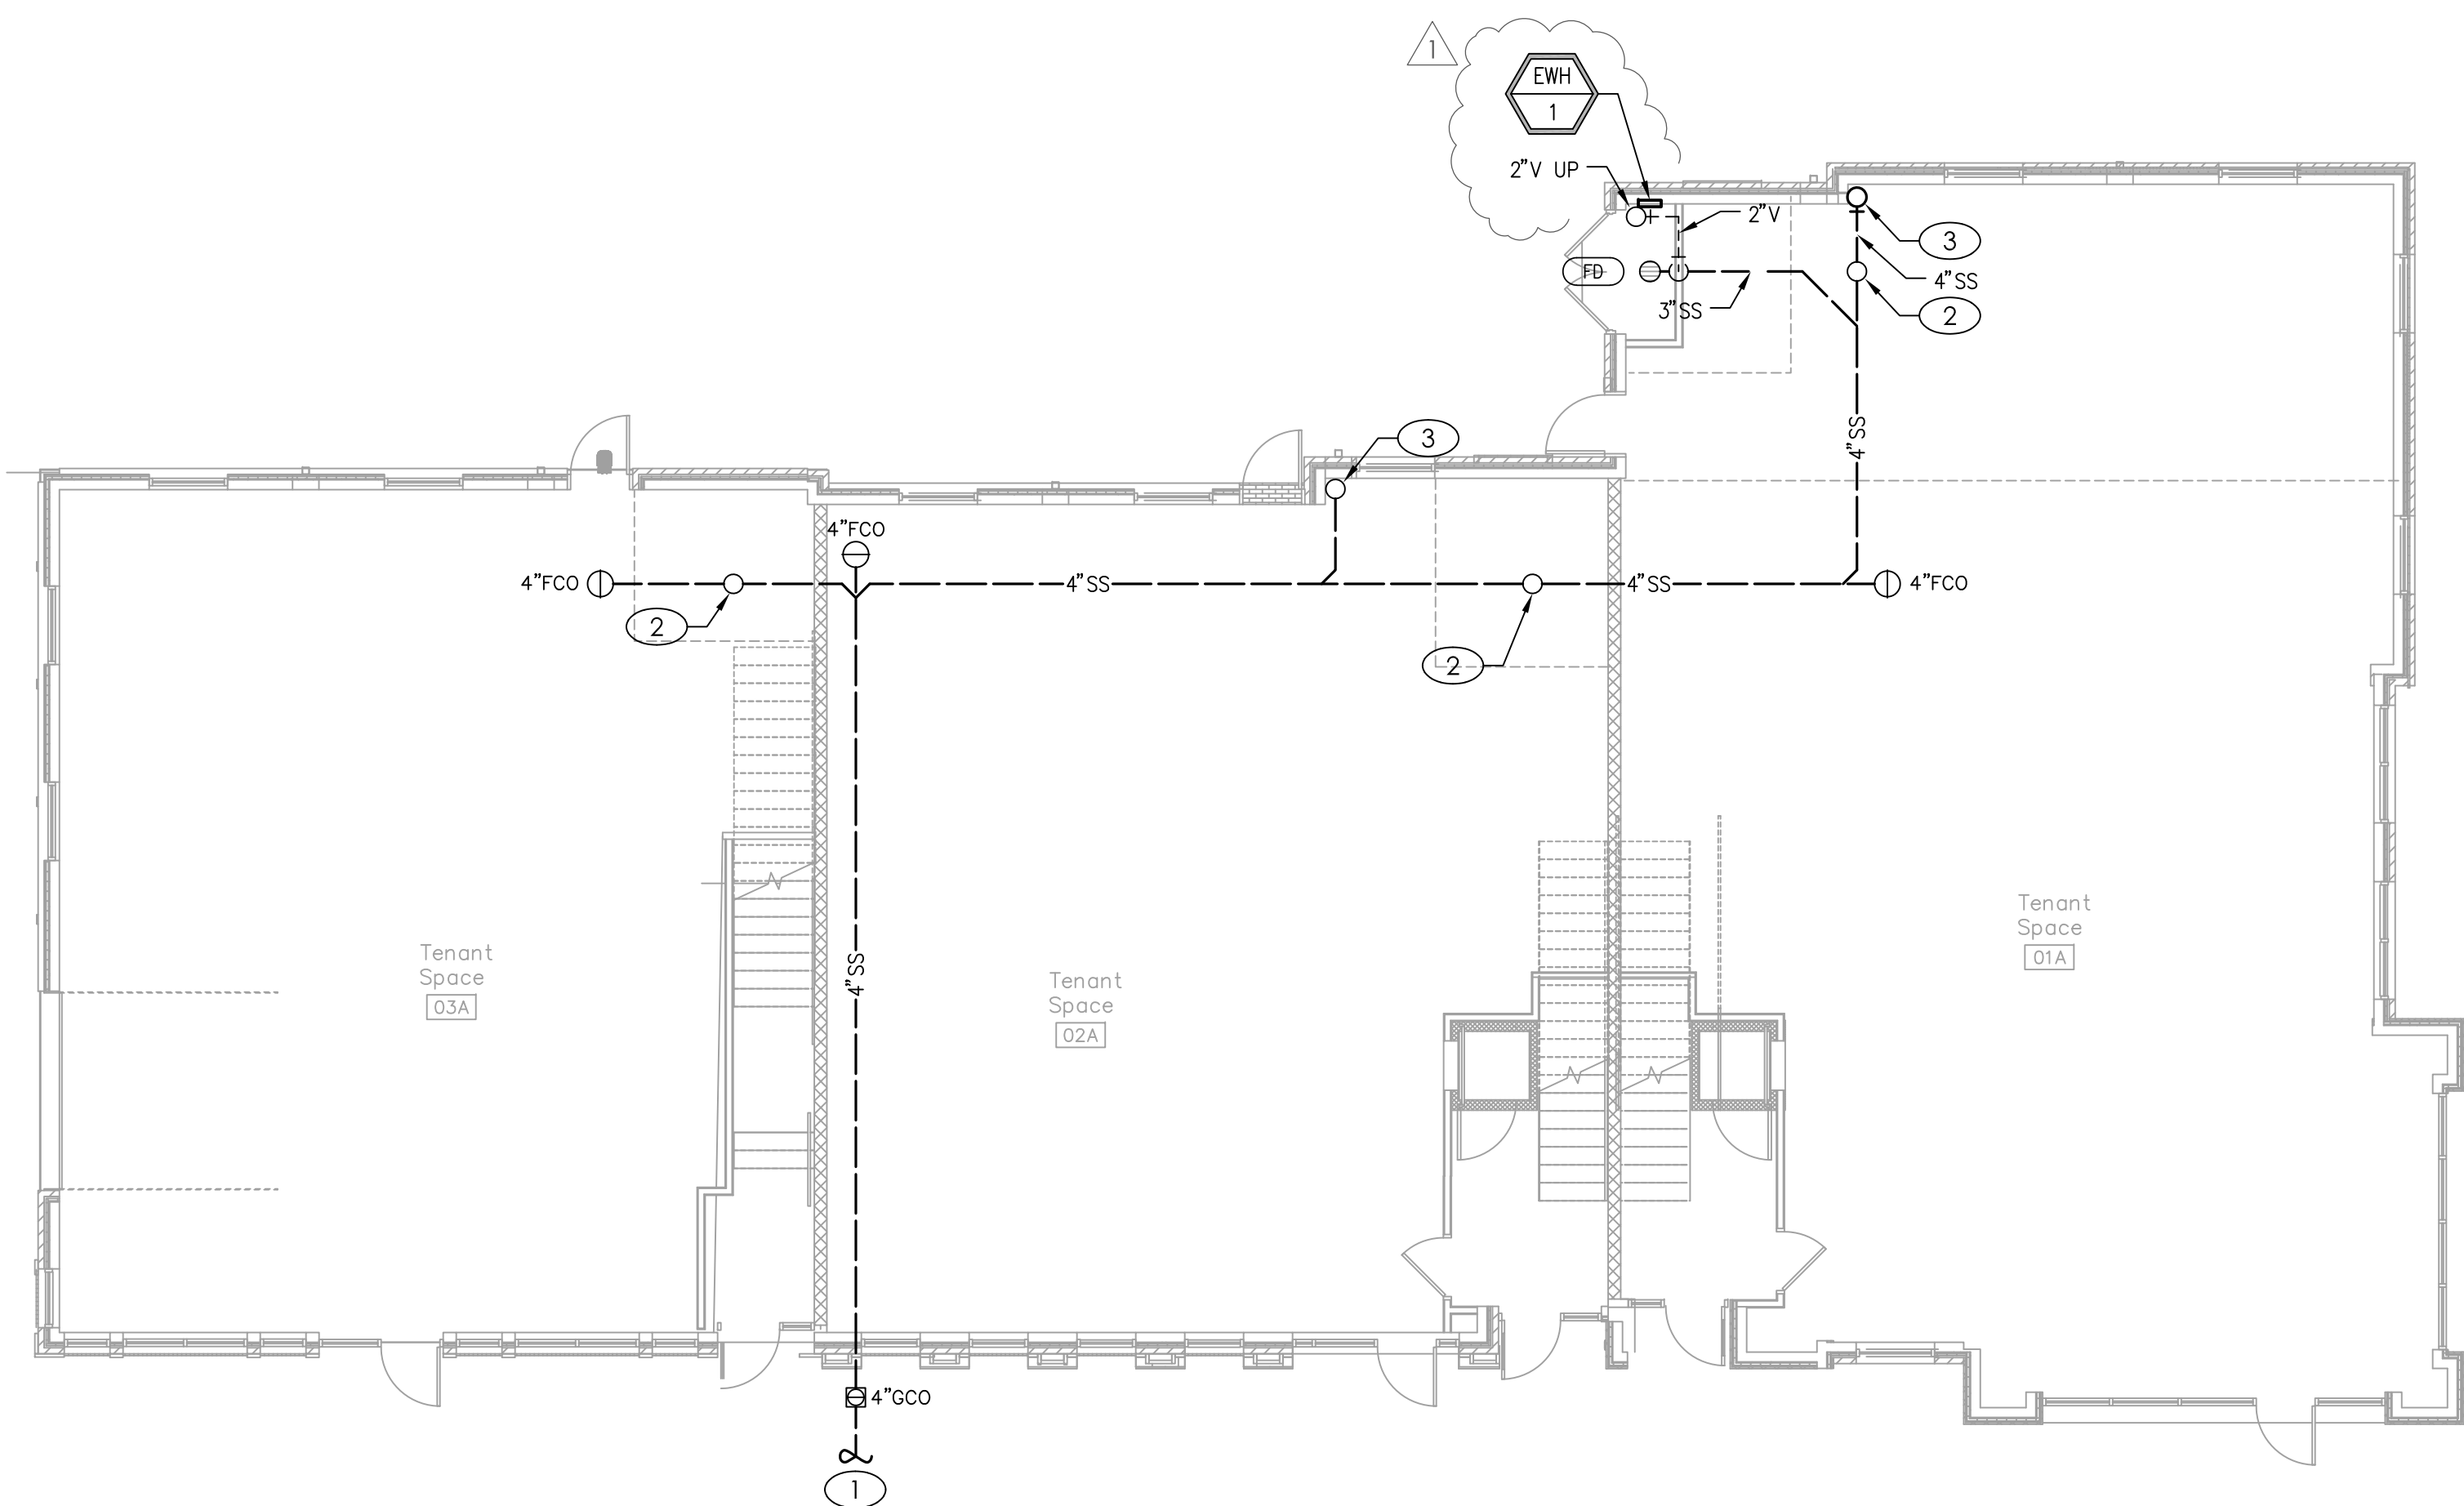

SCALE : 1/8" = 1'-0"

1



LOT 7, BUILDING 31

3140 SW LONGVIEW BLVD
LEE'S SUMMIT, MO. 64081




08-17-2021

REV	ISSUE	DATE
1	PLANCHECK	2021 08 11

MECHANICAL & PLUMBING PLANS

MP101

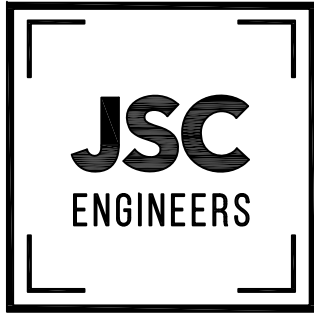


GENERAL NOTES

- A. DRAWINGS ARE DIAGRAMMATIC ONLY AND REPRESENT THE GENERAL SCOPE OF WORK. REVIEW THE GENERAL NOTES, SPECIFICATIONS AND PLANS FOR ADDITIONAL REQUIREMENTS THAT MAY NOT BE SPECIFICALLY CALLED OUT IN THIS PORTION OF THE CONSTRUCTION DOCUMENTS. NOTIFY ARCHITECT, ENGINEER AND/OR OWNER OF CONFLICTS OR DISCREPANCIES PRIOR TO SUBMISSION OF BID.
- B. PROVIDE THE ARCHITECT AND OWNER WITH A COPY OF THE INSPECTION REPORTS AND APPROVAL CERTIFICATES FROM LOCAL AND STATE INSPECTIONS.
- C. EXACT LOCATION AND ELEVATIONS OF ALL EXISTING UTILITIES SHALL BE VERIFIED PRIOR TO ANY INSTALLATION OR CONNECTIONS THEREOF.
- D. COORDINATE PIPE ROUTING AWAY FROM ELECTRICAL PANELS. DO NOT INSTALL PIPING OVER ELECTRICAL PANELS.

KEYED PLAN NOTES


1. 1-1/2" DOMESTIC COLD WATER TO UTILITY SERVICE. SEE CIVIL PLANS FOR CONTRADICTION. CONTRACTOR SHALL WORK WITH THE WATER COMPANY FOR THE INSTALLATION OF A NEW WATER MAIN ENTRANCE, INCLUDING TAP, METER, METER PIT, PIPING, ETC. FOR A COMPLETE INSTALLATION.
2. PROVIDE RPZ BACKFLOW PREVENTER AS SCHEDULED. COORDINATE EXACT LOCATION WITH OWNER PRIOR TO INSTALLATION. INSTALL BACKFLOW PREVENTER 24" ABOVE FINISHED FLOOR (CENTERLINE ELEVATION) AND MINIMUM 12" CLEARANCE FRONT AND BACK. PROVIDE DRAIN FROM BFP TO FLOOR DRAIN AND DISCHARGE WITH AIR GAP. SEE INSTALLATION DETAIL ON SHEET MP001.
3. PROVIDE CAPPED 3/4"CW LINE IN CEILING SPACE FOR FUTURE TENANT.
4. 3/4"CW FROM FIRST FLOOR.
5. 1"CW TO IRRIGATION SYSTEM.
6. 3/4"CW TO FREEZE PROOF ROOF HYDRANT. COORDINATE EXACT LOCATION WITH OWNER PRIOR TO START OF WORK.
7. PROVIDE HEAT TRACE FOR DOMESTIC WATER LINE IN THIS TENANT SPACE. COORDINATE WITH ELECTRICAL CONTRACTOR FOR LOCATION OF POWER SOURCE. EACH TENANT SPACE SHALL HAVE SEPARATE HEAT TRACE SYSTEMS.
8. COORDINATE INSTALLATION OF WATER SERVICE ENTRY WITH ELECTRICAL CONTRACTOR TO ALLOW FOR REQUIRED ELECTRICAL PANEL WORKING CLEARANCES. COORDINATE REQUIREMENT PRIOR TO START OF WORK.

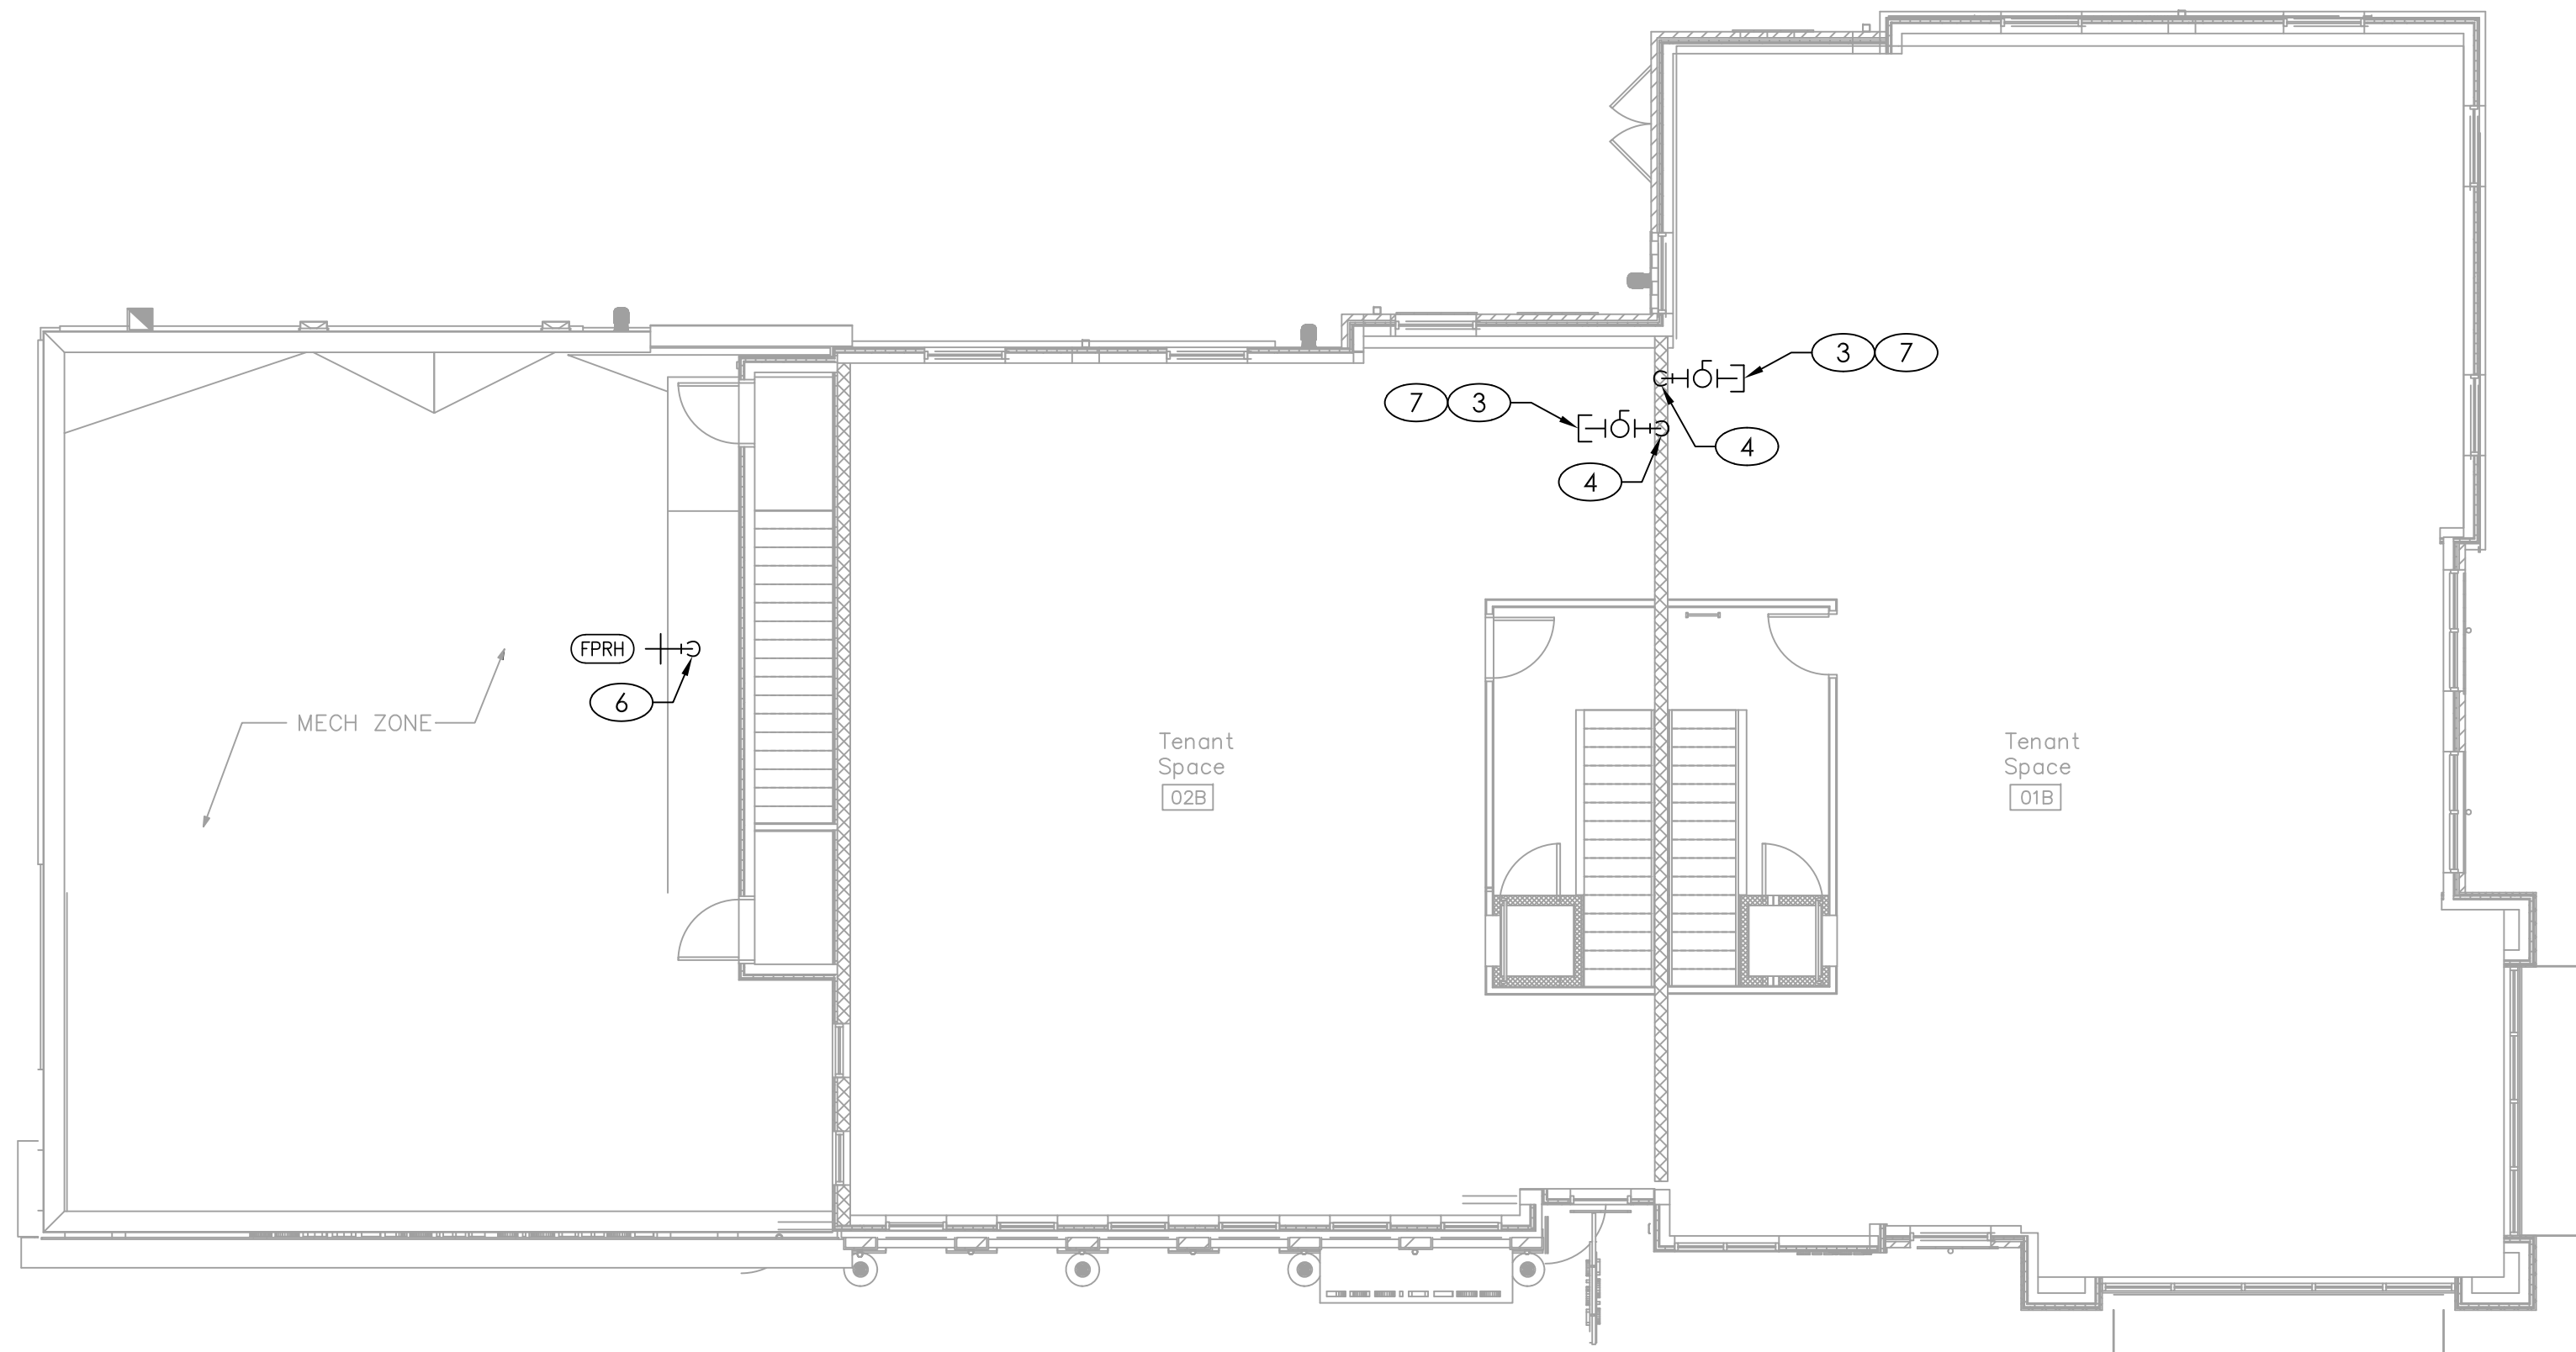

SECOND FLOOR WATER & GAS PLAN

SCALE : 1/8" = 1'-0"

2

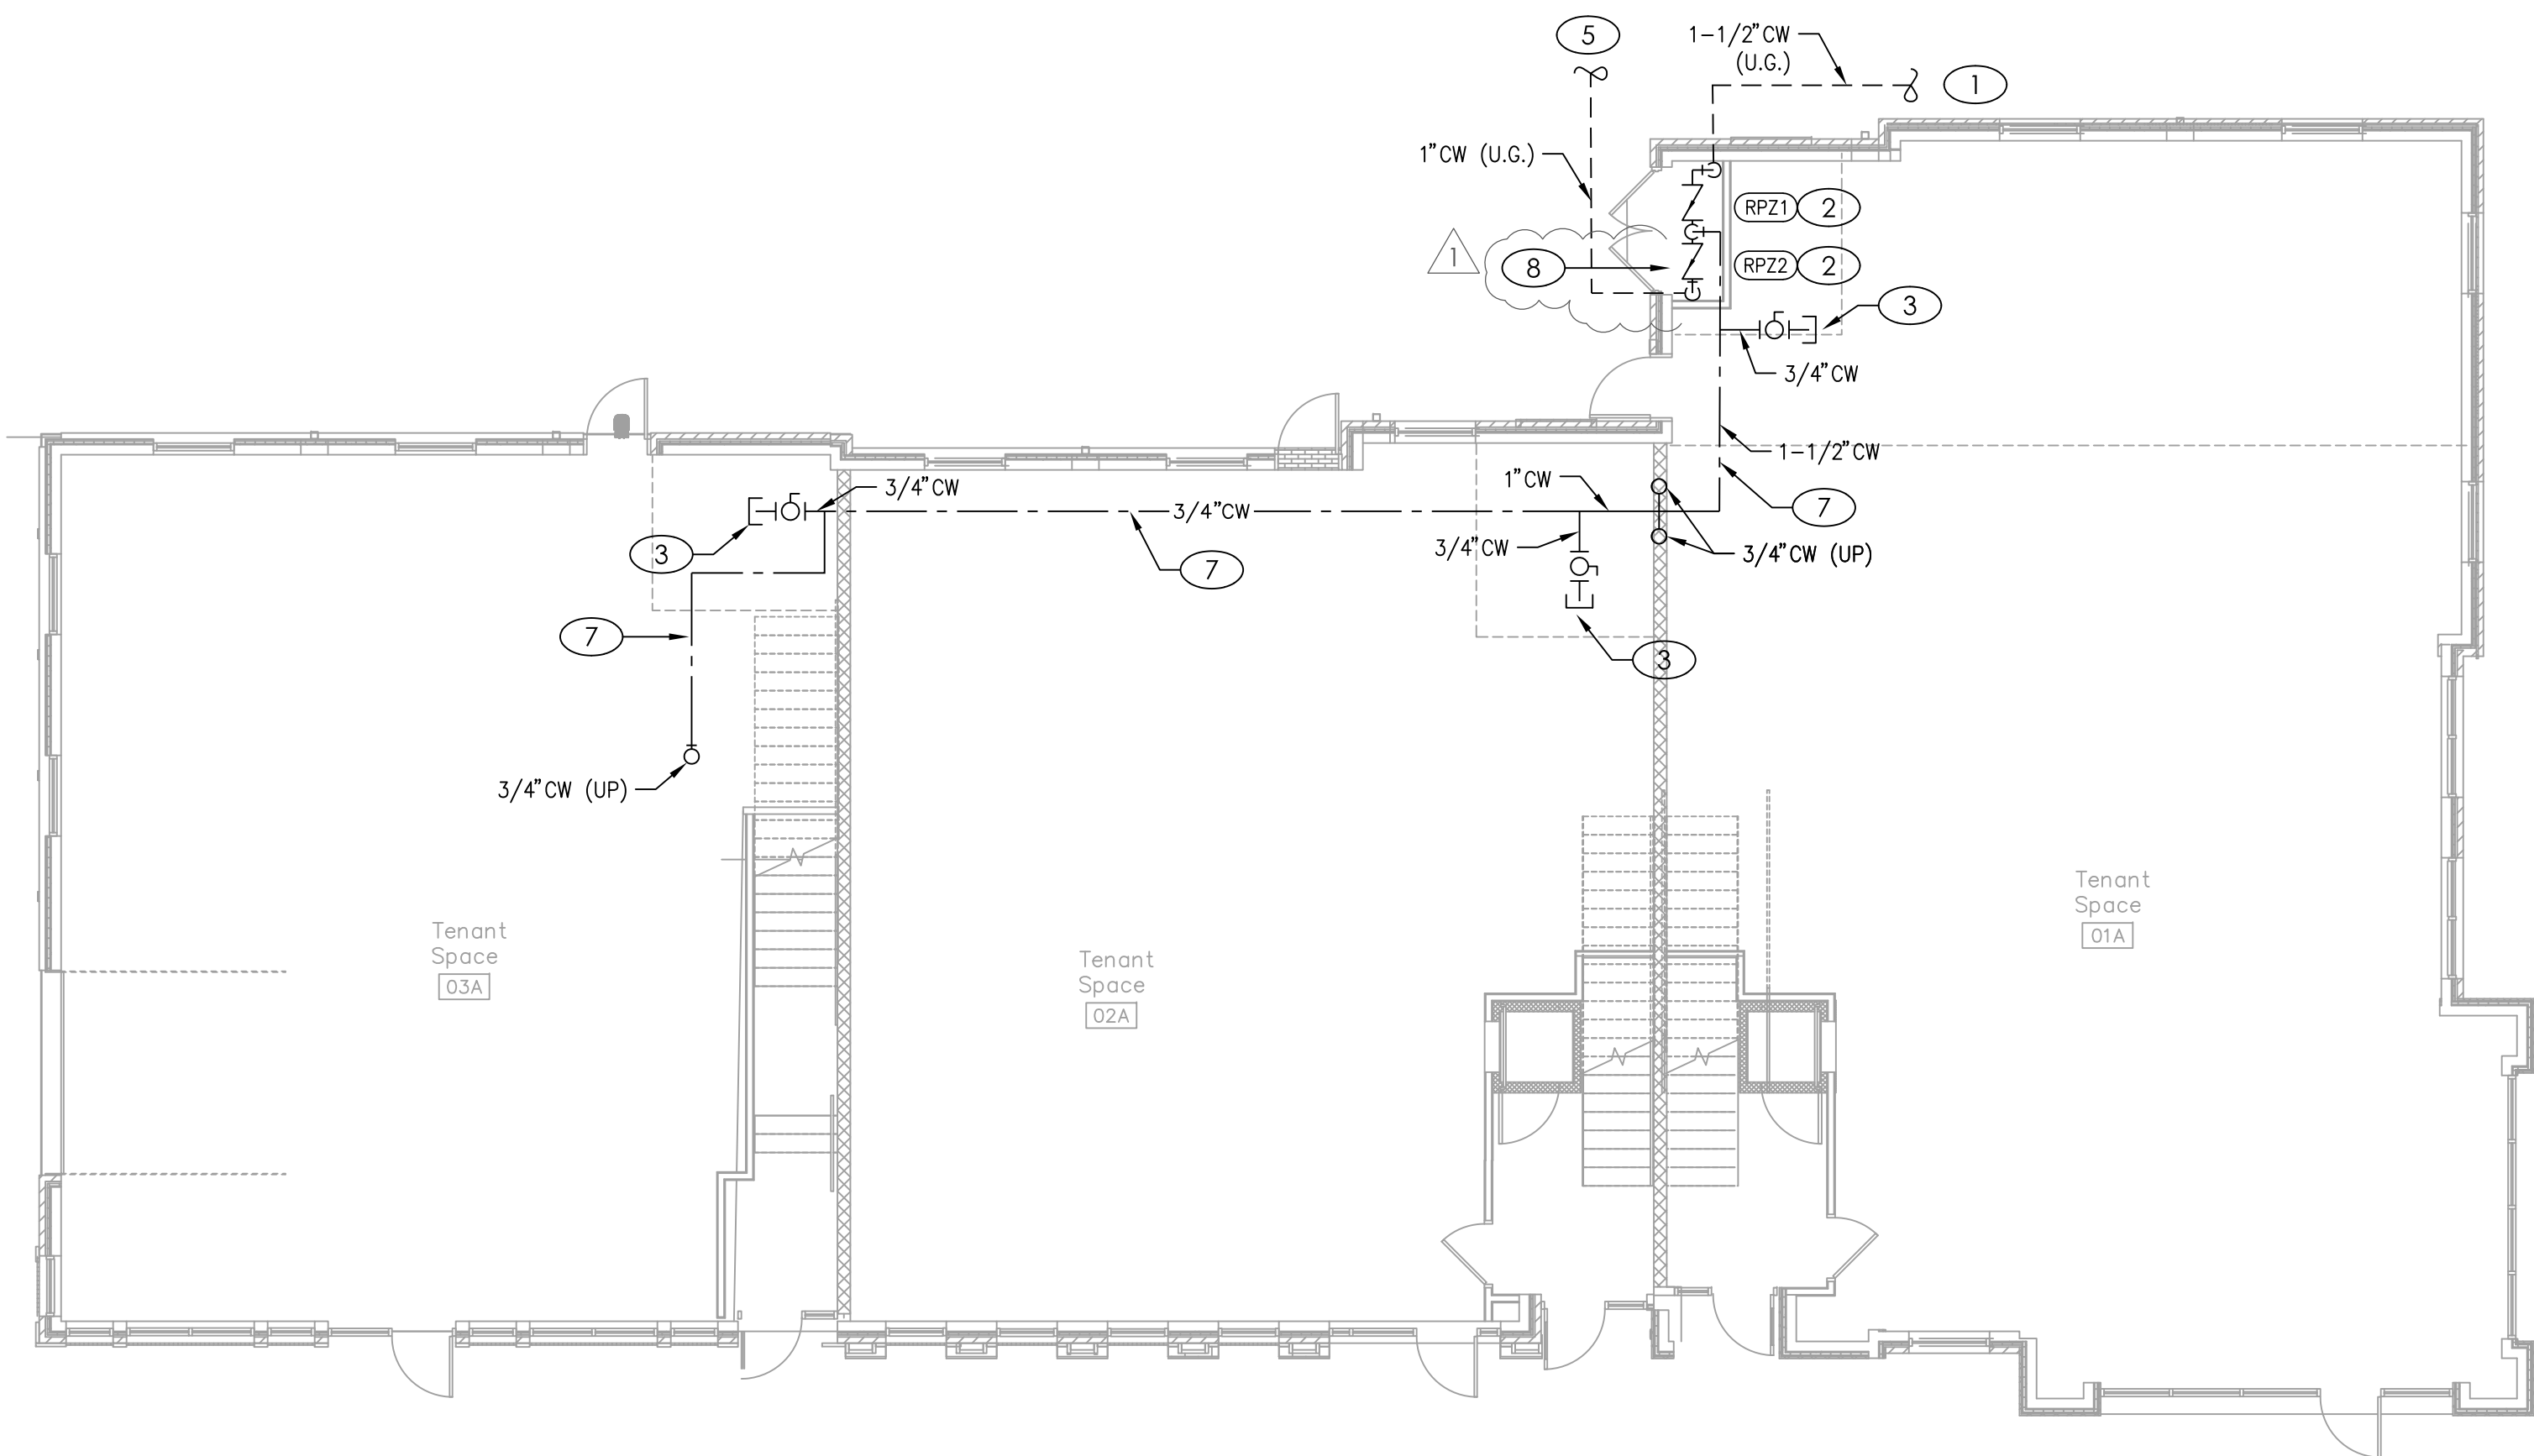

FIRST FLOOR WATER & GAS PLAN

SCALE : 1/8" = 1'-0"

1



LOT 7, BUILDING 31

3140 SW LONGVIEW BLVD
LEE'S SUMMIT, MO 64081



REV	ISSUE	DATE
1	PLANCHECK	2021 08 17

PLUMBING PLANS:
WATER & GAS

MP102

ELECTRICAL SPECIFICATIONS

PART I – GENERAL

A. CONDITIONS

- FURNISH AND INSTALL A COMPLETELY WIRED AND OPERATIONAL ELECTRICAL SYSTEM AS SHOWN ON THE DRAWINGS AND SPECIFIED HEREIN, INCLUDING BUT NOT LIMITED TO, THESE MAJOR ITEMS:
A. LIGHTING FIXTURES AS INDICATED AND SPECIFIED ON THE PLANS.
B. ELECTRICAL PANELS, SERVICE, CONDUIT, WIRING, ETC., FOR ALL OUTLETS AND EQUIPMENT.
C. TELEPHONE, TELEVISION, AND FIRE ALARM, OUTLETS AND CONDUIT AS INDICATED.
- OBTAIN AND REVIEW ALL OTHER DRAWINGS INCLUDING REFLECTED CEILING PLAN, INTERIOR AND EXTERIOR ELEVATIONS, FURNITURE PLANS AND ALL MILL WORK DRAWINGS. COORDINATE INSTALLATION OF ALL ELECTRICAL DEVICES AND EQUIPMENT PRIOR TO ROUGH-IN.
- OBTAIN SUBMITTAL AND SHOP DRAWINGS FROM OTHER TRADES AND EQUIPMENT TO COORDINATE INSTALLATION ACCORDINGLY.
- INSTALLATION SHALL COMPLY WITH ALL CURRENT APPLICABLE CODES AND GOVERNING AGENCIES HAVING JURISDICTION.
- FIRE ALARM SYSTEM, IF REQUIRED PER IBC, SHALL BE DESIGN-BUILD BY OWNER'S/GC'S FIRE ALARM CONTRACTOR. DESIGN SHALL BE IN ACCORDANCE WITH NFPA 72. FIRE ALARM CONTRACTOR SHALL SUBMIT STAMPED DRAWINGS TO AHJ FOR REVIEW AND APPROVAL. FIRE ALARM CONTRACTOR IS RESPONSIBLE FOR TESTING AND VERIFYING THAT THE AUDIBILITY OF THE FIRE ALARM SYSTEM MEETS A MINIMUM OF 15 DBA ABOVE AMBIENT NOISE LEVELS AND HORN WHERES REQUIRED TO MAINTAIN MINIMUM LEVELS.
- PROVIDE FIRE STOP ON ALL PIPING THAT PENETRATES RATED WALLS, METHOD OF FIRE STOP SHALL MEET WALL RATING. REFER TO ARCHITECTURAL DRAWINGS FOR LOCATION OF FIRE RATED WALLS. THIS CONTRACTOR SHALL PROVIDE FIRE RATED ENCLOSURES AROUND ALL ROUGH-IN BOXES, PANELS, ETC. THAT ARE LOCATED IN FIRE RATED WALLS AND SHALL FIRE CAULK ALL OPENINGS IN RATED ASSEMBLIES.

B. RELATED WORK BY OTHERS

- THE ELECTRICAL CONTRACTOR SHALL PROVIDE CONDUIT, TRENCH, AND BACKFILL FOR ELECTRICAL SERVICE ENTRANCE FROM THE MAIN SERVICE TO UTILITY POINT OF ELECTRICAL SERVICE. ELECTRICAL CONTRACTOR SHALL COORDINATE THE INSTALLATION OF THE ELECTRICAL SERVICE ENTRANCE WITH SERVING UTILITY COMPANY.
- THE ELECTRICAL CONTRACTOR SHALL PROVIDE CONDUIT, TRENCH, AND BACKFILL FOR PRIMARY PHONE AND CATV SERVICE FROM THE TELEPHONE TERMINAL BOARD OR CABINET TO THE PHONE COMPANY AND CATV COMPANY POINT OF SERVICE. COORDINATE WITH LOCAL UTILITY COMPANIES.

C. CODES, REGULATIONS, AND STANDARDS

- THE INSTALLATION SHALL COMPLY WITH APPLICABLE LOCAL AND STATE CODES AND ORDINANCES, WITH THE REGULATIONS OF THE LATEST EDITION OF THE NATIONAL ELECTRIC CODE AND WITH THE REQUIREMENTS OF THE POWER, TELEPHONE, AND CATV COMPANIES FURNISHING SERVICES TO THIS INSTALLATION.
- THE LATEST EDITIONS OF THE FOLLOWING INDUSTRY STANDARDS, SPECIFICATIONS, AND CODES ARE MINIMUM REQUIREMENTS:
A. THE NATIONAL ELECTRICAL MANUFACTURERS' ASSOCIATION STANDARDS.
B. THE NATIONAL ELECTRICAL CODE, INCLUDING LOCAL AMENDMENTS.
C. UNDERWRITER LABORATORIES INCORPORATED STANDARDS.
D. AMERICAN NATIONAL STANDARDS INSTITUTE.
E. INTERNATIONAL BUILDING CODE.

D. INSPECTION OF SITE

- PRIOR TO SUBMITTING A BID FOR ELECTRICAL WORK, THE CONTRACTOR SHALL VISIT THE SITE OF THE PROPOSED CONSTRUCTION AND SHALL THOROUGHLY ACQUAINT HIMSELF WITH EXISTING UTILITIES, AND WORKING CONDITIONS TO BE ENCOUNTERED, ETC. ALLOWANCE WILL NOT BE MADE FOR NONCOMPLIANCE WITH THIS CONDITION AFTER BIDDING.
- ELECTRICAL INSTALLATION SHALL MEET THE EXISTING CONDITIONS.

E. STORAGE AND HANDLING OF MATERIAL

- DELIVER MATERIALS AND EQUIPMENT TO THE PROJECT IN THE MANUFACTURER'S ORIGINAL, UNOPENED, LABELED CONTAINERS. PROTECT AGAINST MOISTURE, TAMPERING, OR DAMAGE FROM IMPROPER HANDLING OR STORAGE. CONTRACTOR SHALL PROTECT AND BE RESPONSIBLE FOR ANY DAMAGE TO WORK OR MATERIALS UNTIL FINAL ACCEPTANCE BY THE OWNER, AND SHALL MAKE GOOD WITHOUT COST TO THE OWNER, ANY DAMAGE OR LOSS THAT MAY OCCUR DURING THIS PERIOD.
- ARRANGE FOR TIMELY DELIVERY OF MATERIALS AND EQUIPMENT TO THE JOB SITE IN ORDER TO MINIMIZE THE LENGTH OF TIME BETWEEN DELIVERY AND INSTALLATION.
- COVER AND PROTECT ANY MATERIAL WHICH MAY BE AFFECTED BY THE WEATHER WHILE IN TRANSIT OR STORED AT THE PROJECT SITE. ANY MATERIAL FOUND DEFECTIVE OR NOT INSTALLED IN ACCORDANCE WITH THE CONTRACT DOCUMENTS MAY BE REJECTED BY THE ENGINEER.

F. CLEANUP

- KEEP THE PREMISES FREE FROM ACCUMULATION OF WASTE MATERIALS, OR RUBBISH CAUSED BY EMPLOYEES OR WORK UNDER THIS DIVISION OF THE SPECIFICATIONS. AT THE COMPLETION OF THE WORK REMOVE ALL SURPLUS MATERIALS, TOOLS, ETC., AND LEAVE THE PREMISES BROOM-CLEAN.

G. EXCAVATION, CUTTING, AND FITTING

- PERFORM ALL EXCAVATION AND BACK FILLING REQUIRED FOR WORK PERFORMED UNDER THIS DIVISION OF THE SPECIFICATIONS. USE EXCAVATED MATERIALS FOR BACKFILL UNLESS OFF SITE MATERIALS ARE DEDICED NECESSARY.
- PERFORM THE EXCAVATION, CUTTING, FITTING, REPAIRING, AND FINISHING OF THE WORK NECESSARY FOR THE INSTALLATION OF THE EQUIPMENT OF THIS SECTION. HOWEVER, NO CUTTING OF THE WORK OF OTHER TRADES OR OF ANY STRUCTURAL MEMBERS SHALL BE DONE WITHOUT THE CONSENT OF THE ARCHITECT.

H. DRAWINGS

- THE DRAWINGS INDICATE THE GENERAL ARRANGEMENT AND LOCATIONS OF THE ELECTRICAL WORK DATA PRESENTED ON THESE DRAWINGS ARE AS ACCURATE AS PLANNING CAN DETERMINE, BUT FIELD VERIFICATION OF ALL DIMENSIONS, LOCATIONS, LEVELS, ETC., TO SUIT FIELD CONDITIONS IS REQUIRED. REVIEW ALL ARCHITECTURAL, STRUCTURAL, AND MECHANICAL DRAWINGS AND ADJUST ALL WORK TO MEET THE REQUIREMENTS OF CONDITIONS SHOWN. THE ARCHITECTURAL DRAWINGS SHALL TAKE PRECEDENCE OVER ALL OTHER DRAWINGS. DISCREPANCIES BETWEEN DIFFERENT PLANS, OR BETWEEN DRAWINGS AND SPECIFICATIONS, OR REGULATIONS AND CODES GOVERNING THE INSTALLATION SHALL BE BROUGHT TO THE ATTENTION OF THE ENGINEER IN WRITING BEFORE THE DATE OF BID OPENING. IF DISCREPANCIES ARE NOT REPORTED, THE CONTRACTOR SHALL BID THE GREATER QUANTITY OR BETTER QUALITY, AND APPROPRIATE ADJUSTMENTS WILL BE MADE AFTER CONTRACT AWARD. CONTRACTOR SHALL BE RESPONSIBLE TO FIELD MEASURE AND CONFIRM MOUNTING HEIGHTS AND LOCATION OF ELECTRICAL EQUIPMENT WITH RESPECT TO COUNTERS, RADIATION, ETC. DO NOT SCALE DISTANCES OFF THE ELECTRICAL DRAWINGS. USE ACTUAL BUILDING DIMENSIONS.

I. COOPERATION WITH OTHER CONTRACTORS

- COOPERATE WITH THE OTHER TRADES SO THAT THE INSTALLATION OF THE ELECTRICAL OUTLETS AND EQUIPMENT WILL BE PROPERLY COORDINATED. CONDUIT, LIGHTING FIXTURES, AND OTHER EQUIPMENT LOCATIONS SHALL BE VERIFIED WITH OTHER TRADES TO AVOID CONFLICT WITH THE PIPING, DUCTWORK, STEEL, BEAMS, OR OTHER OBSTRUCTIONS.
- CAREFULLY VERIFY THE LOCATIONS OF THE OUTLET BOXES AND DETERMINE THAT THEY HAVE NOT BEEN DISTURBED DURING THE INSTALLATION OF MATERIALS OF OTHER TRADES.
- COORDINATE THE LOCATION OF THE TRENCHES AND CONDUITS FOR ELECTRICAL AND TELEPHONE UTILITY SERVICES WITH THE GENERAL CONTRACTOR.
- COORDINATE HVAC AND PLUMBING EQUIPMENT CONNECTION REQUIREMENTS WITH HVAC AND PLUMBING CONTRACTORS.

J. RECORD DRAWINGS

- THE ELECTRICAL CONTRACTOR SHALL MAINTAIN A SET OF DRAWINGS AT THE JOB SITE FOR THE EXCLUSIVE PURPOSE OF MAINTAINING A RECORD OF ALL WORK INSTALLED AND TO SHOW ANY DEVIATIONS FROM THE WORK INDICATED ON THE DRAWINGS.
A. AT THE COMPLETION OF THE PROJECT, ONE SET OF REPRODUCIBLE DRAWINGS, SHOWING ALL RECORD CONDITIONS, SHALL BE DELIVERED TO THE OWNER FOR ACCEPTANCE PRIOR TO FINAL PAYMENT.

PART II – PRODUCTS AND EXECUTION

A. MATERIALS

- ALL MATERIALS SHALL BE NEW AND OF QUALITY AS SPECIFIED ON THE PLANS OR SPECIFICATIONS AND MUST CARRY THE UNDERWRITER'S LABORATORIES APPROVAL COVERING THE PURPOSE FOR WHICH THEY ARE USED, IN ADDITION TO MEETING ALL REQUIREMENTS OF THE CURRENT APPLICABLE CODES AND REGULATIONS.

B. SHOP DRAWINGS AND APPROVALS

- THE ITEMS SPECIFIED HEREIN AND ON DRAWINGS ARE USED AS A STANDARD OF QUALITY. ANY MATERIALS OF EQUAL QUALITY AND AESTHETIC VALUE WILL BE GIVEN CONSIDERATION AS A SUBSTITUTE FOR THE MATERIALS SPECIFIED. NO APPROVAL WILL BE GIVEN TO A SPECIFIC CATALOG NUMBER, MODEL, OR TYPE OF EQUIPMENT, PRIOR TO BIDDING. AFTER BIDDING, THE DECISION OF THE ARCHITECT AND/OR ENGINEER DETERMINING EQUAL MATERIALS WILL BE FINAL.

- THE CONTRACTOR SHALL SUBMIT SEVEN (7) IDENTICAL BOUND SETS OF SHOP DRAWINGS ON THE FOLLOWING ITEMS:
A. LIGHTING FIXTURE CUTS AND PERFORMANCE DATA.
B. OUTLINE DRAWINGS AND DATA SHEETS OF EACH PANELBOARD, LOAD CENTERS, AND DISTRIBUTION PANELS.
C. OUTLINE DRAWINGS OF ALL SWITCH GEAR COMPONENTS.
D. WIRING DEVICES AND COVER PLATES.
E. ALL CIRCUIT BREAKERS INSTALLED IN PANELBOARDS, LOAD CENTERS, AND DISTRIBUTION PANELS. SUBMIT ITEMS AT ONE TIME IN A NEAT AND ORDERLY MANNER WITHIN 15 DAYS OF AWARD OF CONTRACT. PARTIAL SUBMITTALS WILL NOT BE ACCEPTABLE.

C. SYSTEM GROUNDING

- GROUNDING SHALL COMPLY WITH REQUIREMENTS OF ARTICLE 250. ALL EXPOSED NONCURRENT CARRYING METALLIC PARTS OF ELECTRICAL EQUIPMENT, METALLIC RACEWAY SYSTEMS, METALLIC CABLE ARMOR, GROUNDING CONDUCTOR OF NONMETALLIC SHEATHED CABLES, GROUNDING CONDUCTOR IN NONMETALLIC RACEWAYS, AND GROUNDING CONDUCTORS OF THE WIRING SYSTEM SHALL BE GROUNDED.
- THE GROUNDING CONDUCTOR (NEUTRAL) OF THE WIRING SYSTEM SHALL BE CONNECTED TO THE SYSTEM GROUNDING CONDUCTOR AT A SINGLE PLACE IN EACH SYSTEM BY REMOVABLE BONDING JUMPERS, SIZED ACCORDING TO THE APPLICABLE PROVISIONS OF THE NATIONAL ELECTRICAL CODE. THE GROUNDED CONDUCTOR (NEUTRAL) TO THE GROUNDING CONDUCTOR CONNECTION SHALL BE LOCATED IN THE ENCLOSURE FOR THE SYSTEM'S OVERCURRENT PROTECTION OR WHERE OTHERWISE INDICATED ON THE PLANS OR SPECIFICATIONS.
- A GROUND BUS SEPARATE FROM THE NEUTRAL BUS SHALL BE PROVIDED IN ALL DISTRIBUTION PANELS AND PANELBOARDS. PROPER TORQUE ON GROUND BUS SHALL BE VERIFIED, PER MANUFACTURER'S RECOMMENDATIONS, PRIOR TO ENERGIZING EQUIPMENT.
- GROUND BUSES AND NEUTRAL BUSES IN ALL DISTRIBUTION PANELS, LOAD CENTERS, PANELBOARDS, AND THOSE PROVIDED IN ANY EQUIPMENT SHALL BE ISOLATED EXCEPT WHERE REQUIRED TO BE CONNECTED AS SPECIFIED ABOVE FOR THE SERVICE ENTRANCE.
- WHEN INDICATED ON THE DRAWINGS, EQUIPMENT GROUNDING CONDUCTORS SHALL BE EXTENDED FROM THE GROUND BUS IN THE DISTRIBUTION EQUIPMENT TO THE RECEPTACLE, FIXTURE OR DEVICE LUGS WHERE THEY ARE PROVIDED. WHERE LUGS ARE NOT PROVIDED, EQUIPMENT GROUNDING CONDUCTORS SHALL BE CONNECTED TO EQUIPMENT ENCLOSURES. THE CONNECTIONS SHALL BE ARRANGED SUCH THAT REMOVAL OF THE RECEPTACLE, EQUIPMENT GROUND CONDUCTORS, OR GROUND JUMPERS FROM GROUND RACEWAYS MAY NOT BE USED AS A GROUNDING CONDUCTOR FOR POWER AND LIGHTING CIRCUITS. ALL CONDUIT SHALL HAVE SEPARATE CODE SIZED GREEN GROUND WIRE INSTALLED IN THE CONDUIT TO INSURE A CONTINUOUS GROUNDING PATH.
- IN INACCESSIBLE LOCATIONS, MAKE CONNECTIONS BY EXOTHERMIC WELD PROCESS.
- IN ACCESSIBLE LOCATIONS, CONNECTIONS SHALL BE MADE WITH BOLTED THROUGH, APPROVED SOLDERLESS BRONZE GROUNDING DEVICES.

D. WIRE

- CONDUCTOR SIZES SHOWN ON THE DRAWINGS ARE BASED ON COPPER WIRE. UNLESS OTHERWISE SPECIFIED, ALL WIRE SHALL BE TYPE WHW OR SE FOR FEEDERS OR BRANCH CIRCUITS LARGER THAN 4 AWG, TYPE THHN/THWN INSULATION FOR FEEDERS AND BRANCH CIRCUITS 4 AWG AND SMALLER. ALL BRANCH CIRCUIT WIRING SHALL BE COPPER.
- ALUMINUM CONDUCTORS MAY BE UTILIZED FOR SERVICE ENTRANCE AND PANEL FEEDERS. CONDUCTORS SHALL BE ALUMINUM ALLOW AA-8000 SERIES.
- THE WIRES SHALL BE MARKED WITH COLOR TO SIMPLIFY CIRCUIT IDENTIFICATION. UNLESS OTHERWISE REQUIRED BY LOCAL ORDINANCES, GROUND WIRES SHALL BE GREEN, NEUTRAL WIRES SHALL BE 120V-WHITE, AND LIVE WIRES 208Y/120V AND 120/240 SHALL BE BLACK (PHASE A), RED (PHASE B), AND BLUE (PHASE C). CIRCUIT SHALL BE LABELED IN EACH J-BOX.
- ALL CONDUCTORS SHALL BE RATED 600 VOLT.
- SPLICES IN EXTERIOR PULL BOXES AND MANHOLES SHALL BE WEATHERPROOF USING "SCOTCHCAST" SPLICE KIT OR APPROVED EQUAL. SEAL ENDS OF CONDUITS AND DUCTS WITH "DUCISEAL" OR APPROVED EQUAL.
- PROVIDE SOLID CONDUCTOR FOR 12 AWG AND SMALLER.
- ALL WIRING WITHIN RESIDENTIAL UNITS ONLY MAY BE TYPE NM CABLE.
- NO WIRE SHALL BE INSTALLED IN THE CONDUIT SYSTEM UNTIL THE CONDUIT SYSTEM IS COMPLETE. USE MINERALAC NO. 100 OR EQUIVALENT AS A LUBRICANT TO FACILITATE THE INSTALLATION OF THE CONDUCTORS IN THE CONDUIT SYSTEM.
- MC CABLE WITH COPPER CONDUCTORS AND GROUND WIRE MAY BE USED WHERE PERMITTED.

E. CONDUIT

- ALL WIRING SHALL BE INSTALLED IN LISTED METALLIC CONDUIT EXCEPT AS PERMITTED IN OTHER SECTIONS. RGS, WITH A 20 MIL PVC COATING WILL BE USED WHEN IN CONTACT WITH EARTH. IMC MAY BE USED IN INDOOR LOCATIONS NOT IN CONTACT WITH EARTH. EMT MAY BE USED IN INDOOR LOCATIONS NOT IN CONTACT WITH EARTH, NOT IN CONCRETE SLABS OR WALLS AND NOT SUBJECT TO DAMAGE. PVC MAY BE USED IN OR BELOW CONCRETE AND DIRECT BURIED IN EARTH. FLEXIBLE STEEL CONDUIT SHALL BE USED FOR INDOOR FANL CONNECTIONS TO EQUIPMENT IN LENGTHS NOT TO EXCEED 72". LIQUID-TIGHT FLEXIBLE STEEL CONDUIT SHALL BE FOR OUTDOOR FANL CONNECTIONS TO EQUIPMENT NOT TO EXCEED 48".
- WHERE CONDUIT ENTERS OUTLET BOXES, FIXTURES OR CABINETS, FIRMLY FASTEN WITH STEEL SET SCREW, CONDUIT CONNECTORS, OR CABLE LOCKNUTS FOR EMT. ALL CONNECTIONS SHALL HAVE BUSSINGS OR INSULATED THROUGH CONNECTORS. FIRMLY FASTEN CONDUIT TO THE BUILDING CONSTRUCTION. RUN EXPOSED CONDUIT PARALLEL TO THE BUILDING LINES, SUPPORTED BY APPROPRIATE HANGERS (UNISTRUT, T & B OR APPLETON, OR EQUAL).
- COVER METALLIC CONDUIT IN CONTACT WITH EARTH WITH POLYETHYLENE TAPE SPIRAL WRAPPED, 1/2 LAPPED TO PROVIDE 20 MIL THICKNESS. TAPE SHALL BE SCOTCH NO. 50 TAPE. CONDUIT AND DUCTS NOT UNDER BUILDINGS AND FEEDER DUCTS SHALL BE INSTALLED PER N.E.C. 300-5. MAKE JOINTS WITH CONDUIT TO BE WATER TIGHT.
- SCHEDULE 40 PVC CONDUIT SHALL BE PERMITTED UNDERGROUND WITH PROPER FITTINGS, ALL UL APPROVED AND CEMENTED JOINTS. PENETRATIONS THROUGH FLOOR SLABS AND BENDS GREATER THAN 22" SHALL BE WRAPPED RIGID GALVANIZED STEEL ELBOWS.
- FITTINGS AND CONDUIT BODIES SHALL BE STEEL. DIECAST FITTINGS ARE NOT ACCEPTABLE.
- CONDUIT SIZES SHALL BE AS REQUIRED BY CODE AND AS INDICATED OR SPECIFIED.
- ALL EMPTY CONDUIT SYSTEMS SHALL HAVE A 200 LB. TEST NYLON PULL STRING TO FACILITATE INSTALLATION OF FUTURE WIRE.
- WIRING, CONDUITS, AND OUTLETS SHALL BE CONCEALED WITH THE BUILDING STRUCTURE, EXCEPT THAT CERTAIN MOTOR AND LIGHTING FEEDER CONDUITS MAY BE RUN EXPOSED IN CERTAIN AREAS AS INDICATED ON THE DRAWINGS.
- CONDUIT PENETRATION THROUGH ROOF SHALL HAVE ROOF FLASHING WITH CAULK TYPE COUNTER FLASHING SLEEVE. INSTALLATION SHALL BE WATER TIGHT.
- CONDUITS SHALL BE ROUTED PARALLEL AND PERPENDICULAR TO THE STRUCTURE.

F. OUTLET, PULL, AND JUNCTION BOXES

- EACH SWITCH, LIGHT, RECEPTACLE OR OTHER OUTLET, INSTALLED IN RESIDENTIAL UNITS, SHALL BE PROVIDED WITH A CODE SIZED, PLASTIC OUTLET BOX. JUNCTION AND PULL BOXES SHALL BE CODE SIZED, PLASTIC OR METAL OUTLET BOX. ALL OTHER OUTLET BOXES SHALL BE STEEL.
- BOXES INSTALLED IN POURED CEMENT FLOORS SHALL BE FLUSH TYPE CAST IRON OR STEEL WITH WATER TIGHT GASKETED COVERS. WHERE BOXES ARE INSTALLED IN FLOORS WITH TILE OR CARPET FLOOR COVERING, COVERS SHALL BE OF THE RECESSED TYPE TO ACCOMMODATE THE FLOOR COVERING. BOXES INSTALLED FOR THE ALARM, COMPUTER, AND SECURITY SYSTEM SHALL BE PROVIDED WITH APPROPRIATE COVER PLATES.
- BOXES FOR TELEPHONE, COMPUTER, T.V., FIRE ALARM, SECURITY, AND SIMILAR SYSTEMS SHALL BE MINIMUM 2-1/8" DEEP.

G. WIRING DEVICES

- WALL SWITCHES SHALL BE SPECIFICATION GRADE AC SILENT TYPE SWITCHES, 20A 120/277 VOLT.
- RECEPTACLES SHALL BE SPECIFICATION GRADE, DUPLEX TYPE, NEMA3-20R, 20 AMPERE, 120VOLT GROUNDED TYPE. SPECIAL APPLICATION RECEPTACLES SHALL BE INDICATED ON PLANS. MOUNT WITH THE GROUND DOWN.
- DEVICE PLATES SHALL BE EQUAL TO SIERRA SMOOTH-LINE PLASTIC WALL PLATES. COLOR SHALL BE WHITE, UNLESS OTHERWISE NOTED.
- RECEPTACLES IN OUTDOOR AND WET LOCATIONS SHALL BE INSTALLED WITH A HINGED OUTLET COVER/ENCLOSURE CLEARLY MARKED AND U.L. LISTED SUITABLE FOR WET LOCATIONS WHILE IN USE, EQUAL TO TAYMAC SPECIFICATION GRADE.

H. SERVICE ENTRANCE SECTION

- THE SERVICE ENTRANCE EQUIPMENT SHALL BE AS INDICATED ON THE DRAWINGS. EQUIPMENT SHALL CARRY THE U.L. LABEL AND SHALL CONFORM TO THE POWER COMPANY REGULATIONS.
- SERVICE ENTRANCE EQUIPMENT SHALL BE PROVIDED WITH A FULLY RATED COPPER OR ALUMINUM BUS. HORIZONTALLY TAPERED BUSSING SHALL NOT BE ALLOWED.

I. DISTRIBUTION PANELS

- DISTRIBUTION PANELS SHALL BE PROVIDED WITH FULLY RATED COPPER OR ALUMINUM BUS. HORIZONTAL TAPERED BUSSING SHALL NOT BE ALLOWED.
- ACCEPTABLE MANUFACTURERS – CUTLER HAMMER, SIEMENS, SQUARE D OR GENERAL ELECTRIC FACTORY ASSEMBLED DEAD FRONT, METAL ENCLOSED, AND SELF-SUPPORTING SWITCH BOARD ASSEMBLY CONFORMING T NEMA PB 2 AND UL 891, AND COMPLETE FROM INCOMING LINE TERMINALS TO LOAD SIDE TERMINATIONS.
- LINE AND LOAD TERMINATIONS ACCESSIBLE FROM FRONT ONLY OF THE SWITCH BOARD, SUITABLE FOR

- CONDUCTOR MATERIALS AND NUMBER OF CONDUCTORS USED.
- BUS CONNECTIONS, BOLTED, ACCESSIBLE FROM FRONT FOR MAINTENANCE. PROVIDE BELLEVILLE WASHERS FOR PROPERLY TORQUE ALL CONNECTIONS
- SUITABLY INSULATED AND BRACED FOR SHORT CIRCUIT CURRENTS. CONTINUOUS CURRENT RATING AS INDICATED ON DRAWINGS.
- ALL CIRCUIT BREAKERS SHALL BE BOLT-ON TYPE.

J. PANEL BOARDS

- CIRCUIT BREAKER TYPE AS INDICATED ON DRAWINGS. UNLESS INDICATED OTHERWISE, ALL PANELS SHALL HAVE PANEL HAVE PANEL BOARD TYPE CONSTRUCTION WITH BOLT-ON CIRCUIT BREAKERS FOR 3Ø PANELS
- MANUFACTURERS SHALL BE GENERAL ELECTRIC, SQUARE D, SIEMENS, CUTLER-HAMMER WITH VOLTAGE, SIZES, AND RATINGS AS INDICATED ON DRAWINGS.
- THE CIRCUIT BREAKERS SHALL BE OPERABLE IN ANY POSITION AND BE REMOVABLE FROM THE FRONT OF THE PANEL BOARD WITHOUT DISTURBING THE ADJACENT UNITS. BRANCH BREAKERS SHALL BE OF SUCH DESIGN THAT COMBINATION OF SINGLE-POLE, DOUBLE-POLE, AND THREE-POLE BREAKERS CAN BE ASSEMBLED ON THE SAME PANEL. EACH BRANCH CIRCUIT SHALL BE CLEARLY NUMBERED, BRANCH AND MAIN TERMINALS SHALL BE SOLDERLESS TYPE. HANDLE TIES TO FORM MULTI-POLE BREAKERS NOT ACCEPTABLE.

K. LOAD CENTER

- CIRCUIT BREAKER TYPE AS INDICATED ON DRAWINGS. MANUFACTURERS SHALL BE GENERAL ELECTRIC, SQUARE D, SIEMENS, CUTLER-HAMMER/EATON WITH VOLTAGE, SIZES, AND RATINGS AS INDICATED ON DRAWINGS.
- THE CIRCUIT BREAKERS SHALL BE OPERABLE IN ANY POSITION AND BE REMOVABLE FROM THE FRONT OF THE PANEL BOARD WITHOUT DISTURBING THE ADJACENT UNITS. BRANCH BREAKERS SHALL BE OF SUCH DESIGN THAT COMBINATION OF SINGLE-POLE AND DOUBLE-POLE BREAKERS CAN BE ASSEMBLED ON THE SAME PANEL. EACH BRANCH CIRCUIT SHALL BE CLEARLY NUMBERED. BRANCH AND MAIN TERMINALS SHALL BE OF THE SOLDERLESS TYPE. HANDLE TIES TO FORM MULTI-POLE BREAKERS NOT ACCEPTABLE.
- A CIRCUIT BREAKERS SHALL BE PLUG-IN TYPE.
- WIRE TERMINATION FOR PANEL BOARDS AND CIRCUIT BREAKERS SHALL BE LISTED AS SUITABLE FOR 75 DEGREES C.
- PROVIDE A TYPEWRITTEN CIRCUIT INDEX BEHIND CLEAR PLASTIC COVER ON INSIDE OF DOOR.
- INFORMATION SHALL INCLUDE ROOM AND TYPE LOAD SERVED. ALL CIRCUIT BREAKERS SHALL BE IDENTIFIED, INCLUDING SPARES. INDEX CARD FRAME SHALL BE METAL, SECURED TO DOOR.
- PANEL BOARDS/LOAD CENTERS TO BE PROVIDED WITH COPPER BUSSING ONLY.

L. LIGHTING FIXTURES

- PROVIDE ALL LIGHTING FIXTURES, WIRED AND CONNECTED. THE DRAWINGS INDICATE THE FIXTURES FOR EACH LOCATION. PROVIDE LAMPS FOR ALL FIXTURES. THE LAMPS SHALL BE BY THE SAME MANUFACTURER. VERIFY CEILING CONSTRUCTION BEFORE ORDERING RECESSED UNITS. PROVIDE PLASTER FRAMES AND HANGERS AS REQUIRED. CEILING CONSTRUCTION, ARCHITECTURAL ACCESSORIES, VOLTAGE, AND BALLASTS TO MEET THE EXISTING CEILING CONDITION.

M. LIGHTING CONTROL

- FURNISH AND INSTALL TIME SWITCHES, PHOTOCELLS, CONTRACTORS AND FULL LIGHTING CONTROL SYSTEMS AS REQUIRED FOR LIGHTING CONTROLS INDICATED ON THE DRAWINGS.
- TIME SWITCHES SHALL BE EQUAL TO PARAGON, GENERAL ELECTRIC, TORK, OR INTERMATIC AND SHALL HAVE SIZE AND NUMBER OF POLES AS REQUIRED.
- PHOTOCELLS SHALL BE EQUAL TO TORK OR INTERMATIC WITH VOLTAGE AS INDICATED.

N. TELEPHONE AND CABLE TELEVISION SYSTEMS

- TELEPHONE WALL OUTLETS SHALL CONSIST OF STANDARD BOXES MOUNTED 18" ABOVE THE FLOOR UNLESS OTHERWISE INDICATED. PROVIDE A TERMINAL MOUNTING BOARD FOR THE INCOMING SERVICE CABLE.
- CABLE TELEVISION OUTLETS SHALL CONSIST OF STANDARD BOXES MOUNTED 18" ABOVE THE FLOOR UNLESS OTHERWISE INDICATED. PROVIDE A TERMINAL MOUNTING BOARD FOR THE INCOMING SERVICE CABLE.

O. GUARANTEE

- GUARANTEE ALL MATERIAL FURNISHED AND ALL WORKMANSHIP PERFORMED FOR A PERIOD OF ONE YEAR FROM DATE OF FINAL ACCEPTANCE OF WORK. ANY DEFECTS DEVELOPING WITHIN THIS PERIOD, TRACEABLE TO MATERIAL FURNISHED AS A PART OF THIS SECTION OR WORKMANSHIP PERFORMED HEREUNDER, SHALL BE MADE GOOD AT NO EXPENSE TO THE OWNER.

SYMBOLS LEGEND

NOTE: THIS IS A MASTER LEGEND AND NOT ALL SYMBOLS, ETC., ARE NECESSARILY USED ON THE DRAWINGS.

FLUORESCENT OR LED FIXTURE (SEE SCHEDULE)

FIXTURE WITH EMERGENCY BATTERY BALLAST UNIT

DOWNLIGHT FIXTURE WITH EMERGENCY BATTERY BALLAST UNIT

WALL MOUNTED FIXTURE WITH EMERGENCY BATTERY BALLAST UNIT

DOWNLIGHT FIXTURE

WALL MOUNTED FIXTURE

PENDANT MOUNTED FIXTURE

WALL WASHER

SINGLE FACE EXIT SIGN – UNIVERSAL MOUNTED

SINGLE FACE EXIT SIGN W/ DIRECTIONAL ARROWS – UNIVERSAL MTD

DOUBLE FACE EXIT SIGN W/ DIRECTIONAL ARROWS – UNIVERSAL MTD

DUAL HEADED EMERGENCY UNIT

COMBO DUAL HEADED EMERGENCY AND EXIT SIGN UNIT

LETTER INDICATES LIGHT FIXTURE AS INDICATED ON FIXTURE SCHED

S SINGLE POLE SWITCH @ +48" UNLESS NOTED

S₁ SWITCH BANK @ +48" UNLESS NOTED. LOWER CASE LETTER INDICATES FIXTURE CONTROLLED.

S₂ 2 POLE SWITCH @ +48" UNLESS NOTED

S₃ 3-WAY SWITCH @ +48" UNLESS NOTED

S₄ 4-WAY SWITCH @ +48" UNLESS NOTED

S₅ DIMMER SWITCH – SIZE AS REQUIRED @ +48" UNLESS NOTED

S₆ 3-WAY DIMMER SWITCH – SIZE AS REQUIRED @ +48" UNLESS NOTED

S₇ 3-WAY DIMMER SWITCH BANK @ +48" UNLESS NOTED. LOWER CASE LETTER INDICATES FIXTURE CONTROLLED.

S₈ SWITCH SENSOR @ +48" UNLESS NOTED

S₉ MANUAL MOTOR STARTER

S₁₀ LOW VOLTAGE OCCUPANCY SENSOR – PROVIDE WITH ALL CONTROL UNITS AND EXTRA CONTROL CABLE

S₁₁ WALL SWITCH WITH OCCUPANCY SENSOR. TWO BUTTON DIGITAL LOW VOLTAGE WALL SWITCH. PROVIDES ON/OFF/0-10V DIMMING. SWITCH @ +48" UNLESS NOTED. LOWER CASE LETTER INDICATES FIXTURE CONTROLLED.

S₁₂ TWO BUTTON DIGITAL LOW VOLTAGE WALL SWITCH. PROVIDES ON/OFF/0-10V DIMMING. SWITCH @ +48" UNLESS NOTED. LOWER CASE LETTER INDICATES FIXTURE CONTROLLED. PROVIDE EXTRA CONTROL CABLES NEEDED TO FIXTURE CONTROLLED.

L LIGHTING CONTRACTOR

LC LIGHTING CONTROLS POWER PACK (SEE LIGHTING CONTROLS SCHEDULE FOR TYPE INDICATED BY "#")

OC OCCUPANCY SENSOR (SEE LIGHTING CONTROLS SCHEDULE FOR TYPE INDICATED BY "X")

C CAMERA

S SPEAKER

TELEPHONE OUTLET @ +18" UNLESS NOTED

DATA OUTLET @ +18" UNLESS NOTED. # DENOTES CAT 5 CABLE COUNT

COMBINATION TELEPHONE/DATA OUTLET @ +18" UNLESS NOTED

TELEVISION OUTLET @ +18" UNLESS NOTED

DUCT DETECTOR

HEAT DETECTOR

120 VOLT SMOKE DETECTOR WITH SOUNDER BASE AND BATTERY BACKUP

AUXILIARY SYSTEM TERMINAL CABINET

SWITCHBOARD, MOTOR CONTROL CENTER OR DISTRIBUTION BOARD

3 PHASE, 4 WIRE PANELBOARD, UNO

GENERATOR

TRANSFORMER

MOTOR OUTLET

DISCONNECT SWITCH – SIZE AND TYPE NOTED

COMBINATION FUSED STARTER DISCONNECT SWITCH FUSE SIZE AS INDICATED, STARTER SIZE "1"

MECHANICAL EQUIP. CONNECTION, SEE SCHED. ON MECH. PLAN

JUNCTION BOX

CONDUIT RUN CONCEALED IN WALL OR ABOVE CEILING

CONDUIT RUN BELOW FLOOR OR GRADE

SPECIAL HEAVY DUTY RECEPTACLE – SIZE AS NOTED. @ +18" UNLESS NOTED

1/2 SWITCHED RECEPTACLE @ +18" UNLESS NOTED

FIRE RATED POKE THRU WITH TYPE INDICATED

FLUSH FLOOR BOX WITH TYPE INDICATED

SINGLE RECEPTACLE @ +18" UNLESS NOTED

DUPLEX RECEPTACLE @ +18" UNLESS NOTED

DOUBLE DUPLEX RECEPTACLE @ +18" UNLESS NOTED

GFI DUPLEX RECEPTACLE

FULL SWITCHED RECEPTACLE

DUPLEX RECEPTACLE INSTALLED ABOVE COUNTERTOP

DUPLEX RECEPTACLE WITH WEATHERPROOF COVER PLATE @ 18" UNLESS NOTED

HOMERUN TO PANELBOARD, INFORMATION AT ARROWS ARE CIRCUIT NUMBERS AND PANELBOARD FOR TERMINATION. REFER TO ASSOCIATED NOTE FOR BRANCH CIRCUIT CONDUCTOR SIZES.

INDICATES 1/2" CONDUIT CONCEALED IN CEILING OR WALL WITH (3) CONDUCTORS. (1) PHASE, (1) NEUTRAL, AND (1) GROUND WIRE. ALL ARE #12 AWG UNLESS NOTED OTHERWISE.

WHIP COUNT INDICATES NUMBER OF HOT CONDUCTORS

(E) INDICATES EXISTING DEVICE TO REMAIN

COMBINATION FIRE ALARM HORN/STROBE WALL MOUNTED.

FIRE ALARM STROBE LIGHT WALL MOUNTED.

COMBINATION FIRE ALARM HORN/STROBE CEILING MOUNTED.

FIRE ALARM STROBE LIGHTS CEILING MOUNTED.


FIRE ALARM MANUAL PULL STATION WALL MOUNTED. INSTALL WITH TOP 48" AFF.

FIRE ALARM ANNUNCIATOR.

FIRE ALARM CONTROL PANEL.

FIRE ALARM SYSTEM CEILING SMOKE DETECTOR.

MEP ENGINEER:

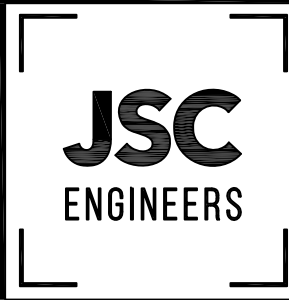


MO CON NO. 202007861-KS CON NO. 62018
1001 WESTBURY PARKWAY, SUITE 100, KANSAS CITY, MO 64105
314.500.1111
www.jsc-engineers.com

LOT 7, BUILDING 31

3140 SW LONGVIEW BLVD
LEE'S SUMMIT, MO 64081



REV ISSUE DATE
1 PLANCHHECK 2021 08 17

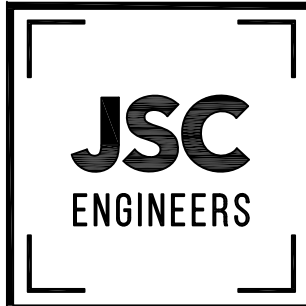


MO COA NO. 20200781 / KS COA NO. 62816
1001 WESTBELL PARKWAY / UNIT 100 / KANSAS CITY, MO 64105
3RD FLOOR / UNIT RELEASE TOWER
PHONE: (816) 274-0585
info@jsc-engineers.com

GENERAL NOTES

- REFER TO ARCHITECTURAL DRAWINGS AND ELEVATIONS FOR EXACT LOCATIONS AND MOUNTING HEIGHTS OF ALL LIGHTING FIXTURES.
- REFER TO LIGHTING FIXTURE SCHEDULE FOR LIGHT FIXTURE TYPES AND REQUIREMENTS.
- CONNECT ALL EXIT SIGNS AND EMERGENCY LIGHTING UNITS TO THE INDICATED CIRCUIT WITH A SEPARATE AND UN-SWITCHED CONDUCTOR BYPASSING ALL CONTROLS AND CONTACTORS. REFER TO MANUFACTURER'S WRITTEN INSTRUCTIONS FOR PROPER INSTALLATION AND TESTING.
- CONTRACTOR SHALL BE RESPONSIBLE FOR ENSURING THAT COORDINATION AND CONFLICT ISSUES BE RESOLVED PRIOR TO INSTALLATION OF LIGHT FIXTURES.
- ROUTE ALL EXPOSED, RIGID CONDUIT TIGHT TO STRUCTURE, PARALLEL TO BUILDING LINES AND IN UNISTRUT CABLE/PIPE TRAY WHERE POSSIBLE. COORDINATE CONDUIT ROUTING AND INSTALLATION WITH OTHER TRADES PRIOR TO ROUGH-IN. SUPPORT CONDUIT FROM STRUCTURE NOT ROOF DECK. MAINTAIN 2" MIN. SPACING FROM BOTTOM OF ROOF DECK TO PREVENT ROOFING SCREWS FROM PENETRATING CONDUITS.
- THROUGH WIRING OF RECESSED LIGHT FIXTURES, IN SUSPENDED CEILINGS, IS NOT PERMITTED. CONNECT EACH LIGHT FIXTURE BY A WHIP TO A JUNCTION BOX. PROVIDE CABLE WHIPS OF SUFFICIENT LENGTH TO ALLOW FOR RELOCATING EACH LIGHT FIXTURE WITHIN A 5-FOOT RADIUS OF ITS INSTALLED LOCATION, BUT NOT EXCEEDING 6 FEET IN UNSUPPORTED LENGTH.
- ALL INTERNALLY ILLUMINATED SIGNS SHALL BE PROVIDED WITH AN ACCESSIBLE DISCONNECTION MEANS. VERIFY EACH SIGN IS FURNISHED WITH AN INTEGRAL DISCONNECT SWITCH. PROVIDE WEATHERPROOF DISCONNECT SWITCHES WITHIN SIGHT OF ALL SIGNS AS REQUIRED. MAKE FINAL CONNECTION AS REQUIRED.
- SEE SHEET MP001 FOR ACCEPTABLE WALL PENETRATION METHODS.

KEYED PLAN NOTES


- REFER TO SINGLE LINE DIAGRAM ON SHEET E-201 AND PANELBOARD SCHEDULES ON SHEET E-202 FOR MORE INFORMATION.
- PHOTOCELL FOR CONTROL OF EXTERIOR LIGHTING FIXTURES. MOUNT PHOTOCELL TO TOP OF PARAPET AND POINT NORTH.
- WET LOCATION LED TAPE LIGHT TO BE MOUNTED 45DEG CHANNEL ON EXTERIOR SIDE OF STRUCTURAL WINDOW FRAME. PROVIDE FIXTURES, DRIVERS/TRANSFORMERS, AND OTHER ACCESSORIES TO FILL LATERAL PORTION AT TOP OF WINDOW FRAME AND VERTICAL PORTIONS AT EACH SIDE OF WINDOW FRAME. PROVIDE INDIVIDUAL DRIVER/TRANSFORMER FOR EACH MANUFACTURER-RECOMMENDED STANDARD LENGTH OF FIXTURE. LOCATE DRIVERS ON INTERIOR SIDE OF WALL IN INCONSPICUOUS, ACCESSIBLE LOCATION. COORDINATE EXACT LOCATION OF DRIVER BANK AND MOUNTING WITH ARCHITECT PRIOR TO CONSTRUCTION. CONTROL VIA PHOTOCELL.
- WET LOCATION LED DOWNLIGHT MOUNTED IN SOFFIT ABOVE. REFER TO ARCHITECTURAL DRAWINGS FOR EXACT LOCATION.

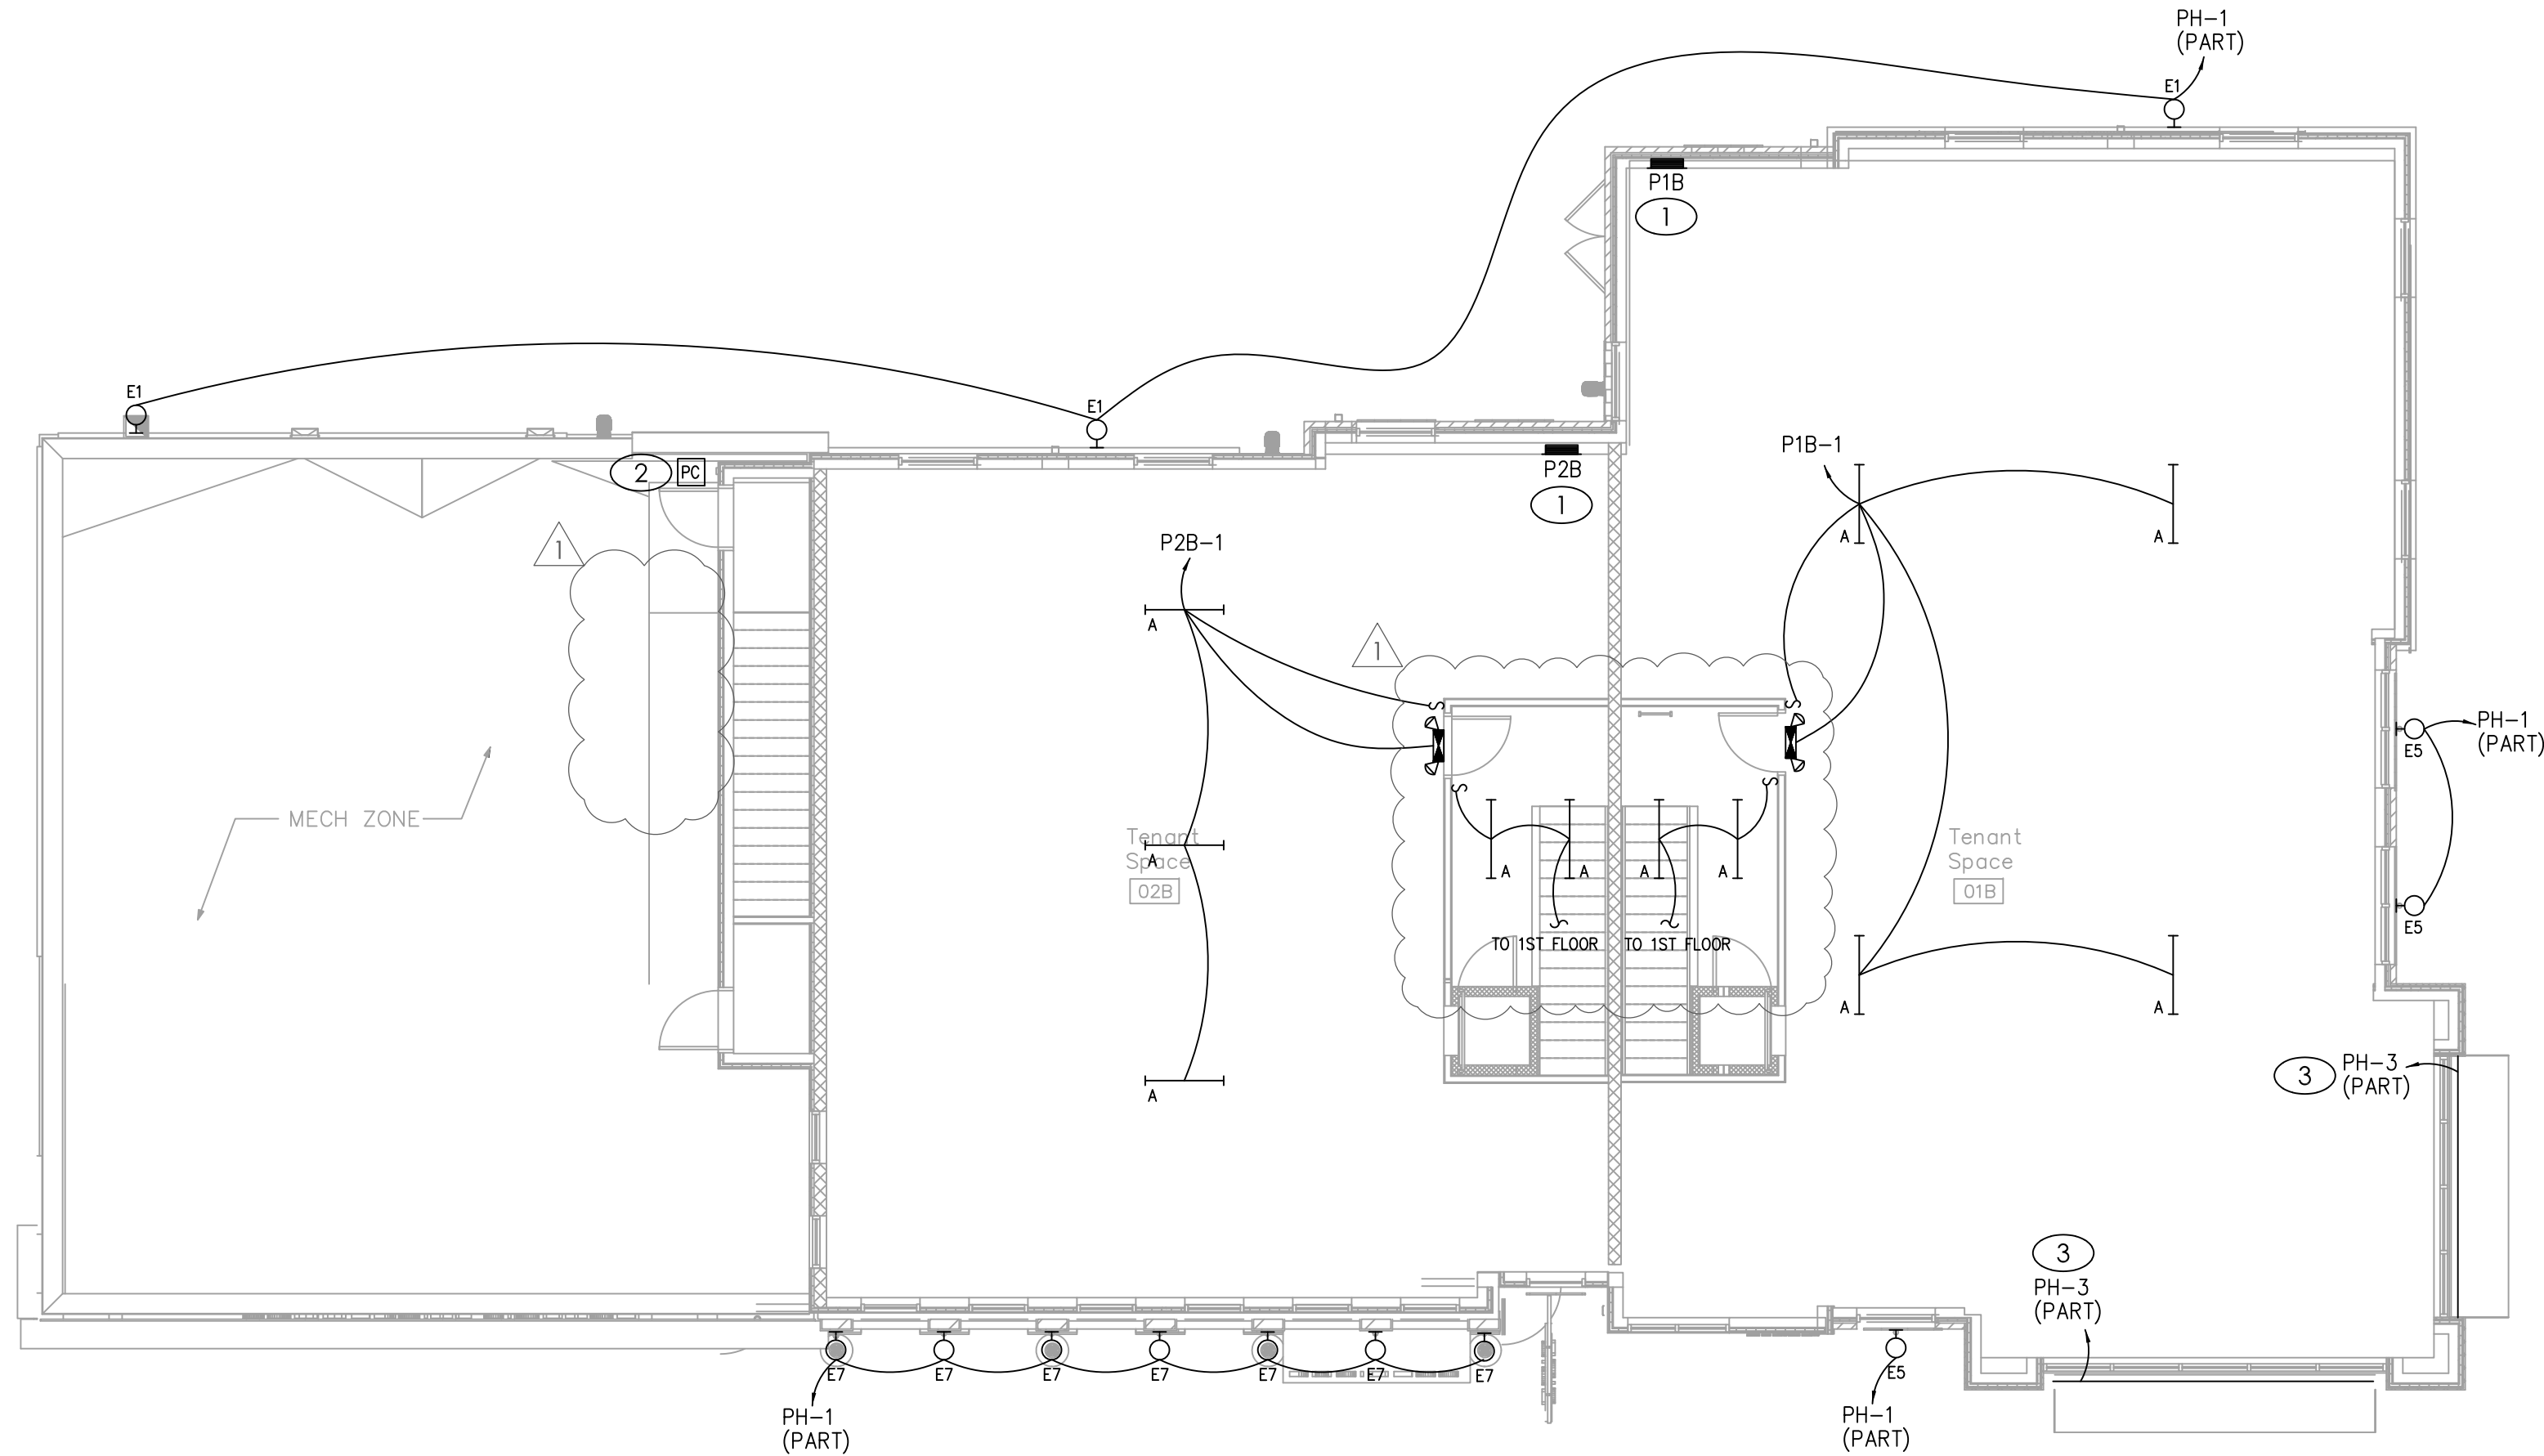

SECOND FLOOR LIGHTING PLAN

SCALE : 1/8" = 1'-0"

2

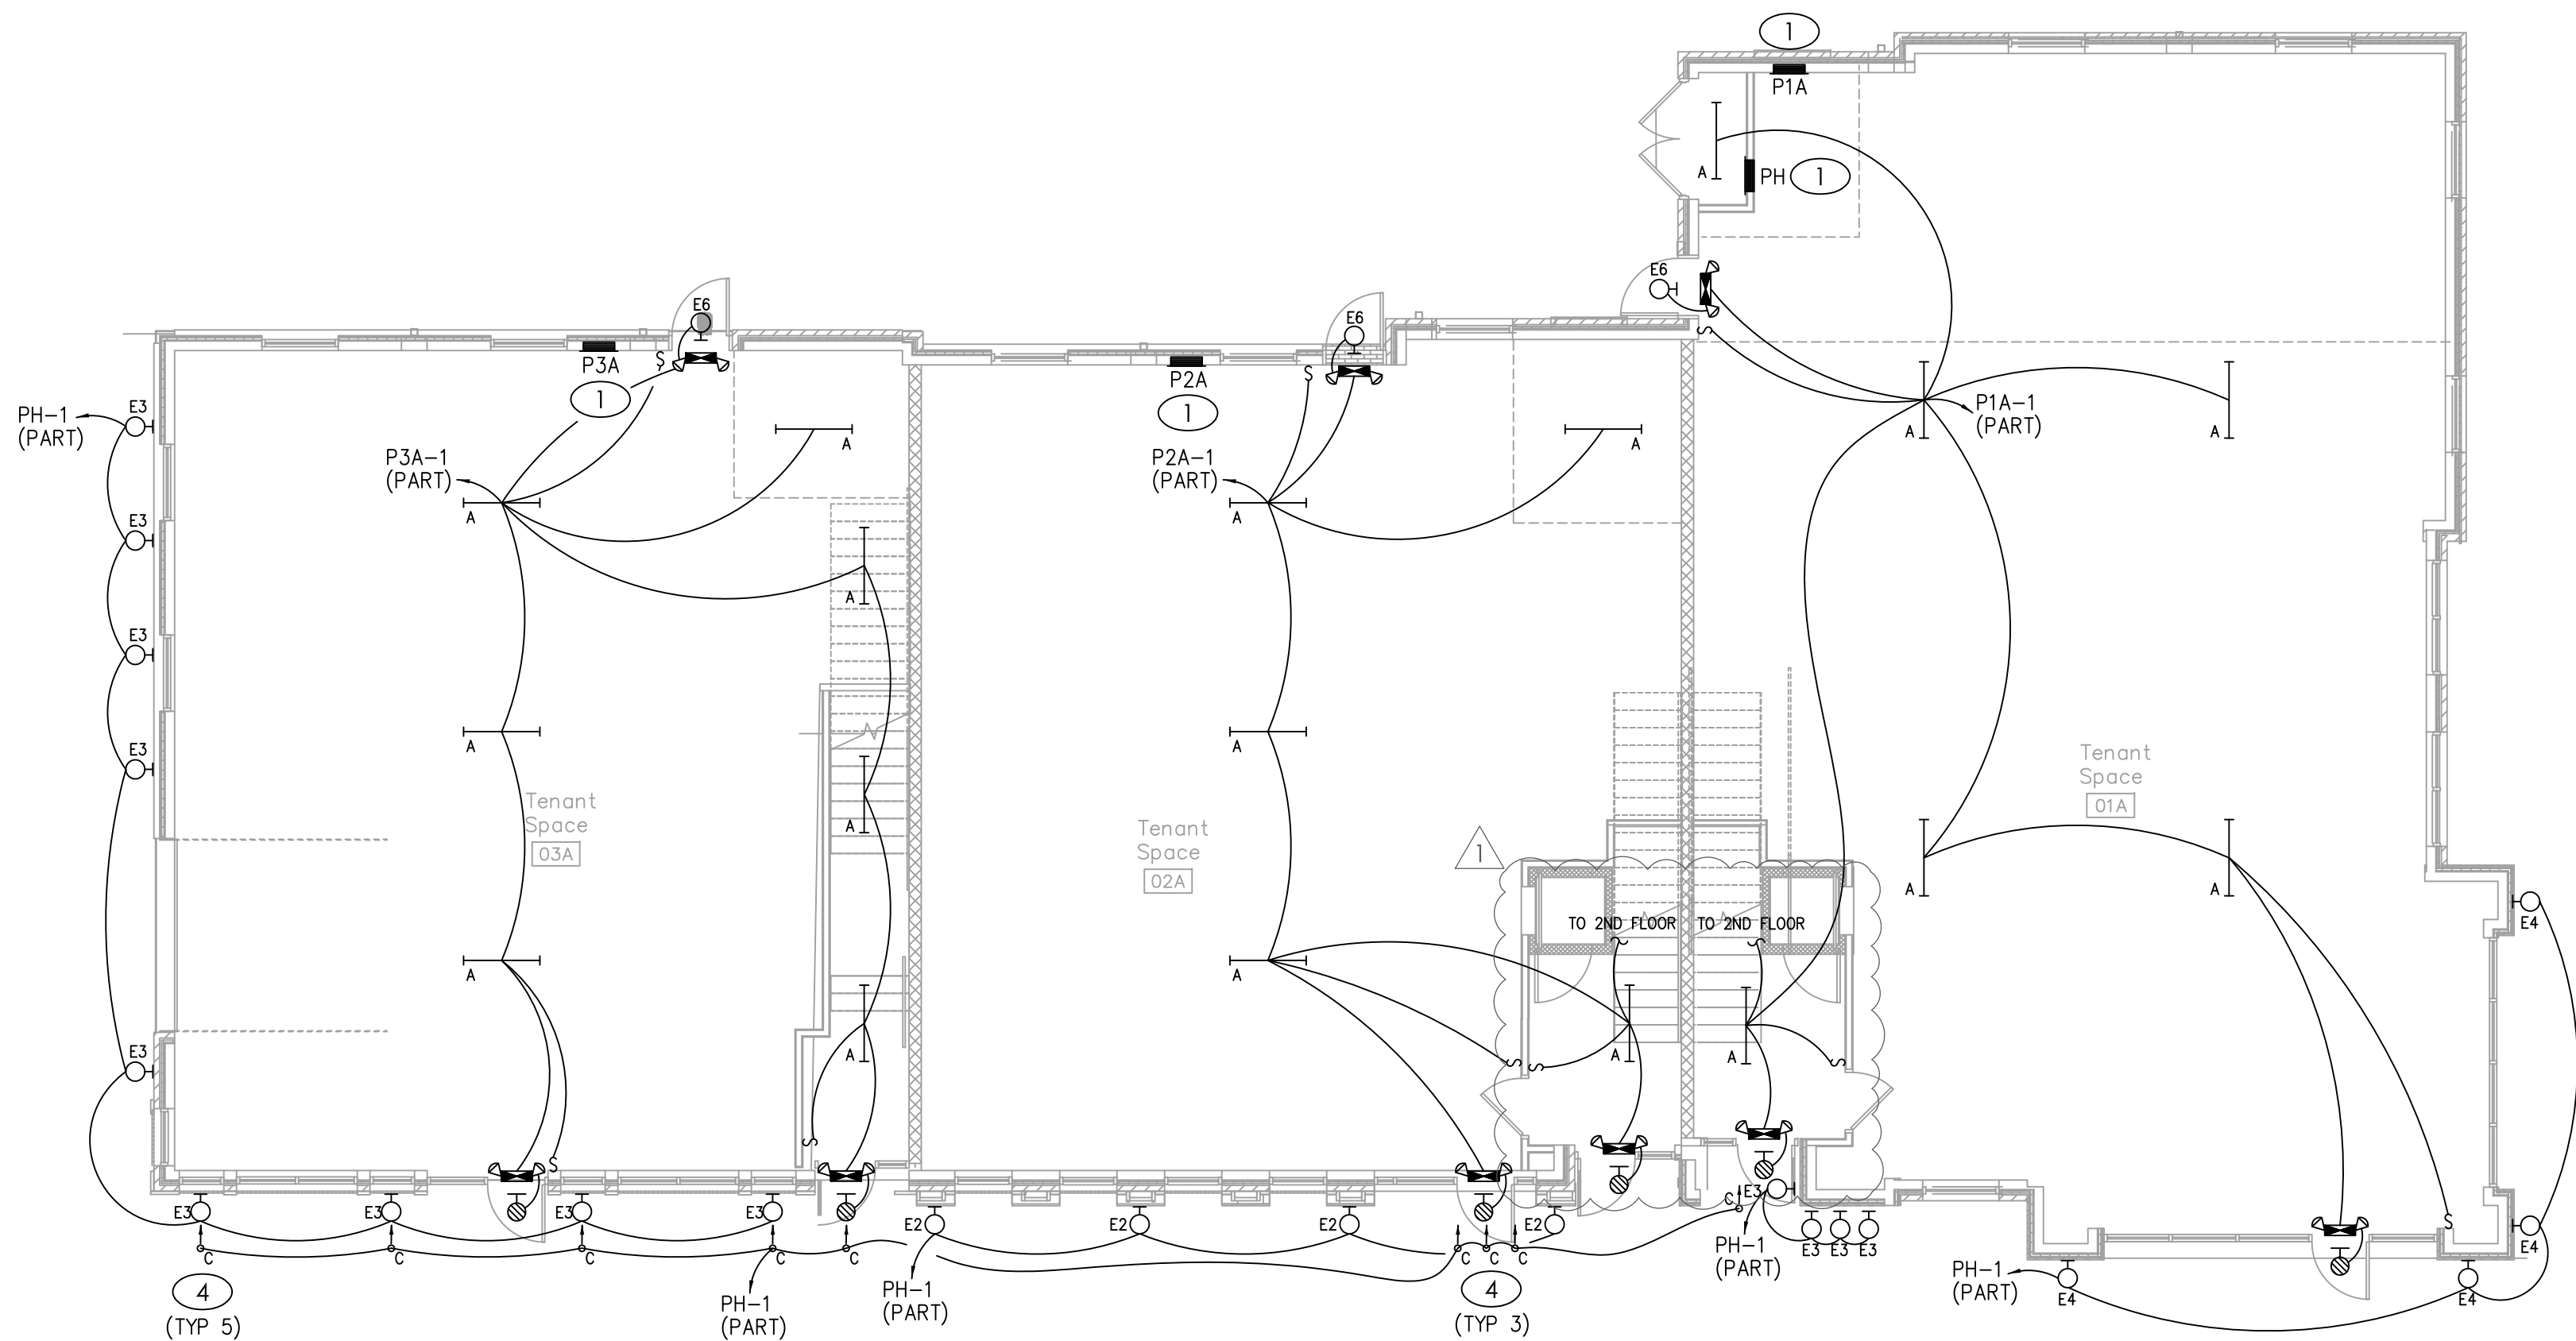

FIRST FLOOR LIGHTING PLAN

SCALE : 1/8" = 1'-0"

1



LOT 7, BUILDING 31


3140 SW LONGVIEW BLVD
LEE'S SUMMIT, MO 64081



REV	ISSUE	DATE
1	PLANCHHECK	2021 08 17

ELECTRICAL PLANS:
LIGHTING

E101

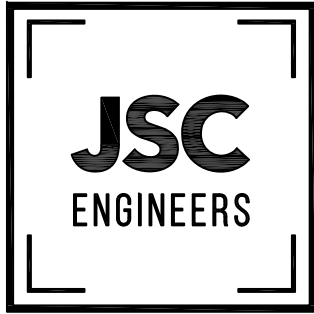


MO COA NO. 202008761 KS COA NO. 62676
1001 WEST BLUE PAVEMENT, UNITY VILLAGE, 801 W. 80th
3RD FLOOR, UNITY VILLAGE TOWER
PHONE: (816) 274-0888
info@jsc-engineers.com jsc-engineers.com

GENERAL NOTES

- A. DRAWINGS ARE DIAGRAMMATIC AND SHALL NOT BE SCALED. REFER TO ARCHITECTURAL PLANS OR FIELD MEASUREMENTS FOR DIMENSIONS.
- B. ALL WORK SHALL COMPLY WITH THE LATEST ADOPTED EDITION OF THE NATIONAL ELECTRICAL CODE (NFPA 70) AND ALL LOCAL BUILDING CODES AND AMENDMENTS.
- C. ALL ROOF AND WALL PENETRATIONS SHALL BE COORDINATED WITH THE GENERAL CONTRACTOR. PROVIDE ALL REQUIRED SLEEVES, FLASHINGS, CURBS, REINFORCED ANGLES, SUPPORTING FRAMES, ETC. UNLESS THEY ARE SPECIFICALLY CALLED OUT TO BE FURNISHED BY OTHERS.
- D. COORDINATE ALL WORK WITH OTHER TRADES AND EXISTING CONDITIONS AS REQUIRED TO PROPERLY INSTALL ALL SYSTEMS AS INTENDED, WITHIN THE CONFINES OF THE SPACE AVAILABLE, AND WITHOUT INTERFERENCES.
- E. THIS CONTRACTOR SHALL PERFORM ALL WORK INDICATED AND/OR AS REQUIRED FOR THE PROPER INSTALLATION AND OPERATION OF THE ELECTRICAL SYSTEMS.
- F. THE ELECTRICAL SYSTEM DESIGN IS BASED IN PART ON THE SPECIFIED HVAC AND PLUMBING EQUIPMENT. IT IS THE RESPONSIBILITY OF THE CONTRACTOR TO COORDINATE THE EXACT LOCATIONS AND ELECTRICAL REQUIREMENTS OF ALL EQUIPMENT BEING FURNISHED. ANY CHANGES TO THE ELECTRICAL SYSTEM DUE TO HVAC EQUIPMENT SUBSTITUTIONS SHALL BE PROVIDED AT NO ADDITIONAL COST TO THE OWNER.
- G. ALL POWER WIRING SHALL BE BY THE ELECTRICAL CONTRACTOR. ALL CONTROL WIRING SHALL BE ROUTED BY THE ELECTRICAL CONTRACTOR WITH FINAL CONTROL DEVICE (T-STATS) LANDINGS BY THE MECHANICAL CONTRACTOR.
- H. ALL WIRING SHALL BE IN APPROVED RACEWAY.
- I. WIRE SIZE SHALL BE MINIMUM #12 AWG, THWN SOLID COPPER UNLESS OTHERWISE NOTED. PROVIDE GROUND WIRE WHERE REQUIRED BY CODE. INCREASE WIRE SIZE TO COMPENSATE FOR VOLTAGE DROP WHERE TOTAL LENGTH OF ANY BRANCH EXCEEDS 100 FEET.
- K. FIRE ALARM, AUDIO/VIDEO AND SURVEILLANCE SYSTEMS BY OTHERS.
- L. SEE SHEET MP001 FOR ACCEPTABLE WALL PENETRATION METHODS.

KEYED PLAN NOTES


1. REFER TO SINGLE LINE DIAGRAM ON SHEET E-201 AND PANELBOARD SCHEDULES ON SHEET E-202 FOR MORE INFORMATION.
2. MAKE CONNECTION TO DIVISION 22/23 EQUIPMENT PER MANUFACTURER'S RECOMMENDATIONS. COORDINATE ELECTRICAL CONNECTION WITH DIVISION 22/23 CONTRACTOR.
3. WEATHERPROOF RECEPTACLE AT PARAPET WALL FOR "CHRISTMAS LIGHT" LOAD. COORDINATE EXACT LOCATION WITH ARCHITECT PRIOR TO CONSTRUCTION.
4. JUNCTION BOX FOR HARDWIRE CONNECTION TO VERTICAL LIFT. COORDINATE EXACT CONNECTION REQUIREMENTS WITH EQUIPMENT SPECIFICATIONS PRIOR TO CONSTRUCTION.
5. JUNCTION BOX FOR HARDWIRE CONNECTION TO HEAT TRACE SYSTEM BY OTHERS. COORDINATE EXACT JUNCTION BOX/CONNECTION LOCATION AND REQUIREMENTS WITH DIVISION 22/23 CONTRACTOR PRIOR TO CONSTRUCTION.
6. COORDINATE WITH PLUMBING CONTRACTOR TO ENSURE INSTALLATION OF BACKFLOW PREVENTER DOES NOT ENCR OACH UPON ELECTRICAL PANEL WORKING CLEARANCE.
7. ROUTE 1-1/4" CONDUIT BACK TO TELECOMMUNICATIONS BACKBOARD. COORDINATE EXACT ROUTING AND STUB-OUT LOCATION WITH ARCHITECT & LIFT INSTALLER PRIOR TO CONSTRUCTION.

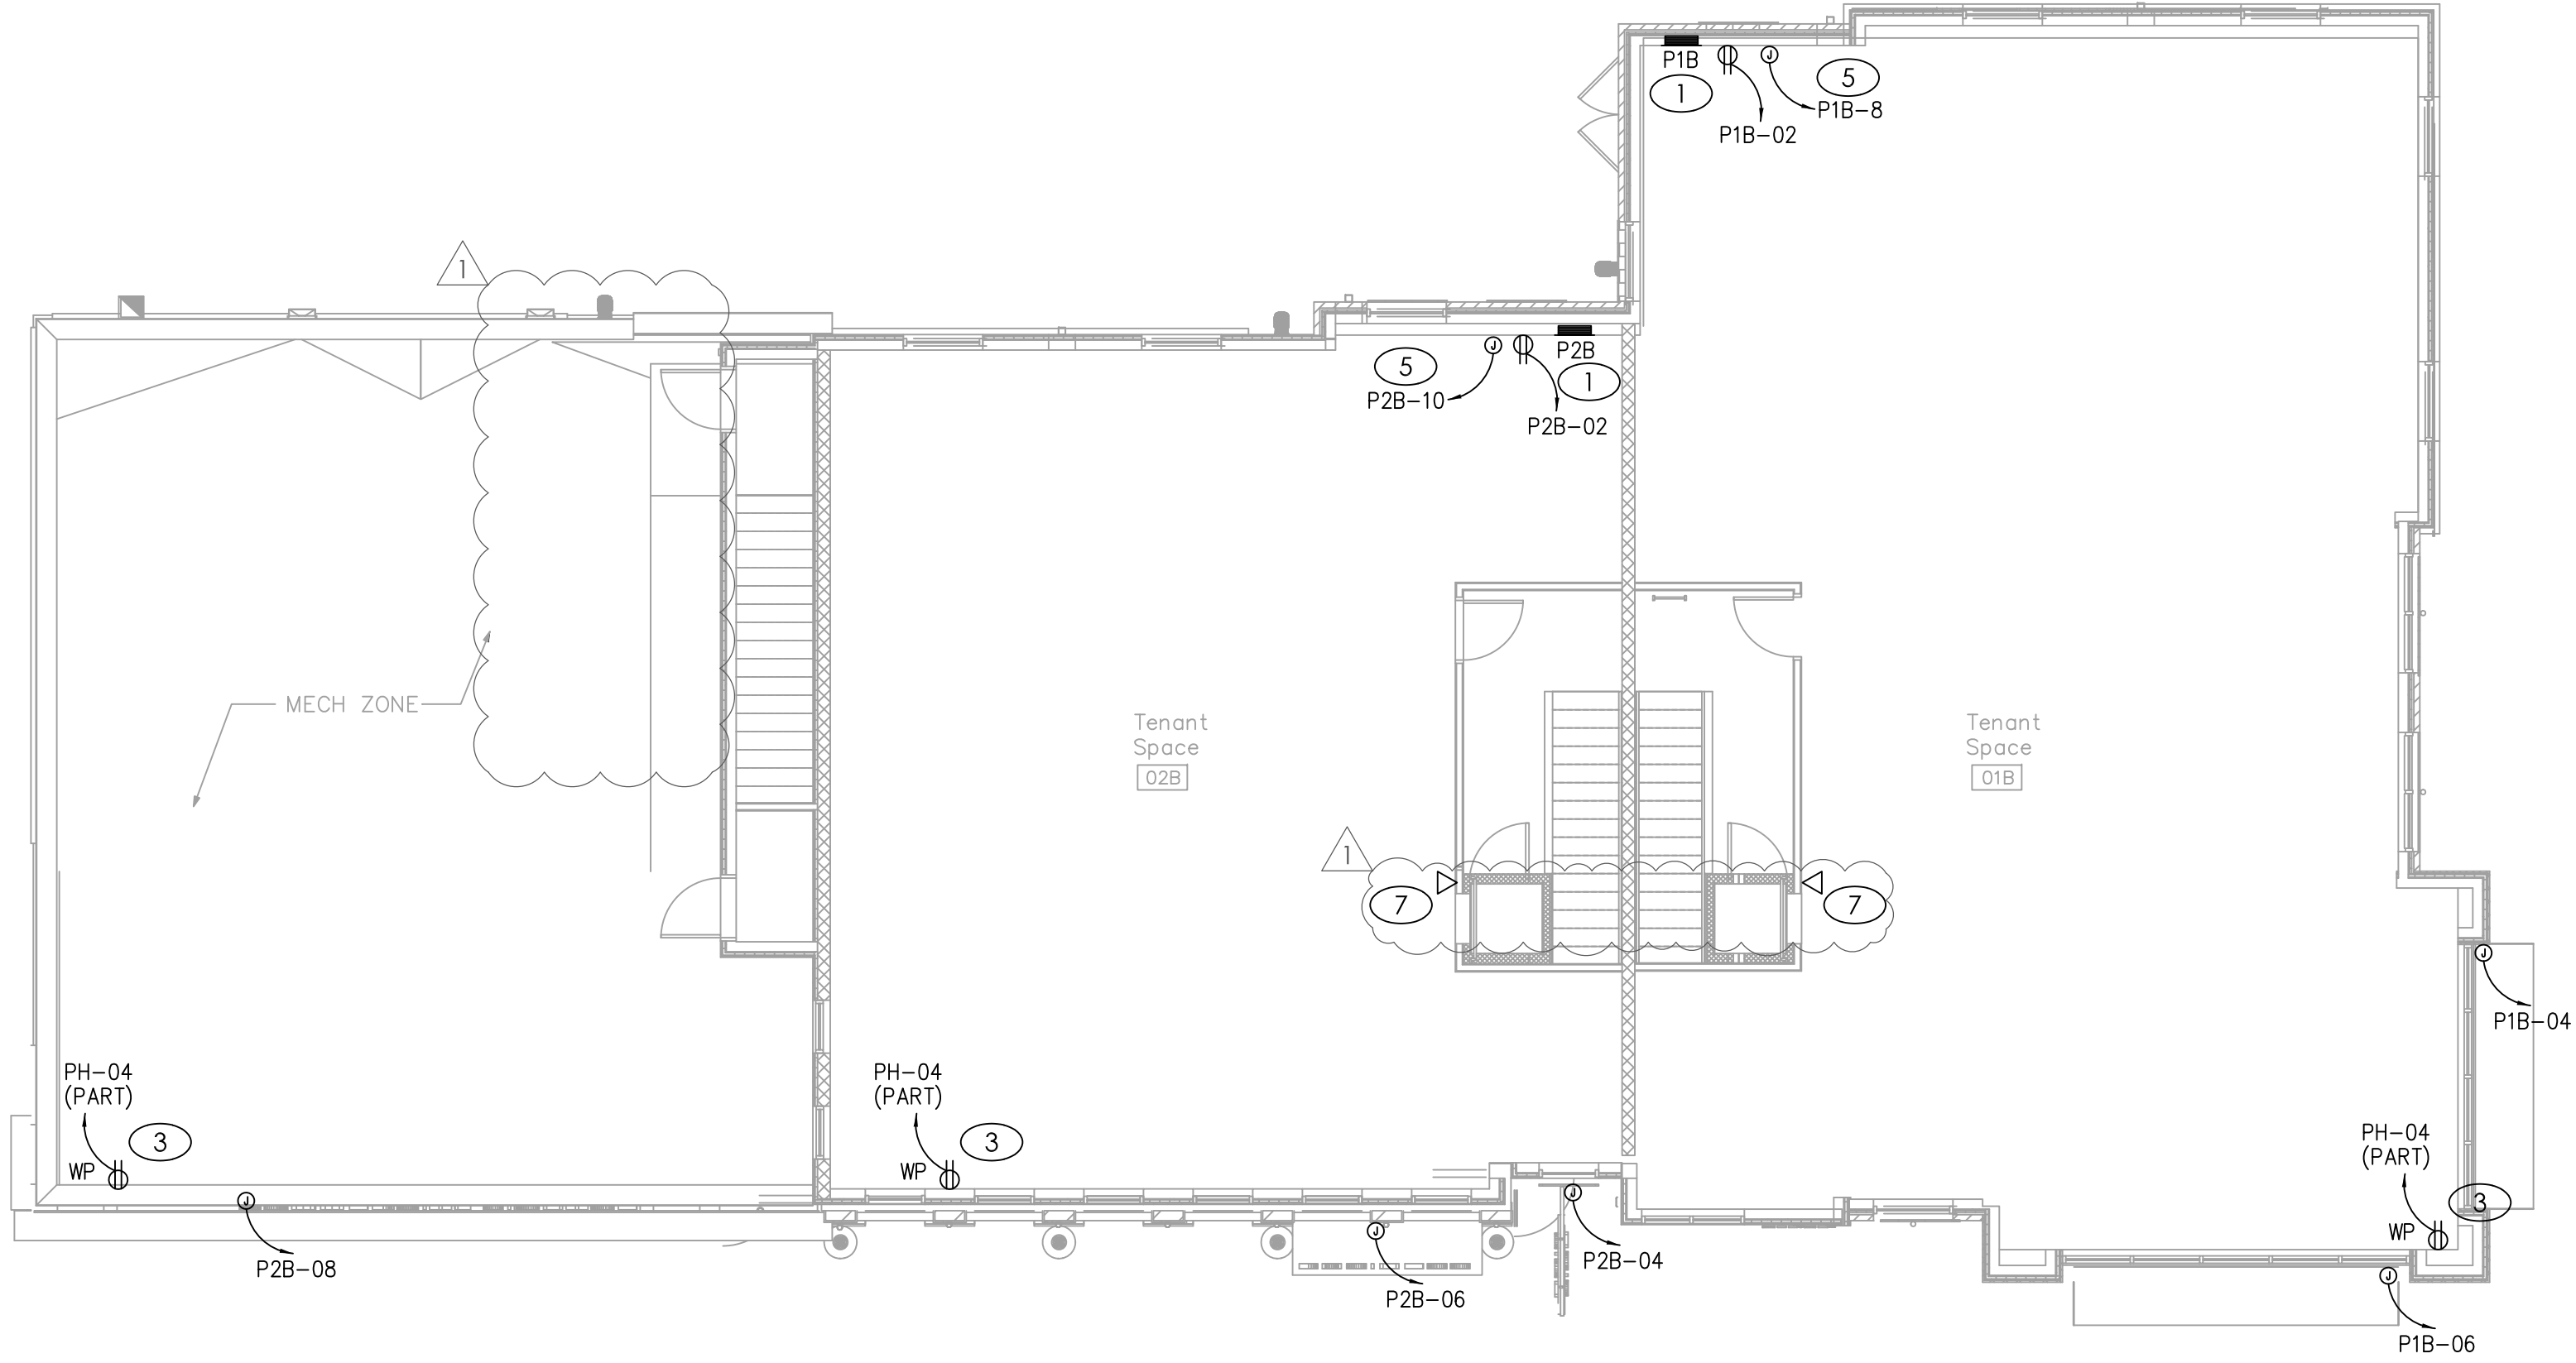

SECOND FLOOR POWER PLAN

SCALE : 1/8" = 1'-0"

2

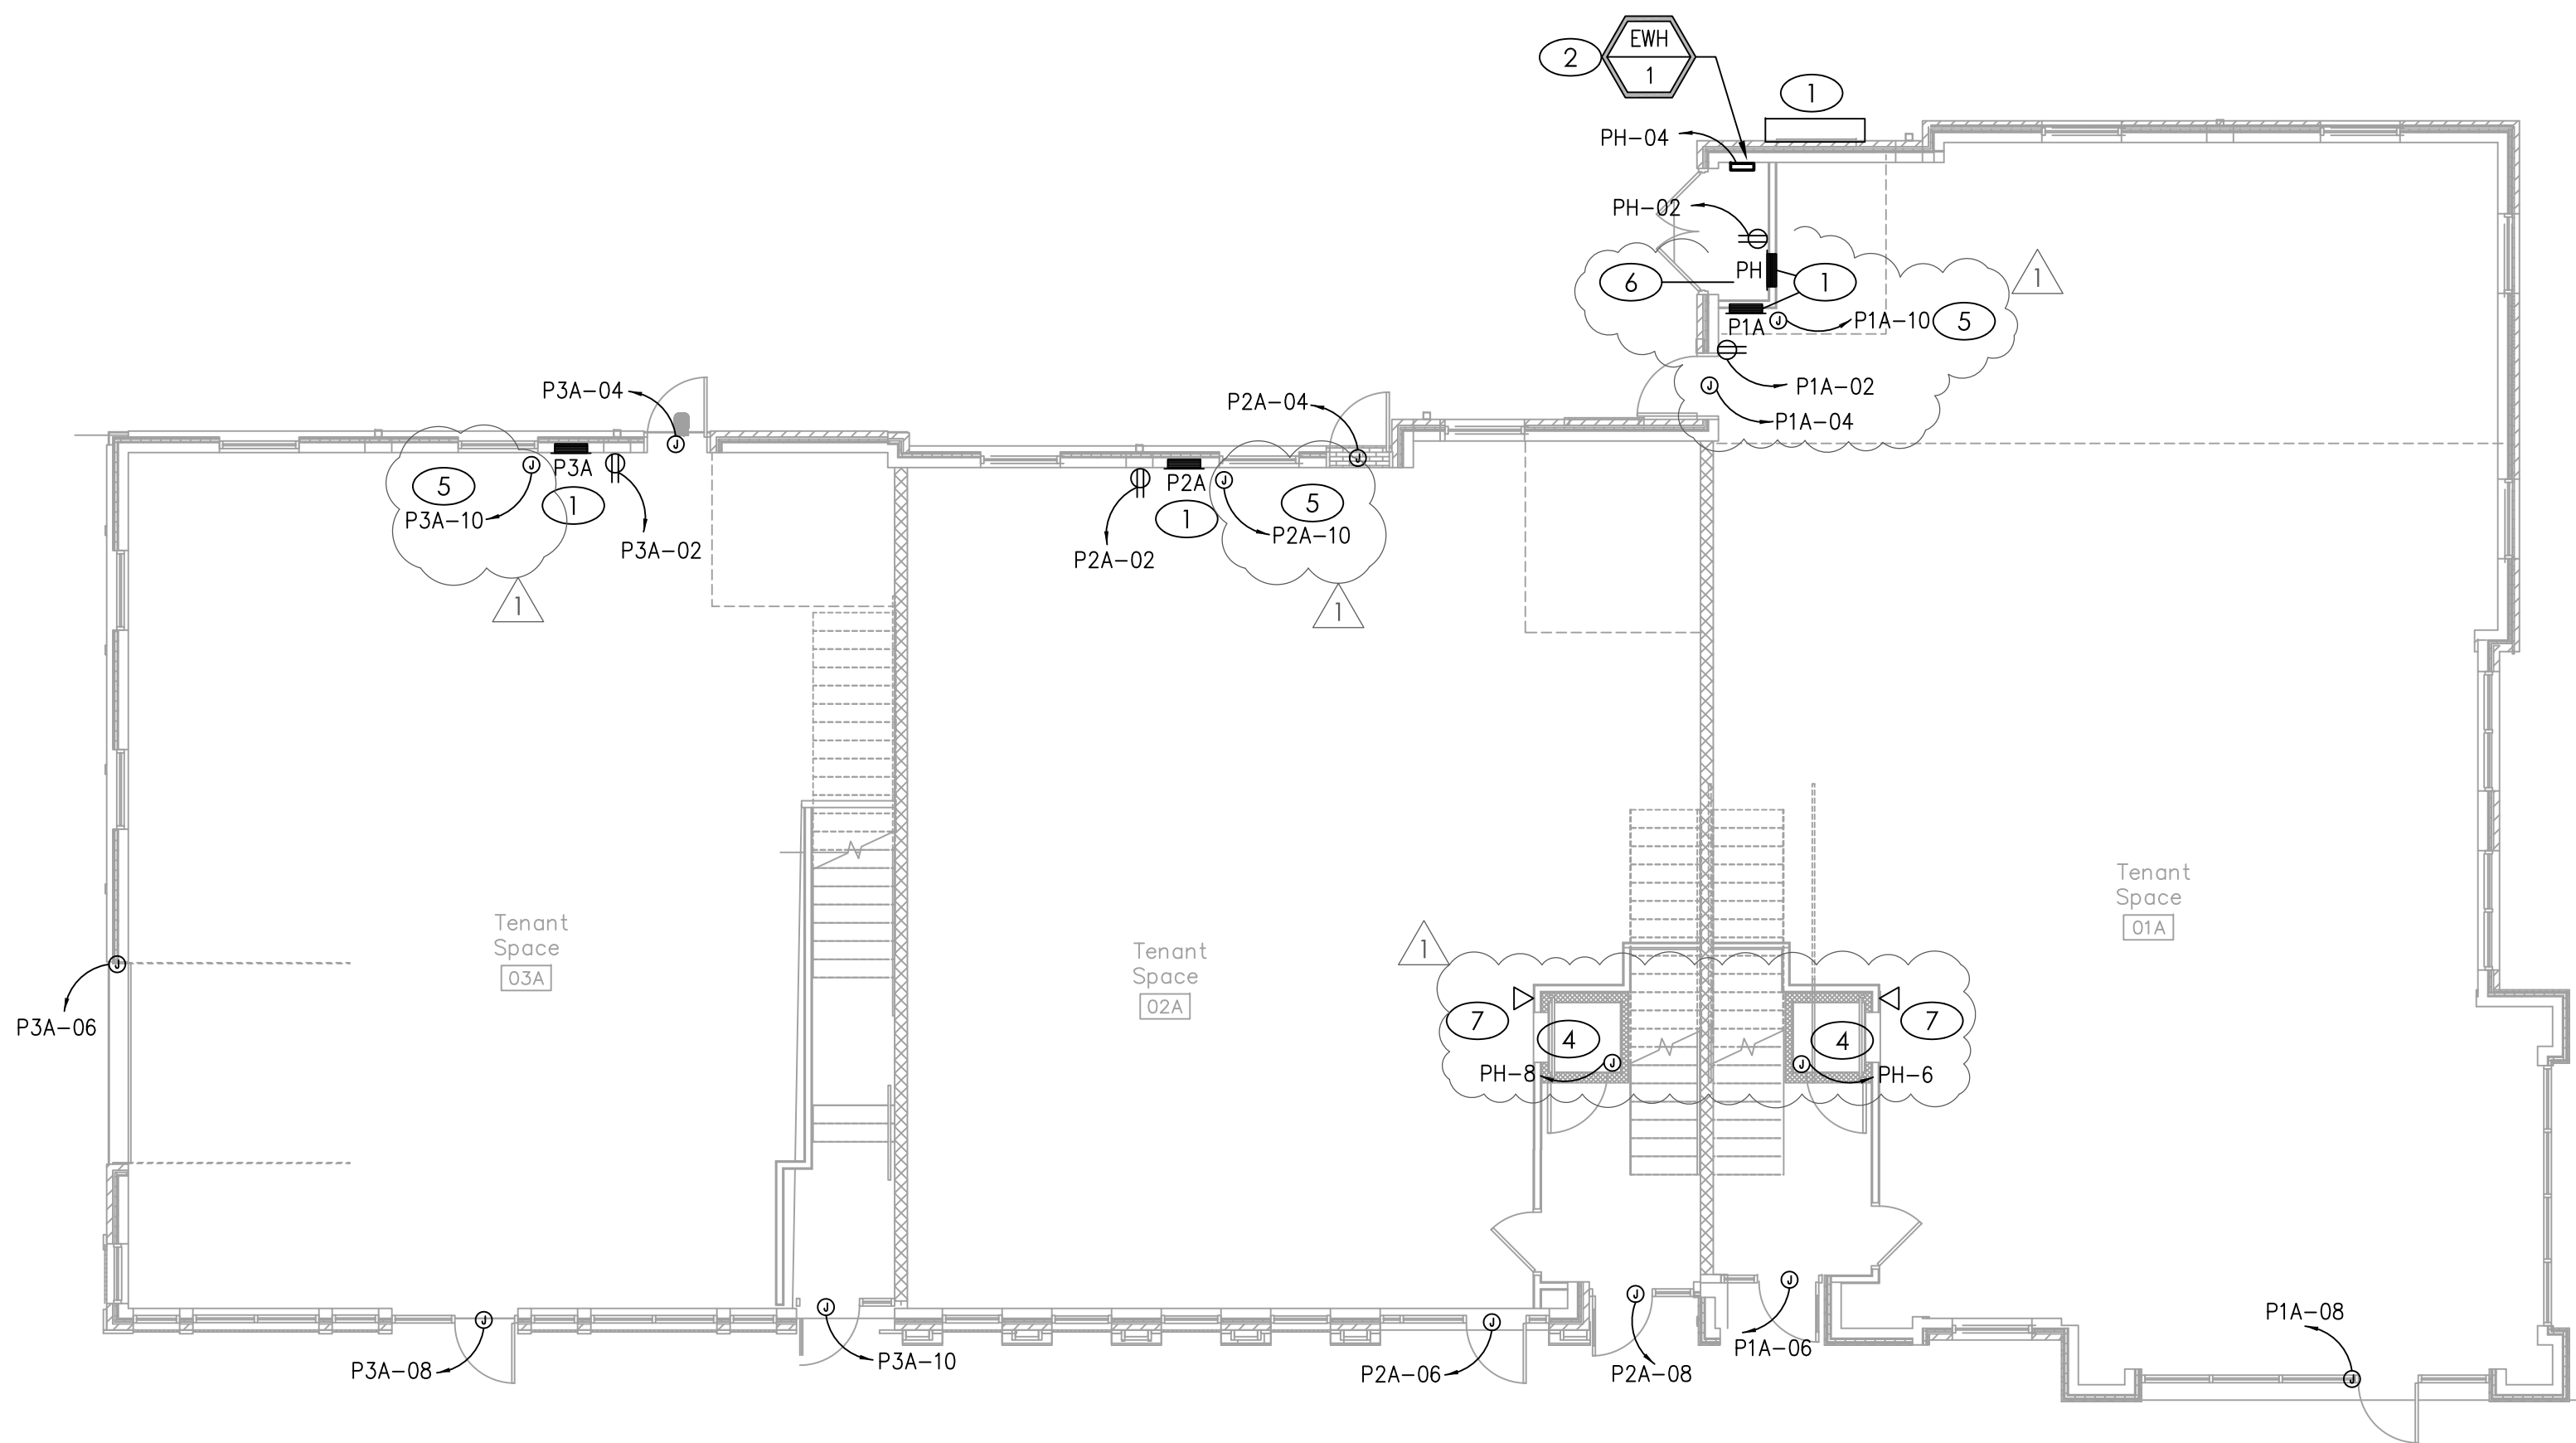

FIRST FLOOR POWER PLAN

SCALE : 1/8" = 1'-0"

1



LOT 7, BUILDING 31


3140 SW LONGVIEW BLVD
LEE'S SUMMIT, MO 64081



REV	ISSUE	DATE
1	PLANCHECK	2021 08 17

ELECTRICAL PLANS:
POWER

E102

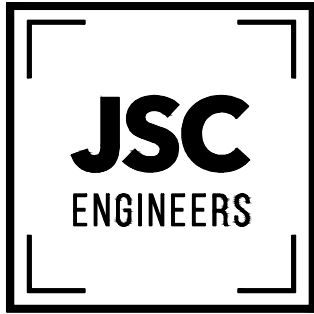

NO. 004 NO. 303030761 NO. 004 NO. 004
1001 NEW BLUE HARBOR, UNIT 1001, KANSAS CITY, MO 64105
347 FLOOR, UNIT 1001, KANSAS CITY, MO 64105
PHONE: (816) 272-5555
EMAIL: jsc@jscengineers.com

ELECTRICAL LIGHTING SCHEDULE (OR EQUAL, VERIFY ALL SELECTIONS AND FINISHES WITH OWNER AND ARCHITECT PRIOR TO ORDERING).							
FIXTURE TYPE	NAME	MANUFACTURER SERIES	VOLT AMPS	MOUNTING	LAMP TYPE	REMARKS	VOLT
A	LITHONIA	CSS 4' STRIP LIGHT	35.8	SUSPENDED	INCLUDED 3500K LED	4' LED STRIP LIGHT - COORDINATE MOUNTING WITH CEILING PER ROOM.	120
C	LITHONIA	WF4	10	RECESSED	INCLUDED 4000K LED	4' LED CAN LIGHT - WET LOCATION RATED	120
D	ELEMENTAL LED OR EQUAL	BLAZE BASICS LED TAPE LIGHT	3W/FT	SURFACE	INCLUDED 3000K LED	LED LINEAR TAPE LIGHT - 200LM/FT - 3000K - WET LOCATION RATED - PROVIDE DRIVERS/TRANSFORMERS AND OTHER ACCESSORIES AS NECESSARY TO MAKE COMPLETE SYSTEM IN ACCORDANCE WITH DESIGN INTENT - CONTROL VIA EXTERIOR PHOTOCCELL	120
E1	LITHONIA	WDGE3-P3-40K-80CRI-R4-MVOLT-SRM-E15WC	71	WALL SURFACE	INCLUDED 4000K LED	EXTERIOR WALL PACK	120
E2	LUMINIS	ECLIPSE EC613-EC6W	24	WALL SURFACE	INCLUDED 4000K LED	EXTERIOR ARCHITECTURAL WALL FIXTURE	120
E3	EATON	LUMIERE 123SE-SQ	4	WALL RECESSED	INCLUDED 4000K LED	EXTERIOR STEP LIGHT - PROVIDE WITH TRANSFORMERS/DRIVERS AS NECESSARY TO MAKE FULLY OPERATIONAL SYSTEM	12
E4	LUMINIS	NAUTILUX-LED N7854R	25	WALL RECESSED	INCLUDED 4000K LED	EXTERIOR STEP LIGHT	120
E5	LUMINIS	LUMISTIK CL325	20	WALL SURFACE	INCLUDED 4000K LED	EXTERIOR ARCHITECTURAL TUBE LIGHT	120
E6	LUMINIS	SCIROCCO-LED SR528	18	WALL SURFACE	INCLUDED 4000K LED	EXTERIOR EGRESS LIGHT	120
E7	LUMINIS	SYRIOS-LED SY300	13	WALL SURFACE	INCLUDED 3500K LED	EXTERIOR ARCHITECTURAL WALL UPLIGHT	120
	LITHONIA	ELM2-SD	5	SURFACE	INCLUDED LED	EMERGENCY EGRESS LIGHTING UNIT WITH 90 MIN. BATTERY PACK	120
	LITHONIA	LHGM-LED-R-SD	5	SURFACE	INCLUDED LED	EMERGENCY EXIT EGRESS COMBO LIGHTING UNIT WITH RED FACE EXIT SIGN AND 90 MIN. BATTERY PACK	120
	LITHONIA	ELA-B-T-QWP-10309-SD	5	SURFACE	INCLUDED LED	OUTDOOR EMERGENCY REMOTE EGRESS LIGHTING UNIT	120

Short-Circuit and Voltage Drop Calculations

Distances are for calculation purposes only and shall not be used for contractor takeoffs nor bidding - Contractor shall notify Engineer of any field condition that results in a change of 10% or greater circuit distance

The following calculations are based on the "Point-by-Point" method where:

$$ISC_{(1)} = ISC_{(1)} \times M_{(1)}$$

$$ISC_{(1)} = \text{short circuit current at fault point 1}$$

$$ISC_{(2)} = \text{short circuit current at fault point 2}$$

$$M = 1/(1+I)$$

$$\text{Feeder: } f_{(100)} = \frac{1.732 \times L \times I_{sc}}{C \times E}$$

$$\text{XFMR: } f_{(100)} = \frac{I_{sc} \times V_p \times 1.73 \times \%Z}{100,000 \times KVA}$$

$$\text{Feeder: } f_{(100)} = \frac{2 \times L \times I_{sc}}{C \times E}$$

$$\text{XFMR: } f_{(100)} = \frac{I_{sc} \times V_p \times \%Z}{100,000 \times KVA}$$

$$IS_{(100)} = \frac{V_p \times M \times I_{sc}}{V_s}$$

VOLTAGE DROP (3Ø):

$$\%VD = ((R \times \cos(\arccos(pf)) + X \times \sin(\arccos(pf))) \times L \times I \times 1.73) / E$$

VOLTAGE DROP (1Ø):

$$\%VD = ((R \times \cos(\arccos(pf)) + X \times \sin(\arccos(pf))) \times 2 \times L \times I) / E$$

IP = Primary short circuit current

Vp = Primary voltage

IS = Secondary short circuit current

Vs = Secondary voltage

L = Length of circuit

E = Line to line volts

C = "C" Factor from Bussman table where "C" = 1 / impedance per linear foot

Feeder Types =

NM - Non Magnetic Conduit, M - Magnetic Conduit, FB - Feeder Busway, PB - Plug-in Busway, TX - Transformer

%VD CUM= Cumulative Voltage Drop from Fault Point 1 to Fault Point #

R= resistance in ohms per LF

X= reactances in ohms per LF

Date of Calculations: 09/22/2020

System Voltage: 208Y/120V - 3 phase

Fault Point (#)	Bus/Feeder Description	Source (Fault Point)	Phase	Source Isc (amps)	Conduit Type/TX	Material	Quantity of Parallel Sets and Bus/Phase & Neutral Size	Conductor 'C' Value	Busway 'C' Value	L-L Voltage (E)	Circuit Length (L)	Load Power Factor (pf)	Circuit Load (Amperage)	Resistance (R)	Conductor Reactance (X)	Arccos (pf) (Radians)	Type	Degree Rise	kVA	New Xlmr Z	Existing Xlmr Z	Secondary Voltage	Tap Setting	f	M	Fault Current (amps)	Voltage Drop (%)	Cumulative Voltage Drop (%)	Fault Point (#)	
1	Utility Service Point			55,580			at the secondary of the utility transformer																						1	
300 The connected full load motor amps (includes compressors) on the system																														
2	TO MIDP	1	3	57380	NM	AL	41 Sets(s) of 1/350 AWG	12844	--	208	150	0.8	80	0.000061	0.000040	0.843501									1.068	0.48	27777	-0.18%	-0.18%	2
3	TO PNLBD 'PH'	2	3	27777	M	CU	11 Set(s) of 3/30 AWG	12844	--	208	20	0.8	4	0.000079	0.000052	0.843501									0.360	0.74	20422	-0.01%	-0.19%	3
4	TO PNLBD 'P1A'	2	3	27777	M	CU	11 Set(s) of 3/30 AWG	12844	--	208	30	0.8	15	0.000079	0.000052	0.843501									0.540	0.65	18034	-0.04%	-0.22%	4
5	TO PNLBD 'P2A'	2	3	27777	M	CU	11 Set(s) of 3/30 AWG	12844	--	208	70	0.8	15	0.000079	0.000052	0.843501									1.261	0.44	12287	-0.08%	-0.26%	5
6	TO PNLBD 'P3A'	2	3	27777	M	CU	11 Set(s) of 3/30 AWG	12844	--	208	100	0.8	11	0.000079	0.000052	0.843501									1.801	0.36	9917	-0.09%	-0.27%	6
7	TO PNLBD 'P1B'	2	3	27777	M	CU	11 Set(s) of 3/30 AWG	12844	--	208	35	0.8	19	0.000079	0.000052	0.843501									0.630	0.61	17038	-0.05%	-0.23%	7
8	TO PNLBD 'P2B'	2	3	27777	M	CU	11 Set(s) of 3/30 AWG	12844	--	208	55	0.8	16	0.000079	0.000052	0.843501									0.990	0.50	13955	-0.07%	-0.25%	8

SC/VD CALCULATIONS

SCALE : NO SCALE

2


- PROVIDE NEW CONDUCTORS TO UTILITY TRANSFORMER. VERIFY EXACT LOCATION AND REQUIREMENTS WITH UTILITY PRIOR TO TRENCHING.
- PROVIDE NEW UTILITY METER SECTION PER UTILITY REQUIREMENTS IN COORDINATION WITH SWITCHGEAR VENDOR. BASIS OF DESIGN IS GENERAL ELECTRIC TMP3SB10R MAIN BREAKER MODULE - BOTTOM CENTER FEED CONSTRUCTION - 1000A MCB, 65KAIC PROTECTED, 3PH, 4WIRE. PROVIDE WITH (6) TOTAL TENANT METER SOCKETS - BASIS OF DESIGN IS GENERAL ELECTRIC TMPR12322R - TWO STACKS OF (3) 225A METER SOCKETS ON EACH SIDE OF CENTER FEED SECTION. VERIFY ACTUAL METERING SCHEME IS PROPERLY SELECTED, APPROVED BY UTILITY, AND PRICED AS SUCH PRIOR TO BIDDING.
- EXTEND TENANT SERVICE FEEDERS FROM EXTERIOR METER CENTER TO TENANT PANEL.
- PROVIDE NEW GROUND PER NEC 250.52(A)(5). REFER TO DIAGRAM 3 THIS SHEET.
- BOND PER NEC 250.52(A)(2). REFER TO DIAGRAM 3 THIS SHEET.
- PROVIDE NEW GROUND PER NEC 250.52(A)(3). REFER TO DIAGRAM 3 THIS SHEET.
- PROVIDE NEW GROUND PER NEC 250.52(A)(1). REFER TO DETAIL 3 THIS SHEET.

FEEDER NUMBER	
1	(4) 4" (PVC) W/ 4 #350 AL EACH
2	(1) 2" (PVC) W/ 4 #3/0 CU & 1 #6 CU GRND

GROUNDING ELECTRODE SYSTEM DIAGRAM

SCALE : NO SCALE

3

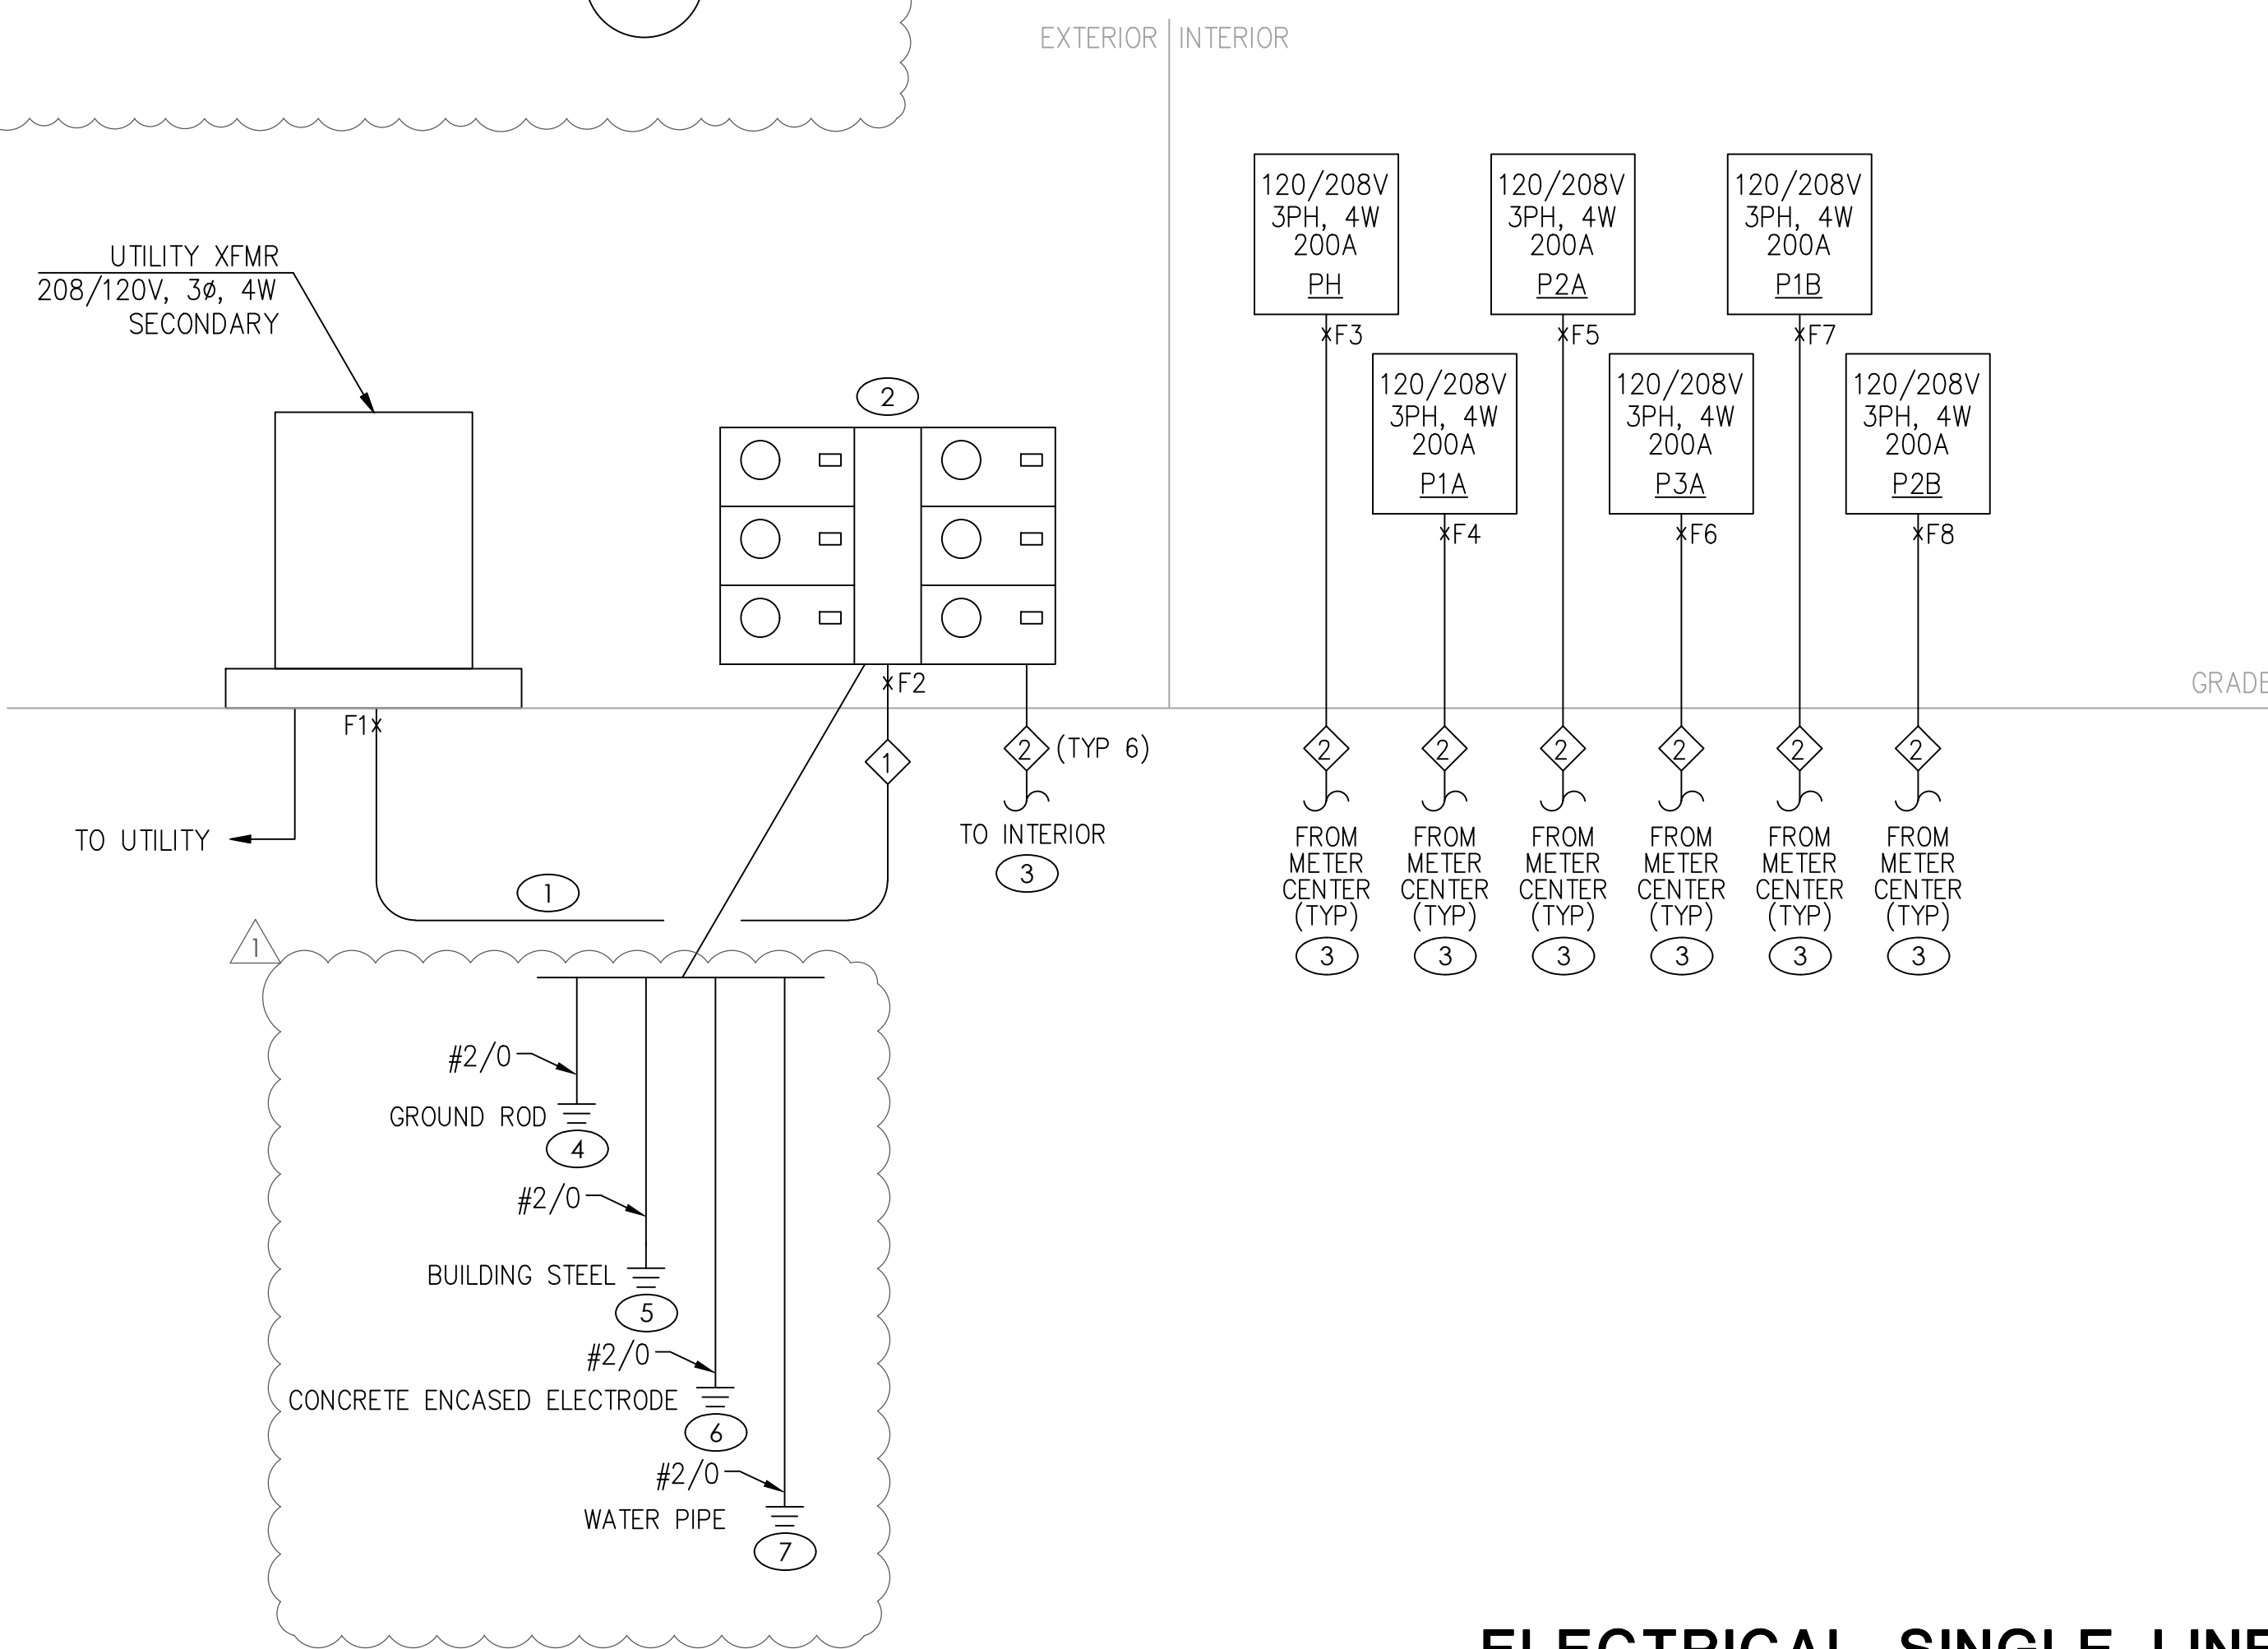

ELECTRICAL SINGLE LINE DIAGRAM

SCALE : NO SCALE

1

LOT 7, BUILDING 31

3140 SW LONGVIEW BLVD
LEE'S SUMMIT, MO 64081




REV ISSUE DATE
1 PLANCHUCK 2021 08 17

ELECTRICAL DIAGRAMS
& SCHEDULES

E201

MEP ENGINEER:

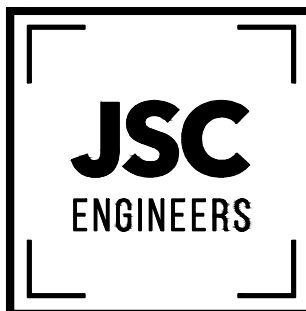MO CON NO. 300007816 HS CON NO. E-2018
1001 WEST BLUE HAWKWAY, UNITY VILLAGE, MO 64108
3RD FLOOR, UNITY VILLAGE TOWER
PHONE: (816) 272-5285
EMAIL: jsc@jsc-engineers.com

PANELBOARD: PH (NEW)														FED FROM:				MDP				LINE-SIDE LUGS: MECHANICAL							
BUS AMPS: 225A														AC RATING: FCA +10% MINIMUM FULLY RATED												EQUIPMENT GROUND BUS			
MAIN SIZE/TYPE: 200A MCB														SERVES: HOUSE															
VOLT/PHASE: 208Y/120V, 3PH, 4W														MOUNTING: RECESSED															
SECTION: 1														LOCATION: BACK OF HOUSE															
CKT NO.	DESCRIPTION	VOLT/AMPS/PHASE			WIRE NO.	BKR AMP	P	BKR AMP	WIRE NO.	VOLT/AMPS/PHASE			DESCRIPTION	CKT NO.															
		A	B	C						A	B	C																	
1	LTG - EXTERIOR W/ATC	1,200			12	20	1	1	20	12	180			2															
3	LTG - EXTERIOR TAPE W/ATC		550		12	20	1	1	20	12		540		4															
5	SPARE				20	1	1	1	20	12			1,200	6															
7	SPARE				20	1	1	1	20	12		1,200		8															
9	SPARE				20	1	1	1	20					10															
11	SPARE				20	1	1	1	20					12															
13	SPARE				20	1	1	1	20					14															
15	SPARE				20	1	1	1	20					16															
17	SPARE				20	1	1	1	20					18															
19	SPARE				20	1	1	1	20					20															
21	PROVISIONAL SPACE					1	1	1						22															
23	PROVISIONAL SPACE					1	1	1						24															
25	PROVISIONAL SPACE					1	1	1						26															
27	PROVISIONAL SPACE					1	1	1						28															
29	PROVISIONAL SPACE					1	1	1						30															
31	PROVISIONAL SPACE					1	1	1						32															
33	PROVISIONAL SPACE					1	1	1						34															
35	PROVISIONAL SPACE					1	1	1						36															
37	PROVISIONAL SPACE					1	1	1						38															
39	PROVISIONAL SPACE					1	1	1						40															
41	PROVISIONAL SPACE					1	1	1						42															
SUBTOTAL		1,200	550							1,380	540	1,200																	
TOTAL PHASE A - VA		2,580			LOAD		CONN. VA		DF	LOAD		CONN. VA		DF															
AMPS		22			COOLING		1,000		1.00	REFRIG		1,000		1.00															
TOTAL PHASE B - VA		1,090			HEATING		0		1.25	SIGN/DISP		1,25		1.25															
AMPS		9			LIGHTING		1,750		1.25	KITCHEN		1,00		1.00															
TOTAL PHASE C - VA		1,200			RECEPTACLES		720		1.0/5	EXISTING		1,00		1.00															
AMPS		10			MOTORS		2,400		1.00	LRG MOTOR		1,25		1.25															
TOTAL PNLBD - VA		4,870			SUFF HEAT		1,00		1.25	SHOW WNDW		1,25		1.25															
AMPS		14			IMISC EQUIP		1,00		1.00	LTG TRACK		1,00		1.00															
PANELBOARD NOTES														5,398 VA		15A													

PANELBOARD: P1A (NEW)														FED FROM: MDP				LINE-SIDE LUGS: MECHANICAL			
BUS AMPS: 225A														AC RATING: FCA +10% MINIMUM FULLY RATED				EQUIPMENT GROUND BUS			
MAIN SIZE/TYPE: 200A MCB														SERVES: P1A							
VOLT/PHASE: 208Y/120V, 3PH, 4W														MOUNTING: RECESSED							
SECTION: 1														LOCATION: BACK OF HOUSE							
CKT NO.	DESCRIPTION	VOLT/AMPS/PHASE			WIRE NO.	BKR AMP	P	BKR AMP	WIRE NO.	VOLT/AMPS/PHASE			DESCRIPTION	CKT NO.							
		A	B	C						A	B	C									
1	LTG - TENANT SPACE P1A	500			12	20	1	1	20	12	180		RCPT - BY PANEL	2							
3	SPARE				20	1	1	1	20	12		1,200	PWR - SIGNAGE 1	4							
5	SPARE				20	1	1	1	20	12			1,200	PWR - SIGNAGE 2	6						
7	SPARE				20	1	1	1	20	12		1,200	PWR - SIGNAGE 3	8							
9	SPARE				20	1	1	1	20	12			1,200	PWR - HEAT TRACE	10						
11	SPARE				20	1	1	1	20					SPARE	12						
13	SPARE				20	1	1	1	20					SPARE	14						
15	SPARE				20	1	1	1	20					SPARE	16						
17	SPARE				20	1	1	1	20					SPARE	18						
19	SPARE				20	1	1	1	20					SPARE	20						
21	PROVISIONAL SPACE								1	1				PROVISIONAL SPACE	22						
23	PROVISIONAL SPACE								1	1				PROVISIONAL SPACE	24						
25	PROVISIONAL SPACE								1	1				PROVISIONAL SPACE	26						
27	PROVISIONAL SPACE								1	1				PROVISIONAL SPACE	28						
29	PROVISIONAL SPACE								1	1				PROVISIONAL SPACE	30						
31	PROVISIONAL SPACE								1	1				PROVISIONAL SPACE	32						
33	PROVISIONAL SPACE								1	1				PROVISIONAL SPACE	34						
35	PROVISIONAL SPACE								1	1				PROVISIONAL SPACE	36						
37	PROVISIONAL SPACE								1	1				PROVISIONAL SPACE	38						
39	PROVISIONAL SPACE								1	1				PROVISIONAL SPACE	40						
41	PROVISIONAL SPACE								1	1				PROVISIONAL SPACE	42						
SUBTOTAL		500								1,380	2,400	1,200		SUBTOTAL							
TOTAL PHASE A - VA		1,880			LOAD		CONN. VA		DF	LOAD		CONN. VA		DF							
AMPS		16			COOLING		1,000		1.00	REFRIG		1,000		1.00							
TOTAL PHASE B - VA		2,400			HEATING		0		1.25	SIGN/DISP		3,800		1.25							
AMPS		20			LIGHTING		500		1.25	KITCHEN		1,00		1.00							
TOTAL PHASE C - VA		1,200			RECEPTACLES		180		1.0/5	EXISTING		1,00		1.00							
AMPS		10			MOTORS		1,000		1.00	LRG MOTOR		1,25		1.25	TOTAL DEMAND						
TOTAL PNLBD - VA		5,480			SUPP HEAT		1,000		1.25	SHOW WNDW		1,25		1.25	6,555 VA						
AMPS		15			MISC EQUIP		1,200		1.00	LTG TRACK		1,00		1.00	18 A						
PANELBOARD NOTES																					

SIGN/DISPLAY - SIGNAGE & DISPLAY CASE

PANELBOARD: P2A (NEW)										FED FROM: MDP				LINE-SIDE LUGS: MECHANICAL					
BUS AMPS: 225A										AC RATING: FCA +10% MINIMUM FULLY RATED									
MAIN SIZE/TYPE: 200A MCB										SERVES: P2A									
VOLT/PHASE: 208Y/120V, 3PH, 4W										MOUNTING: RECESSED									
SECTION: 1										LOCATION: BACK OF HOUSE									
CKT NO.	DESCRIPTION	VOLT/AMPS/PHASE			WIRE NO.	BKR AMP	P	BKR AMP	WIRE NO.	VOLT/AMPS/PHASE			DESCRIPTION	CKT NO.					
		A	B	C						A	B	C							
1	LTG - TENANT SPACE P2A	500			12	20	1	1	20	12	180		RCPT - BY PANEL	2					
3	SPARE				20	1	1	1	20	12		1,200	PWR - SIGNAGE 1	4					
5	SPARE				20	1	1	1	20	12			1,200	PWR - SIGNAGE 2	6				
7	SPARE				20	1	1	1	20	12		1,200	PWR - SIGNAGE 3	8					
9	SPARE				20	1	1	1	20	12		1,200	PWR - HEAT TRACE	10					
11	SPARE				20	1	1	1	20				SPARE	12					
13	SPARE				20	1	1	1	20				SPARE	14					
15	SPARE				20	1	1	1	20				SPARE	16					
17	SPARE				20	1	1	1	20				SPARE	18					
19	SPARE				20	1	1	1	20				SPARE	20					
21	SPARE				1	1	1	1					PROVISIONAL SPACE	22					
23	PROVISIONAL SPACE				1	1	1	1					PROVISIONAL SPACE	24					
25	PROVISIONAL SPACE				1	1	1	1					PROVISIONAL SPACE	26					
27	PROVISIONAL SPACE				1	1	1	1					PROVISIONAL SPACE	28					
29	PROVISIONAL SPACE				1	1	1	1					PROVISIONAL SPACE	30					
31	PROVISIONAL SPACE				1	1	1	1					PROVISIONAL SPACE	32					
33	PROVISIONAL SPACE				1	1	1	1					PROVISIONAL SPACE	34					
35	PROVISIONAL SPACE				1	1	1	1					PROVISIONAL SPACE	36					
37	PROVISIONAL SPACE				1	1	1	1					PROVISIONAL SPACE	38					
39	PROVISIONAL SPACE				1	1	1	1					PROVISIONAL SPACE	40					
41	PROVISIONAL SPACE				1	1	1	1					PROVISIONAL SPACE	42					
SUBTOTAL		500								1,380	2,400	1,200		SUBTOTAL					
TOTAL PHASE A - VA		1,880	LOAD		CONN. VA	DF		LOAD		CONN. VA	DF								
AMPS		16	COOLING		1,000	1.00		REFRIG			1,000								
TOTAL PHASE B - VA		2,400	HEATING		0	0.00		SIGN/DISP		3,600	1.25								
AMPS		20	AMPS		500	1.25		KITCHEN			1.00								
TOTAL PHASE C - VA		1,200	RECEPTACLES		180	10/5		EXISTING											
AMPS		10	MOTORS		0	0.00		LRG MOTOR			1.25	TOTAL DEMAND							
TOTAL PNL BD - VA		5,480	SUPP HEAT		1,000	1.00		SHOW/WDW			1.25	6,505 VA							
AMPS		15	MISC EQUIP		1,200	1.00		LTG TRACK			1.00	12 A							
PANELBOARD NOTES																			
SIGN/DISPLAY - SIGNAGE & DISPLAY CABS																			