## SHAKE SHACK®

2051 NW LOWENSTEIN DRIVE LEE'S SUMMIT, MISSOURI 64081 SHACK #1348

FIELD NOTICE #3: 2021-08-09 FIELD NOTICE #4 2021-09-09



PERSPECTIVE VIEW RAREA / LOCATION MAP PERMIT/BID ISSUE DATE NO. ISSUE DATE DESCRIPTION

PROJECT TEAM			ET INDEX AND ISSUE MATRIX
OMNIEDIO DECICAL DECI MANACED	MED ENGINEED	SHEET NO.	SHEET NAME
<u>OWNER'S DESIGN PROJECT MANAGER</u> SHAKE SHACK	MEP ENGINEER SCHNACKEL ENGINEERS, INC.	<b>q</b> ——	
25 VARICK ST, SUITE 301	3035 SOUTH 72ND STREET	00 GENER	RAL
IEW YORK, NY 10014	OMAHA, NE 68124	T001	TITLE SHEET
CONTACT: THEA WILLIAMSON : 347.640.0982	CONTACT: DUSTIN WOLLENBURG T: 531.329.6292	T002	RESPONSIBILITY SCHEDULE & VENDOR CONTACTS
. 347.040.0302	1. 331.323.0232	T003	SYMBOLS, GENERAL NOTES & ABBREVIATIONS
WNER'S CONSTRUCTION PROJECT MANAGER	STRUCTURAL ENGINEER	T004	CODE ANALYSIS, OCCUPANCY & EGRESS
HAKE SHACK	H+O STRUCTURAL ENGINEERING	K	
25 VARICK ST, SUITE 301 EW YORK, NY 10014	51 MELCHER ST FLR 1 BOSTON, MA 02210	01 CIVIL	
CONTACT: CHRIS PIPER	CONTACT: RENS HAYES	C-1	SITE PLAN
646.661.0958	T: 617.938.3349 x 7011	C-2 C-3	UTILITY PLAN GRADING PLAN
ANDLORD	KITCHEN CONSULTANT	U-3	GRADING PLAN
RAKE DEVELOPMENT	TRIMARK UNITED EAST FOOD SERVICE DESIGN	02 SITE	
200 W. 132ND ST., SUITE 150	505 COLLINS STREET	AS101	ARCHITECTURAL SITE PLAN
VERLAND PARK, KS 66213	SOUTH ATTLEBORO, MA 02703	AS102	ENLARGED PATIO PLAN AND EXTERIOR DETAILS
ONTACT: IAN MUSSMAN 913.662.2630	CONTACT: MICHAEL HENDERSON T: 508.399.2392	AS201	SITE DETAILS
710.002.2000	1. 000.088.2082	4	-
<u>CHITECT</u>	CIVIL ENGINEER	03 STRUC	CTURAL
RGMEYER ASSOCIATES, INC.	SW ENGINEERING	S000	ISOMETRIC VIEWS
SLEEPER STREET, 6TH FLOOR OSTON, MA 02210	5507 HIGH MEADOW CIRCLE MANHATTAN, KS 66503	S001	GENERAL NOTES I
RINCIPAL IN CHARGE: MIKE DAVIS	CONTACT: SAM MALINOWSKY	S002	GENERAL NOTES II
OJECT MANAGER: CHRISTINA SANDORE	T: 785.341.9747	S003	LOADING PLANS
617.542.1025		S100	FOUNDATION PLAN
	GENERAL CONTRACTOR SPIEGELGLASS CONSTRUCTION COMPANY	S101	CANOPY FRAMING PLAN
	18 WORTHINGTON ACCESS DRIVE	S102	ROOF FRAMING PLAN
	MARYLAND HEIGHTS, MO 63043	S200	COLUMN SCHEDULE
	CONTACT: TIM SPIEGELGLASS	S201	BUILDING SECTIONS
	E: TIM@SPIEGELGLASS-GC.COM	S300	LATERAL FRAME ELEVATIONS
	T: 314.575.9938	S400	CONCRETE DETAILS I
		S401	CONCRETE DETAILS II
		S500 S501	STEEL DETAILS I
		S501	STEEL DETAILS III
		0302	STEEL DETAILS III
		04 ARCHI	TECTURAL
		A100	CURB & FOUNDATION PLAN
		A101	GENERAL ARRANGEMENT PLAN
		A102	DIMENSIONED PLAN
		A103	FLOOR FINISH PLAN
		A104	FURNITURE & EQUIPMENT PLAN
		A105	SIGNAGE AND GRAPHICS PLAN
		A120	REFLECTED CEILING PLAN
		A150	ROOF PLAN
		A201 A210	EXTERIOR ELEVATIONS
		A210 A211	INTERIOR ELEVATIONS INTERIOR ELEVATIONS
		A211 A301	BUILDING SECTIONS
		A301 A302	EXTERIOR WALL SECTIONS
		A302 A303	EXTERIOR WALL SECTIONS  EXTERIOR WALL SECTIONS
		A303	EXTERIOR WALL SECTIONS
		A305	EXTERIOR WALL SECTIONS
		A310	INTERIOR SECTIONS
		A401	ENLARGED MANAGER'S OFFICE PLAN
ROJECT NARRATIVE		A402	ENLARGED WOMENS RESTROOM PLAN
		A403	ENLARGED MENS RESTROOM PLAN
		A501	EXTERIOR DETAILS - PLAN
HIS PROJECT IS NEW CONSTRUCTION, FREE STANDING		A502	EXTERIOR DETAILS - SECTION
HE INTENDED USE GROUP IS A2. NEW STRUCTURAL, C ROTECTION COMPONENTS ARE PROPOSED	IVIL, MECHANICAL, ELECTRICAL, PLUMBING, AND FIRE	A503	EXTERIOR DETAILS - SECTION
CILCITON COMECINENTS AND FROPUSED		A504	EXTERIOR DETAILS - ROOF
IE BUILDING WILL BE SPRINKLERED.		A510	WALL TYPES
		A520	ATAS METAL PANEL TRIM DETAILS
		A530	INTERIOR DETAILS

INTERIOR SEATS EXTERIOR SEATS

TOTAL SEATS

EXTERIOR SF TOTAL SF

SQUARE FOOTAGE


1039 SF

4399 SF

SHEET NO.	SHEET NAME	PERMIT/BID ISSUE DATE	NO.	ISSUE DATE	REVISION DESCRIPTION
.,	1	IOOUL DATE	IVO.	1000L DATE	DESCRIPTION
00 GENEF					
T001 T002	TITLE SHEET RESPONSIBILITY SCHEDULE & VENDOR CONTACTS	2021-01-11 2021-01-11	7	2021-09-09 2021-04-26	FIELD NOTICE #4 ISSUED FOR CONSTRUCTION
T002	SYMBOLS, GENERAL NOTES & ABBREVIATIONS	2021-01-11	3	2021-04-26	ISSUED FOR CONSTRUCTION
T004	CODE ANALYSIS, OCCUPANCY & EGRESS	2021-01-11	3	2021-04-26	ISSUED FOR CONSTRUCTION
	,			_	
01 CIVIL	Tanana	Tanan ann a		T	T
C-1	SITE PLAN	2021-01-11	5	2021-05-17	FIELD NOTICE #2
C-2 C-3	UTILITY PLAN GRADING PLAN	2021-01-11 2021-01-11	3	2021-04-26 2021-04-26	ISSUED FOR CONSTRUCTION ISSUED FOR CONSTRUCTION
U-3	GRADING FLAN	2021-01-11	3	2021-04-20	1330ED FOR CONSTRUCTION
02 SITE					
AS101	ARCHITECTURAL SITE PLAN	2021-01-11	7	2021-09-09	FIELD NOTICE #4
AS102	ENLARGED PATIO PLAN AND EXTERIOR DETAILS	2021-01-11	6	2021-08-09	FIELD NOTICE #3
AS201	SITE DETAILS		6	2021-08-09	FIELD NOTICE #3
03 STRUC	CTURAL				
S000	ISOMETRIC VIEWS	2021-01-11	3	2021-04-26	ISSUED FOR CONSTRUCTION
S001	GENERAL NOTES I	2021-01-11	3	2021-04-26	ISSUED FOR CONSTRUCTION
S002	GENERAL NOTES II	2021-01-11	3	2021-04-26	ISSUED FOR CONSTRUCTION
S003	LOADING PLANS	2021-01-11	3	2021-04-26	ISSUED FOR CONSTRUCTION
S100 S101	FOUNDATION PLAN  CANOPY FRAMING PLAN	2021-01-11 2021-01-11	3	2021-04-26 2021-04-26	ISSUED FOR CONSTRUCTION ISSUED FOR CONSTRUCTION
S101 S102	ROOF FRAMING PLAN	2021-01-11	3	2021-04-26	ISSUED FOR CONSTRUCTION
S200	COLUMN SCHEDULE	2021-01-11	3	2021-04-26	ISSUED FOR CONSTRUCTION
S201	BUILDING SECTIONS	2021-01-11	3	2021-04-26	ISSUED FOR CONSTRUCTION
S300	LATERAL FRAME ELEVATIONS	2021-01-11	3	2021-04-26	ISSUED FOR CONSTRUCTION
S400	CONCRETE DETAILS I	2021-01-11	6	2021-08-09	FIELD NOTICE #3
S401 S500	CONCRETE DETAILS II STEEL DETAILS I	2021-01-11 2021-01-11	3	2021-04-26	ISSUED FOR CONSTRUCTION ISSUED FOR CONSTRUCTION
S500 S501	STEEL DETAILS I	2021-01-11	3	2021-04-26	ISSUED FOR CONSTRUCTION
S502	STEEL DETAILS III	2021-01-11	3		ISSUED FOR CONSTRUCTION
	TECTURAL				
A100	CURB & FOUNDATION PLAN	2021-01-11	6		FIELD NOTICE #3
A101 A102	GENERAL ARRANGEMENT PLAN  DIMENSIONED PLAN	2021-01-11 2021-01-11	6	2021-04-26 2021-08-09	ISSUED FOR CONSTRUCTION FIELD NOTICE #3
A102	FLOOR FINISH PLAN	2021-01-11	6	2021-08-09	FIELD NOTICE #3
A104	FURNITURE & EQUIPMENT PLAN	2021-01-11	6	2021-08-09	FIELD NOTICE #3
A105	SIGNAGE AND GRAPHICS PLAN	2021-01-11	3	2021-04-26	ISSUED FOR CONSTRUCTION
A120	REFLECTED CEILING PLAN	2021-01-11	6	2021-08-09	FIELD NOTICE #3
A150	ROOF PLAN	2021-01-11	7	2021-09-09	FIELD NOTICE #4
A201 A210	EXTERIOR ELEVATIONS	2021-01-11	3	2021-04-26	ISSUED FOR CONSTRUCTION
A210 A211	INTERIOR ELEVATIONS INTERIOR ELEVATIONS	2021-01-11 2021-01-11	6	2021-08-09 2021-08-09	FIELD NOTICE #3 FIELD NOTICE #3
A301	BUILDING SECTIONS	2021-01-11	3	2021-04-26	ISSUED FOR CONSTRUCTION
A302	EXTERIOR WALL SECTIONS	2021-01-11	6	2021-08-09	FIELD NOTICE #3
A303	EXTERIOR WALL SECTIONS	2021-01-11	6	2021-08-09	FIELD NOTICE #3
A304	EXTERIOR WALL SECTIONS	2021-01-11	6	2021-08-09	FIELD NOTICE #3
A305	EXTERIOR WALL SECTIONS	2021-01-11	6	2021-08-09	FIELD NOTICE #3
A310 A401	INTERIOR SECTIONS ENLARGED MANAGER'S OFFICE PLAN	2021-01-11 2021-01-11	3 5	2021-04-26 2021-05-17	ISSUED FOR CONSTRUCTION FIELD NOTICE #2
A401 A402	ENLARGED WANAGER'S OFFICE PLAN  ENLARGED WOMENS RESTROOM PLAN	2021-01-11	3	2021-03-17	ISSUED FOR CONSTRUCTION
A403	ENLARGED MENS RESTROOM PLAN	2021-01-11	3	2021-04-26	ISSUED FOR CONSTRUCTION
A501	EXTERIOR DETAILS - PLAN	2021-01-11	3	2021-04-26	ISSUED FOR CONSTRUCTION
A502	EXTERIOR DETAILS - SECTION	2021-01-11	7	2021-09-09	FIELD NOTICE #4
A503	EXTERIOR DETAILS - SECTION	2021-01-11	3	2021-04-26	ISSUED FOR CONSTRUCTION
A504 A510	EXTERIOR DETAILS - ROOF WALL TYPES	2021-01-11 2021-01-11	3	2021-04-26 2021-04-26	ISSUED FOR CONSTRUCTION ISSUED FOR CONSTRUCTION
A510 A520	ATAS METAL PANEL TRIM DETAILS	2021-01-11	3	2021-04-26	ISSUED FOR CONSTRUCTION
A530	INTERIOR DETAILS	2021-01-11	3	2021-04-26	ISSUED FOR CONSTRUCTION
A540	MILLWORK DETAILS	2021-01-11	6	2021-08-09	FIELD NOTICE #3
A601	FINISH SCHEDULE	2021-01-11	6	2021-08-09	FIELD NOTICE #3
A602	DOOR, HARDWARE & SCHEDULES	2021-01-11	3	2021-04-26	ISSUED FOR CONSTRUCTION
A603	STOREFRONT SCHEDULES & ELEVATIONS  ADCHITECTURAL SPECIFICATIONS	2021-01-11	3	2021-04-26	ISSUED FOR CONSTRUCTION
A701 A702	ARCHITECTURAL SPECIFICATIONS ARCHITECTURAL SPECIFICATIONS	2021-01-11 2021-01-11	3	2021-04-26 2021-04-26	ISSUED FOR CONSTRUCTION ISSUED FOR CONSTRUCTION
A702	ARCHITECTURAL SPECIFICATIONS  ARCHITECTURAL SPECIFICATIONS	2021-01-11	3	2021-04-26	ISSUED FOR CONSTRUCTION
A704	ARCHITECTURAL SPECIFICATIONS	2021-01-11	3	2021-04-26	ISSUED FOR CONSTRUCTION
A705	ARCHITECTURAL SPECIFICATIONS	2021-01-11	3	2021-04-26	ISSUED FOR CONSTRUCTION
A801	EXTERIOR RENDERINGS	2021-01-11	3	2021-04-26	ISSUED FOR CONSTRUCTION
A802	INTERIOR RENDERINGS	2021-01-11	3	2021-04-26	ISSUED FOR CONSTRUCTION
05 KIT∩⊔I	EN EQUIPMENT				
QF001	FOODSERVICE GENERAL NOTES, LEGENDS, SHEET INDEX	2021-01-11	3	2021-04-26	ISSUED FOR CONSTRUCTION
QF101	FOODSERVICE EQUIPMENT PLAN	2021-01-11	6	2021-08-09	FIELD NOTICE #3
QF102	FOODSERVICE SCHEDULES	2021-01-11	3	2021-04-26	ISSUED FOR CONSTRUCTION
QF102A	FOODSERVICE UTILITY SCHEDULES	2021-01-11	3	2021-04-26	ISSUED FOR CONSTRUCTION
QF102B	FOODSERVICE UTILITY SCHEDULES	2021-01-11	3	2021-04-26	ISSUED FOR CONSTRUCTION

QF201	FOODSERVICE PLUMBING IN-SLAB ROUGH-IN PLAN	2021-01-11	6	2021-08-09	FIELD NOTICE #3
QF202	FOODSERVICE PLUMBING ABOVE SLAB ROUGH-IN PLAN	2021-01-11	3	2021-04-26	ISSUED FOR CONSTRUCTION
QF301	FOODSERVICE ELECTRICAL ROUGH-IN PLAN	2021-01-11	6	2021-08-09	FIELD NOTICE #3
QF401	FOODSERVICE SPECIAL CONDITIONS PLAN	2021-01-11	6	2021-08-09	FIELD NOTICE #3
QF501	FOODSERVICE ELEVATIONS	2021-01-11	3	2021-04-26	ISSUED FOR CONSTRUCTION
06 FIRE I	PROTECTION				
F001	FIRE PROTECTION ABBREVIATIONS & SYMBOLS	2021-01-11	3	2021-04-26	ISSUED FOR CONSTRUCTION
F101	FIRE PROTECTION PLAN	2021-01-11	4	2021-05-03	FIELD NOTICE #1
F501	FIRE PROTECTION DETAILS	2021-01-11	3	2021-04-26	ISSUED FOR CONSTRUCTION
F590	FIRE PROTECTION SPECIFICATIONS	2021-01-11	3	2021-04-26	ISSUED FOR CONSTRUCTION
F591	FIRE PROTECTION SPECIFICATIONS	2021-01-11	3	2021-04-26	ISSUED FOR CONSTRUCTION
07 MECH	AANICAI				
M001	MECHANICAL ABBREVIATIONS & SYMBOLS	2021-01-11	3	2021-04-26	ISSUED FOR CONSTRUCTION
M101	MECHANICAL FLOOR PLAN	2021-01-11	6	2021-08-09	FIELD NOTICE #3
M102	MECHANICAL REFRIGERANT PIPING LAYOUT PLAN	2021-01-11	3	2021-04-26	ISSUED FOR CONSTRUCTION
M150	MECHANICAL ROOF PLAN	2021-01-11	3	2021-04-26	ISSUED FOR CONSTRUCTION
M501	MECHANICAL DETAILS	2021-01-11	3	2021-04-26	ISSUED FOR CONSTRUCTION
M502	MECHANICAL DETAILS	2021-01-11	3	2021-04-26	ISSUED FOR CONSTRUCTION
M590	MECHANICAL SPECIFICATIONS	2021-01-11	3	2021-04-26	ISSUED FOR CONSTRUCTION
M591	MECHANICAL SPECIFICATIONS	2021-01-11	3	2021-04-26	ISSUED FOR CONSTRUCTION
M592	MECHANICAL SPECIFICATIONS	2021-01-11	3	2021-04-26	ISSUED FOR CONSTRUCTION
M593	MECHANICAL SPECIFICATIONS	2021-01-11	3	2021-04-26	ISSUED FOR CONSTRUCTION
M601	MECHANICAL SCHEDULES	2021-01-11	3	2021-04-26	ISSUED FOR CONSTRUCTION
M701	HALTON DRAWINGS	2021-01-11	3	2021-04-26	ISSUED FOR CONSTRUCTION
M702	HALTON DRAWINGS	2021-01-11	3	2021-04-26	ISSUED FOR CONSTRUCTION
M703	HALTON DRAWINGS	2021-01-11	3	2021-04-26	ISSUED FOR CONSTRUCTION
M704	HALTON DRAWINGS	2021-01-11	3	2021-04-26	ISSUED FOR CONSTRUCTION
M705	HALTON DRAWINGS	2021-01-11	3	2021-04-26	ISSUED FOR CONSTRUCTION
08 PLUM				T	1
P001	PLUMBING ABBREVIATIONS & SYMBOLS	2021-01-11	3	2021-04-26	ISSUED FOR CONSTRUCTION
P101	PLUMBING WASTE & VENT PLAN	2021-01-11	6	2021-08-09	FIELD NOTICE #3
P120	PLUMBING WATER & GAS	2021-01-11	6	2021-08-09	FIELD NOTICE #3
P150	PLUMBING ROOF PLAN	2021-01-11	3	2021-04-26	ISSUED FOR CONSTRUCTION
P501	PLUMBING DETAILS	2021-01-11	3	2021-04-26	ISSUED FOR CONSTRUCTION
P502	PLUMBING DETAILS	2021-01-11	3	2021-04-26	ISSUED FOR CONSTRUCTION
P590	PLUMBING SPECIFICATIONS	2021-01-11	3	2021-04-26	ISSUED FOR CONSTRUCTION
P591	PLUMBING SPECIFICATIONS	2021-01-11	3	2021-04-26	ISSUED FOR CONSTRUCTION
P592	PLUMBING SPECIFICATIONS	2021-01-11	3	2021-04-26	ISSUED FOR CONSTRUCTION
P601	PLUMBING SCHEDULE	2021-01-11	3	2021-04-26	ISSUED FOR CONSTRUCTION
P901	PLUMBING RISERS	2021-01-11	6	2021-08-09	FIELD NOTICE #3
09 ELEC	TRICAL				
E001	ELECTRICAL ABBREVIATION & SYMBOL LEGEND	2021-01-11	3	2021-04-26	ISSUED FOR CONSTRUCTION
E100	SITE ELECTRICAL PLAN	2021-01-11	7	2021-09-09	FIELD NOTICE #4
E101	ELECTRICAL POWER PLAN	2021-01-11	7	2021-09-09	FIELD NOTICE #4
E102	LOW VOLTAGE SYSTEMS PLAN	2021-01-11	6	2021-08-09	FIELD NOTICE #3
E120	ELECTRICAL LIGHTING PLAN	2021-01-11	7	2021-09-09	FIELD NOTICE #4
E150	ELECTRICAL ROOF PLAN	2021-01-11	3	2021-04-26	ISSUED FOR CONSTRUCTION
E501	ELECTRICAL DETAILS	2021-01-11	3	2021-04-26	ISSUED FOR CONSTRUCTION
E590	ELECTRICAL SPECIFICATIONS	2021-01-11	3	2021-04-26	ISSUED FOR CONSTRUCTION
E591	ELECTRICAL SPECIFICATIONS	2021-01-11	3	2021-04-26	ISSUED FOR CONSTRUCTION
E601	ELECTRICAL SCHEDULES & ONE-LINE	2021-01-11	7	2021-09-09	FIELD NOTICE #4
E620	LIGHTING SCHEDULES	2021-01-11	7	2021-09-09	FIELD NOTICE #4
E621	LUTRON VIVE ONE-LINE	2021-01-11	3	2021-04-26	ISSUED FOR CONSTRUCTION
E622	LUTRON VIVE ONE-LINE	2021-01-11	3	2021-04-26	ISSUED FOR CONSTRUCTION
E623	LUTRON VIVE ONE-LINE	2021-01-11	3	2021-04-26	ISSUED FOR CONSTRUCTION

SHEET NAME

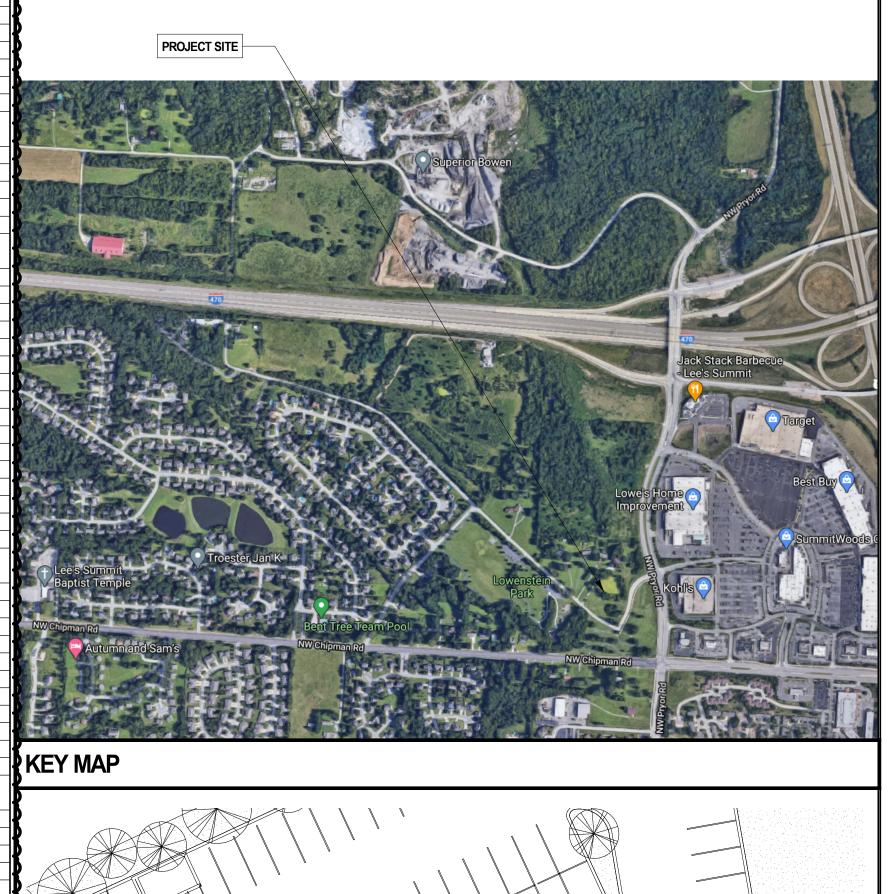

KEY MAP		_ E

SEAL/ SIGNATURE:


2021-09-09 | FIELD NOTICE #4 2021-08-09 FIELD NOTICE #3 2021-05-17 FIELD NOTICE #2 2021-05-03 FIELD NOTICE #1 2021-04-26 ISSUED FOR CONSTRUCTION 2021-03-31 ADDENDUM 2 2021-03-09 ADDENDUM 1 2021-01-11 PERMIT/BID SET 2020-12-21 75% SET 2020-10-12 DD SET O. BY DATE


SHAKE SHACK - LEE'S SUMMIT MO

2051 NW LOWENSTEIN DRIVE LEE'S SUMMIT, MISSOURI 64081 SHACK #1348

FIELD NOTICE #3

TITLE SHEET

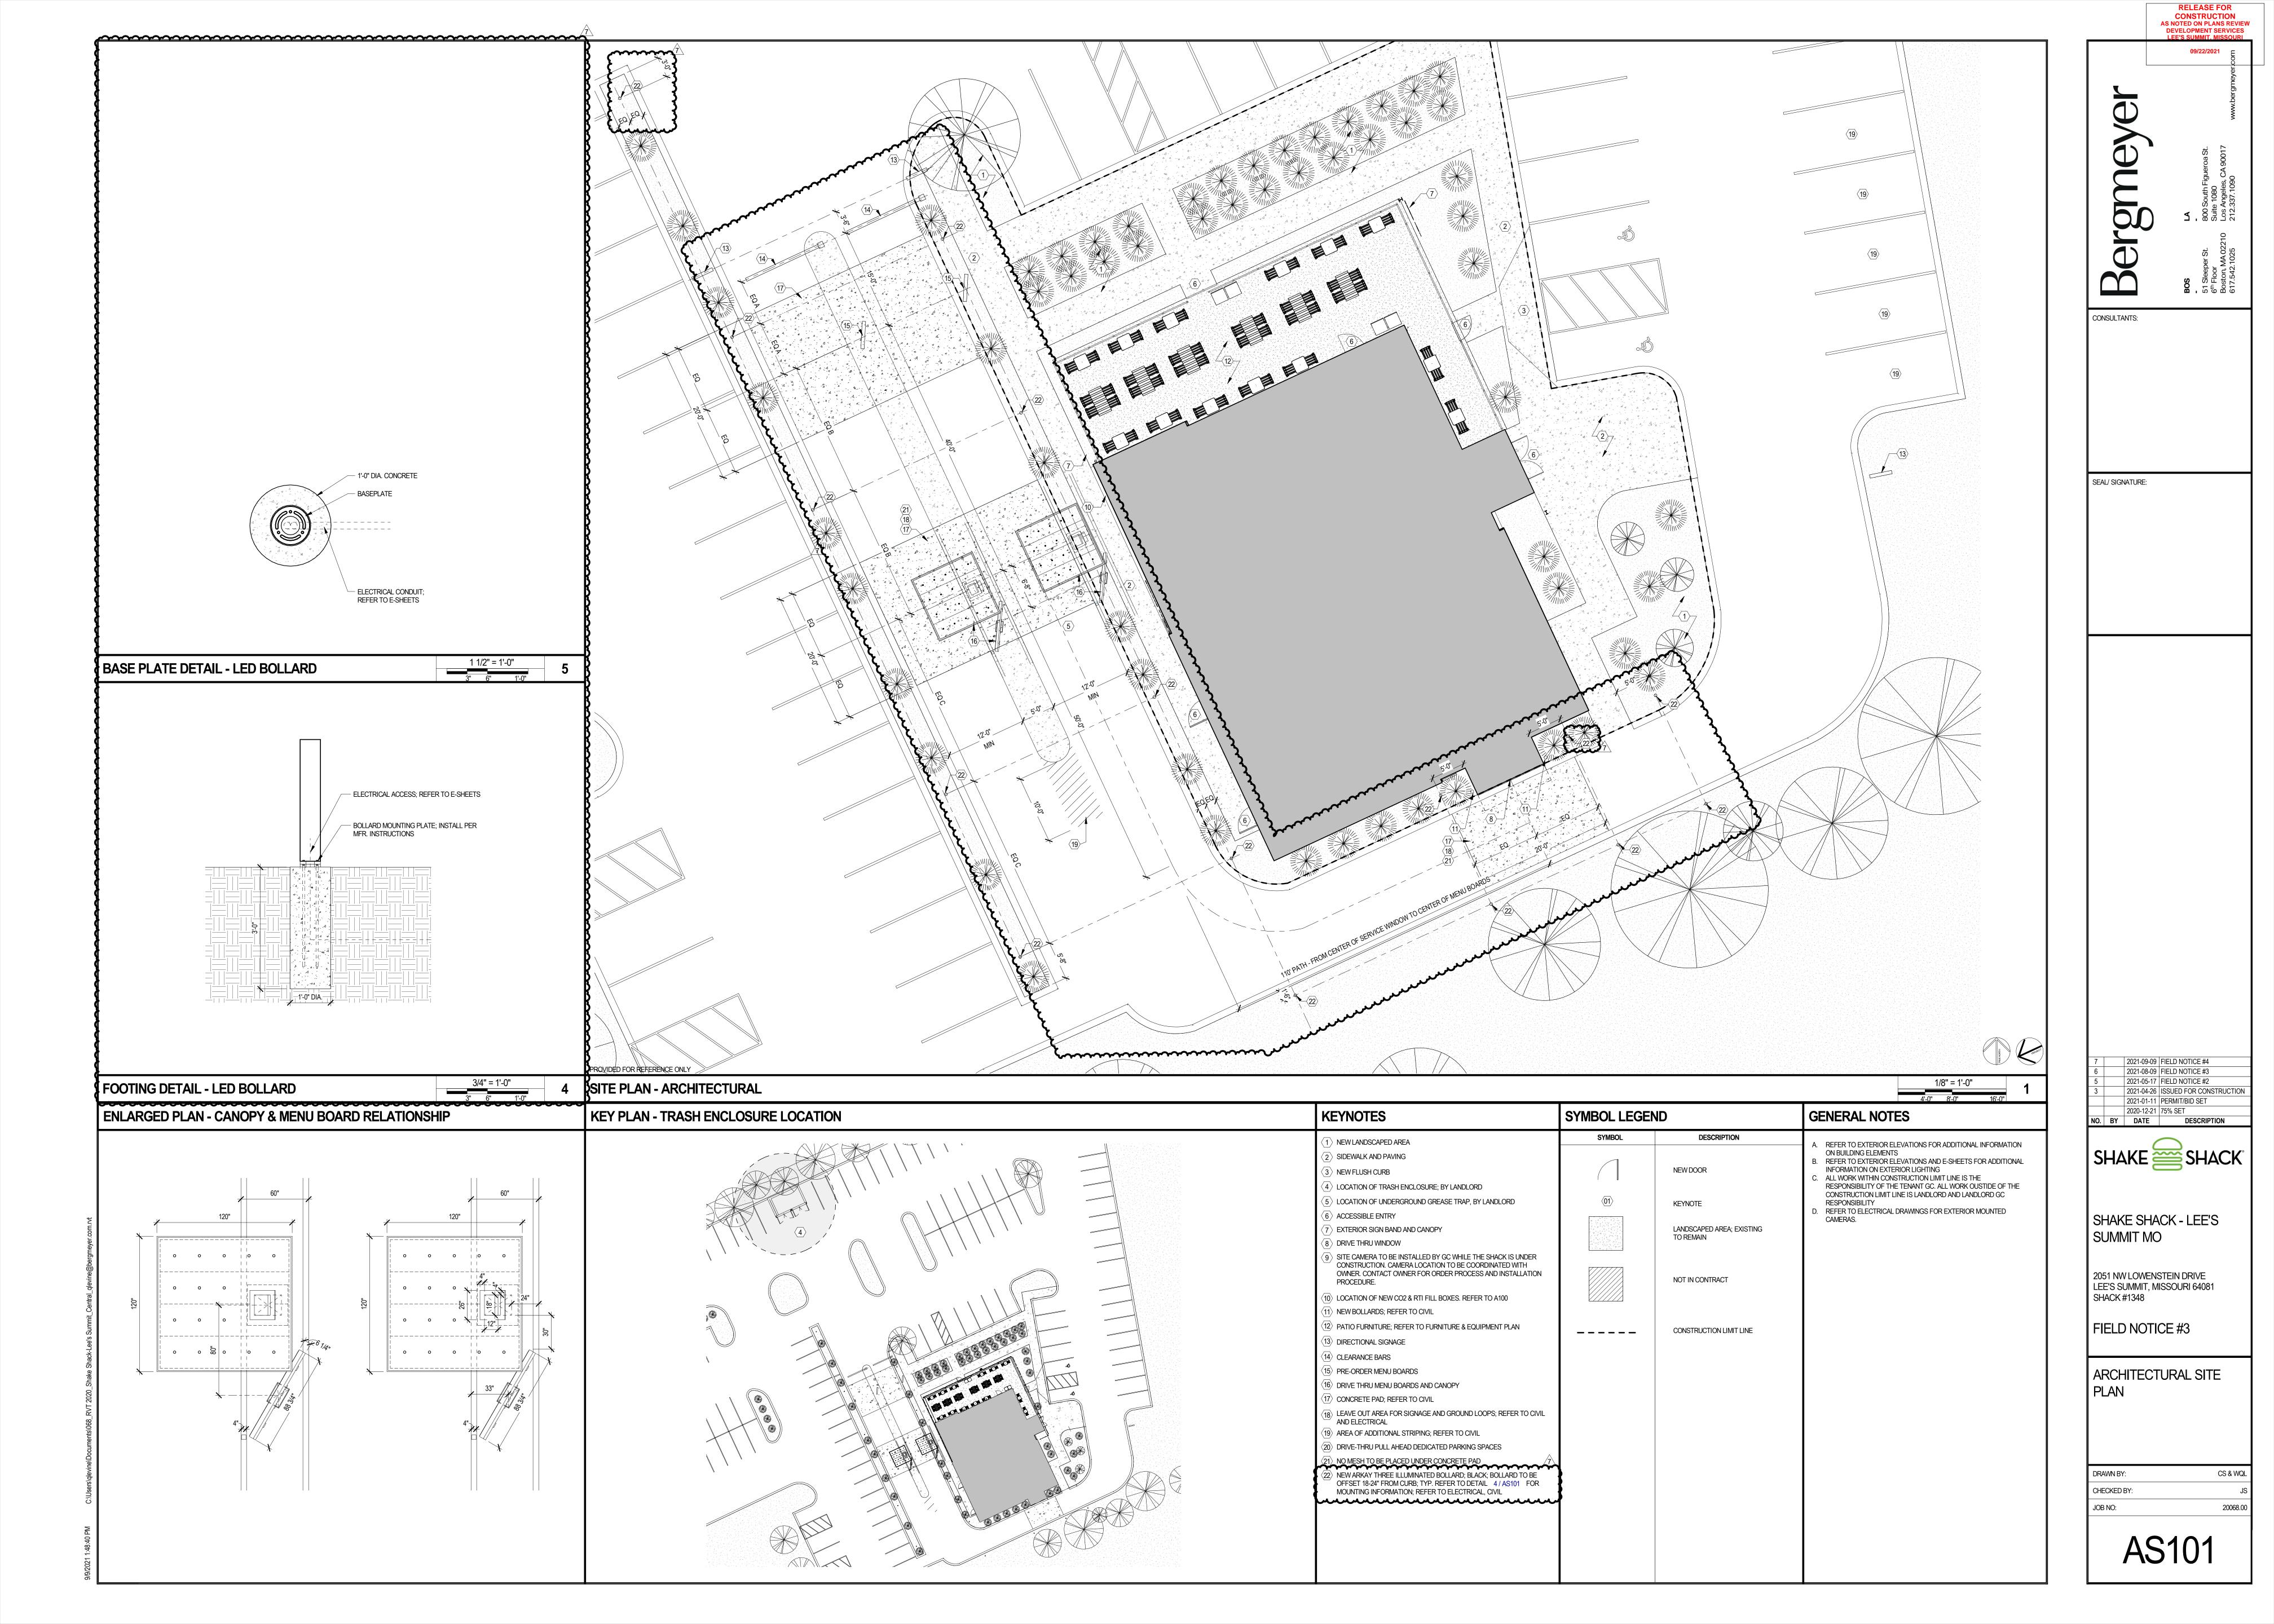

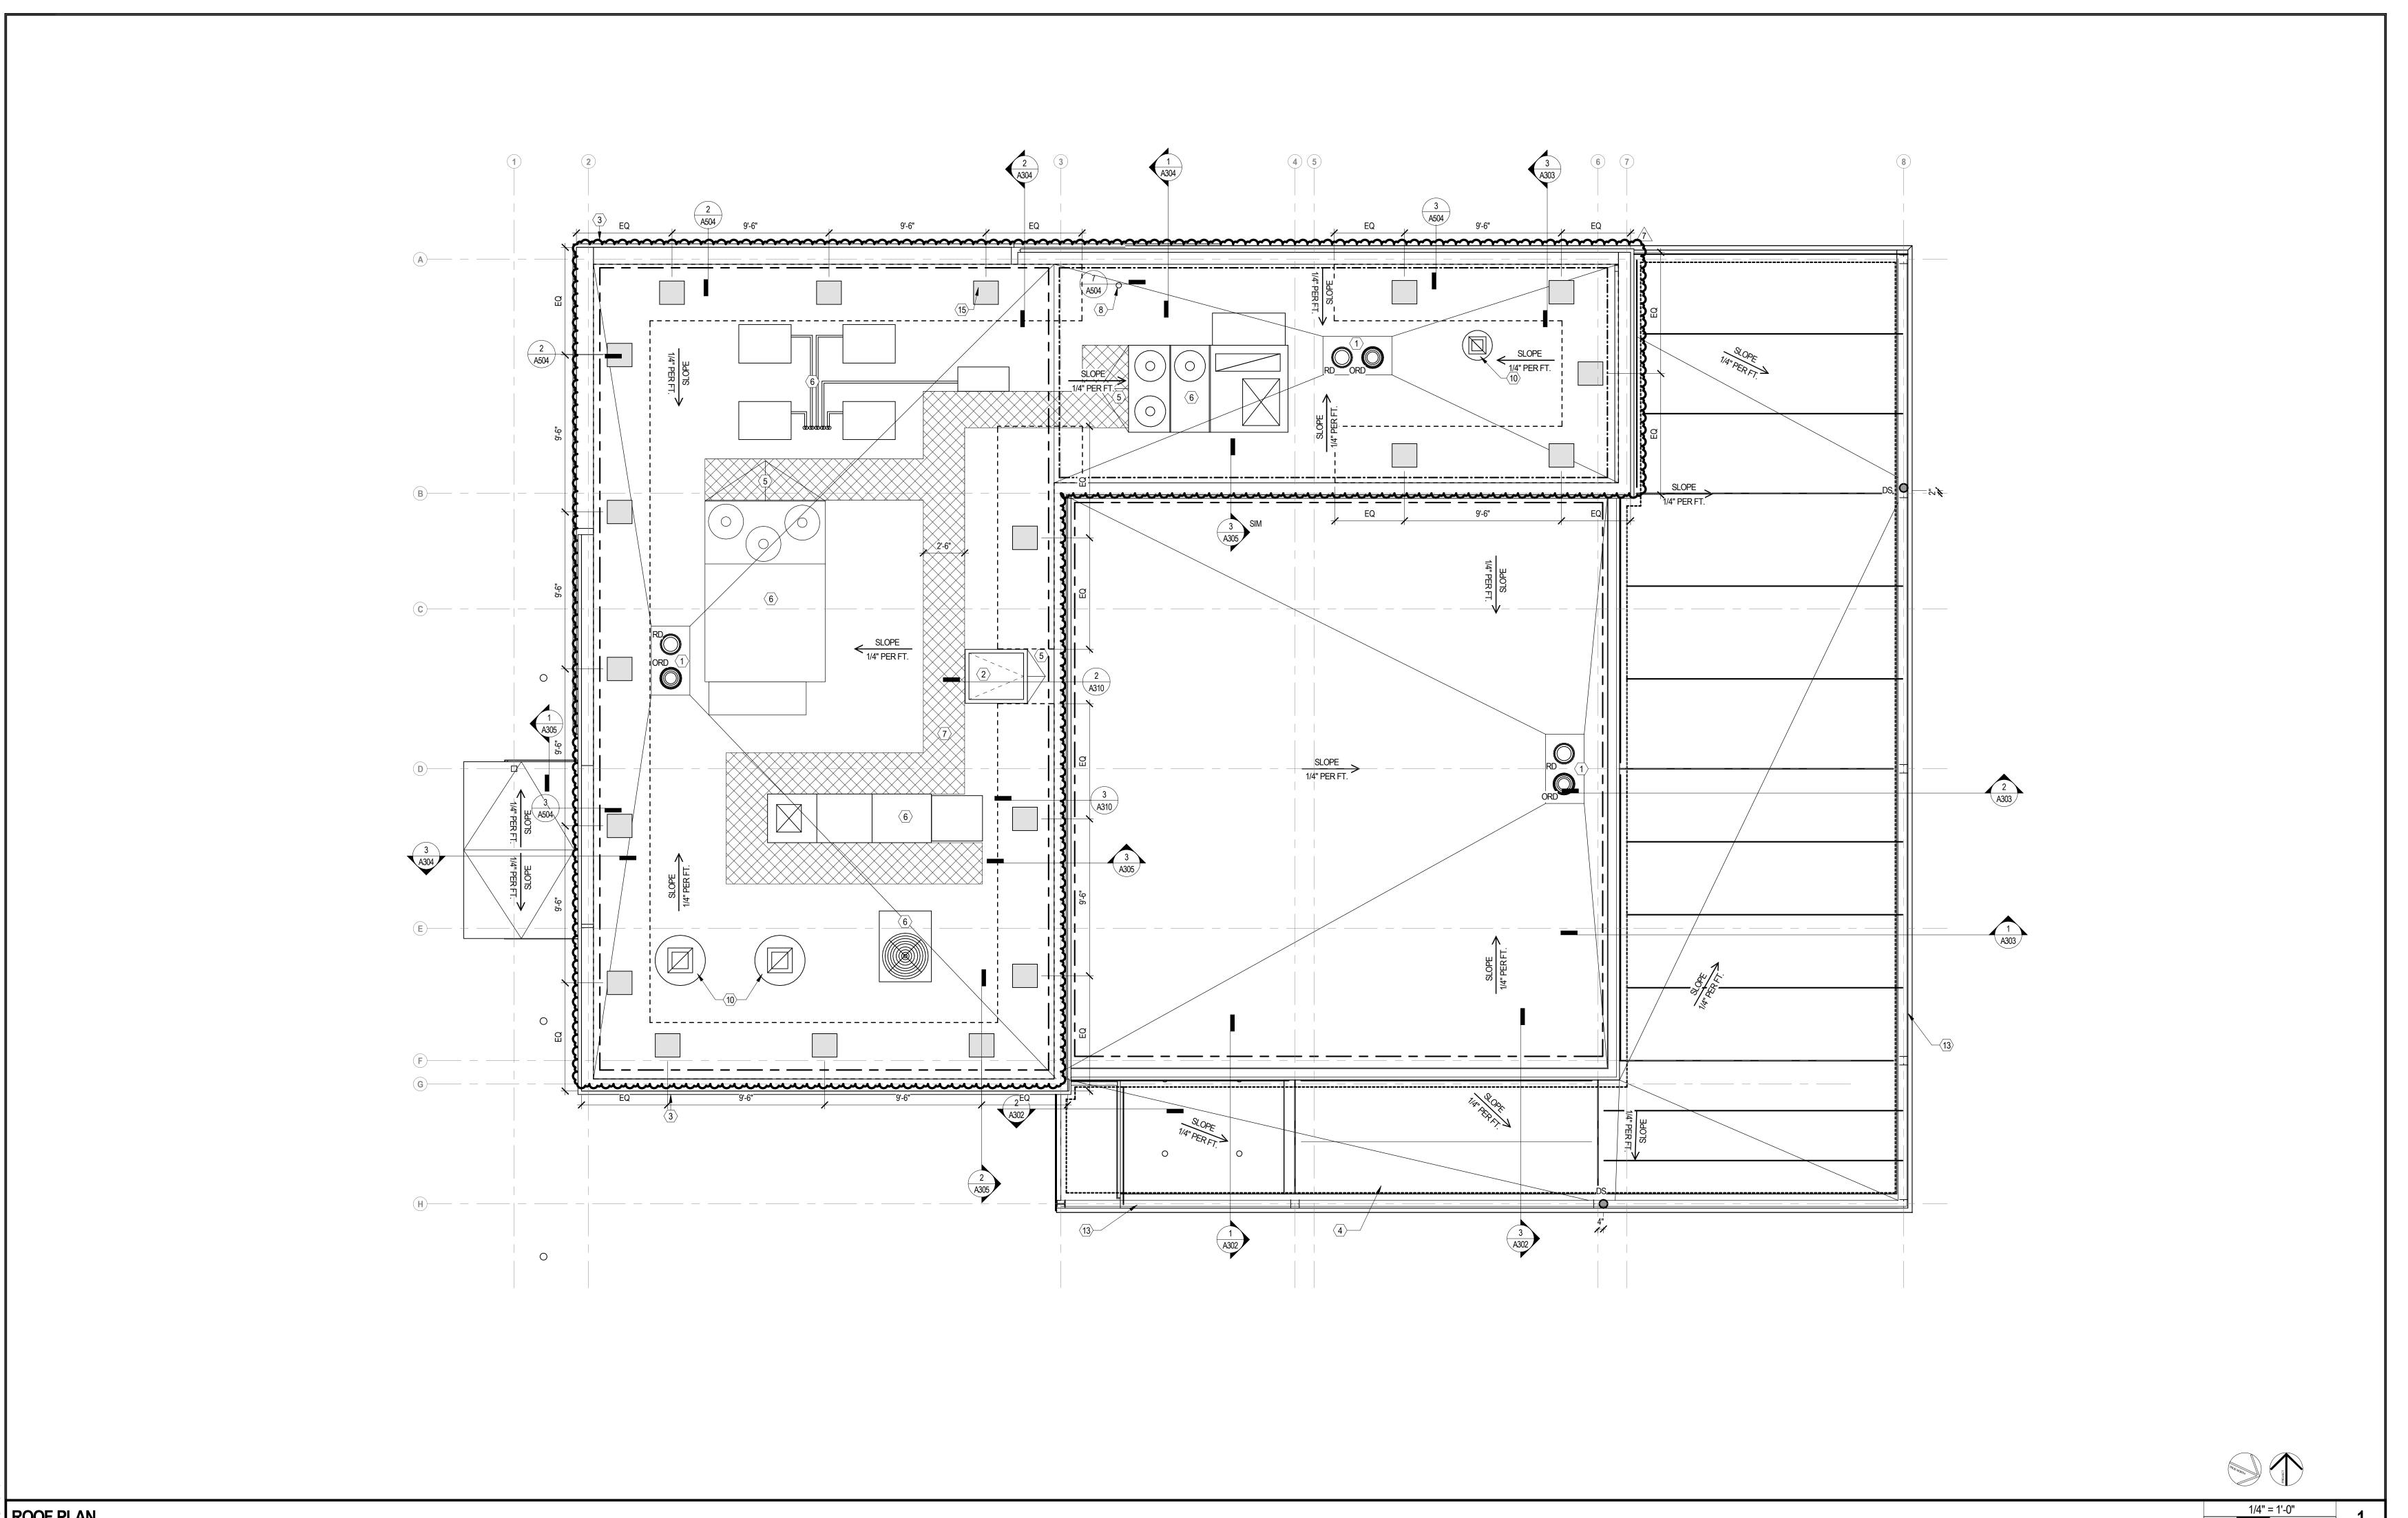

1/4" = 1'-0" ROOF PLAN SYMBOL LEGEND NOT USED **KEY NOTES GENERAL NOTES** ROOF DRAIN AND OVERFLOW DRAIN; REFER TO PLUMBING DRAWINGS WORK SHALL COMPLY WITH FEDERAL, STATE AND LOCAL BUILDING CODES AND REGULATIONS. B. CONFLICTS BETWEEN SITE CONDITIONS AND DRAWINGS SHALL BE BROUGHT TO THE IMMEDIATE ATTENTION LOCKABLE ROOF HATCH; BASIS OF DESIGN: BILCO; TYPE S ROOF HATCH, THERMALLY BROKEN, 36" X30" ROOF STRUCTURE SLOPED FOR OF THE ARCHITECT/DESIGNER. DRAINAGE; REFER TO STRUCTURAL EXTERIOR SIGNAGE BY OWNER'S SIGNAGE CONTRACTOR, FILE SIGNAGE UNDER SEPARATE PERMIT. GC TO PROVIDE POWER AS REQUIRED; COORDINATE WITH OWNER'S VENDOR AND ELECTRICAL DRAWINGS START OF CONSTRUCTION. \_----INDICATES SURFACE WALKING PADS D. COORDINATE BLOCKING REQUIREMENTS AND LOCATIONS WITH ELEVATIONS AND DETAILS. BLOCKING TO BE BUILT UP TAPERED INSULATION STEEL CANOPY WITH ROOF; REFER TO STRUCTURAL DRAWINGS FOR STEEL SIZES; PAINT ALL EXPOSED FIRE TREATED. SLOPED FOR DRAINAGE TO ROOF E. DIMENSIONS ARE TO BE TO FINISHED FACE OF WALL, UNO. APPLIED MATERIALS ARE TO BE APPLIED AFTER THE FINISH DIMENSIONS HAVE BEEN CONFIRMED. LEASE LINE \_\_\_\_\_ ROOF CRICKET, TAPER INSULATION TO CREATE 1/4" PER 12" SLOPE, PROVIDE CRICKET AT ALL ROOF DRAWINGS ARE NOT TO BE SCALED. VERIFY ANY MISSING OR CONFLICTING WRITTEN DIMENSIONS WITH THE BUILT UP TAPERED INSULATION SLOPED EQUIPMENT AS REQUIRED; ARCHITECT/DESIGNER PRIOR TO CONSTRUCTION. FOR DRAINAGE TO GUTTERS 6. NOTIFY ARCHITECT OF CONDITIONS WHERE CLEAR OR CRITICAL DIMENSIONS ARE DESIGNATED BUT CANNOT OVERFLOW ROOF DRAIN ROOF EQUIPMENT; REFER TO MECHANICAL DRAWINGS BE MET OR WHERE CORRIDOR/ AISLE WIDTH CANNOT MEET THE MINIMUM REQUIREMENT. H. PROVIDE POWER AND DATA WHERE NEEDED TO ACCOMMODATE RELOCATION OF EQUIPMENT ROOF WALKWAY PAD, SHOWN SCHEMATICALLY FOR BID PURPOSE. INSTALL AS REQUIRED TO PROVIDE CONTRACTOR SHALL MAINTAIN BUILDING MECHANICAL CODE REQUIREMENTS FOR VENTILATION ROOF DRAIN CONTINUOUS PATH TO SERVICE SIDE OF ALL EQUIPMENT THROUGHOUT CONSTRUCTION WHILE MAINTAINING AIR DIFFUSERS, REGISTERS, GRILLES, DUCTWORK AND VENT THROUGH ROOF; REFER TO PLUMBING DRAWINGS EQUIPMENT FREE OF DEBRIS, DUST, CONTAMINATION, AND DAMAGE. CONTRACTOR IS RESPONSIBLE FOR ALL CRICKET (5) PREVENTATIVE MAINTENANCE OF HVAC SYSTEM AND SHALL BE TURNED OVER TO OWNER IN NEW CONDITION AIR INTAKE FOR MANAGER'S OFFICE; REFER TO MECHANICAL DRAWINGS AT THE END OF WORK. DOCUMENT ALL REQUIRED WORK AND INCLUDE MATERIAL AND LABOR COSTS IN BID. CONTRACTOR TO VERIFY THE LOCATIONS OF ALL ROOF DRAINS, ROOF PENETRATIONS AND OTHER ROOF EXHAUST FAN; REFER TO MECHANICAL DRAWINGS ELEMENTS NOT SHOWN IN THIS PLAN, INCLUDING BUT NOT LIMITED TO ROOF VENTS, ROOFTOP UNITS, PITCH ELEVATION HEIGHT BOXES, ETC. REFER TO MECHANICAL DRAWINGS TAPERED INSULATION, PITCH TOWARDS ROOF DRAINS, TYP CONTRACTOR TO COORDINATE FINAL LOCATIONS OF PENETRATIONS AND DRAINS W/ ROOF INSTALLER SO THAT THE LOCATION OF THE PENETRATIONS DO NOT JEOPARDIZE THE ROOF WARRANTY. WRAP ROOFING AT THE ENDS OF PARAPET WALLS .. NO PENETRATIONS WITHIN 12" OF PARAPET, UNO. M. ALL SEALANTS AND WATERPROOF MASTICS TO BE COMPATIBLE WITH THE MATERIAL WHICH THEY WILL COME SLOPE > PVC ROOF TROUGH AROUND ROOF PERIMETER INDICATES DIRECTION OF SLOPE IN CONTACT WITH CAUSING NO DELETERIOUS EFFECTS. 4> PROVIDE TAPERED RIGID INSULATION 1/4" PER FOOT TO DOWNSPOUT LOCATION, TYP N. REFER TO ELECTRICAL DRAWINGS FOR EXTERIOR LIGHTING O. NEW CURBS FOR MECHANICAL UNITS ARE TO BE INSTALLED PER ROOFING MANUFACTURER'S REQUIREMENTS ROOF MOUNTED ATTIC VENTILATOR; MOUNT EVERY +/- 8'-0" ALONG HIGH PARAPET WALL

CONSTRUCTION
AS NOTED ON PLANS REVIEW
DEVELOPMENT SERVICES
LEE'S SUMMIT. MISSOURI CONSULTANTS: SEAL/ SIGNATURE:

2021-09-09 FIELD NOTICE #4 2021-04-26 ISSUED FOR CONSTRUCTION 2021-03-31 ADDENDUM 2 2021-01-11 PERMIT/BID SET 2020-12-21 75% SET

SHAKE SHACK - LEE'S SUMMIT MO

2051 NW LOWENSTEIN DRIVE LEE'S SUMMIT, MISSOURI 64081 SHACK #1348


FIELD NOTICE #3


ROOF PLAN

DRAWN BY: CS & WQL CHECKED BY: JOB NO: 20068.00


TO COMPLY WITH AND MAINTAIN ROOF WARRANTY

P. ALL TARGET ELEVATIONS ARE TAKEN FROM PROJECT FINISH FLOOR HEIGHT, 0'-0"

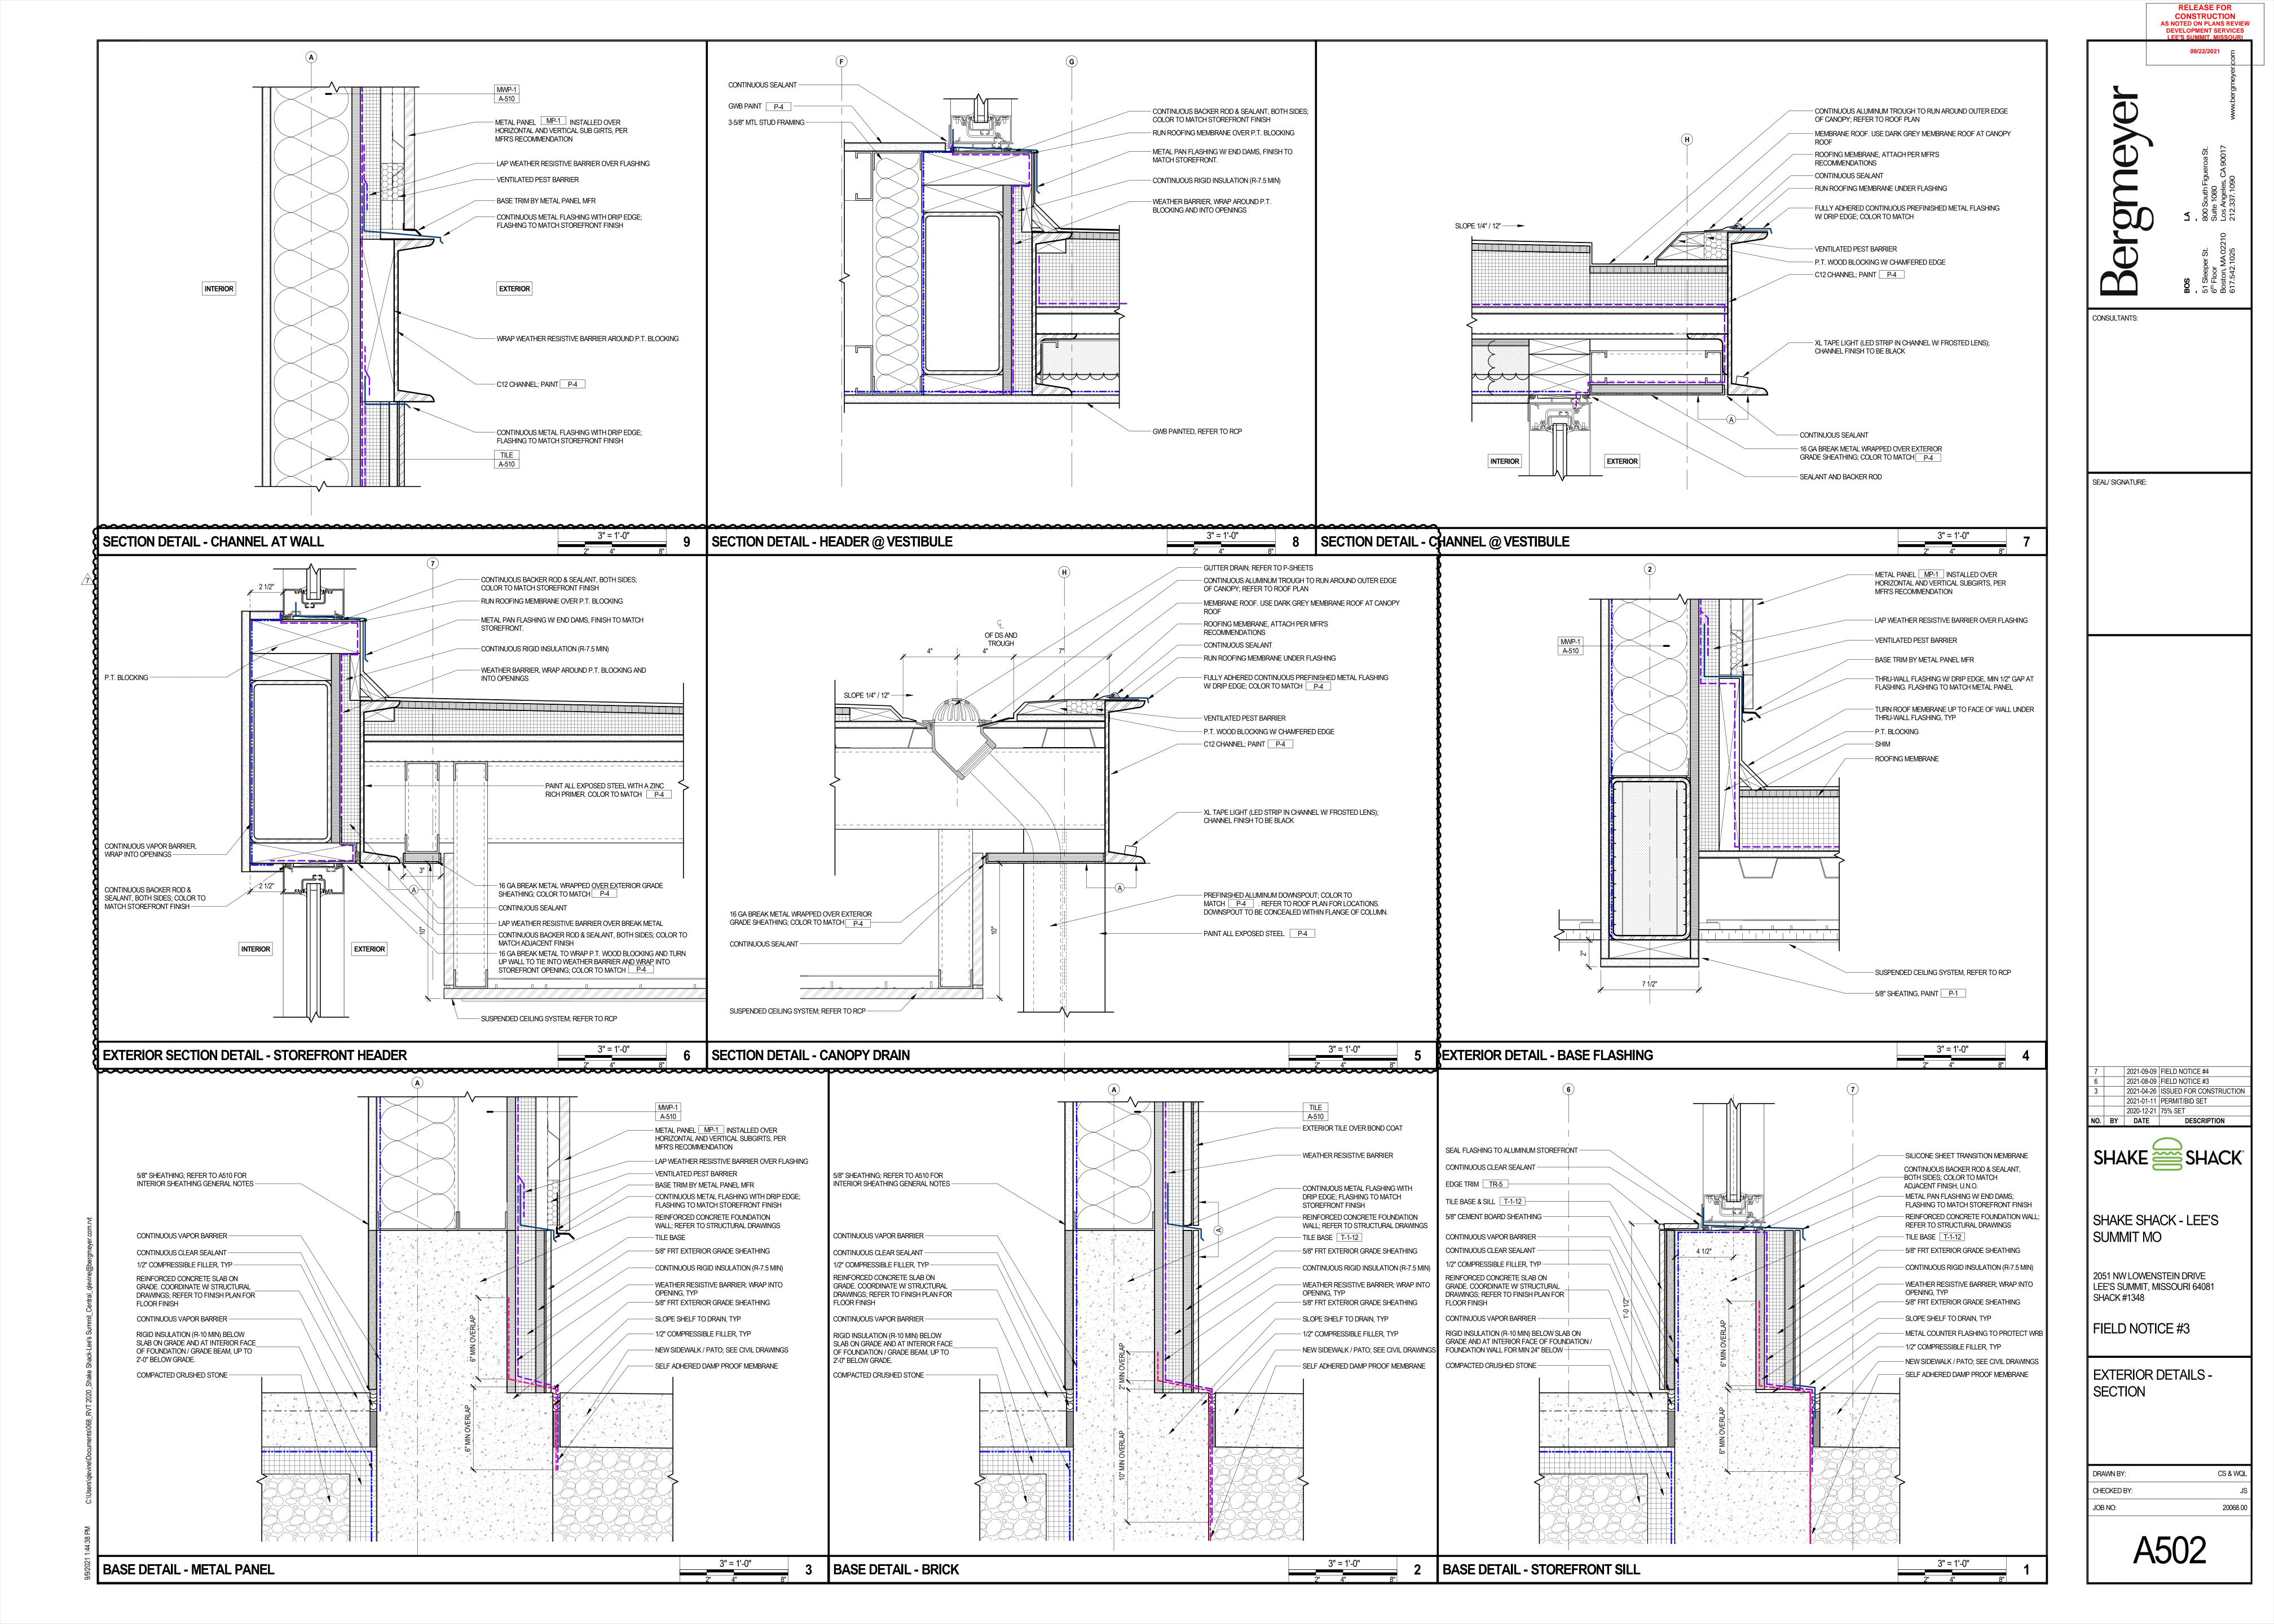


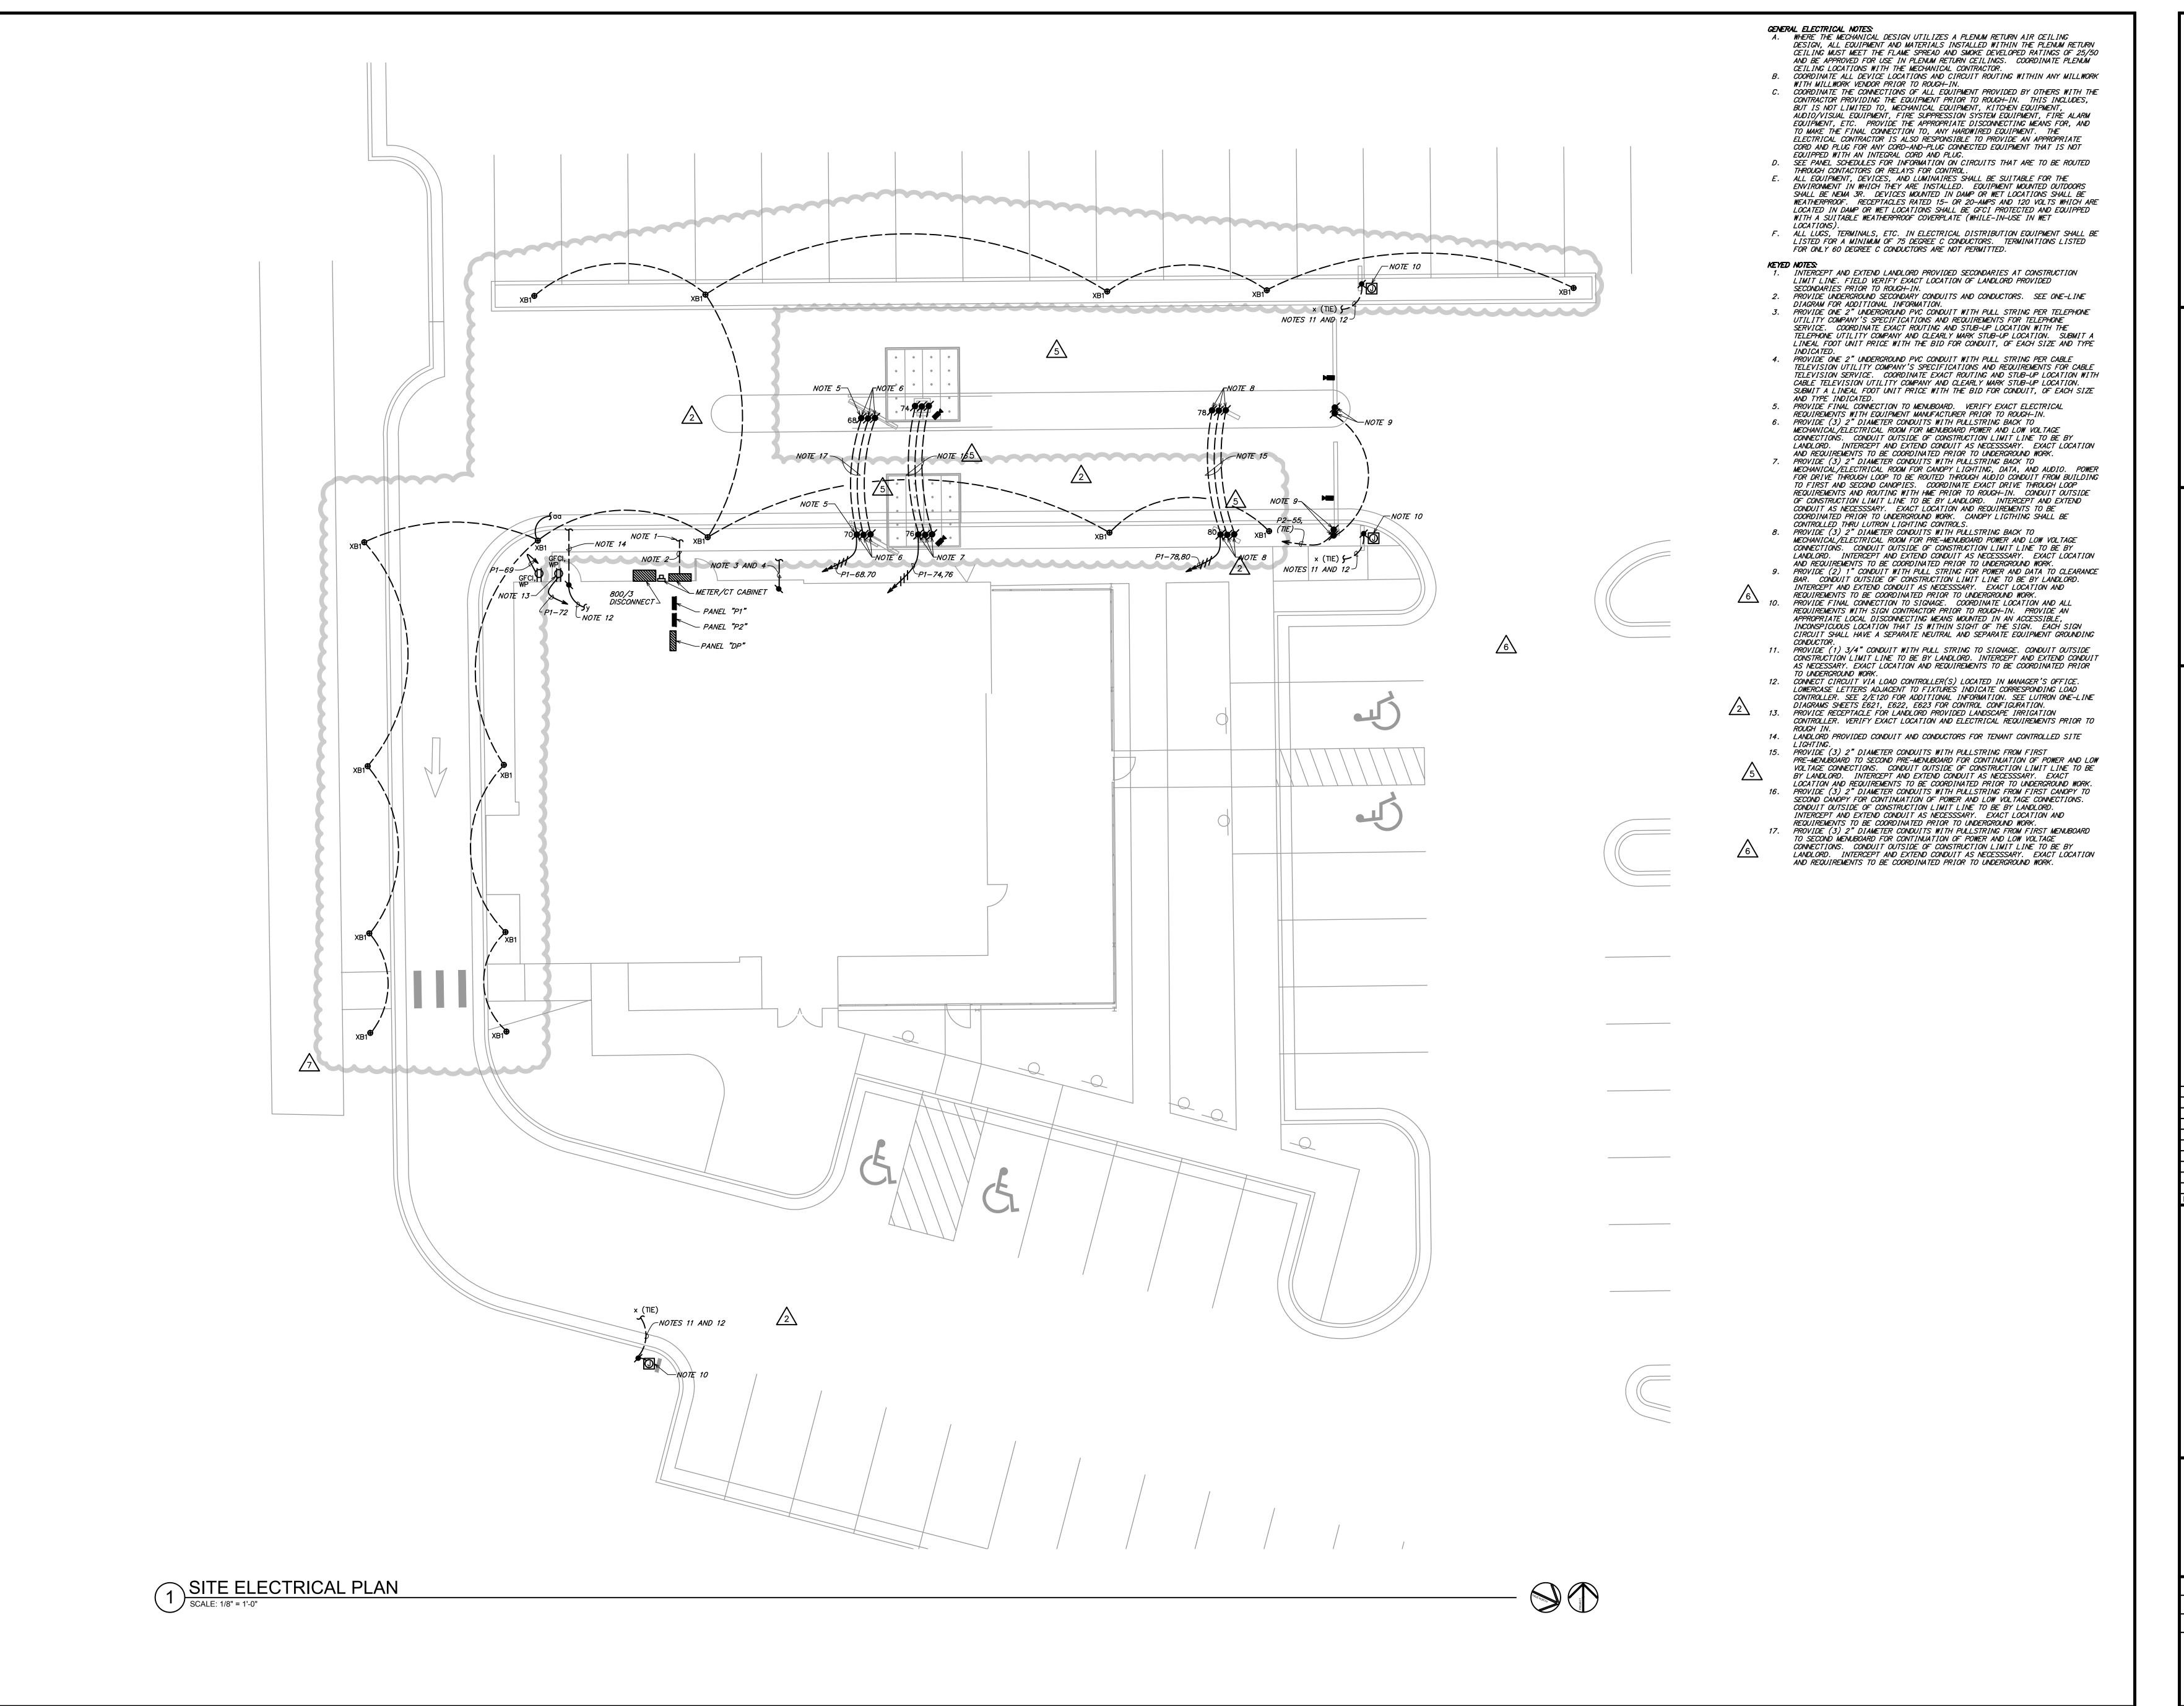

RELEASE FOR CONSTRUCTION AS NOTED ON PLANS REVIEW DEVELOPMENT SERVICES
LEE'S SUMMIT, MISSOURI

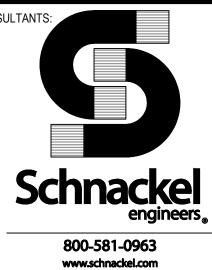

SE JOB#: 200383 SEAL/ SIGNATURE:

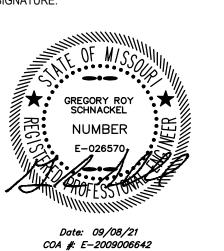


7 2021-09-09 FIELD NOTICE #4 6 2021-08-09 FIELD NOTICE #3 5 2021-05-17 FIELD NOTICE #2 4 2021-05-03 FIELD NOTICE #1 3 2021-04-26 ISSUED FOR CONSTRUCTION
2 2021-03-31 ADDENDUM #2
1 2021-03-09 ADDENDUM #1
2021-01-11 PERMIT/BID SET 2020-12-21 75% SET 
 NO.
 BY
 DATE
 DESCRIPTION

SHAKE SHACK - LEE'S SUMMIT MO

LEE'S SUMMIT MISSOURI SHACK #1348

PERMIT/BID SET

SITE ELECTRICAL PLAN

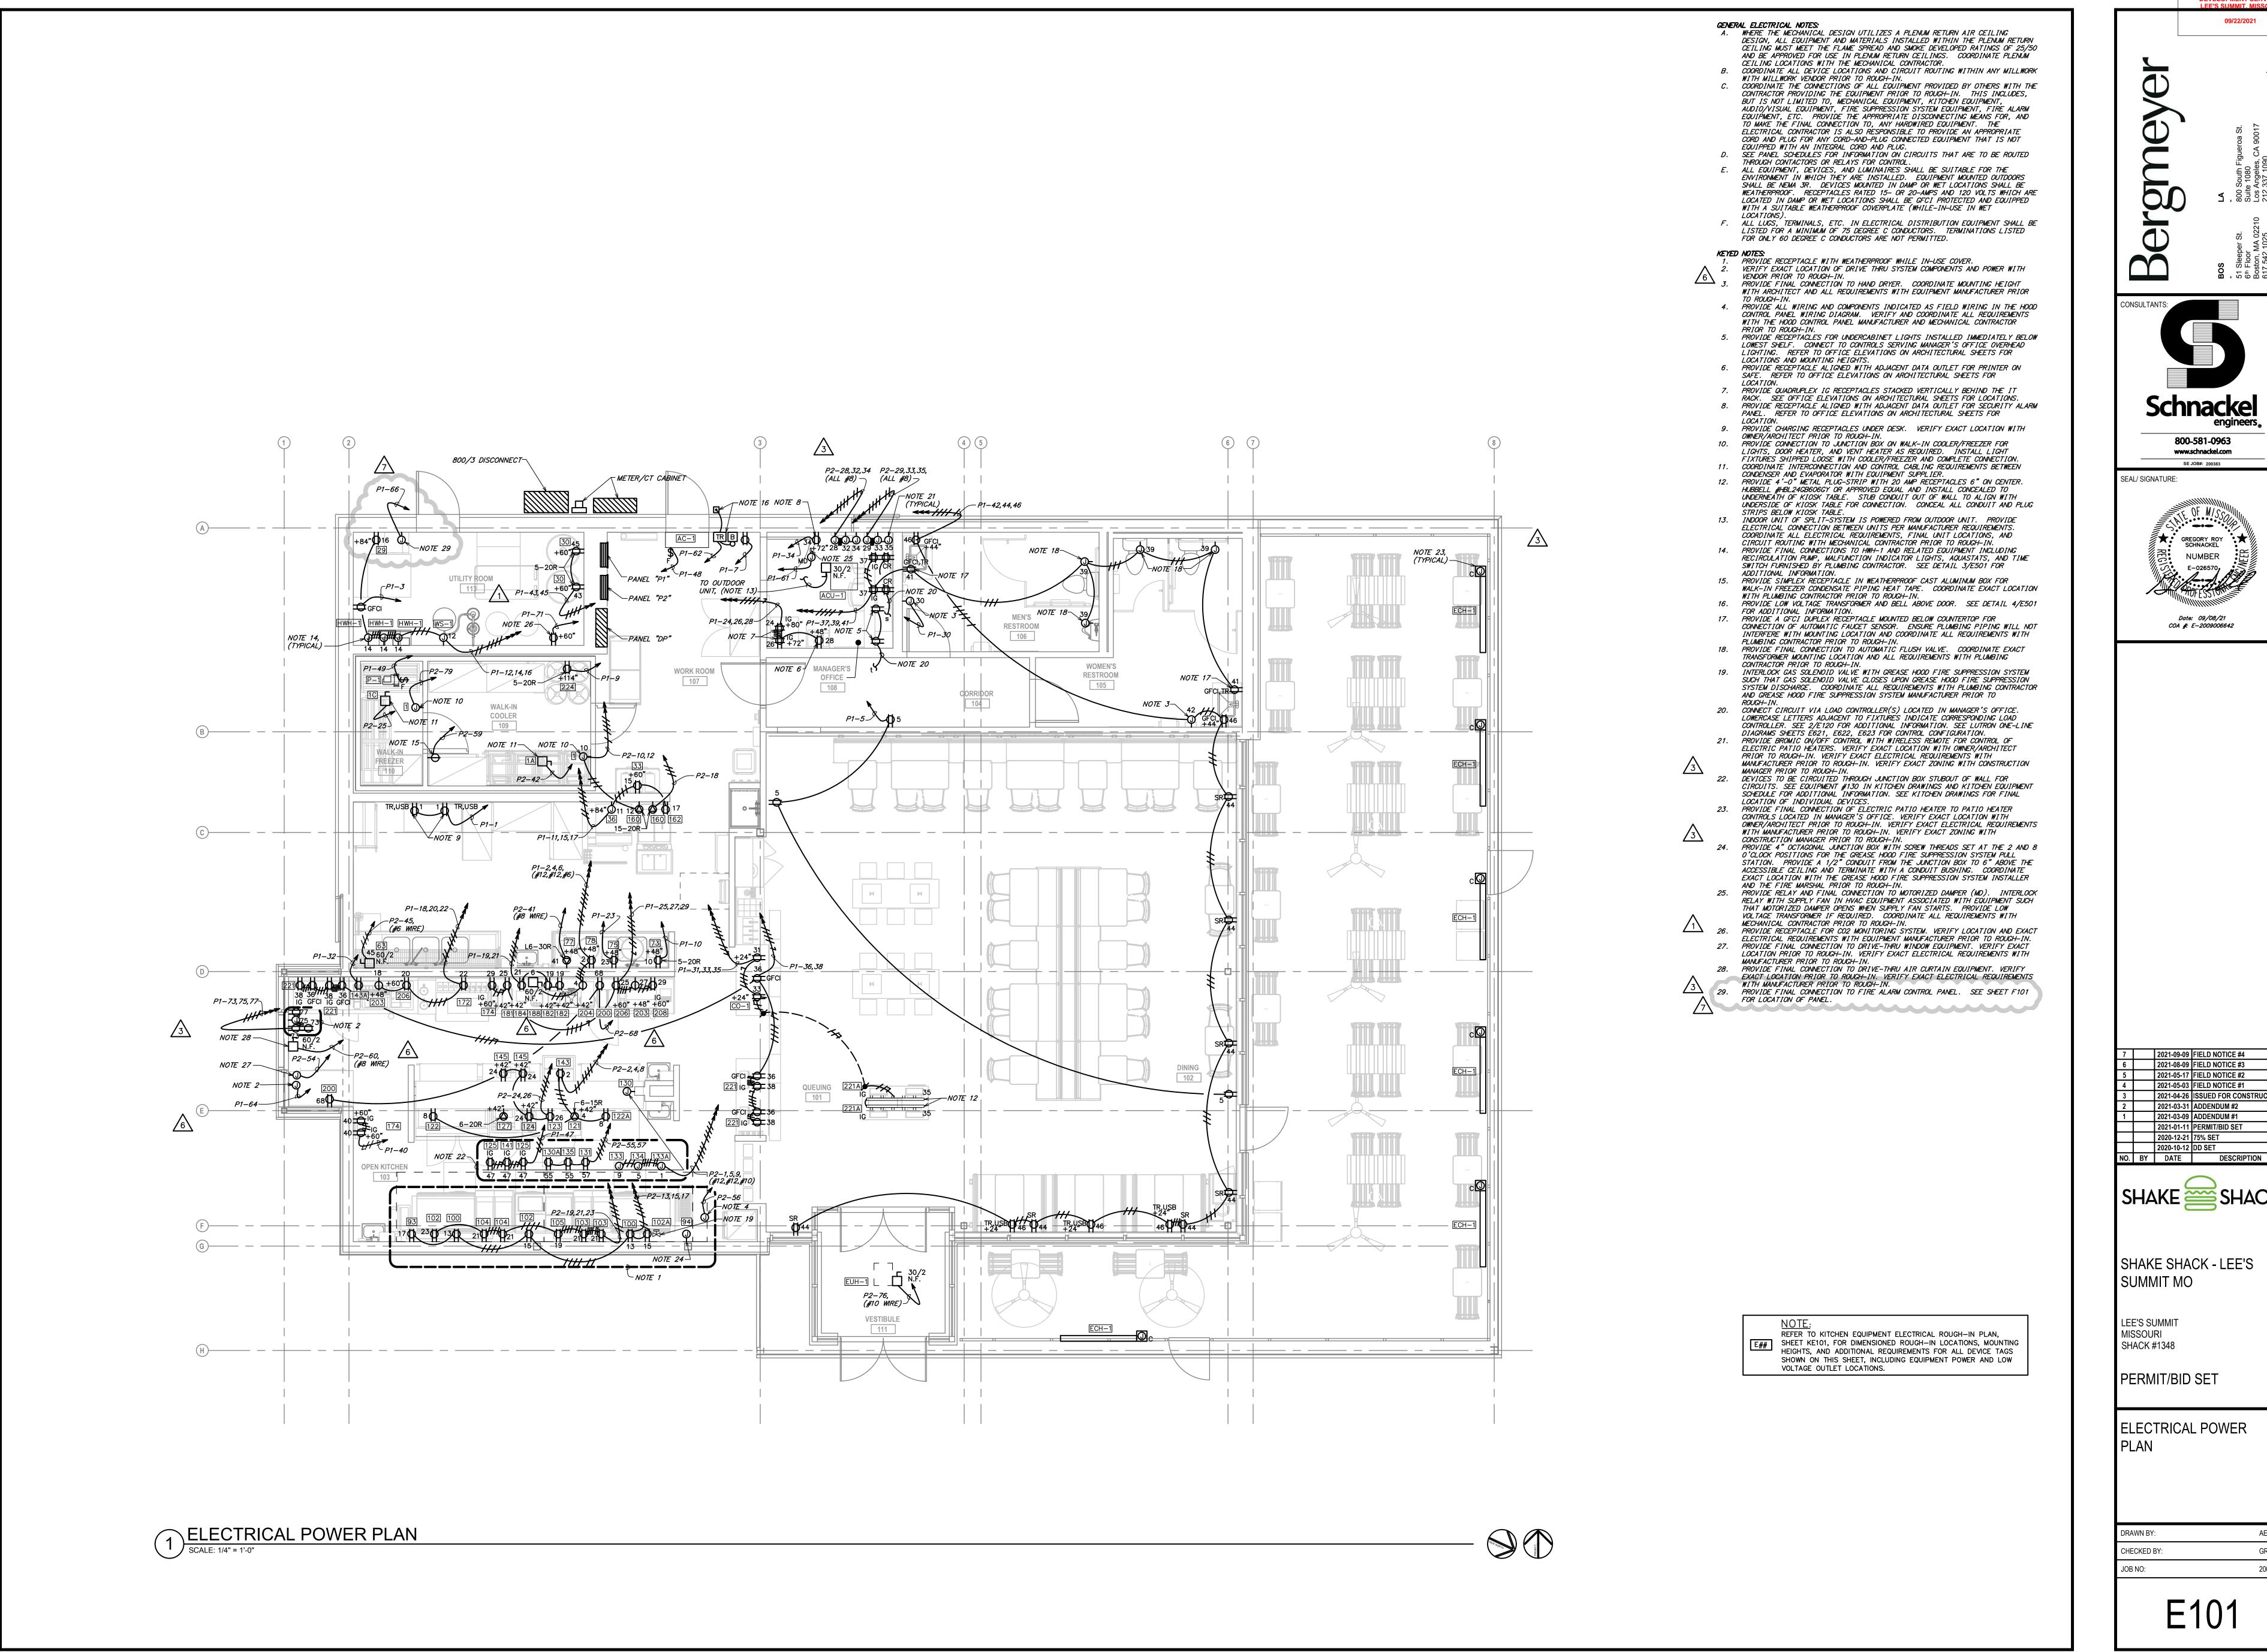


**RELEASE FOR** CONSTRUCTION AS NOTED ON PLANS REVIEW DEVELOPMENT SERVICES
LEE'S SUMMIT. MISSOURI

**Schnackel** 800-581-0963

www.schnackel.com

SE JOB#: 200383 SEAL/ SIGNATURE:

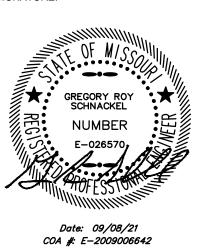


7 2021-09-09 FIELD NOTICE #4 6 2021-08-09 FIELD NOTICE #3 5 2021-05-17 FIELD NOTICE #2 4 2021-05-03 FIELD NOTICE #1 3 2021-04-26 ISSUED FOR CONSTRUCTION 2 2021-03-31 ADDENDUM #2 1 2021-03-09 ADDENDUM #1 2021-01-11 PERMIT/BID SET 2020-12-21 75% SET 2020-10-12 DD SET

SHAKE SHACK - LEE'S SUMMIT MO

LEE'S SUMMIT MISSOURI SHACK #1348

PERMIT/BID SET


ELECTRICAL POWER

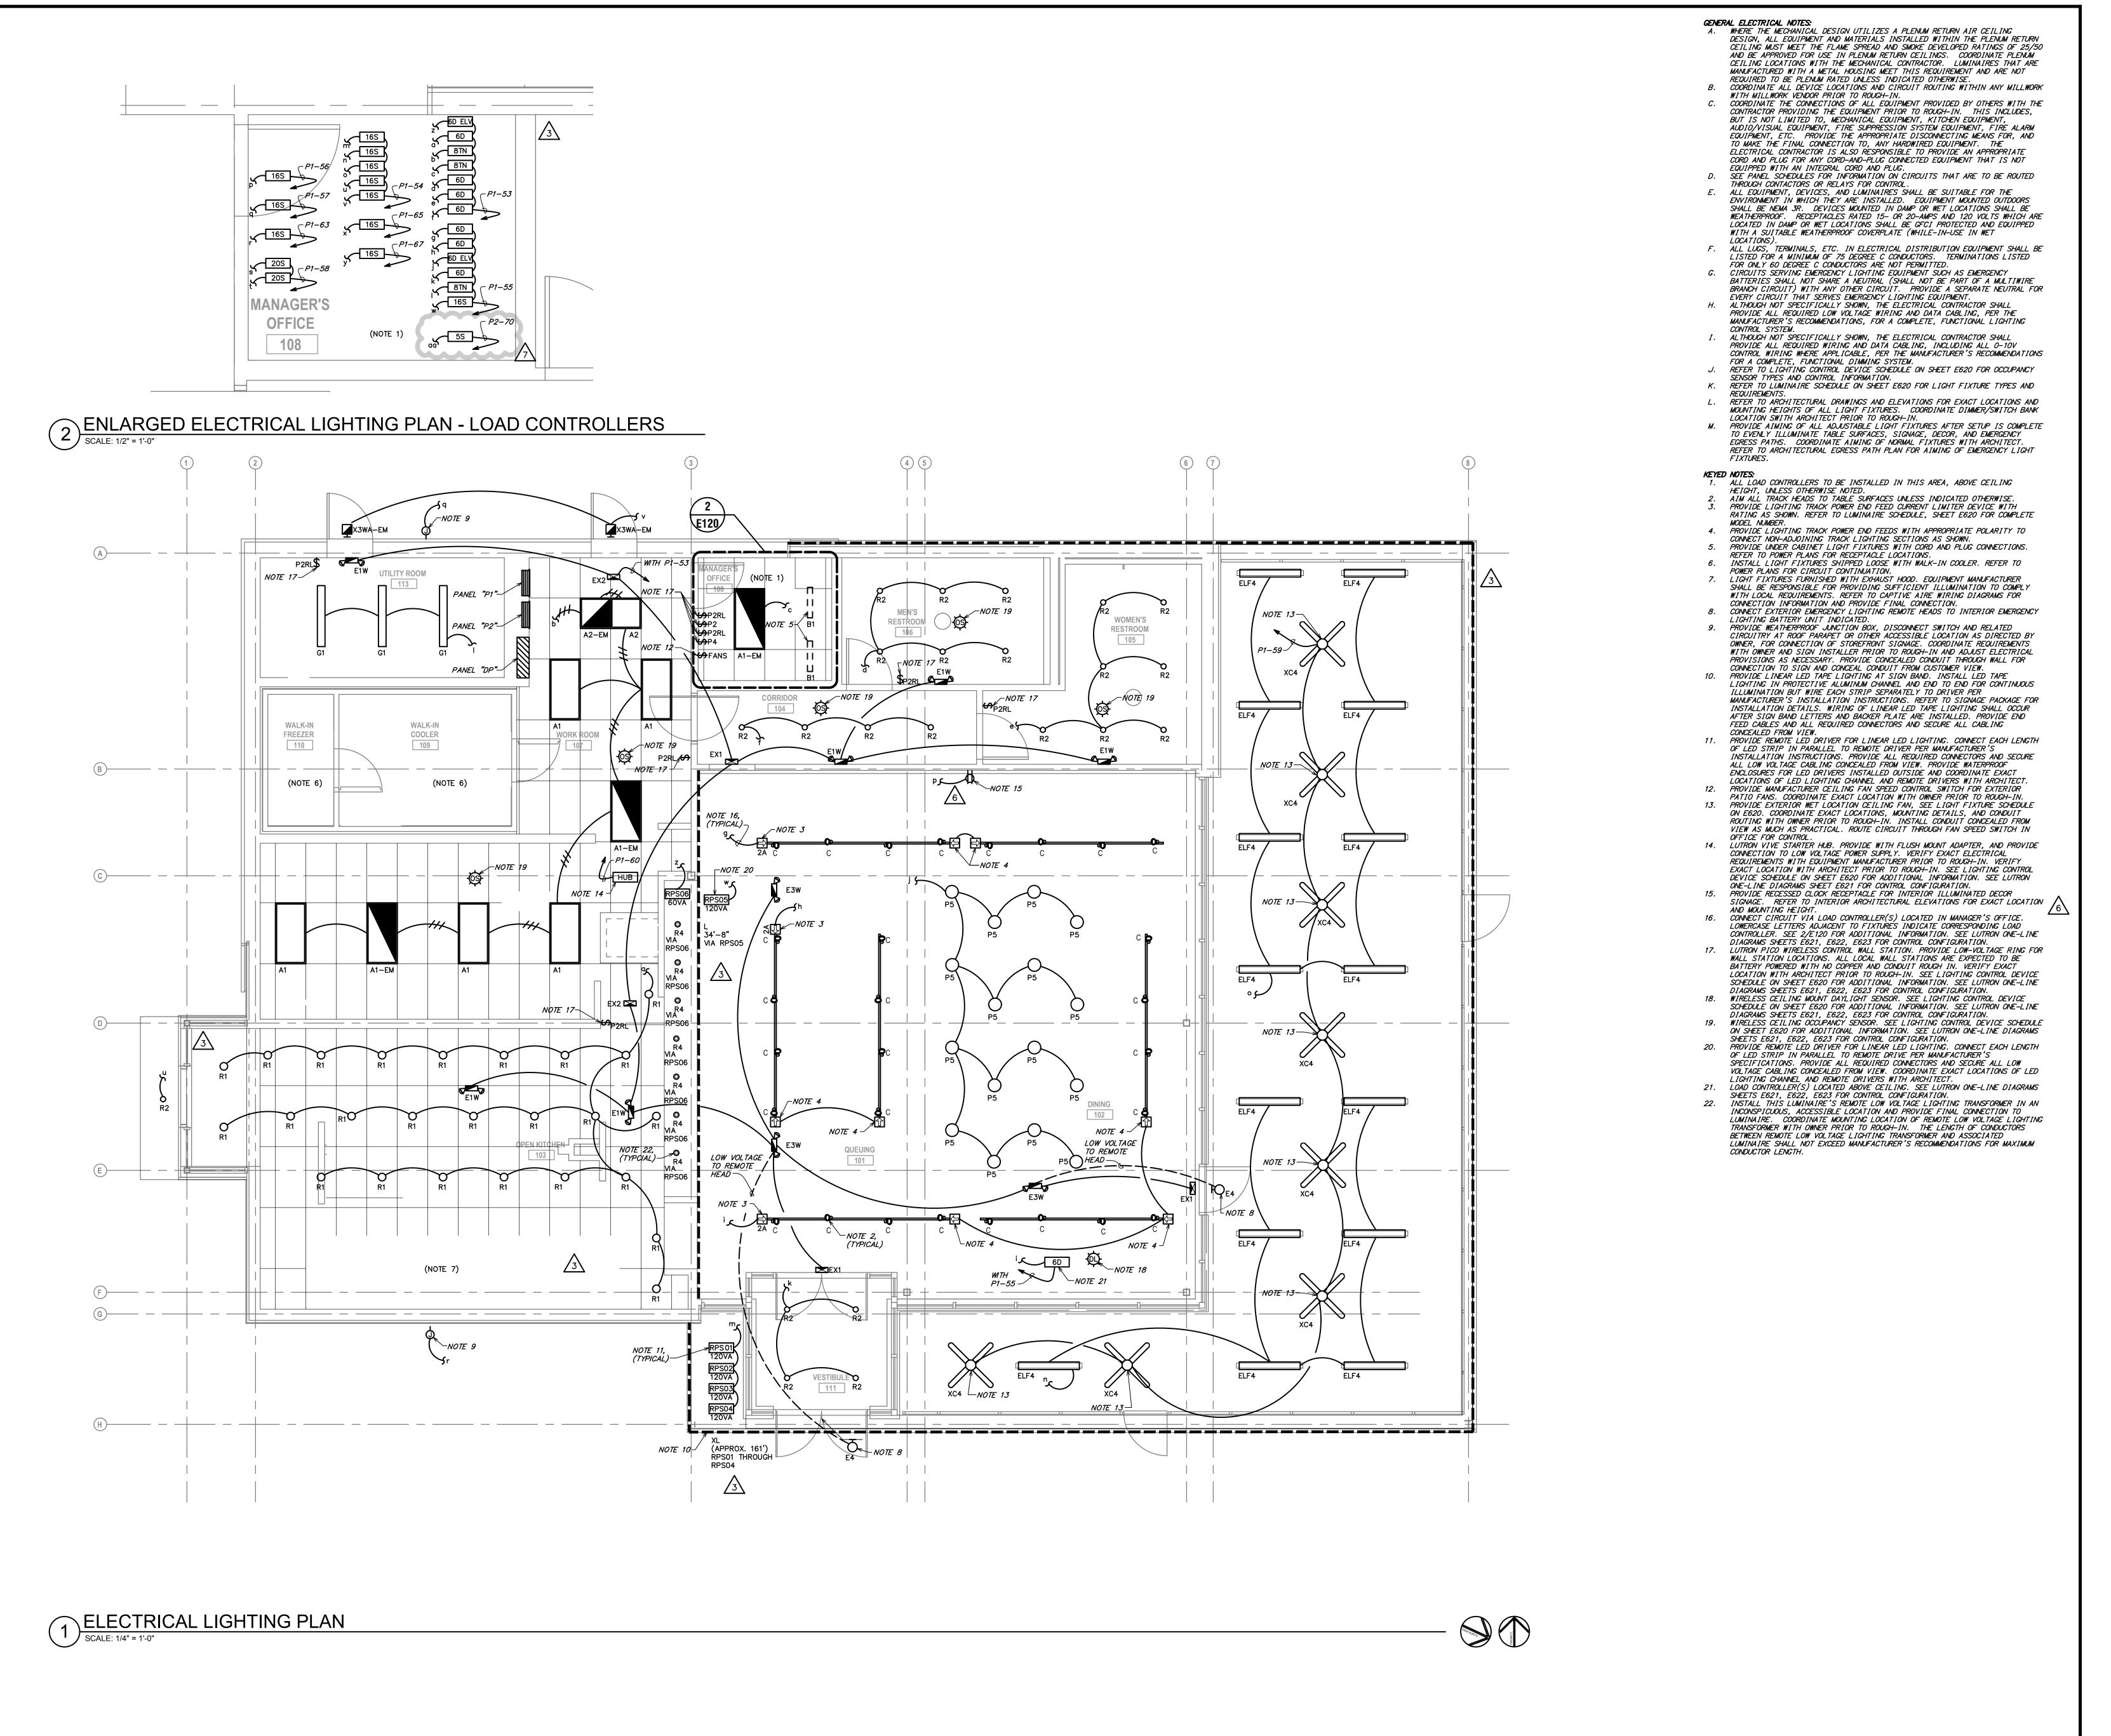


RELEASE FOR
CONSTRUCTION
AS NOTED ON PLANS REVIEW
DEVELOPMENT SERVICES
LEE'S SUMMIT, MISSOURI

ergmeyer

Bos LA 51 Sleeper St. 800 S

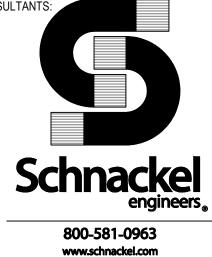

SE JOB#: 200383
SEAL/ SIGNATURE:

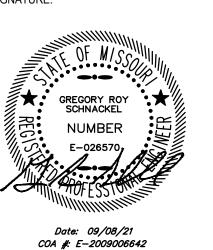

7 2021-09-09 FIELD NOTICE #4
6 2021-08-09 FIELD NOTICE #3
5 2021-05-17 FIELD NOTICE #2
4 2021-05-03 FIELD NOTICE #1
3 2021-04-26 ISSUED FOR CONSTRUCTION
2 2021-03-31 ADDENDUM #2
1 2021-03-09 ADDENDUM #1
2021-01-11 PERMIT/BID SET
2020-12-21 75% SET
2020-10-12 DD SET

IAKE SHA

NO. BY DATE DESCRIPTION


SHAKE SHACK - LEE'S SUMMIT MO

LEE'S SUMMIT MISSOURI SHACK #1348

PERMIT/BID SET

ELECTRICAL LIGHTING

DRAWN BY:

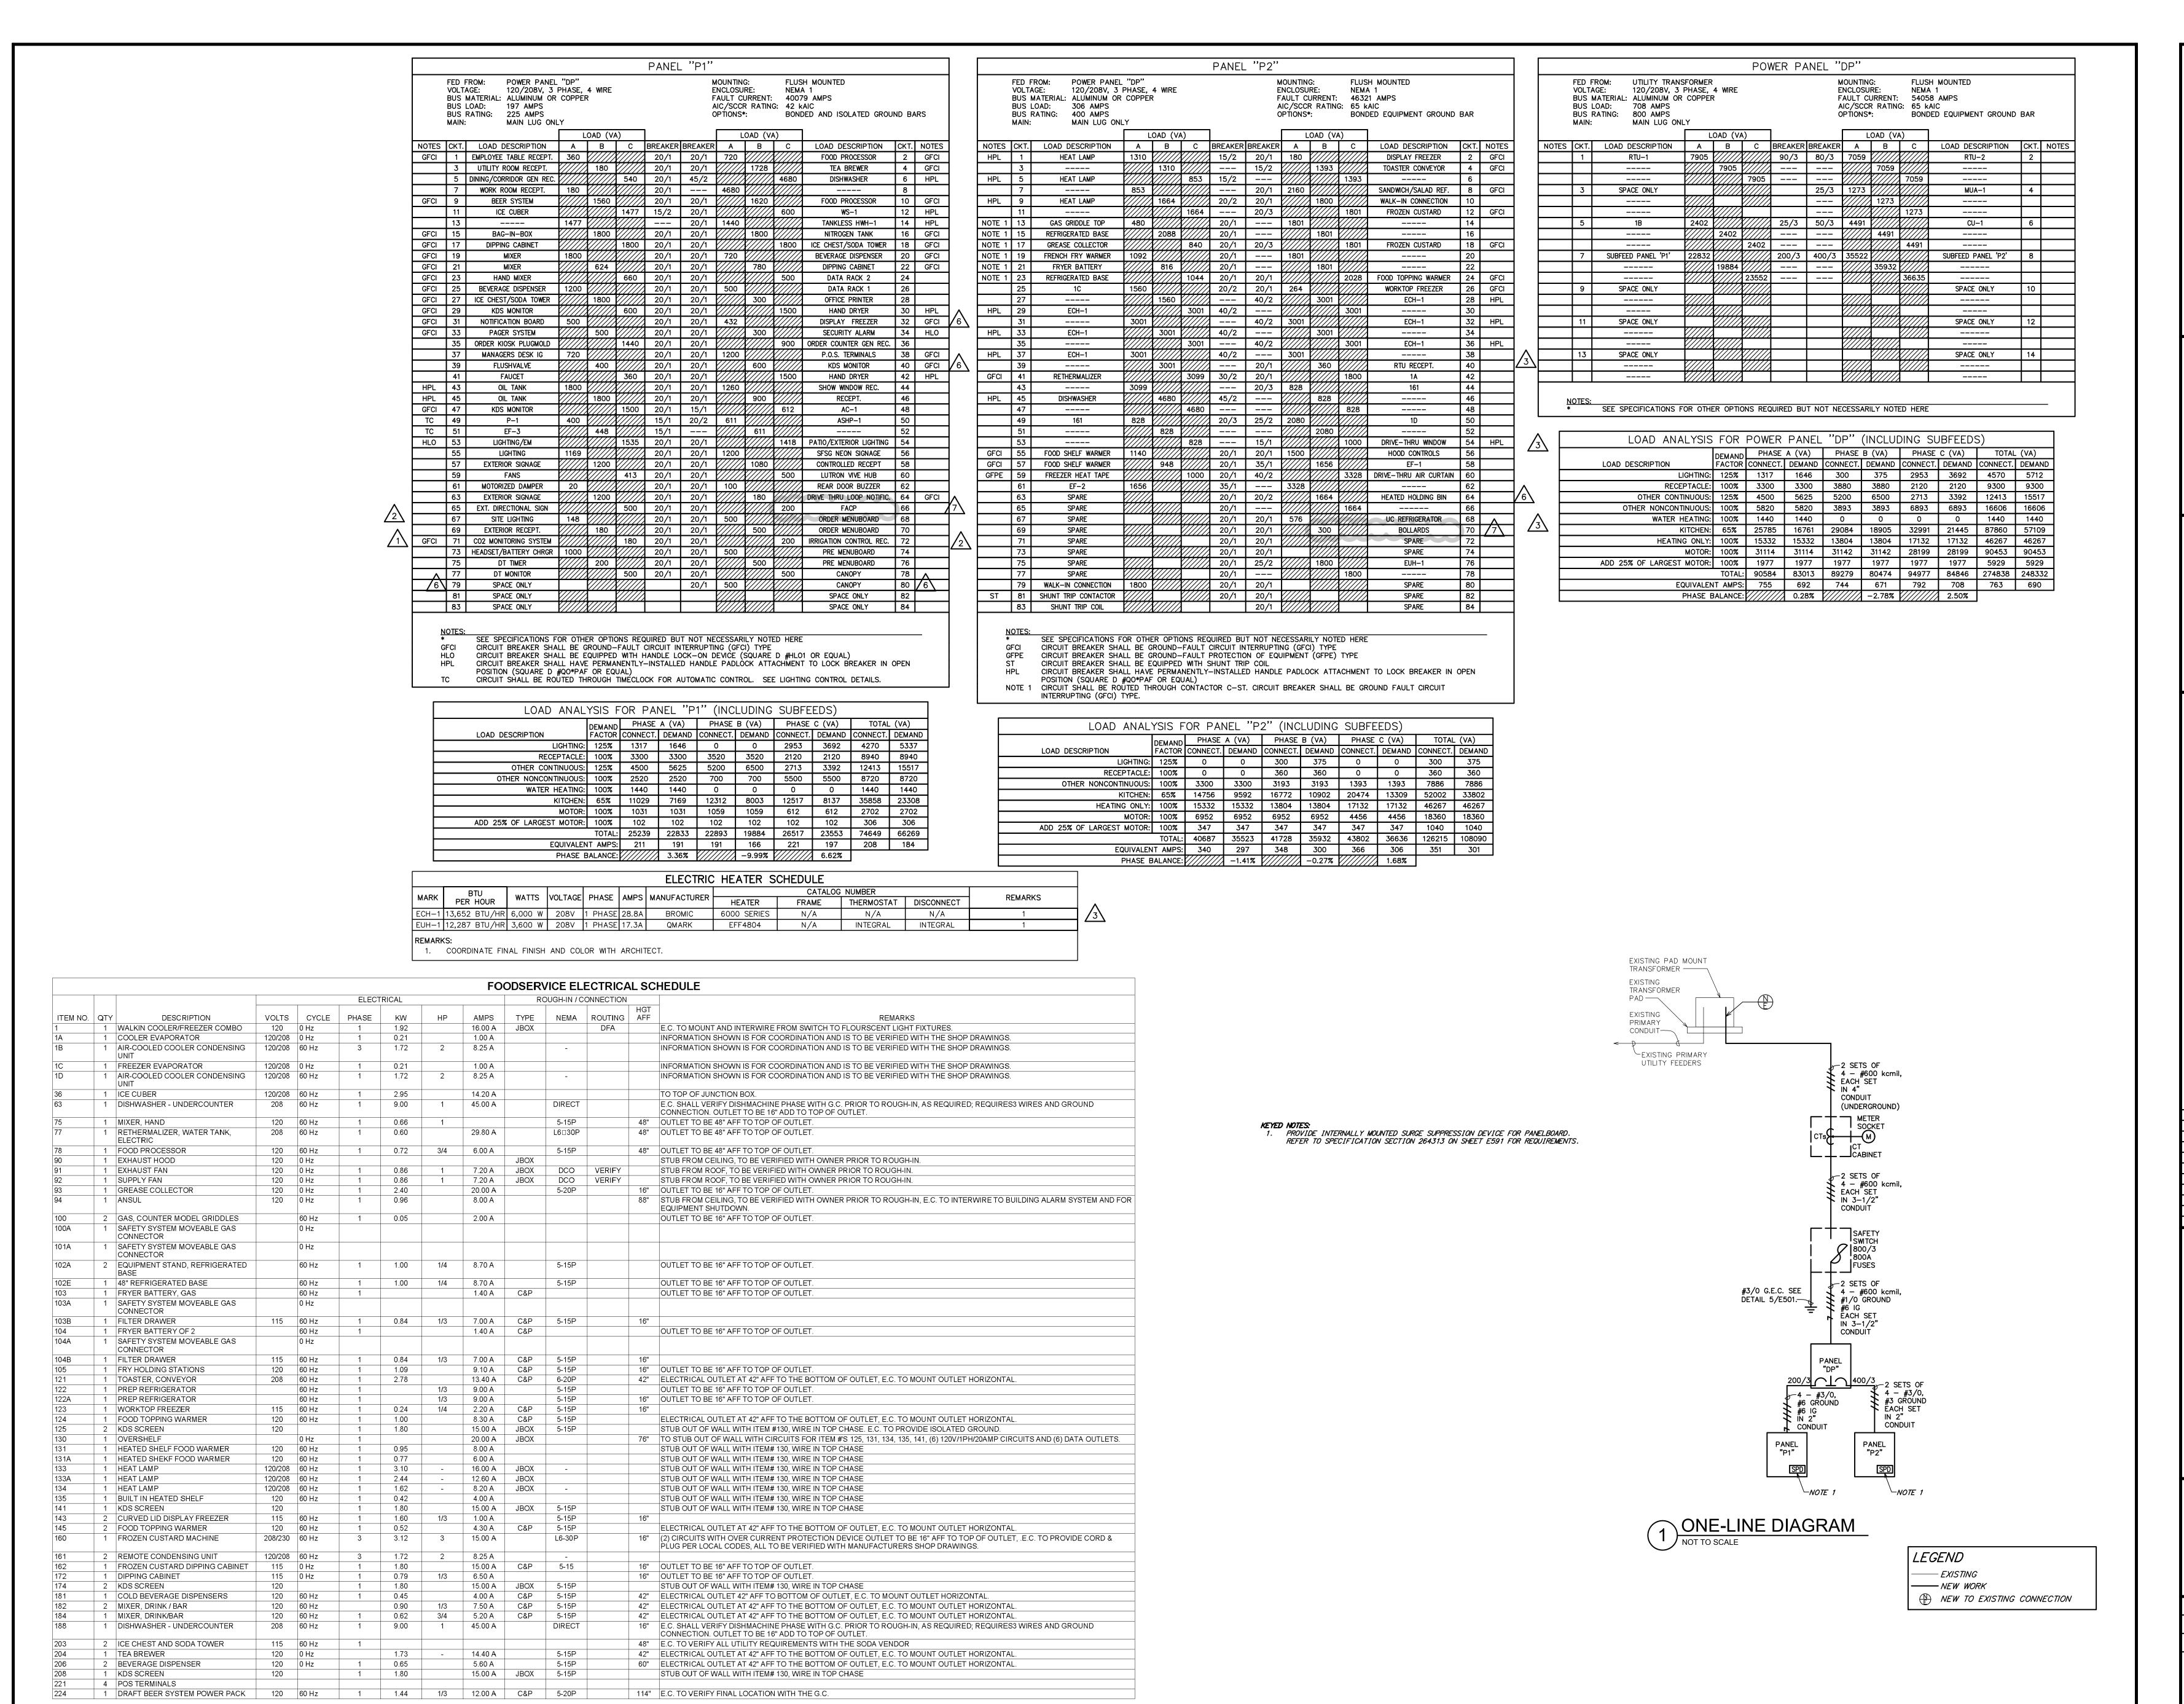

RELEASE FOR
CONSTRUCTION
AS NOTED ON PLANS REVIEW
DEVELOPMENT SERVICES
LEE'S SUMMIT, MISSOURI

09/22/2021


Sergmeyer

Schnackel engineers.

800-581-0963

www.schnackel.com

SEJOB#: 200383

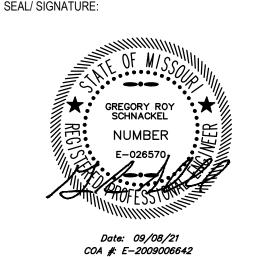

7 2021-09-09 FIELD NOTICE #4
6 2021-08-09 FIELD NOTICE #3
5 2021-05-17 FIELD NOTICE #2
4 2021-05-03 FIELD NOTICE #1
3 2021-04-26 ISSUED FOR CONSTRUCTION
2 2021-03-31 ADDENDUM #2
1 2021-03-09 ADDENDUM #1
2021-01-11 PERMIT/BID SET
2020-12-21 75% SET
2020-10-12 DD SET
NO. BY DATE DESCRIPTION

SHAKE SHACK - LEE'S SUMMIT MO

LEE'S SUMMIT MISSOURI SHACK #1348

PERMIT/BID SET

ELECTRICAL SCHEDULES AND ONE-LINE

DRAWN BY: A
CHECKED BY: G

E601

JOB NO:

20068.00

MARK HUB	CATALOG NUMBER  HJS-O-FM	QUANTITY 1
	HJS-O-FM	1
		<b>'</b>
P2	PJ2-2B-GWH-L01	1
P2RL	PJ2-2BRL-GWH-L01	7
P4	PJ2-4B-GWH-EL2	1
DL	LRF2-DCRB-WH	1
OS	LRF2-OCR2B-P-WH	5

MARK	CATALOG NUMBER	QUANTITY
6D	MRF2S-6ND-120-GR	7
6D ELV	MRF2S-6ELV-120-GR	2
16S	RMJS-16R-DV-B	11
20S	RMJS-20R-DV-B	2
8TN	RMJS-8TN-DV-B	3
5S	RMJS-5R-DV-B	1
GENERAL NOTES:		•
Α.	SEE LUTRON ONE-LINE DIAGRAMS SHEETS E621, E622, E623 FOR ADDITIONAL INFORMATION.	
	6D 6D ELV 16S 20S 8TN 5S GENERAL NOTES:	6D MRF2S-6ND-120-GR 6D ELV MRF2S-6ELV-120-GR 16S RMJS-16R-DV-B 20S RMJS-20R-DV-B 8TN RMJS-8TN-DV-B 5S RMJS-5R-DV-B  GENERAL NOTES:  SEE LUTRON ONE-LINE DIAGRAMS SHEETS E621, E622, E623 FOR

		<u>,                                      </u>	• ,	LUM	NAIRE SCHEDUL	1		· ·		
MARK	MANUFACTURER	CATALOG NUMBER	VOLTAGE	WATTS	MOUNTING	LAMP QUANTITY	LAMP DESCRIPTION	LAMP TYPE	SELECTED BY OTHERS?	REMARKS
A1	TOPAZ	F-L24-50-835-D-HE2	120	50	CEILING, RECESSED	-	INTEGRAL LED	LED	YES	
A1-EM	TOPAZ	F-L24-50-835-D-HE2	120	50	CEILING, RECESSED	_	INTEGRAL LED	LED	YES	PROVIDE WITH NICOR EMB80 EM DRIVER
A2	TOPAZ	F-L22-30-835-D-HE2	120	30	CEILING, RECESSED	_	INTEGRAL LED	LED	YES	
A2-EM	TOPAZ	F-L22-30-835-D-HE2	120	30	CEILING, RECESSED	_	INTEGRAL LED	LED	YES	PROVIDE WITH NICOR EMB80 EM DRIVER
B1	BEST LIGHTING	LEDUC-E24-3K CORDPLUG-WHT-6C3P	120	10	UNDERCABINET	-	INTEGRAL LED	LED	YES	
С	CONTECH LIGHTING	HEAD: CTL603-P TRACK: LT-LENGTH-P	120	12	TRACK	1	TCP #LED12P30D27KNFL	LED	YES	PROVIDE LA-23-RN-P CURRENT LIMITING DEVICE PER PLANS. 1A=REG1, 2A=REG21, 3A=REG4, 4A=REG5 LENGTH = SEE PLAN FOR REQUIRED LENGTHS
ELF	AXIS LIGHTING	WBRLED-900-80-27-S-4-W-UNV-DP-1-D	120	40	CEILING, RECESSED	_	INTEGRAL LED	LED	YES	
P5	TUDO AND CO	GLASS BUBBLE LAMP SHADE PENDANT	120	9	CEILING, SUSPENDED	1	LED E27 BASE LEDLIGHT #65844 OR SIMILAR	LED	YES	VERIFY FINAL MOUNTING HEIGHT WITH ARCHITECT
R1	JUNO	IC22LED-G4-14LM-27K-90CRI-120-FRPC 24 WWH	120	20	CEILING, RECESSED	_	INTEGRAL LED	LED	YES	
R2	JUNO	IC4AL-07LM-27K-90CRI-FL-120-FRPC 42 PTSC	120	11	CEILING, RECESSED	_	INTEGRAL LED	LED	YES	
R4	JUNO	MG1LG2-27K-NFL-SN	12	5	CEILING, RECESSED	_	INTEGRAL LED	LED	YES	
XL	DIODE LED	DI-12V-0160 BLAZE	12	3W/FT	CEILING, SURFACE	_	INTEGRAL LED	LED	YES	
L	DIODE LED	DI-12V-FV30-80SP	12	1.5W/FT	CEILING, SURFACE	_	INTEGRAL LED	LED	YES	
G1	LITHONIA	ZLD-L48-3000LM-FST-MVOLT-4000K-80CRI-WH	120	30	CEILING, SURFACE	_	INTEGRAL LED	LED	YES	
E1W	BEST LIGHTING	R-16-LED	120	5	CEILING, SURFACE	2	3W LED LAMPS	LED	YES	
E3W	BEST LIGHTING	R-16HO-LED	120	15	CEILING, SURFACE	2	3W LED LAMPS	LED	YES	
E4	BEST LIGHTING	RHLED-2-WP-MV-B	6	2	CEILING, SURFACE	2	3W LED LAMPS	LED	YES	
EX1	BEST LIGHTING	ELXTEU-1-R-C-A-EM	120	4	CEILING, SUSPENDED	_	INTEGRAL LED	LED	YES	
EX2	BEST LIGHTING	EZXTEU-2-R-W-W-EM-SDT	120	4	WALL, SURFACE	<b>-</b>	INTEGRAL LED	LED	YES	******
XB1	TECH LIGHTING	7000BARK3-830-36-FINISH-UNV	120	15	GRADE, POLE		INTEGRAL LED	LED	YES	
XC4	MINKA AIRE	F753-KA	120	47	CEILING, SURFACE		NO LAMPING		YES	
X3WA-EM	LUMARK	XTOR9A-N-CBP	120	79	WALL, RECESSED	_	INTEGRAL LED	LED	YES	'

LAMP TYPE CODES: FL=LINEAR FLUORESCENT, CFL=COMPACT FLUORESCENT, IND=INCANDESCENT, MH=METAL HALIDE, HPS=HIGH PRESSURE SODIUM, LED=LIGHT EMITTING DIODE

## LUMINAIRE SCHEDULE GENERAL NOTES:

- LUMINAIRE SYMBOLS THAT ARE SHOWN HALF-SHADED, OR LABELED "EM", ON THE PLAN(S) INDICATE LUMINAIRES THAT SERVE AS EMERGENCY LIGHTING. UNLESS SERVED BY A CIRCUIT ORIGINATING AT AN EMERGENCY PANELBOARD OR CENTRAL LIGHTING INVERTER, EMERGENCY LIGHTING LUMINAIRES SHALL BE PROVIDED WITH AN EMERGENCY BATTERY
- TO PROVIDE EMERGENCY ILLUMINATION FOR A MINIMUM OF 90 MINUTES. INTEGRAL EMERGENCY BATTERIES SHALL MEET THE FOLLOWING MINIMUM PERFORMANCE REQUIREMENTS UNLESS OTHERWISE INDICATED:
- LINEAR FLUORESCENT LUMINAIRES: 1400 LUMENS, MINIMUM, PER LUMINAIRE. - COMPACT FLUORESCENT LUMINAIRES: 1100 LUMENS, MINIMUM, PER LUMINAIRE.
  - INTEGRATED LED LUMINAIRES RATED 1000 LUMENS OR LESS: 10 WATT, MINIMUM, OUTPUT.
- INTEGRATED LED LUMINAIRES RATED GREATER THAN 1000 LUMENS: 20 WATT, MINIMUM, OUTPUT. ANY PROPOSED SUBSTITUTIONS FOR LUMINAIRES THAT ARE SELECTED BY OTHERS REQUIRE THE APPROVAL OF THE SPECIFYING ENTITY.
- PROVIDE LIGHT EMITTING DIODES (LEDS) BINNED WITHIN A MAXIMUM THREE-STEP MACADAM ELLIPSE TO ENSURE COLOR CONSISTENCY AMONGST LUMINAIRES OF THE SAME TYPE AND LEDS THAT MEET UL STANDARD 8750 "LIGHT EMITTING DIODE EQUIPMENT FOR USE IN LIGHTING PRODUCTS," IES STANDARD LM-79 "ELECTRICAL AND PHOTOMETRIC MEASUREMENTS OF SOLID-STATE LIGHTING PRODUCTS," IES STANDARD LM-80 "MEASURING LUMEN MAINTENANCE OF LED LIGHT SOURCES," IES STANDARD TM-21 "PROJECTING LONG TERM LUMEN MAINTENANCE OF LED LIGHT SOURCES," AND ANSI C78.377 "SPECIFICATIONS FOR THE CHROMATICITY OF SOLID STATE LIGHTING PRODUCTS." LED LUMINAIRES SHALL BE MODULAR AND ALLOW FOR SEPARATE REPLACEMENT OF LED LAMPS AND DRIVERS. USER SERVICEABLE LED LAMPS AND DRIVERS SHALL BE REPLACEABLE FROM THE ROOM SIDE. LED DRIVERS SHALL BE ELECTRONIC-TYPE, LABELED AS COMPLIANT WITH RADIO FREQUENCY INTERFERENCE (RFI) REQUIREMENTS OF FCC TITLE 47 PART 15, AND COMPLY WITH NEMA SSL 1 "ELECTRONIC DRIVERS FOR LED DEVICES, ARRAYS, OR SYSTEMS." LED DRIVERS SHALL HAVE A SOUND RATING OF "A," HAVE A MINIMUM EFFICIENCY OF 85 PERCENT, AND SHALL HAVE A TOTAL HARMONIC DISTORTION (THD) OF LESS THAN 20 PERCENT AT ALL INPUT VOLTAGES.

		Store Name: Shake Shack Store #: Lutron Project #:				Contro	ol Intent & Sc	hedules1		Include on "Front of House" Keypad	include on Signage Keypad	Include on "Back of House" Keypad Keypad System Webpage Control	Occupancy / Vacancy	Daylight Harvesting2	Sunrise 6:00am	10:45 AM	Sunset 10:00 PM	12:00 AM	Spare Event Spare Event Spare Event
Customer Circuit #	Feed Circuit #	Lutron Circuit # (Lutron Use)	Zone Location	Fixture Type	Specified Zone Name	Zone Type	Dim/Non-Dim2	Load Type	Load Controller (Lutron Use)	1		Manual Controls		Auto	11 '	<u> </u>	Sche	dule	
1	P1-53	To be filled out by Lutron	Interior: Back-of-House	R1	OPEN KITCHEN	Kitchen - Open Area	DIM	Forward Phase	[Select Load Controller]	-	-	7 7 7	<del>      _                                </del>	_	- 11	00% -		10%	
2	P1-53	To be filled out by Lutron	Interior: Back-of-House	R4	ORDER/PICKUP COUNTER	Kitchen - Open Area	DIM	Reverse Phase	[Select Load Controller]	-	-	? ? ?		-	<del></del>	00% -	1 - 1 -	10%	<del>                                     </del>
3	P1-53	To be filled out by Lutron	Interior: Back-of-House	A1, A1-EM	WORK ROOM	Ktichen - Work Area (R4)	DIM	0-10V	[Select Load Controller]	-	-	? ? ?	<del>                                     </del>	-	- 1			10%	<del>                                     </del>
4	P1-53	To be filled out by Lutron	Interior: Back-of-House	A1-EM	MANAGER'S OFFICE	Manager's Office	DIM	0-10V	[Select Load Controller]	-	-	? ? ?	?	-	-			-	
5	P1-53	To be filled out by Lutron	Interior: Front-of-House	R2	MEN'S RESTROOM	Restrooms	DIM	Forward Phase	[Select Load Controller]	-	-	- ? ?	?	-	-			-	
6	P1-53	To be filled out by Lutron	Interior: Front-of-House	R2	WOMEN'S RESTROOM	Restrooms	DIM	Forward Phase	[Select Load Controller]	-	-	- ? ?	?	-	-			-	
7	P1-53	To be filled out by Lutron	Interior: Front-of-House	R2	CORRIDOR	Restroom Hallway	DIM	Forward Phase	[Select Load Controller]	?	_	?	-	-	- 1	00% 80%	50% 10	0% 10%	
8	P1-55	To be filled out by Lutron	Interior: Front-of-House	С	DINING TRACK A	Dining Area	DIM	Forward Phase	[Select Load Controller]	?	_	?	-	?	- 1	00% 80%	50% 10	0%	
9	P1-55	To be filled out by Lutron	Interior: Front-of-House	С	DINING TRACK B	Dining Area	DIM	Forward Phase	[Select Load Controller]	?	_	?	-	?	- 1	00% 80%	50% 10	0%	
10	P1-55	To be filled out by Lutron	Interior: Front-of-House	С	QUEUING TRACK	Queuing Area	DIM	Forward Phase	[Select Load Controller]	?	_	?	-	?	- 1	00% 80%	50% 10	)% 10%	
11	P1-55	To be filled out by Lutron	Interior: Front-of-House	P5	DINING PENDANTS	Dining Area	DIM	Reverse Phase	[Select Load Controller]	?	_	- ?	-	?	- 1	00% 80%	50% 10	0%	
12	P1-55	To be filled out by Lutron	Interior: Front-of-House	R2	VESTIBULE	Vestibule / Entry	DIM	Forward Phase	[Select Load Controller]	?	_	- ?	-	?	- 1	00% 80%	50% 10	)% 10%	
13	P1-55	To be filled out by Lutron	Interior: Front-of-House	L	INT. SIGN BAND OF LETTERS	Interior Signage and Menu Board	NON-DIM	Non-Dim	[Select Load Controller]	?	?	?	-	?	-	- 100%	80% 10	0%	
14	P1-55	To be filled out by Lutron	Interior: Back-of-House	G1	UTILITY ROOM	Work Room3	DIM	0-10V	[Select Load Controller]	-	-	? ? ?	?	-	- 100	%, DOB -	-	-, EO3	
15	P1-54	To be filled out by Lutron	Exterior: All	XL	EXT. SIGN BAND OF LETTERS	Exterior Signage including LED tape at band of letters	NON-DIM	Non-Dim	[Select Load Controller]	-	?	- ? ?	-	-	-	- ON	-	OFF	
16	P1-54	To be filled out by Lutron	Exterior: All	ELF4	PATIO A	Exterior Patio Lights	NON-DIM	Non-Dim	[Select Load Controller]	-	-	- ? ?	-	-	-	- ON	-   -	OFF	
17	P1-54	To be filled out by Lutron	Exterior: All	ELF4	PATIO B	Exterior Patio Lights	NON-DIM	Non-Dim	[Select Load Controller]	-	-	- ? ?	-	-	-	- ON	-   -	OFF	
18 6	P1-78	To be filled out by Lutron	Exterior: All	DRIVE THRU CANOPY	DRIVE-THRU CANOPY	Exterior Building Lights including canopy downlights, wall packs, and security lights	NON-DIM	Non-Dim	[Select Load Controller]	-	-	- ?	-		OFF	- ON			
19	P1-54	To be filled out by Lutron	Exterior: All	X3WA-EM	REAR DOORS	Exterior Building Lights including canopy downlights, wall packs, and security lights	NON-DIM	Non-Dim	[Select Load Controller]	-	-	- ?	-	_	OFF	- ON	-	-	
20	P1-56	To be filled out by Lutron	Interior: Front-of-House	SFSG SIGN	SFSG SIGN	Interior Signage and Menu Board	NON-DIM	Non-Dim	[Select Load Controller]	?	?	?	-	?	-	- 100%	80% 10	0%	
21	P1-57	To be filled out by Lutron	Exterior: All	BUILDING SIGN	BUILDING SIGNAGE A	Exterior Signage including LED tape at band of letters	NON-DIM	Non-Dim	[Select Load Controller]	-	?	- ? ?	-	-	-	- ON	-	OFF	
22	P1-63	To be filled out by Lutron	Exterior: All	BUILDING SIGN	BUILDING SIGNAGE B	Exterior Signage including LED tape at band of letters	NON-DIM	Non-Dim	[Select Load Controller]	-	?	- ? ?	-	-	-	- ON		OFF	
23	P1-58	To be filled out by Lutron	Interior: Back-of-House	RECEPTACLE FOR B1	OFFICE UNDERCOUNTER	Manager's Office	NON-DIM	Non-Dim	[Select Load Controller]	-	-	? ? ?	?	-	-		-	-	
24	P1-58	To be filled out by Lutron	Interior: Back-of-House	CONTROLLED RECEPT	OFFICE CONTROLLED RECEPT.	Time Clock On/Off	NON-DIM	Non-Dim	[Select Load Controller]	-	-	- ?	-	_	-	ON -	-	OFF	
25	P1-65	To be filled out by Lutron	Exterior: All	SITE SIGN	SITE SIGNAGE	Exterior Signage including LED tape at band of letters	NON-DIM	Non-Dim	[Select Load Controller]	-	?	- ? ?	-	-	-	- ON	-	OFF	
26	P1-67	To be filled out by Lutron	Exterior: All	LANDLORD PROVIDED	SITE LIGHTING	Exterior Parking Lightings	NON-DIM	Non-Dim	[Select Load Controller]	-	-	- ?	-	_	-	- ON		OFF	
27	P1-80	To be filled out by Lutron	Exterior: All	DRIVE THRU CANOPY	DRIVE-THRU CANOPY	Exterior Building Lights including canopy downlights, wall packs, and security lights	NON-DIM	Non-Dim	[Select Load Controller]	-	-	?	-	_	OFF	- ON		-	

1) Where schedule deviates from Shake Shack standard, state why in notes.

2) Where required/allowed by local energy code.

3) Disable Occupancy ("DO") Sensor at 6:00am and turn ON lights. Enable Occupancy ("EO") Sensor at close + 60minutes.

4) " - " means Unaffected or Not Applicable.

Form Notes: 1) "Hidden" unused rows. 2) "?" implies Zone Type cell for given zone does not match a valid Zone Type from approved list or is waiting to be filled in.

Store Hours	CONTROLS	LOCKS
Open	11:00 AM	0:15
Close	10:00 PM	1:00
Close	10.00 FW	1.00

PERMIT/BID SET

LEE'S SUMMIT MISSOURI SHACK #1348

SHAKE SHACK - LEE'S

LIGHTING SCHEDULES

RELEASE FOR CONSTRUCTION AS NOTED ON PLANS REVIEW DEVELOPMENT SERVICES
LEE'S SUMMIT, MISSOURI

800-581-0963 www.schnackel.com

COA #: E-2009006642

SEAL/ SIGNATURE: