


Black panel is considered part of branding logo and therefore, approved.

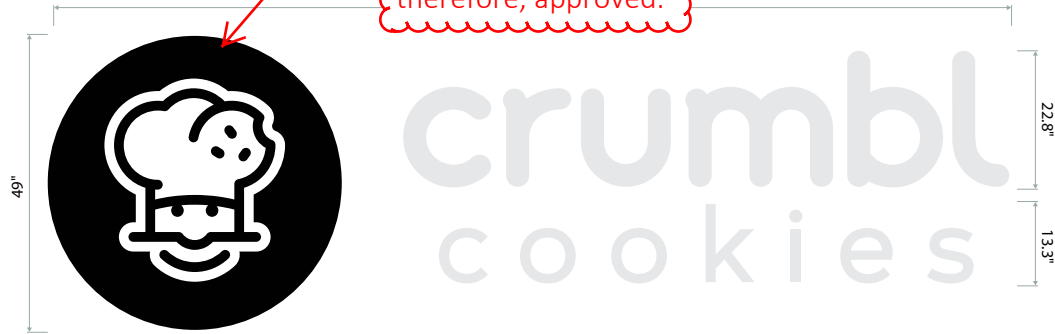

1.1 Front Lit Channel Letters  
Scale : 3/8" = 1'-0"

Standard Sign Review Comments

- Tenant shall be responsible for meeting all applicable codes and obtaining all jurisdictional approvals.
- Tenant shall field verify lease space for existing conditions and that space conforms to approved lease outline diagram as approved with Lease Agreement.
- Provide blocking at all signage to ensure secure connection to building.
- Transformers shall be concealed from public view and accessible from within the tenant space.
- UL labels and manufacturer stickers are required but shall not be visible to public view.
- A local disconnect for the sign shall be installed by the Tenant's sign contractor.
- "Open" signs not permitted in any form within first 4'-0" of storefront glass.
- This review pertains to the information contained in this sign review package. Any information or aspect of the signs, graphics, banners etc. not included in this sign package is subject to Landlord approval.



1.3 Front Elevation  
Scale : 1/8" = 1'-0"



Channel Letter Color Reference

COLOR SCHEDULE

- MATTHEWS BLACK (PNT1)
- VINYL - 3M OPAQUE BLACK (VNL1)
- MATTHEWS WHITE (PNT3)

Details :

LOGO ICON:

3" THICK FRONT LIT CHANNEL LETTER (PNT3) WITH VINYL OVERLAYS (VNL1)  
2" THICK ALUMINUM BACKER (PNT1)  
3/16" ACRYLIC FACE  
WHITE TRIM CAPS  
.040 ALUMINUM WHITE RETURNS | .063 ALUMINUM BACKS (PNT3) WHITE LEDS

LETTERS:

3" THICK FRONT LIT CHANNEL LETTER (PNT3)  
3/16" ACRYLIC FACE  
WHITE TRIM CAPS  
.040 ALUMINUM WHITE RETURNS | .063 ALUMINUM BACKS (PNT3) WHITE LEDS

ALLOWED SQ FT: 24.583' X 22.583' X 10% = 55.52 SQ FT  
SIGN SIZE: 54.51 SQ FT

**\*\* ELECTRICAL REQUIREMENTS PROVIDED BY OTHERS :  
EACH SIGN WILL REQUIRE IT'S OWN DEDICATED CIRCUIT  
PROVIDED BY OTHERS WITHIN 6' OF THE SIGN AREA AND  
ON A TIMER AND/OR PHOTOCELL DEPENDING ON LOCAL  
SIGN REQUIREMENTS.**

**IF NO ELECTRICAL IS PRESENT AT TIME OF INSTALLATION,  
A WHIP WILL BE LEFT FOR OTHERS TO HOOK UP.\*\***

Final Approval For Construction

approved  
approved as noted  
returned for corrections




The approval of working drawings are subject to the foll  
a | all previous review comments  
b | field approval by owner's representative  
c | terms and conditions of the Lease Agreement


By: **APPROVED**  
By Eric Hessler at 3:24 pm, Sep 24, 2021

The sole purpose of the drawing review by the Landlord's representative was an evaluation of the consistency with the aesthetic components of both the established criteria booklet and Landlord's design requirements. By reviewing these drawings and compliance, compliance with all applicable codes, regulations, standards, and all other applicable laws and guidelines.

ALL COMPONENTS **UL** LISTED

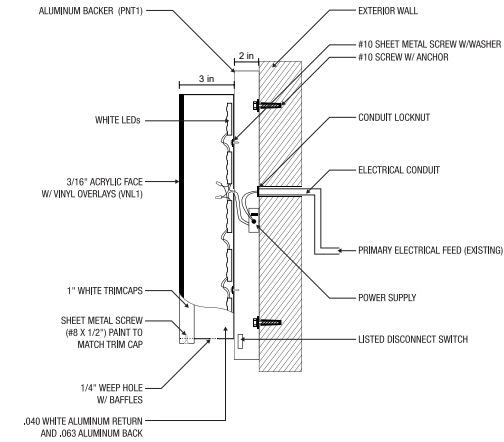

LOGO ICON

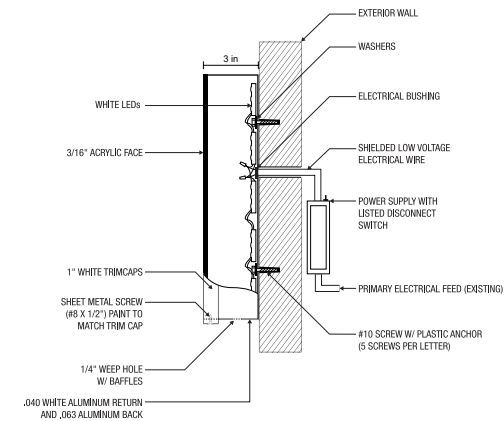

LETTERS

**\*\* ALL BOLTS AND SCREWS ARE STAINLESS STEEL \*\***

1.2 Mounting Detail  
Scale : NTS

Existing frame shall be brought to as-new condition.



Night Simulation



1.4 Awning Recovery on Existing Frame  
Scale : NTS  
Material: Sunbrella Black  
Dimensions to be field verified



**SIGNDESIGNLAB**

Project Management | Signage  
signdesignlab.com · sales@signdesignlab.com

**(888) 735-7446**

PROJECT INFORMATION  
COMPANY & LOCATION

**Crumbl Cookies**  
1736 NW Chipman Rd  
Lees Summit, MO 64081

OVERVIEW

Exterior Signs

DATE	PROJECT #
09/17/21	SDLP1585

DESIGNER

JA

REVISIONS

(1) - (JEN) - 09/17/21 - No backer allowed.  
Switched sign to Option B.

APPROVAL

- ☐ APPROVED WITH NO CHANGES
- ☐ APPROVED WITH CHANGES AS NOTED
- ☐ REVISE AS NOTED AND RESUBMIT

Signature \_\_\_\_\_ Date \_\_\_\_\_

DESIGN

**A02**


SHEET

**01 of 02**

All original ideas, designs and signage remain the property of Sign Design Lab until paid in full.

Colors and designs are representations of the final product. Final signage colors and build will be based on specifications noted on final proofs and/or invoice.



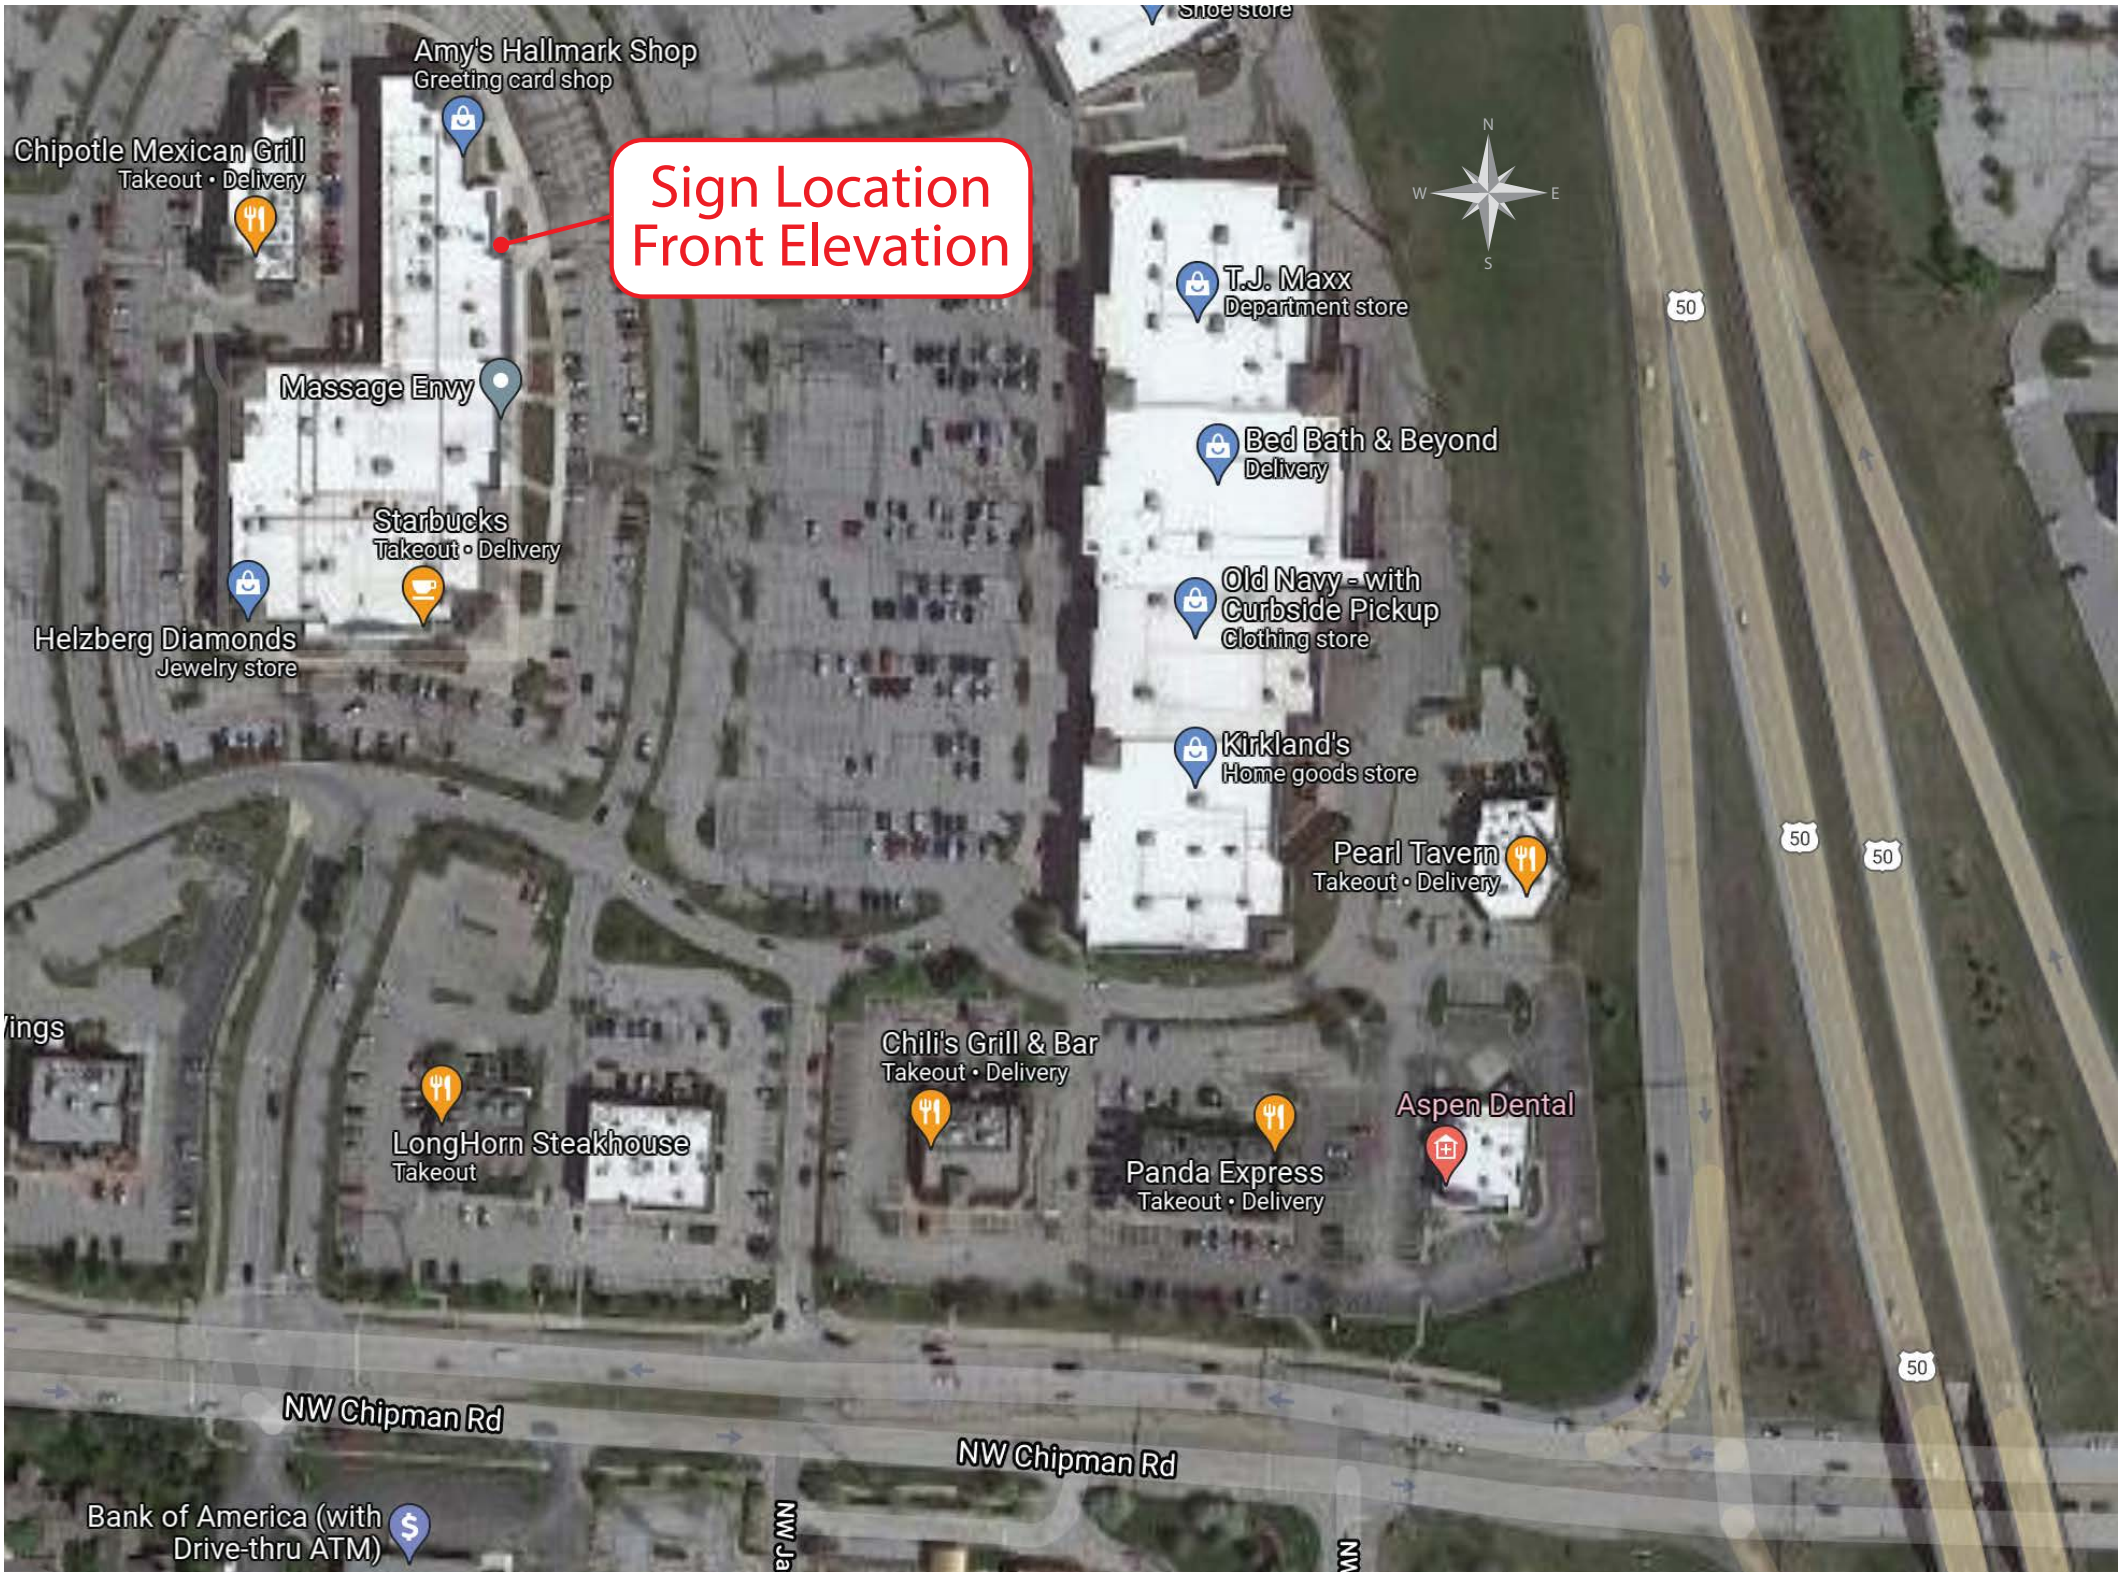

2.1 Site Map  
Scale : NTS



**SIGNDESIGNLAB**

Project Management | Signage  
signdesignlab.com • sales@signdesignlab.com

(888) 735-7446

**PROJECT INFORMATION**

**COMPANY & LOCATION**

**Crumbl Cookies**  
1736 NW Chipman Rd  
Lees Summit, MO 64081

**OVERVIEW**

Exterior Signs

DATE	PROJECT #
09/17/21	SDLP1585

**DESIGNER**

JA

**REVISIONS**

**APPROVAL**

- ☐ APPROVED WITH NO CHANGES
- ☐ APPROVED WITH CHANGES AS NOTED
- ☐ REVISE AS NOTED AND RESUBMIT

Signature

Date

**DESIGN**

**A02**

**SHEET**

**02 of 02**

All original ideas, designs and signage remain the property of Sign Design Lab until paid in full.

Colors and designs are representations of the final product. Final signage colors and build will be based on specifications noted on final proofs and/or invoice.