


RECORD DRAWING


SURVEY COMPLETED JULY 9, 2021

INFORMATION PROVIDED ON THIS DRAWING DEPICTS AS-CONSTRUCTED CONDITIONS OF SANITARY SEWER WORK PERFORMED BY REDFORD CONSTRUCTION, INC. I, NOR SNYDER & ASSOCIATES, INC IN ANY WAY EXPRESS OR IMPLY WARRANTY OF THE DESIGN OR THE ENGINEERING OF THE AS-CONSTRUCTED IMPROVEMENTS SHOWN HEREON.

I HEREBY CERTIFY THAT THIS RECORD CORRECTLY DEPICTS THE WORK CONSTRUCTED AS TO SIZE, HORIZONTAL AND VERTICAL LOCATION, AND GRADE AS SHOWN ON THE APPROVED CONSTRUCTION DRAWINGS. THE WORK WAS DONE IN ACCORDANCE WITH THESE RECORDS AND THE CURRENT VERSION OF THE STANDARDS AND SPECIFICATIONS.

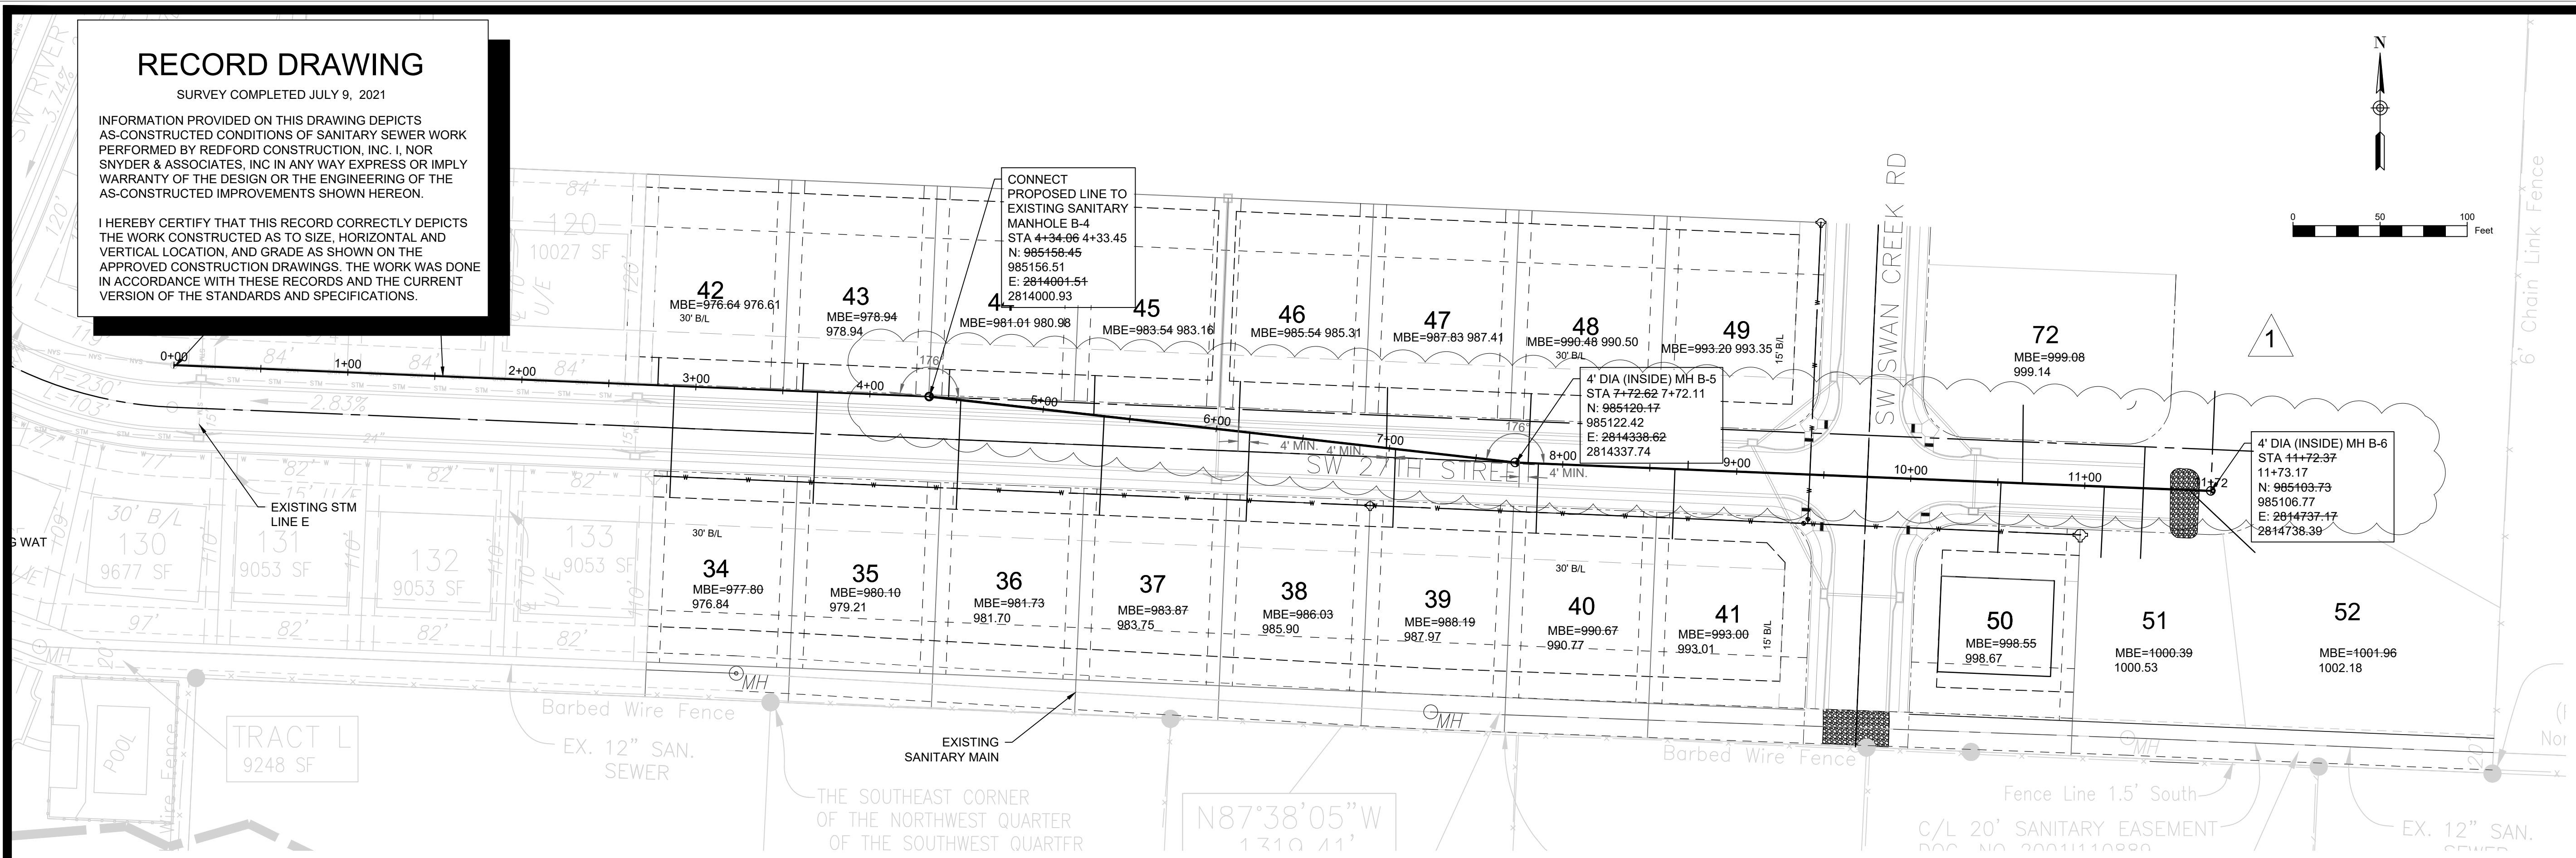

NOTE:
FUTURE SANITARY EXTENSION TO BE CORE-DRILLED
NO STUB-OFFS ALLOWED

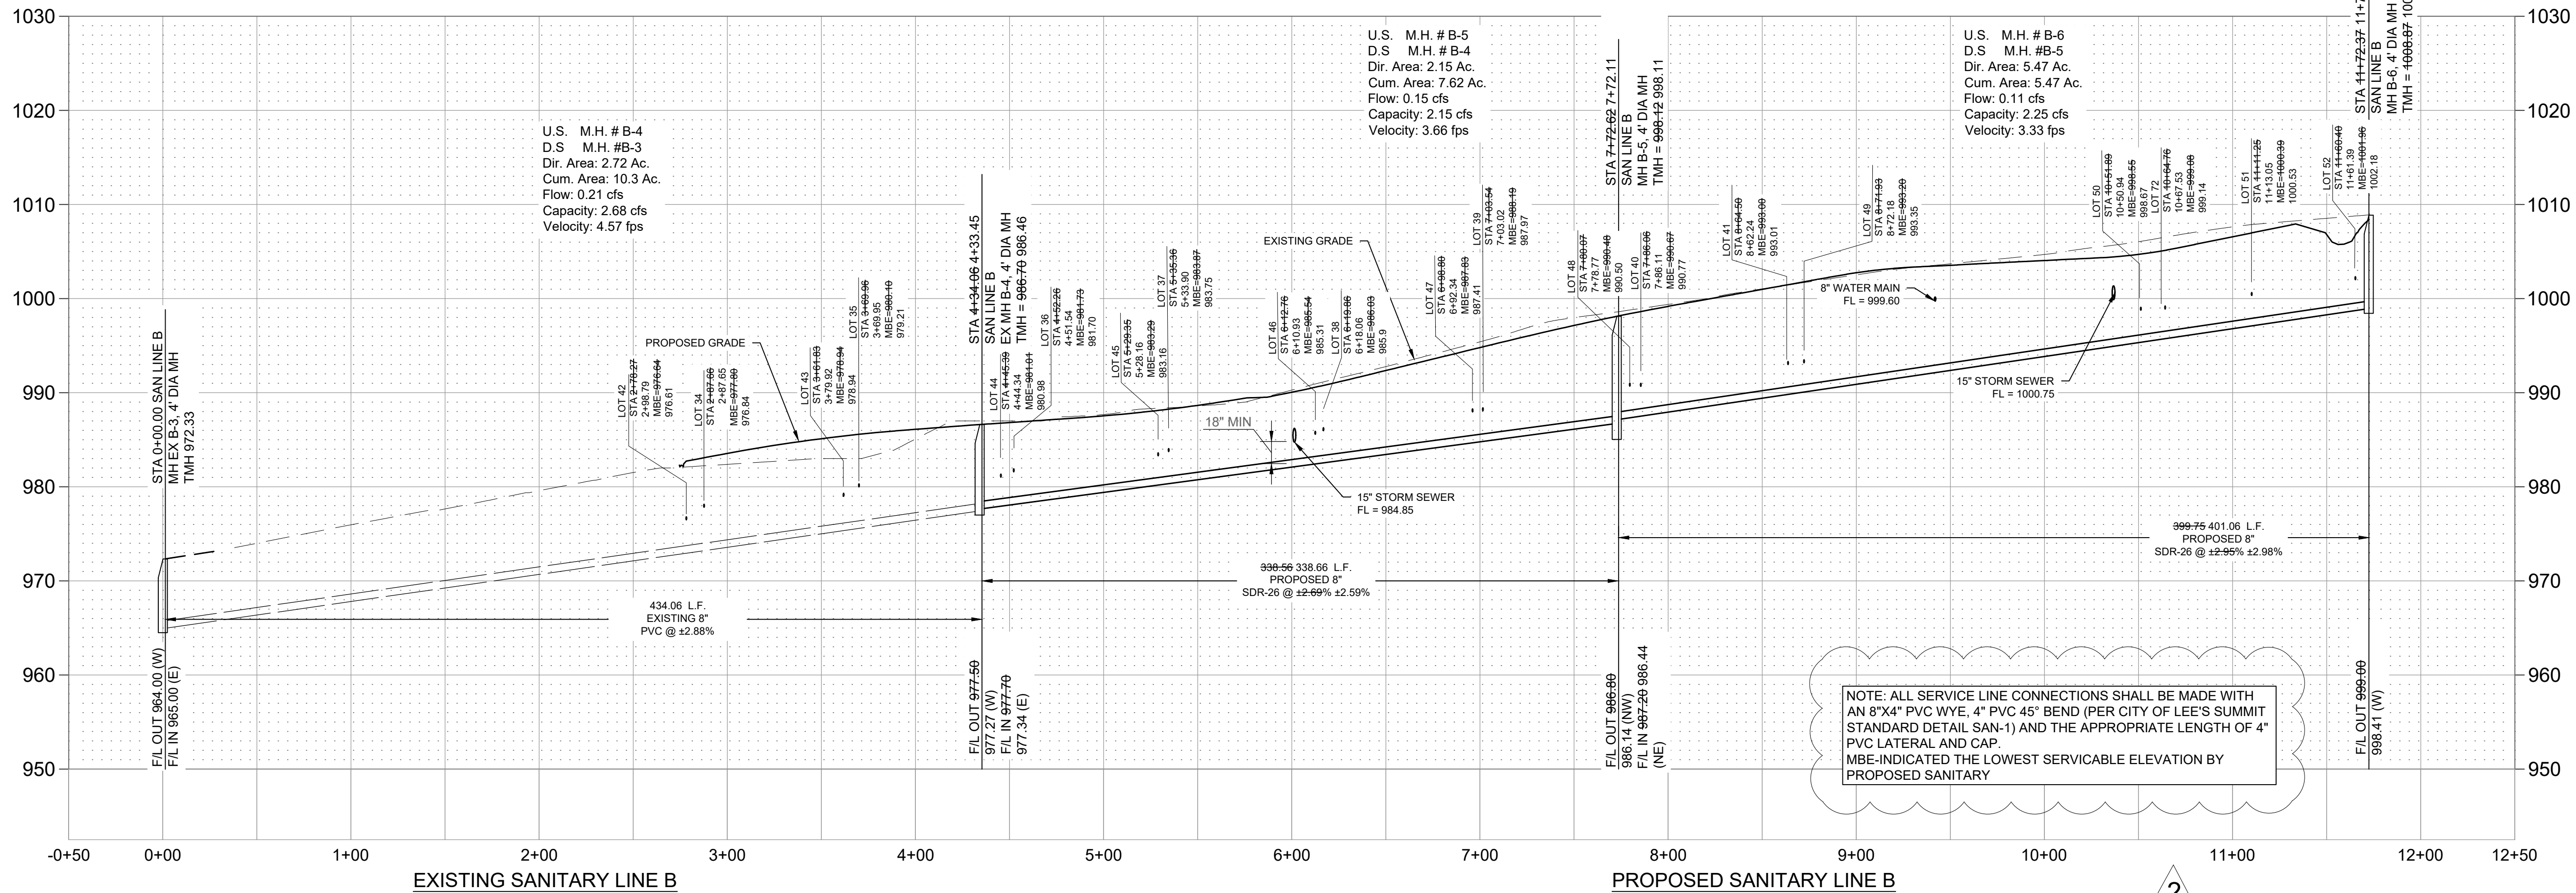

WHISPERING WOODS 2ND PLAT
SANITARY SEWER PLANS

SANITARY SEWER PLAN & PROFILE

SNYDER & ASSOCIATES
ENGINEERS & PLANNERS, INC.



Project No: 1200484.11

Sheet 5

LEE'S SUMMIT, MO

802 FRANCIS STREET
ST. JOSEPH, MO 64501
816-364-5222

SHAWN DUKE - ENGINEER
MO PE#2013006489

