

GENERAL NOTES

- THESE **PLANS AND SPECIFICATIONS**, AS INSTRUMENTS OF SERVICE, ARE AND SHALL REMAIN THE PROPERTY OF **THE ARCHITECT**. THEY ARE NOT TO BE REPRODUCED IN PART OR WHOLE OR USED ON ANY OTHER PROJECTS EXCEPT BY AGREEMENT IN WRITING WITH AND AFTER APPROPRIATE COMPENSATION TO **THE ARCHITECT**.
- CONSTRUCTION SHALL FOLLOW THE LOCAL GOVERNING CODE, APPLICABLE EDITION, AS ADOPTED BY THE GOVERNING AUTHORITIES, AND ALL APPLICABLE AMENDMENTS. THE CONTRACTOR(S) SHALL BE RESPONSIBLE FOR BUILDING THIS PROJECT IN ACCORDANCE WITH THE DRAWINGS, SPECIFICATIONS, AND STATE AND LOCAL CODES, UNLESS WRITTEN NOTIFICATION IS RECEIVED.
- THE ARCHITECT DOES NOT GUARANTEE THE PERFORMANCE OF THE PROJECT IN ANY RESPECT OTHER THAN THE ARCHITECTURAL WORK PERFORMED WHICH MEETS THE STANDARDS OF PROFESSIONAL CARE.
- THE CONTRACTOR SHALL VISIT THE SITE, BEFORE SUBMITTING PROPOSALS.
- THE CONTRACTOR SHALL COORDINATE ALL THE WORK OF ALL THE TRADES.
- THE CONTRACTOR SHALL VERIFY ALL DIMENSIONS AND CONDITIONS AT THE JOB SITE PRIOR TO STARTING ANY WORK AND NOTIFY THE ARCHITECT IN WRITING IMMEDIATELY OF ANY ERRORS OR OMISSIONS OR THE CONTRACTOR SHALL ACCEPT FULL RESPONSIBILITY FOR THE ERRORS AND OMISSIONS. DO NOT SCALE THE DRAWINGS.
- THESE PLANS, AS DRAWN AND NOTED, COMPLY WITH THE BUILDING ENVELOPE ENERGY REQUIREMENTS OF THE GOVERNING BUILDING CODE. THE CONTRACTOR SHALL FAMILIARIZE HIMSELF WITH THE GOVERNING CODE IN THEIR ENTIRETIES AND BUILD IN ACCORDANCE WITH ALL PROVISIONS OF THESE CODES WHICH MAY NOT BE SPECIFICALLY ADDRESSED IN THE PLANS AND NOTES.
- THE CONTRACTOR WILL NOT SUBSTITUTE ITEMS WHICH THEY BELUEVE TO BE EQUAL OR BETTER THAN ITEMS SPECIFIED ON THESE DRAWINGS WITHOUT PRIOR NOTICE. ITEMS WHICH, WHEN SUBSTITUTED, REQUIRE APPROVAL OF THE BUILDING OFFICIAL WILL BE SUBMITTED TO THE BUILDING OFFICIAL, THE TENANT, AND THE ARCHITECT.
- THE CONTRACTOR IS RESPONSIBLE FOR ADEQUATE BRACING, STRUCTURAL, AND NON-STRUCTURAL MEMBERS DURING CONSTRUCTION.
- ALL FRAME WALLS SHALL BE CONSTRUCTED WITH ANCHORS, TOP AND BOTTOM OF EACH STUD, PER CODE.
- ALL WORK SHALL BE ERECTED AND INSTALLED PLUMB, LEVEL, SQUARE AND TRUE, AND IN PROPER ALIGNMENT.
- ANY ITEM SCHEDULED TO BE REUSED MUST BE REFURBISHED AND MAINTAINED TO A "LIKE NEW" CONDITION. NO EXCEPTIONS.
- ALL FLOOR PENETRATIONS MUST BE SEALED WITH A 2 HOUR RATING.
- ALL PENETRATIONS INTO OR THROUGH FIRE WALLS, FIRE BARRIERS, SMOKE BARRIER WALLS, AND FIRE PENETRATIONS SHALL COMPLY WITH APPLICABLE BUILDING CODES.

PERMIT NOTES

- ALTERATION OF THE AUTOMATIC FIRE SPRINKLER SYSTEM IS REQUIRED, UNDER SEPARATE PERMIT.
- ALTERATION OF THE FIRE ALARM SYSTEM IS REQUIRED, UNDER SEPARATE PERMIT.

FLOOR PLAN NOTES

- ALL DIMENSIONS MARKED 'CLEAR' OR 'CLR' SHALL BE MAINTAINED AND SHALL ALLOW FOR THICKNESS OF ALL WALL FINISHES, UNLESS OTHERWISE NOTED.
- ALL CONCEALED LUMBER AND BLOCKING TO BE FIRE TREATED. SILL COVER TO SUPPORT MINIMUM LIVE LOAD OF 300 LBS.
- ALL WOOD NOT CALLED OUT SHALL BE PRESSURE-TREATED FIRE RATED OR FIRE RETARDANT TREATED WOOD.

CONCRETE

- ALL CONCRETE SHALL HAVE SAND AND GRAVEL AGGREGATE, TYPE I PORTLAND CEMENT, AND SHALL HAVE A COMPRESSIVE STRENGTH OF ANY NEW CONCRETE SHALL BE 3,500 PSI AT 28 DAYS.
- MINIMUM CEMENT RATIO TO BE: 6 SACKS PER CUBIC. MAXIMUM WATER CEMENT RATIO TO BE 0.50.
- ALL CONCRETE REINFORCEMENT BARS SHALL CONFORM TO ASTM A615, GRADE 60.
- ALL WELDED WIRE FABRIC SHALL CONFORM TO ASTM 185.
- DETAILING, FABRICATION AND PLACING OF CONCRETE REINFORCEMENT AND ACCESSORIES SHALL BE IN ACCORDANCE WITH ACI SP-66, LATEST EDITION.
- ALL MIXING, TRANSPORTING, PLACING AND CURING OF CONCRETE SHALL BE DONE IN ACCORDANCE WITH THE RECOMMENDATION OF THE LATEST EDITIONS OF THE AMERICAN CONCRETE INSTITUTE ACI 318, ACI 301, ACI 309, ACI 305 AND ACI 306. MAXIMUM FALL FOR CONCRETE SHALL BE 3'-0".
- ALL CONCRETE SHALL BE CONSOLIDATED BY VIBRATION, SPADING OR RODDING, SO THAT THE CONCRETE IS THOROUGHLY WORKED AROUND THE REINFORCEMENT, EMBEDDED ITEMS, AND INTO CORNERS OF FORMS, ELIMINATING ALL AIR OR STONE POCKETS WHICH MIGHT CAUSE HONEYCOMBING. CARE SHALL BE TAKEN NOT TO OVER VIBRATE AND CAUSE SEGREGATION.

METAL STUDS / DRYWALL

- GYPSUM BOARD JOINTS SHALL BE STAGGERED AS REQUIRED BY GOVERNING BUILDING CODES.
- PROVIDE WATER RESISTANT GYPSUM BOARDS AROUND RESTROOM FIXTURES.
- ALL BACKING/BLOCKING SHALL CONSIST OF 16 GAUGE METAL FRAMING AND/OR 2" X F.T. LUMBER.
- ALL DIMENSIONS ARE FROM FACE OF GYPSUM WALL BOARD, UNLESS NOTED OTHERWISE.
- ALL EXPOSED GYPSUM BOARD EDGES TO HAVE METAL EDGE TRIM, UNLESS OTHERWISE NOTED.

CABINETS

- ALL EXPOSED CABINET ENDS SHALL HAVE FINISH PANELS. GENERAL CONTRACTOR SHALL COORDINATE LOCATION OF ALL CABINET FILLERS, FALSE PANELS, MISC. COMPONENTS FOR CABINERY AND MILLWORK & COUNTER TOP PENETRATIONS REQUIRED BY EQUIPMENT.
- ALL COUNTERTOP / WALL INTERSECTIONS SHALL HAVE A 4" HIGH BACKSPASH. UNLESS NOTED OTHERWISE.
- ALL MILLWORK TO BE FASTENED TO THE PARTITION THEY ADJOIN. PROVIDE BLOCKING FOR ALL MILLWORK NOT SUPPORTED BY SLABS.

FINISH PLAN NOTES

- ALL INTERIOR WALLS SHALL BE FINISHED PER SCHEDULE. IF NO INDICATION PROVIDED, THE SURFACE SHALL BE PAINTED WITH A PAINT SPECIFICATION BEING USED PREDOMINANTLY ON THIS PROJECT.
- ALL INTERIOR PARTITIONS SHALL RECEIVE ONE PRIMER & TWO FINISH COATS.
- ALL HORIZONTAL GYPSUM BOARD SURFACES SHALL BE PRIMED WITH TINTED PRIMER TO COINCIDE WITH FINSH PAINT COLOR. ALL LEFT OVER PAINT SHALL BE CLEARLY LABELED AND APPROPRIATELY PACKAGED. CONTRACTOR SHALL DELIVER ALL LEFTOVER PAINT AND FINISH MATERIALS TO TENANT FOR STORAGE.
- FLOOR FINISHES ON BOTH SIDES OF A DOOR SHALL BE LEVEL FOR A DISTANCE EQUAL TO 5' TO EITHER SIDE OF DOOR.
- CENTER FLOOR TILES IN ROOM UNLESS NOTED OTHERWISE.
- CENTER ACOUSTIC CEILING TILES TO ROOM UNLESS NOTED OTHERWISE.

DOOR NOTES

- TRIM THE BOTTOM OF DOORS TO CLEAR THE TOP OF ALL FINISHED FLOORS. AS APPLICABLE BY 1/4" MAXIMUM, UNLESS OTHERWISE NOTED.
- VERIFY SLAB CONDITIONS. TRIM EACH DOOR TO FIT CONDITIONS.
- WHERE RADICAL VARIATIONS IN FLOOR ELEVATION EXIST, DOORS SHALL BE ORDERED WITH BOTTOM STILE SIZED TO ACCOMMODATE THESE UNDERCUT CONDITIONS.

3330 N.E. 34th Street
Ft. Lauderdale, FL 33308 P: 954.566.5051
www.laskyarchitect.com
architects - interior designers
engineers - construction managers

THIS DOCUMENT IS THE PROPERTY OF LASKY ARCHITECT, P.A. AND SHALL NOT BE REPRODUCED WITHOUT THE WRITTEN CONSENT OF LASKY ARCHITECT, P.A.

PROJECT

THE DRIPBAR

930-M NW BLUE PKWY,
LEES SUMMIT, MO 64086

REVISIONS DATES:

10/20/21 BD COMMENTS

10/26/21 CLIENT AND LL COMMENTS

PROFESSIONAL SEAL

STATE OF MISSOURI

SCOTT L. LASKY, ARCHITECT

NUMBER A2019015157






















10-2-2021

SCOTT L. LASKY A2019015157
REGISTERED ARCHITECT
STATE OF MISSOURI

ISSUE DATE: 08-25-2021
PROJECT #: 328P.1313P
DRAWN BY: AJ
CHECKED BY: CC-SL

GENERAL NOTES

CS-2

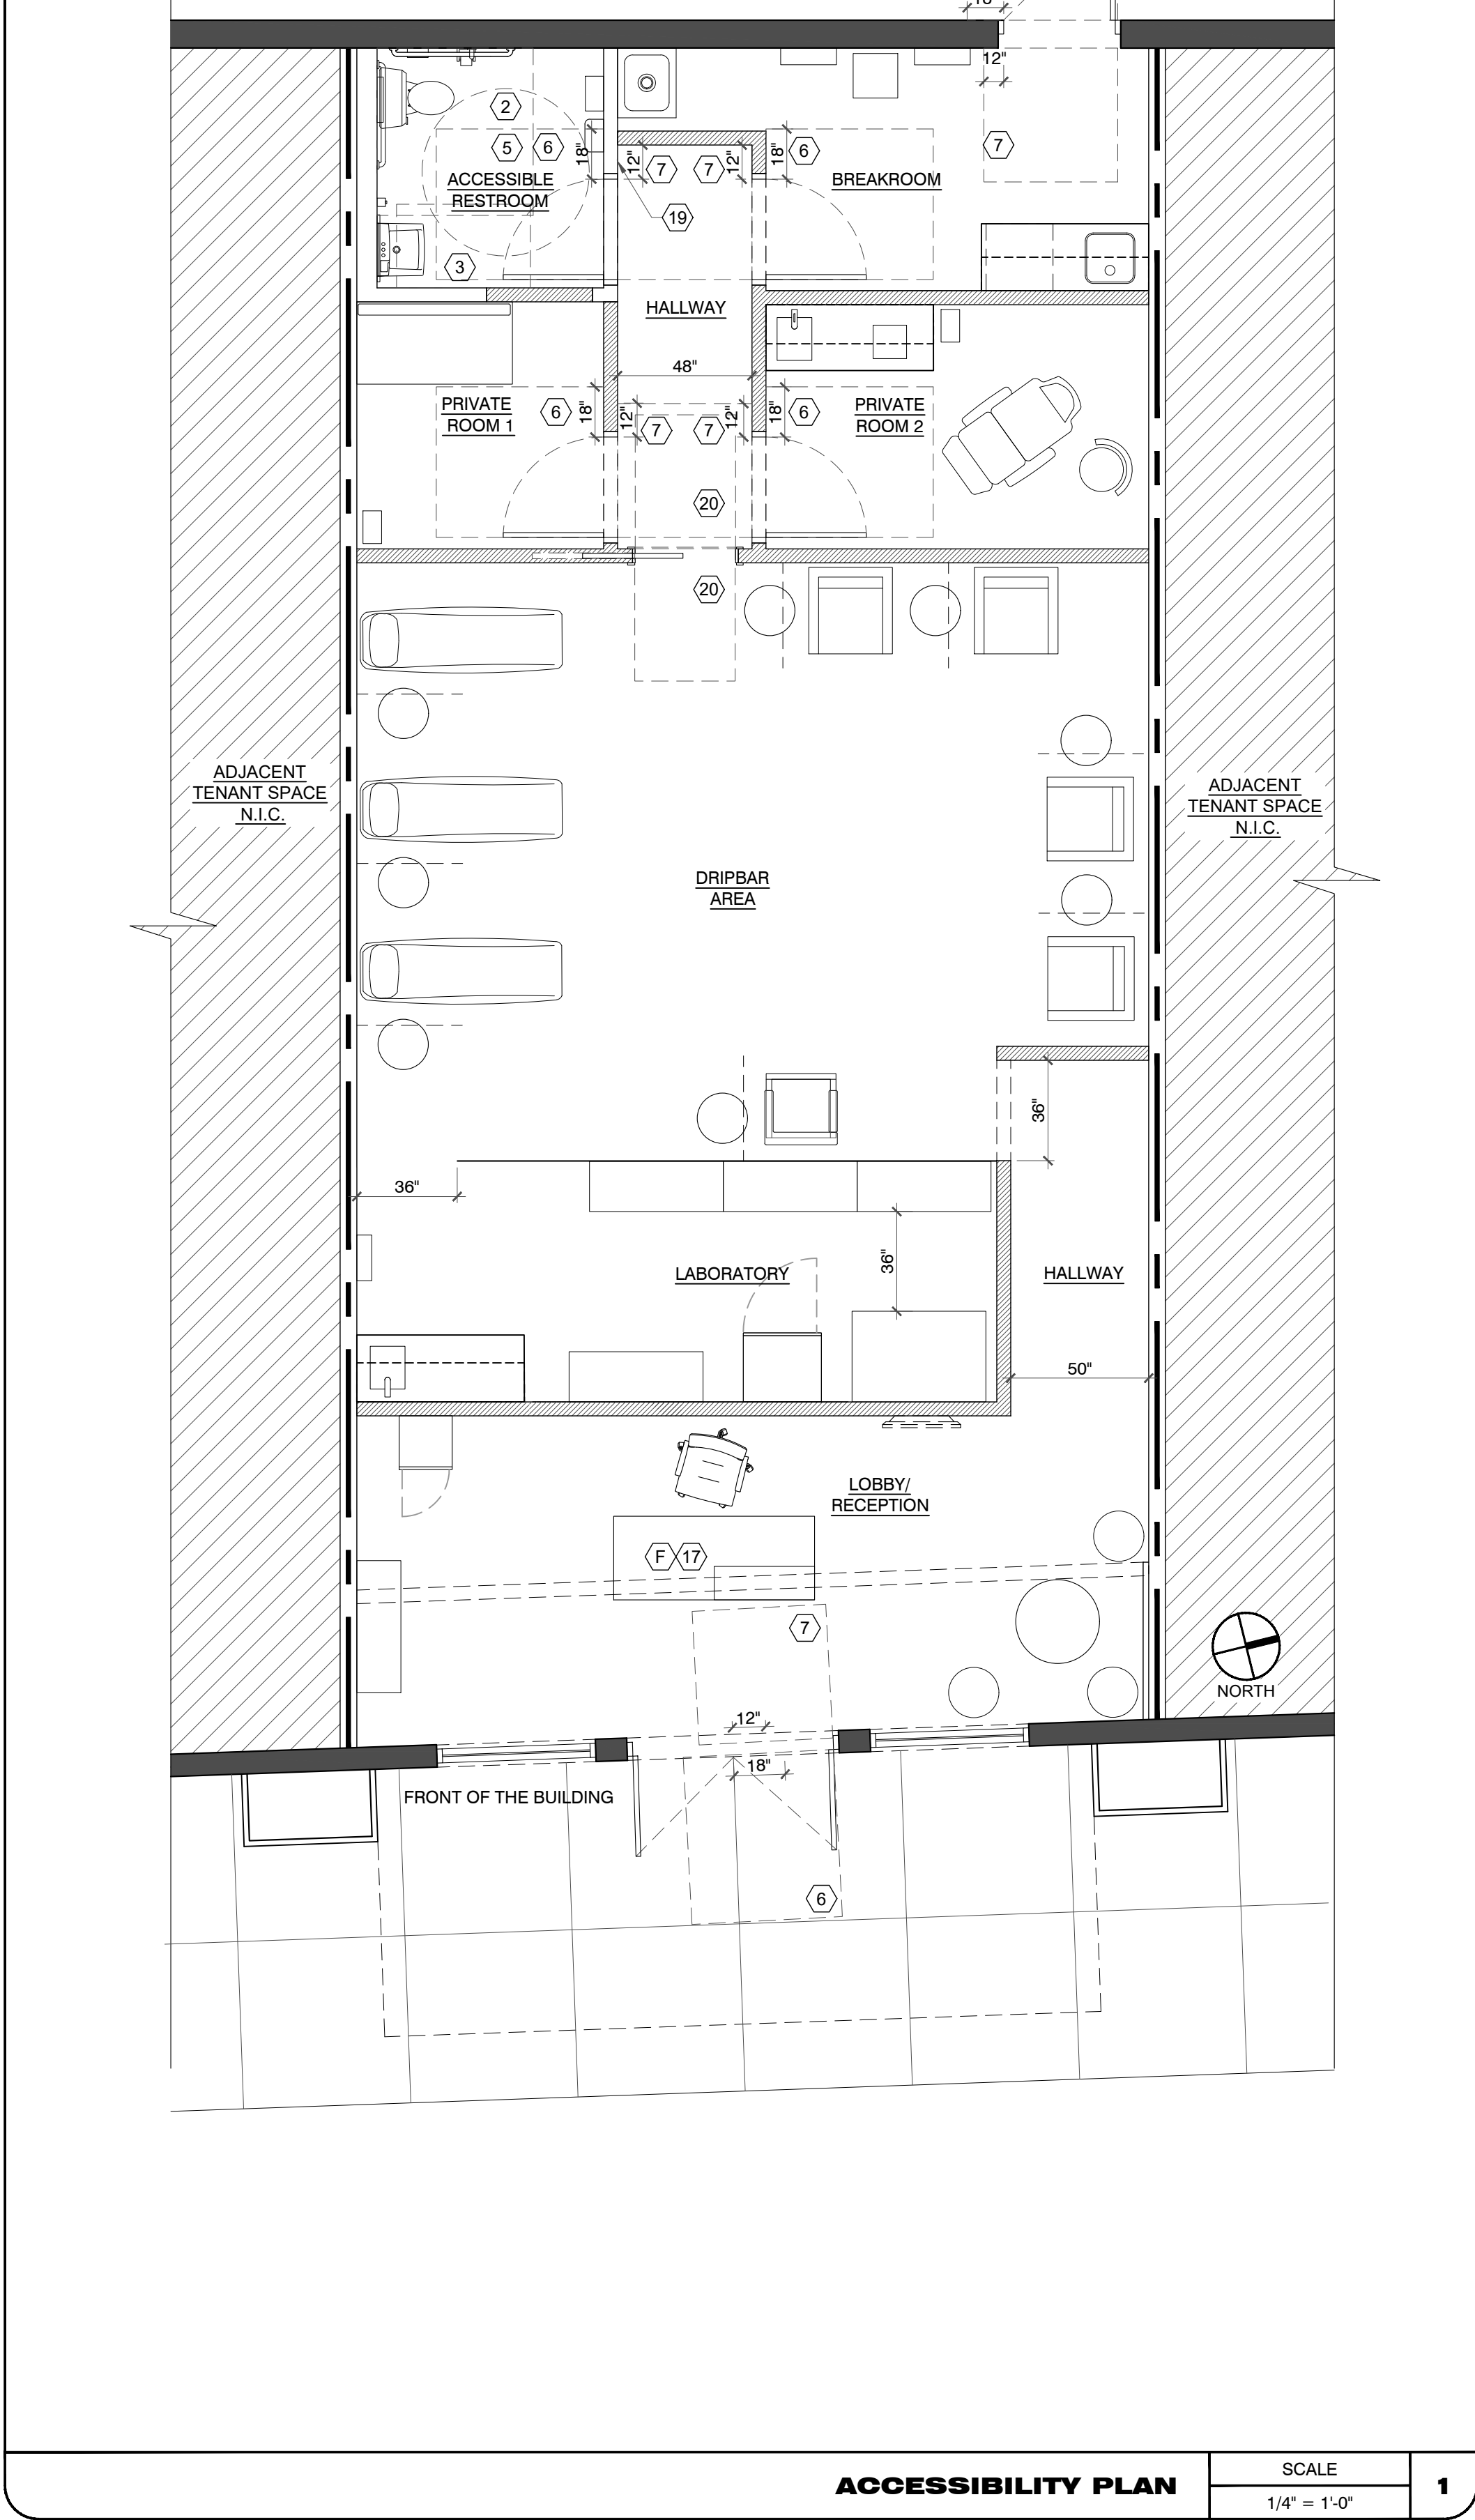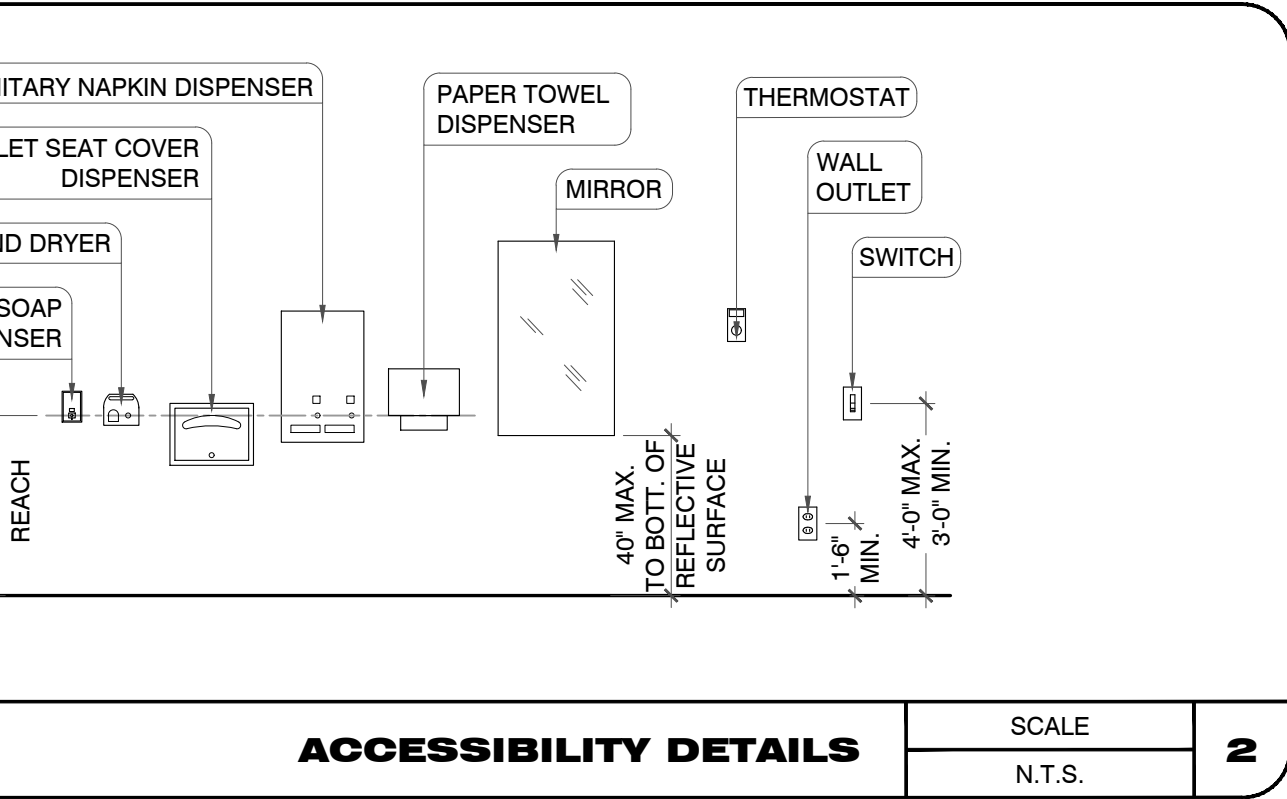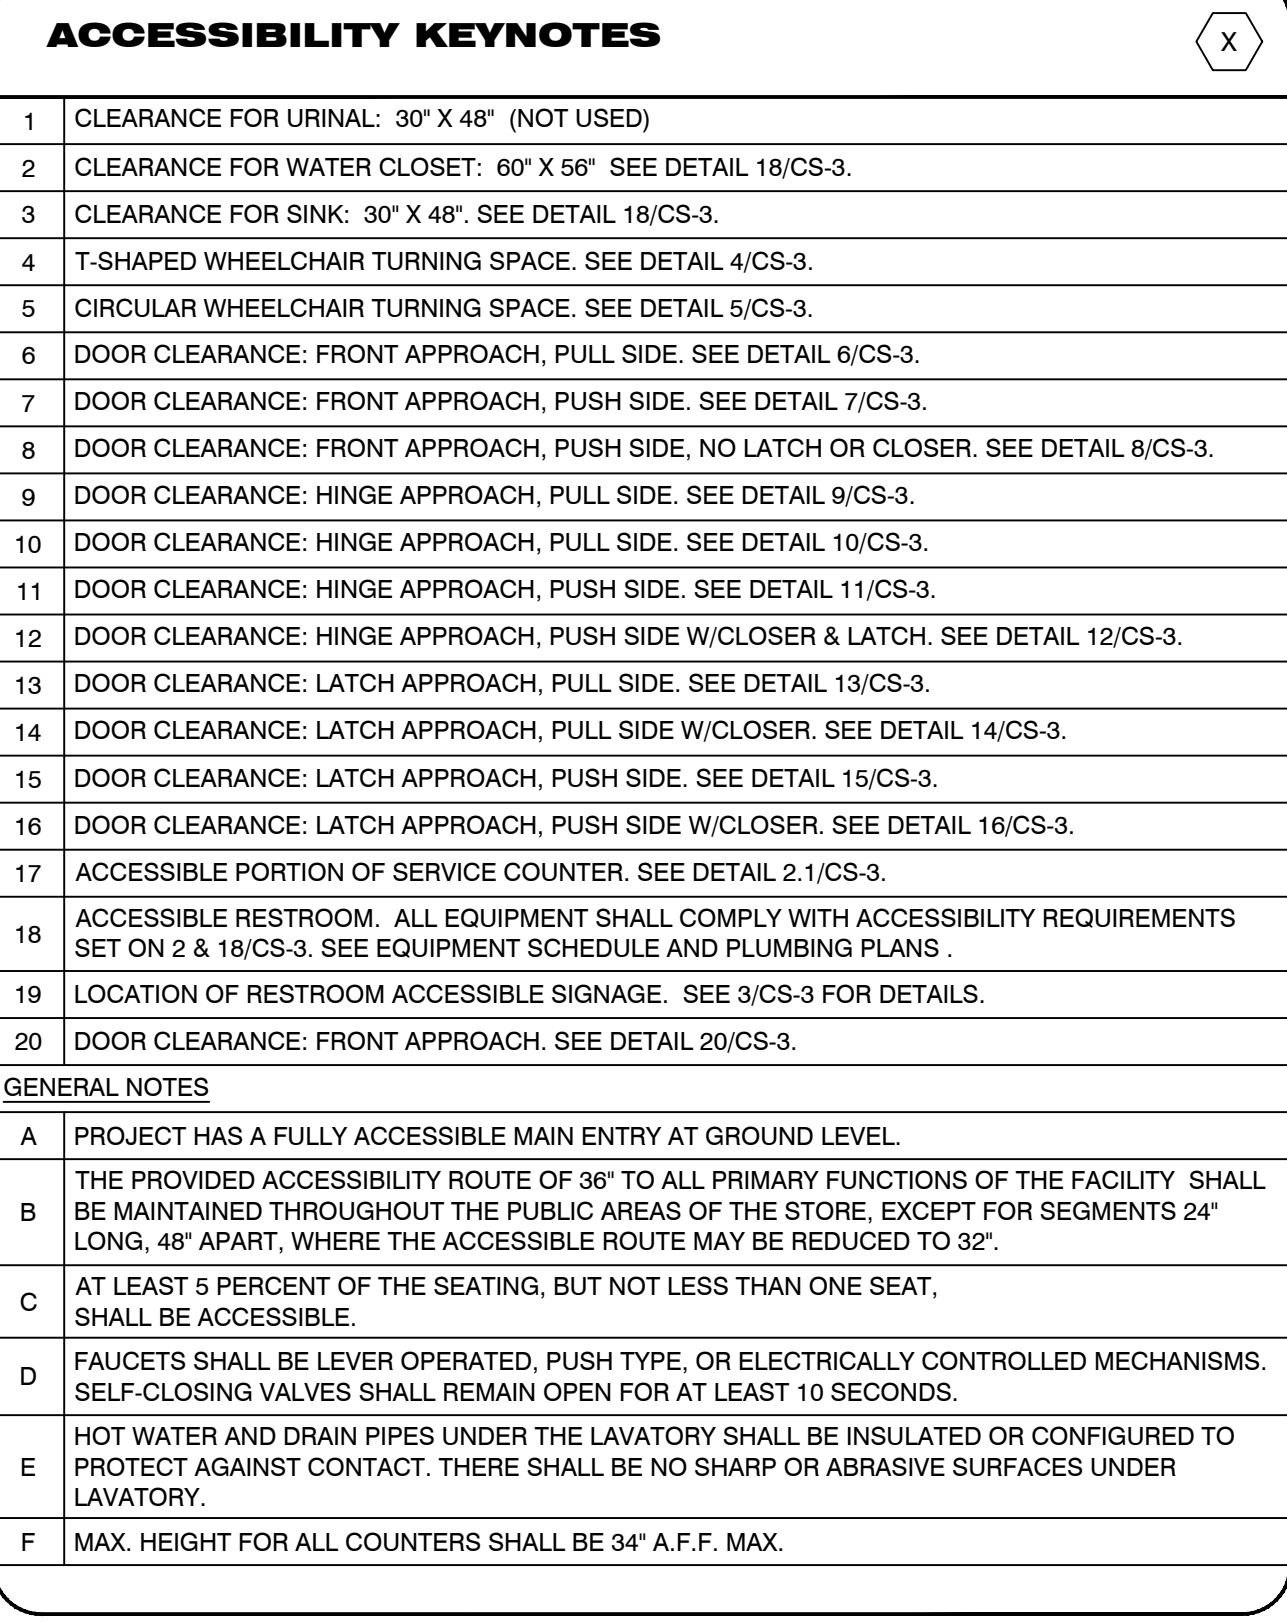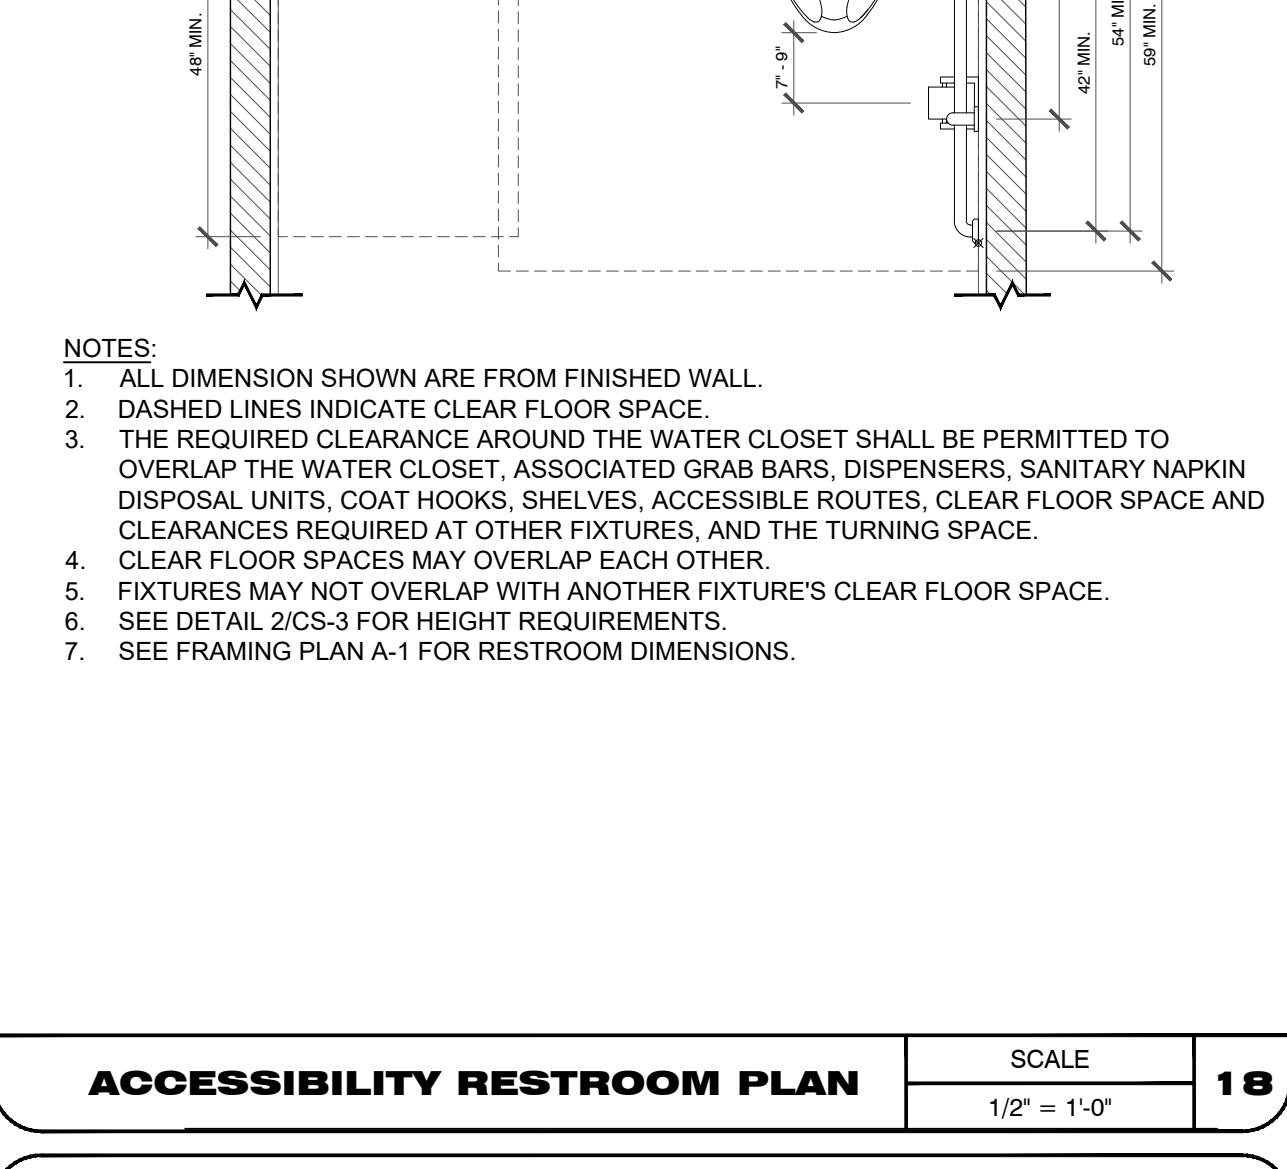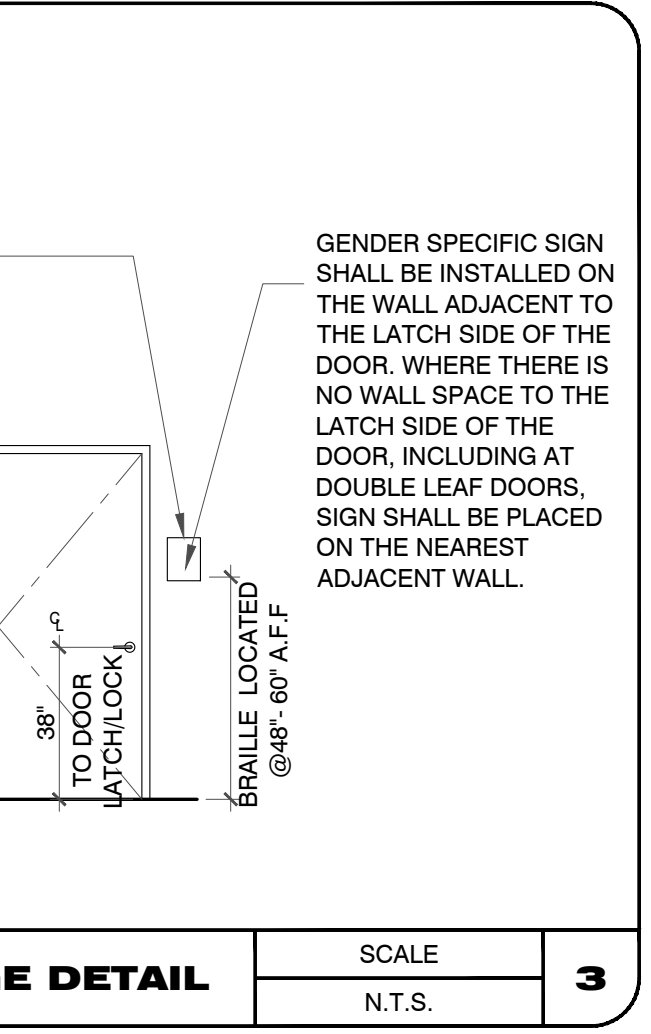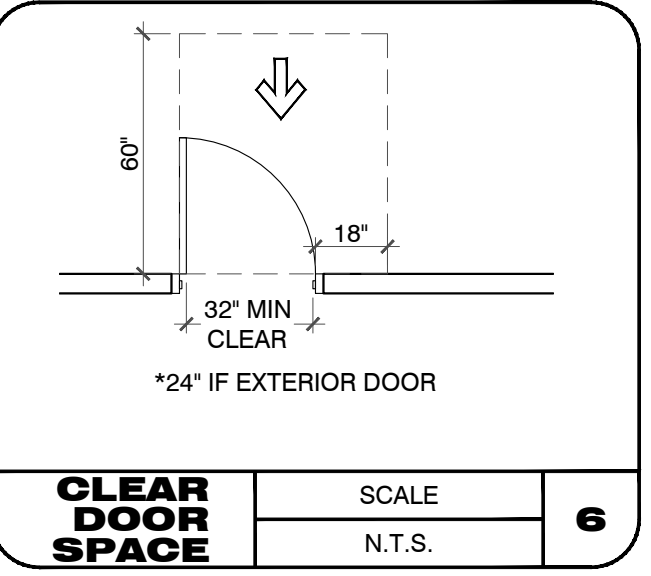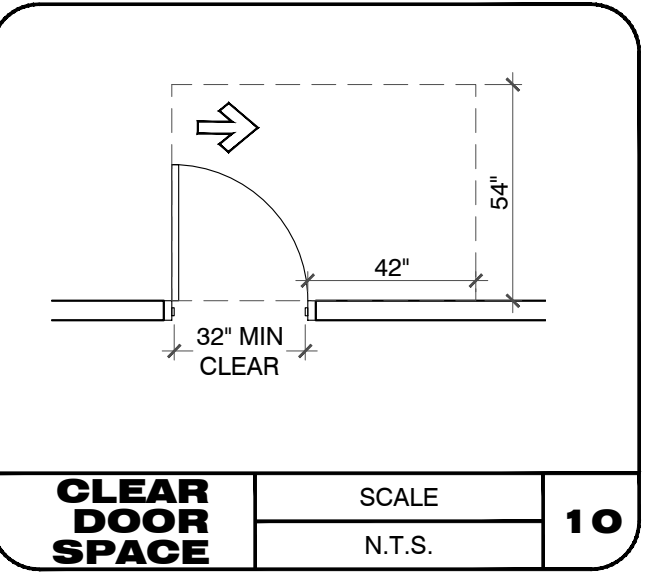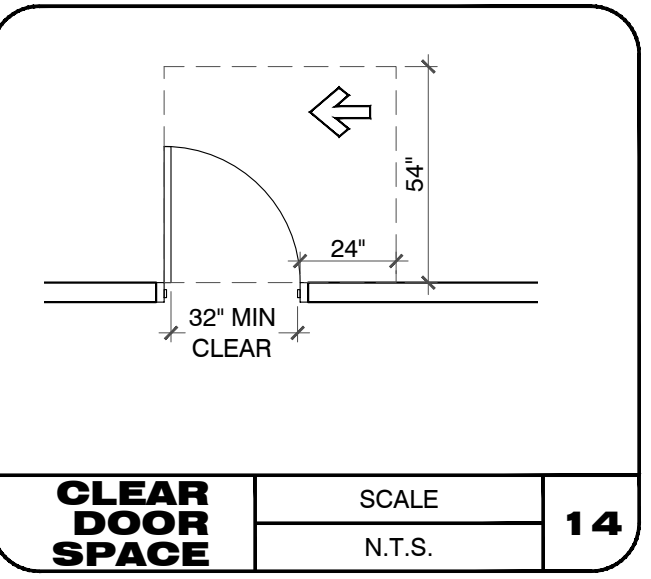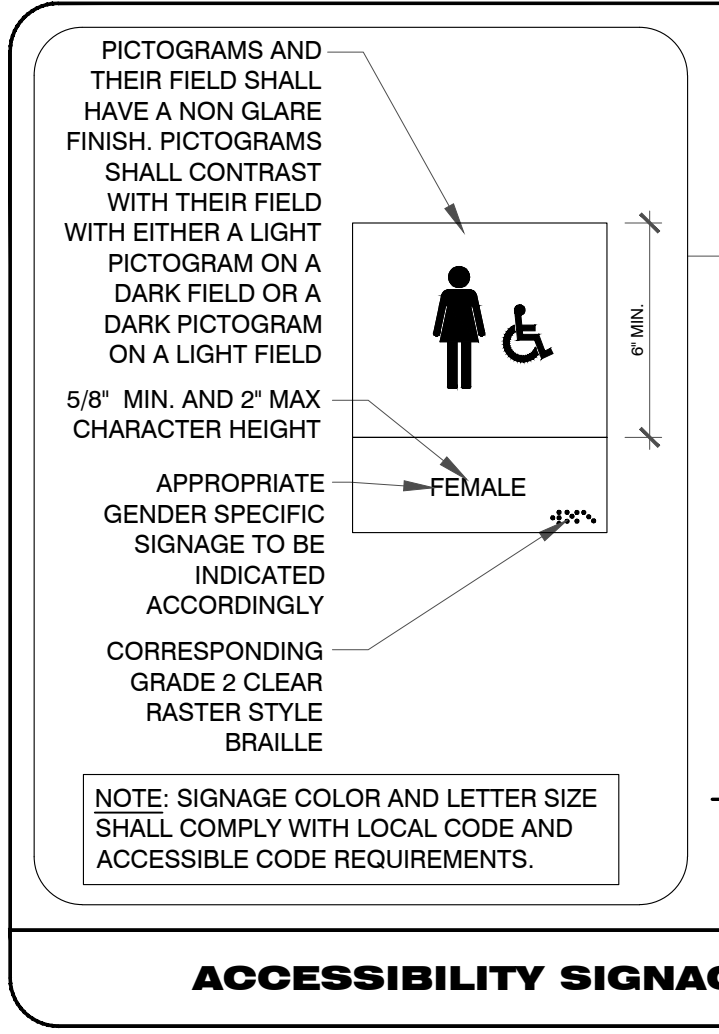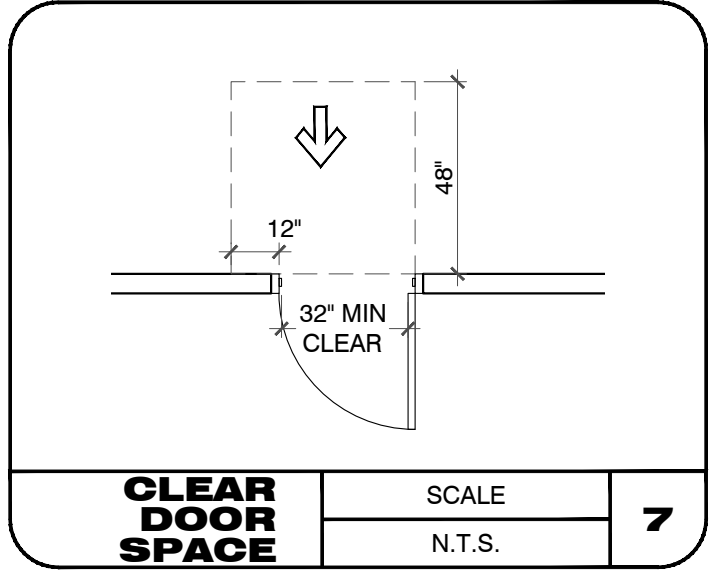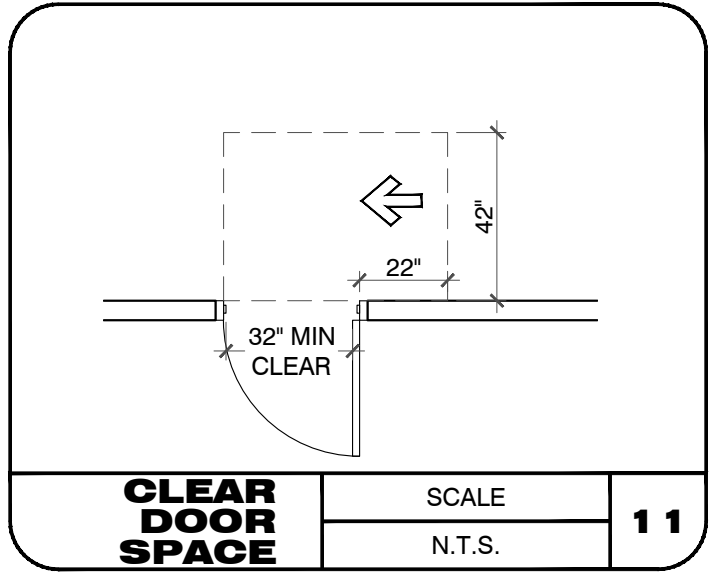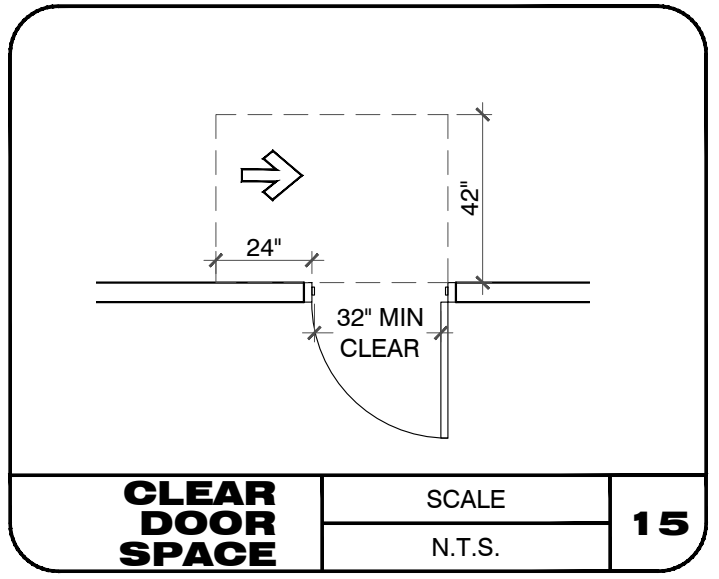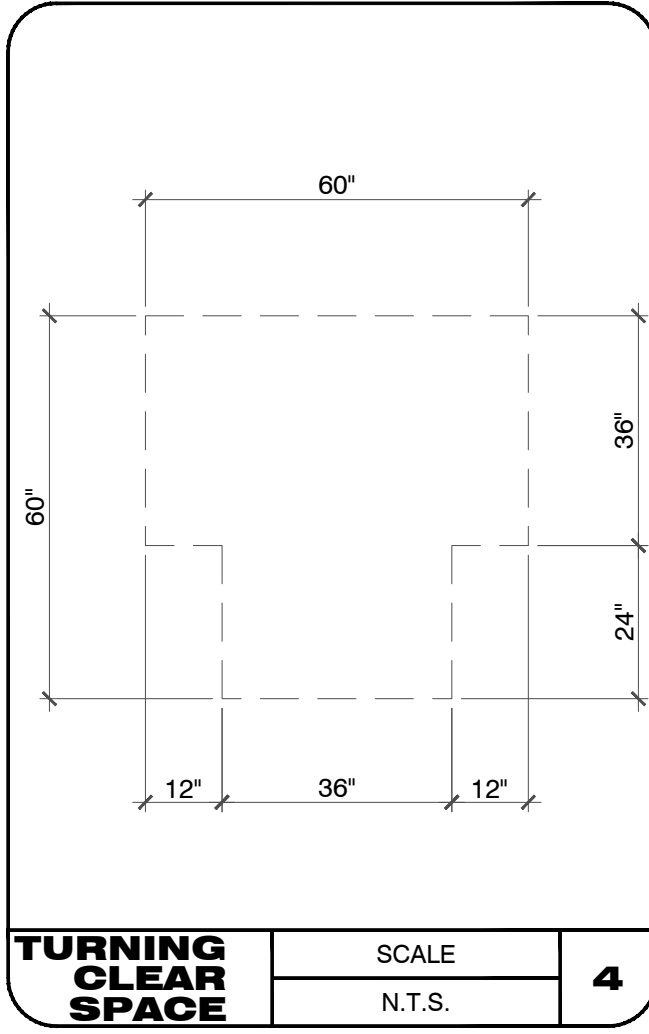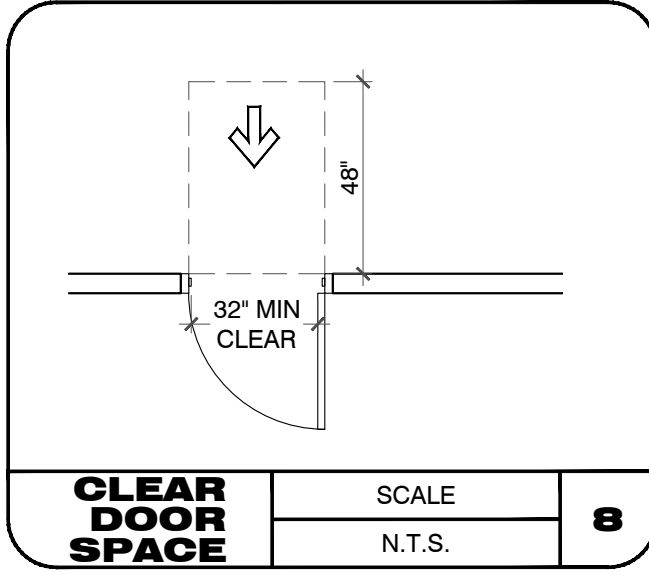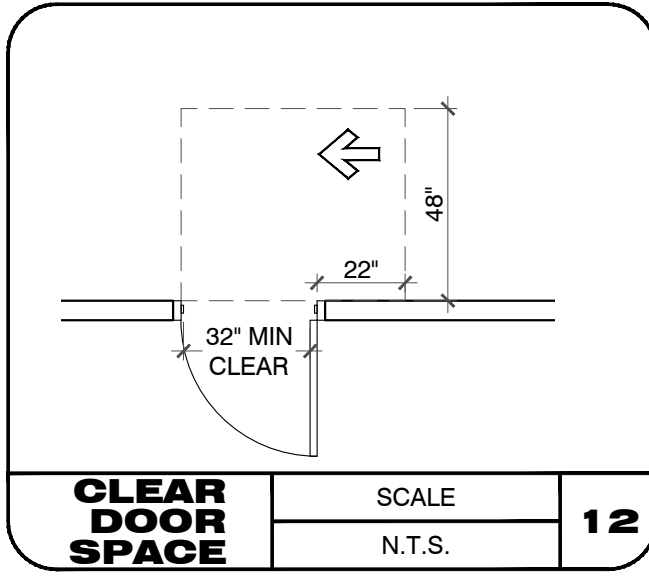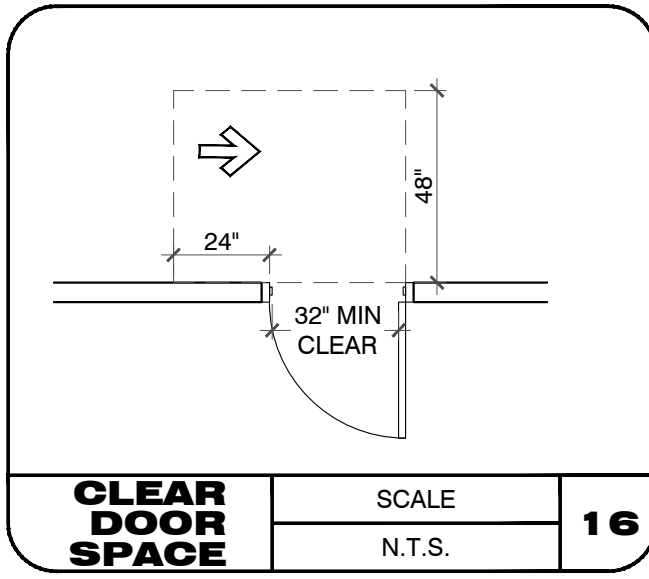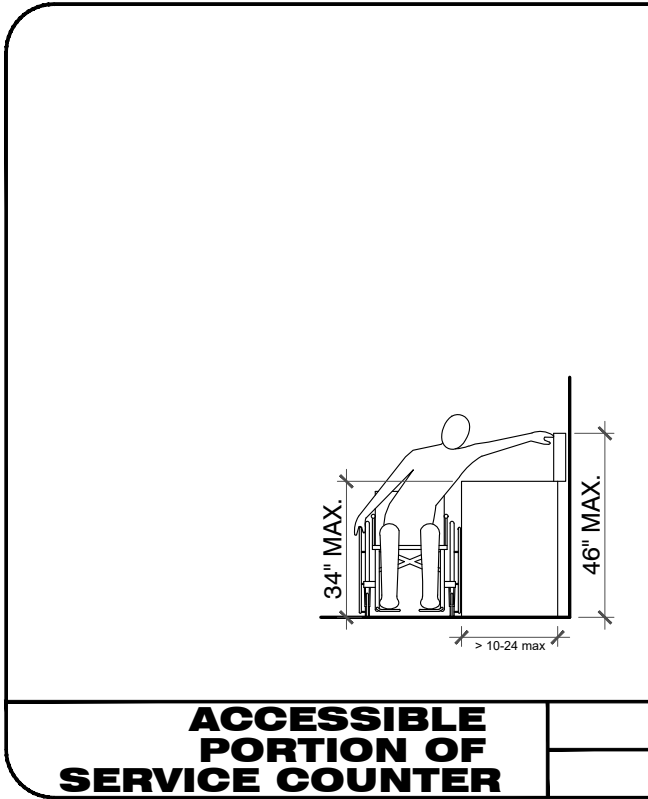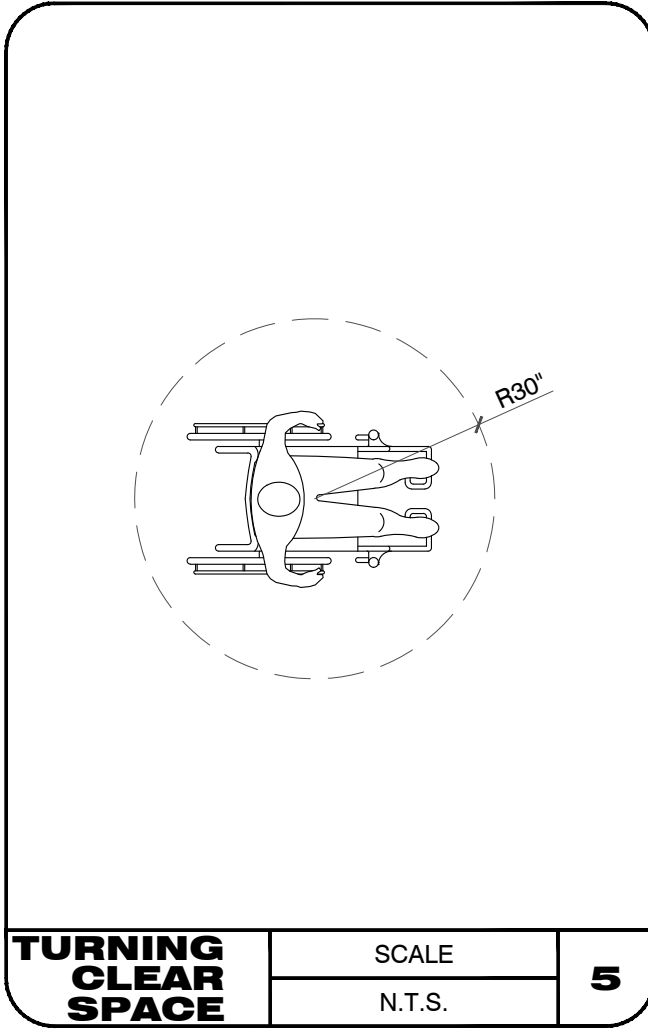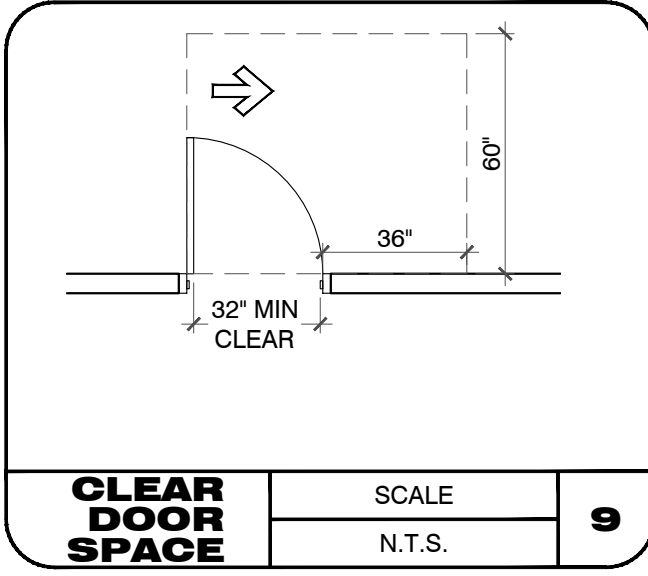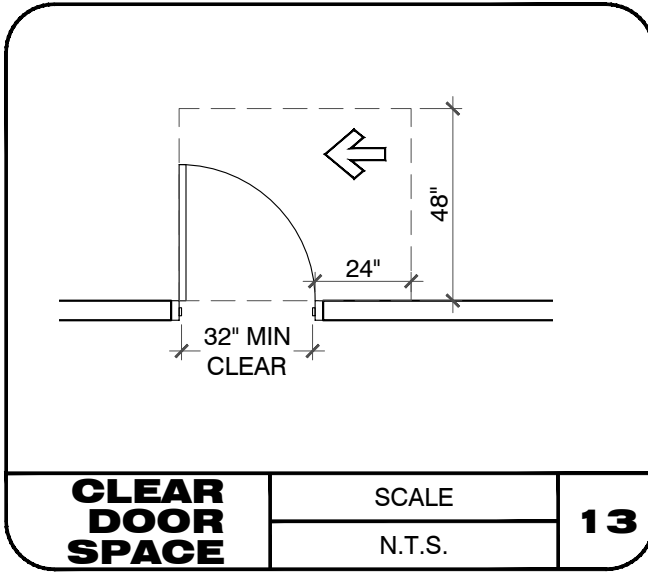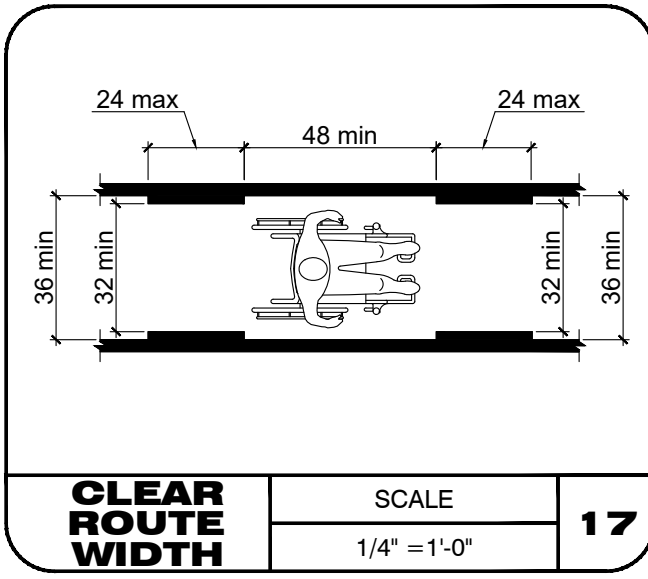

3330 N.E. 34th Street
Ft. Lauderdale, FL 33308 P: 954.566.5051
www.laskyarchitect.com
architects - interior designers
engineers - construction managers

THIS DOCUMENT IS THE PROPERTY OF LASKY ARCHITECT, P.A. AND SHALL NOT BE REPRODUCED WITHOUT THE WRITTEN CONSENT OF LASKY ARCHITECT, P.A.

PROJECT

THE DRIPBAR
930-M NW BLUE PKWY,
LEES SUMMIT, MO 64086

REVISIONS DATES:
10/20/21 BD COMMENTS
10/26/21 CLIENT AND LL COMMENTS

PROFESSIONAL SEAL
SCOTT L. LASKY A2019015157
REGISTERED ARCHITECT
STATE OF MISSOURI


ISSUE DATE: 08-25-2021
PROJECT #: 328P.1313P
DRAWN BY: AJ
CHECKED BY: CC-SL

ACCESSIBILITY PLAN

CS-3

System No. W-L-1158
November 30, 2004
F Ratings - 1 and 2 Hr (See Item 1)
T Rating - 0 Hr
I. Rating at Ambient - Less Than 1 CFM/sq ft

Drawing Not to Scale

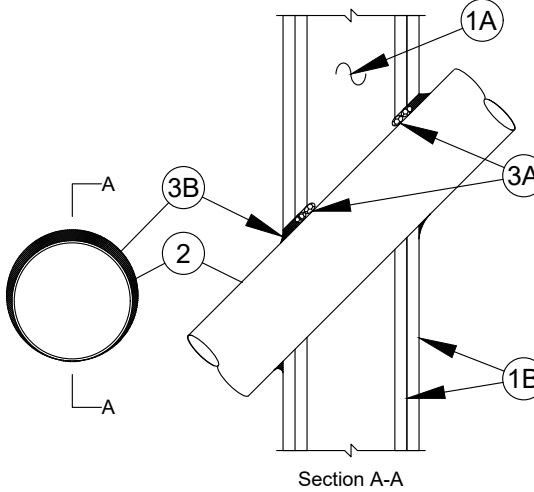

1. **Wall Assembly** - The 1 or 2 hour fire-rated gypsum board stud wall assembly shall be constructed of the materials and in the manner specified in the individual U300, U400 or V400 Series Wall and Partition Designs in the UL Fire Resistance Directory and shall include the following construction features:
- A. **Studs** - Wall framing may consist of either wood studs or steel channel studs. Wood studs to consist of nom 2 by 4 in. (51 by 102 mm) lumber spaced 16 in. (406 mm) OC. Steel studs to be min 2-1/2 in. (64 mm) wide and spaced max 24 in. (610 mm) OC.
 - B. **Gypsum Board*** - One or two layers of nom 1/2 or 5/8 in. (13 or 16 mm) thick gypsum board as specified in the individual Wall and Partition Design. Max diam of opening is 15-1/8 in. (394 mm).
 - The hourly F Rating of the firestop system is equal to the hourly fire rating of the wall assembly in which it is installed.
 - 1A. **Steel Sleeve** - (Optional, Not shown) Cylindrical sleeve fabricated from min 0.013 in. (0.330 mm) thick (No. 30 gauge) to max 0.056 in. (1.42 mm) (No. 16 gauge) galv steel sheet and having a min 1 in. (25 mm) lap along the longitudinal seam. Ends of sleeve to be trimmed flush with both surfaces of wall. Sleeve to be installed by coiling the sheet metal to a diam smaller than the through opening, inserting the coil through the opening and releasing the coil to let it uncoil against the circular cutouts in the gypsum board layers.
 - 2. **Through Penetrants** - One metallic pipe, tubing or conduit to be installed either concentrically or eccentrically within the firestop system. Pipe, tubing or conduit to be rigidly supported on both sides of wall assembly. The pipe, tubing or conduit may be installed at an angle not greater than 45 degrees perpendicular to the annular space shall be min 0 (point contact) in. to max 1-7/8 in. (48 mm). The following types and sizes of metallic pipe tubing or conduit may be used:
 - A. **Steel Pipe** - Nom 12 in. (305 mm) diam (or smaller) Schedule 40 (or heavier) steel pipe.
 - B. **Iron Pipe** - Nom 12 in. (305 mm) diam (or smaller) cast or ductile iron pipe.
 - C. **Conduit** - Nom 4 in. (102 mm) diam (or smaller) steel electrical metallic tubing or nom 6 in. diam (or smaller) steel conduit.
 - D. **Copper Tubing** - Nom 4 in. (102 mm) diam (or smaller) Type L (or heavier) copper tubing.
 - E. **Copper Pipe** - Nom 4 in. (102 mm) diam (or smaller) Type L (or heavier) copper pipe.
 - 3. **Firestop System** - The firestop system shall consist of the following:
 - A. **Packing Material** - (Optional) - Foam backer rod firmly packed into the opening as a permanent form. Packing material to be recessed from both surfaces of wall as required to accommodate the required thickness of fill material.
 - B. **Fill, Void or Cavity Material*** - (Caulk) Min 1/2 in. (13 mm) thickness of fill material applied within the annulus, flush with both surfaces of wall. When annular space exceeds 1/2 in. (13 mm), the min thickness of fill material is 5/8 in. (16 mm). Additional fill material to be installed such that a min 3/8 in. (10 mm) void is applied at the pipe/wall interface at the point contact location.
- TREMCO INC - TREMstop Intumescent Acrylic
*Bearing the UL Classification Mark


Reproduced courtesy of Underwriters Laboratories, Inc.
See UL Fire Resistance Directory for additional information.



Page 1 of 1

System No. W-L-2463
November 03, 2005
F Ratings - 1 and 2 Hr (See Item 1)
T Rating - 0 Hr

Drawing Not to Scale

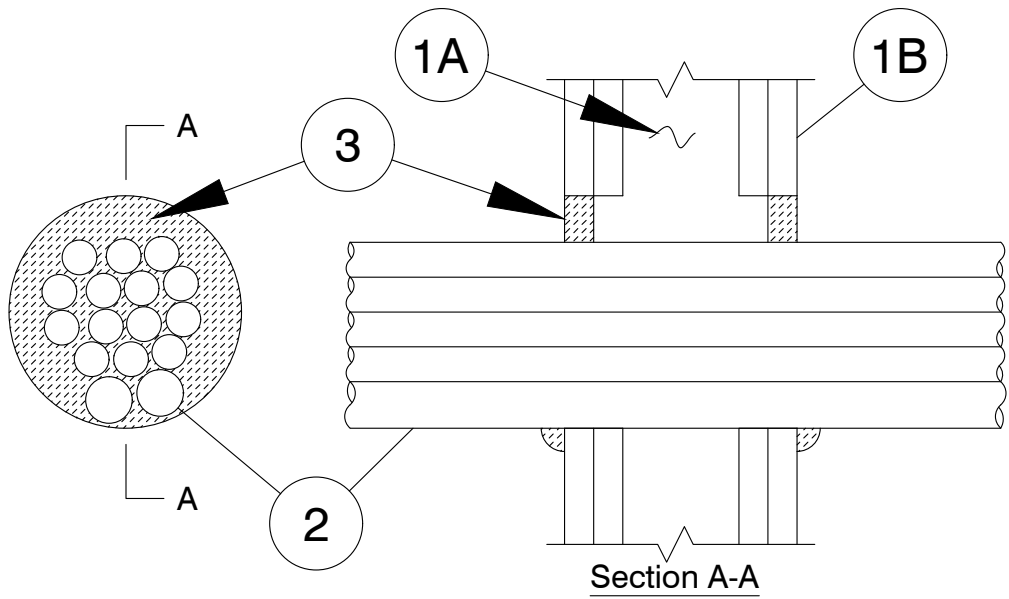

1. **Wall Assembly** - The 1 or 2 hr fire rated gypsum board/stud wall assembly shall be constructed of the materials and in the manner specified in the individual U300, U400 or V400 Series Wall and Partition Designs in the UL Fire Resistance Directory and shall include the following construction features:
- A. **Studs** - Wall framing may consist of either wood studs or steel channel studs. Wood studs to consist of nom 2 by 4 in. (51 by 102 mm) lumber spaced 16 in. (406 mm) OC. Steel studs to be min 2-1/2 in. (64 mm) wide and spaced max 24 in. (610 mm) OC.
 - B. **Gypsum Board*** - 5/8 in. (16 mm) thick, 4 ft (1.22 m) wide with square or tapered edges. Thickness, type, number of layers and fasteners as required in the individual Wall and Partition Design. Max diam of opening is 5 in. (127 mm).
 - The hourly F and T Ratings of the firestop system are equal to the hourly fire rating of the wall assembly in which it is installed.
 - 2. **Through Penetrant** - Multiple nonmetallic tubing for use in closed (process or supply) piping systems. Max 4 in. (102 mm) diam bundle of tubes in opening, tightly bundled. The annular space between bundle of tubes and periphery of opening shall be min 0 in. (point contact) to max 1 in. (25 mm). Tubing to be rigidly supported on both sides of wall assembly. The following types of tubing may be used:
 - A. **Crosslinked Polyethylene (PEX) Tubing** - Nom 1 in. (25 mm) diam (or smaller) SDR 9 PEX tubing for use in closed (process or supply) piping systems.
 - 3. **Fill, Void or Cavity Materials*** - **Caulk** - Min 5/8 in. (16 mm) thickness of fill material applied within annulus, flush with each surface of wall. Min 5/8 in. (16 mm) thickness of fill material applied into interstices of tubes to maximum extent possible, on both sides of wall. Min 1/2 in. (13 mm) diam bead of caulk applied to the tubing/gypsum interface at the point contact location on both sides of wall.
- TREMCO INC - TREMstop Intumescent Acrylic
*Bearing the UL Classification Mark


Reproduced courtesy of Underwriters Laboratories, Inc.
See UL Fire Resistance Directory for additional information.



Page 1 of 1

System No. W-L-8036
February 07, 2003
F Ratings - 1 and 2 Hr (See Item 1B)
T Rating - 0 Hr

Drawing Not to Scale

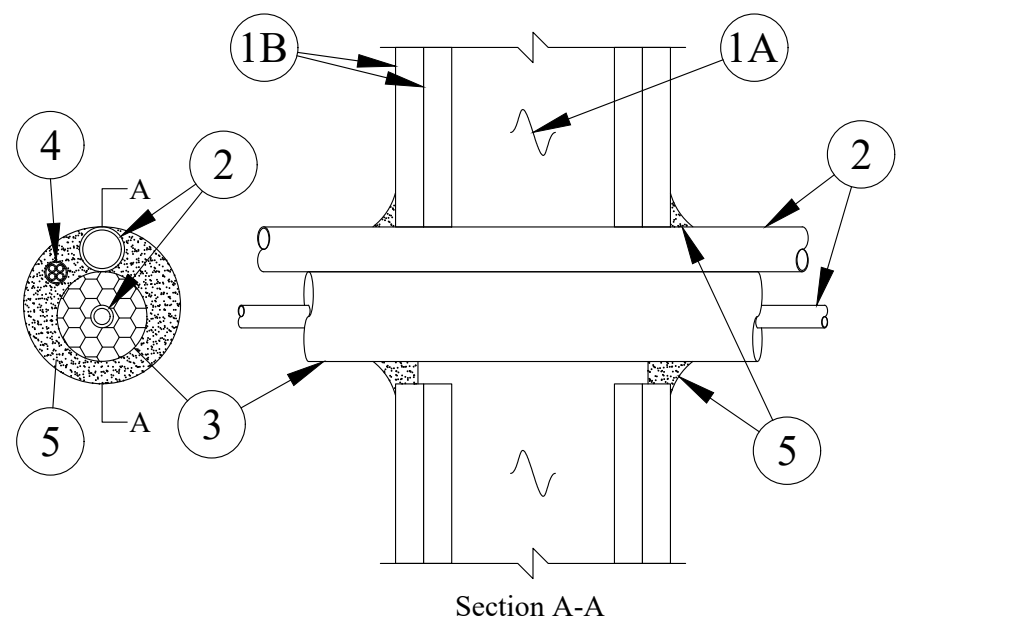

1. **Wall Assembly** - The 1 or 2 hr fire-rated gypsum board/stud wall assembly shall be constructed of the materials and in the manner described in the individual U300 or U400 Series Wall or Partition Design in the UL Fire Resistance Directory and shall include the following construction features:
- A. **Studs** - Wall framing may consist of either wood studs or steel channel studs. Wood studs to consist of nom 2 by 4 in. lumber spaced 16 in. O.C. with nom 2 by 4 in. lumber end plates and cross braces. Steel studs to be min 2-1/2 in. wide and spaced max 24 in. O.C.
 - B. **Gypsum Board*** - 5/8 in. thick, 4 ft wide with square or tapered edges. The gypsum board type, thickness, number of layers, fastener type and sheet orientation shall be as specified in the individual U300 or U400 Series Design in the UL Fire Resistance Directory. Max diam of opening is 3-1/2 in.
 - The hourly F Rating of the firestop system is equal to the hourly fire rating of the wall assembly in which it is installed.
 - 2. **Through Penetrant** - A max of two pipes or tubing to be installed within the opening. Of the two pipes, or tubing, only one of the pipes or tubing shall have a nom diam greater than 1/2 in. The annular space between pipes or tubing and periphery of opening shall be min 0 in. (point contact) to max 1/2 in. Pipes or tubing to be rigidly supported on both sides of wall assembly. The following types and sizes of metallic pipes or tubing may be used:
 - A. **Steel Pipe** - Nom 1 in. diam (or smaller) Schedule 10 (or heavier) steel pipe.
 - B. **Iron Pipe** - Nom 1 in. diam (or smaller) cast or ductile iron pipe.
 - C. **Copper Tubing** - Nom 1 in. diam (or smaller) Type L (or heavier) copper tubing.
 - D. **Copper Pipe** - Nom 1 in. diam (or smaller) Regular (or heavier) copper pipe.
 - 3. **Tube Insulation - Plastics*** - Nom 3/4 in. thick acrylonitrile butadiene/polyvinyl chloride (AB/PVC) flexible foam furnished in the form of tubing. The tube insulation may be installed on a max of one pipe or tubing. The annular space between penetrating item and periphery of opening shall be min 1/2 into max 3/4 in. The space between pipes or tubing shall be 0 in. (point contact)
 - See **Plastics** (QMF22) category in the Recognized Component Directory for names for manufacturers. Any Recognized Component tube insulation material meeting the above specifications and having a UL 94 Flammability Classification of 94-5VA may be used.
 - 4. **Cables** - One 4 pair No. 18 AWG (or smaller) thermostat cable with polyvinyl chloride (PVC) insulation and jacket materials. Cable to be spaced a min 0 in. (point contact) to max 1/2 in. from the other penetrants. The space between the cable and the periphery of the opening shall be a min 0 in. (point contact) to max 1/2 in. Cable to be rigidly supported on both sides of wall assembly.
 - 5. **Fill, Void or Cavity Material*** - **Sealant** - Min 1/2 in. thickness of fill material applied within annulus, flush with both surfaces of wall. Additional fill material to be to be forced into interstices within groups of penetrating items to max extent possible and installed such that a min 1/4 in. thick crown is formed around the penetrating items and lapping 1/4 in. beyond the periphery of the opening.
- TREMCO INC - TREMstop Intumescent Acrylic
*Bearing the UL Classification Mark


Reproduced courtesy of Underwriters Laboratories, Inc.
See UL Fire Resistance Directory for additional information.



Page 1 of 1

System No. BW-S-0006
March 12, 2004
Assembly Ratings - 1 and 2 Hr (See Item 2)
Joint Width - 1 In. (25 mm) Max

Drawing Not to Scale

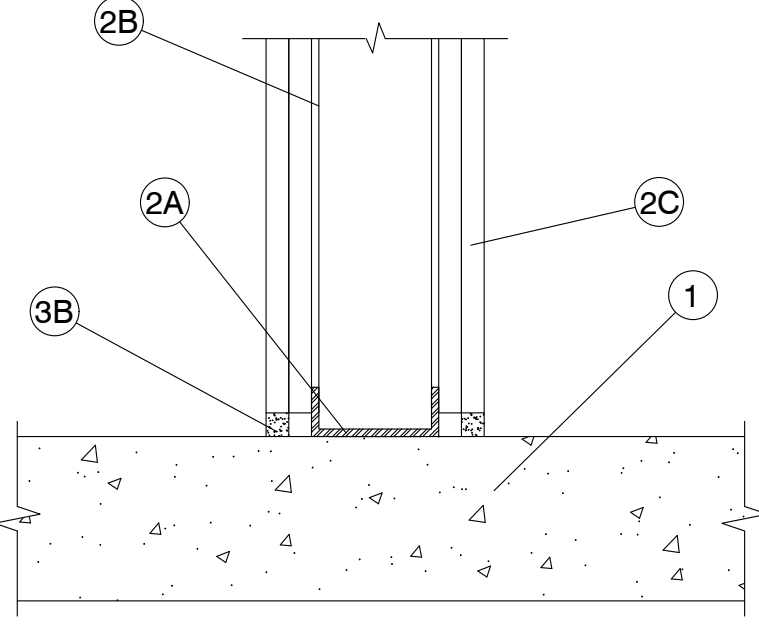

1. **Floor Assembly** - Min 4-1/2 in. (114 mm) thick reinforced lightweight or normal weight (100-150 pcf (1600-2400 kg/cu meter)) structural concrete. Floor may also be constructed of any 6 in. (152 mm) thick UL Classified hollow-core **Precast Concrete Units***. See **Precast Concrete Units** category in the Fire Resistance Directory for names of manufacturers.
2. **Wall Assembly** - The 1 or 2 hr fire-rated gypsum board/steel stud wall assembly shall be constructed of the materials and in the manner specified in the individual U400 or V400 Series Wall or Partition Design in the UL Fire Resistance Directory. In addition, the wall may incorporate a head-of-wall joint system constructed as specified in the HW Series Joint Systems in the UL Fire Resistance Directory. The wall shall include the following construction features:
- A. **Steel Floor Runner** - Floor runners of wall assembly shall consist of min No. 25 gauge galv steel channels sized to accommodate steel studs (Item 2B). Floor runners to be provided with min 1-1/4 in. (32 mm) flanges. Runners secured with steel fasteners spaced 12 in. (305 mm) OC.
 - B. **Studs** - Steel studs to be min 2-1/2 in. (64 mm) wide. Studs cut 1/2 to 3/4 in. (13 to 19 mm) less in length than assembly height with bottom nesting in, resting on and fastened to floor runner with metal screws. Stud spacing not to exceed 24 in. (610 mm) OC.
 - C. **Gypsum Board*** - Gypsum board installed to a min total thickness of 5/8 in. (16 mm) or 1-1/4 in. (32 mm) on each side of wall for a 1 or 2 hr rated wall, respectively. Wall to be constructed as specified in the individual U400 or V400 Series Design in the UL Fire Resistance Directory except that a max 1 in. (25 mm) gap shall be maintained between the bottom of the gypsum board and the top of the concrete floor.
 - The hourly fire rating of the joint system is equal to the hourly fire rating of the wall.
 - 3. **Joint System** - Max separation between top of floor and bottom of gypsum board is 1 in. (25 mm). The joint system consists of a packing material and a fill material, as follows:
 - A. **Packing Material** - (Optional, Not Shown) - Foam backer rod firmly packed into the gap between the bottom of the gypsum board and the top of the concrete floor and recessed from each surface of the wall to accommodate the required thickness of fill material.
 - B. **Fill, Void or Cavity Material*** - **Sealant** - Min 1/2 in. (13 mm) thickness of fill material installed on each side of the wall between the bottom of the gypsum board and the top of the concrete floor, flush with each surface of the wall.
- TREMCO INC - TREMstop Acrylic, TREMstop Intumescent Acrylic (IA) or TREMstop Silicone (Fyre-Sil)
*Bearing the UL Classification Mark


Reproduced courtesy of Underwriters Laboratories, Inc.
See UL Fire Resistance Directory for additional information.



Page 1 of 1

Wall Opening Protective Materials (CLIV)
CLIV R 13432
F Ratings - 1 and 2 Hrs. for TREMstop MP; 2 Hrs. for TREMstop Electrical Box
Inserts

Drawing Not to Scale

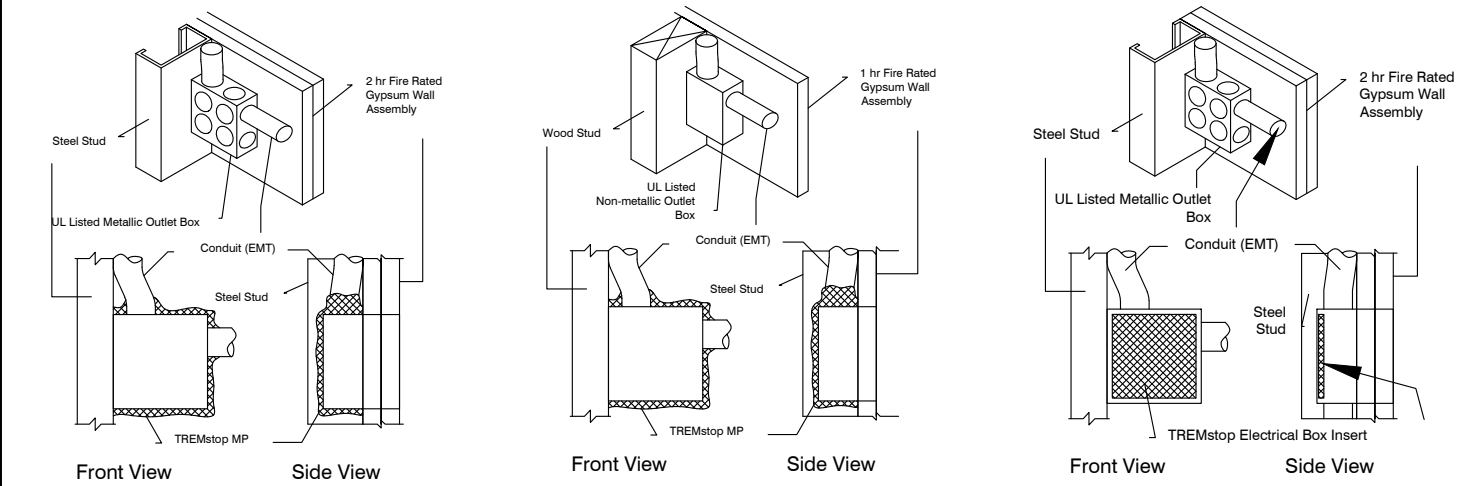

TREMstop MP - Metallic Outlet Boxes (Shown above, left detail)

Type TREMstop MP moldable putty pads for use with max 4-11/16 by 4-11/16 in. flush device UL Listed **Metallic** Outlet Boxes installed with **steel cover plates** in 2 hr fire rated gypsum board wall assemblies framed with min 3-1/2 in. deep **steel studs** and constructed of the materials and in the manner specified in the individual U400 and V400 Series Wall and Partition Designs in the Fire Resistance Directory. Min 0.2 in. thick moldable putty pads are to be installed to completely cover the exterior surfaces of the outlet box (except for the side of the outlet box against the stud) and completely seal against the stud and gypsum board within the stud cavity. An additional 3/4 in. ball of putty pad material used to plug the end of each electrical metallic tube or conduit at its connection to the box. The putty pads may be installed with the release liner intact on the outside of the pad with the exception of any overlaps, in which case the liner is to be removed from the bottom layer. When moldable putty pad outlet box protective material is used on boxes on both sides of wall as directed, the horizontal separation between boxes on opposite sides of the wall may be less than 24 in. provided that the boxes are not installed back to back.

Type TREMstop MP moldable putty pads for use with max 4 by 4 by 2-1/8 in. flush device UL Listed **Metallic** Outlet Boxes installed with **steel or plastic cover plates** in 2 hr fire rated gypsum board wall assemblies framed with min 3-1/2 in. deep **steel studs** and constructed of the materials and in the manner specified in the individual U400 and V400 Series Wall and Partition Designs in the Fire Resistance Directory. Min 0.2 in. thick moldable putty pads are to be installed to completely cover the exterior surfaces of the outlet box (except for the side of the outlet box against the stud) and completely seal against and lap min 1/2 in. onto the stud and gypsum board within the stud cavity. An additional 3/4 in. ball of putty pad material used to plug the end of each electrical metallic tube or conduit at its connection to the box. The putty pads may be installed with the release liner intact on the outside of the pad with the exception of any overlaps, in which case the liner is to be removed from the bottom layer. When moldable putty pad outlet box protective material is used on boxes on both sides of wall as directed, the horizontal separation between boxes on opposite sides of the wall may be less than 24 in. provided that the boxes are not installed back to back.

Type TREMstop MP moldable putty pads for use with max 14-1/4 by 4-1/2 by 2-1/2 in. flush device UL Listed **Metallic** Outlet Boxes installed with **steel cover plates** in 2 hr fire rated gypsum board wall assemblies framed with min 3-1/2 in. deep **steel studs** and constructed of the materials and in the manner specified in the individual U400 and V400 Series Wall and Partition Designs in the Fire Resistance Directory. Min 0.2 in. thick moldable putty pads are to be installed to completely cover the exterior surfaces of the outlet box (except for the side of the outlet box against the stud) and completely seal against and lap min 1/2 in. onto the stud and gypsum board within the stud cavity. An additional 3/4 in. ball of putty pad material used to plug the end of each electrical metallic tube or conduit at its connection to the box. The putty pads may be installed with the release liner intact on the outside of the pad with the exception of any overlaps, in which case the liner is to be removed from the bottom layer. When moldable putty pad outlet box protective material is used on boxes on both sides of wall as directed, the horizontal separation between boxes on opposite sides of the wall may be less than 24 in. provided that the boxes are not installed back to back.

Reproduced courtesy of Underwriters Laboratories, Inc.
See UL Fire Resistance Directory for additional information.



Page 1 of 2

Wall Opening Protective Materials (CLIV)
CLIV R 13432
F Ratings - 1 and 2 Hrs. for TREMstop MP; 2 Hrs. for TREMstop Electrical Box
Inserts

Drawing Not to Scale

TREMstop MP - Non-metallic Outlet Boxes (Shown above, center detail)

Type TREMstop MP moldable putty pads for use with max 4 by 3-3/4 by 3 in. deep UL Listed **Nonmetallic** Outlet Boxes manufactured by **Carlton** Electrical Products, made of PVC and bearing a 2 hr rating under the "Outlet Boxes and Fittings Classified for Fire Resistance category in the Fire Resistance Directory. Boxes installed with **steel cover plates**, for use in 1 hr rated gypsum board wall assemblies framed with min 3-1/2 in. wide **wood studs** and constructed as specified in the individual U300 Series Wall and Partition Designs in the Fire Resistance Directory. Min 0.2 in. thick moldable putty pads are to be installed to completely cover the exterior surfaces of the outlet box (except for the side of the outlet box against the stud) including nailing tabs and completely seal against and lap min 1/2 in. onto the stud, gypsum board and nonmetallic sheathed cable at its connection to the box. The putty pads may be installed with the release liner intact on the outside of the pad with the exception of any overlaps, in which case the liner is to be removed from the bottom layer. When moldable putty pad outlet box protective material is used on boxes on both sides of wall as directed, the horizontal separation between boxes on opposite sides of the wall may be less than 24 in. provided that the boxes are not installed back to back.

Type TREMstop MP moldable putty pads for use with max 4 by 3-3/4 by 3 in. deep UL Listed **Nonmetallic** Outlet Boxes manufactured by **Carlton** Electrical Products, made of PVC and bearing a 2 hr rating under the "Outlet Boxes and Fittings Classified for Fire Resistance category in the Fire Resistance Directory. Boxes installed with **plastic cover plates**, for use in 2 hr rated gypsum board wall assemblies framed with min 3-1/2 in. wide **wood studs** and constructed as specified in the individual U300 Series Wall and Partition Designs in the Fire Resistance Directory. Min 0.2 in. thick moldable putty pads are to be installed to completely cover the exterior surfaces of the outlet box (except for the side of the outlet box against the stud) including nailing tabs and completely seal against and lap min 1/2 in. onto the stud, gypsum board and nonmetallic sheathed cable at its connection to the box. The putty pads may be installed with the release liner intact on the outside of the pad with the exception of any overlaps, in which case the liner is to be removed from the bottom layer. When moldable putty pad outlet box protective material is used on boxes on both sides of wall as directed, the horizontal separation between boxes on opposite sides of the wall may be less than 24 in. provided that the boxes are not installed back to back.

TREMstop Electrical Box Inserts (Shown above, right detail)

TREMstop Electrical Box Inserts, for use with max 4-11/16 by 4-11/16 by 2-1/8 in. flush device UL Listed **Metallic** Outlet Boxes without internal clamps installed with steel extension rings and steel cover plates in 2 hr fire rated gypsum board wall assemblies framed with min 3-5/8 in. deep steel studs and constructed of the materials and in the manner specified in the individual U400 or V400 Series Wall and Partition Designs in the Fire Resistance Directory. One 4-1/2 by 4-1/2 in. insert adhered to the interior back wall of the outlet box in accordance with the instructions supplied with the product. Installation to comply with the National Electrical Code (NFPA 70). When protective material is used within outlet boxes on both sides of the wall as directed, the horizontal separation between outlet boxes on opposite sides of the wall may be less than 24 in. provided that the boxes are not installed back-to-back.

Use and Installation

For additional information on the use and installation of TREMstop Putty Pads and TREMstop Electrical Box Inserts, please see the Introduction to the **Wall Opening and Protective Materials (CLIV)** Category in the UL Fire Resistance Directory.

Reproduced courtesy of Underwriters Laboratories, Inc.
See UL Fire Resistance Directory for additional information.




Page 2 of 2

System No. HW-D-0256

July 22, 2005
Assembly Ratings - 1 and 2 hr (See Items 2 and 3)
Nominal Joint Width - 1/2 in.
Class II and III movement capabilities - 25 % compression or extension (See Item 2)

Drawing Not to Scale

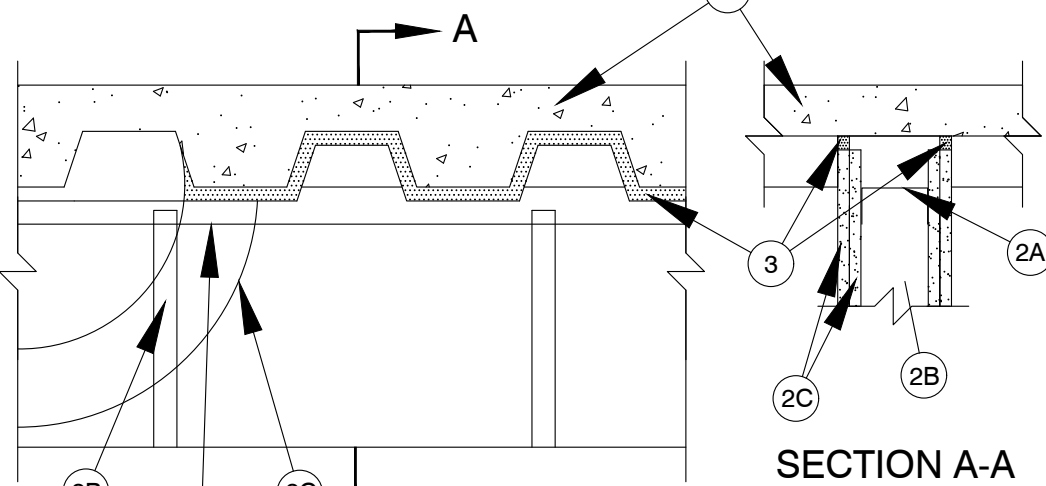

1. **Floor Assembly** - The fire rated fluted steel deck / concrete floor assembly shall be constructed of the materials and in the manner described in the individual Floor-Ceiling Design in the UL Fire Resistance Directory and shall include the following construction features
- A. **Steel Floor And Form Units*** - Max 3 in. deep galv steel fluted floor units.
 - B. **Concrete** - Min 2-1/2 in. thick reinforced lightweight or normal weight concrete, as measured from the top plane of the floor units.
 - 1A. **Roof Assembly** - (Not Shown) - As an alternate to the floor assembly, a fire-rated fluted steel deck roof assembly may be used. The roof assembly shall be constructed of the materials and in the manner described in the individual P900 Series Roof-Ceiling Design in the UL Fire Resistance Directory. The hourly rating of the roof assembly shall be equal to or greater than the hourly rating of the wall assembly. The roof assembly shall include the following construction features:
 - A. **Steel Roof Deck** - Max 3 in. deep galv steel fluted roof deck.
 - B. **Roof Insulation** - Min 2-1/4 in. thick poured insulating concrete, as measured from the top plane of the roof deck.
 - 2. **Wall Assembly** - The 1 or 2 hr fire-rated gypsum board/stud wall assembly shall be constructed of the materials and in the manner described in the individual U400 and V400 Series Wall and Partition Design in the UL Fire Resistance Directory and shall include the following construction features:
 - A. **Steel Floor And Ceiling Runners** - Floor and ceiling runners of wall assembly shall consist of galv steel channels sized to accommodate steel studs. Ceiling runner to be provided with min 1-1/4 in. flanges. Ceiling runner secured to steel floor units or roof deck with steel fasteners or welds spaced max 12 in. OC.
 - A1. **Light Gauge Framing*** - **Slotted Ceiling Runner** - As an alternate to the ceiling runner in Item 2A, slotted ceiling runner to consist of galv steel channel with slotted flanges sized to accommodate steel studs (Item 2B). Slotted ceiling runner is secured to bottom of steel floor units or roof deck with steel fasteners or by welds spaced max 24 in. OC.
 - A2. **Light Gauge Framing*** - **Vertical Deflection Ceiling Runner** - As an alternate to the ceiling runners in Items 2A and 2A1, vertical deflection ceiling runner to consist of galv steel channel with slotted vertical deflection clips mechanically fastened within runner. Slotted clips provided with stop bushings for permanent fastening of steel studs. Flanges sized to accommodate steel studs (Item 2B). Vertical deflection ceiling runner secured to bottom of steel floor units or roof deck with steel fasteners or by welds spaced max 24 in. OC.
 - A3. **Light Gauge Framing*** - **Vertical Deflection Clip** - (Optional) Steel clips can be used in conjunction with steel studs (Item 2B) or ceiling runner (Item 2A). Clips installed over the top of studs and inserted within the ceiling runner. Clip shall be secured to the ceiling runner with No. 8 self drilling, self tapping steel fasteners through holes provided within the clip. Clip may be secured to the stud with No. 6 pan head steel screw through holes provided within the clip. As an alternate, the legs of the clip may be installed over the top of the stud without attachment in accordance with manufacturer's installation instructions.
 - FLEX-ABILITY CONCEPTS L.L.C.** - Three Legged Dog Deflection Clip
 - B. **Studs** - Steel studs to be min 3-5/8 in. wide. Studs cut 1/2 in. to 3/4 in. less in length than assembly height with the bottom nesting in and resting on floor runner and with the top nesting in ceiling runner without attachment. When slotted ceiling runner (Item 2A1) is used, steel studs secured to slotted ceiling runner with No. 8 by 1/2 in. long washer head steel screws at midheight of slot on each side of wall. When vertical deflection ceiling runner (Item 2A2) is used, steel studs secured to slotted vertical deflection clips, through the bushings, with steel screws at midheight of each slot. Stud spacing not to exceed 24 in. OC.

Reproduced courtesy of Underwriters Laboratories, Inc.
See UL Fire Resistance Directory for additional information.



Page 1 of 2

System No. HW-D-0256

July 22, 2005
Assembly Ratings - 1 and 2 hr (See Items 2 and 3)
Nominal Joint Width - 1/2 in.
Class II and III movement capabilities - 25 % compression or extension (See Item 2)

Drawing Not to Scale

C. **Gypsum Board*** - Gypsum board sheets installed to a min total thickness of 5/8 in. and 1-1/4 in. on each side of wall for 1 and 2 hr fire rated assemblies, respectively. Wall to be constructed as specified in the individual Wall and Partition Design in the UL Fire Resistance Directory, except that the gypsum board is cut to follow the contour of the steel floor units or roof deck with a nom 1/2 in. gap maintained between the gypsum board and the steel floor units or roof deck. In addition, the top row of screws shall be installed into the steel studs 1/2 to 1 in. below the bottom edge of the ceiling runner flange.

The hourly fire rating of the joint system is dependent on the hourly rating of the wall assembly in which it is installed. The movement capability of the joint system is Class II and III except that when the vertical deflection clip (Item 2A3) is used, the movement capability is Class II only.

3. **Joint System** - Max separation between bottom of steel floor units or roof deck and top of wall is 1/2 in. The joint system is designed to accommodate a max 25 percent compression or extension from its installed width. The joint system consists of the following:

- A. **Forming Material*** - (Optional, Not shown) - Nom 3 in. thick, min 4 per density mineral wool batt insulation cut into strips to fill the gap between the top of the ceiling runner and bottom of the steel floor units or roof deck. Mineral wool cut into strips having a width equal to ceiling runner and length approximately 2-1/2 in. longer than flute bottom length, then compressed into flute cavity.
- B. **Forming Material** - (Optional) - (Not shown) - In 2 Hr fire rated wall assemblies, foam backer rod friction fit into joint opening and recessed a min 5/8 in. from each surface of wall.
- C. **Fill, Void or Cavity Material*** - **Sealant** - Min 5/8 in. thickness of fill material applied within joint opening on both sides of wall, flush with each surface of gypsum board. For 1 hr systems or in 2 hr systems where forming material (Item 3B) is not used, optional bond breaker tape may be applied to ceiling runner on each side of wall.

TREMCO INC - TREMstop Acrylic
*Bearing the UL Classification Mark

Reproduced courtesy of Underwriters Laboratories, Inc.
See UL Fire Resistance Directory for additional information.



Page 2 of 2

UL LISTING NOTES:

- SPECIFICATIONS AND INFORMATION IN THIS SHEET ARE FOR CONTRACTOR INFORMATION ONLY. INFORMATION ARE TAKEN FROM MATERIALS PUBLISHED BY TREMCO AND UL LABS WHO ARE RESPONSIBLE FOR THEIR CONTENT.
- CONTRACTOR SHALL BE RESPONSIBLE FOR COMPLYING WITH THE MOST CURRENT VERSION OF ALL LISTED UL SPECIFICATIONS.

3330 N.E. 34th Street
Ft. Lauderdale, FL 33308 P: 954.566.5051
www.laskyarchitect.com
architects - interior designers
engineers - construction managers

LASKY
ARCHITECT, P.A.
THIS DOCUMENT IS THE PROPERTY OF LASKY ARCHITECT, P.A. AND SHALL NOT BE REPRODUCED WITHOUT THE WRITTEN CONSENT OF LASKY ARCHITECT, P.A.

PROJECT

THE DRIPBAR
930-M NW BLUE PKWY,
LEES SUMMIT, MO 64086

REVISIONS DATES:

- 10/20/21 BD COMMENTS
- 10/26/21 CLIENT AND UL COMMENTS

PROFESSIONAL SEAL

STATE OF MISSOURI
SCOTT L. LASKY
NUMBER 14
1201905157
ARCHITECT

10-2-2021

ISSUE DATE: 08-25-2021

PROJECT #: 328P.1313P

DRAWN BY: AJ

CHECKED BY: CS-SL

UL LISTINGS

CS-4

7/1/2014

BUXUV U419 - Fire Resistance Ratings - ANSI/UL 263

UL ONLINE CERTIFICATIONS DIRECTORY

Design No. U419

BUXUV U419

Fire Resistance Ratings - ANSI/UL 263

Page Bottom

Design/System/Construction/Assembly Usage Disclaimer

- Authorities Having Jurisdiction should be consulted in all cases as to the particular requirements covering the installation and use of UL Certified products, equipment, system, devices, and materials.
- Authorities Having Jurisdiction should be consulted before construction.
- Fire resistance assemblies and products are published by the design submitter and have been investigated by UL for compliance with applicable requirements. The published information cannot always address every construction nuance encountered in the field.
- When field issues arise, it is recommended the first contact for assistance be the technical service staff provided by the product manufacturer noted for the design. Users of fire resistance assemblies are advised to consult the general Guide Information for each product category and each group of assemblies. The Guide Information includes specifics concerning alternate materials and alternate methods of construction.
- Only products which bear UL's Mark are considered Certified.

BUXUV - Fire Resistance Ratings - ANSI/UL 263

BUXUV7 - Fire Resistance Ratings - CAN/ULC-S101 Certified for Canada

See General Information for Fire Resistance Ratings - ANSI/UL 263

See General Information for Fire Resistance Ratings - CAN/ULC-S101 Certified for Canada

Design No. U419

May 14, 2014

Nonbearing Wall Ratings - 1, 2, 3 or 4 Hr (See Items 4 & 5)

When used in Canada it is required that all materials included within the UL design are also cUL certified.

4

4A

2

5

8

5

5

1B. Framing Members* - Floor and Ceiling Runner - Not shown - In lieu of Item 1 - For use with Item 2C, proprietary channel shaped runners, 1-1/4 in. wide by 3-5/8 in. deep fabricated from min 0.020 in. thick galv steel, attached to floor and ceiling with fasteners spaced 24 in. OC max.

CALIFORNIA EXPANDED METAL PRODUCTS CO - Viper20™ Track

MARINO/WARE, DIV OF WARE INDUSTRIES INC - Viper20™ Track

PHILLIPS MFG CO LLC - Viper25™ Track

1C. Framing Members* - Floor and Ceiling Runners - (Not shown) - In lieu of Item 1 - Channel shaped, attached to floor and ceiling with fasteners 24 in. OC max.

ALLSTEEL & GYPSUM PRODUCTS INC - Type SUPREME Framing System

CONSOLIDATED FABRICATORS CORP, BUILDING PRODUCTS DIV - Type SUPREME Framing System

7/1/2014

BUXUV U419 - Fire Resistance Ratings - ANSI/UL 263

Rating, Hr

Min Stud Depth, in. Item 2, 2C, 2D, 3R and 2G

No. of Layers & Thins of Panel

Min Thins of Insulation (Item 4)

1

3-1/2

1 layer, 5/8 in. thick

Optional

1

2-1/2

1 layer, 1/2 in. thick

1-1/2 in.

1

1-5/8

1 layer, 3/4 in. thick

Optional

2

1-5/8

2 layers, 1/2 in. thick

Optional

2

1-5/8

2 layers, 5/8 in. thick

Optional

3

3-1/2

1 layer, 3/4 in. thick

3 in.

3

1-5/8

3 layers, 1/2 in. thick

Optional

3

1-5/8

2 layers, 3/4 in. thick

Optional

4

1-5/8

4 layers, 5/8 in. thick

Optional

4

1-5/8

4 layers, 1/2 in. thick

Optional

4

2-1/2

2 layers, 3/4 in. thick

2 in.

CGC INC - 1/2 in. thick Type C, IP-X2 or IPC-AR; WRC, 5/8 in. thick Type AR, C, IP-AR, IP-X1, IP-X2, IPC-AR, SCX, SHX, WRX or WRC; 3/4 in. thick Types IP-X3 or ULTRACODE

UNITED STATES GYPSUM CO - 1/2 in. thick Type C, IP-X2, IPC-AR or WRC; 5/8 in. thick Type SCX, SGX, SHX, WRX, IP-X1, AR, C, WRC, FRX-G, IP-AR, IP-X2, IPC-AR, 3/4 in. thick Types IP-X3 or ULTRACODE

USG MEXICO SA DE CV - 1/2 in. thick Type C, IP-X2, IPC-AR or WRC; 5/8 in. thick Type AR, C, IP-AR, IP-X1, IP-X2, IPC-AR, SCX, SHX, WRX, WRC; 3/4 in. thick Types IP-X3 or ULTRACODE

When Item 7B, Steel Framing Members*, is used, Nonbearing Wall Rating is limited to 1 Hr. Min. stud depth, 5/8 in. thick, shall be attached to furring channels as described in Item 6. One layer of gypsum board panels (1/2 in. or 5/8 in. thick) shall be attached to opposite side of stud without furring channels as described in Item 6. 5A. Gypsum Board* - (As an alternate to Item 5) - 5/8 in. thick, 24 to 54 in. wide, applied vertically or horizontally. Secured as described in Item 6. CGC INC - Type SHX.

UNITED STATES GYPSUM CO - Type FRX-G, SHX.

USG MEXICO SA DE CV - Type SHX.

5B. Gypsum Board* - (Not shown) - As an alternate to Item 5 when used as the base layer on one or both sides of wall when 5/8 in. or in. thick products are specified. For direct attachment only to steel studs Item 2A, not to be used with Item 3. Nom 5/8 in. or in. may be used as alternate to 5/8 in. or in. in. shown in Item 5. Wallboard Protection on Each Side of Wall table. Nom 5/8 in. or in. thick lead backed gypsum panels with beveled, square or tapered edges, applied vertically. Vertical joints centered over studs and staggered min 1 stud cavity on opposite sides of studs. Gypsum board secured to 20 MSG steel studs Item 2A with 1-1/4 in. long Type 5-12 steel screw spaced 8 in. OC at perimeter and 12 in. OC in the field. To be used with Lead Batten Strips (see Item 11) or Lead Discs or Tabs (see Item 12).

RAY-BAR ENGINEERING CORP - Type RB-LBG

5C. Gypsum Board* - (For Use With Item 2B) Rating Limited to 1 hour, 5/8 in. thick, 48 in. wide, Gypsum panels with beveled, square or tapered edges, applied vertically or horizontally. (Vertical Application) - The gypsum board is to be installed on each side of the studs with 1 in. long Type S coated steel screw spaced 8 in. OC along vertical and bottom edges and 12 in. OC in the field. Vertical joints centered over studs and staggered min 1 stud cavity on opposite sides of studs. Wallboard secured to studs with 1-1/4 in. long Type 5-12 steel screw spaced 8 in. OC at perimeter and 12 in. OC in the field. To be used with Lead Batten Strips (see Item 11) or Lead Discs or Tabs (see Item 12).

7/1/2014

BUXUV U419 - Fire Resistance Ratings - ANSI/UL 263

1

5

7A

7A

2

4

4A

5

5

5

7A

7A

2

1D. Floor and Ceiling Runners - (Not shown) - For use with Item 2A Channel shaped, fabricated from min 20 MSG corrosion-protected or galv steel, min depth to accommodate stud size, with min 1 in. long legs, attached to floor and ceiling with fasteners spaced max 24 in. OC.

1E. Framing Members* - Floor and Ceiling Runners - (Not shown) - As an alternate to Item 1) - For use with Item 2B, proprietary channel shaped runners, 3-5/8 in. deep fabricated from min 0.015 in. (min bare metal thickness) galvanized steel, attached to floor and ceiling with fasteners 24 in. OC max.

CLARKDIETRICH BUILDING SYSTEMS - CD ProTRAK

DMFCWBS LLC - ProTRAK

MBA BUILDING SUPPLIES INC - ProTRAK

RAM SALES LLC - Ram ProTRAK

SOUTHEASTERN STUD & COMPONENTS INC - ProTRAK

STEEL STRUCTURAL SYSTEMS LLC - Tri-S ProTRAK

1F. Framing Members* - Floor and Ceiling Runners - (Not shown) - In lieu of Item 1 - For use with Item 2F, proprietary channel shaped runners, minimum width to accommodate stud size, with 1- 1/8 in. long legs, attached to floor and ceiling with fasteners 24 in. OC max.

CALIFORNIA EXPANDED METAL PRODUCTS CO - Viper25™ Track

CRACO MFG INC - SmartTrack25™

MARINO/WARE, DIV OF WARE INDUSTRIES INC - Viper25™ Track

PHILLIPS MFG CO LLC - Viper25™ Track

18. Framing Members* - Floor and Ceiling Runner - Not shown - In lieu of Item 1 - For use with Item 2C, proprietary channel shaped runners, 3-5/8 in. deep fabricated from min 0.020 in. thick galv steel, attached to floor and ceiling with fasteners 24 in. OC max.

CALIFORNIA EXPANDED METAL PRODUCTS CO - Viper20™ Track

MARINO/WARE, DIV OF WARE INDUSTRIES INC - Viper20™ Track

PHILLIPS MFG CO LLC - Viper20™ Track

1C. Framing Members* - Floor and Ceiling Runners - (Not shown) - In lieu of Item 1 - Channel shaped, attached to floor and ceiling with fasteners 24 in. OC max.

ALLSTEEL & GYPSUM PRODUCTS INC - Type SUPREME Framing System

CONSOLIDATED FABRICATORS CORP, BUILDING PRODUCTS DIV - Type SUPREME Framing System

7/1/2014

BUXUV U419 - Fire Resistance Ratings - ANSI/UL 263

5

one stud cavity on opposite sides of studs. (Horizontal Application) - The gypsum board is to be installed on each side of the studs with 1 in. long Type S coated steel screw spaced 8 in. OC starting 4 in. from the edge of the board at the vertical edges and 12 in. OC starting 6 in. from the edge of the board at the center of each board. Gypsum boards are to be secured to the top and bottom track with screw spaced 8 in. OC starting 4 in. from the board edge. Fasteners shall not penetrate through both the stud and the track at the same time. All horizontal joints are to be backed as outlined under section VI of Volume 1 in the Fire Resistive Directory.

CGC INC - Type SCX.

UNITED STATES GYPSUM CO - Type SCX, SGX.

USG MEXICO SA DE CV - Type SCX.

5D. Gypsum Board* - (As an alternate to Item 5) - 5/8 in. thick, 48 in. wide, applied vertically or horizontally. Secured as described in Item 6. For use with Items 1 and 2 only.

UNITED STATES GYPSUM CO - Type USGX.

5E. Gypsum Board* - (Not shown) - (As an alternate to Item 5 when used as the base layer on one or both sides of wall when 1/2 in. or 5/8 in. thick products are specified. For direct attachment only to steel studs Item 2A, not to be used with Item 3). Nominal 5/8 in. thick lead backed gypsum panels with beveled, square or tapered edges, applied vertically. Vertical joints centered over studs and staggered min 1 stud cavity on opposite sides of studs. Wallboard secured to studs with 1-1/4 in. long Type 5-12 steel screw spaced 8 in. OC at perimeter and 12 in. OC in the field. To be used with Lead Batten Strips (see Item 11) or Lead Discs or Tabs (see Item 12).

NEW ENGLAND LEAD BURNING CO INC, DBA NELCO - Nelco

5F. Gypsum Board* - (As an alternate to Item 5) - For use with Items 1E and 2E and limited to 1 Hour. Rating only. Gypsum panels with beveled, square or tapered edges, applied vertically, and fastened to the steel studs with 1 in. long Type S screw spaced 8 in. OC along vertical and bottom edges and 12 in. OC in the field. Vertical joints centered over studs and staggered one stud cavity on opposite sides of studs. Steel stud depth shall be a minimum 3-5/8 in.

UNITED STATES GYPSUM CO - 5/8 in. thick Type SCX, SGX.

5G. Gypsum Board* - (As an alternate to Item 5) - For use with Items 1E and 2E only. Gypsum panels with beveled, square or tapered edges, applied vertically or horizontally, as specified in the table below and fastened to the steel studs as described in Item 6. Vertical joints centered over studs and staggered one stud cavity on opposite sides of studs. Vertical joints in adjacent layers (multilayer systems) staggered one stud cavity. Horizontal joints need not be backed by steel framing. Horizontal edge joints and horizontal butt joints in adjacent layers (multilayer systems) staggered a min of 12 in. The thickness and number of layers for the 2 hr, 3 hr and 4 hr ratings are as follows:

Rating, Hr	Min Stud Depth, in. Item 2E	No. of Layers & Thickness of Panel	Min Thins of Insulation (Item 4)
2	1-5/8	2 layers, 1/2 in. thick	Optional
2	1-5/8	2 layers, 5/8 in. thick	Optional
3	1-5/8	3 layers, 1/2 in. thick	Optional
3	1-5/8	4 layers, 5/8 in. thick	Optional
4	1-5/8	4 layers, 1/2 in. thick	Optional
4	1-5/8	4 layers, 5/8 in. thick	Optional
4	1-5/8	4 layers, 1/2 in. thick	Optional

CGC INC - 1/2 in. thick Type C, IP-X2 or IPC-AR; 5/8 in. thick Type AR, C, IP-AR, IP-X1, IP-X2, IPC-AR, SCX, SHX, or 3/4 in. thick Types IP-X3 or ULTRACODE

UNITED STATES GYPSUM CO - 1/2 in. thick Type C, IP-X2, IPC-AR or WRC; 5/8 in. thick Type SCX, SGX, SHX, IP-X1, AR, C, FRX-G, IP-AR, IP-X2, IPC-AR, 3/4 in. thick Types IP-X3 or ULTRACODE

7/1/2014

BUXUV U419 - Fire Resistance Ratings - ANSI/UL 263

2

QUAL RUN BUILDING MATERIALS INC - Type SUPREME Framing System

SCAFCO STEEL STUD MANUFACTURING CO - Type SUPREME Framing System

STEEL CONSTRUCTION SYSTEMS INC - Type SUPREME Framing System

UNITED METAL PRODUCTS INC - Type SUPREME Framing System

1D. Floor and Ceiling Runners - (Not shown) - For use with Item 2A Channel shaped, fabricated from min 20 MSG corrosion-protected or galv steel, min depth to accommodate stud size, with min 1 in. long legs, attached to floor and ceiling with fasteners spaced max 24 in. OC.

1E. Framing Members* - Floor and Ceiling Runners - (Not shown) - As an alternate to Item 1) - For use with Item 2B, proprietary channel shaped runners, 3-5/8 in. deep fabricated from min 0.015 in. (min bare metal thickness) galvanized steel, attached to floor and ceiling with fasteners 24 in. OC max.

CLARKDIETRICH BUILDING SYSTEMS - CD ProTRAK

DMFCWBS LLC - ProTRAK

MBA BUILDING SUPPLIES INC - ProTRAK

RAM SALES LLC - Ram ProTRAK

SOUTHEASTERN STUD & COMPONENTS INC - ProTRAK

STEEL STRUCTURAL SYSTEMS LLC - Tri-S ProTRAK

1F. Framing Members* - Floor and Ceiling Runners - (Not shown) - In lieu of Item 1 - For use with Item 2F, proprietary channel shaped runners, minimum width to accommodate stud size, with 1- 1/8 in. long legs, attached to floor and ceiling with fasteners 24 in. OC max.

CALIFORNIA EXPANDED METAL PRODUCTS CO - Viper25™ Track

CRACO MFG INC - SmartTrack25™

MARINO/WARE, DIV OF WARE INDUSTRIES INC - Viper25™

PHILLIPS MFG CO LLC - Viper25™

2C. Framing Members* - Steel Studs - (Not shown) - In lieu of Item 2 - proprietary channel shaped steel studs, min depth as indicated under Item 5, spaced a max of 24 in. OC. Studs to be cut 3/8 to 3/4 in. less than assembly height.

CALIFORNIA EXPANDED METAL PRODUCTS CO - Viper20™

MARINO/WARE, DIV OF WARE INDUSTRIES INC - Viper20™

PHILLIPS MFG CO LLC - Viper20™

2D. Framing Members* - Steel Studs - In lieu of Item 2 - Channel shaped studs, min depth as indicated under Item 5, spaced a max of 24 in. OC. Studs to be cut 3/8 in. less than assembly height.

ALLSTEEL & GYPSUM PRODUCTS INC - Type SUPREME Framing System

CONSOLIDATED FABRICATORS CORP, BUILDING PRODUCTS DIV - Type SUPREME Framing System

QUAL RUN BUILDING MATERIALS INC - Type SUPREME Framing System

SCAFCO STEEL STUD MANUFACTURING CO - Type SUPREME Framing System

STEEL CONSTRUCTION SYSTEMS INC - Type SUPREME Framing System

UNITED METAL PRODUCTS INC - Type SUPREME Framing System

2E. Framing Members* - Steel Studs - (Not shown) - As an alternate to Item 2) - For use with Items 5F or 5G or 5I only, channel shaped studs, min depth as indicated under Item 5F, 5G or 5I, fabricated from min 0.015 in. (min bare metal thickness) galvanized steel, spaced a max of 24 in. OC. Studs to be cut 3/4 in. less than assembly height.

CLARKDIETRICH BUILDING SYSTEMS - CD ProSTUD

USG MEXICO SA DE CV - 1/2 in. thick Type C, IP-X2, IPC-AR or 5/8 in. thick Type AR, C, IP-AR, IP-X1, IP-X2, IPC-AR, SCX, SHX, or 3/4 in. thick Types IP-X3 or ULTRACODE

5H. Gypsum Board* - (Not shown) - (As an alternate to Item 5 when used as the base layer on one or both sides of wall when 5/8 or 3/4 in. thick products are specified. For direct attachment only to steel studs Item 2A, not to be used with Item 3). Nom 5/8 or 3/4 in. may be used as alternate to all 5/8 or 3/4 in. shown in Item 5. Wallboard Protection on Each Side of Wall table. Nom 5/8 or 3/4 in. thick lead backed gypsum panels with beveled, square or tapered edges, applied vertically. Vertical joints centered over 20 MSG steel studs and staggered min 1 stud cavity on opposite sides of studs. Wallboard secured to studs with 1-1/4 in. long Type 5-12 steel screw spaced 8 in. OC at perimeter and 12 in. OC in the field. Gypsum board secured to 20 MSG steel studs Item 2B with 1-1/4 in. long Type 5-12 steel screw spaced 8 in. OC at perimeter and 12 in. OC in the field. For use with Lead Batten Strips (see Item 11) or Lead Discs (see Item 12A).

5I. Gypsum Board* - (As an alternate to Item 5) - Nom. 5/8 in. thick gypsum panels with beveled, square or tapered edges installed as described in Item 5. Steel stud minimum depth shall be indicated in Item 6.

CGC INC - Type ULX

UNITED STATES GYPSUM CO - Type ULX

USG MEXICO SA DE CV - Type ULX

5J. Gypsum Board* - (Not shown) - (As an alternate to Item 5 when used as the base layer on one or both sides of wall when 1/2 in. or 5/8 in. thick products are specified. For direct attachment only to steel studs Item 2A, not to be used with Item 3). Nom 5/8 in. thick lead backed gypsum panels with beveled, square or tapered edges, applied vertically. Vertical joints centered over studs and staggered min 1 stud cavity on opposite sides of studs. Wallboard secured to studs with 1-1/4 in. long Type 5-12 steel screw spaced 8 in. OC at perimeter and 12 in. OC in the field. Lead batten strips required behind vertical joints of lead backed gypsum wallboard and optional at remaining stud locations. Lead batten strips, min 2 in. wide, max 8 ft long with a max thickness of 0.14 in. placed on the face of studs and attached to the stud with construction adhesive and two 1 in. long Type 5-12 pan head steel screw, one at the top of the stud and one at the bottom of the stud. Lead discs, nominal 3/8 in. diam by max 0.85 in. thick. Compression fitted or adhered over the screw heads. Lead batten strips and discs to have a purity of 99.9% meeting the Federal specification QQ-C-2011, Grade "C".


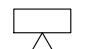
RADIATION PROTECTION PRODUCTS INC - Type RPP - Lead Lined Drywall

6. Fasteners - (Not shown) - For use with Items 2 and 2F - Type S or S-12 steel screws used to attach panels to studs. 1. In. long for 1/2 and 5/8 in. thick panels, spaced 8 in. OC when panels are applied horizontally, 9 in. OC along vertical and bottom edges and 12 in. OC in the field when panels are applied vertically. 2. In. long for 1/2 and 5/8 in. thick panels, spaced 8 in. OC when panels are applied horizontally, 9 in. OC along vertical and bottom edges and 12 in. OC in the field when panels are applied vertically. 3. In. long for 1/2 and 5/8 in. thick panels, spaced 8 in. OC when panels are applied horizontally, 9 in. OC along vertical and bottom edges and 12 in. OC in the field when panels are applied vertically. 4. In. long for 1/2 and 5/8 in. thick panels, spaced 8 in. OC when panels are applied horizontally, 9 in. OC along vertical and bottom edges and 12 in. OC in the field when panels are applied vertically. 5. In. long for 1/2 and 5/8 in. thick panels, spaced 8 in. OC when panels are applied horizontally, 9 in. OC along vertical and bottom edges and 12 in. OC in the field when panels are applied vertically. 6. In. long for 1/2 and 5/8 in. thick panels, spaced 8 in. OC when panels are applied horizontally, 9 in. OC along vertical and bottom edges and 12 in. OC in the field when panels are applied vertically. 7. In. long for 1/2 and 5/8 in. thick panels, spaced 8 in. OC when panels are applied horizontally, 9 in. OC along vertical and bottom edges and 12 in. OC in the field when panels are applied 8 in. OC when panels are applied horizontally, 9 in. OC along vertical and bottom edges and 12 in. OC in the field when panels are applied vertically. 95. In. long for 1/2 and 5/8 in. thick panels, spaced 8 in. OC when panels are applied horizontally, 9 in. OC along vertical and bottom edges and 12 in. OC in the field when panels are applied vertically. 96. In. long for 1/2 and 5




LIFE SAFETY NOTES

- CONTRACTOR TO FIELD VERIFY THE PRESENCE OF A DUCT SMOKE DETECTOR & THAT IT IS IN COMPLIANCE WITH CURRENT LOCAL MECHANICAL CODE.
- REQUIRED "PRELIMINARY SMOKE / LIFE SAFETY SYSTEM TEST": G.C. TO COORDINATE EXECUTION WITH HVAC SUB , LIFE SAFETY MONITOR SUB - PRIOR TO CONTACTING AND SCHEDULING FINAL SMOKE TEST WITH THE CITY.
- EXIT ACCESS SHALL BE PERMITTED TO PASS THROUGH STOREROOMS PROVIDED THAT THE FOLLOWING CONDITIONS ARE MET:
 - NOT MORE THAN 50 PERCENT OF EXIT ACCESS SHALL BE PROVIDED THROUGH THE STOREROOM
 - THE STOREROOM SHALL NOT BE SUBJECT TO LOCKING
 - THE MAIN AISLE THROUGH THE STOREROOM SHALL NOT BE LESS THAN 44 in. (112 cm) WIDE
 - THE PATH OF TRAVEL THROUGH THE STOREROOM, DEFINED WITH FIXED BARRIERS, SHALL BE DIRECT AND CONTINUOUSLY MAINTAINED IN AN UNOBSTRUCTED CONDITION.
- PROVIDE (1) TYPE-ABC FIRE EXTINGUISHER FOR EACH 2,500 S.F. AND NOT MORE THAN 75 FEET APART.
- FIRE EXTINGUISHERS SHALL BE PLACED BY ALL EXIT DOORS AND SHALL BE VISIBLE AND ACCESSIBLE AT ALL TIMES DURING REMODELING.
- ALL EXIT WAYS SHALL BE KEPT FREE AND CLEAR FOR EXITING AND ENTERING PURPOSES.

NOTE:

-  DENOTES 5LB ABC FIRE EXTINGUISHER
-  DENOTES 5LB ABC FIRE EXTINGUISHER WITH SEMI-RECESSED CABINET

FIXTURE LEGEND

SYMBOL	DESCRIPTION - SEE ELECTRICAL PLANS FOR DETAILS
	WALL-MOUNTED EMERGENCY LIGHTS
	WALL-MOUNTED EXIT SIGN/EMERGENCY LIGHT COMBO
	CEILING MOUNTED DIRECTIONAL EXIT SIGN


EGRESS DOOR REQUIREMENTS

ALL EGRESS DOORS, NEW OR EXISTING, SHALL COMPLY WITH NFPA 101 SECTION 7.2.1, AND THE FOLLOWING REQUIREMENTS:

- MINIMUM CLEAR WIDTH WHEN OPEN 90 DEGREES SHALL BE 32"
- THE ELEVATION OF THE FLOOR SURFACES ON BOTH SIDES OF THE DOOR SHALL NOT VARY BY MORE THAN 1/2". THE ELEVATION SHALL BE MAINTAINED FOR A (MIN.) DISTANCE EQUAL TO THE WIDTH OF THE LEAF.
- IN EXISTING BUILDINGS DOORS DISCHARGING TO THE OUTSIDE, THE FLOORS OUTSIDE MAY BE ONE STEP LOWER THAN THAT OF THE INSIDE (8" MAX).
- THE OPENING FORCE (APPLIED TO THE LATCH STILE) TO FULLY OPEN THE DOOR SHALL NOT EXCEED 15 LBF TO RELEASE THE LATCH, 30 LBF TO SET THE DOOR IN MOTION AND 15 LBF TO OPEN THE DOOR TO THE REQUIRED WIDTH.
- THE OPENING FORCE TO FULLY OPEN AN EXISTING DOOR IN AN EXISTING BUILDING SHALL NOT EXCEED 50 LBF.
- DOOR SHALL BE ARRANGED TO BE OPENED READILY FORM THE EGRESS SIDE WHENEVER THE BUILDING IS OCCUPIED. LOCKS SHALL NOT REQUIRE THE USE OF A KEY, TOOL, EFFORT OR SPECIAL KNOWLEDGE FOR OPERATION ON THE EGRESS SIDE.

ALL LOCKS ON EGRESS DOORS, NEW OR EXISTING, SHALL COMPLY WITH NFPA 1 SECTION 7.2.1.5.3, AND THE FOLLOWING REQUIREMENTS:

- DOOR LEAVES SHALL BE ARRANGED TO BE OPENED READILY FROM THE EGRESS SIDE WHENEVER THE BUILDING IS OCCUPIED.
- LOCKS, IF PROVIDED, SHALL NOT REQUIRE THE USE OF A KEY, A TOOL, OR SPECIAL KNOWLEDGE OR EFFORT FOR OPERATION FROM THE EGRESS SIDE.
- A LATCH OR OTHER FASTENING DEVICE ON A DOOR LEAF SHALL BE PROVIDED WITH A RELEASING DEVICE THAT HAS AN OBVIOUS METHOD OF OPERATION AND THAT IS READILY OPERATED UNDER ALL LIGHTING CONDITIONS.

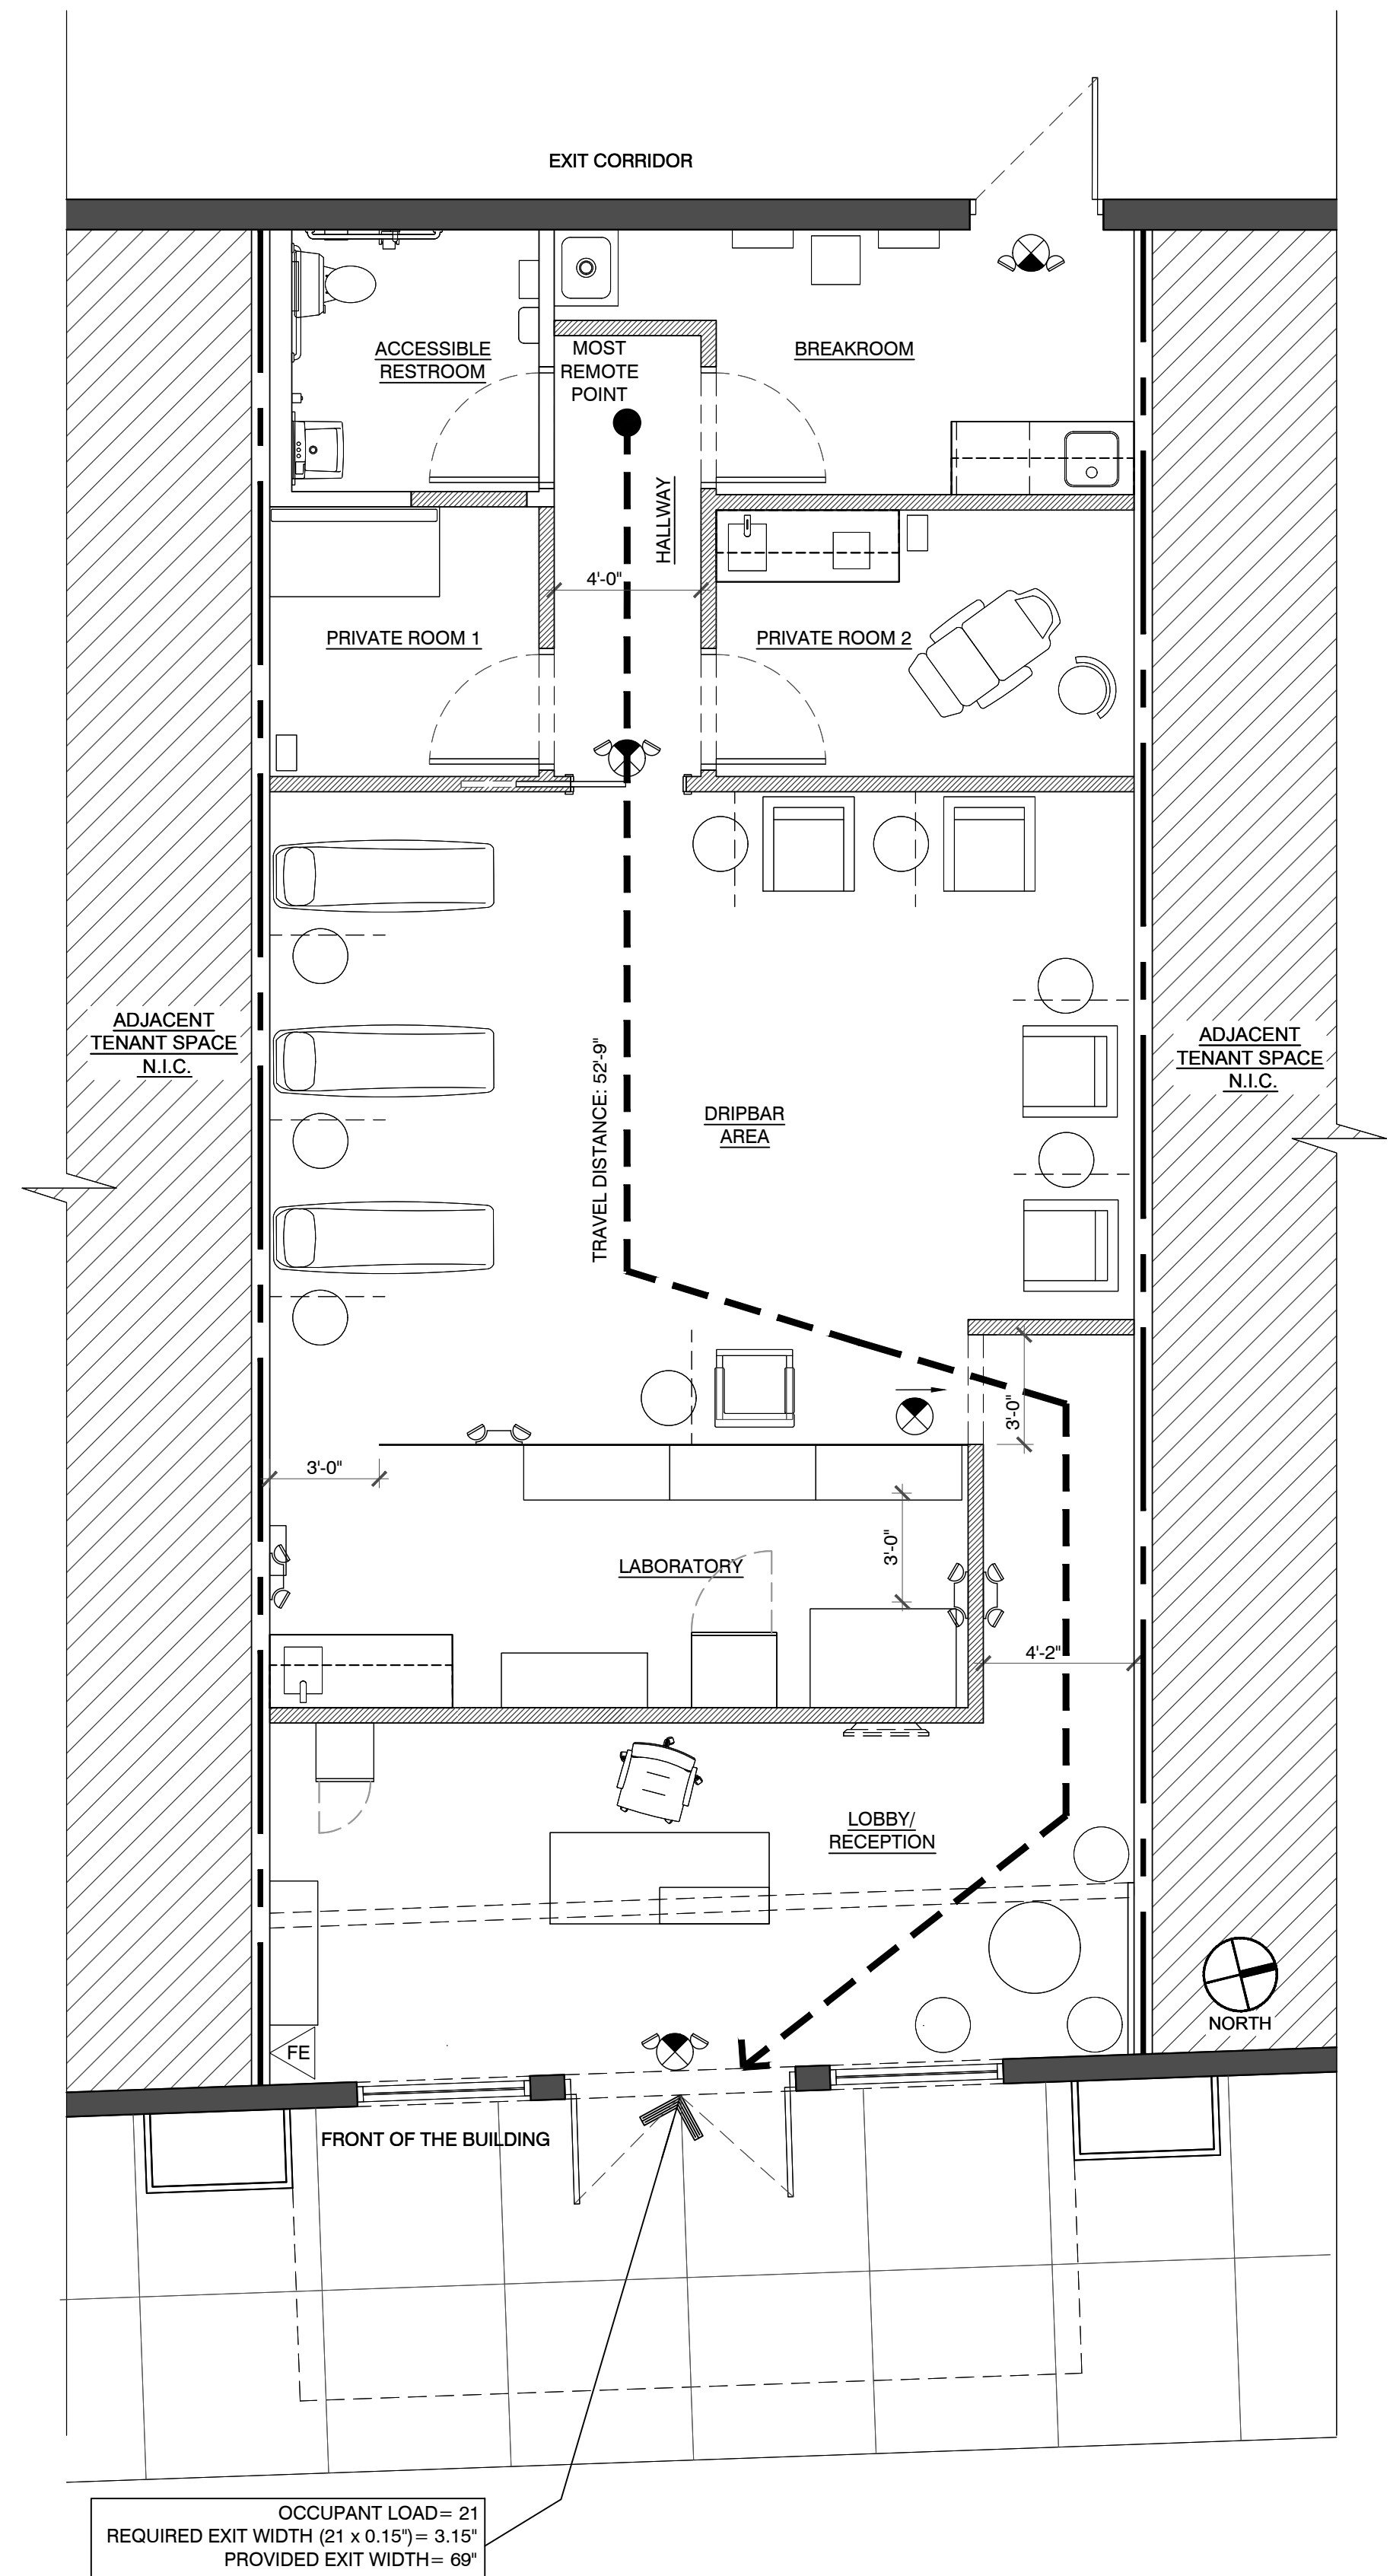

LIFE SAFETY PLAN

SCALE
1/4" = 1'-0"


1

THE DRIPBAR
930-M NW BLUE PKWY,
LEES SUMMIT, MO 64086

REVISIONS DATES:

-  10/20/21 BD COMMENTS
-  10/26/21 CLIENT AND LL COMMENTS

PROFESSIONAL SEAL

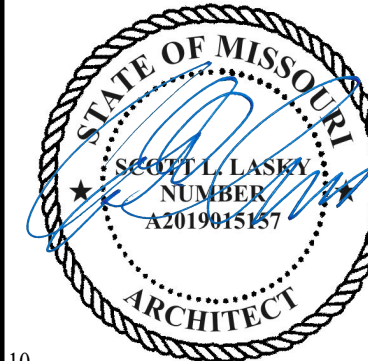


SCOTT L. LASKY A2019015157
REGISTERED ARCHITECT
STATE OF MISSOURI

ISSUE DATE: 08-25-2021
PROJECT #: 328P.1313P
DRAWN BY: AJ
CHECKED BY: CC-SL

LIFE SAFETY

LS-1

3330 N.E. 34th Street
Ft. Lauderdale, FL 33308 P: 954.566.5051
www.laskyarchitect.com
architects - interior designers
engineers - construction managers

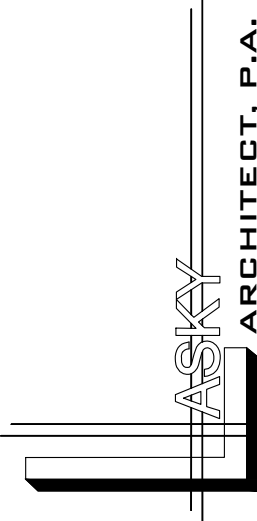

THIS DOCUMENT IS THE PROPERTY OF LASKY ARCHITECT, P.A. AND SHALL NOT BE REPRODUCED WITHOUT THE WRITTEN CONSENT OF LASKY ARCHITECT, P.A.

PROJECT

EXISTING EXTERIOR WALL
TO REMAIN

EXISTING INTERIOR
PARTITION TO REMAIN

EXISTING WALL/PARTITION
TO BE REMOVED

EXISTING TENANT
DEMISING WALL TO
REMAIN

DEMOLITION KEYNOTES

1

(E) INTERIOR PARTITION WALLS TO BE REMOVED. G.C. TO PATCH AND REPAIR ADJACENT WALL AFFECTED BY DEMOLITION.

2

(E) ACOUSTICAL CEILING SYSTEM TO BE REMOVED, FIRE SPRINKLER SYSTEM SHALL REMAIN.

3

(E) DOOR, FRAME & HARDWARE TO BE REMOVED.

4

(E) DOOR & HARDWARE SHALL REMAIN.

5

(E) DRINKING FOUNTAIN TO BE REMOVED. GC TO CAP & SEAL ANY PLUMBING LINES NOT BEING USED.

6

(E) STOREFRONT SYSTEM SHALL REMAIN.

7

(E) RESTROOM ACCESSORIES & FINISHES TO BE REMOVED.

8

(E) FURNITURE, MERCHANDISE DISPLAYS & MILLWORK TO BE REMOVED

9

(E)TENANT DEMISING WALL SHALL REMAIN AND BE PROTECTED DURING DEMOLITION.

10

(E) MOP SINK TO BE RELOCATED. GC TO CAP & SEAL ANY PLUMBING LINES NOT BEING USED.

11

(E) WATER HEATER, LOCATED ABOVE RESTROOM CEILING, TO BE REMOVED.GC TO CAP & SEAL ANY PLUMBING LINES NOT BEING USED.

12

(E) LIGHTING CONTROL PANEL TO BE REMOVED.

13

(E) DRYWALL CEILING SHALL REAMIN. GC TO PREPARE SURFACE TO RECEIVE NEW FINISH.

14

(E) ELECTRICAL PANELS & TRANSFORMER SHALL REMAIN.

GENERAL NOTES

A

ALL (E) FLOORING MATERIAL TO BE REMOVED, GC TO PREPARE FLOOR SLAB TO RECEIVE NEW FLOOR FINISHES.

B

ALL (E) INTERIOR WALL FINISHES TO BE REMOVED. GC TO PATCH & PREPARE WALLS TO RECEIVE NEW FINISHES.

DEMOLITION NOTES

1. THIS PORTION OF THE WORK TO INCLUDE ALL LABOR, MATERIALS AND SERVICES NECESSARY FOR ALL DISMANTLING, DEMOLITION AND SALVAGE AS SHOWN ON THE DRAWING AND SPECIFIED HEREIN.

2. DEMOLITION WORK SHALL BE CONDUCTED IN ACCORDANCE WITH THE APPLICABLE SAFETY REQUIREMENTS OF THE LANDLORD, CITY AND STATE OF THE PROJECT, THE ASSOCIATED GENERAL CONTRACTORS MANUAL OF ACCIDENT PREVENTION ON CONSTRUCTION, LATEST EDITION, AND THE APPLICABLE REQUIREMENTS OF THE LOCAL BUILDING CODE.

3. ALL REQUIRED BUILDING AND OTHER PERMITS IN CONNECTION WITH THE CONSTRUCTION AND COMPLETION OF THE TENANTS WORK IS THE SOLE RESPONSIBILITY OF THE TENANT / TENANT'S CONTRACTOR(S).

4. CONTRACTOR TO VISIT THE SITE TO DETERMINE DEMOLITION REQUIREMENTS. FAILURE OF CONTRACTOR TO ACQUAINT HIMSELF WITH ALL AVAILABLE INFORMATION CONCERNING CONDITIONS WILL NOT RELIEVE HIM FROM THE RESPONSIBILITY FOR ACCURATELY ESTIMATING THE DIFFICULTY OR THE COST OF THE WORK.

5. GC MUST VERIFY CONDITIONS FOR ALL DEMISING WALLS. PATCH AND REPAIR AS NECESSARY. FIRE SEPARATION BETWEEN TENANTS MUST COMPLY WITH ALL LOCAL CODES. ALL DEMISING WALL WORK TO BE DONE PRIOR TO INTERIOR CONSTRUCTION. DEMISING WALLS SHALL BE 1-HOUR RATED, PATCHED AND FIRE STOPPED AS REQUIRED. NONMETALLIC PIPES PENETRATING DEMISING WALLS SHALL USE ATTACHED FIRE COLLAR.

6. THE EXISTING CONCRETE SLAB SHALL BE WELL PREPARED TO RECEIVE NEW FLOORINGS.

7. ALL MATERIALS USED IN THE CONSTRUCTION OF THE SPACE MUST BE ASBESTOS FREE.

8. NOTIFY ARCHITECT IMMEDIATELY OF ANY INCONSISTENCIES OR DISCREPANCIES WITH PLANS IN RELATION TO EXISTING FIELD CONDITIONS.

9. IT IS THE TENANT / TENANTS CONTRACTOR RESPONSIBILITY TO FIELD VERIFY ALL EXISTING CONDITIONS AND DIMENSIONS.

10. IF ANY EXISTING FIRE PROOFING OR FIRE ASSEMBLIES TO REMAIN ARE DAMAGED DURING DEMOLITION, THEY SHALL BE REPAIRED TO CONFORM TO THE ORIGINAL FIRE PROTECTION REQUIREMENTS. CONTACT ARCHITECT TO VERIFY UL ASSEMBLIES TO BE USED FOR REPAIRS.

11. REFER TO MECHANICAL, PLUMBING, FIRE PROTECTION, COMMUNICATIONS INFORMATION SYSTEMS AND ELECTRICAL DRAWINGS FOR EXTENT AND LOCATION OF CHANNELING OF EXISTING FLOOR SLAB. IF EXISTING PIPING OR CONDUIT WORK (OTHER THAN THE DESIRED CONNECTION) IS ENCOUNTERED WHILE CHANNELING, THE CONTRACTOR SHALL NOTIFY THE ARCHITECT BEFORE CONTINUING

12. THE CONTRACTOR SHALL VERIFY THAT CONSTRUCTION OF EXISTING WALLS MEETS THE FIRE PROTECTION RATING DESIGNATED ON THESE DRAWINGS. HE SHALL ALSO MAKE ANY REPAIRS OR MODIFICATIONS NECESSARY TO BRING EXISTING WALLS, FLOORS, DUCTS, ETC. UP TO THE PROPER INDICATED FIRE PROTECTION RATING. DOORS AND FRAMES NOT MEETING RATING REQUIREMENTS OR BEARING PROPER LABELS SHALL BE REPLACED.

13. DEMO CONTRACTOR IS GENERALLY RESPONSIBLE, BUT NOT LIMITED TO THE FOLLOWING:

A. WALL, FRAMING & FINISH REMOVAL

B. REMOVAL OF EXISTING FLOORING MATERIAL DOWN TO BARE CONCRETE DECK

C. COMPLETE REMOVAL OF STOREFRONT & WALL SYSTEMS

D. REMOVAL OF WALLS, LOCKERS & OTHER EQUIPMENT FROM LEASE LINE

E. REMOVAL OF EXISTING PLUMBING FIXTURES & PIPES CAPPED BELOW OR INSIDE OF WALLS TO REMAIN

F. REMOVAL OF ANY EXISTING MISC. WALLS & DOORS NOT NOT SHOWN IN PLANS, TO PROVIDE A CLEAN & UNOBSSTRUCTED SPACE

G. REMOVAL OF ALL MEP OR ELECTRICAL EQUIPMENT NOT BEING RE-USED, AS INDICATED IN PLANS, INCLUDING CONDUIT, J-BOXES, WIRING, ETC. BACK TO LANDLORDS POINT OF CONNECTION.

H. REMOVAL OF ALL EXISTING CABINETRY, FURNITURE, & EQUIPMENT NOT BEING USED (AS INDICATED IN PLANS) ALONG W/ ANY MISC. ITEMS ATTACHED THERETO

I. REMOVAL OF EXISTING LIGHT FIXTURES & SALVAGE THOSE INDICATED IN PLANS

J. REMOVAL OF ALL HARD CEILING, GRIDS, & ALL OTHER CEILING SYSTEMS

K. REMOVAL OF ALL A/C DUCT WORK & DIFFUSERS, EXCEPT FOR MAIN TRUNK LINE

L. ALL FIRE DETECTION, SPEAKERS, WIRING, ETC.

EXIT CORRIDOR

ADJACENT
TENANT SPACE
N.I.C.

ADJACENT
TENANT SPACE
N.I.C.

FRONT OF THE BUILDING

NORTH

1

2

3

DEMOLITION PLAN

SCALE
1/4" = 1'-0"

1

3330 N.E. 34th Street
Ft. Lauderdale, FL 33308
www.laskyarchitect.com
architects - interior designers
engineers - construction managers

THIS DOCUMENT IS THE PROPERTY OF LASKY ARCHITECT, P.A. AND SHALL NOT BE REPRODUCED WITHOUT THE WRITTEN CONSENT OF LASKY ARCHITECT, P.A.

PROJECT

THE DRIPBAR

930-M NW BLUE PKWY,
LEES SUMMIT, MO 64086

REVISIONS DATES:

10/20/21 BD COMMENTS

10/26/21 CLIENT AND LL COMMENTS

PROFESSIONAL SEAL

STATE OF MISSOURI

SCOTT L. LASKY
REGISTERED ARCHITECT
STATE OF MISSOURI
NUMBER
A2019015157

SCOTT L. LASKY A2019015157
REGISTERED ARCHITECT
STATE OF MISSOURI

ISSUE DATE: 08-25-2021


PROJECT #: 328P.1313P

DRAWN BY: AJ

CHECKED BY: CC-SL

DEMOLITION PLAN

D-1

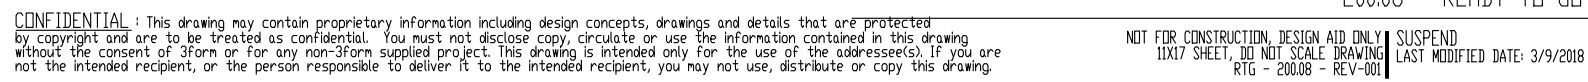

SCALE
1/2" = 1'-0"

Technical drawing of a door assembly. The drawing shows a rectangular door with a central glass panel. The overall width is 3'0" and the overall height is 5'0". The glass panel is 2'0" wide and 3'0" high. The frame is 2" thick. The glass is frosted. The frame is primed and painted to match the door laminate. The door is shown with a handle and a lock. The drawing includes dimensions for the glass, frame, and overall door size.

2" 3'0" 2" FROSTED GLASS

2" HOLLOW METAL FRAME FACTORY PRIMED, FIELD PAINTED TO MATCH DOOR LAMINATE

5'0" 2'0" 3'0" 1'0"

Diagram illustrating the components and installation instructions for a double door assembly:

- FRAME FACTORY PRIMED, FIELD PAINTED**: Points to the outer frame of the door.
- MATCH DOOR LAMINATE**: Points to the inner frame of the door.
- INSTALL PER MANUFACTURER**: Points to the door panel.
- FROSTED GLASS**: Points to the glass insert in the door panel.

NOTES:

1. ALL HARDWARE TO BE US26D
2. DOOR CLOSERS SHALL BE ADJUSTED SO THAT FROM 90°, THE TIME REQUIRED TO MOVE THE DOOR TO 12° FROM THE LATCH IS 5 SECONDS MIN. MAXIMUM PUSH OR PULL FORCE FOR ALL DOORS: 5LB.

1	(E) ELECTRICAL PANEL, REFER TO ELECTRICAL FOR DETAILS.
2	(E) & (N) HEADER WALL ABOVE. SEE REFLECTED CEILING PLAN FOR DETAILS.
3	(N) FRAMELESS SUSPENDED PARTITIONS MANUFACTURER: 3FORM MATERIAL: 200.08 VARIA ICECAP GAUGE 3/8" FRONT AND BACK FINISH: SANDSTONE COLOR: UMBRA DESIGN COLLECTION HARDWARE: STAINLESS https://www.3-form.com/products/frameless-suspended-partition REFER TO DETAIL 2/A-1
4	(N) ACCESSIBLE RESTROOM. ALL EQUIPMENT SHALL COMPLY WITH ACCESSIBILITY REQUIREMENTS SCHEDULE 3. SEE RESTROOM EQUIPMENT SCHEDULE AND PLUMBING PLANS FOR DETAILS.
5	(N) EXISTING WALL TO BE BROUGHT UP 6" ABOVE NEW CEILING.

STUD SIZE	GAUGE	THICKNESS	SPACING	MAX. HEIGHT*
2 $\frac{1}{2}$ "	25	18 MIL	16"	9'-10"
3 $\frac{5}{8}$ "	25	18 MIL	16"	12'-4"
3 $\frac{5}{8}$ "	22	27 MIL	16"	13'-7"
3 $\frac{5}{8}$ "	20	30 MIL	16"	14'-3"
3 $\frac{5}{8}$ "	18	43 MIL	16"	16'-7"
3 $\frac{5}{8}$ "	16	54 MIL	16"	17'-9"
6"	25	18 MIL	16"	17'-11"
6"	22	27 MIL	16"	20'-3"
6"	20	30 MIL	16"	21'-4"
6"	18	43 MIL	16"	23'-8"

*NOTES:

- NON-LOAD BEARING
- 5# LATERAL LOAD
- L/360 DEFLECTION

DOOR #	DESCRIPTION	STYLE	DIMENSION	DOOR		FRAME		HARDWARE	SADDLE	REMARKS	
				THICKNESS	MAT'L FINISH	MAT'L FINISH					
E1	LOBBY-STOREFRONT DOOR	-	(1) 6'-0" X 7'-0"	EXISTING DOOR TO REMAIN						GC TO V.I.F. THAT EXISTING PANIC HARDWARE MEETS LOCAL REQUIREMENT. IF NOT, GC TO PROVIDE NEW PANIC HARDWARE.	
E2	REAR DOOR	-	(1) 3'-0" X 7'-0"	EXISTING DOOR TO REMAIN						GC TO V.I.F. THAT EXISTING PANIC HARDWARE MEETS LOCAL REQUIREMENT. IF NOT, GC TO PROVIDE NEW PANIC HARDWARE.	
01	PRIVATE ROOM	B	(1) 3'-0" X 7'-0"	1-3/4"	S.C./GL	LAM	H.M.	PNT	1	-	WHITE LAMINATE-FROSTED GLASS- FRAME PAINT TO MATCH LAMINATE
02	BREAKROOM	A	(1) 3'-0" X 7'-0"	1 3/4"	S.C.	LAM	H.M.	PNT	2	-	WHITE LAMINATE- FRAME PAINT TO MATCH LAMINATE
03	UNISEX RESTROOM	A	(1) 3'-0" X 7'-0"	1 3/4"	S.C.	LAM	H.M.	PNT	3		WHITE LAMINATE- FRAME PAINT TO MATCH LAMINATE
04	HALLWAY	C	(1) 3'-0" X 7'-0"	1 3/4"	S.C./GL	LAM	H.M.	PNT	PER MANUFACTURER	-	WHITE LAMINATE-FROSTED GLASS- FRAME PAINT TO MATCH LAMINATE

LEGEND: H.C. = HOLLOW CORE WOOD S.C. = SOLID CORE WOOD H.M. = HOLLOW METAL S.P. = SOLID PLASTIC LAM. = LAMINATE LOUV. = LOUVER

NOTES:

1. ALL EXTERIOR DOORS (INCLUDING EXISTING) SHALL BE SELF-CLOSING AND RODENT PROOF.
2. ALL HARDWARE PACKAGES TO BE REVIEWED W/ TENANT PRIOR TO ORDERING INCLUDING DESIGNATED LOCKS/DEADBOLTS
3. SEE EXIT DOOR REQUIREMENTS ON LS-1.

X	WALL TYPE			EXISTING EXTERIOR WALL	EXISTING TENANT DEMISING WALL	3	4
	STUD	GAGLE	SPACING				
	8" CONCRETE BLOCK						
	7/8" HAT TRACK						
	1-1/2" METAL STUD						
	2-1/2" METAL STUD						
	3-5/8" METAL STUD						
	6" METAL STUD						
	12" O.C.						
	16" O.C.						
	24" O.C.						
	18 GA						
	20 GA						
	25 GA						
	3'-4" A.F.F.						
	4'-10" A.F.F.						
	UP TO EXTENT OF OPENING						
	UP TO CEILING						
	6" ABOVE CEILING TILES						
	UNDERSIDE OF STRUCTURE (BRACE TO STRUCTURE)						
	1/2" GWB						
	5/8" GWB						
	5/8" TYPE-X GWB						
	5/8" DUROCK						
	5/8" PURPLE BOARD						
	5/8" PURPLE BOARD TYPE-X						
	3/4" FIRE TREATED PLYWOOD						
	SHEATHING ON ONE SIDE ONLY						
	SAME SHEATHING ON BOTH SIDES						
	DIFFERENT SHEATHING ON EACH SIDE						
	EXTENT OF WALL						
	UP TO CEILING						
	6" ABOVE CEILING TILES						
	TO UNDERSIDE OF STRUCTURE						
	BATT INSULATION (R-VALUE)						
	RIGID INSULATION (R-VALUE)						
	SOUND ATTENUATION (STC)						
	FIRE RATING (NO. OF HOURS)					1HR	
	WALL TYPE NOTES			A	A,B	E	
WALL TYPE NOTES	A	CONTRACTOR TO VERIFY IN FIELD THE CONSTRUCTION AND ASSEMBLY OF EXISTING WALLS.					
	B	GC TO MAINTAIN FIRE RATING THROUGHOUT. REFER TO CS-4 FOR DETAILS.					
	C	TO MATCH EXISTING.					
	D	FIRE RATING PER UL DESIGN U419 FOR 1-4 HOURS. SEE CS-4.1					
E	IN BREAKROOM BEHIND CABINET, REPLACE 18" OF DRYWALL W/ 5/8" PURPLE BOARD.						
GENERAL NOTES	1	GC TO PROVIDE ADEQUATE BLOCKING IN THE WALL WHEN NECESSARY.					
	2	AT ALL NEW PARTITIONS, SEE BRACING AND ATTACHEMENT REQUIREMENTS AND DETAILS ON CS-2.					
	3	INSTALL SHEATHING UP TO UNDERSIDE OF GWB; AND 6" ABOVE CEILING TILES IF BOTH CONDITIONS ARE PRESENT IN SAME WALL, U.N.O.					

PART	MODEL NO	MANUFACTURER
HINGES	1279 4 1/2x4 1/2xUS26D	HAGER
	NRP BB1191 4 1/2x4 1/2x1/2xNRPxUS32D	HAGER
LATCH SET	PASSAGE: ND10S RHO 626	SCHLAGE
LOCK SET	PRIVACY: ND40S RHO 626	SCHLAGE
	OFFICE: ND50P RHO 626	SCHLAGE
	CLASSROOM: ND70P RHO 626	SCHLAGE
	STOREROOM: ND80P RHO 626	SCHLAGE
	ENTRANCE: ND53P RHO 626	SCHLAGE
CLOSER	1070 xSEX BOLTS	LCN
PANIC EXIT DEVICE	99L-F (FIRE PROOF)	VONDUPRIN
	99EO	VONDUPRIN
	99L	VONDUPRIN
THRESHOLD	THRESHOLD # 119NXAL	NGP
	WEATHER STRIP # 160A	NGP
	DRIP # 16 AP	NGP
STOPPER	STOP W 302Px626	QUALITY
	FLOOR STOP	QUALITY
	SILENCERS 1337A	QUALITY
KICK PLATES	12"x2" LDWx.050x630	QUALITY
PULL PLATE	31E US26D	HAGER
PUSH PLATE	30S US26D	HAGER

NOTE: FINISHES INDICATED HERE ARE STANDARD UNLESS INDICATED ELSEWHERE.



SCALE

$1/4" = 1'-0"$

REVISIONS DATES:

1	10/20/21 BD COMMENTS
2	10/26/21 CLIENT AND LL COMMENTS

PROFESSIONAL SEAL



SCOTT L. LASKY A2019015157
REGISTERED ARCHITECT
STATE OF MISSOURI

ISSUE DATE: 08-25-2021
PROJECT #: 328P.1313P
DRAWN BY: AJ
CHECKED BY: CC-SL

FLOOR PLAN

A-1

EQUIPMENT SCHEDULE

RESTROOMS EQUIPMENT

Item	Qty	Description	Manufacturer	Model No.	Finish / Color	Furnished	Installed By	Remarks
A1	1	WALL MOUNTED SINK		EXISTING TO REMAIN				
A2	1	TOILET		EXISTING TO REMAIN				
A3	1	36" GRAB BAR	BOBRICK	B-6806 x 36	STAINLESS STEEL	G.C.	G.C.	
A4	1	42" GRAB BAR	BOBRICK	B-6806 x 42	STAINLESS STEEL	G.C.	G.C.	
A5	1	TOILET TISSUE DISPENSER	BOBRICK	B-4288	STAINLESS STEEL	G.C.	G.C.	
A6	1	SOAP DISPENSER	SIMPLY HUMAN	SINGLE	STAINLESS STEEL	G.C.	G.C.	
A7	1	PAPER TOWEL DISPENSER	GEORGIA PACIFIC	59462	TRANSLUCENT SMOKE	G.C.	G.C.	
A8	1	LIGHTED MIRROR	EUROFASE LIGHTING	37140		G.C.	G.C.	
A9	1	MOP SINK		EXISTING TO BE RELOCATED		G.C.	G.C.	
A10	-	WATER HEATER		EXISTING TO REMAIN				
A11	3	SINK		REFER TO PLUMBING PLANS FOR DETAILS		G.C.	G.C.	
A12	1	SANITARY NAPKIN DISPOSAL	BOBRICK	B-270		G.C.	G.C.	
A13	-	DRINKING FOUNTAIN						NOT USED IN THIS PROJECT
A14	1	TOILET SEAT COVER DISPENSER	BOBRICK	B-221		G.C.	G.C.	
A15	3	SS 14.4 GAL RECTANGULAR TRASH CAN	SIMPLE HUMAN	10080211	SS	G.C.	G.C.	RESTROOM AND PRIVATE ROOMS
A16	1	18" VERTICAL GRAB BAR	BOBRICK	B-6806 x 18	STAINLESS STEEL	G.C.	G.C.	
A17	1	KITCHEN SINK		REFER TO PLUMBING PLANS FOR DETAILS		G.C.	G.C.	

GENERAL EQUIPMENT


Item	Qty	Description	Manufacturer	Model No.	Finish / Color	Furnished	Installed By	Remarks
B1	-	MOBILE MAYO TRAY STAND	MAYO	81-11100	STAINLESS STEEL	TENANT	G.C.	AMOUNT TBD BY OWNER
B2	-	IV STAND 2 HOOKS	BLICKMAN	14155S-4	STAINLESS STEEL	TENANT	G.C.	AMOUNT TBD BY OWNER
B3	4	INTER METRO 3-SHELF SOLUTION	THE CONTAINER STORE	10064011		TENANT	G.C.	18" X 48"
B4	4	METRO COMMERCIAL CLEAR SHELF LINER	THE CONTAINER STORE	10070637		TENANT	G.C.	
B5	1	MOUNTED CABINET DEFIRILATOR	PHILLIPS BASIC SURFACE	989803136531		TENANT	G.C.	
B6	1	COMPOUNDING ASEPTIC CONTAINMENT ISOLATOR	PHARMAGARD	NU-PR797-400		TENANT	G.C.	HOOD
B7	1	CENTRIFUGE SPINNER	SELPHYL	TBD		TENANT	G.C.	
B8	1	28" WIDE PHARMACY REFRIGERATOR	NUAIRE	ACR1718RH	STAINLESS STEEL	TENANT	G.C.	
B9	-	INTER METRO SHELVING SOLUTION	THE CONTAINER STORE	TBD		TENANT	G.C.	NOT USED IN THIS PROJECT
B10	1	COUNTERTOP DISPLAY REFRIGERATOR	EXCELLENCE	EMM-4HC		TENANT	G.C.	
B11	9	DOCK CLEAT	EVERBILT	41644	GRADE SS	G.C.	G.C.	@ 37" A.F.F
B11.A	9	PLATED SWIVEL PULLEY	EVERBILT	43334	NICKEL	G.C.	G.C.	BACK WALL TO THE PULLEY 24"
B11.B	9	WHITE TWISTED NYLON ROPE	EVERBILT	73052		G.C.	G.C.	LENGTH +- 162"
B11.C	5	PLATED UTILITY SCREW HOOK	EVERBILT	43054	ZINC	G.C.	G.C.	
B11.D	9	13/16" X 3-3/16" ROUND FIXED EYE SNAP HOOK	EVERBILT	42464	SS	G.C.	G.C.	@ 84" A.F.F
B12	1	TV SCREEN				TENANT	G.C.	RECEPTACLE @ 7'-0" A.F.F
B13	1	UNDERCOUNTER REFRIGERATOR	WHIRLPOOL	WRT1115FDB		TENANT	G.C.	
B14	1	MICROWAVE	KENMORE	72129		TENANT	G.C.	
B15	-	RED LIGHTS SYSTEM	TBD			TENANT	G.C.	NOT USED IN THIS PROJECT
B16	-	SS 12 GA. SEMI ROUND TRASH CAN	SIMPLE HUMAN	10083613	SS	TENANT	G.C.	DRIPBAR - AMOUNT TBD BY OWNER
B17	-	SAFE - WALL MOUNTED	ADIROFFICE	631-05-BLK		TENANT	G.C.	NOT USED IN THIS PROJECT
B18	-	INFRARED SAUNA	CLEARLIGHT INFRARED SAUNAS	SANCTUARY RETREAT- 4P		TENANT	G.C.	NOT USED IN THIS PROJECT

FURNITURE

Item	Qty	Description	Manufacturer	Model No.	Finish / Color	Furnished	Installed By	Remarks
Item	Qty	Description	Manufacturer	Model No.	Finish / Color	Furnished	Installed By	Remarks
C1	4	LOUNGE CHAIR	CITI SQUARE/ SHEEHANS	S7875-S3	A04F IVORY / CHROME	TENANT	G.C.	TO REFER TO FURNITURE PACKAGE FOR DETAILS
C2	1	PHLEBOTOMY CHAIR	INTENSA	25925	ALABASTER	TENANT	G.C.	
C3	3	CHAISE LOUNGE	SENCE RELAX/ SHEEHANS			TENANT	G.C.	TO REFER TO FURNITURE PACKAGE FOR DETAILS
C4	-	OTTOMAN- TRIANGLE (OPTION 2)	SHEEHANS			TENANT	G.C.	TO REFER TO FURNITURE PACKAGE FOR DETAILS
C4.1	-	OTTOMAN- DIAMOND (OPTION 2)	SHEEHANS			TENANT	G.C.	TO REFER TO FURNITURE PACKAGE FOR DETAILS
C4.2	-	OTTOMAN- TRAPEZOID (OPTION3)	SHEEHANS			TENANT	G.C.	TO REFER TO FURNITURE PACKAGE FOR DETAILS
C5	1	AESTHETICS CHAIR	SALON AND EQUIPMENT	SKU16135	WHITE	TENANT	G.C.	
C6	5	SIDE TABLE (LOUNGE CHAIR)	SHEEHANS		WHITE	TENANT	G.C.	TO REFER TO FURNITURE PACKAGE FOR DETAILS
C6.1	3	SIDE TABLE (CHAISE LOUNGE)	SHEEHANS		WHITE	TENANT	G.C.	TO REFER TO FURNITURE PACKAGE FOR DETAILS
C7	-	LOBBY LOFT SEATING (OPTION 1)	SHEEHANS			TENANT	G.C.	TO REFER TO FURNITURE PACKAGE FOR DETAILS
C7.1	-	LOBBY LOFT SEATING (OPTION 2)	SHEEHANS			TENANT	G.C.	TO REFER TO FURNITURE PACKAGE FOR DETAILS
C7.2	3	LOBBY LOFT SEATING (OPTION 3)	SHEEHANS			TENANT	G.C.	TO REFER TO FURNITURE PACKAGE FOR DETAILS
C8	-	COFFEE TABLE (OPTION 1)	SHEEHANS			TENANT	G.C.	TO REFER TO FURNITURE PACKAGE FOR DETAILS
C8.1	1	COFFEE TABLE (OPTION 2)	SHEEHANS			TENANT	G.C.	TO REFER TO FURNITURE PACKAGE FOR DETAILS
C9	1	RECEPTION CHAIR (OPTION 1)	SHEEHANS	WIT	GREY/BLUE	TENANT	G.C.	TO REFER TO FURNITURE PACKAGE FOR DETAILS
C9.1	-	RECEPTION CHAIR (OPTION 2)	SHEEHANS	MAVIC	GREY/ORANGE	TENANT	G.C.	TO REFER TO FURNITURE PACKAGE FOR DETAILS
C9.2	-	RECEPTION CHAIR (OPTION 3)	SHEEHANS	VECTRA	GREY/GREEN	TENANT	G.C.	TO REFER TO FURNITURE PACKAGE FOR DETAILS
C10	1	RECEPTION DESK	SHEEHANS			TENANT	G.C.	72" - TO REFER TO FURNITURE PACKAGE FOR DETAILS
C11	1	RETAIL DISPLAY	SHEEHANS			TENANT	G.C.	TO REFER TO FURNITURE PACKAGE FOR DETAILS
C12	2	PRIVATE ROOM/LABORATORY CABINETRY	LOWE'S		WHITE	TENANT	G.C.	60" L-REFER TO PRIVATE ROOM CABINET SCHEDULE
C13	1	PHLEBOTOMY CART	KINGCRACK	KK KINGCRACK	GREY	TENANT	G.C.	
C14	11	LUMBAR PILLOW FOR ARM		IM120	WHITE	TENANT	G.C.	
C15	1	SWIVEL CHAIR	TBD	TBD		TENANT	G.C.	
C16	1	SOFA	SHEEHANS			TENANT	G.C.	
C17	-	DESK	TBD BY TENANT	TBD BY TENANT		TENANT	G.C.	
C18	1	BREAKROOM CABINET	TBD BY TENANT	TBD BY TENANT		TENANT	G.C.	
C19	-	SMALL PRIVATE ROOM CABINET	LOWES		WHITE	TENANT	G.C.	TO MATCH CABINET STANDARD

PRIVATE ROOM/ LABORATORY CABINET SCHEDULE

DESCRIPTION	QTY (PER ROOM)	COLOR	SPECIFICATION
VANITY DRAWERS BASE	1	WHITE	<ul style="list-style-type: none">34 1/2" HIGH,SOFT CLOSE DOORS AND DRAWERS,21 " HIGH DOORS,FULL -DEPTH SHELVES,CONCEALED GLIDES ON DRAWERS
VANITY SINK BASE	1	WHITE	<ul style="list-style-type: none">34 1/2" HIGH,SOFT CLOSE DOORS,21 " HIGH DOORS,FULL -DEPTH SHELVES,
HIGH WALL CABINET	2	WHITE	<ul style="list-style-type: none">AS HIGH AS POSSIBLE TO GIVE A BUILT-IN LOOK,SOFT CLOSE DOORS,FULL -DEPTH SHELVES,
COUNTERTOP	1	VARIES	<ul style="list-style-type: none">MANUFACTURER: WILSONART -MODEL: CLOUD MIST 9243SS,GC TO COORDINATE CUT INTO THE COUNTERTOP WITH SINK DIMENSIONS.
HANDLE	10	SATIN NICKEL	<ul style="list-style-type: none">T-BAR PULL
DOORS DRAWERS	8 2	WHITE	<ul style="list-style-type: none">SHAKER STYLE DOOR,FULL OVERLAY,DOOR PANEL: RECESSED,DOOR FRAME: 3 -IN STILE & RAIL,DRAWER FRONT: 5- PIECE RECESSED PANEL

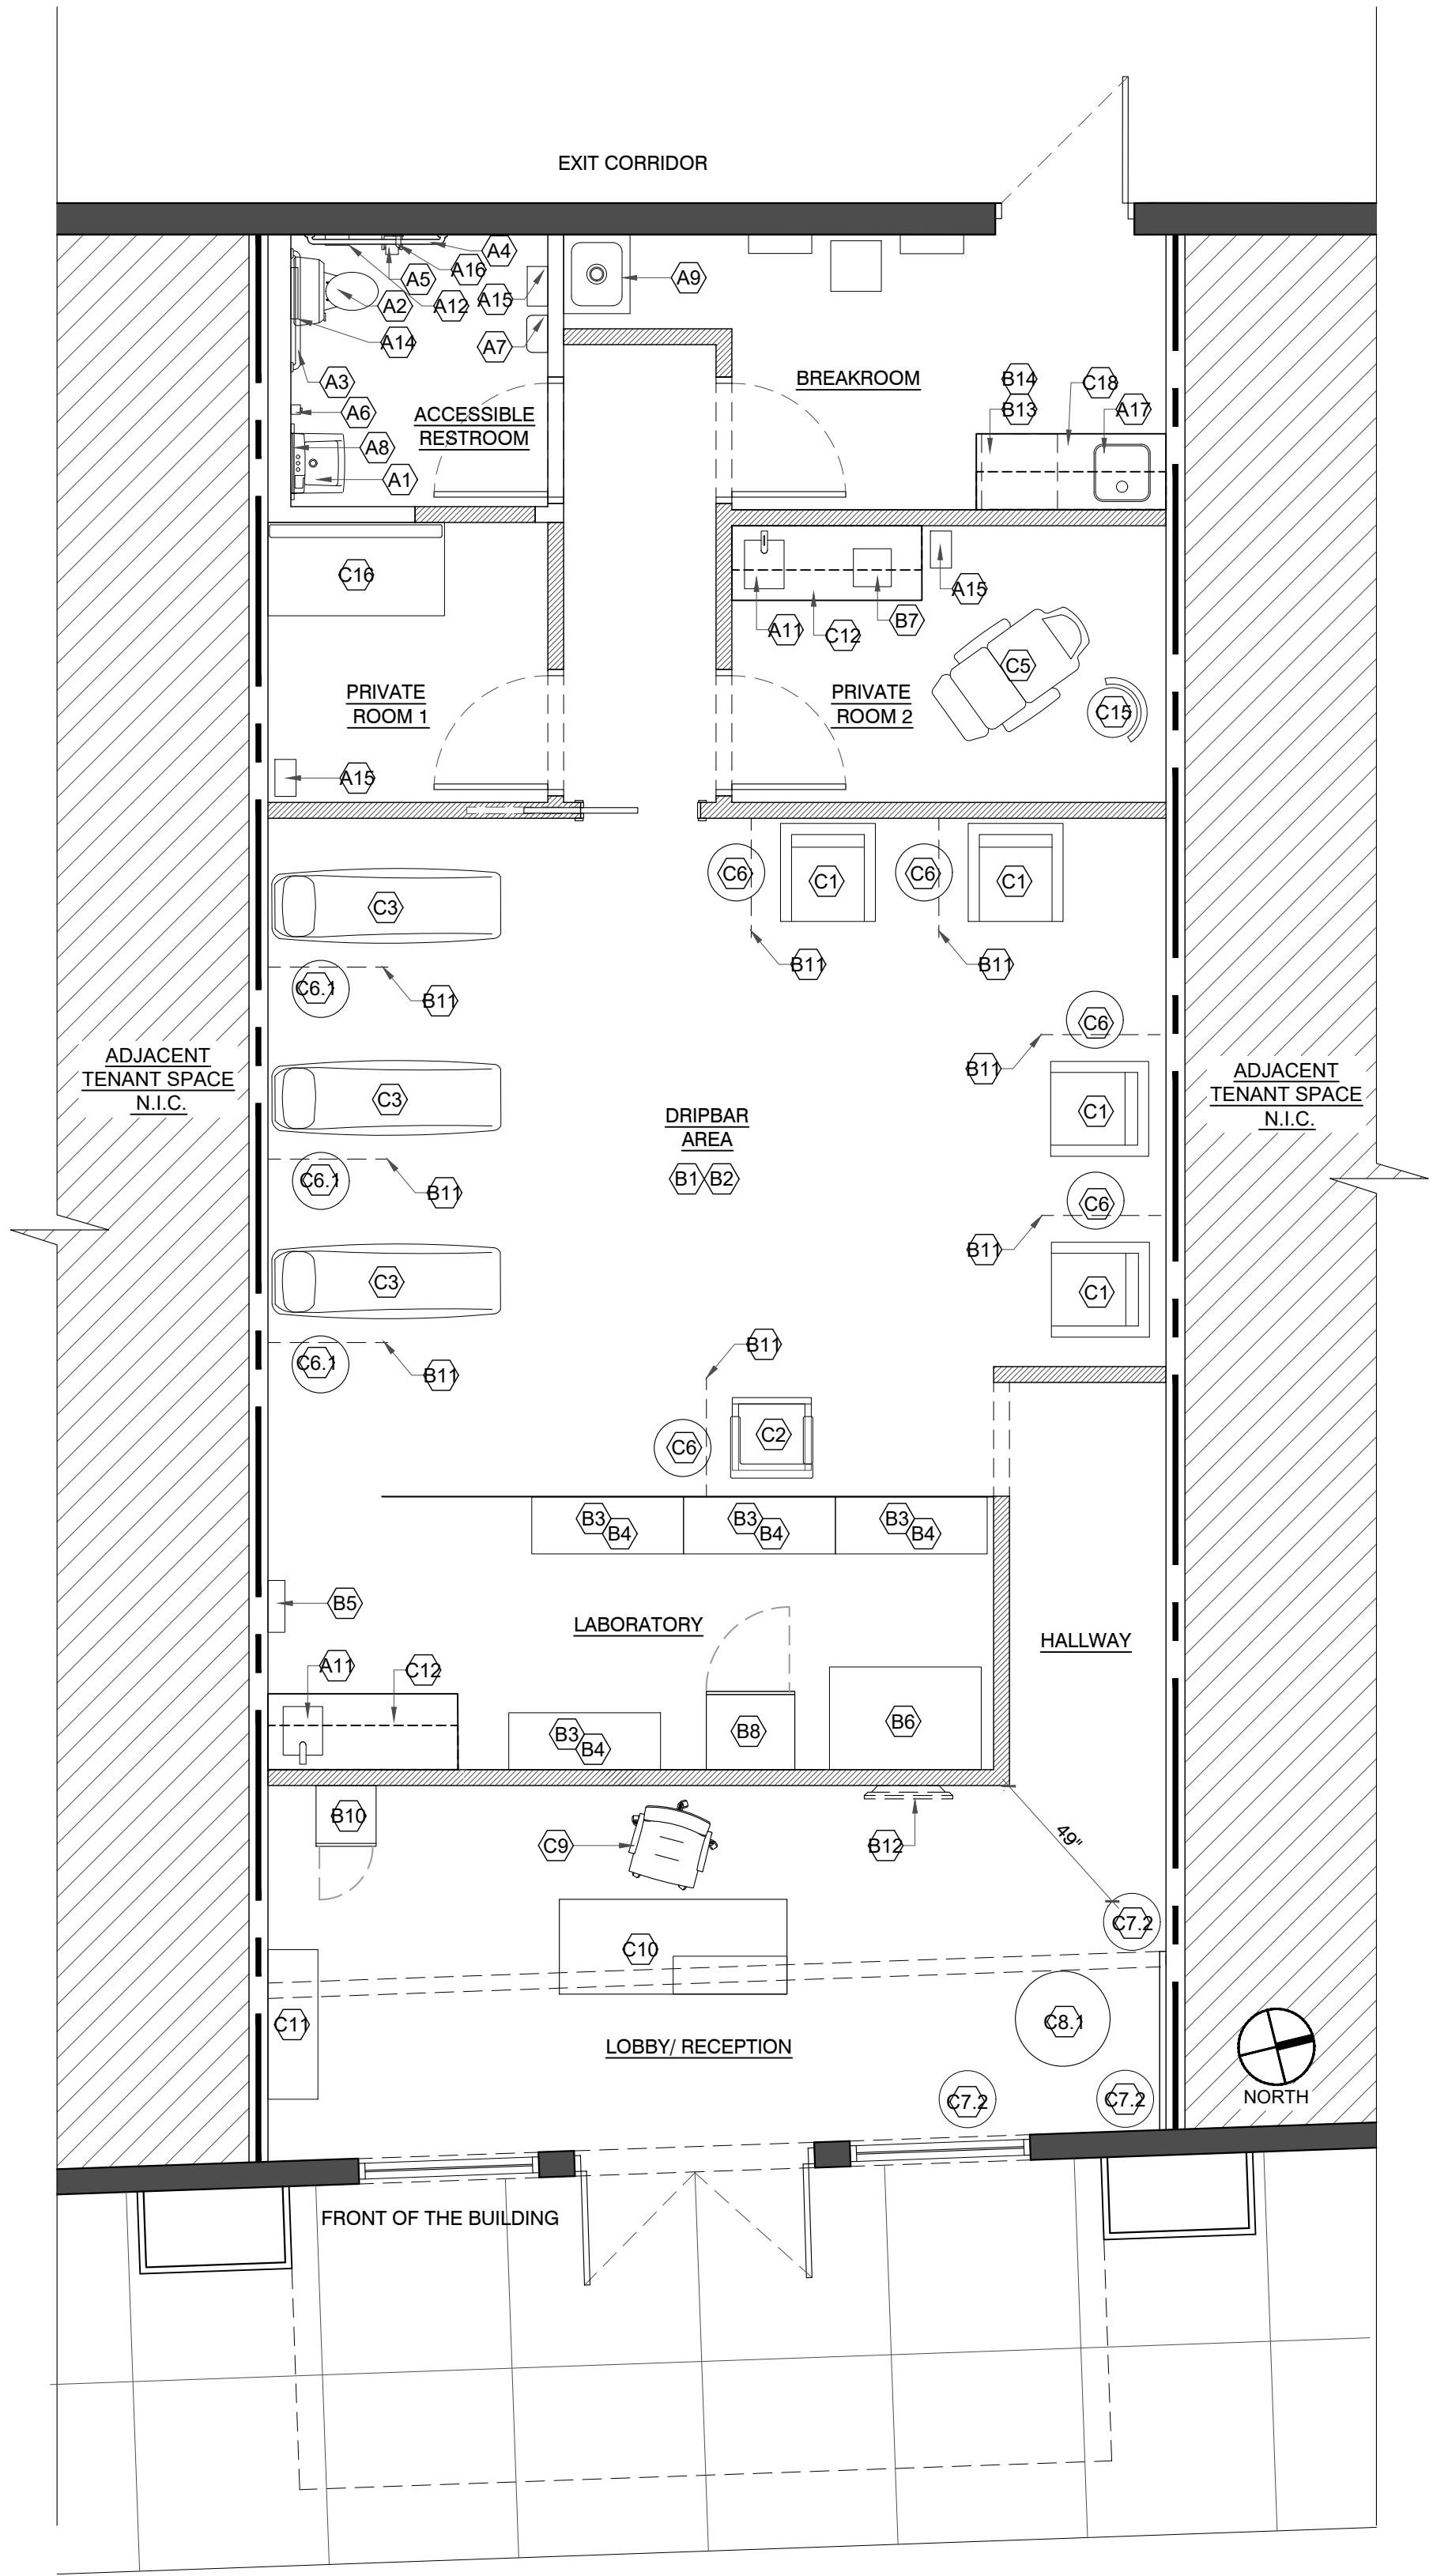

EQUIPMENT PLAN

SCALE
1/4" = 1'-0"


1

THE DRIPBAR
930-M NW BLUE PKWY,
LEES SUMMIT, MO 64086

REVISIONS DATES:

- 10/20/21 BD COMMENTS
- 10/26/21 CLIENT AND LL COMMENTS

PROFESSIONAL SEAL

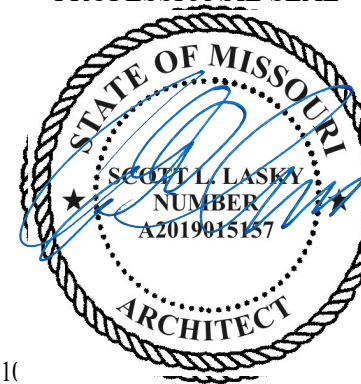


SCOTT L. LASKY A201901517
REGISTERED ARCHITECT
STATE OF MISSOURI

ISSUE DATE: 08-25-2021
PROJECT #: 328P.1313P
DRAWN BY: AJ
CHECKED BY: CC-SL

EQUIPMENT PLAN


A-1.1

3330 N.E. 34th Street
Ft. Lauderdale, FL 33308 P: 954.566.5051
www.laskyarchitect.com
architects - interior designers
engineers - construction managers

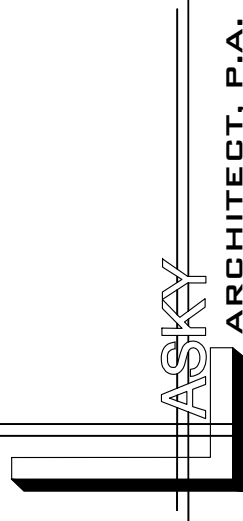

THIS DOCUMENT IS THE PROPERTY OF LASKY ARCHITECT, P.A. AND SHALL NOT BE REPRODUCED WITHOUT THE WRITTEN CONSENT OF LASKY ARCHITECT, P.A.

PROJECT

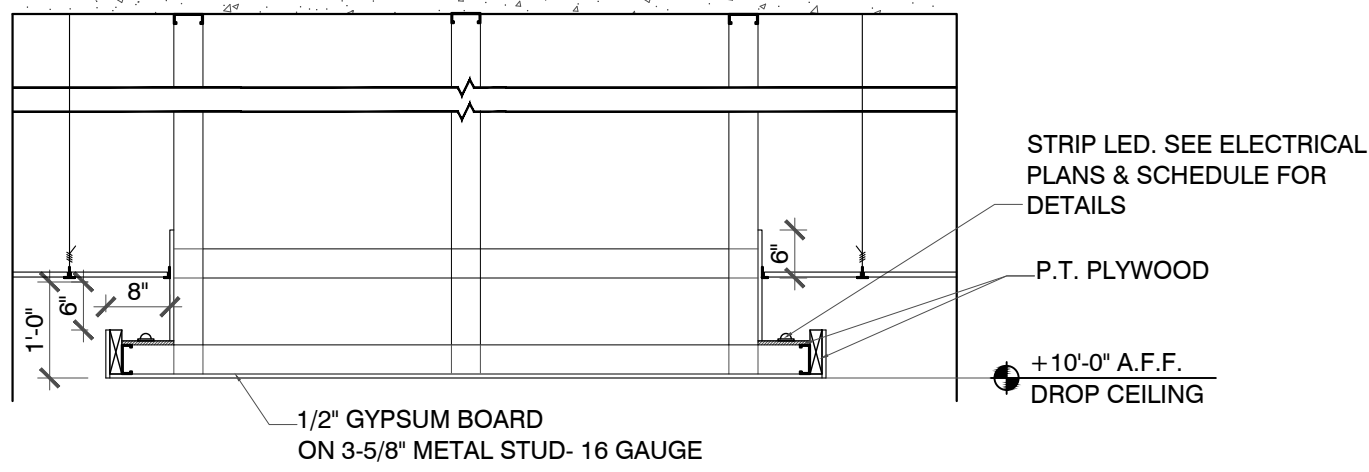

DROP CEILING DETAIL

SCALE
1/2" = 1'-0"

2


REFLECTED CEILING SCHEDULE

CODE	DESCRIPTION	SPECIFICATION
DWC-1	DRYWALL CEILING	GYPSUM WALLBOARD TO BE PAINTED COLOR: WHITE-PNT-01
ACT-1	ACOUSTICAL CEILING TILE	MANUFACTURER: AMSTRONG ITEM: CLEAN ROOM VL COLOR: WHITE DIMS: 24" X 24" X .625" GRID: DONN DX/DXL DROP-IN TILE FOR STANDARD 15/16 SUSPENDED CEILING GRID
ACT-2	ACOUSTICAL CEILING TILE	MANUFACTURER: AMSTRONG ITEM: CALLA .2824 COLOR: WHITE DIMS: 24" X 24" X .625" GRID: DONN DX/DXL DROP-IN TILE FOR STANDARD 15/16 SUSPENDED CEILING GRID
EX-C	DRYWALL CEILING	EXISTING DRYWALL CEILING TO BE PAINTED. (PNT-01)

LIGHTING SCHEDULE

SYMBOL	TYPE	DESCRIPTION	VENDOR	REMARKS
	A	4" RECESSED LED DOWNLIGHT W/ DIMMING	COMMERCIAL LIGHTING	LOBBY, OFFICE, BREAKROOM AND RESTROOM
	B	4" RECESSED LED WALL WASH W/ DIMMING	COMMERCIAL LIGHTING	LOBBY AND DRIPBAR
	C	ACCENT PENDANT LIGHT	COMMERCIAL LIGHTING	BOTTOM @ 6'-6" A.F.F. GC TO V.I.F THAT PENDANT CENTERED ON RECEPTION DESK
	D	CHANDELIER	COMMERCIAL LIGHTING	BOTTOM @ 7'-6" A.F.F
	F	LED WALL SCONCE	COMMERCIAL LIGHTING	MOUNTED @ BETWEEN 5'-0" TO 6'-0" A.F.F AND 6" FROM DOOR FRAME
	G	4" RECESSED LED DOWNLIGHT W/ DIMMING	COMMERCIAL LIGHTING	LABORATORY
	H	4" RECESSED LED DOWNLIGHT W/ DIMMING	COMMERCIAL LIGHTING	DRIPBAR
	I	LED ROPE LIGHT	COMMERCIAL LIGHTING	DRIPBAR
	EX	EXIT SIGN-EMERGENCY LIGHT COMBO	COMMERCIAL LIGHTING	
	X1	EXIT SIGN	COMMERCIAL LIGHTING	
	(E)	EXISTING TRACK LIGHTING SURFACE MOUNTED		

- LIGHTING SPECIFICATION NOTES
- ALL LIGHT FIXTURES SHALL BE FURNISHED ON NEW JUNCTION BOXES.
 - ALL LIGHTING TO BE PURCHASED FROM:
COMMERCIAL LIGHTING
NATIONAL ACCOUNT
CONTACT: JEFF BERNSTEIN
jbernstein@commercial-lighting.net
PHONE: (800)755.0155

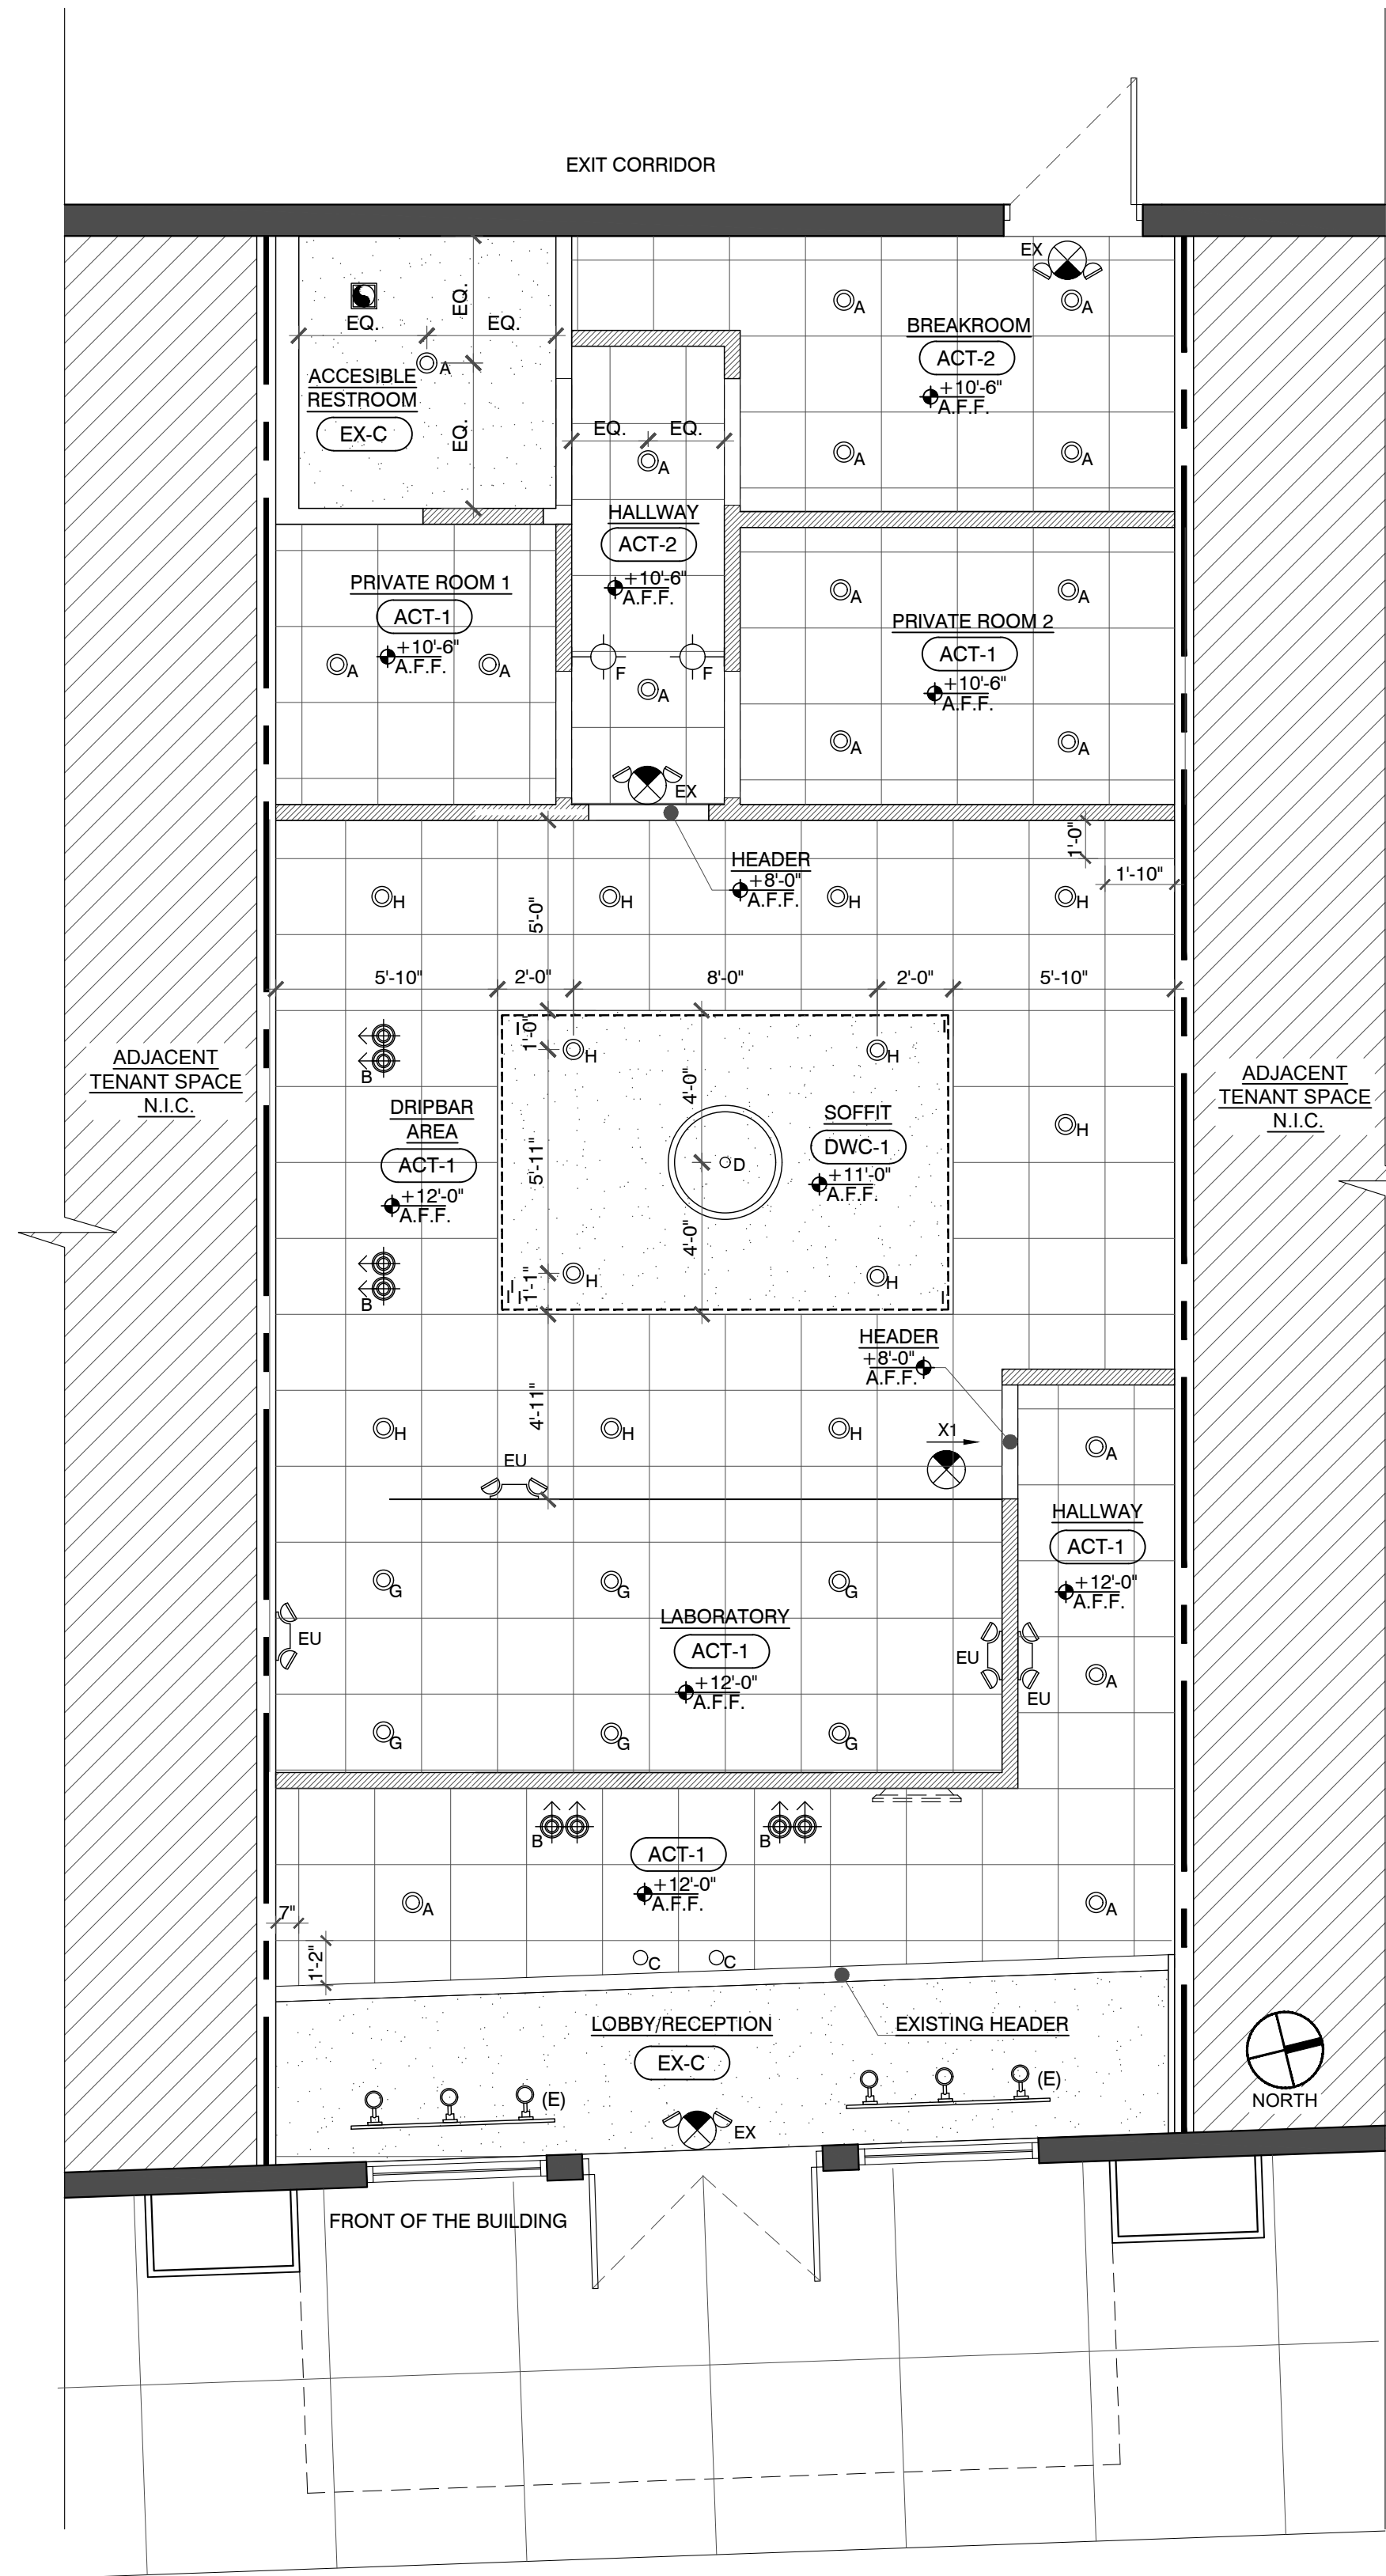


REFLECTED CEILING PLAN

SCALE
1/4" = 1'-0"

1

3330 N.E. 34th Street
Ft. Lauderdale, FL 33308 P: 954.566.5051
www.laskyarchitect.com
architects - interior designers
engineers - construction managers

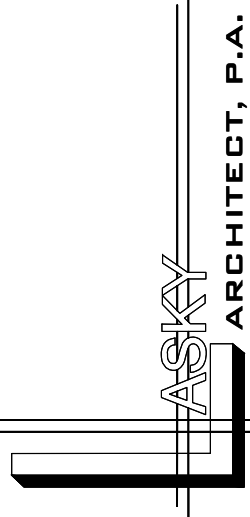

THIS DOCUMENT IS THE PROPERTY OF LASKY ARCHITECT, P.A. AND SHALL NOT BE REPRODUCED WITHOUT THE WRITTEN CONSENT OF LASKY ARCHITECT, P.A.

PROJECT

THE DRIPBAR
930-M NW BLUE PKWY,
LEES SUMMIT, MO 64086

REVISIONS DATES:

- 10/20/21 BD COMMENTS
10/26/21 CLIENT AND LL COMMENTS

PROFESSIONAL SEAL





SCOTT L. LASKY A2019015157
REGISTERED ARCHITECT
STATE OF MISSOURI

ISSUE DATE: 08-25-2021
PROJECT #: 328P.1313P
DRAWN BY: AJ
CHECKED BY: CC-SL

REFLECTED
CEILING PLAN


A-2

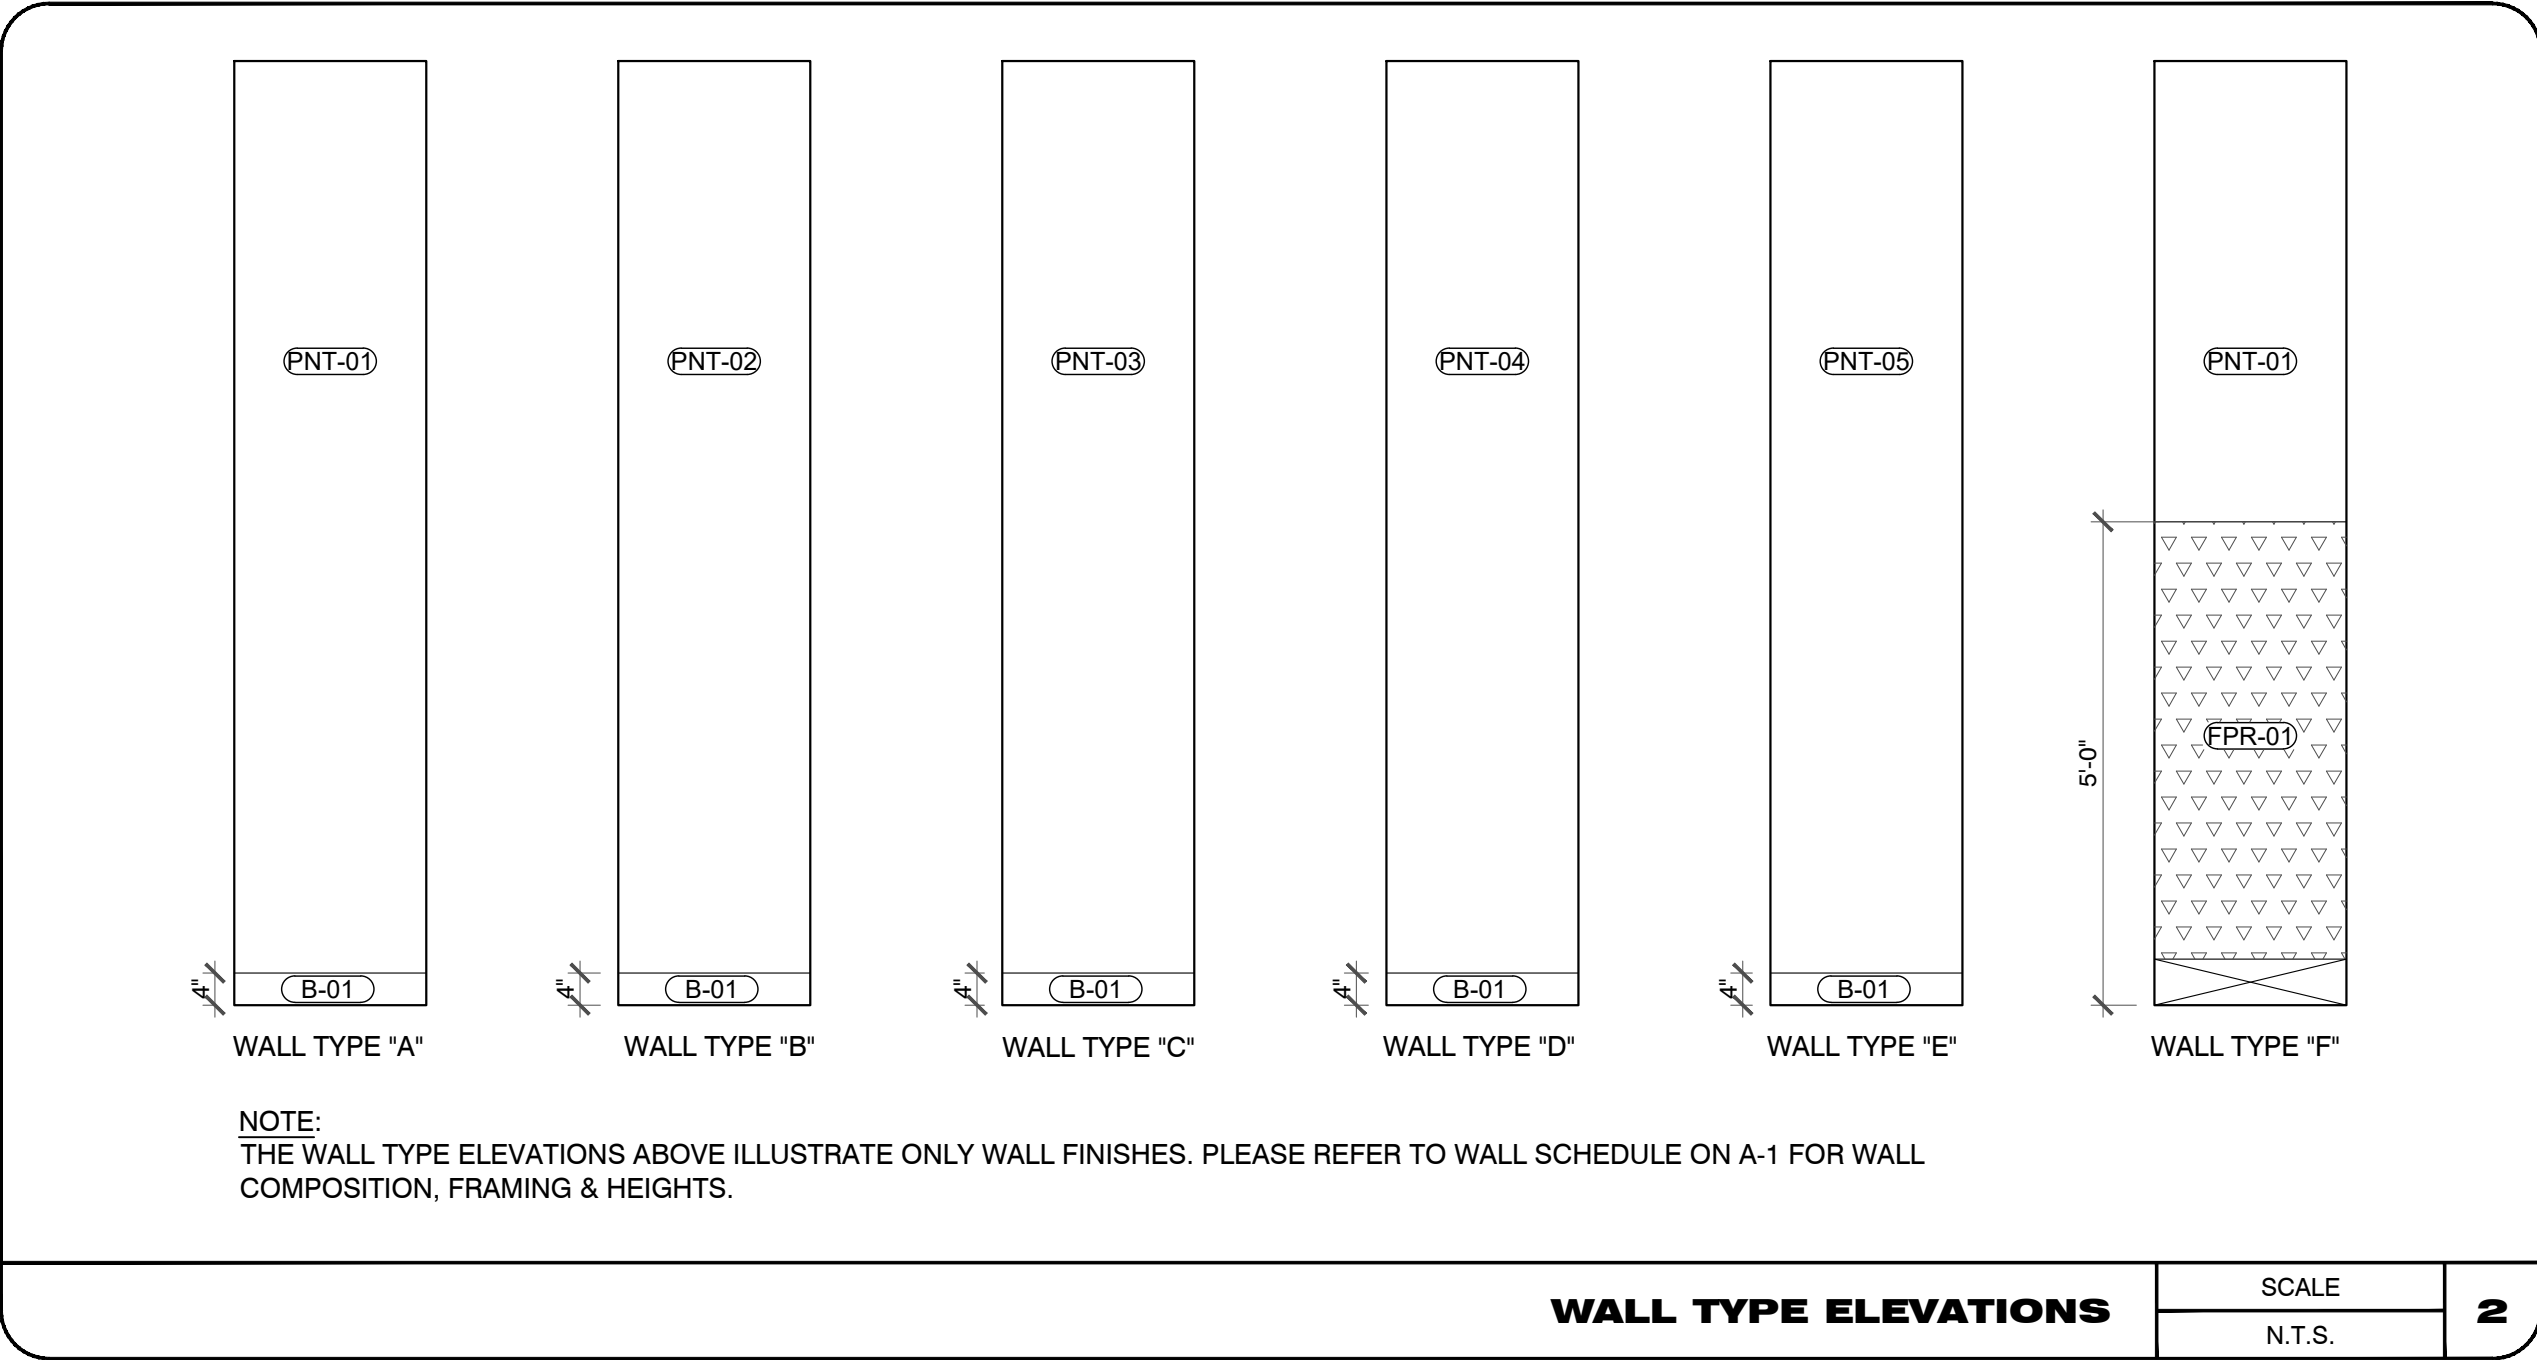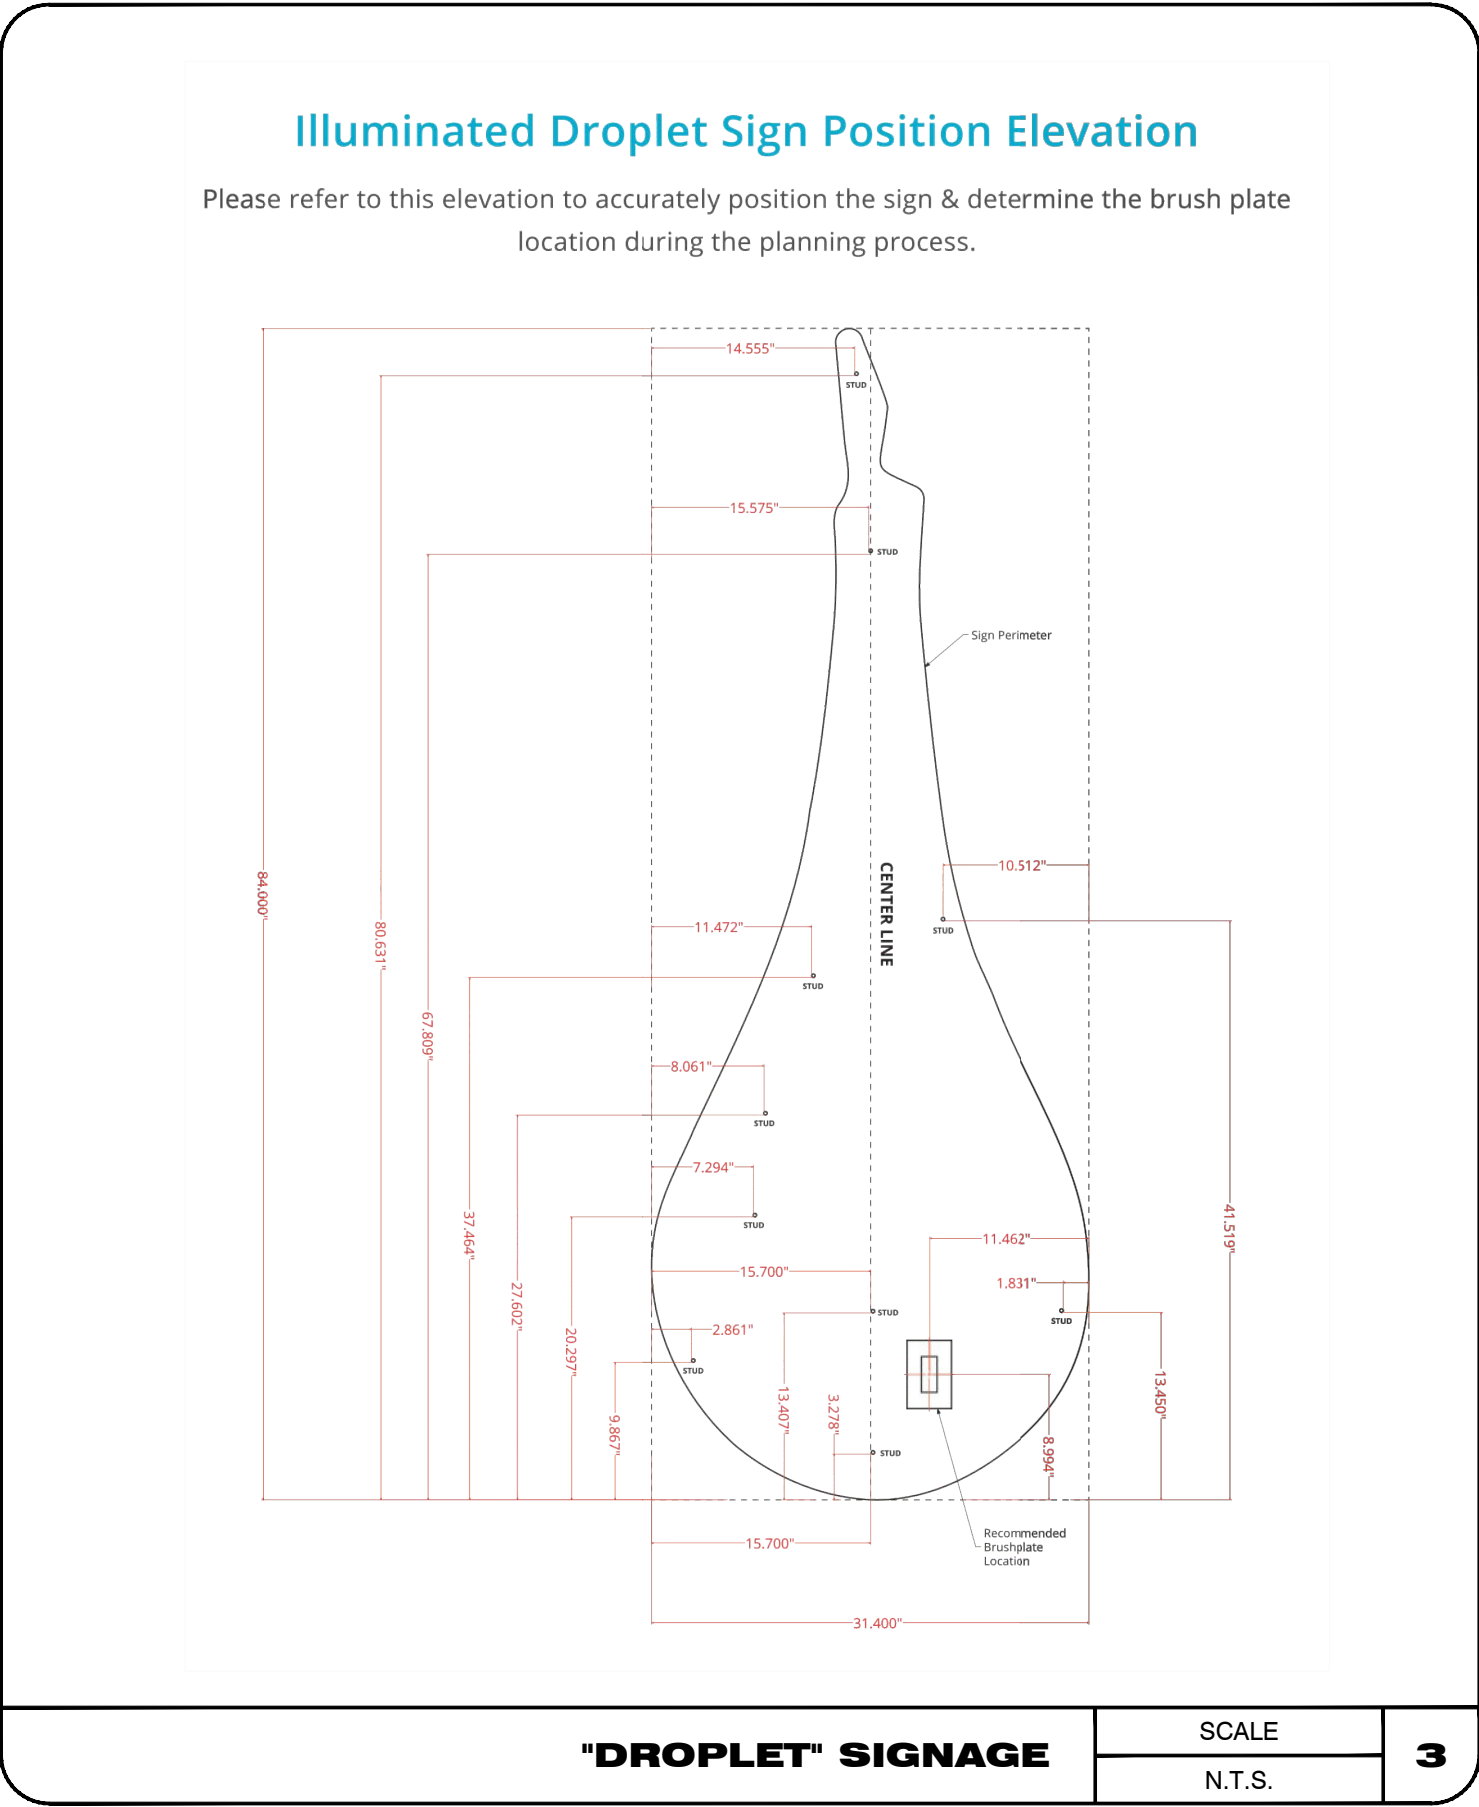

GRAPHICS SCHEDULE		
CODE	DESCRIPTION	SPECIFICATION
GR-01 LOBBY BEHIND RECEPTION	"THE DRIPBAR" GRAPHIC	"THE DRIPBAR" GRAPHIC LOGO. GC TO COORDINATE GRAPHICS DETAILS WITH CORPORATE VENDOR. NOTE: CENTER GRAPHIC ON WALL.
GR-02 DRIPBAR AREA	"WALL GRAPHIC"	WALL GRAPHIC GC TO COORDINATE GRAPHICS DETAILS WITH CORPORATE VENDOR. NOTE: CENTER GRAPHIC IN THE WALL CORNER.
GR-03 HALLWAY	" THE DROPLET"	ILLUMINATED SIGNAGE REFER TO 3/A-3. GC TO COORDINATE GRAPHICS DETAILS WITH CORPORATE VENDOR.
VENDOR NATIONAL ACCOUNT: NORTHEAST COLOR CONTACT: EMILY BERGERON PH: (603)436-8210 EMAIL:EBERGERON@NORTHEASTCOLOR		

FLOOR/ BASE SCHEDULE		
CODE	DESCRIPTION	SPECIFICATION
LVT-01 ALL SPACES	LUXURY VINYL TILE	MANUFACTURER: ARMSTRONG MODEL: SOLANO MAPLE HONEYSUCKLE NA170 NOTE: INSTALL PER MANUFACTURER SPECIFICATIONS
EXIST	PORCELAIN TILE	EXISTING PORCELAIN TILES GC TO PURCHASE SIMILAR TILES FOR PATCH AND REPAIR.
B-01 ALL SPACES	WALL BASE	PVC TRIM BOARD MANUFACTURER: ROYAL BUILDING PRODUCTS MODEL: # 02709 HEIGHT: 4 INCH COLOR: WHITE SUPPLIER: LOWE'S NOTE: INSTALL PER MANUFACTURER SPECIFICATIONS

WALL FINISH SCHEDULE		
CODE	DESCRIPTION	SPECIFICATION
PNT-01 ALL SPACES	PAINT	SHERWIN WILLIAMS COLOR: SW7007 8917-2.5,8988-2.5,8991-2.25 COLOR: WHITE FINISH: EGGSHELL
PNT-02 PRIVATE ROOMS	PAINT	VALSPAR (LOWE'S) # 101-6,107-4,113-11,217-2 COLOR: GREY FINISH: EGGSHELL
PNT-03 RESTROOM	PAINT	VALSPAR (LOWE'S) # 102-9,113-23.5,203-2.5 COLOR: AQUA FINISH: EGGSHELL
PNT-04 DRIPBAR AREA	PAINT	VALSPAR (LOWE'S) # 107-8.5,113-9.5,114-16,203-0.5 COLOR: GREEN FINISH: EGGSHELL
PNT-05 RECEPTION	PAINT	VALSPAR (LOWE'S) # 102-22.5,107-1.5,109-2,113-9 COLOR: DARK BLUE FINISH: EGGSHELL
FPR-01 BREAKROOM/ STORAGE	FIBERGLASS REINFORCED PLASTIC	FPR PANEL MANUFACTURER: MARLITE MODEL: STANDARD / PEBBLED COLOR: WHITE (P 100)
NOTE: 1. IN RESTROOM, ALL PAINT TO BE EPOXY BASE. 2. APPLY PRIMER AND THEN TWO COATS OF PAINT.		

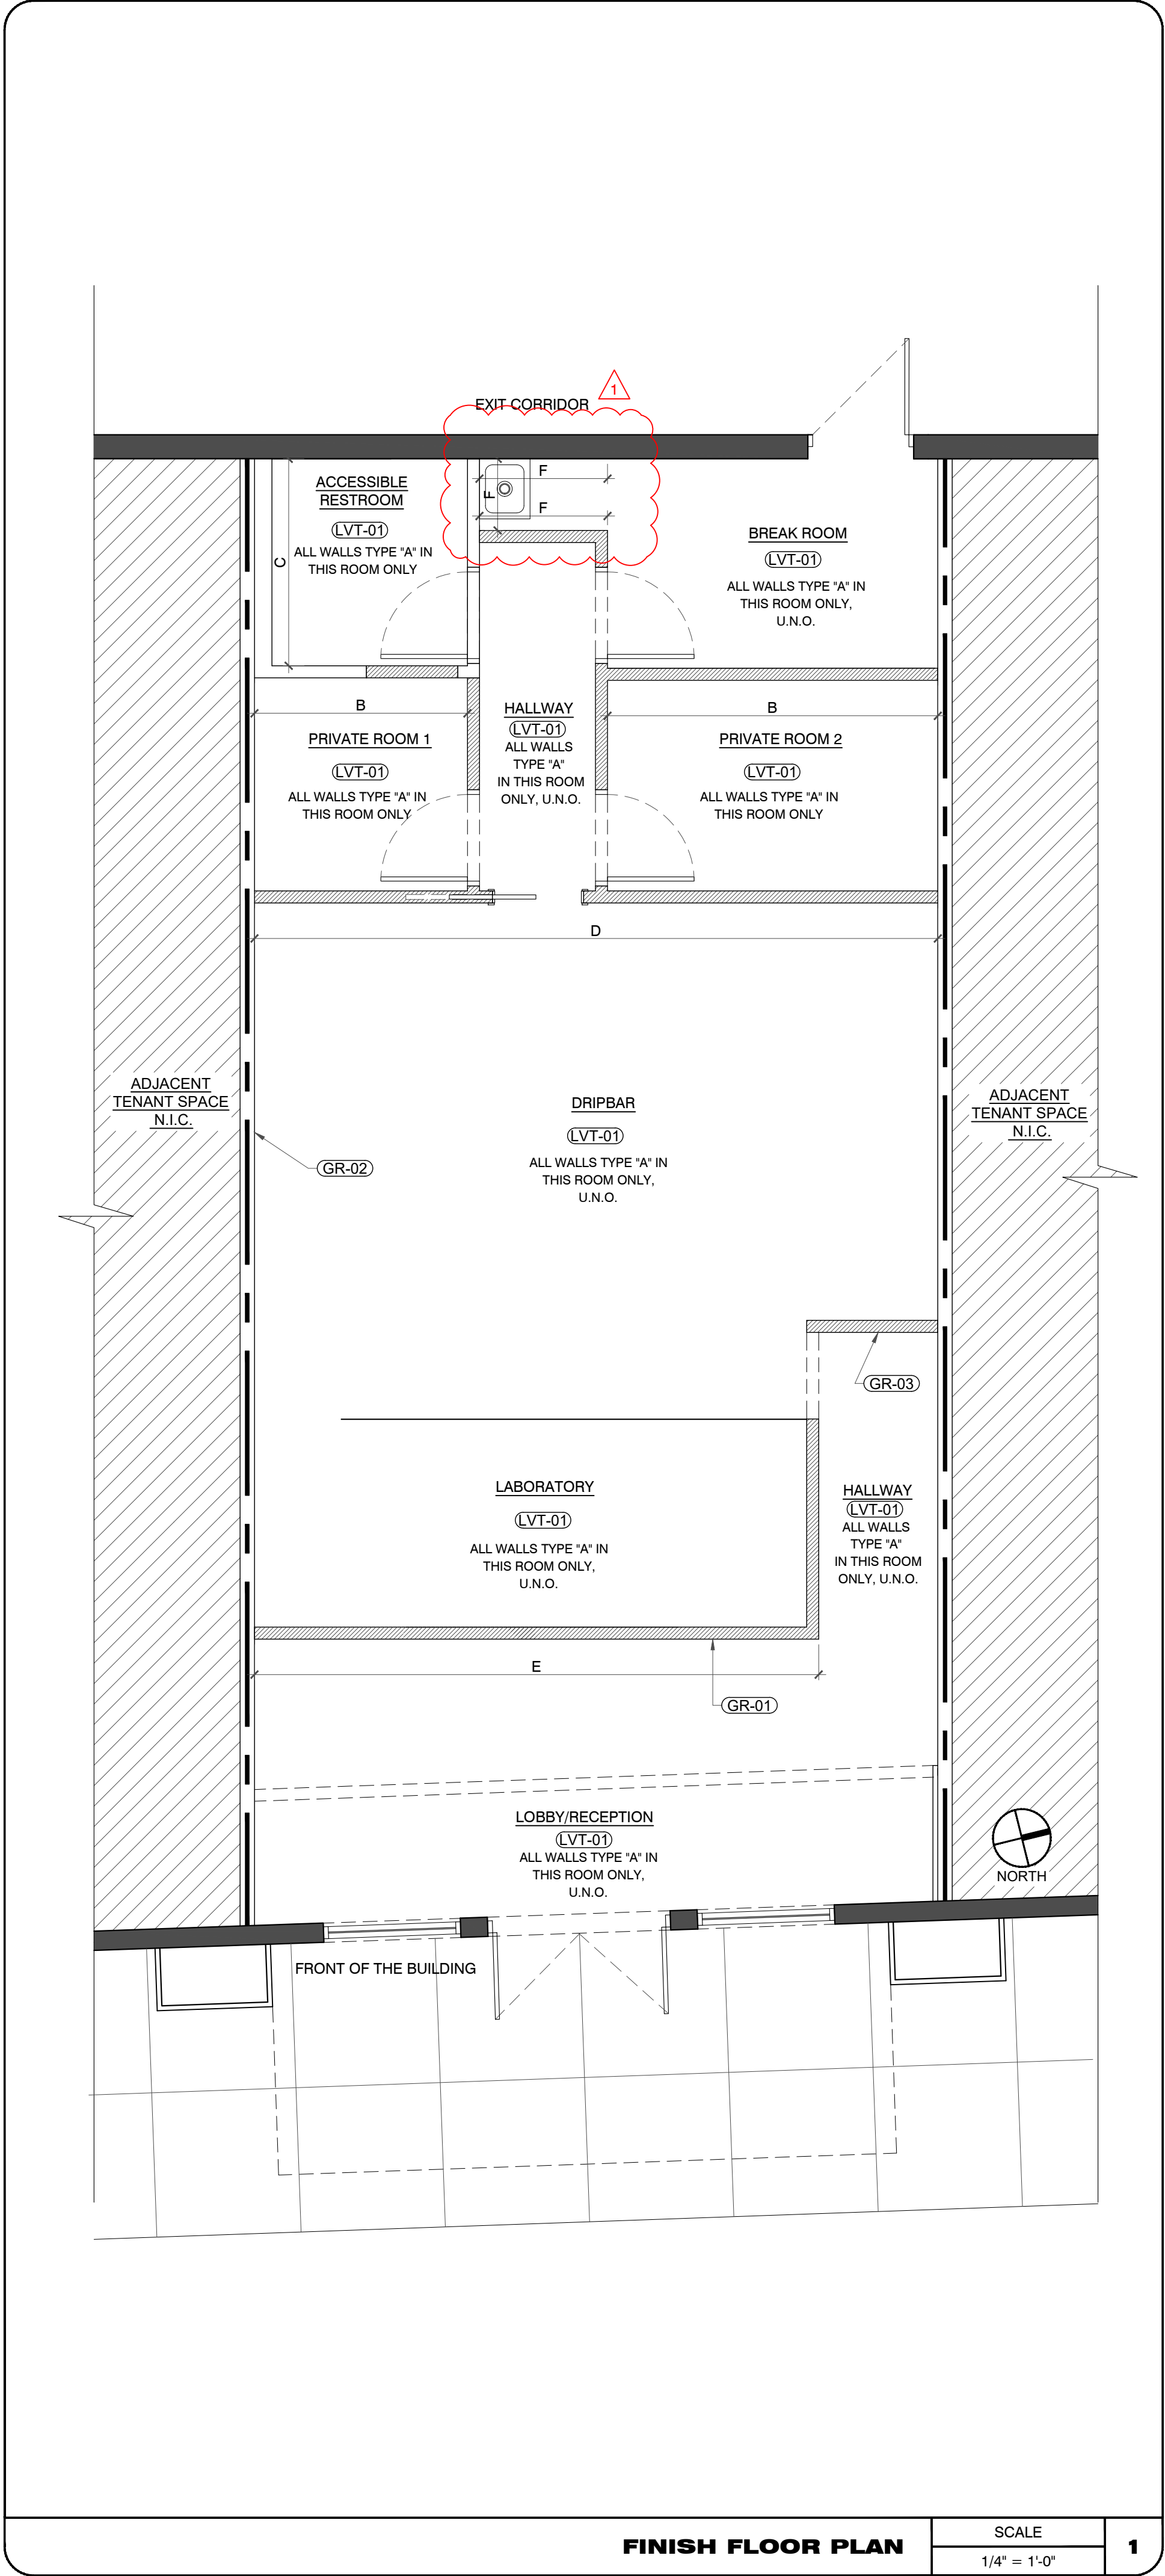

3330 N.E. 34th Street
Ft. Lauderdale, FL 33308 P: 954.566.5051
www.laskyarchitect.com
architects - interior designers
engineers - construction managers

ASKY ARCHITECT, P.A.

THIS DOCUMENT IS THE PROPERTY OF LASKY ARCHITECT, P.A. AND SHALL NOT BE REPRODUCED WITHOUT THE WRITTEN CONSENT OF LASKY ARCHITECT, P.A.

PROJECT

THE DRIPBAR

930-M NW BLUE PKWY,
LEES SUMMIT, MO 64086

REVISIONS DATES:

10/20/21 BD COMMENTS

10/26/21 CLIENT AND LL COMMENTS

PROFESSIONAL SEAL

STATE OF MISSOURI

SCOTT L. LASKY
NUMBER A2019015157
REGISTERED ARCHITECT
STATE OF MISSOURI

ISSUE DATE: 08-25-2021
PROJECT #: 328P.1313P
DRAWN BY: AJ
CHECKED BY: CC-SL

FINISH PLAN

A-3

PLUMBING NOTES

- ALL WORKMANSHIP AND MATERIALS SHALL BE IN STRICT ACCORDANCE WITH APPLICABLE LOCAL CODES, RULES AND ORDINANCES.
- PLUMBING CONTRACTOR SHALL REVIEW ALL DRAWINGS OF THIS SET. CONTRACTOR TO VERIFY THAT ALL EQUIPMENT SHOWN AS EXISTING MATCHES THE DESCRIPTIONS AND SPECIFICATIONS SHOWN ON DRAWINGS AND SCHEDULES. IF DIFFERENT NOTIFY ARCHITECT/ENGINEER BEFORE BIDDING, ORDERING OR PRECEDING WITH WORK.
- ALL EQUIPMENT WHICH IS TO REMAIN MUST BE REFURBISHED TO A LIKE NEW CONDITION.
- PLUMBING CONTRACTOR SHALL VISIT THE JOB SITE AND THOROUGHLY FAMILIARIZE HIMSELF WITH ALL EXISTING CONDITIONS.
- ALL MATERIALS SHALL BE NEW.
- ALL WORK SHALL BE PERFORMED BY A LICENSED PLUMBING CONTRACTOR IN A FIRST CLASS WORKMANLIKE MANNER. THE COMPLETED SYSTEM SHALL BE FULLY OPERATIVE. ALL EXCAVATION AND BACKFILL AS REQUIRED FOR THIS PHASE OF CONSTRUCTION SHALL BE A PART OF THIS CONTRACT.
- REQUIRED INSURANCE SHALL BE PROVIDED BY THE PLUMBING CONTRACTOR FOR PROTECTION AGAINST PUBLIC LIABILITY AND PROPERTY DAMAGE FOR THE DURATION OF THE WORK.
- PLUMBING CONTRACTOR SHALL SECURE AND PAY FOR ALL PERMITS, FEES, INSPECTION AND TESTS. PLUMBING CONTRACTOR TO OBTAIN PERMIT AND APPROVED SUBMITTALS PRIOR TO BEGINNING WORK OR ORDERING EQUIPMENT. PLUMBING CONTRACTOR MUST BE PRESENT FOR ALL INSPECTIONS OF HIS WORK BY REGULATORY AUTHORITIES.
- DRAWINGS ARE DIAGRAMMATIC. DO NOT SCALE FOR THE EXACT LOCATION OF FIXTURES, PIPING, EQUIPMENT, ETC.
- ALL WORK SHALL BE COORDINATED WITH OTHER TRADES TO AVOID INTERFERENCE WITH THE PROGRESS OF CONSTRUCTION. REPORT ANY DISCREPANCY TO ENGINEER/ARCHITECT PRIOR TO BEGINNING CONSTRUCTION.
- VERIFY LOCATION, SIZE, DIRECTION OF FLOW AND INVERTS OF ALL EXISTING UTILITIES PRIOR TO BEGINNING OF CONSTRUCTION. ADVISE ENGINEER OF ANY DISCREPANCIES.
- EXPOSED WATER PIPING SHALL BE TYPE "L" COPPER FOR 2" AND UNDER. WATER PIPING IN WALLS AND UNDERGROUND MAY BE "PEX" TYPE PIPING THAT MEETS ANSIS/NSF STANDARD 61.
- SOIL, WASTE, VENT AND RAINWATER PIPING SHALL BE PVC BUT MAY NOT RUN THRU RATED ASSEMBLIES OR IN PLENUMS.
- ALL FIXTURES MUST BE PROVIDED WITH READILY ACCESSIBLE STOPS AND APPROPRIATELY MARKED ACCESS PANELS. COORDINATE LOCATIONS WITH GENERAL CONTRACTOR PRIOR TO INSTALLATION.
- FURNISH AND INSTALL APPROVED AIR CHAMBERS AT EACH PLUMBING FIXTURE GROUP AS PER CODE AND WITH GOOD ENGINEERING PRACTICE.
- DIELECTRIC COUPLINGS ARE REQUIRED BETWEEN ALL DISSIMILAR METAL IN PIPING AND EQUIPMENT CONNECTIONS; EXCEPT AT WATER HEATER AS PER CODE.
- ISOLATE COPPER PIPE FROM HANGER OR SUPPORTS WITH ISOLATOR PAD.
- ALL FIRE RATED FLOOR AND WALL PENETRATIONS SHALL BE PROPERLY PROTECTED FROM FIRE, SMOKE AND WATER PENETRATION BY FILLING VOIDS BETWEEN PIPE AND WALL/FLOOR SLEEVES WITH FIRE RATED FOAM, TO ACHIEVE THE SAME RATING AS WALLS OR FLOORS AS PART OF THE PLUMBER'S WORK.
- PLUMBING CONTRACTOR SHALL GUARANTEE ALL MATERIALS AND WORKMANSHIP FREE FROM DEFECTS FOR A PERIOD OF NOT LESS THAN ONE (1) YEAR FROM DATE OF CERTIFICATE OF OCCUPANCY. CORRECTION OF ANY DEFECTS SHALL BE COMPLETED WITHOUT ADDITIONAL CHARGE WITHIN 72 HOURS OF NOTIFICATION AND SHALL INCLUDE REPLACEMENT OR REPAIR OF ANY OTHER PHASE OF THE INSTALLATION WHICH MAY HAVE BEEN DAMAGED. PROVIDE COPY TO LL.
- STUDOR MINIMAXI AIR ADMITTANCE VALVES MAY NOT BE USED AS AN ALTERNATE TO VENT PIPING THRU ROOF.
- PROVIDE CHROME PLATED COMBINATION COVER PLATE AND CLEAN OUT PLUG OR ACCESS PANEL FOR ALL CLEANOUTS.
- NO COMBUSTIBLE MATERIAL TO BE USED IN MECHANICAL ROOMS OR IN CEILING SPACES WHERE USED AS RETURN AIR PLENUMS.
- NO WATER, SANITARY OR DRAINAGE PIPING PERMITTED IN ELECTRICAL OR ELEVATOR EQUIPMENT ROOMS.
- WATER PIPING INSULATION SHALL BE 1" THICK ARMAFLEX INSTALLED IN ACCORDANCE WITH MANUFACTURER'S INSTRUCTIONS FOR ALL HOT WATER PIPING. WHERE DOMESTIC WATER TEMPERATURES CAN CAUSE SWEATING, ALL COLD WATER PIPING SHALL BE INSULATED WITH 1/2" THICK ARMAFLEX INSULATION.
- CONDENSATE DRAIN LINES TO BE RUN UNDER SLAB IN PVC SCH40 PIPE AND STUBBED OUT OF WALL TO UNIT. TIE-IN OF A/C TO BE BY OTHERS. PVC PIPING WITH 1/2" THICK ARMAFLEX INSULATION MAY BE USED IN LOCATIONS WHERE ALLOWED BY LOCAL CODES. SEE PLUMBING DRAWINGS FOR SIZE AND LOCATION OF PIPING. PVC WILL BE MIN. SCHEDULE 40 FOR SIZE AND LOCATION OF PIPING. PVC WILL BE MIN. SCHEDULE 40.
- PROVIDE ANGLE STOPS ON ALL WATER SERVICE LINES TO FIXTURES FOR INDIVIDUAL SHUT-OFF.
- NO JOINTS UNDERGROUND FOR COPPER.
- PLUMBING FIXTURES SHALL COMPLY WITH IPC.
- WATER HAMMER ARRESTORS AS PER IPC.
- PLUMBING CONTRACTOR TO PROVIDE ANTI-SCALDING VALVE FOR TUBS AND SHOWERS.
- PLUMBING CONTRACTOR SHALL REVIEW ALL BID DOCUMENTATION.
- PLUMBING CONTRACTOR SHALL REVIEW WALL FINISHES @ LOCATION REQUIRING BARRIER-FREE COMPLIANCE (EXAMPLE: CENTER LINE TO TOILET).
- CONSTRUCTION "AS BUILT" DRAWINGS AND DOCUMENTS SHALL BE PROVIDED TO THE OWNER WITHIN 30 DAYS AFTER THE DATE OF ACCEPTANCE. PROVIDE A COPY TO LL.
- OPERATION MANUALS AND MAINTENANCE MANUALS SHALL BE PROVIDED TO THE BUILDING OWNER. PROVIDE A COPY TO LL.

SCOPE OF WORK

PROVIDE ALL PLUMBING FOR IV VITAMIN FACILITY INCLUDING ALL WATER & SANITARY LINES AND CONNECT TO EXISTING UTILITIES. PROVIDE NEW TANKLESS WATER HEATER.
COORDINATE WITH GC AND MECHANICAL CONTRACTOR FOR ANY REQUIRED CONDENSATE LINES.

EXISTING CONTIDITONS NOTES

STOP AND READ
THE CONTRACTOR AND SUB-CONTRACTORS SHALL NOT INITIATE ANY WORK UNTIL EXISTING FIELD CONDITIONS ARE PROPERLY VERIFIED. THIS SHALL HOLD TRUE FOR FIRST GENERATION AND 2ND GENERATION SPACES. WHEN DEMOLITION IS REQUIRED, THAT WILL BE PERMITTED TO EXPOSE CONDITIONS. THESE VERIFICATIONS SHALL INCLUDE BUT NOT LIMITED TO: DIMENSIONS BOTH HORIZONTALLY AND VERTICAL, ELECTRICAL SERVICE /PANELS LOCATION AND VOLTS/PHASE, LOCATION/QTY OF ROOF MOUNTED HVAC EQUIPMENT, CONFIRM THAT INTERIOR HVAC HUNG UNITS HAVE PROPER SUPPORT CONNECTIONS FOR EXISTING STRUCTURE, FIRE SPRINKLER MAIN RUNS, TOILET ROOM DIMENSIONS, DOOR SWING FOR DOORS TO REMAIN AND ETC. IF NOT VERIFIED AND DISCOVERED AT A LATER TIME, THE CONTRACTOR SHALL REIMBURSE THE ARCHITECT FOR THE REDESIGN FEE. THIS DOES NOT INCLUDE HIDDEN WORK I.E. PITCH OF SANITARY LINES, ACTUAL CONDITIONS OF EXISTING HVAC EQUIPMENT, STRUCTURAL COLUMNS/BEARING WALLS OR CONDITIONS OF GREASE INTERCEPTORS AND ETC.

ENERGY CONSERVATION NOTES

- AS PER 2018 INTERNATIONAL ENERGY CONSERVATION CODE, WITH AMENDMENTS, SECTION C404.4, PIPING FROM A WATER HEATER TO THE TERMINATION OF HEATED WATER FIXTURE SUPPLY PIPE SHALL BE INSULATED IN ACCORDANCE WITH TABLE C403.11.3 OF MINIMUM PIPE INSULATION THICKNESS.
- HOT WATER SYSTEM PIPING IS DESIGNED AS PER MAXIMUM ALLOWED PIPE LENGTH METHOD AS PER 2018 INTERNATIONAL ENERGY CONSERVATION CODE, WITH AMENDMENTS. C404.5.1. THE HOT WATER VOLUME FROM THE NEAREST SOURCE OF HEATED WATER TO THE TERMINATION OF THE FIXTURE SUPPLY PIPE SHALL BE AS PER MAXIMUM PIPING LENGTH TABLE.
- AS PER 2018 INTERNATIONAL ENERGY CONSERVATION CODE, WITH AMENDMENTS, C404.6.1, CONTROLS FOR CIRCULATING HOT WATER SYSTEM PUMPS SHALL START THE PUMP BASED ON THE IDENTIFICATION OF A DEMAND FOR HOT WATER WITHIN THE OCCUPANCY. THE CONTROLS SHALL AUTOMATICALLY TURN OFF THE PUMP WHEN THE WATER IN THE CIRCULATION LOOP IS AT THE DESIRED TEMPERATURE AND WHEN THERE IS NOT DEMAND FOR HOT WATER.
- AS PER 2018 INTERNATIONAL ENERGY CONSERVATION CODE, WITH AMENDMENTS, C404.7, THE CONTROLS SHALL LIMIT THE TEMPERATURE OF THE WATER ENTERING THE COLD-WATER PIPING TO NOT GREATER THAN 104°F (40°C).

FIXTURE BRANCH SCHEDULES



FIXTURE	COLD WATER	HOT WATER	WASTE	VENT
WATER CLOSET (TANK)	3/4"	--	4"	2"
LAVATORY	1/2"	1/2"	2"	1 1/2"-2"
SERVICE SINK	1/2"	1/2"	2"	1 1/2"-2"
FLOOR DRAIN	--	--	3"-4"	--

SANITRAY PLAN NOTES

- CONNECT NEW 4" SANITARY LINE INTO LANDLORDS EXISTING SANITARY SERVICE. FIELD VERIFY EXACT LOCATION, SIZE AND FLOW DIRECTION OF LANDLORDS MAIN PRIOR TO BIDDING.
- EXISTING PLUMBING FIXTURE WITH PLUMBING CONNECTION TO REMAIN. CONTRACTOR TO FIELD VERIFY EXISTING CONDITIONS REPLACE IF REQUIRED.

PLUMBING LEGEND

	SANITARY SEWER PIPING
	EX. SANITARY SEWER PIPING
	VENT PIPING
	DOMESTIC COLD WATER PIPING
	HOT WATER PIPING
	HOT WATER RETURN PIPING
	PIPE RISE OR DROP
	PIPE RISER UP
	BALANCING VALVE
	CAPPED END OF PIPE
	CLEAN OUT
	P-TRAP
	SHUT-OFF VALVE
	DOMESTIC COLD WATER
	DOMESTIC HOT WATER
	DOMESTIC HOT WATER RETURN
	VENT THRU ROOF
	GATE VALVE
	CHECK VALVE
	BALANCING VALVE
	WATER HAMMER ARRESTER
	FLOOR DRAIN
	FLOOR SINK
	POINT OF CONNECTION
	THERMOSTATIC MIXING VALVE

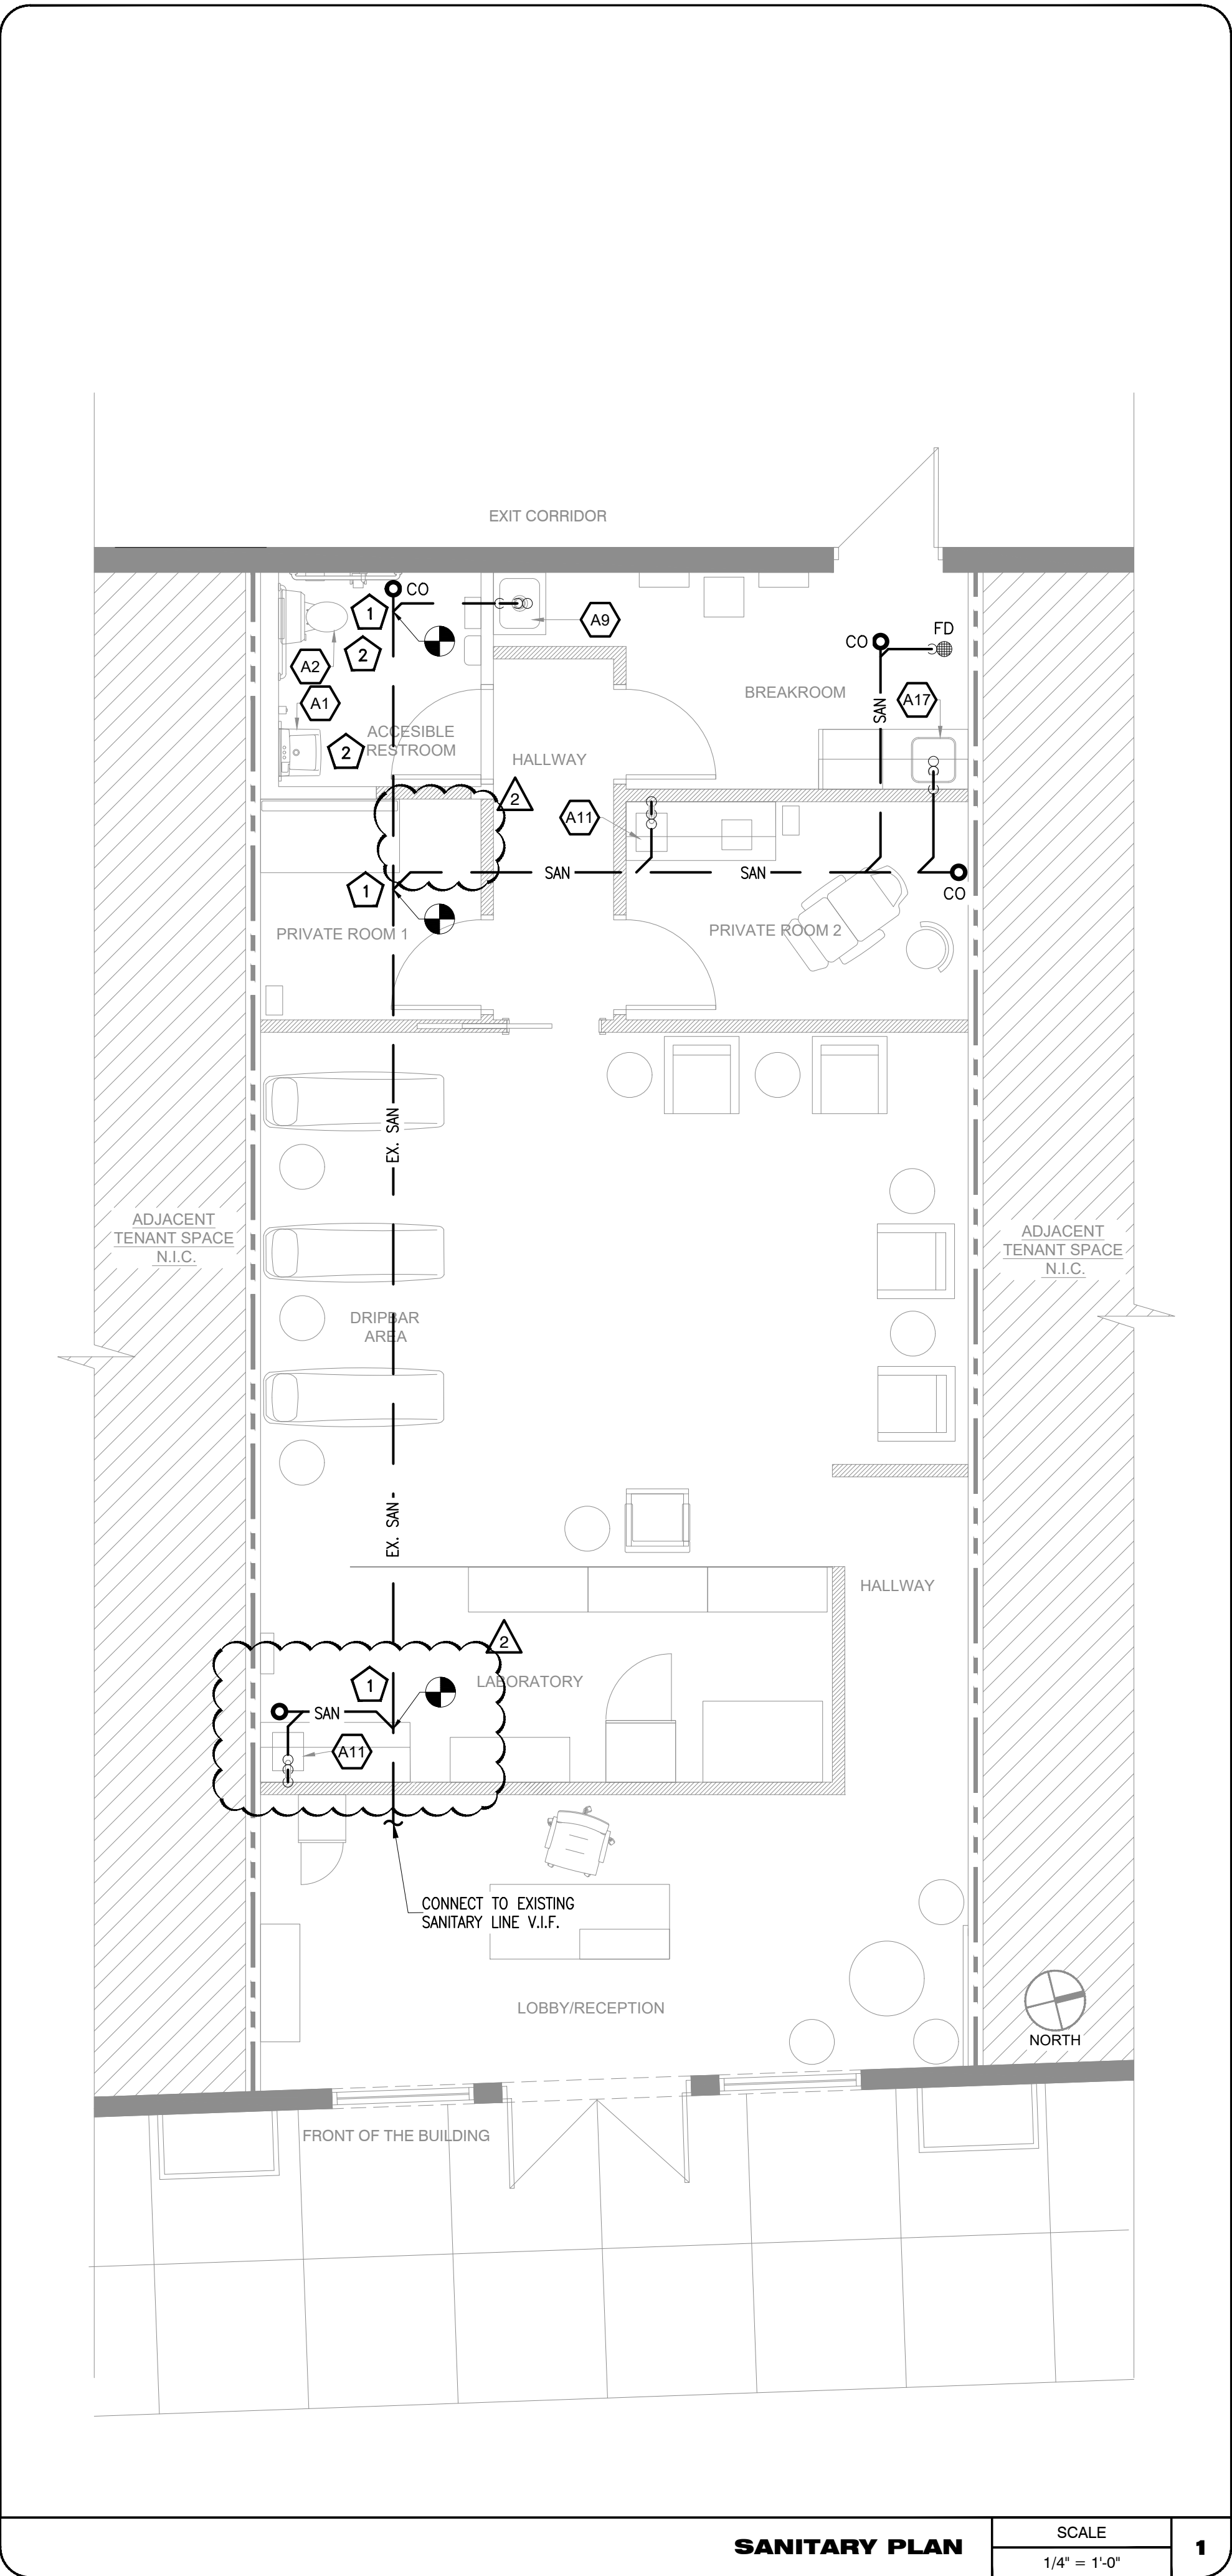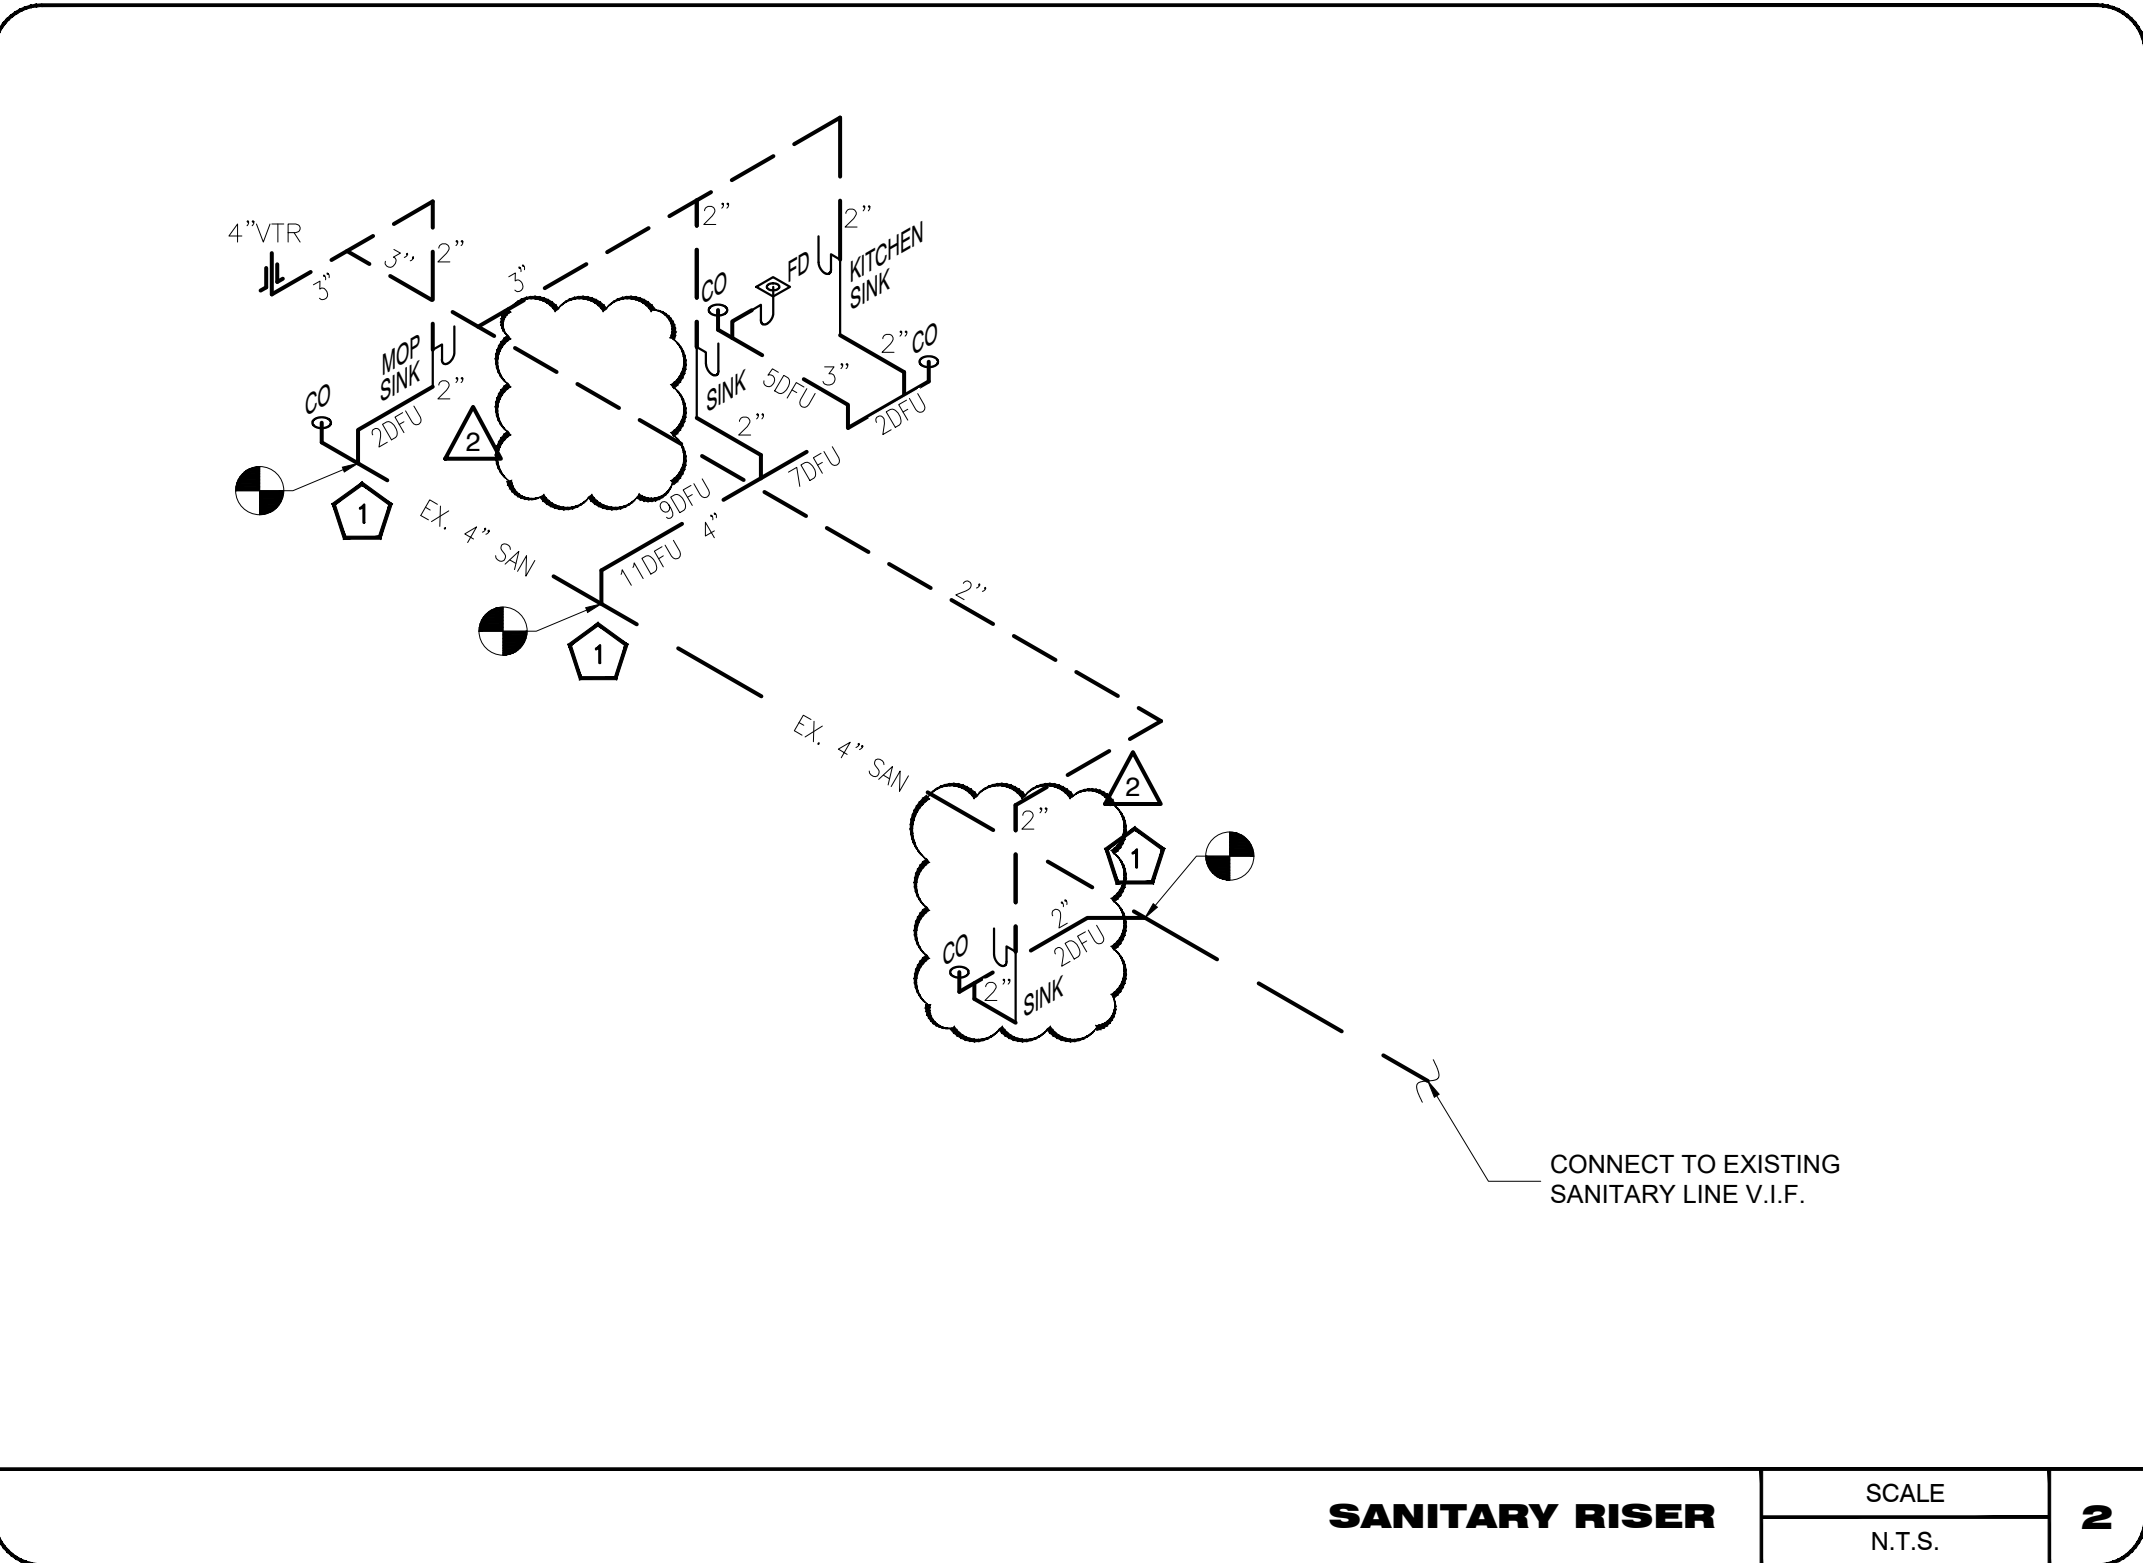

NY ENGINEERS

382 NE 191ST ST.
SUITE, 49674, MIAMI
FL 33179

THIS DOCUMENT IS THE PROPERTY OF NEARBY ENGINEERS, AND SHALL NOT BE REPRODUCED WITHOUT THE WRITTEN CONSENT OF NEARBY ENGINEERS.

PROJECT

THE DRIPBAR

930-M NW BLUE PKWY,
LEES SUMMIT, MO 64086

REVISIONS DATES:

2 10.26.2021 REVISION 2

PROFESSIONAL SEAL



ERIC ENGELL #2002014528
PROFESSIONAL ENGINEER
STATE OF MISSOURI

ISSUE DATE: 08.23.2021
PROJECT #: 328P.1313P
DRAWN BY: NYE
CHECKED BY: NYE

PLUMBING
SANITARY PLAN,
RISER & NOTES


P-1

RECIRCULATION PUMP SCHEDULE	
MANUFACTURER & MODEL	GRUNDFOS UP 15-35 SUC TLC
EQUIPMENT TAG	CP
STATUS	NEW
GPM	2
WATER TEMP. (°F)	140
PUMP TYPE	INLINE
MHP	86 WATTS
V/PH/Hz	115/1/60
RPM	2800
SERVICE FACTOR	1.0

1. CONNECT NEW 1" CW LINE WITH RPZ TO EXISTING CW WATER LINE WITH NEW WATER METER. CONTRACTOR TO INSTALL SHUTOFF VALVE AT ACCESSIBLE LOCATION. CONTRACTOR TO FIELD VERIFY PIPE SIZE AND LOCATION IN FIELD.
2. EXISTING PLUMBING FIXTURE WITH PLUMBING CONNECTION TO REMAIN. CONTRACTOR TO FIELD VERIFY EXISTING CONDITIONS REPLACE IF REQUIRED


WATER HEATER SCHEDULE		
MANUFACTURER	HUBBELL	CHROMONITE
MODEL	TX27-374	CM-20L/208
EQUIPMENT TAG	WH1	WH-2
STATUS	NEW	NEW
CAPACITY	TANKLESS	TANKLESS
QUANTITY	1	1
KW	24	4.16
FLOW RATE	2.73 GPM*	0.5 GPM*
ENERGY FACTOR	0.92	0.97
VOLTAGE	480/3/60	208/1/60
AMPERAGE	29	15
WEIGHT (EMPTY)	21 LBS.	5 LBS.
* @ 60° F TEMPERATURE RISE		

PLUMBING FIXTURE SCHEDULE					WATER		WASTE		
Item No.	Qty.	Description	Manufacturer	Model	Hot	Cold	Waste	Usage	Spec
A1	1	LAVATORY		EXISTING TO REMAIN			1 1/2"		
	1	LAVATORY FAUCET			1/2"	1/2"		0.5	GPM
	5	THERMAL MIXING VALVES			1/2"	1/2"			
	1	INSULATED PLUMBING COVERS							
A2	1	WATER CLOSET		EXISTING TO REMAIN		1/2"	4"	1.6	GPF
	1	ELONGATED SEAT							
A9	1	MOP SINK	ADVANCE TABCO	9-OP-44			2"		
	1	MOP SINK FAUCET	REGENCY	600FM086	1/2"	1/2"			
A10	2	WATER HEATER	SEE SCHEDULE	SEE SCHEDULE	3/4"	3/4"			
A11	2	SINK	MATRIX DECOR	MD-LU14189R1			1 1/2"		
	2	SINK FAUCET	MOEN	87702	1/2"	1/2"			
A17	1	KITCHEN SINK					1 1/2"		
		FLOOR DRAINS*	ZURN	Z-1446 C/W					

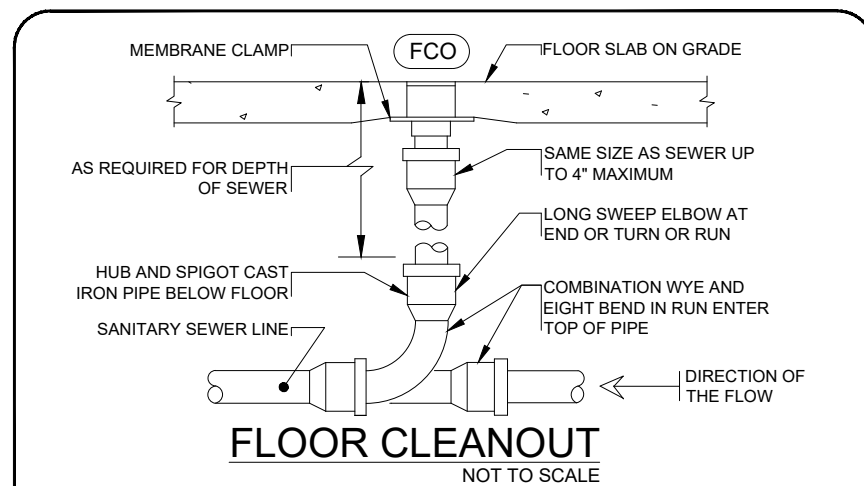


FLOOR CLEANOUT DETAIL NOTES

- 1) LOCATE CLEANOUT AT THIS LOCATIONS:
- A) BUILDING EXIT
 - B) AT TURNS OF PIPES GREATER THAN 45 DEGREES
 - C) AT 90° INTERVALS ON STRAIGHT RUNS
 - D) WHERE IS SHOWN ON PLANS
 - E) WHERE IS 18" CLEAR AROUND

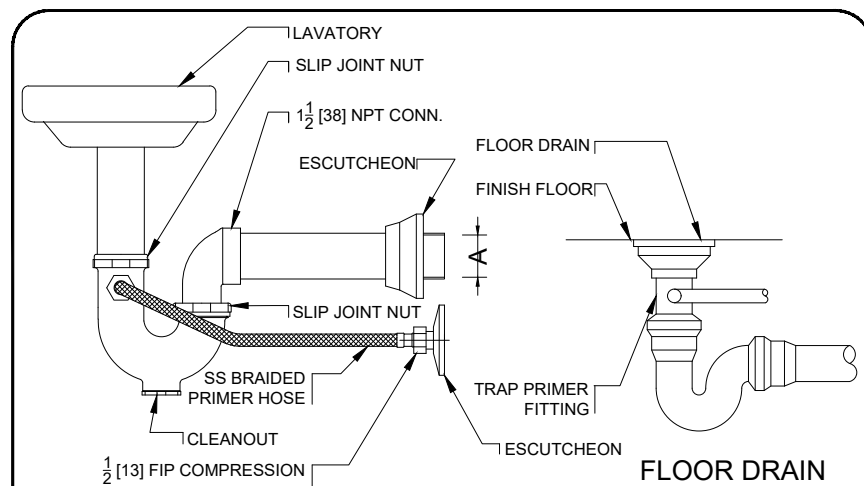


TRAP RESEAL DETAIL

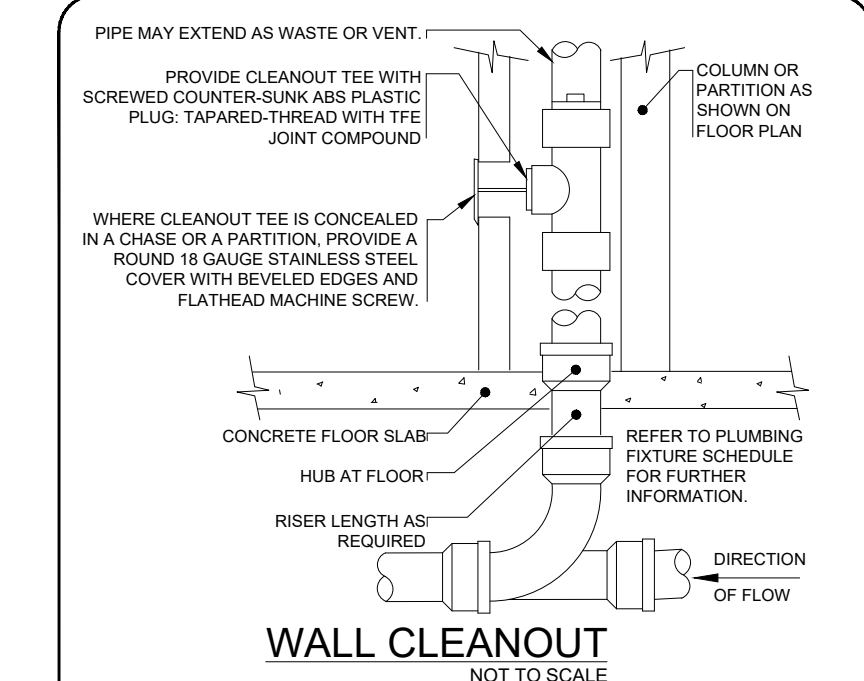

WALL CLEANOUT DETAIL NOTES

- 1) PROVIDE WCO WHERE SHOWN ON PLANE, AND ON SANITARY WASTE BRANCHES NOT SERVED WITH A FLOOR CLEANOUT
- 2) LOCATE ABOVE FIXTURE FLOOR RIM WITHIN 4" OF FLOOR.
- 3) CONSULT LOCAL CODES FOR OTHER WCO REQUIREMENTS.
- 4) LONG SWEEP AT END OF LINE OR COMBINATION WYE AND EIGHT BEND IN RUN OF LINE
- 5) CLEAN OUT FACE SHALL BE WITHIN 4" OF WALL SURFACE. PROVIDE A PIPE EXTENSION IF REQUIRED
- 6) REFER TO PLUMBING FIXTURE SCHEDULE FOR FURTHER INFORMATION FOR

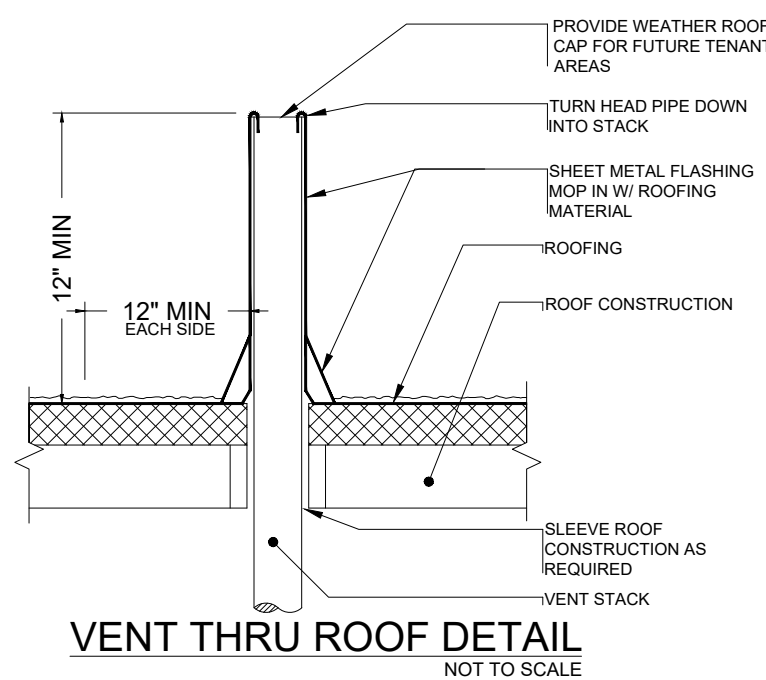


NOTE- ALL ROOFING ACCESSORIES MUST BE GAF APPROVED

VENT THRU ROOF DETAIL NOTE


ANY VENT FIRE WITHIN 10'-0" OF ANY DOOR, WINDOW, OR EXHAUST OPENING SHALL
EXTEND NOT LESS THAN 3'-0" ABOVE SUCH

<u>FIXTURE FACTOR VALUE *</u>		
1 WATER CLOSET @ 5	=	5
1 LAVATORY @ 2	=	2
3 SINKS @ 4	=	12
1 KITCHEN SINK @ 4	=	4
1 MOP SINK @ 3	=	3
TOTAL	=	26

* TABLE E103.3(2) - 2018 INTERNATIONAL
PLUMBING CODE, WITH AMENDMENTS
1" METER & 1" WATER LINE REQUIRED

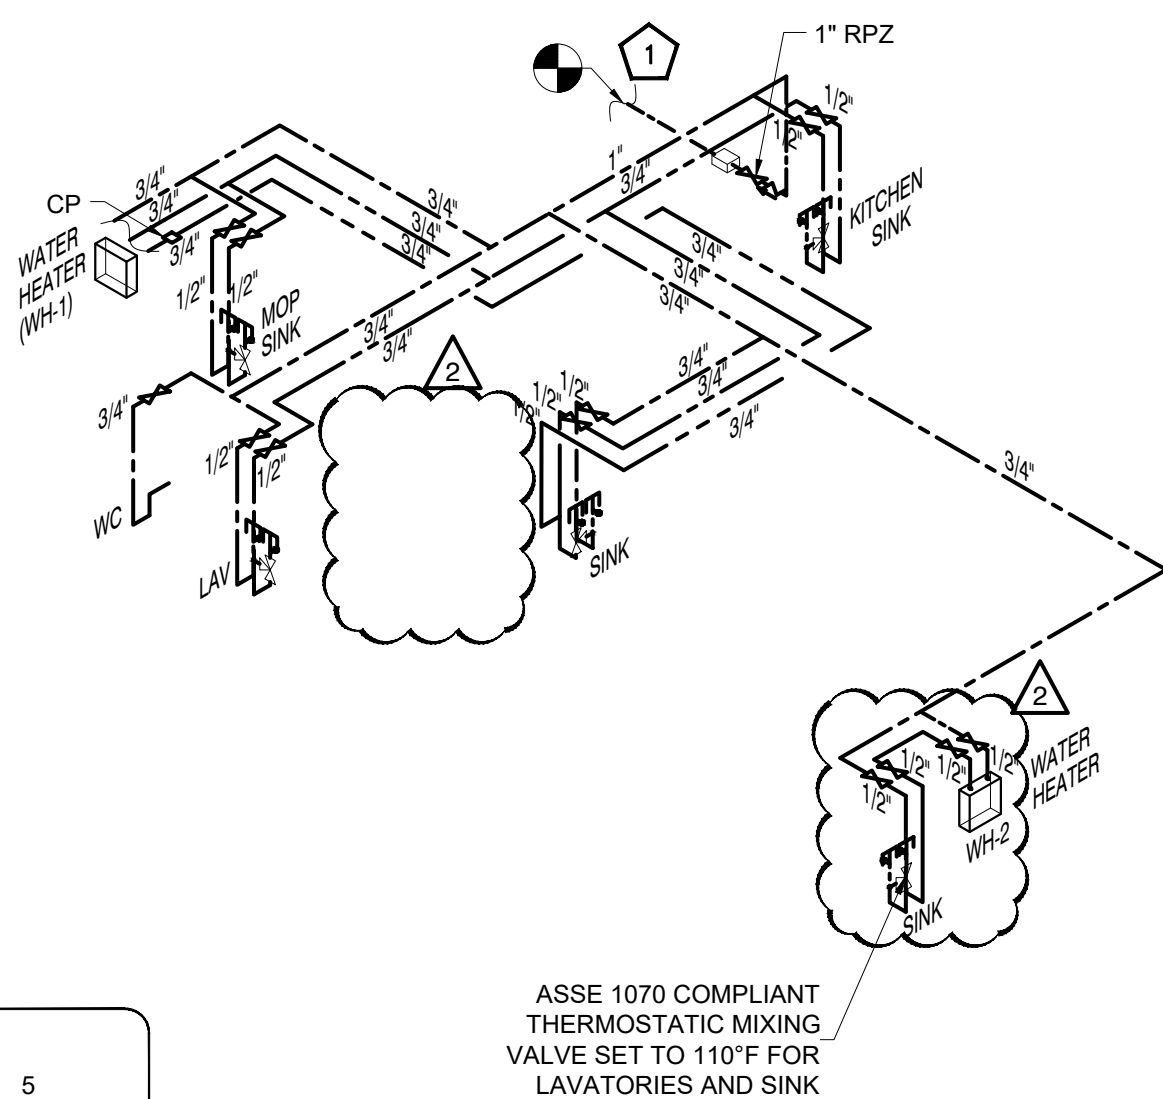

ASSE 1070 COMPLIANT
THERMOSTATIC MIXING
VALVE SET TO 110°F FOR
LAVATORIES AND SINK

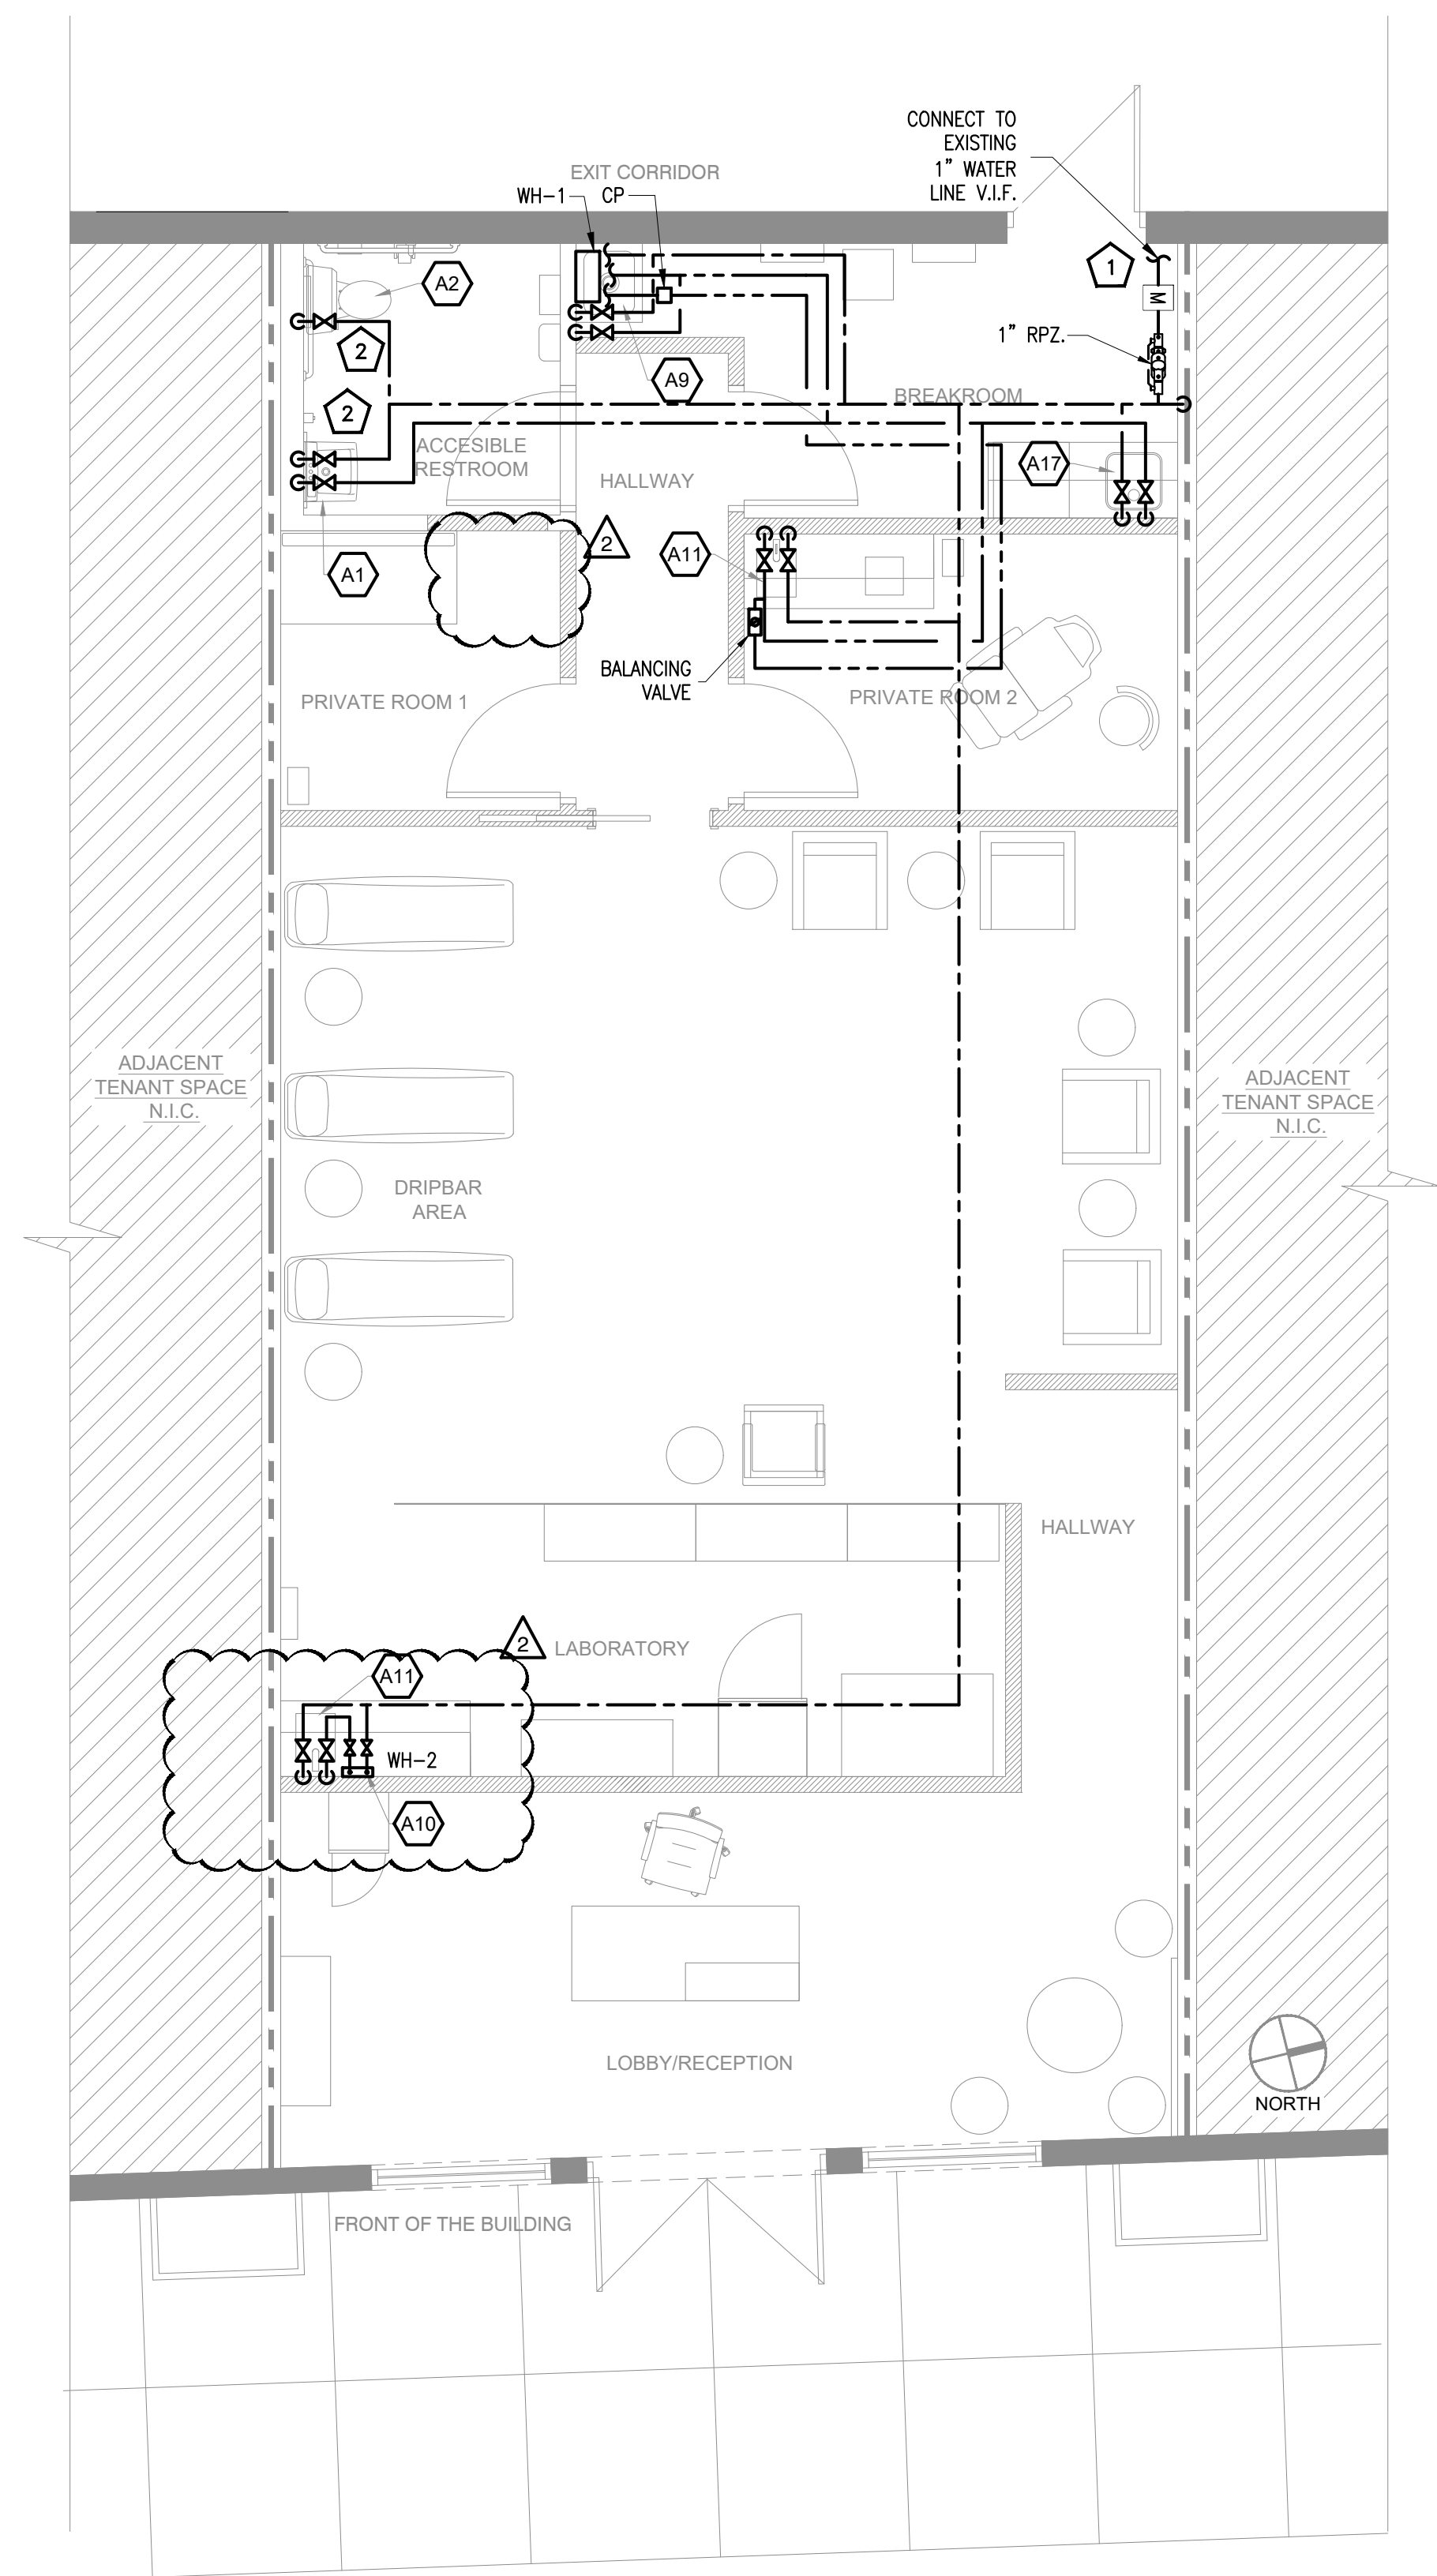

WATER RISER

SCALE
N.T.S.

2

WATER PLAN

SCALE
1/4" = 1'-0"

1

THE DRIPBAR

930-M NW BLUE PKWY,
LEES SUMMIT, MO 64086

REVISIONS DATES:

10.26.2021 REVISION 2

PROFESSIONAL SEAL



ERIC ENGELL #2002014523
PROFESSIONAL ENGINEER
STATE OF MISSOURI

ISSUE DATE: 08.23.2021

PROJECT #: 328P.1313P

DRAWN BY: NYE

CHECKED BY: NYE

PLUMBING WATER PLAN, RISER & NOTES

EXISTING CONDITION NOTES

THE CONTRACTOR AND SUB CONTRACTOR SHALL NOT INITIATE ANY WORK UNTIL EXISTING FIELD CONDITIONS ARE PROPERLY VERIFIED. THIS SHALL HOLD TRUE FOR FIRST GENERATION AND SECOND GENERATION SPACES. WHEN DEMOLITION IS REQUIRED, THAT WILL BE PERMITTED TO EXPOSE CONDITIONS. THESE VERIFICATIONS SHALL INCLUDE BUT NOT LIMITED TO: DIMENSIONS BOTH HORIZONTAL AND VERTICAL, ELECTRICAL SERVICE/PANELS LOCATION AND VOLTS/PHASE, LOCATION/QTY. OF ROOF MOUNTED HVAC EQUIPMENT, CONFIRM THAT INTERIOR HVAC HUNG UNITS HAVE PROPER SUPPORT CONNECTIONS FOR EXISTING STRUCTURE, FIRE SPRINKLER MAIN RUNS, TOILET ROOM DIMENSIONS, DOOR SWING FOR DOORS TO REMAINED ETC. IF NOT VERIFIED AT A LATER TIME, THE CONTRACTOR SHALL REIMBURSE THE ARCHITECT FOR THE REDESIGN FEE. THIS DOES NOT INCLUDE HIDDEN WORK I.E. PITCH OF SANITARY LINES, ACTUAL CONDITIONS OF EXISTING HVAC EQUIPMENT, STRUCTURAL COLUMNS/BEARING WALLS OR CONDITIONS OF GREASE INTERCEPTORS AND ETC.

SCOPE OF WORK

USE EXISTING 5 TON ELECTRIC HEAT ROOFTOP UNIT AND PROVIDE ALL DUCTWORK AND NECESSARY ACCESSORIES FOR COMPLETE HVAC SYSTEM.

PROVIDE NEW BATHROOM EXHAUST FAN.

COORDINATE WITH GC ANY ADDITIONAL REFRIGERATION WORK REQUIRED AND WITH GC AND PLUMBING CONTRACTOR PROVIDING CONDENSATE LINES FOR MECHANICAL EQUIPMENT.

MECHANICAL PLAN NOTES

- A. USE EXISTING UNIT WITH ELECTRIC HEAT. PROVIDE MODIFICATIONS TO DUCT SYSTEM AS SHOWN. PROVIDE FLEXIBLE CONNECTORS ON SUPPLY AND RETURN AIR DUCT CONNECTIONS. INSTALL FIRE DAMPERS IN ANY FIRE WALLS AND BETWEEN FLOORS. TRANSITION TO DUCT SIZES SHOWN. PROVIDE DUCTWORK AND AIR DISTRIBUTION DEVICES AS INDICATED ON THE PLAN. REFER TO A/C UNIT SCHEDULE FOR ADDITIONAL REQUIREMENTS.
- B. FOR SYSTEM OVER 2,000 CFM CHECK FOR DUCT MOUNTED AIR SMOKE DETECTORS AND THAT MEET THE REQUIREMENTS OF UL 268A. INTERLOCKED TO SHUTDOWN A/C UNIT UPON DETECTION OF SMOKE. IF NECESSARY PROVIDE SMOKE DETECTOR WITH AN ANNUNCIATOR, ALARM AND POWER L.E.D.'S FOR VISIBLE AND AUDIBLE ALARM SIGNAL, AND VISIBLE TROUBLE SIGNAL. MOUNT ANNUNCIATOR ON ROOM SIDE OF CEILING.
- C. ALL DUCTS WILL MINIMUM 26 GAUGE SHEET METAL WITH EXTERNAL DUCT WRAP INSULATION. ALL DUCTS TO BE MANUFACTURED AND INSTALLED ACCORDING TO ASHRAE AND SMACNA METAL DUCT CONSTRUCTION STANDARD, LATEST EDITION. ALL MATERIALS WILL CONFORM TO NFPA 90A. NO DUCT BOARD ALLOWED.
- D. THERMOSTATS SHALL BE 7-DAY PROGRAMMABLE TYPE. MOUNT THERMOSTAT 48" A.F.F. COORDINATE LOCATION OF THERMOSTAT.
- E. ALL INTERIOR AIR DUCTS WITH INSULATION SHALL HAVE A MINIMUM OF THICKNESS OF 1.5", R-8 INSULATION. EXTERIOR AIR DUCTS TO HAVE R-8 INSULATION ACCORDING TO INTERNATIONAL ENERGY CONSERVATION CODE - 2018.
- F. ALL SEAMS, JOINTS, ETC WILL BE SEALED TO MAKE AIR DUCT AIRTIGHT. PRESSURE SENSITIVE MATERIALS AND OTHERS APPROVED BY LATEST SMACNA. SEALING MATERIALS WILL BE USED.
- G. ALL EVAPORATOR UNITS SHALL HAVE A FLOAT SWITCH TO CONTROL OVERFLOW THAT WILL AUTOMATICALLY SHUT DOWN THE RTU SYSTEM. THE DEVICE SHALL BE ATTACHED TO THE SECONDARY DRAIN OUTLET ON THE UNIT.
- H. ALL RTU CONDENSATE DRAINS WILL BE COPPER FULL DIAMETER OF OUTLET AND WILL TERMINATE IN THE NEAREST ROOF DRAIN OR INDIRECT WASTE.
- I. ALL EQUIPMENT AND MATERIALS WILL BE INSTALLED ACCORDING TO THE MANUFACTURER'S INSTRUCTIONS AND ACCORDING TO THE BEST PRACTICE.
- J. TESTING AND BALANCING SHALL BE DONE ACCORDANCE WITH THE NATIONAL ENVIRONMENTAL BALANCING BUREAU (N.E.B.B.), THE ASSOCIATED AIR BALANCE COUNCIL (A.A.B.C) NATIONAL STANDARDS OR EQUIVALENT PROCEDURES.
- K. HANGER ATTACHMENTS TO THE STEEL STRUCTURE WILL BE RATED POWDER ACTUATED FASTENERS, "C" CLAMPS, WELDED STUDS, CLAMP HANGERS, JOIST CLAMPS OR OTHER METHODS RECOMMENDED BY SMACNA'S "METAL AND FLEXIBLE STANDARDS", CHAPTER 4, AND WILL HAVE A MINIMUM SAFETY MARGIN OF 4:1. SUSPENDED FROM TOP CHORD OF JOISTS, NOTHING FROM DECK OR CROSS BRACING.
- L. ALL HVAC CONTROLS AND CONTROL WIRING SHALL BE PROVIDED BY THE MECHANICAL CONTRACTOR.

LEE'S SUMMIT BUILDING DEPARTMENT NOTES

- ALL WORK SHALL COMPLY WITH APPLICABLE SECTIONS OF 2018 IBC AND ALL AMENDMENTS AND RULES AND REGULATIONS OF THE DEPARTMENT OF BUILDINGS TO DATE.
1. THE CONTRACTOR SHALL ENGAGE THE SERVICES OF A PROFESSIONAL ENGINEER TO PROVIDE THE REQUIRED SPECIAL INSPECTIONS AND TESTS.
2. THE LICENSED PROFESSIONAL ENGINEER, ARCHITECT OR OTHER PERSON HAVING NOT LESS THAN FIVE (5) YEARS EXPERIENCE SUPERVISING THE INSTALLATION OF SUCH MECHANICAL SYSTEMS AND CONDUCTING SUCH TESTS WILL FILE DOCUMENTATION AND REPORTS OF TESTS THAT THE SYSTEM COMPLIES WITH THE CONSTRUCTION DOCUMENTS AND APPLICABLE LAWS.
3. THE FOLLOWING WORK ITEMS, COMPONENTS, MATERIALS, CAPACITIES, ETC. SHALL COMPLY WITH THE REFERENCED CODE OR STANDARD:
- A. DUCT CONSTRUCTION AND INSTALLATION- 2018 IMC - SECTION 603
- B. AIR INTAKES, EXHAUSTS AND RELIEF - 2018 IMC SECTION 401.5
4. MINIMUM TEMPERATURE TO BE MAINTAINED IN OCCUPIED SPACES DURING HEATING SEASON: 68 DEG. FAHRENHEIT.
5. A STATEMENT SHALL BE FILED BY THE OWNER OR TENANT IN POSSESSION THAT THE VENTILATION SYSTEM WILL BE KEPT IN CONTINUOUS OPERATION AT ALL TIMES DURING THE NORMAL OCCUPANCY OF THE STRUCTURE AS REQUIRED BY IMC-2018 .
6. VENTILATION FOR ALL AREA SHALL COMPLY WITH IMC-2018.
7. A STATEMENT SHALL BE FILED BY THE OWNER OR TENANT IN POSSESSION THAT THE VENTILATION SYSTEM WILL BE KEPT IN CONTINUOUS OPERATION AT ALL TIMES DURING THE NORMAL OCCUPANCY OF THE STRUCTURE AS REQUIRED BY IMC-2018.
8. REFER TO ARCHITECTURAL DRAWINGS FOR REQUIRED FIRE-RATED WALL AND SMOKE WALL CONSTRUCTION AND LOCATION.
9. THESE PLANS ARE APPROVED ONLY FOR THE WORK INDICATED ON THE APPLICATION SPECIFICATION SHEET. ALL OTHER MATTERS SHOWN ARE NOT TO BE RELIED UPON OR TO BE CONSIDERED AS EITHER BEING APPROVED OR IN ACCORDANCE WITH APPLICABLE CODES.
8. MECHANICAL SYSTEMS SHALL BE COMMISSIONED PER IECC 2018 C403.3.2, C408.2.1, C408.2.5 FINAL COMMISSIONING REPORT SHALL BE DUE WITHIN 90 DAYS OF RECEIPT OF CERTIFICATE OF OCCUPANCY.
9. A COMMISSIONING PLAN SHALL BE DEVELOPED BY A LICENSED DESIGN PROFESSIONAL, MECHANICAL ENGINEER OR APPROVED AGENCY.
10. A PRELIMINARY REPORT OF COMMISSIONING TEST PROCEDURES AND RESULTS SHALL BE COMPLETED AND CERTIFIED BY THE LICENSED DESIGN PROFESSIONAL, ELECTRICAL ENGINEER, MECHANICAL ENGINEER OR APPROVED AGENCY AND PROVIDED TO THE BUILDING OWNER OR OWNER'S AUTHORIZED AGENT.
11. ALL HEATING AND COOLING LOADS CALCULATED PER ASHRAE/ACCA 183.
12. SMOKE DETECTOR SHALL MEET UL268A.

GENERAL NOTES

- A. CONTRACTORS AND SUB-CONTRACTORS SHALL CAREFULLY REVIEW THE CONSTRUCTION DOCUMENTS. INFORMATION REGARDING THE COMPLETE WORK IS DISPERSED THROUGHOUT THE DOCUMENT SET AND CANNOT BE ACCURATELY DETERMINED WITHOUT REFERENCE TO THE COMPLETE DOCUMENT SET. PAY SPECIAL ATTENTION TO THE RESPONSIBILITY SCHEDULE. WORK DESIGNATED ON SCHEDULE SHALL BE CONSIDERED INCLUDED IN YOUR SCOPE OF WORK AND CONTRACT AMOUNT.
- B. CONTRACTOR TO VERIFY THAT ALL EQUIPMENT SHOWN AS EXISTING MATCHES THE DESCRIPTIONS AND SPECIFICATIONS SHOWN ON DRAWINGS AND SCHEDULES. IF DIFFERENT NOTIFY ARCHITECT/ENGINEER BEFORE BIDDING, ORDERING, OR PROCEEDING WITH WORK.
- C. DRAWINGS/DETAILS ARE TO BE CONSIDERED DIAGRAMMATIC, NOT NECESSARILY SHOWING IN DETAIL OR TO SCALE ALL MINOR ITEMS. UNLESS SPECIFIC DIMENSIONS ARE SHOWN, THE STRUCTURAL, ARCHITECTURAL AND SITE CONDITIONS SHALL GOVERN EXACT LOCATIONS. CONTRACTOR SHALL FOLLOW DRAWINGS IN LAYING OUT WORK, AND CHECK/COORDINATE DRAWINGS OF ALL TRADES.
- D. COORDINATE WITH THE WORK OF OTHERS SECTIONS, EQUIPMENT FURNISHED BY OTHERS, REQUIREMENTS OF THE OWNER, AND WITH THE CONSTRAINTS OF THE EXISTING CONDITIONS OF THE PROJECT SITE. PROVIDE DUCT RISES AND DRIPS AS REQUIRED FOR FIELD INSTALLATION AND TRADE COORDINATION. NOTIFY ARCHITECT OF ANY DISCREPANCIES BEFORE STARTING WORK.
- E. DRAWINGS FOR HVAC WORK ARE DIAGRAMMATIC, SHOWING THE GENERAL LOCATION, TYPE, LAYOUT, AND EQUIPMENT REQUIRED. THE DRAWINGS SHALL NOT BE SCALED FOR EXACT MEASUREMENT. REFER TO MANUFACTURERS STANDARD INSTALLATION DRAWINGS FOR EQUIPMENT CONNECTIONS, AND INSTALLATION REQUIREMENTS. PROVIDE DUCTWORK, CONNECTIONS, ACCESSORIES, OFFSETS, AND MATERIALS NECESSARY FOR A COMPLETE SYSTEM.
- F. ALL WORK SHALL COMPLY WITH STATE AND LOCAL CODE REQUIREMENTS AS APPROVED AND AMENDED BY THE GOVERNING CITY. PURCHASE ALL PERMITS ASSOCIATED WITH THE WORK. OBTAIN ALL INSPECTIONS REQUIRED BY CODE.
- G. USE OF COMBUSTIBLE MATERIALS IS NOT ALLOWED IN THE RETURN AIR PLENUM. MATERIALS USED IN THE PLENUM SHALL HAVE FLAME SPREAD RATING NOT TO EXCEED 25, AND SMOKE DEVELOPED RATING NOT TO EXCEED 50 WHEN TESTED IN ACCORDANCE WITH ASTM E 84. ALL EXPOSED WIRING IN THE PLENUM SHALL BE PLENUM RATED.
- H. VERIFY LOCATION OF PERMISSIBLE NEW STRUCTURAL ROOF PENETRATIONS AND ADAPT THE REQUIRED DUCTS ACCORDINGLY. THE OPENINGS MUST BE LOCATED USING A REBAR LOCATOR, TRYING TO LEAVE A TRANSVERSE BAR WITHIN 4" FROM THE OPENING. LOCATE OPENINGS AT MID-DISTANCE BETWEEN THE STEMS OF THE DOUBLE TEE AND LONGITUDINAL REINFORCEMENT SHALL NEVER BE CUT. CALL THE ARCHITECT'S OFFICE IN CASE OF UNEXPECTED DIFFICULTIES.
- I. ALL A/C AND FRESH AIR ROUND EXPOSED DUCTS WILL BE SPIRAL GALVANIZED AND READY FOR PAINTING. ALL RECTANGULAR DUCTS OVER CEILINGS MAY BE SHEET METAL WITH EXTERNAL INSULATION. ALL SG SUPPLY GRILLS WILL BE DOUBLE DEFLECTION WITH VOLUME CONTROLS.
- J. G.C. SHALL CONTRACT LANDLORD-APPROVED ROOFING CONTRACTOR TO FLASH AND SEAL ALL ROOF PENETRATIONS TO MAINTAIN ROOFING WARRANTY.
- K. IF APPLICABLE CONTRACTOR TO PROVIDE SHOP DRAWINGS FOR KITCHEN VENTILATION SYSTEM INCLUDING TYPE 1 HOOD AND FOR THE WALK-IN COOLER & FREEZER.
- L. REQUIRED INSURANCE SHALL BE PROVIDED BY THE PLUMBING CONTRACTOR FOR PROTECTION AGAINST PUBLIC LIABILITY AND PROPERTY DAMAGE FOR THE DURATION OF THE WORK.
- M. CONSTRUCTION 'AS BUILT' DRAWINGS AND DOCUMENTS SHALL BE PROVIDED TO THE OWNER WITHIN 30 DAYS AFTER THE DATE OF ACCEPTANCE AND PROVIDE COPY TO LL.
- N. OPERATION MANUALS AND MAINTENANCE MANUALS SHALL BE PROVIDED TO THE BUILDING OWNER.

THERMOSTATIC CONTROLS

- A. GENERAL:
THE SUPPLY OF HEATING AND COOLING ENERGY TO EACH ZONE SHALL BE INDIVIDUALLY CONTROLLED BY THERMOSTATIC CONTROLS RESPONDING TO TEMPERATURE.
- B. DEAD BAND:
WHERE USED TO CONTROL BOTH HEATING AND COOLING, ZONE THERMOSTATIC CONTROLS SHALL BE CAPABLE OF PROVIDING A TEMPERATURE RANGE OR DEAD BAND OF AT LEAST 5°F WITHIN WHICH THE SUPPLY OF HEATING AND COOLING ENERGY TO THE ZONE IS SHUT OFF OR REDUCED TO A MINIMUM.
EXCEPTIONS:
THERMOSTATS THAT REQUIRE MANUAL CHANGEOVER BETWEEN HEATING AND COOLING MODES.
- C. SETBACK CONTROLS:
HEATING SYSTEMS LOCATED IN CLIMATE ZONES 2-8 SHALL BE EQUIPPED WITH CONTROLS THAT HAVE THE CAPABILITY TO AUTOMATICALLY RESTART AND TEMPORARILY OPERATE THE SYSTEM AS REQUIRED TO MAINTAIN ZONE TEMPERATURES ABOVE A HEATING SETPOINT ADJUSTABLE DOWN TO 55°F OR LOWER. COOLING SYSTEMS LOCATED IN CLIMATE ZONES 1B, 2B, AND 3B SHALL BE EQUIPPED WITH CONTROLS THAT HAVE THE CAPABILITY TO AUTOMATICALLY RESTART AND TEMPORARILY OPERATE THE SYSTEM AS REQUIRED TO MAINTAIN ZONE TEMPERATURES BELOW A COOLING SETPOINT ADJUSTABLE UP TO 90°F OR HIGHER OR TO PREVENT HIGH SPACE HUMIDITY LEVELS.
- D. AUTOMATIC SHUTDOWN:
HVAC SYSTEMS SHALL BE EQUIPPED WITH AT LEAST ONE OF THE FOLLOWING: CONTROLS THAT CAN START AND STOP THE SYSTEM UNDER DIFFERENT TIME SCHEDULES FOR SEVEN DIFFERENT DAY-TYPES PER WEEK, ARE CAPABLE OF RETAINING PROGRAMMING AND TIME SETTING DURING LOSS OF POWER FOR A PERIOD OF AT LEAST TEN HOURS, AND INCLUDE AN ACCESSIBLE MANUAL OVERRIDE, OR EQUIVALENT FUNCTION, THAT ALLOWS TEMPORARY OPERATION OF THE SYSTEM FOR UP TO TWO HOURS.
- E. HEAT PUMP SUPPLEMENTARY HEAT :
HEAT PUMPS HAVING SUPPLEMENTARY ELECTRIC RESISTANCE HEAT SHALL HAVE CONTROLS THAT, EXCEPT DURING DEFROST, PREVENT SUPPLEMENTARY HEAT OPERATION WHERE THE HEAT PUMP CAN PROVIDE THE HEATING LOAD.


OCCUPANCY CALCULATION AS PER, IMC-2018

RECEPTION	130 SQ. FT. @30 PEOPLE/1000SQ.FT.	4 PEOPLE
DRIPBAR	407 SQ. FT. @15 PEOPLE/1000SQ.FT.	7 PEOPLE
LABORATORY	137 SQ. FT. @15 PEOPLE/1000SQ.FT.	2 PEOPLE
PRIVATE ROOM 1	84 SQ. FT. @15 PEOPLE/1000SQ.FT.	3 PEOPLE
PRIVATE ROOM 2	55 SQ. FT. @15 PEOPLE/1000SQ.FT.	1 PEOPLE
BREAK ROOM	95 SQ. FT. @25 PEOPLE/1000SQ.FT.	3 PEOPLE

VENTILATION REQUIREMENTS PER IMC-2018

DRIPBAR	407 SQ. FT. X 0.06 CFM/SQ. FT. =	25 CFM
	7 PEOPLE X 5 CFM/PEOPLE. =	35 CFM
RECEPTION	130 SQ. FT. X 0.06 CFM/SQ. FT. =	8 CFM
	4 PEOPLE X 5 CFM/PEOPLE. =	20 CFM
HALLWAY	191 SQ. FT. X 0.06 CFM/SQ. FT. =	12 CFM
BREAK ROOM	95 SQ. FT. X 0.18 CFM/SQ. FT. =	18 CFM
	3 PEOPLE X 7.5 CFM/PEOPLE. =	23 CFM
PRIVATE ROOM 1	84 SQ. FT. X 0.06 CFM/SQ. FT. =	6 CFM
	2 PEOPLE X 5.0 CFM/PEOPLE. =	10 CFM
PRIVATE ROOM 2	55 SQ. FT. X 0.06 CFM/SQ. FT. =	4 CFM
	1 PEOPLE X 5.0 CFM/PEOPLE. =	5 CFM
LABORATORY	137 SQ. FT. X 0.06 CFM/SQ. FT. =	9 CFM
	3 PEOPLE X 5.0 CFM/PEOPLE. =	15 CFM
OUTSIDE AIR REQUIRED		190 CFM
OUTSIDE AIR THROUGH RTU-3(E)		300 CFM
AIR BALANCE		
O/A PROVIDED		300 CFM
BEF-1(N)		-70 CFM
RTU BAROMETRIC RELIEF		230 CFM

MECHANICAL SYMBOLS

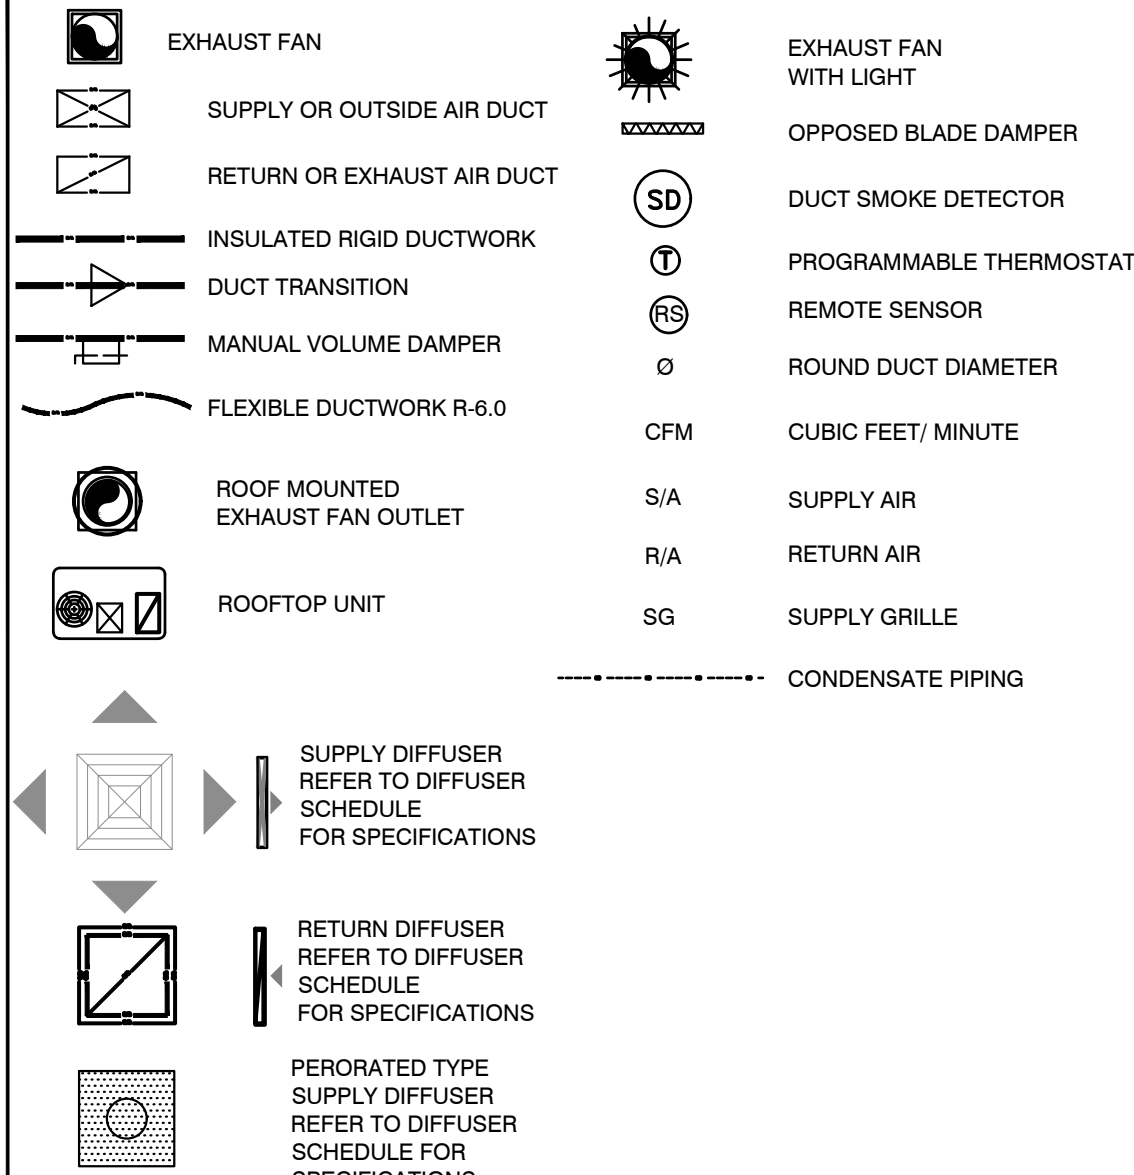

NOTE: THIS PROJECT MAY NOT USE EVERY SYMBOL OR DEVICE APPEARING ON THIS LEGEND.

ROOF TOP UNIT SCHEDULE

TAG	RTU -1 (E)
UNIT	GAS
MANUFACTURER	CARRIER
MODEL	50HCA06A2M6A
STATUS	EXISTING
MOUNTING	ROOF
NOMINAL CAPACITY	5.0 TONS
TOTAL BTUHS	57,500
SENSIBLE BTUHS	SAE
HEATING KW	14
SEER	SAE
SUPPLY AIR (CFM)	1,960
OUTDOOR AIR (CFM)	300
VOLTAGE	480/3/60
MCA (A)	27
MCB(A)	30
WEIGHT (lbs)	SAE


NOTES:

1:EXISTING RTU-1(E) SHOULD HAVE AT LEAST 35.5 MBH OF SENSIBLE COOLING & 45 MBH OF TOTAL COOLING CAPACITY AND 50 MBH OF HEATING CAPACITY. CONTRACTOR TO FIELD VERIFY AND INFORM ENGINEER FOR DISCREPANCIES.

2:CONTRACTOR TO ADJUST MOTORIZED DAMPER ON FRESH AIR TAP TO PROVIDE OUTSIDE AIR AS MENTIONED IN VENTILATION REQUIREMENT TABLE.

DIFFUSER SCHEDULE					
MANUFACTURER	TITUS	TITUS	TITUS	TITUS	TITUS
DESIGNATION	A	A1	C	D	R
USE	SUPPLY	SUPPLY	SUPPLY	SUPPLY	RETURN
MODEL	TDC-AA	TDC-AA	250-AA(2/3 WAY)	FL-15	56FS
MOUNTING	SAT CEILING	HARD CEILING	CEILING	HARD CEILING	SAT CEILING
LOCATION	ANY	ANY	BATROOM/ST O	ANY	ANY
FACE SIZE	24" X 24"	24"X24"	12"X12"	4" 1.5" SLOT, 2 SLOT	AS SHOWN
NECK SIZE	TO MATCH DUCT	TO MATCH DUCT	TO MATCH DUCT	-	TO MATCH DUCT
FRAME TYPE	LAY IN	FLANGED	FLANGED	-	LAY IN
FINISH	WHITE	WHITE	FIELD PAINTED	WHITE	WHITE
NOISE CRITERIA	<30	<30	<30	<30	<30
ACCESSORIES	VOLUME DAMPER	OPPOSED BLADE DAMPER	VOLUME DAMPER	VOLUME DAMPER	VOLUME DAMPER

FAN SCHEDULE	
DESIGNATION	BEF-1 (N)
STATUS	NEW
QUANTITY	1
MANUFACTURER	COOK
MODEL	GC-142
CFM	70@0.25ESP
WATTS	75
SONES	1.2
ACCESSORIES	MANUF. RECOMMENDED
WEIGHT (LBS)	15
VOLTAGE	120/1/60

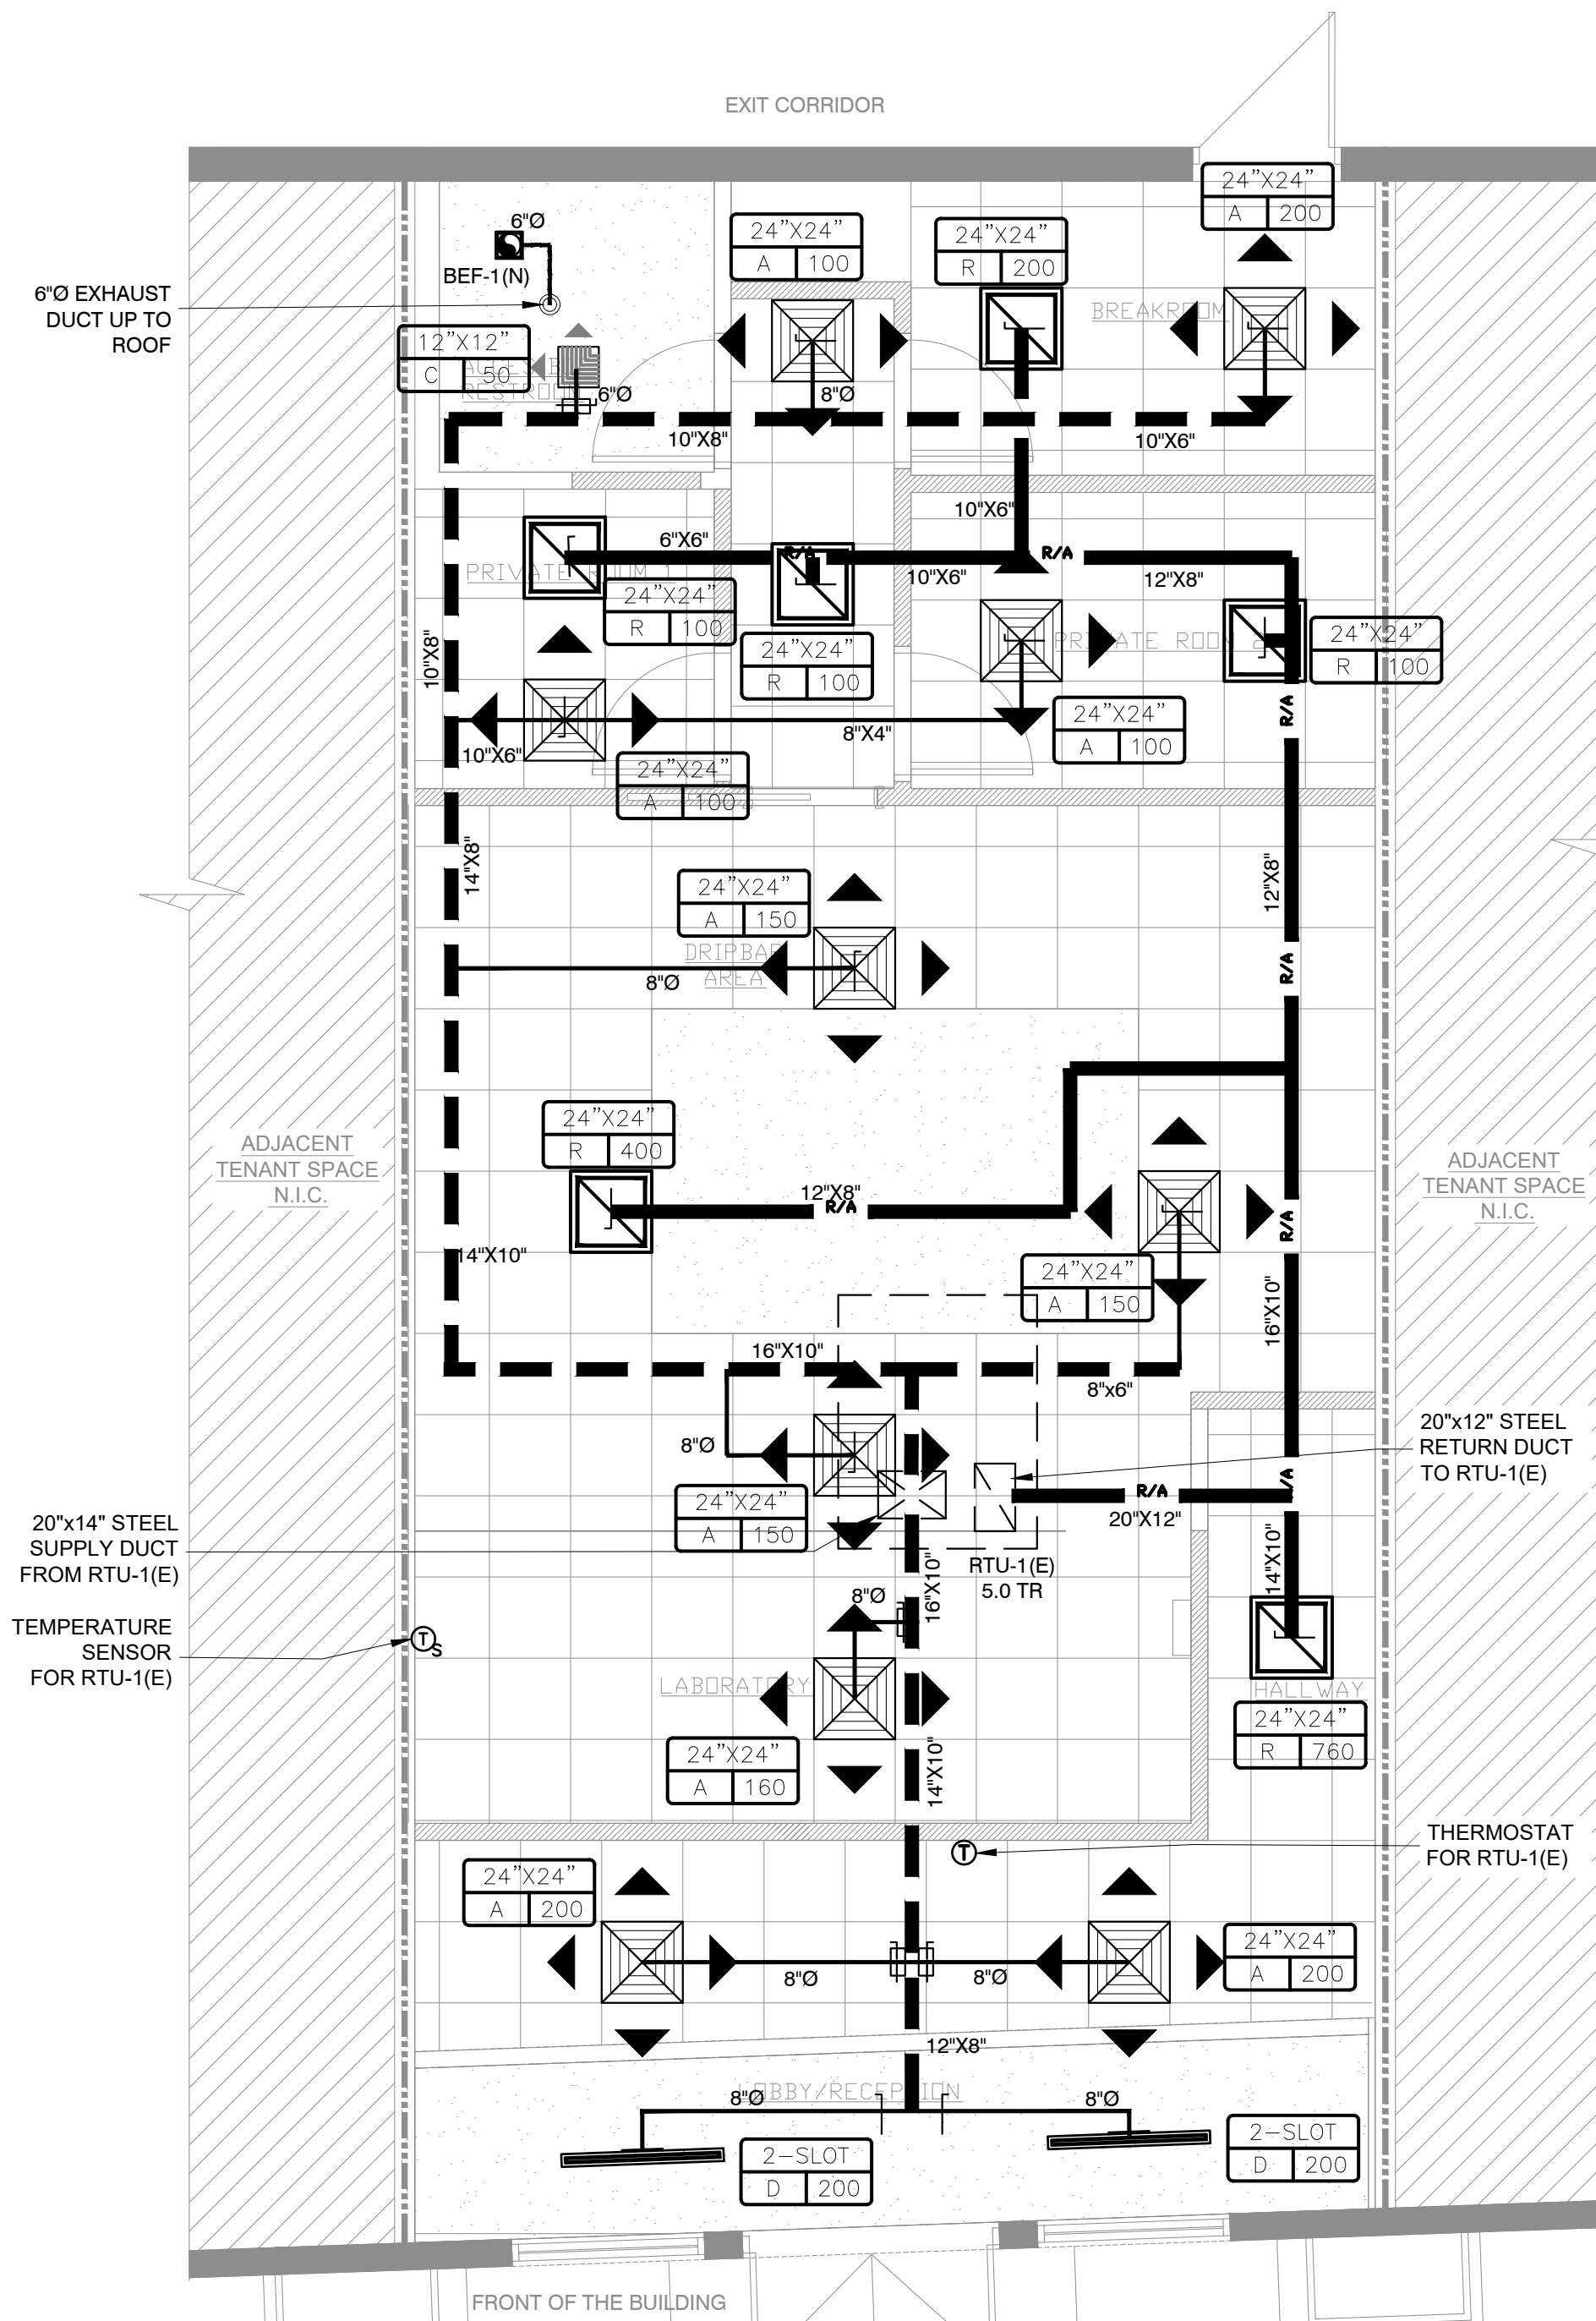

HVAC PLAN

SCALE
1/4" = 1'-0"

1

NY ENGINEERS

382 NE 191ST ST.
SUITE, 49674, MIAMI
FL 33179

THIS DOCUMENT IS THE PROPERTY OF NEWYORK ENGINEERS AND SHALL NOT BE REPRODUCED WITHOUT THE WRITTEN CONSENT OF NEWYORK ENGINEERS.

PROJECT

THE DRIPBAR

930-M NW BLUE PKWY,
LEES SUMMIT, MO 64086

REVISIONS DATES:

PROFESSIONAL SEAL



ERIC ENGELL #2002014528

PROFESSIONAL ENGINEER

STATE OF MISSOURI

ISSUE DATE: 08.23.2021





PROJECT #: 328P.1313P

DRAWN BY: NYE

CHECKED BY: NYE

HVAC NOTES, SCHEDULE
AND PLAN

M-1

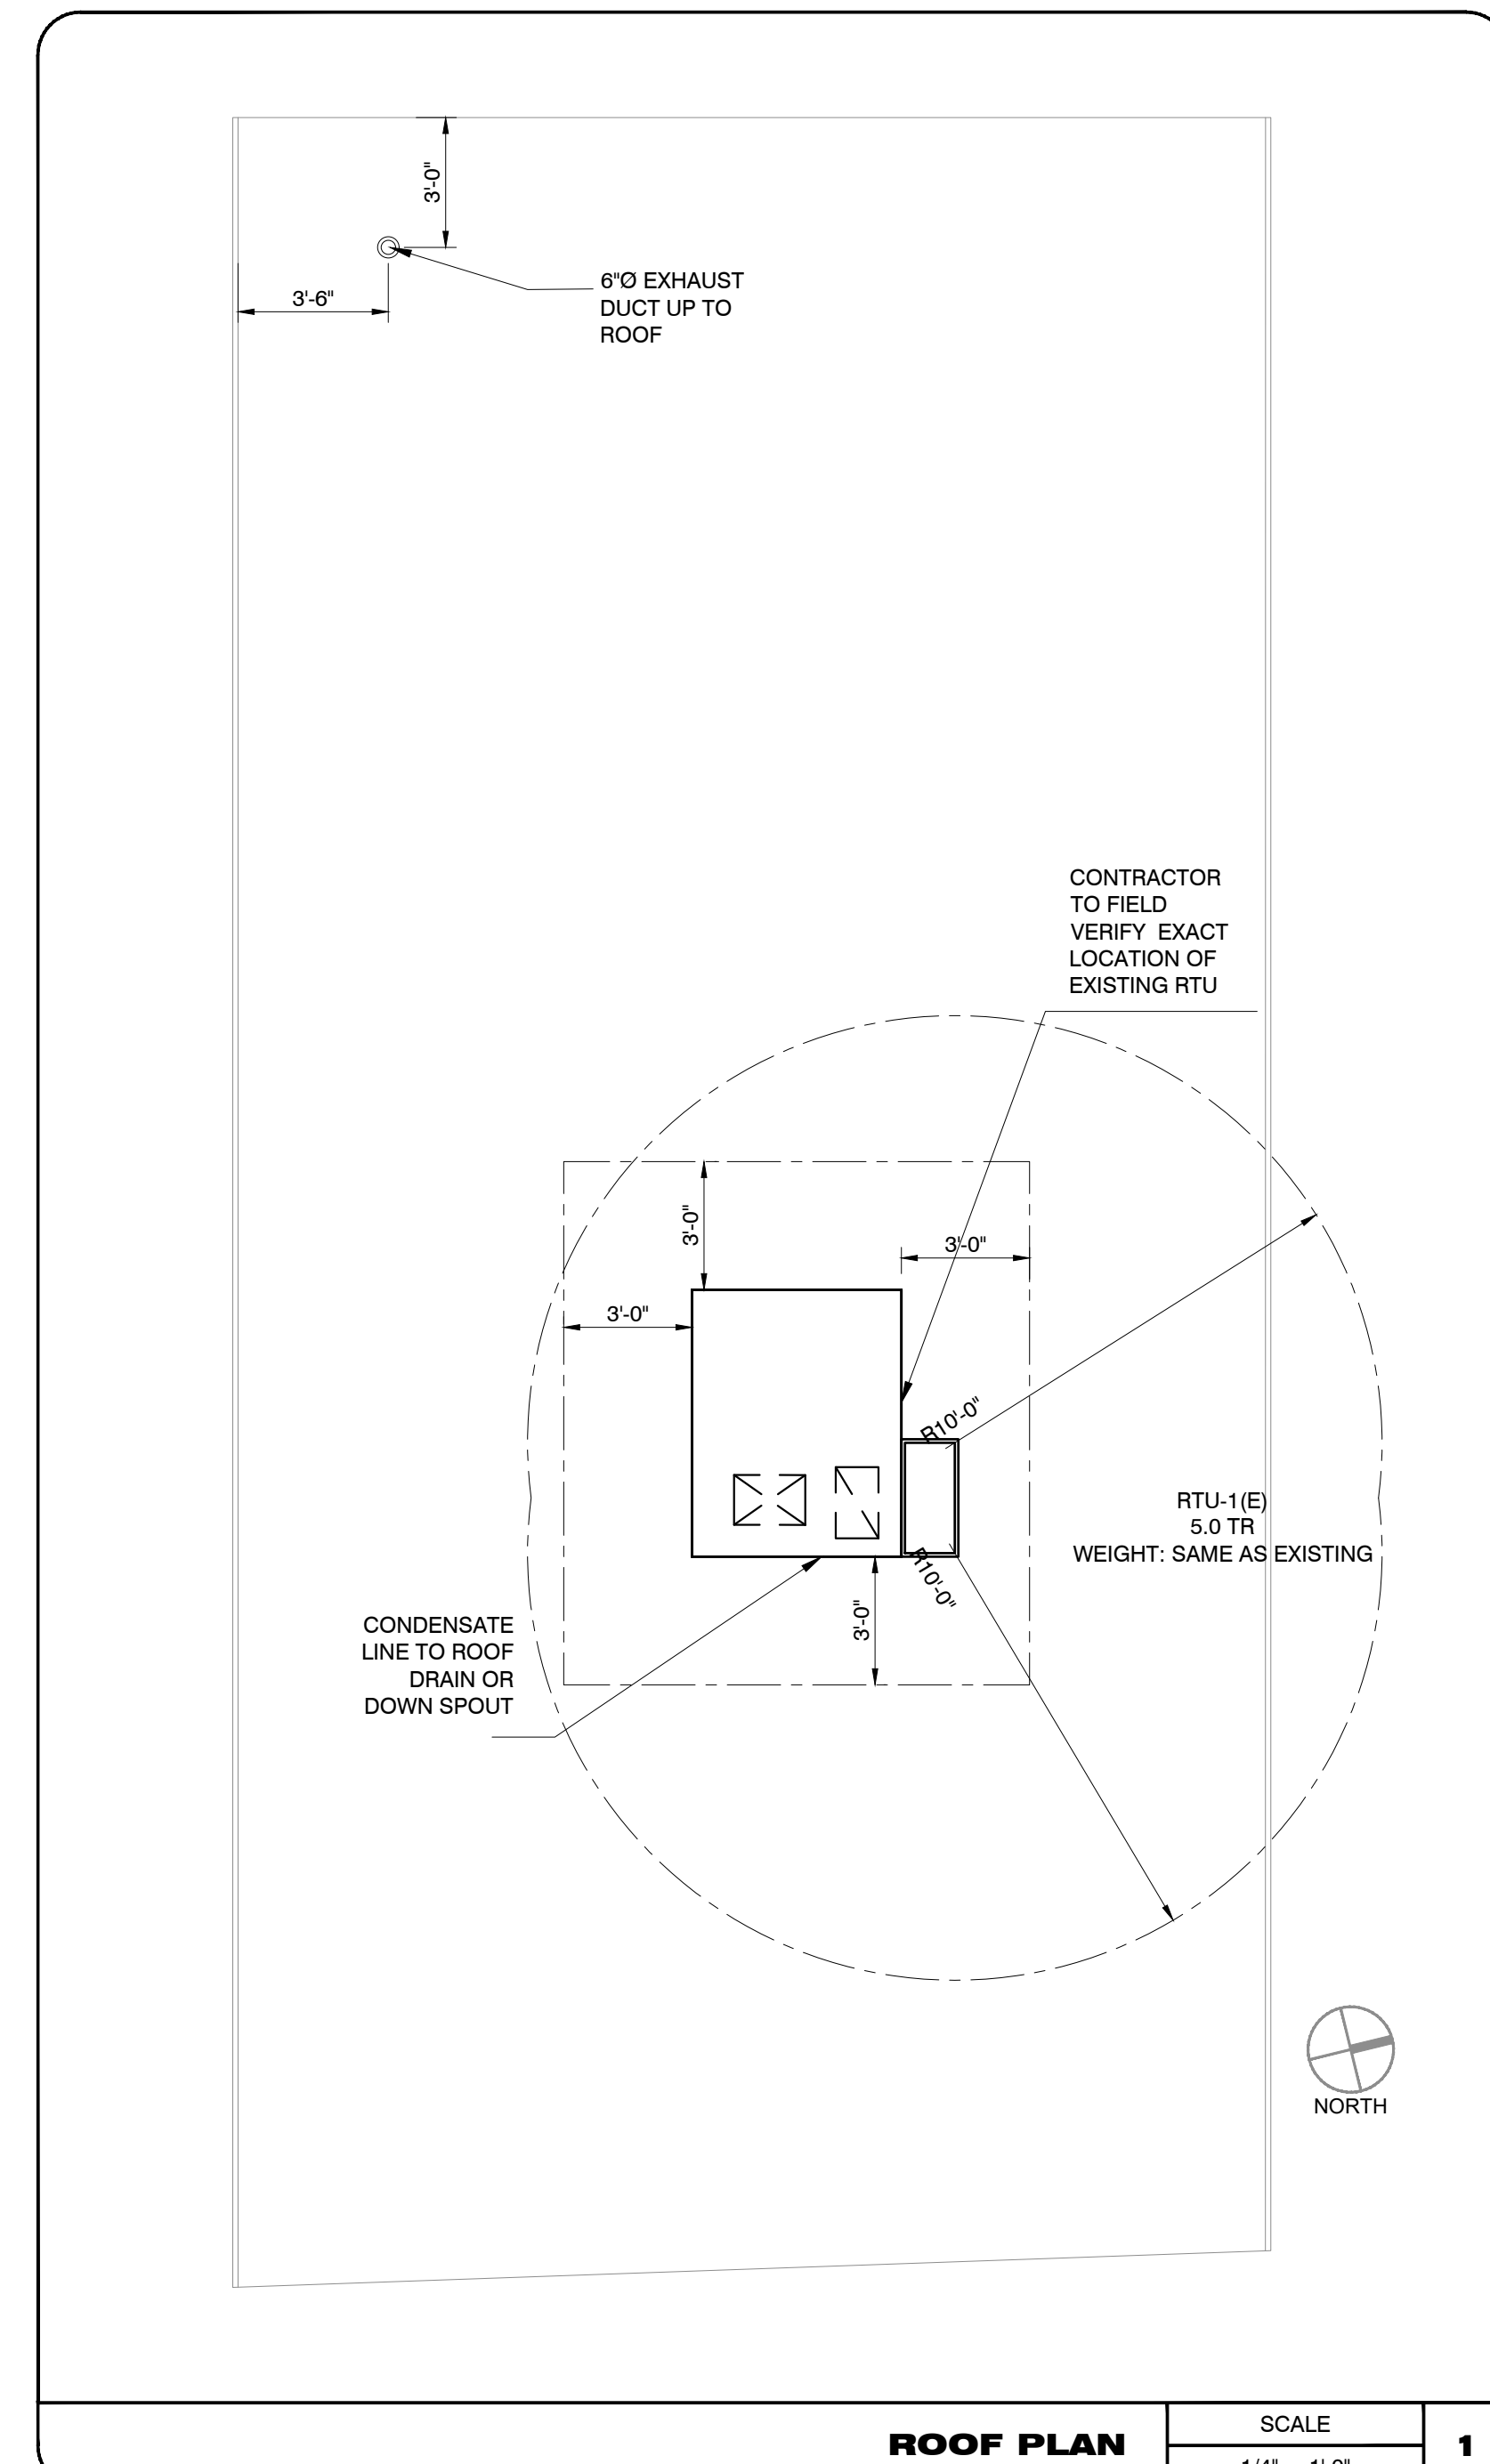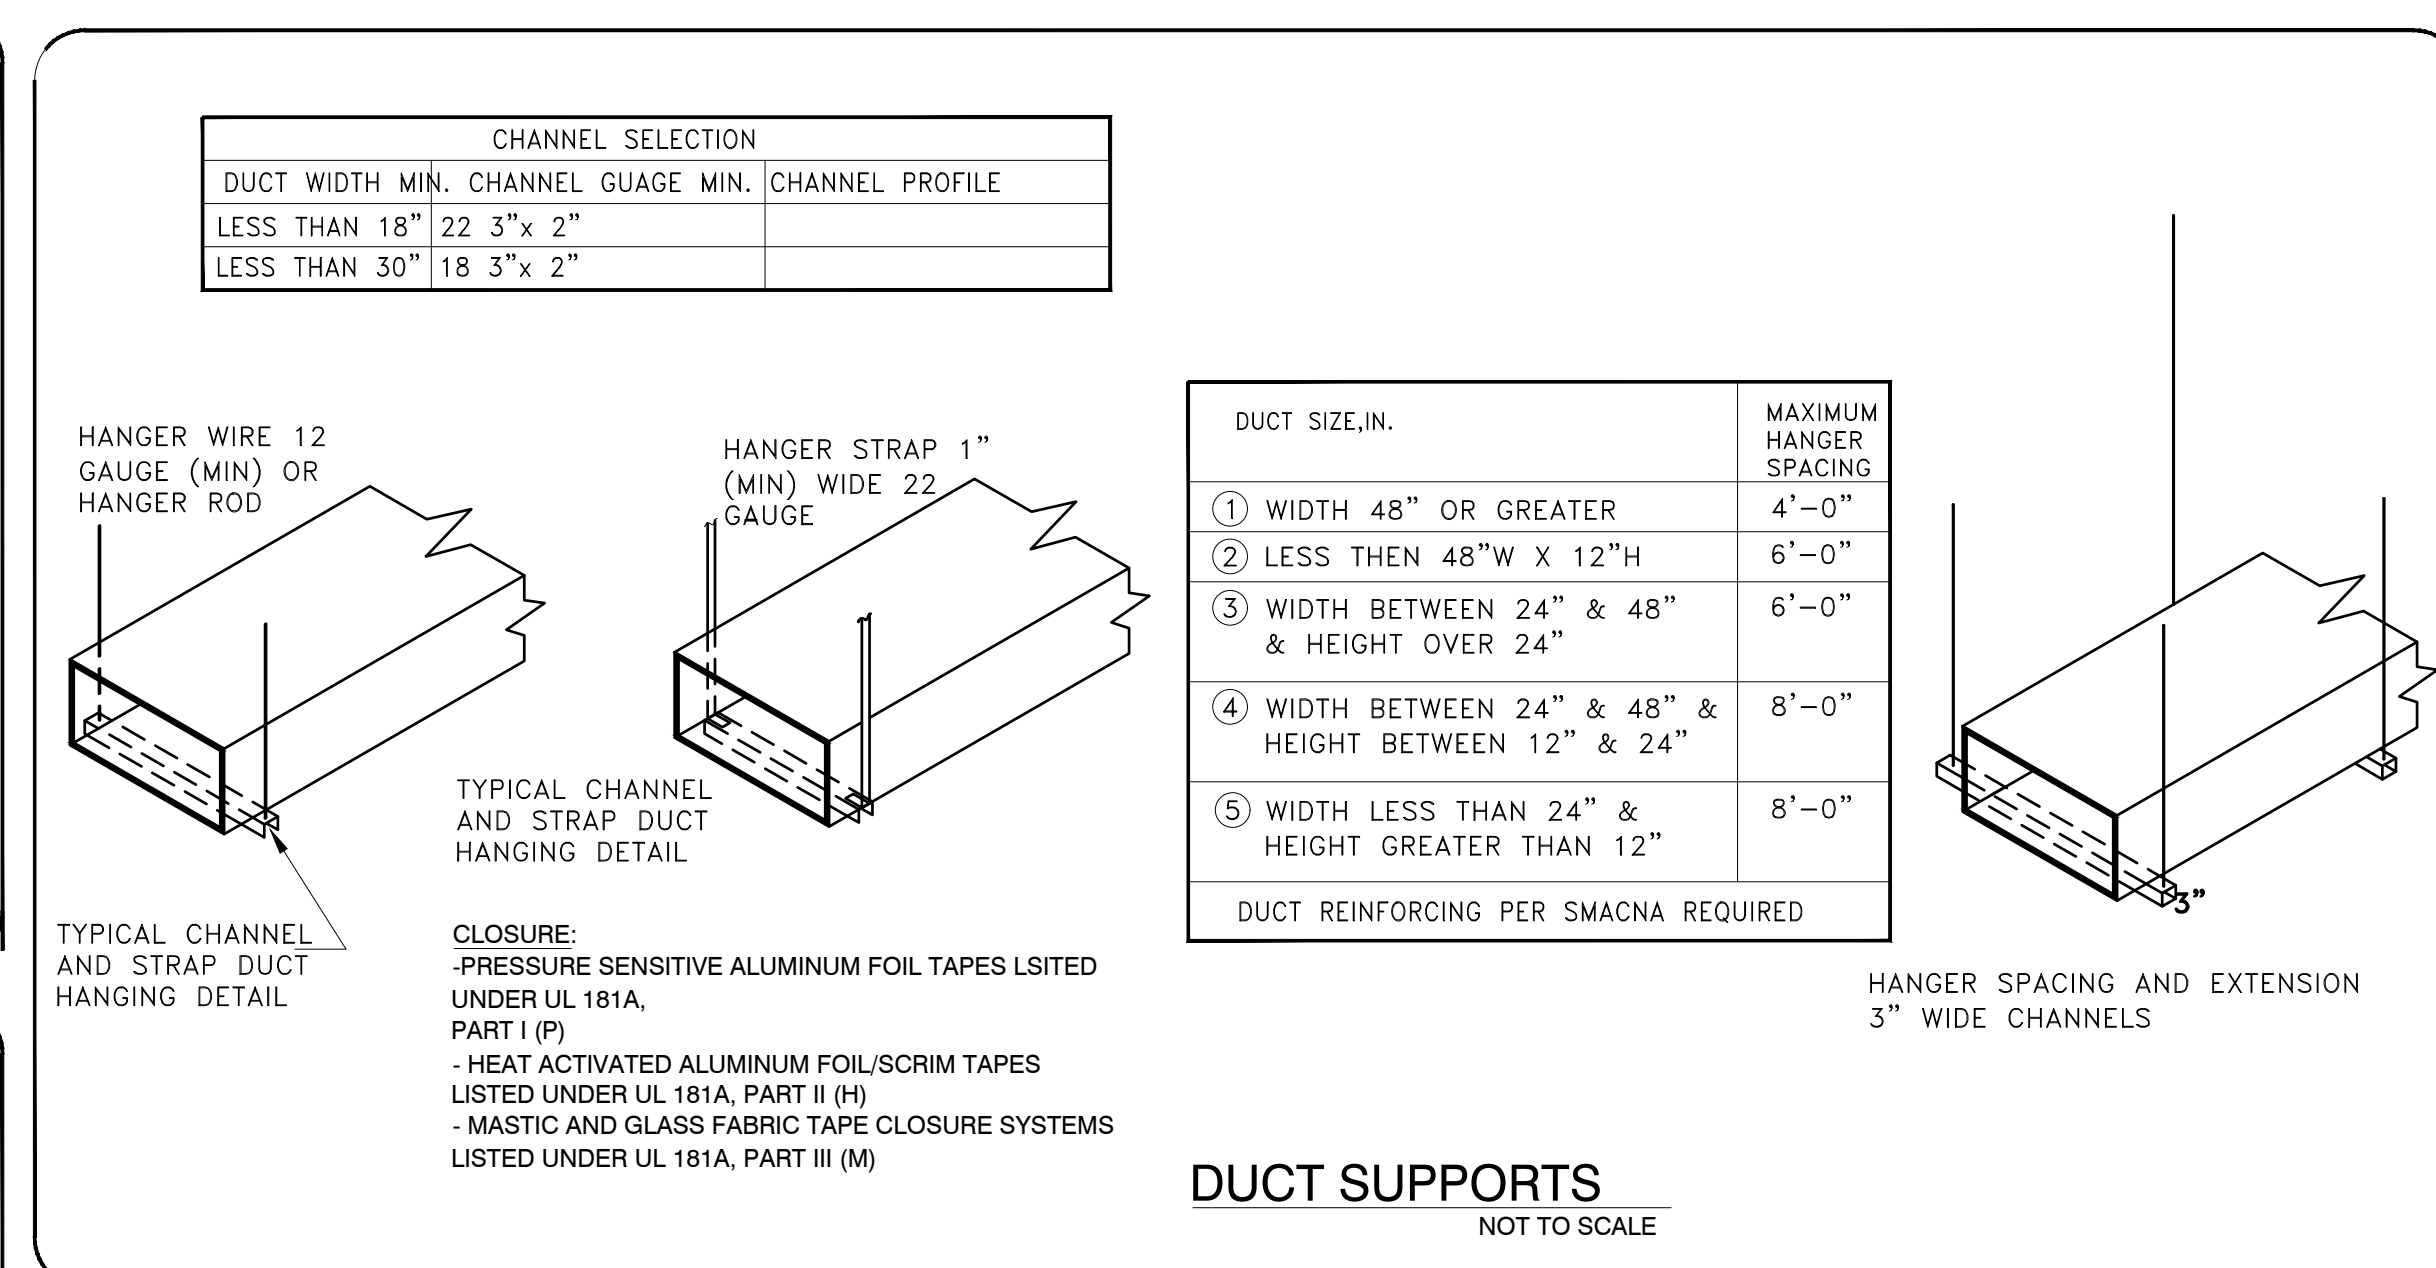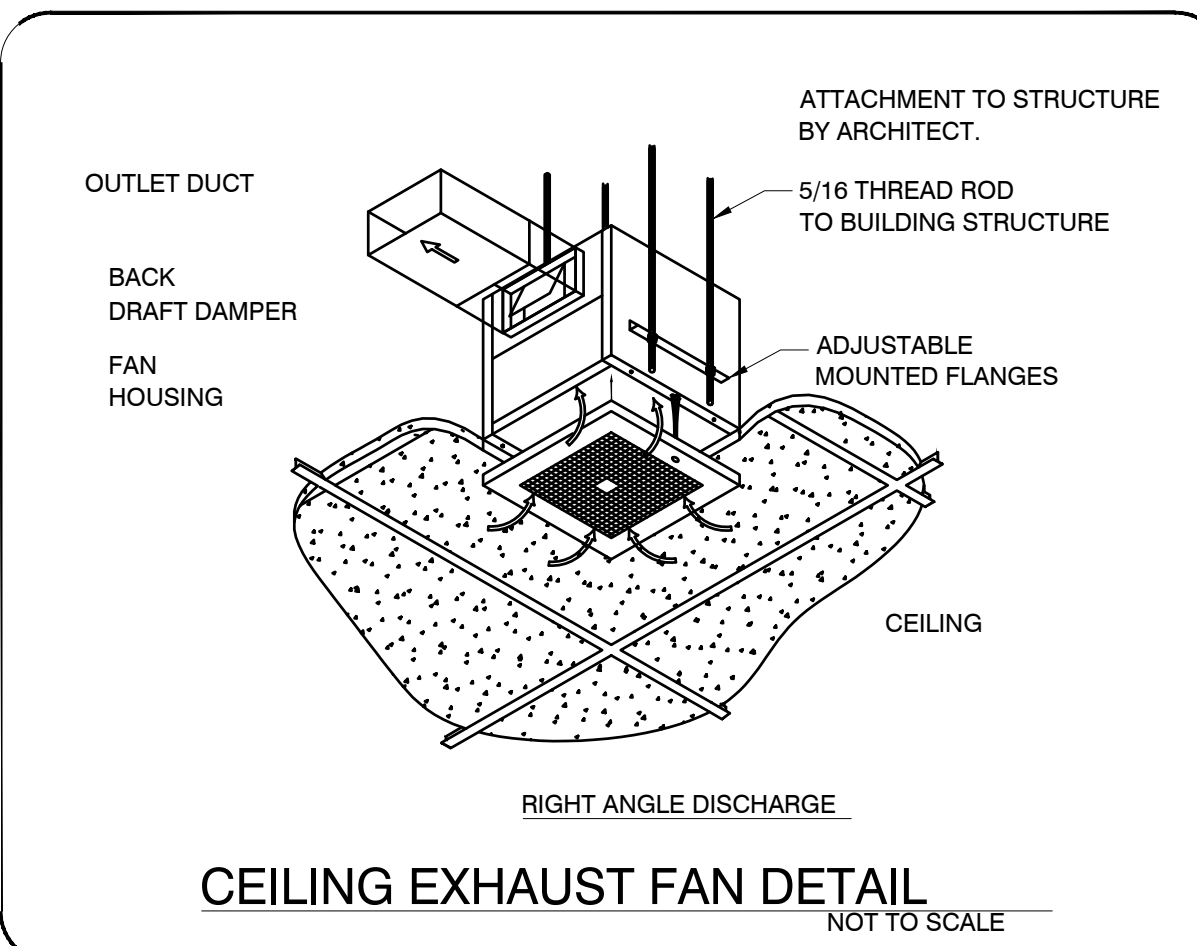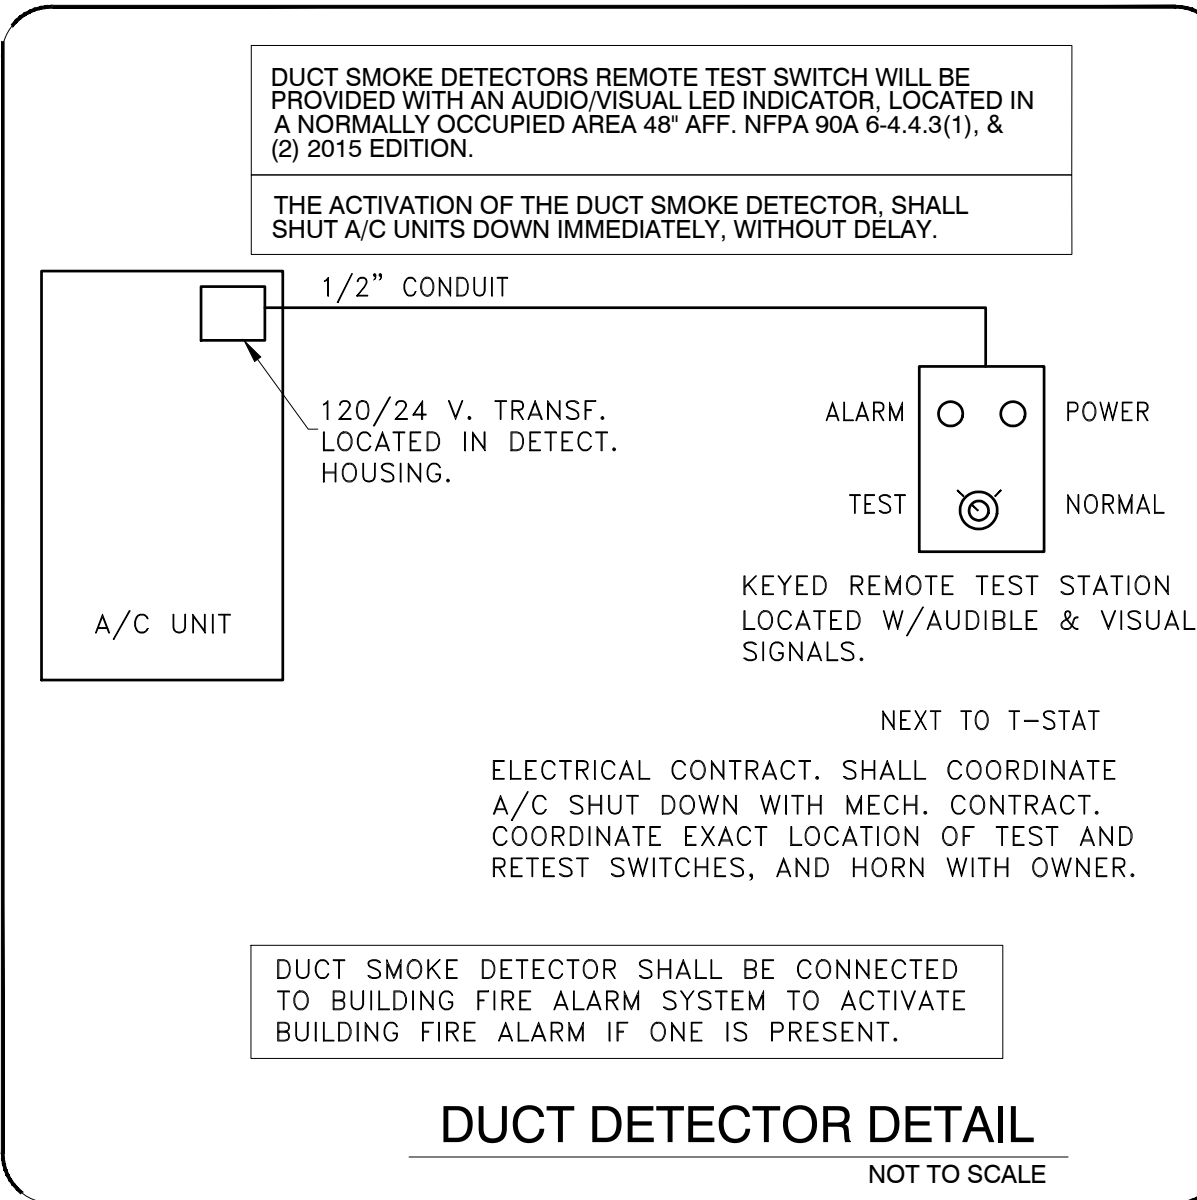

SCOPE OF WORK

USE THE EXISTING 100 AMP 277/480V - 3ø ELECTRICAL SERVICE AND EXISTING ELECTRICAL PANEL AND TRANSFORMER. PROVIDE ALL NECESSARY EQUIPMENT AND ALL WIRING AND LIGHTING FOR DRIPBAR BUILDOUT INCLUDING WIRING FOR HVAC. COORDINATE WITH G.C. FOR LOW VOLTAGE WIRING.

ELECTRICAL PLAN NOTES

- ELECTRICAL CONTRACTOR SHALL REVIEW ALL DRAWINGS OF THIS SET.
 - CONTRACTOR TO VERIFY THAT ALL EQUIPMENT SHOWN AS EXISTING MATCHES THE DESCRIPTIONS AND SPECIFICATIONS SHOWN ON DRAWINGS AND SCHEDULES. IF DIFFERENT, NOTIFY ARCHITECT/ENGINEER BEFORE BIDDING, ORDERING, OR PROCEEDING WITH WORK.
 - ELECTRICAL CONTRACTOR SHALL SUPPLY AND INSTALL ALL NEW ELECTRICAL WORK INDICATED. CONSTRUCTION SHALL BE IN ACCORDANCE WITH DRAWINGS AND APPLICABLE SPECIFICATIONS. IF A PROBLEM IS ENCOUNTERED IN COMPLYING WITH THIS REQUIREMENT, CONTRACTOR SHALL NOTIFY THE OWNER OR HIS REPRESENTATIVE AS SOON AS POSSIBLE AFTER DISCOVERY OF THE PROBLEM AND SHALL NOT PROCEED WITH THAT PORTION OF THE WORK UNTIL OWNER HAS DIRECTED CORRECTIVE ACTION TO BE TAKEN.
 - ELECTRICAL CONTRACTOR SHALL VISIT JOB SITE AND FAMILIARIZE HIMSELF WITH ALL CONDITIONS AFFECTING ELECTRICAL AND COMMUNICATIONS INSTALLATION AND MAKE PROVISIONS AS TO THE COST THEREOF. EXISTING CONDITIONS OF ELECTRICAL EQUIPMENT, LIGHT FIXTURES, ETC., THAT ARE PART OF THE FINAL SYSTEM SHALL BE VERIFIED BY THE CONTRACTOR PRIOR TO SUBMITTING HIS BID.
 - ALL WORK SHALL BE PERFORMED IN ACCORDANCE WITH THE 2020 EDITION OF THE NATIONAL ELECTRIC CODE AND ALL CODES AND ORDINANCES OF THE AUTHORITY HAVING JURISDICTION.
 - DO NOT SCALE THE ELECTRICAL DRAWINGS. REFER TO ARCHITECTURAL PLANS AND ELEVATIONS FOR EXACT LOCATION FOR ALL EQUIPMENT. CONFIRM WITH OWNERS REPRESENTATIVE.
 - ALL ELECTRICAL NOT BEING REUSED MUST BE REMOVED IN ITS ENTIRETY.
 - ALL CONDUIT IN OR UNDERGROUND OR IN CONCRETE MUST BE RIGID GALVANIZED STEEL.
 - CIRCUIT BREAKERS AND PANELS TO BE BOLT ON TYPE.
 - ALL EQUIPMENT SHALL BE APPROVED BY UL OR OTHER NATIONALLY RECOGNIZED TESTING COMPANY.
 - ALL RECEPTACLES SHALL BE GROUNDED AS REQUIRED BY NEC 250.146
 - SUBMIT SERVICE ENTRANCE EQUIPMENT FOR SEPARATE APPROVAL.
 - ALL LOW VOLTAGE MUST BE IN CONDUIT TO ABOVE THE DROP CEILING. BRIDAL RINGS OR "J" HOOKS REQUIRED.
 - SEPARATE PERMITS ARE REQUIRED FOR ALL LOW VOLTAGE SUCH AS TELEPHONE, DATA, THERMOSTAT, MUSIC, ALARMS ETC.
 - SEPARATE PERMIT REQUIRED FOR SIGNAGE.
 - PRIOR TO ANY CONSTRUCTION WORK BEGINNING AN ON-SITE MEETING WITH GENERAL CONTRACTORS IS REQUIRED.
 - ELECTRICIAN MUST BE ON SITE FOR ALL INSPECTIONS.
 - MINIMUM WIRE SIZE SHALL BE #12 A.W.G. EXCLUDING CONTROL WIRING. ALL CONDUCTORS SHALL BE COPPER AND UNLESS OTHERWISE NOTED THIN INSULATION.
 - OUTLET BOXES SHALL BE PRESSED STEEL IN DRY LOCATIONS, PLASTIC AND CAST ALLOY WITH THREADED HUBS IN WET OR DAMP LOCATIONS, AND SPECIAL ENCLOSURES FOR OTHER CLASSIFIED AREAS.
 - IT IS NOT THE INTENT OF THESE PLANS TO SHOW EVERY MINOR DETAIL OF CONSTRUCTION. THE CONTRACTOR IS EXPECTED TO FURNISH AND INSTALL ALL ITEMS FOR A COMPLETE ELECTRICAL SYSTEM AND PROVIDE ALL REQUIREMENTS NECESSARY FOR EQUIPMENT TO BE PLACED IN PROPER WORKING ORDER.
 - ELECTRICAL SYSTEM SHALL BE COMPLETE AND EFFECTIVELY GROUNDED AS REQUIRED BY THE N.E.C. OR LOCAL CODES.
 - ALL MATERIALS SHALL BE NEW AND BEAR UNDERWRITERS' LABELS WHERE APPLICABLE.
 - ALL WORK SHALL BE PERFORMED BY A LICENSED ELECTRICAL CONTRACTOR IN A FIRST CLASS WORKMANLIKE MANNER. THE COMPLETED SYSTEM SHALL BE FULLY OPERATIVE AND ACCEPTED BY ENGINEER/ARCHITECT.
 - ALL WORK SHALL BE COORDINATED WITH OTHER TRADES TO AVOID INTERFERENCE WITH THE PROGRESS OF CONSTRUCTION.
 - ELECTRICAL CONTRACTOR SHALL GUARANTEE ALL MATERIALS AND WORKMANSHIP FREE FROM DEFECTS FOR A PERIOD OF NOT LESS THAN ONE YEAR FROM DATE THAT CERTIFICATE OF OCCUPANCY IS ISSUED. WARRANTY SHALL BE PROVIDED IN WRITING. PROVIDE COPY TO LL.
 - CORRECTION OF ANY DEFECTS SHALL BE COMPLETED WITHOUT ADDITIONAL CHARGE AND SHALL INCLUDE REPLACEMENT OR REPAIR OF ANY OTHER PHASE OF THE INSTALLATION WHICH MAY HAVE BEEN DAMAGED THEREBY.
 - ALL REQUIRED INSURANCE SHALL BE PROVIDED FOR PROTECTION AGAINST PUBLIC LIABILITY AND PROPERTY DAMAGE FOR THE DURATION OF THE WORK.
 - CONTRACTOR SHALL PAY FOR ALL PERMITS, FEES, INSPECTIONS AND TESTING. CONTRACTOR TO OBTAIN PERMIT AND APPROVED SUBMITTALS PRIOR TO BEGINNING WORK OR ORDERING EQUIPMENT.
 - THE ELECTRICAL INSTALLATION SHALL MEET ALL STANDARD REQUIREMENTS OF POWER AND TELEPHONE COMPANIES.
 - CONTRACTOR SHALL COORDINATE WITH MECHANICAL DRAWINGS AND PROVIDE ALL NECESSARY CONTROL WIRING.
 - ALL CIRCUIT BREAKERS FEEDING MECHANICAL EQUIPMENT SHALL BE HACR.
- TYPE CIRCUIT BREAKERS.
 - PROVIDE AND INSTALL CONDUIT, CONDUCTORS, PULL WIRES, BOXES, COVER PLATES, DEVICES, ETC. FOR ALL OUTLETS AS INDICATED.
 - MATERIALS, PRODUCTS, AND EQUIPMENT, INCLUDING ALL COMPONENTS THEREOF, SHALL BE NEW AND SUCH AS APPEAR ON THE UL LIST OF APPROVED ITEMS AND SHALL MEET OR EXCEED THE REQUIREMENTS OF N.E.C., NEMA, AND IECE.
 - CONTRACTOR SHALL SUBMIT SHOP DRAWINGS OR CUT SHEETS OF LIGHTING FIXTURES, SWITCHES, AND OTHER ELECTRICAL ITEMS FOR APPROVAL BY ENGINEER/ARCHITECT.
 - ELECTRICAL CONTRACTOR SHALL BE RESPONSIBLE FOR ALL CUTTING, PATCHING AND FIRED CAULKING REQUIRED OF HIS WORK.
 - ELECTRICAL CONTRACTOR SHALL LABEL ALL PANELS W/TYPE WRITTEN DIRECTORIES.
 - ALL ELECTRICAL AND COMMUNICATIONS OUTLETS TO BE AT 24" A.F.F. UNLESS NOTED OTHERWISE, AND VERTICALLY MOUNTED.
 - ALL LIGHT SWITCHES TO BE AT 42" A.F.F.
 - ALL ELECTRICAL WIRING SHALL BE THE RESPONSIBILITY OF THE ELECTRICAL CONTRACTOR. ALL ELECTRICAL WIRING FOR HVAC SYSTEM INCLUDING CONTROLS, THERMOSTATS, POWER, ETC. SHALL BE THE RESPONSIBILITY OF THE ELECTRICAL CONTRACTOR.
 - BREAKER AND PANELS -- ALL CURRENT CARRYING BUSSES SHALL BE COPPER. ALL GROUND BUS BARS SHALL BE COPPER. PANEL BOARD ENCLOSURES SHALL BE FURNISHED WITHOUT PRE-PUNCHED CONCENTRIC HOLES. A.I.C. RATINGS SHALL BE AS INDICATED ON PANEL BOARD SCHEDULES.
 - DISCONNECT SWITCHES SHALL BE H.P. RATED, GENERAL DUTY, QUICK-MAKE, QUICK-BREAK ENCLOSURES AS REQUIRED BY EXPOSURE.
 - MOTOR STARTERS SHALL BE MANUAL OR MAGNETIC, WITH OVERLOAD RELAYS IN EACH HOT LEG.
 - THE TERM "PROVIDE" USED IN THE CONSTRUCTION DOCUMENTS AND SPECIFICATIONS INDICATES THE CONTRACT SHALL FURNISH AND INSTALL.
 - CONTRACTOR SHALL CONFIRM WITH ANY AND ALL REQUIREMENTS SUCH AS: LUG SIZE RESTRICTIONS, CONDUIT ENTRY, TRANSFORMER SIZE, SCHEDULED DOWN TIME FOR OWNERS' CONFIRMATION, ETC.. ANY CONFLICTS SHALL BE BROUGHT TO ATTENTION OF THE ENGINEER BEFORE PROCEEDING WITH ANY WORK.
 - VOLTAGE DROP FOR ALL BRANCH CONDUCTORS SHALL NOT EXCEED 3%, WHERE VOLTAGE DROP EXCEEDS 3%, CONTRACTOR SHALL INCREASE SIZE OF CONDUCTORS.
 - CONTRACTOR SHALL PROVIDE GFI TYPE BREAKER FOR ALL EXTERIOR 120V CIRCUITS OR GFI PROTECTION -- FOR THE WHOLE CIRCUIT.
 - GAS PIPING SHALL BE BONDED.
 - ELECTRICAL CONTRACTOR SHALL COORDINATE SERVICE ENTRY WITH SERVICE PROVIDER PRIOR TO DETERMINING EXACT LOCATION OF THE METER BOX IN ORDER TO AVOID DISCREPANCIES BETWEEN DRAWINGS AND JOB CONDITIONS.
 - ALL OUTDOOR EQUIPMENT SHALL BE WEATHERPROOF.
 - CONSTRUCTION "AS BUILT" DRAWINGS AND DOCUMENTS SHALL BE PROVIDED TO THE OWNER WITHIN 30 DAYS AFTER THE DATE OF ACCEPTANCE. PROVIDE A COPY TO LL.
 - OPERATION MANUALS AND MAINTENANCE MANUALS SHALL BE PROVIDED TO THE BUILDING OWNER.
 - ABSOLUTELY NO FLEXIBLE CONDUIT IS PERMITTED IN DEMISING WALLS. FLEXIBLE CONDUIT IS PERMITTED FOR SHORT FINAL CONNECTIONS ONLY (6'-0" OR LESS).
 - EXPOSED CONDUIT SHALL BE INSTALLED IN STRAIGHT LINES, PARALLEL OR IN RIGHT ANGLES TO THE BUILDING STRUCTURE. DO NOT LOOP EXCESS FLEXIBLE CONDUIT IN CEILING SPACE OR WALL CAVITY. NO CONDUIT TO BE SUPPORTED FROM THE ROOF DECK.
 - CABLE TYPES AC AND NM CABLES ARE NOT ACCEPTABLE. TYPE MC CABLE, ELECTRIC METALLIC TUBING (EMT) AND RIGID GALVANIZED CONDUIT ARE PERMITTED.
 - ALL EQUIPMENT, DEVICES AND FIXTURES SHALL BE GROUNDED IN COMPLIANCE WITH NEC AND UL REQUIREMENTS.
 - ALL PANELS TO BE UL LABELED WITH BOLT-ON TYPE CIRCUIT BREAKERS.
 - 7-DAY 24-HOUR TIME CLOCK IS REQUIRED TO CONTROL STOREFRONT ENTRY LIGHTS. SHOW WINDOW LIGHTS. SHOW WINDOW RECEPTACLES AND STOREFRONT SIGNAGE. ILLUMINATED STOREFRONT SIGNS MUST REMAIN LIT DURING ALL MALL BUSINESS HOURS.
 - TENANT IS REQUIRED TO MAKE A FIELD SURVEY OF THE EXISTING ELECTRICAL SERVICE TO ENSURE THAT THE TOTAL CONNECTED LOAD DOES NOT EXCEED THE ELECTRIC SERVICE. ANY ALL MODIFICATIONS OR UPGRADES NEEDED ARE SUBJECT TO LANDLORD'S PRIOR APPROVAL AND WILL BE COMPLETED BY TENANT/TENANT'S GC AT TENANT'S SOLE EXPENSE.
 - ALL ELECTRICAL PANELS TO BE MOUNTED ON PLYWOOD BACKER BOARD.
 - PANEL PHASE LOADS TO BE BALANCED WITHIN 10%.

GENERAL LIGHTING NOTES

- WHERE LIGHT FIXTURE IS FOLLOWED BY "NL", THIS FIXTURE IS DESIGNATED AS A NIGHT LIGHT AND SHALL BE CONNECTED TO AN UNSWITCHED HOT CONDUCTOR.
- UPPER CASE LETTER NEXT TO LIGHT FIXTURE DENOTES FIXTURE TYPE AND LOWER CASE LETTER DENOTES SWITCHING SCHEME.
- ALL EMERGENCY FIXTURES SHALL BE CONNECTED TO AN UNSWITCHED HOT CONDUCTOR

ELECTRICAL LEGEND

SYMBOL	DESCRIPTION
	EXHAUST FAN
	COMBINATION EXHAUST FAN/LIGHT (REFER TO MECHANICAL PLANS)
	SPEAKERS @ CEILING
	JUNCTION BOX
	CEILING MOUNTED DAYLIGHT SENSOR
	BATTERY BACK UP EXIT LIGHT
	BATTERY BACK UP EMERGENCY LIGHT
	WALL SWITCH (SINGLE, DOUBLE,)
	WALL SWITCH (3 WAY, 4 WAY)
	WALL SWITCH (TIMER)
	DIMMER WALL SWITCH
	OCCUPANCY SENSOR WALL SWITCH
	VARIABLE SPEED SWITCH
	SIMPLEX RECEPTACLE, +18" AFF OR AS NOTED. SUFFIX DENOTES FOLLOWING: A - NEMA 5-15R B - NEMA 6-15R C - NEMA 14-30R D - NEMA 14-50R E - NEMA L6-30R
	DUPLEX RECEPTACLE
	DUPLEX RECEPTACLE, 46" TO AFF AT KITCHEN, BATHS AND TOPS
	HALF SWITCHED DUPLEX RECEPTACLE
	230 VOLT RECEPTACLE
	QUADRUPLEX RECEPTACLE
	FLOOR MOUNTED, FLUSH DUPLEX RECEPTACLE
	FLOOR MOUNTED, FLUSH QUAD. RECEPTACLE
	FLOOR MOUNTED, FLUSH 230 VOLT RECEPTACLE
	CEILING MOUNTED DUPLEX RECEPTACLE
	ELECTRICAL PANEL
	DISCONNECT SWITCH
	USB CHARGER RECEPTACLE
	TELEVISION OUTLET
	TELEPHONE OUTLET
	TELEPHONE/DATA OUTLET
	DATA OUTLET
	FLOOR MTD. FLUSH TELEPHONE/DATA OUTLET
	QUAD. DATA OUTLET RJ45
	THERMOSTAT DEVICE
	AC OUTDOOR UNIT MOTOR AS NOTED WITH WEATHERPROOF CONTROLLER AND DISCONNECT SWITCH WITH
	NON FUSED DISCONNECT SWITCH AMPERAGE, A ND NUMBER OF POLES AS NOTED
	30A/240V NON FUSED DISCONNECT SWITCH
	60A/240V NON FUSED DISCONNECT SWITCH
	100A/240V NON FUSED DISCONNECT SWITCH
	200A/240V NON FUSED DISCONNECT SWITCH

ABBREVIATIONS:

ABOVE FINISH FLOOR= A.F.F.
COUNTER TOP LEVEL= C
GROUND FAULT INTERRUPTER= GFCI
VERIFY PRIOR TO INSTALL= VH
WEATHER PROOF= WP


BELOW COUNTER= BC
PUSH BUTTON= PB
UNDER CABINET= UC
VAPOR PROOF= VP
SALVAGED = S

EXISTING CONTIDITONS NOTES

STOP AND READ
THE CONTRACTOR AND SUB--CONTRACTORS **SHALL NOT INITIATE ANY WORK UNTIL EXISTING FIELD CONDITIONS ARE PROPERLY VERIFIED.** THIS SHALL HOLD TRUE FOR FIRST GENERATION AND 2ND GENERATION SPACES. WHEN DEMOLITION IS REQUIRED, THAT WILL BE PERMITTED TO EXPOSE CONDITIONS. THESE VERIFICATIONS SHALL INCLUDE BUT NOT LIMITED TO: DIMENSIONS BOTH HORIZONTALLY AND VERTICAL, ELECTRICAL SERVICE /PANELS LOCATION AND VOLTS/PHASE, LOCATION/QTY OF ROOF MOUNTED HVAC EQUIPMENT, CONFIRM THAT INTERIOR HVAC HUNG UNITS HAVE PROPER SUPPORT CONNECTIONS FOR EXISTING STRUCTURE, FIRE SPRINKLER MAIN RUNS, TOILET ROOM DIMENSIONS, DOOR SWING FOR DOORS TO REMAIN AND ETC. IF NOT VERIFIED AND DISCOVERED AT A LATER TIME, THE CONTRACTOR SHALL REIMBURSE THE ARCHITECT FOR THE REDESIGN FEE. THIS DOES NOT INCLUDE HIDDEN WORK I.E. PITCH OF SANITARY LINES, ACTUAL CONDITIONS OF EXISTING HVAC EQUIPMENT, STRUCTURAL COLUMNS/BEARING WALLS OR CONDITIONS OF GREASE INTERCEPTORS AND ETC.

LIGHTING FIXTURE SCHEDULE

	TYPE	DESCRIPTION	MANUFACTURER	CATALOG NUMBER	VOLT	NUMBER OF FIXTURES	LAMP TYPE	TOTAL WATTS	MOUNTING
	A	4" RECESSED DOWN LIGHT LED W/DIMMING	COMMERCIAL LIGHTING	SS4G4DR	120	17	LED	10 WATTS	RECESSED
	B	4" RECESSED LED WALL WASH W/DIMMING	COMMERCIAL LIGHTING	SS4G4DR	120	8	LED	10 WATTS	RECESSED
	C	ACCENT PENDANT LIGHTS	COMMERCIAL LIGHTING	TBD	120	2	LED	40 WATTS	PENDANT
	D	CHANDELIER	COMMERCIAL LIGHTING	TBD	120	1	LED	50 WATTS	PENDANT
	F	LED WALL SCONE	COMMERCIAL LIGHTING	TBD	120	2	LED	10 WATTS	TRACK
	G	4" RECESSED DOWN LIGHT LED W/DIMMING	COMMERCIAL LIGHTING	SS4G4DR	120	6	LED	21 WATTS	RECESSED
	H	4" RECESSED DOWN LIGHT LED W/DIMMING	COMMERCIAL LIGHTING	SS4G4DR	120	12	LED	13 WATTS	RECESSED
	I	LED ROPE LIGHT	COMMERCIAL LIGHTING	TBD	120	31'	LED	-	-
	X1	EXIT/EMERGENCY COMBO SIGNS	COMMERCIAL LIGHTING	LRP-LED	120	1	LED	5 WATTS	WALL/CEILING
	EU	EMERGENCY LIGHTS	COMMERCIAL LIGHTING	ECR-LED	120	6	LED	5 WATTS	WALL
	EX	EXIT/EMERGENCY COMBO SIGNS	COMMERCIAL LIGHTING	ELM2	120	3	LED	5 WATTS	WALL
	(E)	EXISTING TRACK LIGHT	--	--	--	6	--	--	--
	D	DIMMER WALL SWITCH	COMMERCIAL LIGHTING INDUSTRY	CLI-NAROSDS	120				
	T	TIMER WALL SWITCH	LEVITON	6124	120				
	OS	OCCUPANCY WALL SWITCH	LEVITON	ODS10	120				
	OS	CEILING OCCUPANCY SENSOR	LEVITON	O2C10-JDW	120				
	LCP	LIGHTING CONTROL PANEL	COMMERCIAL LIGHTING	LITEKEEPER 16	120				

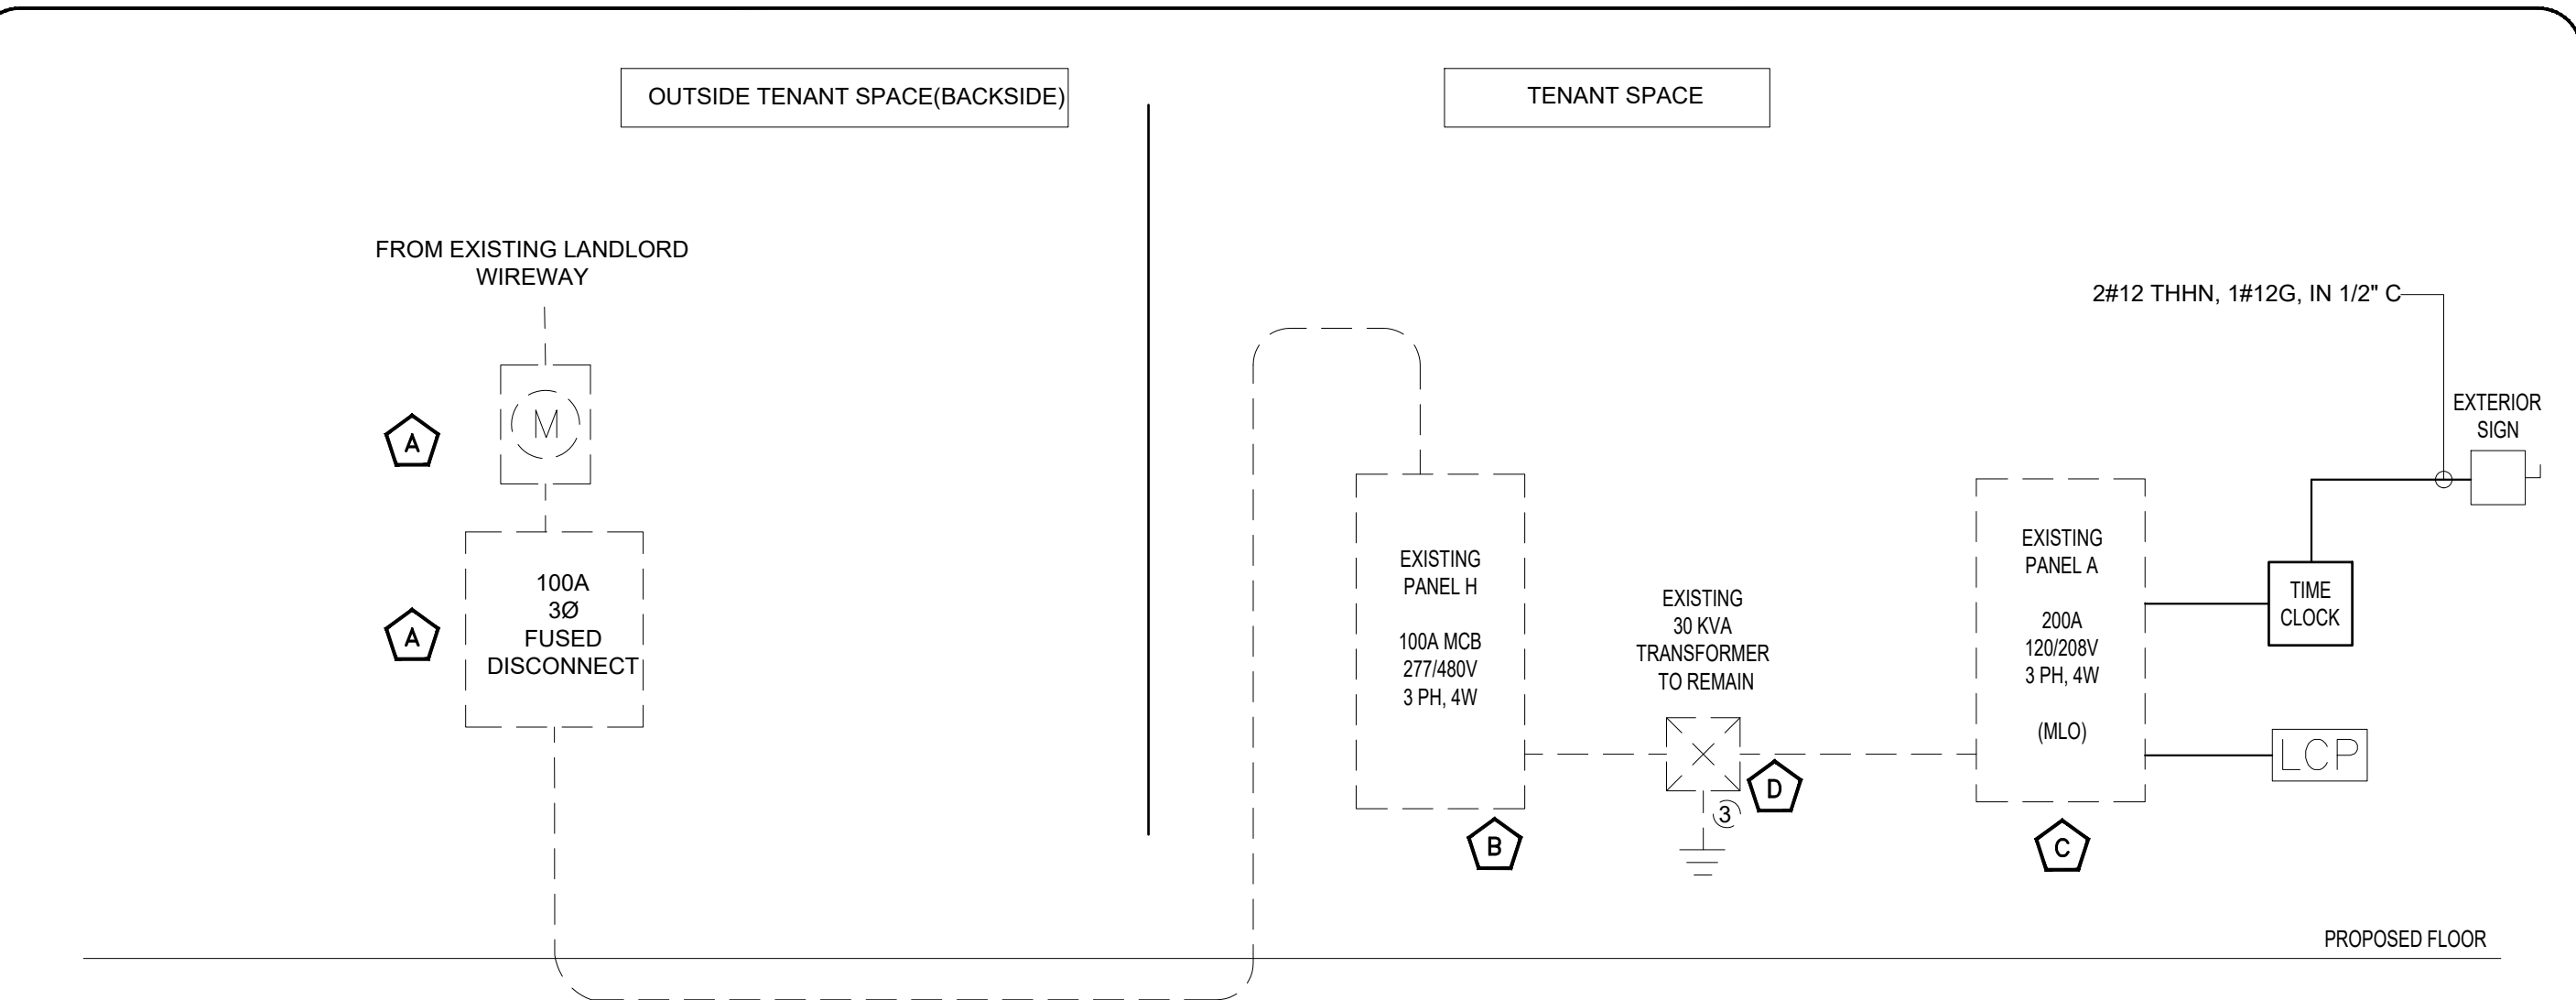

ELECTRICAL RISER KEYED WORK NOTES:

- EXISTING 100A, 277/480 VOLTS 3-PHASE ELECTRICAL DISCONNECT SWITCH AND METER ARE LOCATED AT THE BACK OF SPACE. E.C. SHALL VERIFY THE LOCATION AND COORDINATE WITH THE OWNER FOR EXACT DISTRIBUTION.
- EXISTING 100A, 277/480V, 3-PHASE ELECTRICAL PANEL "H" AND ITS CONNECTIONS TO REMAIN . E.C. TO VERIFY OPERABLE CONDITIONS OF PANEL IN FIELD. REPLACE IF INOPERABLE. BASE BID ACCORDINGLY.
- EXISTING 200A, 120/208V, 3-PHASE ELECTRICAL PANEL "A" TO REMAIN . E.C. TO VERIFY OPERABLE CONDITION OF PANEL IN FIELD. REPLACE IF INOPERABLE. BASE BID ACCORDINGLY.
- EXISTING 30KVA, 3-PHASE TRANSFORMER AND ITS CONNECTIONS TO REMAIN. E.C TO VERIFY OPERABLE CONDITION OF TRANSFORMER IN FIELD. REPLACE IF INOPERABLE. BASE BID ACCORDINGLY.

NOTE:

- ELECTRICAL CONTRACTOR TO COORDINATE FAULT CURRENT (Isc) RATING WITH UTILITY COMPANY AND AHJ PRIOR TO COMMENCING ANY WORK.

ELECTRICAL RISER

SCALE

N.T.S.

1

NY ENGINEERS

382 NE 191ST ST.
SUITE, 49674, MIAMI
FL 33179

THIS DOCUMENT IS THE PROPERTY OF NEARBY ENGINEERS AND SHALL NOT BE REPRODUCED WITHOUT THE WRITTEN CONSENT OF NEARBY ENGINEERS.

PROJECT

THE DRIPBAR

930-M NW BLUE PKWY.,
LEES SUMMIT, MO 64086

REVISIONS DATES:

10.20.2021 REVISION 1
10.26.2021 REVISION 2

PROFESSIONAL SEAL



ERIC ENGELL #2002014528
PROFESSIONAL ENGINEER
STATE OF MISSOURI

ISSUE DATE: 08.23.2021

PROJECT #: 328P.1313P

DRAWN BY: NYE


CHECKED BY: NYE

ELECTRICAL
PLAN NOTES
AND RISER
DIAGRAM

E-1

ELECTRICAL PLAN KEYED WORK NOTES:

- A CONNECT ALL EMERGENCY EGRESS AND NIGHT LIGHTING FIXTURES TO THE NEAREST LIGHTING BRANCH CIRCUIT AHEAD OF ALL SWITCHING AND CONTROLS PER STATE AND LOCAL CODES.
- B E.C. SHALL COORDINATE EXACT LOCATION OF THE LIGHTING CONTROL PANEL "LCP" WITH ARCHITECT/OWNER.
- C EXHAUST FANS SHALL BE CIRCUITED AND CONTROLLED ALONG WITH THE LIGHT FIXTURES IN THE SAME ROOM.
- D 200A, 120/208V, 3-PHASE EXISTING ELECTRICAL PANEL "A". E.C. TO COORDINATE OPERABLE CONDITION OF PANEL, INCOMING FEEDER ON FIELD, ALSO COORDINATE EXACT LOCATION WITH ARCHITECT/OWNER.
- E 100A, 277/480V, 3-PHASE NEW ELECTRICAL PANEL "B". E.C. TO COORDINATE EXACT LOCATION WITH ARCHITECT/OWNER.

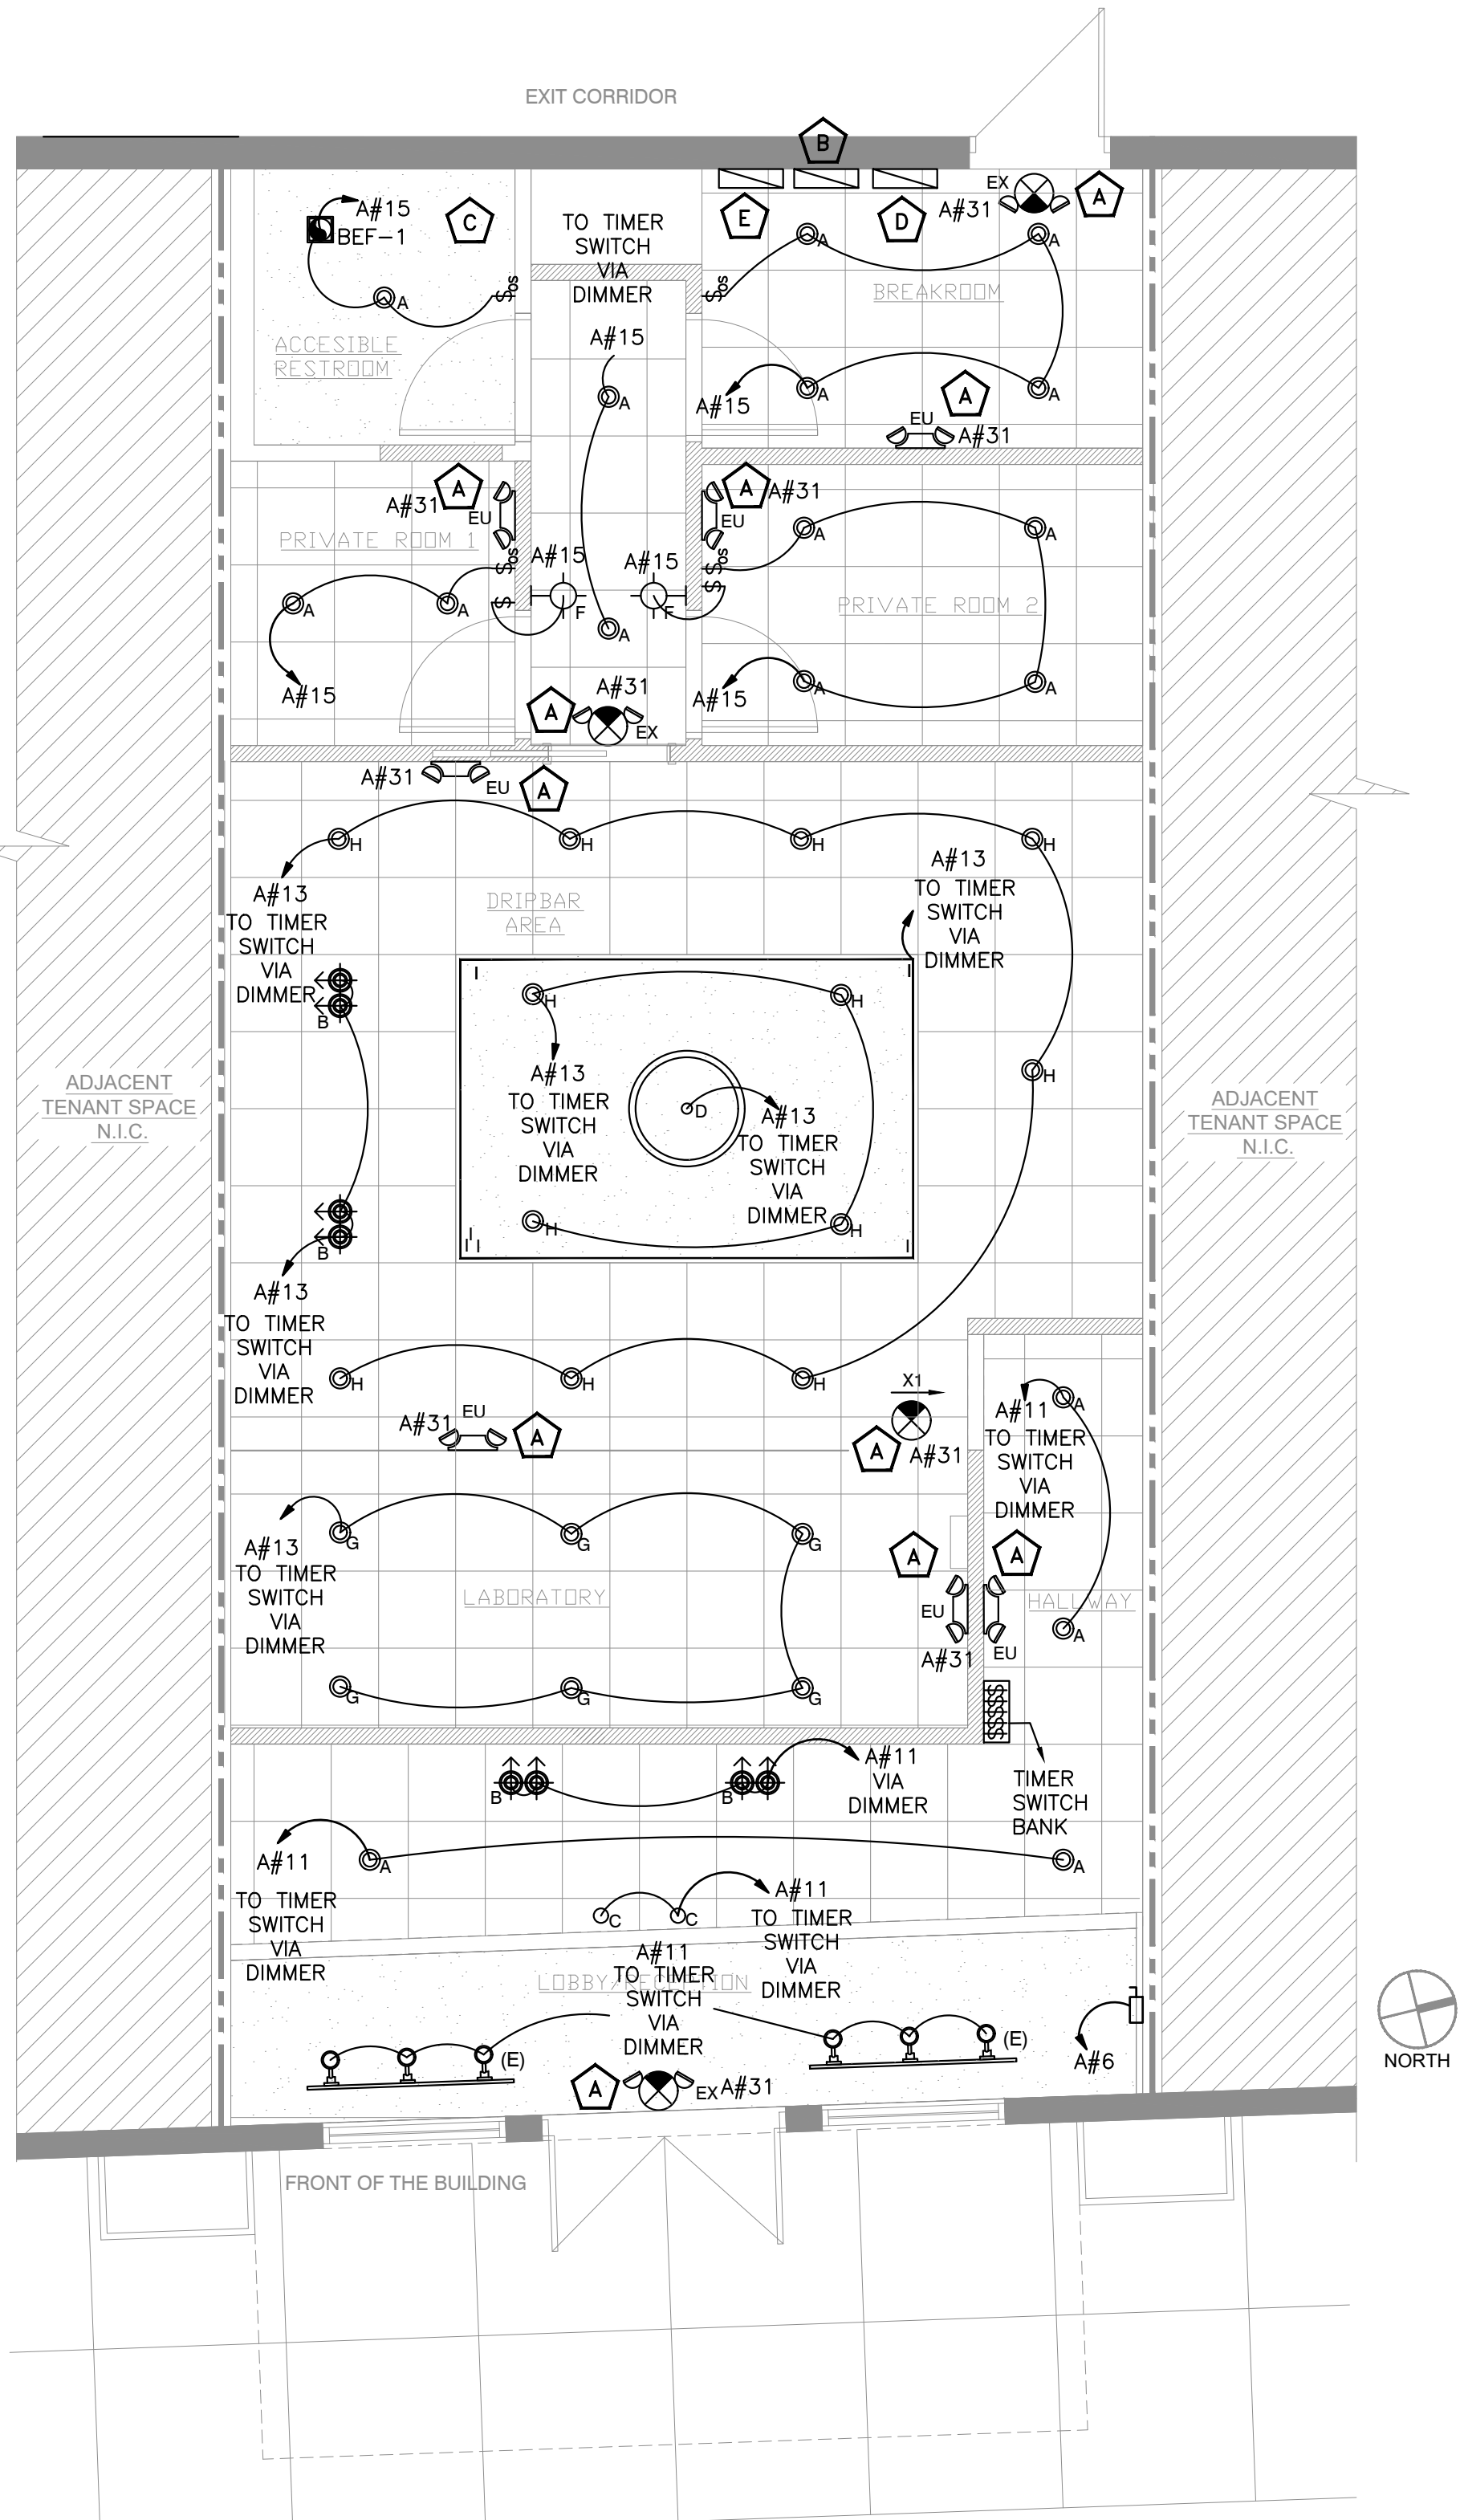

LIGHTING PLAN


SCALE
1/4" = 1'-0"

ELECTRICAL PLAN KEYED WORK NOTES:

- A 200A, 120/208V, 3-PHASE EXISTING ELECTRICAL PANEL "A". E.C. TO COORDINATE OPERABLE CONDITION OF PANEL, INCOMING FEEDER ON FIELD, ALSO COORDINATE EXACT LOCATION WITH ARCHITECT/OWNER.
- B LOCATION OF LIGHTING CONTROL PANEL, CONNECT TO PANEL A CKT #42. E.C. SHALL COORDINATE EXACT LOCATION OF THE LIGHTING CONTROL PANEL "LCP" WITH ARCHITECT/OWNER.
- C EXISTING ROOF TOP UNIT (RTU-1) AND ITS RECEPTACLE SHALL REMAIN CONNECTED TO THE EXISTING ELECTRICAL PANEL TO THE CIRCUIT NUMBER AS INDICATED ON DRAWINGS. E.C. SHALL VERIFY OPERABLE CONDITION OF THE EXISTING BRANCH CIRCUIT AND DISCONNECT SWITCH ON FIELD AND PROVIDE NEW IF FOUND INOPERABLE. BASE BID ACCORDINGLY.
- D 100A, 277/480V, 3-PHASE EXISTING ELECTRICAL PANEL "H" AND IT'S CONNECTIONS TO REMAIN. E.C. TO COORDINATE EXACT LOCATION WITH ARCHITECT/OWNER.
- E EXISTING 30KVA TRANSFORMER TO BE RELOCATED ABOVE CEILING AND ITS ELECTRICAL CONNECTIONS TO REMAIN. E.C. SHALL PLACE THE TRANSFORMER IN A WELL VENTILATED AREA WITH PROPER HEAT DISSIPATION SUCH THAT RELOCATION SHALL NOT CAUSE OVERHEATING ISSUES FOR THE TRANSFORMER. E.C. SHALL MAINTAIN CLEARANCE OF AT LEAST 36" IN FRONT AND 12" ON ALL OTHER SIDES OF THE TRANSFORMER AND SHALL BE ACCESSIBLE FOR MAINTENANCE.
- F E.C. TO COORDINATE HEIGHT OF JUNCTION BOX PER DETAIL ON A/3.

GENERAL NOTES FOR WIRING IN HEALTH CARE SPACES (DRIPBAR AREA AND PRIVATE ROOMS):

- E.C. TO INSTALL ALL BRANCH CIRCUITS IN A METAL RACEWAY SYSTEM SO AS TO PROVIDE EFFECTIVE GROUND FAULT CURRENT PATH. METAL RACEWAY SYSTEM SHALL QUALIFY AS EQUIPMENT GROUNDING CONDUCTOR IN ACCORDANCE WITH ARTICLE 250.118(NEC 2017).
- INSULATED COPPER GROUNDING CONDUCTOR SHALL BE INSTALLED WITH THE BRANCH CIRCUIT CONDUCTORS IN THE METAL RACEWAY SYSTEM AND SHALL BE CLEARLY IDENTIFIED ALONG ITS ENTIRE LENGTH BY GREEN INSULATION.
- THE FOLLOWING SHALL BE DIRECTLY CONNECTED TO AN INSULATED COPPER EQUIPMENT GROUNDING CONDUCTOR
 - THE GROUNDING TERMINALS OF ALL RECEPTACLES OTHER THAN ISOLATED GROUND RECEPTACLES.
 - METAL OUTLET BOXES, METAL DEVICE BOXES, OR METAL ENCLOSURES
 - ALL NON-CURRENT-CARRYING CONDUCTIVE SURFACES OF FIXED ELECTRICAL EQUIPMENT LIKELY TO BECOME ENERGIZED THAT ARE SUBJECT TO PERSONAL CONTACT, OPERATING AT OVER 100 VOLTS.

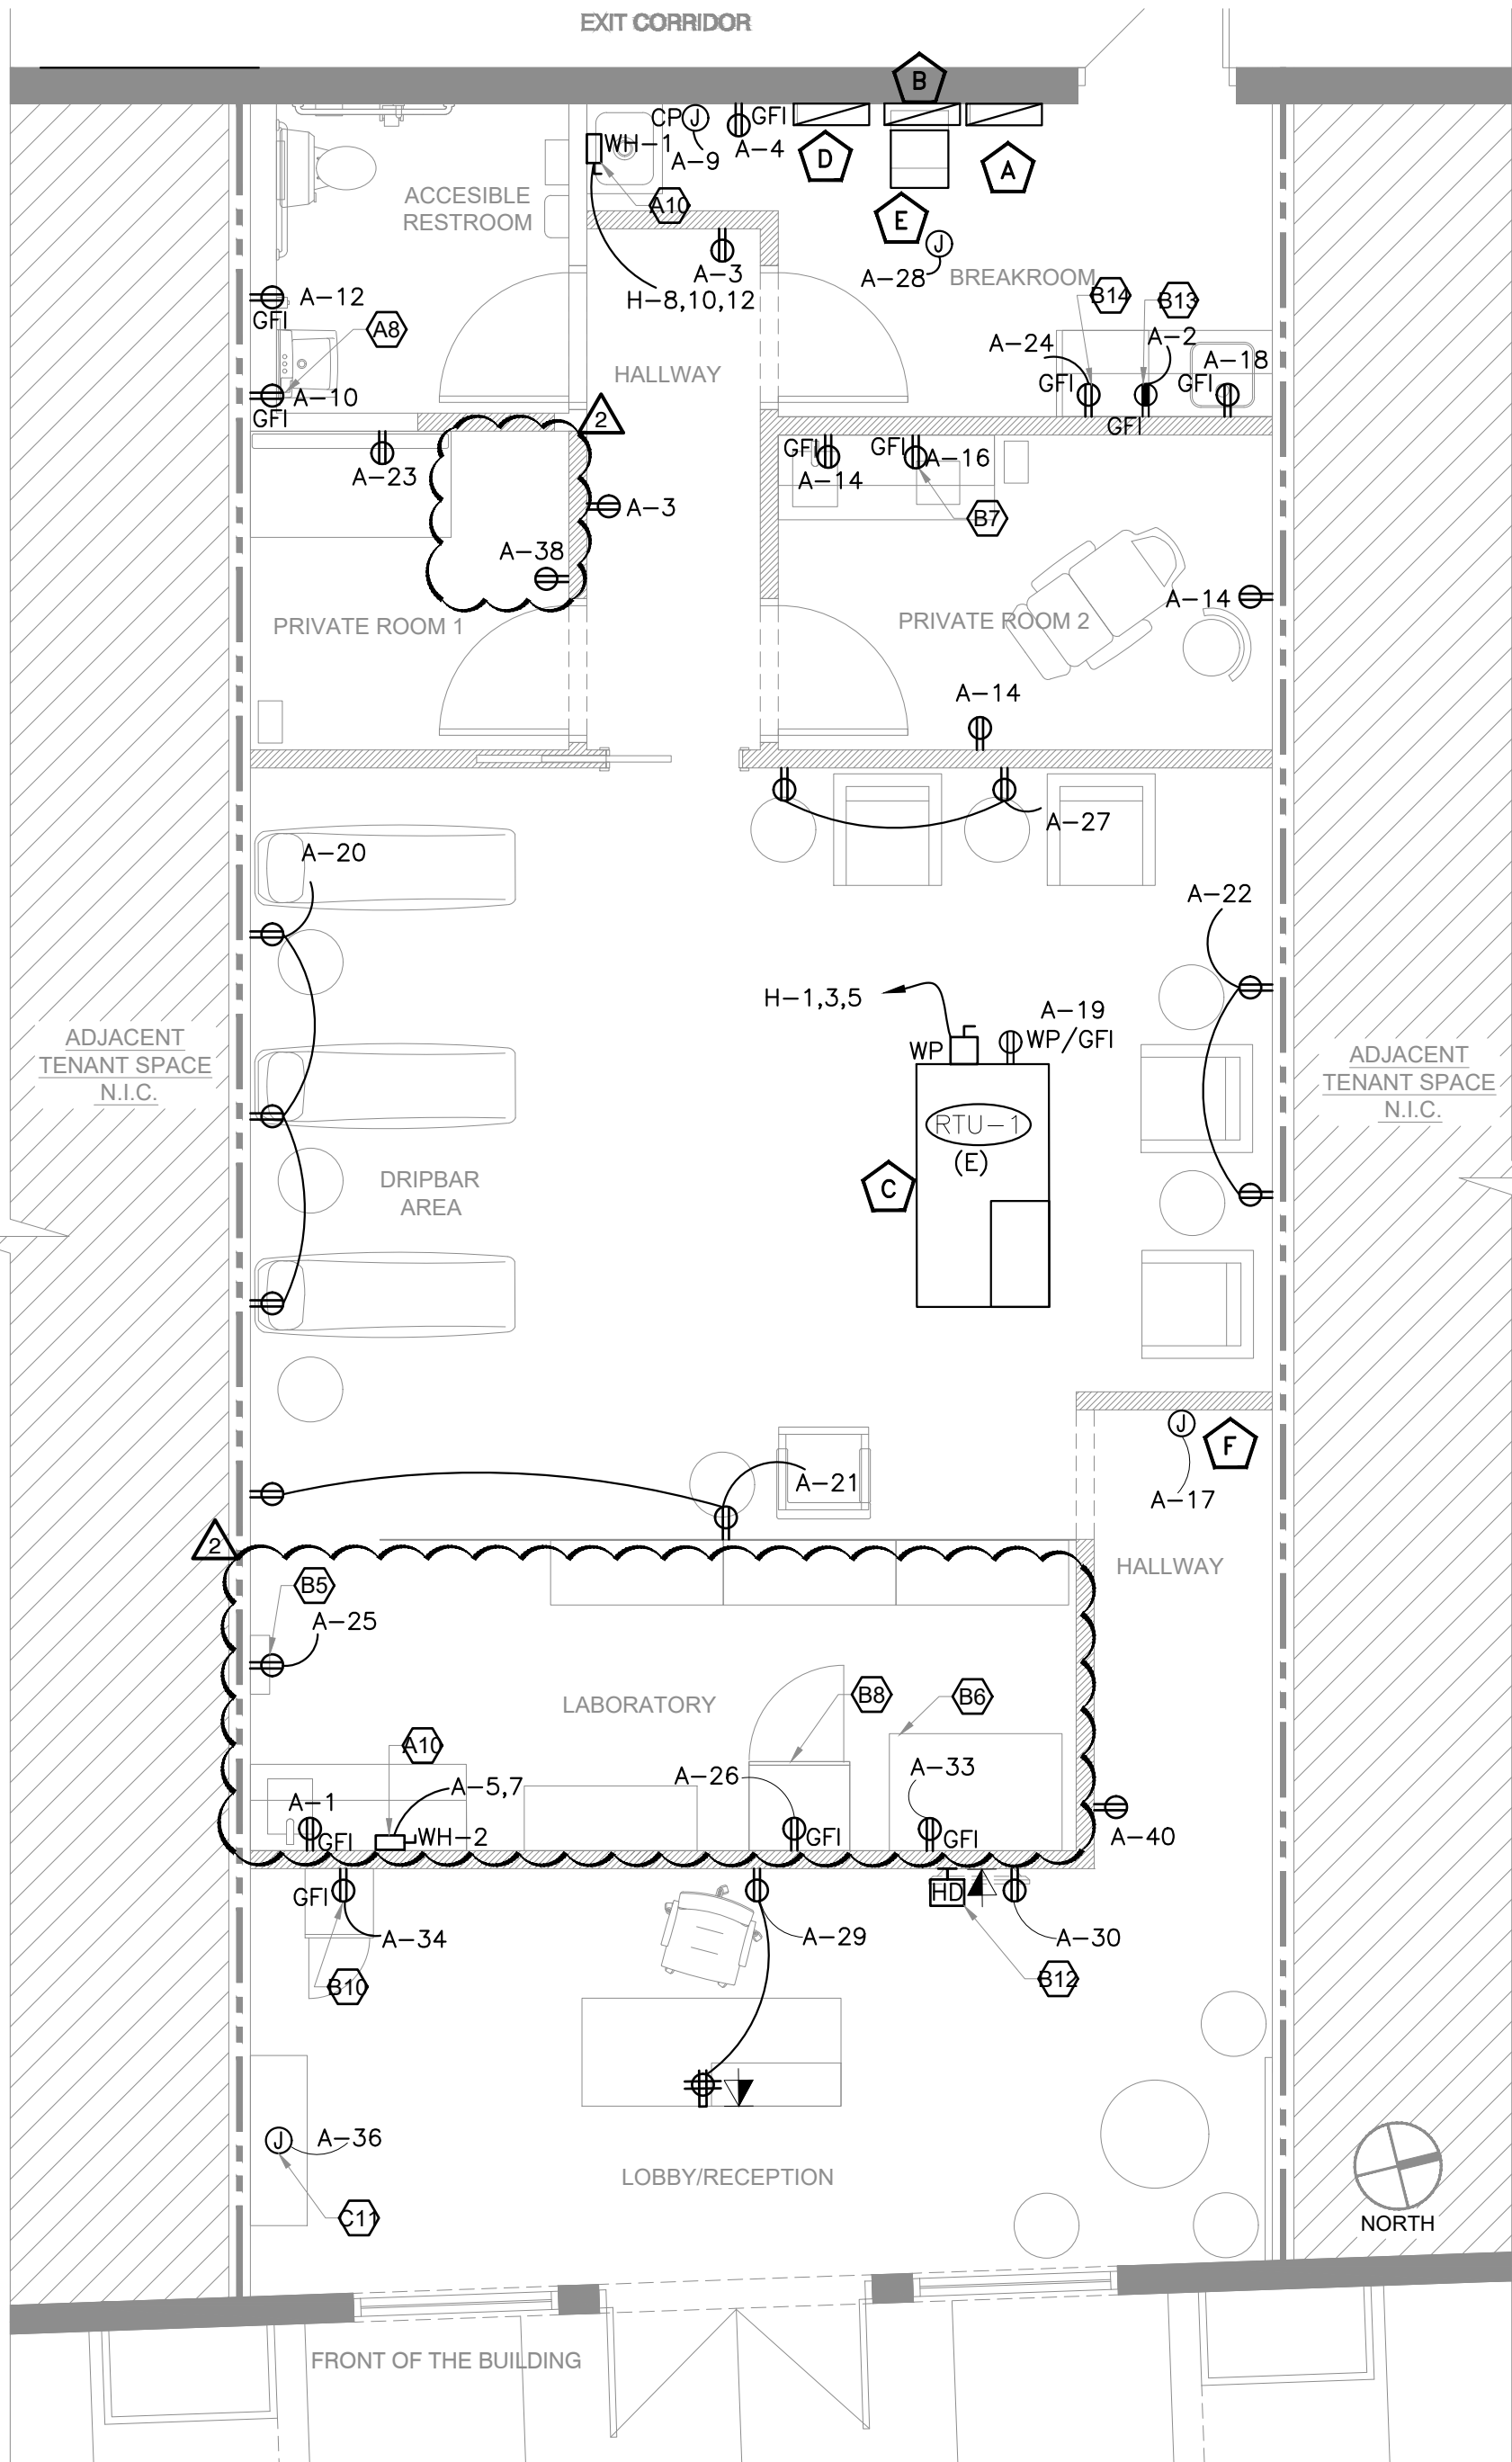

POWER PLAN

SCALE
1/4" = 1'-0"

REVISIONS DATES:

- 10.20.2021 REVISION 1
10.26.2021 REVISION 2

PROFESSIONAL SEAL



ERIC ENGELL #2002014528
PROFESSIONAL ENGINEER
STATE OF MISSOURI


ISSUE DATE: 08.23.2021
PROJECT #: 328P.1313P
DRAWN BY: NYE
CHECKED BY: NYE

LIGHTING &
POWER PLAN

PANEL:	H (EXISTING)													MOUNTING:	SURFACE		
480Y/277	VOLTS,		3	PHASE,		4	WIRE										
MAIN CB	100			BUS	125A	MIN,											
CKT NO.	TRIP AMPS	DESCRIPTION OF LOAD			LOAD TYPE	LOAD (KVA)	MINIMUM BRANCH CIRCUIT	PER PHASE (KVA)			MINIMUM BRANCH CIRCUIT	LOAD (KVA)	LOAD TYPE	DESCRIPTION OF LOAD		TRIP AMPS	CKT NO.
1	30/3P	RTU-1 (E)			M	7.10	EXISTING	13.71	B	C	EXISTING	6.61	E	30KVA TRANSFORMER (EX)		50/3P	2
3					M	7.10			13.71			6.61	E				4
5					M	7.10				13.71			6.61				E
7	20	SPARE						8.00			3#8, 1#10G, 3/4"C	8.00	H	WATER HEATER(WH-1)		40/3P	8
9	20	SPARE							8.00			8.00	H				10
11	20	SPARE								8.00			H				12
13		SPACE						0.00						SPACE			14
15		SPACE							0.00					SPACE			16
17		SPACE								0.00				SPACE			18
				TOTAL LOAD (KVA)				21.71	21.71	21.71							

PANEL SCHEDULE GENERAL NOTES:

- A. ALL CIRCUITING SHOWN FROM PANEL "A" IS FOR REFERENCE PURPOSE ONLY. E.C. SHALL VERIFY CIRCUITING OF THE EXISTING DEVICES IN FIELD AND MODIFY/ADJUST CIRCUITING AS REQUIRED.
- B. ELECTRICAL CONTRACTOR TO VERIFY THE EXACT PANEL SIZES AND INCOMING FEEDER SIZE.
- C. E.C. SHALL PROVIDE NEW CIRCUIT BREAKERS IN PLACE OF EXISTING CIRCUIT BREAKERS WHEREVER NECESSARY TO BE IN LINE WITH THE PANEL SCHEDULE.
- D. ALL FEEDERS AND WIRES SIZES SHALL BE OF COPPER CONDUCTORS.
- E. E.C. TO VERIFY COPPER EQUIPMENT BONDING CONDUCTOR SIZES OF EXISTING BRANCH CIRCUIT CONNECTIONS ARE IN ACCORDANCE WITH ARTICLE 250.122 (NEC 2017).



GENERAL NOTE:

1. ELECTRICAL CONTRACTOR SHALL VERIFY EXACT POWER REQUIREMENTS WITH THE MANUFACTURER PRIOR TO ROUGH-IN. BASE BID ACCORDINGLY.

382 NE 191ST ST.
SUITE, 49674, MIAMI
FL 33179

THIS DOCUMENT IS THE PROPERTY OF NEARBY ENGINEERS. AND
SHALL NOT BE REPRODUCED WITHOUT THE WRITTEN CONSENT
OF NEARBY ENGINEERS.

PROJECT

THE DRIPBAR

930-M NW BLUE PKWY,
LEES SUMMIT, MO 64086

REVISIONS DATES:

10.20.2021 REVISION 1

10.26.2021 REVISION 2

PROFESSIONAL SEAL



ERIC ENGELL #2002014520
PROFESSIONAL ENGINEER
STATE OF MISSOURI

ISSUE DATE: 08.23.2021

PROJECT #: 328P.1313P

DRAWN BY: NYE

CHECKED BY: NYE

PANEL SCHEDULES

E-3