
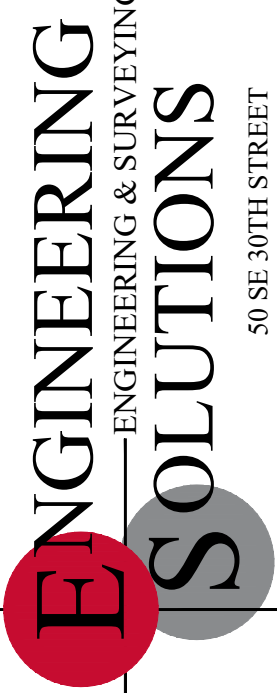


WATER LINE GENERAL LAYOUT

SCALE: 1" = 80'

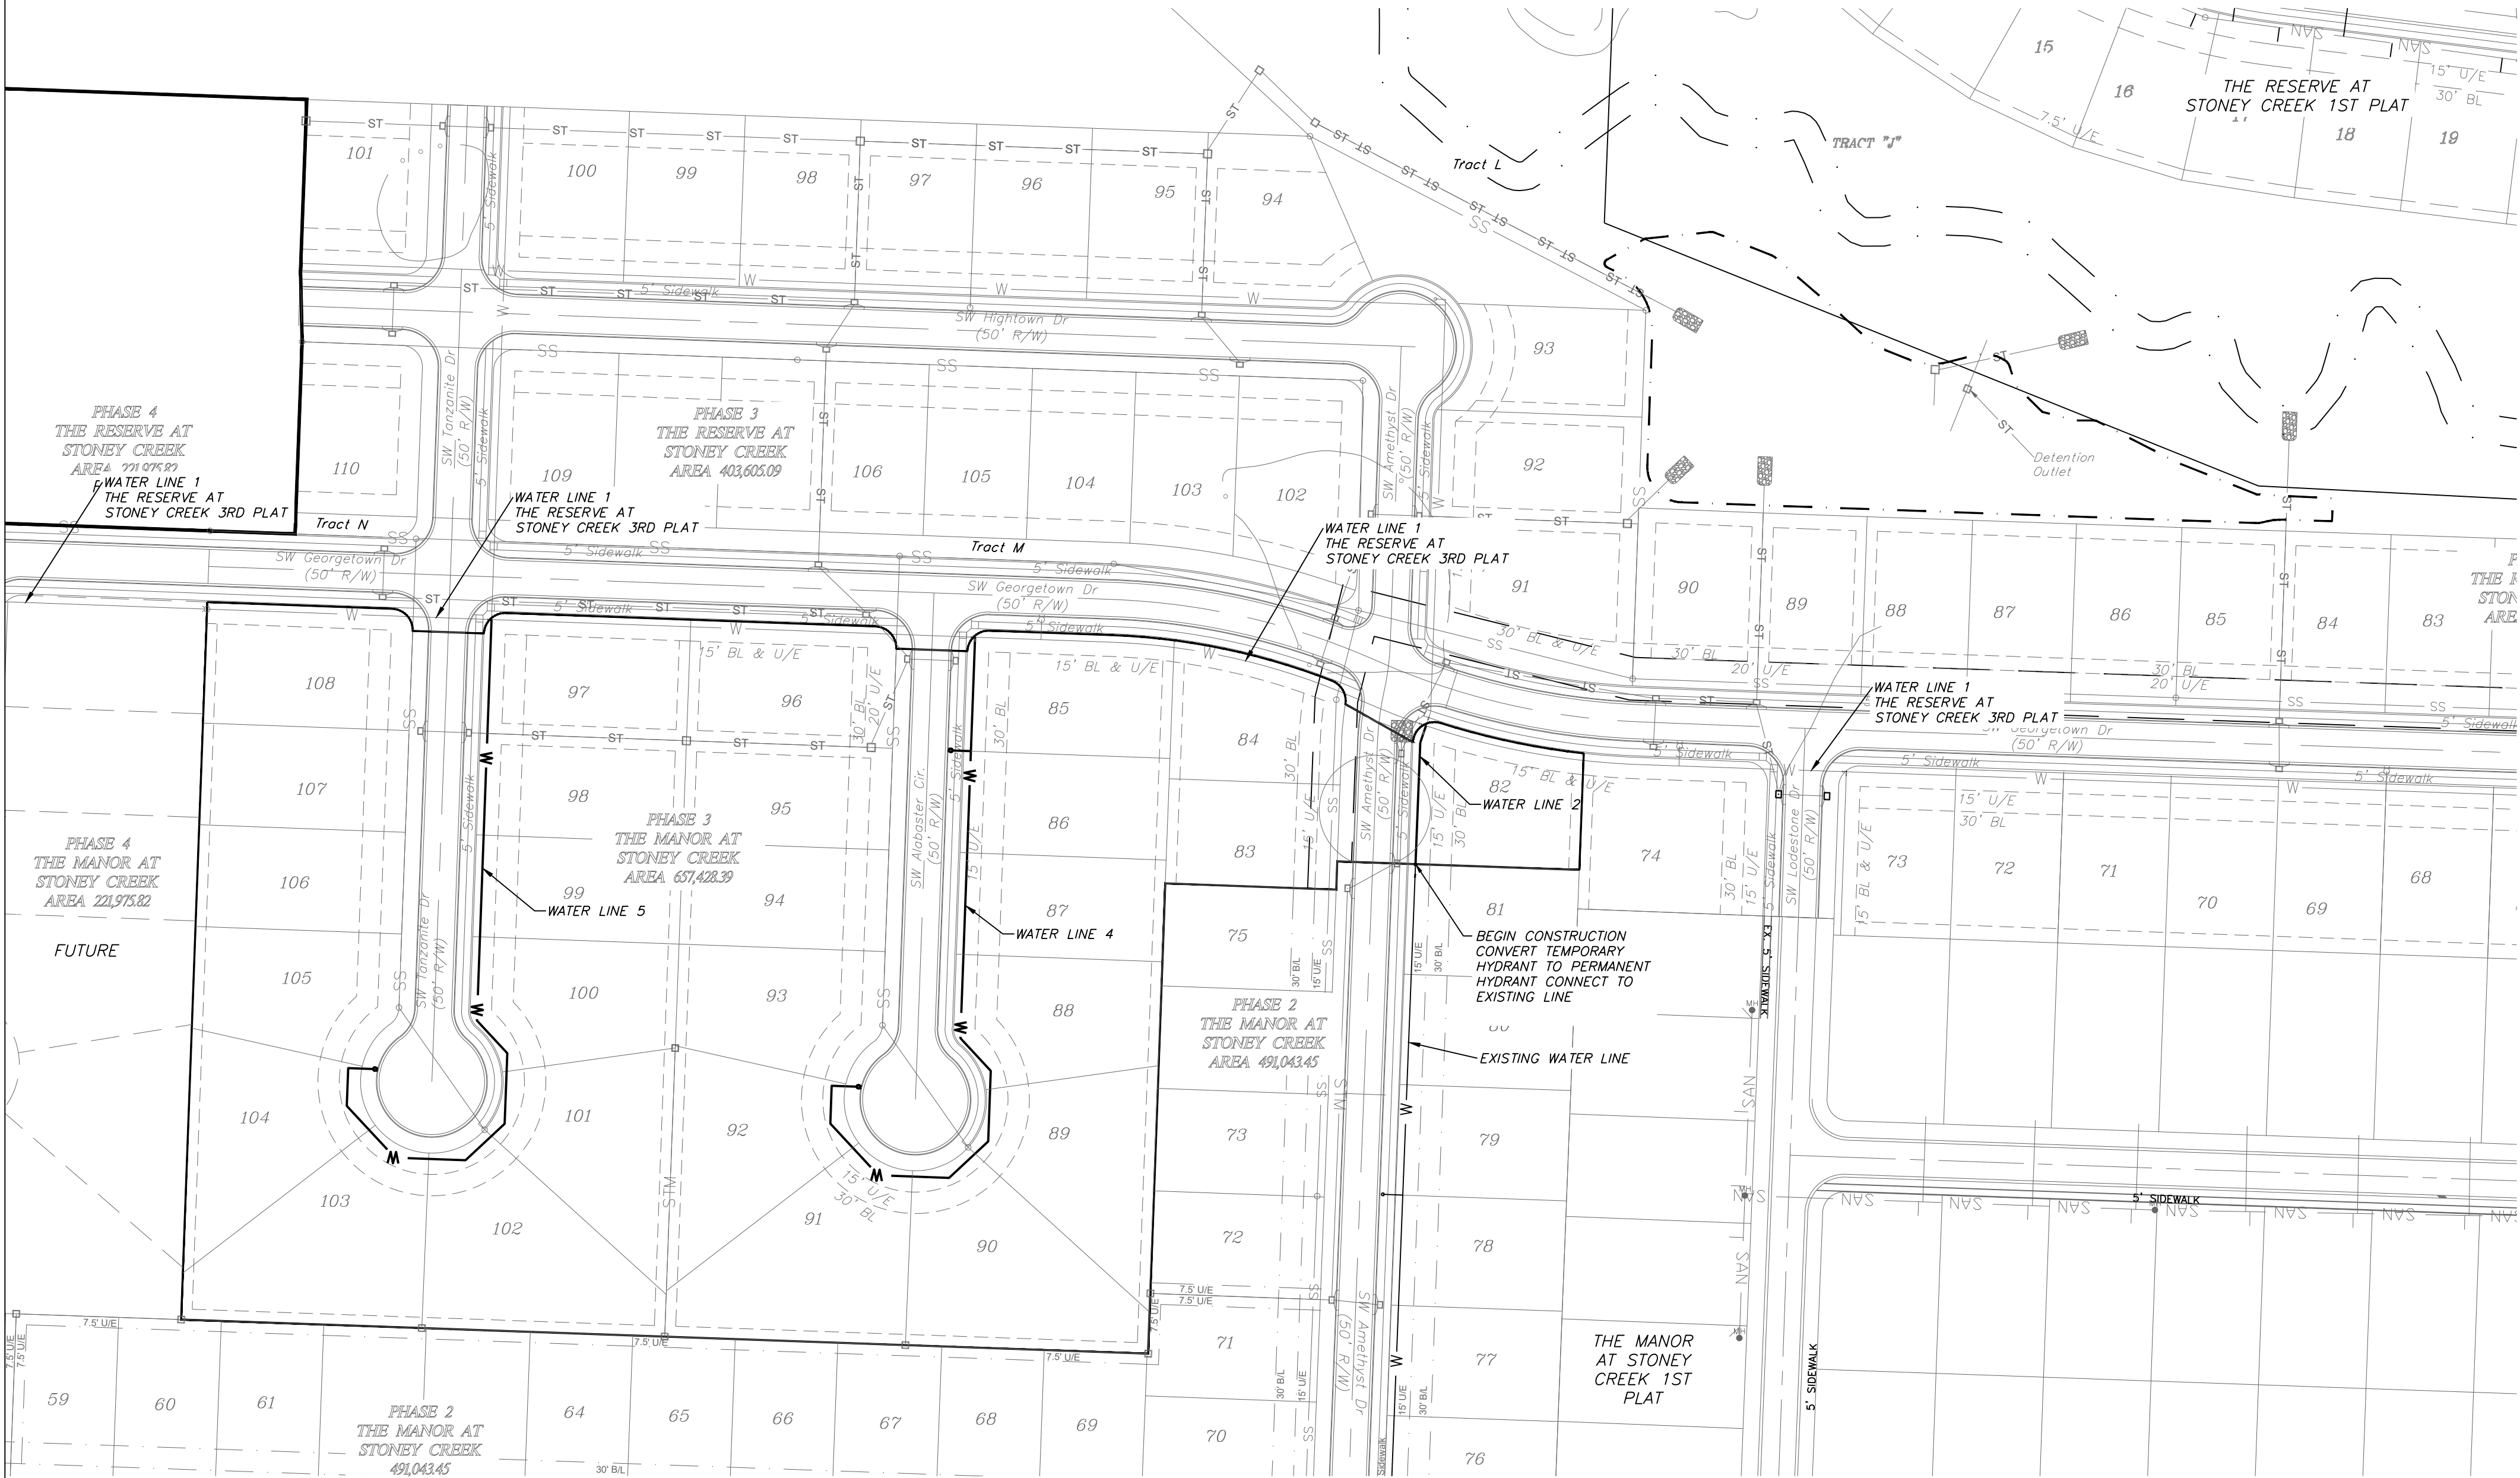


Professional Registration
Missouri
Engineering 2005002188-D
Surveying 2005005189-D
Kansas
Engineering E-1695
Surveying LS-218
Oklahoma
Engineering 6254
Nebraska
Engineering CA2821

The Manor at Stoney Creek - 3rd Plat
Lee's Summit, Jackson County, Missouri

Project: AT STONEY CREEK 3RD
Issue Date: July 18, 2017

Water Line General Layout
Construction Plans for:
The Manor at Stoney Creek - 3rd Plat
Lee's Summit, Jackson County, Missouri



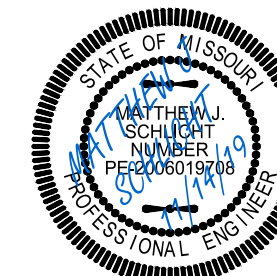


Matthew J. Schlicht
MO PE 2006019708
KS PE 19071
OK PE 25526


REVISIONS
9/24/19 - As-Built
11/7/19 - As-Built
11/14/19 - As-Built

"AS-BUILT"


900.10
~~900.00~~ Indicates data replaced with "As-Built" information. All other data is as designed and has not been field verified.

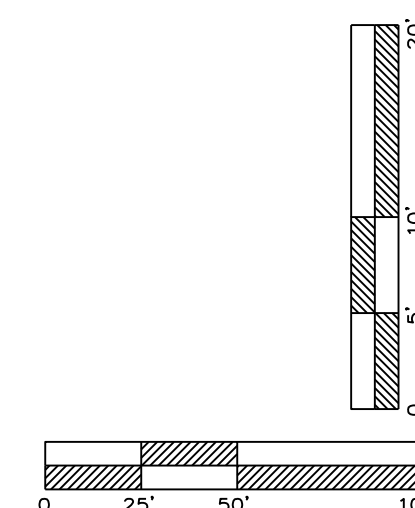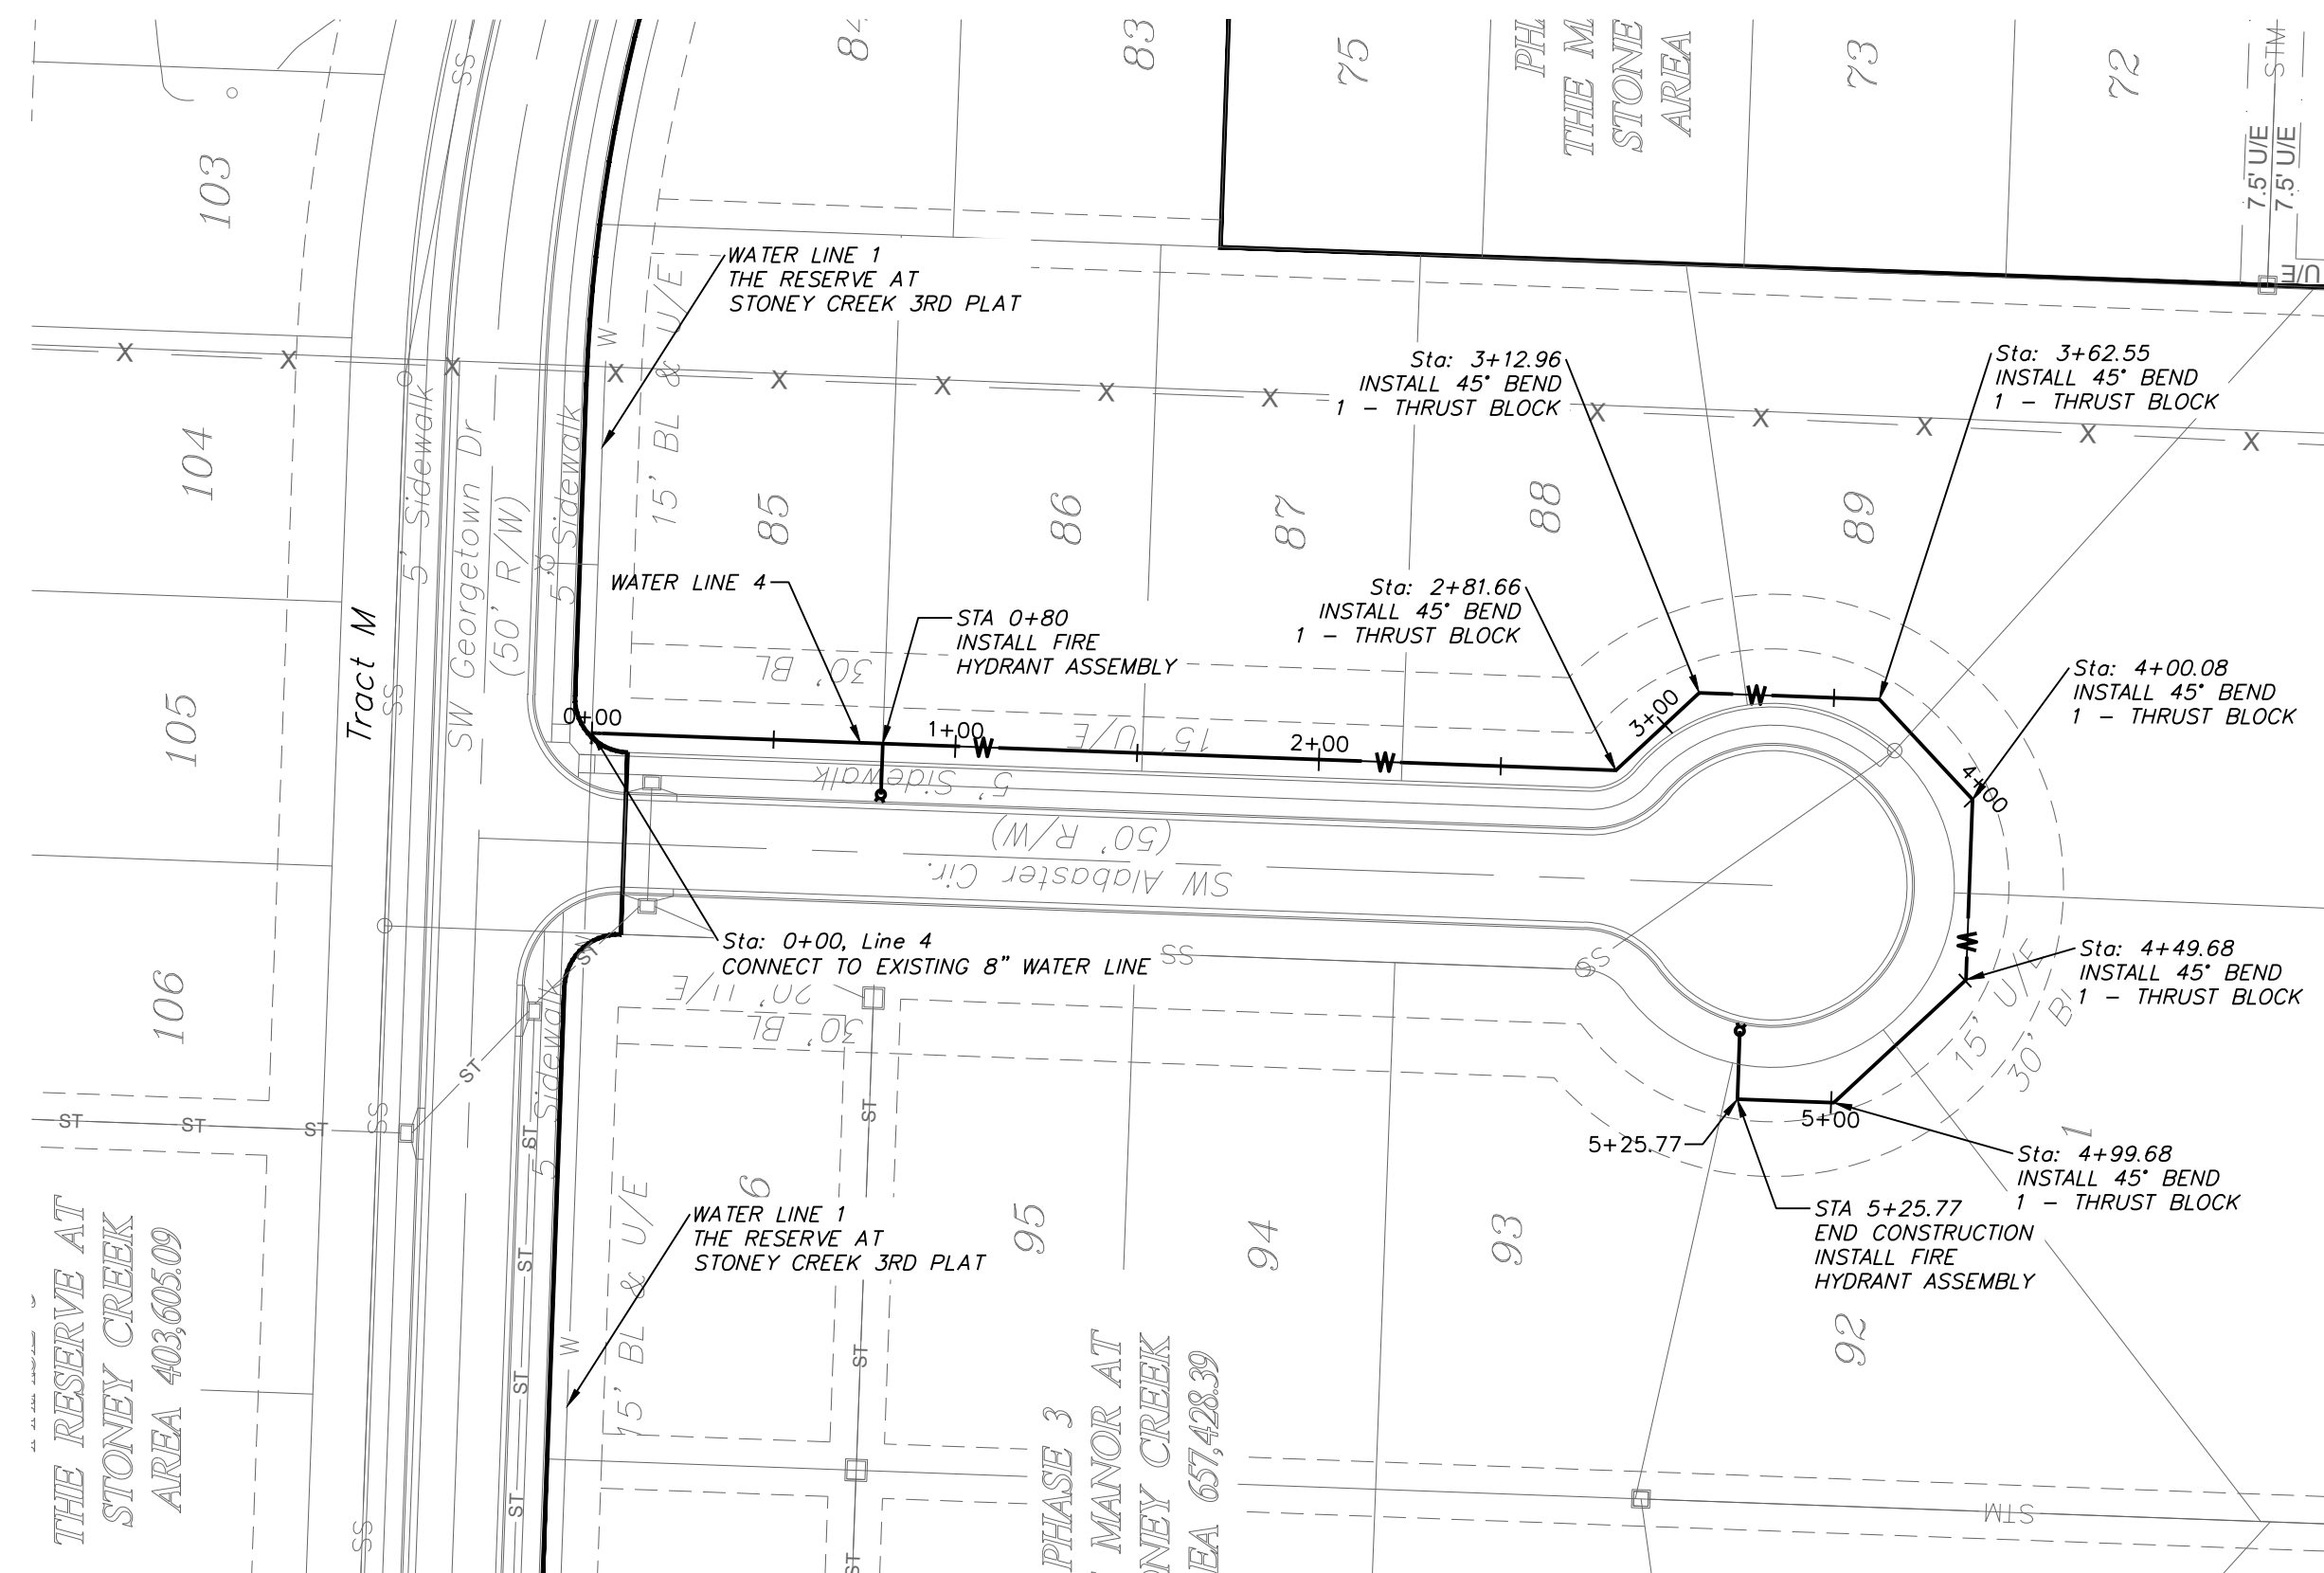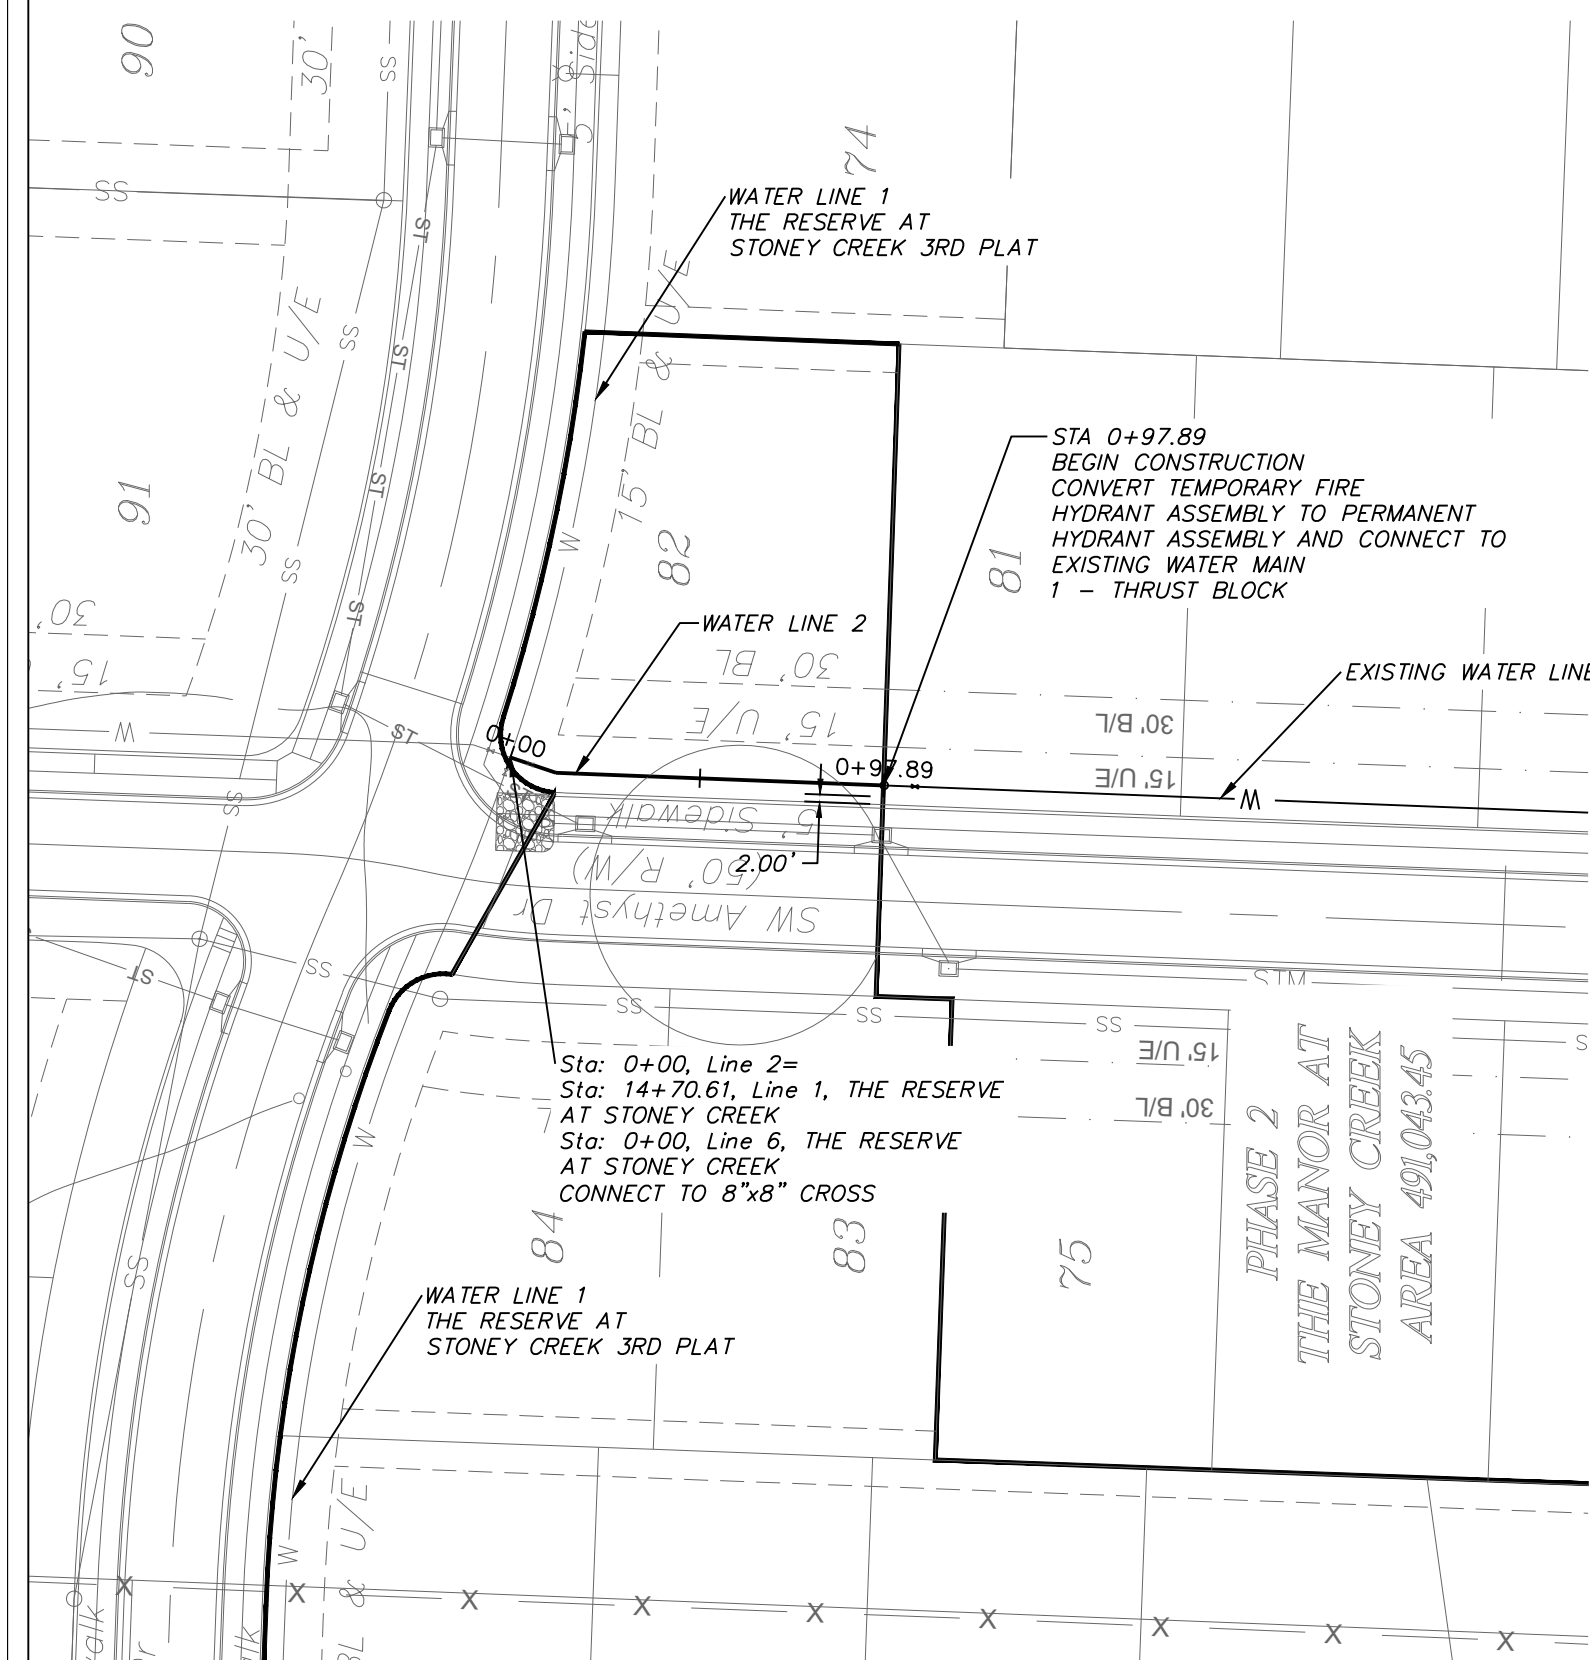

900.10
~~900.00~~ Indicates data replaced with "As-Built"
information. All other data is as designed
and has not been field verified.

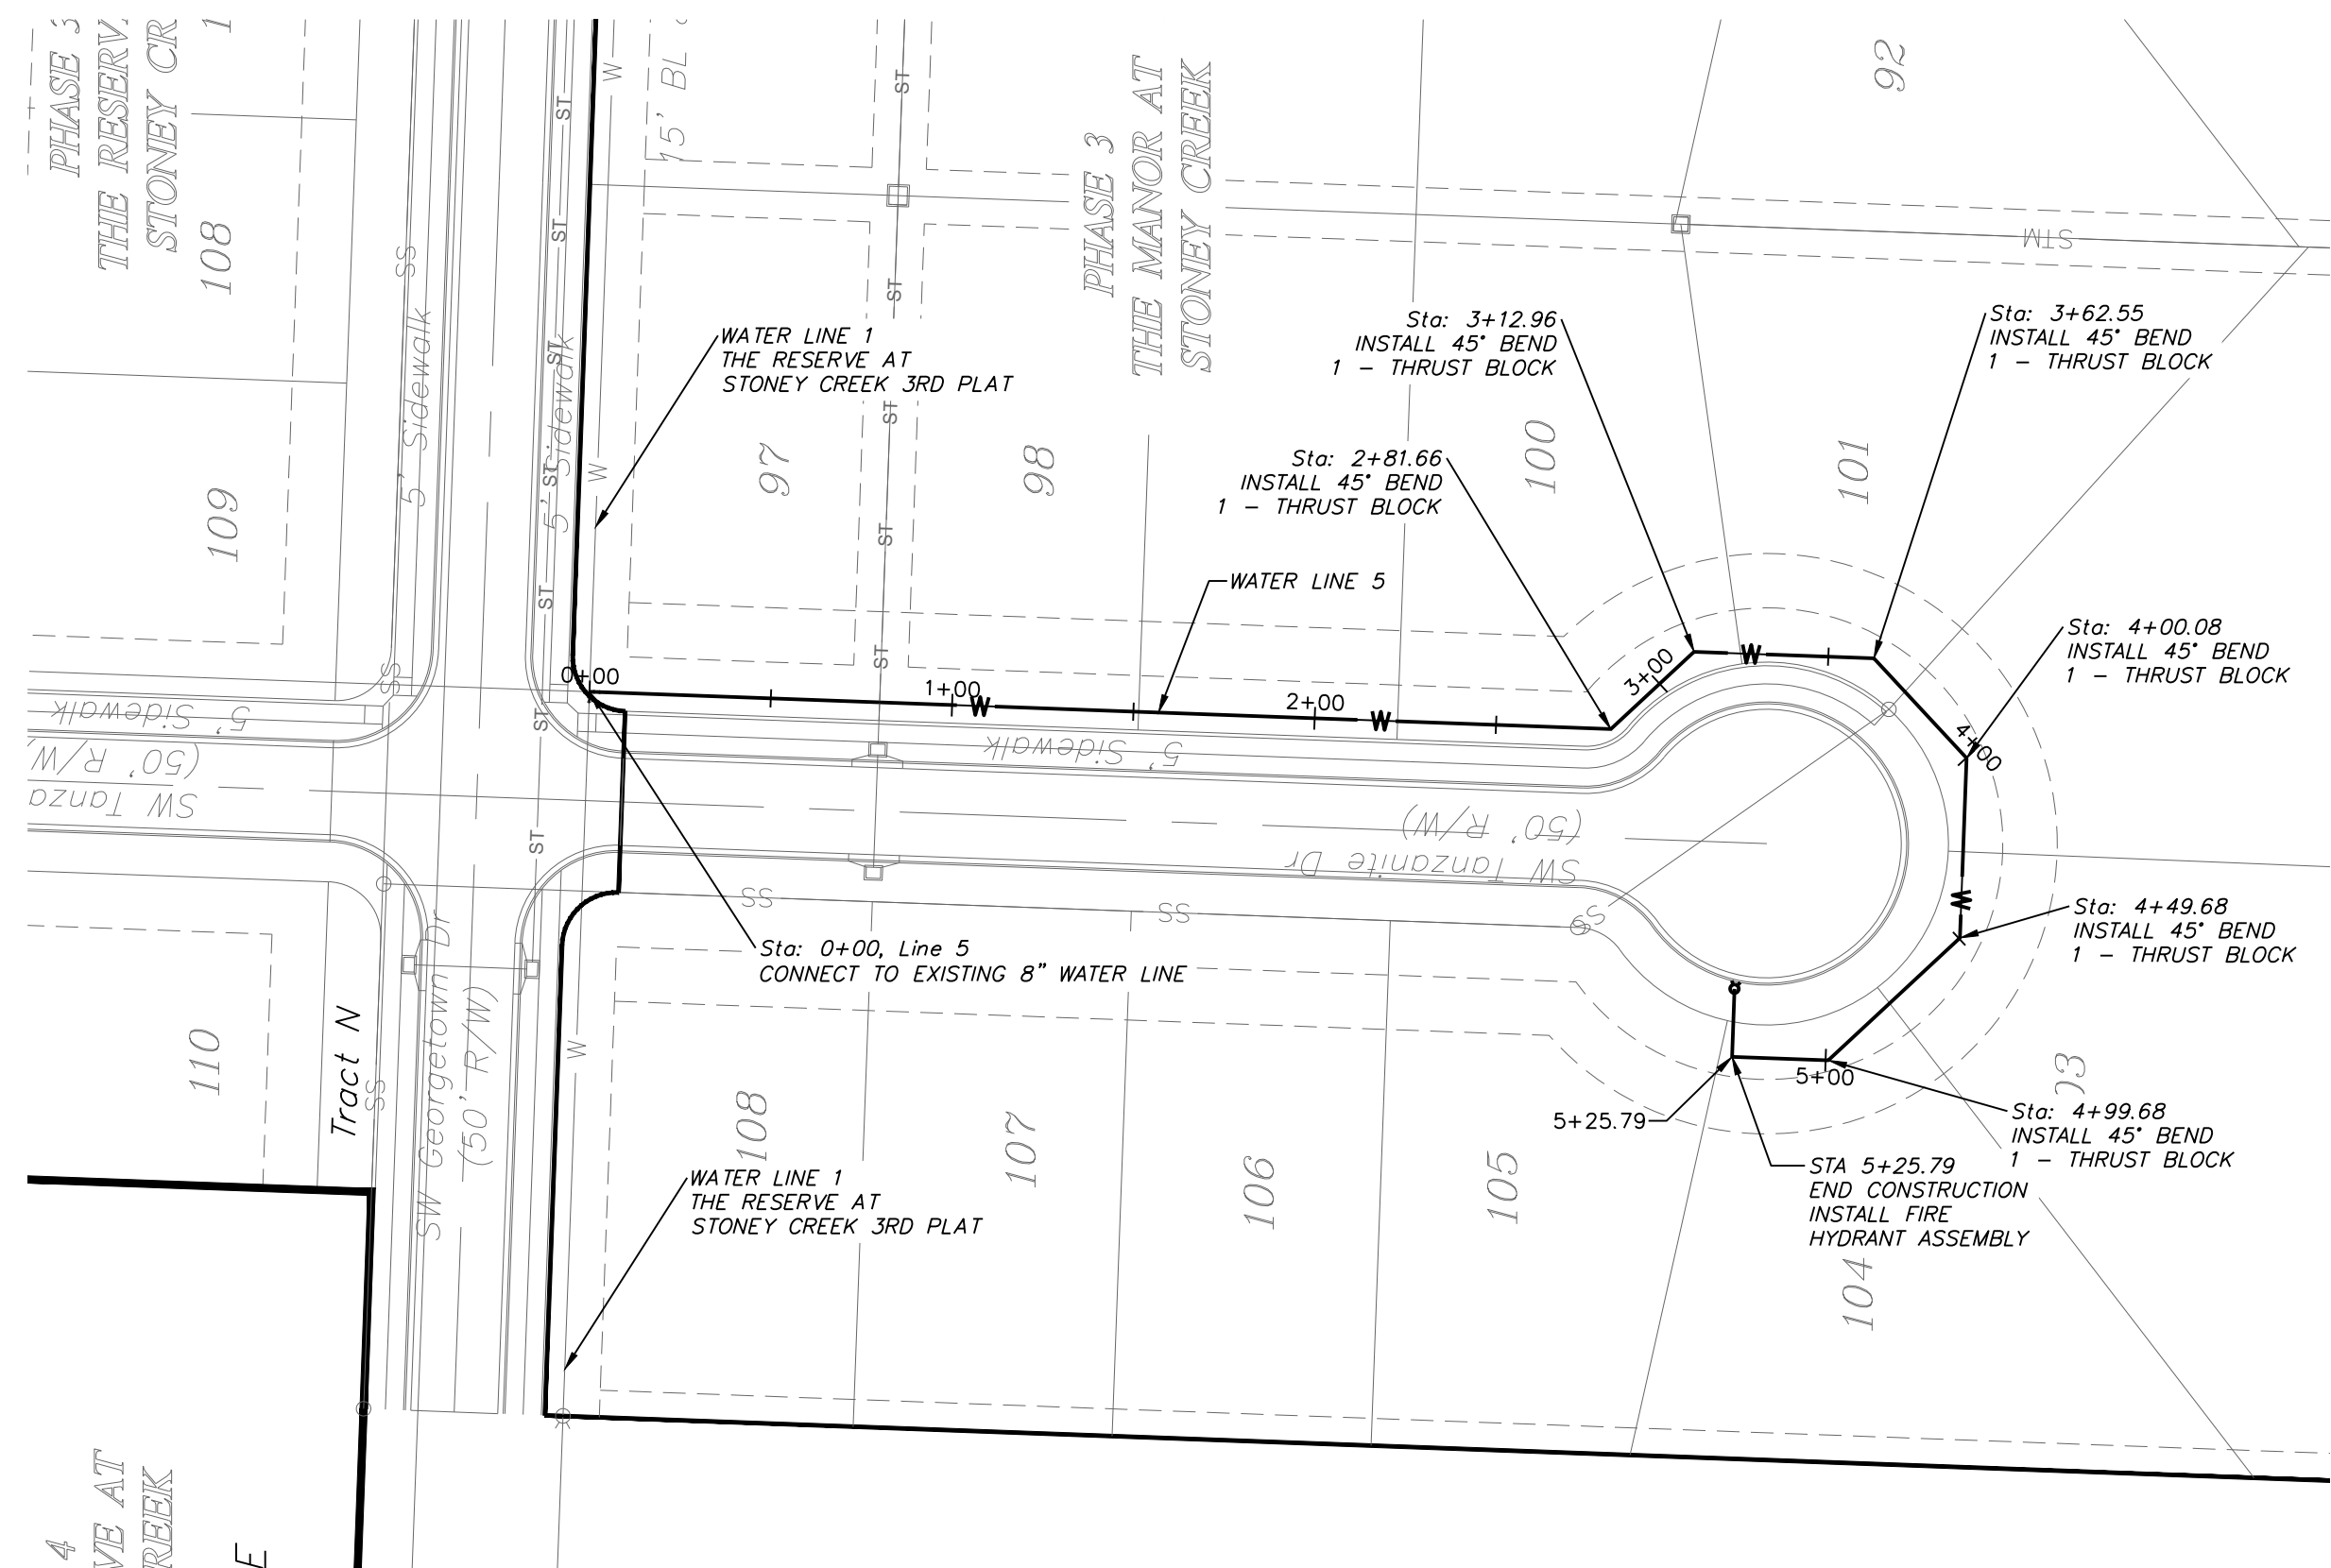


WATER LINE 5 PHASE 3

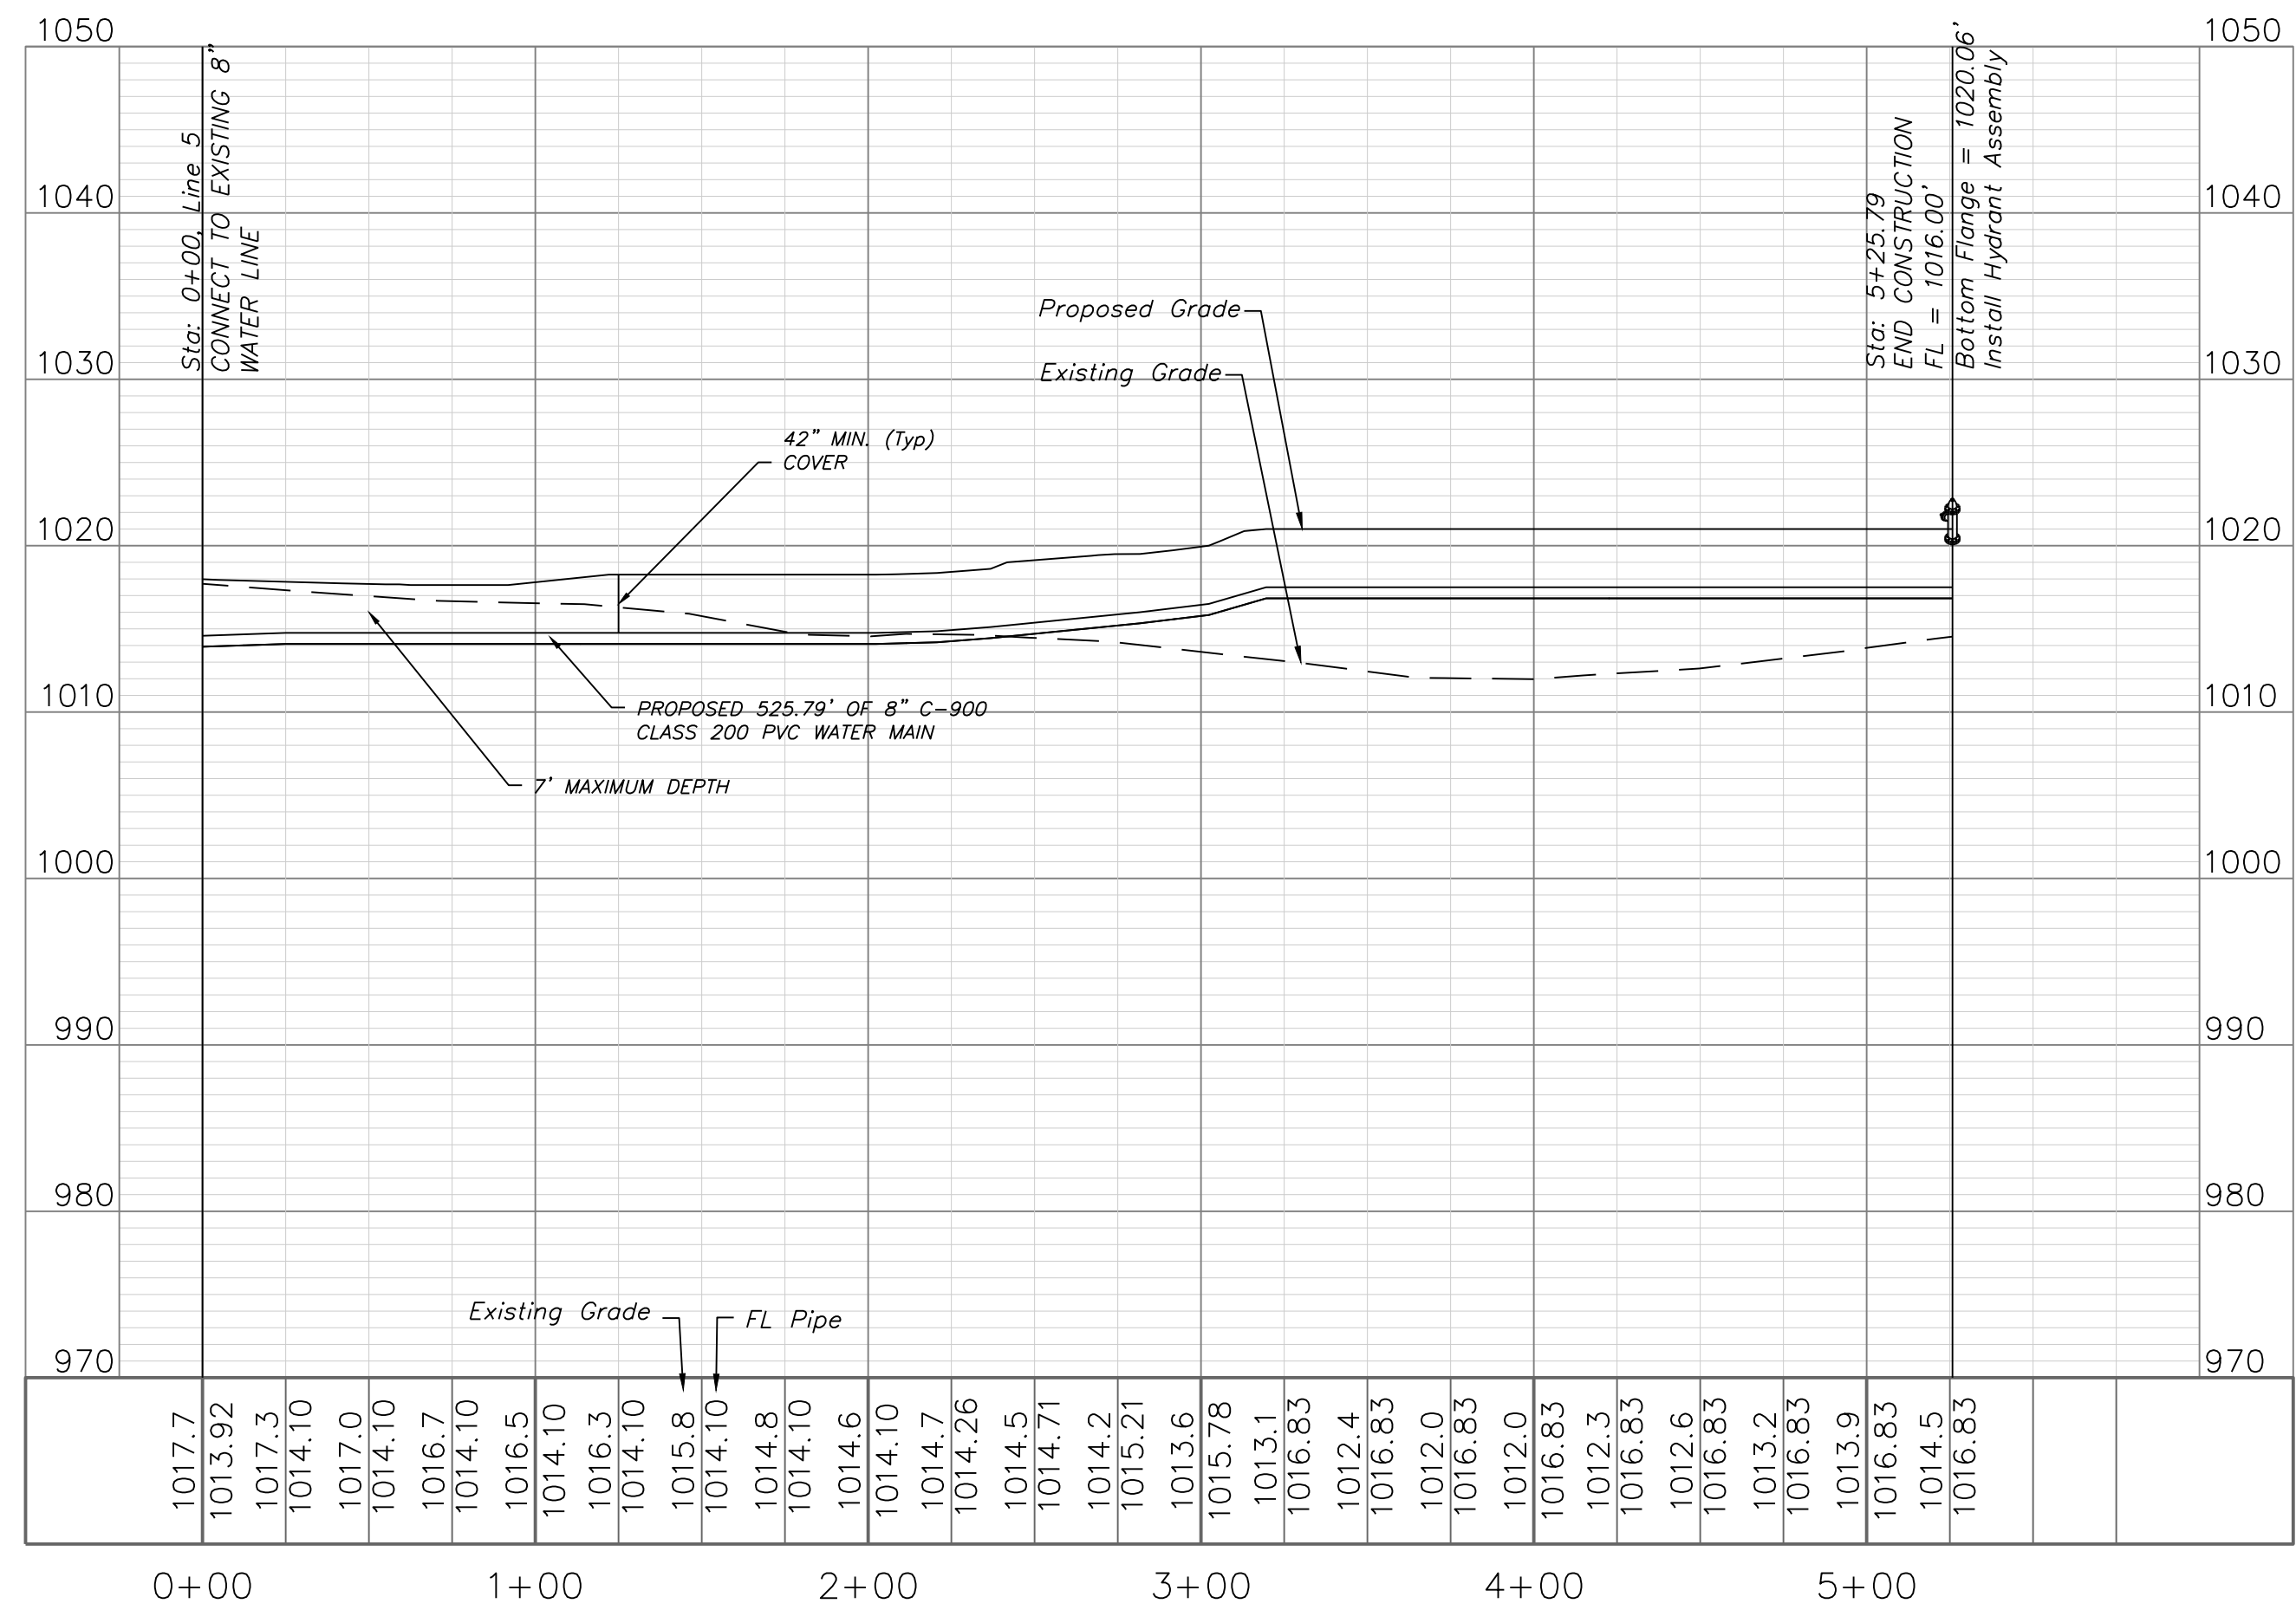

"AS-BUILT"

900.10
~~900.00~~ Indicates data replaced with "As-Built" information. All other data is as designed and has not been field verified.

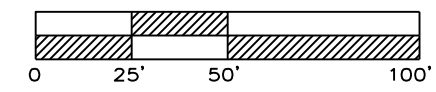

WATER PLAN & PROFILE
SCALE: 1" = 50'




Professional Registration
Missouri
Engineering 200502188-D
Surveying 200500519-D
Kansas
Engineering E-1695
Surveying LS-218
Oklahoma
Engineering 6254
Nebraska
Engineering CA2821

The Manor at Stoney Creek - 3rd Plat
Lee's Summit, Jackson County, Missouri







Project: AT
STONEY CREEK
3RD
Issue Date:
July 18, 2017

Water Main Plan and Profile, Line 2
Construction Plans for:
The Manor at Stoney Creek - 3rd Plat
Lee's Summit, Jackson County, Missouri

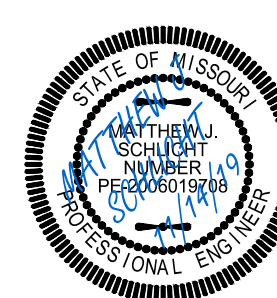

Matthew J. Schlicht
MO PE 2006019708
KS PE 19071
OK PE 25226


REVISIONS
9/24/19 - As-Built
11/7/19 - As-Built
11/14/19 - As-Built

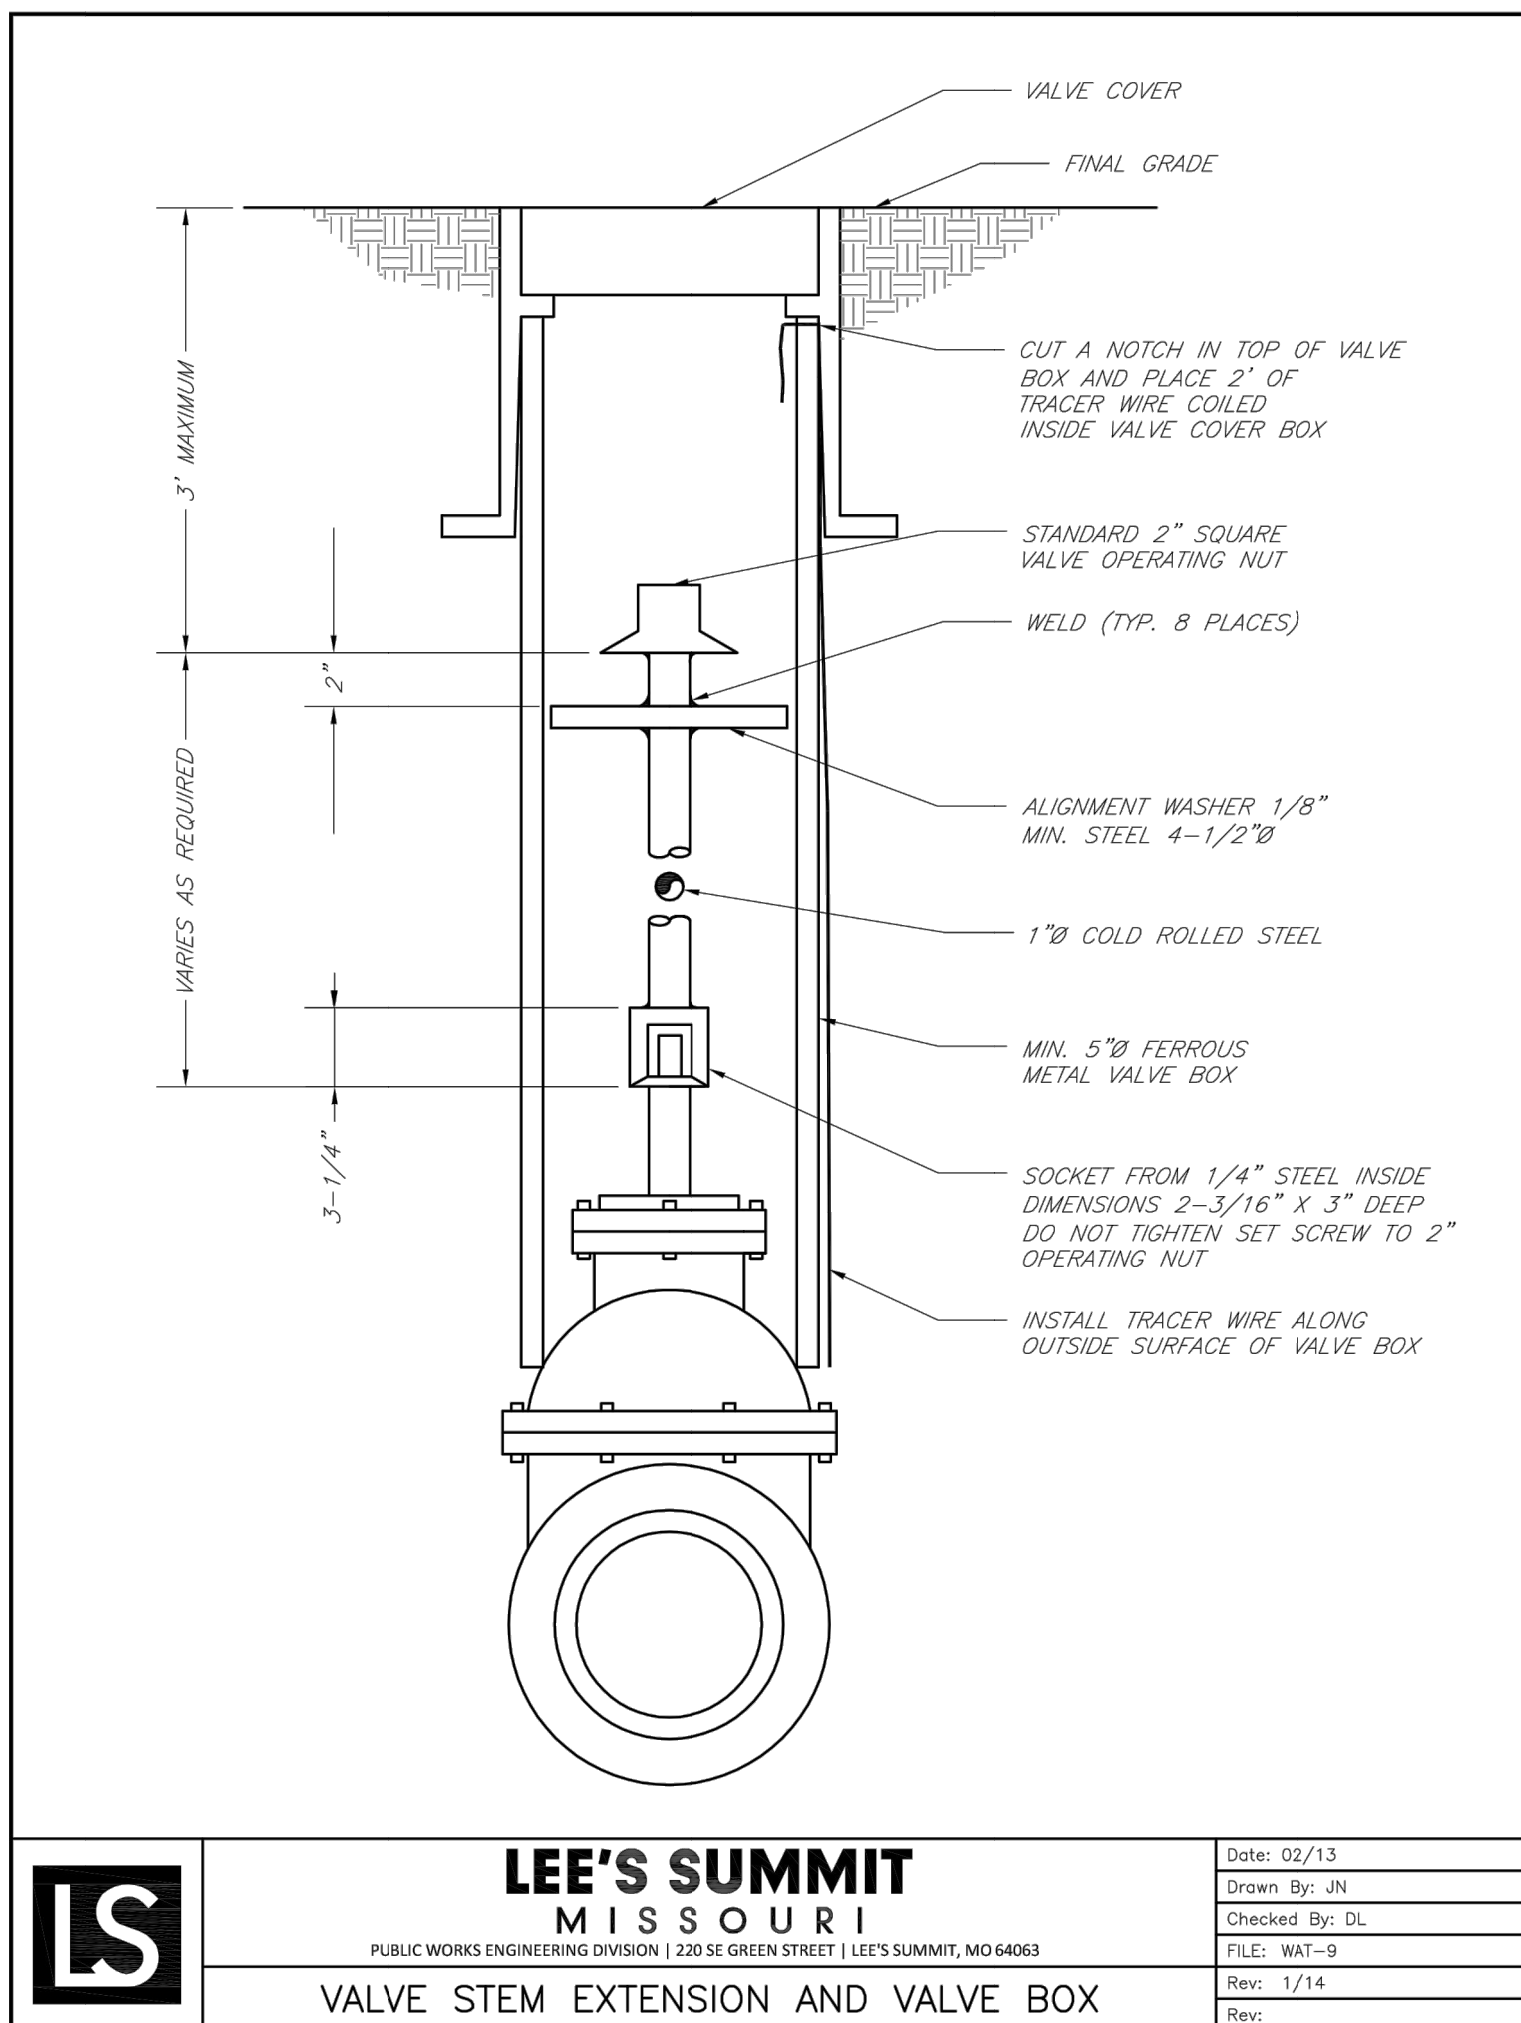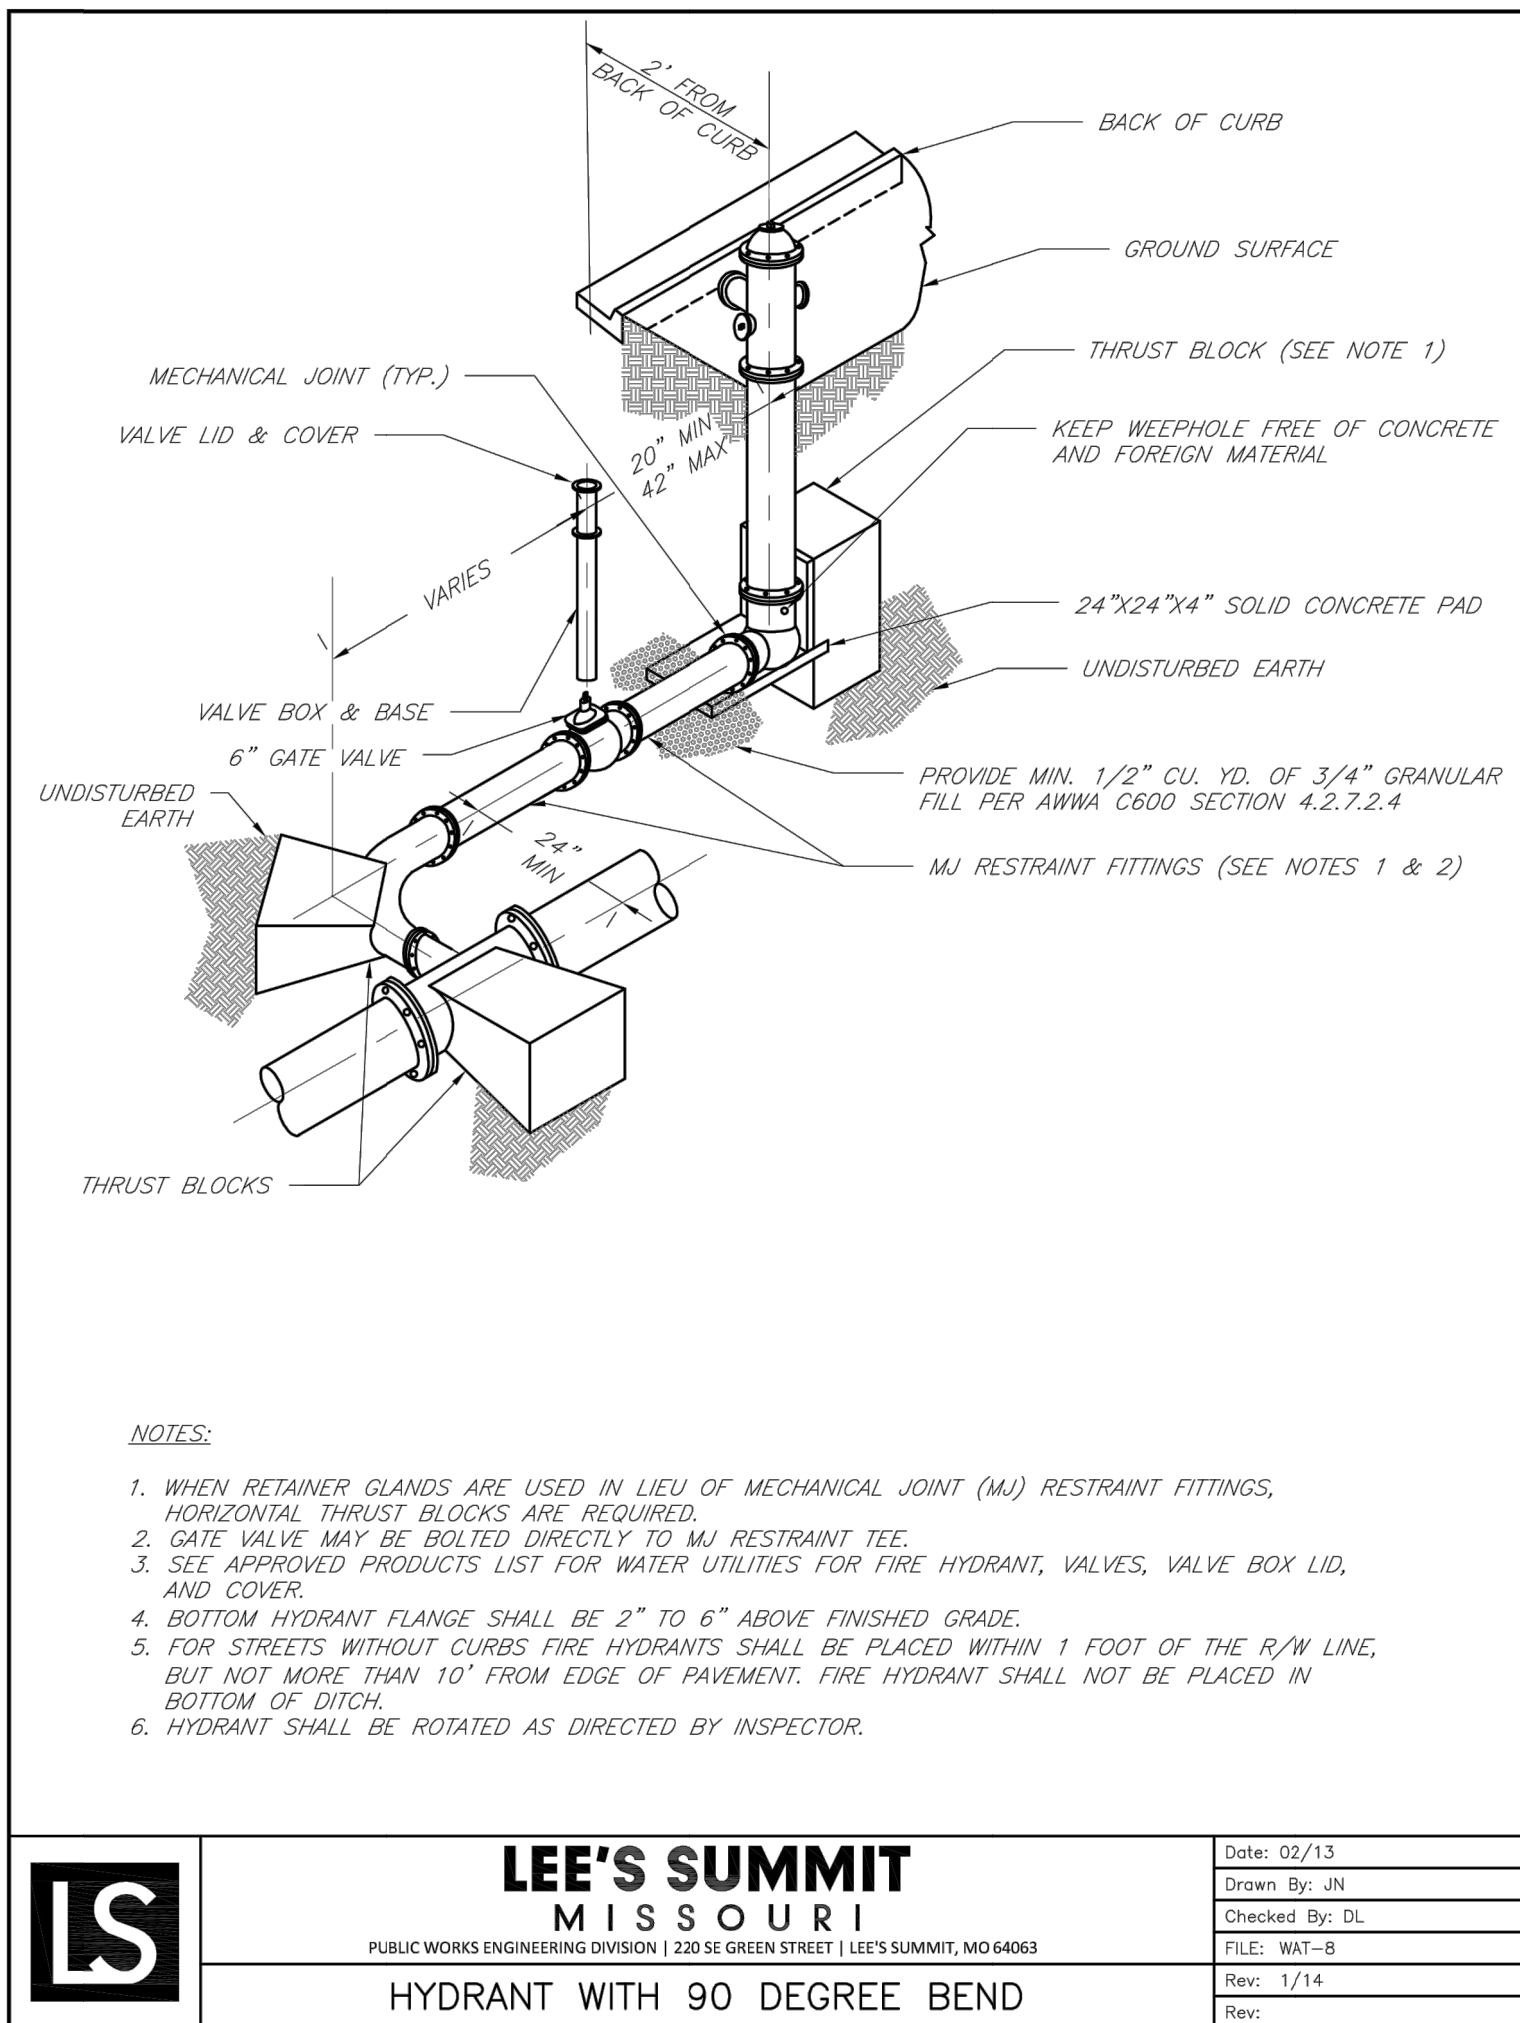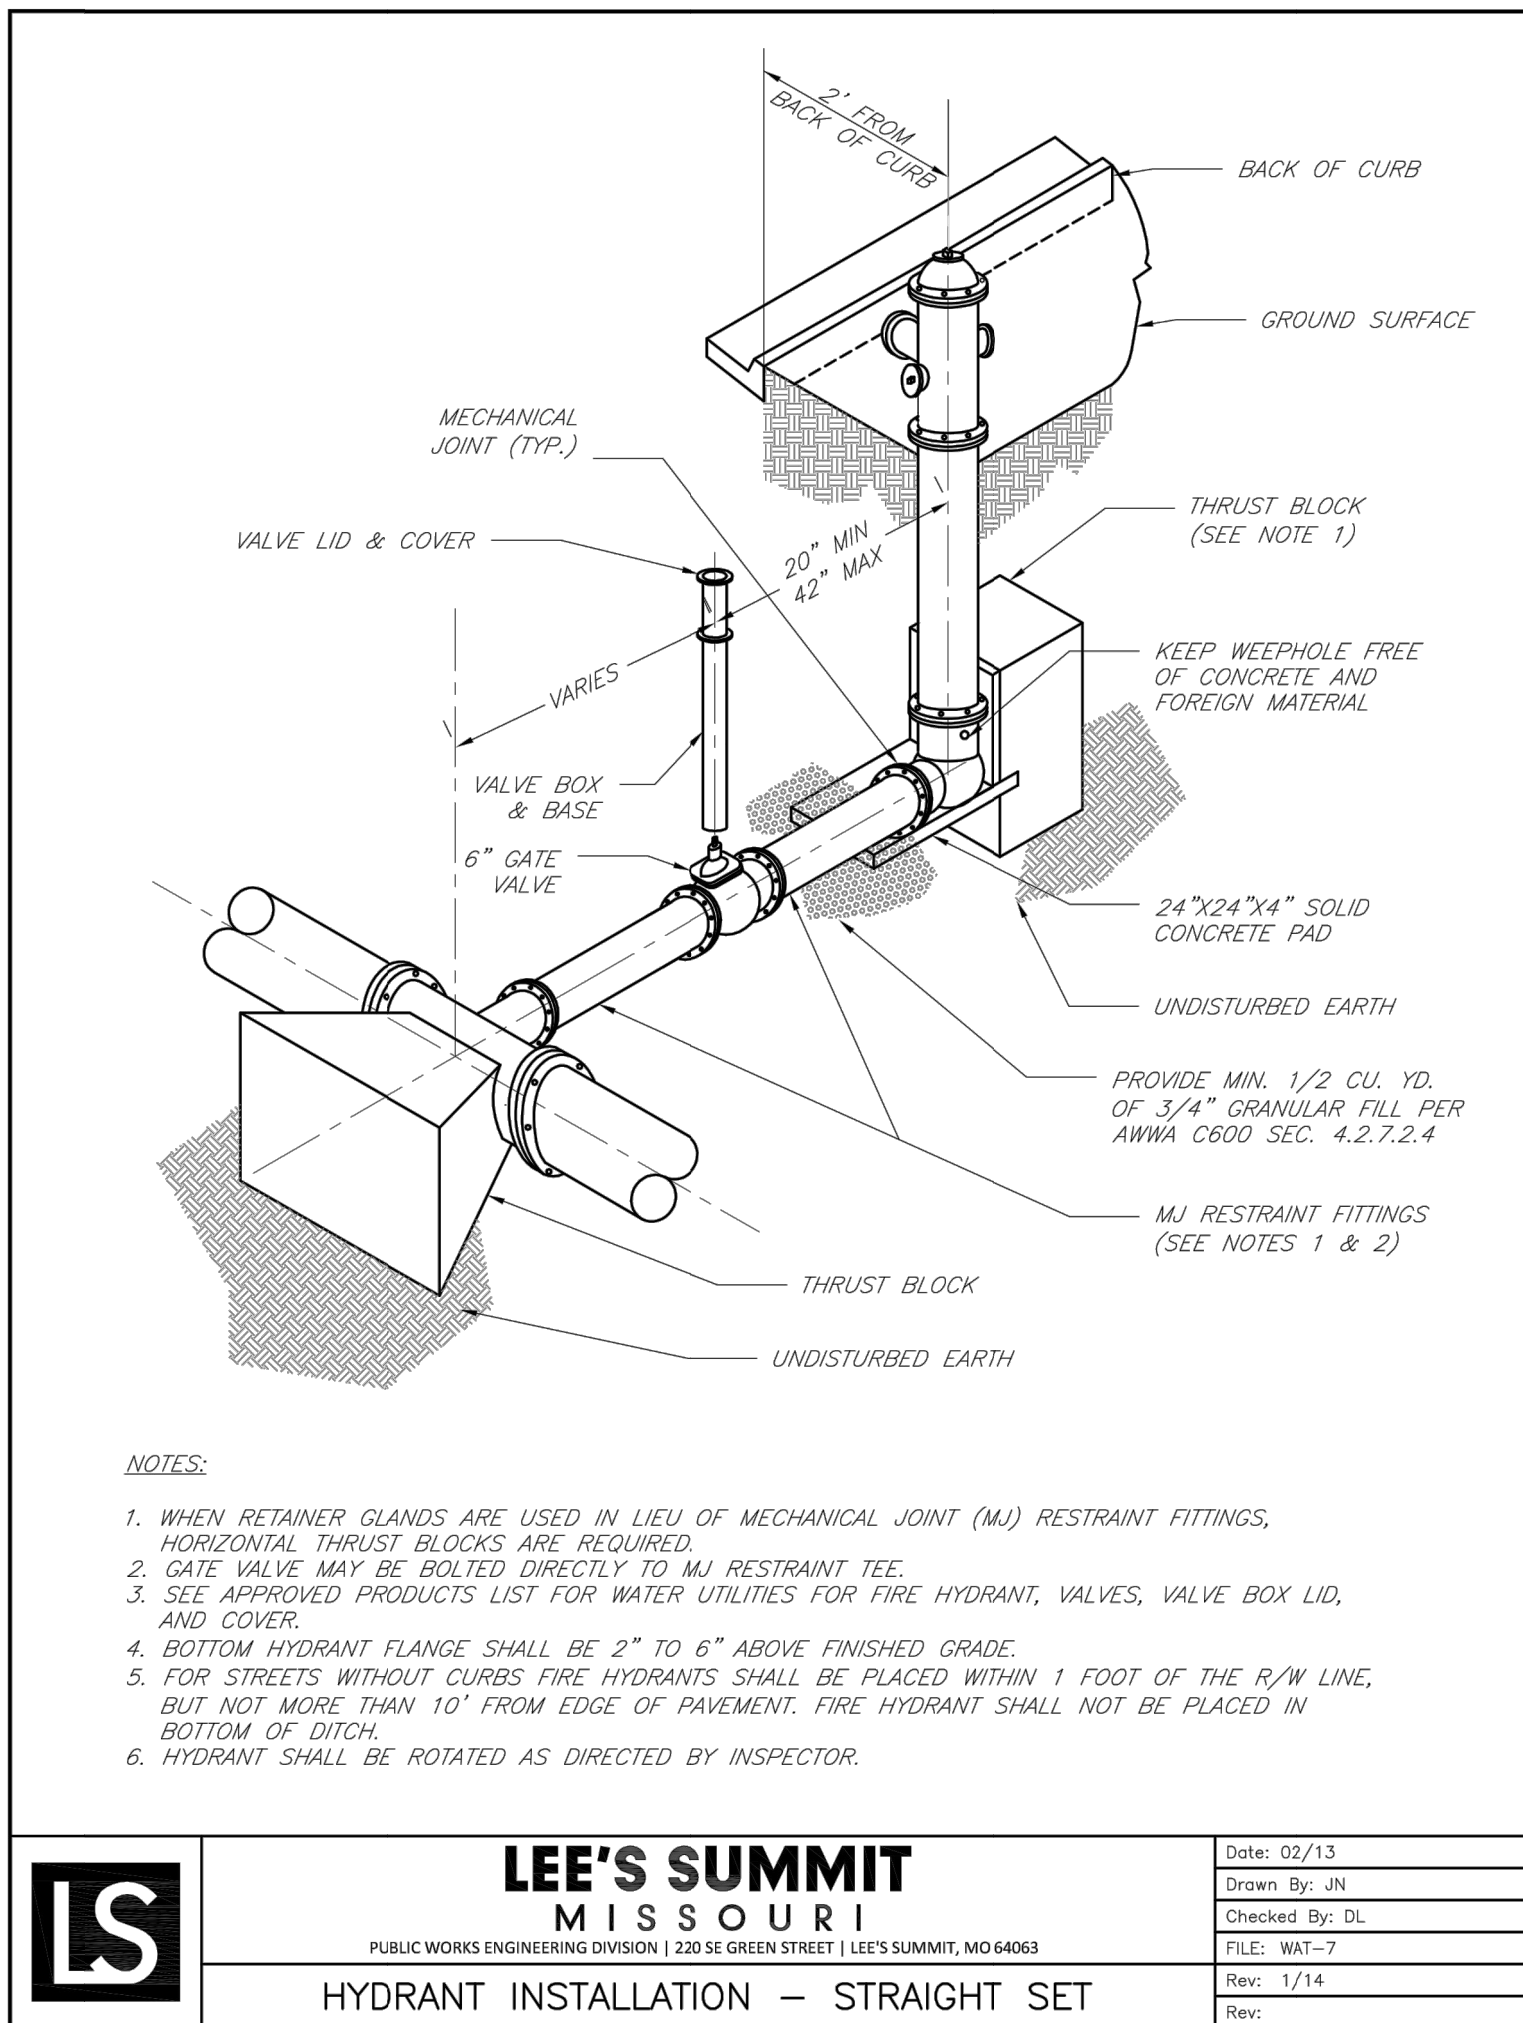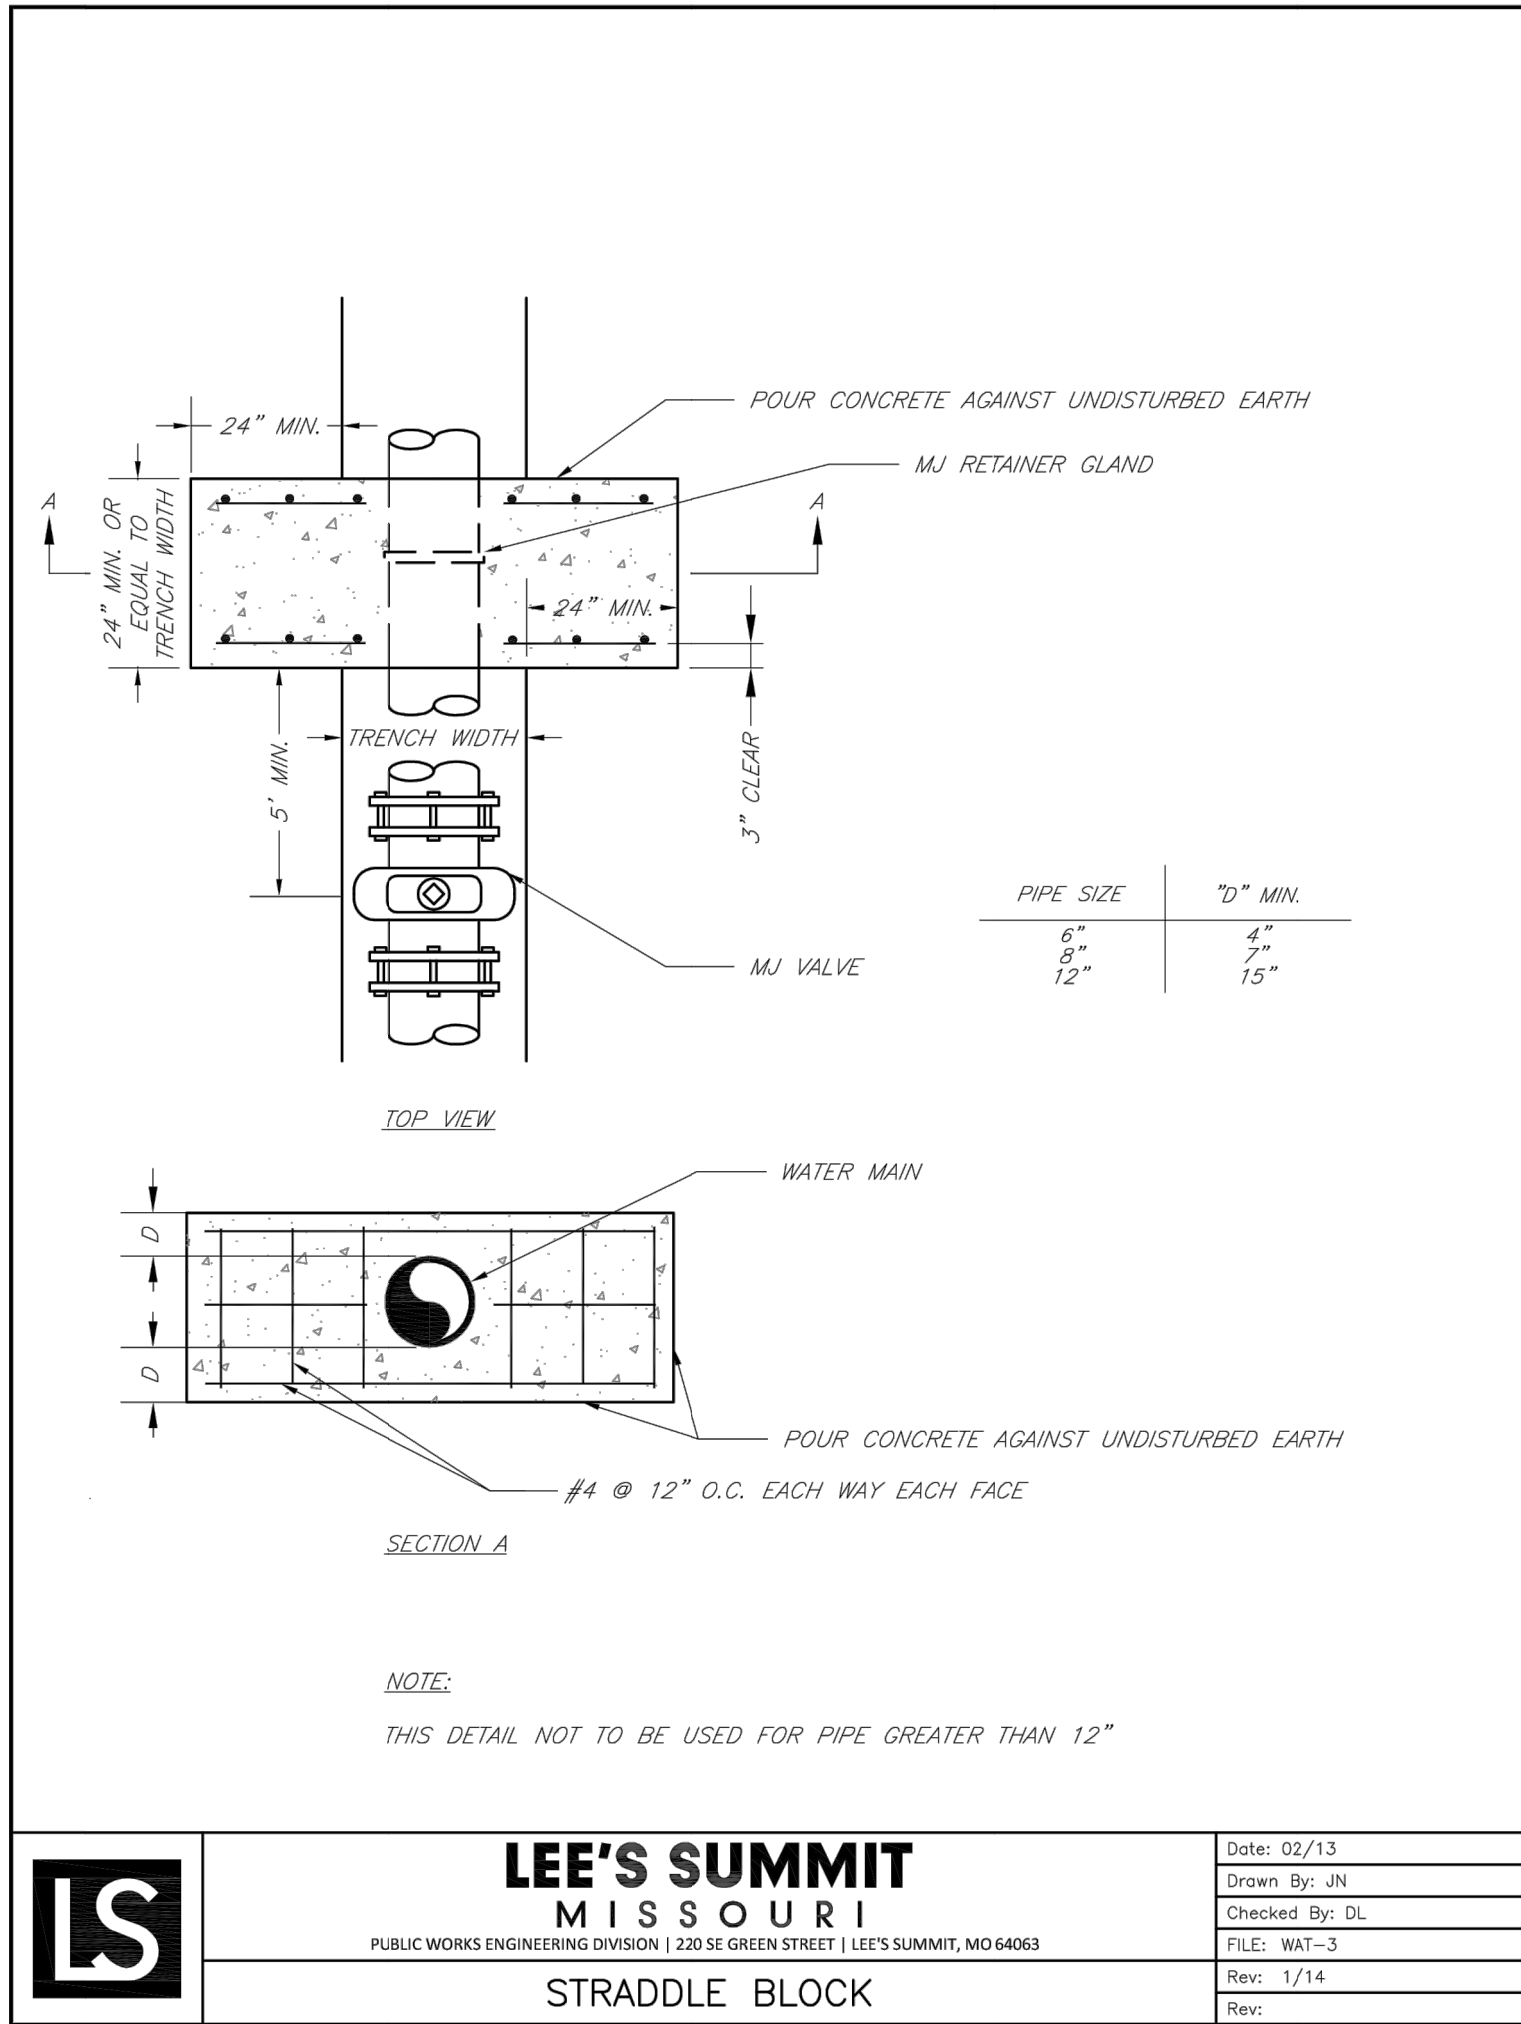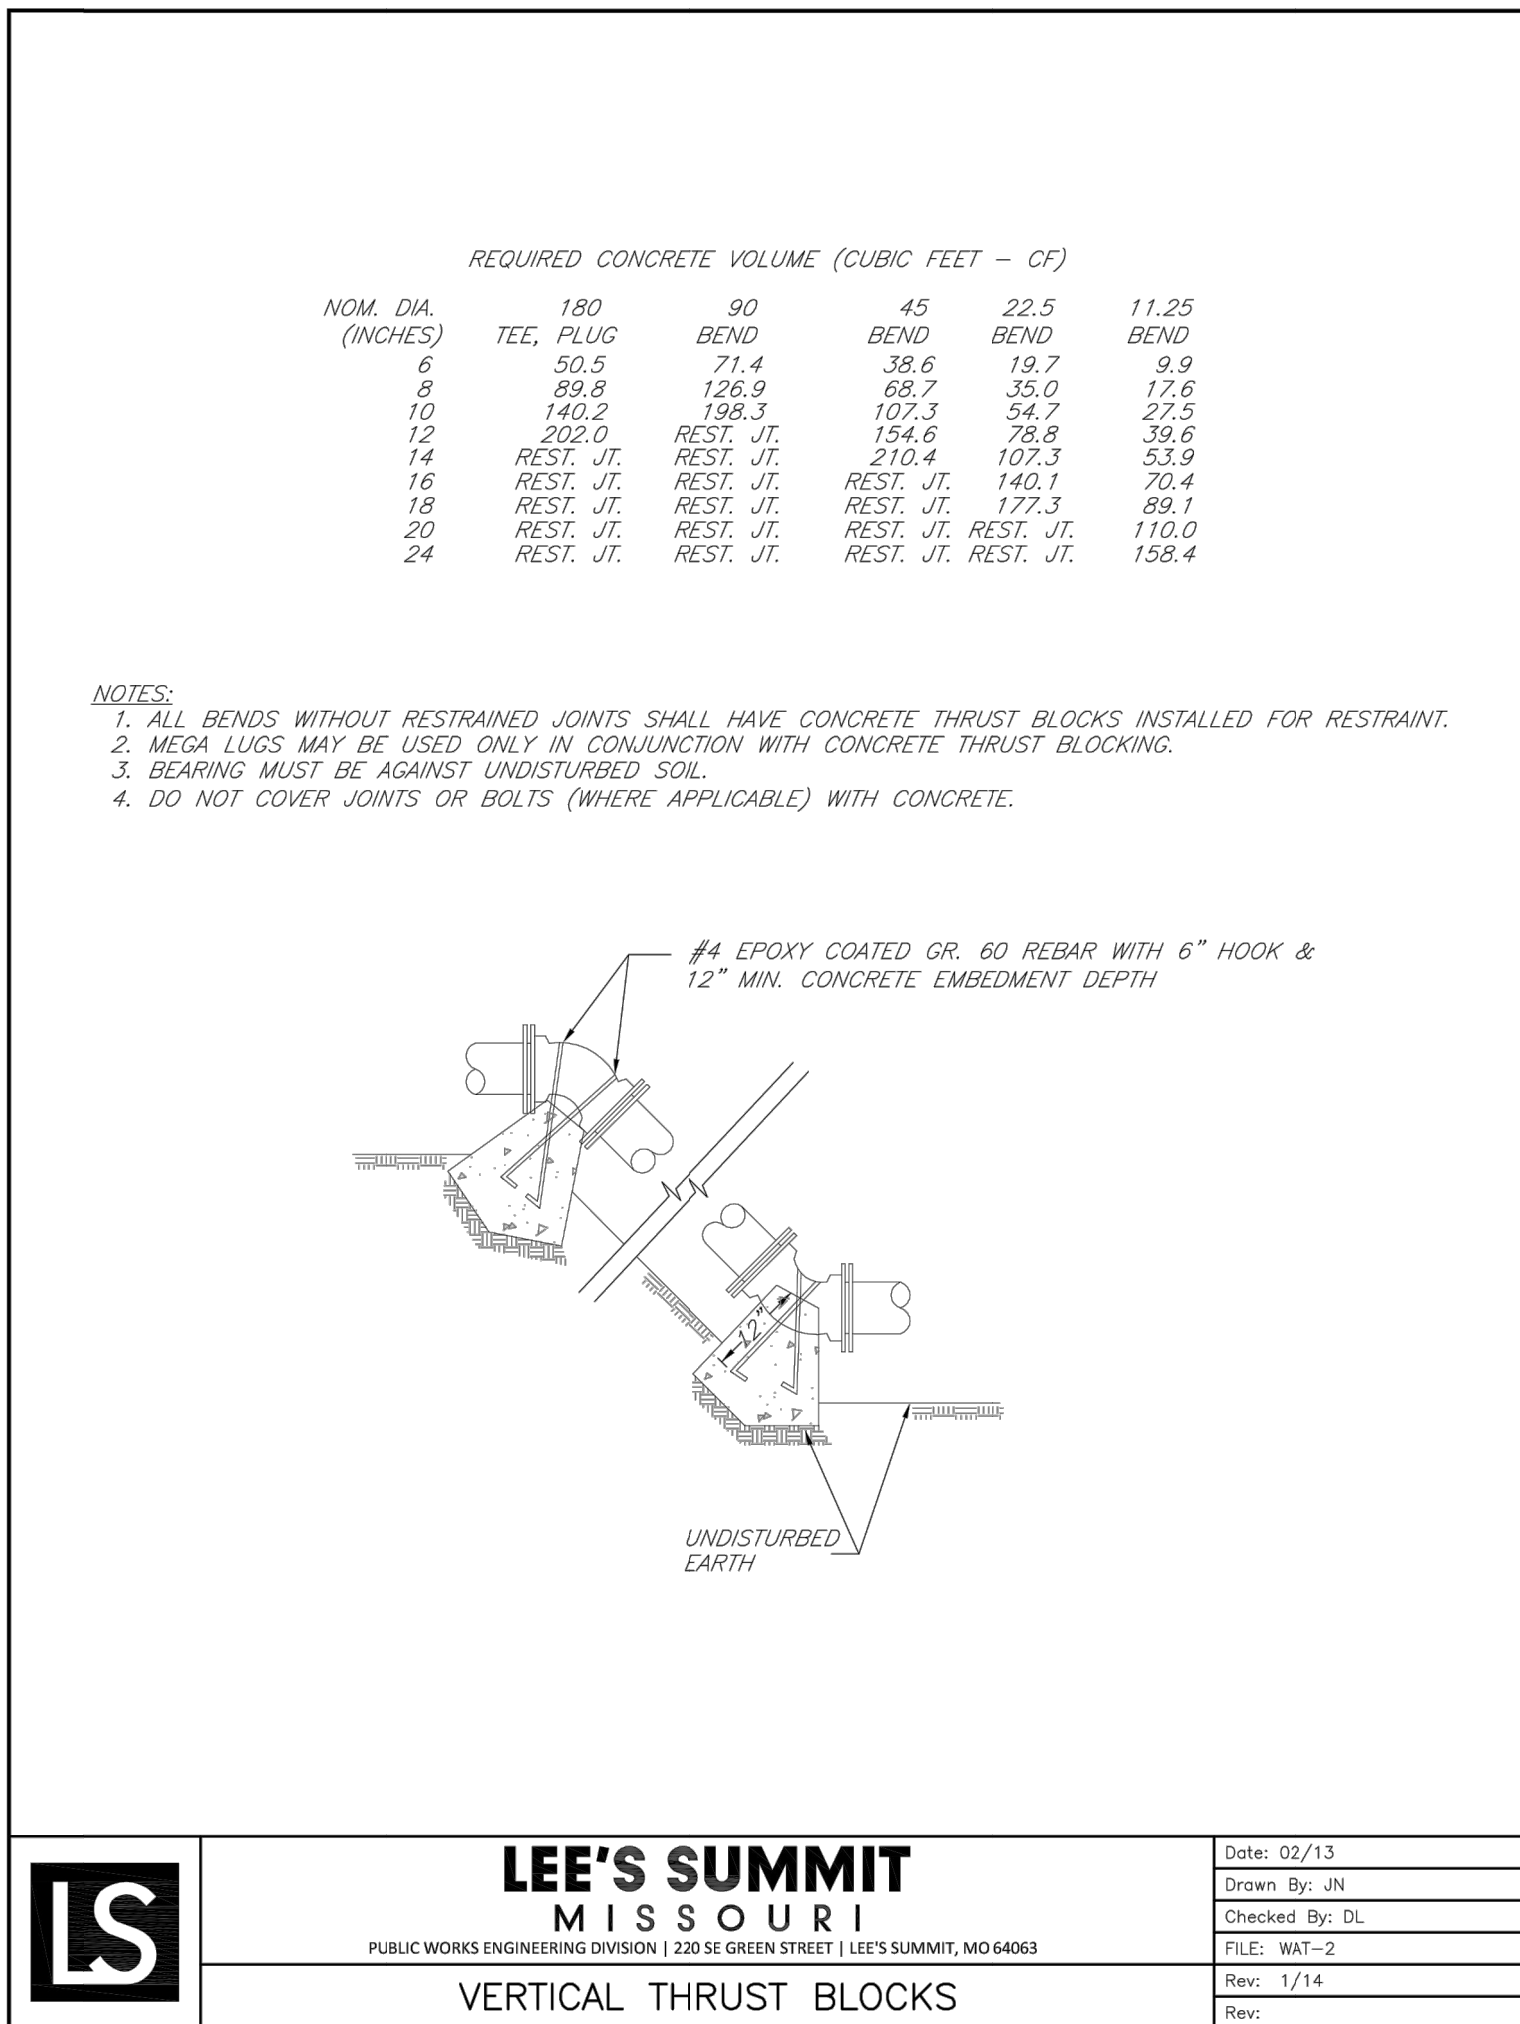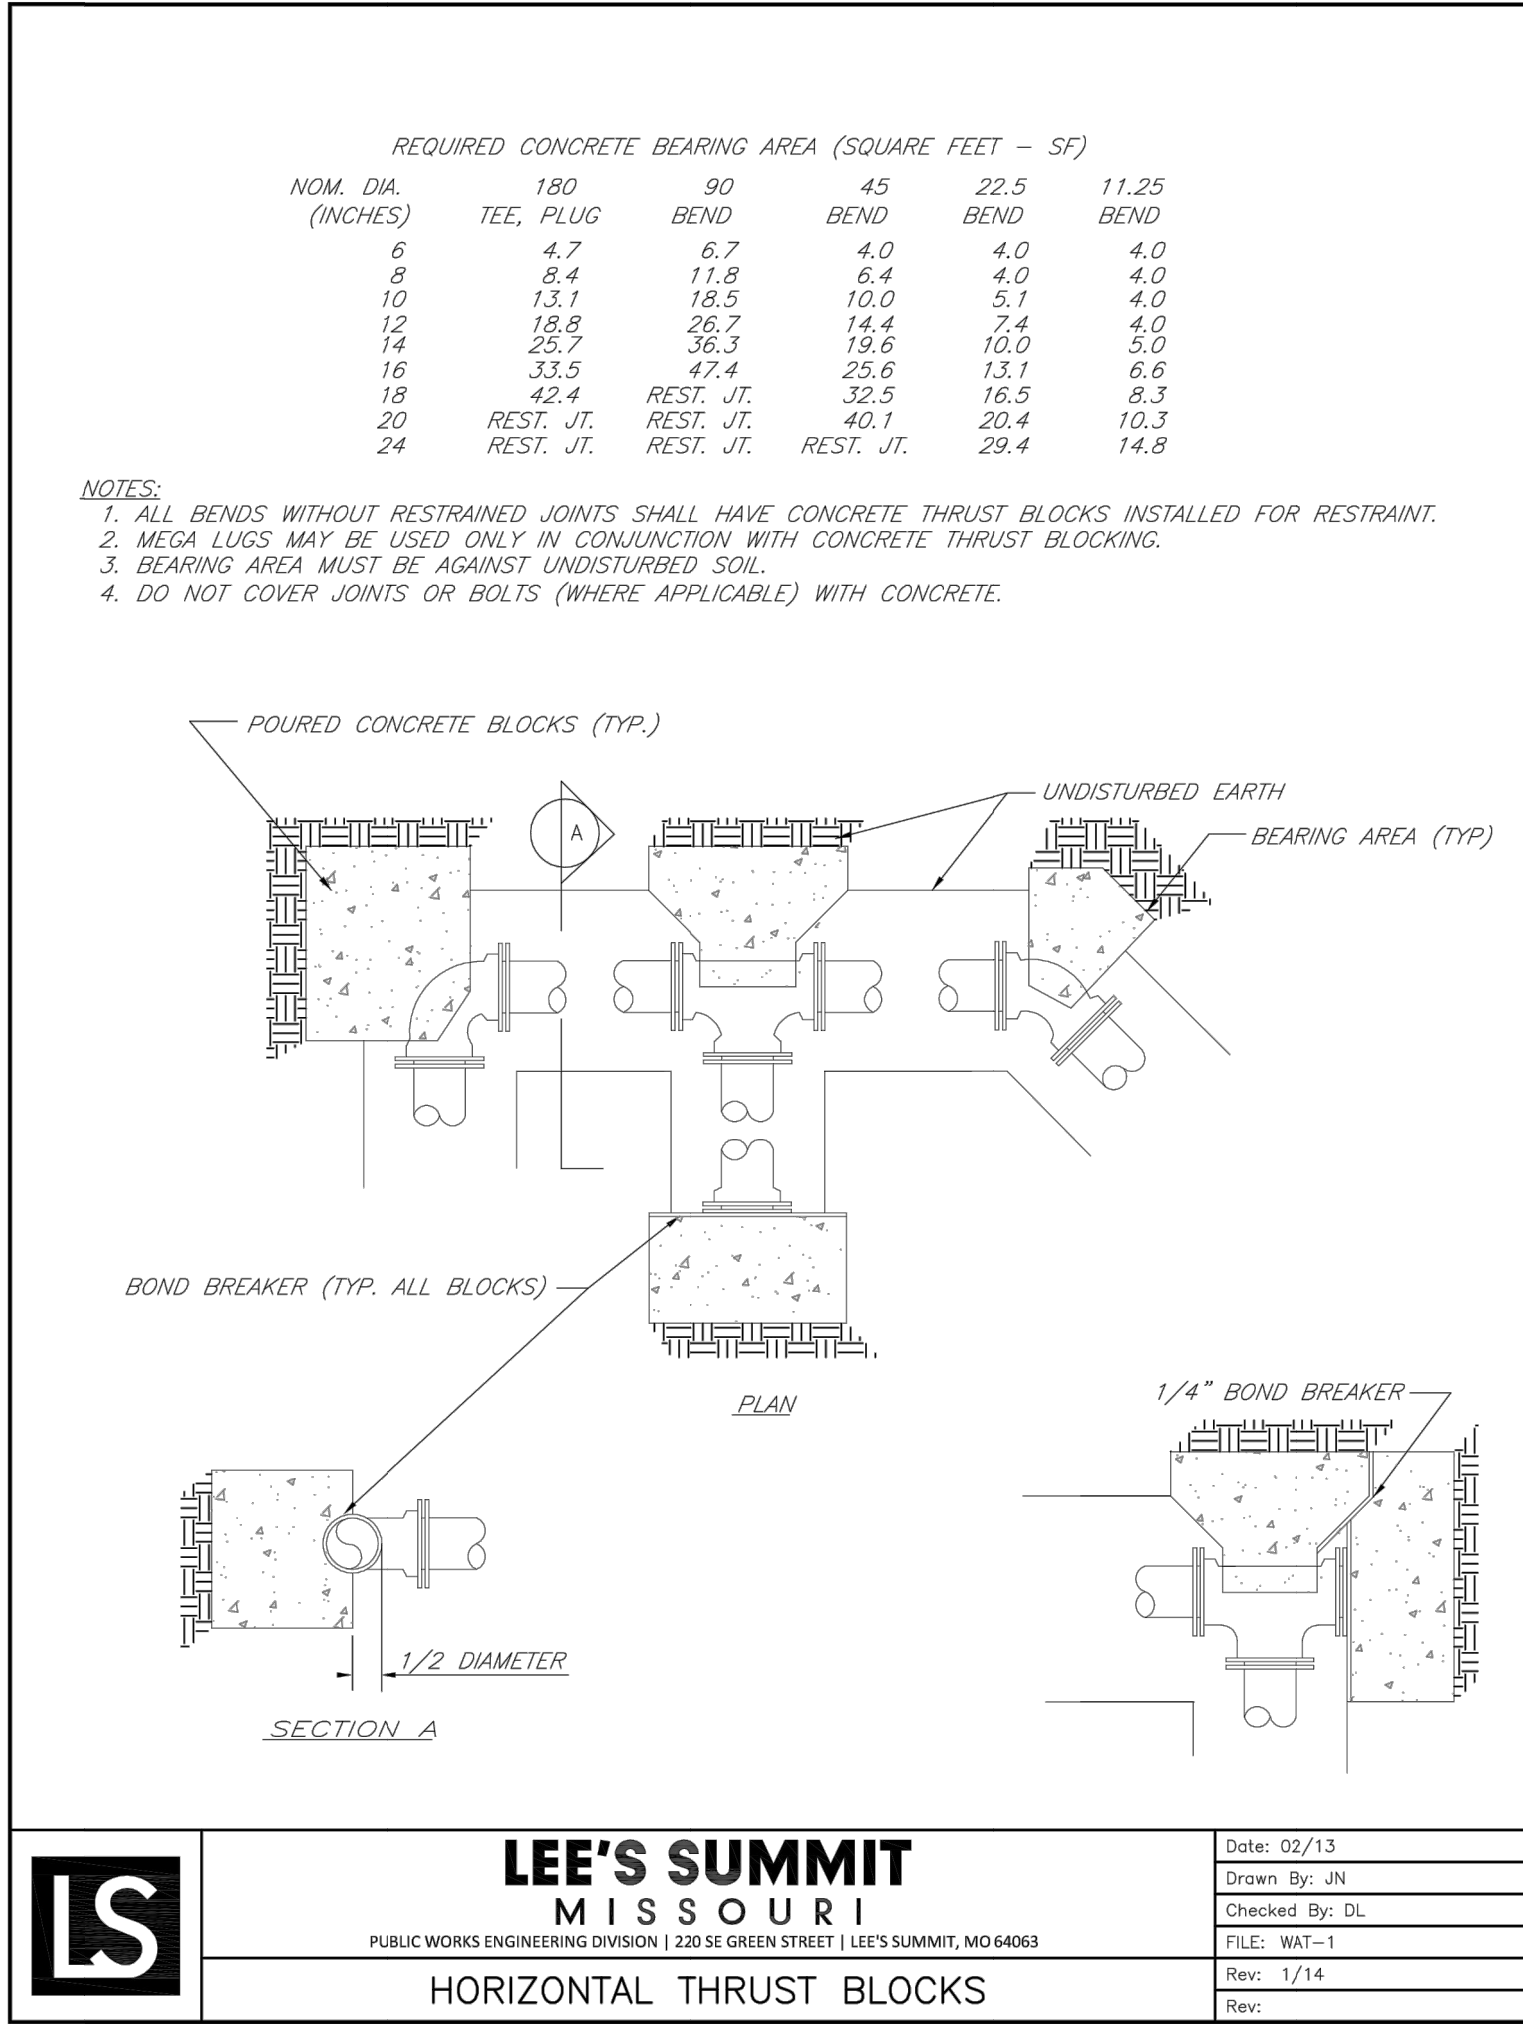

"AS-BUILT"
900.10
~~900.00~~ Indicates data replaced with "As-Built" information. All other data is as designed and has not been field verified.

The Manor at Stoney Creek - 3rd Plat
Lee's Summit, Jackson County, Missouri

Water Main Detail
Construction Plans for:
The Manor at Stoney Creek - 3rd Plat
Lee's Summit, Jackson County, Missouri

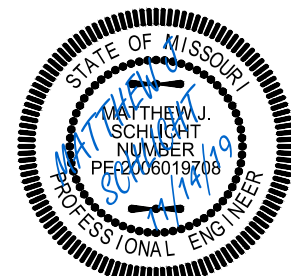

REVISIONS

9/24/19	- As-Built
11/7/19	- As-Built
11/14/19	- As-Built