


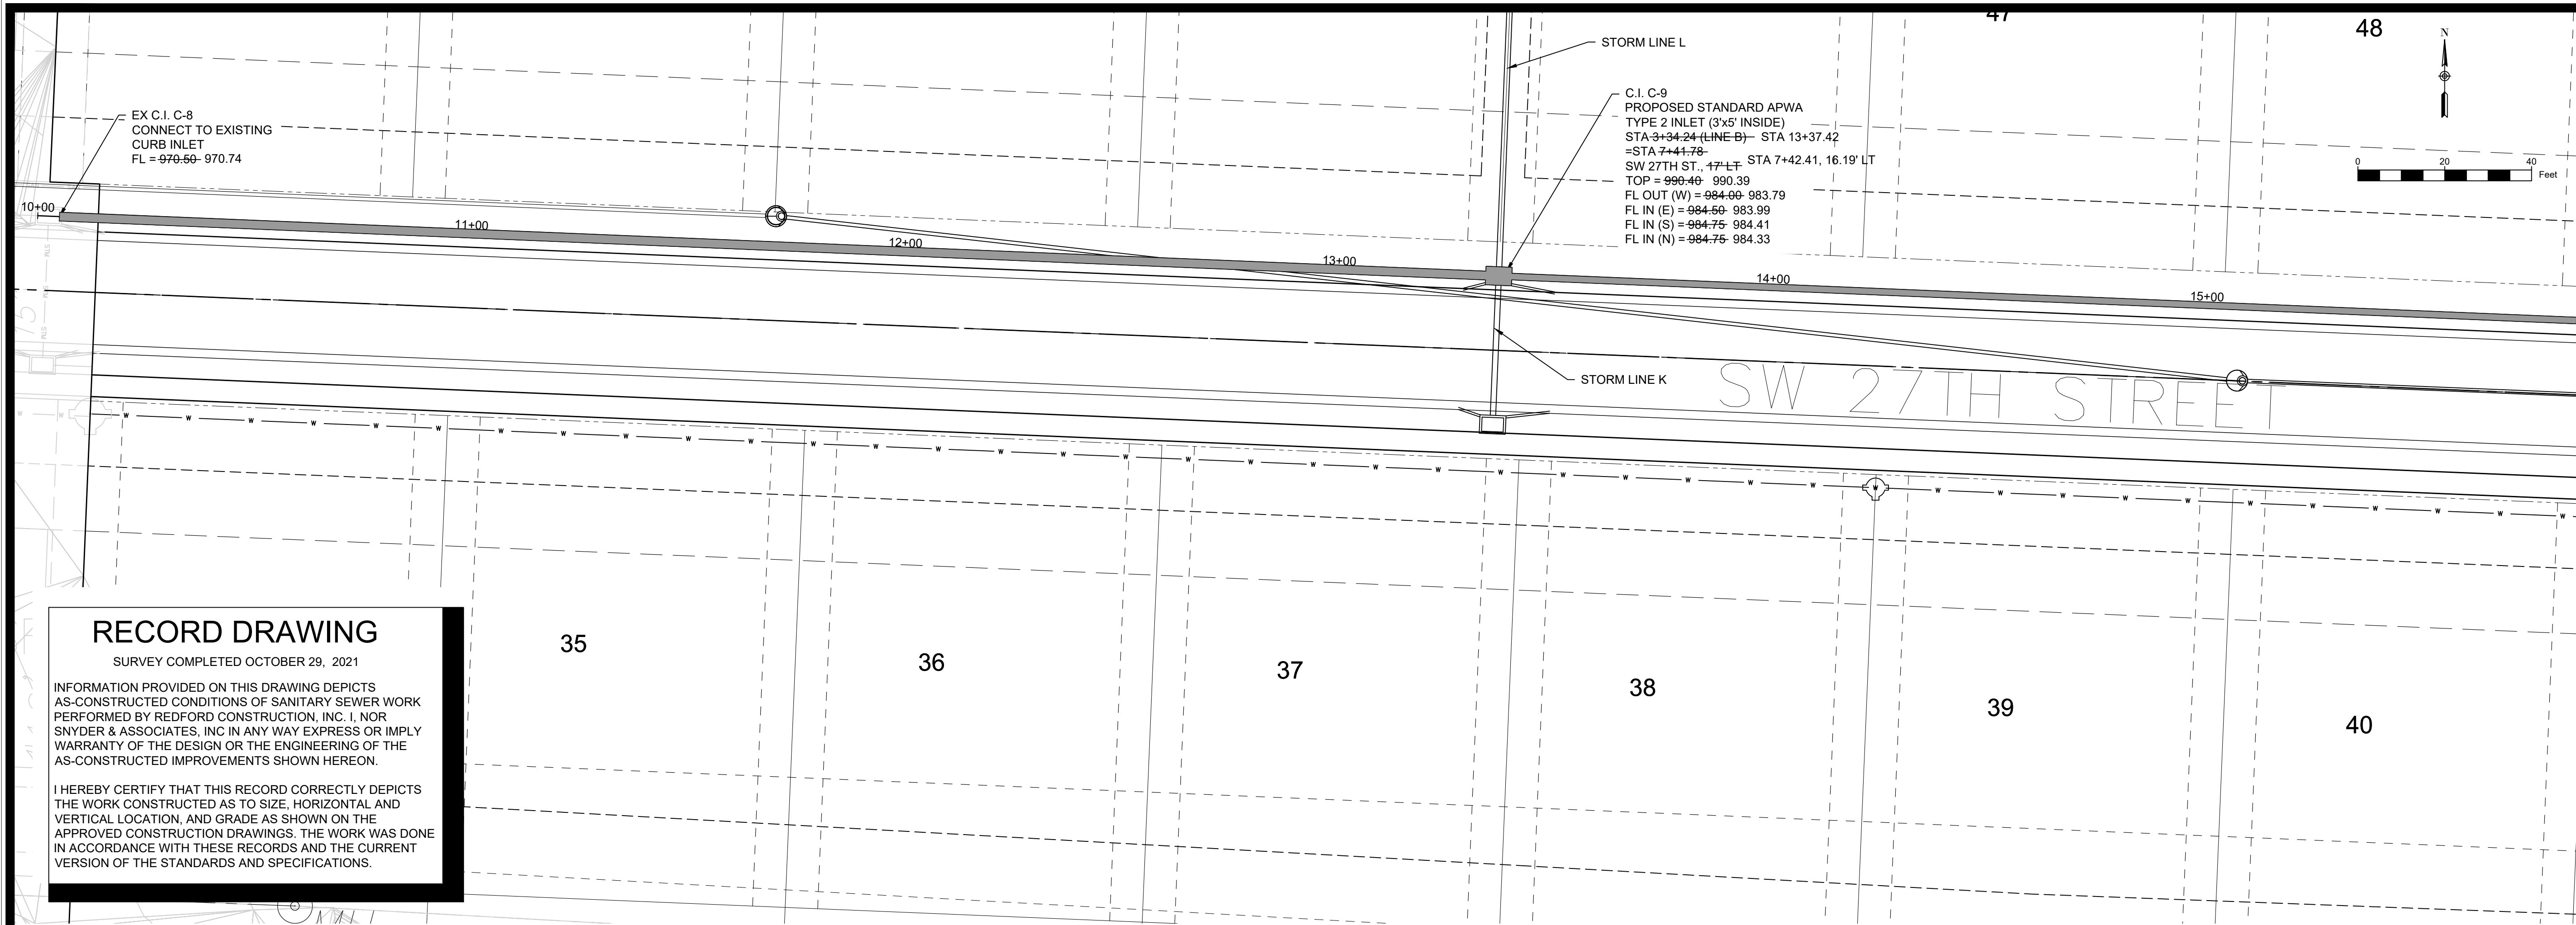


C.I. C-9
PROPOSED STANDARD APWA
TYPE 2 INLET (3'x5' INSIDE)
STA 3+34.24 (LINE B) - STA 13+37.42
=STA 7+41.78-
SW 27TH ST., 17' LT STA 7+42.41, 16.19' LT
TOP = 990.40 990.39
FL OUT (W) = 984.00 983.79
FL IN (E) = 984.50 983.99
FL IN (S) = 984.75 984.41
FL IN (N) = 984.75 984.33

RECORD DRAWING

SURVEY COMPLETED OCTOBER 29, 2021

INFORMATION PROVIDED ON THIS DRAWING DEPICTS AS-CONSTRUCTED CONDITIONS OF SANITARY SEWER WORK PERFORMED BY REDFORD CONSTRUCTION, INC. I, NOR SNYDER & ASSOCIATES, INC IN ANY WAY EXPRESS OR IMPLY WARRANTY OF THE DESIGN OR THE ENGINEERING OF THE AS-CONSTRUCTED IMPROVEMENTS SHOWN HEREON.

I HEREBY CERTIFY THAT THIS RECORD CORRECTLY DEPICTS THE WORK CONSTRUCTED AS TO SIZE, HORIZONTAL AND VERTICAL LOCATION, AND GRADE AS SHOWN ON THE APPROVED CONSTRUCTION DRAWINGS. THE WORK WAS DONE IN ACCORDANCE WITH THESE RECORDS AND THE CURRENT VERSION OF THE STANDARDS AND SPECIFICATIONS.

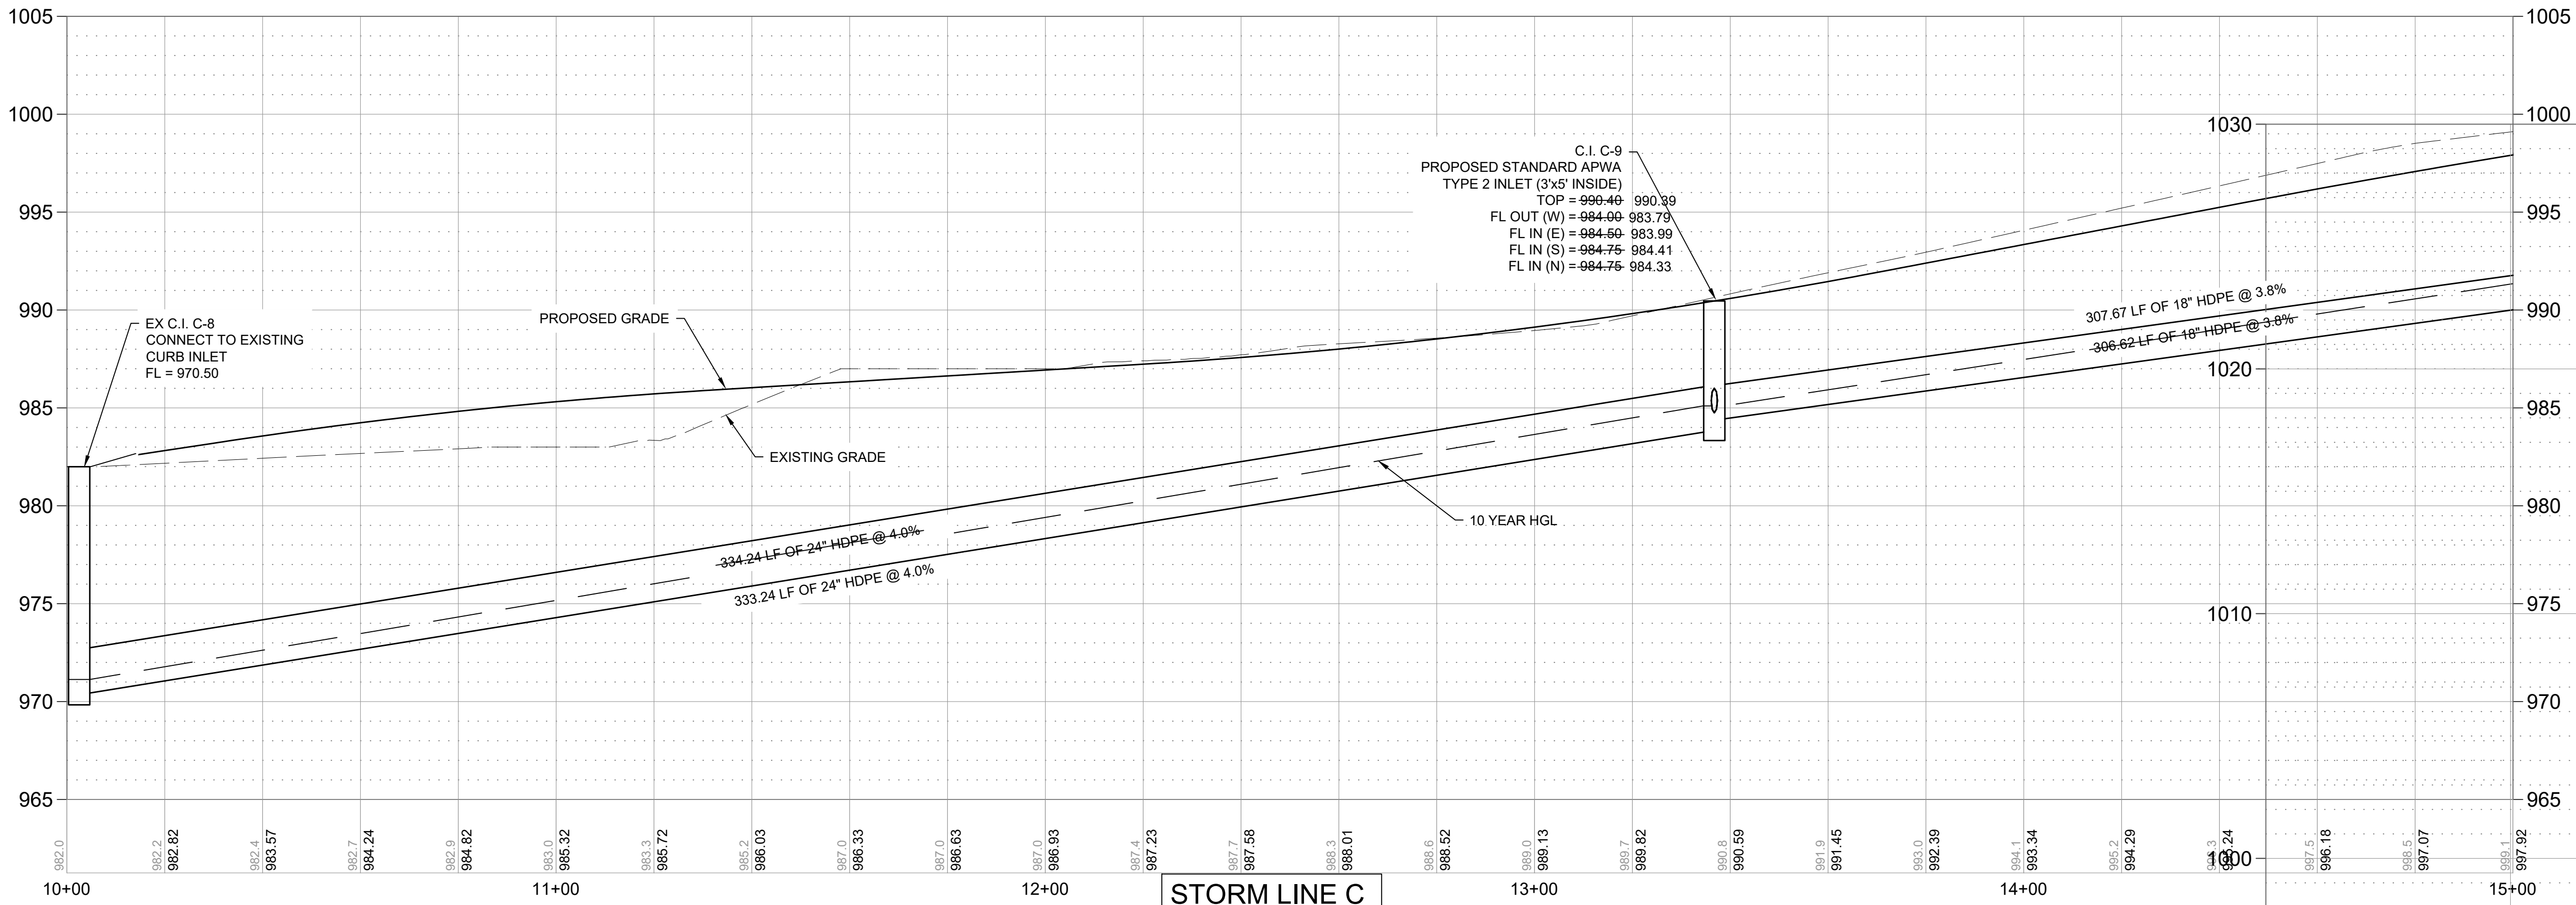

STORM LINE C

MARK	REVISION	DATE	BY
Engineer: SD	Checked By: SD	Scale: 1"= 20'	
Technician: JS	Date: 7-28-20	Field Bk: Pg:	
Snyder & Associates Engineers & Planners, Inc.			Sheet 9
Missouri State Certificate of Authority #200008544			

SHAWN DUKE - ENGINEER
MO PE#2013006489

WHISPERING WOODS 2ND PLAT
STREET & STORM SEWER PLANS

STORM PLAN & PROFILE




LEE'S SUMMIT, MO

802 FRANCIS STREET
ST. JOSEPH, MO 64501
816-364-5222

SNYDER & ASSOCIATES
ENGINEERS & PLANNERS, INC.

www.snyder-associates.com

SNYDER & ASSOCIATES

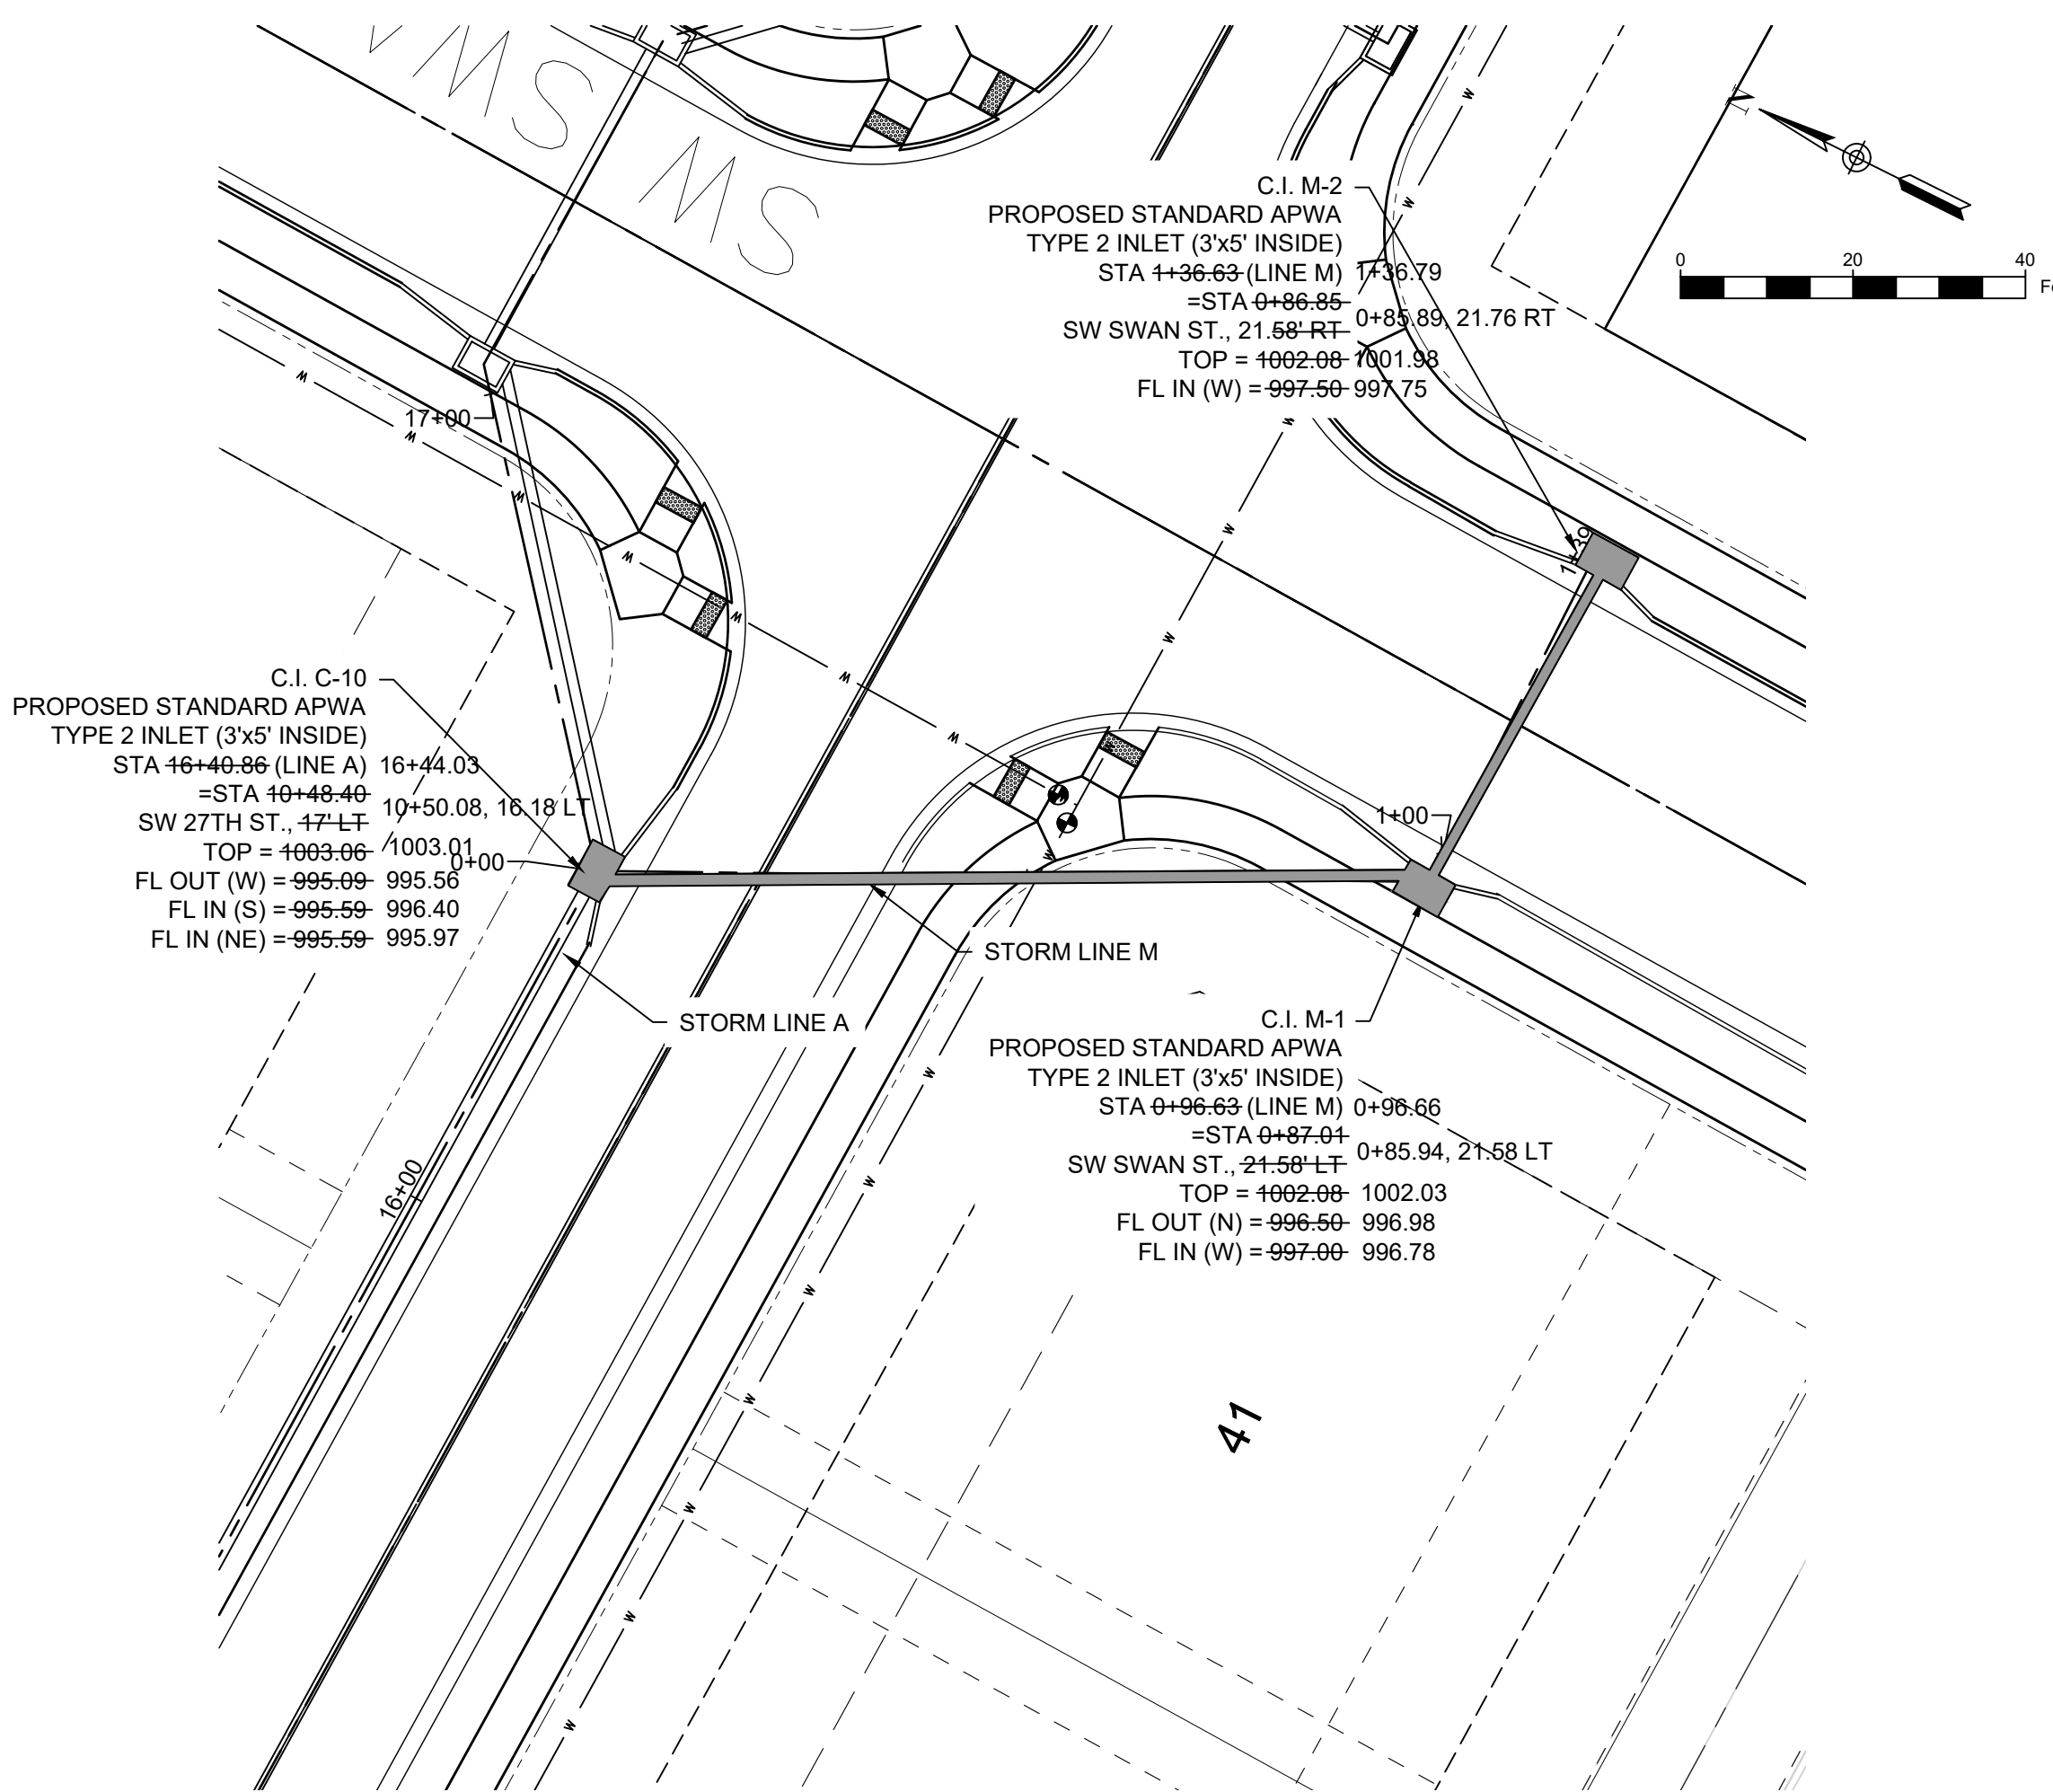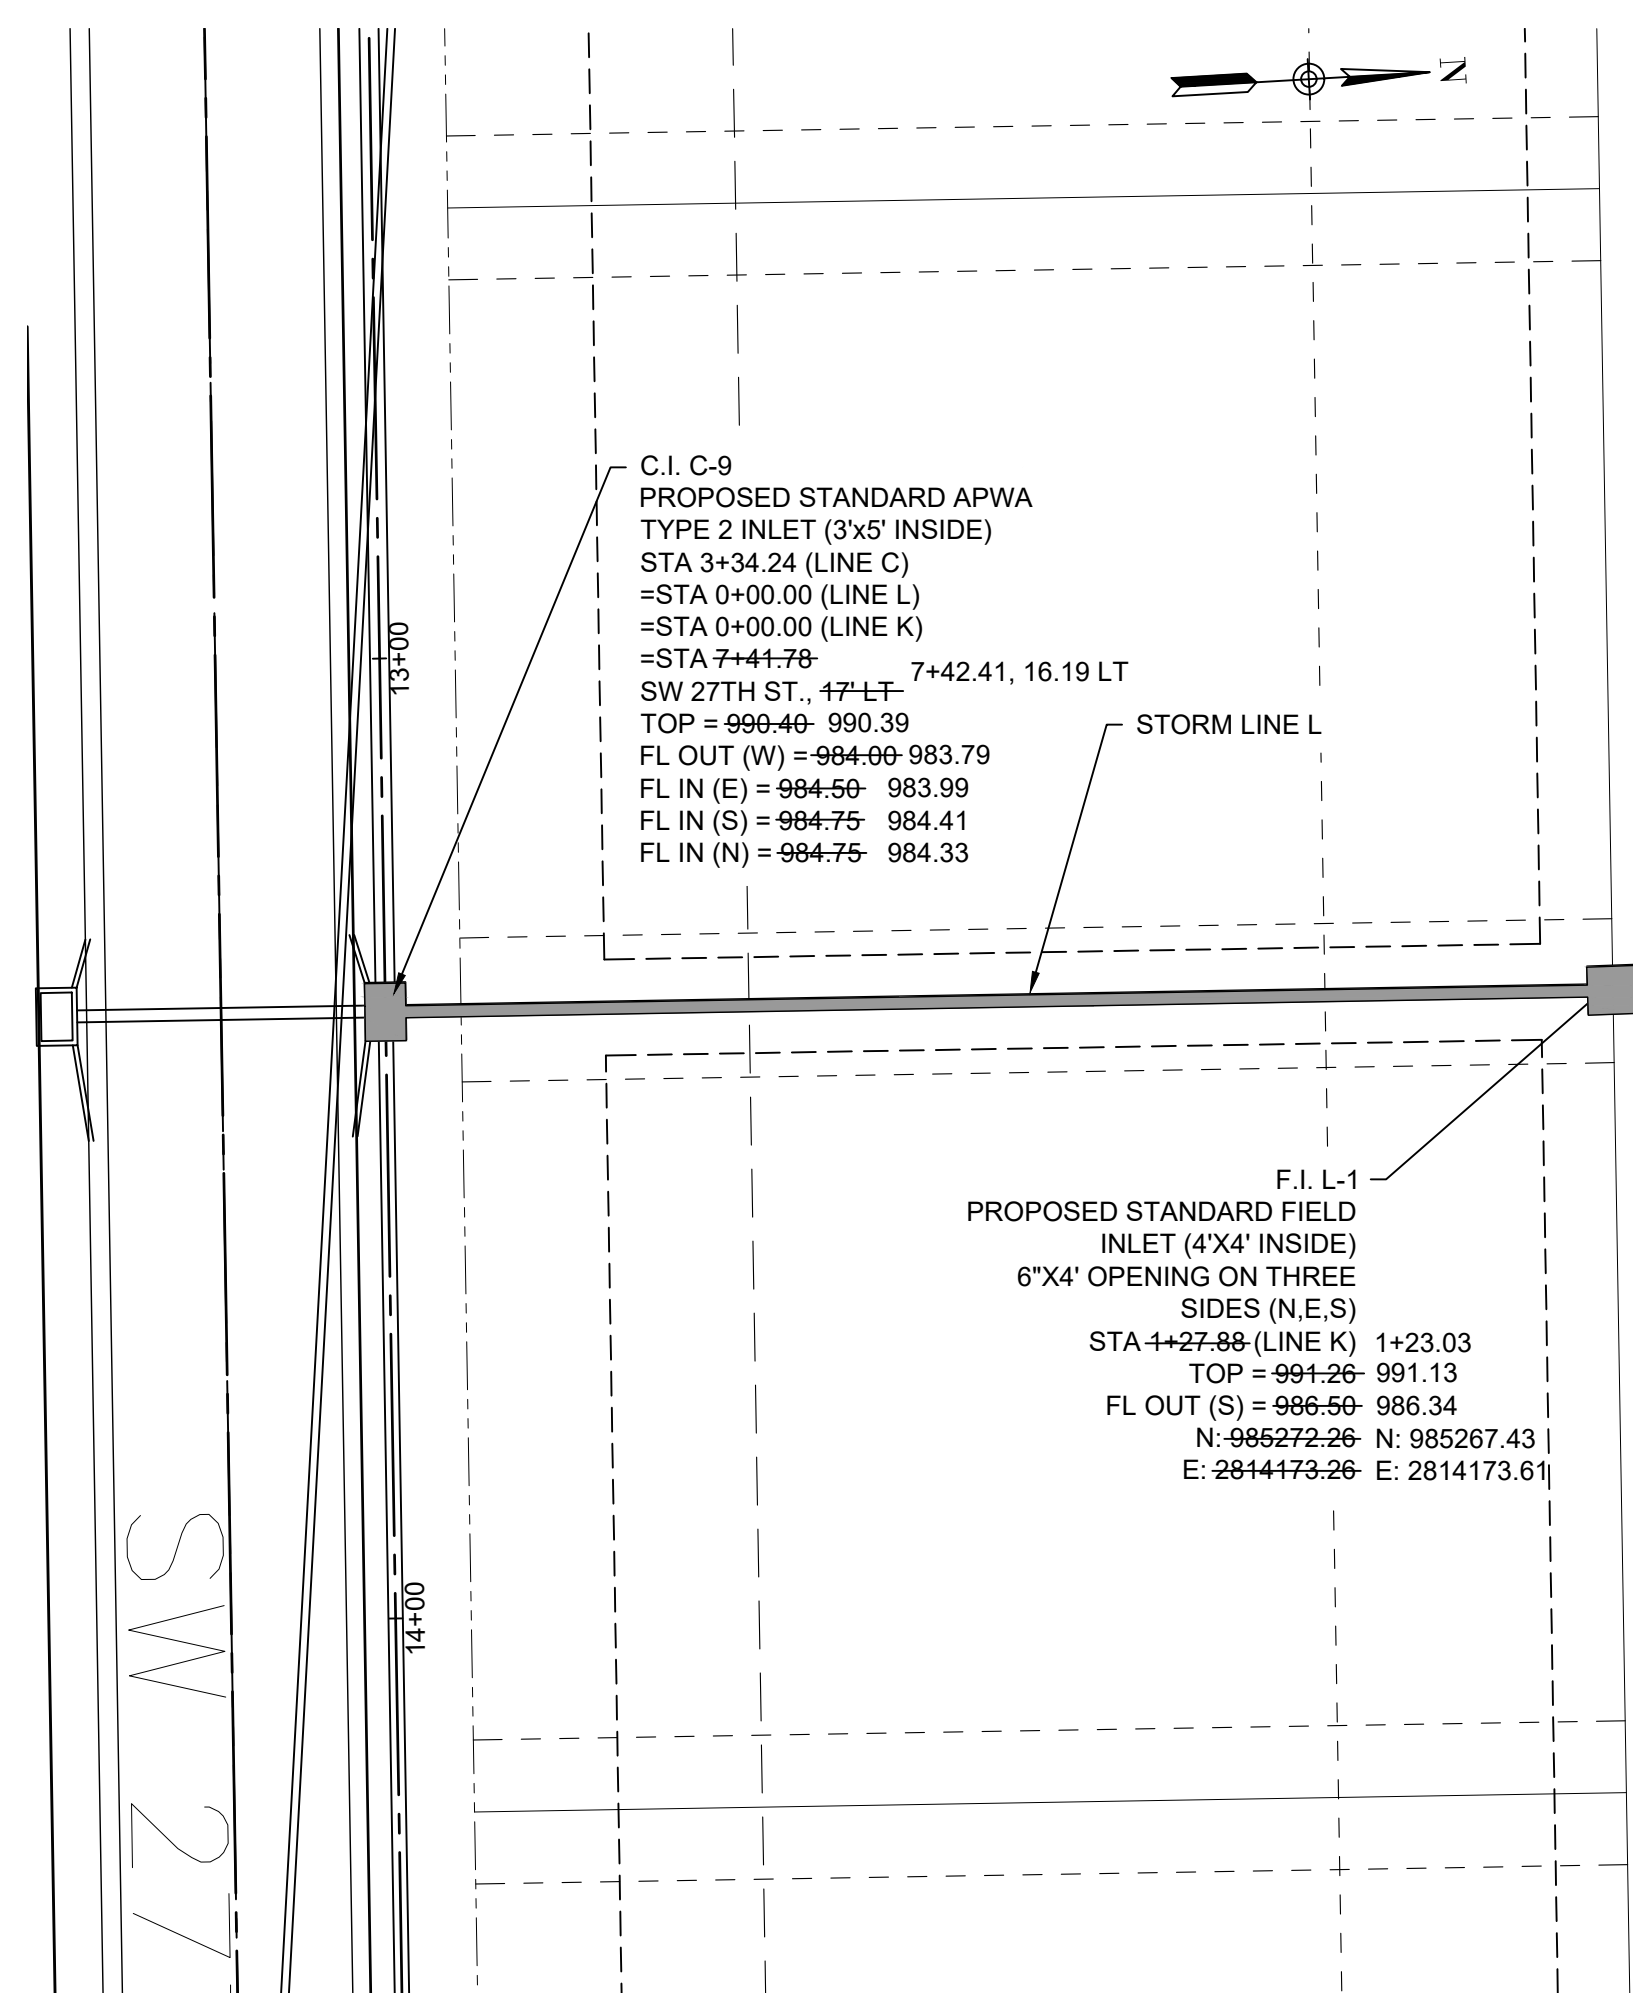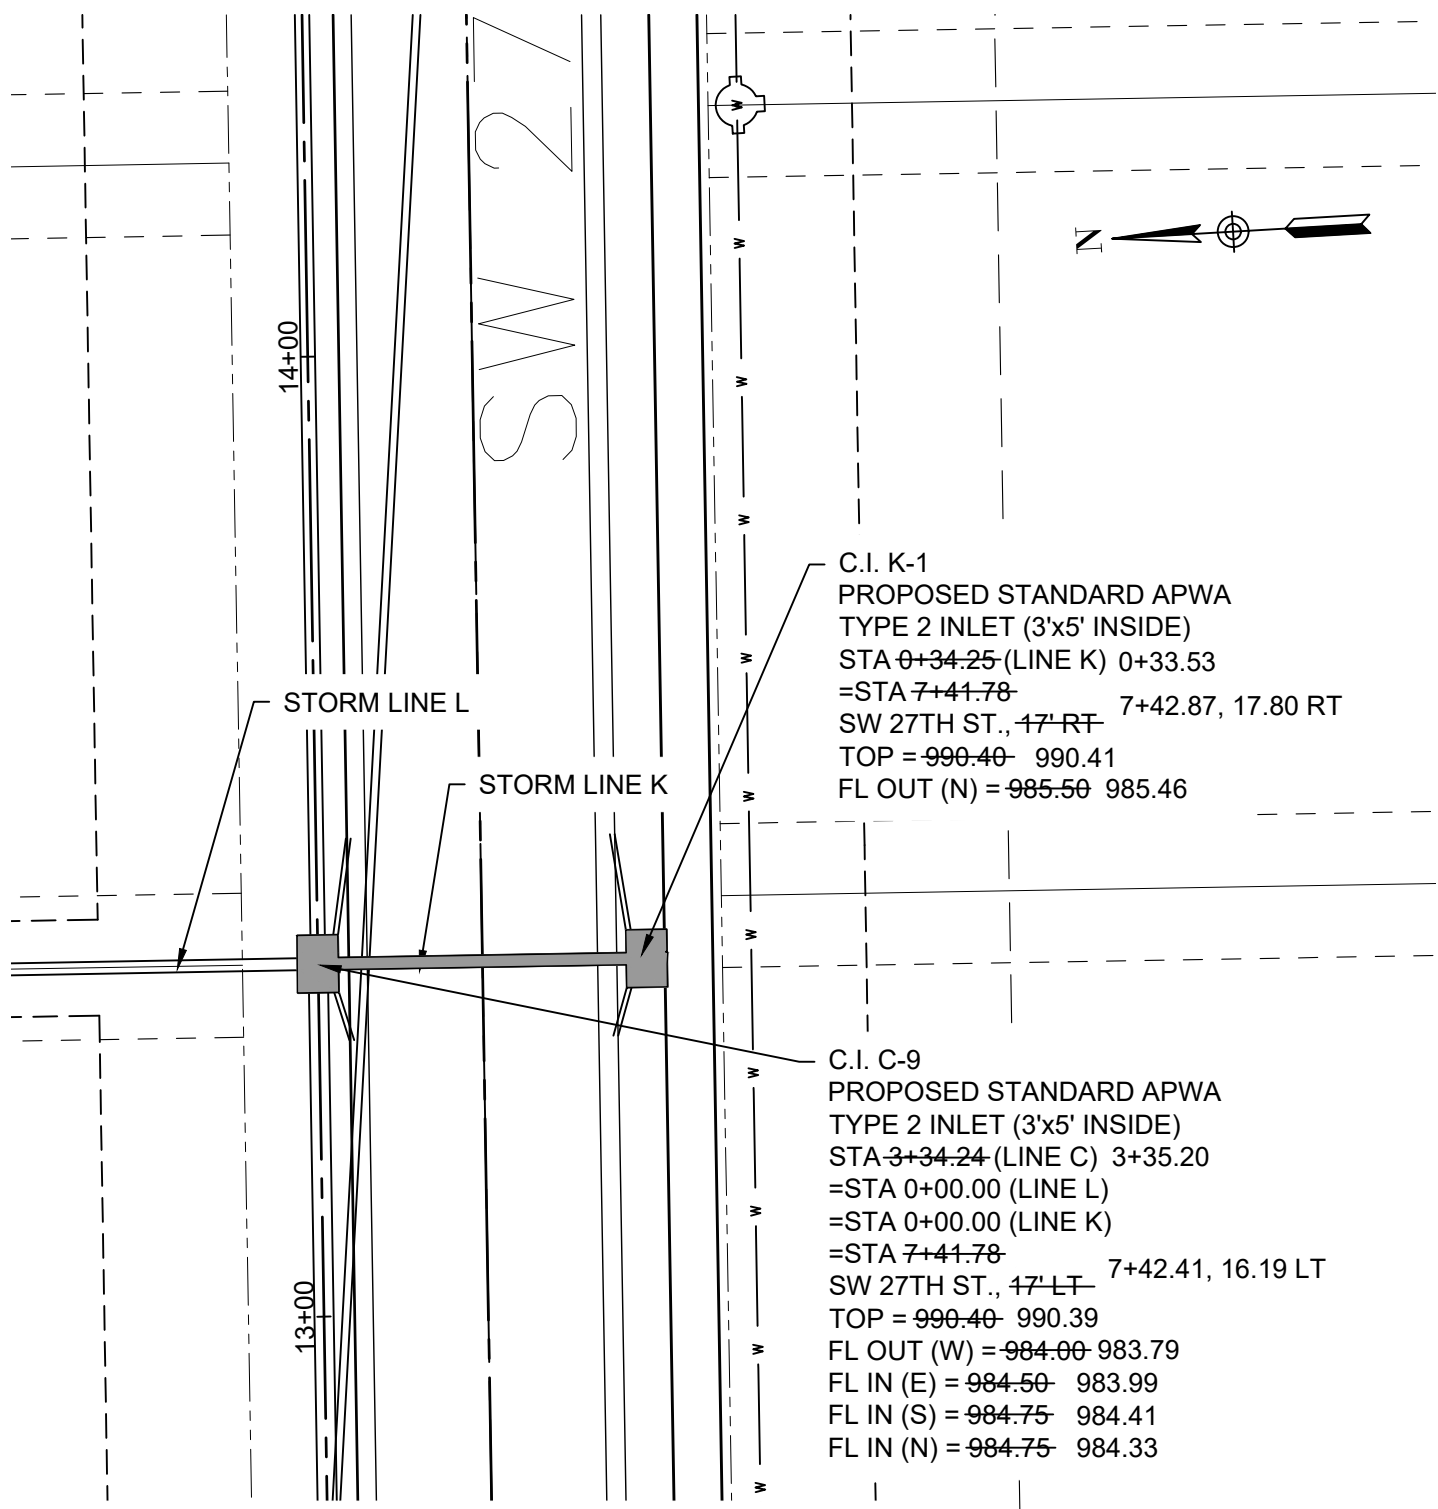


RECORD DRAWING


SURVEY COMPLETED OCTOBER 29, 2021

INFORMATION PROVIDED ON THIS DRAWING DEPICTS AS-CONSTRUCTED CONDITIONS OF SANITARY SEWER WORK PERFORMED BY REDFORD CONSTRUCTION, INC. I, NOR SNYDER & ASSOCIATES, INC IN ANY WAY EXPRESS OR IMPLY WARRANTY OF THE DESIGN OR THE ENGINEERING OF THE AS-CONSTRUCTED IMPROVEMENTS SHOWN HEREON.


I HEREBY CERTIFY THAT THIS RECORD CORRECTLY DEPICTS THE WORK CONSTRUCTED AS TO SIZE, HORIZONTAL AND VERTICAL LOCATION, AND GRADE AS SHOWN ON THE APPROVED CONSTRUCTION DRAWINGS. THE WORK WAS DONE IN ACCORDANCE WITH THESE RECORDS AND THE CURRENT VERSION OF THE STANDARDS AND SPECIFICATIONS.

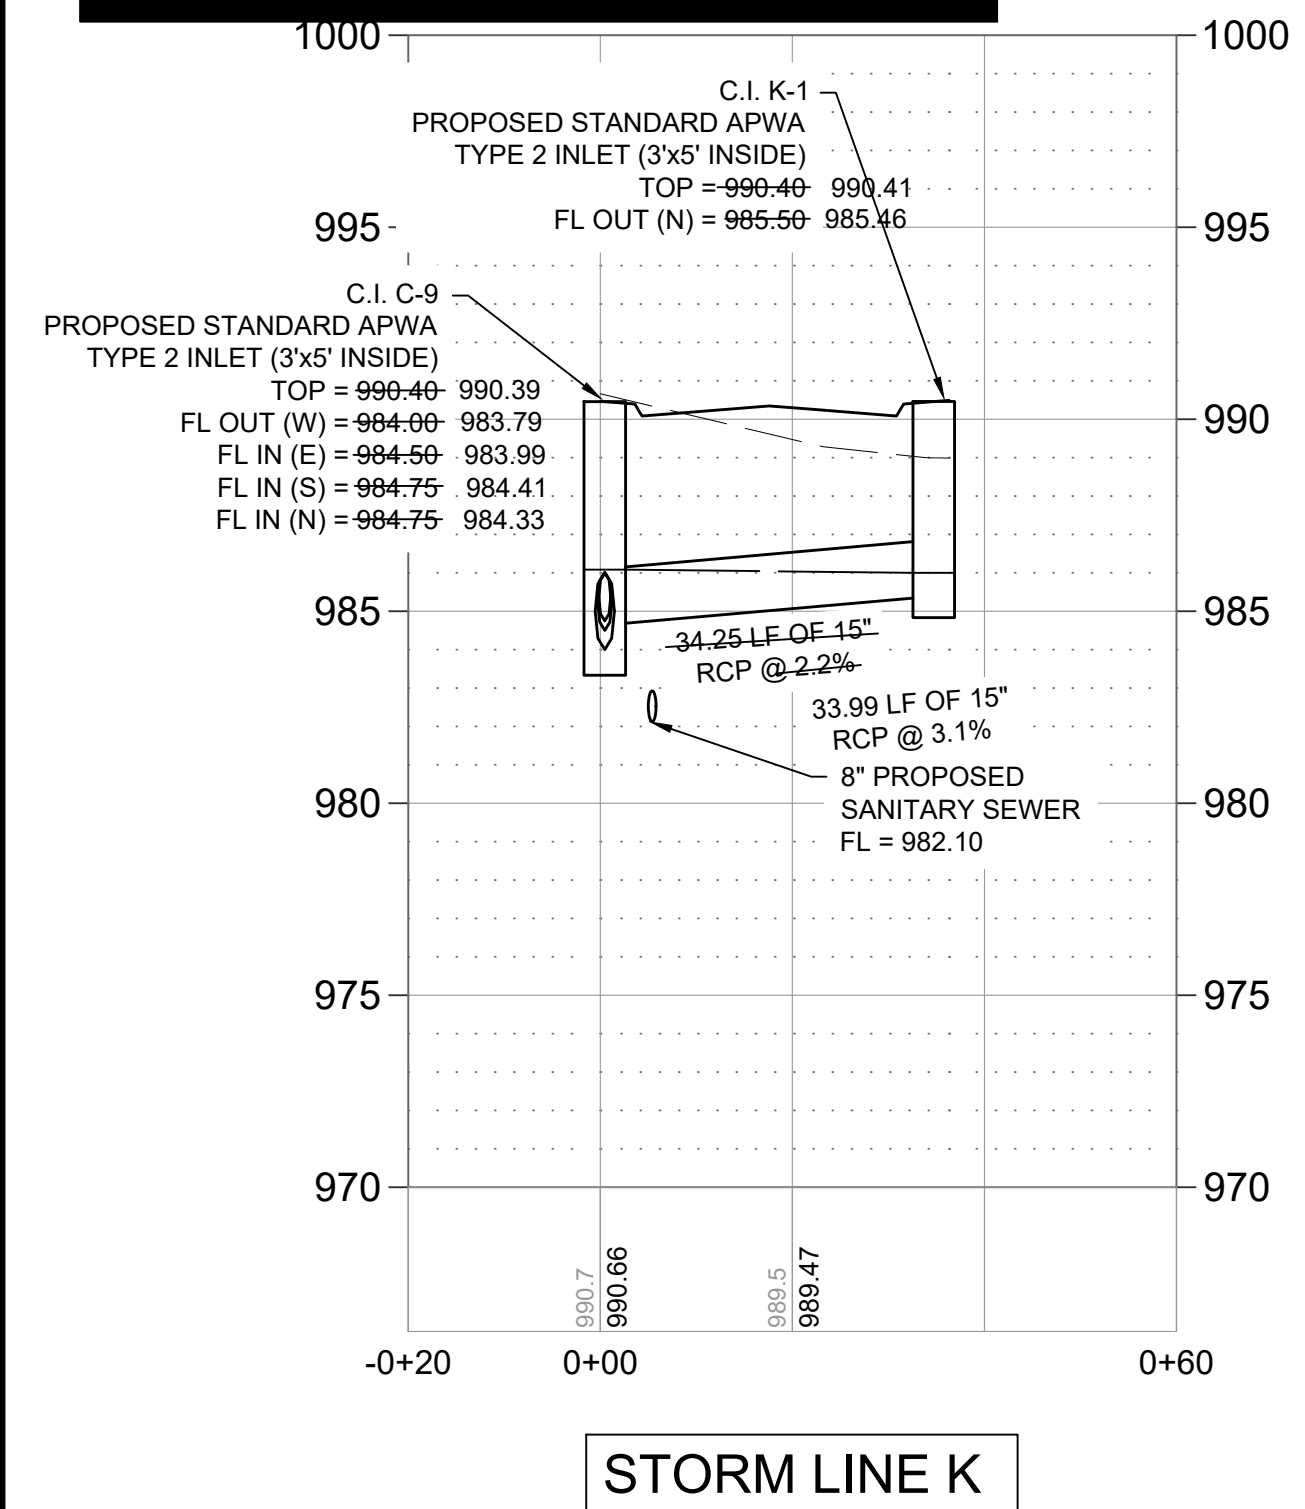

STORM LINE K

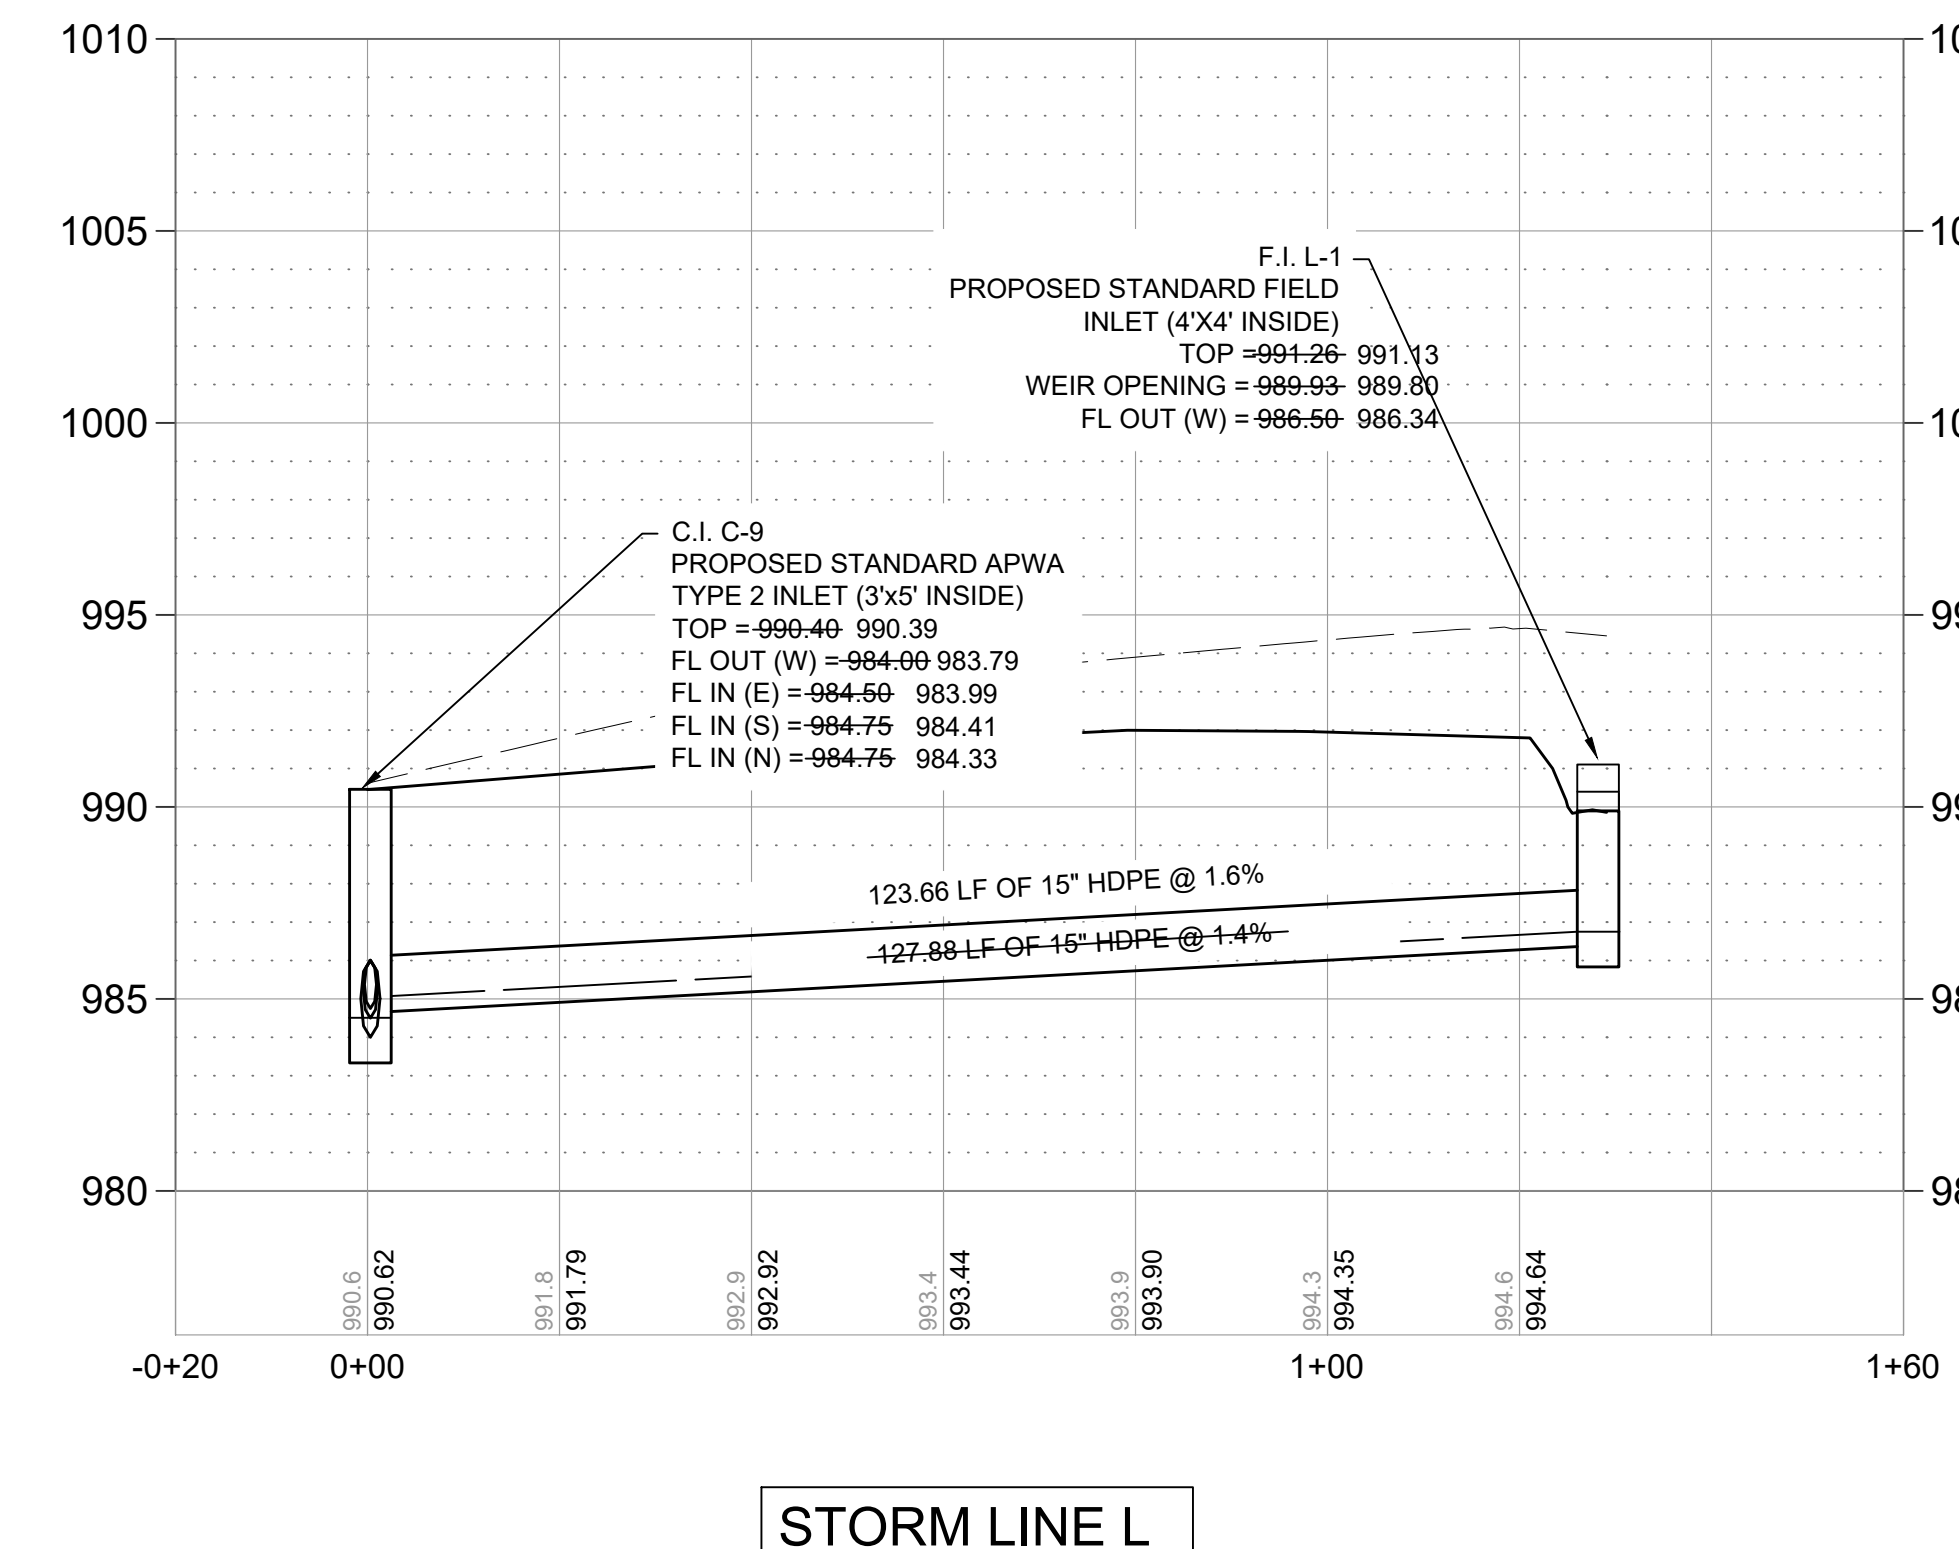

STORM LINE L

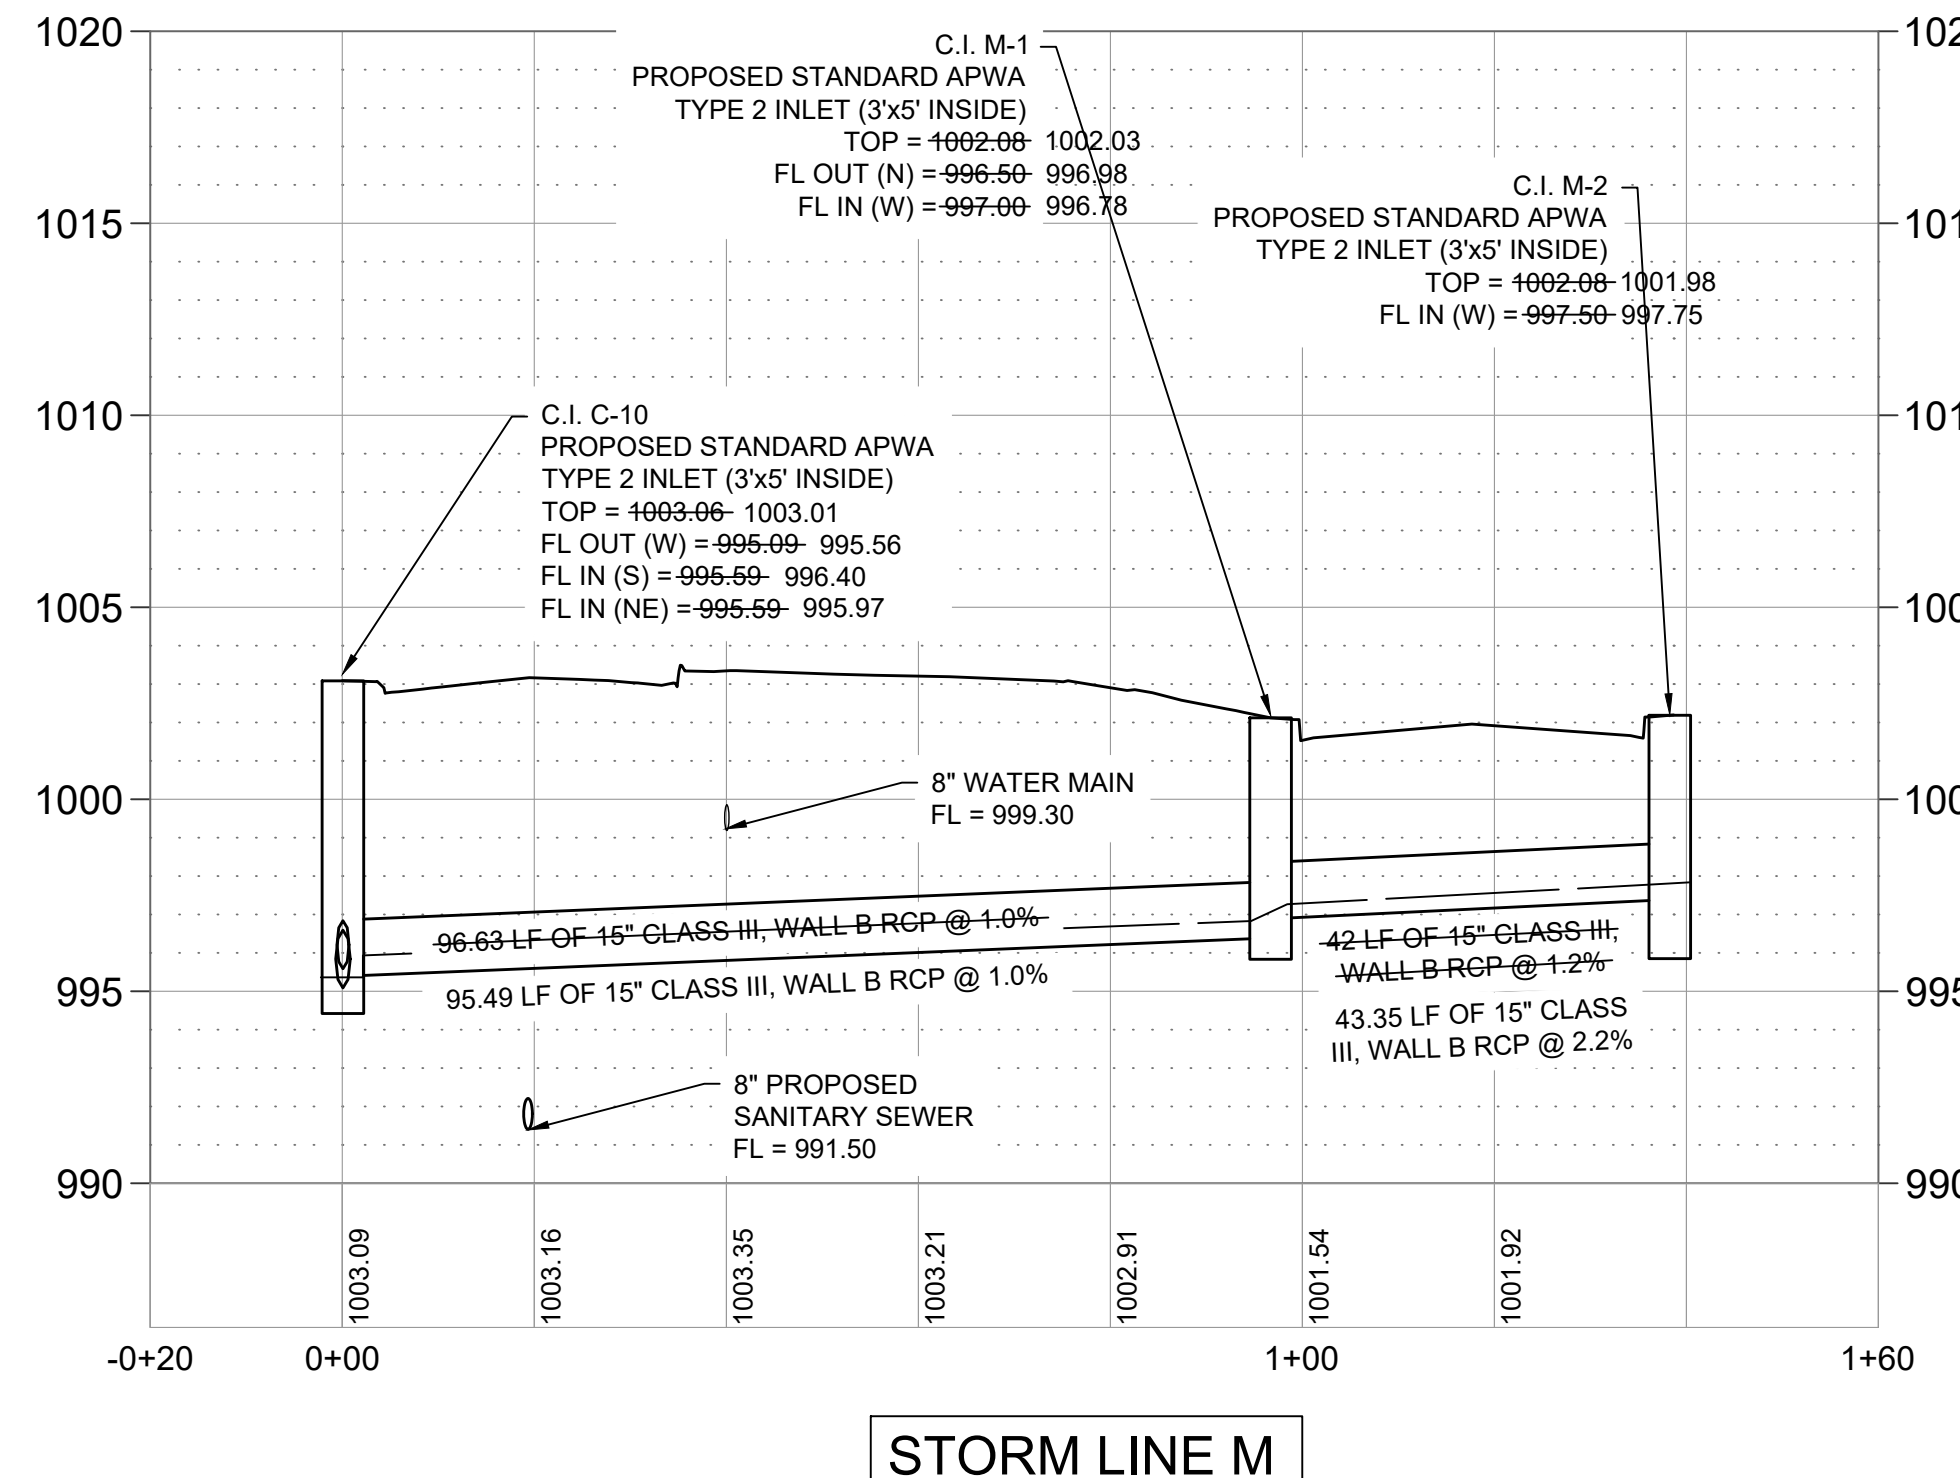

STORM LINE M

WHISPERING WOODS 2ND PLAT STREET & STORM SEWER PLANS

STORM PLAN & PROFILE

SNYDER & ASSOCIATES
ENGINEERS & PLANNERS, INC.
www.snyder-associates.com



Project No: 1200484.11

Sheet 11

SHAWN DUKE - ENGINEER
MO PE#2013006489

LEE'S SUMMIT, MO
802 FRANCIS STREET
ST. JOSEPH, MO 64501
816-364-5222

MARK	REVISION	DATE	BY
Engineer: SD	Checked By: SD	Scale: 1"= 20'	
Technician: JS	Date: 7-28-20	Field Bk: Pg:	
Snyder & Associates Engineers & Planners, Inc.			Sheet 11
Missouri State Certificate of Authority #20000854			