


RELEASE FOR CONSTRUCTION
AS NOTED FOR PLAN REVIEW
DEVELOPMENT SERVICES

LEE'S SUMMIT, MISSOURI

11/08/2021

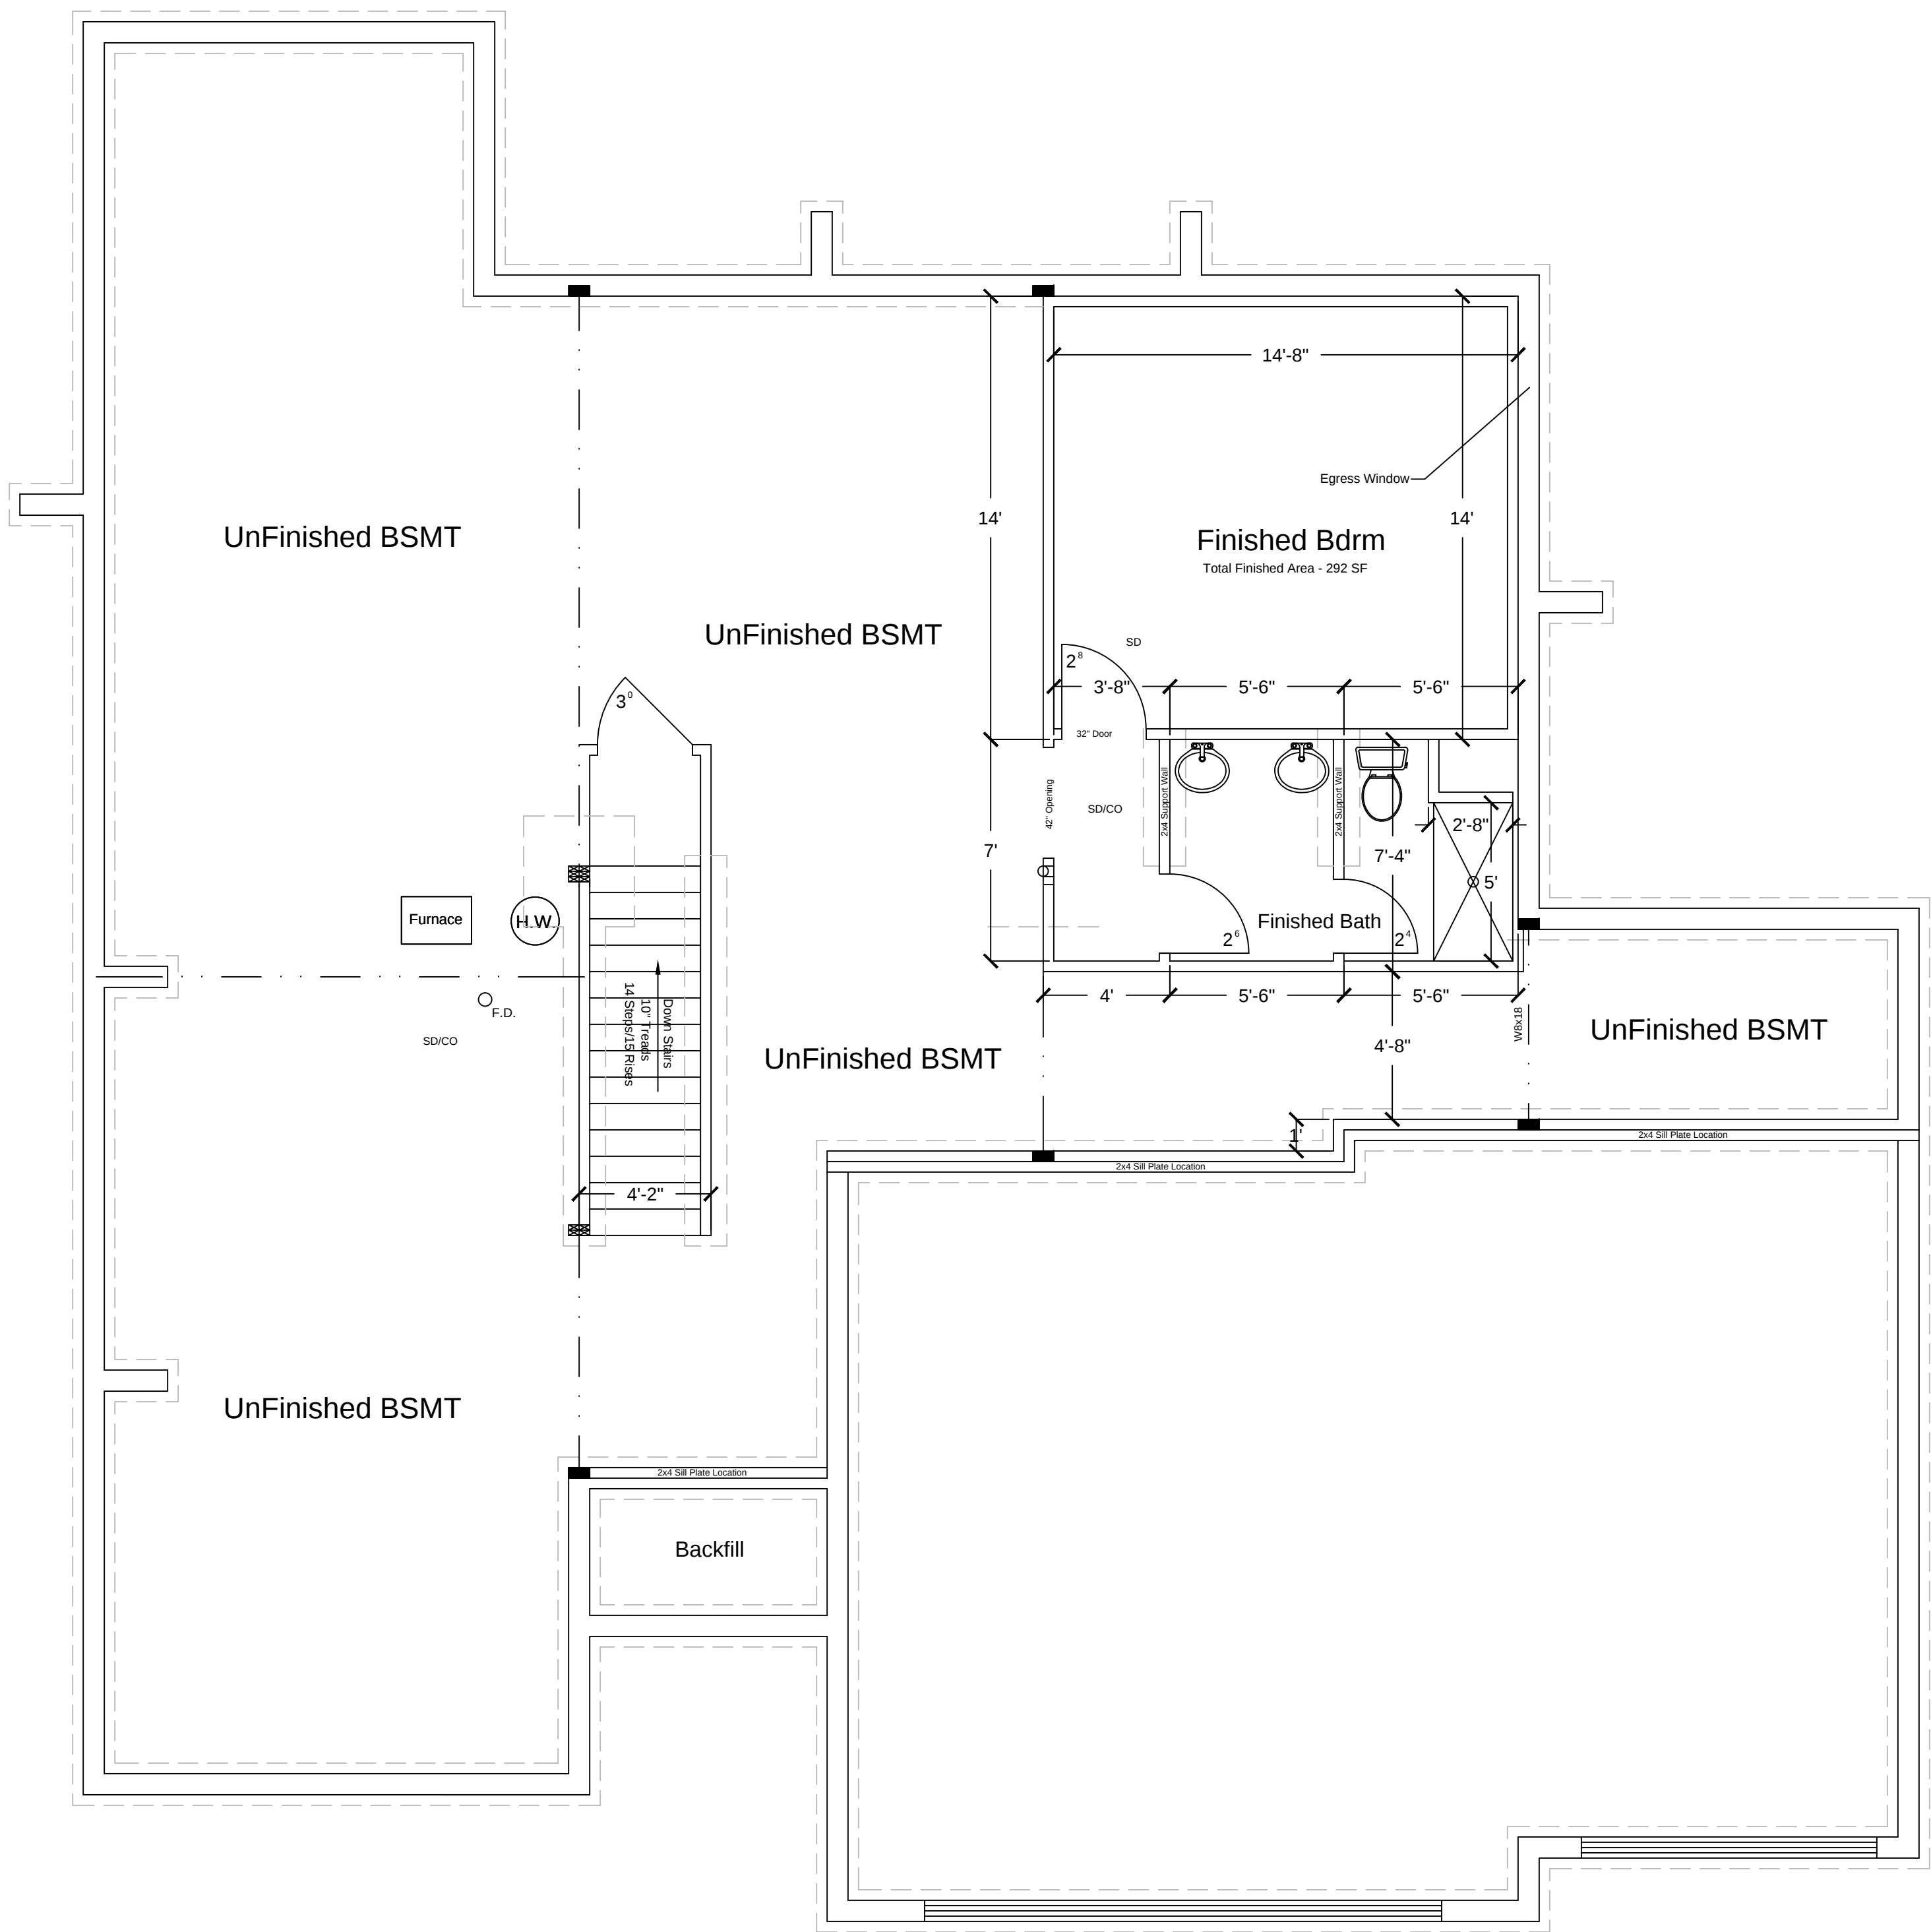

6

1/4" = 1'-0"

4/13/2021

Plan: 20.05.KSH

Mr. & Mrs. Mike Hubbard Residence

Lot 165, Napa Valley 4th Plat
Lees Summit, MO