

LAND SURVEY COMPANY

a division of MIGAR Enterprises, Inc.
P.O. BOX 528 - GRANDVIEW, MISSOURI 64030 - PHONE: 966-0839 - FAX: 763-1761

CONSTRUCTION STAKE PLOT PLAN

ORDERED BY:

46.80 DON SHUMAKER
SKOEMAIER

DESCRIPTION:

Lot 3, REPLAT OF EDGEWOOD TRAILS, a subdivision in
Lee's Summit, Jackson County, Missouri.



RELEASE FOR CONSTRUCTION
AS NOTED FOR PLAN REVIEW
DEVELOPMENT SERVICES
LEE'S SUMMIT, MISSOURI

11/12/2021

RECEIVED

FEB 23 1996

BLDG. INSP. DEPT.
LEE'S SUMMIT, MO.

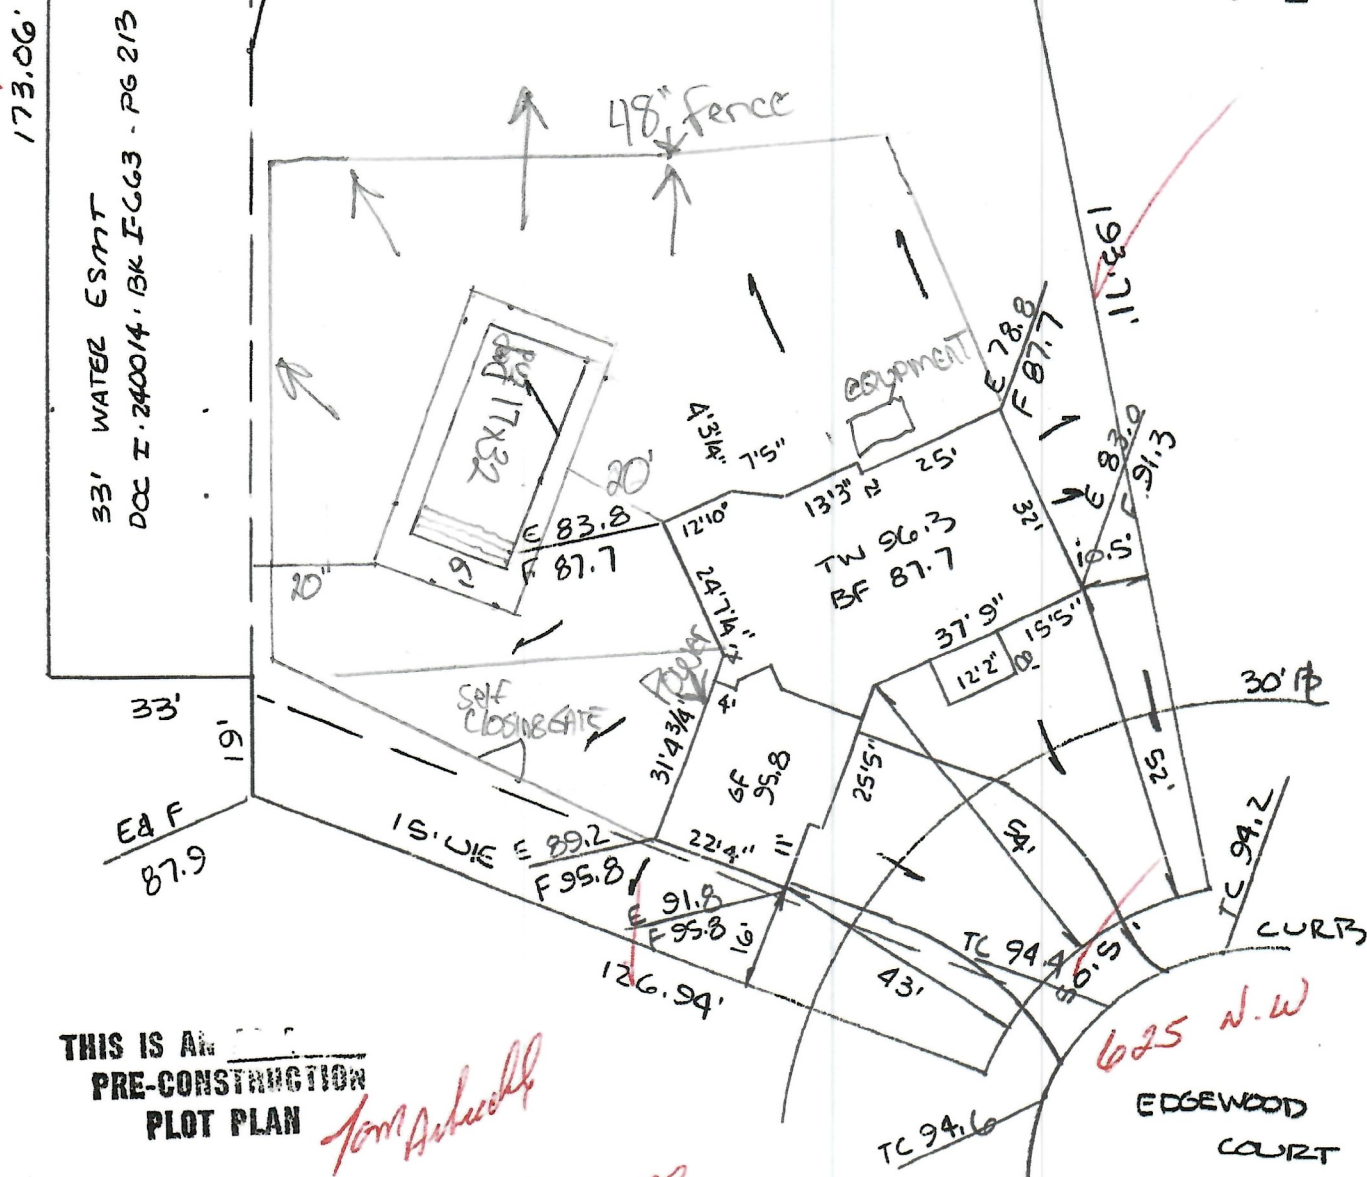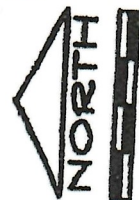

THIS IS ALL
PRE-CONSTRUCTION
PLOT PLAN

Tom Ashcraft

no side walk.

ATTENTION: This plat was prepared for use before and during foundation construction only. House staked as shown on plat. Contractor to check and verify house dimensions and elevations at job site. We are not responsible for unknown or unplatted easements of any kind unless we are furnished the description of said easements before the field work is performed. NOTE: Cuts shown hereon for excavation are a guide only. Final decision as to cuts and foundation height to be made by builder on job site.

SCALE: 1"=40'

DATE: 2.15.96

JOB NO: