


CONSTRUCTION STAKE PLOT PLAN

Ordered by: Elevate Design
Description: Lot 15 Hook Farms First Plat, Lee's Summit, Mo.
Address: 2046 SW HOOK FARM DRIVE

Footprint 1718 sf

As-graded plot plan per Sec. 7-160 Code of Ordinances is required prior to occupancy.

RELEASE FOR CONSTRUCTION AS NOTED ON PLANS REVIEW Development Services LEE'S SUMMIT, MISSOURI

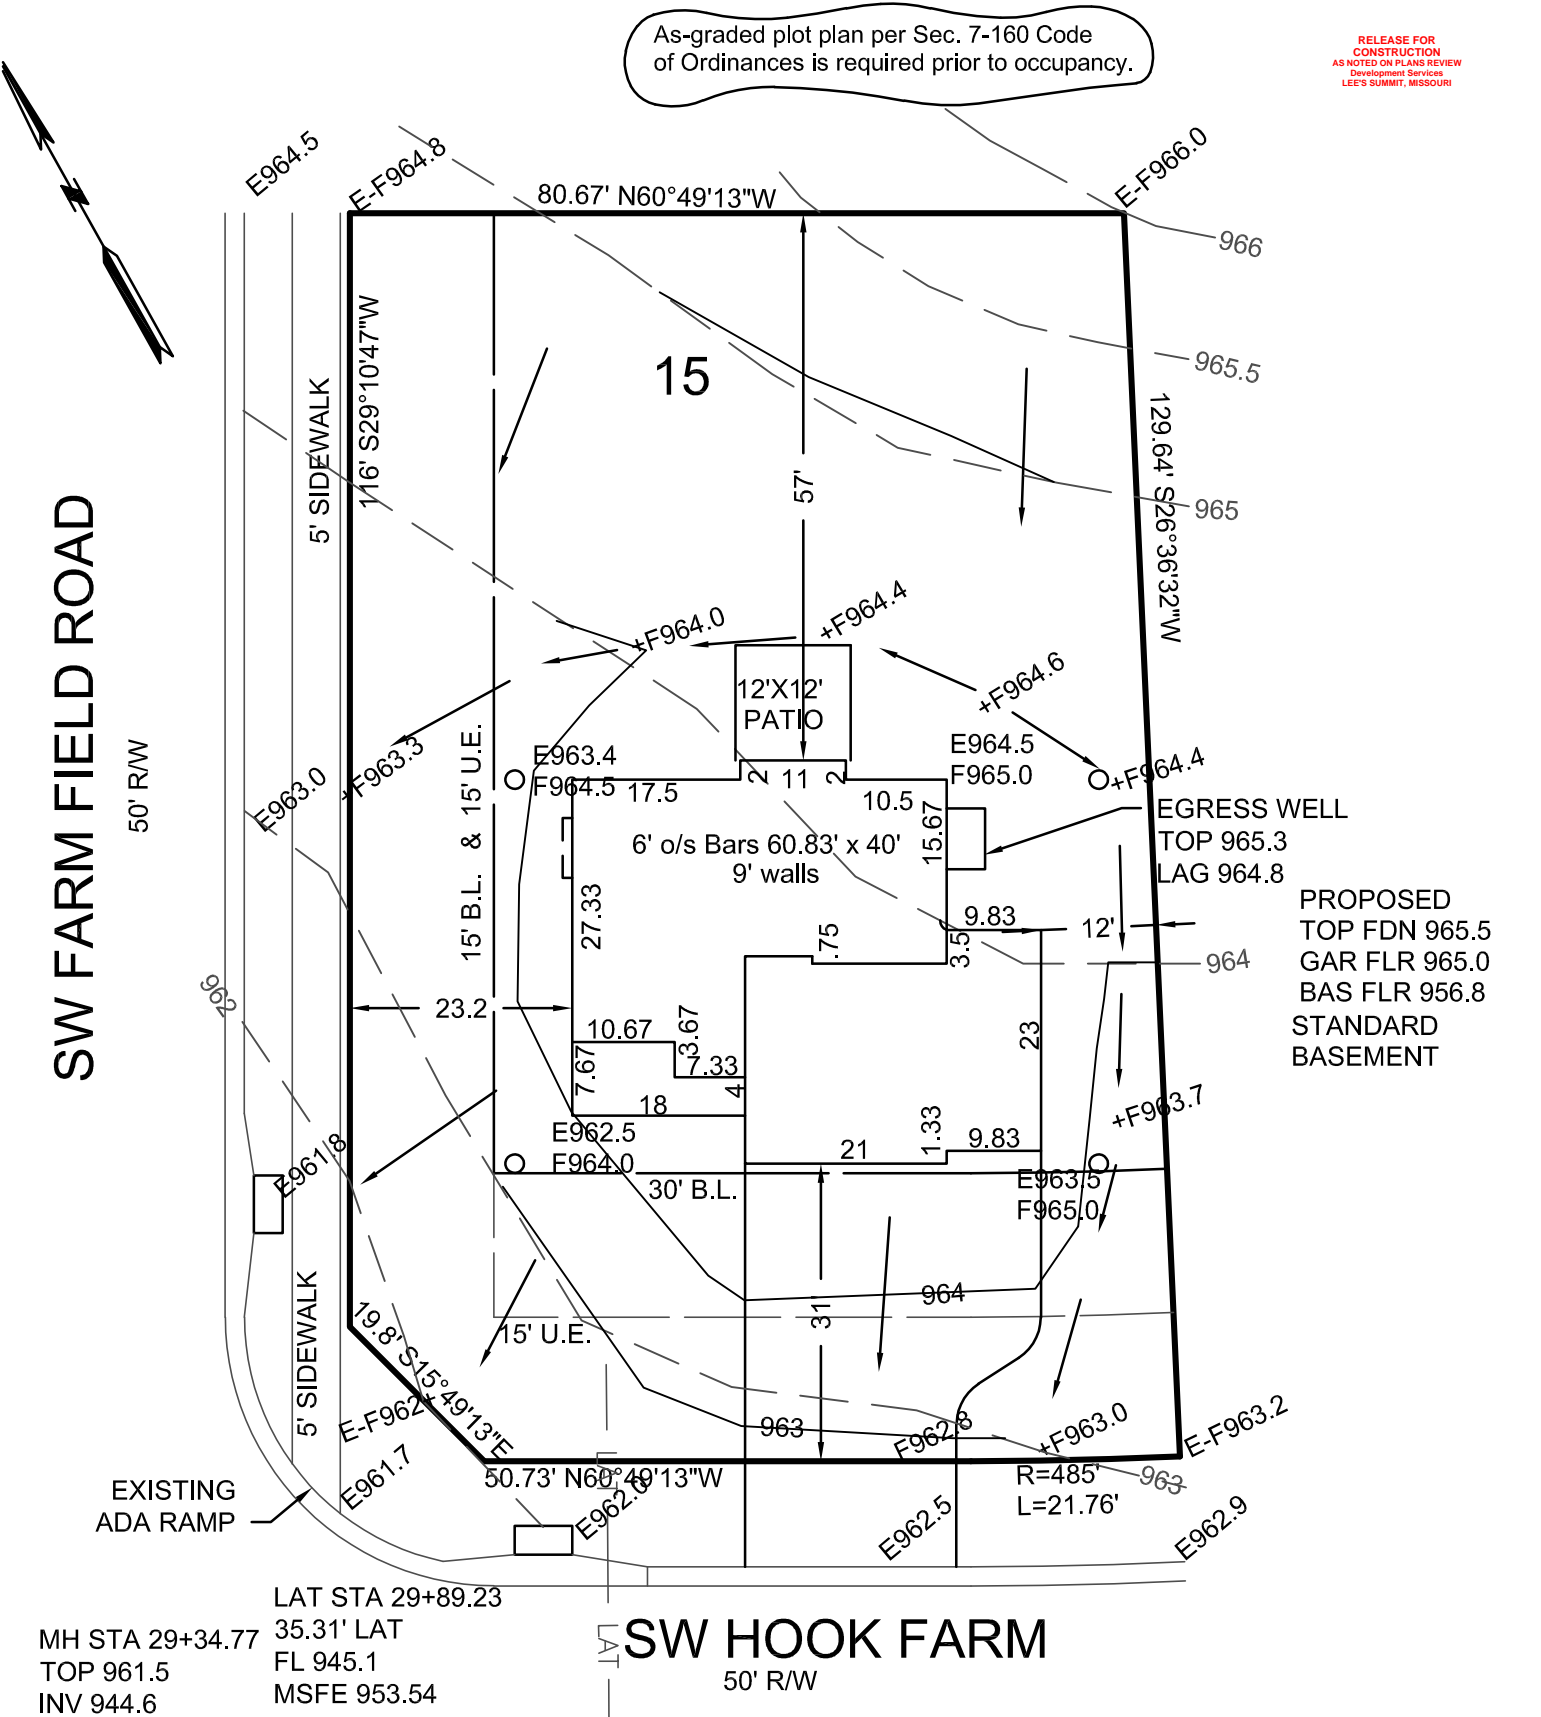

PROPOSED
TOP FDN 965.5
GAR FLR 965.0
BAS FLR 956.8
STANDARD
BASEMENT

This plot plan is not an "as-built" survey as the house was staked prior to being built and cannot be used in place of a "Surveyors Real Property Report". This plot plan was prepared for use before and during foundation construction only and should not be used to establish property lines for fences or other structures. House staked as shown on this plot plan. House dimensions may have been assumed and contractor must check house dimensions shown and compare to the final house plans. Contractor to verify all elevations at job site. Builder must make final decision as to cuts and foundation heights at the job site, any floor elevations shown are shown as a guide only. Sanitary sewer and lateral elevations cannot be verified at time of staking, and it may be necessary to verify sanitary sewer elevation and location (BY DIGGING UP THE SEWER LATERAL) prior to excavation for foundation. Underground utilities and un-platted easements may not be shown. This does not constitute a boundary survey and builder must check to make sure description shown is correct with the deed for the property. It is recommended that no work be done until building permits are obtained and plot plan has been verified by local building codes authorities to comply with all setback and other restrictions.

= DRAINAGE PATTERN

CONSTRUCTION ENGINEERING SERVICES, INC.

16810-C East 40 Highway
Independence, MO 64055
(816)478-2323

lee@engineeringkc.com

SCALE: 1"=20'

DATE: 10/5/2021 & 11/29/2021

JOB NO: 17967 & 18052

LEE BODENHEIMER, L.S.
Land Surveyor

