
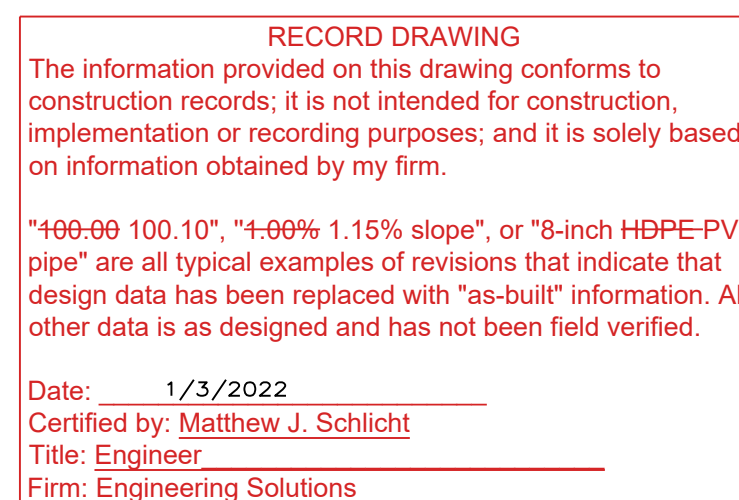
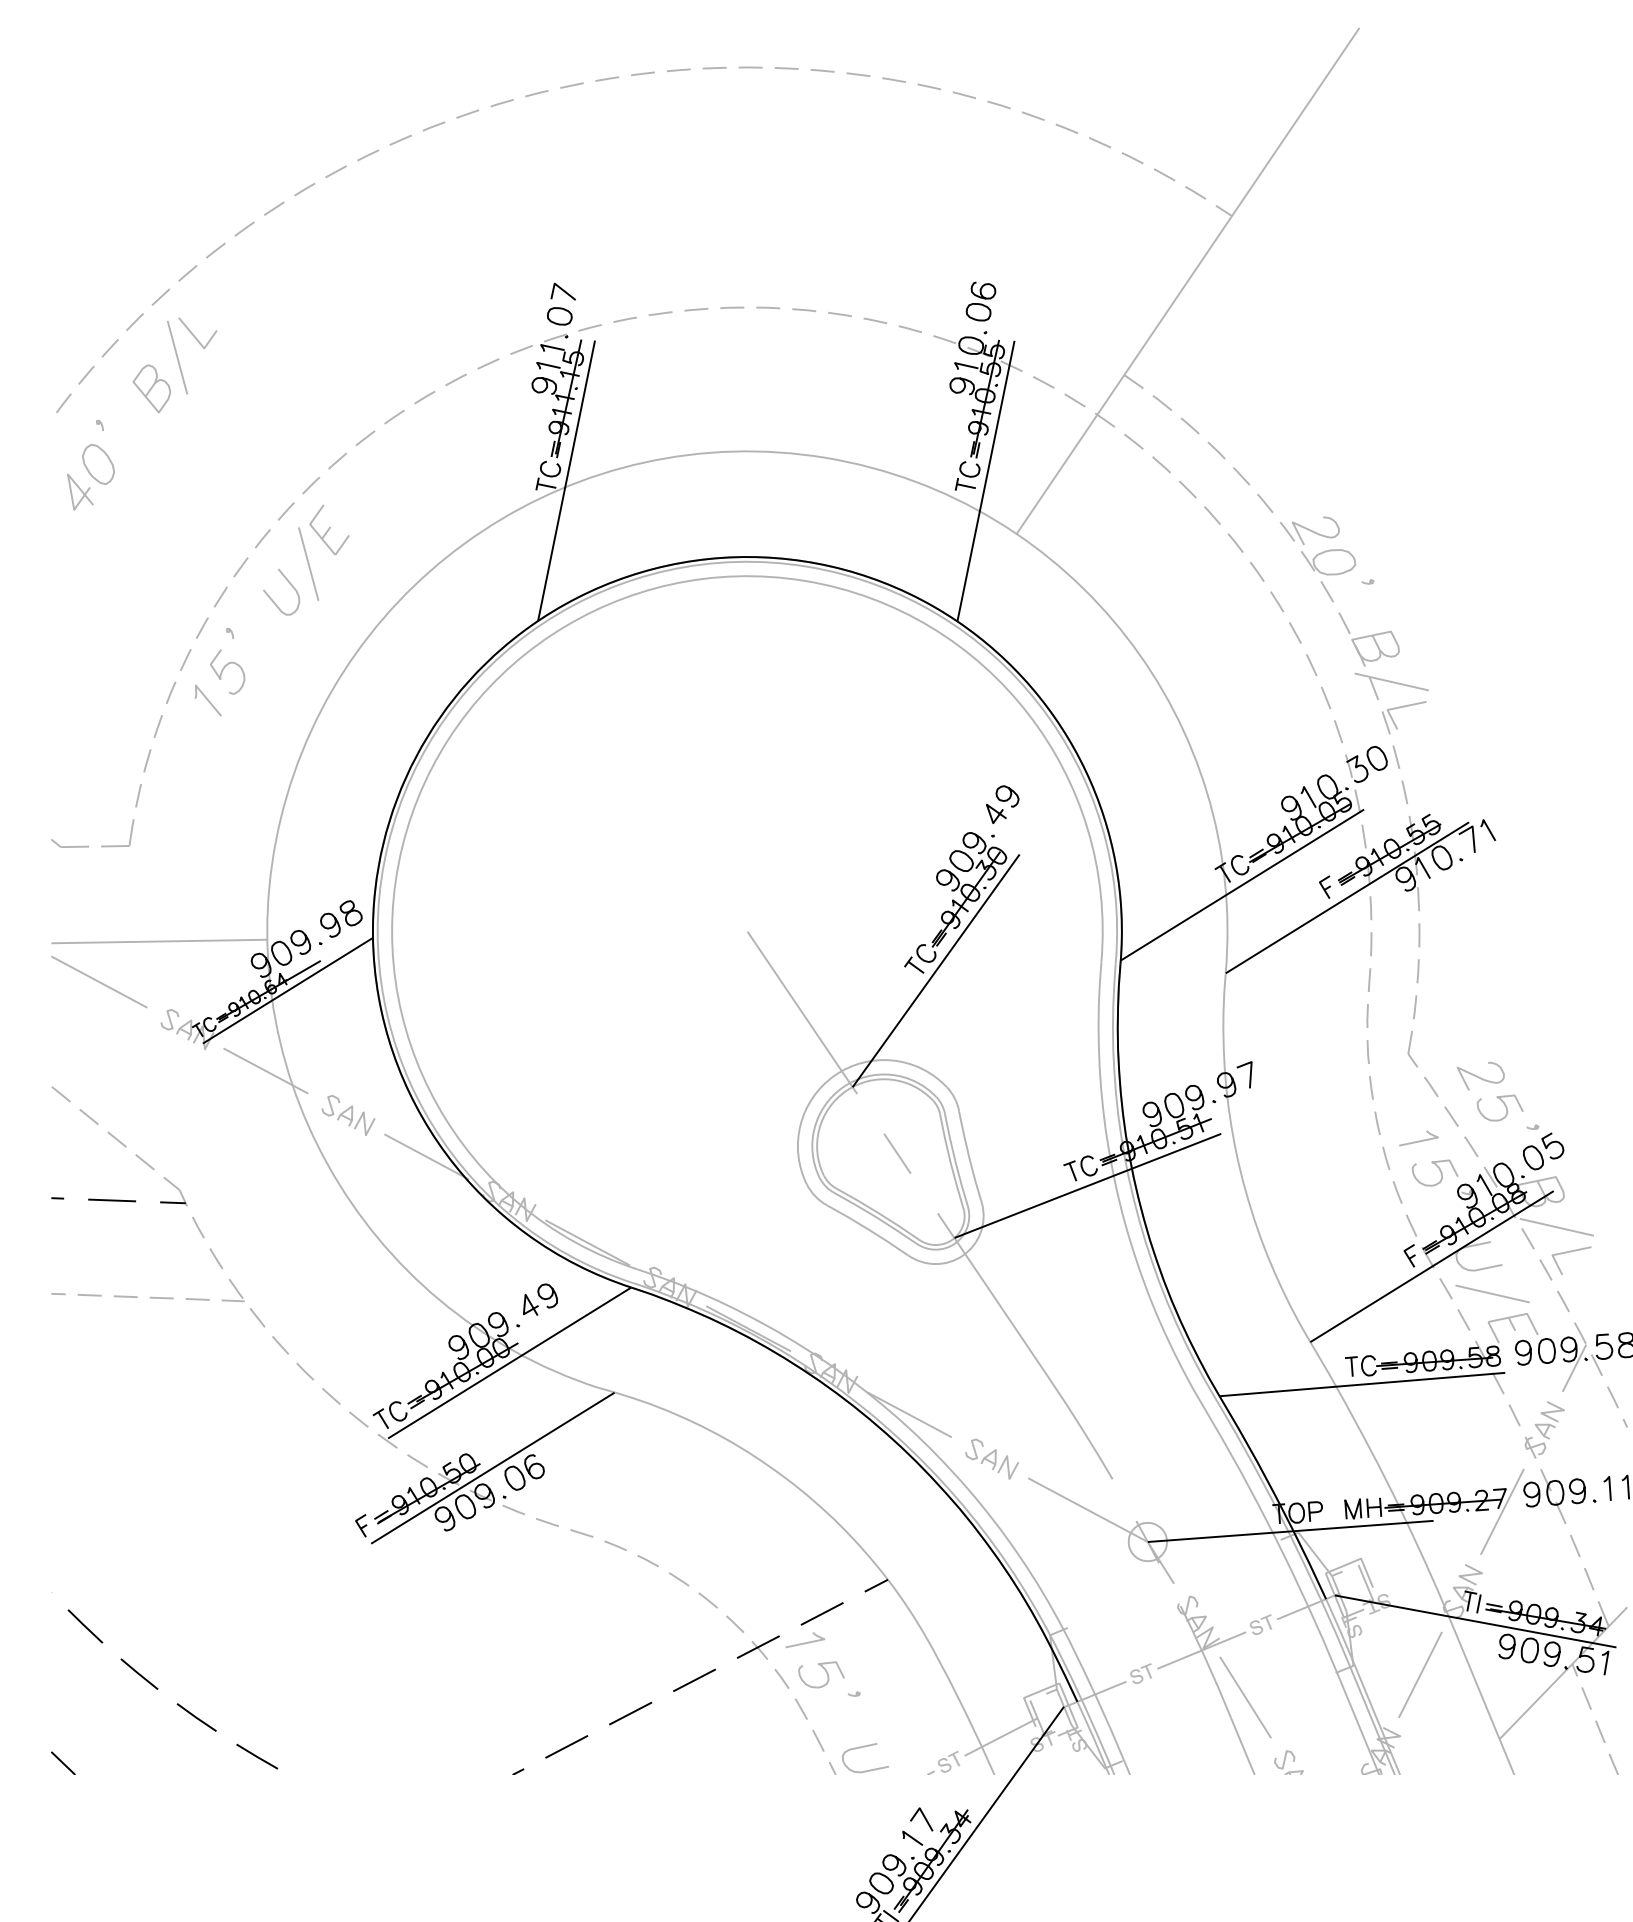
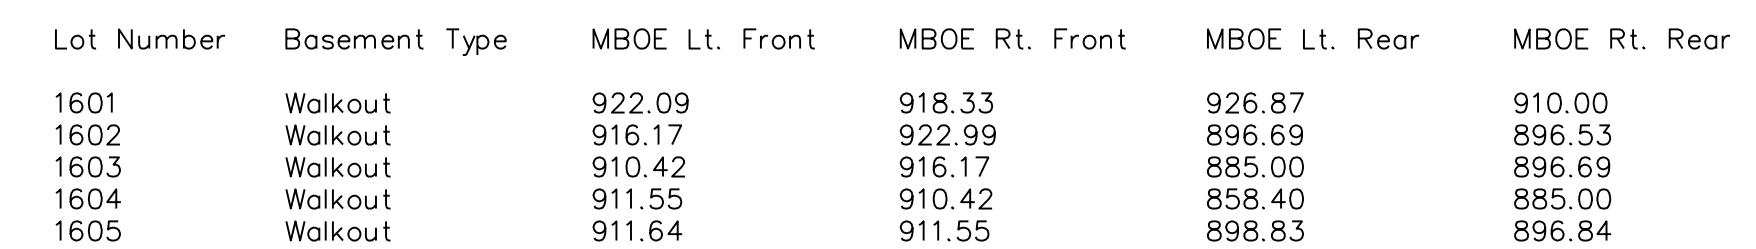


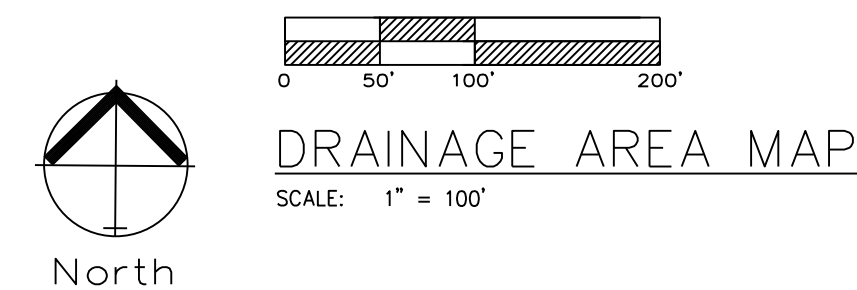

[illegible]

RECORD DRAWING

The information provided on this drawing conforms to construction records; it is not intended for construction, implementation or recording purposes; and it is solely based on information obtained by our firm.

"400-00 100.10", "4+00% 1.15% slope", or "8-inch HDPE-PVC pipe" are all typical examples of revisions that indicate that design data has been replaced with "as-built" information. All other data is as designed and has not been field verified.

Date: 1/3/2022

Certified by: Matthew J. Schlicht

Title: Engineer

Firm: Engineering Solutions