



MiTek USA, Inc.
16023 Swingley Ridge Rd
Chesterfield, MO 63017
314-434-1200

Re: 3008841
C&H/159 COBEY CREEK/MO

The truss drawing(s) referenced below have been prepared by MiTek USA, Inc. under my direct supervision based on the parameters provided by Builders FirstSource (Valley Center).

Pages or sheets covered by this seal: I49431985 thru I49432010

My license renewal date for the state of Missouri is December 31, 2023.

Missouri COA: Engineering 001193



December 28, 2021

Sevier, Scott ,Engineer

IMPORTANT NOTE: The seal on these truss component designs is a certification that the engineer named is licensed in the jurisdiction(s) identified and that the designs comply with ANSI/TPI 1. These designs are based upon parameters shown (e.g., loads, supports, dimensions, shapes and design codes), which were given to MiTek or TRENCO. Any project specific information included is for MiTek's or TRENCO's customers file reference purpose only, and was not taken into account in the preparation of these designs. MiTek or TRENCO has not independently verified the applicability of the design parameters or the designs for any particular building. Before use, the building designer should verify applicability of design parameters and properly incorporate these designs into the overall building design per ANSI/TPI 1, Chapter 2.

Job	Truss	Truss Type	Qty	Ply	C&H/159 COBEY CREEK/MO	RELEASE FOR CONSTRUCTION
3008841	A1	Common Supported Gable	1	1		AS NOTED FOR PLAN REVIEW
					Job Reference (optional)	DEVELOPMENT SERVICES
						LEE'S SUMMIT, MISSOURI

Builders FirstSource (Valley Center), Valley Center, KS - 67147,

8.430 s Aug 16 2021 MiTek Industries, Inc Mon Dec 27 09:44:52 2021 Page 1

ID:xKFGJ7evN?7xhJE66FFHnCzvA57-RG?nscoMXGhGah8jRrF00nWabCio6Mss/FKv4ol9

0-10-8 13-6-0 27-0-0 0-10-8 13-6-0 27-0-0 0-10-8

Scale: 1/4"=1'

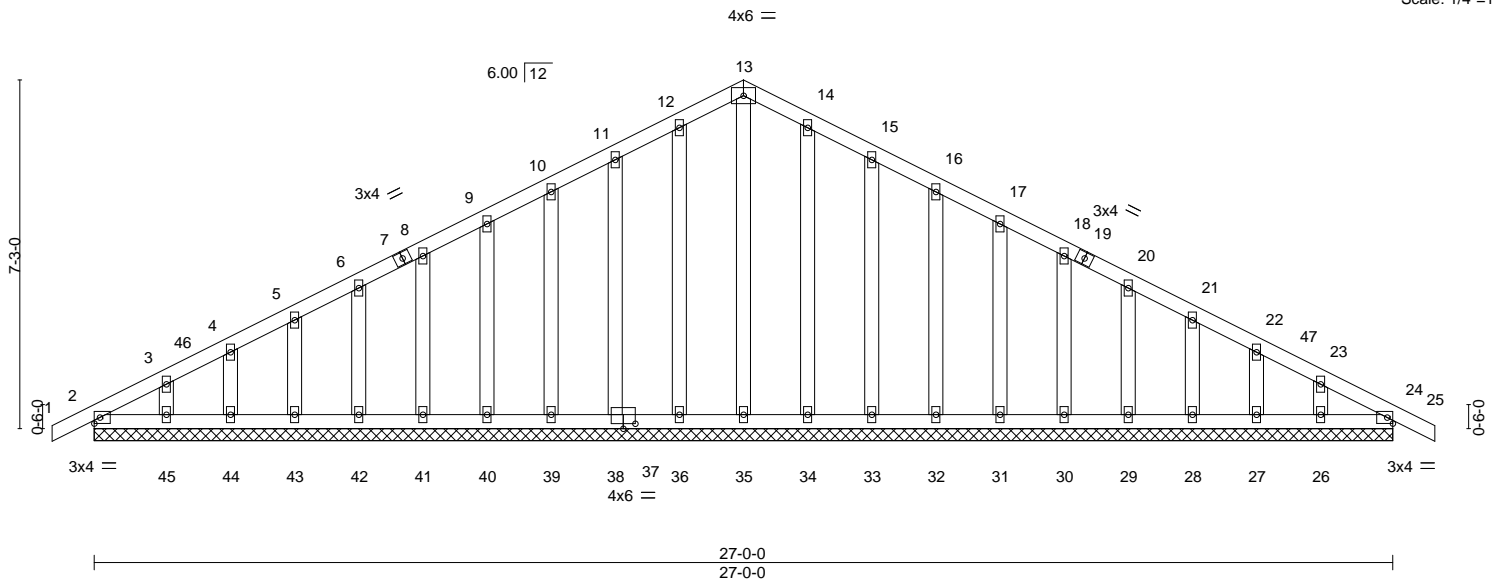


Plate Offsets (X,Y)-- [37:0-3-0-0-1-4]							
LOADING (psf)	SPACING-	2-0-0	CSI.	DEFL.	in (loc)	l/defl	L/d
TCLL 25.0	Plate Grip DOL	1.15	TC 0.05	Vert(LL)	-0.00	25	n/r
TCDL 10.0	Lumber DOL	1.15	BC 0.02	Vert(CT)	-0.00	25	n/r
BCLL 0.0	Rep Stress Incr	YES	WB 0.11	Horz(CT)	0.00	24	n/a
BCDL 10.0	Code IRC2018/TPI2014		Matrix-S				
				PLATES	GRIP		
				MT20	197/144		
				Weight: 145 lb		FT = 20%	

LUMBER-

TOP CHORD 2x4 SPF No.2
BOT CHORD 2x4 SPF No.2
OTHERS 2x4 SPF No.2

BRACING-

TOP CHORD Structural wood sheathing directly applied or 6-0-0 oc purlins.
BOT CHORD Rigid ceiling directly applied or 10-0-0 oc bracing.

REACTIONS.

All bearings 27-0-0.

(lb) - Max Horz 2=114(LC 17)

Max Uplift All uplift 100 lb or less at joint(s) 2, 36, 38, 39, 40, 41, 42, 43, 44, 45, 34, 33, 24, 32, 31, 30, 29, 28, 27, 26

Max Grav All reactions 250 lb or less at joint(s) 2, 35, 36, 38, 39, 40, 41, 42, 43, 44, 45, 34, 33, 24, 32, 31, 30, 29, 28, 27, 26

FORCES. (lb) - Max. Comp./Max. Ten. - All forces 250 (lb) or less except when shown.

NOTES-

- Unbalanced roof live loads have been considered for this design.
- Wind: ASCE 7-16; Vult=115mph (3-second gust) Vasd=91mph; TCDL=6.0psf; BCDL=4.2psf; h=15ft; Cat. II; Exp C; Enclosed; MWFRS (envelope) gable end zone and C-C Corner(3E) -0-10-8 to 2-1-8, Exterior(2N) 2-1-8 to 13-6-0, Corner(3R) 13-6-0 to 16-6-0, Exterior(2N) 16-6-0 to 27-10-8 zone; cantilever left and right exposed; end vertical left and right exposed; C-C for members and forces & MWFRS for reactions shown; Lumber DOL=1.60 plate grip DOL=1.60
- Truss designed for wind loads in the plane of the truss only. For studs exposed to wind (normal to the face), see Standard Industry Gable End Details as applicable, or consult qualified building designer as per ANSI/TPI 1.
- All plates are 2x4 MT20 unless otherwise indicated.
- Gable requires continuous bottom chord bearing.
- Gable studs spaced at 1-4-0 oc.
- This truss has been designed for a 10.0 psf bottom chord live load nonconcurrent with any other live loads.
- Provide mechanical connection (by others) of truss to bearing plate capable of withstanding 100 lb uplift at joint(s) 2, 36, 38, 39, 40, 41, 42, 43, 44, 45, 34, 33, 24, 32, 31, 30, 29, 28, 27, 26.
- This truss is designed in accordance with the 2018 International Residential Code sections R502.11.1 and R802.10.2 and referenced standard ANSI/TPI 1.



December 28, 2021

WARNING - Verify design parameters and READ NOTES ON THIS AND INCLUDED MITEK REFERENCE PAGE MII-7473 rev. 5/19/2020 BEFORE USE.

Design valid for use only with MiTek® connectors. This design is based only upon parameters shown, and is for an individual building component, not a truss system. Before use, the building designer must verify the applicability of design parameters and properly incorporate this design into the overall building design. Bracing indicated is to prevent buckling of individual truss web and/or chord members only. Additional temporary and permanent bracing is always required for stability and to prevent collapse with possible personal injury and property damage. For general guidance regarding the fabrication, storage, delivery, erection and bracing of trusses and truss systems, see

Safety Information available from Truss Plate Institute, 2670 Crain Highway, Suite 203 Waldorf, MD 20601


ANSI/TPI1 Quality Criteria, DSB-89 and BCSI Building Component



16023 Swingley Ridge Rd
Chesterfield, MO 63017

Job	Truss	Truss Type	Qty	Ply	C&H/159 COBEY CREEK/MO	RELEASE FOR CONSTRUCTION
3008841	A2	Common	2	1		AS NOTED FOR PLAN REVIEW
					Job Reference (optional)	DEVELOPMENT SERVICES
						LEE'S SUMMIT, MISSOURI

Builders FirstSource (Valley Center), Valley Center, KS - 67147, 8.430 s Aug 16 2021 MiTek Industries, Inc. Mon Dec 27 09:44:56 2021 Page 1
ID:xKFGJ7evN?7xhJE66FFHnCzvA57-K1Eli_stbVBi3ISyGwBB101X2oH8V4hHUpjQOy4o15 02/11/2022
0-10-8 6-10-7 13-6-0 20-1-9 27-0-0 27-10-8
0-10-8 6-10-7 6-7-9 6-7-9 6-10-7 0-10-8

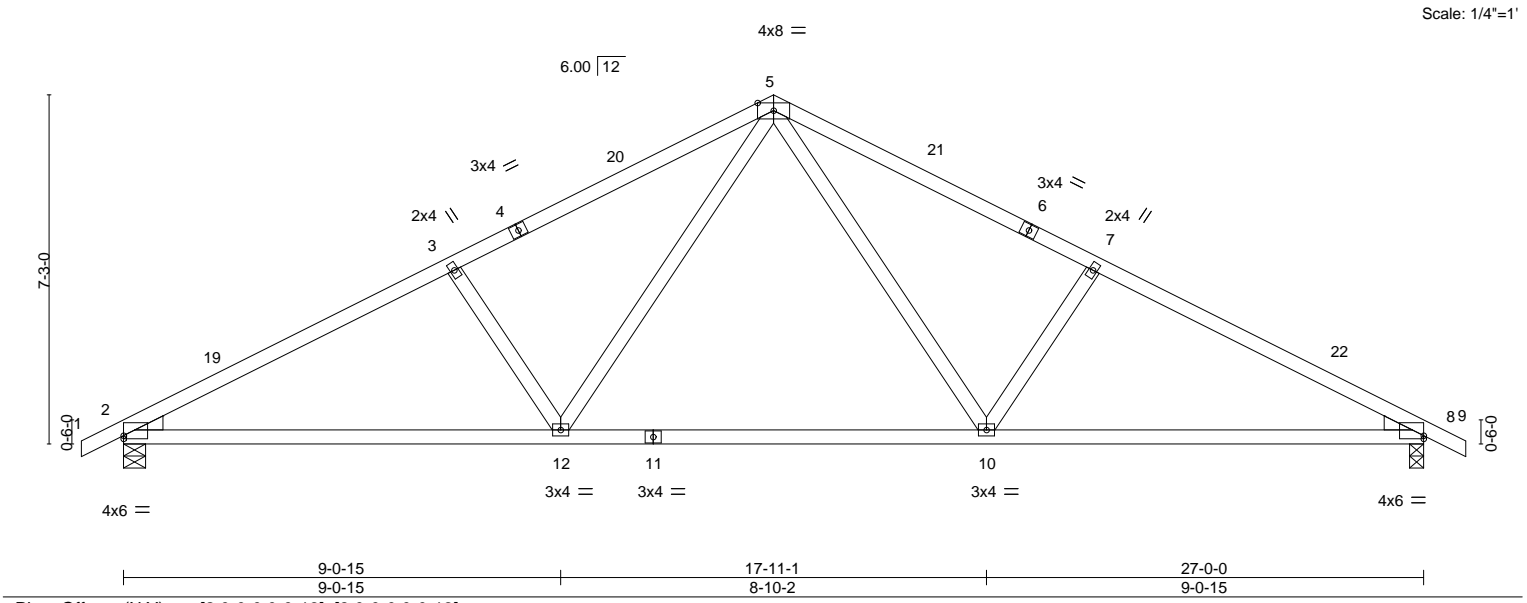

LOADING (psf)	SPACING-	2-0-0	CSI.	DEFL.	in (loc)	l/defl	L/d	PLATES	GRIP
TCLL 25.0	Plate Grip DOL	1.15	TC 0.46	Vert(LL)	-0.12 12-15	>999	240	MT20	197/144
TCDL 10.0	Lumber DOL	1.15	BC 0.68	Vert(CT)	-0.27 12-15	>999	180		
BCLL 0.0	Rep Stress Incr	YES	WB 0.17	Horz(CT)	0.06 8	n/a	n/a		
BCDL 10.0	Code IRC2018/TPI2014		Matrix-AS					Weight: 97 lb	FT = 20%

LUMBER-
TOP CHORD 2x4 SPF No.2
BOT CHORD 2x4 SPF No.2
WEBS 2x4 SPF No.2
WEDGE
Left: 2x4 SP No.3 , Right: 2x4 SP No.3

BRACING-
TOP CHORD Structural wood sheathing directly applied.
BOT CHORD Rigid ceiling directly applied.

REACTIONS. (size) 2=0-5-8, 8=0-3-8
Max Horz 2=-114(LC 13)
Max Uplift 2=-169(LC 12), 8=-169(LC 13)
Max Grav 2=1276(LC 1), 8=1276(LC 1)

FORCES. (lb) - Max. Comp./Max. Ten. - All forces 250 (lb) or less except when shown.
TOP CHORD 2-3=-2089/301, 3-5=-1838/321, 5-7=-1838/321, 7-8=-2089/301
BOT CHORD 2-12=-265/1781, 10-12=-74/1194, 8-10=-187/1781
WEBS 5-10=-135/679, 7-10=-462/220, 5-12=-135/679, 3-12=-462/220

- NOTES-**
- 1) Unbalanced roof live loads have been considered for this design.
 - 2) Wind: ASCE 7-16; Vult=115mph (3-second gust) Vasd=91mph; TCDL=6.0psf; BCDL=4.2psf; h=15ft; Cat. II; Exp C; Enclosed; MWFRS (envelope) gable end zone and C-C Exterior(2E) -0-10-8 to 2-1-8, Interior(1) 2-1-8 to 13-6-0, Exterior(2R) 13-6-0 to 16-6-0, Interior(1) 16-6-0 to 27-10-8 zone; cantilever left and right exposed ; end vertical left and right exposed; C-C for members and forces & MWFRS for reactions shown; Lumber DOL=1.60 plate grip DOL=1.60
 - 3) This truss has been designed for a 10.0 psf bottom chord live load nonconcurrent with any other live loads.
 - 4) Provide mechanical connection (by others) of truss to bearing plate capable of withstanding 100 lb uplift at joint(s) except (jt=lb) 2=169, 8=169.
 - 5) This truss is designed in accordance with the 2018 International Residential Code sections R502.11.1 and R802.10.2 and referenced standard ANSI/TPI 1.
 - 6) This truss design requires that a minimum of 7/16" structural wood sheathing be applied directly to the top chord and 1/2" gypsum sheetrock be applied directly to the bottom chord.



December 28, 2021

Job	Truss	Truss Type	Qty	Ply	C&H/159 COBEY CREEK/MO	AS NOTED FOR PLAN REVIEW DEVELOPMENT SERVICES LEE'S SUMMIT, MISSOURI
3008841	A2A	Roof Special	1	1	Job Reference (optional)	

Builders FirstSource (Valley Center),

Valley Center, KS - 67147,

8.430 s Aug 16 2021 MiTek Industries, Inc. Mon Dec 27 09:44:59 2021 Page 1

ID: xKFGJ7evN7?xhJE66FFHnCzvA57-kcwQK0uluQZHwIEUdPTvche1AklA1hm7z32N?2v-402

0-10-8 4-3-8 9-1-0 11-6-8 13-6-0 19-1-13 20-1-9 27-0-0 27-10-8
 0-10-8 4-3-8 4-9-8 2-5-8 1-11-8 5-7-13 0-11-12 6-10-7 0-10-8

Scale: 1/4"=1'

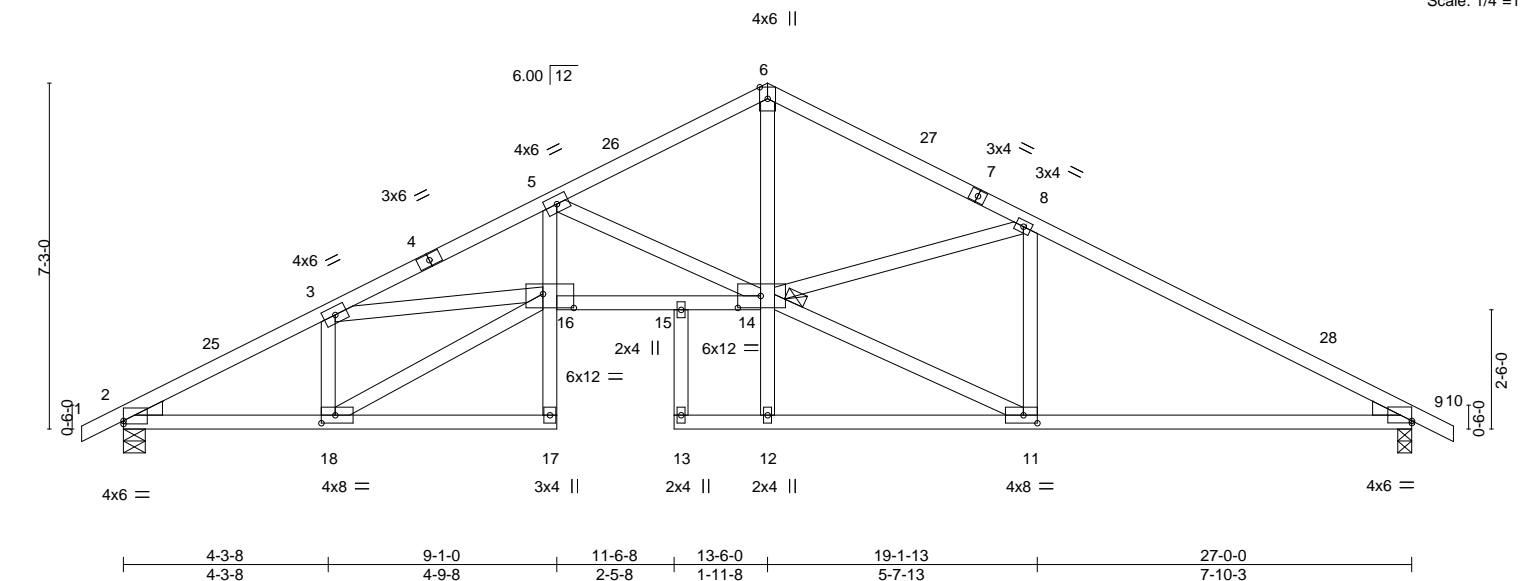


Plate Offsets (X,Y)--		[2:0-0-0,0-0-13], [9:0-0-0,0-0-9], [11:0-3-8,0-2-0], [14:0-5-12,0-3-0], [16:0-7-12,0-3-8], [18:0-3-8,0-2-0]	
LOADING (psf)	SPACING-	CSI.	DEFL.
TCLL 25.0	Plate Grip DOL 1.15	TC 0.57	in (loc) l/defl L/d
TCDL 10.0	Lumber DOL 1.15	BC 0.90	Vert(LL) -0.23 15-16 >999 240
BCLL 0.0	Rep Stress Incr YES	WB 0.81	Vert(CT) -0.41 15-16 >788 180
BCDL 10.0	Code IRC2018/TPI2014	Matrix-AS	Horz(CT) 0.23 9 n/a n/a
		PLATES MT20 GRIP 197/144	
		Weight: 122 lb FT = 20%	

LUMBER-

TOP CHORD 2x4 SPF No.2
 BOT CHORD 2x4 SPF No.2
 WEBS 2x4 SPF No.2

WEDGE

Left: 2x4 SP No.3 , Right: 2x4 SP No.3

BRACING-

TOP CHORD Structural wood sheathing directly applied.
 BOT CHORD Rigid ceiling directly applied.
 JOINTS 1 Brace at Jt(s): 14

REACTIONS.

(size) 2=0-5-8, 9=0-3-8
 Max Horz 2=114(LC 12)
 Max Uplift 2=-169(LC 12), 9=-169(LC 13)
 Max Grav 2=1276(LC 1), 9=1276(LC 1)

FORCES. (lb) - Max. Comp./Max. Ten. - All forces 250 (lb) or less except when shown.

TOP CHORD 2-3=-2180/286, 3-5=-3962/492, 5-6=-2158/300, 6-8=-2128/292, 8-9=-2044/285
 BOT CHORD 2-18=-288/1881, 5-16=-142/1287, 15-16=-409/3511, 14-15=-402/3470, 9-11=-159/1722
 WEBS 5-14=-1828/345, 6-14=-149/1522, 8-11=-578/118, 11-14=-167/1825, 3-18=-981/201,
 16-18=-321/2061, 3-16=-120/1601

NOTES-

- Unbalanced roof live loads have been considered for this design.
- Wind: ASCE 7-16; Vult=115mph (3-second gust) Vasd=91mph; TCDL=6.0psf; BCDL=4.2psf; h=15ft; Cat. II; Exp C; Enclosed; MWFRS (envelope) gable end zone and C-C Exterior(2E) -0-10-8 to 2-1-8, Interior(1) 2-1-8 to 13-6-0, Exterior(2R) 13-6-0 to 16-6-0, Interior(1) 16-6-0 to 27-10-8 zone; cantilever left and right exposed ; end vertical left and right exposed; C-C for members and forces & MWFRS for reactions shown; Lumber DOL=1.60 plate grip DOL=1.60
- This truss has been designed for a 10.0 psf bottom chord live load nonconcurrent with any other live loads.
- Provide mechanical connection (by others) of truss to bearing plate capable of withstanding 100 lb uplift at joint(s) except (jt=lb) 2=169, 9=169.
- This truss is designed in accordance with the 2018 International Residential Code sections R502.11.1 and R802.10.2 and referenced standard ANSI/TPI 1.
- This truss design requires that a minimum of 7/16" structural wood sheathing be applied directly to the top chord and 1/2" gypsum sheetrock be applied directly to the bottom chord.



December 28, 2021

WARNING - Verify design parameters and READ NOTES ON THIS AND INCLUDED MITEK REFERENCE PAGE MII-7473 rev. 5/19/2020 BEFORE USE.



Design valid for use only with MiTek® connectors. This design is based only upon parameters shown, and is for an individual building component, not a truss system. Before use, the building designer must verify the applicability of design parameters and properly incorporate this design into the overall building design. Bracing indicated is to prevent buckling of individual truss web and/or chord members only. Additional temporary and permanent bracing is always required for stability and to prevent collapse with possible personal injury and property damage. For general guidance regarding the fabrication, storage, delivery, erection and bracing of trusses and truss systems, see

ANSI/TPI1 Quality Criteria, DSB-89 and BCSI Building Component

Safety Information available from Truss Plate Institute, 2670 Crain Highway, Suite 203 Waldorf, MD 20601

16023 Swingley Ridge Rd
Chesterfield, MO 63017

Job	Truss	Truss Type	Qty	Ply	C&H/159 COBEY CREEK/MO	RELEASE FOR CONSTRUCTION
3008841	A3	Common	2	1		AS NOTED FOR PLAN REVIEW
Builders FirstSource (Valley Center), Valley Center, KS - 67147,					Job Reference (optional)	DEVELOPMENT SERVICES
					8.430 s Aug 16 2021 MiTek Industries, Inc	LEE'S SUMMIT, MISSOURI

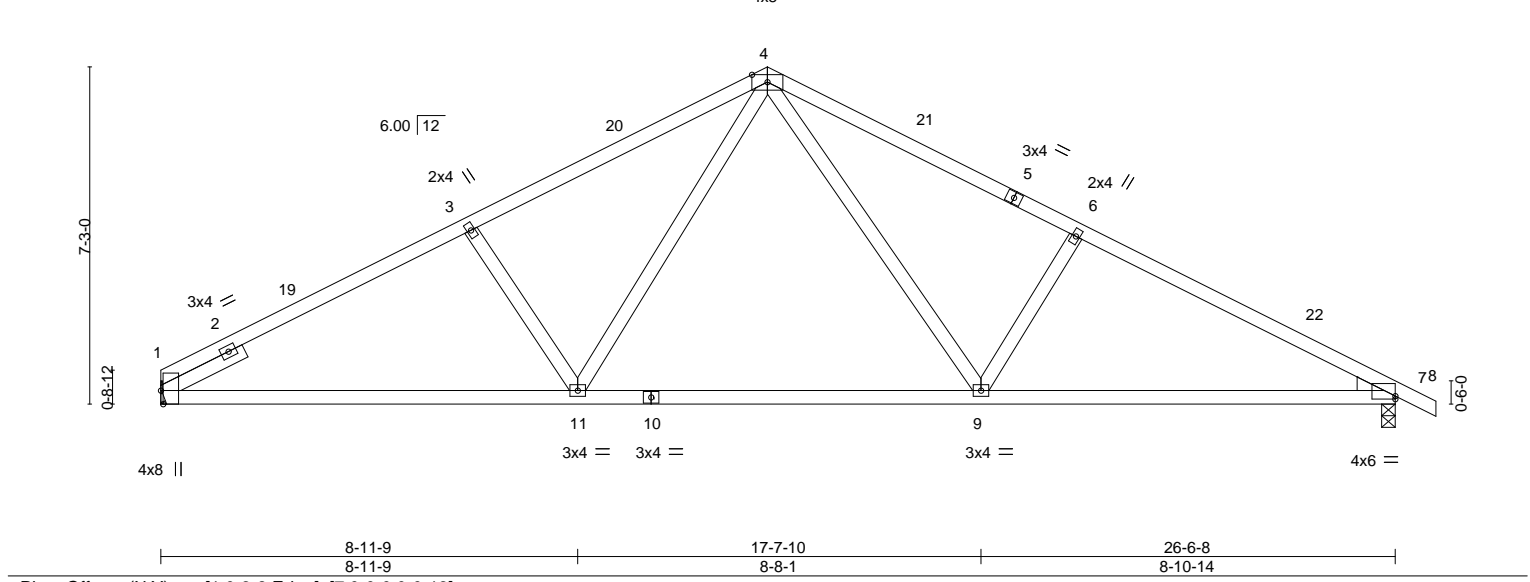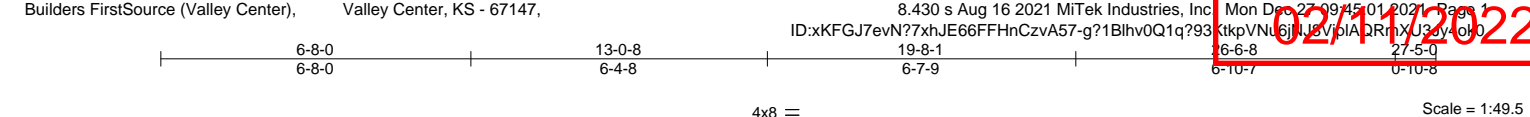

LOADING (psf)	SPACING-	2-0-0	CSI.	DEFL.	in (loc)	l/defl	L/d	PLATES	GRIP
TCLL 25.0	Plate Grip DOL	1.15	TC 0.46	Vert(LL)	-0.11 9-18	>999	240	MT20	197/144
TCDL 10.0	Lumber DOL	1.15	BC 0.66	Vert(CT)	-0.25 9-11	>999	180		
BCLL 0.0	Rep Stress Incr	YES	WB 0.18	Horz(CT)	0.06 7	n/a	n/a		
BCDL 10.0	Code IRC2018/TPI2014		Matrix-AS					Weight: 96 lb	FT = 20%

LUMBER-	BRACING-
TOP CHORD 2x4 SPF No.2	TOP CHORD Structural wood sheathing directly applied.
BOT CHORD 2x4 SPF No.2	BOT CHORD Rigid ceiling directly applied.
WEBS 2x4 SPF No.2	
WEDGE	
Right: 2x4 SP No.3	
SLIDER Left 2x4 SPF No.2 2-0-0	

REACTIONS.	(size) 1=Mechanical, 7=0-3-8
	Max Horz 1=-125(LC 13)
	Max Uplift 1=-147(LC 12), 7=-168(LC 13)
	Max Grav 1=1193(LC 1), 7=1257(LC 1)

FORCES.	(lb) - Max. Comp./Max. Ten. - All forces 250 (lb) or less except when shown.
TOP CHORD	1-3=-1901/296, 3-4=-1704/315, 4-6=-1814/325, 6-7=-2050/300
BOT CHORD	1-11=-241/1633, 9-11=-69/1156, 7-9=-188/1746
WEBS	3-11=-403/206, 4-11=-120/590, 4-9=-143/693, 6-9=-458/220

- NOTES-**
- 1) Unbalanced roof live loads have been considered for this design.
 - 2) Wind: ASCE 7-16; Vult=115mph (3-second gust) Vasd=91mph; TCDL=6.0psf; BCDL=4.2psf; h=15ft; Cat. II; Exp C; Enclosed; MWFRS (envelope) gable end zone and C-C Exterior(2E) 0-0-0 to 3-0-0, Interior(1) 3-0-0 to 13-0-8, Exterior(2R) 13-0-8 to 16-0-8, Interior(1) 16-0-8 to 27-5-0 zone; cantilever left and right exposed; end vertical left and right exposed; C-C for members and forces & MWFRS for reactions shown; Lumber DOL=1.60 plate grip DOL=1.60
 - 3) This truss has been designed for a 10.0 psf bottom chord live load nonconcurrent with any other live loads.
 - 4) Refer to girder(s) for truss to truss connections.
 - 5) Provide mechanical connection (by others) of truss to bearing plate capable of withstanding 100 lb uplift at joint(s) except (jt=lb) 1=147, 7=168.
 - 6) This truss is designed in accordance with the 2018 International Residential Code sections R502.11.1 and R802.10.2 and referenced standard ANSI/TPI 1.
 - 7) This truss design requires that a minimum of 7/16" structural wood sheathing be applied directly to the top chord and 1/2" gypsum sheetrock be applied directly to the bottom chord.




December 28, 2021

Job	Truss	Truss Type	Qty	Ply	C&H/159 COBEY CREEK/MO	RELEASE FOR CONSTRUCTION
3008841	A3A	Roof Special	1	1		AS NOTED FOR PLAN REVIEW
					Job Reference (optional)	DEVELOPMENT SERVICES
						LEE'S SUMMIT, MISSOURI

Builders FirstSource (Valley Center), Valley Center, KS - 67147,

8.430 s Aug 16 2021 MiTek Industries, Inc. Mon Dec 27 09:45:02 2021 Page 1

ID:xKFGJ7evN?7xhJE66FFHnCzvA57-8BbZz1weALysnDvIX0cQKGTz6NY3DZQCH12v4ol? 02/11/2022

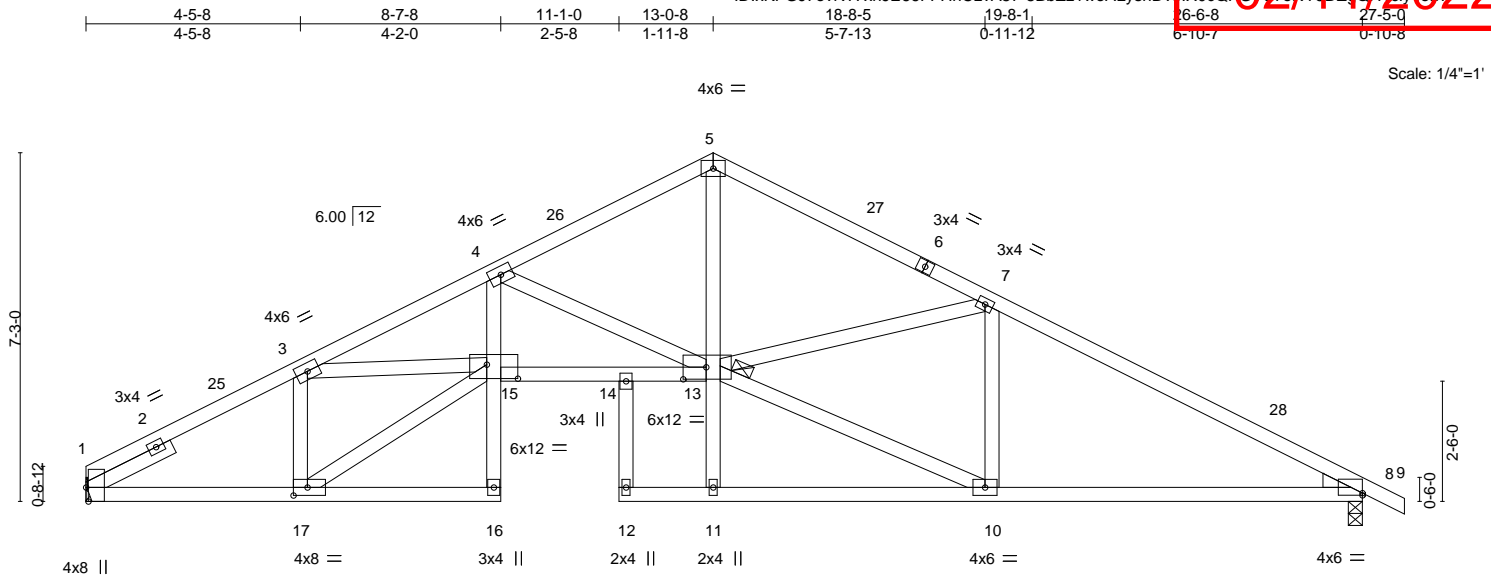

<div><div></div><div></div><div></div><div></div><div></div><div></div><div></div><div></div><div></div><div></div><div></div><div></div><div></div><div></div><div></div><div></div><div></div><div></div><div></div><div></div><div></div><div></div><div></div><div></div><div></div><div></div><div></div><div></div><div></div><div></div><div></div><div></div><div></div><div></div><div></div><div></div><div></div><div></div><div></div><div></div><div></div><div></div><div></div><div></div><div></div><div></div><div></div><div></div><div></div><div></div><div></div><div></div><div></div><div></div><div></div><div></div><div></div><div></div><div></div><div></div><div></div><div></div><div></div><div></div><div></div><div></div><div></div><div></div><---	--	--	--	--	--	--	--	--	--

LUMBER-

TOP CHORD 2x4 SPF No.2
 BOT CHORD 2x4 SPF No.2
 WEBS 2x4 SPF No.2
 WEDGE
 Right: 2x4 SP No.3
 SLIDER Left 2x4 SPF No.2 2-0-0

BRACING-

TOP CHORD Structural wood sheathing directly applied.
 BOT CHORD Rigid ceiling directly applied.
 JOINTS 1 Brace at Jt(s): 13

REACTIONS.

(size) 1=Mechanical, 8=0-3-8
 Max Horz 1=-125(LC 13)
 Max Uplift 1=-147(LC 12), 8=-168(LC 13)
 Max Grav 1=1193(LC 1), 8=1257(LC 1)

FORCES. (lb) - Max. Comp./Max. Ten. - All forces 250 (lb) or less except when shown.

TOP CHORD 1-3=-1919/279, 3-4=-3780/471, 4-5=-2088/299, 5-7=-2065/286, 7-8=-2020/286
 BOT CHORD 1-17=-253/1653, 4-15=-141/1219, 14-15=-390/3369, 13-14=-382/3322, 8-10=-165/1705
 WEBS 4-13=-1735/332, 5-13=-138/1442, 7-10=-538/118, 10-13=-172/1787, 3-17=-1024/197,
 15-17=-292/1884, 3-15=-133/1691

NOTES-

- Unbalanced roof live loads have been considered for this design.
- Wind: ASCE 7-16; Vult=115mph (3-second gust) Vasd=91mph; TCDL=6.0psf; BCDL=4.2psf; h=15ft; Cat. II; Exp C; Enclosed; MWFRS (envelope) gable end zone and C-C Exterior(2E) 0-0-0 to 3-0-0, Interior(1) 3-0-0 to 13-0-8, Exterior(2R) 13-0-8 to 16-0-8, Interior(1) 16-0-8 to 27-5-0 zone; cantilever left and right exposed ; end vertical left and right exposed;C-C for members and forces & MWFRS for reactions shown; Lumber DOL=1.60 plate grip DOL=1.60
- This truss has been designed for a 10.0 psf bottom chord live load nonconcurrent with any other live loads.
- Refer to girder(s) for truss to truss connections.
- Provide mechanical connection (by others) of truss to bearing plate capable of withstanding 100 lb uplift at joint(s) except (jt=lb) 1=147, 8=168.
- This truss is designed in accordance with the 2018 International Residential Code sections R502.11.1 and R802.10.2 and referenced standard ANSI/TPI 1.
- This truss design requires that a minimum of 7/16" structural wood sheathing be applied directly to the top chord and 1/2" gypsum sheetrock be applied directly to the bottom chord.



December 28, 2021

WARNING - Verify design parameters and READ NOTES ON THIS AND INCLUDED MITEK REFERENCE PAGE MII-7473 rev. 5/19/2020 BEFORE USE.

Design valid for use only with MiTek® connectors. This design is based only upon parameters shown, and is for an individual building component, not a truss system. Before use, the building designer must verify the applicability of design parameters and properly incorporate this design into the overall building design. Bracing indicated is to prevent buckling of individual truss web and/or chord members only. Additional temporary and permanent bracing is always required for stability and to prevent collapse with possible personal injury and property damage. For general guidance regarding the fabrication, storage, delivery, erection and bracing of trusses and truss systems, see **ANSI/TPI1 Quality Criteria, DSB-89 and BCSI Building Component Safety Information** available from Truss Plate Institute, 2670 Crain Highway, Suite 203 Waldorf, MD 20601



16023 Swingley Ridge Rd
 Chesterfield, MO 63017

Job	Truss	Truss Type	Qty	Ply	C&H/159 COBEY CREEK/MO	RELEASE FOR CONSTRUCTION
3008841	A3B	Roof Special	2	1		AS NOTED FOR PLAN REVIEW DEVELOPMENT SERVICES LEE'S SUMMIT, MISSOURI


Builders FirstSource (Valley Center), Valley Center, KS - 67147,

8.430 s Aug 16 2021 MiTek Industries, Inc. Mon Dec 27 09:45:11 2021 Page 1

ID:xKFGJ7evN?77xJE66FFHnCzvA57-Oweys61H364aM5oKwHjH084Asn99Lk4J20Fky40s

02/11/2022

Scale = 1:47.5

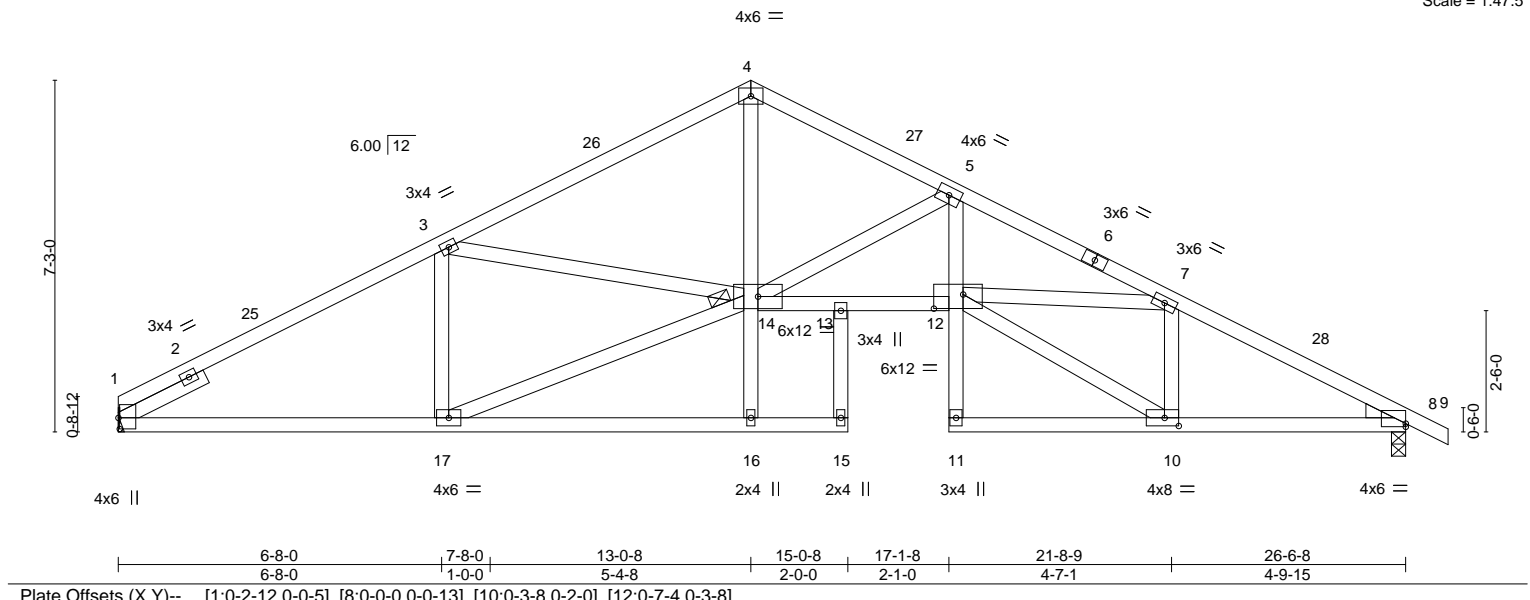

LOADING (psf)	SPACING-	2-0-0	CSI.	DEFL.	in (loc)	l/defl	L/d	PLATES	GRIP
TCLL 25.0	Plate Grip DOL	1.15	TC 0.56	Vert(LL)	-0.20	12	>999	240	MT20
TCDL 10.0	Lumber DOL	1.15	BC 0.87	Vert(CT)	-0.37	12-13	>867	180	197/144
BCLL 0.0	Rep Stress Incr	YES	WB 0.64	Horz(CT)	0.21	8	n/a	n/a	
BCDL 10.0	Code IRC2018/TPI2014		Matrix-AS						
								Weight: 123 lb	FT = 20%

LUMBER-

TOP CHORD 2x4 SPF No.2
BOT CHORD 2x4 SPF No.2
WEBS 2x4 SPF No.2
WEDGE
Right: 2x4 SP No.3
SLIDER Left 2x4 SPF No.2 2-0-0

BRACING-

TOP CHORD Structural wood sheathing directly applied.
BOT CHORD Rigid ceiling directly applied.
JOINTS 1 Brace at Jt(s): 14

REACTIONS.

(size) 1=Mechanical, 8=0-3-8
Max Horz 1=-125(LC 13)
Max Uplift 1=-147(LC 12), 8=-168(LC 13)
Max Grav 1=1193(LC 1), 8=1257(LC 1)

FORCES. (lb) - Max. Comp./Max. Ten. - All forces 250 (lb) or less except when shown.

TOP CHORD 1-3=-1918/286, 3-4=-2082/289, 4-5=-2094/296, 5-7=-3653/438, 7-8=-2125/287
BOT CHORD 1-17=-232/1645, 13-14=-257/3163, 12-13=-265/3211, 5-12=-91/1205, 8-10=-191/1826
WEBS 5-14=-1595/235, 4-14=-133/1409, 7-10=-984/153, 10-12=-216/2032, 7-12=-74/1377,
3-17=-500/134, 14-17=-242/1695, 3-14=-82/270

NOTES-

- Unbalanced roof live loads have been considered for this design.
- Wind: ASCE 7-16; Vult=115mph (3-second gust) Vasd=91mph; TCDL=6.0psf; BCDL=4.2psf; h=15ft; Cat. II; Exp C; Enclosed; MWFRS (envelope) gable end zone and C-C Exterior(2E) 0-0-0 to 3-0-0, Interior(1) 3-0-0 to 13-0-8, Exterior(2R) 13-0-8 to 16-0-8, Interior(1) 16-0-8 to 27-5-0 zone; cantilever left and right exposed; end vertical left and right exposed; C-C for members and forces & MWFRS for reactions shown; Lumber DOL=1.60 plate grip DOL=1.60
- This truss has been designed for a 10.0 psf bottom chord live load nonconcurrent with any other live loads.
- Refer to girder(s) for truss to truss connections.
- Provide mechanical connection (by others) of truss to bearing plate capable of withstanding 100 lb uplift at joint(s) except (jt=lb) 1=147, 8=168.
- This truss is designed in accordance with the 2018 International Residential Code sections R502.11.1 and R802.10.2 and referenced standard ANSI/TPI 1.
- This truss design requires that a minimum of 7/16" structural wood sheathing be applied directly to the top chord and 1/2" gypsum sheetrock be applied directly to the bottom chord.



December 28, 2021

WARNING - Verify design parameters and READ NOTES ON THIS AND INCLUDED MITEK REFERENCE PAGE MII-7473 rev. 5/19/2020 BEFORE USE.

Design valid for use only with MiTek® connectors. This design is based only upon parameters shown, and is for an individual building component, not a truss system. Before use, the building designer must verify the applicability of design parameters and properly incorporate this design into the overall building design. Bracing indicated is to prevent buckling of individual truss web and/or chord members only. Additional temporary and permanent bracing is always required for stability and to prevent collapse with possible personal injury and property damage. For general guidance regarding the fabrication, storage, delivery, erection and bracing of trusses and truss systems, see **ANSI/TPI1 Quality Criteria, DSB-89 and BCSI Building Component Safety Information** available from Truss Plate Institute, 2670 Crain Highway, Suite 203 Waldorf, MD 20601



16023 Swingley Ridge Rd
Chesterfield, MO 63017

Job	Truss	Truss Type	Qty	Ply	C&H/159 COBEY CREEK/MO	RELEASE FOR CONSTRUCTION
3008841	A4	Roof Special	4	1		AS NOTED FOR PLAN REVIEW
					Job Reference (optional)	DEVELOPMENT SERVICES
						LEE'S SUMMIT, MISSOURI

Builders FirstSource (Valley Center), Valley Center, KS - 67147, 8.430 s Aug 16 2021 MiTek Industries, Inc. Mon Dec 27 09:45:16 2021 Page 1
ID:xKFGJ7evN?7xhJE66FFHnCzvA57-ktRrvq5QteisSNJ7THuHwzBahqRoujgnky4dn 19431991
0-10-8 6-10-7 7-11-15 13-6-0 15-9-0 20-2-12 23-4-5 24-8-8 27-0-0 27-10-8
0-10-8 6-10-7 1-1-8 5-6-1 2-3-0 4-5-12 3-1-9 1-4-3 2-3-8 0-10-8

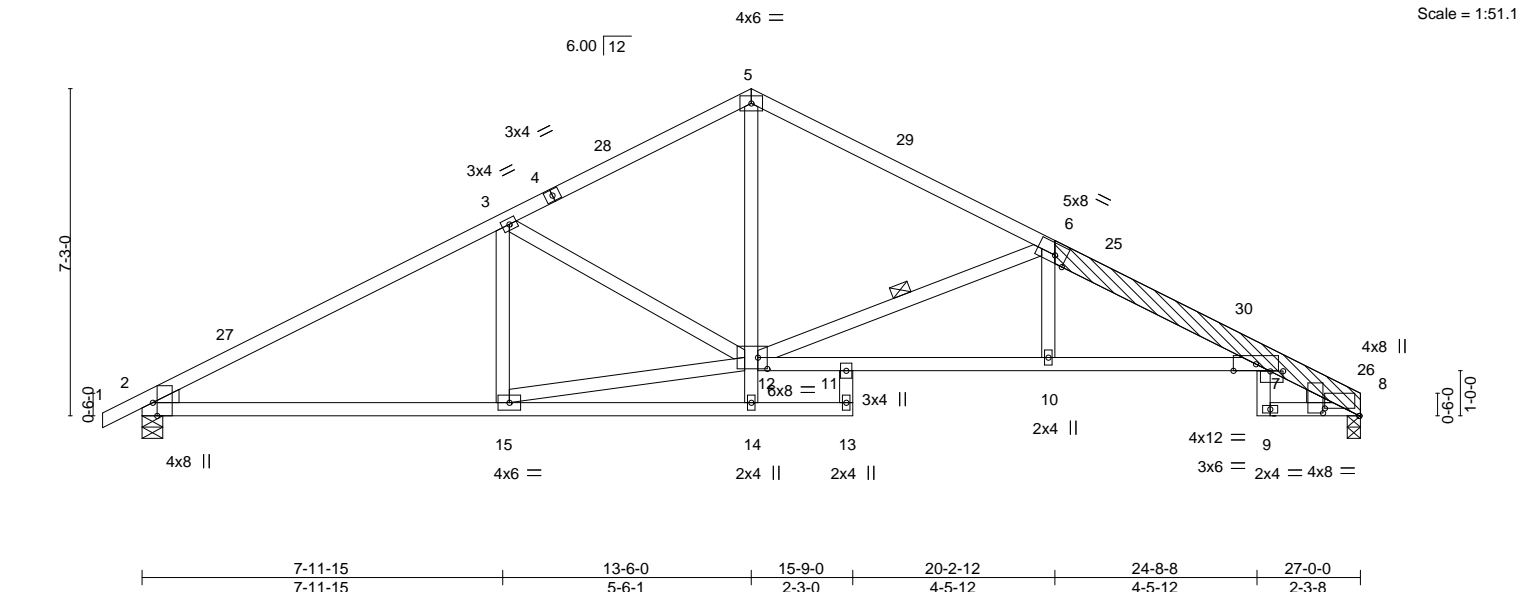


Plate Offsets (X,Y)-- [2:0-3-8,Edge], [6:0-3-0,Edge], [7:0-3-7,0-0-1], [8:0-9-3,0-2-0], [8:0-0-12,0-9-11], [12:0-2-8,0-3-0]											
LOADING (psf)		SPACING- 2-0-0		CSI.		DEFL.		in (loc) l/defl L/d		PLATES GRIP	
TCLL	25.0	Plate Grip DOL	1.15	TC	0.53	Vert(LL)	-0.19	10-21	>999	240	MT20 197/144
TCDL	10.0	Lumber DOL	1.15	BC	0.89	Vert(CT)	-0.36	10-11	>907	180	
BCLL	0.0	Rep Stress Incr	YES	WB	0.40	Horz(CT)	0.20	8	n/a	n/a	
BCDL	10.0	Code IRC2018/TPI2014		Matrix-AS							Weight: 135 lb FT = 20%

LUMBER-	BRACING-
TOP CHORD 2x4 SPF No.2 *Except*	TOP CHORD Structural wood sheathing directly applied.
6-8: 2x6 SP 2400F 2.0E	BOT CHORD Rigid ceiling directly applied.
BOT CHORD 2x4 SPF No.2	WEBS 1 Row at midpt 6-12
WEBS 2x4 SPF No.2	
OTHERS 2x6 SP 2400F 2.0E	
LBR SCAB 6-8 2x6 SP 2400F 2.0E one side	
WEDGE	
Left: 2x4 SPF No.2 , Right: 2x4 SPF No.2	

REACTIONS.	(size) 2=0-5-8, 8=0-3-8
	Max Horz 2=120(LC 16)
	Max Uplift 2=169(LC 12), 8=152(LC 13)
	Max Grav 2=1276(LC 1), 8=1212(LC 1)

FORCES.	(lb) - Max. Comp./Max. Ten. - All forces 250 (lb) or less except when shown.
TOP CHORD	2-3=-2025/287, 3-5=-1634/277, 5-6=-1687/277, 6-7=-2714/374, 7-8=-485/91
BOT CHORD	2-15=-234/1719, 11-12=-229/2467, 10-11=-272/2551, 7-10=-274/2540
WEBS	5-12=-110/1018, 12-15=-199/1615, 3-12=-483/189, 6-10=0/268, 6-12=-1233/287

- NOTES-**
- 1) Attached 7-9-8 scab 6 to 8, front face(s) 2x6 SP 2400F 2.0E with 2 row(s) of 10d (0.131"x3") nails spaced 9" o.c. except : starting at 0-0-8 from end at joint 6, nail 2 row(s) at 7" o.c. for 2-0-0; starting at 3-2-3 from end at joint 6, nail 2 row(s) at 4" o.c. for 4-4-5.
 - 2) Unbalanced roof live loads have been considered for this design.
 - 3) Wind: ASCE 7-16; Vult=115mph (3-second gust) Vasd=91mph; TCDL=6.0psf; BCDL=4.2psf; h=15ft; Cat. II; Exp C; Enclosed; MWFRS (envelope) gable end zone and C-C Exterior(2E) -0-10-8 to 2-1-8, Interior(1) 2-1-8 to 13-6-0, Exterior(2R) 13-6-0 to 16-6-0, Interior(1) 16-6-0 to 26-11-11 zone; cantilever left and right exposed ; end vertical left and right exposed; C-C for members and forces & MWFRS for reactions shown; Lumber DOL=1.60 plate grip DOL=1.60
 - 4) This truss has been designed for a 10.0 psf bottom chord live load nonconcurrent with any other live loads.
 - 5) Bearing at joint(s) 8 considers parallel to grain value using ANSI/TPI 1 angle to grain formula. Building designer should verify capacity of bearing surface.
 - 6) Provide mechanical connection (by others) of truss to bearing plate capable of withstanding 100 lb uplift at joint(s) except (jt=lb) 2=169, 8=152.
 - 7) This truss is designed in accordance with the 2018 International Residential Code sections R502.11.1 and R802.10.2 and referenced standard ANSI/TPI 1.
 - 8) This truss design requires that a minimum of 7/16" structural wood sheathing be applied directly to the top chord and 1/2" gypsum sheetrock be applied directly to the bottom chord.



December 28, 2021

Job	Truss	Truss Type	Qty	Ply	C&H/159 COBEY CREEK/MO	RELEASE FOR CONSTRUCTION
3008841	A5	Roof Special	5	1		AS NOTED FOR PLAN REVIEW
					Job Reference (optional)	DEVELOPMENT SERVICES
						LEE'S SUMMIT, MISSOURI

Builders FirstSource (Valley Center),
Valley Center, KS - 67147,

8.430 s Aug 16 2021 MiTek Industries, Inc.
Mon Dec 27 09:45:17 2021 Page 1
ID:xKFGJ7evN?7xhJE66FFHnCzvA57-C4?E6962eyrj4WZxgl6o7XUCw6wH7sqm6FQKdby4ojn
19-8-1
26-6-8
27-5-0
6-7-9
6-10-7
0-10-8

02/11/2022

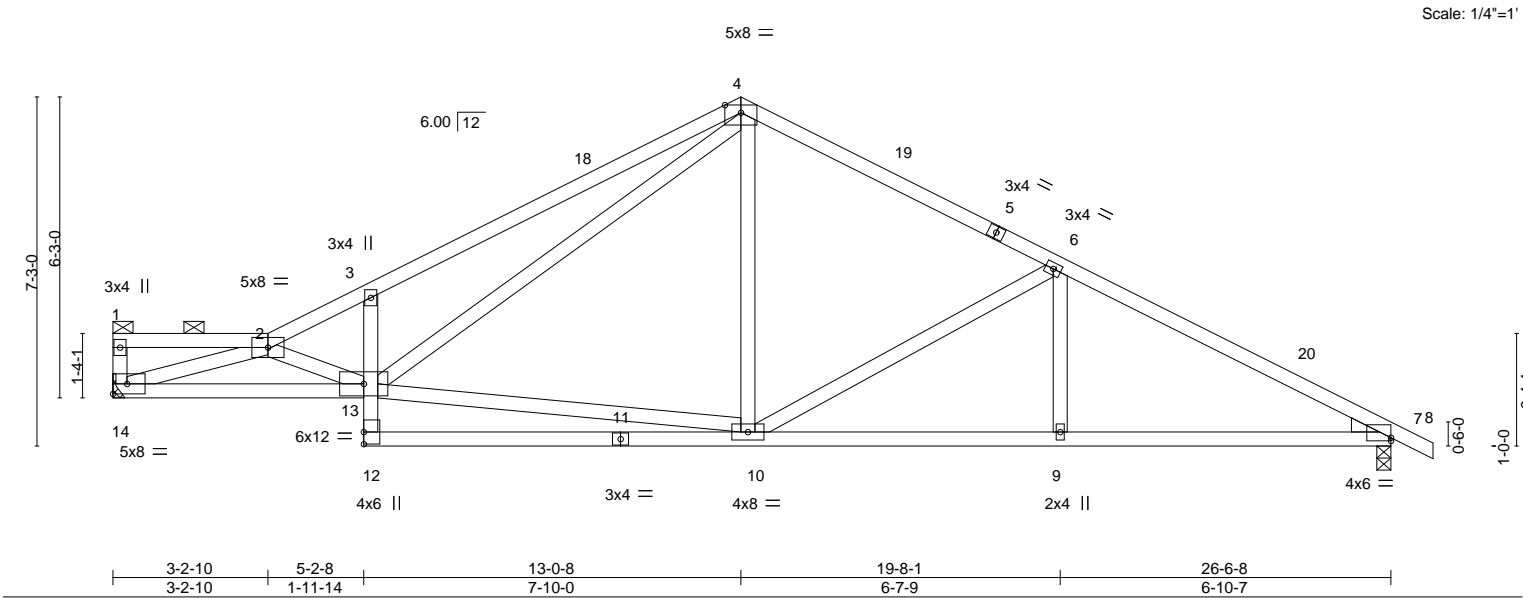


Plate Offsets (X,Y)-- [7:0-0-0,0-0-13]									
LOADING (psf)	SPACING-	2-0-0	CSI.	DEFL.	in (loc)	l/defl	L/d	PLATES	GRIP
TCLL 25.0	Plate Grip DOL	1.15	TC 0.99	Vert(LL)	-0.16 12	>999	240	MT20	197/144
TCDL 10.0	Lumber DOL	1.15	BC 0.80	Vert(CT)	-0.33 10-12	>960	180		
BCLL 0.0	Rep Stress Incr	YES	WB 0.64	Horz(CT)	-0.08 14	n/a	n/a		
BCDL 10.0	Code IRC2018/TPI2014		Matrix-AS					Weight: 115 lb	FT = 20%

LUMBER-	BRACING-
TOP CHORD 2x4 SPF No.2	TOP CHORD Structural wood sheathing directly applied, except end verticals, and
BOT CHORD 2x4 SPF No.2	2-0-0 oc purlins (6-0-0 max.): 1-2.
WEBS 2x4 SPF No.2	BOT CHORD Rigid ceiling directly applied.
WEDGE	
Right: 2x4 SP No.3	

REACTIONS.	(size) 14=Mechanical, 7=0-3-8
	Max Horz 7=140(LC 13)
	Max Uplift 14=149(LC 12), 7=167(LC 13)
	Max Grav 14=1187(LC 1), 7=1250(LC 1)

FORCES.	(lb) - Max. Comp./Max. Ten. - All forces 250 (lb) or less except when shown.
TOP CHORD	2-3=-2681/376, 3-4=-2788/517, 4-6=-1436/267, 6-7=-2048/287
BOT CHORD	13-14=-426/2912, 3-13=-511/247, 10-12=-11/317, 9-10=-278/1741, 7-9=-278/1741
WEBS	2-14=-2889/424, 10-13=-127/865, 4-13=-367/1525, 4-10=-30/445, 6-10=-673/216, 2-13=-530/84

- NOTES-**
- 1) Unbalanced roof live loads have been considered for this design.
 - 2) Wind: ASCE 7-16; Vult=115mph (3-second gust) Vasd=91mph; TCDL=6.0psf; BCDL=4.2psf; h=15ft; Cat. II; Exp C; Enclosed; MWFRS (envelope) gable end zone and C-C Exterior(2E) 0-1-12 to 3-2-10, Interior(1) 3-2-10 to 13-0-8, Exterior(2R) 13-0-8 to 16-0-8, Interior(1) 16-0-8 to 27-5-0 zone; cantilever left and right exposed ; end vertical left and right exposed; C-C for members and forces & MWFRS for reactions shown; Lumber DOL=1.60 plate grip DOL=1.60
 - 3) Provide adequate drainage to prevent water ponding.
 - 4) This truss has been designed for a 10.0 psf bottom chord live load nonconcurrent with any other live loads.
 - 5) Refer to girder(s) for truss to truss connections.
 - 6) Provide mechanical connection (by others) of truss to bearing plate capable of withstanding 100 lb uplift at joint(s) except (jt=lb) 14=149, 7=167.
 - 7) This truss is designed in accordance with the 2018 International Residential Code sections R502.11.1 and R802.10.2 and referenced standard ANSI/TPI 1.
 - 8) This truss design requires that a minimum of 7/16" structural wood sheathing be applied directly to the top chord and 1/2" gypsum sheetrock be applied directly to the bottom chord.
 - 9) Graphical purlin representation does not depict the size or the orientation of the purlin along the top and/or bottom chord.



December 28, 2021

8.430 s Aug 16 2021 MiTek Industries, Inc | Mon Dec 27 09:45:19 2021 Page 1

ID:xKFGJ7evN?7xhJE66FFHnCzvA57-9S7_Xr7IAZ5RJdiKobqbcvTZ9Odc1vb3aZvRhGy4ok

27-5-0
0-10-8

Scale: 1/4"=1'


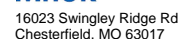


Plate Offsets (X,Y)-- [35:0-3-0,0-1-4]

Weight: 143 lb FT = 20%

TOP CHORD	Structural wood sheathing directly applied or 6-0-0 oc purlins, except end verticals.
BOT CHORD	Rigid ceiling directly applied or 10-0-0 oc bracing.

 December 28, 2021



Job	Truss	Truss Type	Qty	Ply	C&H/159 COBEY CREEK/MO
3008841	B1	Roof Special Girder	1	2	

RELEASE FOR CONSTRUCTION
AS NOTED FOR PLAN REVIEW
DEVELOPMENT SERVICES
LEE'S SUMMIT, MISSOURI

Builders FirstSource (Valley Center), Valley Center, KS - 67147, 8.430 s Aug 16 2021 MiTek Industries, Inc. Mon Dec 27 09:45:22 2021 Page 1
ID:xKFGJ7evN77xhJE66FFHnCzvA57-Z1p79tABTUT0AJRvTkNE75-BaIE4WGX75f0y4ch

02/11/2022

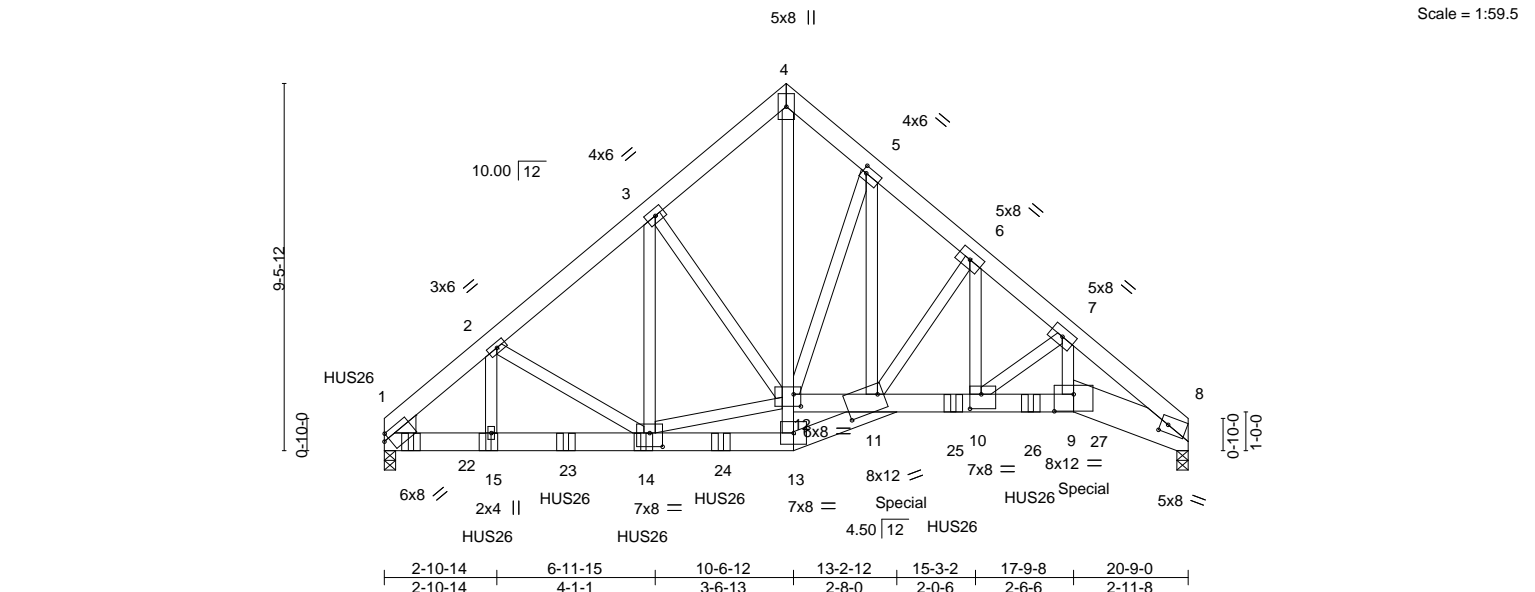


Plate Offsets (X,Y)--	[1:0-1-10,0-1-14], [5:0-1-4,0-2-0], [8:0-2-4,0-2-8], [9:0-6-0,0-5-4], [10:0-3-8,0-4-8], [11:0-10-4,0-4-12], [12:0-2-4,0-3-12], [14:0-4-0,0-4-4]
-----------------------	---

LOADING (psf)	SPACING-	2-0-0	CSI.	DEFL.	in (loc)	l/defl	L/d	PLATES	GRIP
TCLL 25.0	Plate Grip DOL	1.15	TC 0.38	Vert(LL)	-0.10 10-11	>999	240	MT20	197/144
TCDL 10.0	Lumber DOL	1.15	BC 0.53	Vert(CT)	-0.20 10-11	>999	180		
BCLL 0.0	Rep Stress Incr	NO	WB 0.86	Horz(CT)	-0.10 1	n/a	n/a		
BCDL 10.0	Code IRC2018/TPI2014		Matrix-MS					Weight: 354 lb	FT = 20%

LUMBER-
TOP CHORD 2x6 SPF No.2 *Except*
4-8: 2x6 SP 2400F 2.0E
BOT CHORD 2x6 SP 2400F 2.0E *Except*
9-12: 2x6 SPF 2100F 1.8E, 8-9: 2x10 SP 2400F 2.0E
WEBS 2x4 SPF No.2
WEDGE
Left: 2x6 SP No.2

BRACING-
TOP CHORD Structural wood sheathing directly applied or 5-0-4 oc purlins.
BOT CHORD Rigid ceiling directly applied or 10-0-0 oc bracing.

REACTIONS. (size) 1=0-3-8, 8=0-3-8
Max Horz 8=203(LC 27)
Max Uplift 1=262(LC 8), 8=137(LC 9)
Max Grav 1=7207(LC 1), 8=6397(LC 1)

FORCES. (lb) - Max. Comp./Max. Ten. - All forces 250 (lb) or less except when shown.
TOP CHORD 1-2=-8586/216, 2-3=-7287/12, 3-4=-5689/0, 4-5=-5687/0, 5-6=-7390/0, 6-7=-9443/23, 7-8=-12280/239
BOT CHORD 1-15=-126/6411, 14-15=-126/6411, 13-14=0/2044, 11-13=0/2114, 11-12=-219/3524, 10-11=-19/7356, 9-10=-235/8965, 8-9=-299/9692
WEBS 3-14=-395/2374, 12-13=-328/0, 4-12=0/6672, 5-11=-226/4312, 12-14=-334/3570, 3-12=-1918/467, 5-12=-3179/313, 2-14=-1041/330, 2-15=-263/1403, 6-10=-374/3475, 6-11=-3204/381, 7-9=-258/3336, 7-10=-2054/277

- NOTES-**
- 2-ply truss to be connected together with 10d (0.131"x3") nails as follows:
Top chords connected as follows: 2x6 - 2 rows staggered at 0-9-0 oc.
Bottom chords connected as follows: 2x6 - 2 rows staggered at 0-2-0 oc, 2x10 - 2 rows staggered at 0-8-0 oc.
Webs connected as follows: 2x4 - 1 row at 0-9-0 oc.
 - All loads are considered equally applied to all plies, except if noted as front (F) or back (B) face in the LOAD CASE(S) section. Ply to ply connections have been provided to distribute only loads noted as (F) or (B), unless otherwise indicated.
 - Unbalanced roof live loads have been considered for this design.
 - Wind: ASCE 7-16; Vult=115mph (3-second gust) Vasd=91mph; TCDL=6.0psf; BCDL=4.2psf; h=15ft; Cat. II; Exp C; Enclosed; MWFRS (envelope) gable end zone; cantilever left and right exposed; end vertical left and right exposed; Lumber DOL=1.60 plate grip DOL=1.60
 - This truss has been designed for a 10.0 psf bottom chord live load nonconcurrent with any other live loads.
 - Bearing at joint(s) 8 considers parallel to grain value using ANSI/TPI 1 angle to grain formula. Building designer should verify capacity of bearing surface.
 - Provide mechanical connection (by others) of truss to bearing plate capable of withstanding 100 lb uplift at joint(s) except (jt=lb) 1=262, 8=137.
 - This truss is designed in accordance with the 2018 International Residential Code sections R502.11.1 and R802.10.2 and referenced standard ANSI/TPI 1.



December 28, 2021

Job	Truss	Truss Type	Qty	Ply	C&H/159 COBEY CREEK/MO	AS NOTED FOR PLAN REVIEW DEVELOPMENT SERVICES LEE'S SUMMIT, MISSOURI
3008841	B1	Roof Special Girder	1	2	Job Reference (optional)	19431994

Builders FirstSource (Valley Center), Valley Center, KS - 67147,

8.430 s Aug 16 2021 MiTek Industries, Inc. Mon Dec 27 09:45:22 2021 Page 3

ID:xKFGJ7evN?7xhJE66FFHnCzvA57-Z1p79tABTUT0JIRvTkNE75_BdIE4WGX75bW4ch

02/11/2022

NOTES-

- 9) Load case(s) 1, 2, 3, 39, 40 has/have been modified. Building designer must review loads to verify that they are correct for the intended use of this truss.
- 10) Use Simpson Strong-Tie HUS26 (14-10d Girder, 4-10d Truss) or equivalent spaced at 2-0-0 oc max. starting at 0-8-4 from the left end to 8-8-4 to connect truss(es) to front face of bottom chord.
- 11) Use Simpson Strong-Tie HUS26 (14-10d Girder, 4-10d Truss) or equivalent spaced at 2-0-0 oc max. starting at 14-8-4 from the left end to 16-8-4 to connect truss(es) to front face of bottom chord.
- 12) Fill all nail holes where hanger is in contact with lumber.
- 13) Hanger(s) or other connection device(s) shall be provided sufficient to support concentrated load(s) 1167 lb down and 169 lb up at 12-7-0, and 1167 lb down and 169 lb up at 18-8-4 on bottom chord. The design/selection of such connection device(s) is the responsibility of others.

LOAD CASE(S) Standard

- 1) Dead + Roof Live (balanced): Lumber Increase=1.15, Plate Increase=1.15
Uniform Loads (plf)
Vert: 1-4=-70, 4-8=-70, 13-16=-20, 11-13=-20, 9-11=-20, 9-19=-20
Concentrated Loads (lb)
Vert: 12=-1200(F) 14=-1173(F) 11=-1167(F) 15=-1173(F) 22=-1176(F) 23=-1173(F) 24=-1173(F) 25=-1167(F) 26=-1167(F) 27=-1167(F)
- 2) Dead + 0.75 Roof Live (balanced): Lumber Increase=1.15, Plate Increase=1.15
Uniform Loads (plf)
Vert: 1-4=-58, 4-8=-58, 13-16=-20, 11-13=-20, 9-11=-20, 9-19=-20
Concentrated Loads (lb)
Vert: 12=-1200(F) 14=-1008(F) 11=-1002(F) 15=-1008(F) 22=-1011(F) 23=-1008(F) 24=-1008(F) 25=-1002(F) 26=-1002(F) 27=-1002(F)
- 3) Dead + Uninhabitable Attic Without Storage: Lumber Increase=1.25, Plate Increase=1.25
Uniform Loads (plf)
Vert: 1-4=-20, 4-8=-20, 13-16=-40, 11-13=-40, 9-11=-40, 9-19=-40
Concentrated Loads (lb)
Vert: 12=-1200(F) 14=-756(F) 11=-752(F) 15=-756(F) 22=-762(F) 23=-756(F) 24=-756(F) 25=-752(F) 26=-752(F) 27=-752(F)
- 4) Dead + 0.6 MWFRS Wind (Pos. Internal) Left: Lumber Increase=1.60, Plate Increase=1.60
Uniform Loads (plf)
Vert: 1-4=-15, 4-8=9, 13-16=-8, 11-13=-8, 9-11=-8, 9-19=-8
Horz: 1-4=3, 4-8=21
Concentrated Loads (lb)
Vert: 12=-1200(F) 14=155(F) 11=157(F) 15=155(F) 22=154(F) 23=155(F) 24=155(F) 25=157(F) 26=157(F) 27=157(F)
- 5) Dead + 0.6 MWFRS Wind (Pos. Internal) Right: Lumber Increase=1.60, Plate Increase=1.60
Uniform Loads (plf)
Vert: 1-4=9, 4-8=-15, 13-16=-8, 11-13=-8, 9-11=-8, 9-19=-8
Horz: 1-4=-21, 4-8=-3
Concentrated Loads (lb)
Vert: 12=-1200(F) 14=155(F) 11=157(F) 15=155(F) 22=154(F) 23=155(F) 24=155(F) 25=157(F) 26=157(F) 27=157(F)
- 6) Dead + 0.6 MWFRS Wind (Neg. Internal) Left: Lumber Increase=1.60, Plate Increase=1.60
Uniform Loads (plf)
Vert: 1-4=-33, 4-8=-10, 13-16=-20, 11-13=-20, 9-11=-20, 9-19=-20
Horz: 1-4=13, 4-8=10
Concentrated Loads (lb)
Vert: 12=-1200(F) 14=167(F) 11=169(F) 15=167(F) 22=164(F) 23=167(F) 24=167(F) 25=169(F) 26=169(F) 27=169(F)
- 7) Dead + 0.6 MWFRS Wind (Neg. Internal) Right: Lumber Increase=1.60, Plate Increase=1.60
Uniform Loads (plf)
Vert: 1-4=-10, 4-8=-33, 13-16=-20, 11-13=-20, 9-11=-20, 9-19=-20
Horz: 1-4=-10, 4-8=-13
Concentrated Loads (lb)
Vert: 12=-1200(F) 14=167(F) 11=169(F) 15=167(F) 22=164(F) 23=167(F) 24=167(F) 25=169(F) 26=169(F) 27=169(F)
- 8) Dead + 0.6 MWFRS Wind (Pos. Internal) 1st Parallel: Lumber Increase=1.60, Plate Increase=1.60
Uniform Loads (plf)
Vert: 1-4=25, 4-8=9, 13-16=-8, 11-13=-8, 9-11=-8, 9-19=-8
Horz: 1-4=-37, 4-8=21
Concentrated Loads (lb)
Vert: 12=-1200(F) 14=155(F) 11=157(F) 15=155(F) 22=154(F) 23=155(F) 24=155(F) 25=157(F) 26=157(F) 27=157(F)
- 9) Dead + 0.6 MWFRS Wind (Pos. Internal) 2nd Parallel: Lumber Increase=1.60, Plate Increase=1.60
Uniform Loads (plf)
Vert: 1-4=9, 4-8=25, 13-16=-8, 11-13=-8, 9-11=-8, 9-19=-8
Horz: 1-4=-21, 4-8=37
Concentrated Loads (lb)
Vert: 12=-1200(F) 14=155(F) 11=157(F) 15=155(F) 22=154(F) 23=155(F) 24=155(F) 25=157(F) 26=157(F) 27=157(F)
- 10) Dead + 0.6 MWFRS Wind (Pos. Internal) 3rd Parallel: Lumber Increase=1.60, Plate Increase=1.60
Uniform Loads (plf)
Vert: 1-4=14, 4-8=4, 13-16=-8, 11-13=-8, 9-11=-8, 9-19=-8
Horz: 1-4=-26, 4-8=16
Concentrated Loads (lb)
Vert: 12=-1200(F) 14=155(F) 11=157(F) 15=155(F) 22=154(F) 23=155(F) 24=155(F) 25=157(F) 26=157(F) 27=157(F)
- 11) Dead + 0.6 MWFRS Wind (Pos. Internal) 4th Parallel: Lumber Increase=1.60, Plate Increase=1.60
Uniform Loads (plf)
Vert: 1-4=4, 4-8=14, 13-16=-8, 11-13=-8, 9-11=-8, 9-19=-8
Horz: 1-4=-16, 4-8=26
Concentrated Loads (lb)
Vert: 12=-1200(F) 14=155(F) 11=157(F) 15=155(F) 22=154(F) 23=155(F) 24=155(F) 25=157(F) 26=157(F) 27=157(F)
- 12) Dead + 0.6 MWFRS Wind (Neg. Internal) 1st Parallel: Lumber Increase=1.60, Plate Increase=1.60

Continued on page 3

WARNING - Verify design parameters and READ NOTES ON THIS AND INCLUDED MITEK REFERENCE PAGE MII-7473 rev. 5/19/2020 BEFORE USE.

Design valid for use only with MiTek® connectors. This design is based only upon parameters shown, and is for an individual building component, not a truss system. Before use, the building designer must verify the applicability of design parameters and properly incorporate this design into the overall building design. Bracing indicated is to prevent buckling of individual truss web and/or chord members only. Additional temporary and permanent bracing is always required for stability and to prevent collapse with possible personal injury and property damage. For general guidance regarding the fabrication, storage, delivery, erection and bracing of trusses and truss systems, see

ANSI/TPI Quality Criteria, DSB-89 and BCSI Building Component**Safety Information** available from Truss Plate Institute, 2670 Crain Highway, Suite 203 Waldorf, MD 2060116023 Swingley Ridge Rd
Chesterfield, MO 63017

Job	Truss	Truss Type	Qty	Ply	C&H/159 COBEY CREEK/MO	AS NOTED FOR PLAN REVIEW DEVELOPMENT SERVICES LEE'S SUMMIT, MISSOURI
3008841	B1	Roof Special Girder	1	2	Job Reference (optional)	14921994

Builders FirstSource (Valley Center), Valley Center, KS - 67147,

8.430 s Aug 16 2021 MiTek Industries, Inc. Mon Dec 27 09:45:22 2021 Page 3

ID:xKFGJ7evN?7xhJE66FFHnCzvA57-Z1p79tABTUT0AJRvTkNE75_BaIE#WGX75toV4ch

02/11/2022

LOAD CASE(S) Standard

Uniform Loads (plf)

Vert: 1-4=6, 4-8=-10, 13-16=-20, 11-13=-20, 9-11=-20, 9-19=-20

Horz: 1-4=-26, 4-8=10

Concentrated Loads (lb)

Vert: 12=-1200(F) 14=167(F) 11=169(F) 15=167(F) 22=164(F) 23=167(F) 24=167(F) 25=169(F) 26=169(F) 27=169(F)

- 13) Dead + 0.6 MWFRS Wind (Neg. Internal) 2nd Parallel: Lumber Increase=1.60, Plate Increase=1.60

Uniform Loads (plf)

Vert: 1-4=-10, 4-8=6, 13-16=-20, 11-13=-20, 9-11=-20, 9-19=-20

Horz: 1-4=-10, 4-8=26

Concentrated Loads (lb)

Vert: 12=-1200(F) 14=167(F) 11=169(F) 15=167(F) 22=164(F) 23=167(F) 24=167(F) 25=169(F) 26=169(F) 27=169(F)

- 14) Dead: Lumber Increase=0.90, Plate Increase=0.90 Plt. metal=0.90

Uniform Loads (plf)

Vert: 1-4=-20, 4-8=-20, 13-16=-20, 11-13=-20, 9-11=-20, 9-19=-20

Concentrated Loads (lb)

Vert: 12=-1200(F) 14=-511(F) 11=-508(F) 15=-511(F) 22=-514(F) 23=-511(F) 24=-511(F) 25=-508(F) 26=-508(F) 27=-508(F)

- 15) Dead + 0.75 Roof Live (bal.) + 0.75(0.6 MWFRS Wind (Neg. Int) Left): Lumber Increase=1.60, Plate Increase=1.60

Uniform Loads (plf)

Vert: 1-4=-67, 4-8=-50, 13-16=-20, 11-13=-20, 9-11=-20, 9-19=-20

Horz: 1-4=10, 4-8=8

Concentrated Loads (lb)

Vert: 12=-1200(F) 14=63(F) 11=64(F) 15=63(F) 22=59(F) 23=63(F) 24=63(F) 25=64(F) 26=64(F) 27=64(F)

- 16) Dead + 0.75 Roof Live (bal.) + 0.75(0.6 MWFRS Wind (Neg. Int) Right): Lumber Increase=1.60, Plate Increase=1.60

Uniform Loads (plf)

Vert: 1-4=-50, 4-8=-67, 13-16=-20, 11-13=-20, 9-11=-20, 9-19=-20

Horz: 1-4=-8, 4-8=-10

Concentrated Loads (lb)

Vert: 12=-1200(F) 14=63(F) 11=64(F) 15=63(F) 22=59(F) 23=63(F) 24=63(F) 25=64(F) 26=64(F) 27=64(F)

- 17) Dead + 0.75 Roof Live (bal.) + 0.75(0.6 MWFRS Wind (Neg. Int) 1st Parallel): Lumber Increase=1.60, Plate Increase=1.60

Uniform Loads (plf)

Vert: 1-4=-38, 4-8=-50, 13-16=-20, 11-13=-20, 9-11=-20, 9-19=-20

Horz: 1-4=-20, 4-8=8

Concentrated Loads (lb)

Vert: 12=-1200(F) 14=63(F) 11=64(F) 15=63(F) 22=59(F) 23=63(F) 24=63(F) 25=64(F) 26=64(F) 27=64(F)

- 18) Dead + 0.75 Roof Live (bal.) + 0.75(0.6 MWFRS Wind (Neg. Int) 2nd Parallel): Lumber Increase=1.60, Plate Increase=1.60

Uniform Loads (plf)

Vert: 1-4=-50, 4-8=-38, 13-16=-20, 11-13=-20, 9-11=-20, 9-19=-20

Horz: 1-4=-8, 4-8=20

Concentrated Loads (lb)

Vert: 12=-1200(F) 14=63(F) 11=64(F) 15=63(F) 22=59(F) 23=63(F) 24=63(F) 25=64(F) 26=64(F) 27=64(F)

- 19) Dead + 0.6 MWFRS Wind Min. Left: Lumber Increase=1.60, Plate Increase=1.60

Uniform Loads (plf)

Vert: 1-4=-17, 4-8=-12, 13-16=-8, 11-13=-8, 9-11=-8, 9-19=-8

Horz: 1-4=5

Concentrated Loads (lb)

Vert: 12=-1200(F) 14=85(F) 11=88(F) 15=85(F) 22=84(F) 23=85(F) 24=85(F) 25=88(F) 26=88(F) 27=88(F)

- 20) Dead + 0.6 MWFRS Wind Min. Right: Lumber Increase=1.60, Plate Increase=1.60

Uniform Loads (plf)

Vert: 1-4=-12, 4-8=-17, 13-16=-8, 11-13=-8, 9-11=-8, 9-19=-8

Horz: 4-8=5

Concentrated Loads (lb)

Vert: 12=-1200(F) 14=85(F) 11=88(F) 15=85(F) 22=84(F) 23=85(F) 24=85(F) 25=88(F) 26=88(F) 27=88(F)

- 21) 1st Dead + Roof Live (unbalanced): Lumber Increase=1.15, Plate Increase=1.15

Uniform Loads (plf)

Vert: 1-4=-70, 4-8=-20, 13-16=-20, 11-13=-20, 9-11=-20, 9-19=-20

Concentrated Loads (lb)

Vert: 12=-1200(F) 14=-1173(F) 11=-1167(F) 15=-1173(F) 22=-1176(F) 23=-1173(F) 24=-1173(F) 25=-1167(F) 26=-1167(F) 27=-1167(F)

- 22) 2nd Dead + Roof Live (unbalanced): Lumber Increase=1.15, Plate Increase=1.15

Uniform Loads (plf)

Vert: 1-4=-20, 4-8=-70, 13-16=-20, 11-13=-20, 9-11=-20, 9-19=-20

Concentrated Loads (lb)

Vert: 12=-1200(F) 14=-1173(F) 11=-1167(F) 15=-1173(F) 22=-1176(F) 23=-1173(F) 24=-1173(F) 25=-1167(F) 26=-1167(F) 27=-1167(F)

- 23) 3rd Dead + 0.75 Roof Live (unbalanced): Lumber Increase=1.15, Plate Increase=1.15

Uniform Loads (plf)

Vert: 1-4=-58, 4-8=-20, 13-16=-20, 11-13=-20, 9-11=-20, 9-19=-20

Concentrated Loads (lb)

Vert: 12=-1200(F) 14=-1008(F) 11=-1002(F) 15=-1008(F) 22=-1011(F) 23=-1008(F) 24=-1008(F) 25=-1002(F) 26=-1002(F) 27=-1002(F)

- 24) 4th Dead + 0.75 Roof Live (unbalanced): Lumber Increase=1.15, Plate Increase=1.15

Uniform Loads (plf)

Vert: 1-4=-20, 4-8=-58, 13-16=-20, 11-13=-20, 9-11=-20, 9-19=-20

Continued on page 4.

WARNING - Verify design parameters and READ NOTES ON THIS AND INCLUDED MITEK REFERENCE PAGE MII-7473 rev. 5/19/2020 BEFORE USE.

Design valid for use only with MiTek® connectors. This design is based only upon parameters shown, and is for an individual building component, not a truss system. Before use, the building designer must verify the applicability of design parameters and properly incorporate this design into the overall building design. Bracing indicated is to prevent buckling of individual truss web and/or chord members only. Additional temporary and permanent bracing is always required for stability and to prevent collapse with possible personal injury and property damage. For general guidance regarding the fabrication, storage, delivery, erection and bracing of trusses and truss systems, see

ANSI/TPI Quality Criteria, DSB-89 and BCSI Building Component**Safety Information** available from Truss Plate Institute, 2670 Crain Highway, Suite 203 Waldorf, MD 2060116023 Swingley Ridge Rd
Chesterfield, MO 63017

Job	Truss	Truss Type	Qty	Ply	C&H/159 COBEY CREEK/MO	AS NOTED FOR PLAN REVIEW DEVELOPMENT SERVICES LEE'S SUMMIT, MISSOURI
3008841	B1	Roof Special Girder	1	2	Job Reference (optional)	19931994

Builders FirstSource (Valley Center), Valley Center, KS - 67147,

8.430 s Aug 16 2021 MiTek Industries, Inc. Mon Dec 27 09:45:22 2021 Page 4
ID:xKFGJ7evN?7xhJE66FFHnCzvA57-Z1p79tABTUT0AJRvTKNE75_BaIE#WGX75toY4ch

02/11/2022

LOAD CASE(S) Standard

Concentrated Loads (lb)

Vert: 12=-1200(F) 14=-1008(F) 11=-1002(F) 15=-1008(F) 22=-1011(F) 23=-1008(F) 24=-1008(F) 25=-1002(F) 26=-1002(F) 27=-1002(F)

25) Reversal: Dead + 0.6 MWFRS Wind (Pos. Internal) Left: Lumber Increase=1.60, Plate Increase=1.60

Uniform Loads (plf)

Vert: 1-4=-15, 4-8=9, 13-16=-8, 11-13=-8, 9-11=-8, 9-19=-8

Horz: 1-4=3, 4-8=21

Concentrated Loads (lb)

Vert: 12=-1200(F) 14=-499(F) 11=-460(F) 15=-499(F) 22=-500(F) 23=-499(F) 24=-499(F) 25=-460(F) 26=-460(F) 27=-460(F)

26) Reversal: Dead + 0.6 MWFRS Wind (Pos. Internal) Right: Lumber Increase=1.60, Plate Increase=1.60

Uniform Loads (plf)

Vert: 1-4=9, 4-8=-15, 13-16=-8, 11-13=-8, 9-11=-8, 9-19=-8

Horz: 1-4=-21, 4-8=-3

Concentrated Loads (lb)

Vert: 12=-1200(F) 14=-499(F) 11=-460(F) 15=-499(F) 22=-500(F) 23=-499(F) 24=-499(F) 25=-460(F) 26=-460(F) 27=-460(F)

27) Reversal: Dead + 0.6 MWFRS Wind (Neg. Internal) Left: Lumber Increase=1.60, Plate Increase=1.60

Uniform Loads (plf)

Vert: 1-4=-33, 4-8=-10, 13-16=-20, 11-13=-20, 9-11=-20, 9-19=-20

Horz: 1-4=13, 4-8=10

Concentrated Loads (lb)

Vert: 12=-1200(F) 14=-487(F) 11=-449(F) 15=-487(F) 22=-491(F) 23=-487(F) 24=-487(F) 25=-449(F) 26=-449(F) 27=-449(F)

28) Reversal: Dead + 0.6 MWFRS Wind (Neg. Internal) Right: Lumber Increase=1.60, Plate Increase=1.60

Uniform Loads (plf)

Vert: 1-4=-10, 4-8=-33, 13-16=-20, 11-13=-20, 9-11=-20, 9-19=-20

Horz: 1-4=-10, 4-8=-13

Concentrated Loads (lb)

Vert: 12=-1200(F) 14=-487(F) 11=-449(F) 15=-487(F) 22=-491(F) 23=-487(F) 24=-487(F) 25=-449(F) 26=-449(F) 27=-449(F)

29) Reversal: Dead + 0.6 MWFRS Wind (Pos. Internal) 1st Parallel: Lumber Increase=1.60, Plate Increase=1.60

Uniform Loads (plf)

Vert: 1-4=25, 4-8=9, 13-16=-8, 11-13=-8, 9-11=-8, 9-19=-8

Horz: 1-4=-37, 4-8=21

Concentrated Loads (lb)

Vert: 12=-1200(F) 14=-499(F) 11=-460(F) 15=-499(F) 22=-500(F) 23=-499(F) 24=-499(F) 25=-460(F) 26=-460(F) 27=-460(F)

30) Reversal: Dead + 0.6 MWFRS Wind (Pos. Internal) 2nd Parallel: Lumber Increase=1.60, Plate Increase=1.60

Uniform Loads (plf)

Vert: 1-4=9, 4-8=25, 13-16=-8, 11-13=-8, 9-11=-8, 9-19=-8

Horz: 1-4=-21, 4-8=37

Concentrated Loads (lb)

Vert: 12=-1200(F) 14=-499(F) 11=-460(F) 15=-499(F) 22=-500(F) 23=-499(F) 24=-499(F) 25=-460(F) 26=-460(F) 27=-460(F)

31) Reversal: Dead + 0.6 MWFRS Wind (Pos. Internal) 3rd Parallel: Lumber Increase=1.60, Plate Increase=1.60

Uniform Loads (plf)

Vert: 1-4=14, 4-8=4, 13-16=-8, 11-13=-8, 9-11=-8, 9-19=-8

Horz: 1-4=-26, 4-8=16

Concentrated Loads (lb)

Vert: 12=-1200(F) 14=-499(F) 11=-460(F) 15=-499(F) 22=-500(F) 23=-499(F) 24=-499(F) 25=-460(F) 26=-460(F) 27=-460(F)

32) Reversal: Dead + 0.6 MWFRS Wind (Pos. Internal) 4th Parallel: Lumber Increase=1.60, Plate Increase=1.60

Uniform Loads (plf)

Vert: 1-4=4, 4-8=14, 13-16=-8, 11-13=-8, 9-11=-8, 9-19=-8

Horz: 1-4=-16, 4-8=26

Concentrated Loads (lb)

Vert: 12=-1200(F) 14=-499(F) 11=-460(F) 15=-499(F) 22=-500(F) 23=-499(F) 24=-499(F) 25=-460(F) 26=-460(F)

27=-460(F)

33) Reversal: Dead + 0.6 MWFRS Wind (Neg. Internal) 1st Parallel: Lumber Increase=1.60, Plate Increase=1.60

Uniform Loads (plf)

Vert: 1-4=6, 4-8=-10, 13-16=-20, 11-13=-20, 9-11=-20, 9-19=-20

Horz: 1-4=-26, 4-8=10

Concentrated Loads (lb)

Vert: 12=-1200(F) 14=-487(F) 11=-449(F) 15=-487(F) 22=-491(F) 23=-487(F) 24=-487(F) 25=-449(F) 26=-449(F)

27=-449(F)

34) Reversal: Dead + 0.6 MWFRS Wind (Neg. Internal) 2nd Parallel: Lumber Increase=1.60, Plate Increase=1.60

Uniform Loads (plf)

Vert: 1-4=-10, 4-8=6, 13-16=-20, 11-13=-20, 9-11=-20, 9-19=-20

Horz: 1-4=-10, 4-8=26

Concentrated Loads (lb)

Vert: 12=-1200(F) 14=-487(F) 11=-449(F) 15=-487(F) 22=-491(F) 23=-487(F) 24=-487(F) 25=-449(F) 26=-449(F)

27=-449(F)

35) Reversal: Dead + 0.75 Roof Live (bal.) + 0.75(0.6 MWFRS Wind (Neg. Int) Left): Lumber Increase=1.60, Plate Increase=1.60

Uniform Loads (plf)

Vert: 1-4=-67, 4-8=-50, 13-16=-20, 11-13=-20, 9-11=-20, 9-19=-20

Horz: 1-4=10, 4-8=8

Concentrated Loads (lb)

Vert: 12=-1200(F) 14=-866(F) 11=-834(F) 15=-866(F) 22=-869(F) 23=-866(F) 24=-866(F) 25=-834(F) 26=-834(F)

27=-834(F)

36) Reversal: Dead + 0.75 Roof Live (bal.) + 0.75(0.6 MWFRS Wind (Neg. Int) Right): Lumber Increase=1.60, Plate Increase=1.60

Continued on page 5

WARNING - Verify design parameters and READ NOTES ON THIS AND INCLUDED MITEK REFERENCE PAGE MII-7473 rev. 5/19/2020 BEFORE USE.

Design valid for use only with MiTek® connectors. This design is based only upon parameters shown, and is for an individual building component, not a truss system. Before use, the building designer must verify the applicability of design parameters and properly incorporate this design into the overall building design. Bracing indicated is to prevent buckling of individual truss web and/or chord members only. Additional temporary and permanent bracing is always required for stability and to prevent collapse with possible personal injury and property damage. For general guidance regarding the fabrication, storage, delivery, erection and bracing of trusses and truss systems, see **ANSI/TPI1 Quality Criteria, DSB-89 and BCSI Building Component Safety Information** available from Truss Plate Institute, 2670 Crain Highway, Suite 203 Waldorf, MD 20601

16023 Swingley Ridge Rd
Chesterfield, MO 63017

Job	Truss	Truss Type	Qty	Ply	C&H/159 COBEY CREEK/MO	RELEASE FOR CONSTRUCTION
3008841	B1	Roof Special Girder	1	2	Job Reference (optional)	AS NOTED FOR PLAN REVIEW DEVELOPMENT SERVICES LEE'S SUMMIT, MISSOURI

Builders FirstSource (Valley Center),
Valley Center, KS - 67147,
8.430 s Aug 16 2021 MiTek Industries, Inc.
Mon Dec 27 09:45:22 2021 Page 5
ID:xKFGJ7evN?7xhJE66FFHnCzvA57-Z1p79tABTUT0AJRvTkNE75_BaIE4fWGx75toy4ch

02/11/2022

LOAD CASE(S) Standard

Uniform Loads (plf)

Vert: 1-4=-50, 4-8=-67, 13-16=-20, 11-13=-20, 9-11=-20, 9-19=-20

Horz: 1-4=-8, 4-8=-10

Concentrated Loads (lb)

Vert: 12=-1200(F) 14=-866(F) 11=-834(F) 15=-866(F) 22=-869(F) 23=-866(F) 24=-866(F) 25=-834(F) 26=-834(F) 27=-834(F)

37) Reversal: Dead + 0.75 Roof Live (bal.) + 0.75(0.6 MWFRS Wind (Neg. Int) 1st Parallel): Lumber Increase=1.60, Plate Increase=1.60

Uniform Loads (plf)

Vert: 1-4=-38, 4-8=-50, 13-16=-20, 11-13=-20, 9-11=-20, 9-19=-20

Horz: 1-4=-20, 4-8=8

Concentrated Loads (lb)

Vert: 12=-1200(F) 14=-866(F) 11=-834(F) 15=-866(F) 22=-869(F) 23=-866(F) 24=-866(F) 25=-834(F) 26=-834(F) 27=-834(F)

38) Reversal: Dead + 0.75 Roof Live (bal.) + 0.75(0.6 MWFRS Wind (Neg. Int) 2nd Parallel): Lumber Increase=1.60, Plate Increase=1.60

Uniform Loads (plf)

Vert: 1-4=-50, 4-8=-38, 13-16=-20, 11-13=-20, 9-11=-20, 9-19=-20

Horz: 1-4=-8, 4-8=20

Concentrated Loads (lb)

Vert: 12=-1200(F) 14=-866(F) 11=-834(F) 15=-866(F) 22=-869(F) 23=-866(F) 24=-866(F) 25=-834(F) 26=-834(F) 27=-834(F)

39) Reversal: Dead + 0.6 MWFRS Wind Min. Left: Lumber Increase=1.60, Plate Increase=1.60

Uniform Loads (plf)

Vert: 1-4=-17, 4-8=-12, 13-16=-8, 11-13=-8, 9-11=-8, 9-19=-8

Horz: 1-4=5

Concentrated Loads (lb)

Vert: 12=-1200(F) 14=-429(F) 11=-390(F) 15=-429(F) 22=-430(F) 23=-429(F) 24=-429(F) 25=-390(F) 26=-390(F) 27=-390(F)

40) Reversal: Dead + 0.6 MWFRS Wind Min. Right: Lumber Increase=1.60, Plate Increase=1.60

Uniform Loads (plf)

Vert: 1-4=-12, 4-8=-17, 13-16=-8, 11-13=-8, 9-11=-8, 9-19=-8

Horz: 4-8=5

Concentrated Loads (lb)

Vert: 12=-1200(F) 14=-429(F) 11=-390(F) 15=-429(F) 22=-430(F) 23=-429(F) 24=-429(F) 25=-390(F) 26=-390(F) 27=-390(F)

Job	Truss	Truss Type	Qty	Ply	C&H/159 COBEY CREEK/MO	RELEASE FOR CONSTRUCTION
3008841	B2	Roof Special	3	1		AS NOTED FOR PLAN REVIEW
					Job Reference (optional)	DEVELOPMENT SERVICES
						LEE'S SUMMIT, MISSOURI

Builders FirstSource (Valley Center), Valley Center, KS - 67147, 8.430 s Aug 16 2021 MiTek Industries, Inc Mon Dec 27 09:45 24 2021 Page 1
ID:xKFGJ7evN?7xhJE66FFHnCzvA57-VQwtaZBR?6jkQbHb9QmJzASMPi/i7tjircCMT44jif

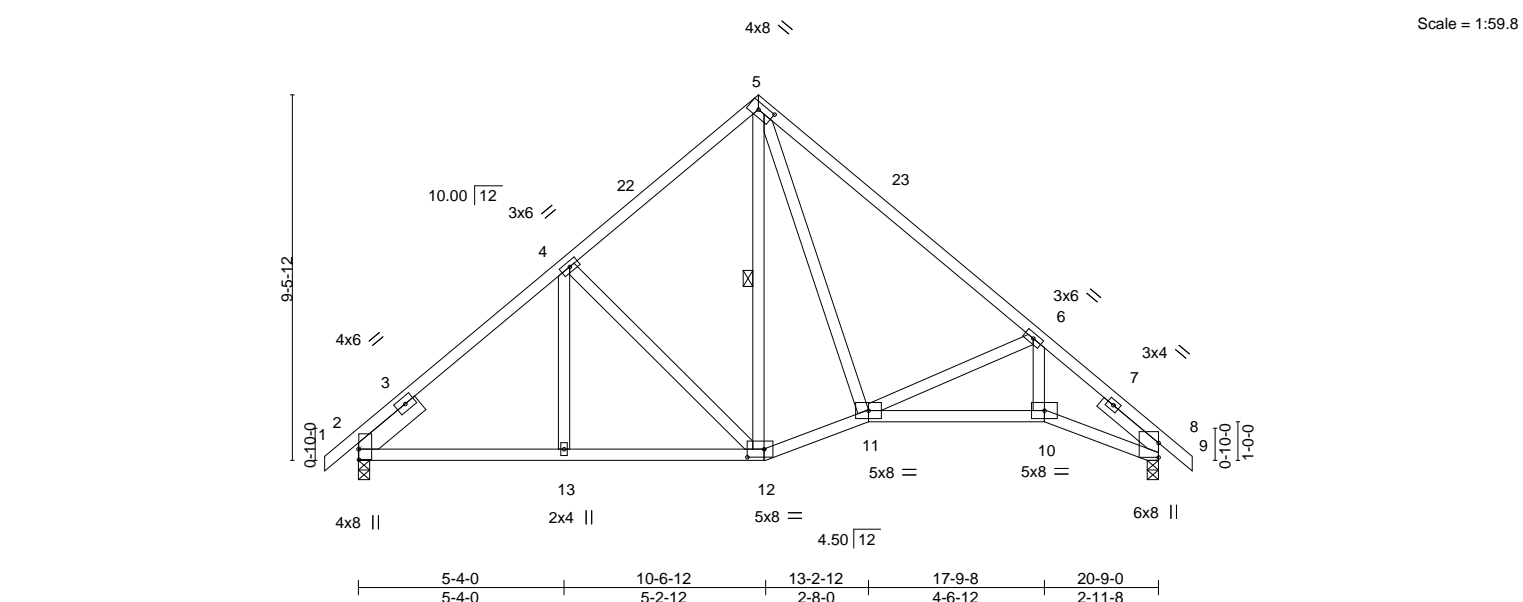


Plate Offsets (X,Y)-- [2:0-3-4,0-0-2], [5:0-4-13,0-2-0], [12:0-5-4,0-2-8]										
LOADING (psf)		SPACING- 2-0-0		CSI.		DEFL. in (loc) l/defl L/d		PLATES GRIP		
TCLL	25.0	Plate Grip DOL	1.15	TC	0.66	Vert(LL)	-0.07 10-11	>999	240	MT20 197/144
TCDL	10.0	Lumber DOL	1.15	BC	0.89	Vert(CT)	-0.14 10-11	>999	180	
BCLL	0.0	Rep Stress Incr	YES	WB	0.30	Horz(CT)	0.09 8	n/a	n/a	
BCDL	10.0	Code	IRC2018/TPI2014	Matrix-AS						Weight: 104 lb FT = 20%

LUMBER-	BRACING-
TOP CHORD 2x4 SPF No.2	TOP CHORD Structural wood sheathing directly applied.
BOT CHORD 2x4 SPF No.2	BOT CHORD Rigid ceiling directly applied.
WEBS 2x4 SPF No.2	WEBS 1 Row at midpt 5-12
SLIDER Left 2x6 SPF No.2 2-0-0, Right 2x4 SPF No.2 2-0-0	

REACTIONS. (size) 2=0-3-8, 8=0-3-8
Max Horz 2=-220(LC 10)
Max Uplift 2=-113(LC 12), 8=-113(LC 13)
Max Grav 2=995(LC 1), 8=995(LC 1)

FORCES. (lb) - Max. Comp./Max. Ten. - All forces 250 (lb) or less except when shown.
TOP CHORD 2-4=-1093/155, 4-5=-813/202, 5-6=-1114/196, 6-8=-1672/185
BOT CHORD 2-13=-133/812, 12-13=-133/812, 11-12=0/604, 10-11=-101/1208, 8-10=-100/1276
WEBS 4-12=-354/193, 6-11=-543/252, 6-10=0/365, 5-11=-32/557

- NOTES-**
- 1) Unbalanced roof live loads have been considered for this design.
 - 2) Wind: ASCE 7-16; Vult=115mph (3-second gust) Vasd=91mph; TCDL=6.0psf; BCDL=4.2psf; h=15ft; Cat. II; Exp C; Enclosed; MWFRS (envelope) gable end zone and C-C Exterior(2E) -0-10-8 to 2-1-8, Interior(1) 2-1-8 to 10-4-8, Exterior(2R) 10-4-8 to 13-4-8, Interior(1) 13-4-8 to 21-7-8 zone; cantilever left and right exposed ; end vertical left and right exposed;C-C for members and forces & MWFRS for reactions shown; Lumber DOL=1.60 plate grip DOL=1.60
 - 3) This truss has been designed for a 10.0 psf bottom chord live load nonconcurrent with any other live loads.
 - 4) Bearing at joint(s) 8 considers parallel to grain value using ANSI/TPI 1 angle to grain formula. Building designer should verify capacity of bearing surface.
 - 5) Provide mechanical connection (by others) of truss to bearing plate capable of withstanding 100 lb uplift at joint(s) except (jt=lb) 2=113, 8=113.
 - 6) This truss is designed in accordance with the 2018 International Residential Code sections R502.11.1 and R802.10.2 and referenced standard ANSI/TPI 1.
 - 7) This truss design requires that a minimum of 7/16" structural wood sheathing be applied directly to the top chord and 1/2" gypsum sheetrock be applied directly to the bottom chord.



December 28,2021

Job	Truss	Truss Type	Qty	Ply	C&H/159 COBEY CREEK/MO
3008841	B3	Roof Special Structural Gable	1	1	
Job Reference (optional)					

AS NOTED FOR PLAN REVIEW
DEVELOPMENT SERVICES
LEE'S SUMMIT, MISSOURI


Builders FirstSource (Valley Center), Valley Center, KS - 67147,

8.430 s Aug 16 2021 MiTek Industries, Inc. Mon Dec 27 09:45:25 2021 Page 1

0-10-8 5-4-0 10-4-8 13-2-12 17-9-8 20-9-0 21-7-8
0-10-8 5-4-0 5-0-8 2-10-4 4-6-12 2-11-8 0-10-8

4x8 //

Scale = 1:59.9

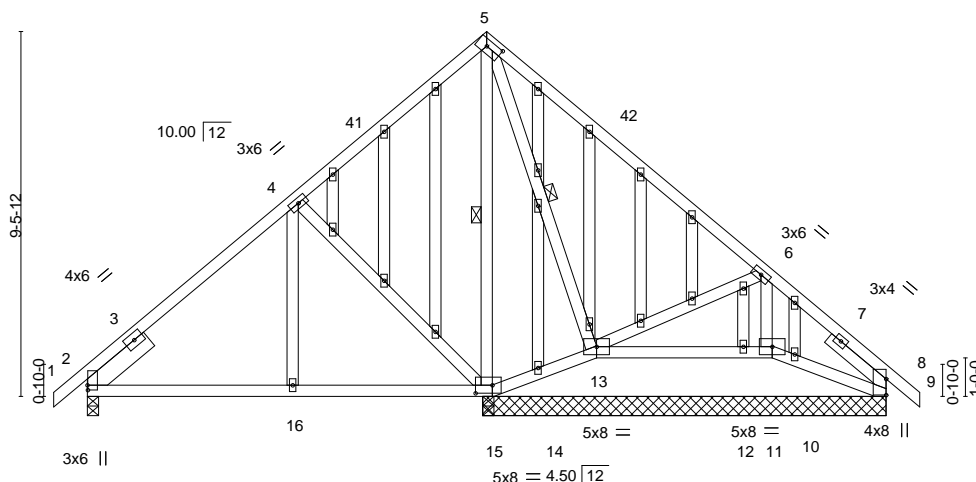

5-4-0 10-3-4 10-6-12 13-2-12 17-9-8 20-9-0
5-4-0 4-11-4 0-3-8 2-8-0 4-6-12 2-11-8

Plate Offsets (X,Y)-- [2:0-1-8,0-0-2], [5:0-4-13,0-2-0], [15:0-5-4,0-2-8]

LOADING (psf)	SPACING-	2-0-0	CSI.	DEFL.	in (loc)	l/defl	L/d	PLATES	GRIP
TCLL 25.0	Plate Grip DOL	1.15	TC 0.52	Vert(LL)	0.03 16-35	>999	240	MT20	197/144
TCDL 10.0	Lumber DOL	1.15	BC 0.21	Vert(CT)	-0.03 15-16	>999	180		
BCLL 0.0	Rep Stress Incr	YES	WB 0.35	Horz(CT)	-0.01 2	n/a	n/a		
BCDL 10.0	Code IRC2018/TPI2014		Matrix-AS					Weight: 144 lb	FT = 20%

LUMBER-

TOP CHORD 2x4 SPF No.2
BOT CHORD 2x4 SPF No.2
WEBS 2x4 SPF No.2
OTHERS 2x4 SPF No.2
SLIDER Left 2x6 SPF No.2 2-0-0, Right 2x4 SPF No.2 2-0-0

BRACING-

TOP CHORD Structural wood sheathing directly applied.
BOT CHORD Rigid ceiling directly applied.
WEBS 1 Row at midpt 5-15, 5-13

REACTIONS.

All bearings 10-5-12 except (jt=length) 2=0-3-8.
(lb) - Max Horz 2=220(LC 10)
Max Uplift All uplift 100 lb or less at joint(s) 2, 15, 8, 14, 10 except 11=267(LC 13)
Max Grav All reactions 250 lb or less at joint(s) 8, 12, 10, 8 except 2=563(LC 1), 15=520(LC 1), 15=520(LC 1), 13=263(LC 1), 11=517(LC 26)

FORCES.

(lb) - Max. Comp./Max. Ten. - All forces 250 (lb) or less except when shown.
TOP CHORD 2-4=-415/118
BOT CHORD 2-16=-118/412, 15-16=-118/412
WEBS 4-15=-407/197, 6-11=-548/256

NOTES-

- 1) Unbalanced roof live loads have been considered for this design.
- 2) Wind: ASCE 7-16; Vult=115mph (3-second gust) Vasd=91mph; TCDL=6.0psf; BCDL=4.2psf; h=15ft; Cat. II; Exp C; Enclosed; MWFRS (envelope) gable end zone and C-C Exterior(2E) -0-10-8 to 2-1-8, Interior(1) 2-1-8 to 10-4-8, Exterior(2R) 10-4-8 to 13-4-8, Interior(1) 13-4-8 to 21-7-8 zone; cantilever left and right exposed; end vertical left and right exposed; C-C for members and forces & MWFRS for reactions shown; Lumber DOL=1.60 plate grip DOL=1.60
- 3) Truss designed for wind loads in the plane of the truss only. For studs exposed to wind (normal to the face), see Standard Industry Gable End Details as applicable, or consult qualified building designer as per ANSI/TPI 1.
- 4) All plates are 2x4 MT20 unless otherwise indicated.
- 5) Gable studs spaced at 1-4-0 oc.
- 6) This truss has been designed for a 10.0 psf bottom chord live load nonconcurrent with any other live loads.
- 7) Provide mechanical connection (by others) of truss to bearing plate capable of withstanding 100 lb uplift at joint(s) 2, 15, 8, 14, 10, 8 except (jt=lb) 11=267.
- 8) This truss is designed in accordance with the 2018 International Residential Code sections R502.11.1 and R802.10.2 and referenced standard ANSI/TPI 1.
- 9) This truss design requires that a minimum of 7/16" structural wood sheathing be applied directly to the top chord and 1/2" gypsum sheetrock be applied directly to the bottom chord.



December 28, 2021

WARNING - Verify design parameters and READ NOTES ON THIS AND INCLUDED MITEK REFERENCE PAGE MII-7473 rev. 5/19/2020 BEFORE USE.

Design valid for use only with MiTek® connectors. This design is based only upon parameters shown, and is for an individual building component, not a truss system. Before use, the building designer must verify the applicability of design parameters and properly incorporate this design into the overall building design. Bracing indicated is to prevent buckling of individual truss web and/or chord members only. Additional temporary and permanent bracing is always required for stability and to prevent collapse with possible personal injury and property damage. For general guidance regarding the fabrication, storage, delivery, erection and bracing of trusses and truss systems, see **ANSI/TPI1 Quality Criteria, DSB-89 and BCSI Building Component Safety Information** available from Truss Plate Institute, 2670 Crain Highway, Suite 203 Waldorf, MD 20601



16023 Swingley Ridge Rd
Chesterfield, MO 63017

Job	Truss	Truss Type	Qty	Ply	C&H/159 COBEY CREEK/MO
3008841	C1	Common Supported Gable	1	1	
Job Reference (optional)					

AS NOTED FOR PLAN REVIEW
DEVELOPMENT SERVICES
LEE'S SUMMIT, MISSOURI

Builders FirstSource (Valley Center),

Valley Center, KS - 67147,


8.430 s Aug 16 2021 MiTek Industries, Inc Mon Dec 27 09:45:27 2021 Page 1

ID:xKFGJ7evN?77xhJE66FFHnCzvA57-w?c0DaEJ15JH3KsGHZTkbwgdKVX6HfPursby40c

0-10-8 5-3-6 10-6-12 11-5-4
0-10-8 5-3-6 5-3-6 0-10-8

4x6 =

Scale = 1:33.1

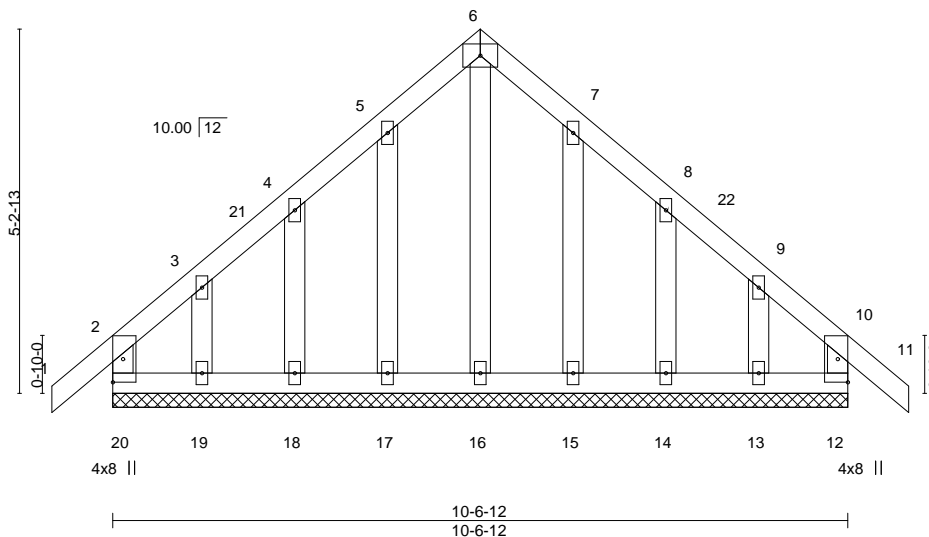

LOADING (psf)	SPACING-	2-0-0	CSI.	DEFL.	in	(loc)	l/defl	L/d	PLATES	GRIP
TCLL 25.0	Plate Grip DOL	1.15	TC 0.08	Vert(LL)	-0.00	11	n/r	120	MT20	197/144
TCDL 10.0	Lumber DOL	1.15	BC 0.04	Vert(CT)	-0.00	11	n/r	120		
BCLL 0.0	Rep Stress Incr	YES	WB 0.08	Horz(CT)	0.00	12	n/a	n/a		
BCDL 10.0	Code IRC2018/TPI2014		Matrix-R						Weight: 54 lb	FT = 20%

LUMBER-

TOP CHORD 2x4 SPF No.2
BOT CHORD 2x4 SPF No.2
WEBS 2x4 SPF No.2
OTHERS 2x4 SPF No.2

BRACING-

TOP CHORD Structural wood sheathing directly applied or 6-0-0 oc purlins, except end verticals.
BOT CHORD Rigid ceiling directly applied or 6-0-0 oc bracing.

REACTIONS.

All bearings 10-6-12.

(lb) - Max Horz 20=142(LC 10)

Max Uplift All uplift 100 lb or less at joint(s) 20, 12, 17, 18, 19, 15, 14, 13

Max Grav All reactions 250 lb or less at joint(s) 20, 12, 16, 17, 18, 19, 15, 14, 13

FORCES. (lb) - Max. Comp./Max. Ten. - All forces 250 (lb) or less except when shown.**NOTES-**

- Unbalanced roof live loads have been considered for this design.
- Wind: ASCE 7-16; Vult=115mph (3-second gust) Vasd=91mph; TCDL=6.0psf; BCDL=4.2psf; h=15ft; Cat. II; Exp C; Enclosed; MWFRS (envelope) gable end zone and C-C Corner(3E) -0-10-8 to 2-1-8, Exterior(2N) 2-1-8 to 5-3-6, Corner(3R) 5-3-6 to 8-3-6, Exterior(2N) 8-3-6 to 11-5-4 zone; cantilever left and right exposed; end vertical left and right exposed; C-C for members and forces & MWFRS for reactions shown; Lumber DOL=1.60 plate grip DOL=1.60
- Truss designed for wind loads in the plane of the truss only. For studs exposed to wind (normal to the face), see Standard Industry Gable End Details as applicable, or consult qualified building designer as per ANSI/TPI 1.
- All plates are 2x4 MT20 unless otherwise indicated.
- Gable requires continuous bottom chord bearing.
- Truss to be fully sheathed from one face or securely braced against lateral movement (i.e. diagonal web).
- Gable studs spaced at 1-4-0 oc.
- This truss has been designed for a 10.0 psf bottom chord live load nonconcurrent with any other live loads.
- Provide mechanical connection (by others) of truss to bearing plate capable of withstanding 100 lb uplift at joint(s) 20, 12, 17, 18, 19, 15, 14, 13.
- This truss is designed in accordance with the 2018 International Residential Code sections R502.11.1 and R802.10.2 and referenced standard ANSI/TPI 1.



December 28, 2021

WARNING - Verify design parameters and READ NOTES ON THIS AND INCLUDED MITEK REFERENCE PAGE MII-7473 rev. 5/19/2020 BEFORE USE.

Design valid for use only with MiTek® connectors. This design is based only upon parameters shown, and is for an individual building component, not a truss system. Before use, the building designer must verify the applicability of design parameters and properly incorporate this design into the overall building design. Bracing indicated is to prevent buckling of individual truss web and/or chord members only. Additional temporary and permanent bracing is always required for stability and to prevent collapse with possible personal injury and property damage. For general guidance regarding the fabrication, storage, delivery, erection and bracing of trusses and truss systems, see

ANSI/TPI1 Quality Criteria, DSB-89 and BCSI Building Component**Safety Information** available from Truss Plate Institute, 2670 Crain Highway, Suite 203 Waldorf, MD 2060116023 Swingley Ridge Rd
Chesterfield, MO 63017

Job 3008841	Truss D1	Truss Type GABLE	Qty 1	Ply 1	C&H/159 COBEY CREEK/MO
----------------	-------------	---------------------	----------	----------	------------------------

Builders First Source, Valley Center, KS 67147

ID:xKFGJ7evN?7xhJE66FFHnCzvA57-z?0YcMjngRXgdA?rIWtNtimpSY05FC?0p3ISMmry4Shp


8.430 s Aug 16 2021 MiTek Industries, Inc. Tue Dec 28 10:43:26 2021 Page 1

Job Reference (optional)

-0-10-8
0-10-85-11-8
5-11-8

02/11/2022

Scale = 1:14.6

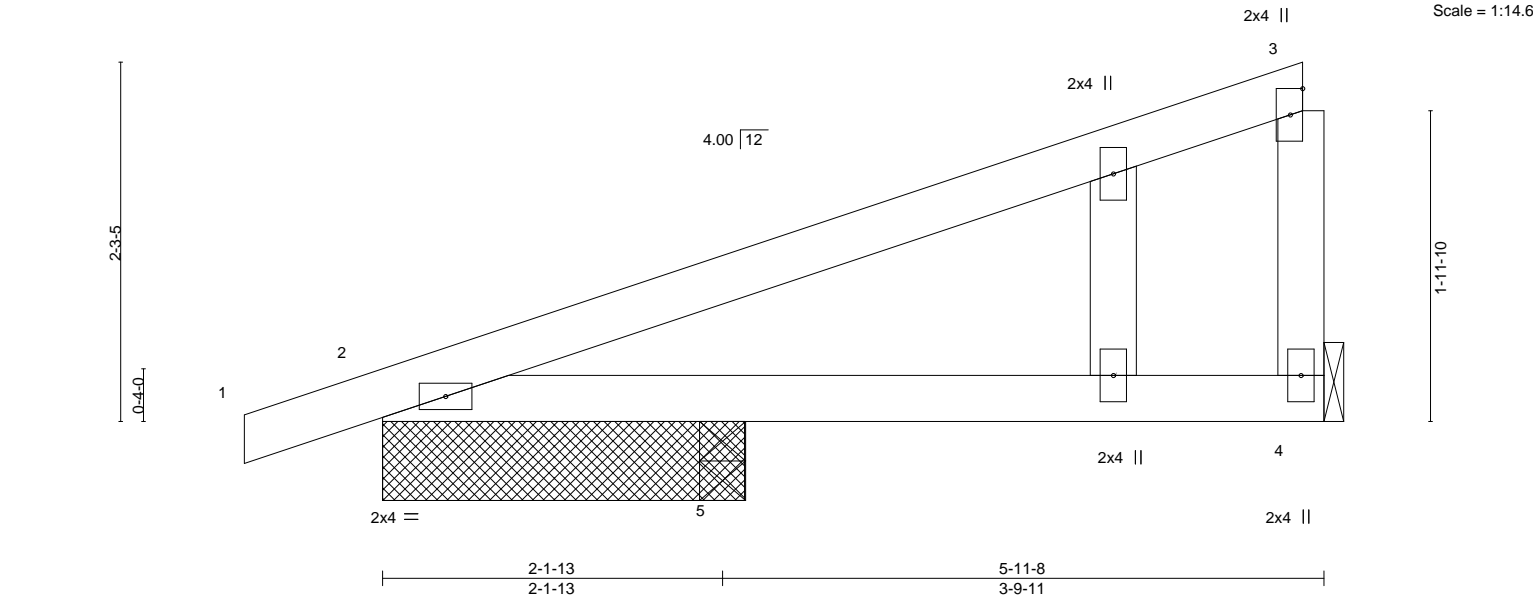

LOADING (psf)	SPACING-	2-0-0	CSI.	DEFL.	in	(loc)	l/defl	L/d	PLATES	GRIP
TCLL 25.0	Plate Grip DOL	1.15	TC 0.65	Vert(LL)	-0.01	4-5	>999	240	MT20	197/144
TCDL 10.0	Lumber DOL	1.15	BC 0.09	Vert(CT)	-0.01	4-5	>999	180		
BCLL 0.0	Rep Stress Incr	YES	WB 0.00	Horz(CT)	0.00	4	n/a	n/a		
BCDL 10.0	Code IRC2018/TPI2014		Matrix-P						Weight: 18 lb	FT = 20%

LUMBER-

TOP CHORD 2x4 SPF No.2
 BOT CHORD 2x4 SPF No.2
 WEBS 2x4 SPF No.2
 OTHERS 2x4 SPF No.2

BRACING-

TOP CHORD Sheathed or 5-11-8 oc purlins, except end verticals.
 BOT CHORD Rigid ceiling directly applied or 10-0-0 oc bracing.

REACTIONS.

(size) 4=Mechanical, 2=2-3-8, 5=0-3-8
 Max Horz 2=83(LC 9)
 Max Uplift 4=-64(LC 12), 2=-97(LC 8)
 Max Grav 4=226(LC 1), 2=279(LC 1), 5=154(LC 3)

FORCES. (lb) - Max. Comp./Max. Ten. - All forces 250 (lb) or less except when shown.

TOP CHORD 3-4=-196/256

NOTES-

- 1) Wind: ASCE 7-16; Vult=115mph (3-second gust) Vasd=91mph; TCDL=6.0psf; BCDL=4.2psf; h=15ft; Cat. II; Exp C; Enclosed; MWFRS (envelope) gable end zone and C-C Corner(3E) -0-10-8 to 2-1-8, Exterior(2N) 2-1-8 to 5-9-5 zone; cantilever left and right exposed; end vertical left and right exposed; C-C for members and forces & MWFRS for reactions shown; Lumber DOL=1.60 plate grip DOL=1.60
- 2) Truss designed for wind loads in the plane of the truss only. For studs exposed to wind (normal to the face), see Standard Industry Gable End Details as applicable, or consult qualified building designer as per ANSI/TPI 1. Truss designed for wind loads in the plane of the truss only. For studs exposed to wind (normal to the face), see Standard Industry Gable End Details as applicable, or consult qualified building designer as per ANSI/TPI 1. Truss designed for wind loads in the plane of the truss only. For studs exposed to wind (normal to the face), see Standard Industry Gable End Details as applicable, or consult qualified building designer as per ANSI/TPI 1.
- 3) Gable studs spaced at 1-4-0 oc.
- 4) This truss has been designed for a 10.0 psf bottom chord live load nonconcurrent with any other live loads.
- 5) Refer to girder(s) for truss to truss connections.
- 6) Provide mechanical connection (by others) of truss to bearing plate capable of withstanding 64 lb uplift at joint 4 and 97 lb uplift at joint 2.
- 7) This truss is designed in accordance with the 2018 International Residential Code sections R502.11.1 and R802.10.2 and referenced standard ANSI/TPI 1.



December 28, 2021

WARNING - Verify design parameters and READ NOTES ON THIS AND INCLUDED MITEK REFERENCE PAGE MII-7473 rev. 5/19/2020 BEFORE USE.

Design valid for use only with MiTek® connectors. This design is based only upon parameters shown, and is for an individual building component, not a truss system. Before use, the building designer must verify the applicability of design parameters and properly incorporate this design into the overall building design. Bracing indicated is to prevent buckling of individual truss web and/or chord members only. Additional temporary and permanent bracing is always required for stability and to prevent collapse with possible personal injury and property damage. For general guidance regarding the fabrication, storage, delivery, erection and bracing of trusses and truss systems, see

ANSI/TPI1 Quality Criteria, DSB-89 and BCSI Building Component

Safety Information available from Truss Plate Institute, 2670 Crain Highway, Suite 203 Waldorf, MD 20601



16023 Swingley Ridge Rd
 Chesterfield, MO 63017

Job	Truss	Truss Type	Qty	Ply	C&H/159 COBEY CREEK/MO	RELEASE FOR CONSTRUCTION
3008841	D2	Monopitch	5	1	Job Reference (optional)	AS NOTED FOR PLAN REVIEW DEVELOPMENT SERVICES LEE'S SUMMIT, MISSOURI

Builders FirstSource (Valley Center), Valley Center, KS - 67147,

8.430 s Aug 16 2021 MiTek Industries, Inc. Mon Dec 27 09:45:28 2021 Page 1

ID:xKFGJ7evN77xhJE66FFHnCzvA57-OBAOQwEx3KD9uD3q_UiUjL0mDole7bOeTaPVFy40b

02/11/2022

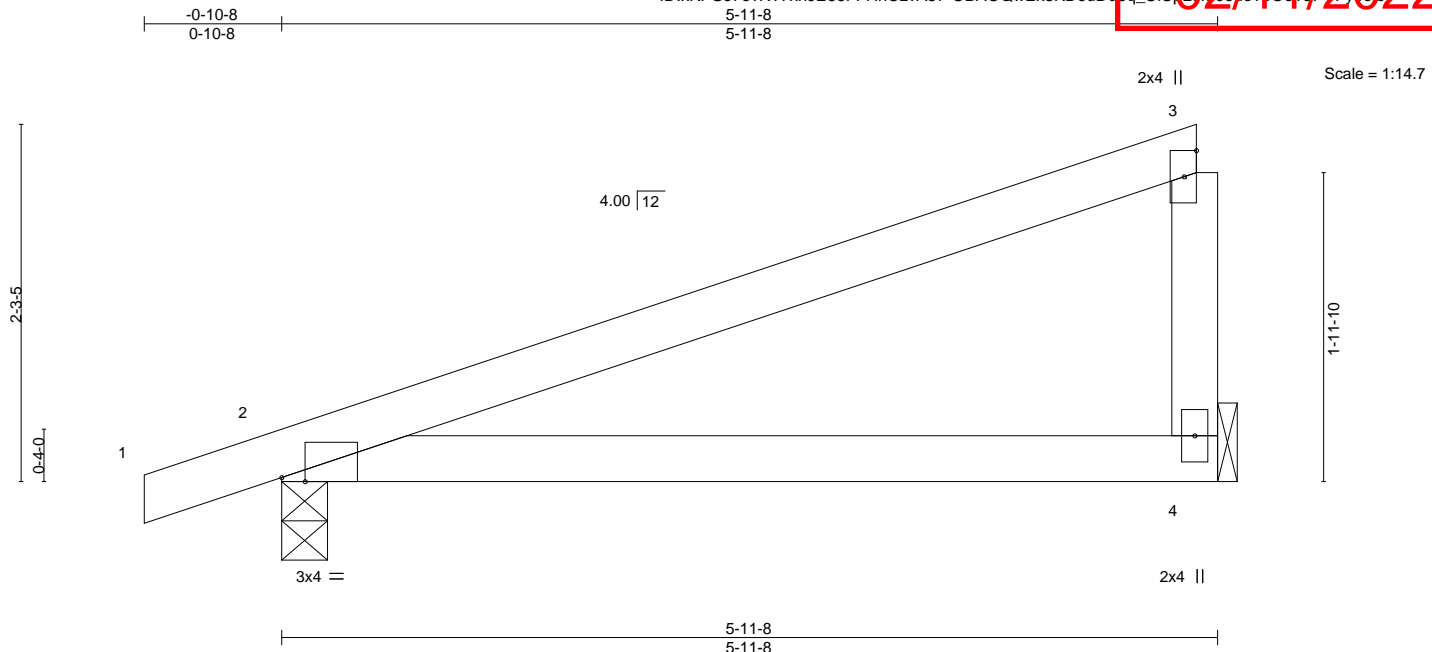


Plate Offsets (X,Y)--		[2:0-1-13,Edge]									
LOADING (psf)		SPACING-		CSI.		DEFL.				PLATES	GRIP
TCLL	25.0	Plate Grip DOL	1.15	TC	0.44	Vert(LL)	-0.06	4-7	>999	MT20	197/144
TCDL	10.0	Lumber DOL	1.15	BC	0.35	Vert(CT)	-0.12	4-7	>569		
BCLL	0.0	Rep Stress Incr	YES	WB	0.00	Horz(CT)	0.00	2	n/a		
BCDL	10.0	Code	IRC2018/TPI2014	Matrix-AS						Weight: 17 lb	FT = 20%

LUMBER-

TOP CHORD 2x4 SPF No.2
BOT CHORD 2x4 SPF No.2
WEBS 2x4 SPF No.2

BRACING-

TOP CHORD Structural wood sheathing directly applied, except end verticals.
BOT CHORD Rigid ceiling directly applied.

REACTIONS.

(size) 4=Mechanical, 2=0-3-8
Max Horz 2=84(LC 11)
Max Uplift 4=52(LC 12), 2=76(LC 8)
Max Grav 4=257(LC 1), 2=327(LC 1)

FORCES. (lb) - Max. Comp./Max. Ten. - All forces 250 (lb) or less except when shown.

NOTES-

- 1) Wind: ASCE 7-16; Vult=115mph (3-second gust) Vasd=91mph; TCDL=6.0psf; BCDL=4.2psf; h=15ft; Cat. II; Exp C; Enclosed; MWFRS (envelope) gable end zone and C-C Exterior(2E) -0-10-8 to 2-1-8, Interior(1) 2-1-8 to 5-9-12 zone; cantilever left and right exposed; end vertical left and right exposed; C-C for members and forces & MWFRS for reactions shown; Lumber DOL=1.60 plate grip DOL=1.60
- 2) This truss has been designed for a 10.0 psf bottom chord live load nonconcurrent with any other live loads.
- 3) Refer to girder(s) for truss to truss connections.
- 4) Provide mechanical connection (by others) of truss to bearing plate capable of withstanding 100 lb uplift at joint(s) 4, 2.
- 5) This truss is designed in accordance with the 2018 International Residential Code sections R502.11.1 and R802.10.2 and referenced standard ANSI/TPI 1.
- 6) This truss design requires that a minimum of 7/16" structural wood sheathing be applied directly to the top chord and 1/2" gypsum sheetrock be applied directly to the bottom chord.



December 28, 2021

WARNING - Verify design parameters and READ NOTES ON THIS AND INCLUDED MITEK REFERENCE PAGE MII-7473 rev. 5/19/2020 BEFORE USE.

Design valid for use only with MiTek® connectors. This design is based only upon parameters shown, and is for an individual building component, not a truss system. Before use, the building designer must verify the applicability of design parameters and properly incorporate this design into the overall building design. Bracing indicated is to prevent buckling of individual truss web and/or chord members only. Additional temporary and permanent bracing is always required for stability and to prevent collapse with possible personal injury and property damage. For general guidance regarding the fabrication, storage, delivery, erection and bracing of trusses and truss systems, see

ANSI/TPI1 Quality Criteria, DSB-89 and BCSI Building Component

Safety Information available from Truss Plate Institute, 2670 Crain Highway, Suite 203 Waldorf, MD 20601



16023 Swingley Ridge Rd
Chesterfield, MO 63017

Job	Truss	Truss Type	Qty	Ply	C&H/159 COBEY CREEK/MO	RELEASE FOR CONSTRUCTION
3008841	D3	Monopitch	5	1	Job Reference (optional)	AS NOTED FOR PLAN REVIEW DEVELOPMENT SERVICES LEE'S SUMMIT, MISSOURI

Builders FirstSource (Valley Center), Valley Center, KS - 67147,

8.430 s Aug 16 2021 MiTek Industries, Inc Mon Dec 27 09:45:29 2021 Page 1

ID:xKFGJ7evN?77xhJE66FFHnCzvA57-sNkmdGFaqeLOWMTFNI?001F0BCN SrX177z2ny40a

02/11/2022

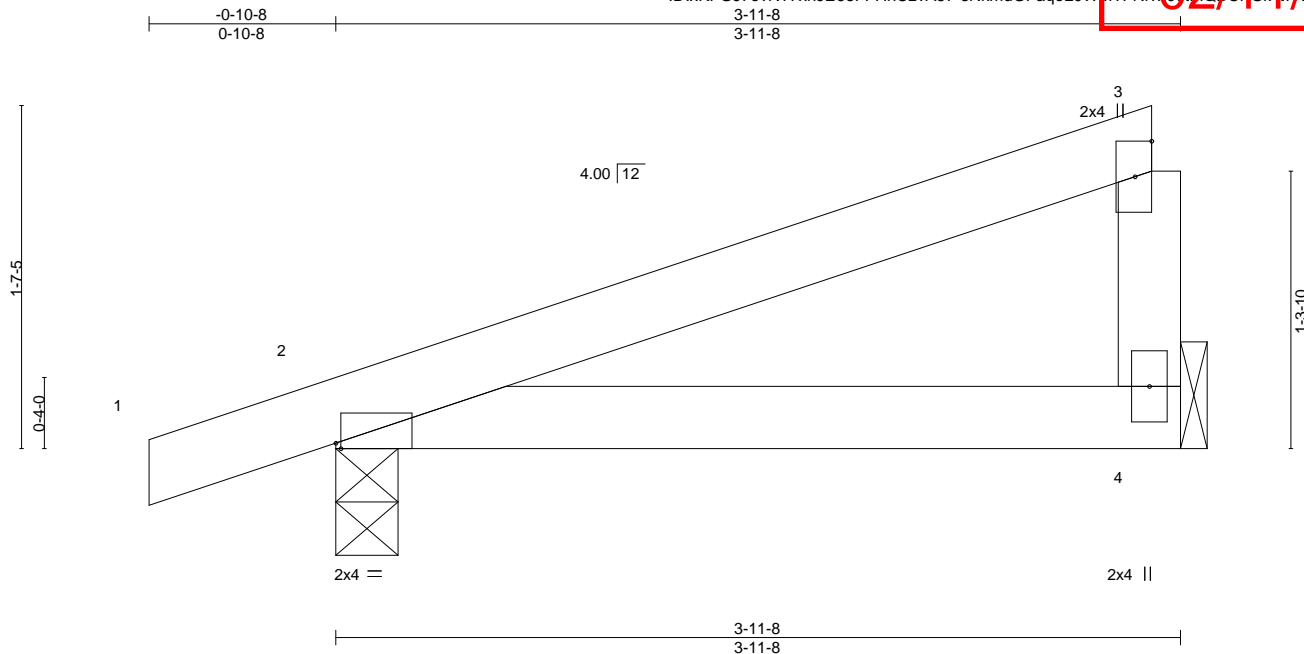


Plate Offsets (X,Y)-- [2:0-0-5,Edge]												
LOADING (psf)		SPACING- 2-0-0		CSI.		DEFL. in (loc) l/defl L/d				PLATES GRIP		
TCLL	25.0	Plate Grip DOL	1.15	TC	0.17	Vert(LL)	-0.01	4-7	>999	240	MT20	197/144
TCDL	10.0	Lumber DOL	1.15	BC	0.15	Vert(CT)	-0.02	4-7	>999	180		
BCLL	0.0	Rep Stress Incr	YES	WB	0.00	Horz(CT)	0.00	2	n/a	n/a		
BCDL	10.0	Code IRC2018/TPI2014		Matrix-MP							Weight: 11 lb	FT = 20%

LUMBER-

TOP CHORD 2x4 SPF No.2
BOT CHORD 2x4 SPF No.2
WEBS 2x4 SPF No.2

BRACING-

TOP CHORD Structural wood sheathing directly applied or 3-11-8 oc purlins, except end verticals.
BOT CHORD Rigid ceiling directly applied or 10-0-0 oc bracing.

REACTIONS.

(size) 4=Mechanical, 2=0-3-8
Max Horz 2=57(LC 11)
Max Uplift 4=33(LC 12), 2=63(LC 8)
Max Grav 4=165(LC 1), 2=240(LC 1)

FORCES. (lb) - Max. Comp./Max. Ten. - All forces 250 (lb) or less except when shown.

NOTES-

- 1) Wind: ASCE 7-16; Vult=115mph (3-second gust) Vasd=91mph; TCDL=6.0psf; BCDL=4.2psf; h=15ft; Cat. II; Exp C; Enclosed; MWFRS (envelope) gable end zone and C-C Exterior(2E) -0-10-8 to 2-1-8, Interior(1) 2-1-8 to 3-9-12 zone; cantilever left and right exposed; end vertical left and right exposed; C-C for members and forces & MWFRS for reactions shown; Lumber DOL=1.60 plate grip DOL=1.60
- 2) This truss has been designed for a 10.0 psf bottom chord live load nonconcurrent with any other live loads.
- 3) Refer to girder(s) for truss to truss connections.
- 4) Provide mechanical connection (by others) of truss to bearing plate capable of withstanding 100 lb uplift at joint(s) 4, 2.
- 5) This truss is designed in accordance with the 2018 International Residential Code sections R502.11.1 and R802.10.2 and referenced standard ANSI/TPI 1.



December 28, 2021

WARNING - Verify design parameters and READ NOTES ON THIS AND INCLUDED MITEK REFERENCE PAGE MII-7473 rev. 5/19/2020 BEFORE USE.

Design valid for use only with MiTek® connectors. This design is based only upon parameters shown, and is for an individual building component, not a truss system. Before use, the building designer must verify the applicability of design parameters and properly incorporate this design into the overall building design. Bracing indicated is to prevent buckling of individual truss web and/or chord members only. Additional temporary and permanent bracing is always required for stability and to prevent collapse with possible personal injury and property damage. For general guidance regarding the fabrication, storage, delivery, erection and bracing of trusses and truss systems, see

ANSI/TPI1 Quality Criteria, DSB-89 and BCSI Building Component

Safety Information available from Truss Plate Institute, 2670 Crain Highway, Suite 203 Waldorf, MD 20601

 


16023 Swingley Ridge Rd
Chesterfield, MO 63017

Builders FirstSource (Valley Center), Valley Center, KS - 67147, 8.430 s Aug 16 2021 MiTek Industries, Inc

8.430 s Aug 16 2021 MiTek Industries, Inc Mon Dec 27 09:45:30 2021 Page 1

ID:xKFGJ7evN?7xhJE66FFHnCzvA57-Kal8rcGCayTt8W2RXPXAZEQFQxgWZ6v5h6h3Wa7y4ojZ



Weight: 11 lb FT = 20%

TOP CHORD	Structural wood sheathing directly applied or 3-11-8 oc purlins, except end verticals.
BOT CHORD	Rigid ceiling directly applied or 10-0-0 oc bracing.

- 1) Wind: ASCE 7-16; Vult=115mph (3-second gust) Vasd=91mph; TCDL=6.0psf; BCDL=4.2psf; h=15ft; Cat. II; Exp C; Enclosed; MWFRS (envelope) gable end zone and C-C Corner(3E) -0-10-8 to 2-1-8, Exterior(2N) 2-1-8 to 3-9-5 zone; cantilever left and right exposed ; end vertical left and right exposed; C-C for members and forces & MWFRS for reactions shown; Lumber DOL=1.60 plate grip DOL=1.60
- 2) Truss designed for wind loads in the plane of the truss only. For studs exposed to wind (normal to the face), see Standard Industry Gable End Details as applicable, or consult qualified building designer as per ANSI/TPI 1.
- 3) Gable requires continuous bottom chord bearing.
- 4) Gable studs spaced at 1-4-0 oc.
- 5) This truss has been designed for a 10.0 psf bottom chord live load nonconcurrent with any other live loads.
- 6) Provide mechanical connection (by others) of truss to bearing plate capable of withstanding 100 lb uplift at joint(s) 4, 2.
- 7) This truss is designed in accordance with the 2018 International Residential Code sections R502.11.1 and R802.10.2 and referenced standard ANSI/TPI 1.



 WARNING - Verify design parameters and READ NOTES ON THIS AND INCLUDED MITEK REFERENCE PAGE MII-7473 rev. 5/19/2020 BEFORE USE

WARNING – verify design parameters and **READ NOTES ON THIS AND INCLUDED WITH REFERENCE TO AISC M14-13 161, JF 19/2020 (BY ONE USER).** Design valid for use only with MITEK® connectors. This design is based only upon parameters shown, and is for an individual building component, not a truss system. Before use, the building designer must verify the applicability of design parameters and properly incorporate this design into the overall building design. Bracing indicated is to prevent buckling of individual truss web and/or chord members only. Additional temporary and permanent bracing is always required for stability and to prevent collapse with possible personal injury and property damage. For general guidance regarding the fabrication, storage, delivery, erection and bracing of trusses and truss systems, see **ANSI/TPI1 Quality Criteria, DSB-89 and BCSI Building Component Safety Information** available from Truss Plate Institute, 2670 Crain Highway, Suite 203 Waldorf, MD 20601




16023 Swingley Ridge Rd
Chesterfield, MO 63017

Job	Truss	Truss Type	Qty	Ply	C&H/159 COBEY CREEK/MO	RELEASE FOR CONSTRUCTION
3008841	D5	Monopitch	7	1	Job Reference (optional)	AS NOTED FOR PLAN REVIEW
Builders FirstSource (Valley Center), Valley Center, KS - 67147,						DEVELOPMENT SERVICES
8.430 s Aug 16 2021 MiTek Industries, Inc. Mon Dec 27 09:45:31 2021 Page 1						LEE'S SUMMIT, MISSOURI

ID: xKFGJ7evN?7xhJE66FFHnCzvA57-omrW2yHqLFbkldcV72P5RzZzEr7rMqKQp36y40Y

02/11/2022

Scale = 1:12.5

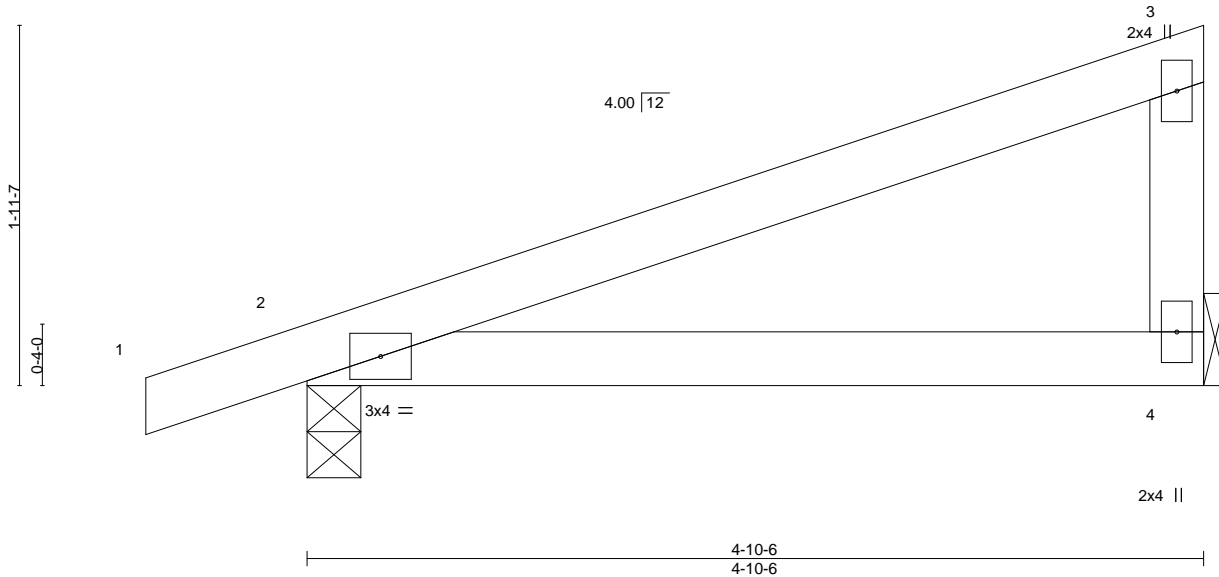

LOADING (psf)	SPACING-	2-0-0	CSI.	DEFL.	in	(loc)	I/defl	L/d	PLATES	GRIP
TCLL 25.0	Plate Grip DOL	1.15	TC 0.28	Vert(LL)	-0.03	4-7	>999	240	MT20	197/144
TCDL 10.0	Lumber DOL	1.15	BC 0.23	Vert(CT)	-0.05	4-7	>999	180		
BCLL 0.0	Rep Stress Incr	YES	WB 0.00	Horz(CT)	0.00	2	n/a	n/a		
BCDL 10.0	Code IRC2018/TPI2014		Matrix-AS						Weight: 14 lb	FT = 20%

LUMBER-

TOP CHORD 2x4 SPF No.2
BOT CHORD 2x4 SPF No.2
WEBS 2x4 SPF No.2

BRACING-

TOP CHORD Structural wood sheathing directly applied, except end verticals.
BOT CHORD Rigid ceiling directly applied.

REACTIONS.

(size) 4=Mechanical, 2=0-3-8
Max Horz 2=69(LC 11)
Max Uplift 4=42(LC 12), 2=69(LC 8)
Max Grav 4=207(LC 1), 2=279(LC 1)

FORCES. (lb) - Max. Comp./Max. Ten. - All forces 250 (lb) or less except when shown.

NOTES-

- 1) Wind: ASCE 7-16; Vult=115mph (3-second gust) Vasd=91mph; TCDL=6.0psf; BCDL=4.2psf; h=15ft; Cat. II; Exp C; Enclosed; MWFRS (envelope) gable end zone and C-C Exterior(2E) -0-10-8 to 2-1-8, Interior(1) 2-1-8 to 4-8-10 zone; cantilever left and right exposed; end vertical left and right exposed; C-C for members and forces & MWFRS for reactions shown; Lumber DOL=1.60 plate grip DOL=1.60
- 2) Truss designed for wind loads in the plane of the truss only. For studs exposed to wind (normal to the face), see Standard Industry Gable End Details as applicable, or consult qualified building designer as per ANSI/TPI 1.
- 3) Gable studs spaced at 2-0-0 oc.
- 4) This truss has been designed for a 10.0 psf bottom chord live load nonconcurrent with any other live loads.
- 5) Refer to girder(s) for truss to truss connections.
- 6) Provide mechanical connection (by others) of truss to bearing plate capable of withstanding 100 lb uplift at joint(s) 4, 2.
- 7) This truss is designed in accordance with the 2018 International Residential Code sections R502.11.1 and R802.10.2 and referenced standard ANSI/TPI 1.
- 8) This truss design requires that a minimum of 7/16" structural wood sheathing be applied directly to the top chord and 1/2" gypsum sheetrock be applied directly to the bottom chord.



December 28, 2021

WARNING - Verify design parameters and READ NOTES ON THIS AND INCLUDED MITEK REFERENCE PAGE MII-7473 rev. 5/19/2020 BEFORE USE.

Design valid for use only with MiTek® connectors. This design is based only upon parameters shown, and is for an individual building component, not a truss system. Before use, the building designer must verify the applicability of design parameters and properly incorporate this design into the overall building design. Bracing indicated is to prevent buckling of individual truss web and/or chord members only. Additional temporary and permanent bracing is always required for stability and to prevent collapse with possible personal injury and property damage. For general guidance regarding the fabrication, storage, delivery, erection and bracing of trusses and truss systems, see

ANSI/TPI1 Quality Criteria, DSB-89 and BCSI Building Component

Safety Information available from Truss Plate Institute, 2670 Crain Highway, Suite 203 Waldorf, MD 20601




16023 Swingley Ridge Rd
Chesterfield, MO 63017

Builders FirstSource (Valley Center),	Valley Center, KS - 67147,
---------------------------------------	----------------------------

8.430 s Aug 16 2021 MiTek Industries, Inc Mon Dec 27 09:45:32 2021 Page 1
ID:xKFGJ7evN?7xhJE66FFHnCzvA57-GyPvGIHS6ZibNgCq3aZeeyUWYeD1api Z4YdfdytoX

 Dec 27 09:45:32 2021 Page 1
ZeeVWWeD1api_Z4Ydfuy4oX



LUMBER-		BRACING-	
TOP CHORD	2x4 SPF No.2	TOP CHORD	Structural wood sheathing directly applied or 4-10-6 oc purlins, except end verticals.
BOT CHORD	2x4 SPF No.2		
WEBS	2x4 SPF No.2	BOT CHORD	Rigid ceiling directly applied or 10-0-0 oc bracing.
OTHERS	2x4 SPF No.2		

REACTIONS. (size) 5=4-10-6, 2=4-10-6, 6=4-10-6
 Max Horiz 2=69(LC 11)
 Max Uplift 5=-29(LC 1), 2=-53(LC 8), 6=-70(LC 12)
 Max Grav 5=10(LC 12), 2=200(LC 1), 6=314(LC 1)

FORCES. (lb) - Max. Comp./Max. Ten. - All forces 250 (lb) or less except when shown.
WEBS 3-6=-240/318

NOTES-

- 1) Wind: ASCE 7-16; Vult=115mph (3-second gust) Vasd=91mph; TCDL=6.0psf; BCDL=4.2psf; h=15ft; Cat. II; Exp C; Enclosed; MWFRS (envelope) gable end zone and C-C Corner(3E) -0-10-8 to 2-1-8, Exterior(2N) 2-1-8 to 4-8-10 zone; cantilever left and right exposed ; end vertical left and right exposed; C-C for members and forces & MWFRS for reactions shown; Lumber DOL=1.60 plate grip DOL=1.60
- 2) Truss designed for wind loads in the plane of the truss only. For studs exposed to wind (normal to the face), see Standard Industry Gable End Details as applicable, or consult qualified building designer as per ANSI/TPI 1.
- 3) Gable requires continuous bottom chord bearing.
- 4) Gable studs spaced at 1-4-0 oc.
- 5) This truss has been designed for a 10.0 psf bottom chord live load nonconcurrent with any other live loads.
- 6) Provide mechanical connection (by others) of truss to bearing plate capable of withstanding 100 lb uplift at joint(s) 5, 2, 6.
- 7) This truss is designed in accordance with the 2018 International Residential Code sections R502.11.1 and R802.10.2 and referenced standard ANSI/TPI 1.



December 28, 2021



Design valid for use only with MiTEK® connectors. This design is based only upon parameters shown, and is for an individual building component, not a truss system. Before use, the building designer must verify the applicability of design parameters and properly incorporate this design into the overall building design. Bracing indicated is to prevent buckling of individual truss web and/or chord members only. Additional temporary and permanent bracing is always required for stability and to prevent collapse with possible personnel injury and property damage. For general guidance regarding the fabrication, storage, delivery, erection and bracing of trusses and truss systems, see **ANSI/TPI1 Quality Criteria, DSB-89 and BCSI Building Code**


Safety Information available from Truss Plate Institute, 2670 Crain Highway, Suite 203 Waldorf, MD 20601



16023 Swingley Ridge Rd
Chesterfield, MO 63017

Job	Truss	Truss Type	Qty	Ply	C&H/159 COBEY CREEK/MO	RELEASE FOR CONSTRUCTION
3008841	E1	Common Supported Gable	1	1		AS NOTED FOR PLAN REVIEW
					Job Reference (optional)	DEVELOPMENT SERVICES
						LEE'S SUMMIT, MISSOURI

Builders FirstSource (Valley Center), Valley Center, KS - 67147, 8.430 s Aug 16 2021 MiTek Industries, Inc. Mon Dec 27 09:45:33 2021 Page 1
ID:xKFGJ7evN?7xhJE66FFHnCzvA57-k9zHTel4tts?_h0cY4tEs2vP1ZJGD7ck1AB8y4ojY 22-0-0 22-10-8 0-10-8 11-0-0 11-0-0 0-10-8
Scale = 1:38.1

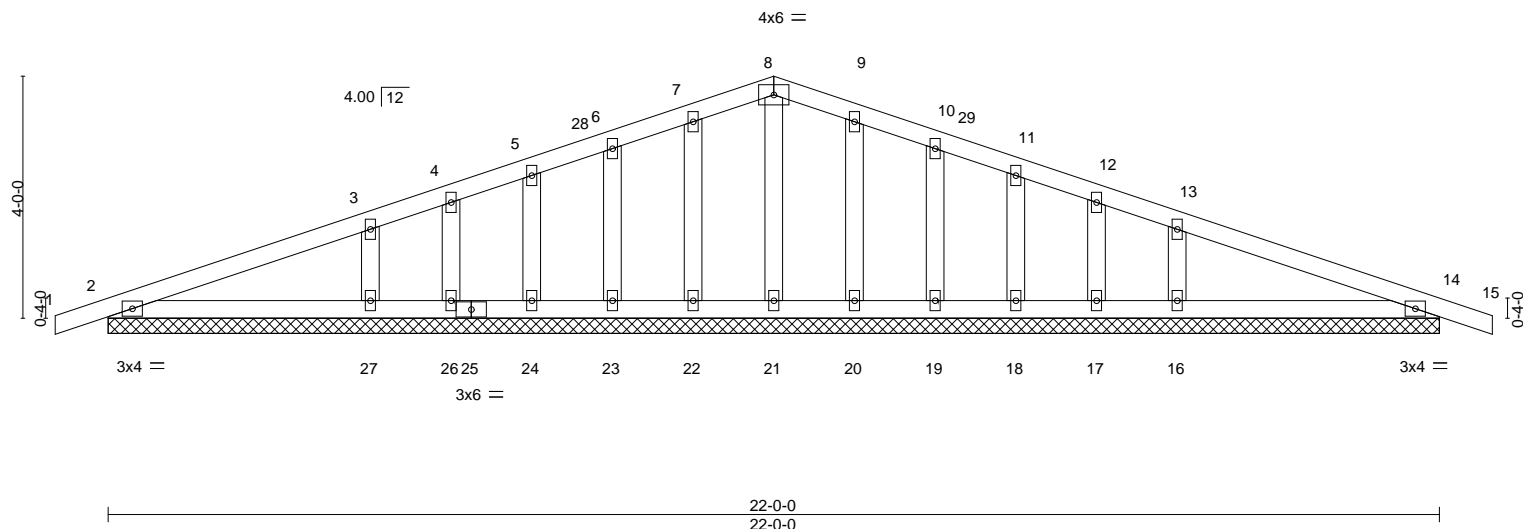

LOADING (psf)	SPACING-	2-0-0	CSI.	DEFL.	in	(loc)	l/defl	L/d	PLATES	GRIP
TCLL 25.0	Plate Grip DOL	1.15	TC 0.21	Vert(LL)	0.01	15	n/r	120	MT20	197/144
TCDL 10.0	Lumber DOL	1.15	BC 0.12	Vert(CT)	0.01	15	n/r	120		
BCLL 0.0	Rep Stress Incr	YES	WB 0.04	Horz(CT)	0.00	14	n/a	n/a		
BCDL 10.0	Code IRC2018/TPI2014		Matrix-S						Weight: 82 lb	FT = 20%

LUMBER-
TOP CHORD 2x4 SPF No.2
BOT CHORD 2x4 SPF No.2
OTHERS 2x4 SPF No.2

BRACING-
TOP CHORD Structural wood sheathing directly applied or 6'-0" oc purlins.
BOT CHORD Rigid ceiling directly applied or 10'-0" oc bracing.

REACTIONS. All bearings 22-0-0.
(lb) - Max Horz 2=63(LC 12)
Max Uplift All uplift 100 lb or less at joint(s) 2, 22, 23, 24, 26, 27, 20, 19, 18, 17, 16, 14
Max Grav All reactions 250 lb or less at joint(s) 2, 21, 22, 23, 24, 26, 20, 19, 18, 17, 14 except 27=417(LC 25), 16=417(LC 26)

FORCES. (lb) - Max. Comp./Max. Ten. - All forces 250 (lb) or less except when shown.
WEBS 3-27=-303/147, 13-16=-303/147


 
- NOTES-**
- 1) Unbalanced roof live loads have been considered for this design.
 - 2) Wind: ASCE 7-16; Vult=115mph (3-second gust) Vasd=91mph; TCDL=6.0psf; BCDL=4.2psf; h=15ft; Cat. II; Exp C; Enclosed; MWFRS (envelope) gable end zone and C-C Corner(3E) -0-10-8 to 2-1-8, Exterior(2N) 2-1-8 to 11-0-0, Corner(3R) 11-0-0 to 14-0-0, Exterior(2N) 14-0-0 to 22-10-8 zone; cantilever left and right exposed; end vertical left and right exposed; C-C for members and forces & MWFRS for reactions shown; Lumber DOL=1.60 plate grip DOL=1.60
 - 3) Truss designed for wind loads in the plane of the truss only. For studs exposed to wind (normal to the face), see Standard Industry Gable End Details as applicable, or consult qualified building designer as per ANSI/TPI 1.
 - 4) All plates are 2x4 MT20 unless otherwise indicated.
 - 5) Gable requires continuous bottom chord bearing.
 - 6) Gable studs spaced at 1'-4" oc.
 - 7) This truss has been designed for a 10.0 psf bottom chord live load nonconcurrent with any other live loads.
 - 8) Provide mechanical connection (by others) of truss to bearing plate capable of withstanding 100 lb uplift at joint(s) 2, 22, 23, 24, 26, 27, 20, 19, 18, 17, 16, 14.
 - 9) This truss is designed in accordance with the 2018 International Residential Code sections R502.11.1 and R802.10.2 and referenced standard ANSI/TPI 1.



December 28, 2021

Builders FirstSource (Valley Center), Valley Center, KS - 67147,

8.430 s Aug 16 2021 MiTek Industries, Inc Mon Dec 27 09:45:35 2021 Page 1

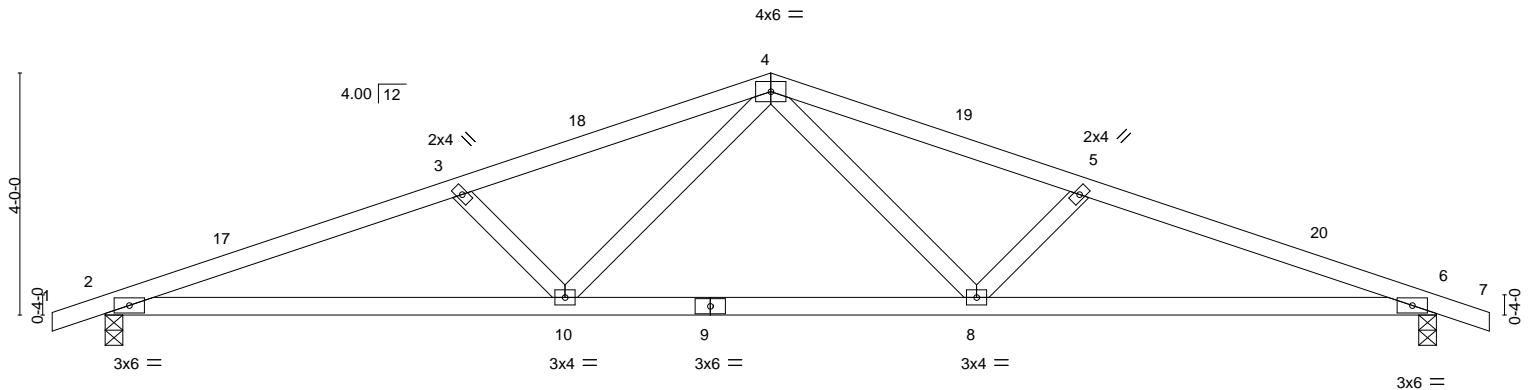

				7-7-3		14-4-13				22-0-0			
				7-7-3		6-9-10				7-7-3			
LOADING	(psf)	SPACING-	2-0-0	CSI.		DEFL.	in	(loc)		l/defl	L/d	PLATES	GRIP
TCLL	25.0	Plate Grip DOL	1.15	TC	0.38	Vert(LL)	-0.12	10		>999	240	MT20	197/144
TCDL	10.0	Lumber DOL	1.15	BC	0.69	Vert(CT)	-0.25	10-13		>999	180		
BCLL	0.0	Rep Stress Incr	YES	WB	0.16	Horz(CT)	0.06	6		n/a	n/a		
BCDL	10.0	Code IRC2018/TPI2014		Matrix-AS								Weight: 70 lb	FT = 20%

TOP CHORD	2x4 SPF No.2
BOT CHORD	2x4 SPF No.2
WEBS	2x4 SPF No.2

TOP CHORD	Structural wood sheathing directly applied.
BOT CHORD	Rigid ceiling directly applied.

(size) 2=0-3-8, 6=0-3-8
 Max Horz 2=63(LC 12)
 Max Uplift 2=-176(LC 8), 6=-176(LC 9)
 Max Grav 2=1051(LC 1), 6=1051(LC 1)

TOP CHORD 2-3=-2359/458, 3-4=-2082/411, 4-5=-2082/411, 5-6=-2359/458
BOT CHORD 2-10=-380/2208, 8-10=-213/1483, 6-8=-381/2208
WEBS 4-8=-96/659, 5-8=-448/170, 4-10=-95/659, 3-10=-448/169

- 1) Unbalanced roof live loads have been considered for this design
- 2) Wind: ASCE 7-16; Vult=115mph (3-second gust) Vasd=91mph; TC DL=6.0psf; BCDL=4.2psf; h=15ft; Cat. II; Exp C; Enclosed; MWFRS (envelope) gable end zone and C-C Exterior(2E) -0-10-8 to 2-1-8, Interior(1) 2-1-8 to 11-0-0, Exterior(2R) 11-0-0 to 14-0-0, Interior(1) 14-0-0 to 22-10-8 zone; cantilever left and right exposed ; end vertical left and right exposed; C-C for members and forces & MWFRS for reactions shown; Lumber DOL=1.60 plate grip DOL=1.60
- 3) This truss has been designed for a 10.0 psf bottom chord live load nonconcurrent with any other live loads.
- 4) Provide mechanical connection (by others) of truss to bearing plate capable of withstanding 100 lb uplift at joint(s) except (jt=lb) 2=176, 6=176.
- 5) This truss is designed in accordance with the 2018 International Residential Code sections R502.11.1 and R802.10.2 and referenced standard ANSI/TPI 1.
- 6) This truss design requires that a minimum of 7/16" structural wood sheathing be applied directly to the top chord and 1/2" gypsum sheetrock be applied directly to the bottom chord.



December 28, 2021



Design valid for use only with MiTek® connectors. This design is based only upon parameters shown, and is for an individual building component, not a truss system. Before use, the building designer must verify the applicability of design parameters and properly incorporate this design into the overall building design. Bracing indicated is to prevent buckling of individual truss web and/or chord members only. Additional temporary and permanent bracing is always required for stability and to prevent collapse with possible personal injury and property damage. For general guidance regarding the fabrication, storage, delivery, erection and bracing of trusses and truss systems, see **ANSI/TPI1 Quality Criteria, DSB-89 and BCSI Building Code**.

Safety Information available from Truss Plate Institute, 2670 Crain Highway, Suite 203 Waldorf, MD 20601



16023 Swingley Ridge Rd
Chesterfield, MO 63017

Job	Truss	Truss Type	Qty	Ply	C&H/159 COBEY CREEK/MO	RELEASE FOR CONSTRUCTION
3008841	V1	Valley	1	1		AS NOTED FOR PLAN REVIEW
					Job Reference (optional)	DEVELOPMENT SERVICES
						LEE'S SUMMIT, MISSOURI


Builders FirstSource (Valley Center),

Valley Center, KS - 67147,

8.430 s Aug 16 2021 MiTek Industries, Inc. Mon Dec 27 09:45:36 2021 Page 1

ID:xKFGJ7evN?7xhJE66FFHnCzvA57-9kfP5fLzAoE1sRWbldaoVgPpFZkWntZUWgonyt0T

02/11/2022

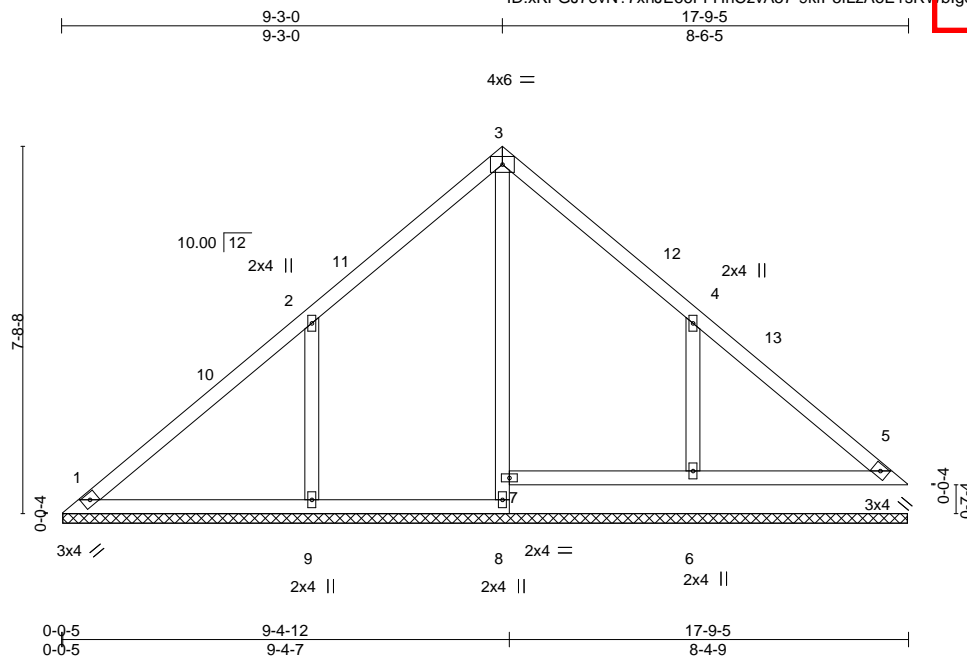

LOADING (psf)	SPACING-	2-0-0	CSI.	DEFL.	in (loc)	l/defl	L/d	PLATES	GRIP
TCLL 25.0	Plate Grip DOL	1.15	TC 0.31	Vert(LL)	n/a	-	n/a	MT20	197/144
TCDL 10.0	Lumber DOL	1.15	BC 0.16	Vert(CT)	n/a	-	n/a		
BCLL 0.0	Rep Stress Incr	YES	WB 0.11	Horz(CT)	0.01	5	n/a		
BCDL 10.0	Code IRC2018/TPI2014		Matrix-S					Weight: 62 lb	FT = 20%

LUMBER-

TOP CHORD 2x4 SPF No.2
BOT CHORD 2x4 SPF No.2
OTHERS 2x4 SPF No.2

BRACING-

TOP CHORD Structural wood sheathing directly applied or 6-0-0 oc purlins.
BOT CHORD Rigid ceiling directly applied or 10-0-0 oc bracing.

REACTIONS.

- All bearings 17-8-11.
(lb) - Max Horz 1=171(LC 9)
Max Uplift All uplift 100 lb or less at joint(s) 1, 5 except 9=227(LC 12), 6=198(LC 13)
Max Grav All reactions 250 lb or less at joint(s) 1, 5, 8 except 7=260(LC 22), 9=508(LC 19), 6=460(LC 20)

FORCES.

(lb) - Max. Comp./Max. Ten. - All forces 250 (lb) or less except when shown.

WEBS

2-9=-390/258, 4-6=-354/236

NOTES-

- Unbalanced roof live loads have been considered for this design.
- Wind: ASCE 7-16; Vult=115mph (3-second gust) Vasd=91mph; TCDL=6.0psf; BCDL=4.2psf; h=15ft; Cat. II; Exp C; Enclosed; MWFRS (envelope) gable end zone and C-C Exterior(2E) 0-4-13 to 3-4-13, Interior(1) 3-4-13 to 9-3-0, Exterior(2R) 9-3-0 to 12-3-0, Interior(1) 12-3-0 to 17-4-8 zone; cantilever left and right exposed; end vertical left and right exposed; C-C for members and forces & MWFRS for reactions shown; Lumber DOL=1.60 plate grip DOL=1.60
- Gable requires continuous bottom chord bearing.
- This truss has been designed for a 10.0 psf bottom chord live load nonconcurrent with any other live loads.
- Bearing at joint(s) 7 considers parallel to grain value using ANSI/TPI 1 angle to grain formula. Building designer should verify capacity of bearing surface.
- Provide mechanical connection (by others) of truss to bearing plate capable of withstanding 100 lb uplift at joint(s) 1, 5 except (jt=lb) 9=227, 6=198.
- Beveled plate or shim required to provide full bearing surface with truss chord at joint(s) 5, 6.
- This truss is designed in accordance with the 2018 International Residential Code sections R502.11.1 and R802.10.2 and referenced standard ANSI/TPI 1.



December 28, 2021

WARNING - Verify design parameters and READ NOTES ON THIS AND INCLUDED MITEK REFERENCE PAGE MII-7473 rev. 5/19/2020 BEFORE USE.

Design valid for use only with MiTek® connectors. This design is based only upon parameters shown, and is for an individual building component, not a truss system. Before use, the building designer must verify the applicability of design parameters and properly incorporate this design into the overall building design. Bracing indicated is to prevent buckling of individual truss web and/or chord members only. Additional temporary and permanent bracing is always required for stability and to prevent collapse with possible personal injury and property damage. For general guidance regarding the fabrication, storage, delivery, erection and bracing of trusses and truss systems, see

ANSI/TPI1 Quality Criteria, DSB-89 and BCSI Building Component

Safety Information available from Truss Plate Institute, 2670 Crain Highway, Suite 203 Waldorf, MD 20601



16023 Swingley Ridge Rd
Chesterfield, MO 63017

Job	Truss	Truss Type	Qty	Ply	C&H/159 COBEY CREEK/MO	RELEASE FOR CONSTRUCTION
3008841	V2	Valley	1	1		AS NOTED FOR PLAN REVIEW
					Job Reference (optional)	DEVELOPMENT SERVICES
						LEE'S SUMMIT, MISSOURI


Builders FirstSource (Valley Center),

Valley Center, KS - 67147,

8.430 s Aug 16 2021 MiTek Industries, Inc Mon Dec 27 09:45:37 2021 Page 1

ID:xKFGJ7evN?77xhJE66FFHnCzvA57-dwDoJ?Lbx5MuU4nrN9pLiD6F7wUf2qijM GOKDy4oS

02/11/2022

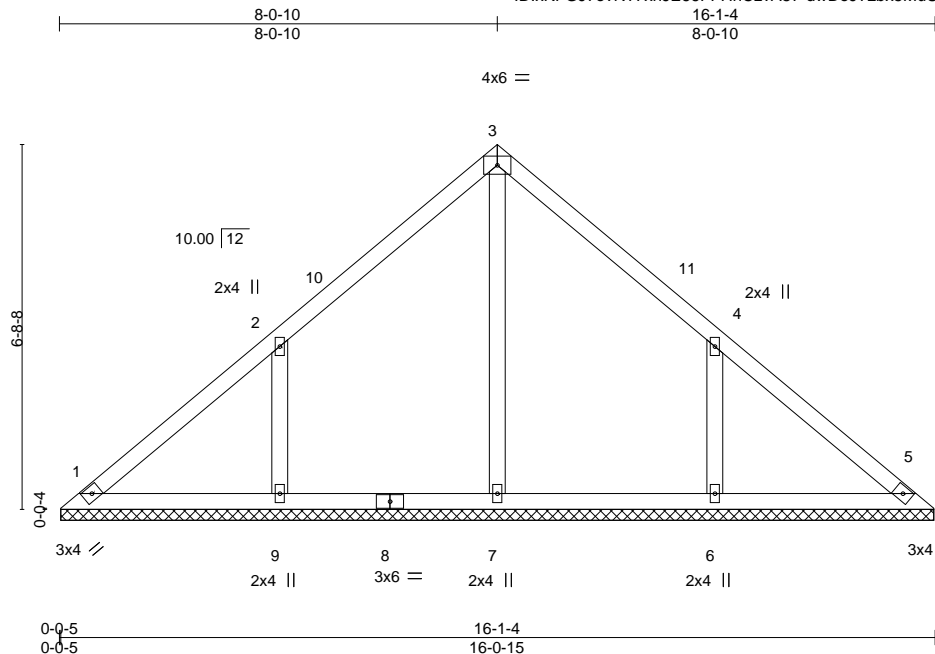

Scale = 1:42.4

LOADING (psf)	SPACING-	2-0-0	CSI.	DEFL.	in (loc)	l/defl	L/d	PLATES	GRIP
TCLL 25.0	Plate Grip DOL	1.15	TC 0.20	Vert(LL)	n/a	-	n/a	999	MT20
TCDL 10.0	Lumber DOL	1.15	BC 0.10	Vert(CT)	n/a	-	n/a	999	197/144
BCLL 0.0	Rep Stress Incr	YES	WB 0.13	Horz(CT)	0.00	5	n/a	n/a	
BCDL 10.0	Code IRC2018/TPI2014		Matrix-S						
								Weight: 54 lb	FT = 20%

LUMBER-

TOP CHORD 2x4 SPF No.2
BOT CHORD 2x4 SPF No.2
OTHERS 2x4 SPF No.2

BRACING-

TOP CHORD Structural wood sheathing directly applied or 6'-0" oc purlins.
BOT CHORD Rigid ceiling directly applied or 10'-0" oc bracing.

REACTIONS.

All bearings 16'-0".
(lb) - Max Horz 1=149(LC 9)
Max Uplift All uplift 100 lb or less at joint(s) 1 except 9=194(LC 12), 6=193(LC 13)
Max Grav All reactions 250 lb or less at joint(s) 1, 5 except 7=255(LC 1), 9=426(LC 19), 6=426(LC 20)

FORCES.

(lb) - Max. Comp./Max. Ten. - All forces 250 (lb) or less except when shown.

WEBS

2-9=333/222, 4-6=333/222

NOTES-

- Unbalanced roof live loads have been considered for this design.
- Wind: ASCE 7-16; Vult=115mph (3-second gust) Vasd=91mph; TCDL=6.0psf; BCDL=4.2psf; h=15ft; Cat. II; Exp C; Enclosed; MWFRS (envelope) gable end zone and C-C Exterior(2E) 0-4-13 to 3-4-13, Interior(1) 3-4-13 to 8-0-10, Exterior(2R) 8-0-10 to 11-0-10, Interior(1) 11-0-10 to 15-8-6 zone; cantilever left and right exposed; end vertical left and right exposed; C-C for members and forces & MWFRS for reactions shown; Lumber DOL=1.60 plate grip DOL=1.60
- Gable requires continuous bottom chord bearing.
- This truss has been designed for a 10.0 psf bottom chord live load nonconcurrent with any other live loads.
- Provide mechanical connection (by others) of truss to bearing plate capable of withstanding 100 lb uplift at joint(s) 1 except (jt=lb) 9=194, 6=193.
- This truss is designed in accordance with the 2018 International Residential Code sections R502.11.1 and R802.10.2 and referenced standard ANSI/TPI 1.



December 28, 2021

WARNING - Verify design parameters and READ NOTES ON THIS AND INCLUDED MITEK REFERENCE PAGE MII-7473 rev. 5/19/2020 BEFORE USE.

Design valid for use only with MiTek® connectors. This design is based only upon parameters shown, and is for an individual building component, not a truss system. Before use, the building designer must verify the applicability of design parameters and properly incorporate this design into the overall building design. Bracing indicated is to prevent buckling of individual truss web and/or chord members only. Additional temporary and permanent bracing is always required for stability and to prevent collapse with possible personal injury and property damage. For general guidance regarding the fabrication, storage, delivery, erection and bracing of trusses and truss systems, see

ANSI/TPI1 Quality Criteria, DSB-89 and BCSI Building Component

Safety Information available from Truss Plate Institute, 2670 Crain Highway, Suite 203 Waldorf, MD 20601



16023 Swingley Ridge Rd
Chesterfield, MO 63017

Job	Truss	Truss Type	Qty	Ply	C&H/159 COBEY CREEK/MO	AS NOTED FOR PLAN REVIEW DEVELOPMENT SERVICES LEE'S SUMMIT, MISSOURI
3008841	V3	Valley	1	1	Job Reference (optional)	149432098

Builders FirstSource (Valley Center),

Valley Center, KS - 67147,

8.430 s Aug 16 2021 MiTek Industries, Inc. Mon Dec 27 09:45:38 2021 Page 1


ID: xKFGJ7evN7?xhJE66FFHnCzvA57-56nAWLMDiPU5f_P5g2uwnP268_vask0pxsgy40R

02/11/2022

6-10-3
6-10-3
13-8-7
6-10-3

4x6 =

Scale = 1:36.1

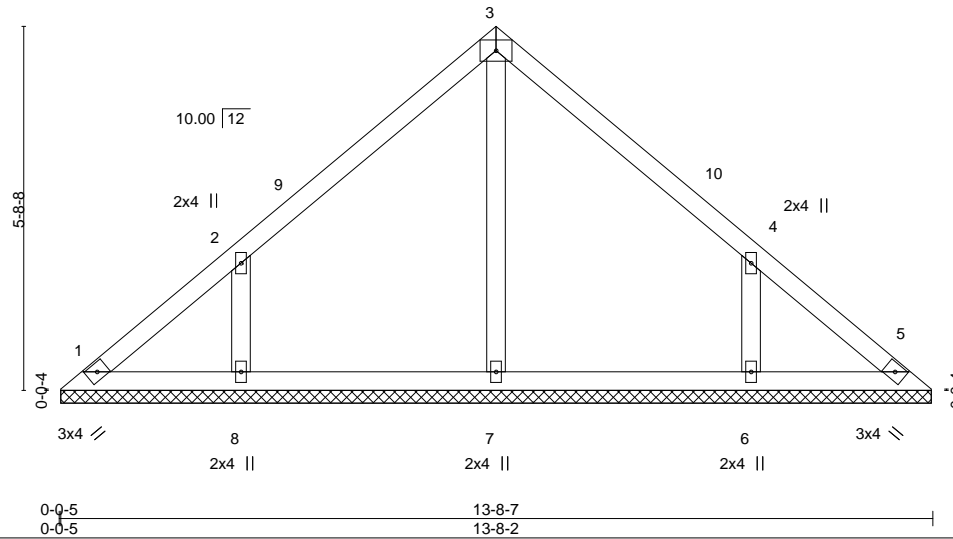

LOADING (psf)	SPACING-	2-0-0	CSI.	DEFL.	in (loc)	l/defl	L/d	PLATES	GRIP
TCLL 25.0	Plate Grip DOL	1.15	TC 0.17	Vert(LL)	n/a	-	n/a	MT20	197/144
BCDL 10.0	Lumber DOL	1.15	BC 0.10	Vert(CT)	n/a	-	n/a		
BCLL 0.0	Rep Stress Incr	YES	WB 0.10	Horz(CT)	0.00	5	n/a		
BCDL 10.0	Code IRC2018/TPI2014		Matrix-S					Weight: 45 lb	FT = 20%

LUMBER-

TOP CHORD 2x4 SPF No.2
BOT CHORD 2x4 SPF No.2
OTHERS 2x4 SPF No.2

BRACING-

TOP CHORD Structural wood sheathing directly applied or 6-0-0 oc purlins.
BOT CHORD Rigid ceiling directly applied or 10-0-0 oc bracing.

REACTIONS.

All bearings 13-7-13.

(lb) - Max Horz 1=126(LC 8)

Max Uplift All uplift 100 lb or less at joint(s) 1, 5 except 8=168(LC 12), 6=168(LC 13)

Max Grav All reactions 250 lb or less at joint(s) 1, 5 except 7=273(LC 1), 8=364(LC 19), 6=364(LC 20)

FORCES. (lb) - Max. Comp./Max. Ten. - All forces 250 (lb) or less except when shown.

WEBS 2-8=-292/197, 4-6=-292/196

NOTES-

- Unbalanced roof live loads have been considered for this design.
- Wind: ASCE 7-16; Vult=115mph (3-second gust) Vasd=91mph; TCCL=6.0psf; BCDL=4.2psf; h=15ft; Cat. II; Exp C; Enclosed; MWFRS (envelope) gable end zone and C-C Exterior(2E) 0-4-13 to 3-4-13, Interior(1) 3-4-13 to 6-10-3, Exterior(2R) 6-10-3 to 9-10-3, Interior(1) 9-10-3 to 13-3-9 zone; cantilever left and right exposed; end vertical left and right exposed; C-C for members and forces & MWFRS for reactions shown; Lumber DOL=1.60 plate grip DOL=1.60
- Gable requires continuous bottom chord bearing.
- This truss has been designed for a 10.0 psf bottom chord live load nonconcurrent with any other live loads.
- Provide mechanical connection (by others) of truss to bearing plate capable of withstanding 100 lb uplift at joint(s) 1, 5 except (jt=lb) 8=168, 6=168.
- This truss is designed in accordance with the 2018 International Residential Code sections R502.11.1 and R802.10.2 and referenced standard ANSI/TPI 1.



December 28, 2021

WARNING - Verify design parameters and READ NOTES ON THIS AND INCLUDED MITEK REFERENCE PAGE MII-7473 rev. 5/19/2020 BEFORE USE.

Design valid for use only with MiTek® connectors. This design is based only upon parameters shown, and is for an individual building component, not a truss system. Before use, the building designer must verify the applicability of design parameters and properly incorporate this design into the overall building design. Bracing indicated is to prevent buckling of individual truss web and/or chord members only. Additional temporary and permanent bracing is always required for stability and to prevent collapse with possible personal injury and property damage. For general guidance regarding the fabrication, storage, delivery, erection and bracing of trusses and truss systems, see

ANSI/TPI1 Quality Criteria, DSB-89 and BCSI Building Component

Safety Information available from Truss Plate Institute, 2670 Crain Highway, Suite 203 Waldorf, MD 20601



16023 Swingley Ridge Rd
Chesterfield, MO 63017

Job	Truss	Truss Type	Qty	Ply	C&H/159 COBEY CREEK/MO	RELEASE FOR CONSTRUCTION
3008841	V4	GABLE	1	1		AS NOTED FOR PLAN REVIEW
					Job Reference (optional)	DEVELOPMENT SERVICES
						LEE'S SUMMIT, MISSOURI


Builders FirstSource (Valley Center),

Valley Center, KS - 67147,

8.430 s Aug 16 2021 MiTek Industries, Inc. Mon Dec 27 09:45:39 2021 Page 1

ID:xKFGJ7evN77xhJE66FFHnCzvA57-ZIKYkhNrTjccvEazoBH07hzMSd5ja0AgjVQ6y4oC

02/11/2022

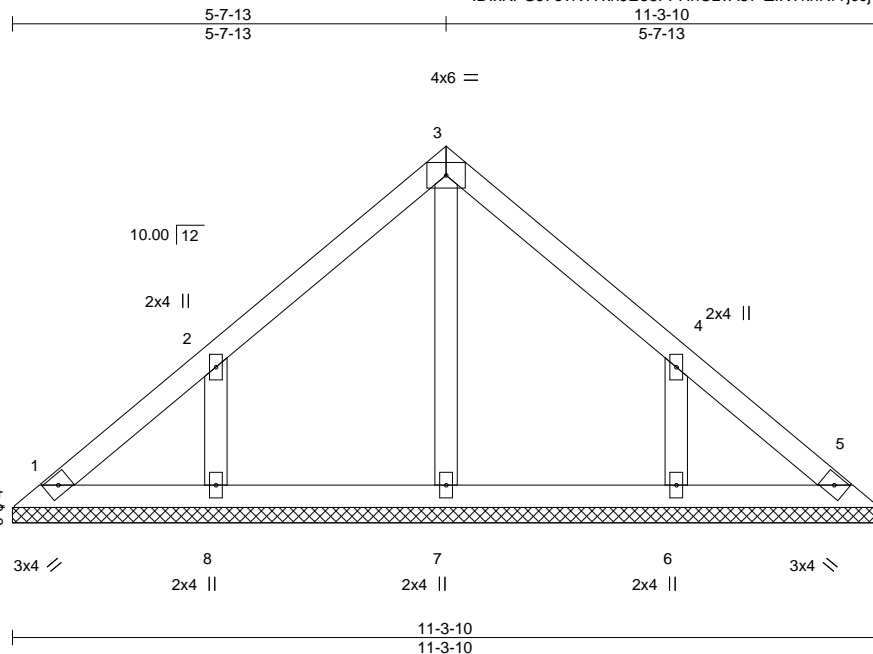

LOADING (psf)	SPACING-	2-0-0	CSI.	DEFL.	in (loc)	l/defl	L/d	PLATES	GRIP
TCLL 25.0	Plate Grip DOL	1.15	TC 0.10	Vert(LL)	n/a	-	n/a	999	MT20
TCDL 10.0	Lumber DOL	1.15	BC 0.05	Vert(CT)	n/a	-	n/a	999	197/144
BCLL 0.0	Rep Stress Incr	YES	WB 0.05	Horz(CT)	0.00	5	n/a	n/a	
BCDL 10.0	Code IRC2018/TPI2014		Matrix-S						
								Weight: 37 lb	FT = 20%

LUMBER-

TOP CHORD 2x4 SPF No.2
BOT CHORD 2x4 SPF No.2
OTHERS 2x4 SPF No.2

BRACING-

TOP CHORD Structural wood sheathing directly applied or 6-0-0 oc purlins.
BOT CHORD Rigid ceiling directly applied or 10-0-0 oc bracing.

REACTIONS.

All bearings 11-3-10.
(lb) - Max Horz 1=103(LC 9)
Max Uplift All uplift 100 lb or less at joint(s) 1 except 8=133(LC 12), 6=133(LC 13)
Max Grav All reactions 250 lb or less at joint(s) 1, 5, 7 except 8=292(LC 19), 6=291(LC 20)

FORCES. (lb) - Max. Comp./Max. Ten. - All forces 250 (lb) or less except when shown.

NOTES-

- Unbalanced roof live loads have been considered for this design.
- Wind: ASCE 7-16; Vult=115mph (3-second gust) Vasd=91mph; TCDL=6.0psf; BCDL=4.2psf; h=15ft; Cat. II; Exp C; Enclosed; MWFRS (envelope) gable end zone and C-C Exterior(2E) 0-4-13 to 3-4-13, Interior(1) 3-4-13 to 5-7-13, Exterior(2R) 5-7-13 to 8-7-13, Interior(1) 8-7-13 to 10-10-13 zone; cantilever left and right exposed; end vertical left and right exposed; C-C for members and forces & MWFRS for reactions shown; Lumber DOL=1.60 plate grip DOL=1.60
- Gable requires continuous bottom chord bearing.
- This truss has been designed for a 10.0 psf bottom chord live load nonconcurrent with any other live loads.
- Provide mechanical connection (by others) of truss to bearing plate capable of withstanding 100 lb uplift at joint(s) 1 except (jt=lb) 8=133, 6=133.
- This truss is designed in accordance with the 2018 International Residential Code sections R502.11.1 and R802.10.2 and referenced standard ANSI/TPI 1.



December 28, 2021

WARNING - Verify design parameters and READ NOTES ON THIS AND INCLUDED MITEK REFERENCE PAGE MII-7473 rev. 5/19/2020 BEFORE USE.

Design valid for use only with MiTek® connectors. This design is based only upon parameters shown, and is for an individual building component, not a truss system. Before use, the building designer must verify the applicability of design parameters and properly incorporate this design into the overall building design. Bracing indicated is to prevent buckling of individual truss web and/or chord members only. Additional temporary and permanent bracing is always required for stability and to prevent collapse with possible personal injury and property damage. For general guidance regarding the fabrication, storage, delivery, erection and bracing of trusses and truss systems, see **ANSI/TPI1 Quality Criteria, DSB-89 and BCSI Building Component**
Safety Information available from Truss Plate Institute, 2670 Crain Highway, Suite 203 Waldorf, MD 20601



16023 Swingley Ridge Rd
Chesterfield, MO 63017


Job	Truss	Truss Type	Qty	Ply	C&H/159 COBEY CREEK/MO	RELEASE FOR CONSTRUCTION
3008841	V5	GABLE	1	1		AS NOTED FOR PLAN REVIEW
					Job Reference (optional)	DEVELOPMENT SERVICES
						LEE'S SUMMIT, MISSOURI

Builders FirstSource (Valley Center), Valley Center, KS - 67147,

8.430 s Aug 16 2021 MiTek Industries, Inc Mon Dec 27 09:45:40 2021 Page 1

ID:xKFGJ7evN77xhJE66FFHnCzvA57-1VuwX1OTE0kTL3pXWwWLL73xvSCU9FKU2xYV40P

02/11/2022

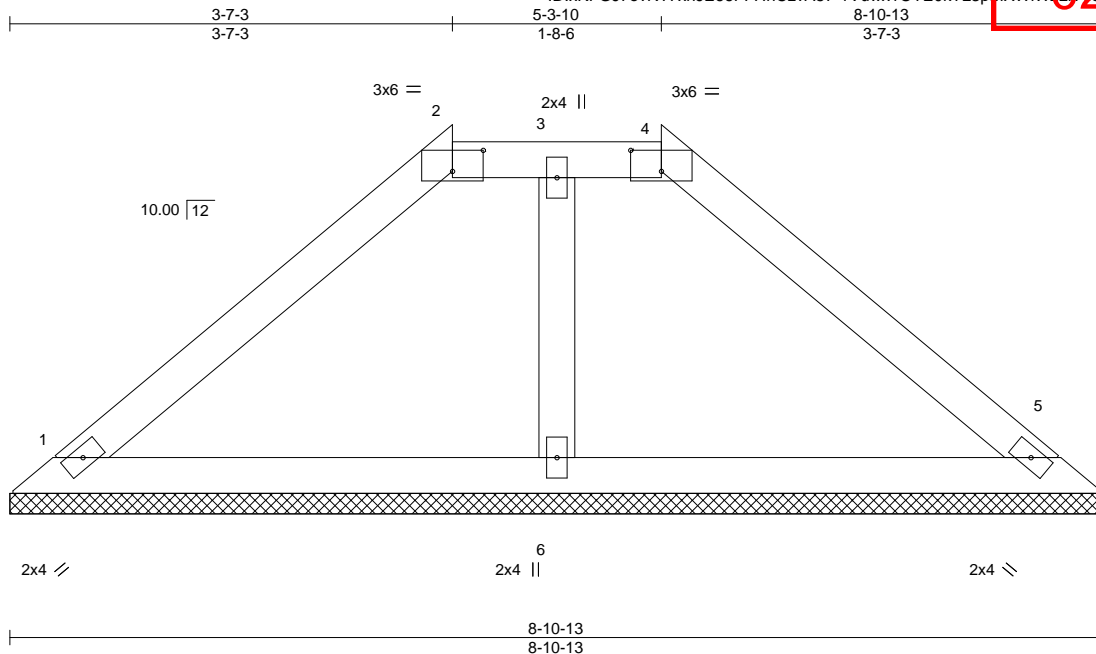

Scale = 1:18.7

Plate Offsets (X,Y)--		[2:0-3-0,0-2-1], [4:0-3-0,0-2-1]									
LOADING (psf)		SPACING-2-0-0		CSI.		DEFL. in (loc)		l/defl L/d		PLATES GRIP	
TCLL	25.0	Plate Grip DOL	1.15	TC	0.17	Vert(LL)	n/a	-	n/a	999	MT20 197/144
TCDL	10.0	Lumber DOL	1.15	BC	0.14	Vert(CT)	n/a	-	n/a	999	
BCLL	0.0	Rep Stress Incr	YES	WB	0.02	Horz(CT)	0.00	5	n/a	n/a	
BCDL	10.0	Code IRC2018/TPI2014		Matrix-S						Weight: 24 lb	FT = 20%

LUMBER-

TOP CHORD 2x4 SPF No.2
BOT CHORD 2x4 SPF No.2
OTHERS 2x4 SPF No.2

BRACING-

TOP CHORD Structural wood sheathing directly applied or 6-0-0 oc purlins, except 2-0-0 oc purlins (6-0-0 max.): 2-4.
BOT CHORD Rigid ceiling directly applied or 10-0-0 oc bracing.

REACTIONS.

(size) 1=8-10-13, 5=8-10-13, 6=8-10-13
Max Horz 1=61(LC 9)
Max Uplift 1=-55(LC 12), 5=-60(LC 13)
Max Grav 1=255(LC 1), 5=255(LC 1), 6=226(LC 3)

FORCES.

(lb) - Max. Comp./Max. Ten. - All forces 250 (lb) or less except when shown.
TOP CHORD 1-2=-263/134, 4-5=-263/143

NOTES-

- Unbalanced roof live loads have been considered for this design.
- Wind: ASCE 7-16; Vult=115mph (3-second gust) Vasd=91mph; TCDL=6.0psf; BCDL=4.2psf; h=15ft; Cat. II; Exp C; Enclosed; MWFRS (envelope) gable end zone and C-C Exterior(2E) zone; cantilever left and right exposed; end vertical left and right exposed; C-C for members and forces & MWFRS for reactions shown; Lumber DOL=1.60 plate grip DOL=1.60
- Provide adequate drainage to prevent water ponding.
- Gable requires continuous bottom chord bearing.
- This truss has been designed for a 10.0 psf bottom chord live load nonconcurrent with any other live loads.
- Provide mechanical connection (by others) of truss to bearing plate capable of withstanding 100 lb uplift at joint(s) 1, 5.
- This truss is designed in accordance with the 2018 International Residential Code sections R502.11.1 and R802.10.2 and referenced standard ANSI/TPI 1.
- Graphical purlin representation does not depict the size or the orientation of the purlin along the top and/or bottom chord.



December 28, 2021

WARNING - Verify design parameters and READ NOTES ON THIS AND INCLUDED MITEK REFERENCE PAGE MII-7473 rev. 5/19/2020 BEFORE USE.

Design valid for use only with MiTek® connectors. This design is based only upon parameters shown, and is for an individual building component, not a truss system. Before use, the building designer must verify the applicability of design parameters and properly incorporate this design into the overall building design. Bracing indicated is to prevent buckling of individual truss web and/or chord members only. Additional temporary and permanent bracing is always required for stability and to prevent collapse with possible personal injury and property damage. For general guidance regarding the fabrication, storage, delivery, erection and bracing of trusses and truss systems, see **ANSI/TPI1 Quality Criteria, DSB-89 and BCSI Building Component**
Safety Information available from Truss Plate Institute, 2670 Crain Highway, Suite 203 Waldorf, MD 20601




16023 Swingley Ridge Rd
Chesterfield, MO 63017


02/11/2022

Symbols

PLATE LOCATION AND ORIENTATION

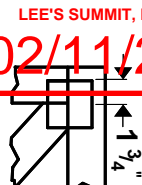

Center plate on joint unless x, y offsets are indicated. Dimensions are in ft-in-sixteenths. Apply plates to both sides of truss and fully embed teeth.

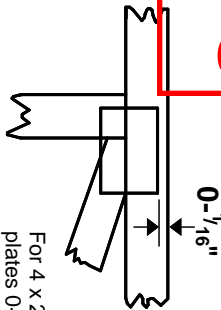

For 4 x 2 orientation, locate plates 0- 1/16" from outside edge of truss.

—
—
This symbol indicates the required direction of slots in connector plates.

* Plate location details available in **MiTek 20/20** software or upon request.

PLATE SIZE

4 X 4


The first dimension is the plate width measured perpendicular to slots. Second dimension is the length parallel to slots.

LATERAL BRACING LOCATION



Indicated by symbol shown and/or by text in the bracing section of the output. Use T or I bracing if indicated.

BEARING

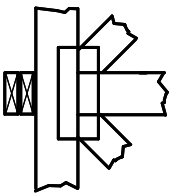


Indicates location where bearings (supports) occur. Icons vary but reaction section indicates joint number where bearings occur. Min size shown is for crushing only.

Industry Standards:

ANSI/TPI 1: National Design Specification for Metal Plate Connected Wood Truss Construction.
DSB-89: Building Component Safety Information, Guide to Good Practice for Handling, Installing & Bracing of Metal Plate Connected Wood Trusses.

Numbering System

6-4-8 dimensions shown in ft-in-sixteenths
(Drawings not to scale)

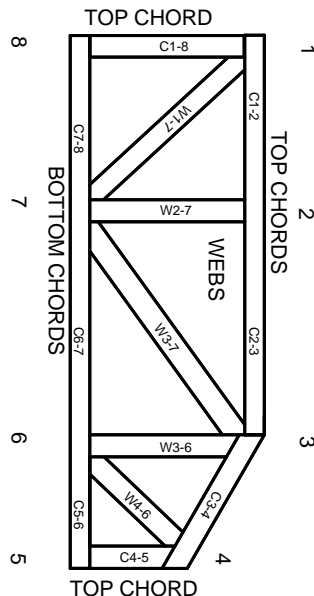

JOINTS ARE GENERALLY NUMBERED/LETTERED CLOCKWISE AROUND THE TRUSS STARTING AT THE JOINT FARTHEST TO THE LEFT.

CHORDS AND WEBS ARE IDENTIFIED BY END JOINT NUMBERS/LETTERS.

PRODUCT CODE APPROVALS

ICC-ES Reports:

ESR-1311, ESR-1352, ESR1988
ER-3907, ESR-2362, ESR-1397, ESR-3282

Trusses are designed for wind loads in the plane of the truss unless otherwise shown.

Lumber design values are in accordance with ANSI/TPI 1 section 6.3 These truss designs rely on lumber values established by others.

© 2012 MiTek® All Rights Reserved



MiTek Engineering Reference Sheet: MII-7473 rev. 5/19/2020



General Safety Notes

Failure to Follow Could Cause Property Damage or Personal Injury

1. Additional stability bracing for truss system, e.g. diagonal or X-bracing, is always required. See BCSI.
2. Truss bracing must be designed by an engineer. For wide truss spacing, individual lateral braces themselves may require bracing, or alternative Tor I bracing should be considered.
3. Never exceed the design loading shown and never stack materials on inadequately braced trusses.
4. Provide copies of this truss design to the building designer, erection supervisor, property owner and all other interested parties.
5. Cut members to bear tightly against each other.
6. Place plates on each face of truss at each joint and embed fully. Knots and wane at joint locations are regulated by ANSI/TPI 1.
7. Design assumes trusses will be suitably protected from the environment in accord with ANSI/TPI 1.
8. Unless otherwise noted, moisture content of lumber shall not exceed 19% at time of fabrication.
9. Unless expressly noted, this design is not applicable for use with fire retardant, preservative treated, or green lumber.
10. Camber is a non-structural consideration and is the responsibility of truss fabricator. General practice is to camber for dead load deflection.
11. Plate type, size, orientation and location dimensions indicated are minimum plating requirements.
12. Lumber used shall be of the species and size, and in all respects, equal to or better than that specified.
13. Top chords must be sheathed or purlins provided at spacing indicated on design.
14. Bottom chords require lateral bracing at 10 ft. spacing, or less, if no ceiling is installed, unless otherwise noted.
15. Connections not shown are the responsibility of others.
16. Do not cut or alter truss member or plate without prior approval of an engineer.
17. Install and load vertically unless indicated otherwise.
18. Use of green or treated lumber may pose unacceptable environmental, health or performance risks. Consult with project engineer before use.
19. Review all portions of this design (front, back, words and pictures) before use. Reviewing pictures alone is not sufficient.
20. Design assumes manufacture in accordance with ANSI/TPI 1 Quality Criteria.
21. The design does not take into account any dynamic or other loads other than those expressly stated.