

EVERSTEAD
SHOP DRAWINGS/SUBMITTAL REVIEW

SUBMITTAL WAS REVIEWED FOR DESIGN CONFORMITY AND GENERAL CONFORMANCE TO CONTRACT DOCUMENTS ONLY. THE CONTRACTOR IS RESPONSIBLE FOR CONFIRMING AND CORRELATING DIMENSIONS AT JOBSITE FOR TOLERANCE, CLEARANCE, QUANTITIES, FABRICATION, COORDINATION OF HIS OR HER WORK WITH OTHER TRADES, AND FULL COMPLIANCE WITH CONTRACT DOCUMENTS.

STATUS:

APPROVED
02/22/2022

REVIEWED BY:
CPD

ENGINEER, EVERSTEAD


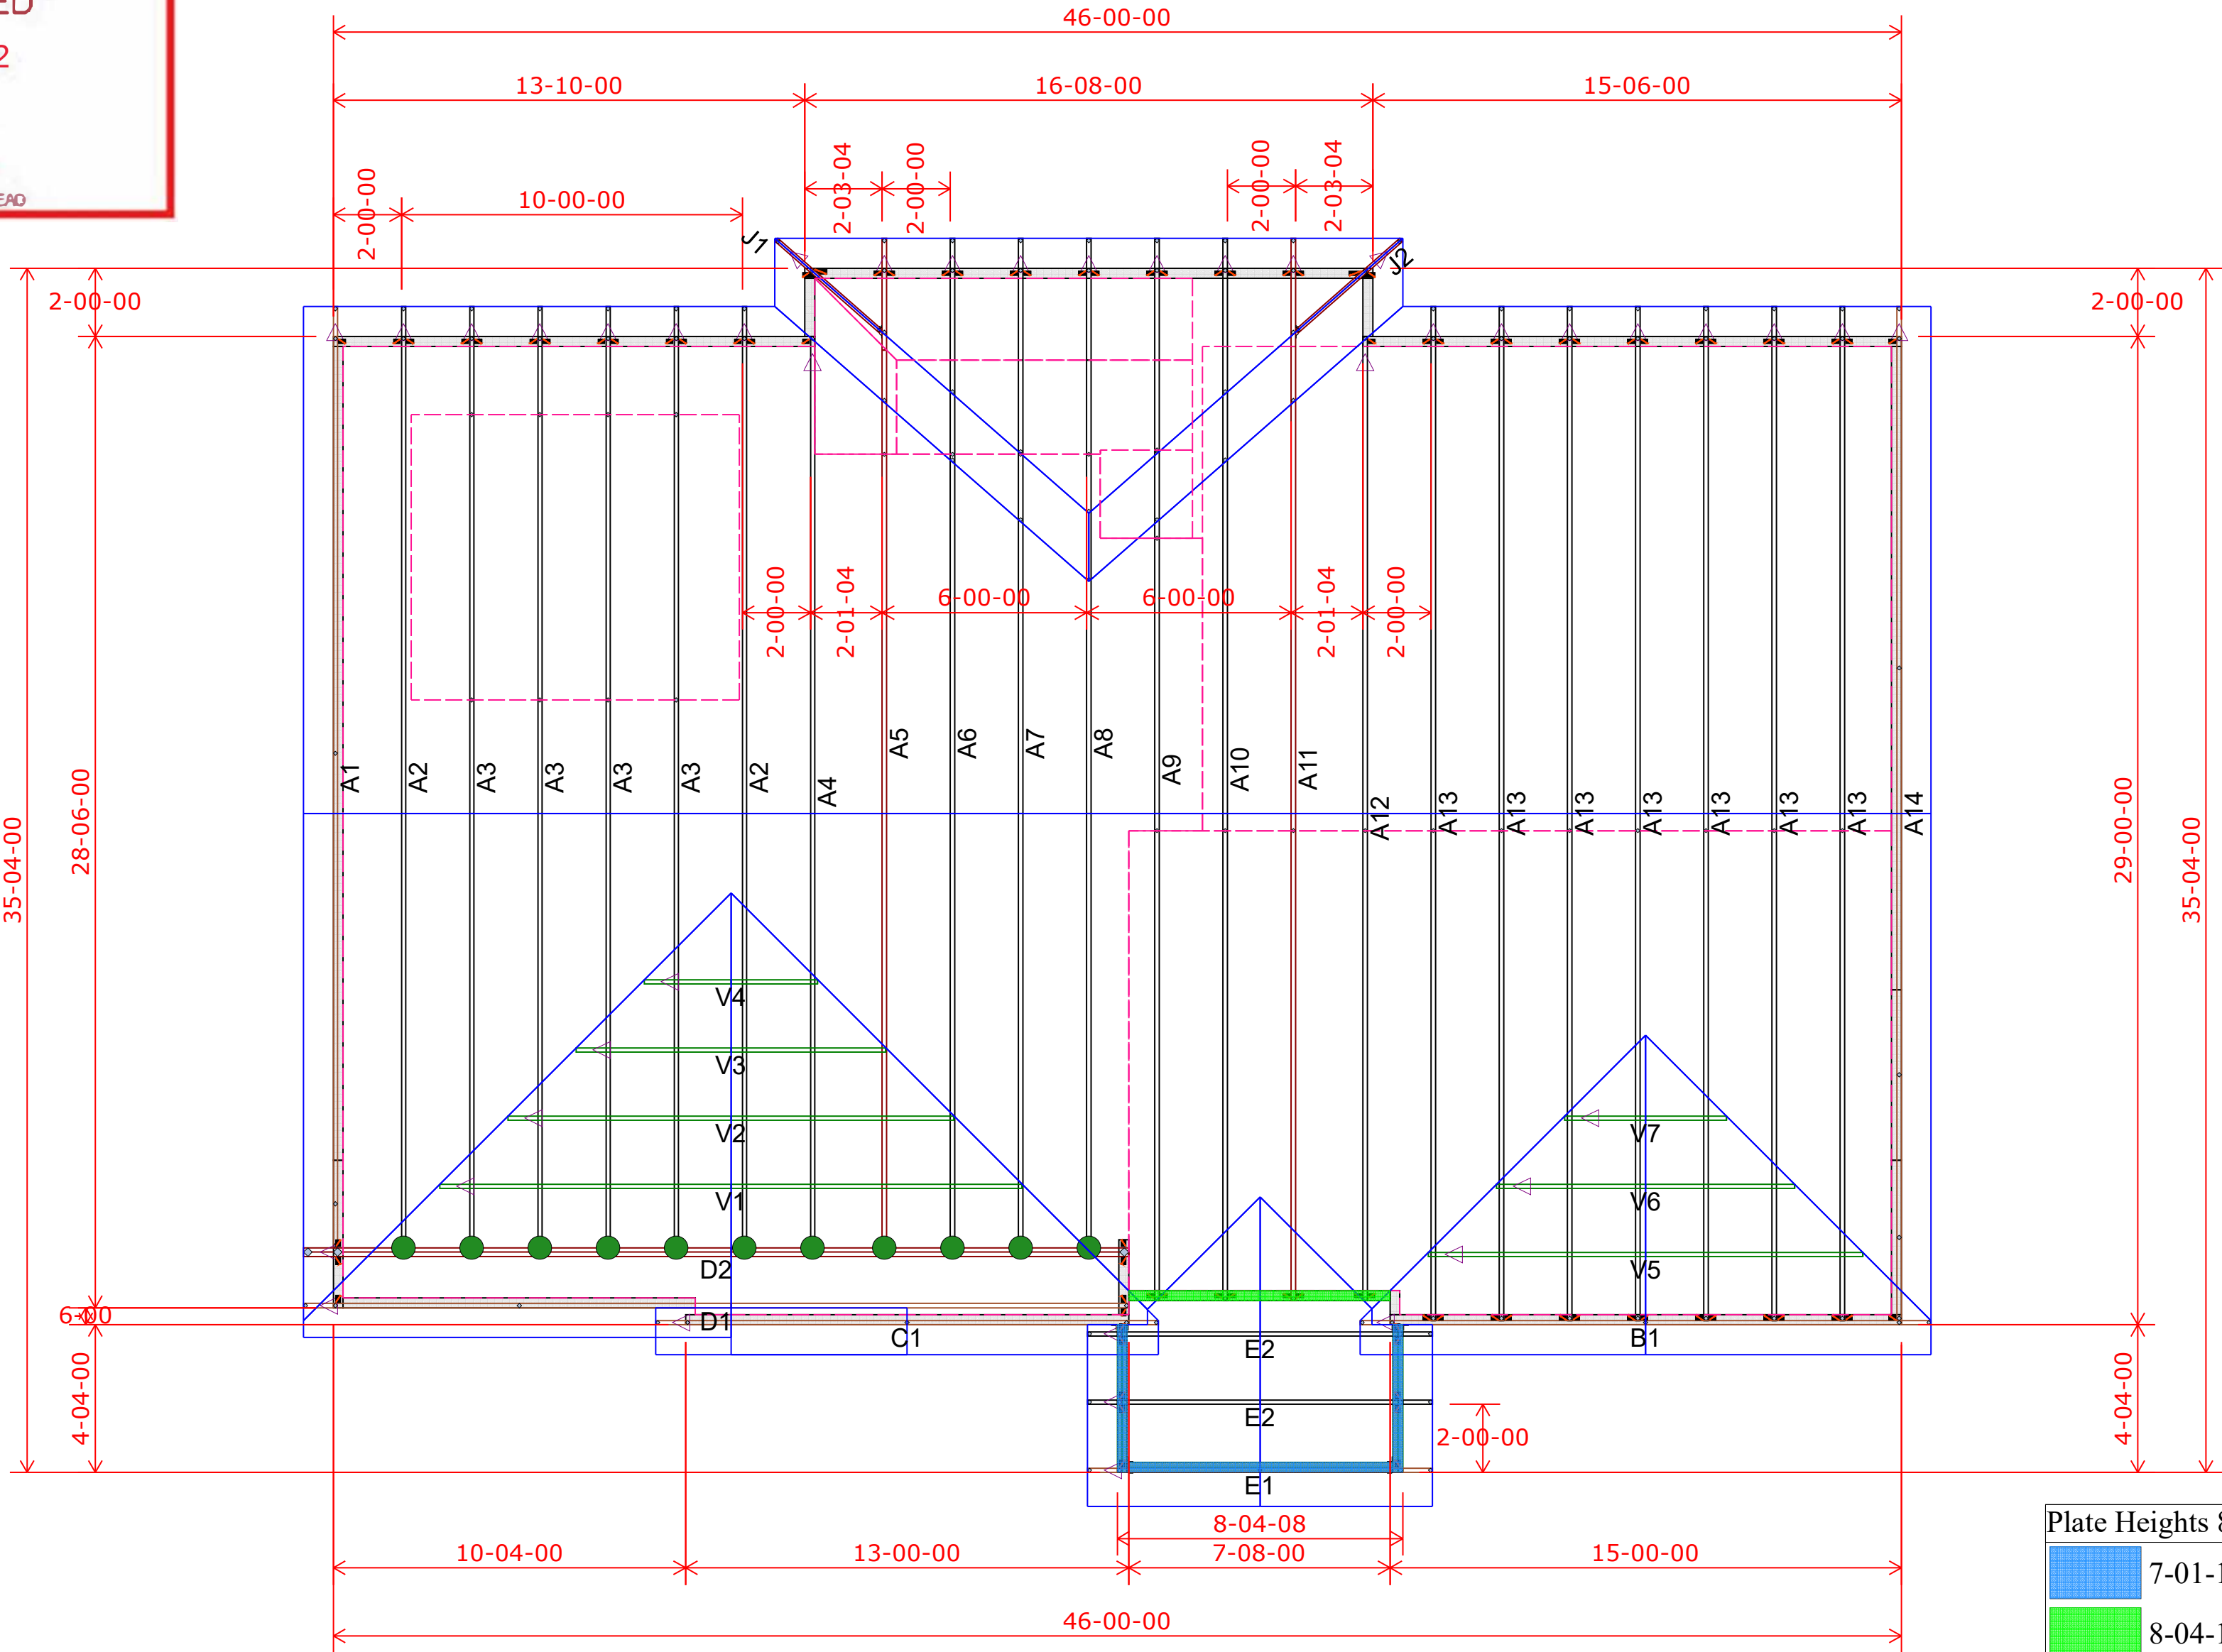


Plate Heights 8-01-02 U.N.O.	
	7-01-10
	8-04-11

HANGER SCHEDULE	Quantity
LUS24	0
LUS26	0
HUS26	11
HHUS26-2	0
HGUS26-2	0
HGUS28-3	0
LTHJA26	0
TJC37	0
TJC57	0
HTS20	0

Triangle denotes the left end of the Truss as it appears on the Engineered Drawings provided.

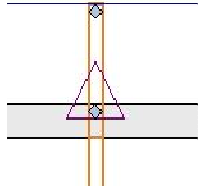

Unless otherwise specified by Engineer Of Record, Wheeler Lumber, LLC recommends an uplift connection at each bearing point per the following:

# of Uplift	Connector
0 - 495:	(1) H2.5A
495 - 990:	(2) H2.5A
990 - 1245:	(1) HTS20

Installation per Simpson Strong-Tie guidelines.

For Reactions greater than 1245#, refer to EOR.

Customer		Job Name		Job Site Address		City, State		Designer		Job #	
Clover & Hive		Lot 143 Cobey Creek		3537 SE Corbin Dr		Lee's Summit MO		Chuck Haspels (785) 746-4266		Job # B220014	

THIS IS A TRUSS LAYOUT. THESE TRUSSES ARE DESIGNED AS INDIVIDUAL BUILDING COMPONENTS TO BE INCORPORATED INTO THE BUILDING DESIGN AT THE SPECIFICATION OF THE BUILDING DESIGNER. SEE INDIVIDUAL DESIGN SHEETS FOR EACH TRUSS DESIGN IDENTIFIED ON THE PLACEMENT DRAWING. THE BUILDING DESIGNER IS RESPONSIBLE FOR TEMPORARY AND PERMANENT BRACING OF THE TRUSSES TO THE BUILDING FRAMEWORK. THE BUILDING DESIGNER IS RESPONSIBLE FOR PROVIDING THE TRUSSES WITH THE NECESSARY BRACING TO THE BUILDING FRAMEWORK. THE BUILDING DESIGNER IS RESPONSIBLE FOR PROVIDING THE TRUSSES WITH THE NECESSARY BRACING TO THE BUILDING FRAMEWORK. THE BUILDING DESIGNER IS RESPONSIBLE FOR PROVIDING THE TRUSSES WITH THE NECESSARY BRACING TO THE BUILDING FRAMEWORK.

THIS LAYOUT IS THE SOLE SOURCE FOR FABRICATION OF TRUSSES AND VOIDS ALL PREVIOUS ARCHITECTURAL OR OTHER TRUSS LAYOUTS. REVIEW AND APPROVAL OF THIS LAYOUT MUST BE RECEIVED BEFORE ANY TRUSSES WILL BE BUILT. VERIFY ALL CONDITIONS TO INSURE AGAINST CHANGES THAT WILL RESULT IN EXTRA CHARGES TO YOU.

Wheeler Lumber
1959 Old Hwy 50 NE
Waverly, KS 66871

Roof Truss Layout
Scale: 1/4" = 1'

RELEASE FOR CONSTRUCTION
AS NOTED FOR PLAN REVIEW
DEVELOPMENT SERVICES
LEE'S SUMMIT, MISSOURI
02/23/2022