


# CONSTRUCTION STAKE PLOT PLAN

Ordered by: Trumark Homes  
 Description: Lot 67, MONTICELLO 2ND PLAT, in Lee's Summit, MO  
 Address: 1249 NE Goshen Drive Landscaping required-see required note below

As-graded plot plan per Sec. 7-160 Code of Ordinances is required prior to occupancy.

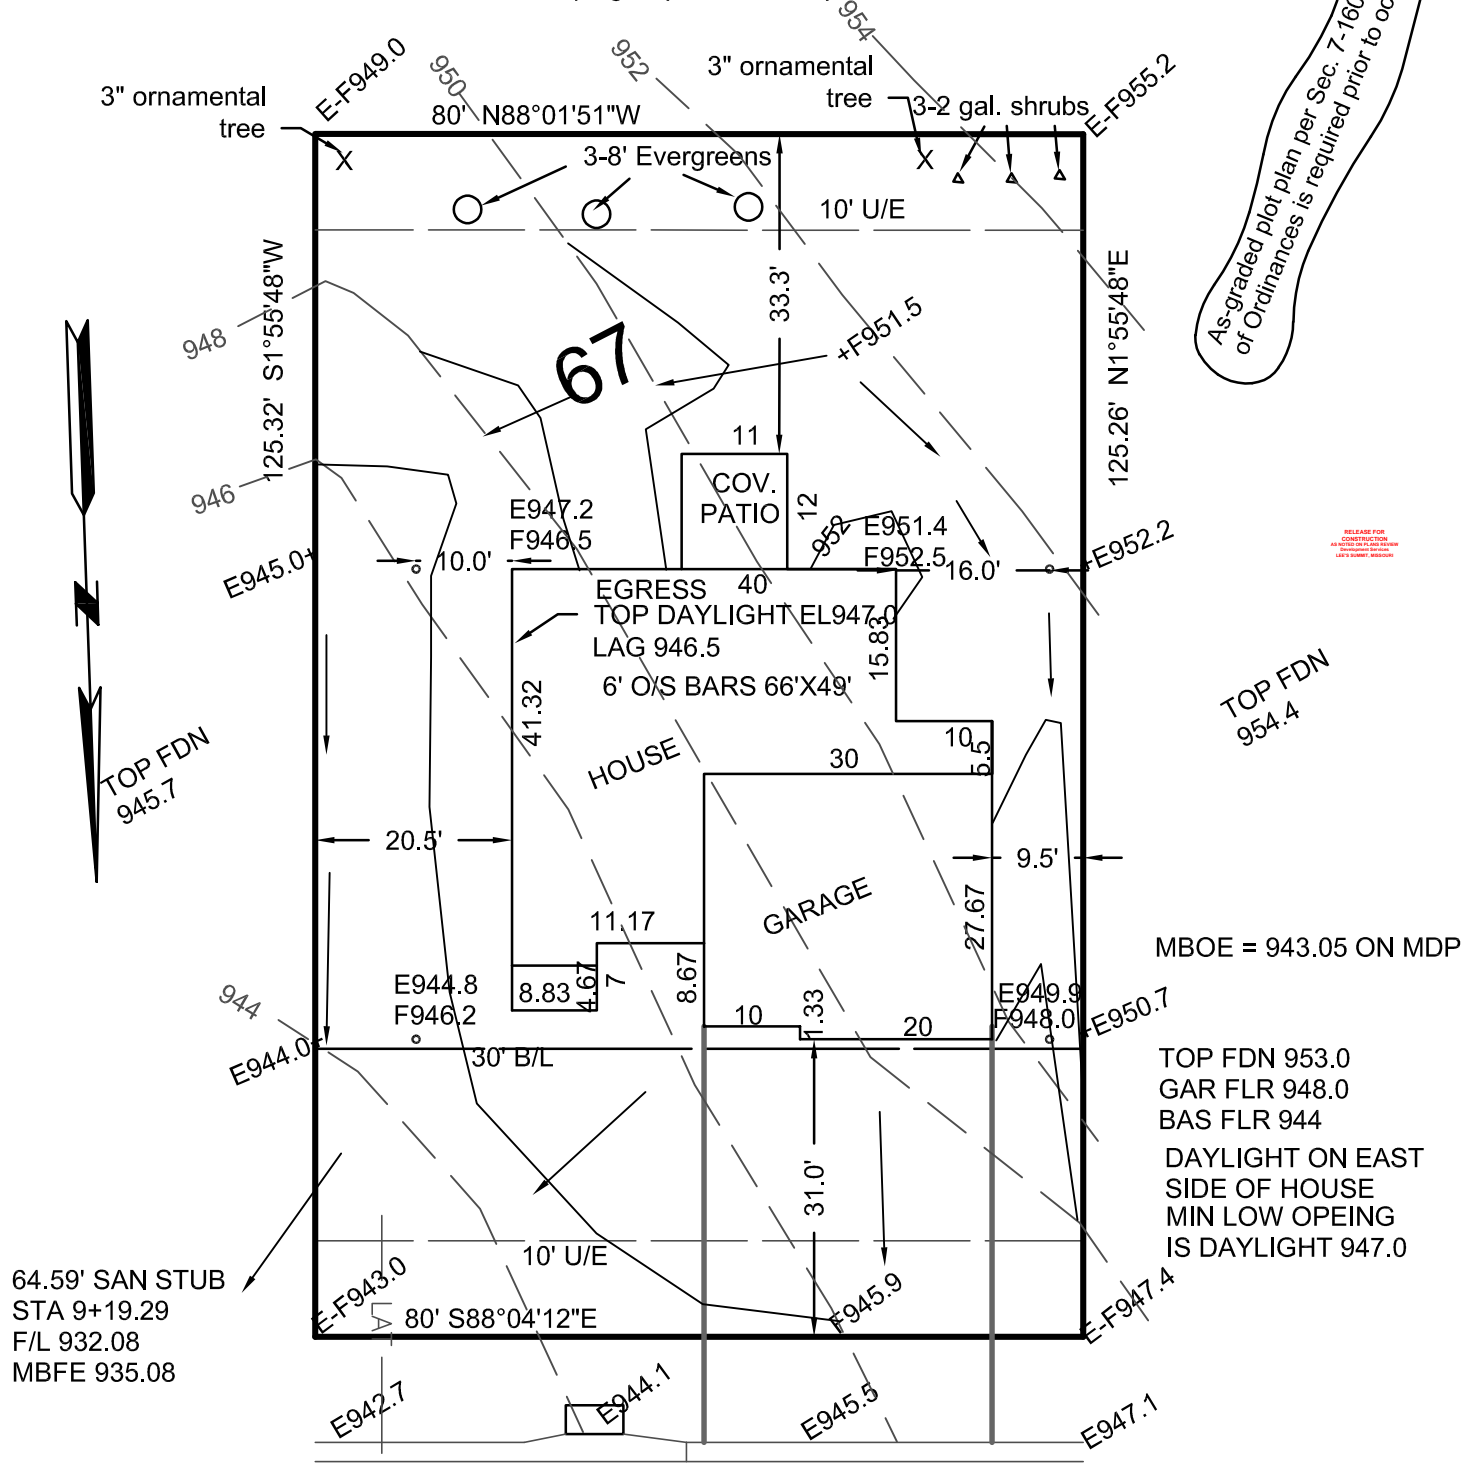

RELEASE FOR CONSTRUCTION AS NOTED ON THIS DRAWING (BY SURVEYOR)

MH STA 9+06.9  
 TOP 940.92  
 INV IN 931.02


Note required-  
 "Per Ordinance 7690, Section 3.10 The builders are required to put a Minimum of three Evergreen Trees, two ornamental trees and three shrubs, on each lot adjacent to the Lake Ridge Meadows and Dalton's Ridge subdivisions, acknowledging that the goal is to provide a visual buffer for the property to the north. No final certificate of occupancy shall be issued for the individually affected lot until such time as the required number of trees and shrubs are planted on said lot. The required landscaping shall be planted within 20 feet of the rear property line. The required landscaping shall meet the minimum size requirements of the UDO at the time of Planting (i.e. 8' for Evergreen trees, 3" caliper for ornamental trees and 2-gallon container for shrubs)."

This plot plan is not an "as-built" survey as the house was staked prior to being built and cannot be used in place of a "Surveyors Real Property Report". This plot plan was prepared for use before and during foundation construction only and should not be used to establish property lines for fences or other structures. House staked as shown on this plot plan. House dimensions may have been assumed and contractor must check house dimensions shown and compare to the final house plans. Contractor to verify all elevations at job site. Builder must make final decision as to cuts and foundation heights at the job site, any floor elevations shown are shown as a guide only. Sanitary sewer and lateral elevations cannot be verified at time of staking, and it may be necessary to verify sanitary sewer elevation and location (BY DIGGING UP THE SEWER LATERAL) prior to excavation for foundation. Underground utilities and un-platted easements may not be shown. This does not constitute a boundary survey and builder must check to make sure description shown is correct with the deed for the property. It is recommended that no work be done until building permits are obtained and plot plan has been verified by local building codes authorities to comply with all setback and other restrictions.

= DRAINAGE PATTERN

CONSTRUCTION ENGINEERING SERVICES, INC.

16810-C East 40 Highway  
 Independence, MO 64055  
 (816)478-2323  
 lee@engineeringkc.com  
 SCALE: 1"=20'  
 DATE: 01-10-2022  
 JOB NO: 18069

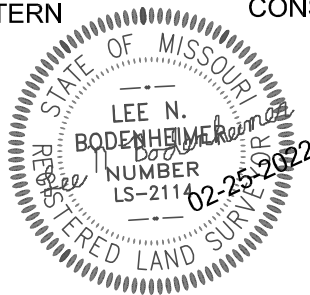

LEE BODENHEIMER, L.S.  
 Land Surveyor

revised 02-25-22 added required note.