### GENERAL NOTES & DESIGN CRITERIA

This plan was designed and drafted to meet average conditions and codes in the State of Missouri at the time it was designed. This plan was also designed for seismic zone B. Consult your local building official to determine the suitability of these plans for your specific site and application. This plan can be adapted to your local building codes and requirements, but also, it is the responsibility of the purchaser and/or builder of this plan to see that the structure is built in strict compliance with all governing municipal codes (city, county, state and federal). The purchaser and/or builder of this plan releases the designer from any claims or lawsuits that may arise during the construction of this structure or anytime thereafter.

#### DESIGN LOADS:

ESIGN LOADS:
Floor: 40 psf. live Roof: 20 psf. live Ceiling: 10 psf. live 10 psf. dead 5 psf. dead 5 psf. dead Soil bearing Capacity - 2000 PSF Live loads, dead loads, wind loads, snow loads, lateral loads, seismic zoning and any specialty loading conditions will need to be confirmed before construction and adjustments to plans made accordingly. See your local building officials for verification of your specific load data, zoning restrictions and site conditions.

#### CONCRETE AND FOUNDATIONS:

All foundation walls and slabs on grade shall be 3000 PSI (28-day compressive strength concrete), unless noted otherwise.

All interior slabs on grade shall bear on 4" compacted granular fill with

All interior states or grade state bear on 4 compacted granular lill with 6 mil. polyethylene vapor barrier underneath. Provide proper expansion and control joints as per local requirements. Foundation walls are not to be backfilled until properly braced. Verify depth of frost footings with your local codes. Provide termite protection as required by HUD minimum property

FEEL:
All structural steel for beams and plates shall comply with ASTM specification A-36.
All structural steel for steel columns shall comply with ASTM specification A-53 Grade B or A-501.
All reinforcing steel for concrete shall comply with ASTM specification A-615 Grade 40.
Provide steel shimns in all beam pockets.

Unless noted otherwise, all framing lumber shall have the following

characteristics:

Fb = 1,000 psi Fv = 75 psi E = 1,400,000 psi
Contractor to confirm the size, spacing and stress characteristics of all
framing and structural members to meet your local code requirements.
Hole sizes and locations in GluLam or Laminated Veneered Lumber
members are to be confirmed by a professional engineer.

Any structural or framing members not indicated on the plan are to be

sized by contractor.

sized by contractor.
Double floor joists under all partition walls, unless noted otherwise.
All subflooring is assumed to be 3/4" thick.-Glued&Nailed
All exterior walls are dimensioned to outside of 1/2" rigid insulation.
All exterior walls are 4" (3 1/2" stud plus 1/2" rigid insulation), All interior

All Main level walls are 4 1/2" unless otherwise shown.

Calculated dimensions take precedence over scaled dimensions.

All Main level walls are 9-1 1/8" high unless otherwise noted or implied.

All angled walls on floor plans are at 45 degree angle, unless otherwise

FRAMING MEMBERS (continued):

\* Any wall 12'-0" high or higher shall be 2x6 and balloon framed.

\* Unless noted otherwise, above all openings that are:
(1) Non-load bearing and less than or equal to 6 ft. ....use 4x6.
(2) Non-load bearing and more than 6 ft. .....use (2) 2 w/1/2" Plywood between.

All trusses to be engineered by truss manufacturer according to the loading indicated on this plan.

All exterior corners shall be braced in each direction with let-in diagonal

All extenor corners shall be braced in each direction with let-in diagonal bracing or plywood.

Place (1) row of 1" x 3" cross-bridging on all spans over 8'-0" and (2) rows of 1" x 3" cross-bridging on all spans over 16'-0".

Collar ties are to be spaced 4'-0" o.c.

All purlins and kickers are to be 2x6's, unless noted otherwise.

Any hip or valley rafters over a 28'-0" span are to be Laminated Veneer Lumber (L.V.L.).

#### MISC. NOTES:

Prefabricated fireplaces and flues are to be U.L. approved and installed as per manufacturer's specifications. All materials, supplies and equipment to be installed as per manufacturer's specifications and as per local codes and requirements.

Note: Provide proper insulation for all plumbing.

1/2" water-resistant drywall around showers, tubs and whirlpools.

1/2" drywall on interior walls and ceilings.

1/2" drywall on interior walls and cellings.
5/8" type "X" fire code drywall on garage walls and ceilings.
Windows are called out by glass size only.
Windows, if not noted, are assumed to be casements.
Header heights are labeled to bottom of arched transoms

Confirm window openings for your local egress requirements and minimum light and ventilation requirements.

Headroom at stairs shall have a minimum clearance of 6'-8" high.

Provide proper handrails at stairs as per local code.

The mechanical and electrical layouts are suggested only. Consult your mechanical and electrical contractors for exact specifications,

locations and sizes.

Jog flue to rear of ridge as necessary.

Note: Provide proper wiring for all electrical appliances, mechanical equipment and whirlpools as per manufacturer's specifications.

All air conditioner locations may vary depending on restrictive

covenants and codes. Typical overhang sizes unless noted otherwise on drawing are as follows:

On pitches of 4/12 - 5/12 - 6/12 = 24" overhang 7/12 = 20" overhang 8/12 = 16" overhang 9/12 = 16" overhang 10/12 - 11/12 - 12/12 = 12" overhang

ARTIST CONCEPTION ONLY

Note: Adjust overhangs to provide clearance for windows to open. Adjust overhangs to maintain a consistent level when the plans call for (2) different pitches at a hip. Minor alterations to this plan can be made by builder. Please contact


our drafting department for information and price quotes if major

our drating department to miorination and price quotes in major changes are required. Plan Pros, Inc. determines finished square footage by measuring to the outside of all walls. We include: interior fireplaces and every location in which the floor joists project from the foundation. We do not include: window boxes where the floor joists do not project from the foundation; 2-story entries; exterior fireplaces; garage, decks; patios; porches; unfinished storage areas; basements or any other unfinished

### ALL CONSTRUCTION WILL MEET THE REQUIREMENTS OF THE 2018 IRC AND 2017 NEC

WALK THROUGH DOOR @ GARAGE TO HOUSE WILL HAVE SELF CLOSING HARDWARE


ALL EGRESS WINDOW WELLS WILL HAVE DRAINS TO DRAIN TILE SYSTEM

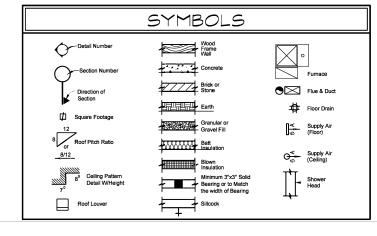

ELE	ECTRICA	AL LE	EGEND
<b>=</b>	110V OUTLET	<u>*************************************</u>	FLOOD LIGHT
<del>-</del>	HALF SWITCHED 110V OUTLET	$\stackrel{\smile}{\rightleftharpoons}$	FLUORESCENT LIGHT
⋹	220V OUTLET	+	TRACK LIGHT
₽E	WEATHERPROOF 110V OUTLET	<b></b>	UNDER COUNTER LIGHT
æ≝	GROUND FAULT	F	EXHAUST FAN
<del>-</del>	110 V. OUTLET	F <del>IÐ</del>	EXHAUST FAN/LIGHT COMBO
<del> </del>	FLOOR 110V OUTLET	~	PADDLE FAN/LIGHT
<del>+</del>	SURFACE MOUNT LIGHT	$\mathbb{X}$	
<del>-(b)</del> -	RECESSED CAN	杰	PADDLE FAN
ъф	LIGHT	SD.	SMOKE DETECTOR (WALL)
₩	WALL MOUNT LIGHT	(9)	SMOKE DETECTOR (CEILING)
<del>- 0  </del> 0	PULL-CORD SURFACE MOUNT LIGHT	s	TWO-WAY SWITCH
Π	THERMOSTAT	S <sub>3</sub>	THREE-WAY SWITCH
<u></u>	CHIMES	S <sub>4</sub>	FOUR-WAY SWITCH
	NOTE: WIRE SMOK	E DETECTORS IN SER	RIES

# ABBREVIATIONS A/C ADJ AWN BLDG BSMT BTW CANT CLG CEIL CMU C.O. CONC DBL DISH DN DRY EA ENT EXP EXT FIN F.J. FLUOR FTG GARB G&N G.L. HDB PROJ RAD RAFT'S REFRIG RM SEC SHWR S.L. SPP STA STD STL STL T.C. T.G. T.G. INSUL INT JST LVL LIN MAX MBR MICRO MIN O.C. O.H.D. OPNG PC PICT POLY 2W 3W 4W

LIFETIME ASHPHALT AND BLACK

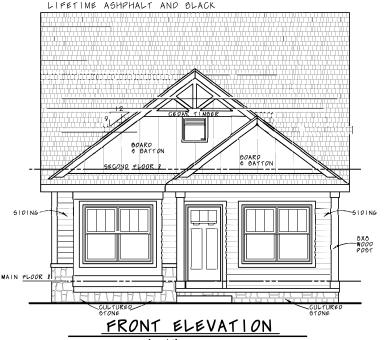



ARTWORK NOT TO SCALE

SCALE: 1/4" - 1'-0" LP PANEL SIDE & BACKWALLS-FRONT & LAP SMART SIDING

I garage **Plan** : 6-3-21 Sideload 626 | Revised:

**RELEASE FOR** 

CONSTRUCTIO AS NOTED ON PLANS R **Development Serv** LEE'S SUMMIT, MISS

Carl Cuozzo Designs 7504 S 95th Street La Vista, NE 68128 402-210-4369 planpro1@cox.net


© 2017


508 NW Main St Lee's Summit


Omaha, Nebraska 1-402-210-4369

Plan No.

Sheet No.

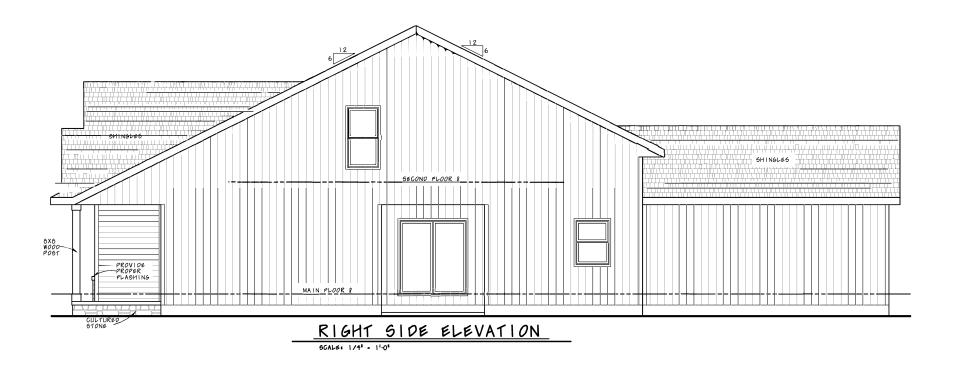

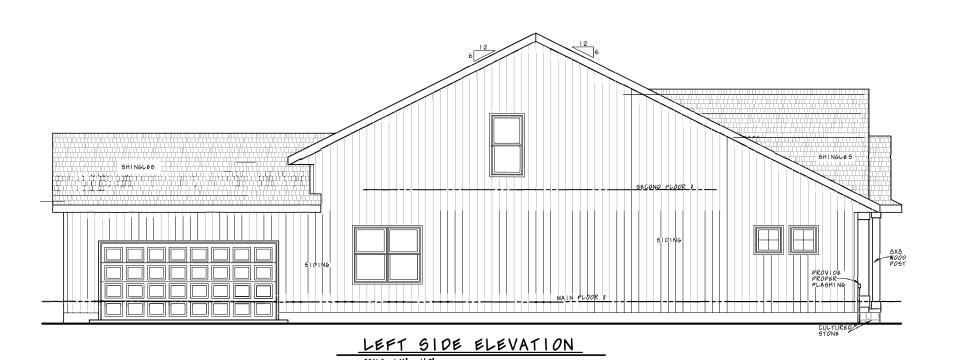

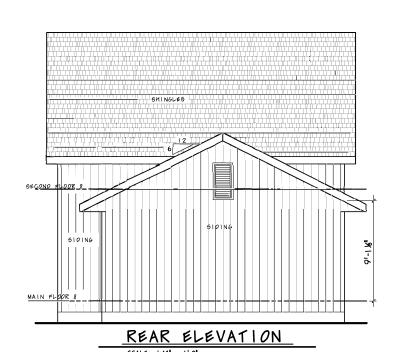



**RELEASE FOR** — CONSTRUCTION
AS NOTED ON PLANS RE
Development Services
LEE'S SUMMIT, MISSO SCALE: 1/4' - 1'0'

LP PANEL SIDE & BACKWALLSFRONT & LAP SMART SIDING

508 NW Main St Lee's Summit

© 2017

Omaha, Nebraska 1-402-210-4369

Sideload garage 1626 Plan Revised: 6-3-21

Plan No.

Sheet No.

#### **EXPANSIVE SOILS DISCLAIMER:**

THESE PLANS HAVE BEEN PREPARED BASED ON A PRESUMPTIVE ALLOWABLE BEARING CAPACITY AS ALLOWED BY IRC CODE AND THE LOCAL ENFORCING

APEX ENGINEERS, INC. (APEX)
RECOMMENDS THAT ALL FOOTING
EXCAVATIONS BE EVALUATED BY A LICENSED GEOTECHNICAL ENGINEER PRIOR TO THE PLACEMENT OF ANY
FOUNDATION ELEMENTS. GEOTECHNICAL INVESTIGATION AND/OR TESTING IS NOT A SERVICE PROVIDED OR OFFERED BY APEX.

APEX HAS NOT BEEN RETAINED TO DETERMINE THE EXPANSIVE SOIL CHARACTERISTICS OF THE SUBGRADE SOIL RESPONSIBLE FOR THE VOLUMETRIC CHANGES OF THE SOIL (INCLUDING BELOW THE BASEMENT SLAB). BY USE OF THESE PLANS WITHOUT AN ACCOMPANYING GEOTECHNICAL ENGINEERING REPORT, APEX SHALL NOT BE HELD LIABLE FOR ANY **FUTURE MOVEMENT AND/OR DIFFERENTIAL** MOVEMENT OF THE PROPOSED STRUCTURE
AND THE POSSIBLE DAMAGE THAT MAY BE CAUSED AS A RESULT OF SUCH MOVEMENT DAMAGE FROM EXPANSIVE SOILS AND/OR SETTLEMENT CAN RESULT IN AMONGST OTHER THINGS, THE FOLLOWING: BASEMENT SLAB HEAVE, SHEETROCK CRACKS, WINDOWS AND DOOR BECOMING OUT OF PLUMB AND STICKING AND/OR NOT OPENING. DAMAGE TO TILE, MOULDING, AND OTHER COSMETIC FINISHES

STRUCTURAL NOTES:

ALL UNMARKED HEADERS MIN

ALL HEADERS AND BEAMS MIN #2 GRADE DF/L (OR EQ.) BEARING WALL

COLUMN & PIER PAD SCHEDULE (REF. 5/S2.0)									
COLUMN MARK	COLUMN MARK PAD SIZE REINFORCEMENT COLUMN SIZE								
À	30" x 30" x 12"	(4) #4 BAR E.W.	3" NOMINAL						
₽	36" x 36" x 12"	(4) #4 BAR E.W.	3" NOMINAL	9 5					
<u></u>	42" x 42" x 12"	(5) #4 BAR E.W.	3" NOMINAL	IE A					
Ŕ	48" x 48" x 12"	(6) #4 BAR E.W.	3" NOMINAL	#ED 8					
Ê	54" x 54" x 16"	(8) #4 BAR E.W.	3½" NOMINAL (4" OD)	SCHEL STEEL FY = 36.					
Ê	60" x 60" x 16"	(10) #4 BAR E.W.	3½" NOMINAL (4" OD)						

COLUMN & PAD SIZES SHOWN ARE FOR MAXIMUM COLUMN HEIGHT OF 10'-0", REQUIRES SEPARATE ENGR'D DESIGN IF GREATER THAN 10'-0" TALL.
 COLUMN & PIER PAD SIZES SHOWN ARE BASED ON AN ASSUMED MINIMUM ALLOWABLE SOIL BEARING CAPACITY OF 2,000psf.

COLUMN & PIER SCHEDULE									
MARK COLUMN SIZE PIER DIA.									
Â	6x6	12"							
Æ	16"								
À	6x6	18"							
Δk	6x6	24"							
$\Lambda$	6x6	28"							

ALL PIERS TO BEAR ON ORIGINAL, UNDISTURBED SOIL OF 2,000psf BEARING CAPACITY OR FILL COMPACTED AND TESTED TO CONFORM TO THE RECOMMENDATIONS OF

#### **DETAIL REFERENCES**

1 S2.0 TYPICAL FOUNDATION WALL DETAIL

3 S2.0 TYPICAL DEAD MAN DETAIL

FOUNDATION WALL JUMP DETAIL

5 S2.0 COLUMN PAD DETAIL

1 TYPICAL STRUCTURAL GARAGE S2.1 SLAB PLAN 2 STRUCTURAL GARAGE SLAB PIER PAD DETAIL

3 STRUCTURAL GARAGE SLAB / WALL SECTION

6 TYPICAL OVERDIG DETAIL AT BASEMENT SLAB

ALTERNATE BRACED WALL PANEL DETAIL

1 S4.0 APA NARROW WALL BRACING METHOD WITHOUT HOLD-DOWNS ALT.

COLUMN AND PIER PAD SCHEDULE (SHEET S2.0)

ROOF DESIGNED FOR LIGHT ROOF COVERING 30psf TOTAL LOAD [10psf DL, 20psf LL (SL)]

ROOF SYSTEM IS DESIGNED TO MEET REQUIREMENTS

\*RAFTERS (HEM-FIR, DOUG-FIR, OR EQUAL): SEE SPAN CHARTS BELOW

RAFTERS	SPACING	MAX HORIZONTAL CLEARSPAN
#2-2x6	AT 24" OC	11'-7"
#2-2x6	AT 16" OC	14'-2"
#2-2x8	AT 24" OC	14'-8"
#2-2x8	AT 16" OC	17'-11"
#2-2x10	AT 24" OC	17'-10"
#2-2x10	AT 16" OC	21'-11"

NOTE: CODE MINIMUM ALLOWS FOR A RAFTER DEFLECTION OF L/180 TOTAL LOAD

<b>IGHER</b>	<b>PERFO</b>	RMAN

THOTER FER ORMANOL								
RAFTERS	SPACING	MAX HORIZONTAL CLEARSPAN						
#2-2x6	AT 24" OC	8'-6"						
#2-2x6	AT 16" OC	9'-9"						
#2-2x8	AT 24" OC	11'-3"						
#2-2x8	AT 16" OC	12'-9"						
#2-2x10	AT 24" OC	14'-3"						
#2-2x10	AT 16" OC	16'-3"						

APEX ENGINEERS, INC. RECOMMENDED DEFLECTION = L/360 LIVE LOAD, L/240 TOTAL LOAD

\*RIDGE BOARDS ARE (UNLESS OTHERWISE NOTED) #2-2x10 UP TO 9:12 PITCH

\*\*RESERVATE OF SHAPE THE HONES OF THE HONES

PURLIN STRUT	MAX PURLIN STRUT LENGTH
(2)2x4	8'-0"
(1)2x4 AND (1)2x6	12'-0"
(1)2x6 AND (1)2x8	20'-0"
(2)2x6 AND (1)2x8	30'-0"
CONSULT ARCH ENGR	>30'-0"

\*EACH END OF STRUT SHALL BE FASTENED WITH MIN (3)8d

"FACH END OF SITUS SHALL BE FAST ENED WITH MIN (3)80 OR (2)16d MAILS
"RIDGE BRACERS ARE SAME AS PURLIN BRACES-SPACING, SIZE, CONFIGURATION, AND INSTALLATION (SEE PURLIN BRACE NOTES ABOVE)
"HIP AND VALLEY BRACES ARE THE SAME AS PURLINS SIZE, CONFIGURATION, AND INSTALLATION (SEE PURLIN BRACE NOTES ABOVE)

= ROOF BRACE/STRUT (PER CHART)

/ -SLASH IS TOP END OF BRACE

-CIRCLE IS BOTTOM END OF BRACE

= PURLIN STRUTS AT 48" OC (PER CHART) U.N.O. ✓ -SLASH IS TOP END OF BRACE

— ARROW IS BEARING LOCATION

DENOTES BEARING WALL DENOTES PURLIN ======== DENOTES BEARING STRUCTURE

THIS IS AN ENGINEERED ROOF STRUCTURE DESIGNED FOR COMPLIANCE WITH IRC 802.3. BUILD AS SHOWN WITH NO DEVIATIONS. ALL HIPS ARE DESIGNED TO BE CONTROLLED BY BENDING. SHEAR AT BEARING WITH MIN 5 1/2" DEPTH DOES NOT CONTROL DESIGN. FOR VALLEYS REF 4/S3.2

TRUSS ROOF NOTES; (BY OTHERS)

1) DESIGNED FOR LIGHT ROOF COVERING
TOP CHORD:
LIVE LOAD/SNOW LOAD (PSF): 20
DEAD LOAD (PSF): 10
BOTTOM CHORD:
DEAD LOAD(PSF): 10

2) ALLE XTERIOR HEADERS SHALL BE MIN. (2) #2-2x10
UNLESS OTHERWISE NOTED.
3) CONSULT ENGINEER IF TRUSSES BEAR ON INTERIOR
WALLS SHOWN AS NON-LOAD BEARING ON APPROVED
PRINTS.

WALLS SHOWN AS NON-LOAD BEARING ON APPROVED PRINTS.


MIN. (4) 2x4 BELOW EACH BEARING POINT OF EACH GIRDER TRUSS, UNLESS OTHERWISE NOTED. PROVIDE 2x SOLID BLOCKING SUPPORT BELOW ALL POINT LOADS CONTINUOUS TO BEARING STRUCTURE AND/OR FOUNDATION BELOW. ROOF IS ENGINEERED TO COMPLY WITH IRC 802. AT EACH TRUSS BEARING POINT USE UPLIET CONNECTORS PER TABLE BELOW UNLESS NOTED OTHER WISE, INSTALL PER MANUFACTURER'S SPECIFICATIONS.

CONNECTOR (1) H2.5A (2) H2.5A

STRUCTURAL NOTES:
- ALL UNMARKED HEADERS MIN

ALL HEADERS AND REAMS MIN #2



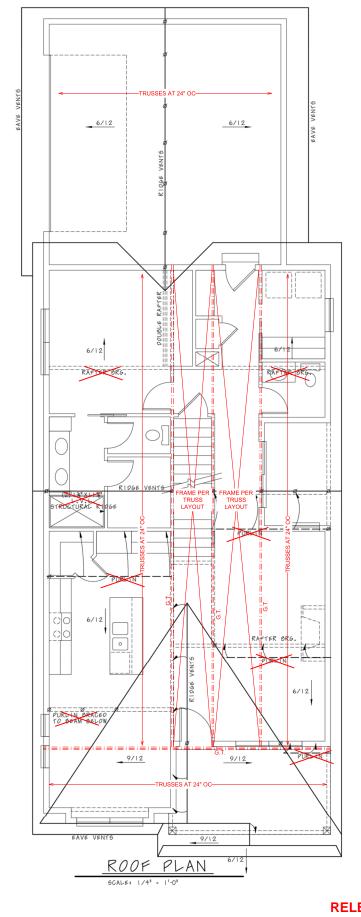

© 2017

508 NW Main St Lee's Summit

Omaha, Nebraska 1-402-210-4369


garage
Plan
: 6-3-21 Sideload 626 | Revised:

Plan No.

Sheet No.

**RELEASE FOR** 


CONSTRUCTION AS NOTED ON PLANS REV **Development Service** LEE'S SUMMIT, MISS

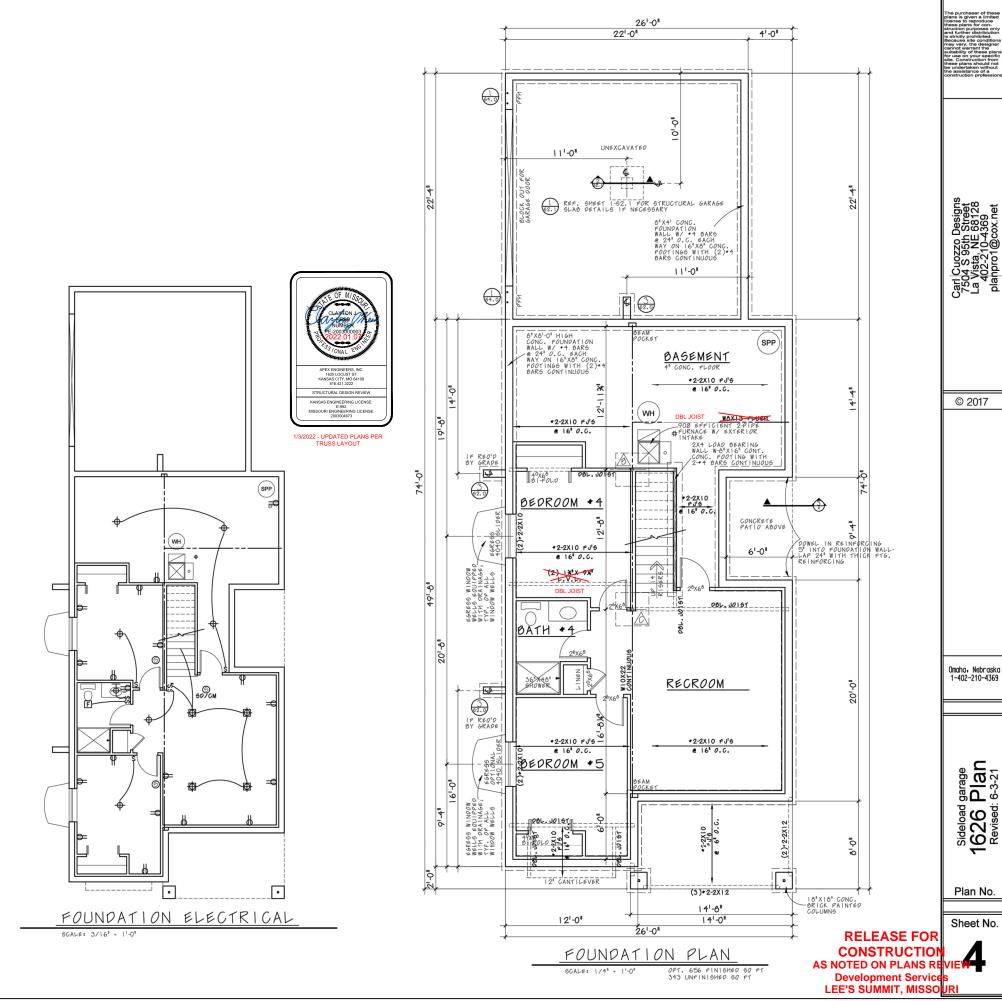


Sideload garage 1626 Plan Revised: 6-3-21

Plan No.

Sheet No.

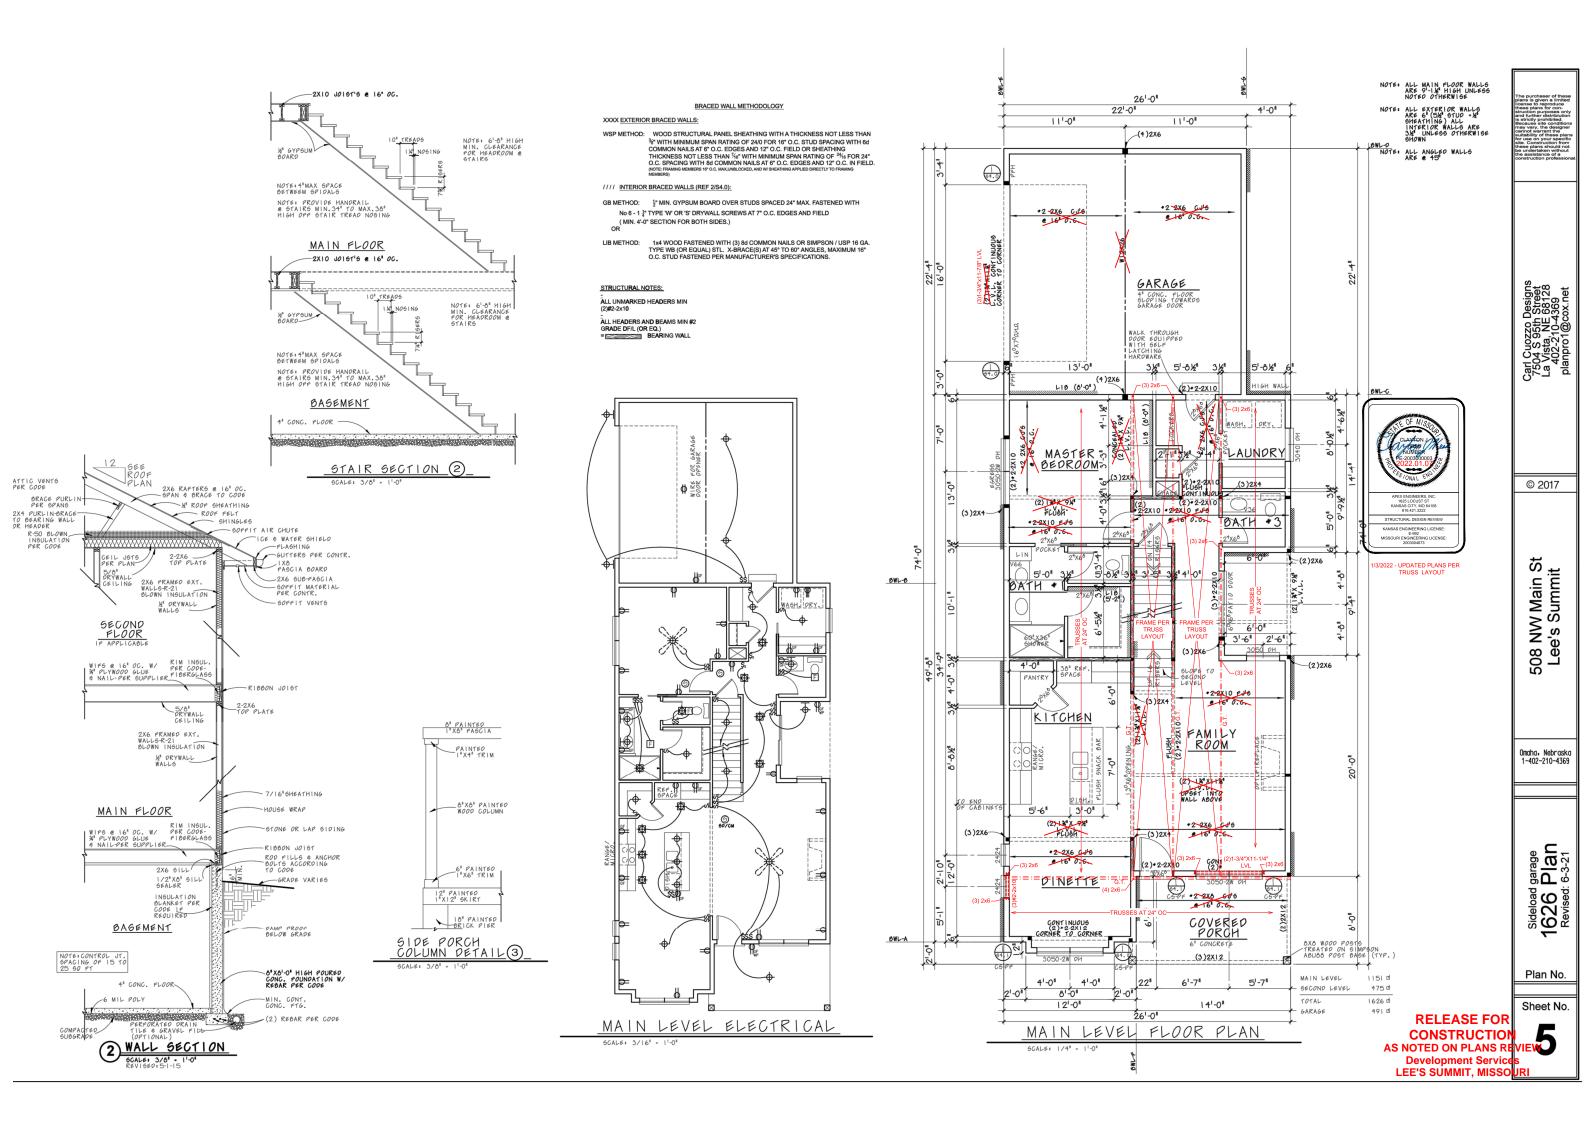

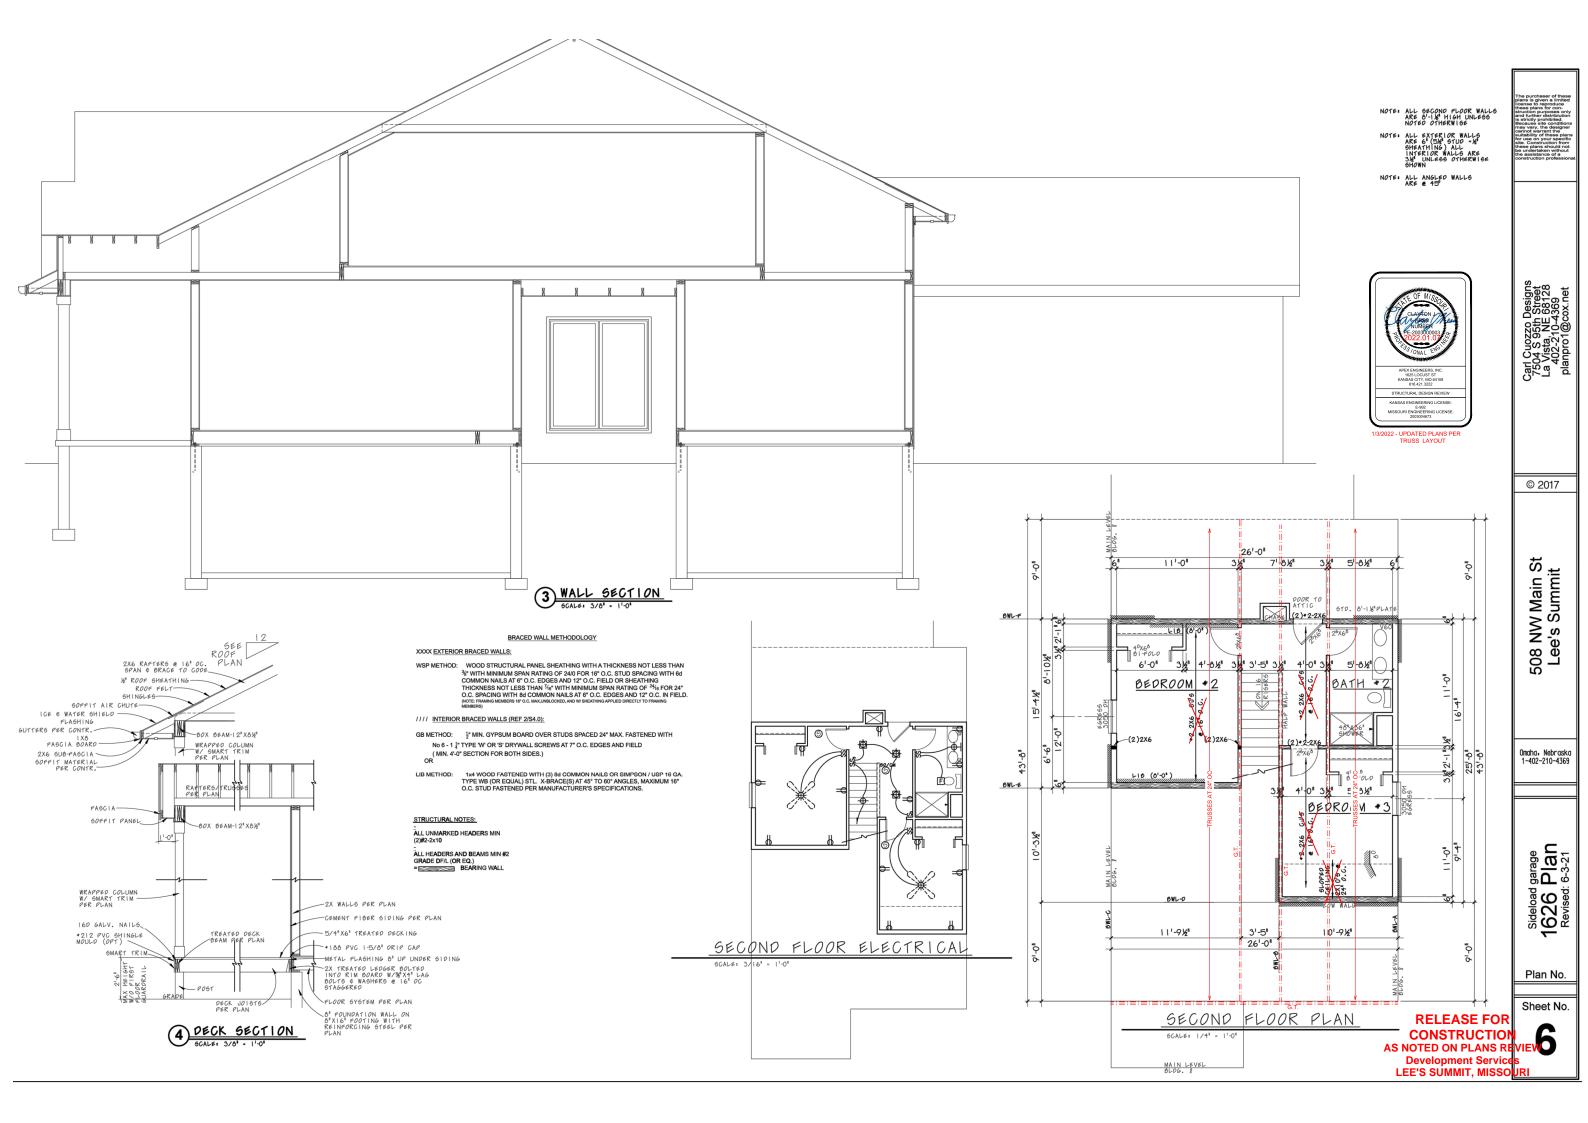

BUILDING COMPONENT	MATERIAL	FASTENING			
BUILDING COMPONENT	7/16" PLYWOOD	16 GA x 1-3/4" STAPLES AT 3"			
ROOF SHEATHING <sup>1</sup>		OC EDGES AND 6" OC IN FIELD  1/2" CROWN STAPLES			
	1x4 #3 FURRING	8d COMMON NAILS AT 6" OC EDGES			
		AND 12" OC IN THE FIELD  14 GA x 2" STAPLES AT 4" OC			
FLOOR SHEATHING <sup>1</sup>	3/4" T&G YELLOW PINE PLYWOOD APPLIED PERPENDICULAR TO	14 GA x 2" STAPLES AT 4" OC EDGES AND 8" OC IN THE FIELD			
	JOISTS AND ENDS STAGGERED	12.5 GA x 1-1/2" RING OR SCREW SHANK NAILS AT 6" OC EDGES			
		AND 8" OC IN THE FIELD			
		7" OC NAILED / 12" OC SCREWED WITH 13 GA, 1-3/8" LONG, 19/64" HEAD; 0.098			
CEILING COVERING <sup>1</sup>	1/2" GYPSUM SHEATHING	DIA, 1-1/4" LONG, ANGRINGED; 5d			
		COOLER NAIL, 0.086 DIA, 1-5/8" LONG, 15/64" HEAD; OR GYP BD NAIL, 0.086 DIA,			
		1-5/8" LONG, 9/32" HEAD 6d COMMON NAILS; 1-5/8"			
INTERIOR WALL	1/2" GYPSUM SHEATHING	GALVANIZED STAPLES; 1-1/4"			
COVERING <sup>1</sup>	1/2 GTI SOMI SITEATIING	SCREWS, TYPE W OR S- AT 4" OC EDGES AND 8" OC IN THE FIELD			
EXTERIOR WALL	MIN 3/8" APA RATED SHEATHING	8d COMMON NAILS AT 6" OC EDGES			
SHEATHING		AND 12" OC IN THE FIELD			
	*SUPPORTING 2 FLOORS, ROOF,	*TOE NAIL RIM JOIST TO SILL OR TOP 8d COMMON AT 6" OC; 3"x0.131" AT 6" OC; 3"x0.13			
	AND CEILING OR LESS. *HEIGHT: 10'-0" OR LESS	STOR NAME OF UDITO TO TOR AND SOLE BLATE: (4) 94 COMMANN: (4) 250 424*			
	SIZE: NOM 2x4 (NOM 2x6 WHEN	*FACE NAIL BUILT-UP CORNER STUDS: 16d AT 24" OC; 3"x0.131" AT 16"			
	SUPPORTING 2 FLOORS, CEILING, AND ROOF)	(AT BRACED WALL PANELS): 16d COMMON NAILS AT 16" OC; 3"x0.131" AT 12" OF TACE NAIL JACK STUDS/TRIMMERS			
CONVENTIONAL WOOD	*SPECIES: DOUG-FIR, HEM-FIR,	SUPPORTING HEADERS WITH: 10d NAILS AT 6" OC 184 COMMON AT 16" OC; 3"x0.131" AT 12" OC; 3"x0.128" AT 12" OC			
FRAMED WALLS	SOUTH PINE, SPRUCE-PINE-FIR *MAXIMUM SPACING 16" OC	I *DBL TOP PLATES WITH MIN 48" OFFSET			
	*STUDS 10' LENGTH OR LESS	*FACE NAIL DBL TOP PLATES AT LAPPED CORNERS AND INTERSECTIONS WITH: (2) 18d COMMON: (3) 3*x0 131** (3) 3*x0 128**			
	SHALL BE #3 STANDARD, OR STUD GRADE	"FACE NAIL SOLE PLATE TO FRAMING SYSTEM WITH: 16d COMMON AT 16" OC; 3"x0.131" AT 12" OC "TOENAIL BRIDDING TO JOIST, EACH END: (2) 8d COMMON; (2) 3"x0.131"; (3) 3"x0.128"			
	*STUDS OVER 10' LENGTH SHALL BE MIN #2 GRADE	*TOENAIL BRIDGING TO JOIST, EACH END: (2) 8d COMMON; (2) 35:0.131*; (3) 35:0.128* "FACE NAIL LEDGER STRIPS SUPPORTING JOISTS OR RAFTERS WITH: (3) 18d COMMON; (4) 35:0.131*; (4) 35:0.128*			
	DE WIIV #2 GIVIDE	(4)			
		*TOE NAIL HEADERS TO WALL STUDS WITH (4) 8d			
CONVENTIONAL WOOD HEADER FRAMING	PER PLAN	NAILS AT EACH END. *FACE NAIL DOUBLE PIECE HEADERS WITH 16d			
		NAILS AT 16" CENTERS ALONG EACH EDGE.			
RAFTER TIES <sup>2</sup>	MIN 2x4 MEMBERS AT EACH RAFTER	REF TABLE R802.5.2			
COLLAR TIES	MIN 1x4 MEMBERS AT 48" OC	FACENAIL TO RAFTERS IN UPPER 1/3 OF ATTIC SPACE WITH (3) 10d NAILS AT EACH			
NOTE: ALL SHEATHING MA	TERIALS TO BE APPLIED PERPENDICUL	AR TO JOISTS AND ENDS STAGGERED.			
	E REQUIRED WHEN A STRUCTURAL RII. ULTED ROOM). SUCH SHALL BE NOTED	DGE HAS BEEN PROVIDED AND ADEQUATELY  AS "STRUCTURAL" ON THE PLAN.			
BUILDING COMPONENT	FASTEN TO	FASTEN WITH			
BUILDING COMPONENT	TO RIDGE/VALLEY/HIP RAFTERS	TOENAIL WITH (4) 16d			
RAFTERS	TO PLATE	ENDNAIL WITH (3) 16d			
		TOENAIL WITH (2) 16d			
CEILING JOISTS	TO TOP PLATE  WHERE CELLING .II	TOENAIL WITH (3) 8d AT EACH END DISTS RUN PARALLEL TO RAFTERS			
	FACENAIL TO	O RAFTERS WITH (3) 10d MIN			
FLOOR JOISTS	TO SILL OR GIRDER	TOENAL WITH: (3) 8d COMMON; (3) 3"x0.131"; (4) 3"x0.			
DACED WALL DANIELS	TO RIM JOIST	ENDNAIL WITH: (3) 16d COMMON; (4) 3"x0.131"; (4) 3"x0 SOLE PL, 16" OC WITH: (3) 16d COMMON; (4) 3"x0.131"			
RACED WALL PANELS ERP TO FRAMING	TO FRAMING MEMBER	TOP PL 6" OC WITH: 8d COMMON: 3"x0 131"			
EMBERS ABOVE/BELOW: ARALLEL TO FRAMING	TO FRAMING AND BLOCKING AT 16" OC	SOLE PL, 16" OC WITH: (3) 16d COMMON; (4) 3"x0.131" AND AT EACH BLOCK: (3) 16d COMMON; (4) 3"x0.131"			
EMBERS ABOVE/BELOW:	DECOMMON TO CO	TOP PL, 6" OC WITH: 8d COMMON; 3"x0.131" AND AT EACH BLOCK: (3) 8d COMMON; 3"x0.131"			
	T. Control of the Con	ULE ARE MINIMUM IRC REQUIREMENTS. SPECIFIC PROJECT			

#### **ENERGY REQUIREMENTS**

- I. LIGHTING FIXTURES PENETRATING THE THERMAL ENVELOPE SHALL BE IC-RATED, LEAKAGE RATED, AND SEALED TO THE GYPSUM WALLBOARD AS REQUIRED PER 111(24.8, 2. PROGRAMMABLE THERMOSTATS SHALL BE INSTALLED AS REQUIRED PER
- I103.1.1. AIR HANDLERS SHALL BE RATED FOR MAXIMUM 2% AIR LEAKAGE RATE PER 4. BUILDING FRAMING CAVITIES SHALL NOT BE USED AS DUCTS OR
- PLENUMBS PER N1103.3.5 5. HOT WATER PIPES SHALL BE INSULATED AS REQUIRED PER N1103.4.
- 5. HOT WATER PIPES SHALL BE INSULATED AS REQUIRED PER INTIUS.4.

  6. ALL EXHAUST FANS SHALL TERMINATE TO THE BUILDING EXTERIOR AS REQUIRED PER M1501.1.

  7. MAKEUP AIR SYSTEMS SHALL BE INSTALLED FOR KITCHEN EXHAUST HOODS THAT EXCEED 400 CFM AS REQUIRED PER M1503.6.

  8. AN AIR HANDLING SYSTEM SHALL NOT SERVE BOTH THE LIVING SPACE AND THE GARAGE PER M1601.6.

### **ENERGY CONSERVATION**

THE ENERGY EFFICIENCY OF THE DWELLING SHALL COMPLY WITH THE FOLLOWING TABLE(S) (WHERE THERE ARE DISCREPANCIES BETWEEN THIS TABLE AND THE PLANS, THE MOST RESTRICTIVE SHALL APPLY). IF TABLE 1 IS NO COMPLETED AND ACCOMPANIED BY RESCHECK CALCULATIONS, THEN TABLE 2 HALL BE APPLIED.

TABLE 1 - ResCheck COMPLIANCE SOFTWARE (FILL IN APPLICABLE VALUES FROM ResCheck CALCS.)

BUILDING ELEMENT

WALLS - FRAMED MIN VALUE WALLS - BASEMENT OORS - UNCONDITIONED SPACE
OORS - OVER OUTSIDE AIR
OORS - CRAWL SPACE SLAB - PERIMETER SLAB - PERIMETER
CEILING - FLAT
CEILING - CATHEDRAL
DOORS - GLASS
DOORS - SOLID
WINDOWS - OPERABLE
WINDOWS - FIXED
WINDOWS - OTHER TORNIAGE
AF UENATE: FOR USE OF TABLE 1 A ResCheck COMPLIANCE FORM MUST BE

SUBMITTED WITH PLANS.

TABLE 2 - PRESCRIPTIVE ENVELOPE (MIN PRESCRIPTIVE APPROACH

BUILDING ELEMENT	MIN VALUE
CEILING - FLAT	R-49
CEILING - CATHEDRAL**	R-30
CEILING - CATHEDRAL	R-38
FLOORS - UNCONDITIONED SPACED	R-19
FLOORS - OVER OUTSIDE AIR	R-30
WALLS - BASEMENT	R-10 (CONT) OR R-13 (CAVITY)
CONCRETE SLAB ON GRADE	R-10 (FOR 2FT)
SKYLIGHTS	U=0.55
WALLS - EXTERIOR (2x4)	R-13 (CAVITY) + R-5 (CONT)
WALLS - EXTERIOR (2x6)	R-20
WALLS - CRAWL SPACE	R-19
GLAZING*	U<=0.32
GLAZING*	SHGF<=0.40
NOTE:	

NOTE:
TABLE 2 PER IRC TABLE N1102.1.2
\*\*DEFAULT U-FACTOR FOR DOUBLE PANE, ARGON FILLED LOW-E
TREATMENT IS U=0.35

\*\*LIMITED TO AREAS LESS THAN 500 SQ-FT OR 20% OF CEILING AREA.

### **DEFERRED SUBMITTALS**

UEPERKEU SUBMITIALS

1. THE ARCHITECT OR ENGINEER OF RECORD SHALL LIST THE DEFERRED

SUBMITTALS ON THE PLANS FOR REVIEW BY THE BUILDING OFFICIAL.

DOCUMENTS FOR DEFERRED SUBMITTAL LITEMS SHALL BE SUBMITTED TO THE

ARCHITECT OR ENGINEER OF RECORD WHO SHALL REVIEW THEM AND

FORWARD THEM TO THE BUILDING OFFICIAL WITH A NOTATION INDICATING

THAT THE DEFERRED SUBMITTAL DOCUMENTS HAVE BEEN REVIEWED AND

FOUND TO BE IN THE GENERAL CONFORMANCE TO THE DESIGN OF THE

BUILDING THE DEFERRED SUBMITTAL HEMS SHALL NOT BE INSTALLED UNTIL

THE DEFERRED SUBMITTAL DOCUMENTS HAVE BEEN APPROVED BY THE

BUILDING OFFICIAL DEFERRED SUBMITTALS ARE DEFINED AS THOSE PORTIONS

OF THE DESIGN THAT ARE NOT SUBMITTED AT THE TIME OF THE APPLICATION

AND THAT ARE TO BE SUBMITTAL ITEMS SHALL HAVE THE APPLICATION

AND THAT ARE TO BE SUBMITTAL ITEMS SHALL HAVE THE PRIOR

APPROVAL OF THE BUILDING OFFICIAL.

- 2. DEFERRED SUBMITTAL ITEMS (WHEN APPLICABLE):
- A TRUSSES B. I-JOISTS
- GUARDRAILS AND HANDRAILS

- C. GUARDRAILS AND HANDRAILS
  D. STEEL FABRICATED STAIRS
  E. PRE-MANUFACTURED CANOPIES AND AWNINGS
  F. PRECAST HOLLOW CORE SLABS
  G. GROUND MERPOYMEMENT AND/OR STRUCTURAL FOUNDATION
  SOLUTIONS (SUCH AS DRILLED PIERS)

#### CONCRETE

CONCRETE SHALL BE AIR ENTRAINED WITH A MINIMUM COMPRESSIVE STRENGTH OF 28 DAYS OF 2,500 PSI FOR BASEMENT AND INTERIOR FLOOR SLABS, 3,000 PSI FOR BASEMENT AND FOUNDATION WALLS, AND 3,500 FOR PORCHES, CARPORTS, AND GARAGE FLOOR SLABS.

### GLAZING

GLAZING IN HAZARDOUS LOCATIONS AS IDENTIFIED IN IRC SECTION R308.4 SHALL BE OF APPROVED SAFETY GLAZING MATERIALS: GLASS IN STORM DOORS: INDIVIDUAL FIXED OR OPENABLE PANELS ADJACENT TO A DOOR WHERE THE NEAREST VERTICAL EDGE IS WITHIN A 24" ARCH OF THE DOOR IN A CLOSED POSITION AND WHOSE BOTTOM EDGE IS WITHIN 80" OF THE FLOOR; WALLS ENCLOSING STAIRWAYS AND LANDINGS WHERE THE GLAZING IS WITHIN 80" OF THE TOP OR BOTTOM OF THE STAIR; ENCLOSURES FOR SPAS, TUBS, SHOWERS, AND WHIRL POOLS; GLAZING IN FIXED OR OPENABLE PANELS EXCEEDING S SQUIARE FEET AND WHOSE BOTTOM GOE IS LESS THAN 18" ABOVE THE FLOOR OR WALKING SURFACE WITHIN 36".

#### **EMERGENCY EGRESS AND RESCUE**

1. PROVIDE ONE WINDOW FROM EACH BEDROOM THAT HAS A MINIMUM OPENABLE AREA OF 5.7 SQUARE FEET WITH A MINIMUM OPENABLE HEIGHT OF 24 INCHES AND WIDTH OF 20 INCHES.

2. BASEMENT EGRESS TO MEET THE REQUIREMENTS OF IRC SECTION 310.

3. SMOKE ALARMS SHALL BE INSTALLED AS REQUIRED PER IRC 2018 SECTION R314. 4. PROVIDE SMOKE ALARMS IN EACH SLEEPING ROOM, OUTSIDE OF EACH SLEEPING AREA, ON EACH FLOOR INCLUDING SASEMENTS AND HABITABLE ATTICS, AND NOT LESS THAN 3-0" HORIZONTALLY FROM DOOR OR OPENING OF A BATHROOM THAT CONTAINS A BATHTUB OR SHOWER. ALARMS SHALL BE INTERCONNECTED IN SUCH A MANNER THAT THE ACTUATION OF ONE ALARM

5. CARBON MONOXIDE ALARMS SHALL BE INSTALLED AS REQUIRED PER IRC 2018 SECTION R315.

SECTION R315.

6. CARBON MONOXIDE ALARMS SHALL BE INSTALLED OUTSIDE OF EACH SEPARATE SLEEPING AREA. WHERE A FUEL-BURNING APPLIANCE IS LOCATED WITHIN A BEDROOM OR ITS ATTACHED BATHROOM, A CARBON MONOXIDE ALARM SHALL BE INSTALLED WITHIN THE BEDROOM.

#### FRAMING GENERAL

- 1. ALL LUMBER SIZES ARE FOR DOUGLAS FIR-LARCH UNLESS NOTED OTHERWISE. 2. ALL HEADERS TO BE MIN (2) #2-2x10 UNLESS NOTED OTHERWISE B. BLOCK CANTILEVERS, DOORJAMBS, AND OVER BEAMS.
- . ALL HEADERS TO BEAR ON A MINIMUM OF (2) 2x4 STUD POSTS UNLESS NOTED 4. ALL HEADERS TO BEAR ON A MINIMUM OF (2) 2x4 STUD POSTS UNLESS NOTED OTHERWISE.

  5. INTERIOR NON-BEARING WALLS, OTHER THAN THOSE RESTING DIRECTLY ON THE FOOTING SHALL BE ISOLATED FROM THE FLOOR FRAMING ABOVE.

  6. WHERE JOISTS RUN PARALLEL TO FOUNDATION WALLS, SOLID BLOCKING FOR A MINIMUM OF (2) QUIST SPACES BE PROVIDED TO A MAXIMUM OF 2-0° CENTERS TO TRANSFER LATERAL LOADS ON THE WALL TO THE FLOOR DIAPHRAGM. THE BLOCKING SHALL BE SECURELY NAILED TO THE JOISTS AND FLOORING NAIL JOISTS AND BLOCKING TO SILL PLATE WITH (3) 100 NAILS (RCS SECTION R602 3,(1)).

  7. IF DUCTS ARE INSTALLED IN THE FIRST JOIST SPACE(S), NAIL 2x4 FLAT AT 2"0° CENTERS WITHIN THE JOIST SPACE(S) AND THEN PROVIDE SOLID BLOCKING, INSTALLED UPRIGHTI, IN THE PREY THYO JOIST SPACES SECURE THE 2x4 TO THE SILL PLATE WITH (4) 100 NAILS.

  8. ALL SILLS AND SLEEPERS SUPPORTED ON CONCRETE OR MASONRY AND FURRING ATTACHED TO CONCRETE OR MASONRY SHALL BE OF DECAY RESISTANT MATERIALS.

  9. JOISTS UNDER BEARING PARTITIONS SHALL BE DOUBLED AND COMPLY WITH IRCS SECTION R502 4.

- 9. JOISTS UNDER BEARING PARTITIONS SHALL BE DOUBLED AND COMPLY WITH IRC SECTION RS02.4.

  10. JOISTS FRAMING FROM OPPOSITE SIDES OVER BEARING SUPPORTS SHALL LAP A MINIMUM 3" AND SHALL BE NAILED TOGETHER WITH A MINIMUM 10d FACE NAILS.

  11. JOISTS FRAMING INTO A WOOD GIRDER OR BEAM SHALL BE SUPPORTED BY APPROVED FRAMING ANCHORS OR MINIMUM 2">2" ELEGER STRIPS.

  12. FRAMING OF OPENINGS HEADERS AND TRIMMERS SHALL BE OF SUFFICIENT CROSS SECTION TO SUPPORT THE FLOOR FRAMING. TRIMMER JOISTS SHALL BE DOUBLED WHEN THE HEADER IS SUPPORTED MORE THAN 3"0" FROM THE TRIMMER JOISTS SHALL BE DOUBLED WHEN THE HEADER IS SUPPORTED MORE THAN 3"0" FROM THE MER JOIST BEARING. WHEN THE HEADER SPAN EXCEEDS 4'-0". THE
- TRIMMER JOIST BEARING, WHEN THE HEADER SPAN EXCEEDS 4-0", THE HEADER AND TRIMMER SHALL BE DOUBLED.

  13. JOISTS AT SUPPORTS SHALL BE SUPPORTED LATERALLY AT THE ENDS BY FULL-DEPTH SOLID BLOCKING NOT LESS THAN 2" NOMINAL THICKNESS OR BY ATTACHMENT TO A HEADER, BAND OR RIM JOIST OR TO AN ADJOINING STUD OR OTHERWISE PROVIDED WITH LATERAL SUPPORT TO PREVENT ROTATION.

  14. WATER-RESISTIVE BARRIER SHALL BE PROVIDED OVER ALL EXTERIOR WALLS. ONE LAYER OF NO. 15 ASPHALT FELT OR ANY OTHER BARRIER THAT MEETS ASTM D226 TYPE 1 FELT. (R703.2)

  15. WHERE CELING JOISTS ARE NOT INSTALLED CONNECTED TO THE RAFTERS AT THE TOP PLATE AND/OR WHERE CEILING JOISTS ARE NOT INSTALLED PARALLEL TO THE RAFTERS, RAFTER TIES SHALL BE INSTALLED IN THE LOWER 1/3 OF THE ATTIC SPACE AND IN ACCORDANCE WITH TABLE 1-S1.0.

  16. COLLAR TIES SHALL BE PROVIDED IN THE UPPER 1/3 OF THE ATTIC SPACE IN ACCORDANCE WITH TABLE 1-S1.0.

GARAGE 1. THE GARAGE FLOOR SHALL SLOPE TOWARDS THE GARAGE DOORWAYS.

1. THE GARAGE FLOOR SHALL SLOPE TOWARDS THE GARAGE DOORWAYS.
2. DOORS BETWEEN THE GARAGE AND THE DWELLING. MINIMUM 1-38" SOLID CORE OR HONEY COMBED STEEL DOOR OR 20-MINUTE FIRE RATED.
3. THE GARAGE SHALL BE SEPARATED FROM THE RESIDENCE AND ITS ATTIC AREA BY SIR", TYPE X GYPSUM BOARD, OR EQUIVALENT MATERIALS APPROVED FOR ONE-HOUR FIRE-RESISTIVE CONSTRUCTION, APPLIED TO GARAGE SIDE. WHERE THE SEPARATION IS A FLOOR-CELLING ASSEMBLY, THE STRUCTURE SUPPORTING THE SEPARATION SHALL ALSO BE PROTECTED BY SIR", TYPE X GYPSUM BOARD, OR MATERIALS APPROVED FOR ONE-HOUR FIRE-RESISTIVE CONSTRUCTION OR EQUIVALENT, APPLIED TO THE GARAGE SIDE. PULL DOWN STAIRS LOCATED WITHIN GARAGE SHALL BE RATED TO BE ADEQUATELY PROTECTED WITH MATERIALS APPROVED FOR ONE-HOUR FIRE-RESISTIVE CONSTRUCTION. ATTIC ACCESS PANELS LOCATED WITHIN GARAGE SHALL BE OF 518", TYPE X GYPSUM BOARD, OR MATERIALS APPROVED FOR ONE-HOUR FIRE-RESISTIVE CONSTRUCTION. ATTIC ACCESS PANELS LOCATED WITHIN GARAGE SHALL BE OF 518", TYPE X GYPSUM BOARD, OR MATERIALS FOR ONE-HOUR FIRE-RESISTIVE CONSTRUCTION.

**STAIRWAYS** 

1. STAIRWAYS SHALL PROVIDE A MAXIMUM 7-3/4" RISE AND MINIMUM 10" RUN.
2. PROVIDE MINIMUM 36" GUARDRAILS ON THE OPEN SIDES OF RAISED FLOORS, PORCHES, AND BALCONIES; MINIMUM 34" GUARDRAILS ON THE OPEN SIDES OF STAIRWAYS LOCATED MORE THAN 30" ABOVE THE FLOOR OR GRADE BELOW. GUARDRAIL ENCLOSURES SHALL HAVE INTERMEDIATE RAILS OR ORNAMENTAL PATTERNS THAT DO NOT ALLOW PASSAGE OF A SPHERE 4" IN DIAMETER.
3. EACH STAIRWAY OF THREE OR MORE RISERS SHALL PROVIDE A CONTINUOUS

ANDRAIL ON AT LEAST ONE SIDE BETWEEN 34" AND 38" ABOVE THE NOSING OF

THE TREADS.

4. HANDRAILS SHALL HAVE A CIRCULAR CROSS SECTION OF 1-1/4" MINIMUM TO 2" MAXIMUM OR OTHER APPROVED GRASPABLE SHAPER PER IRC SECTION 311.7.8.5.

. PROVIDE A MINIMUM 6'-8" OF HEADROOM CLEARANCE IN STAIRWAYS 3. FROVIDE A MINIMON BO DIFFER THE MEMORY STARRWAYS SHALL HAVE WALLS AND THE UNDERSIDE OF THE STARR AND LANDING PROTECTED WITH 12° GYPSUM BOARD ON ENCLOSURE SIDE PER IRC SECTION 302.7.
7. SPIRAL STARS TO BE CONSTRUCTED FROM 18. SPACE STARS TO SECTION 311.7.10.1.

#### **GENERAL**

PLANS SHALL COMPLY WITH THE 2018 INTERNATIONAL RESIDENTIAL CODE WITH AMENDMENTS AS ADOPTED BY THE GOVERNING JURISDICTION. IF ANY CHANGES OR DEVIATIONS FROM THE PLANS ARE MADE DURING CONSTRUCTION, CONTRACTOR SHALL NOTIFY THE APPROPRIATE AUTHORITY AND ENGINEER OF RECORD, EITHER (OR BOTH) OF WHOM MAY REQUIRE REVISED DRAWINGS OR CALCULATIONS AT ITS.

DISCRETIÓN. 2. REPRODUCTION, ALTERATION, OR RE-USE BY ANY METHOD OF ALL OR 2. REPRODUCTION, ALTERATION, OR RE-USE BY ANY METHOD OF ALL OR PORTIONS OF THESE STRUCTURAL PLANS OR VARIATIONS THEREOF WITHOUT WRITTEN PERMISSION FROM APEX ENGINEERS, INC IS STRICTLY PROHIBITED. THE DRAWINGS AND DETAILS OF THIS SHEET SET, BEING INSTRUMENTS OF SERVICE, ARE AND SHALL REMAIN THE PROPERTY OF APEX ENGINEERS, INC. AN UNISEALED VERSION, OR A VERSION ONIO OF APEX PENGINEERS, LOG O AND/OR TITLE BLOCK, SHALL BE CONSIDERED AN UNAUTHORIZED REPRODUCTION.

3. WHERE DISCREPENCIES EXIST BETWEEN THE STANDARD COMMENTS, NOTES FROM THE DESIGN PROFESSIONAL OR THE CODE, THE MOST RESTRICTIVE SHALL

APPLY. THE DWELLING SHALL COMPLY WITH THE FOLLOWING LOAD CONDITION								
AREA	MIN DEAD LOAD	MIN LIVE LOAD						
EXTERIOR BALCONIES	10 PSF	60 PSF						
DECKS	10 PSF	40 PSF						
CEILING JOISTS/ATTICS NO STORAGE - SCUTTLE ACCESS ONLY ROOF SLOPE 3:12 OR LESS	5 PSF	10 PSF						
CEILING JOISTS/ATTICS WITHOUT STORAGE - SCUTTLE ACCESS ONLY ROOF SLOPE OVER 3:12 OR LESS	10 PSF	10 PSF						
CEILING JOISTS/ATTICS WITH STORAGE - DOOR/PULL DOWN LADDER ACCESS	10 PSF	20 PSF						
ROOMS - NON-SLEEPING	10 PSF	40 PSF						
ROOMS - SLEEPING	10 PSF	30 PSF						
ROOF - LIGHT ROOF COVERING	10 PSF	20 PSF						
ROOF - HEAVY ROOF COVERING CONCRETE/TILE/SLATE	20 PSF	20 PSF						

NOTE: HEAVY ROOF COVERING WILL NOT BE INSTALLED OR USED IN THE DESIGN CALCULATIONS UNLESS IT IS SPECIFICALLY NOTED ON THE DESIGN CALCULATIONS UNLESS IT IS SPECIFICALLY NOTED THE PLANS THAT THE DESIGN IS FOR HEAVY ROOF COVERINGS

#### **FOUNDATIONS**

- 1. THE FOUNDATION DESIGN SHALL BE BASED ON A MINIMUM SOIL BEARING CAPACITY OF 2000 PSF, UNLESS OTHERWISE INDICATED ON THE PLANS OR IF MODIFIED BY AN ENGINEERING REPORT BASED ON ACTUAL SITE CONDITIONS. 2. CONCRETE SHALL MEET THE FOLLOWING SPECIFIED DESIGN STRENGTH
- CRITERIA: 2500 PSI FOR BASEMENT FLOOR SLABS ON UNDISTURBED SOIL
- 3000 PSI FOR FOOTINGS AND FOUNDATION WALLS
- 3500 PSI FOR GARAGE FLOOR SLABS 3. FOOTINGS SHALL EXTEND BELOW THE FROST LINE; MINIMUM DEPTH 36 INCHES

- 30. TVOL INFOS STRALE ALERIAD BELOW THE PROST LINE; MINIMUM DEPTH 36 INCHES BELOW GRADE.

  4. UNLESS OTHERWISE, FOOTINGS SHALL BE A MINIMUM OF 16" WIDE AND 8" DEEP WITH (2) #4 BARS CONTINGS SHALL BE A MINIMUM OF 16" WIDE AND 8".

  5. COLLUMN PAOS SHALL BE A MINIMUM 30"x30"x12" WITH (4) #4 BARS EACH WAY UNLESS NOTED OTHERWISE.

  6. UNLESS NOTED OTHERWISE ON THE PLANS, FOUNDATION WALLS SHALL BE MINIMUM 8" THICK 8"-0" (OR 9"-0") TALL AND REINFORCED PER DETAIL 1-\$2.0 (AND 2-\$2.0" WHERE APPLICABLE), FOUNDATION WALLS GREATER THAN 10"-0" TALL REQUIRE A SEPERATE ENGINEERED DESIGN. PROVIDE A 2"-0" LONG INTERIOR OR EXTERIOR DEAD-MAN FOR ANY STRAIGHT WALL PANELS EXCEEDING 20"-0" IN LENGTH (REF 3-\$2.0)

  7. REINFORCEMENT SHALL LAP A MINIMUM OF 24" AT ENDS, SPLICES, AND AROUND CORNERS
- REINFORCEMENT SHALL LAP A MINIMUM OF 24" AT ENDS, SPLICES, AND AROUND CORNERS.

  8. FOUNDATION WALLS SHALL BE BACKFILLED WITH A CLEAN LEAN CLAY (OR BETTER). LOW VOLUME CHANGE MATERIAL. ON-SITE MATERIAL MAY BE USED IF DEEMED ACCEPTABLE BY THE GEOTECHNICAL ENGINEER OF RECORD.

  9. FOUNDATION WALLS WILL NOT ACHIEVE FULL STRENGTH UNTIL THE BASEMENT SLAB AND THE FIRST FLOOR DECK HAVE BEEN PROPERLY PLACED. IF BACKFILLING THE INTERIOR OF THE FOUNDATION WALL WITH GREATER THAN 8" OF EARTHEN FILL OR 24" OF GRANULAR FILL, A STRUCTURAL BASEMENT SLAB (TO BE DESIGNED OR DESIGN REVIEWED BY APEX ENGINEERS), OR ALTERNATE ENGINEERS OLD SOLD STRUCK OR SUMPONDED BY A PROPER OF THE STRUCTURAL BASEMENT SLAB (TO BE DESIGNED OR DESIGN REVIEWED BY APEX ENGINEERS), OR ALTERNATE ENGINEERS SHALL BE FORMED CONTINUOUS AND POURED PER DETAIL 4-S2, OR 1. CONCRETE FLOOR SLABS SHALL BE A MINIMUM 4" THICK OVER A MINIMUM 4" BLOOK OF THE FLOOR SLABS SHALL BE A MINIMUM 4" HICK OVER A MINIMUM 4" BLOOK OF THE FLOOR SLABS SHALL BE A MINIMUM 4" NILLESS NOTED OTHERWISE OR IF SHOULD BE A MINIMUM 4" HICK OVER A MINIMUM 4" BLOOK OF THE PROPER OR IF SHOULD BE A MINIMUM 4" HICK OVER A MINIMUM 4" BLOOK ONLY BE A MINIMUM 4" HICK OVER A MINIMUM 4" BLOOK ONLY BE A MINIMUM 4" HICK OVER A MINIMUM 4" BLOOK ONLY BE A MINIMUM 4" HICK OVER A MINIMUM 4" BLOOK ONLY BE A MINIMUM 4" HICK OVER A MINIMUM 4" BLOOK ONLY BE A MINIMUM 4" BLOOK O
- SITE CONDITIONS REQUIRE OTHERWISE.
  12. PROVIDE A MIN 6 MIL THICK POLYETHYLENE MOISTURE BARRIER OVER
  POURUS GRAUNE BASE UNDER BASEMENT FLOOR SLAB PER R406.2. LAP JOINTS
  MINIMUM 6" (NOT REQUIRED FOR GARAGE SLABS OR DETACHED ACCESSORY
  BILLI DIAIS?)
- MINIMUM 6" (NOT REQUIRED FOR GARAGE SLABS OR DETACHED ACCESSORY BUILDINGS).

  13. FOR A STRUCTURAL REINFORCED CONCRETE FLOOR OVER A USABLE AREA, SUCH AS A GARGE FLOOR OVER A STORAGE AREA, SUBMIT SEALED ENGINEERED DETAILS AND CALCULATIONS.

  14. GARAGE SLABS AND BASEMENT OVERDICS SUPPORTED BY FILL CONSISTING OF MORE THAN 24" OF GRANULAR FILL OR 6" OF EARTH SHALL BE REINFORCED PER DETAILS 1-S2.1 AND 6-S2.1 RESPECTIVELY. WHERE THE LIMITATIONS OF DETAILS 1-S2.1 AND 6-S2.1 ARE NOTE MET, A SEPERATE ENGINEERED DESION SHALL BE REQUIRED.

  15. BASEMENT FOUNDATION SILL PLATES SHALL BE BOLTED TO THE FOUNDATION WITH A MINIMUM OF 12" ANCHOR BOLTS EMBEDDED AT LEAST 7" INTO THE CONCRETE AND SPACED NOT MORE THAN 3".0" ON CENTER AND WITHIN 12" OF EACH END PIECE.
- INTO THE CONCRETE AND SPACED NOT MORE THAN 3°.0° ON CENTER AND WITHIN 12° OF EACH END PIECE.

  16. FOUNDATION WALLS SHALL BE DAMP-PROOFED PER IRC SECTION R406.

  17. PROVIDE A MINIMUM 4° PERFORATED DRAIN AROUND USABLE SPACE BELOW GRADE OR OTHER EQUIVALENT MATERIALS PER IRC SECTION 405.1. THE PIECE SHALL BE PLACED ON A MINIMUM OF 2° OF WASHED GRAVEL OR CRUSHED ROCK AND COVERED WITH NOT LESS THAN 6°. THE DRAIN SHALL DAYLIGHT TO THE STEEDING BELOW THE FLOOR LEVEL OF TERMINATE IN A MINIMUM 20 GALLON 18. INTERIOR BEARING WALLS AND COLUMNS SHALL BE ISOLATED FROM THE BASSFMENT EI ORS 13.8.
- 18. INTERIOR BEARING WALLS AND COLUMNS SHALL BE ISOLATED FROM THE BASEMENT FLOOR SLAB.

  19. INTERIOR NON-BEARING WALLS, OTHER THAN THOSE RESTING DIRECTLY ON THE FOOTING, SHALL BE ISOLATED FROM THE FLOOR FRAMING ABOVE.

  20. ALL EARTH RETAINING STRUCTURES ON SITE GREATER THAN 4-0" TALL (EXCLUDING CONCRETE FOUNDATION WALLS RESTRAINED AT BOTH THEIR TOP AND BOTTOM) SHALL REQUIRE A SEPARATE ENGINEERED DESIGN AS REQUIRED BY THE CODE AUTHORITY.

  21. ANY GEOTECHNICAL IMPROVEMENT METHODS AND/OR STRUCTURAL SOLUTIONS (SUCH AS DRILLED PIERS) EMPLOYED TO ADDRESS UNACCEPTABLE SUBGRADE CONDITIONS SHALL BE SUBMITTED TO EOR AS ENGINEERED SHOP DRAWINGS FOR REVIEW AND APPROVAL. 508°, TYPE X GYPSUM BOARD, OR MATERIALS FOR ONE-HOUR FIRE-RESISTIVE CONSTRUCTION. AND FRAME-THE H-FRAME FOR THE ATTACHMENT OF THE TRACK AND COUNTER BALANCE SHALL CONSIST OF THE FOLLOWING: 2x5 VERTICAL JAMES RUNNING FROM THE FLOOR TO CEILING ATTACHED WITH 1-34\* OF 120° NAILS AT 7" OC STAGGERED WITH (7) 3-14\* V.O. 120° NAILS THRU THE JAME INTO THE HEADER, MINIMUM 2x6 HEADER FOR ATTACHMENT OF COUNTER BALANCE SYSTEM.

## EXPANSIVE SOILS DISCLAIMER:

THESE PLANS HAVE BEEN PREPARED BASED ON A PRESUMPTIVE ALLOWABLE BEARING CAPACITY AS ALLOWED BY IRC CODE AND THE LOCAL ENFORCING

APEX ENGINEERS, INC. (APEX) RECOMMENDS THAT ALL FOOTING EXCAVATION: BE EVALUATED BY A LICENSED GEOTECHNICAL ENGINEER PRIOR TO THE PLACEMENT OF ANY FOUNDATION ELEMENTS. GEOTECHNICAL INVESTIGATION AND/OR TESTING IS NOT A SERVICE PROVIDED OR OFFERED BY APEX.

APEX HAS NOT BEEN RETAINED TO DETERMINE THE EXPANSIVE SOIL APEX HAS NOT BEEN RETAINED TO DETERMINE THE EXPANSIVE SOIL
CHARACTERISTICS OF THE SUBGRADE SOIL AND THEREFORE CANNOT BE HELD
RESPONSIBLE FOR THE VOLUMETRIC CHANGES OF THE SOIL (INCLUDING
BELOW THE BASEMENT SLAB). BY USE OF THESE PLANS WITHOUT AN
ACCOMPANYING GEOTECHNICAL REGINEERING REPORT, APEX SHALL NOT BE
HELD LIABLE FOR ANY FUTURE MOVEMENT AND/OR DIFFERENTIAL MOVEMENT
OF THE PROPOSED STRUCTURE AND THE POSSIBLE DAMAGE THAT THE FOR SELECTION
CAUSED AS A RESULT OF SUCH MOVEMENT. DAMAGE FROM EXPANSIVE SOILS
AND/OR SETTLEMENT CAN RESULT IN AMONGST OTHER THINGS, TIED ON STRUCTION
FOLLOWING: BASEMENT SLAB HEAVE, SHEETFOCK CRACKS, WINDOWS AND
DOOR BECOMING OUT OF PLUMB AND STICKING AND/OR NOT OF WING.
DAMAGE TO TILE, MOULDING, AND OTHER COSMETIC FINISHES.


DEVELOPMENT



AND CLIENT

**APEX** 

1625 LOCUST ST KANSAS CITY, MO 64108 816.421.3222 www.apex-engineers.com

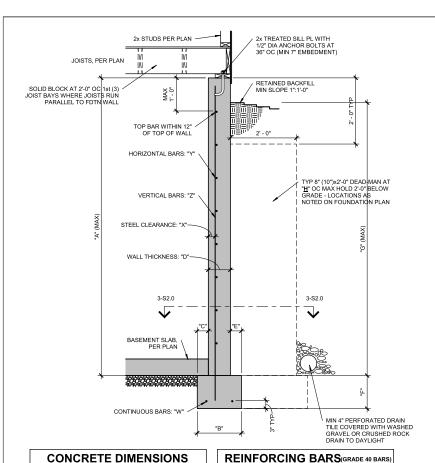

"A" "B" "C" "D" "E" "F" "G" "H"<sup>1</sup>

 "W"
 "X"
 "Y"
 "Z"

 (2) #4
 2 1/2"
 #4 BARS AT 24" OC
 #4 BARS AT 24" OC

 (2) #4
 2 1/2"
 #4 BARS AT 24" OC
 #4 BARS AT 24" OC

 (2) #4
 2 1/2"
 #4 BARS AT 18" OC
 #4 BARS AT 18" OC

NOTES:


1. DIMENSION SHOWN IS FOR MAXIMUM UNINTERRUPTED WALL PANEL LENGTH BEFORE A DEAD-MAN SHALL BE
INSTALLED. NOTE, A MINIMUM 2-0° RETURN OR OFFSET IN THE FOUNDATION WALL SHALL SUBSTITUTE AS A DEAD-MAN
ANDIOR BREAK IN THE WALL PANEL LENGTH.
2. VERTICAL REINFORCING STEEL TO EXTEND TO WITHIN 8° OF TOP WALL. MINIMUM (1) #4 HORIZONTAL BAR WITHIN 12° OF
TOP AND BOTTOM OF WALL.

TOP AND BOTTOM OF WALL.


3. BURIED CONCRETE FOUNDATION WALLS UP TO 9-0" TALL MAY BE 8" NOMINAL THICKNESS WITH #4 BARS AT 24" OC BOTH WAYS OVER 16"%" CONCRETE FOOTINGS WITH (2) #4 BARS CONTINUOUS, UNLESS OTHERWISE REQUIRED BY ENGINEERING REPORT BASED ON ACTUAL SITE CONDITIONS.

4. WALL WILL NOT ACHIEVE FULL STRENGTH UNTIL FIRST FLOOR DECK AND BASEMENT SLAB HAVE BEEN PLACED.


#### TYPICAL FOUNDATION WALL 1 DETAIL **S2.0** 3/4" = 1'-0"

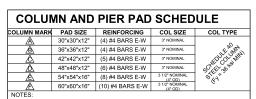

NOTIES: 1. COLUMN AND PIER PAD SIZES SHOWN ARE FOR MAXIMUM COLUMN HEIGHT OF 10-0". REQUIRES SEPERATE ENGINEERED DESIGN IF GREATER THAN 10"0" 2. COLUMN AND PIER PAD SIZES SHOWN ARE BASED ON AN ASSUMED MINIMUM ALLOWABLE SOIL BEARING CAPACITY OF 2,000 PSF

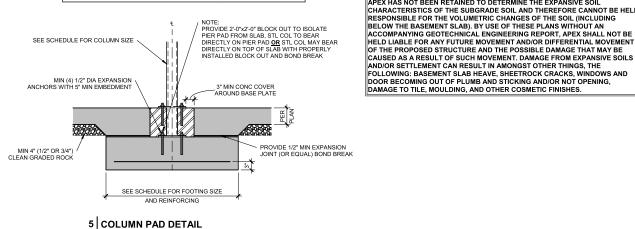

S2.0 3/4" = 1'-0"

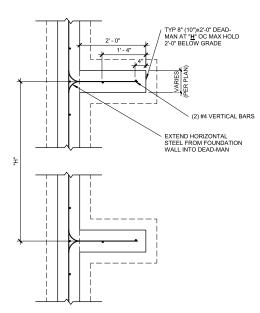

EXPANSIVE SOILS DISCLAIMER:

- NOI 18: 1. MIN 3000 PSI FOOTING COMPRESSIVE CONCRETE STRENGTH.
  2. MIN 3000 PSI WALL COMPRESSIVE CONCRETE STRENGTH.
  3. AIR ENTRAINED BETWEEN 5% 8.7% OF CONCRETE VOLUME.
  4. GRADE 40 REINFORCING STEEL UNLESS OTHERWISE NOTED.
  5. LAD SOI IFES 24" MIN.

- 5. LAP SPLICES 24" MIN.
  6. WALL SHALL BE BACK-FILLED WITH CLEAN, LEAN CLAY (OR BETTER) LOW VOLUME CHANGE MATERIAL. ON-SITE MATERIAL MAY BE USED IF DEEMED ACCEPTABLE BY THE GEOTECHNICAL ENGINEER.
  7. ASSUMED 2,000 PSP BEARING (TO BE VERIFIED BY GEOTECHNICAL ENGINEER).


3 TYPICAL DEAD-MAN SECTION

**S2.0** 3/4" = 1'-0"

THESE PLANS HAVE BEEN PREPARED BASED ON A PRESUMPTIVE ALLOWABLE BEARING CAPACITY AS ALLOWED BY IRC CODE AND THE LOCAL ENFORCING JURISDICTION.

APEX ENGINEERS, INC. (APEX) RECOMMENDS THAT ALL FOOTING EXCAVATIONS BE EVALUATED BY A LICENSED GEOTECHNICAL ENGINEER PRIOR TO THE PLACEMENT OF ANY FOUNDATION ELEMENTS. GEOTECHNICAL INVESTIGATION AND/OR TESTING IS NOT A SERVICE PROVIDED OR OFFERED BY APEX.

APEX HAS NOT BEEN RETAINED TO DETERMINE THE EXPANSIVE SOIL CHARACTERISTICS OF THE SUBGRADE SOIL AND THEREFORE CANNOT BE HELD RESPONSIBLE FOR THE VOLUMETRIC CHANGES OF THE SOIL (INCLUDING BELOW THE BASEMENT SLAB). BY USE OF THESE PLANS WITHOUT AN

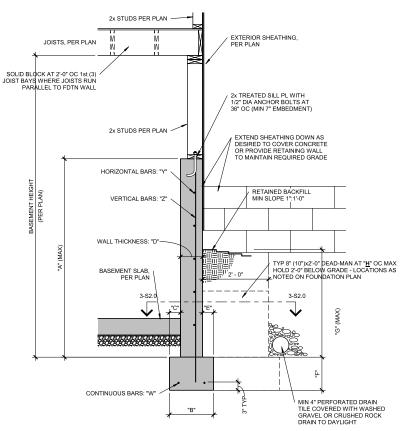

CONCRETE DIMENSIONS					RE	INF	ORCING BAI	RS(GRADE 40 BARS)			
"A"	"B"	"C"	"D"	"E"	"F"	"G"	"H"1	"W"	"X"	"γ"	"Z"
4'-0"	1'-4"	4"	8"	4"	8"	3'-4"	20'-0"	(2) #4	N/A	#4 BARS AT 24" OC	#4 BARS AT 24" OC
6'-0"	1'-4"	4"	8"	4"	8"	4'-4"	20'-0"	(2) #4	N/A	#4 BARS AT 24" OC	#4 BARS AT 24" OC
9'-0"	1'-8"	5"	8"	4"	8"	4'-4"	20'-0"	(2) #4	N/A	#4 BARS AT 24" OC	#4 BARS AT 24" OC

NOTES:


1. DIMENSION SHOWN IS FOR MAXIMUM UNINTERRUPTED WALL PANEL LENGTH BEFORE A DEAD-MAN SHALL BE INSTALLED. NOTE, A MINIMUM 2-0° RETURN OR OFFSET IN THE FOUNDATION WALL SHALL SUBSTITUTE AS A DEAD-MAN AND/OR BREAK IN THE WALL PANEL LENGTH.

2. VERTICAL REINFORCING STEEL TO EXTEND TO WITHIN 8° OF TOP WALL. MINIMUM (1) #4 HORIZONTAL BAR WITHIN 12° OF TOP AND BOTTOM OF WALL.

3. THE BASEMENT SLAB IS AN INTEGRAL PART OF THE "UNRESTRAINED" FOUNDATION WALL DESIGN THEREFORE, IF THE WALL IS BASCHIELD PRIOR TO P DELACEMENT OF THE BASEMENT SLAB. THE CONTRACTOR SHALL BE RESPONSIBLE FOR PROPERLY BRACING THE WALL UNTIL THE BASEMENT SLAB HAS BEEN PLACED.

TYPICAL 'UNRESTRAINED' 2 FOUNDATION WALL DETAIL

**S2.0** 3/4" = 1'-0'

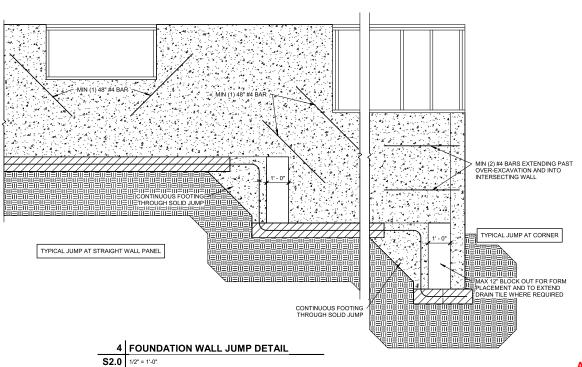






TROOLOT#: 40	+3033		
DRAWN BY:	jae		
CHECKED BY:	BDC		
SUBMITTAL DATE: 2022.0	1.06		
COMMENTS			
DATE			
#			
	-		

RELEASE FOR CONSTRUCTION AS NOTED ON PLANSREY III
Development Security

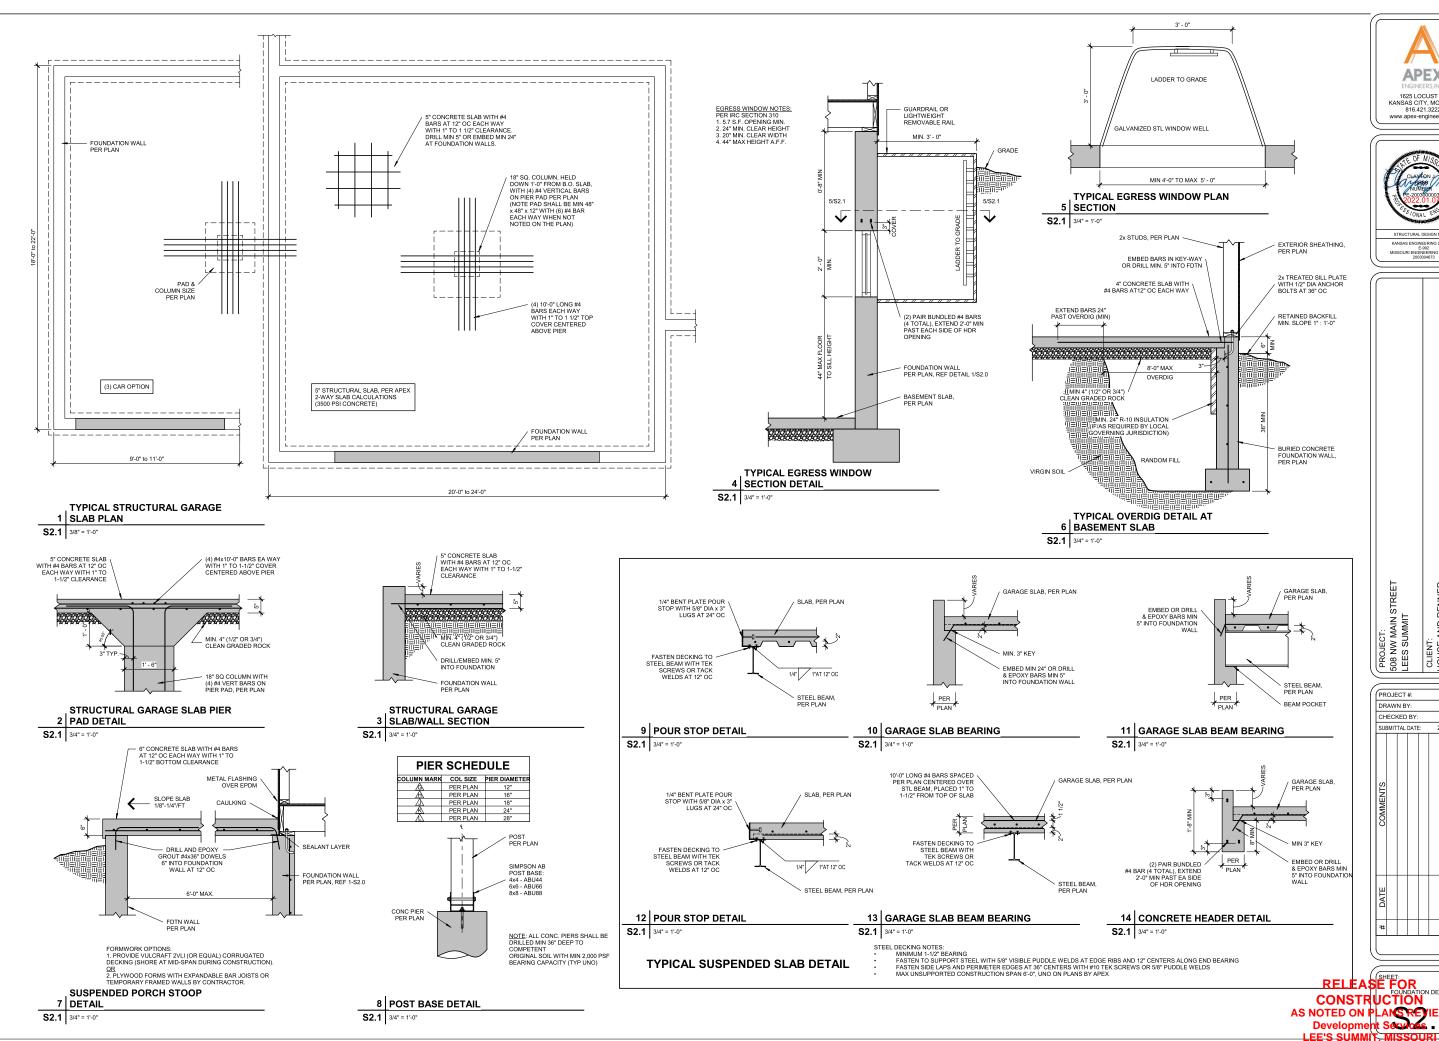



**APEX** 1625 LOCUST ST KANSAS CITY, MO 64108 816.421.3222 www.apex-engineers.com




OUSE

2022.01.06

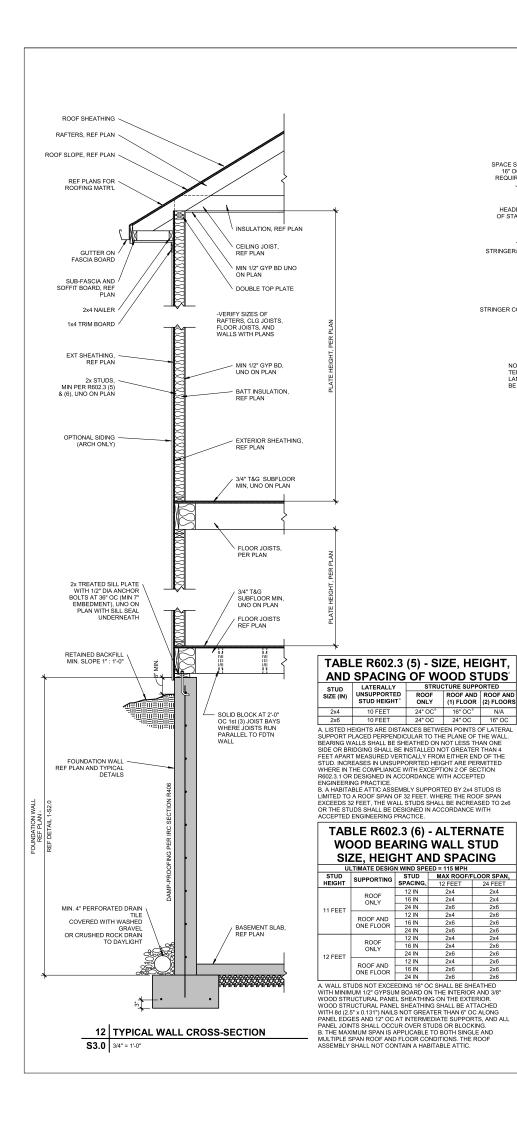

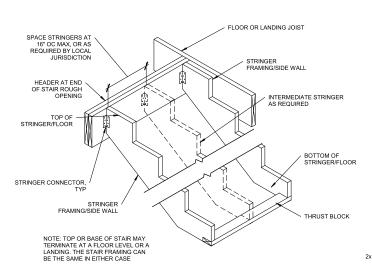


11 TYPICAL STRINGER DETAIL **S3.0** 3/4" = 1'-0"

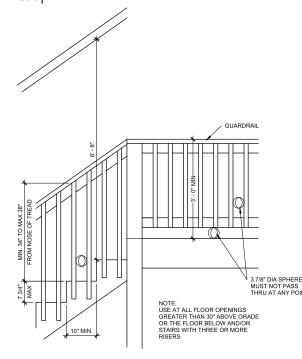


# 10 TYPICAL STAIR/RAIL DETAIL

STRUCTURE SUPPORTED

ROOF ROOF AND ROOF AND
ONLY (1) FLOOR (2) FLOORS

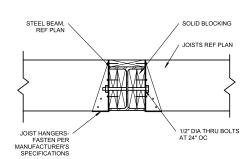


**UPSET STEEL BEAM/JOIST** 9 CONNECTION **S3.0** 1 1/2" = 1'-0"

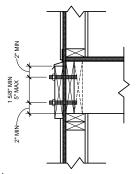


8 LEDGER FASTENER PLACEMENT

S3.0 1 1/2" = 1'-0"

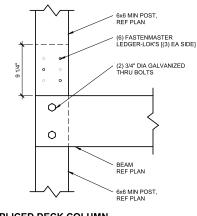


SPLICED DECK COLUMN 4 CONNECTION

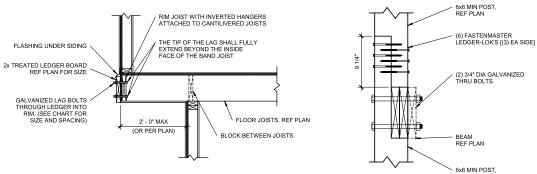

TYPICAL CANTILEVER FRAMING
7 WITH DECK ATTACHMENT

S3.0 3/4" = 1'-0"

SPLICED DECK COLUMN 3 CONNECTION S3.0 1 1/2" = 1'-0"

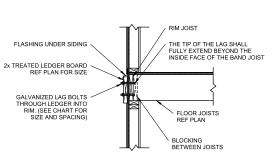


# **DECK LEDGER ATTACHMENT CHART** DECK JOIST SPAN 1/2" DIA LAG SPACING FOR 16" OC JOIST BAYS

CHART IS APPLICABLE ONLY WHEN DECK IS SHOWN ON APPROVED PLAN.


### 6 TYPICAL LEDGER ATTACHMENT

S3.0 3/4" = 1'-0'

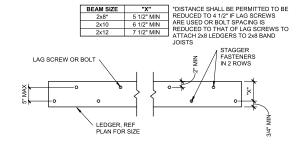

5 TYPICAL LEDGER BOLT SPACING

S3.0 3/4" = 1'-0"

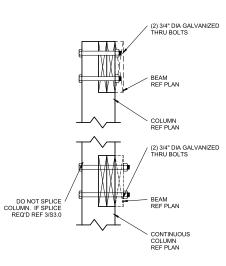

#### DECK BEAM/COLUMN 2 CONNECTION

S3.0 1 1/2" = 1'-0"

**S3.0** 3/4" = 1'-0"

6x6 MIN POST, REF PLAN. NOTCH FOR "MAIN" BEAM BEARING BEAM, REF PLAN 2x TREATED FLOOR JOIST, REF PLAN DO NOT NOTCH POST TO RECEIVE DECK JOIST OR "SIDE" BEAM SIMPSON LUC SERIES OR EQUIV CONCEALED FLANGE JOIST HANGER

DECK BEAM/COLUMN CORNER 1 CONDITION

2022.01.06

12 H2


**APEX** 

1625 LOCUST ST KANSAS CITY, MO 64108 816.421.3222 www.apex-engineers.com

RELEASE FOR
CONSTRUCTION
NOTED ON PLANS REVIEW
Development Security .

PROJECT #:

CHECKED BY

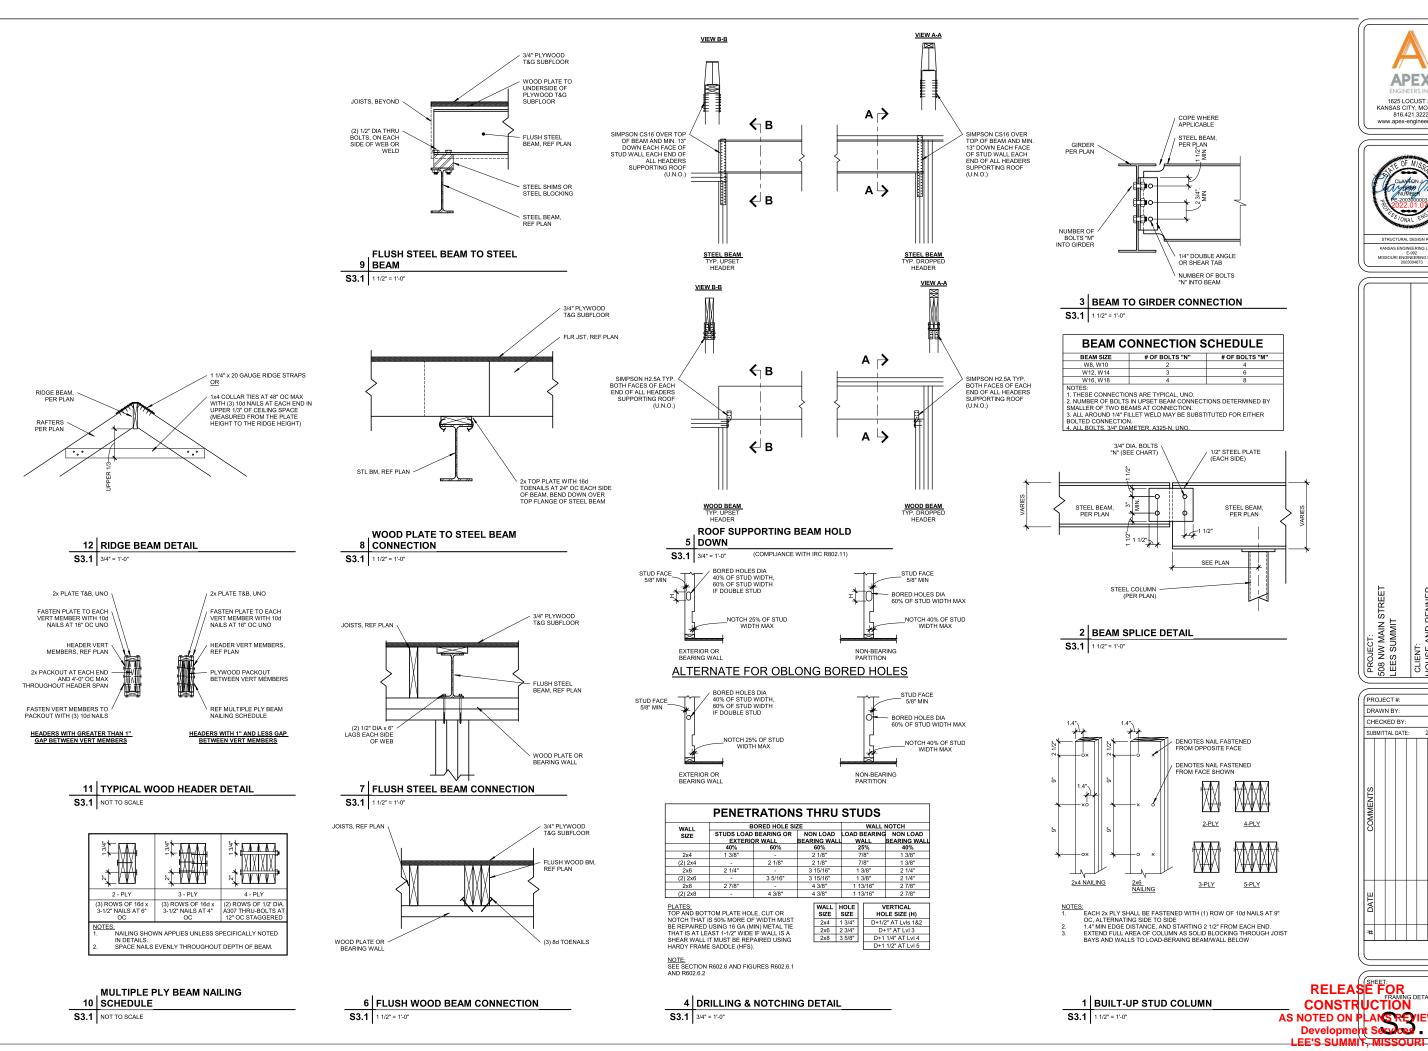


**APEX** 1625 LOCUST ST KANSAS CITY, MO 64108 816.421.3222 www.apex-engineers.com



PROJECT #: CHECKED BY: 2022.01.06


SEN

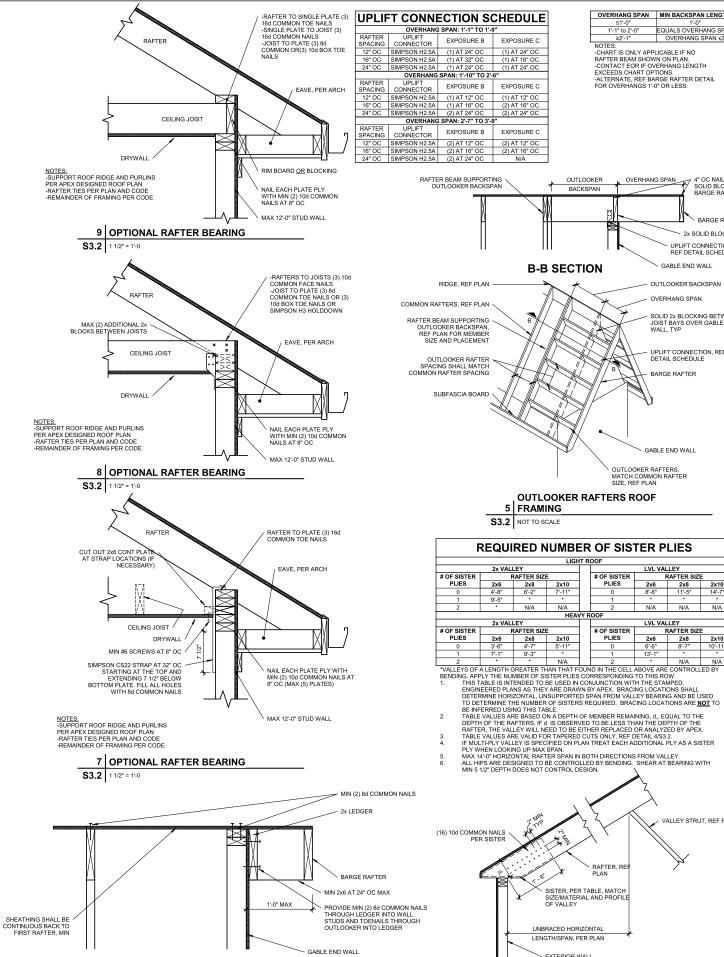

**OPTIONAL OVERHANG 1'-0" OR** 

6 LESS

**S3.2** 1 1/2" = 1'-0

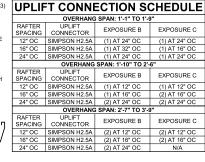

HEDULE		OVERHANG SPAN	MIN BACKSPAN LE	
		≤1'-0"	1'-0"	
		1'-1" to 2'-0"	EQUALS OVERHANG	
EXPOSURE C		≥2'-1"	OVERHANG SPA	
		NOTES:		
(1) AT 24" OC		-CHART IS ONLY APPLICABLE IF NO RAFTER BEAM SHOWN ON PLAN.		
(1) AT 16" OC				
(1) AT 24" OC	-CONTACT EOR IF OVERHANG LENGTH			
		EXCEEDS CHART OP		
EXPOSURE C	-ALTERNATE, REF BARGE RAFTER DETA FOR OVERHANGS 1'-0" OR LESS.			

**B-B SECTION** 

OUTLOOKER RAFTERS ROOF

**REQUIRED NUMBER OF SISTER PLIES** 

RAFTER, RE

SISTER, PER TABLE, MATCH SIZE/MATERIAL AND PROFILE OF VALLEY

UNBRACED HORIZONTA

LENGTH/SPAN, PER PLAN

EXTERIOR WALL

4 TAPERED VALLEY

**S3.2** 3/4" = 1'-0"

5 FRAMING S3.2 NOT TO SCALE

OUTLOOKER OVERHANG SPAN 4" OC NAIL SPACING AT SOLID BLOCKING AND BARGE RAFTER

BARGE RAFTER

2x SOLID BLOCKING

UPLIFT CONNECTION, REF DETAIL SCHEDULE

GABLE END WALL

OUTLOOKER BACKSPAN OVERHANG SPAN

SOLID 2x BLOCKING BETWEEN JOIST BAYS OVER GABLE END WALL, TYP


- UPLIFT CONNECTION, REF DETAIL SCHEDULE

BARGE RAFTER


OUTLOOKER RAFTERS, MATCH COMMON RAFTER SIZE, REF PLAN


LVL VALLEY

VALLEY STRUT, REF PLAN

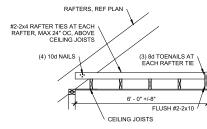


### **A-A SECTION**

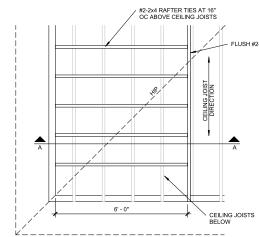

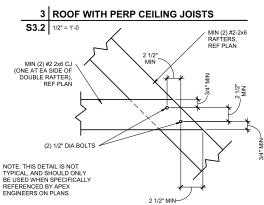

**S3.2** 1 1/2" = 1'-0"

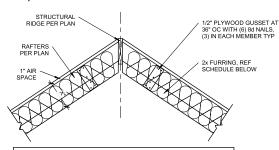

FURR OUT SCHEDULE					
RAFTER SIZE	R-30C INSULATION (X= 9 1/4")	R-38C INSULATION (X=11 1/4")			
2x6	2x6	2x8			
2x8	2x4	2x6			
2x10	NOT REQUIRED	2x4			
2x12	NOT REQUIRED	REQUIRED			
SPAN CHART, 2. ALL VAULTS REQUIRED DE 3. R-30C INSUL 4. R-38C INSUL 5. INSULATION ROOF/CEILING LIMITED TO VA	D RAFTERS SHALL BE #2-26 E UNILESS NOTED OTHERWISE SHALL BE FURRED DOWN WIT PTH OF INSULATION, PLUS 1" F ATION = 8 14" THICK ATION = 10 14" THICK I REQUIREMENTS MAY BE RED ASSEMBLY DOES NOT ALLOW ULTED CEILING AREAS THAT, ERCENT OF THE TOTAL INSULA	IH 2x FRAMING TO THE AIR SPACE. UCED TO R30 IF I SUFFICIENT SPACE BUT IS ARE LESS THAN 500 SQUARE			

VAULTED RAFTER INSULATION 1 FURR OUT

S3.2 3/4" = 1'-0"

WHICHEVER IS LESS. (PER N1102.2.2)

RELEASE FOR
CONSTRUCTION
S NOTED ON PLANS REVIEW
Development Security
LEE'S SUMMIT, MISSOURI


CHECKED BY 2022.01.06

PROJECT #:

OUSE

**APEX** 

1625 LOCUST ST KANSAS CITY, MO 64108 816.421.3222 www.apex-engineers.com

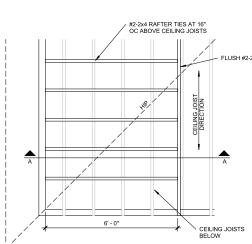

	BOLTED RAFTER HIP
2	BOLTED RAFTER HIP CONNECTION

FURR OUT SCHEDULE				
RAFTER SIZE	R-30C INSULATION (X= 9 1/4")	R-38C INSULATION (X=11		
2x6	2x6	2x8		
2x8	2x4	2x6		
2x10	NOT REQUIRED	2x4		
2x12	NOT REQUIRED	REQUIRED		
SPAN CHART, 2. ALL VAULTS REQUIRED DE	ED RAFTERS SHALL BE #2-2x6 D UNLESS NOTED OTHERWISE. IS SHALL BE FURRED DOWN WIT PTH OF INSULATION, PLUS 1" A LATION = 8 1/4" THICK	TH 2x FRAMING TO THE		

