



DWG: F:\2018\1001-1500\018-1140-C\40-Design\AutoCAD\Final Plans - Asbuilts\Sheets\GNVC\Sanitary Sewer Plans\C_TTL01_C181140.dwg
DATE: Mar 24, 2022 10:56am
USER: ssaylor

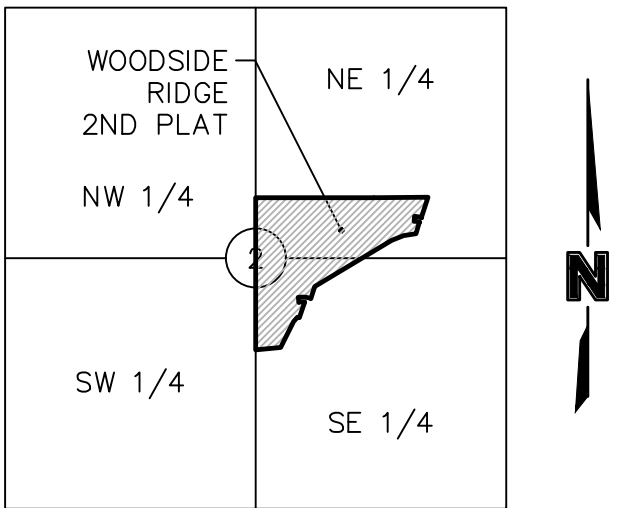

LOCATION MAP
Sec. 2, Twp. 47 N., Rge. 32 W.
(N.T.S.)

PROJECT TEAM & UTILITY CONTACT LIST	
OWNER / DEVELOPER CLAYTON PROPERTIES GROUP, LLC, DBA SUMMIT HOMES 120 SE 30TH STREET LEE'S SUMMIT, MO 64082 CONTACT: VINCENT WALKER PHONE: 816.246.6700 FAX: 816.246.2662	UTILITY SERVICE NUMBERS NAME: DEVELOPMENT SERVICES PHONE: 816-969-1200 NAME: LEE'S SUMMIT WATER & SERVICES DEPARTMENT PHONE: 816-969-1940 NAME: SPIRE (MGE) PHONE: 314-342-0500
ENGINEER OLSSON 1301 BURLINGTON, SUITE 100 NORTH KANSAS CITY, MO 64116 CONTACT: JULIE E SELLERS, P.E. PHONE: 816.361.1177	NAME: AT&T PHONE: 800-286-8313 NAME: EVERGY PHONE: 816-471-5275 NAME: SPECTRUM (TWC) PHONE: 877-772-2253
SURVEYOR OLSSON 1301 BURLINGTON, SUITE 100 NORTH KANSAS CITY, MO 64116 CONTACT: JASON ROUBEUSH, PLS PHONE: 816.361.1177	NAME: GOOGLE FIBER PHONE: 877-454-6959
GEOTECHNICAL ENGINEER OLSSON 1700 E. 123RD ST. OLATHE, KS 66061 CONTACT: JAMES LANDRUM PHONE: 816.829.0078	

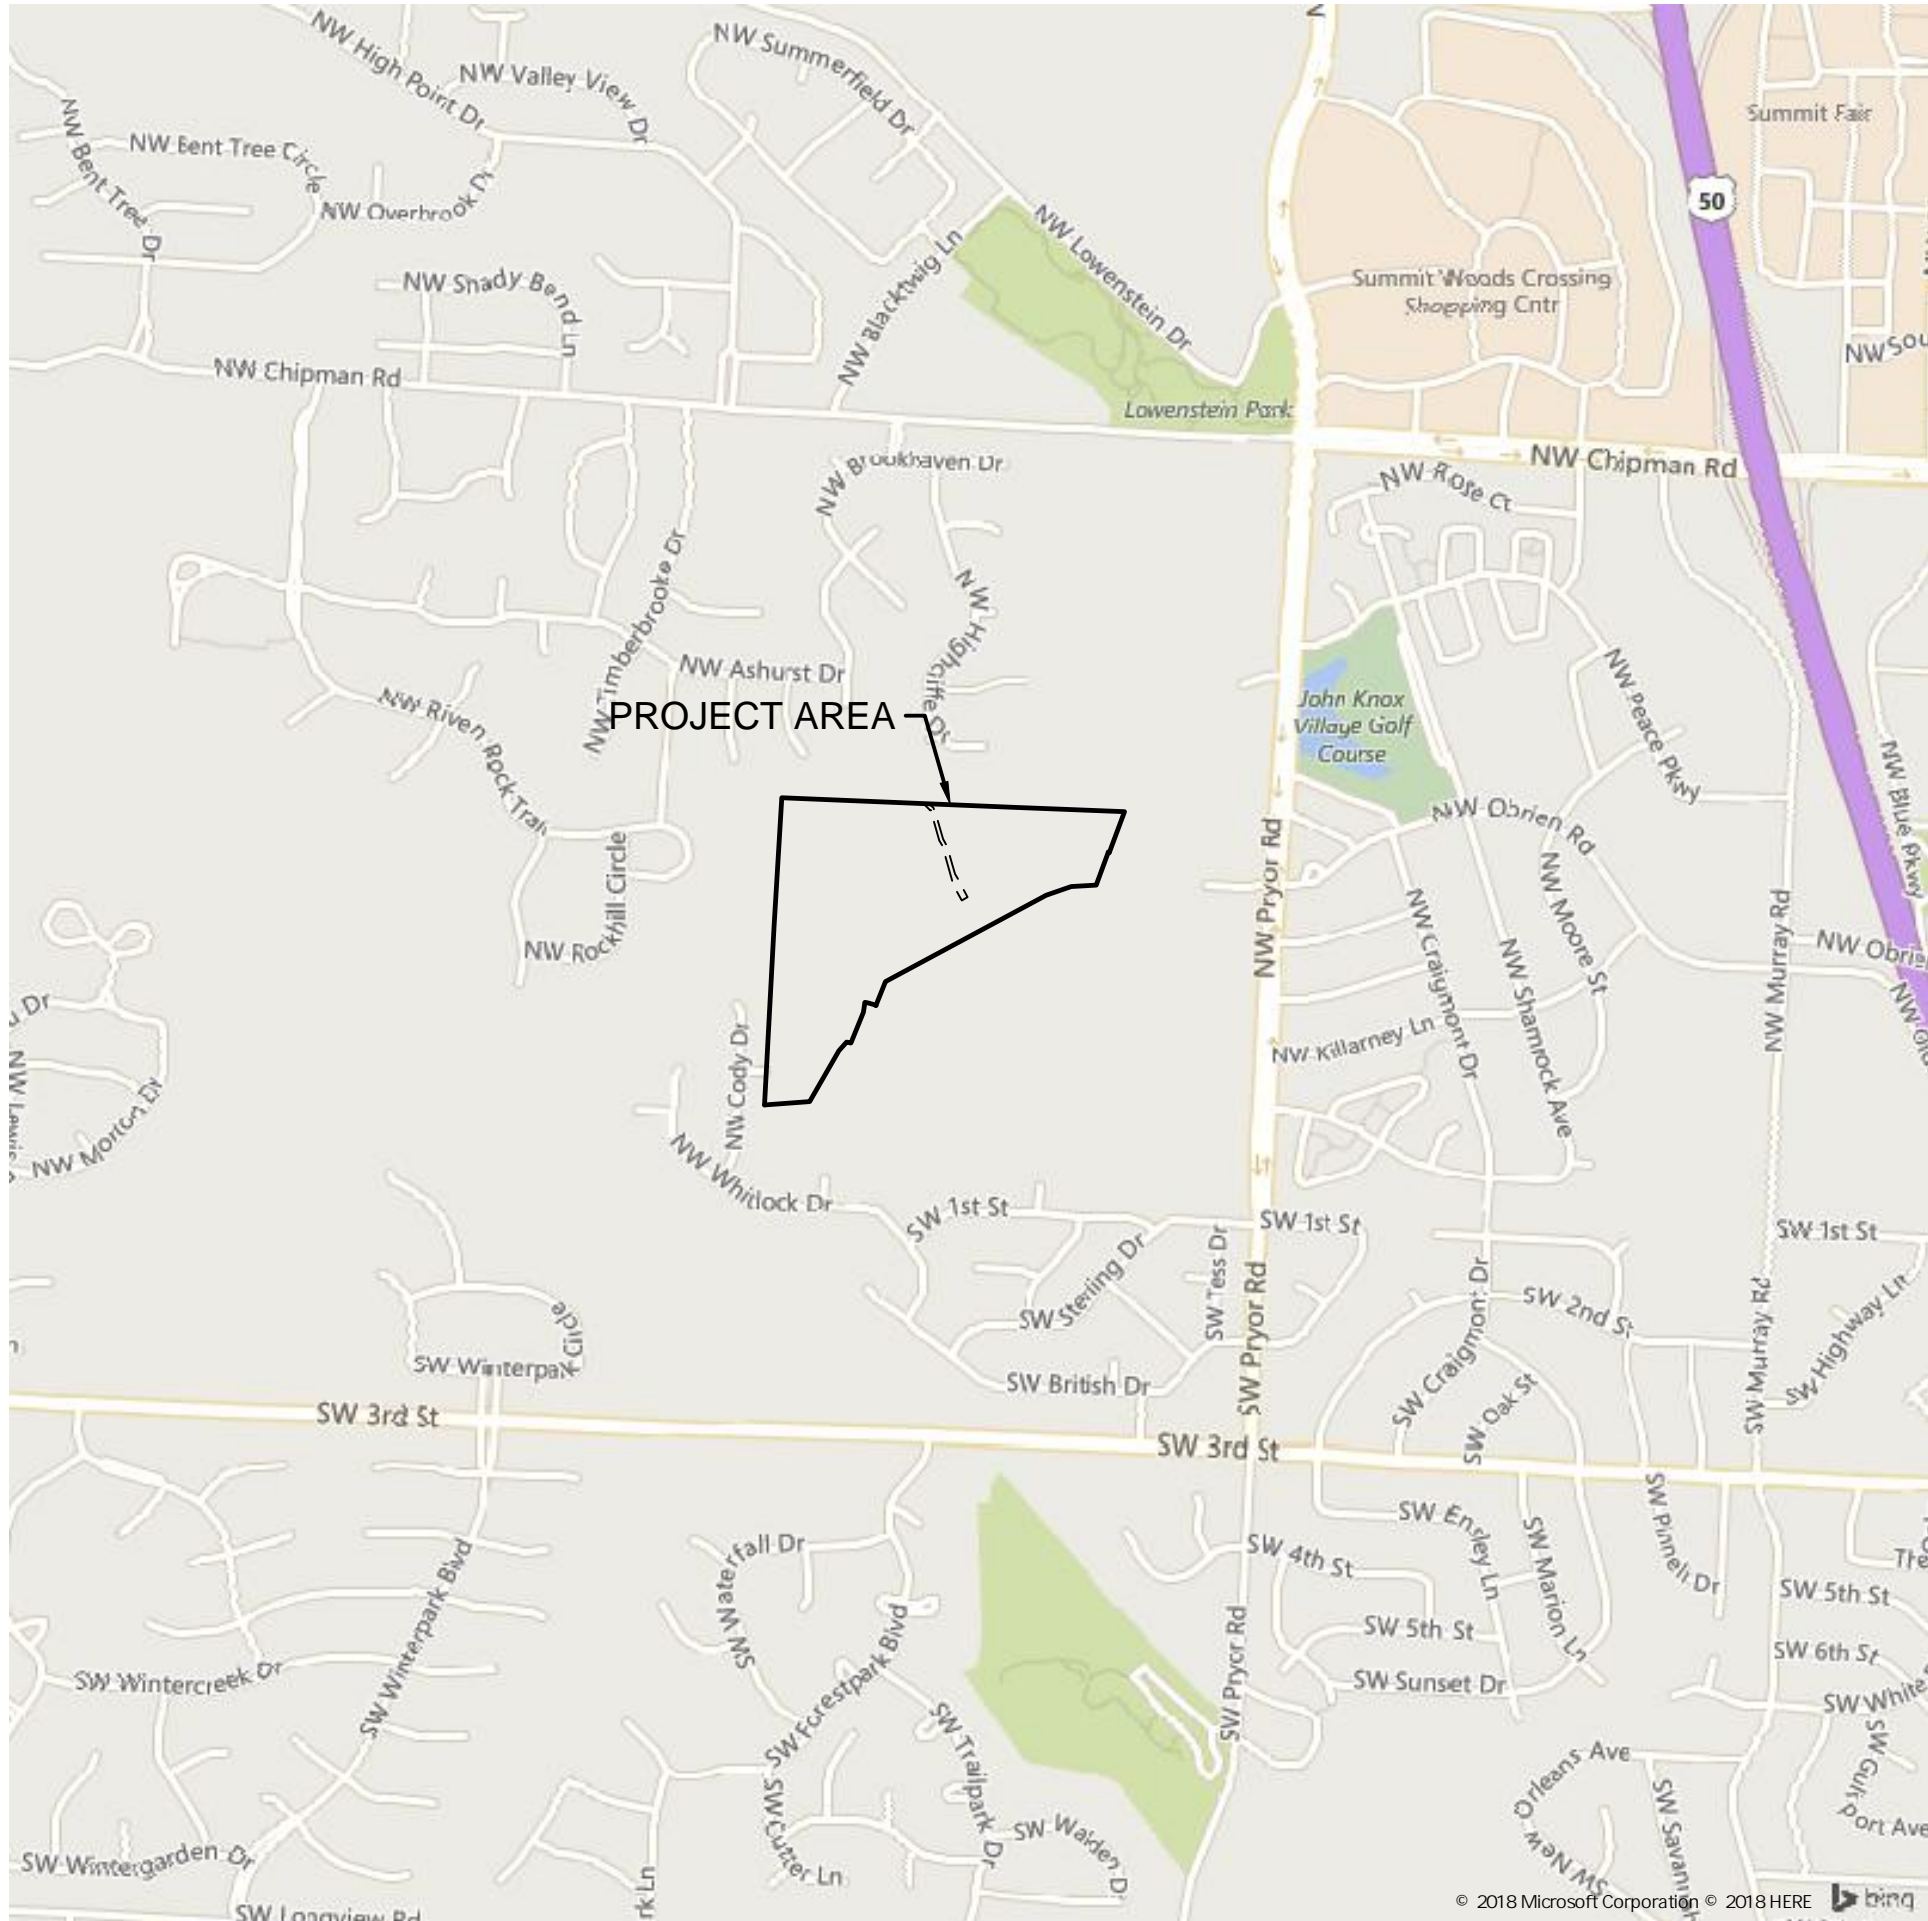

PROPERTY DESCRIPTION:















































































Part of Lot 3B, WEST VILLAGE COMMERCIAL DEVELOPMENT, LOTS 3A AND 3B, a subdivision recorded as Instrument Number 19E0018413 in Book 1182 at Page 62 in Jackson County Recorder of Deeds Office located in the Northeast and Southeast Quarter of Section 2, Township 47 North, Range 32 West of the 5th Principal Meridian in Lee's Summit, Jackson County, Missouri being bounded and described by or under the direct supervision of Jason S Roubush, P.L.S. 2002014092 as follows: Commencing at the Southeast corner of said Southeast Quarter; thence North 87°47'03" West, on the South line of said Southeast Quarter 2,633.21 feet to the Southwest corner of said Southeast Quarter; thence North 03°05'41" East, on the West line of said Southeast Quarter, 1,326.36 feet to the Southwest corner of said Lot 3B, also being the Southwest corner of the North half said Southeast Quarter, also being a point on the Easterly line of STERLING HILLS 5TH PLAT, a subdivision in said Lee's Summit recorded as Instrument Number 11273788 in Book 154 at Page 88 in said Jackson County Recorder of Deeds Office, also being the Southwest corner of proposed WOODSIDE RIDGE 1st Plat, Lots 1 thru 143 Inclusive, and Tracts A, B, C, D, E, F, G and H; thence North 03°05'41" East on said West line and said Easterly line, also being the West line of said Lot 3B, also being the Westerly line of proposed WOODSIDE RIDGE 1ST PLAT, LOTS 1 thru 143 Inclusive, and Tracts A, B, C, D, E, F, G and H, 389.26 feet to the Point of Beginning of the tract of land to be herein described; thence leaving said proposed Westerly line, continuing North 03°05'41" East on said West lines and said Easterly lines, 936.61 feet to the Northeast corner of said STERLING HILLS 5TH PLAT, also being a point on the Easterly line of WINTERSET WOODS - 3RD PLAT, a subdivision in said Lee's Summit recorded as Instrument Number 20030002463 in Book 174 at Page 14 in said Jackson County Recorder of Deeds Office, also being the Northwest corner of said Southeast Quarter; thence North 03°26'14" East, on the said West line of said Lot 3B, said Easterly line and West line of said Northeast Quarter, 665.72 feet to the Northwest corner of the South Half of the South Half of said Northeast Quarter, also being the Northwest corner of said Lot 3B, also being the Northeast corner of said WINTERSET WOODS - 3RD PLAT, also being a point on the Southerly line of BROOKRIDGE ESTATES - SECOND PLAT LOTS 39-84, a subdivision in said Lee's Summit recorded as Instrument Number 1802804 in Book 144 at Page 57 in said Jackson County Recorder of Deeds Office; thence South 87°37'42" East, along said Southerly line, also along the North line of said Lot 3B, also being the North line of said South Half of said South Half of said Northeast Quarter, also being the South line of THE FOREST OF BROOKRIDGE ESTATES - THIRD PLAT LOTS 117 - 133, a distance of 1,210.45 feet to the Southeast corner of said THE FOREST OF BROOKRIDGE ESTATES - THIRD PLAT LOTS 117 - 133 and to a point on said proposed Westerly line; thence South 87°37'42" East on said North line of said South Half of said South Half, said North line of said Lot 3B, and said proposed Westerly line, 574.95 feet; thence leaving said North lines, South 20°32'36" West, along said proposed Westerly line, 229.10 feet; thence Westerly, along said proposed Westerly line, on a curve to the left, having an initial tangent bearing of North 69°27'24" West with a radius of 425.00 feet, a central angle of 00°42'29" and an arc distance of 5.25 feet; thence South 19°50'07" West, along said proposed Westerly line 178.42 feet; thence South 85°52'23" West, along said proposed Westerly line, 130.41 feet; thence South 70°59'24" West, along said proposed Westerly line, 137.47 feet; thence South 61°49'26" West, along said proposed Westerly line, 951.56 feet; thence South 21°24'31" West, along said proposed Westerly line, 135.10 feet; thence Westerly, along said proposed Westerly line, along a curve to the left having an initial tangent bearing of North 68°35'29" West with a radius of 275.00 feet, a central angle of 12°33'32" and an arc distance of 60.28 feet; thence South 08°50'59" West, along said proposed Westerly line, 50.00 feet; thence South 22°12'04" West, along said proposed Westerly line, 173.03 feet; thence North 75°51'31" West, along said proposed Westerly line, 21.43 feet; thence South 41°11'03" West, along said proposed Westerly line, 60.06 feet; thence South 29°55'27" West, along said proposed Westerly line, 306.11 feet; thence South 85°54'26" West, along said proposed Westerly line, 236.75 feet to the Point of Beginning. Containing 1,514,368 square feet or 34.77 acres, more or less.

BENCHMARK

BMK #5 CHISELED SQUARE ON THE S.E. CORNER OF A CONCRETE PAD FOR A TRAFFIC SIGNAL BOX AT THE S.W. CORNER OF PRYOR ROAD AND O'BRIEN ROAD.

ELEVATION: 979.24

PROJECT AREA

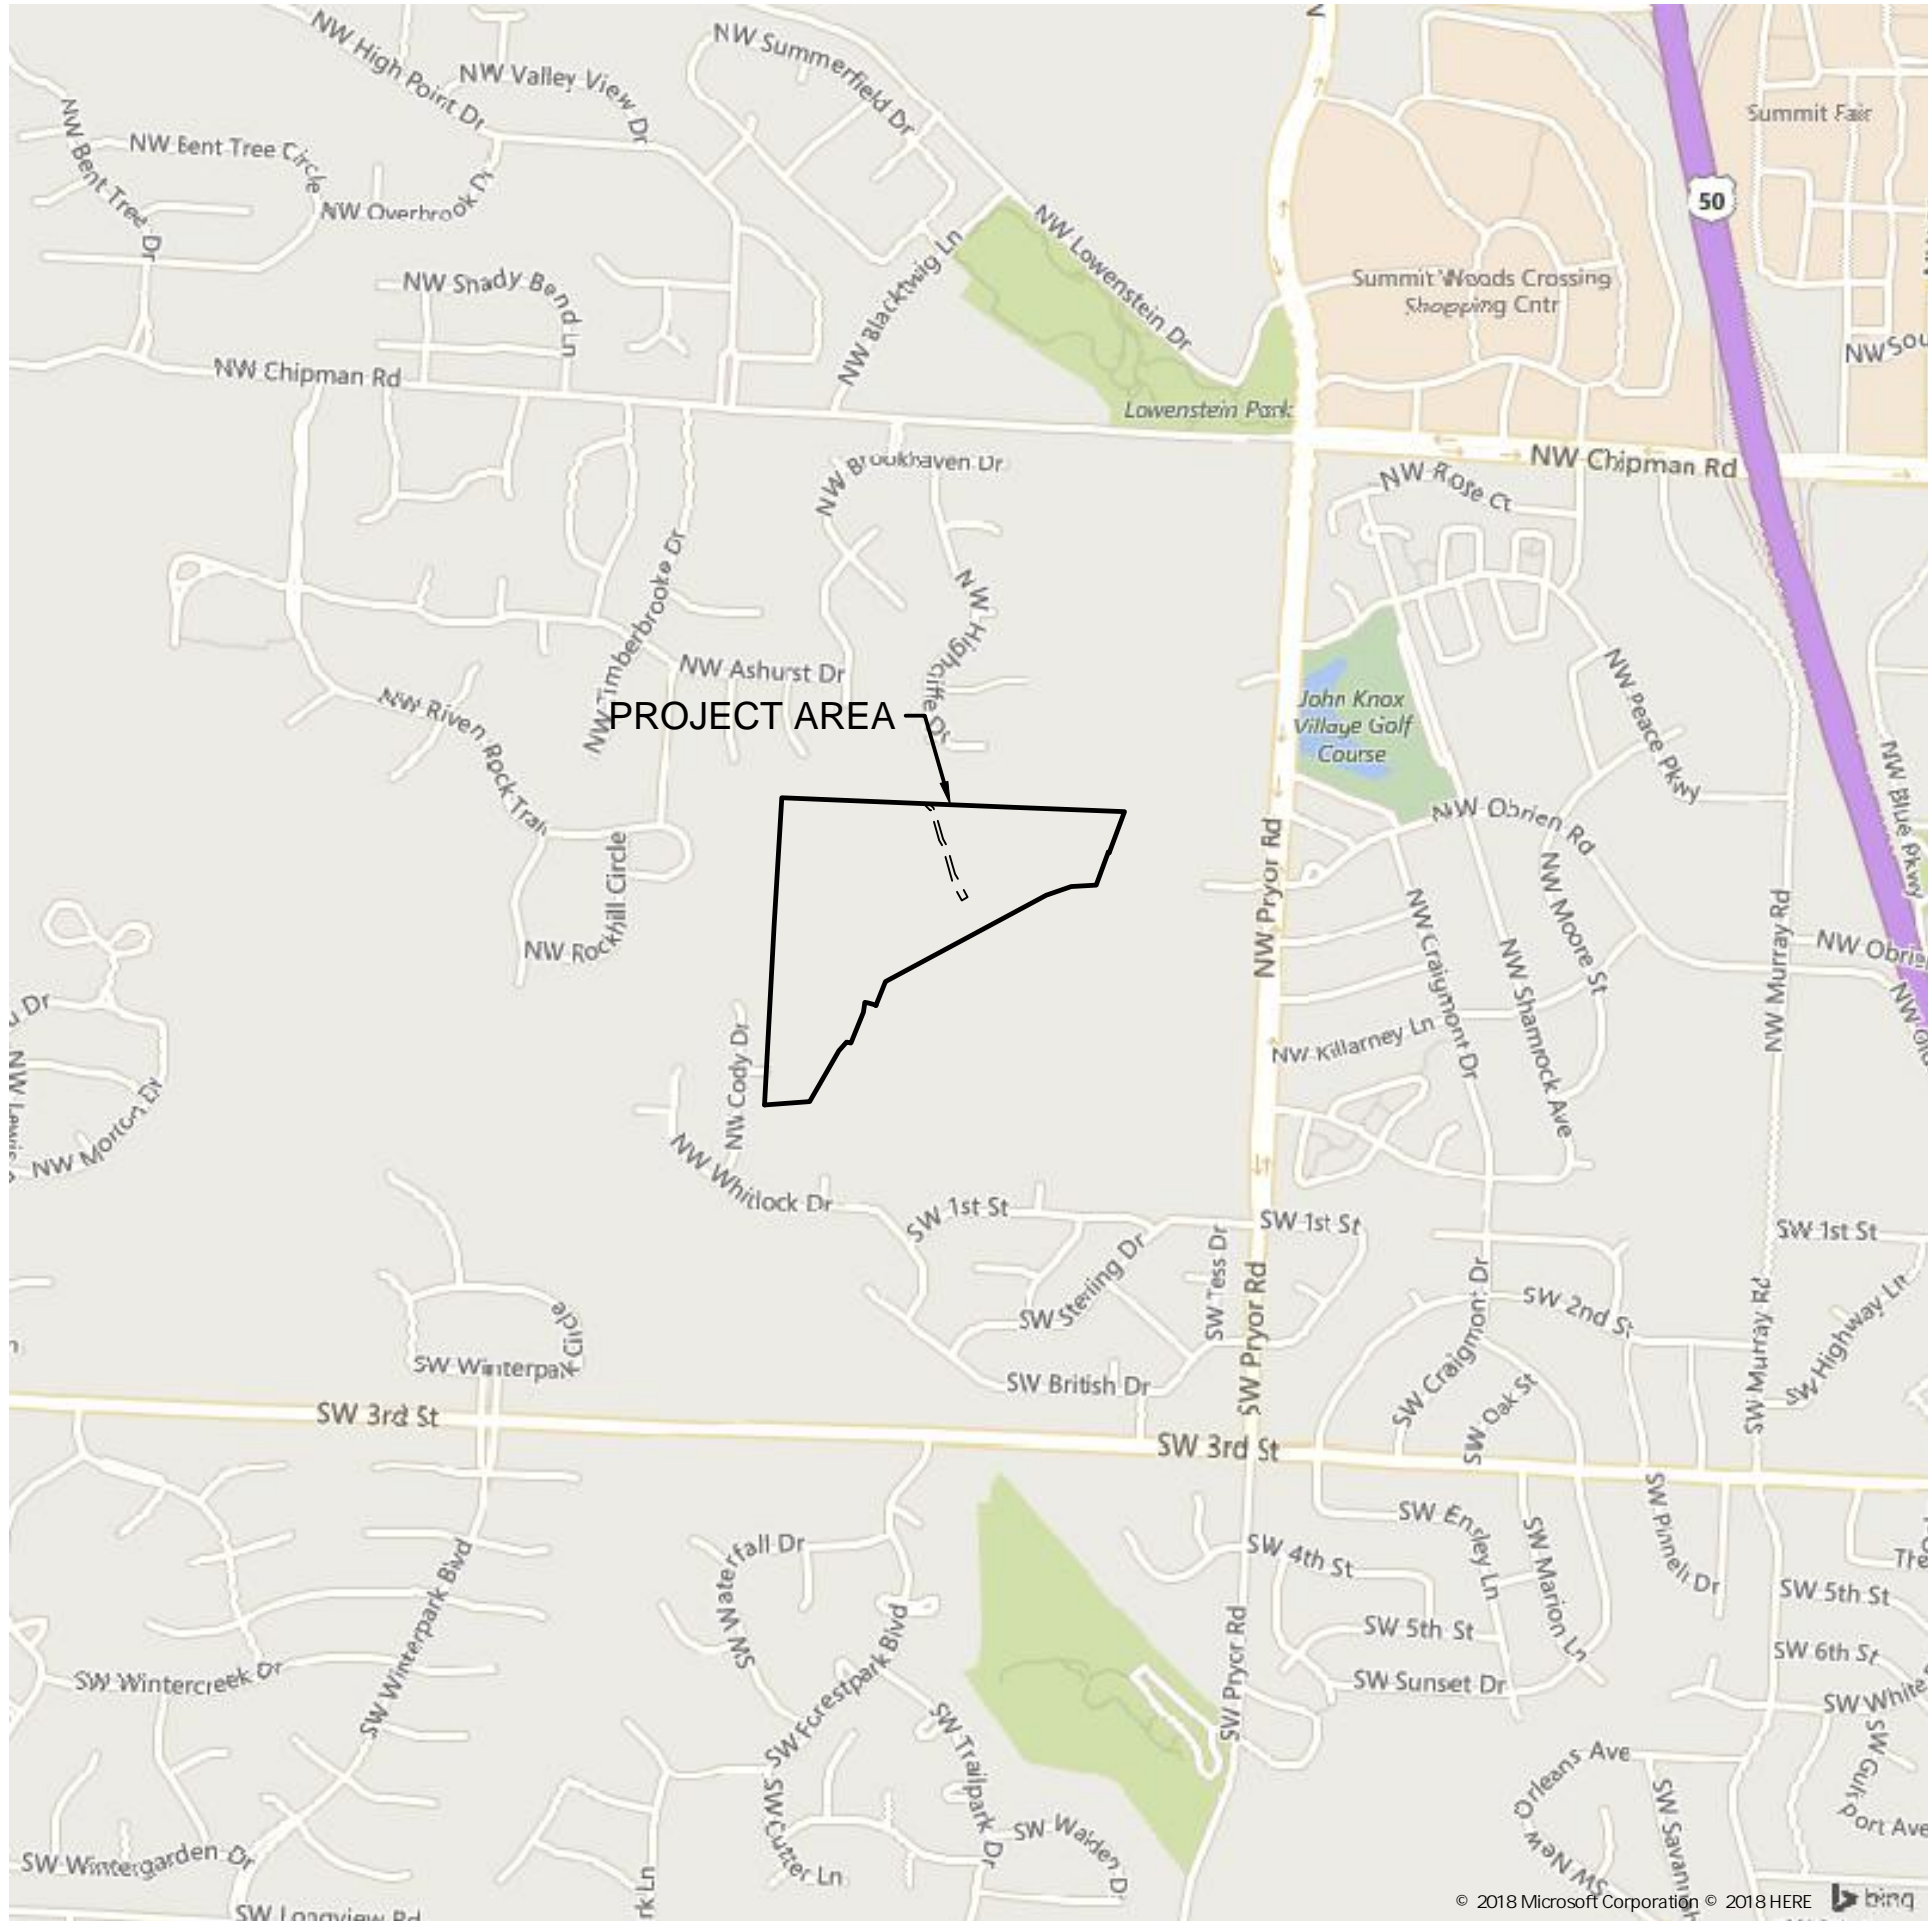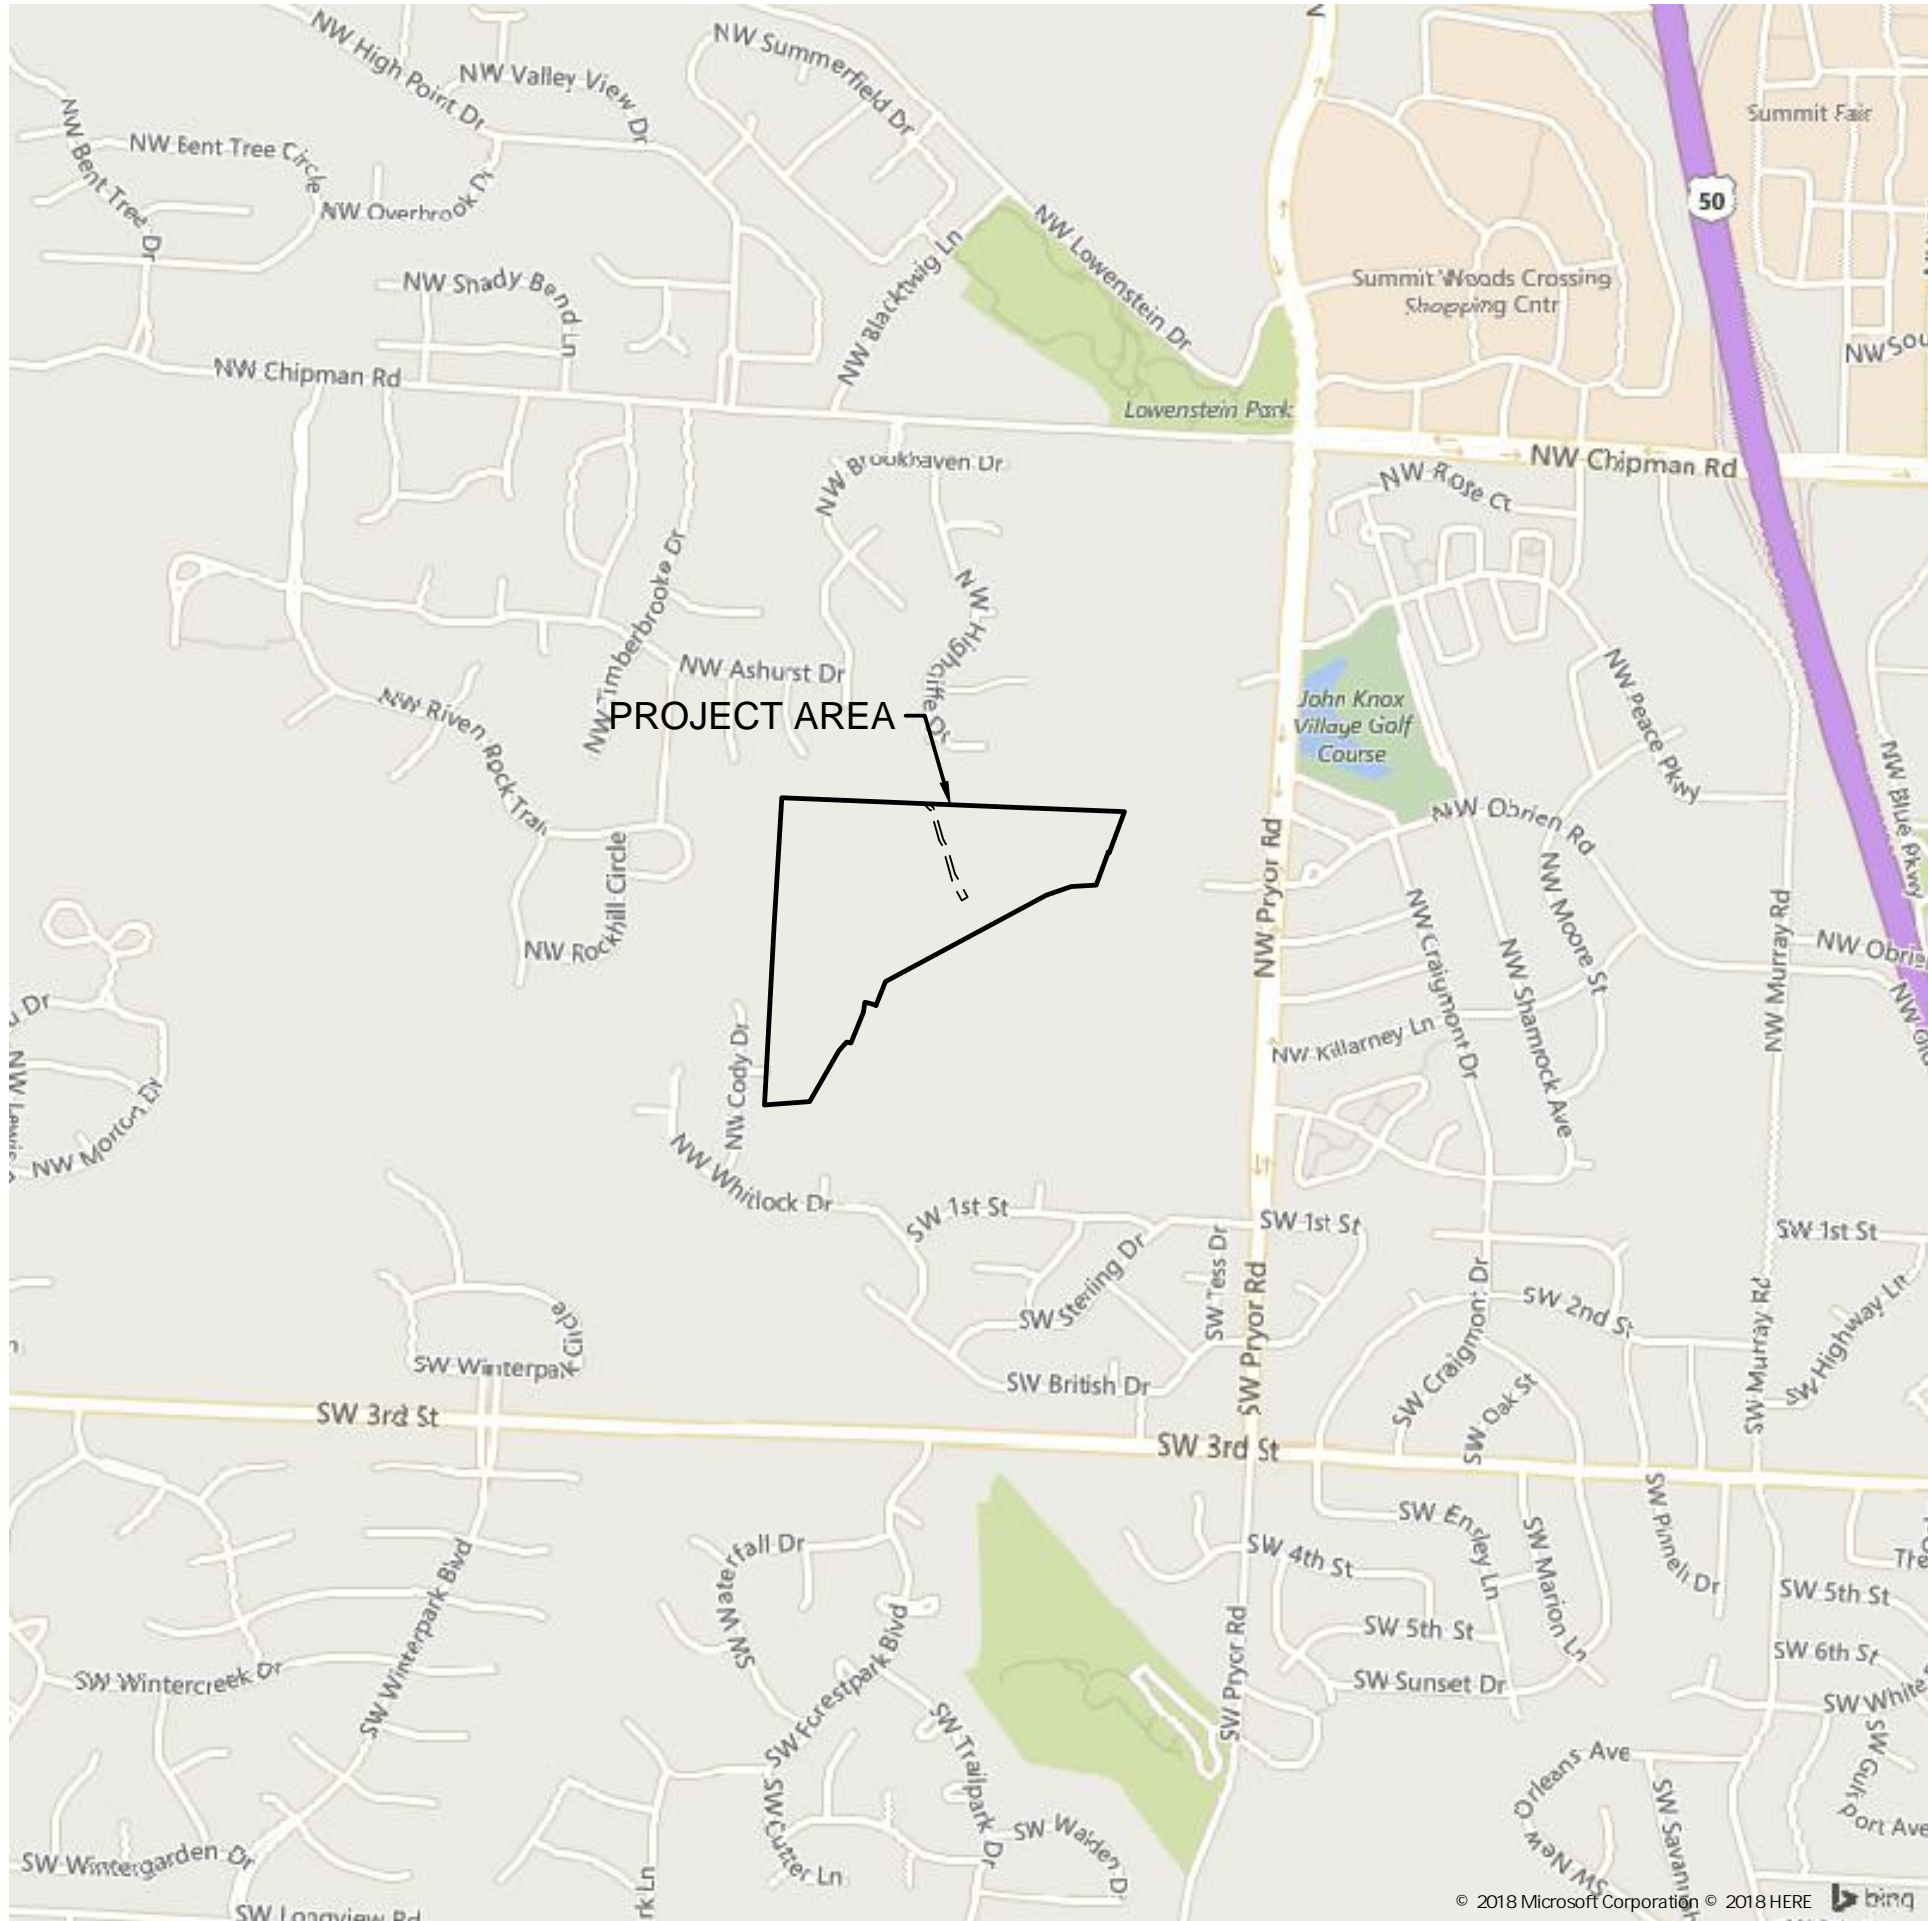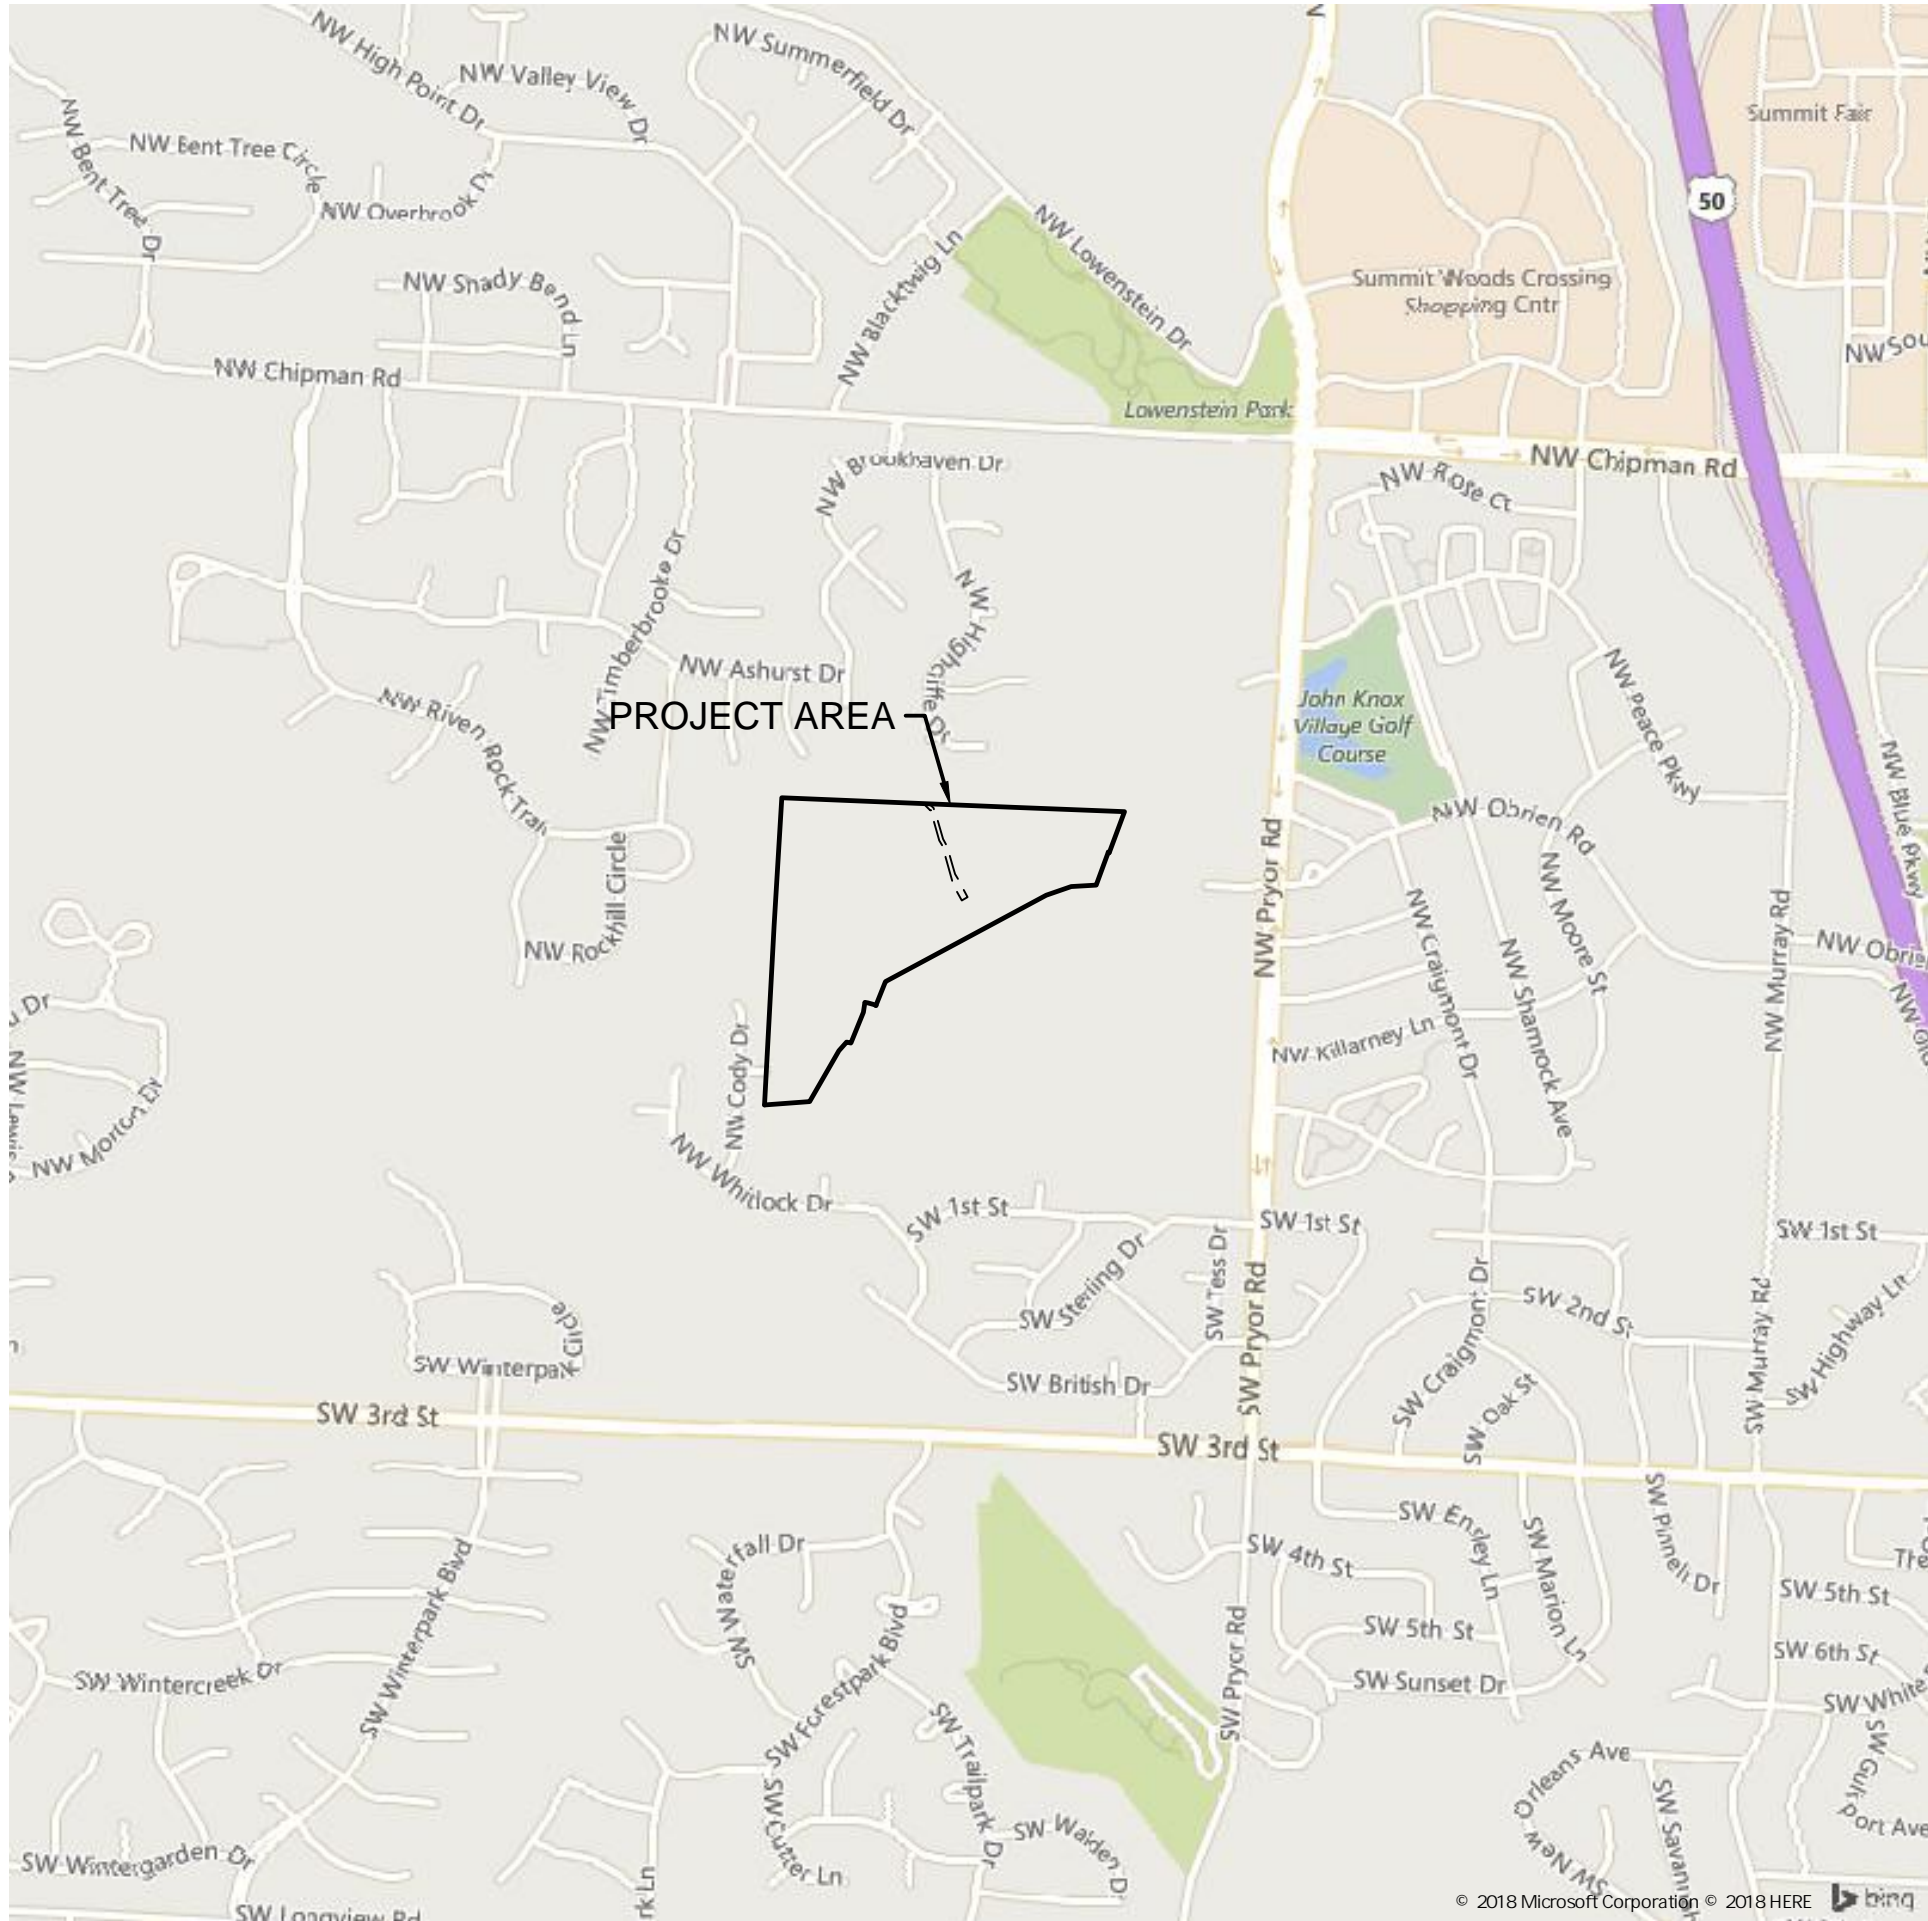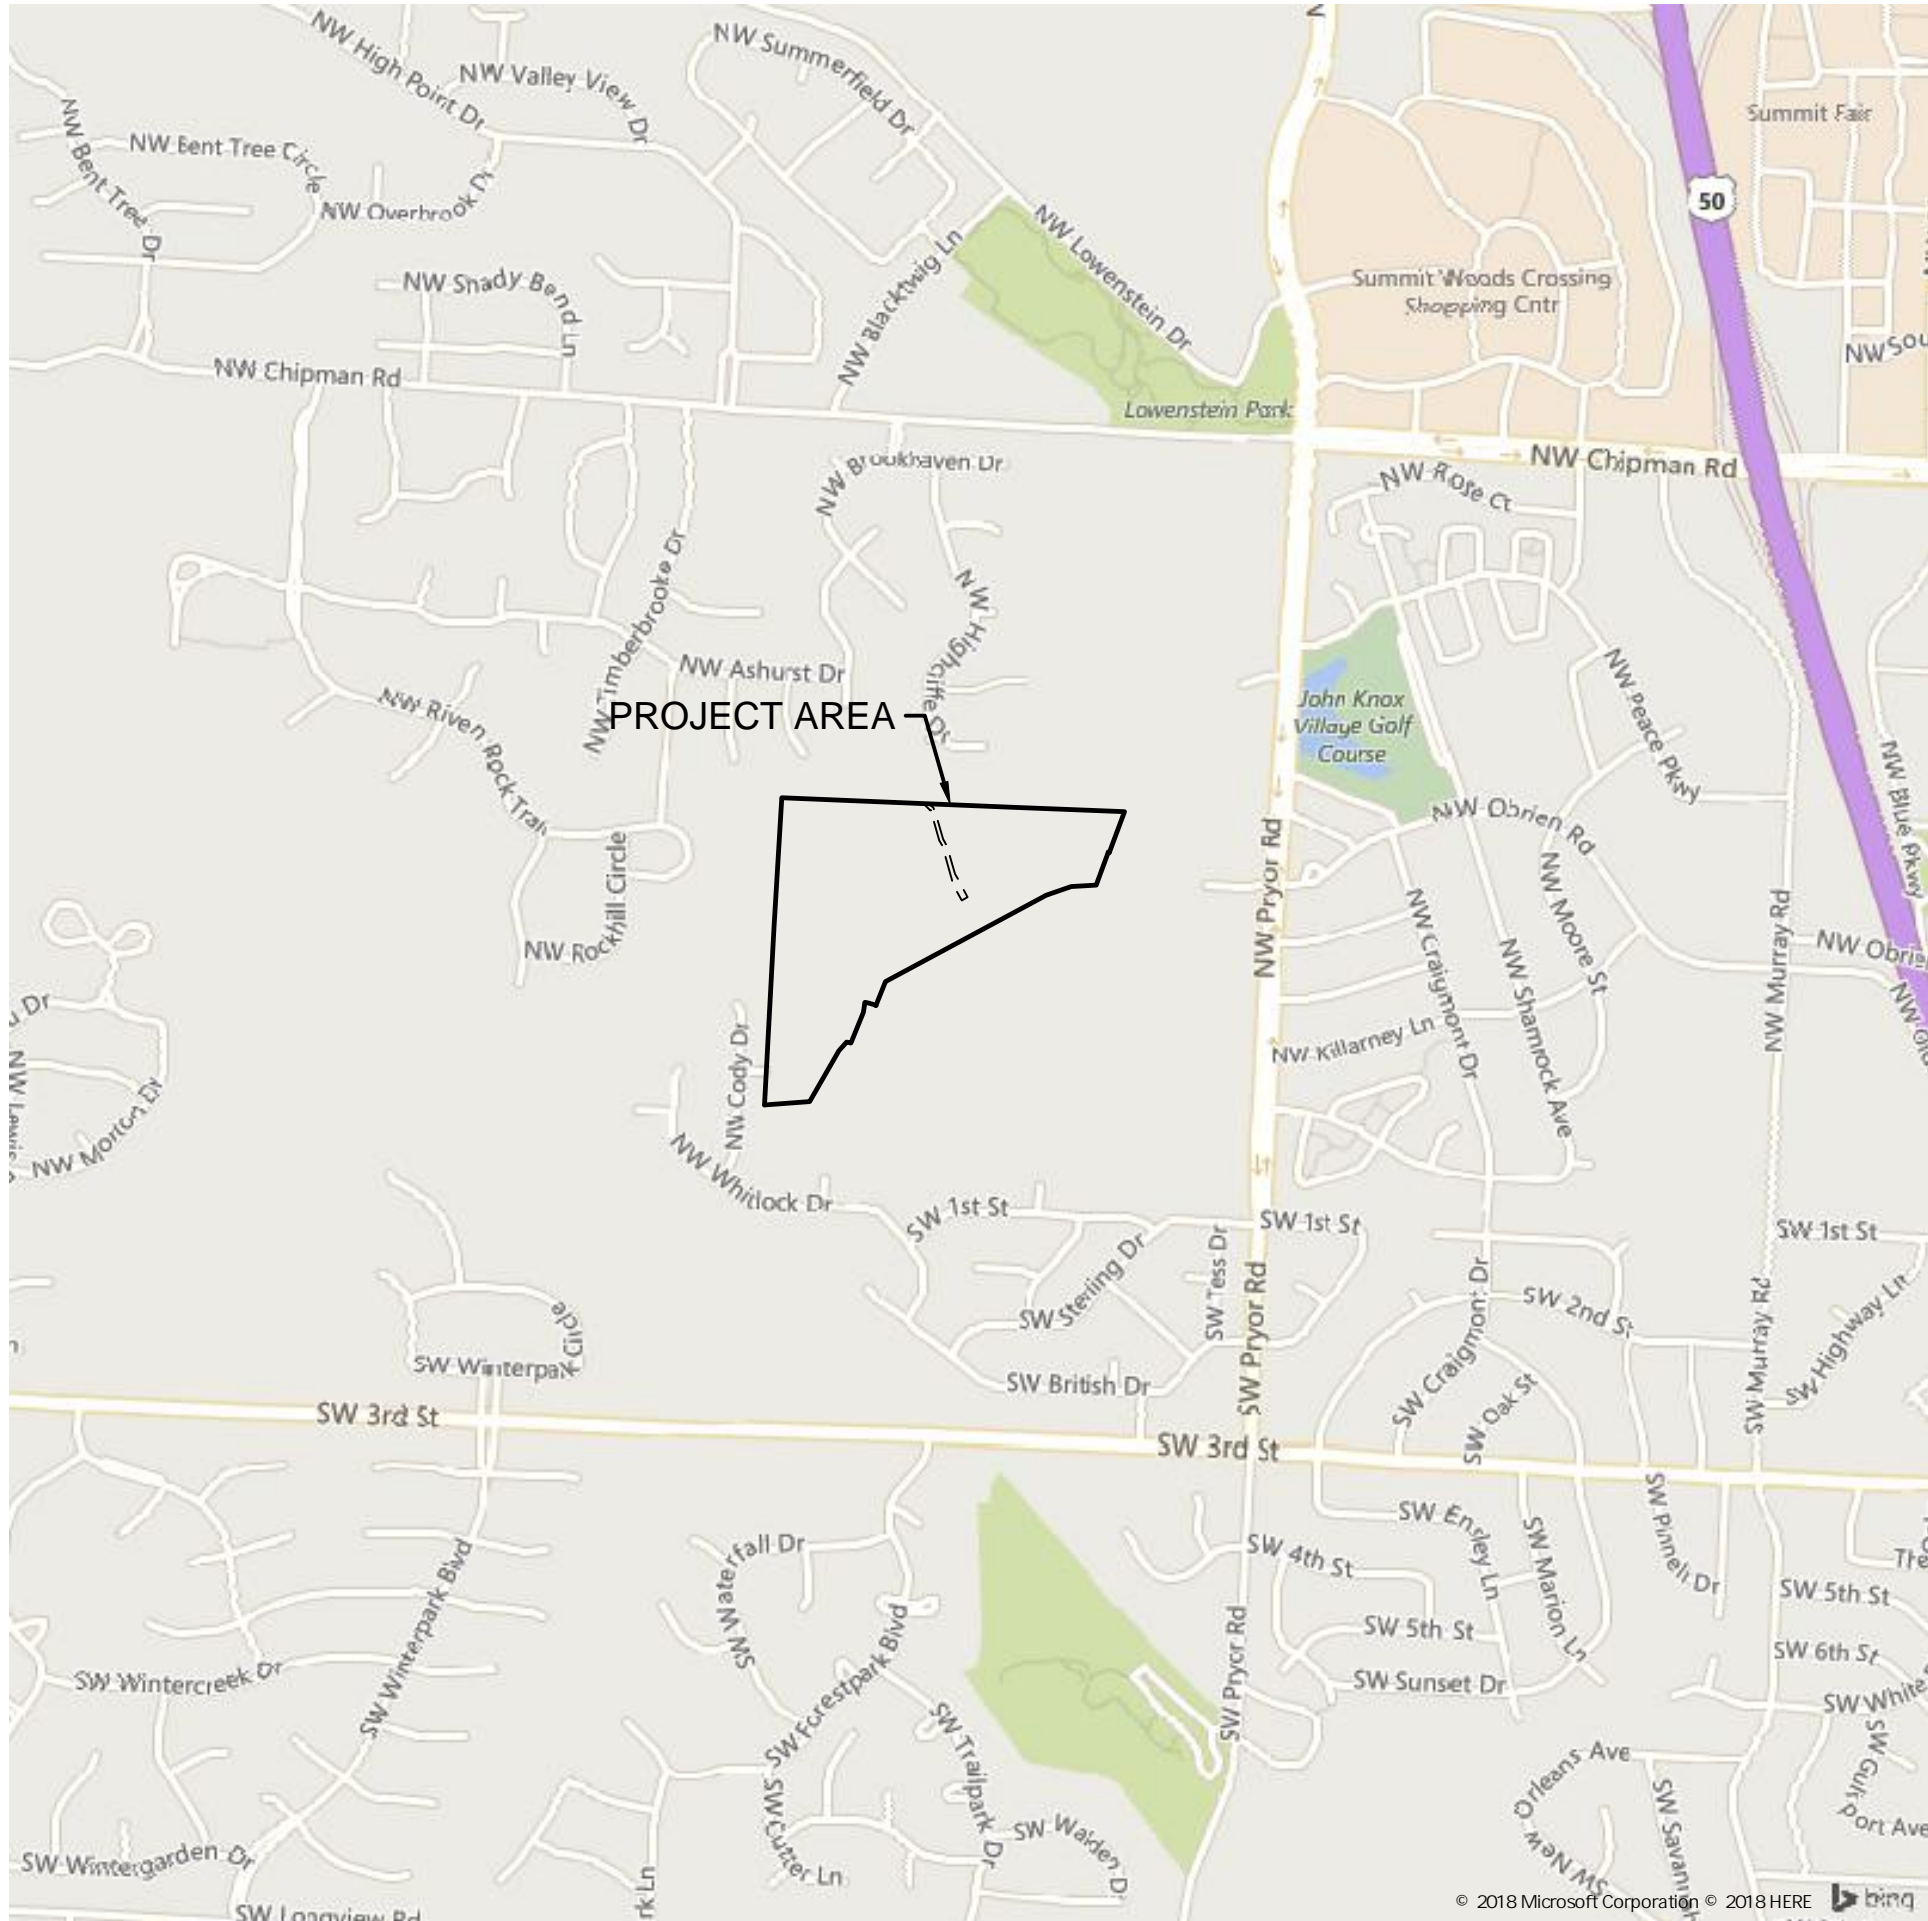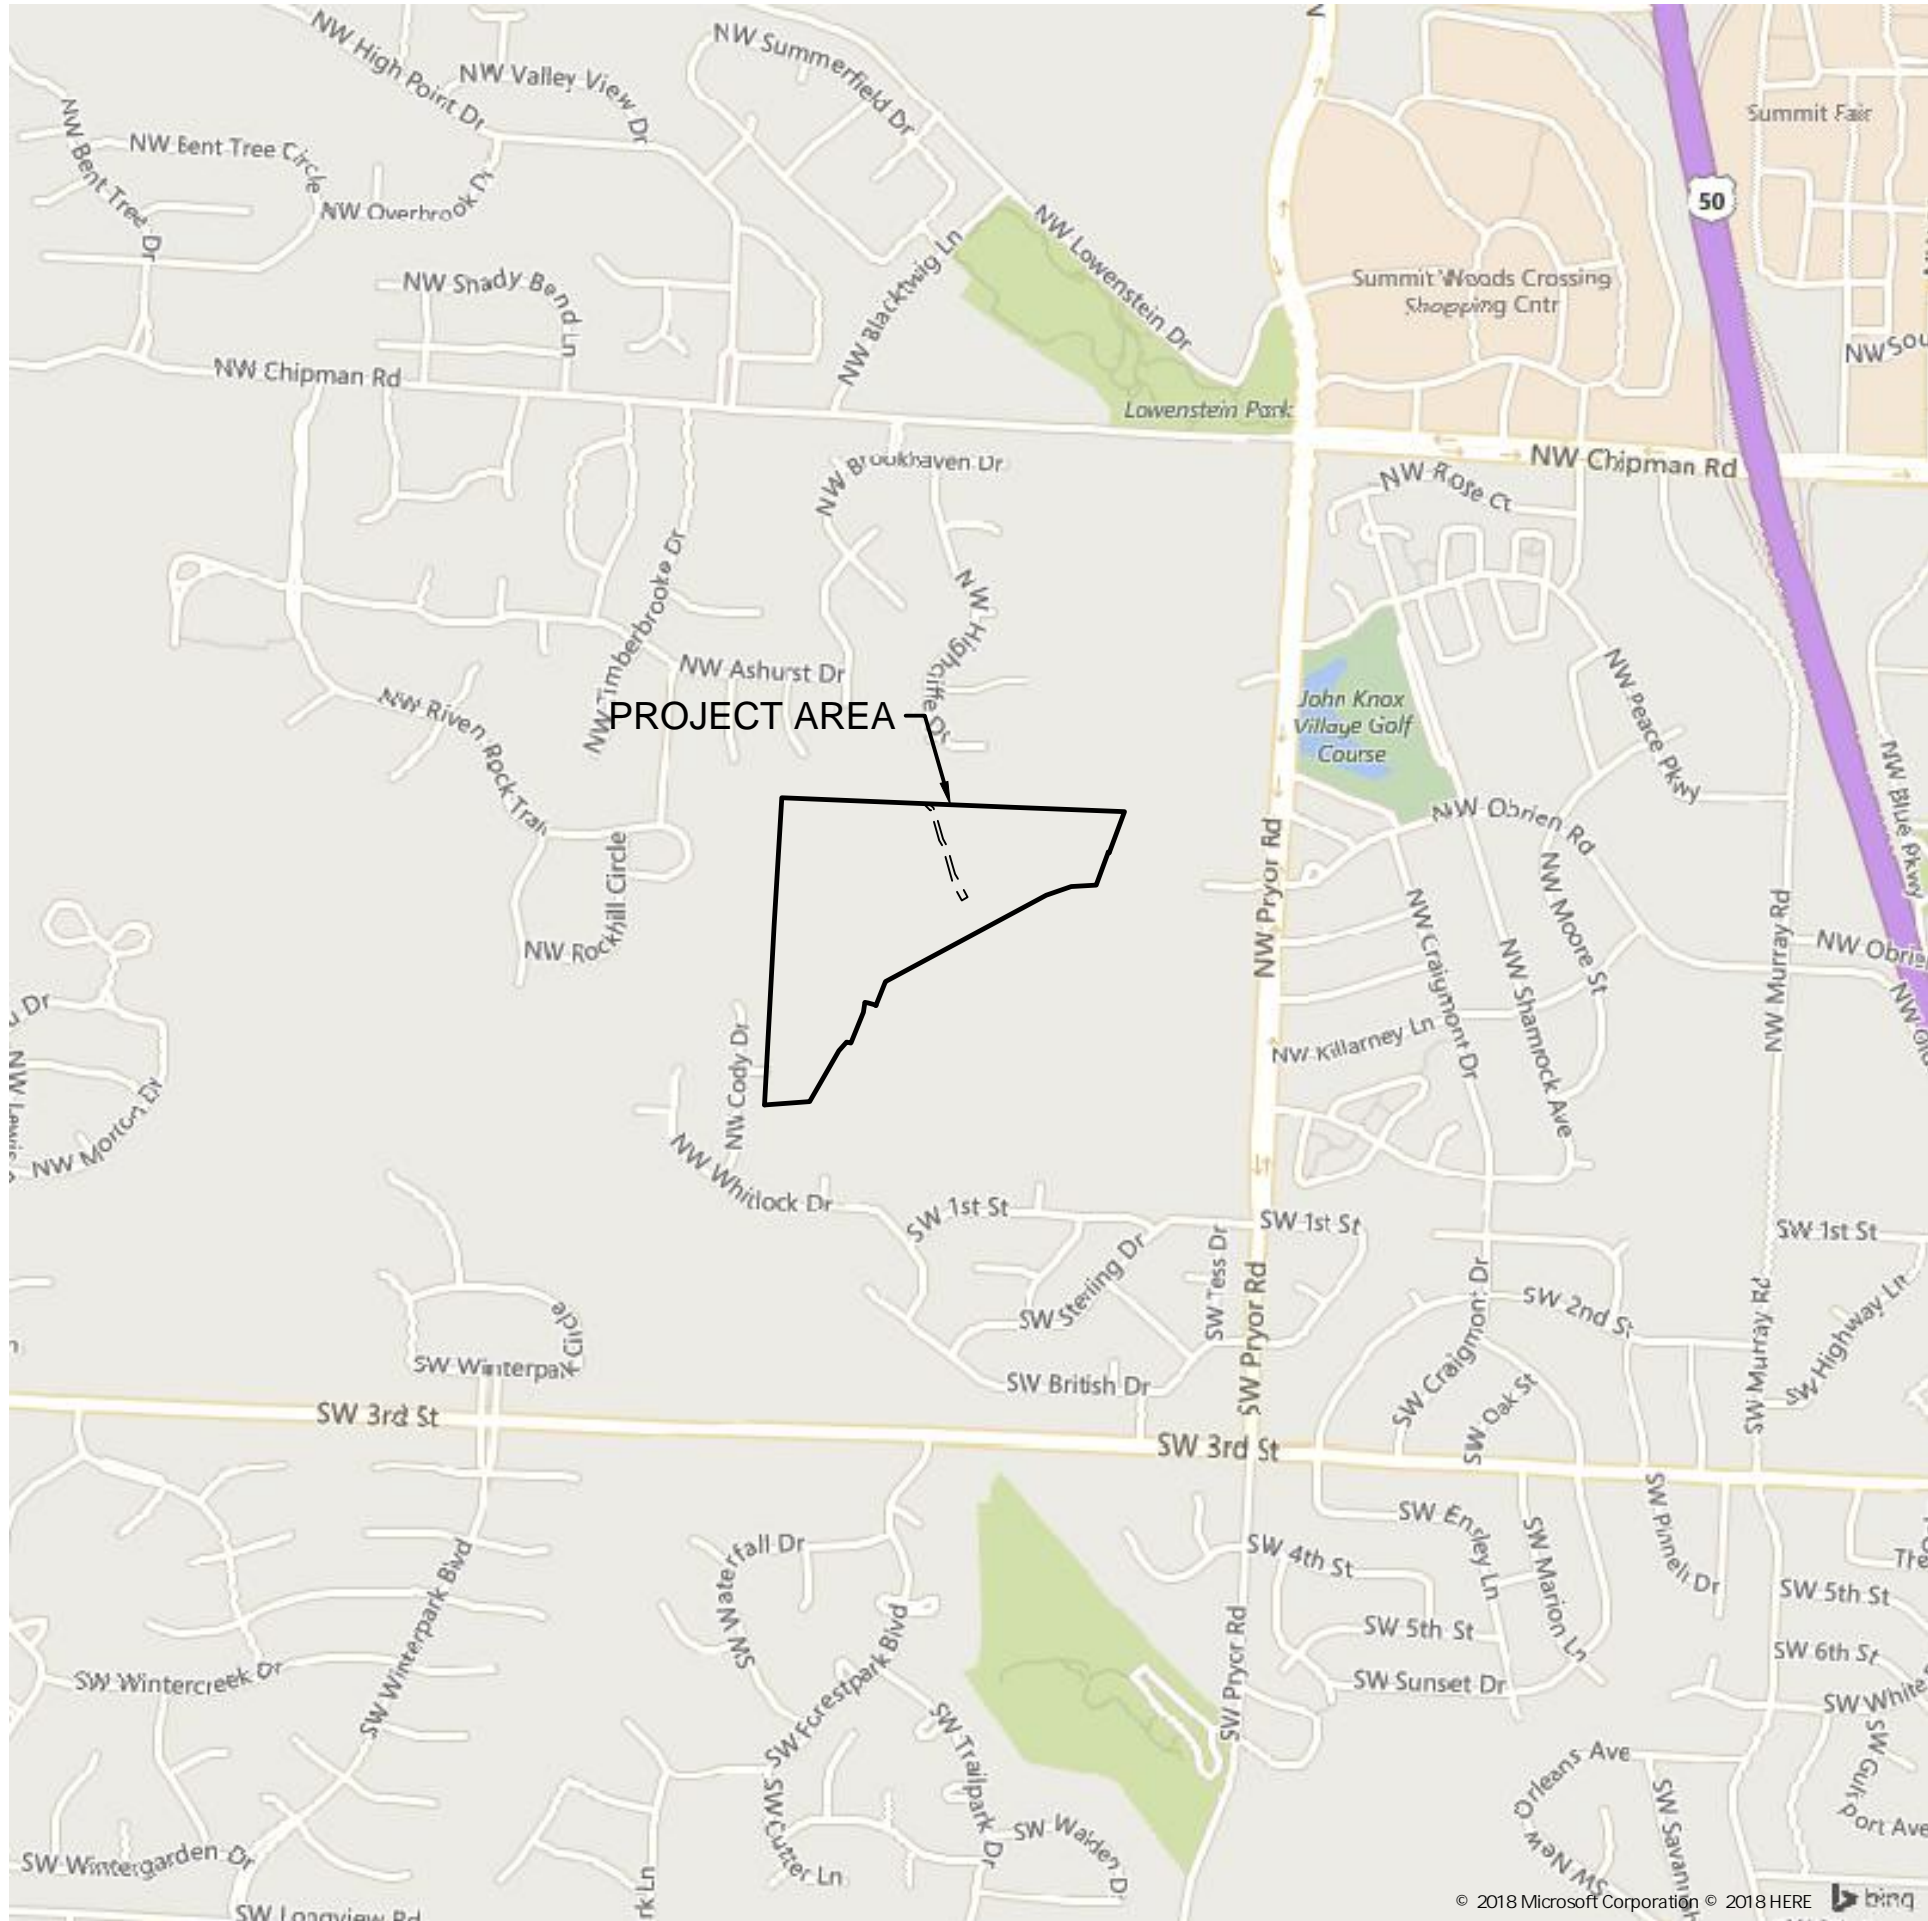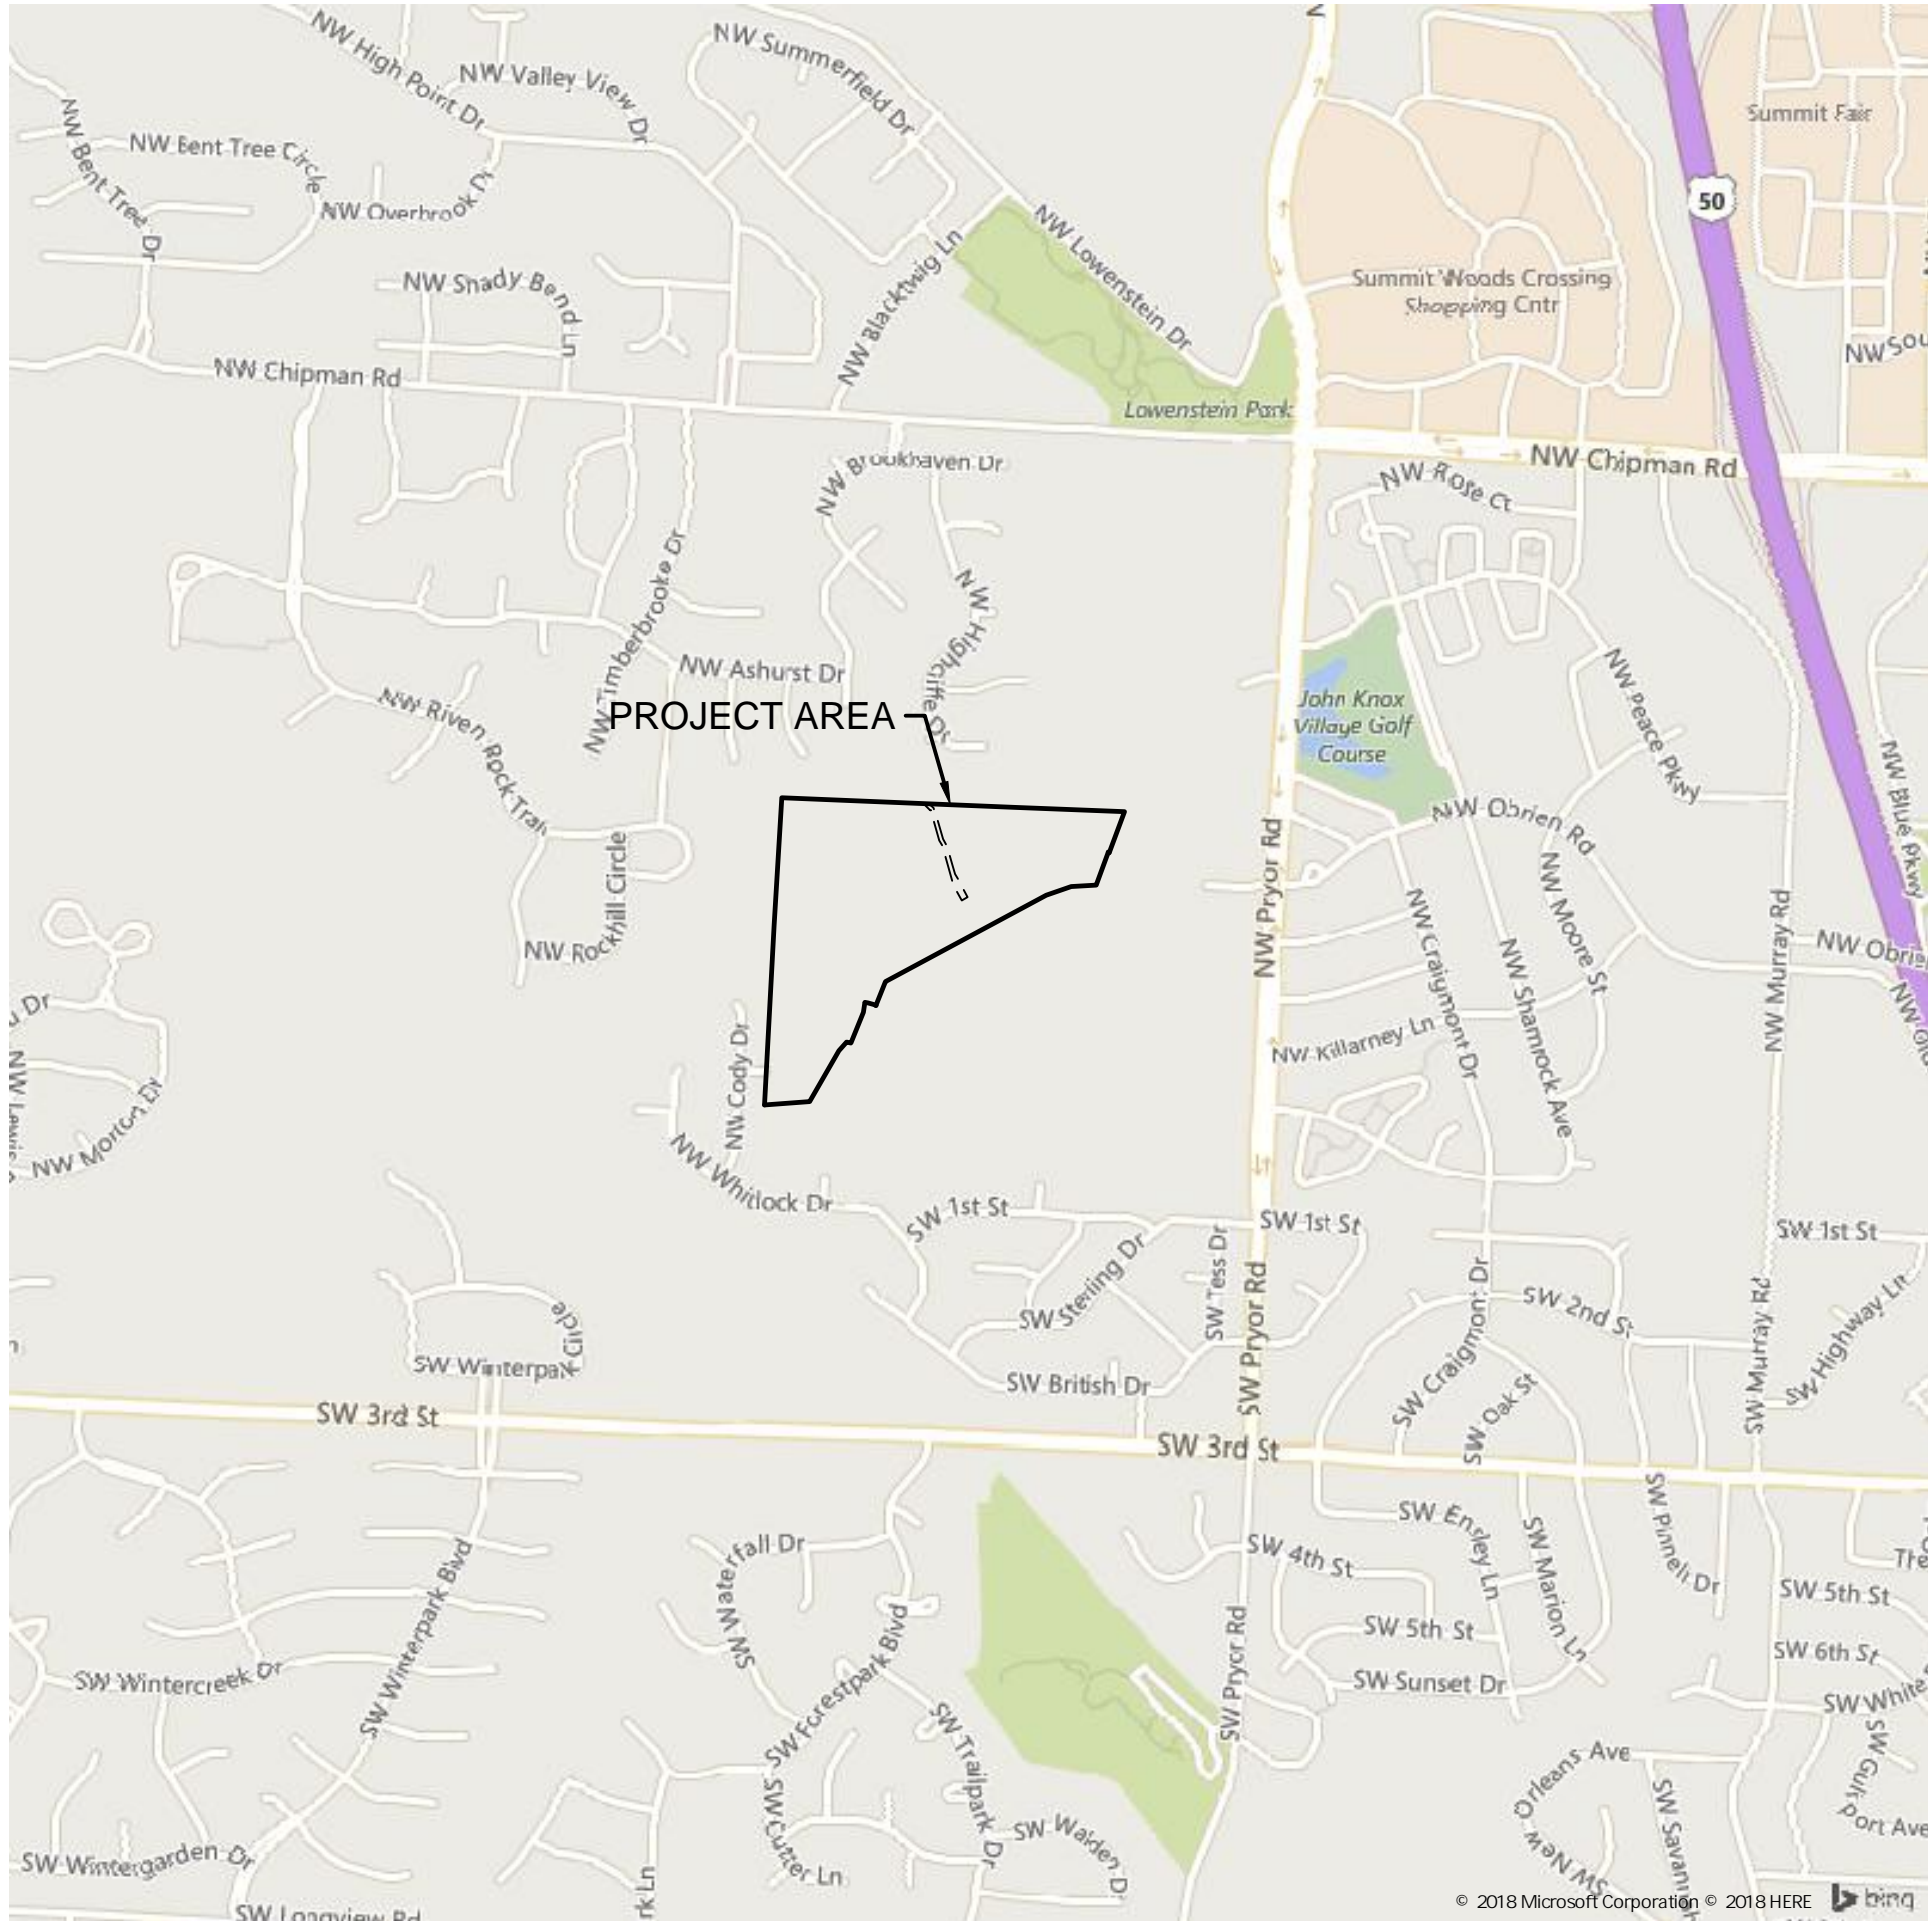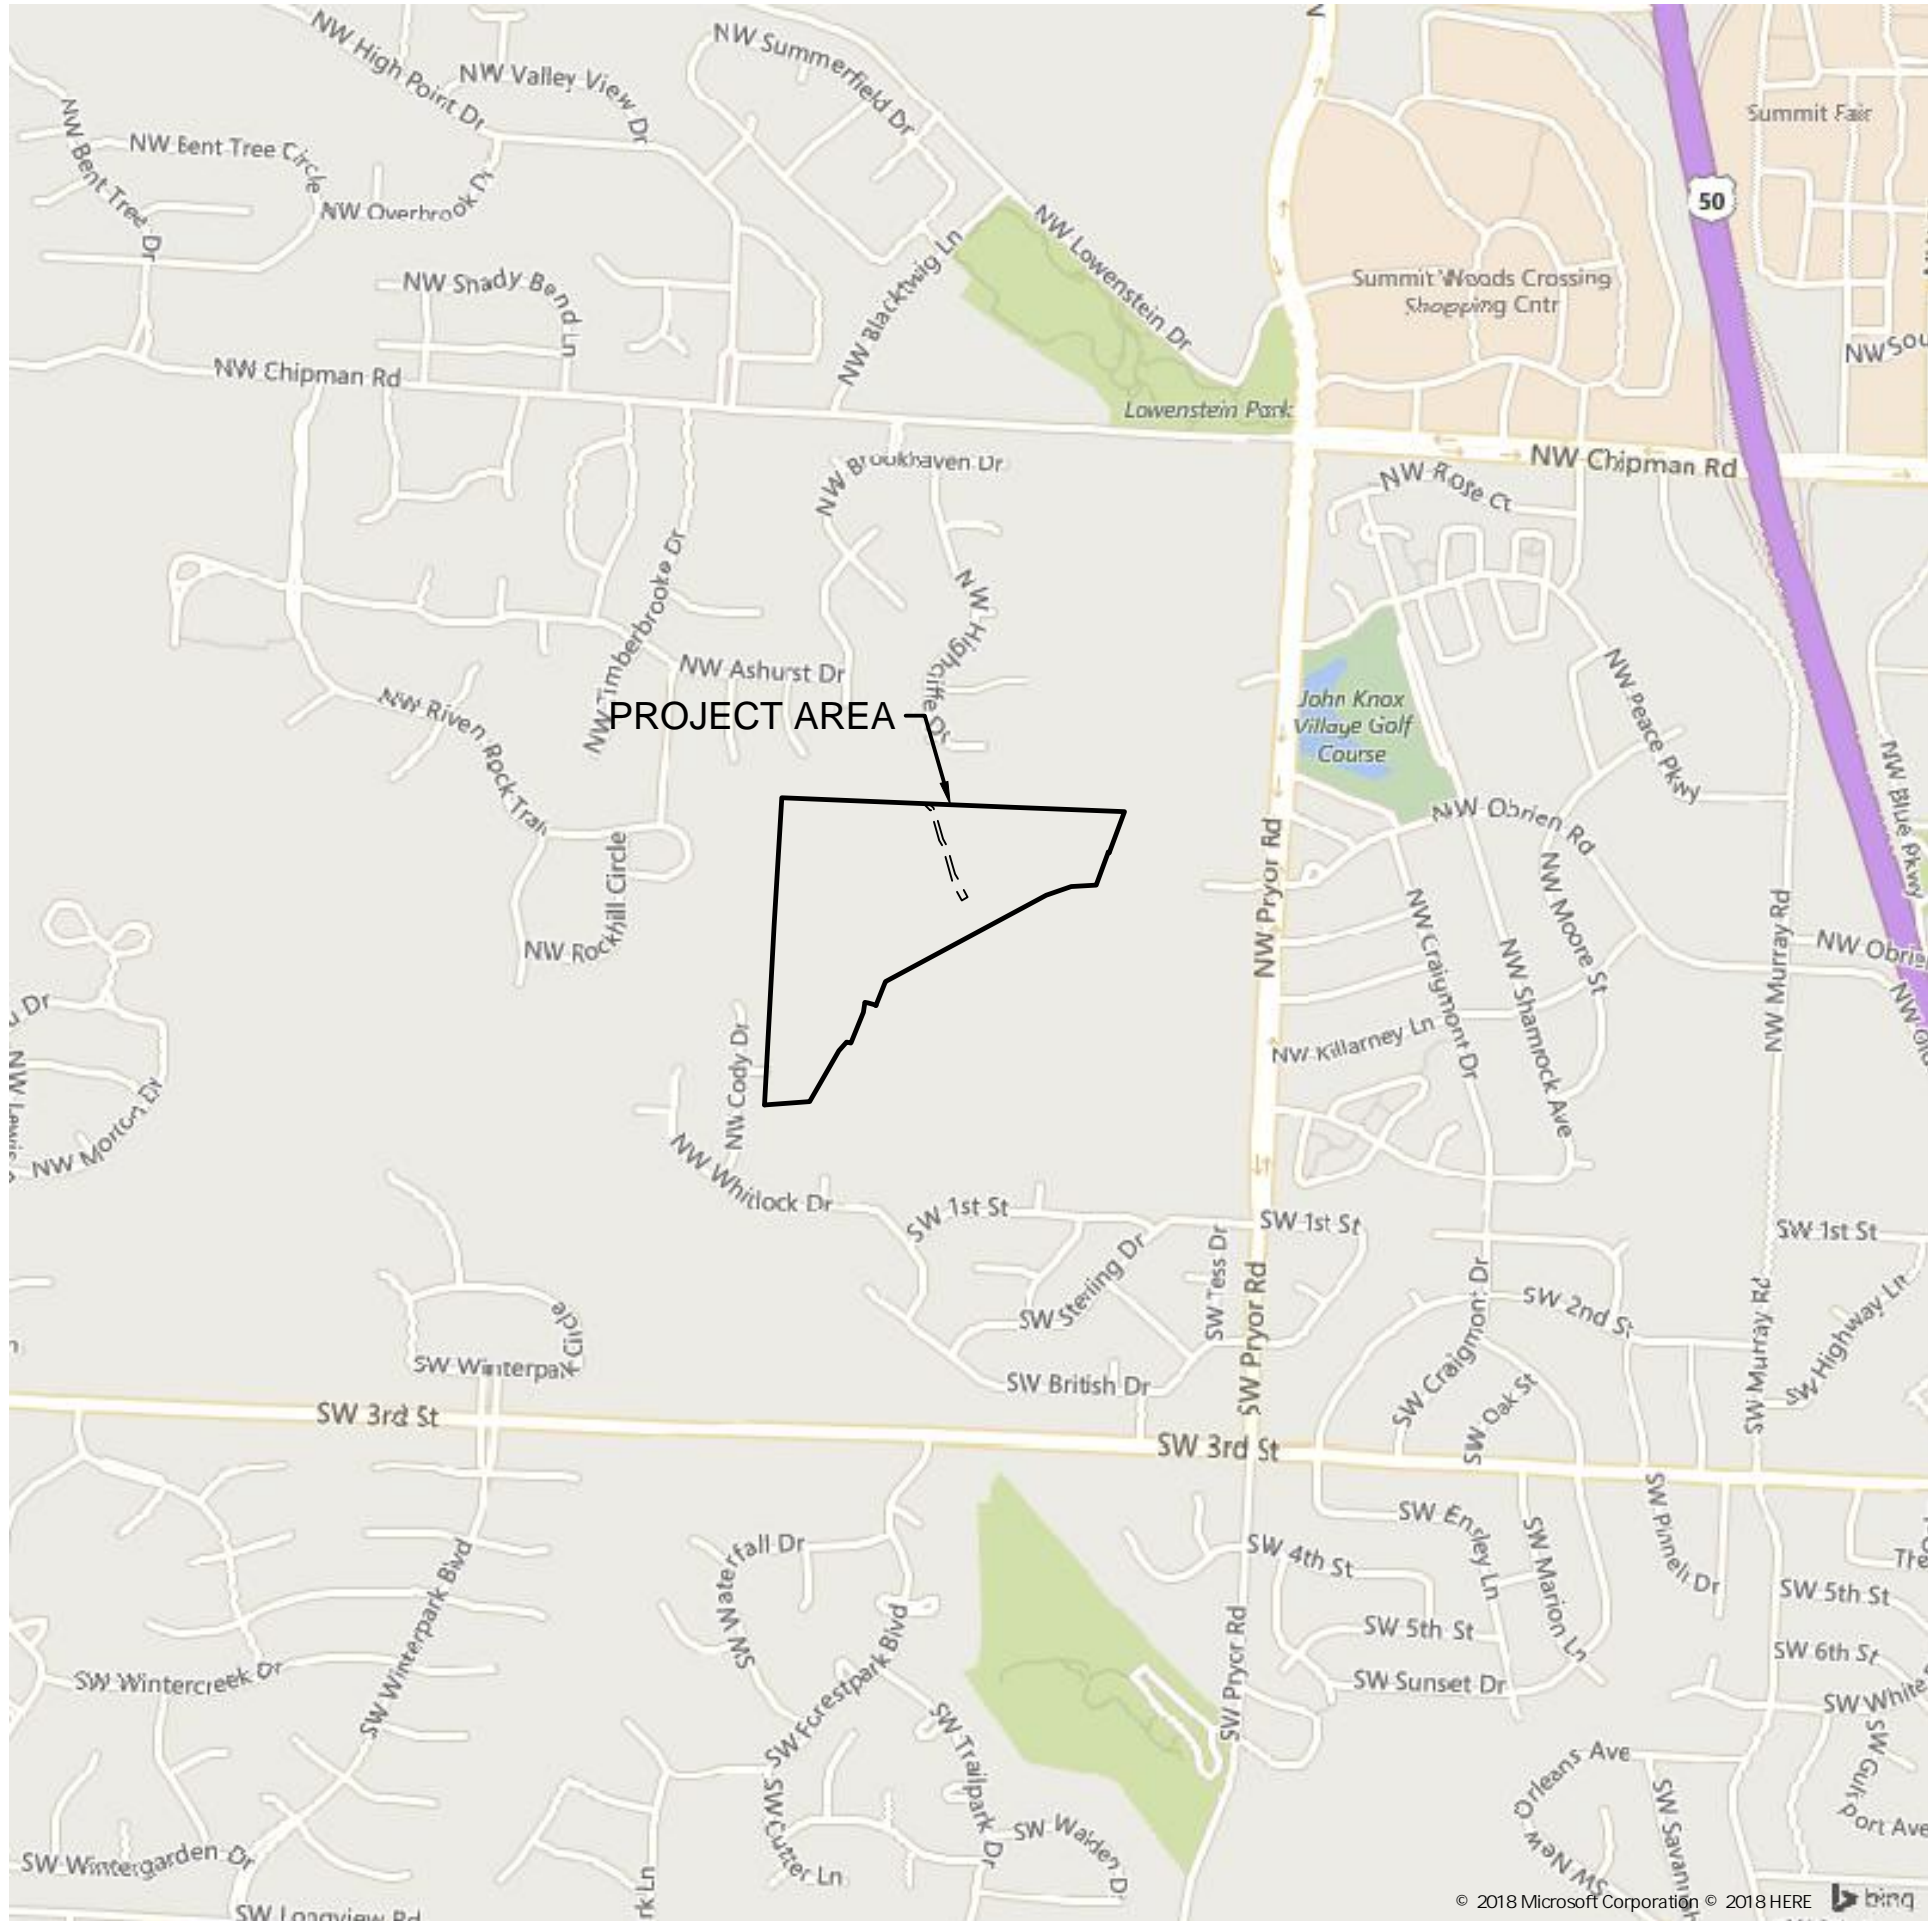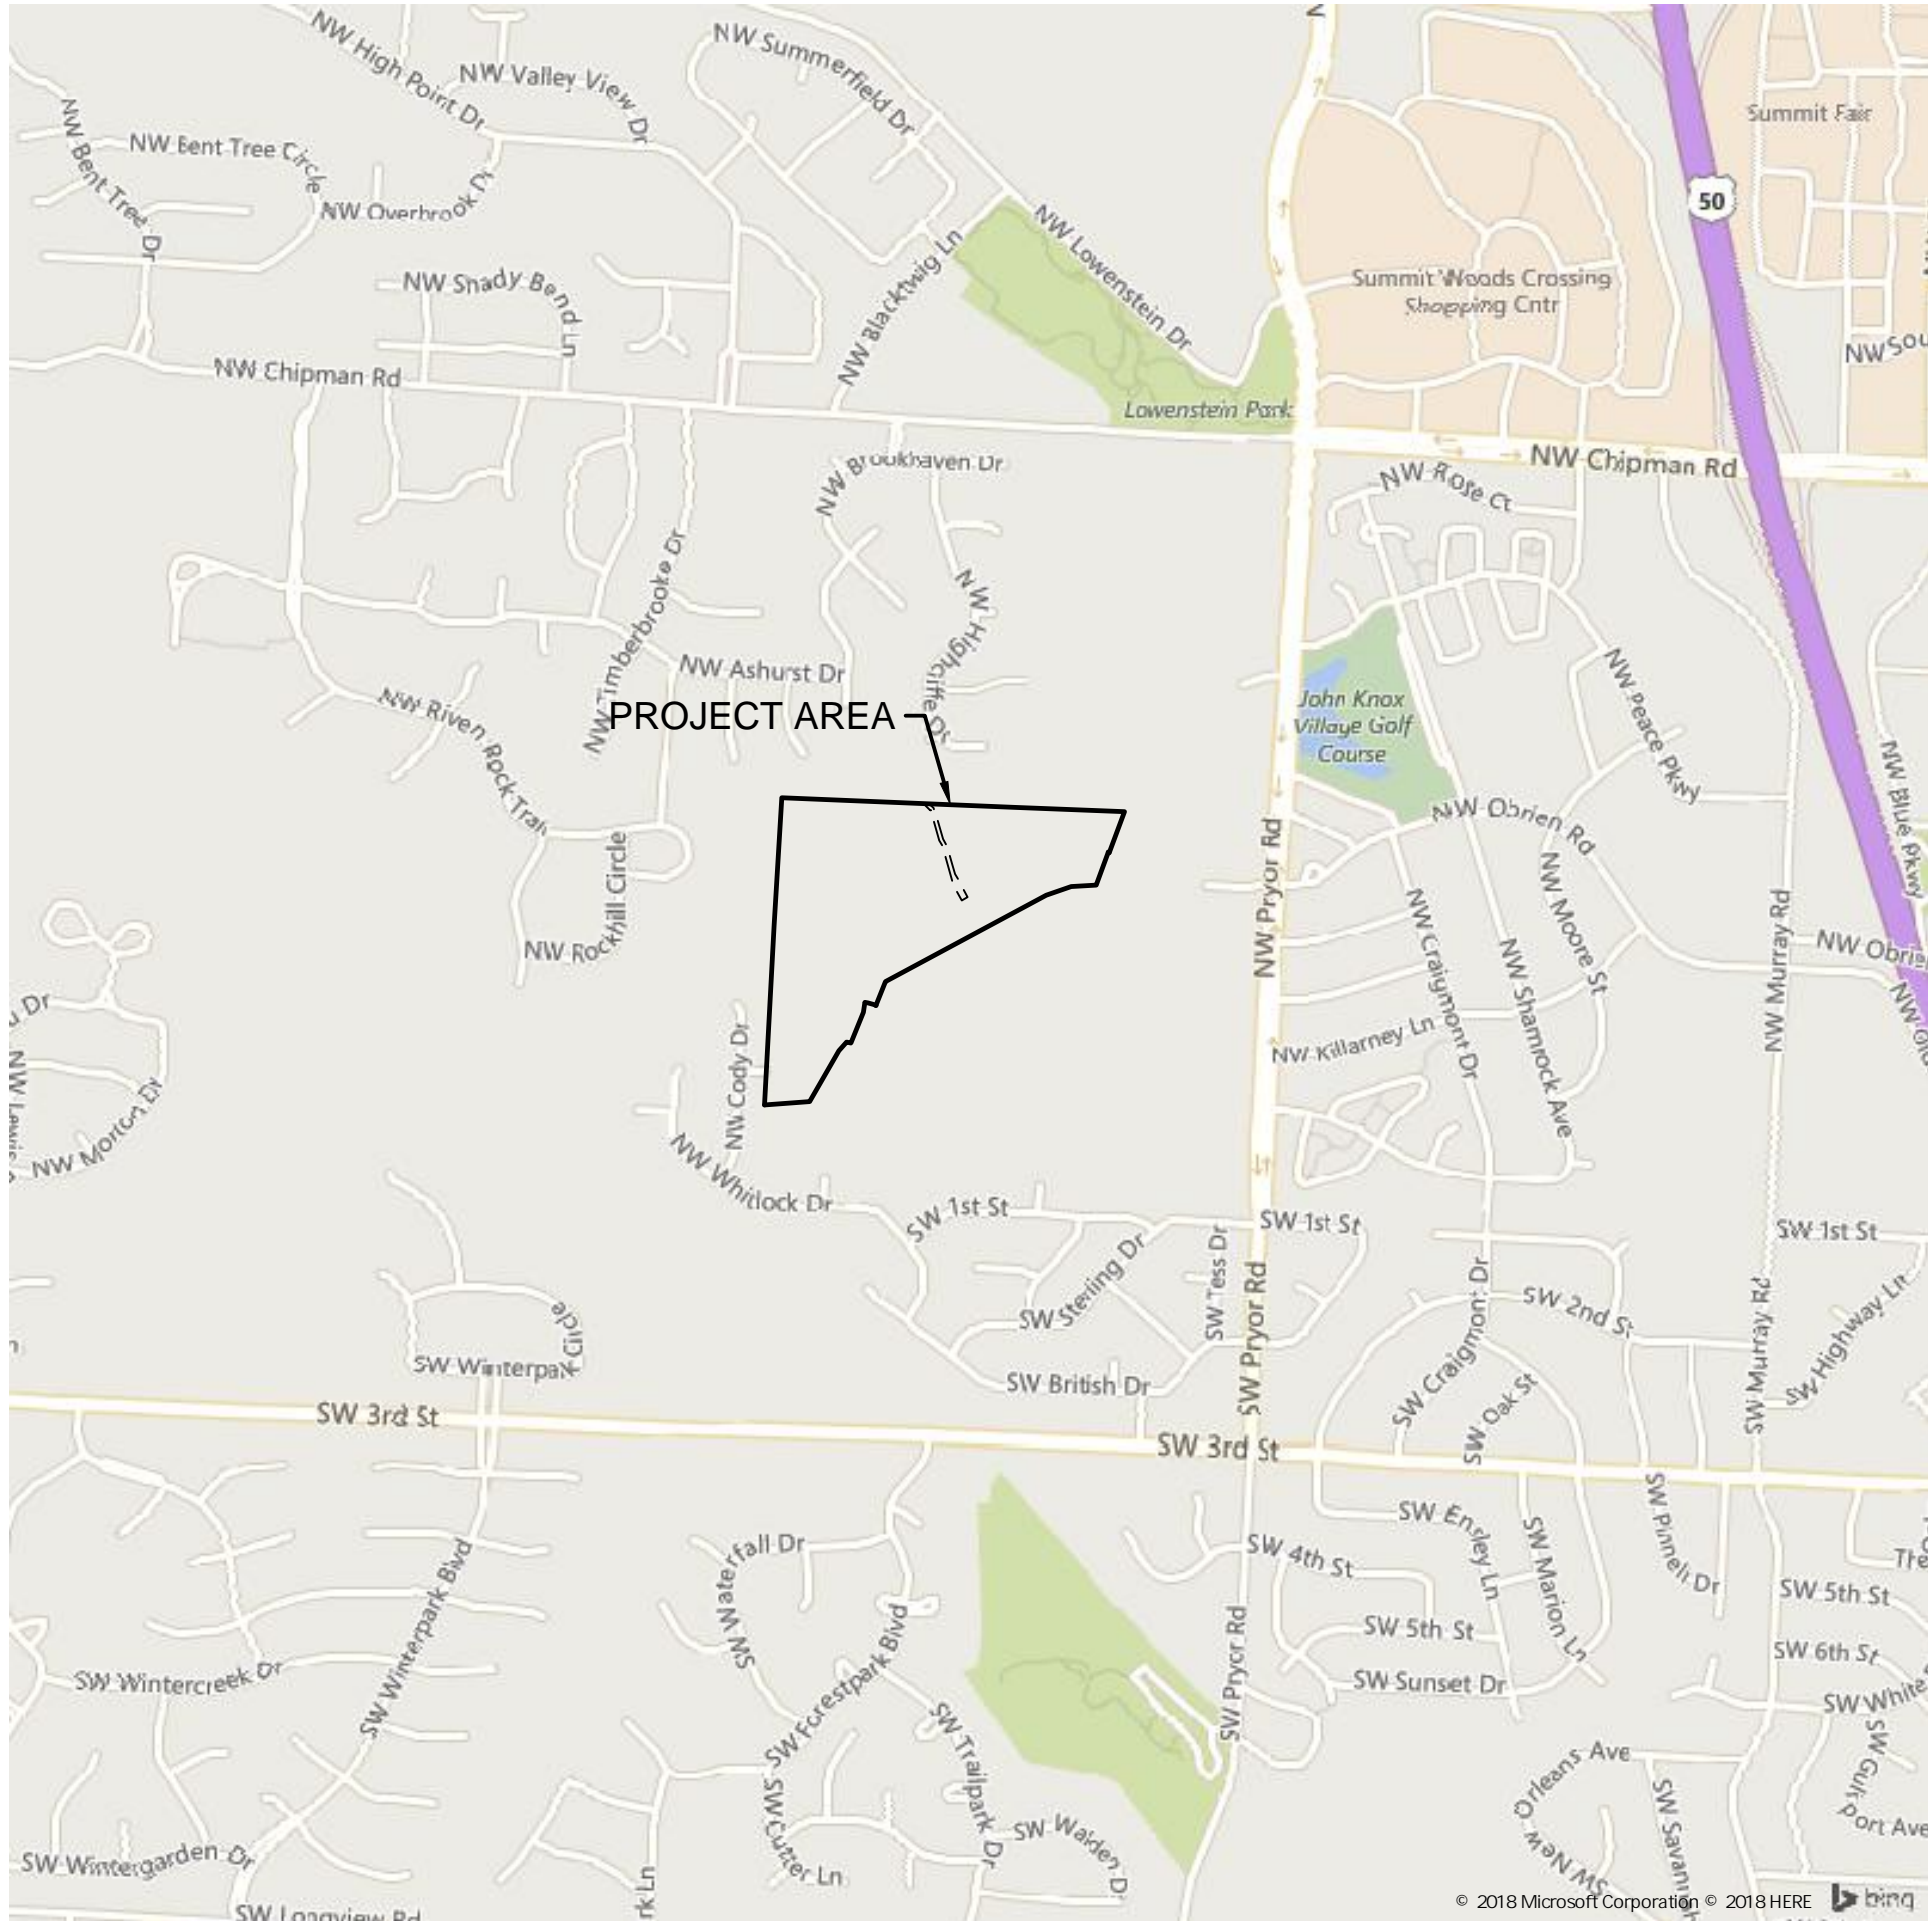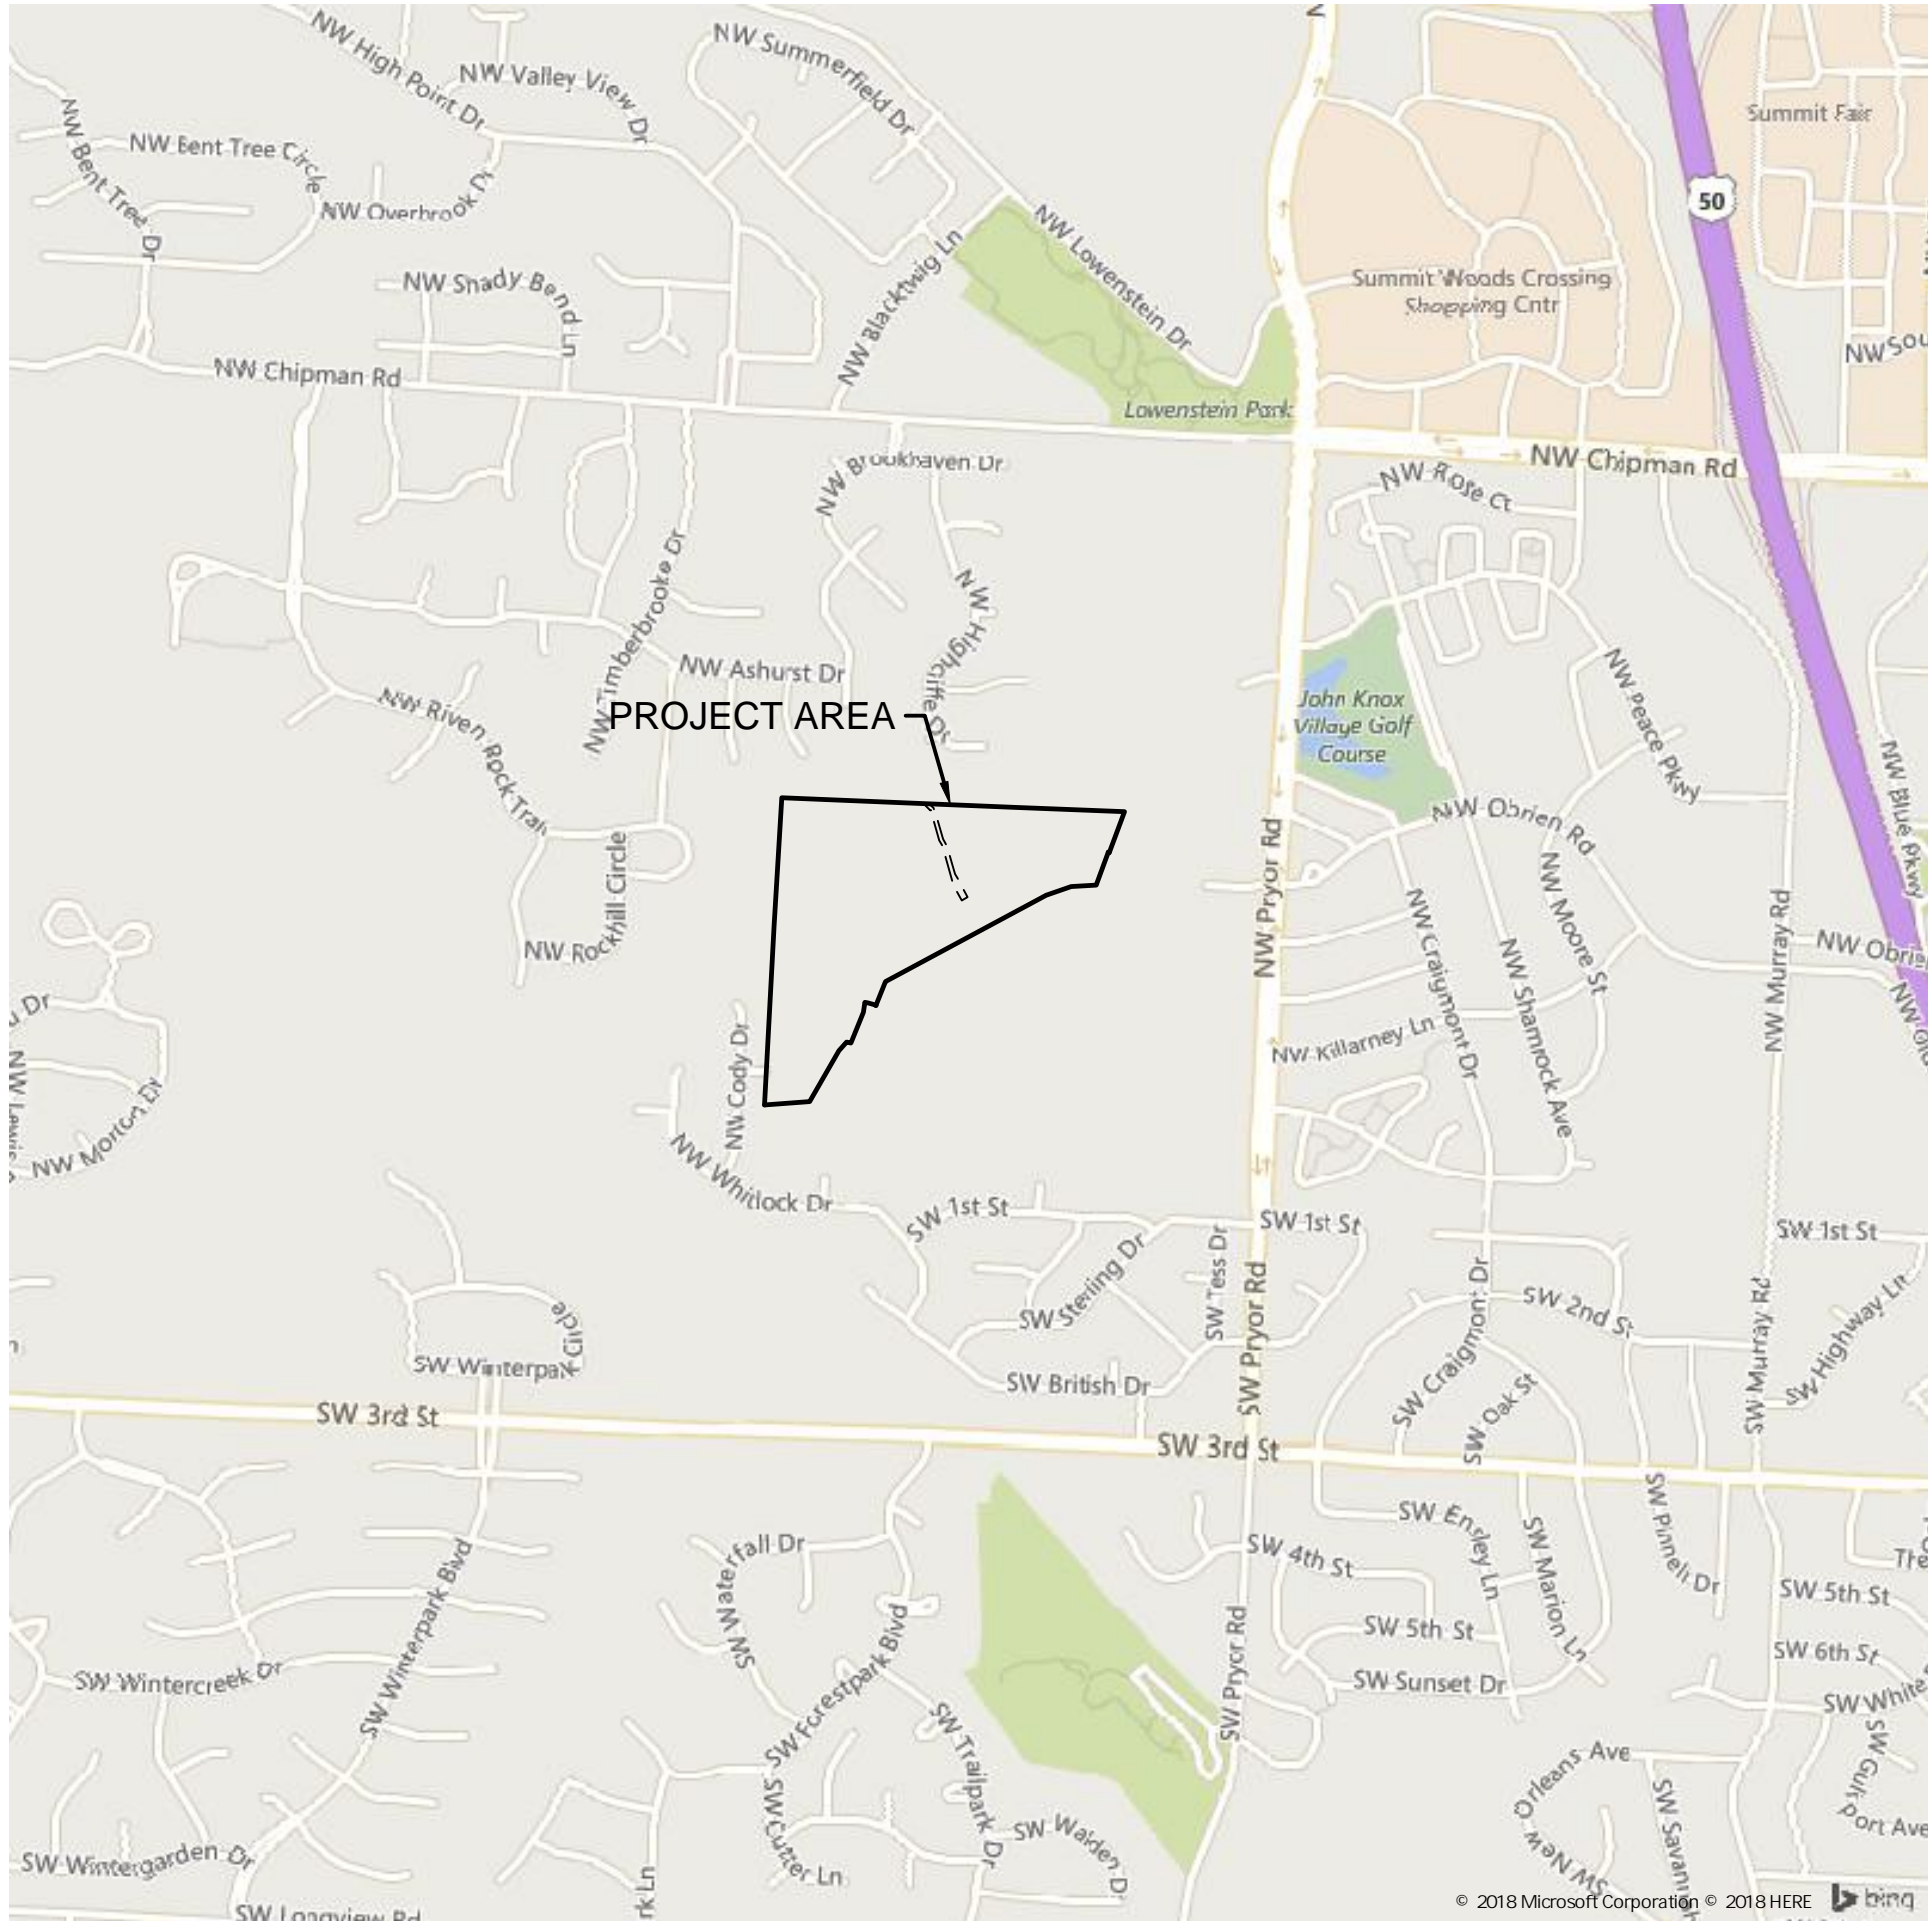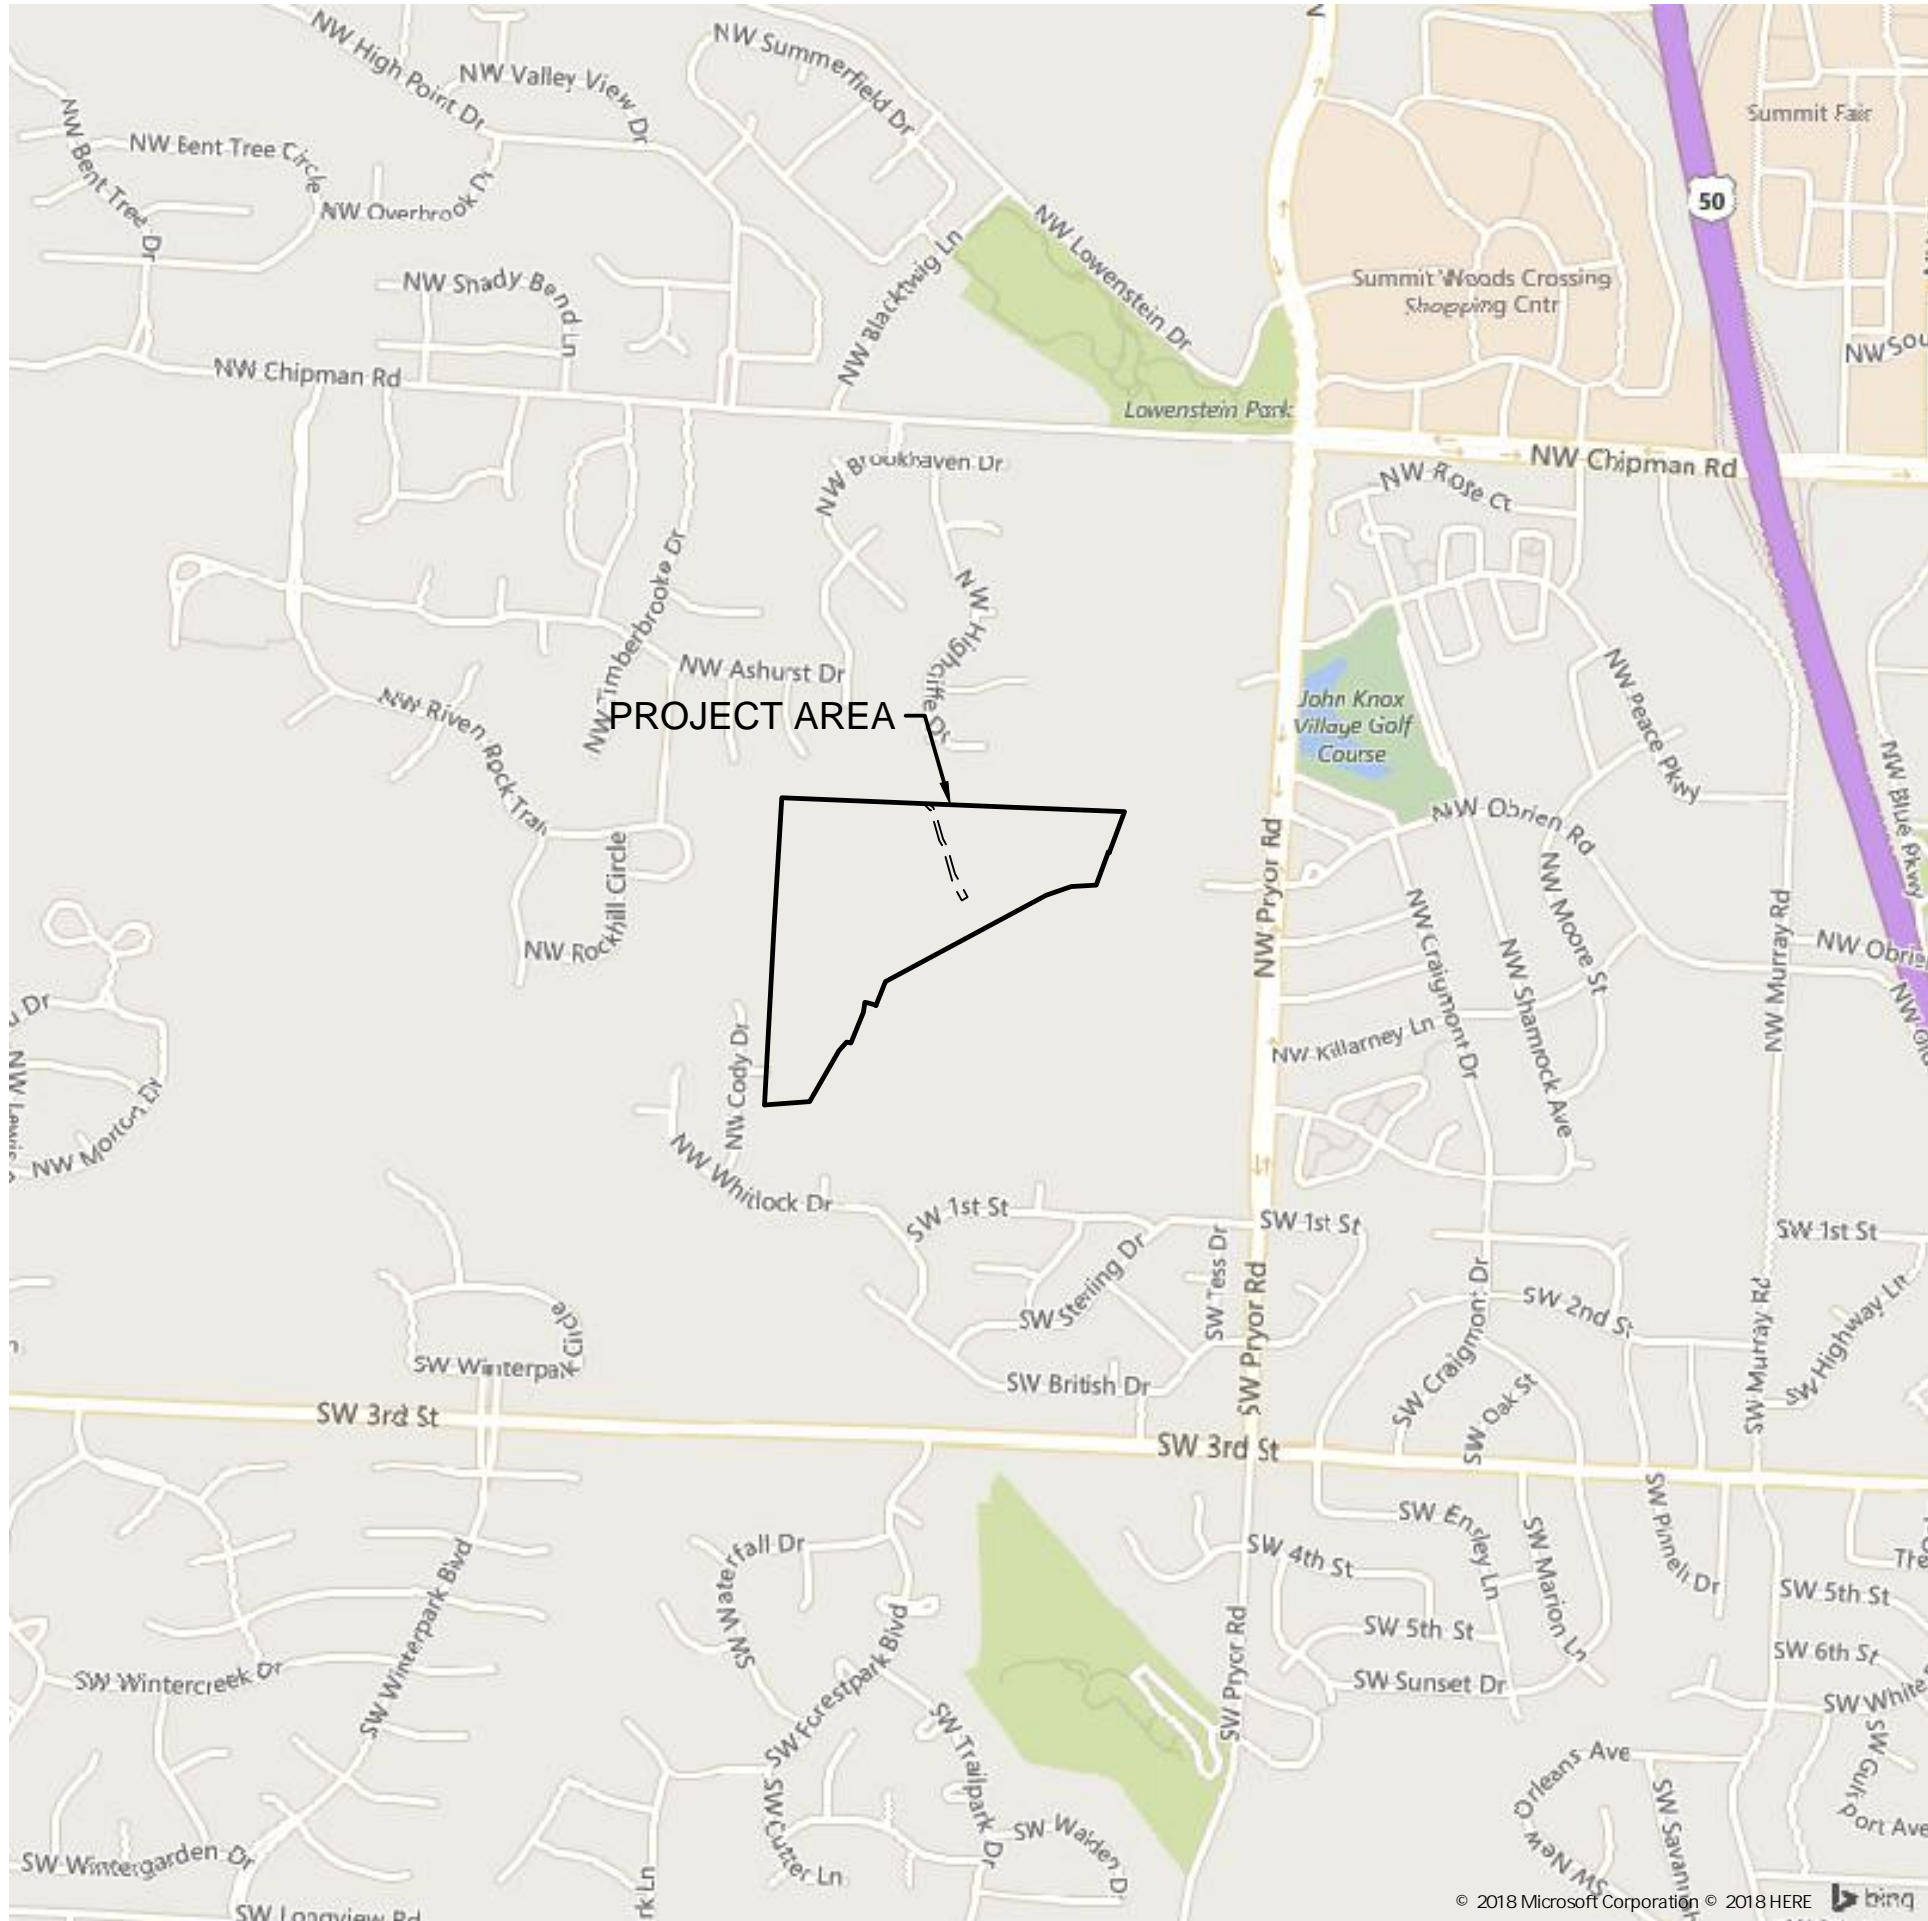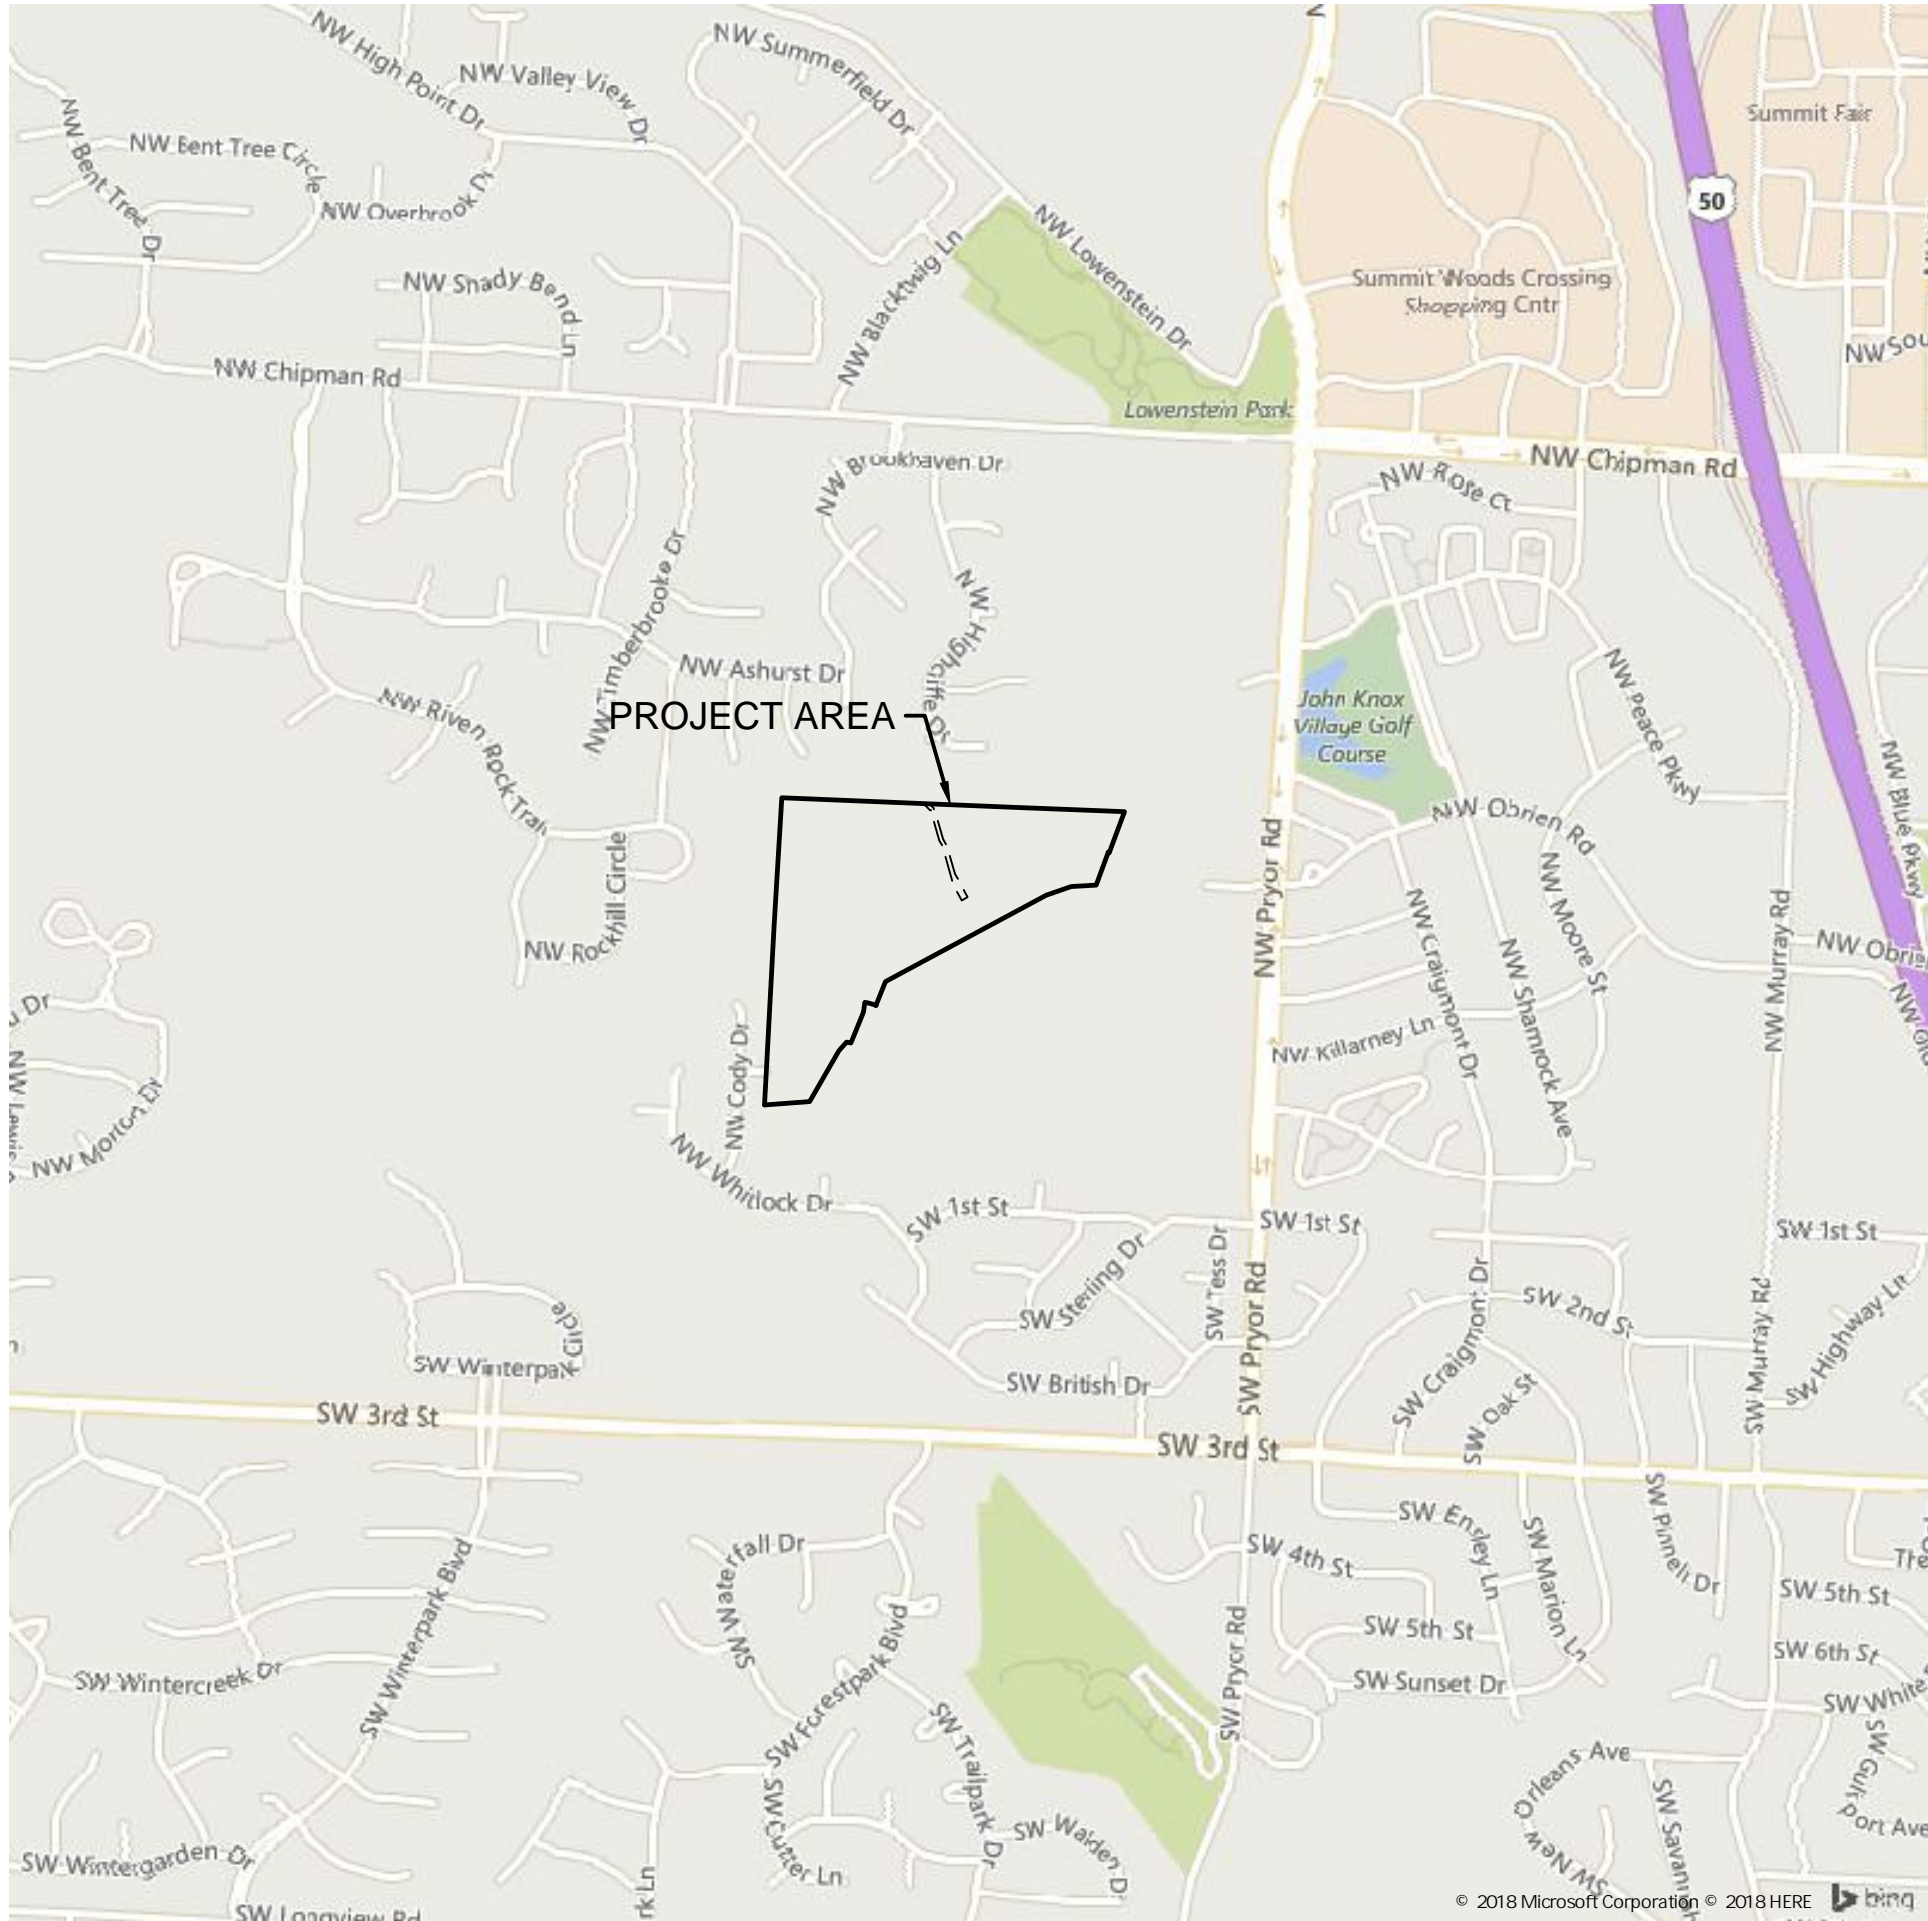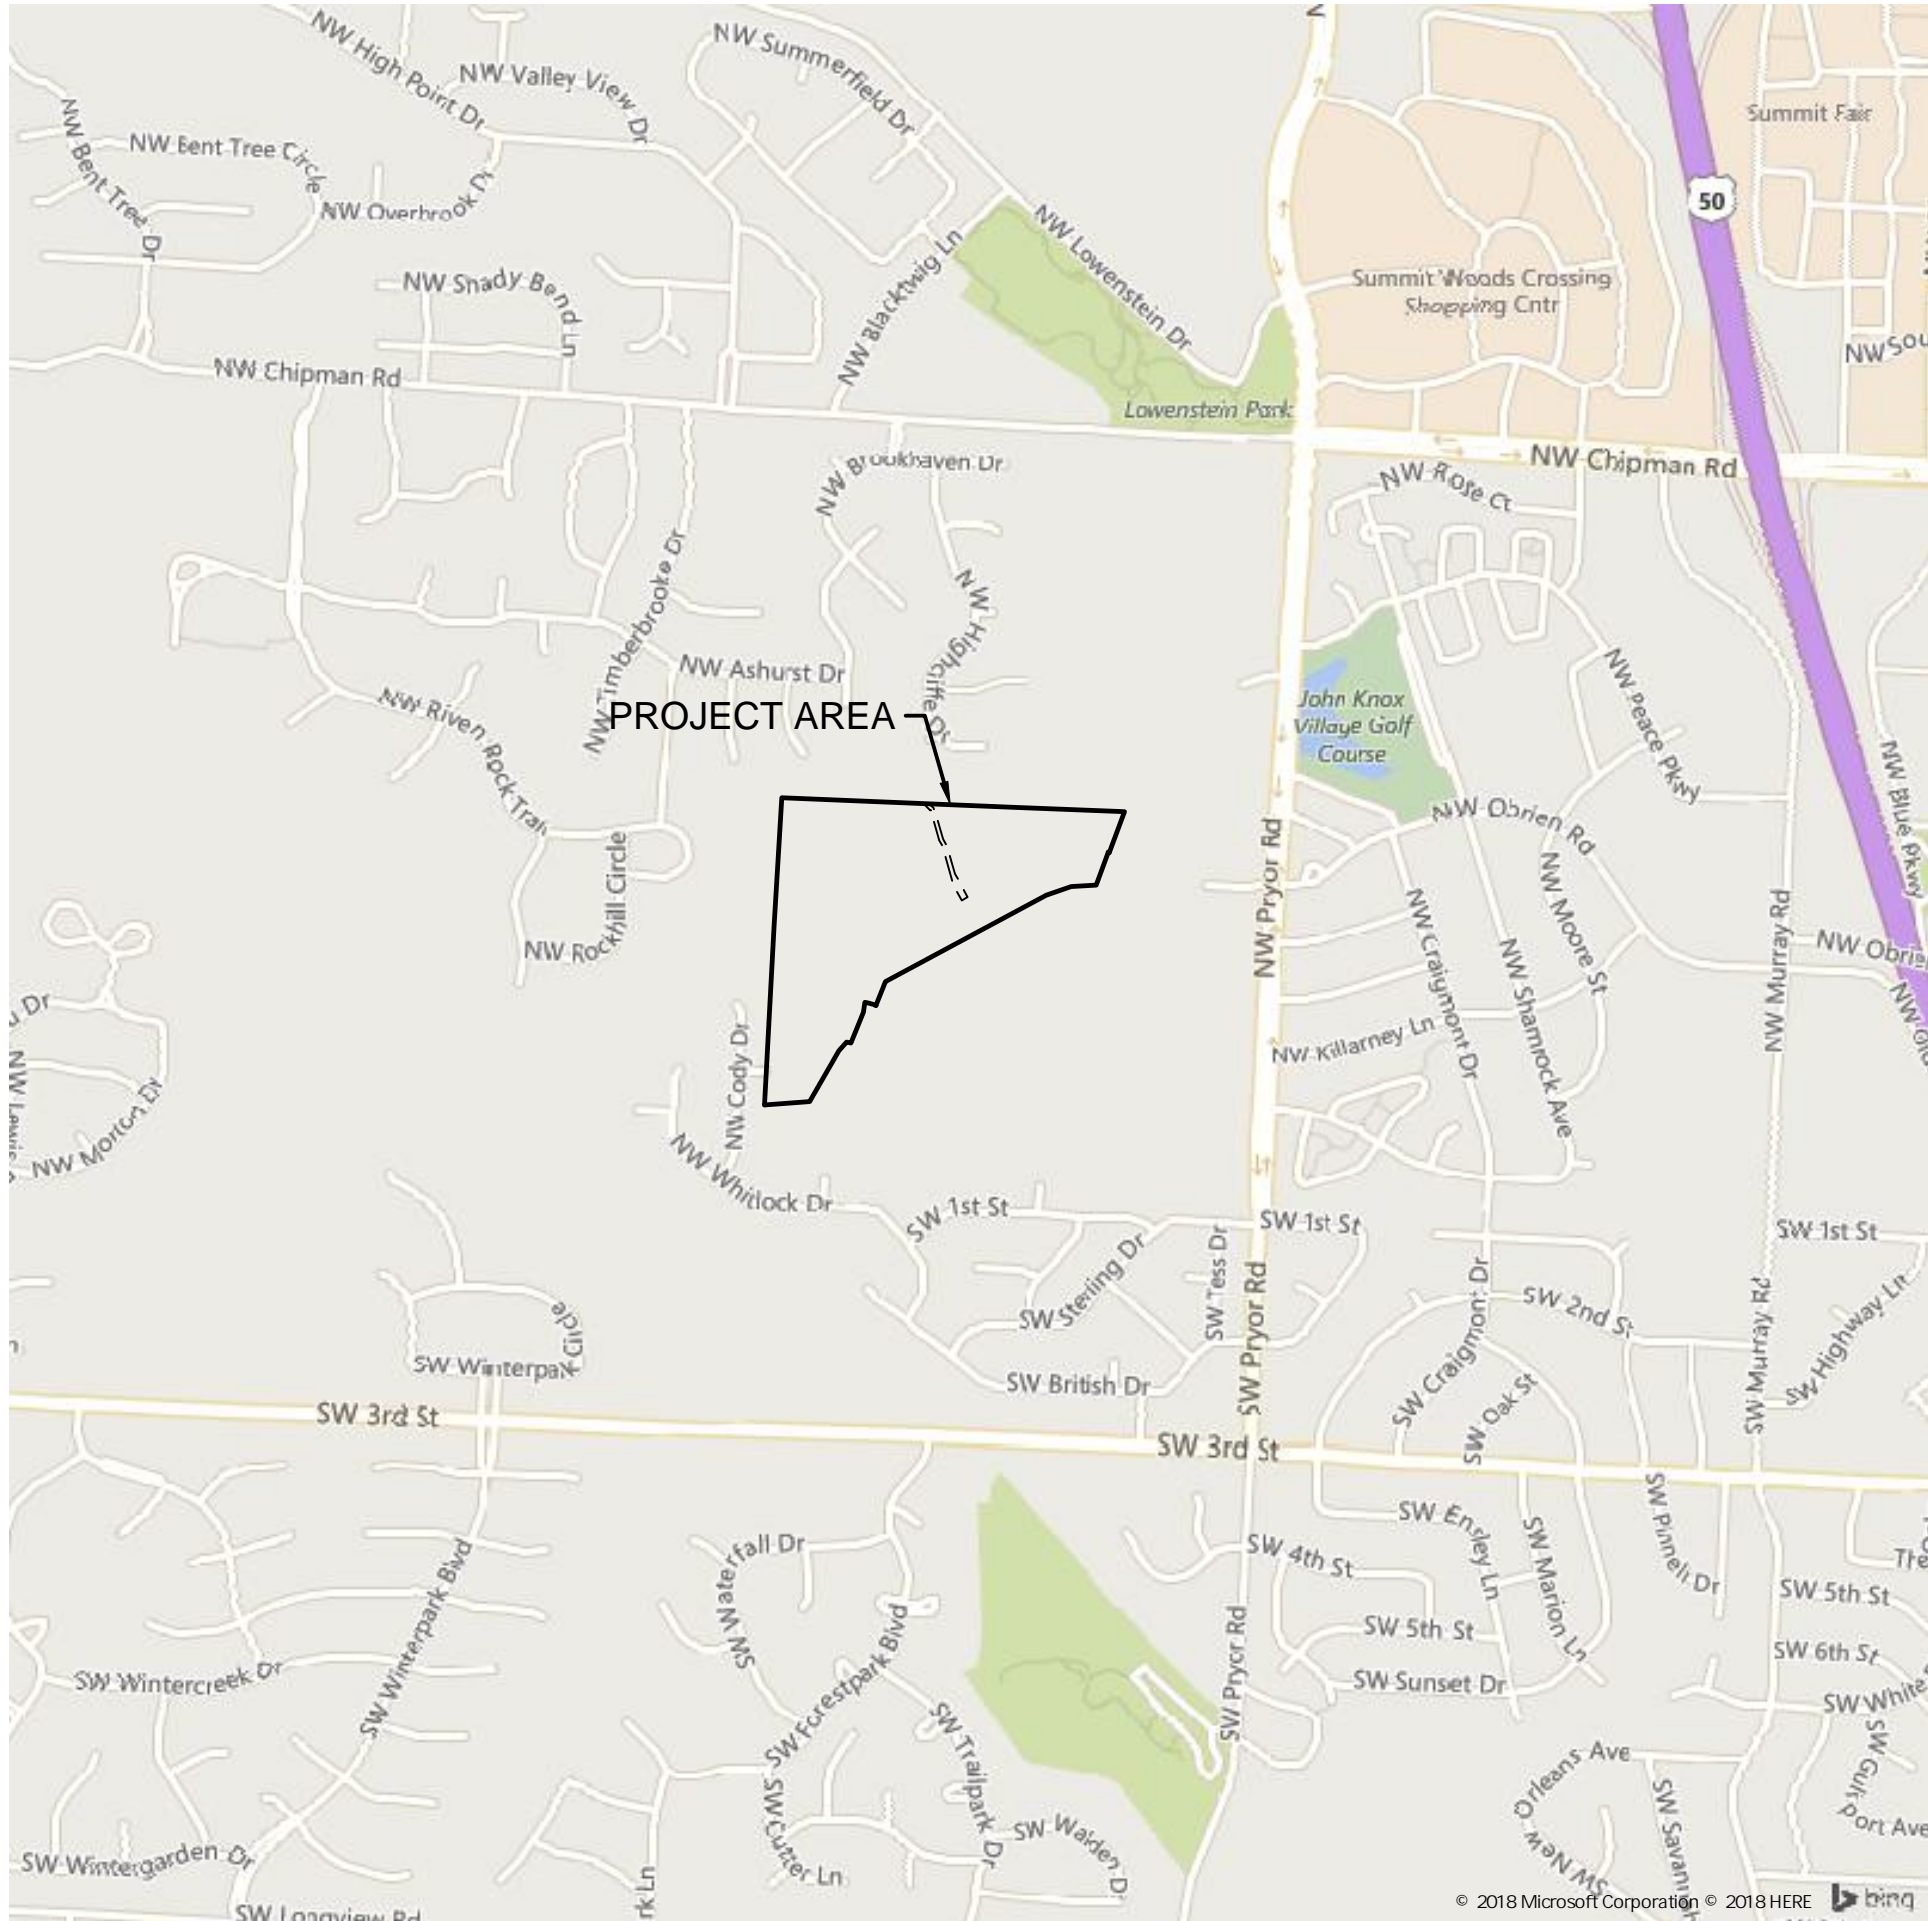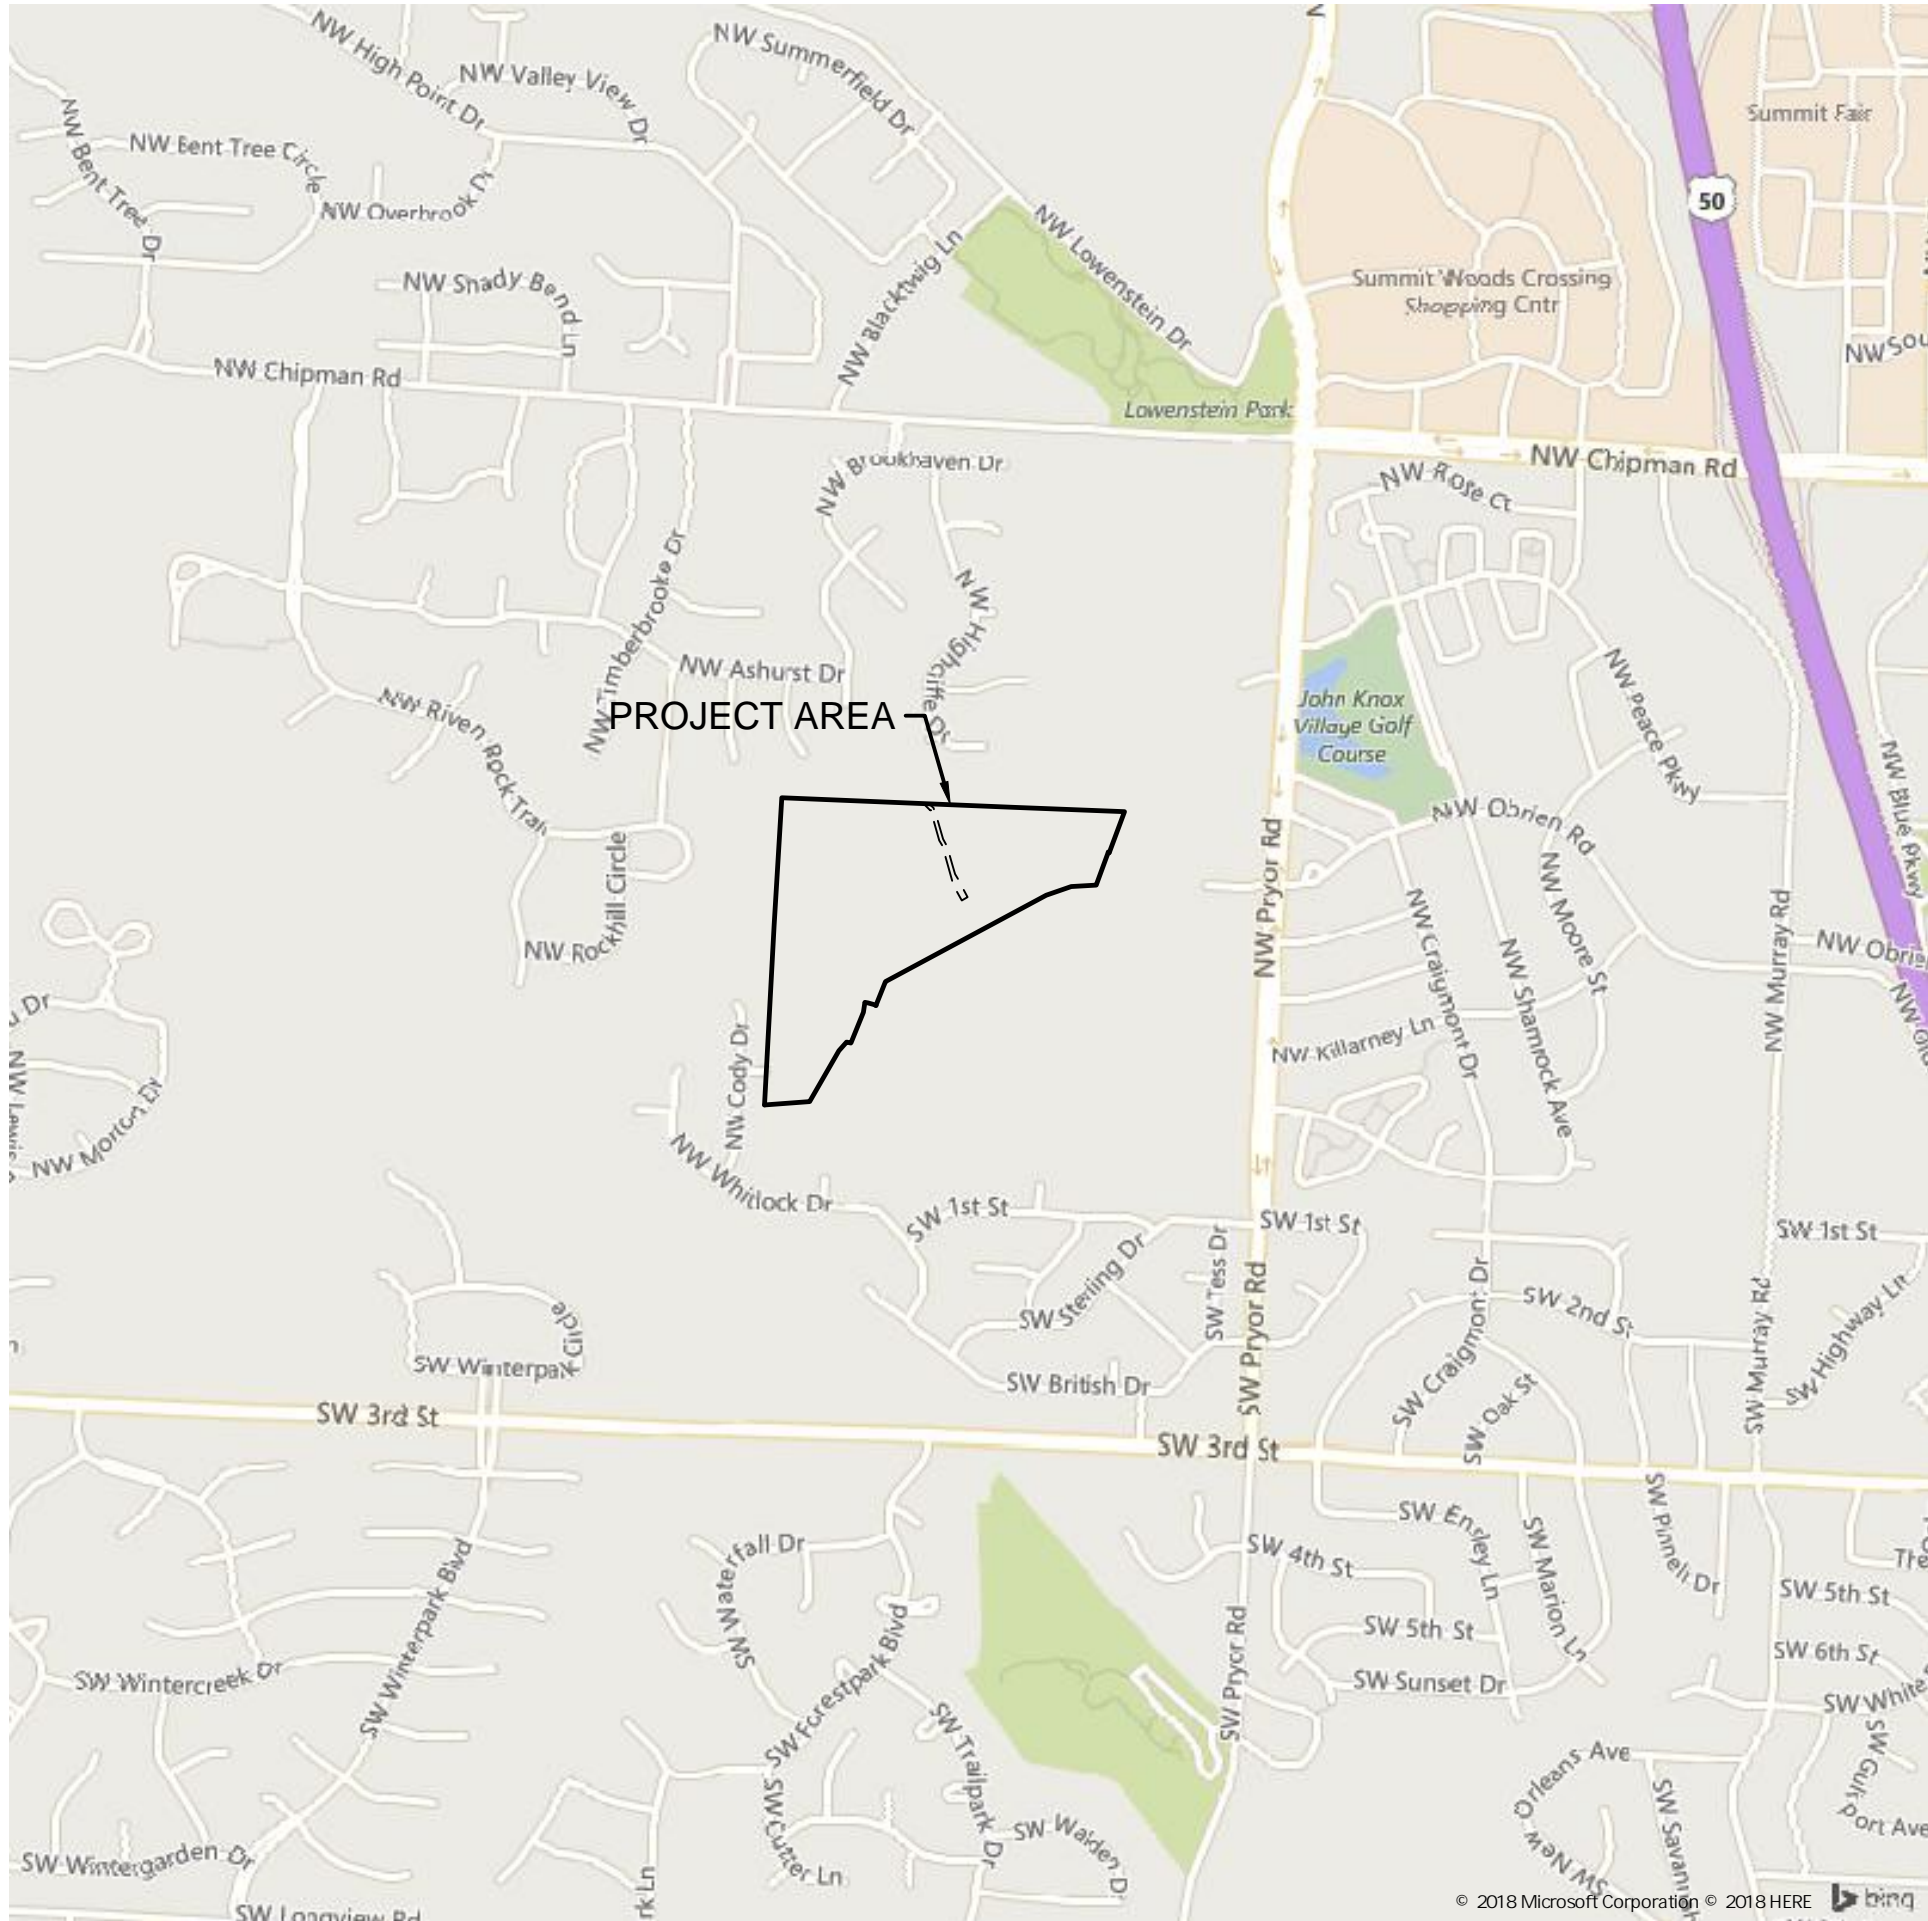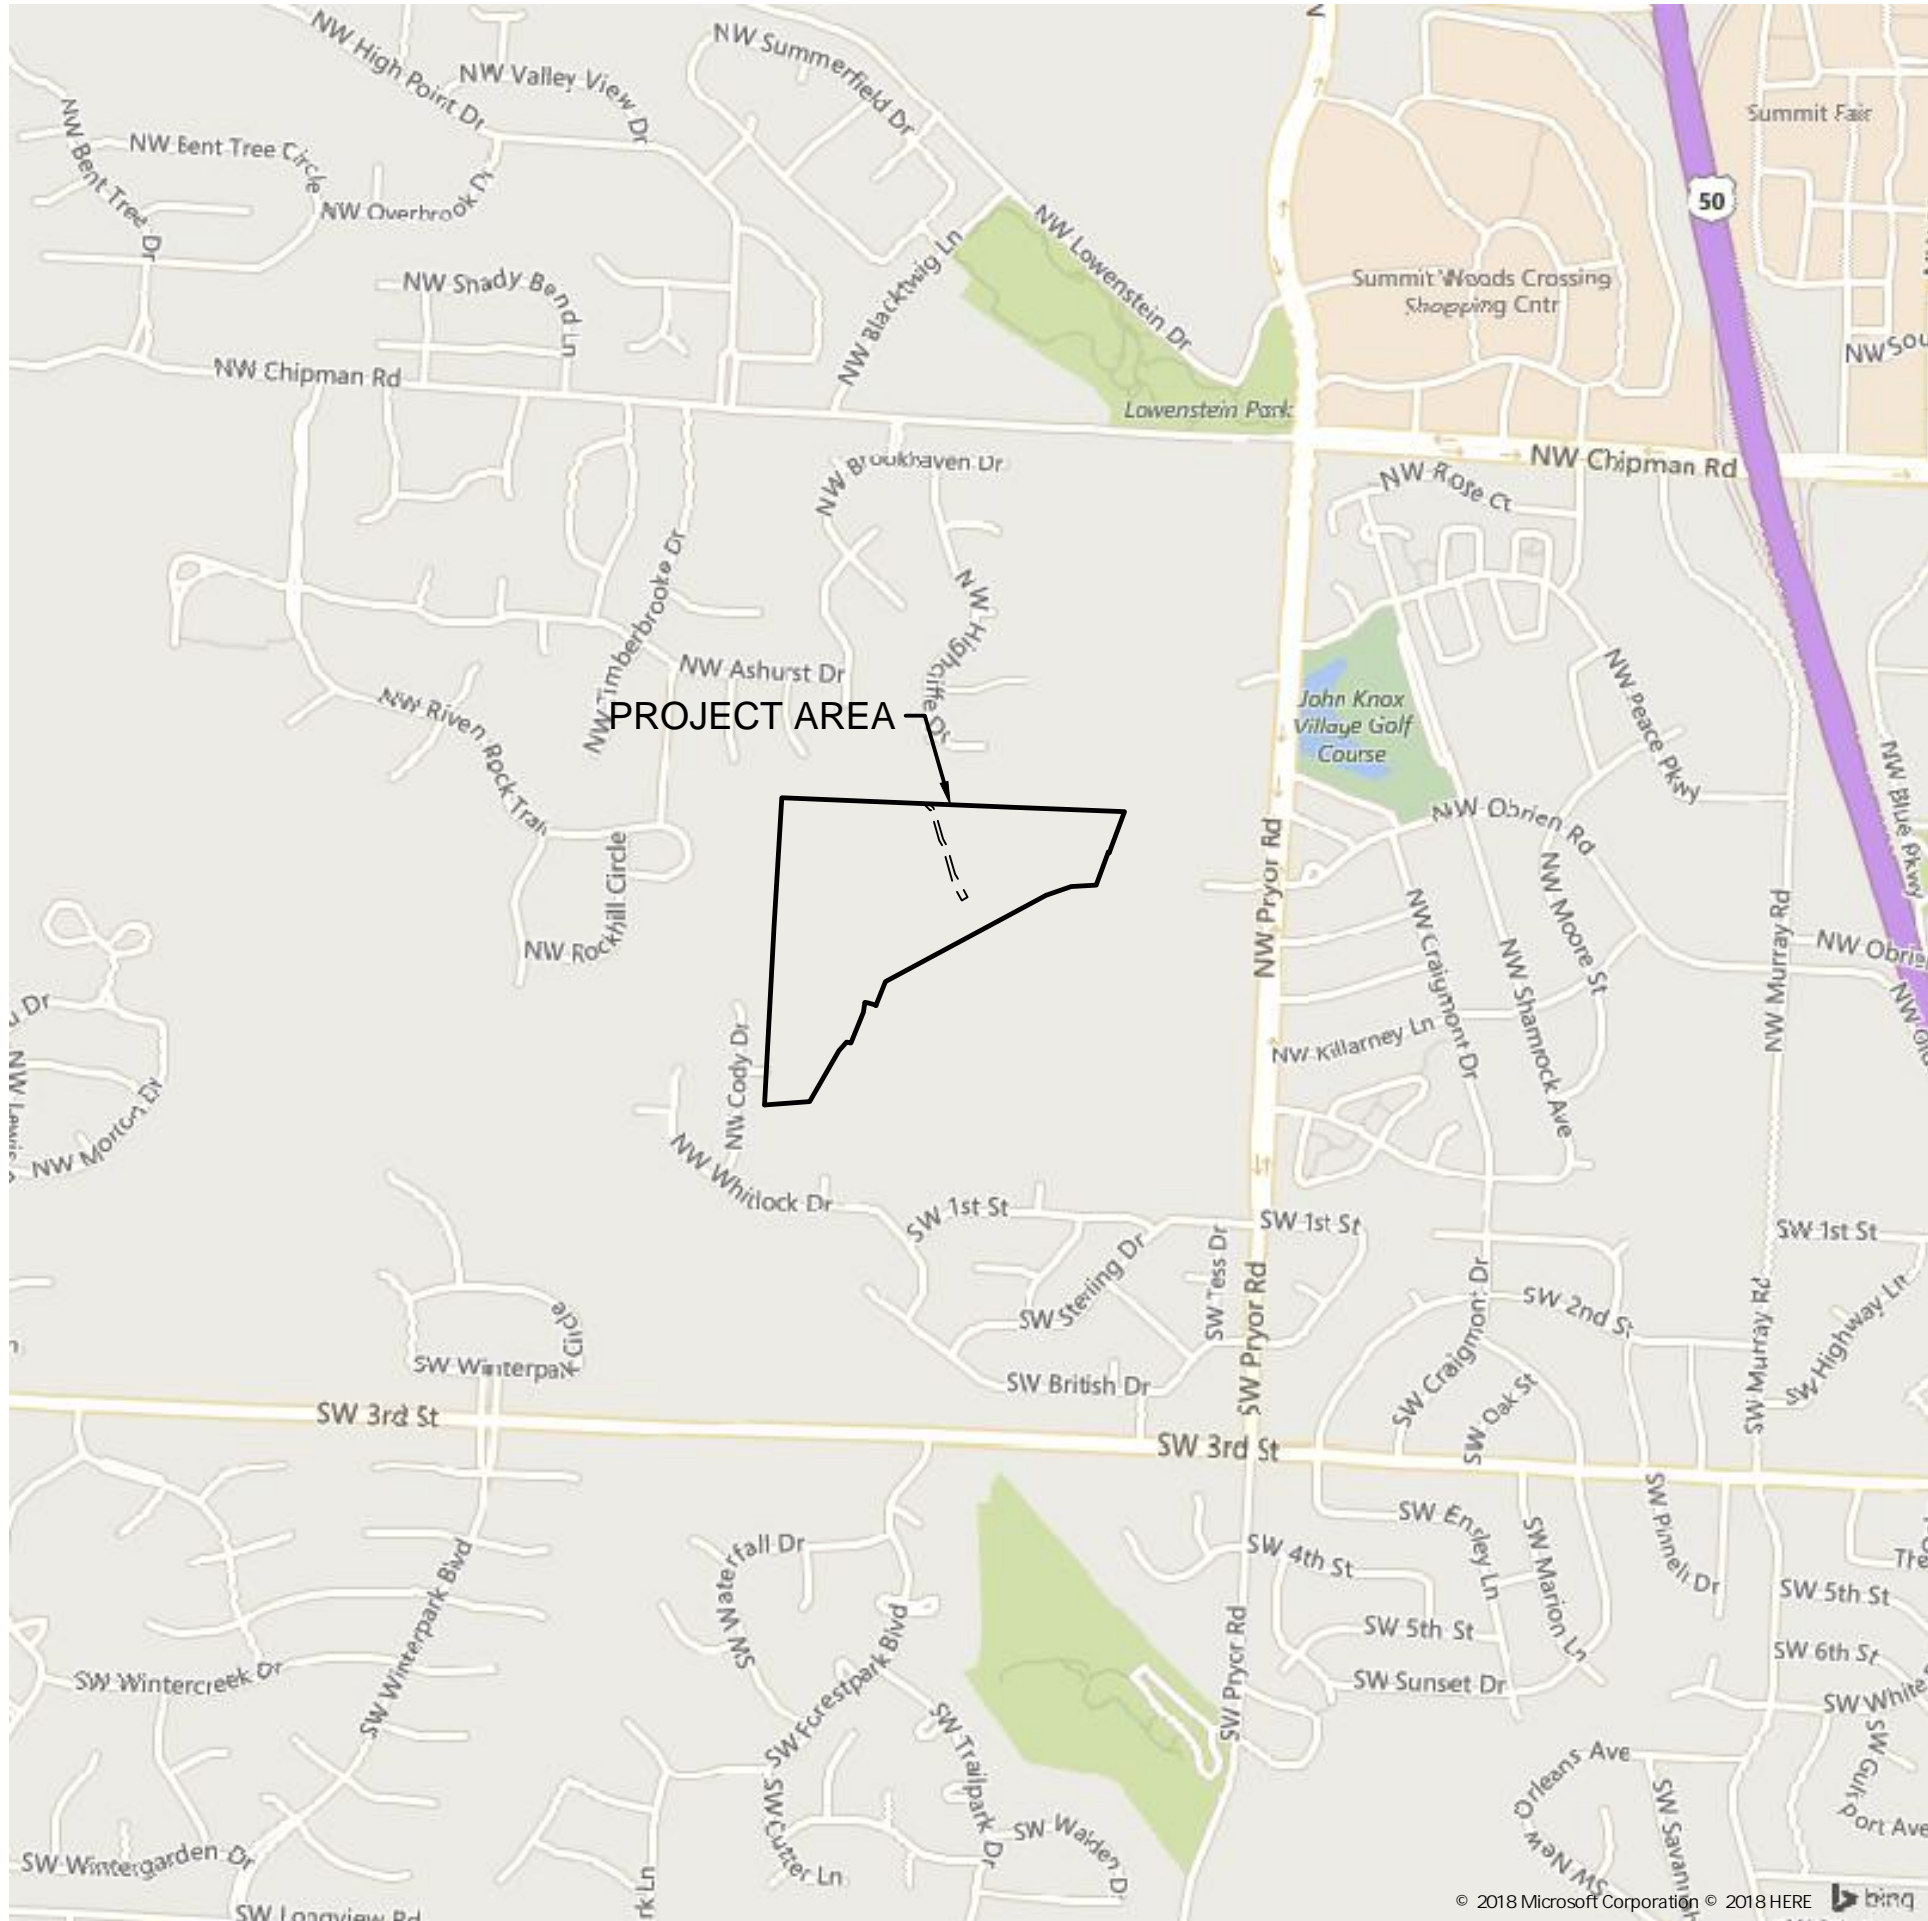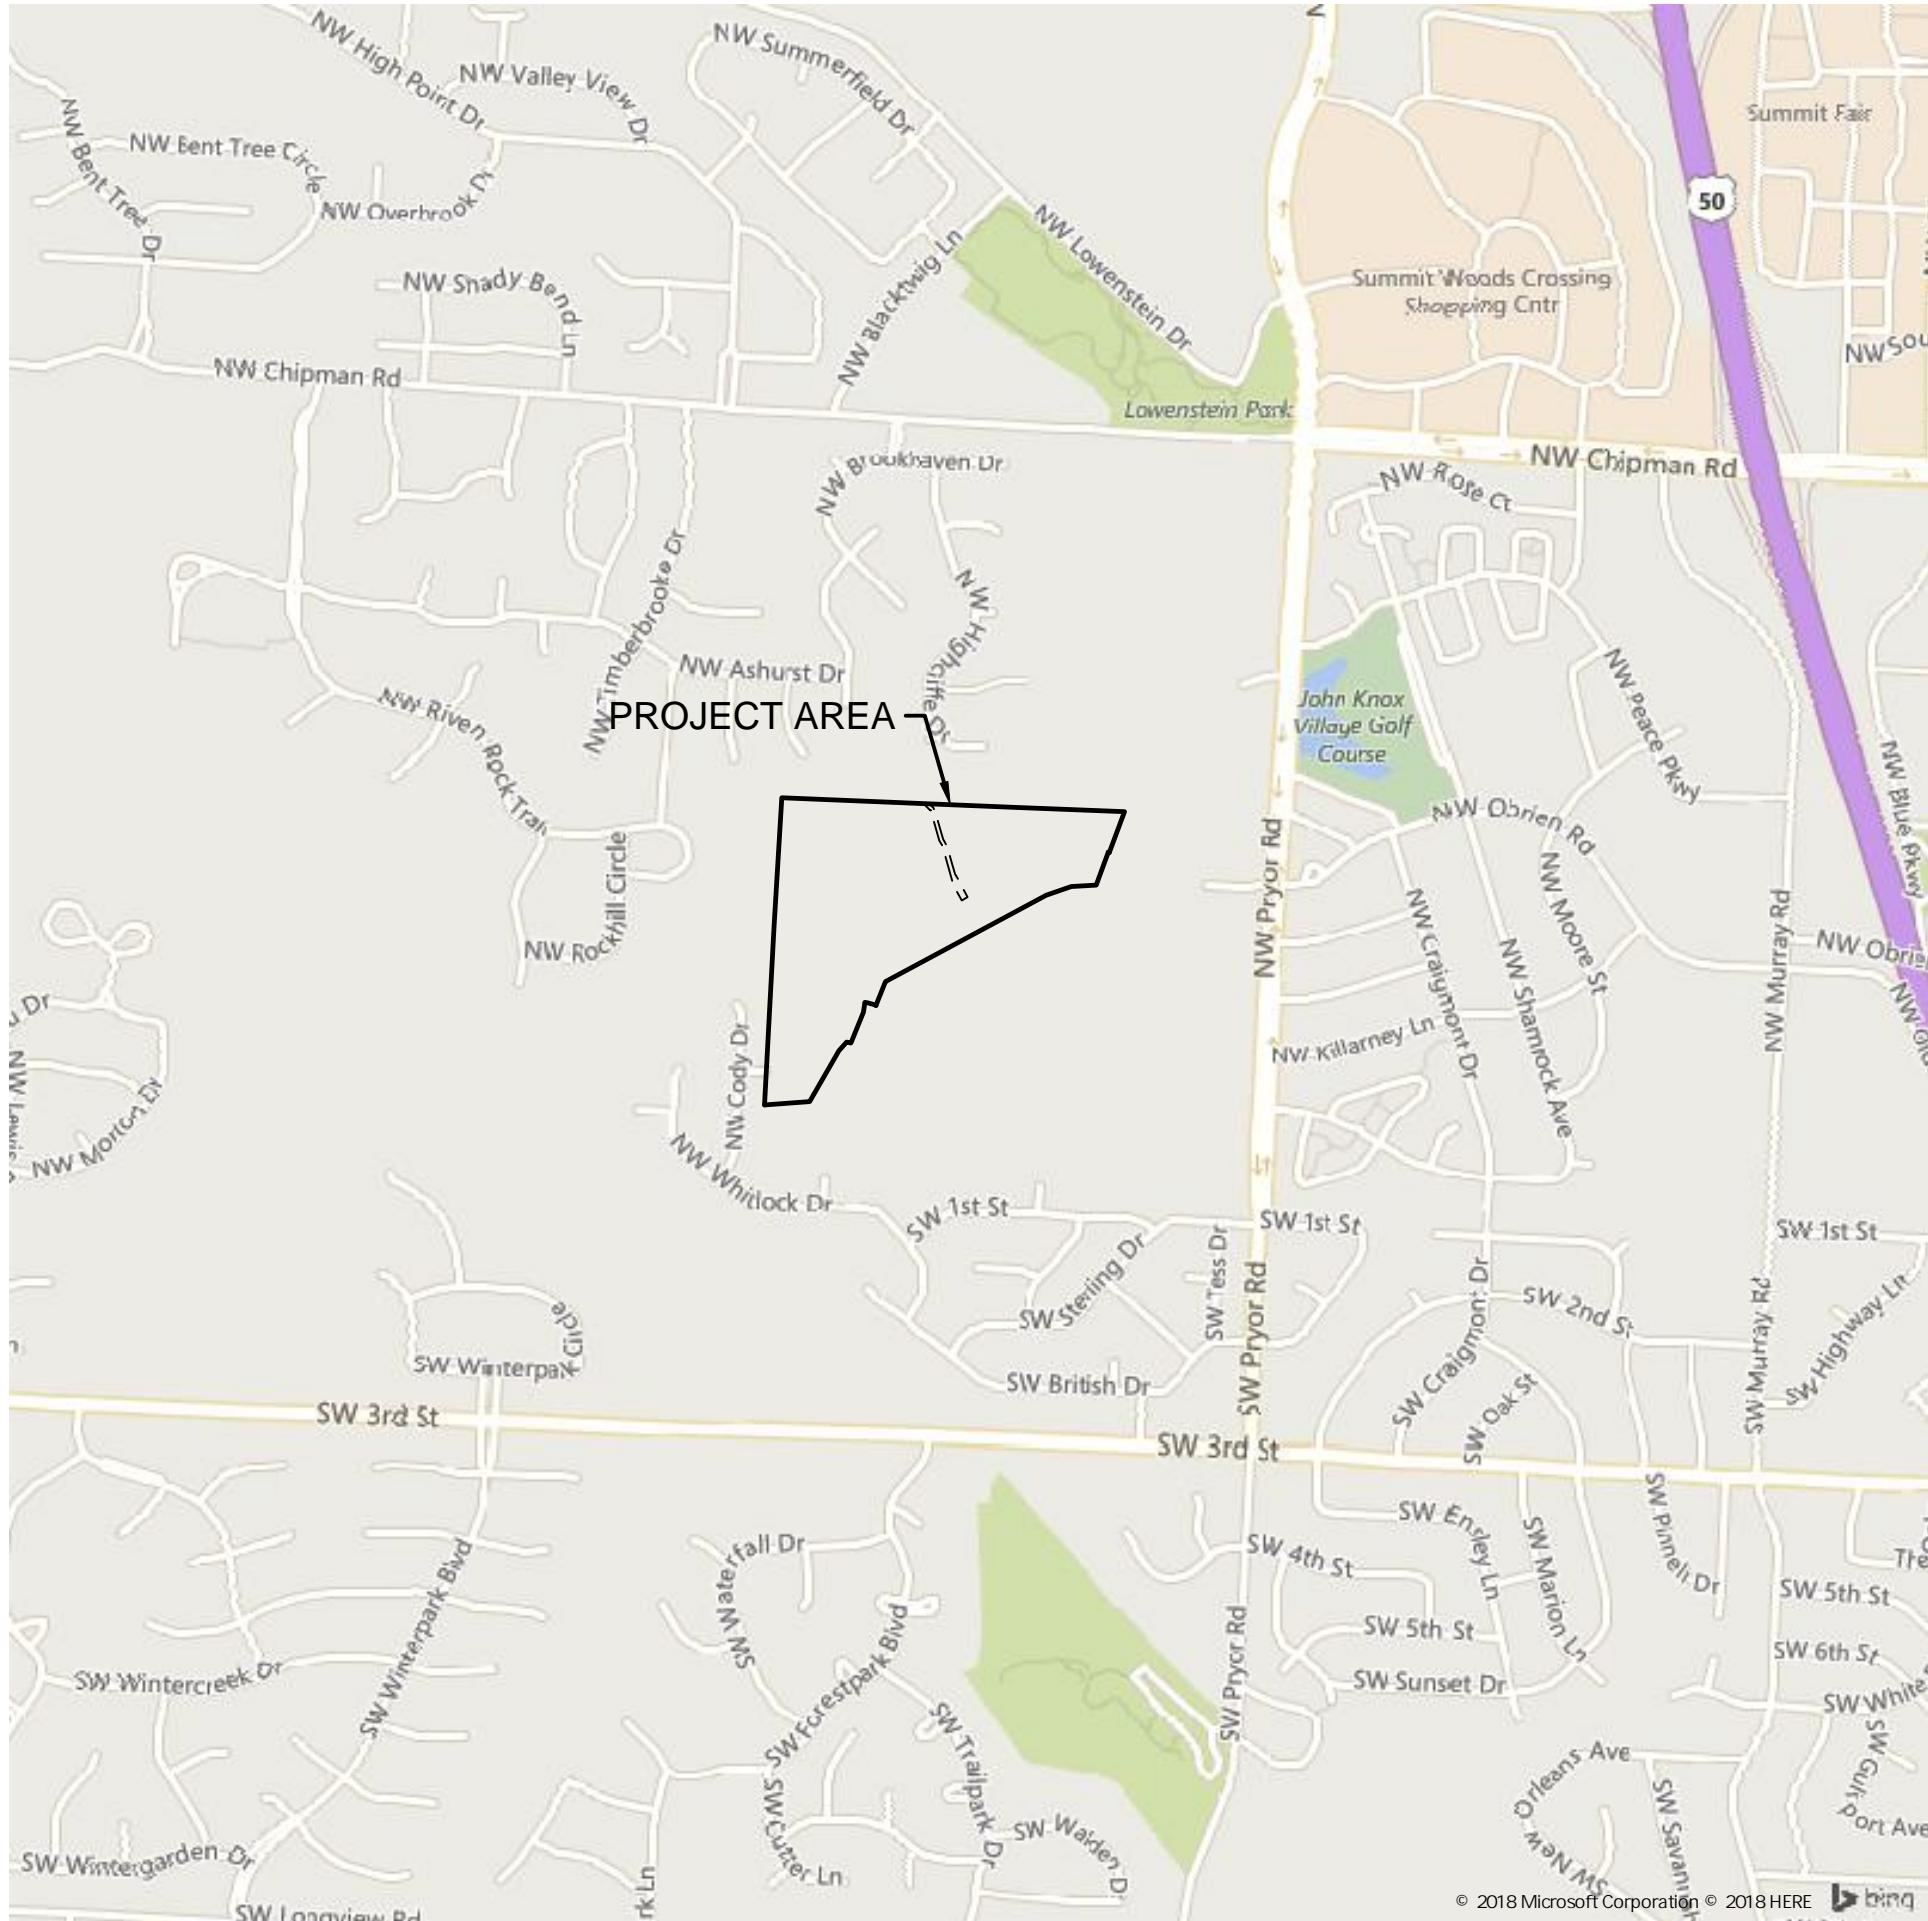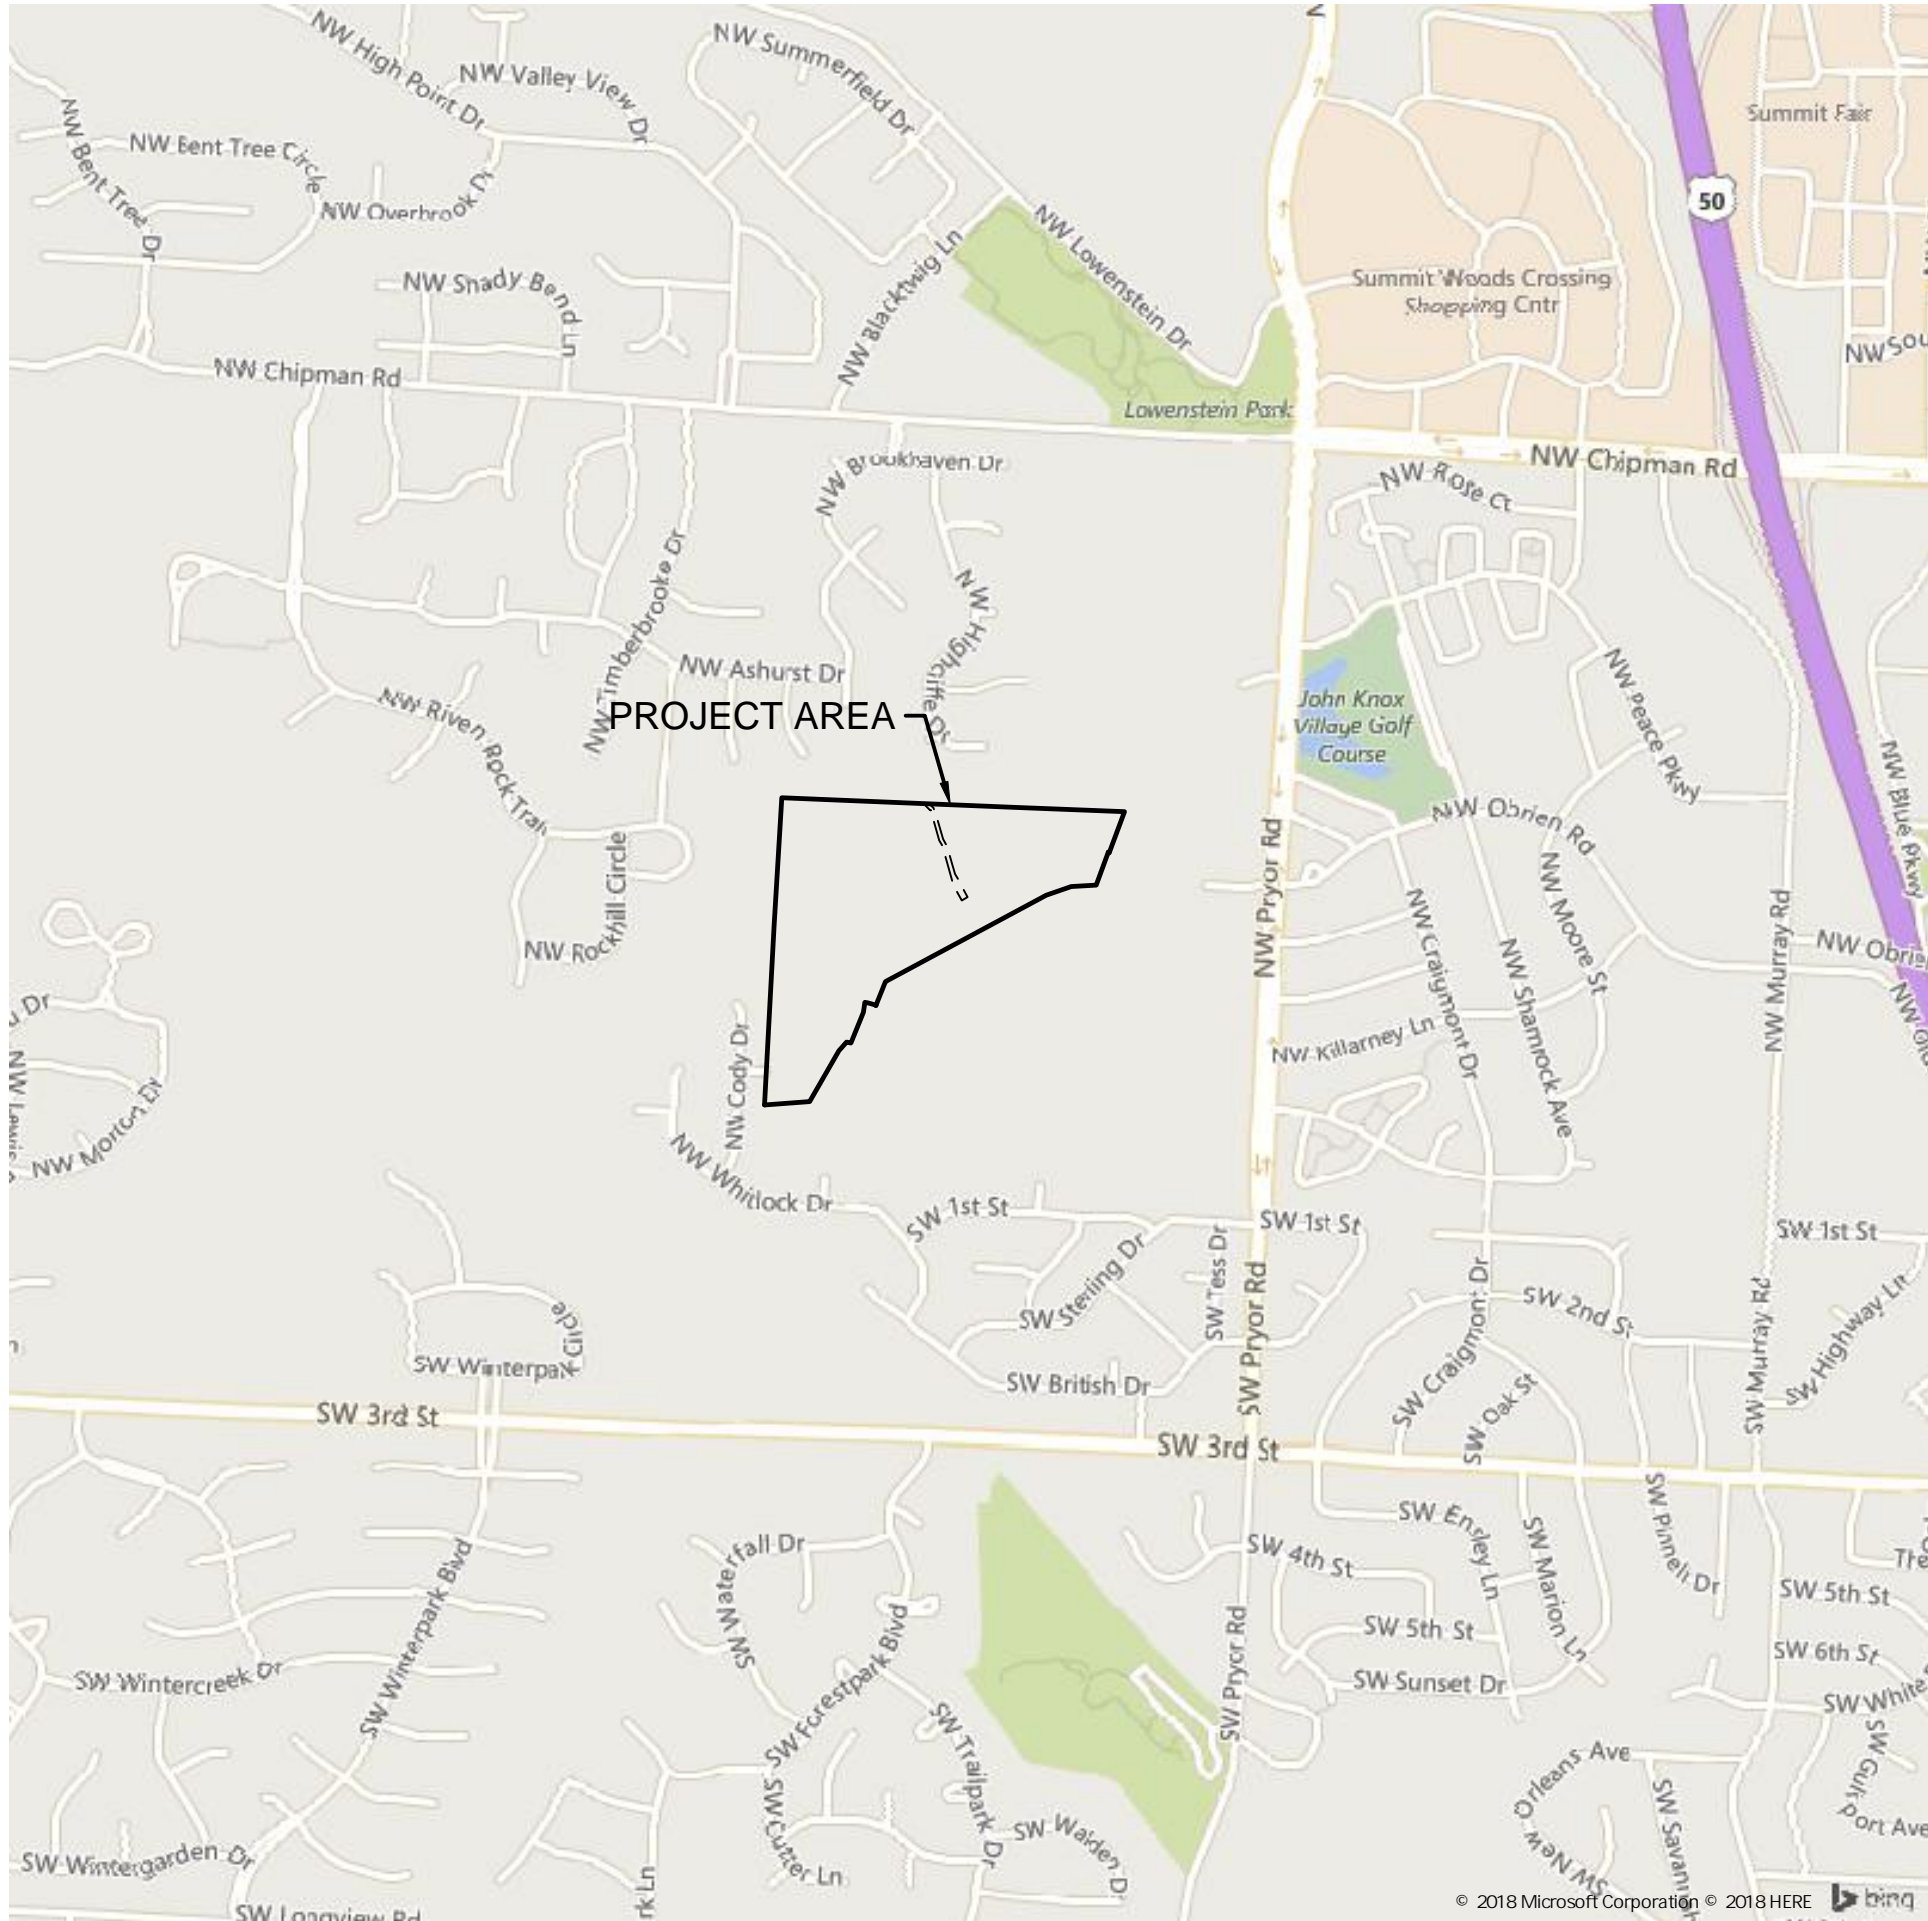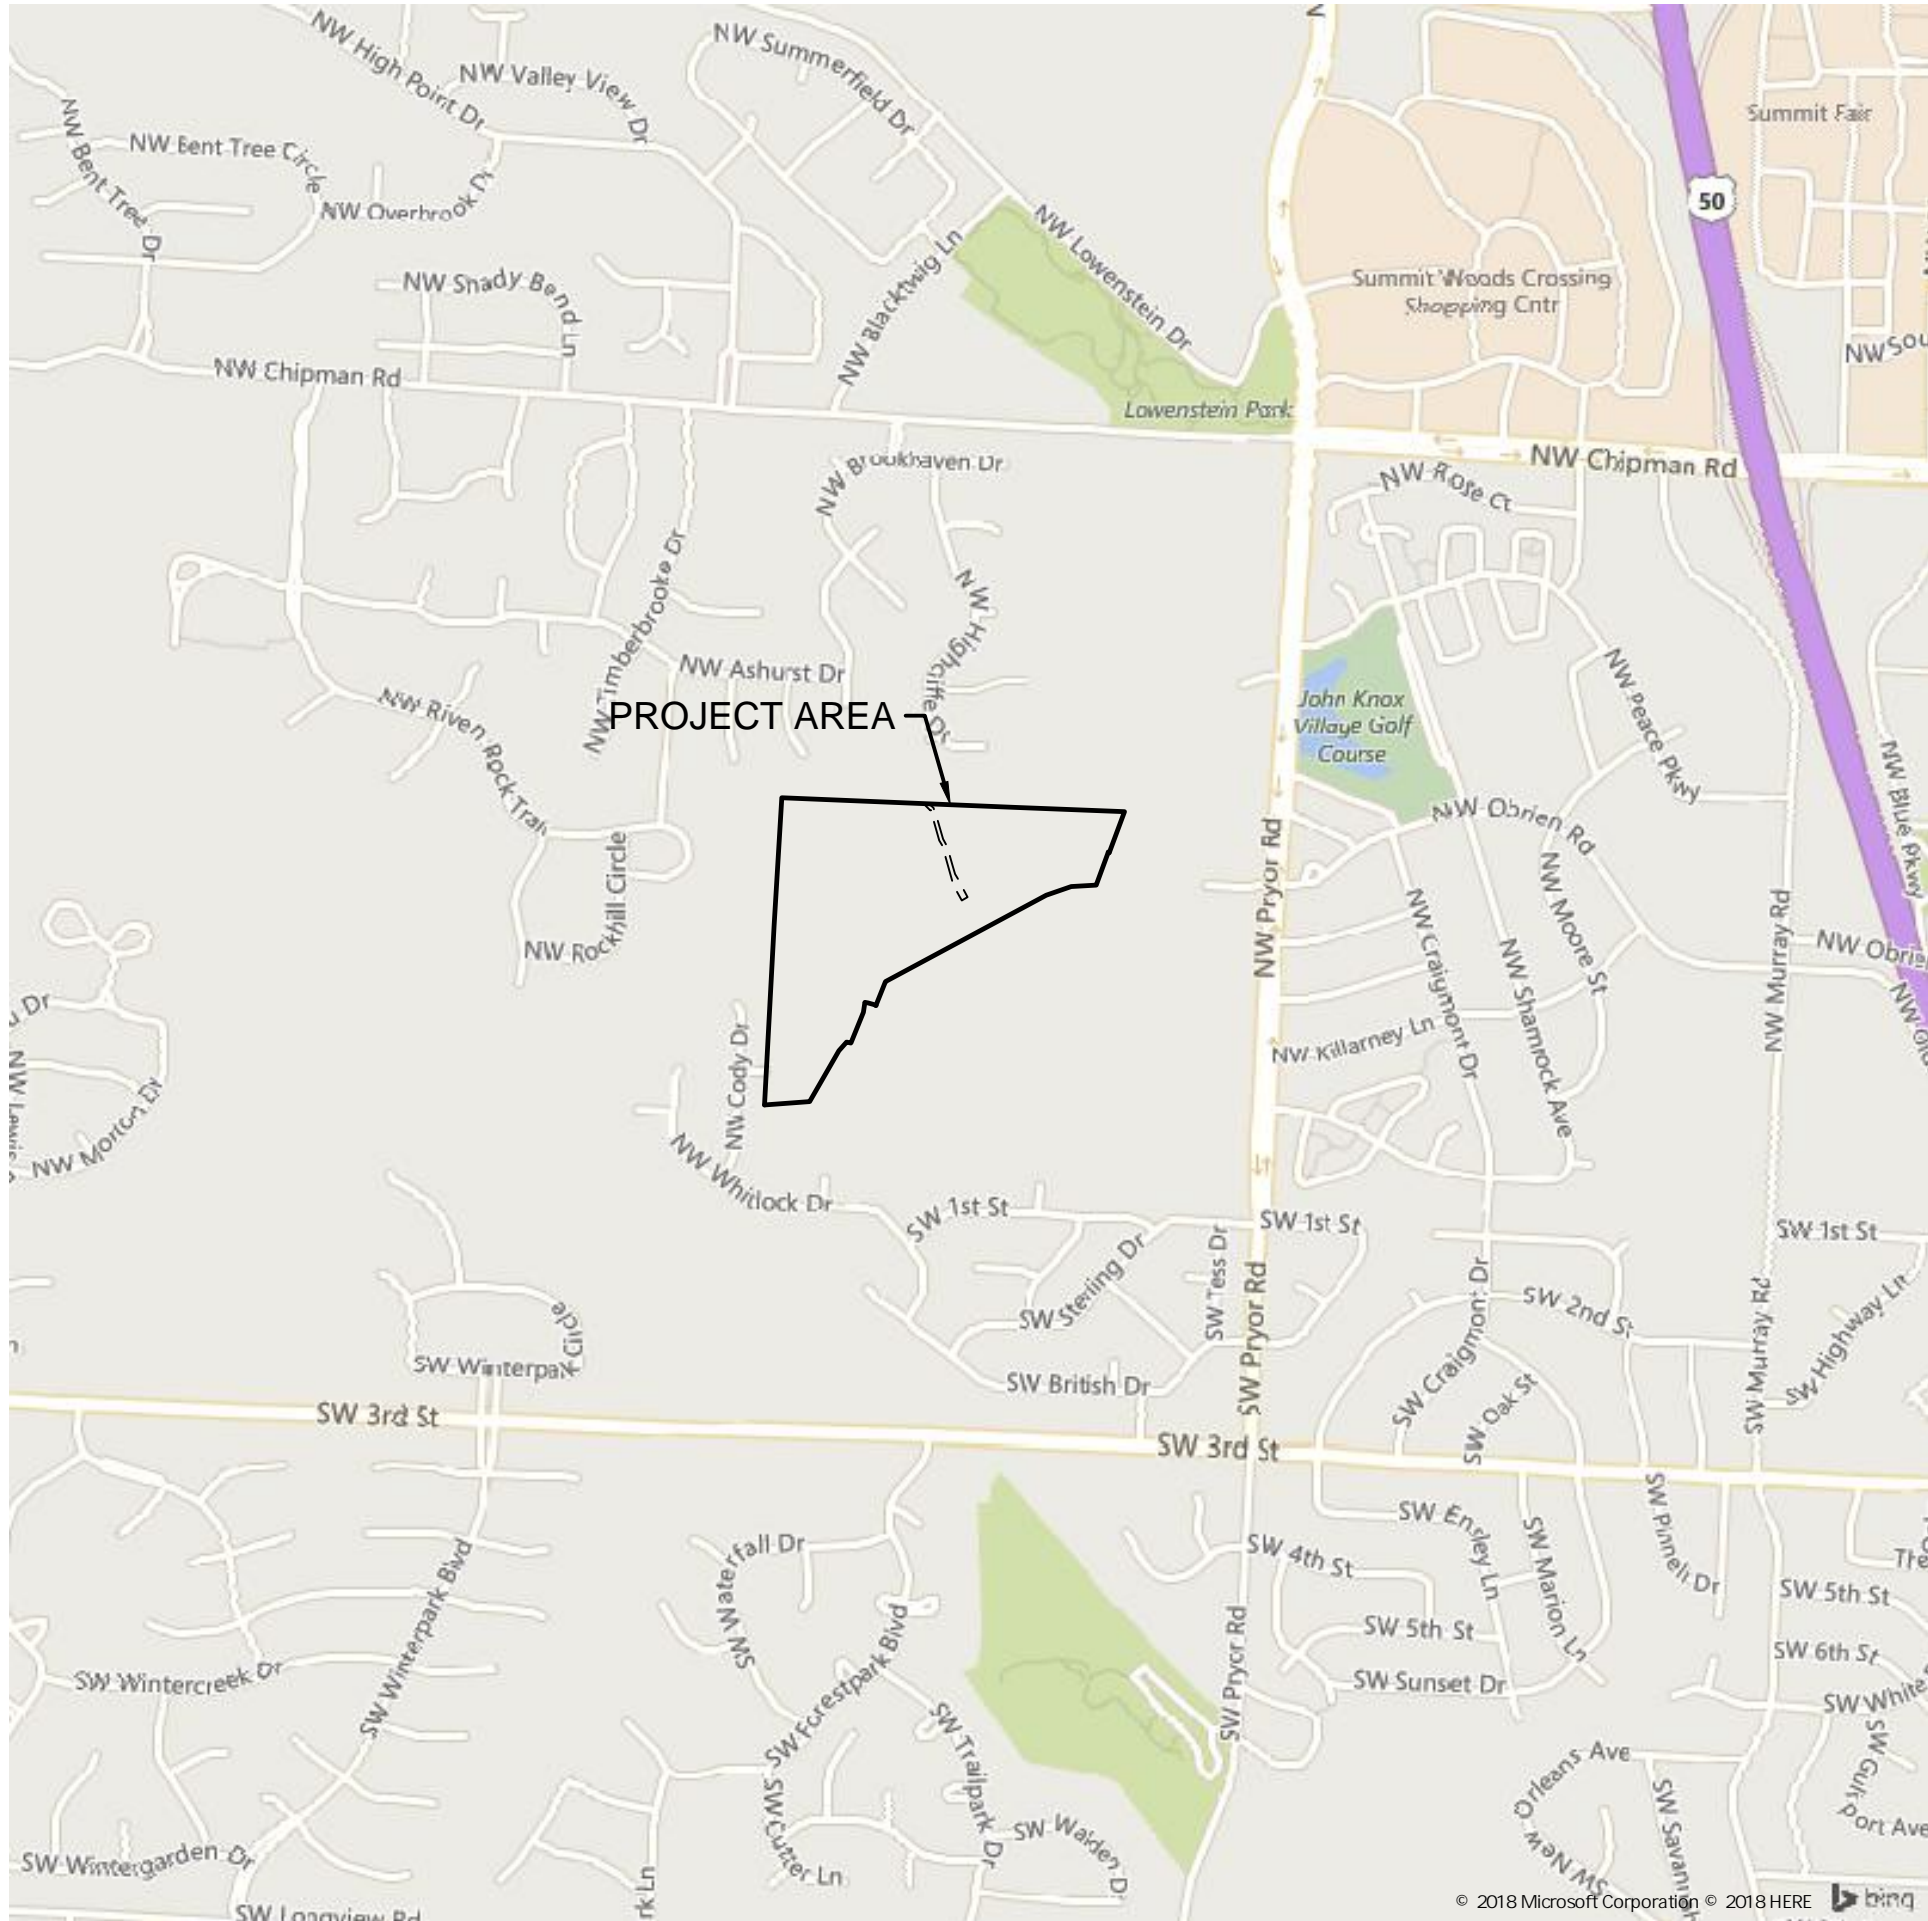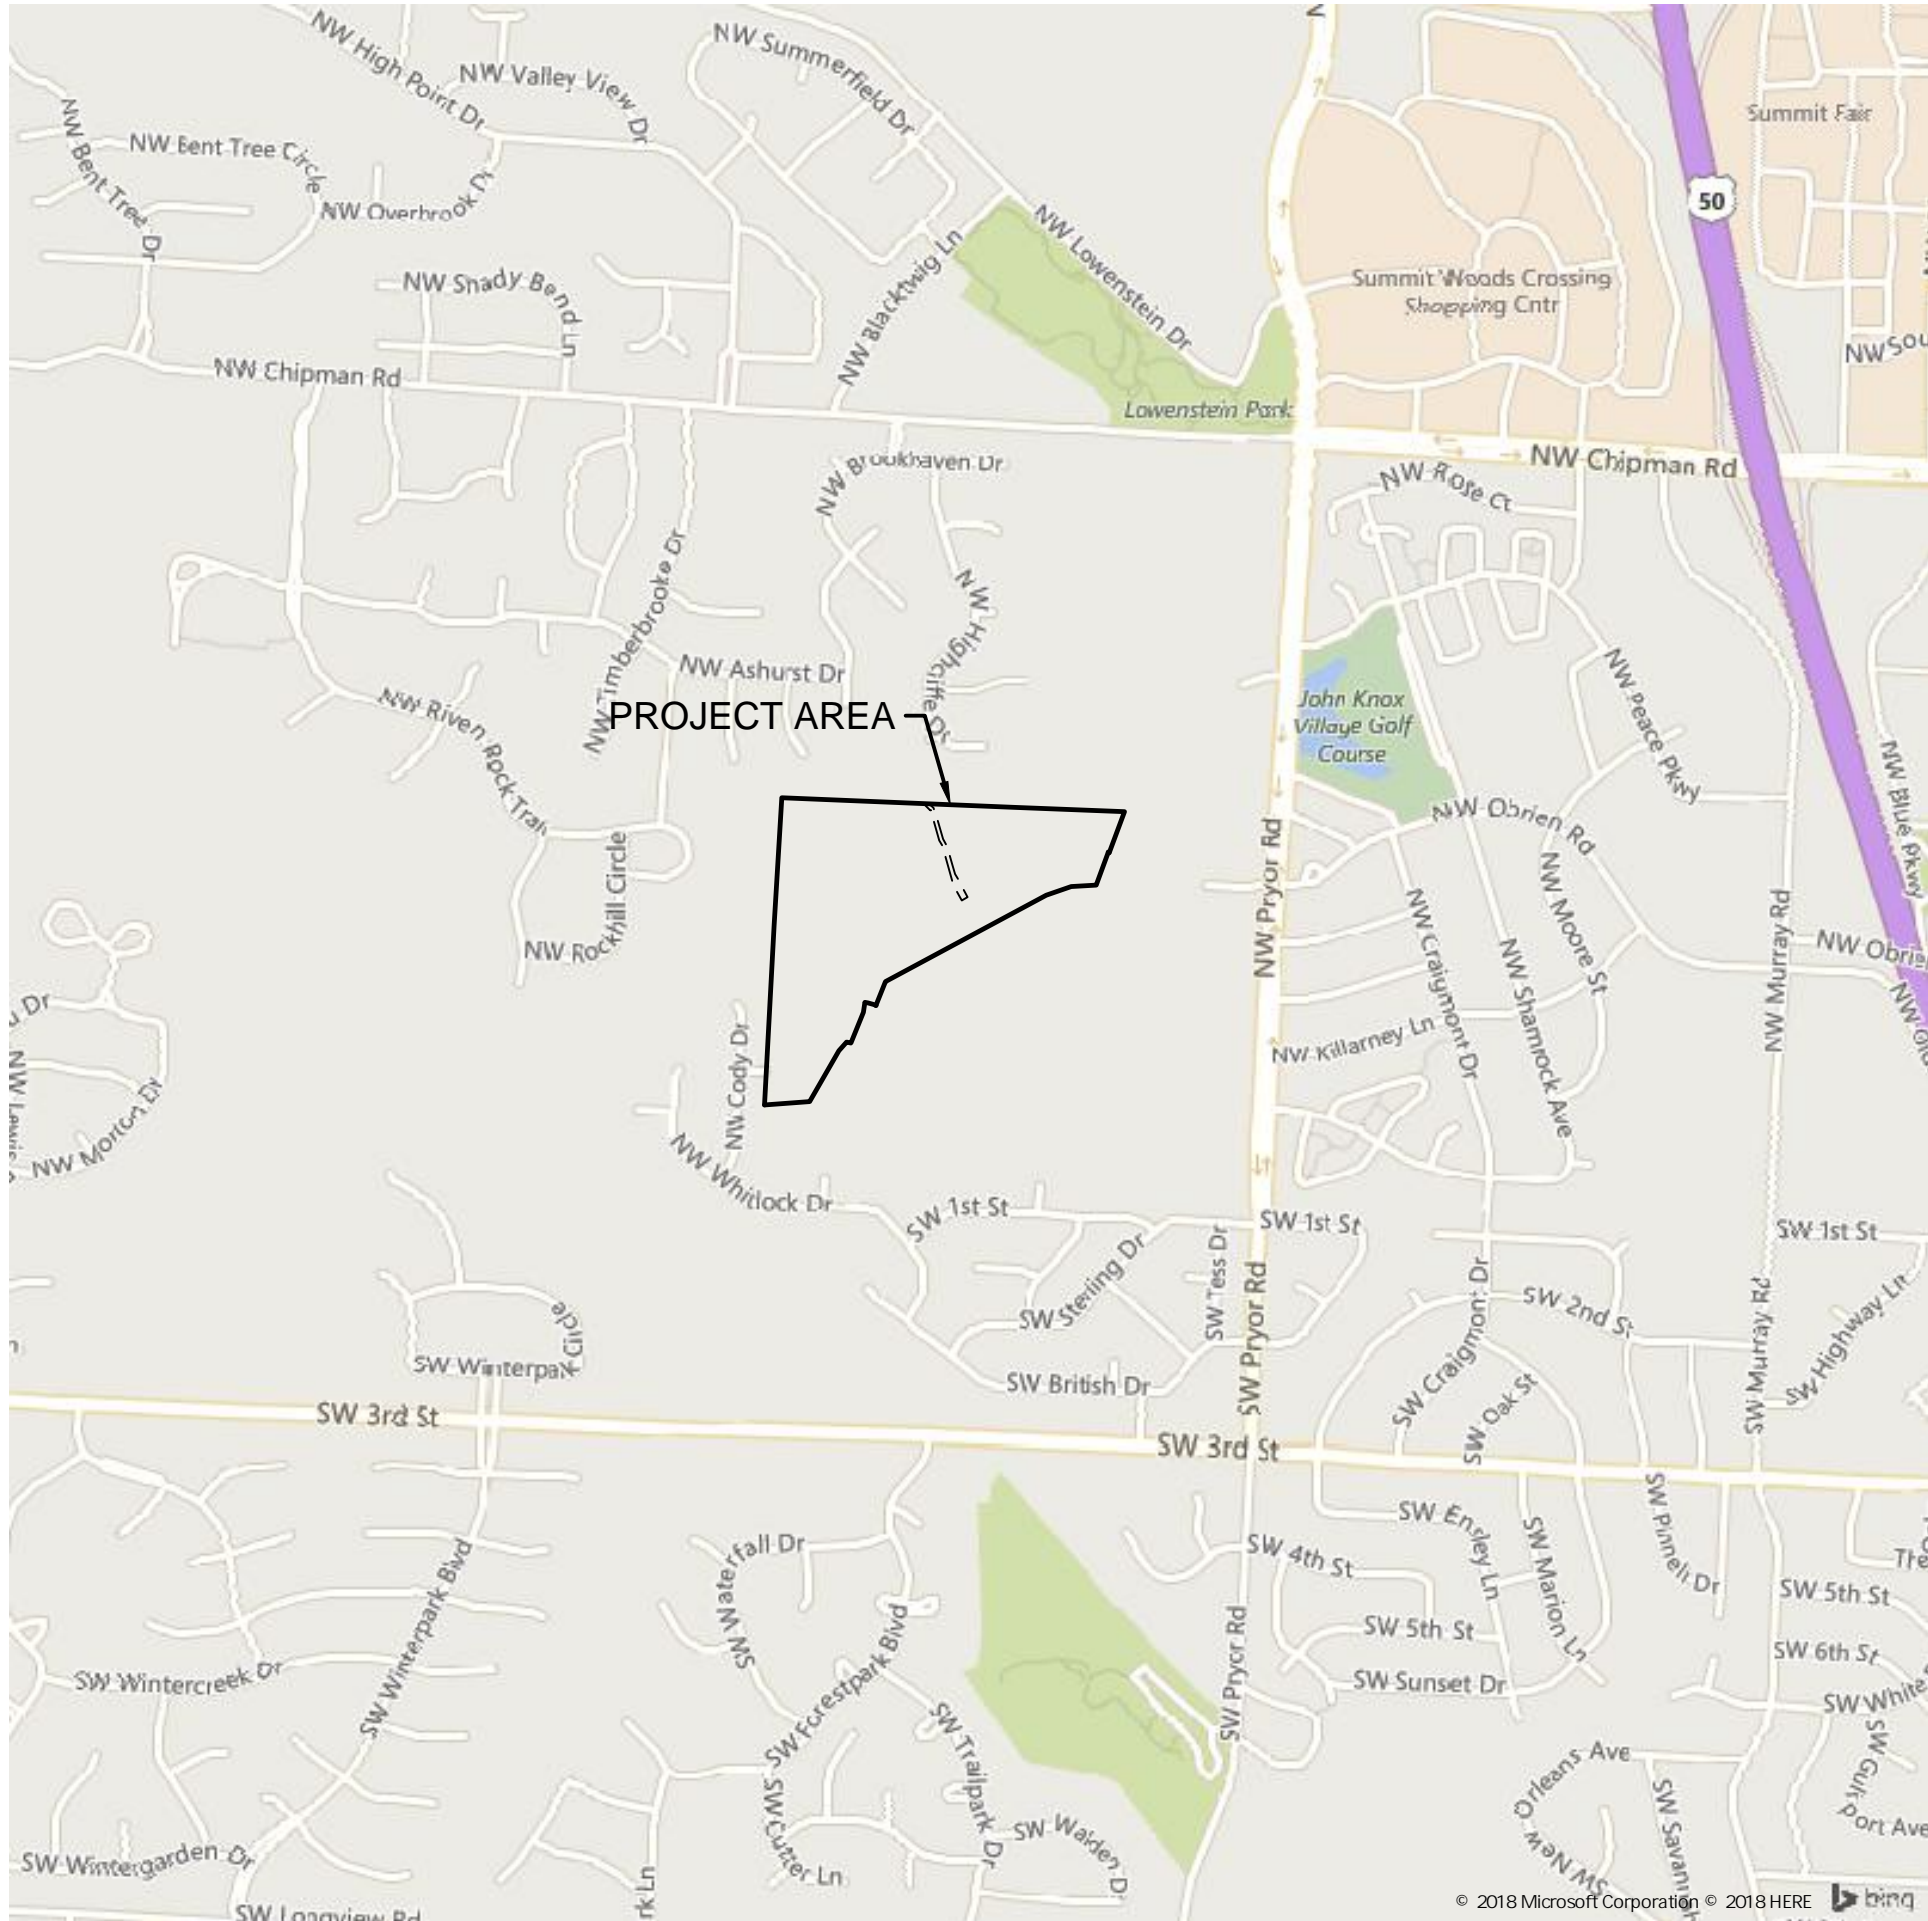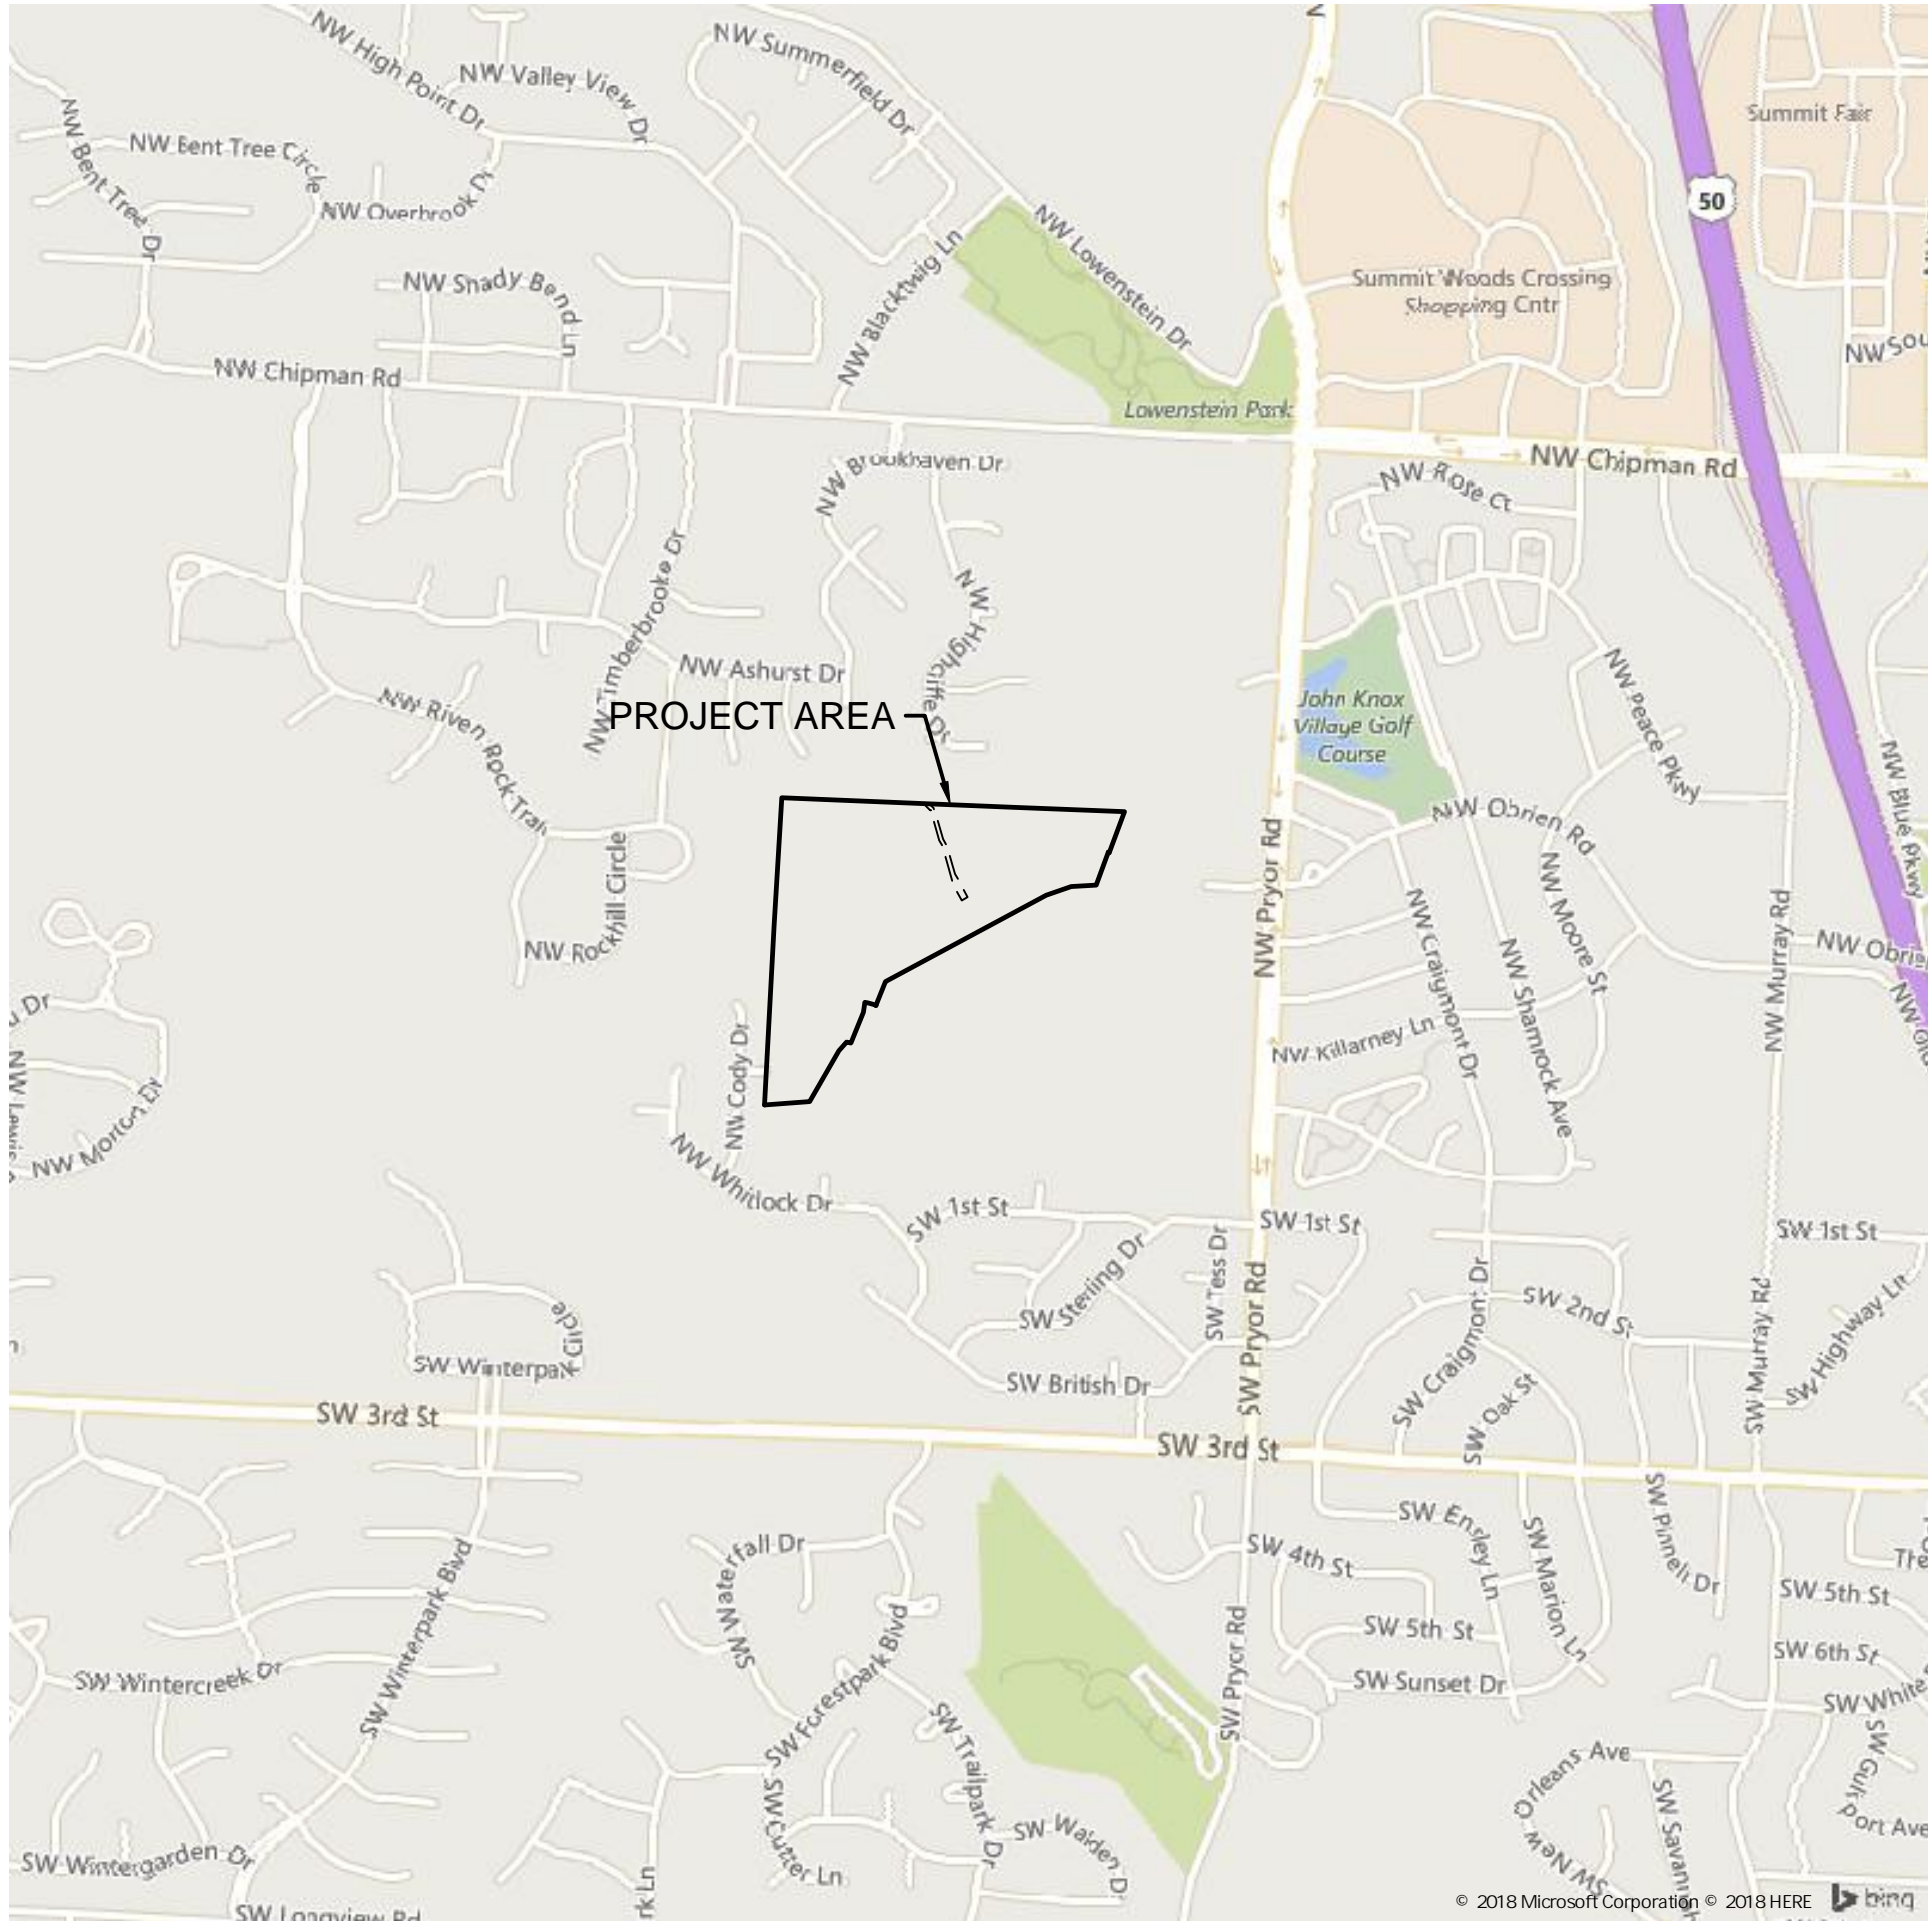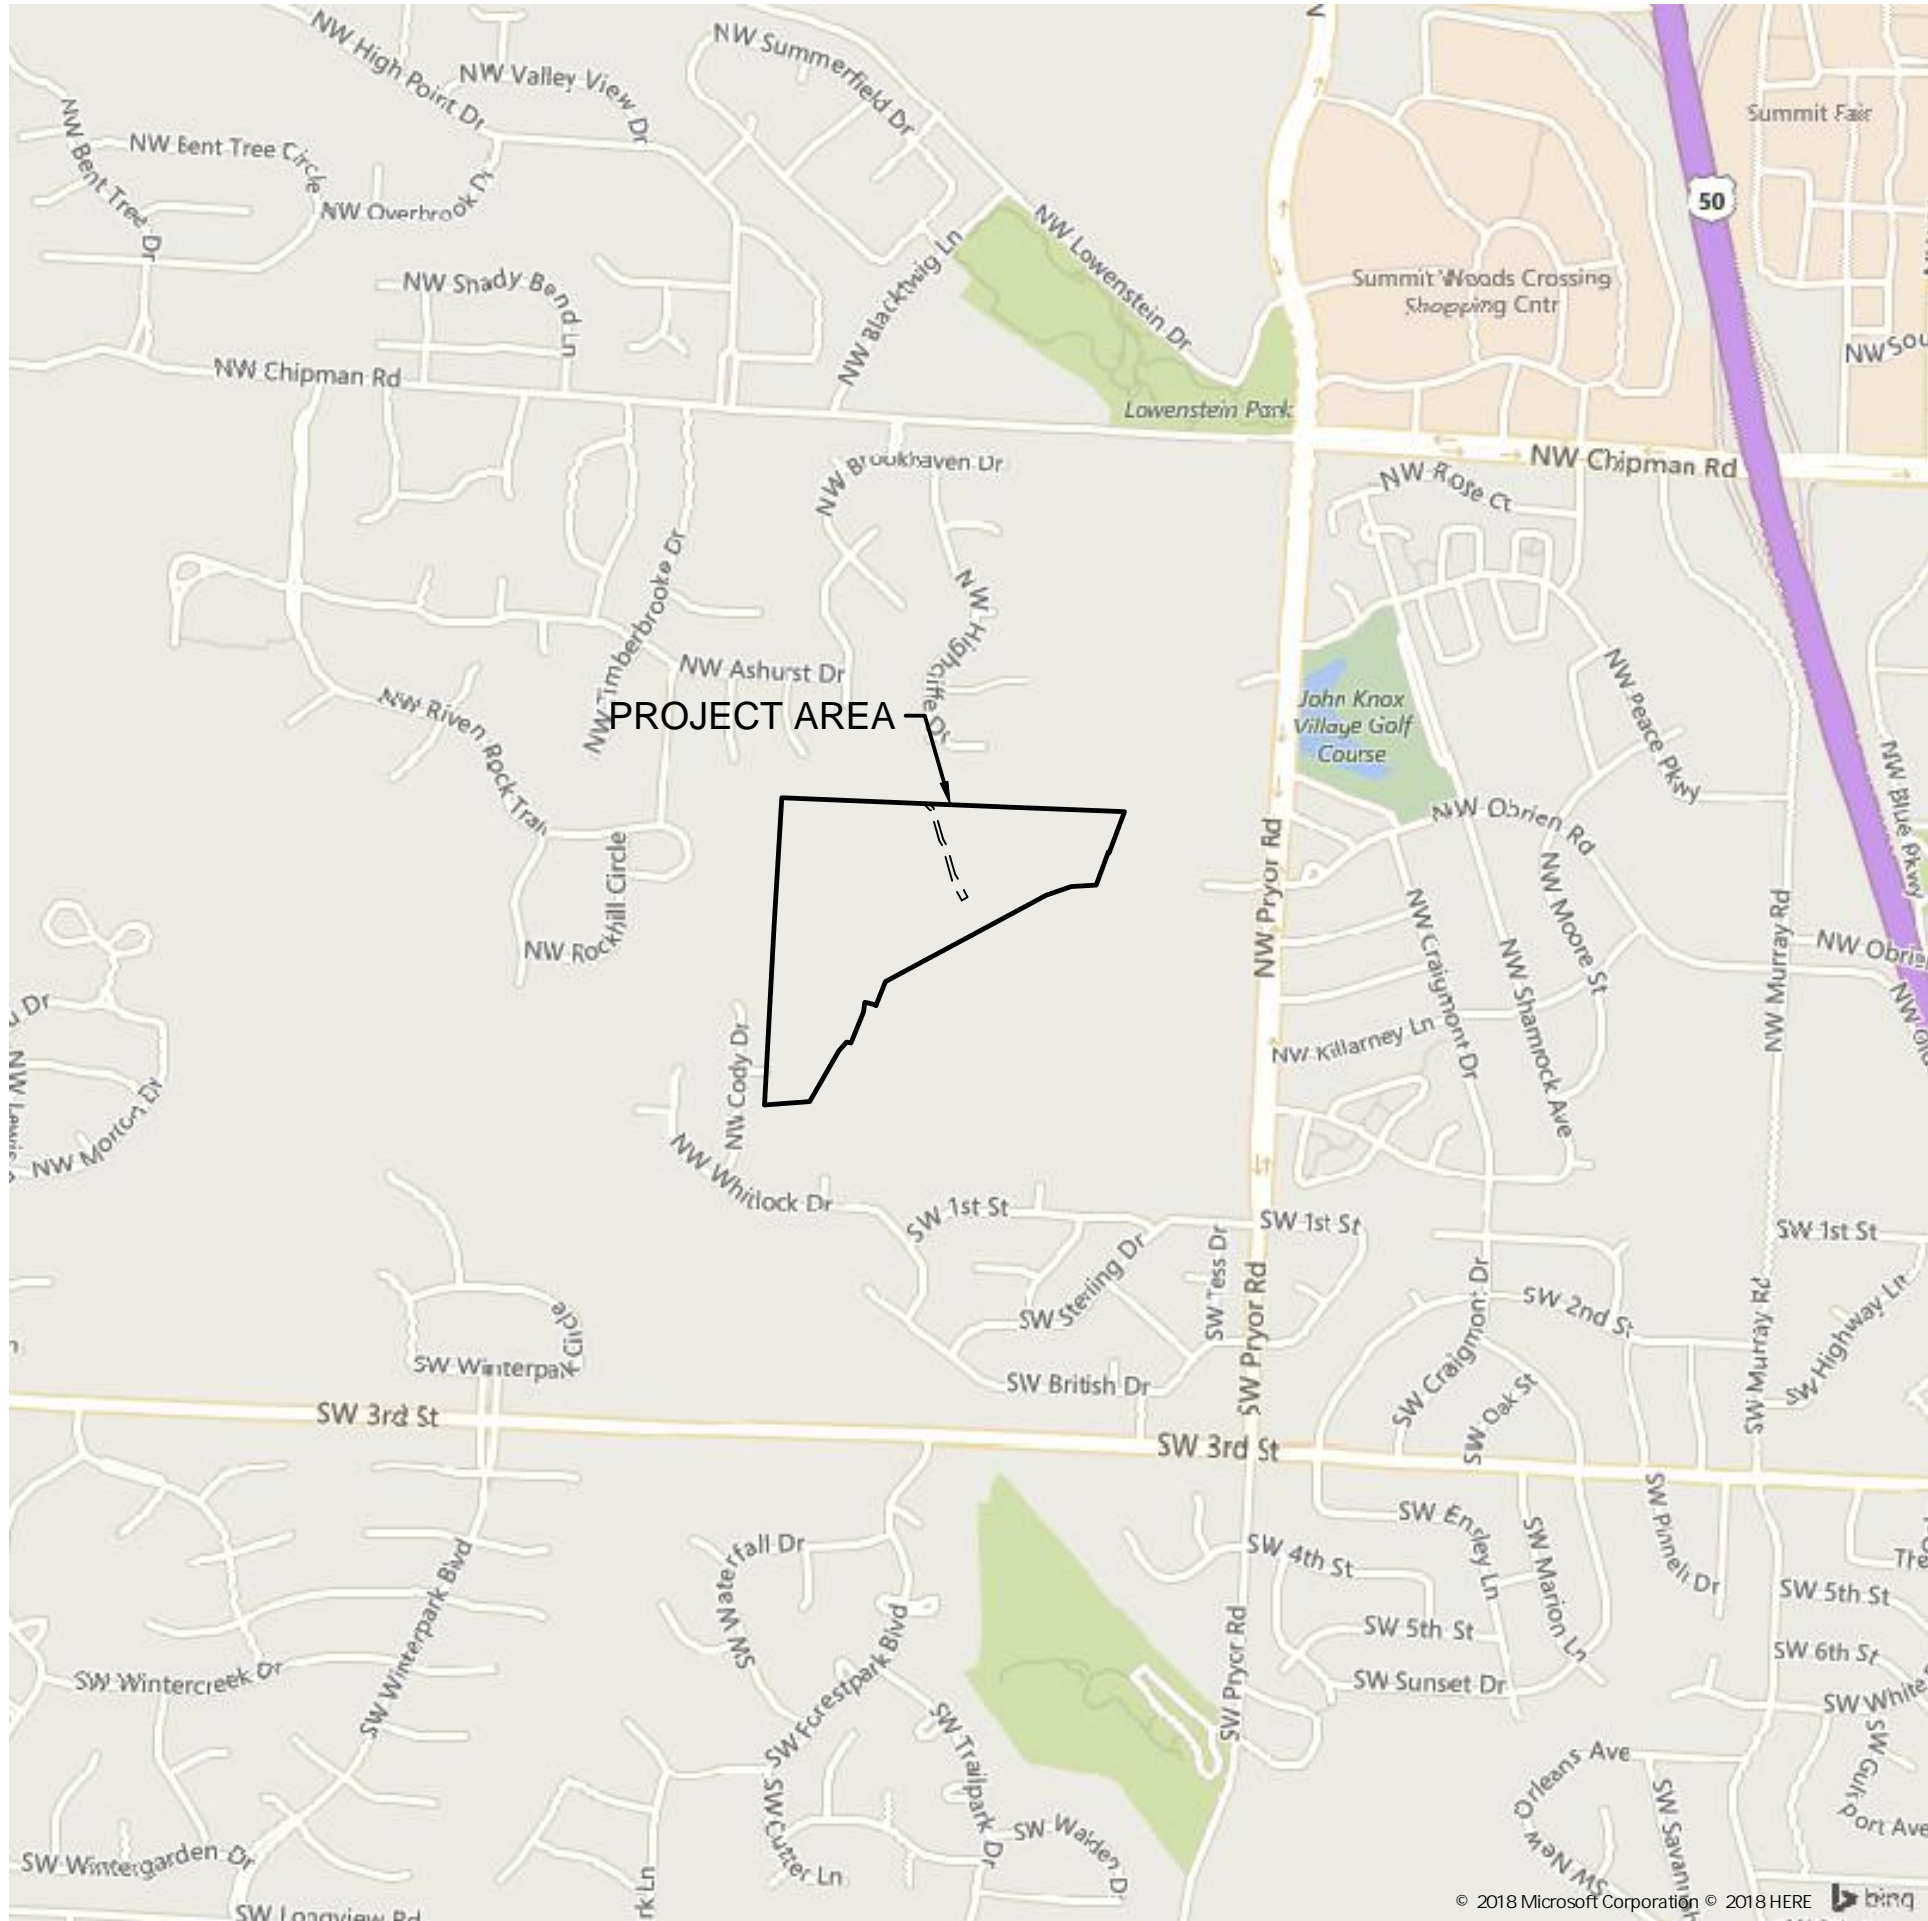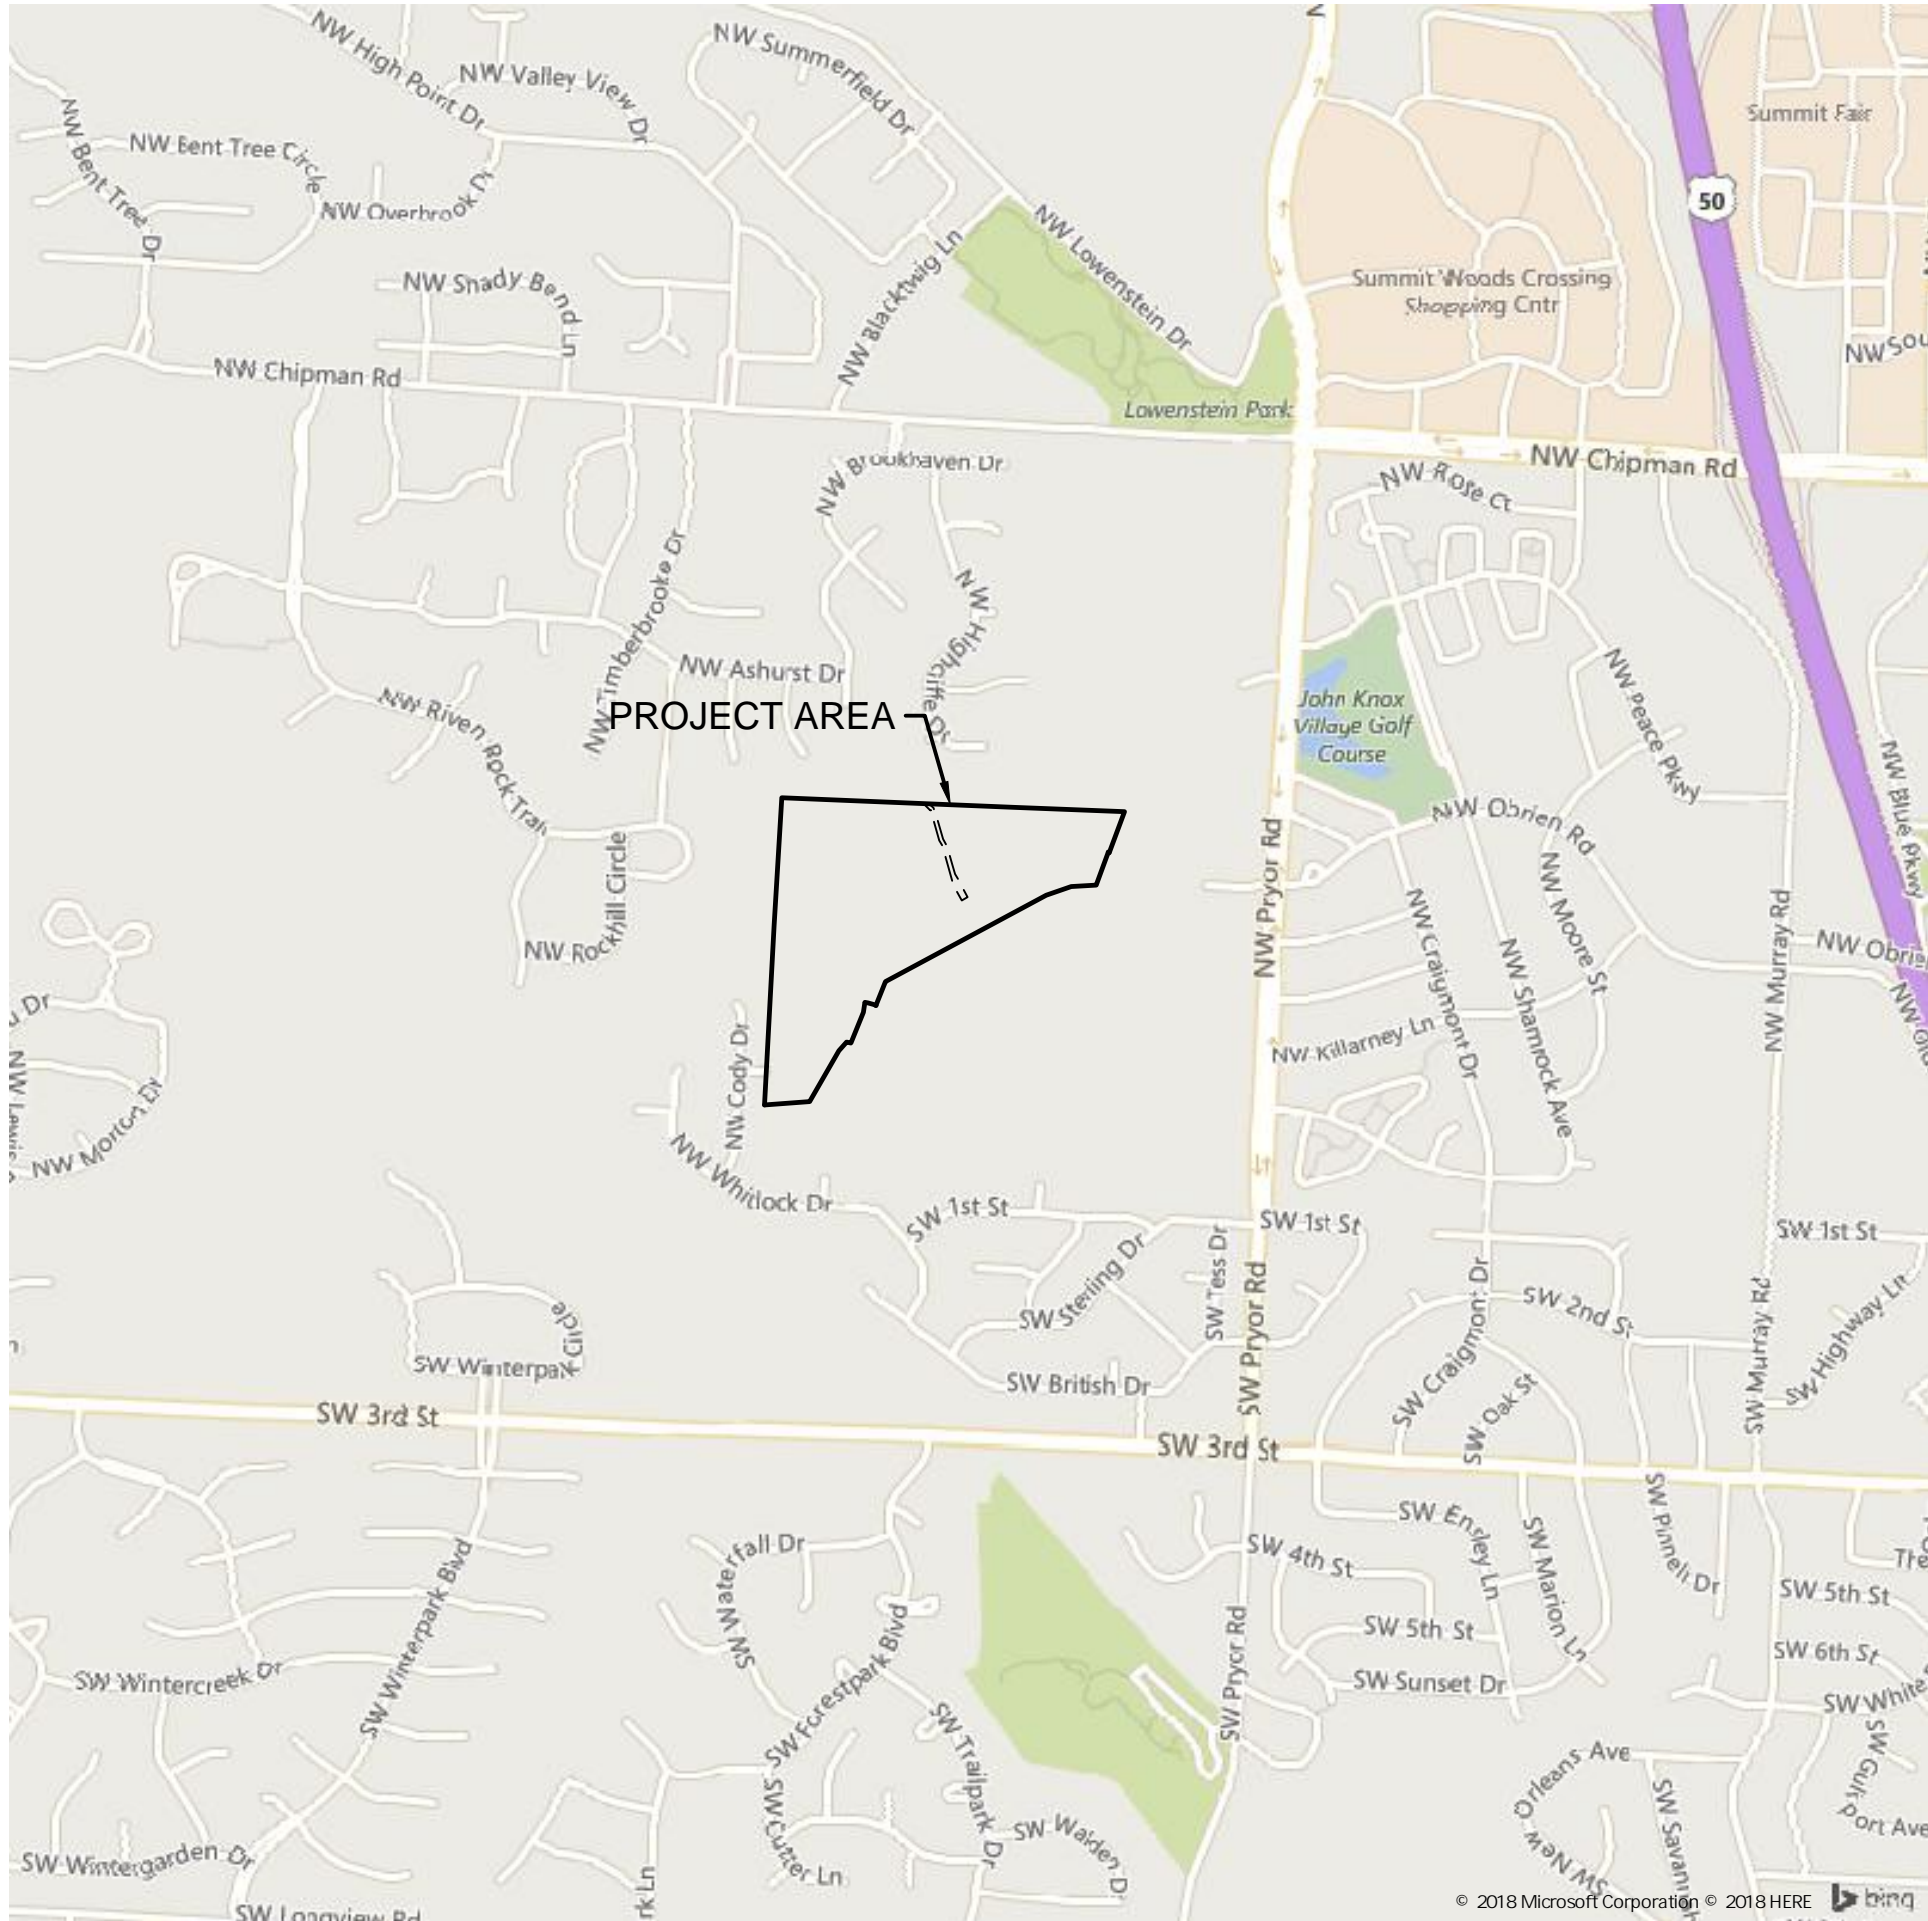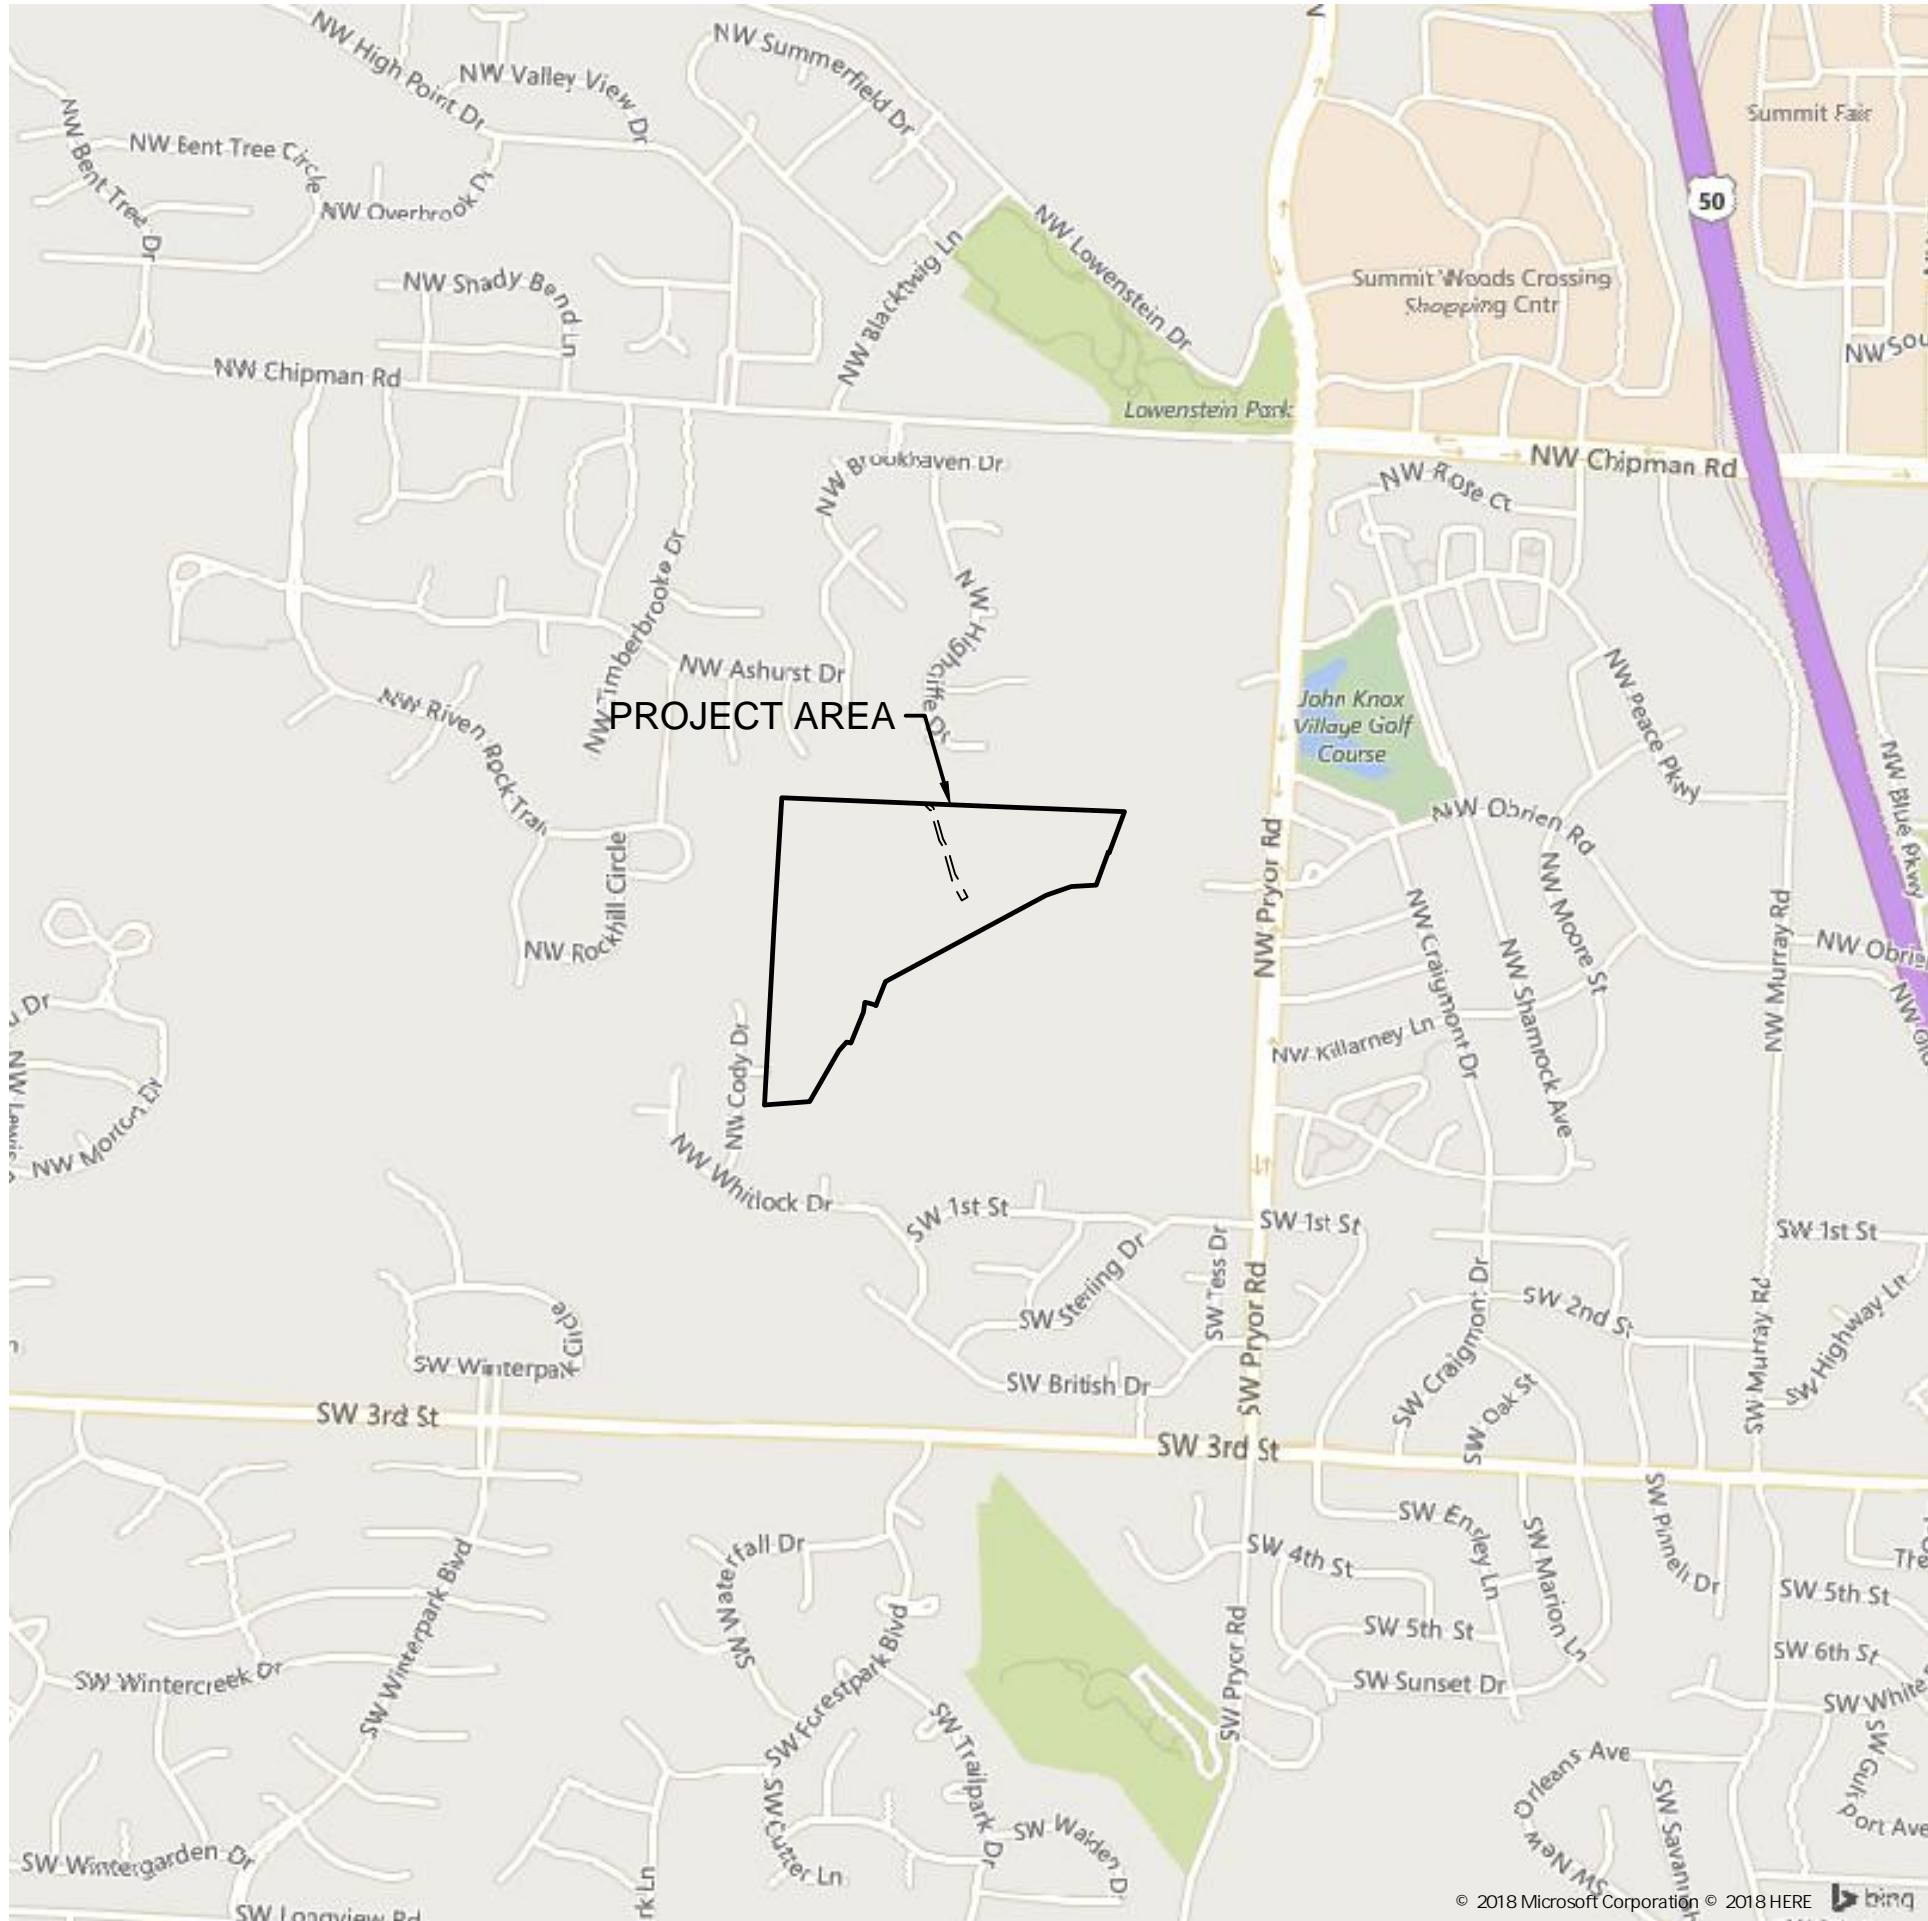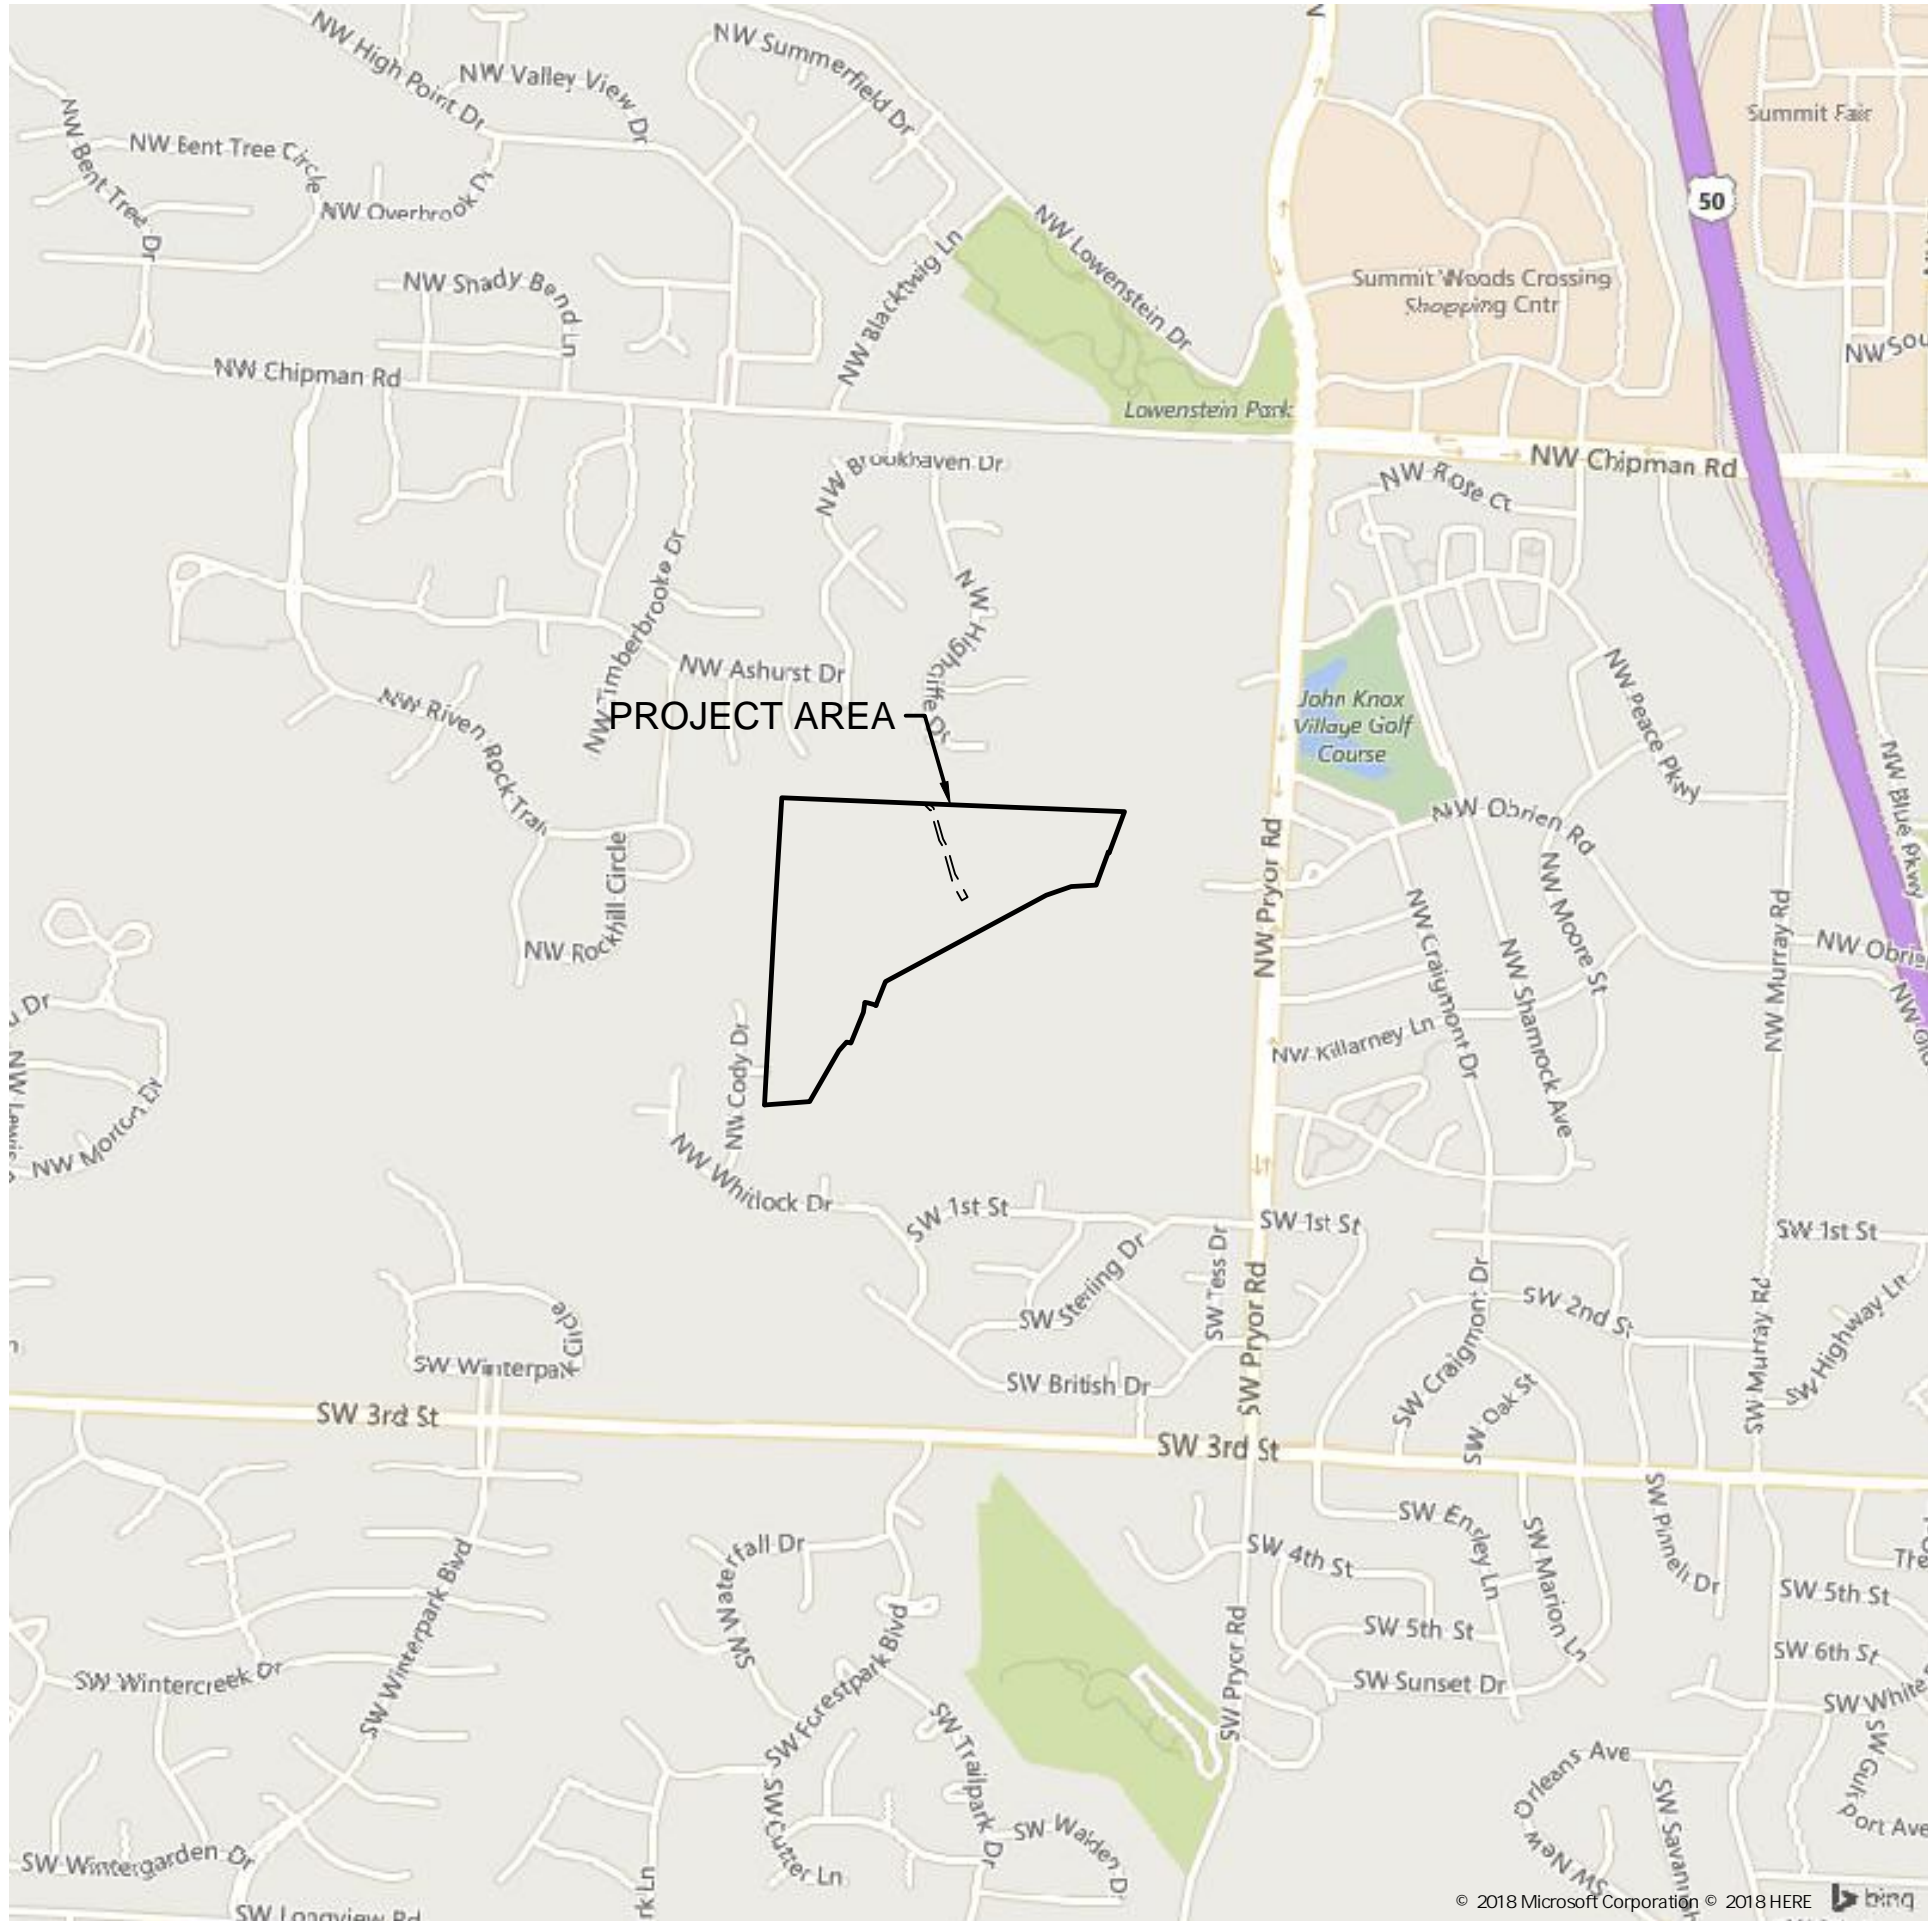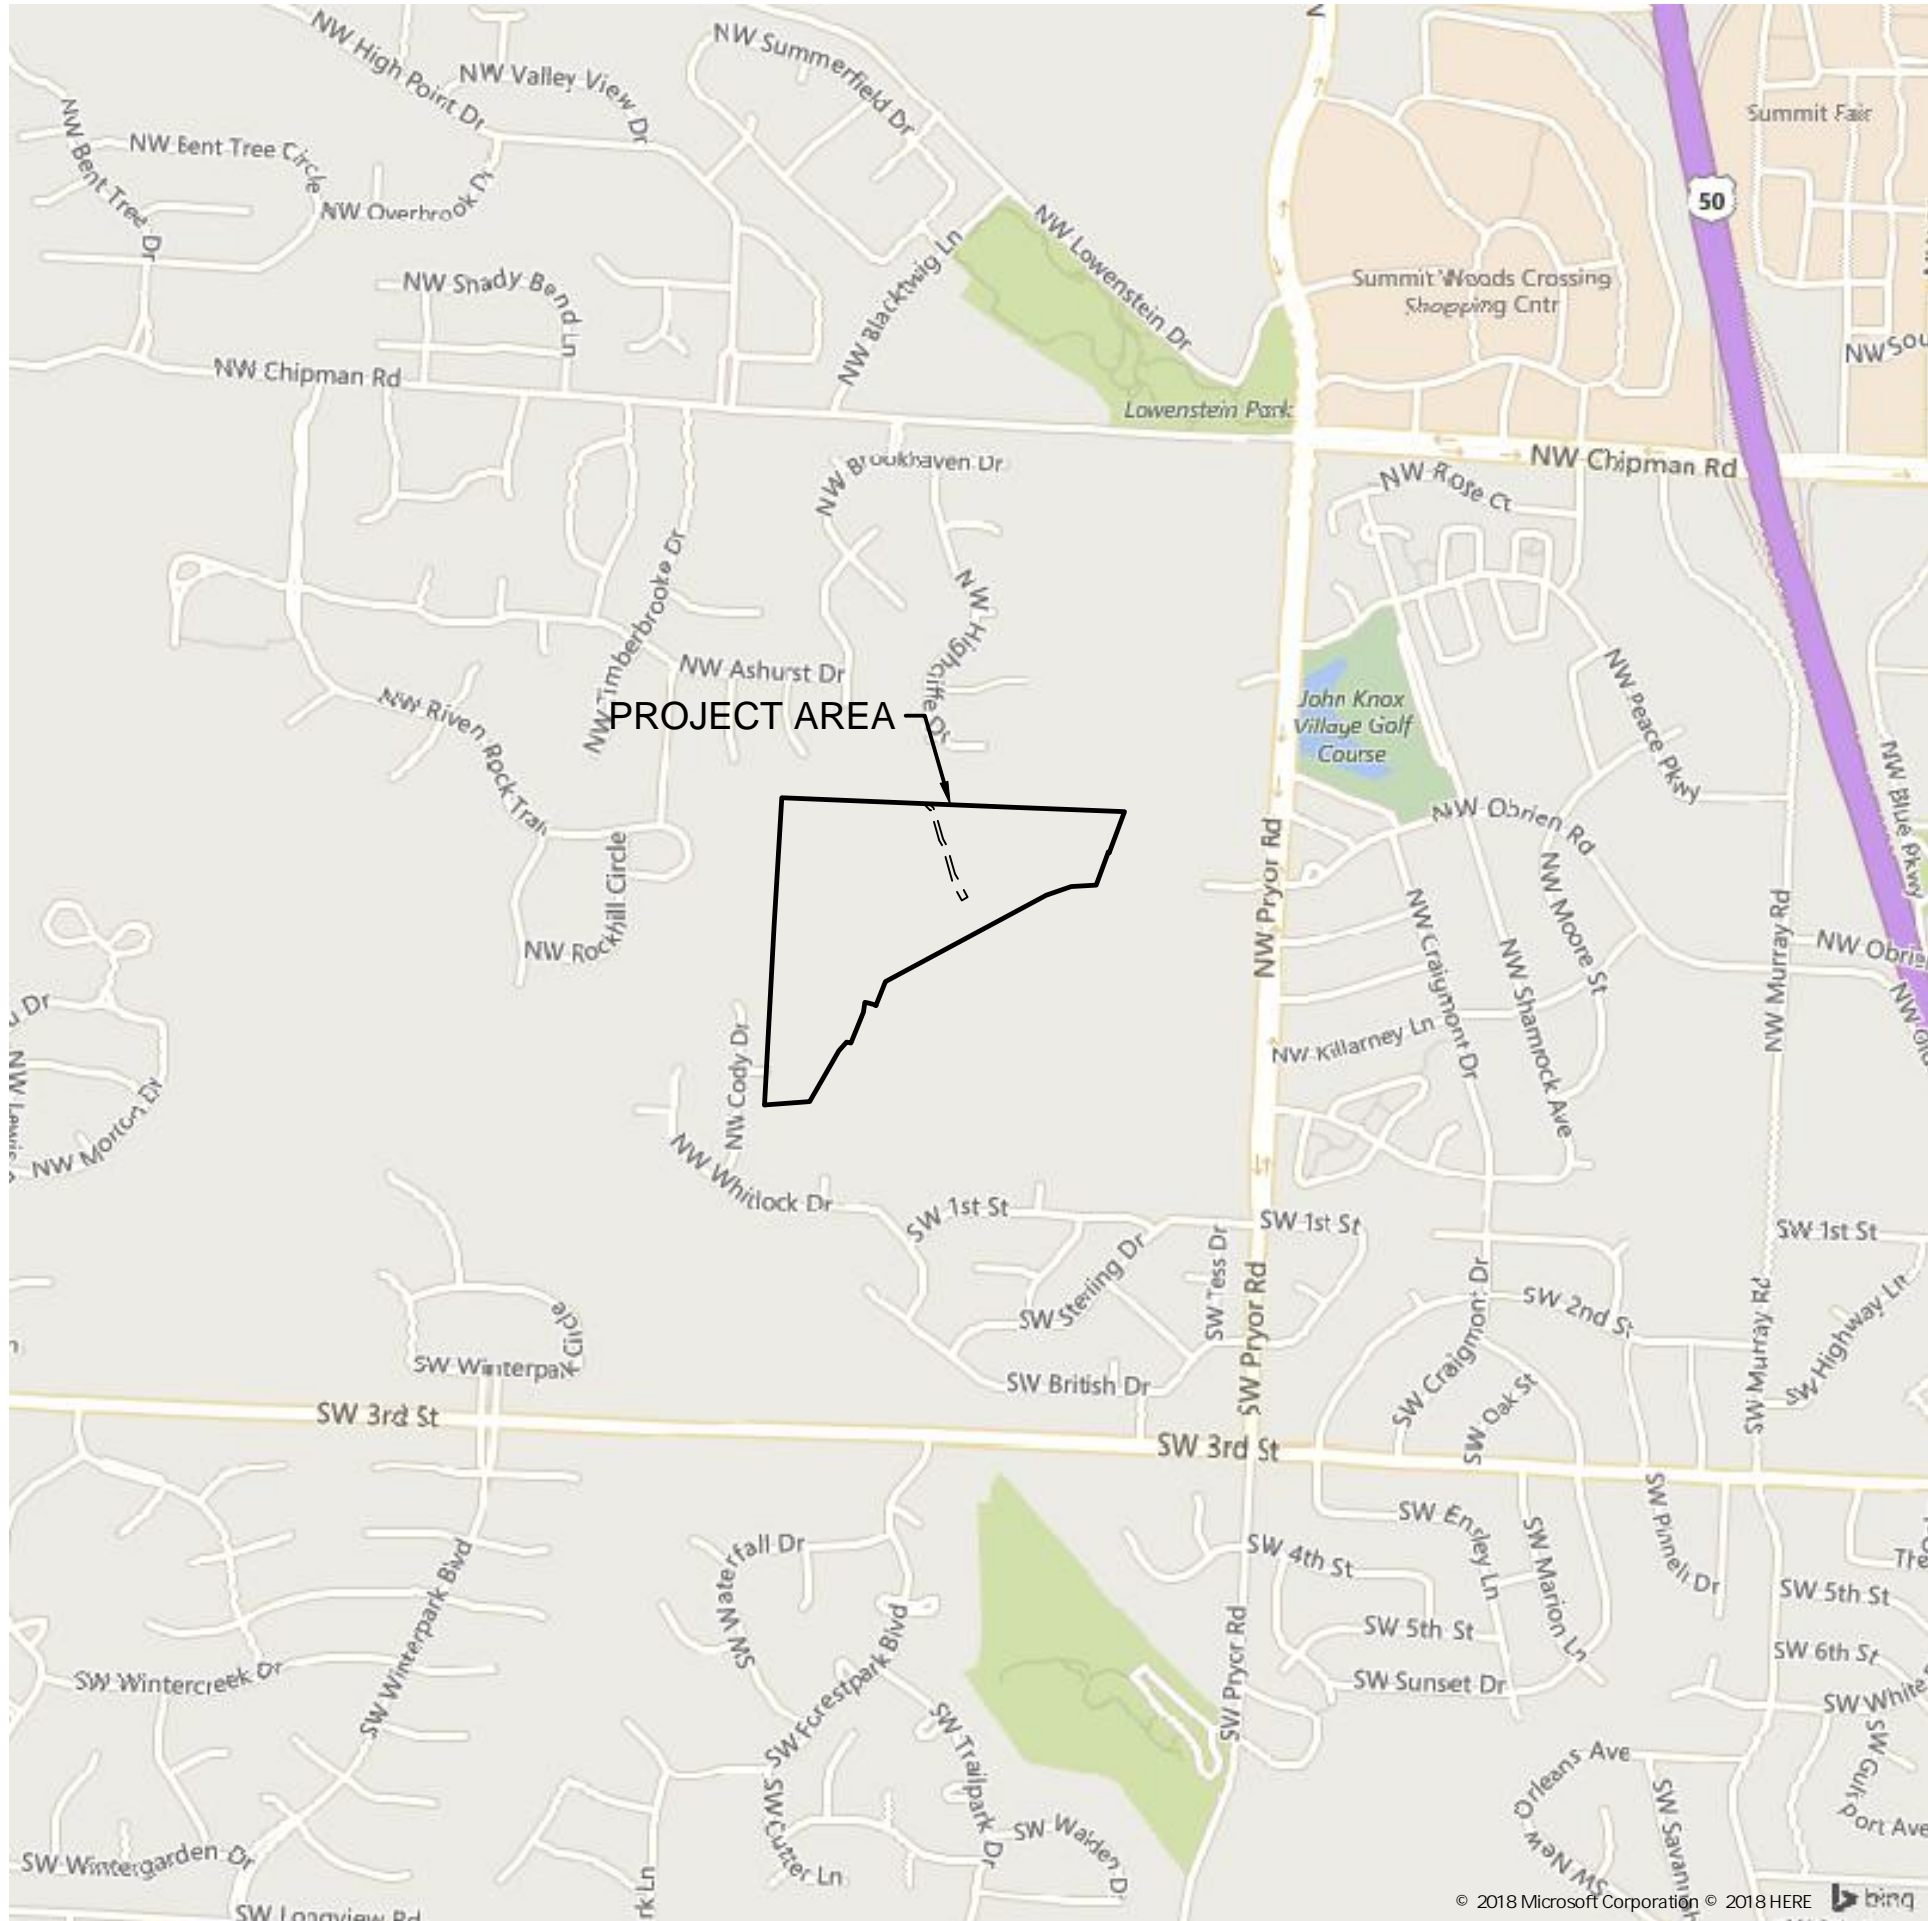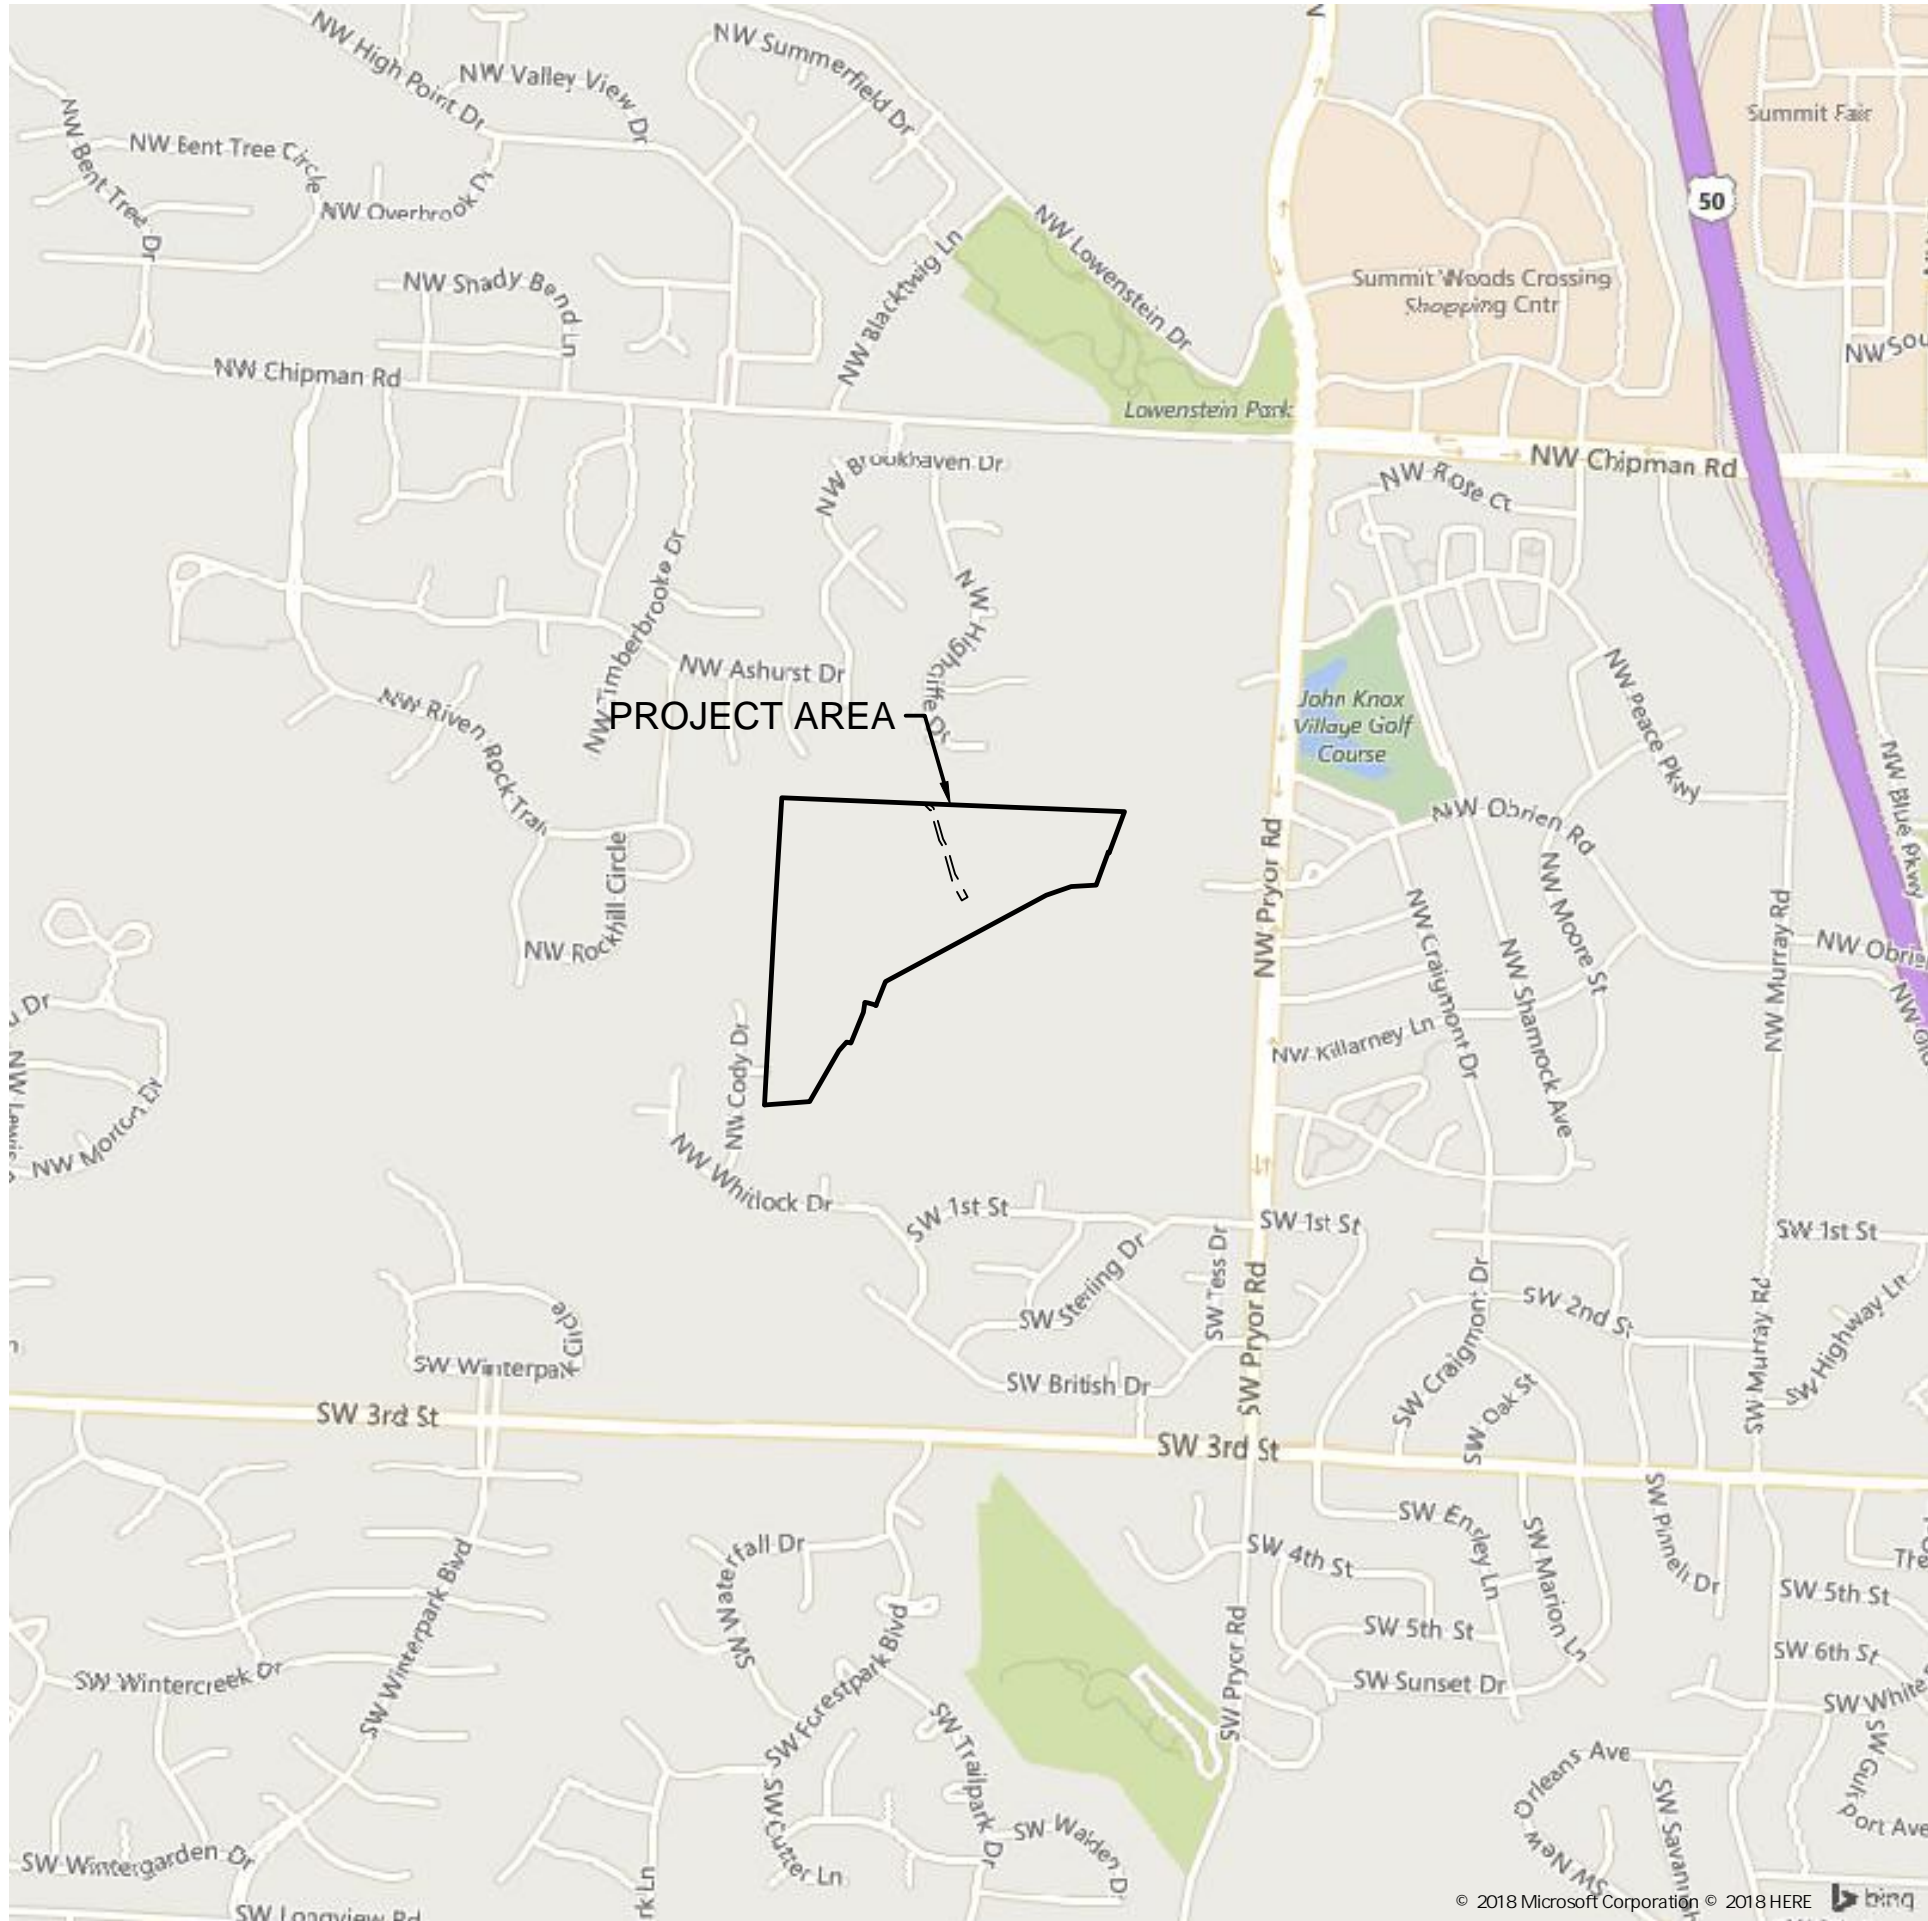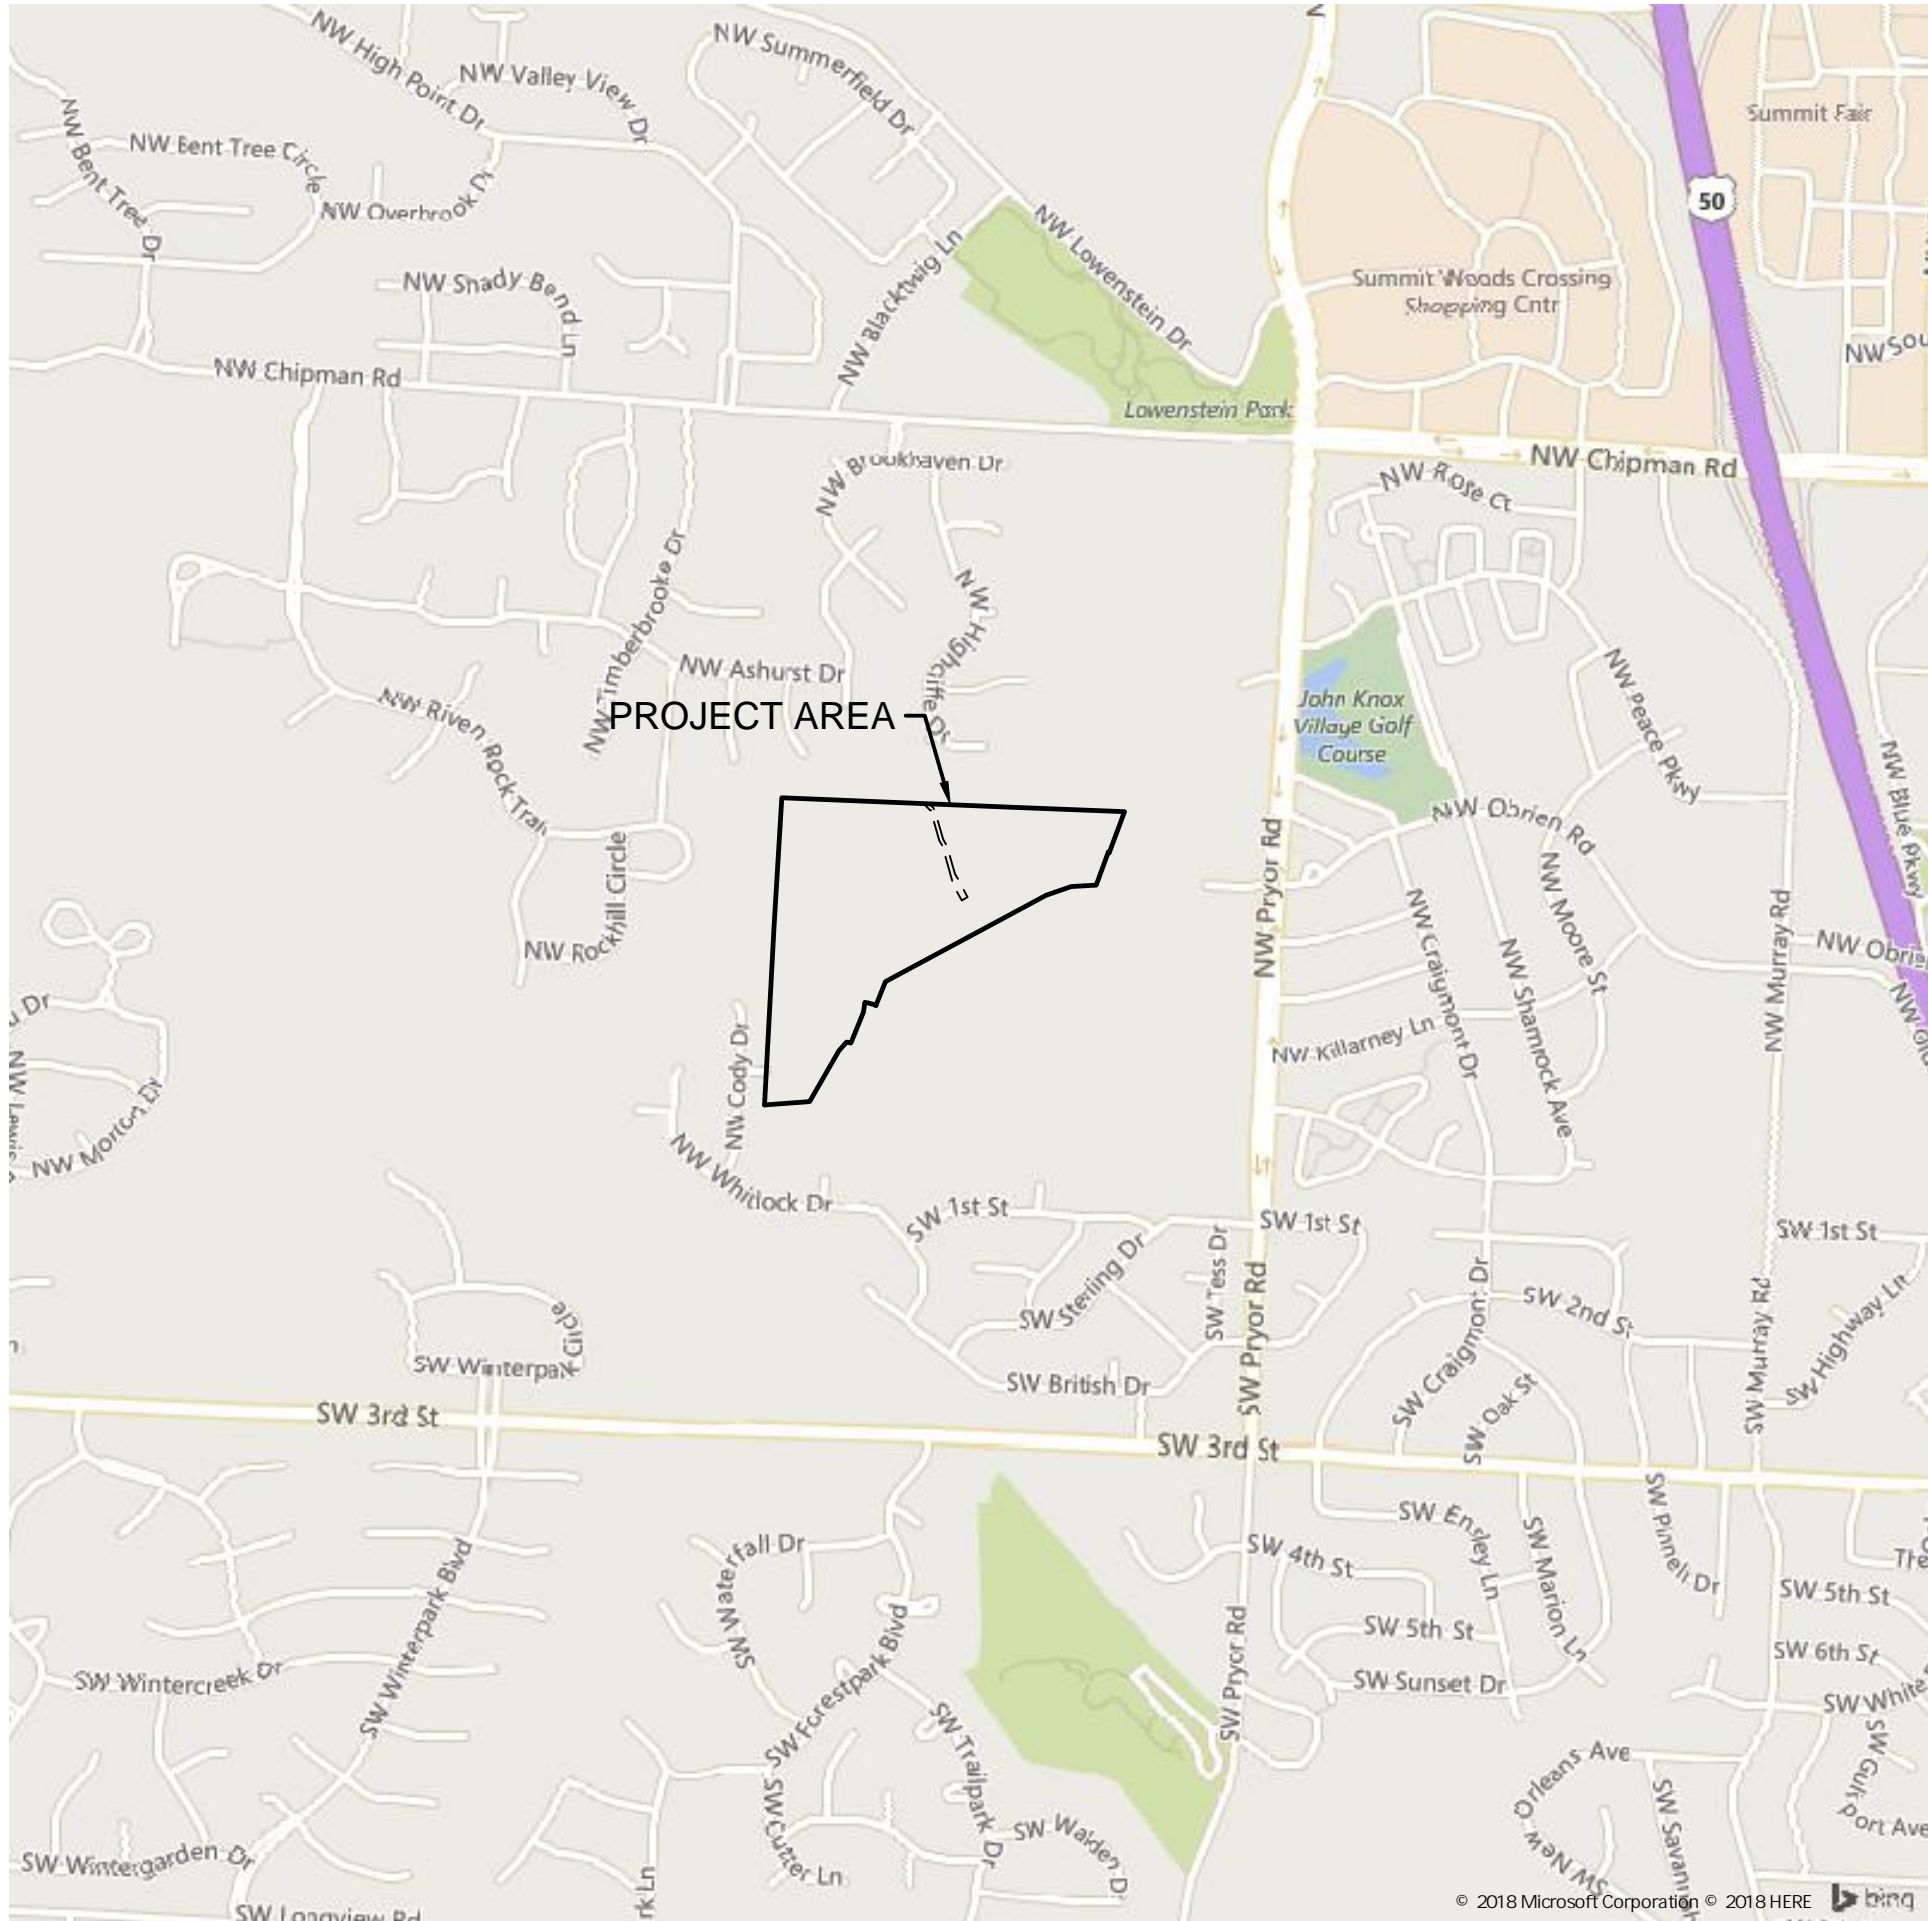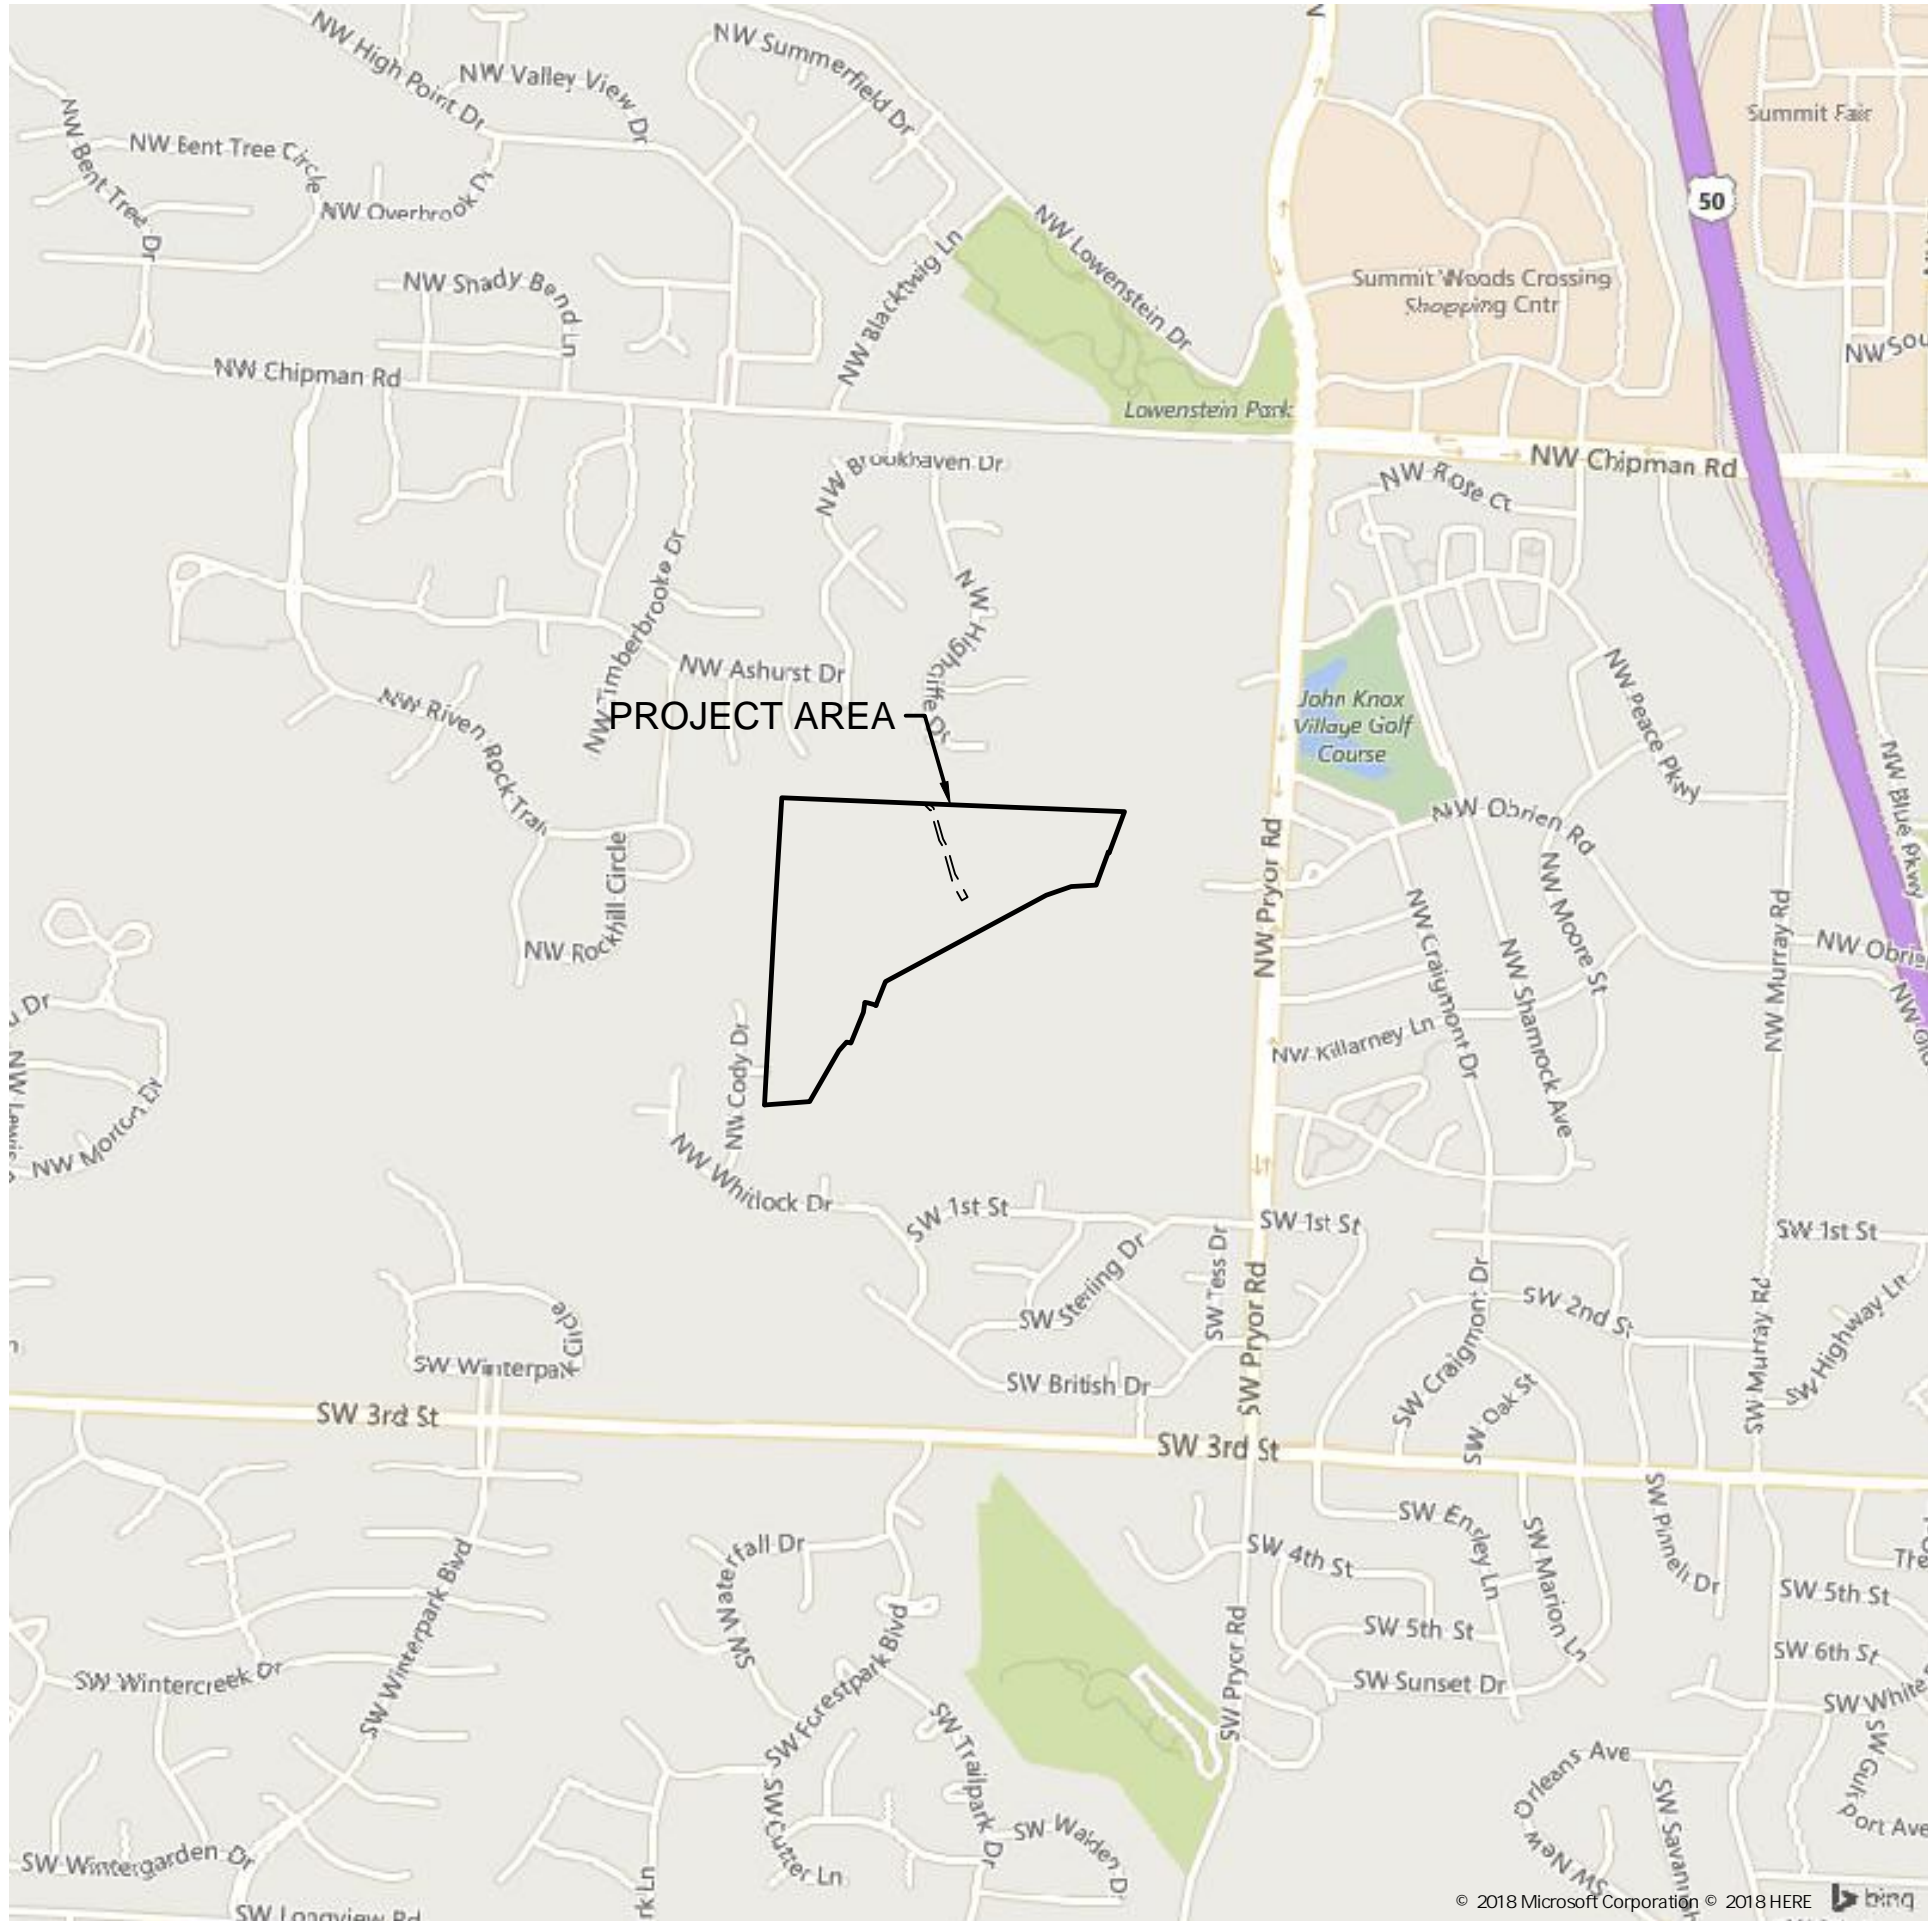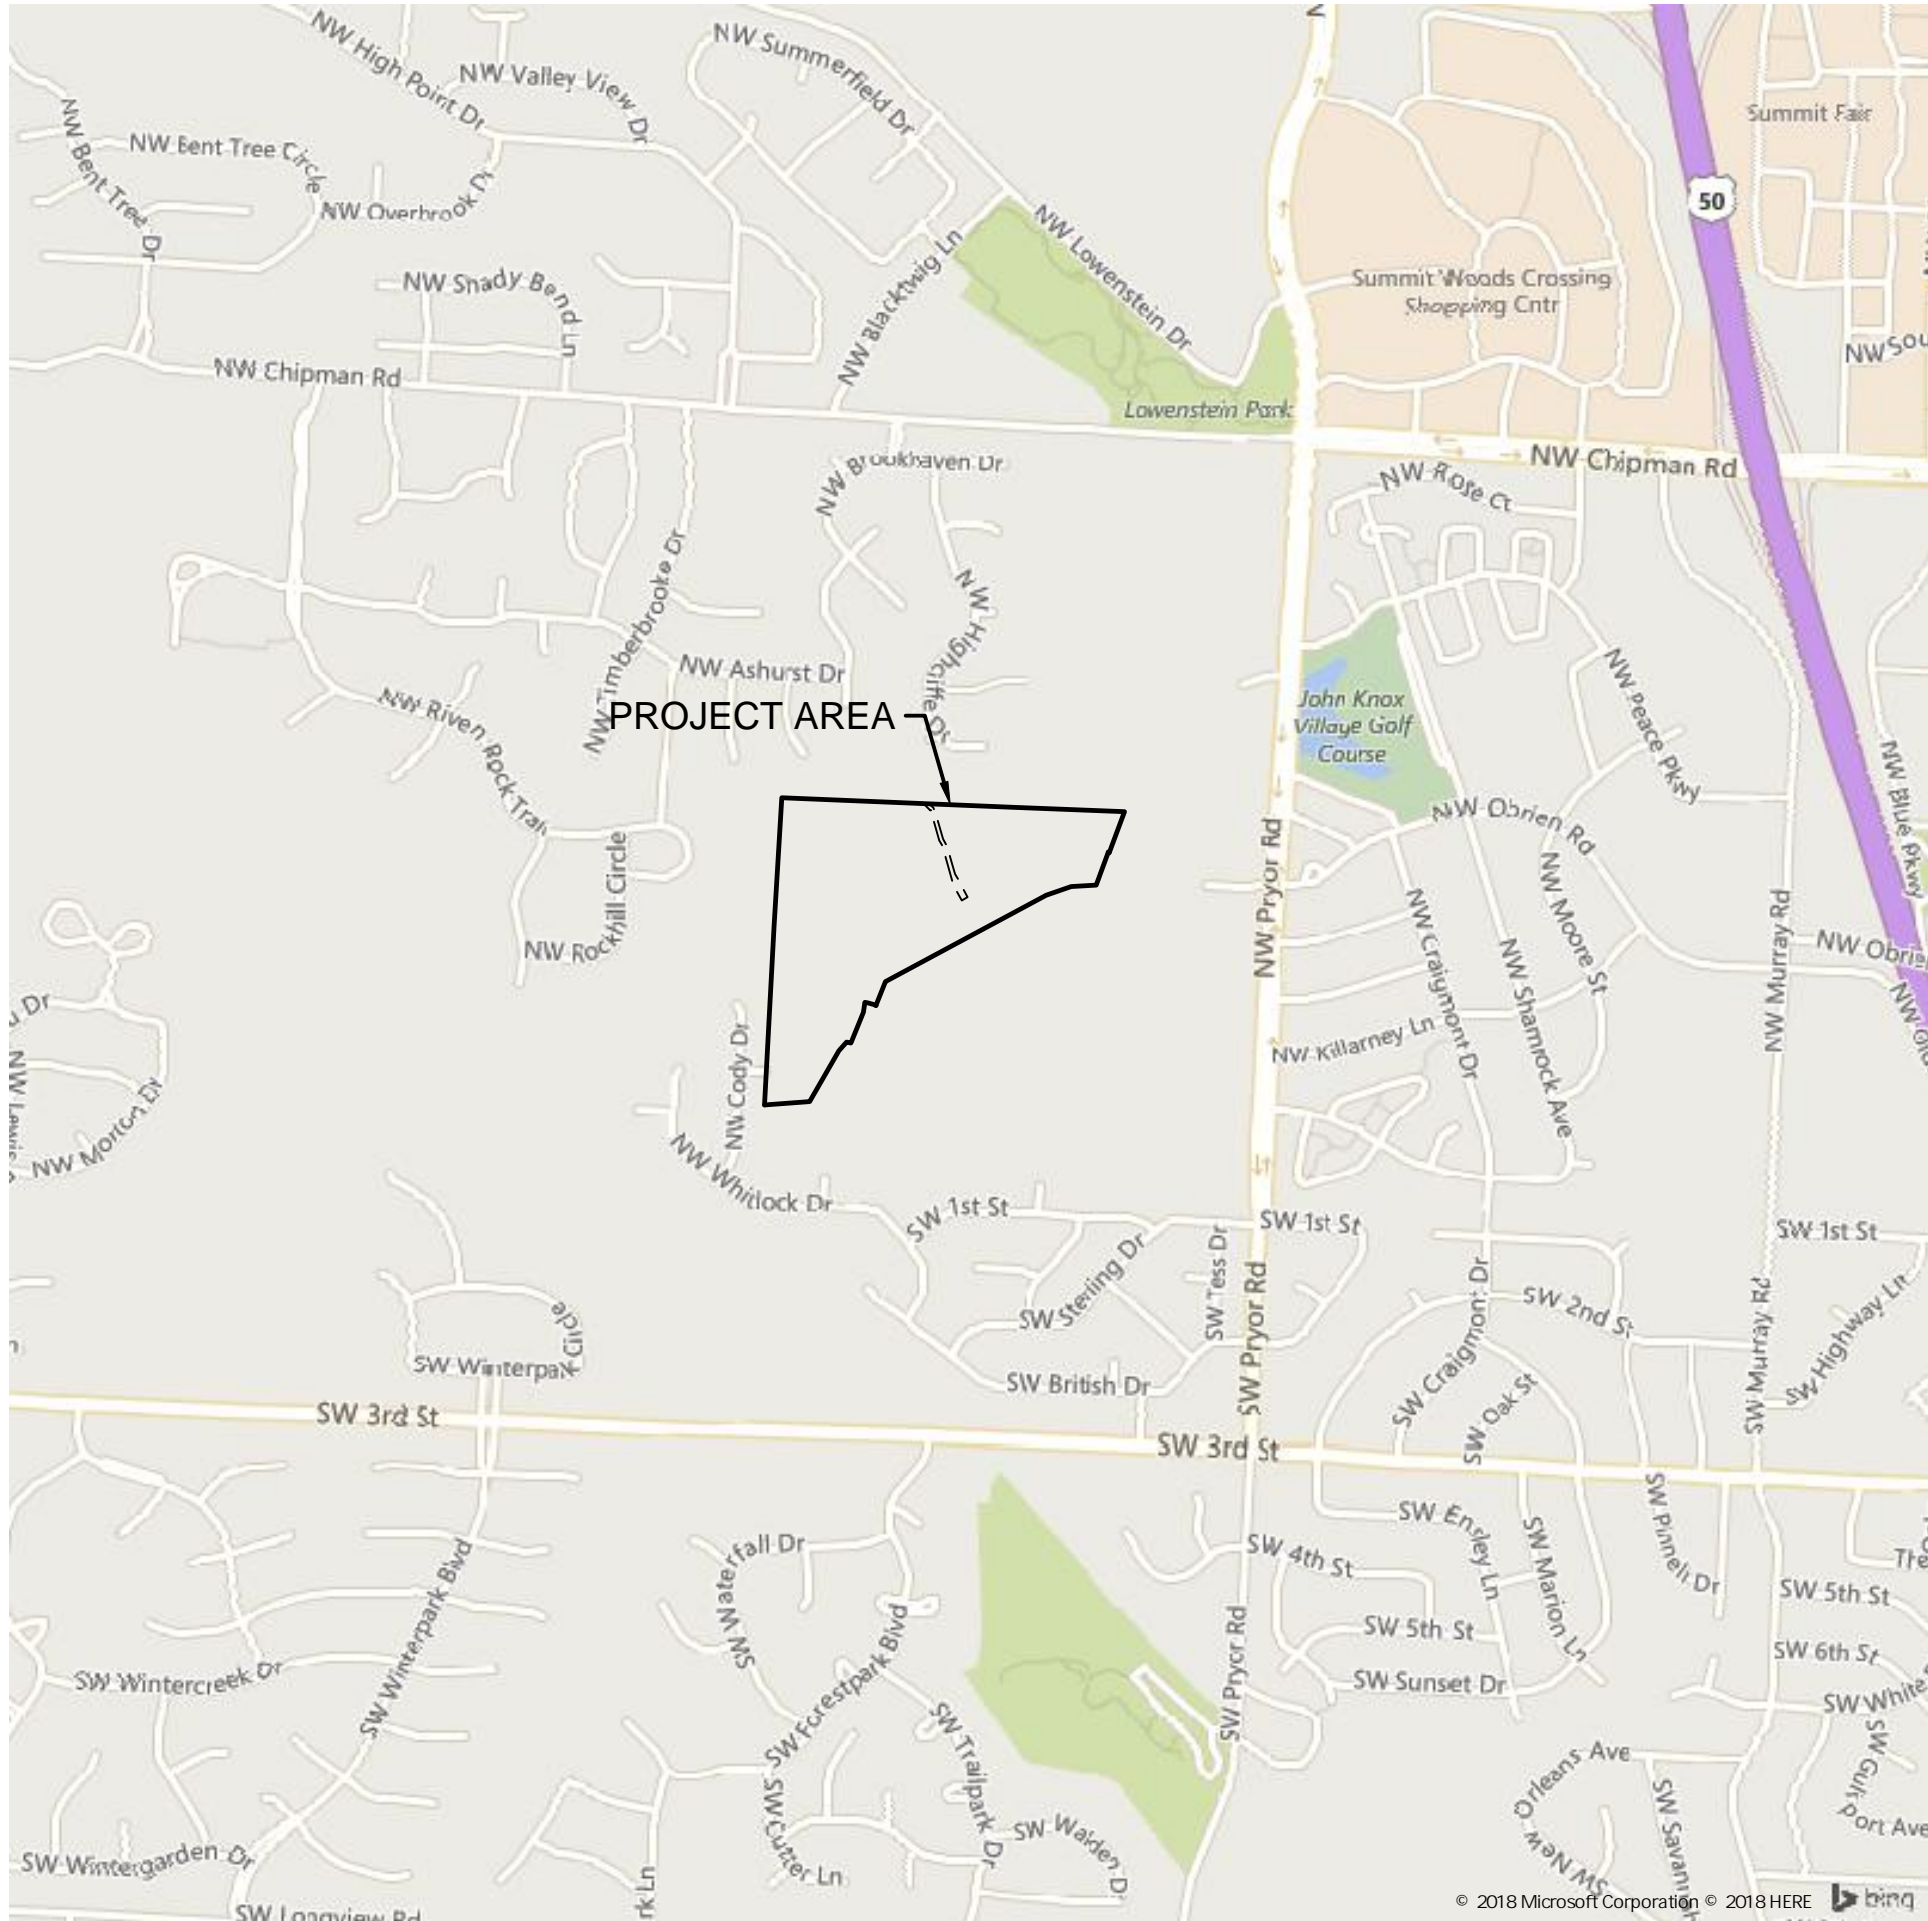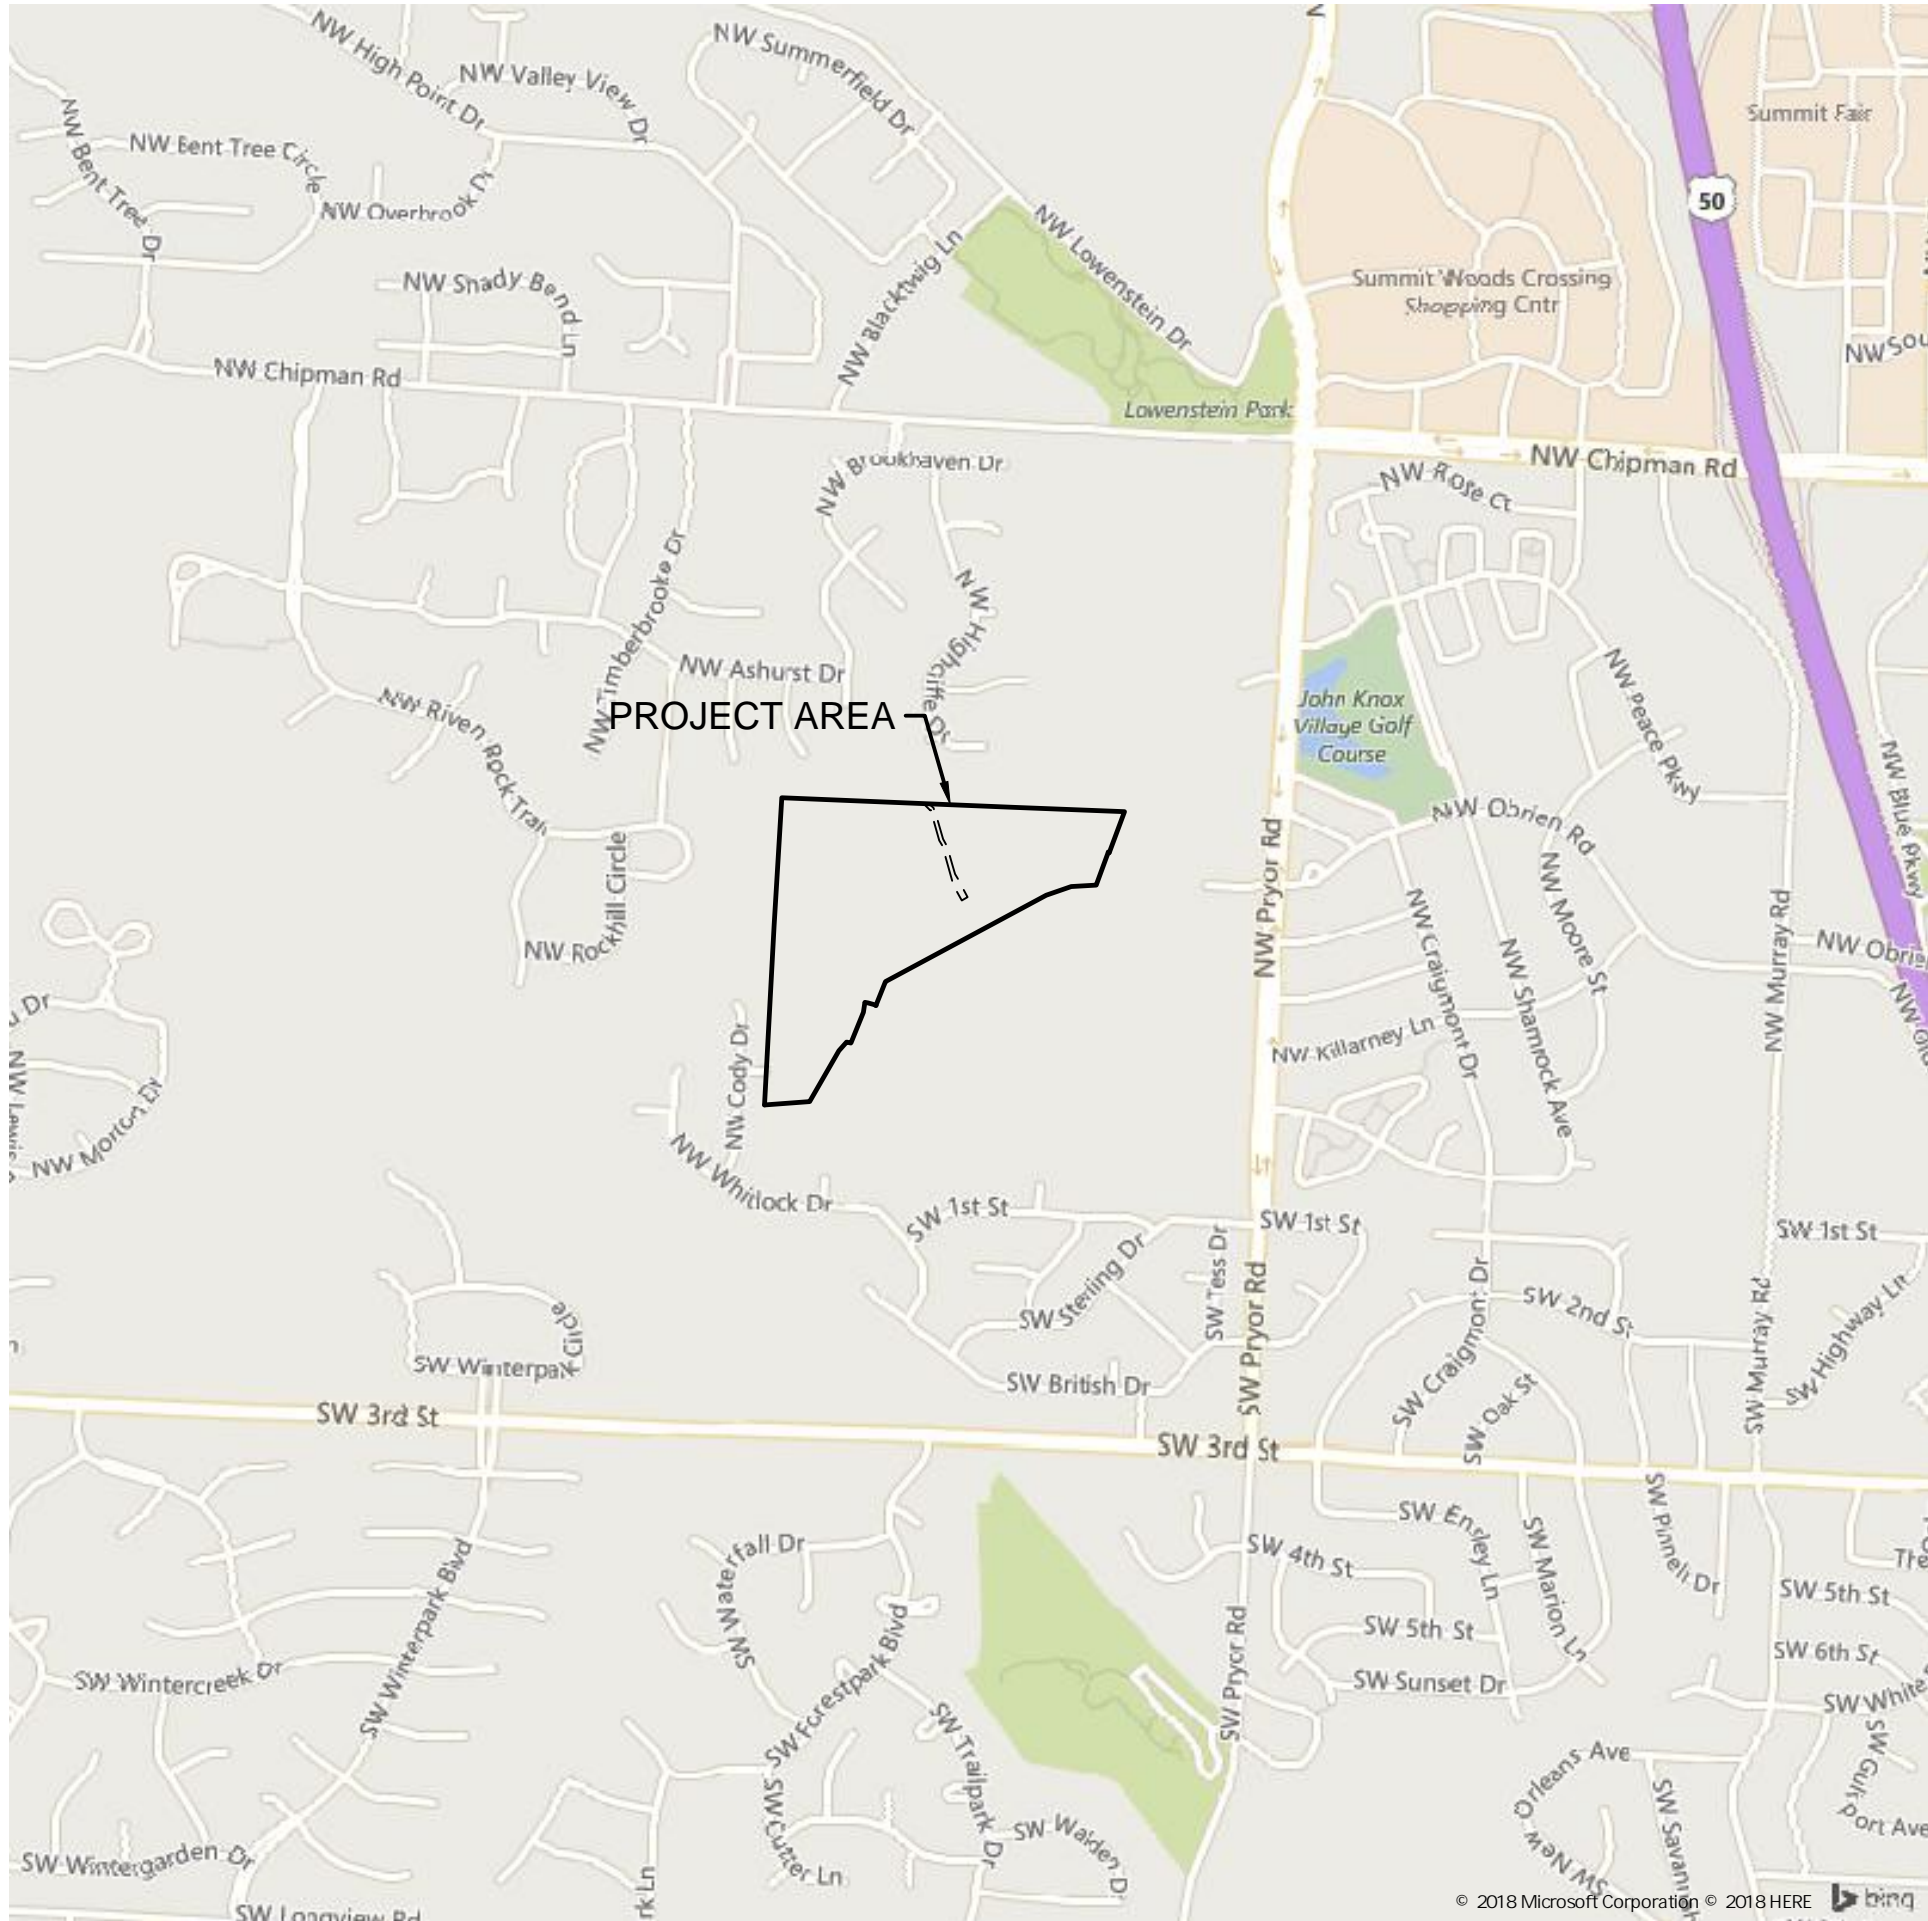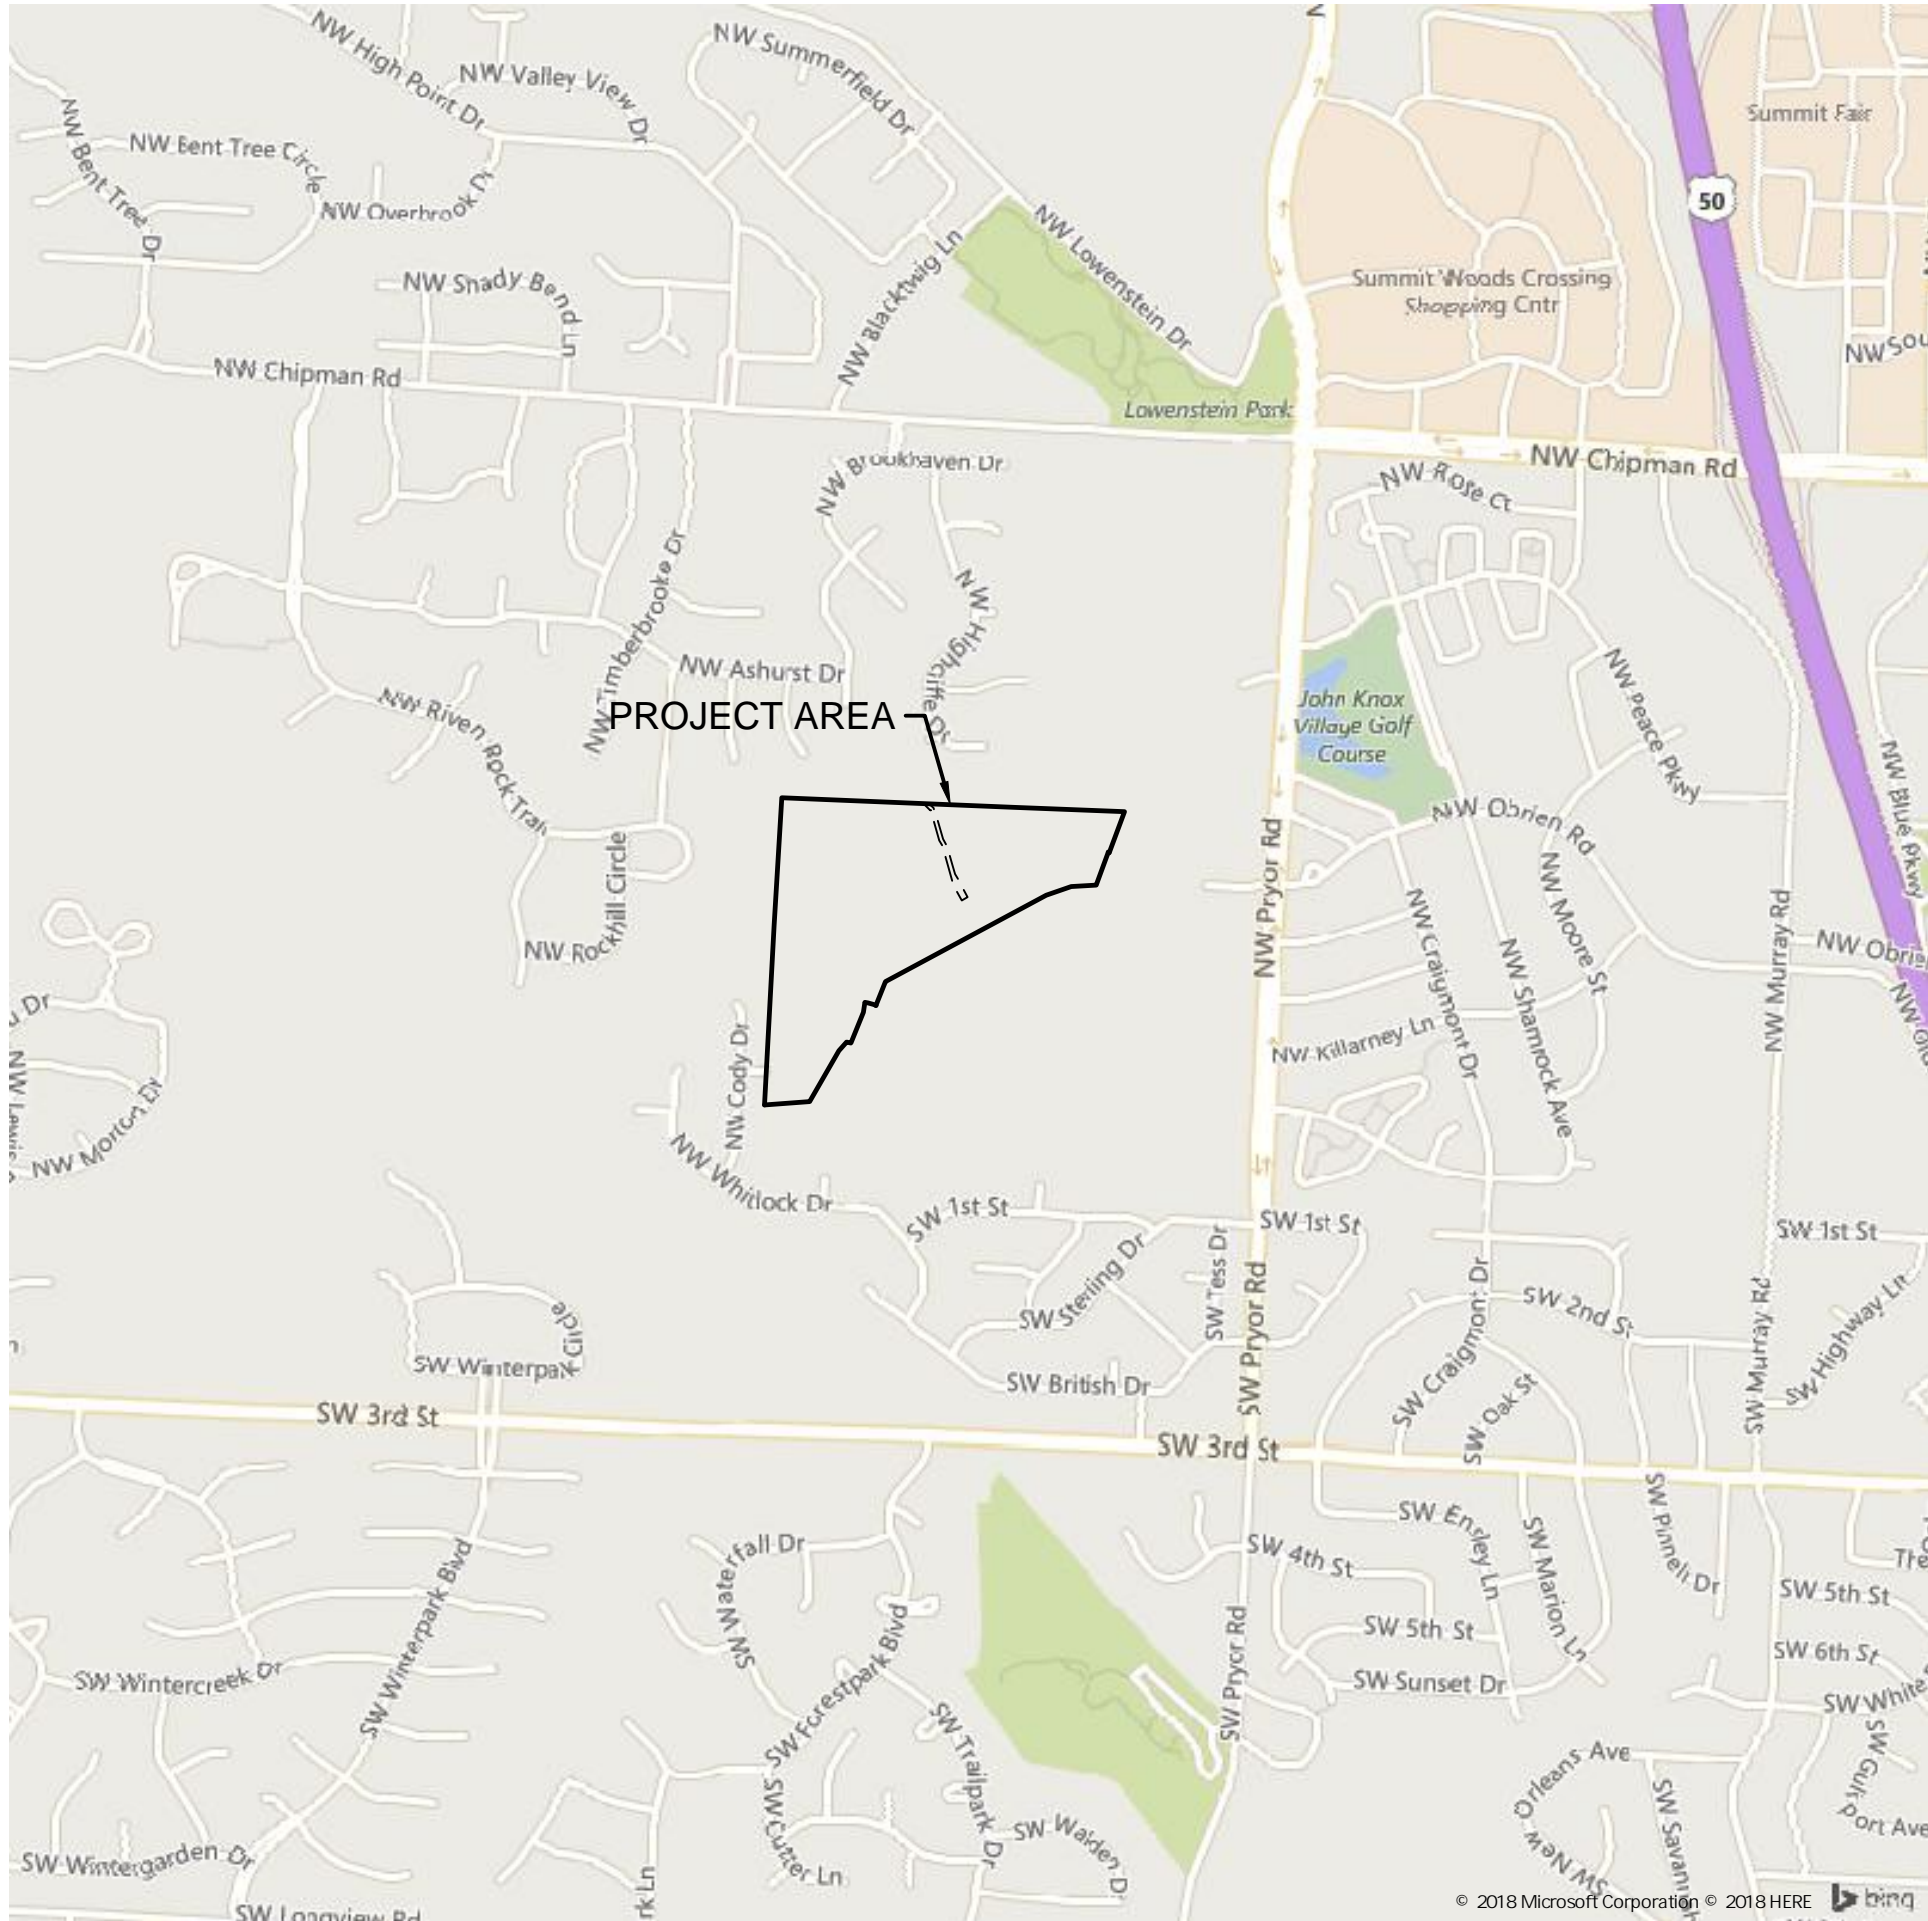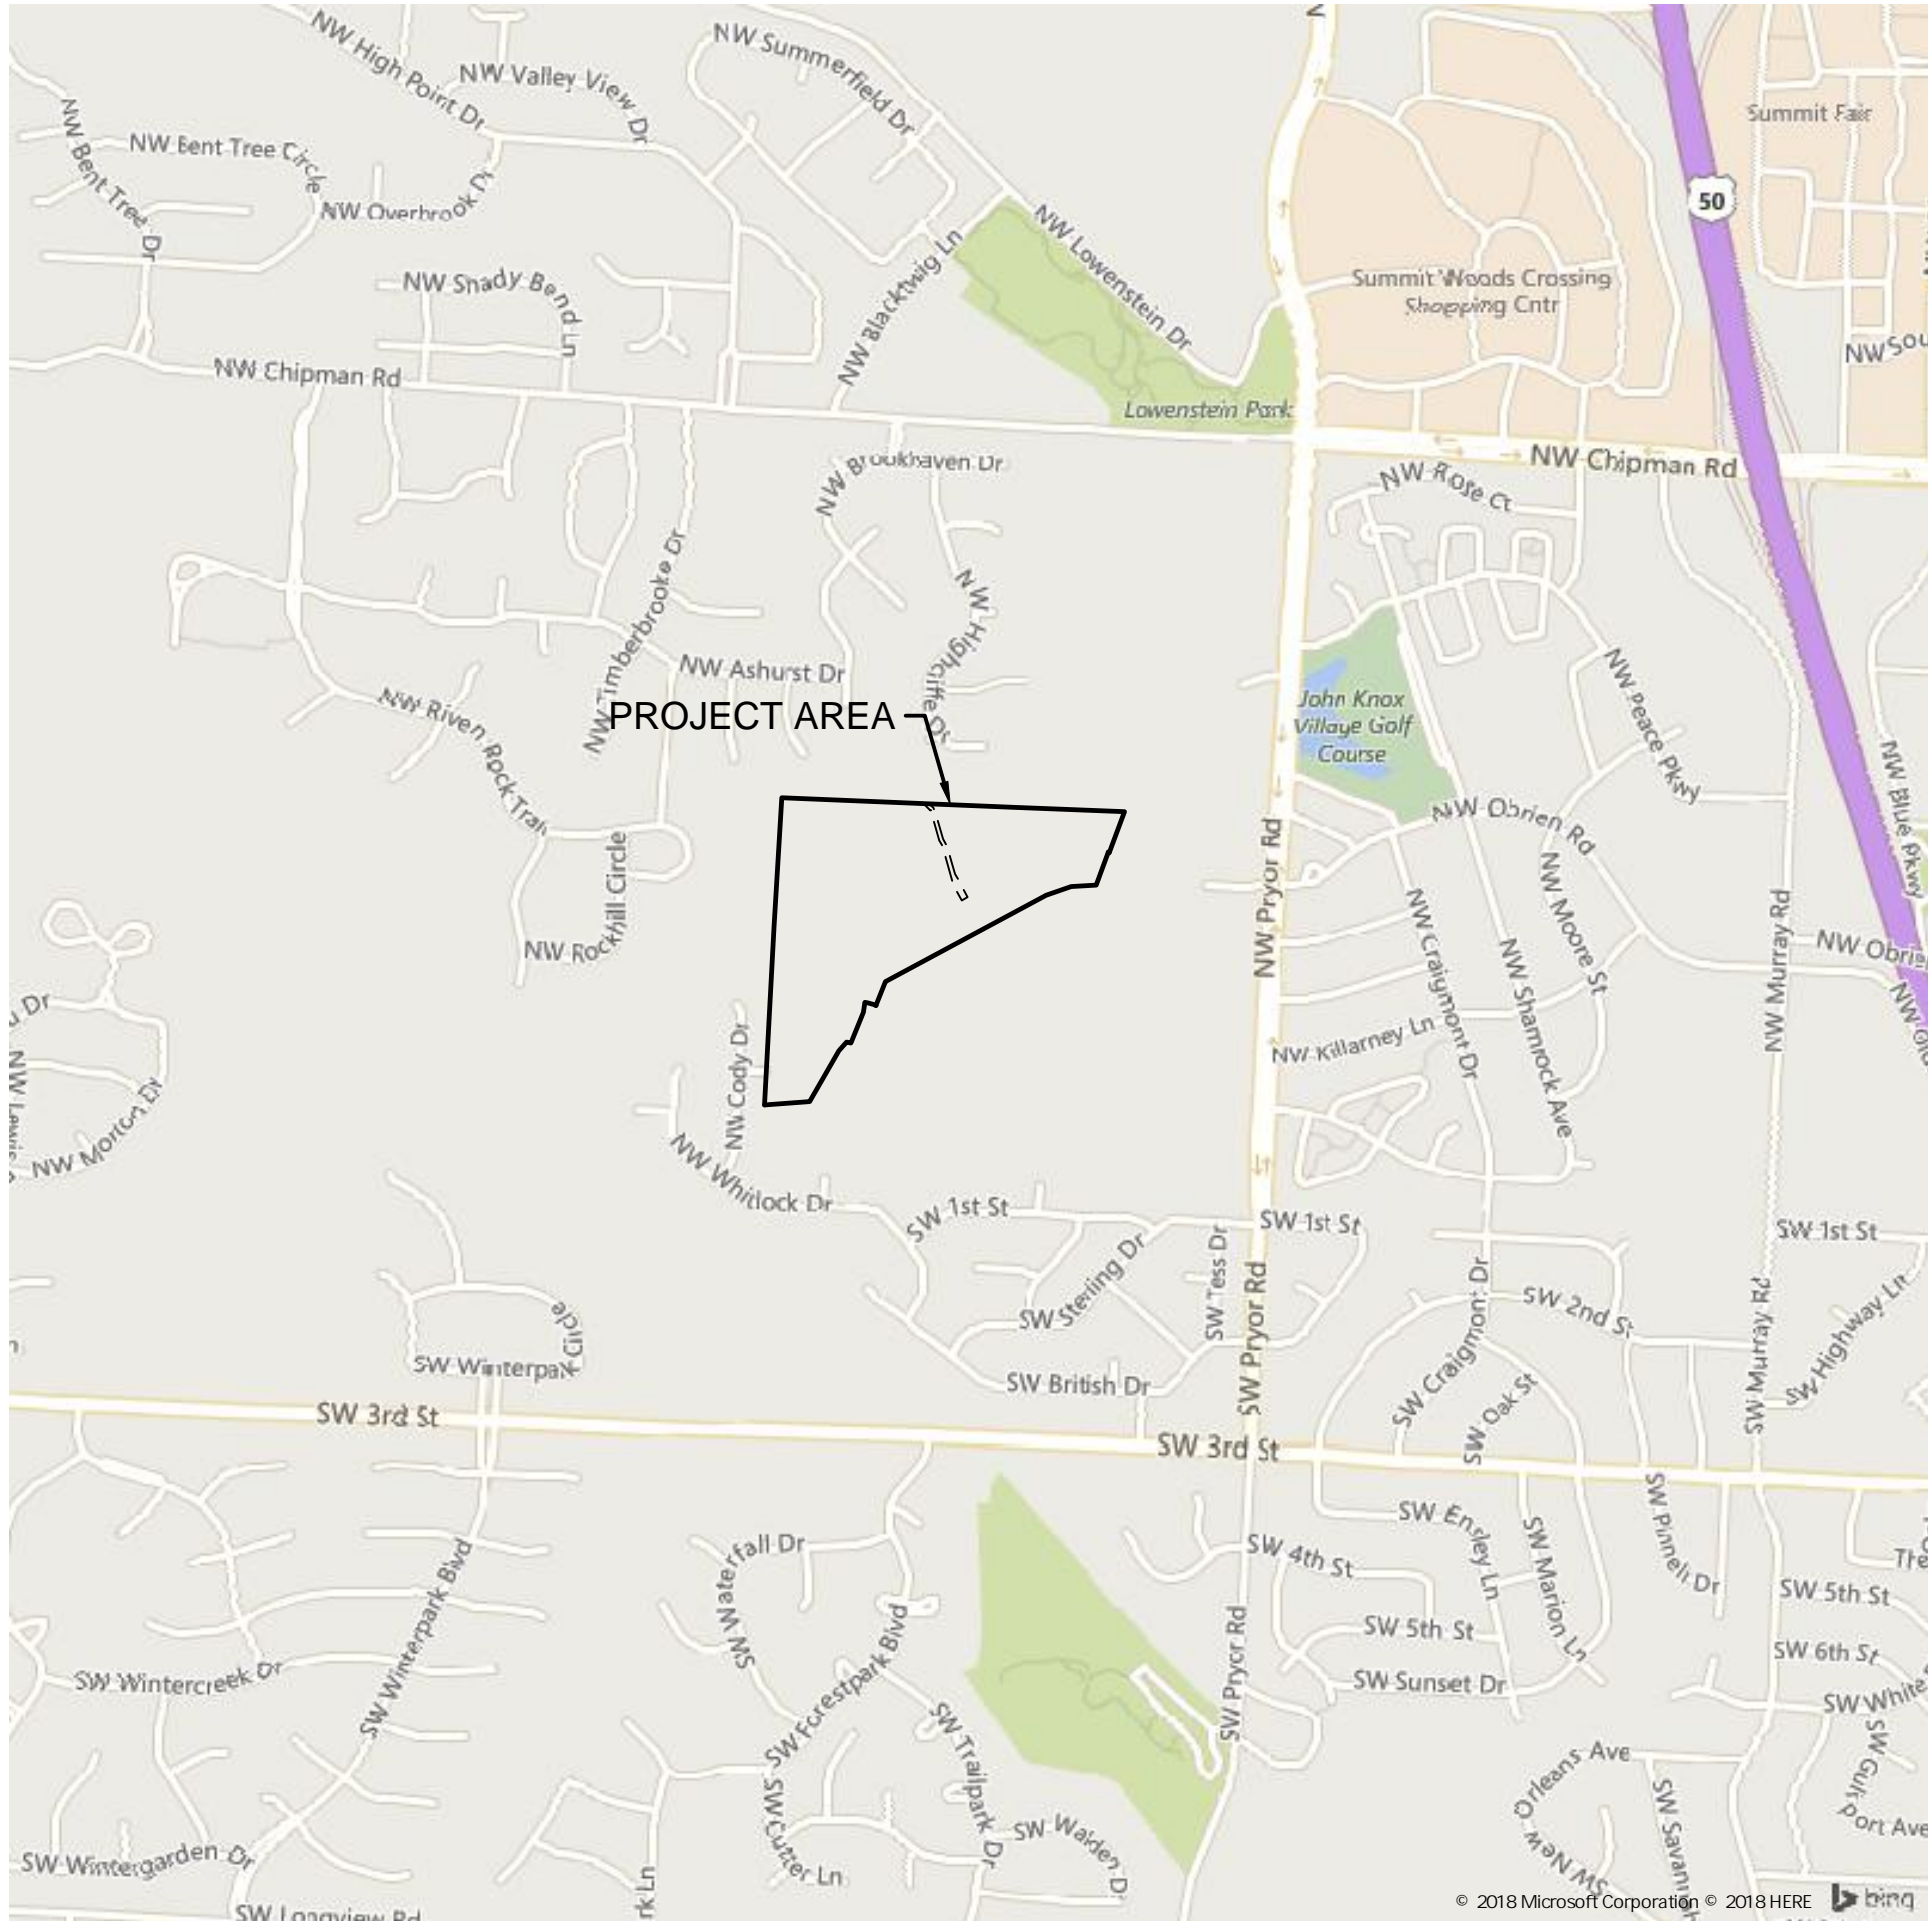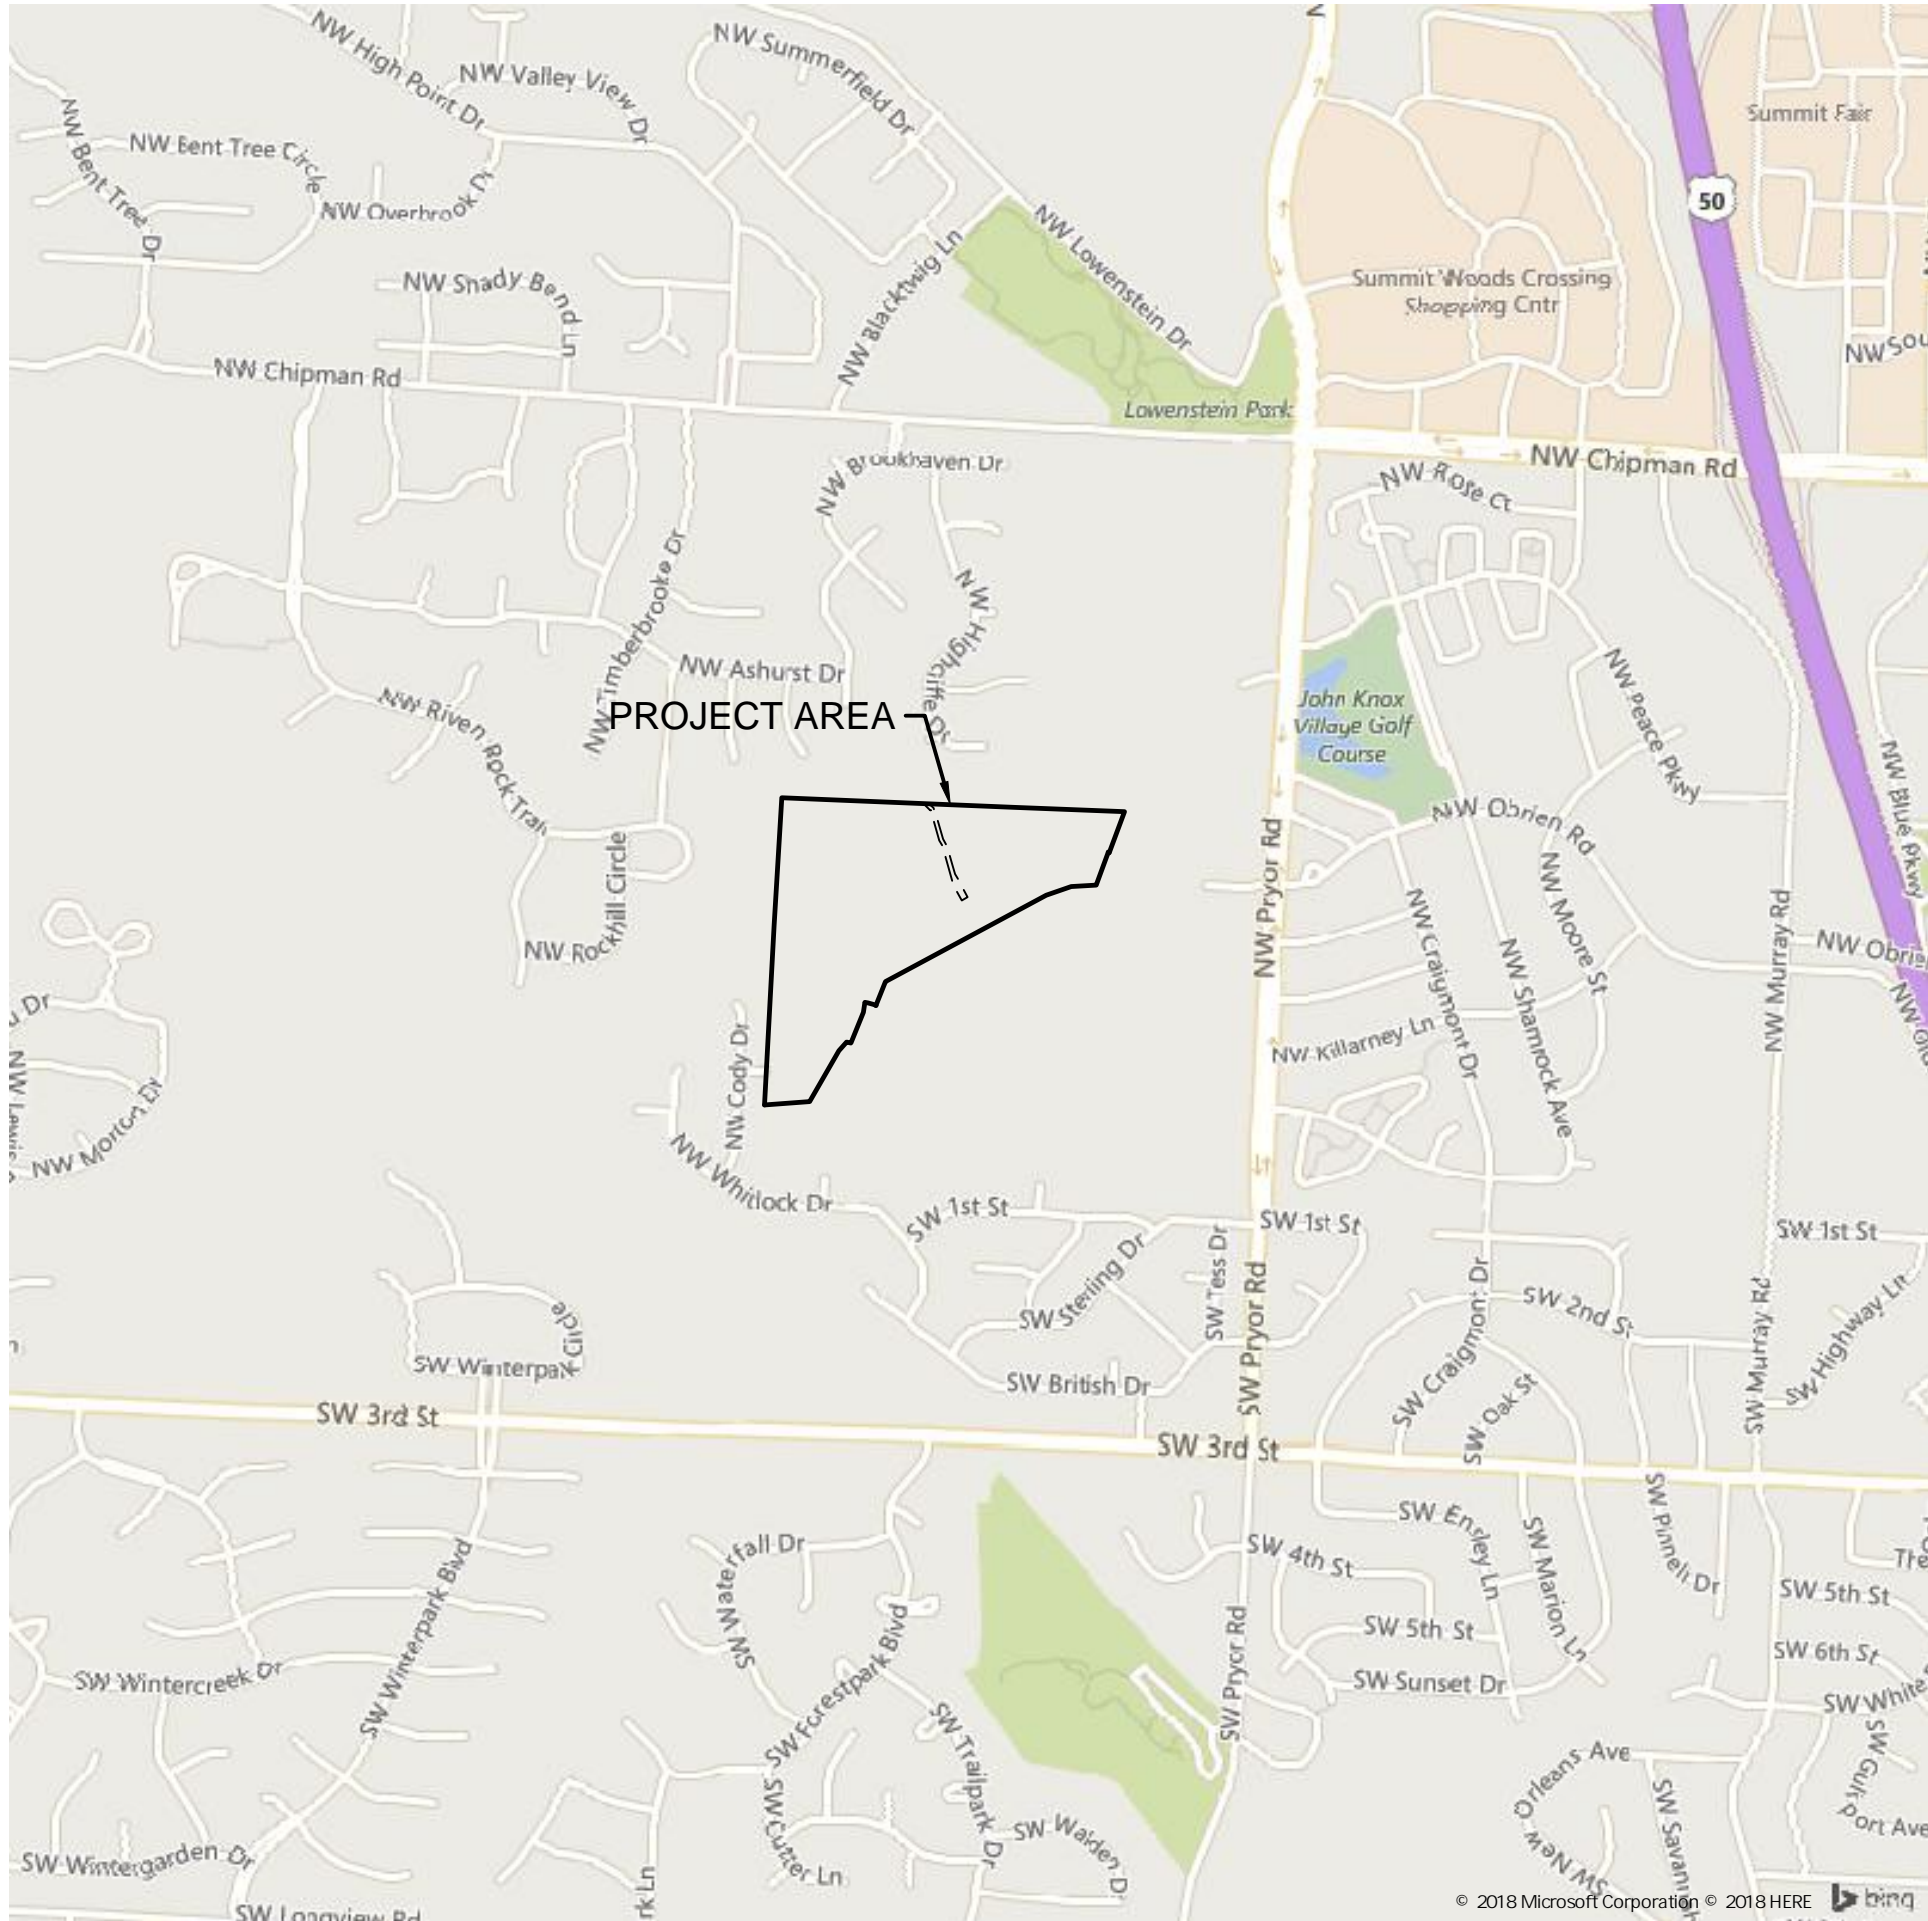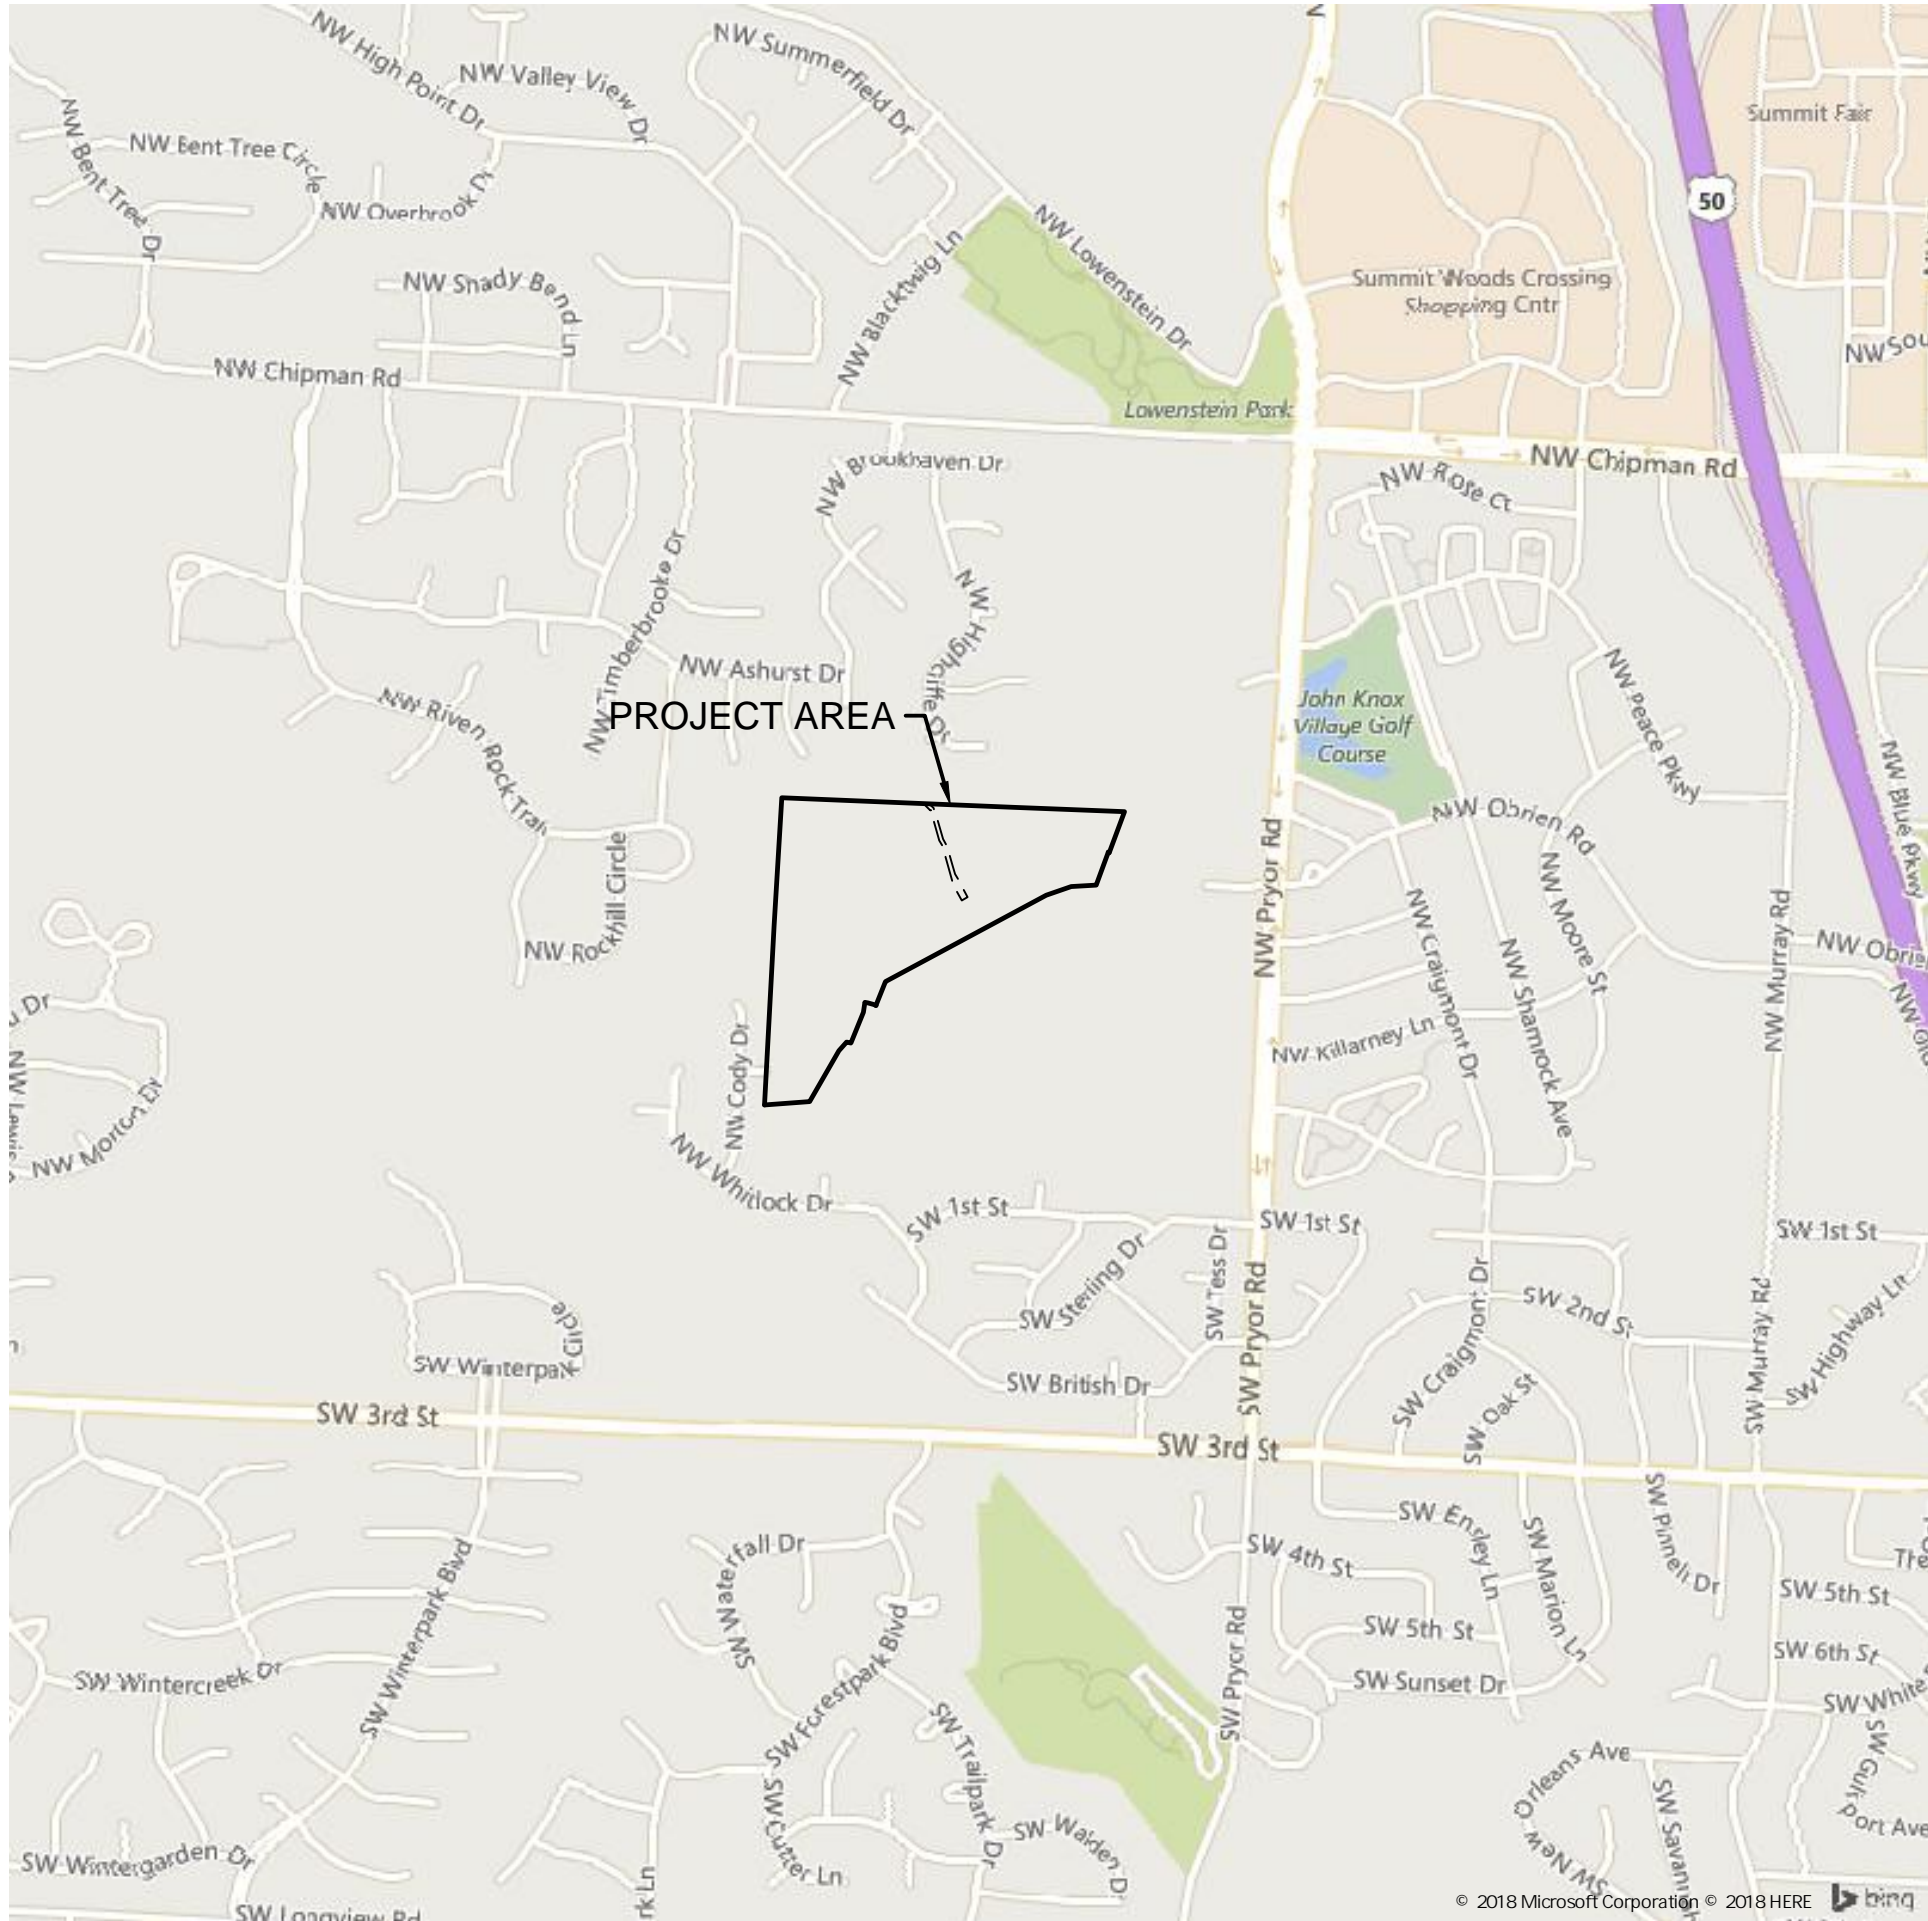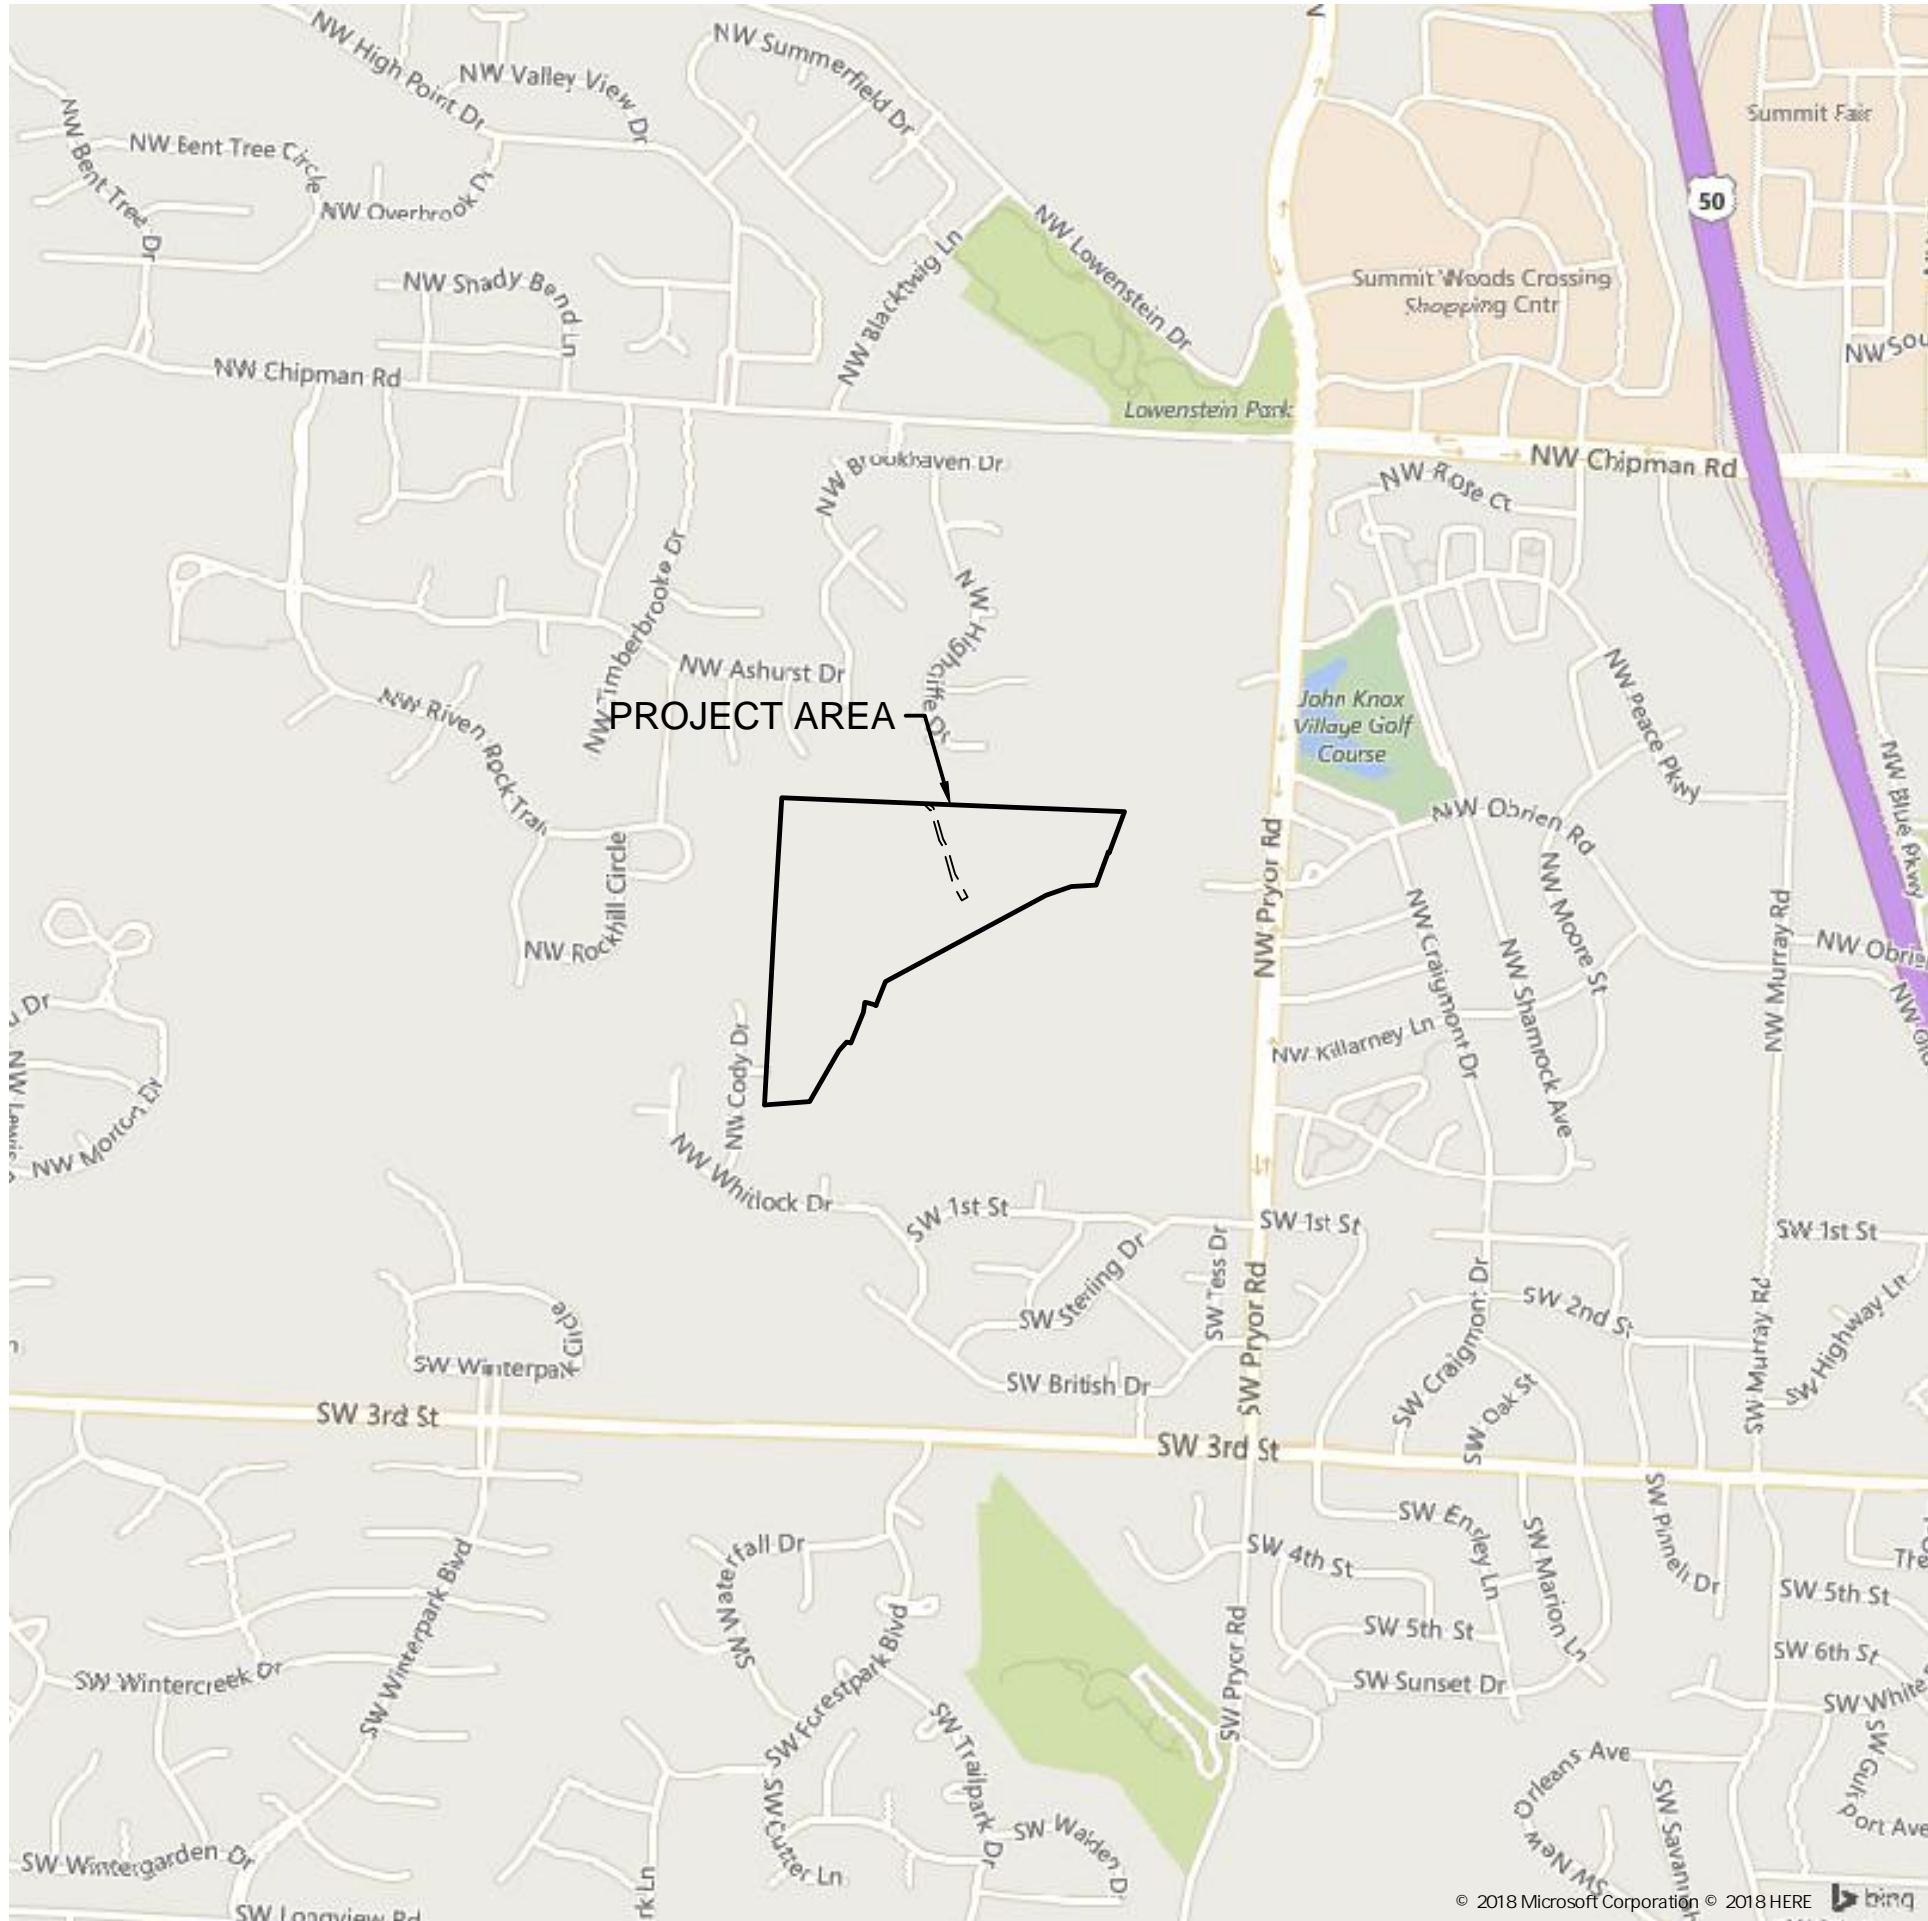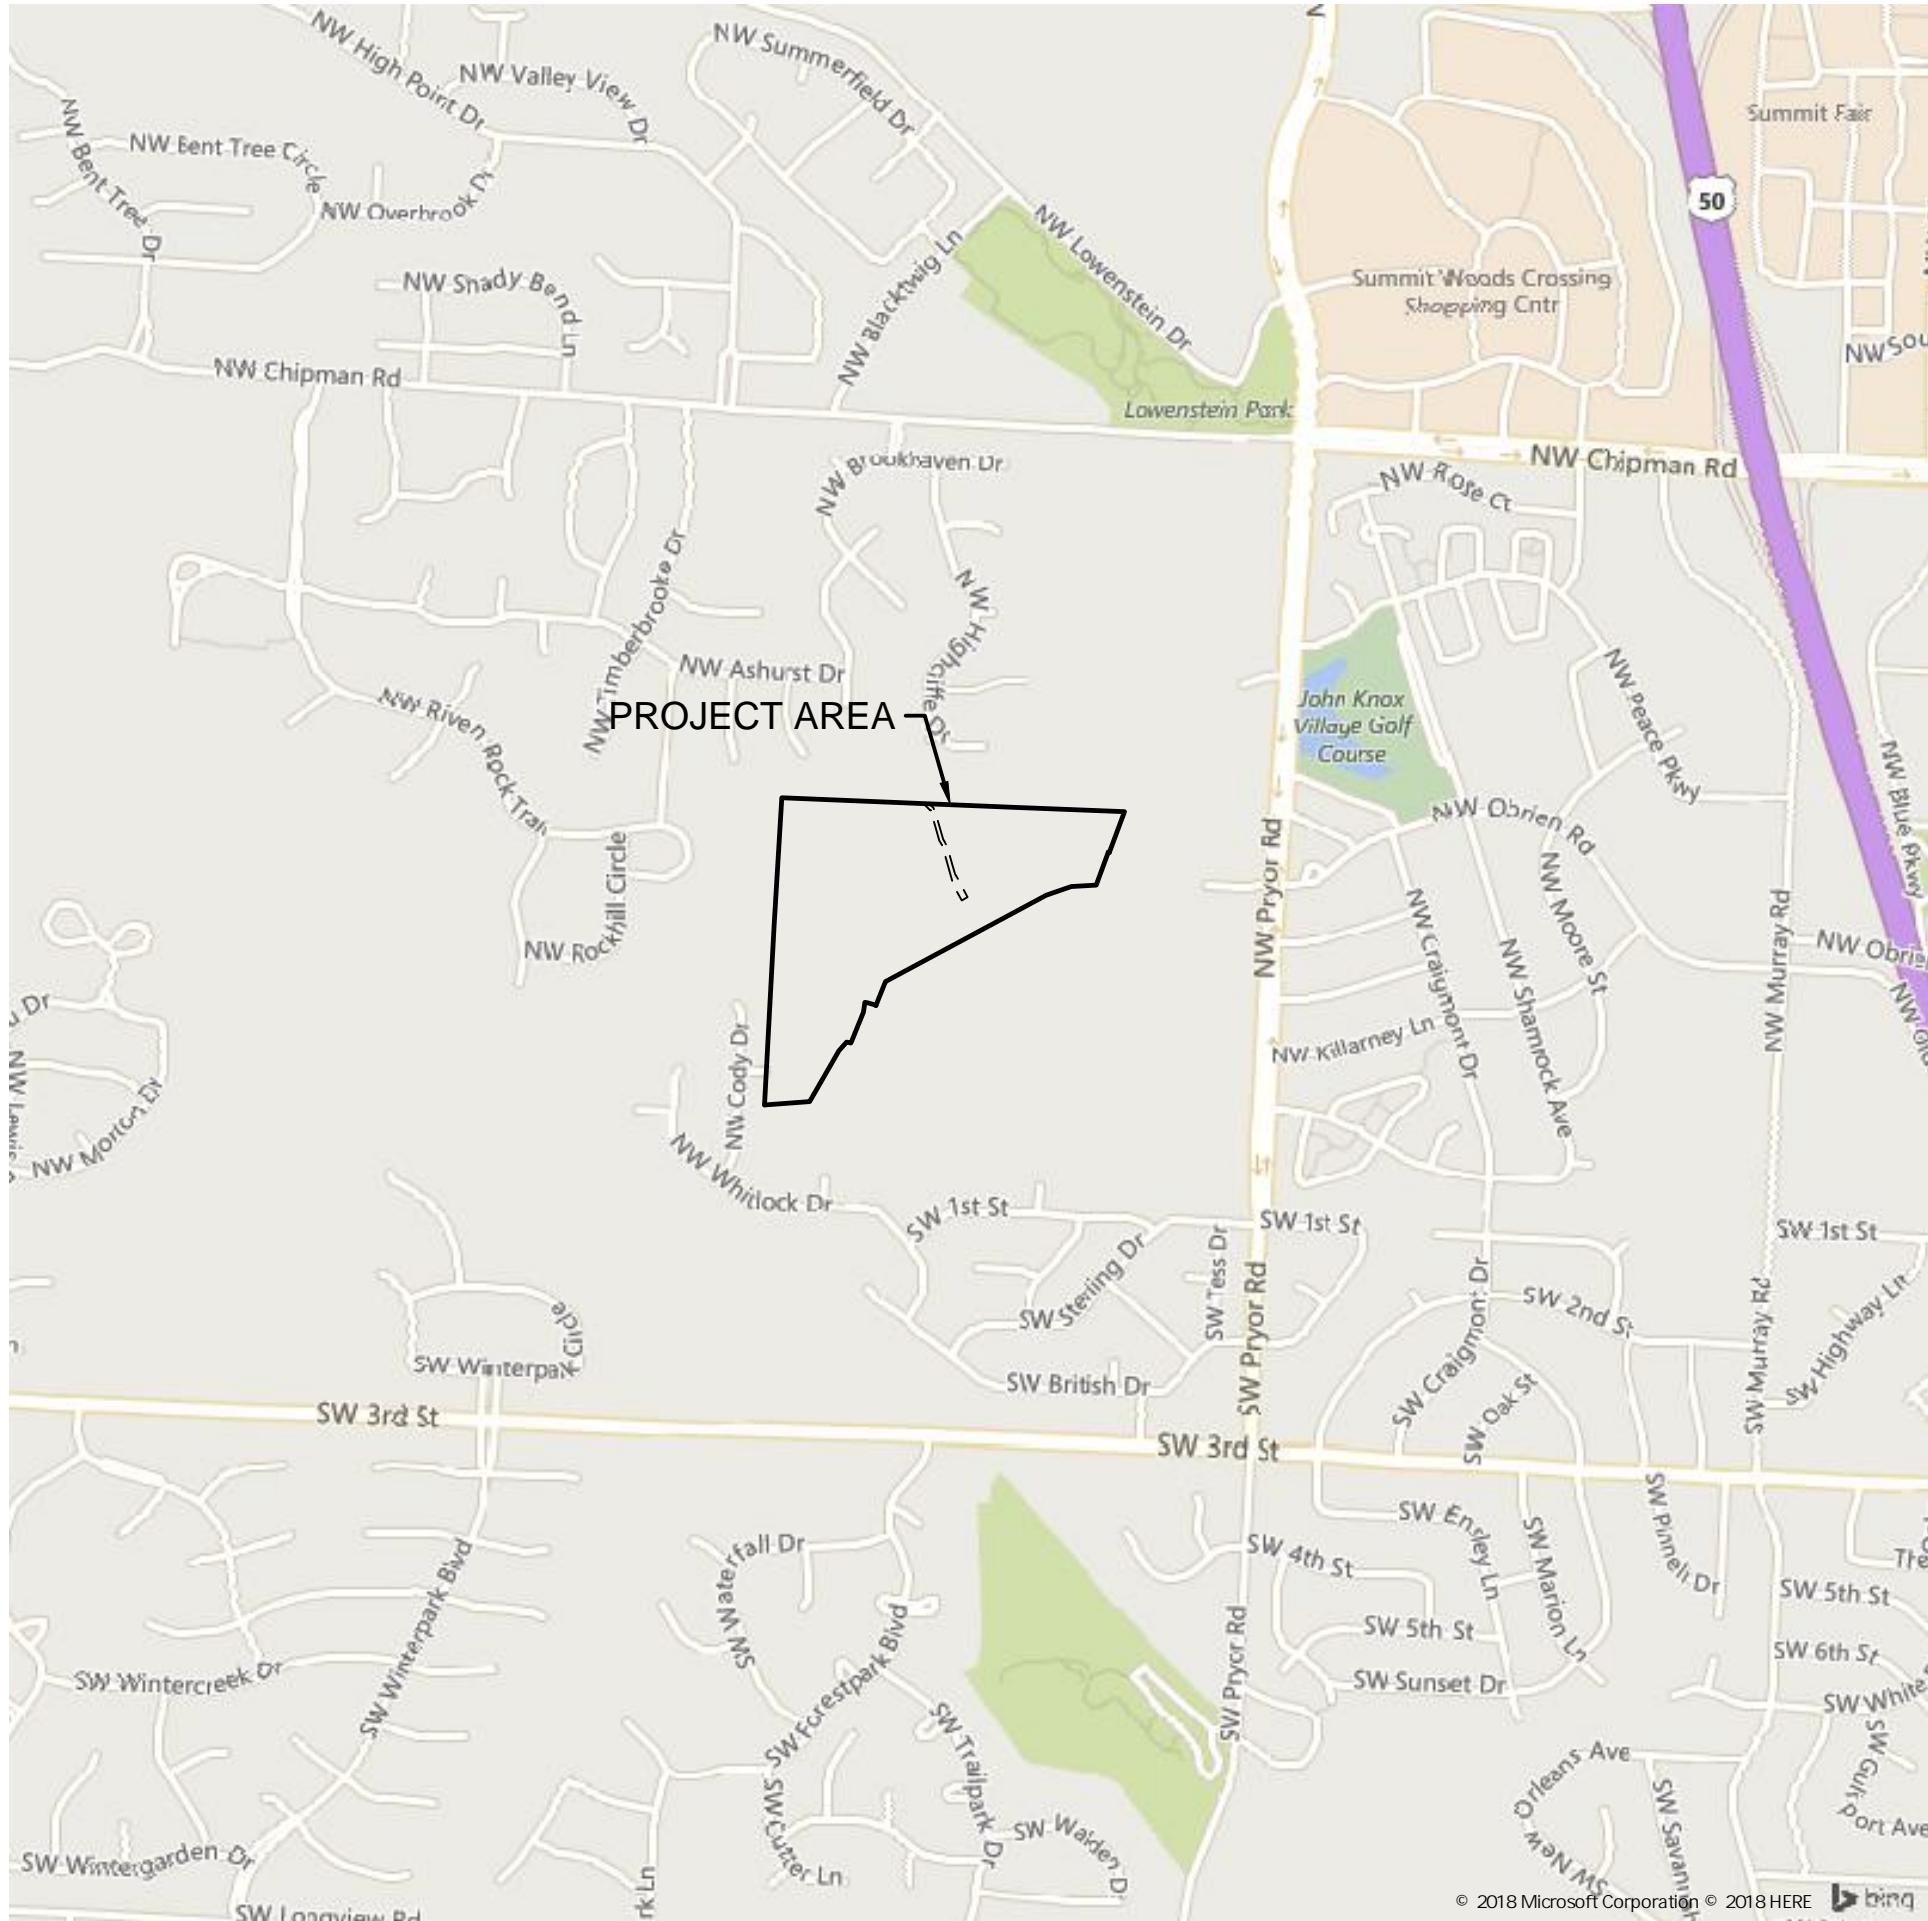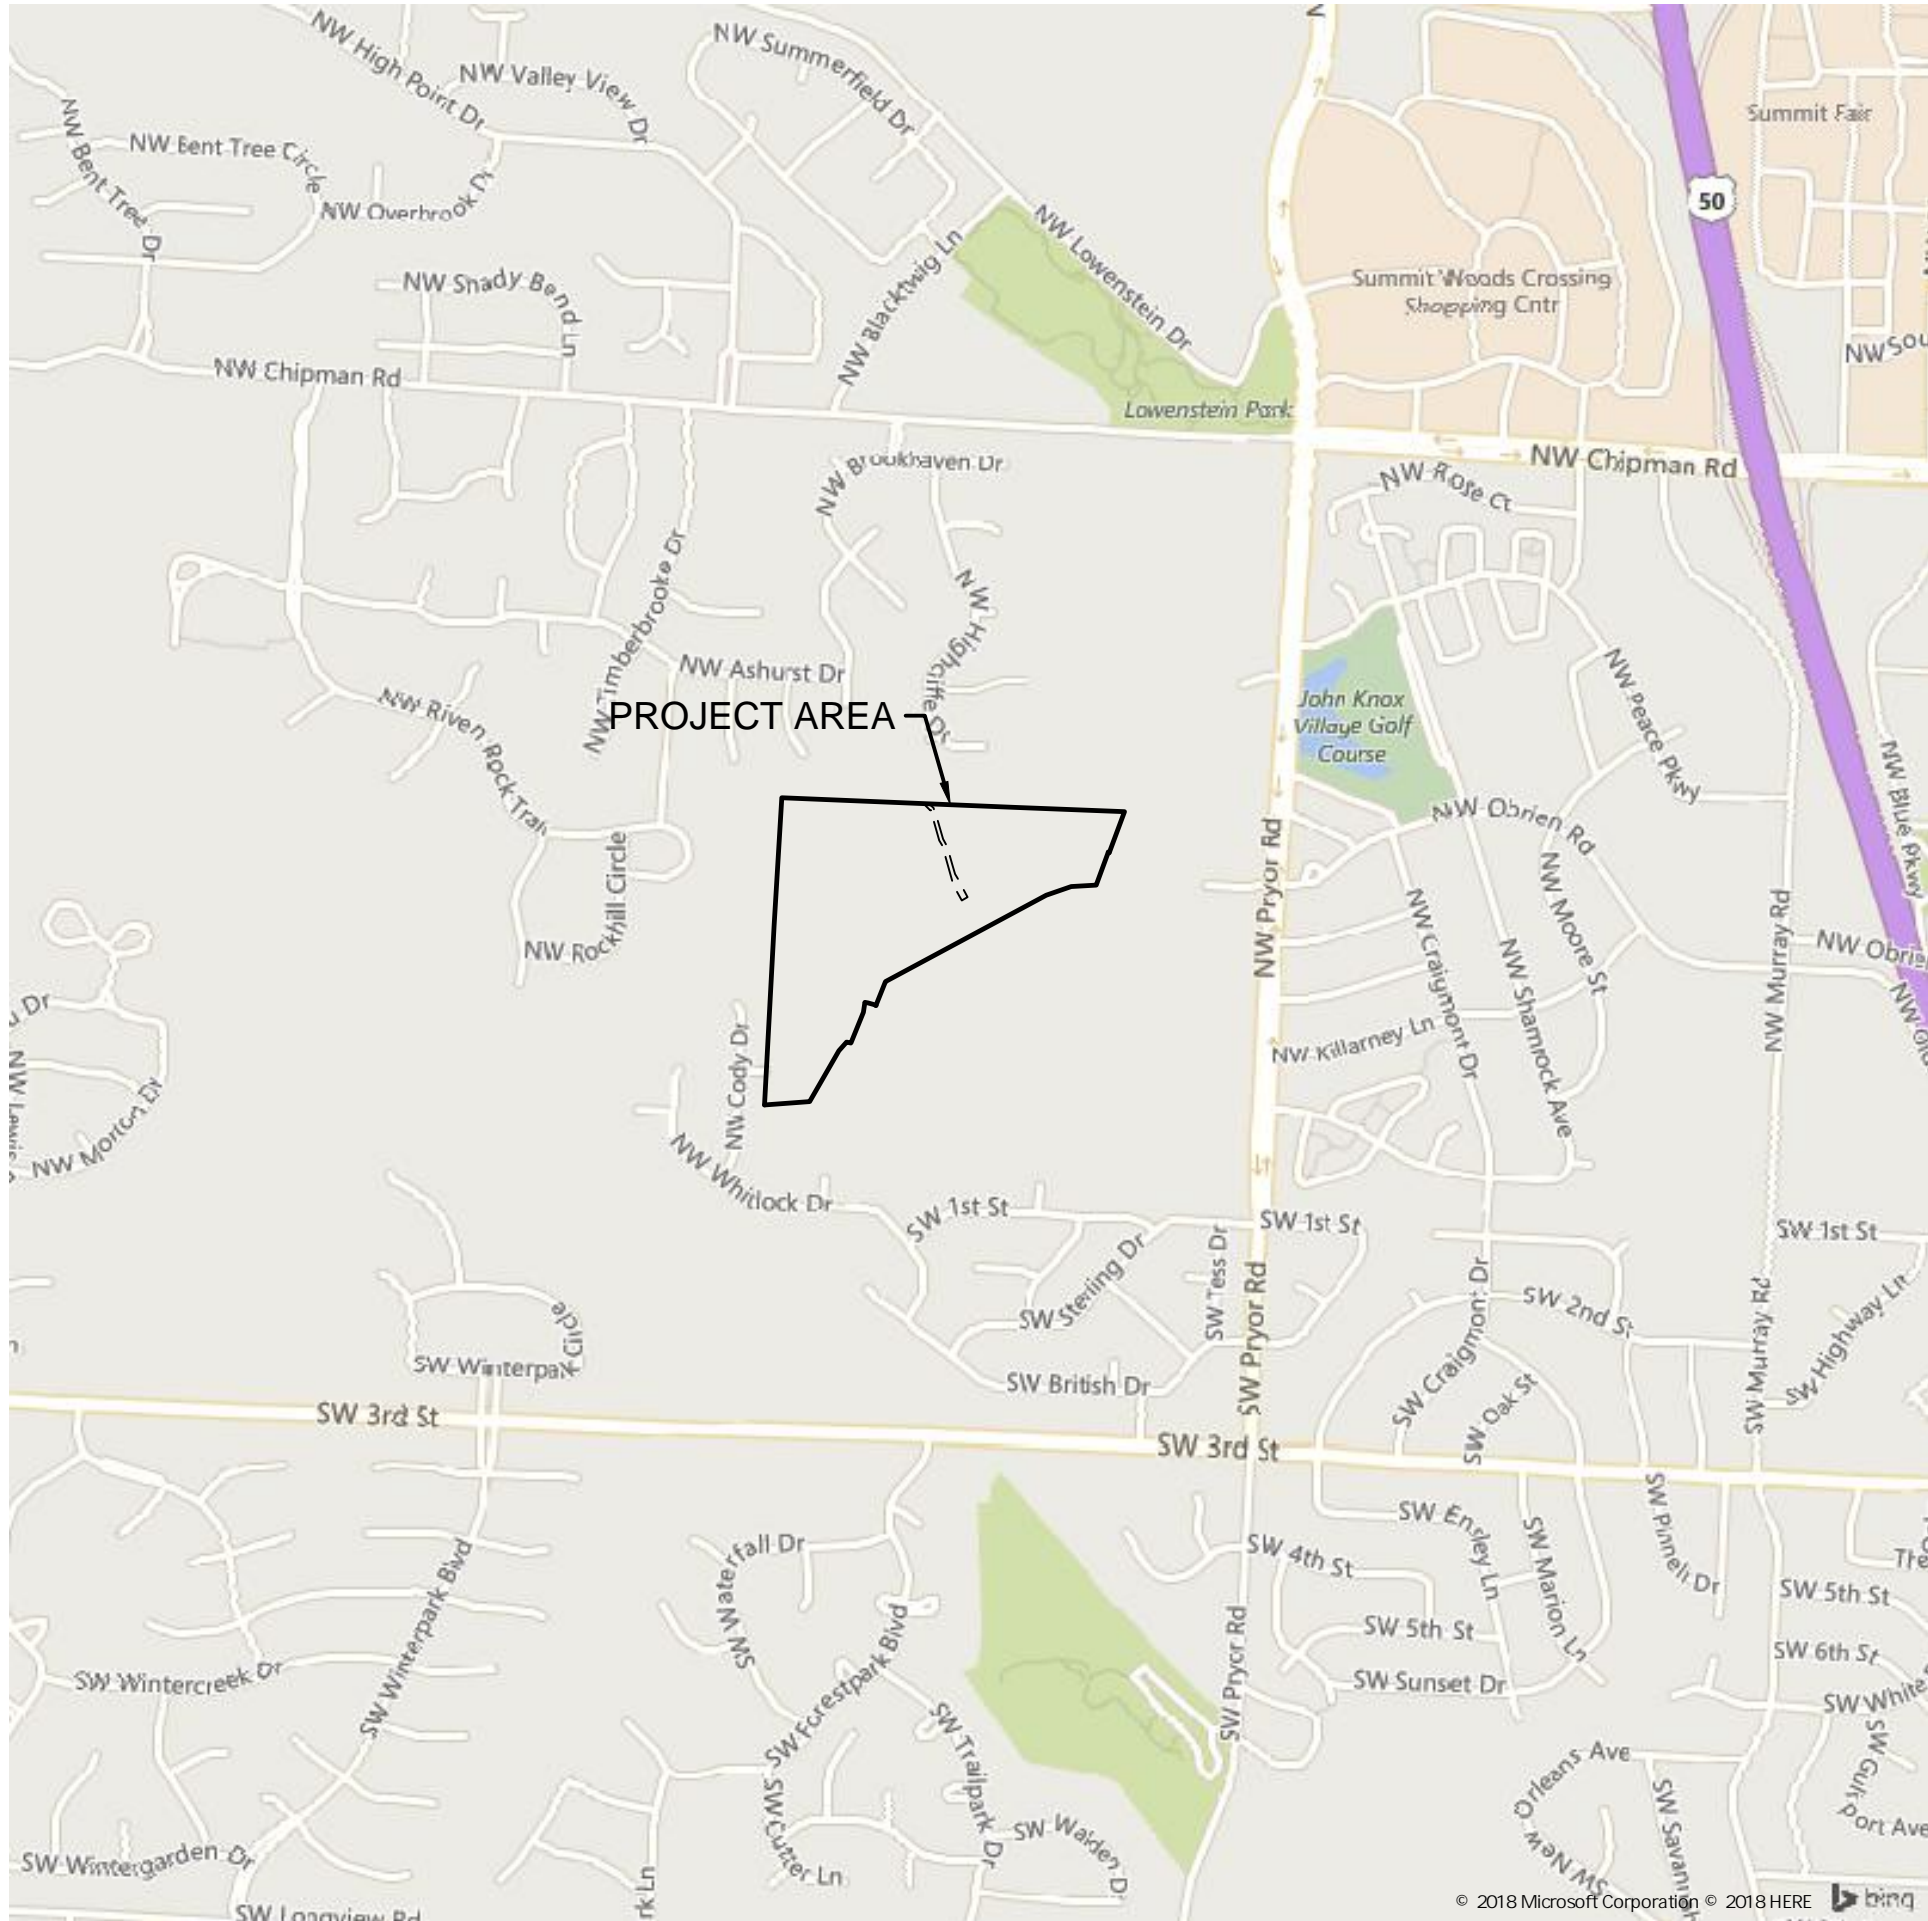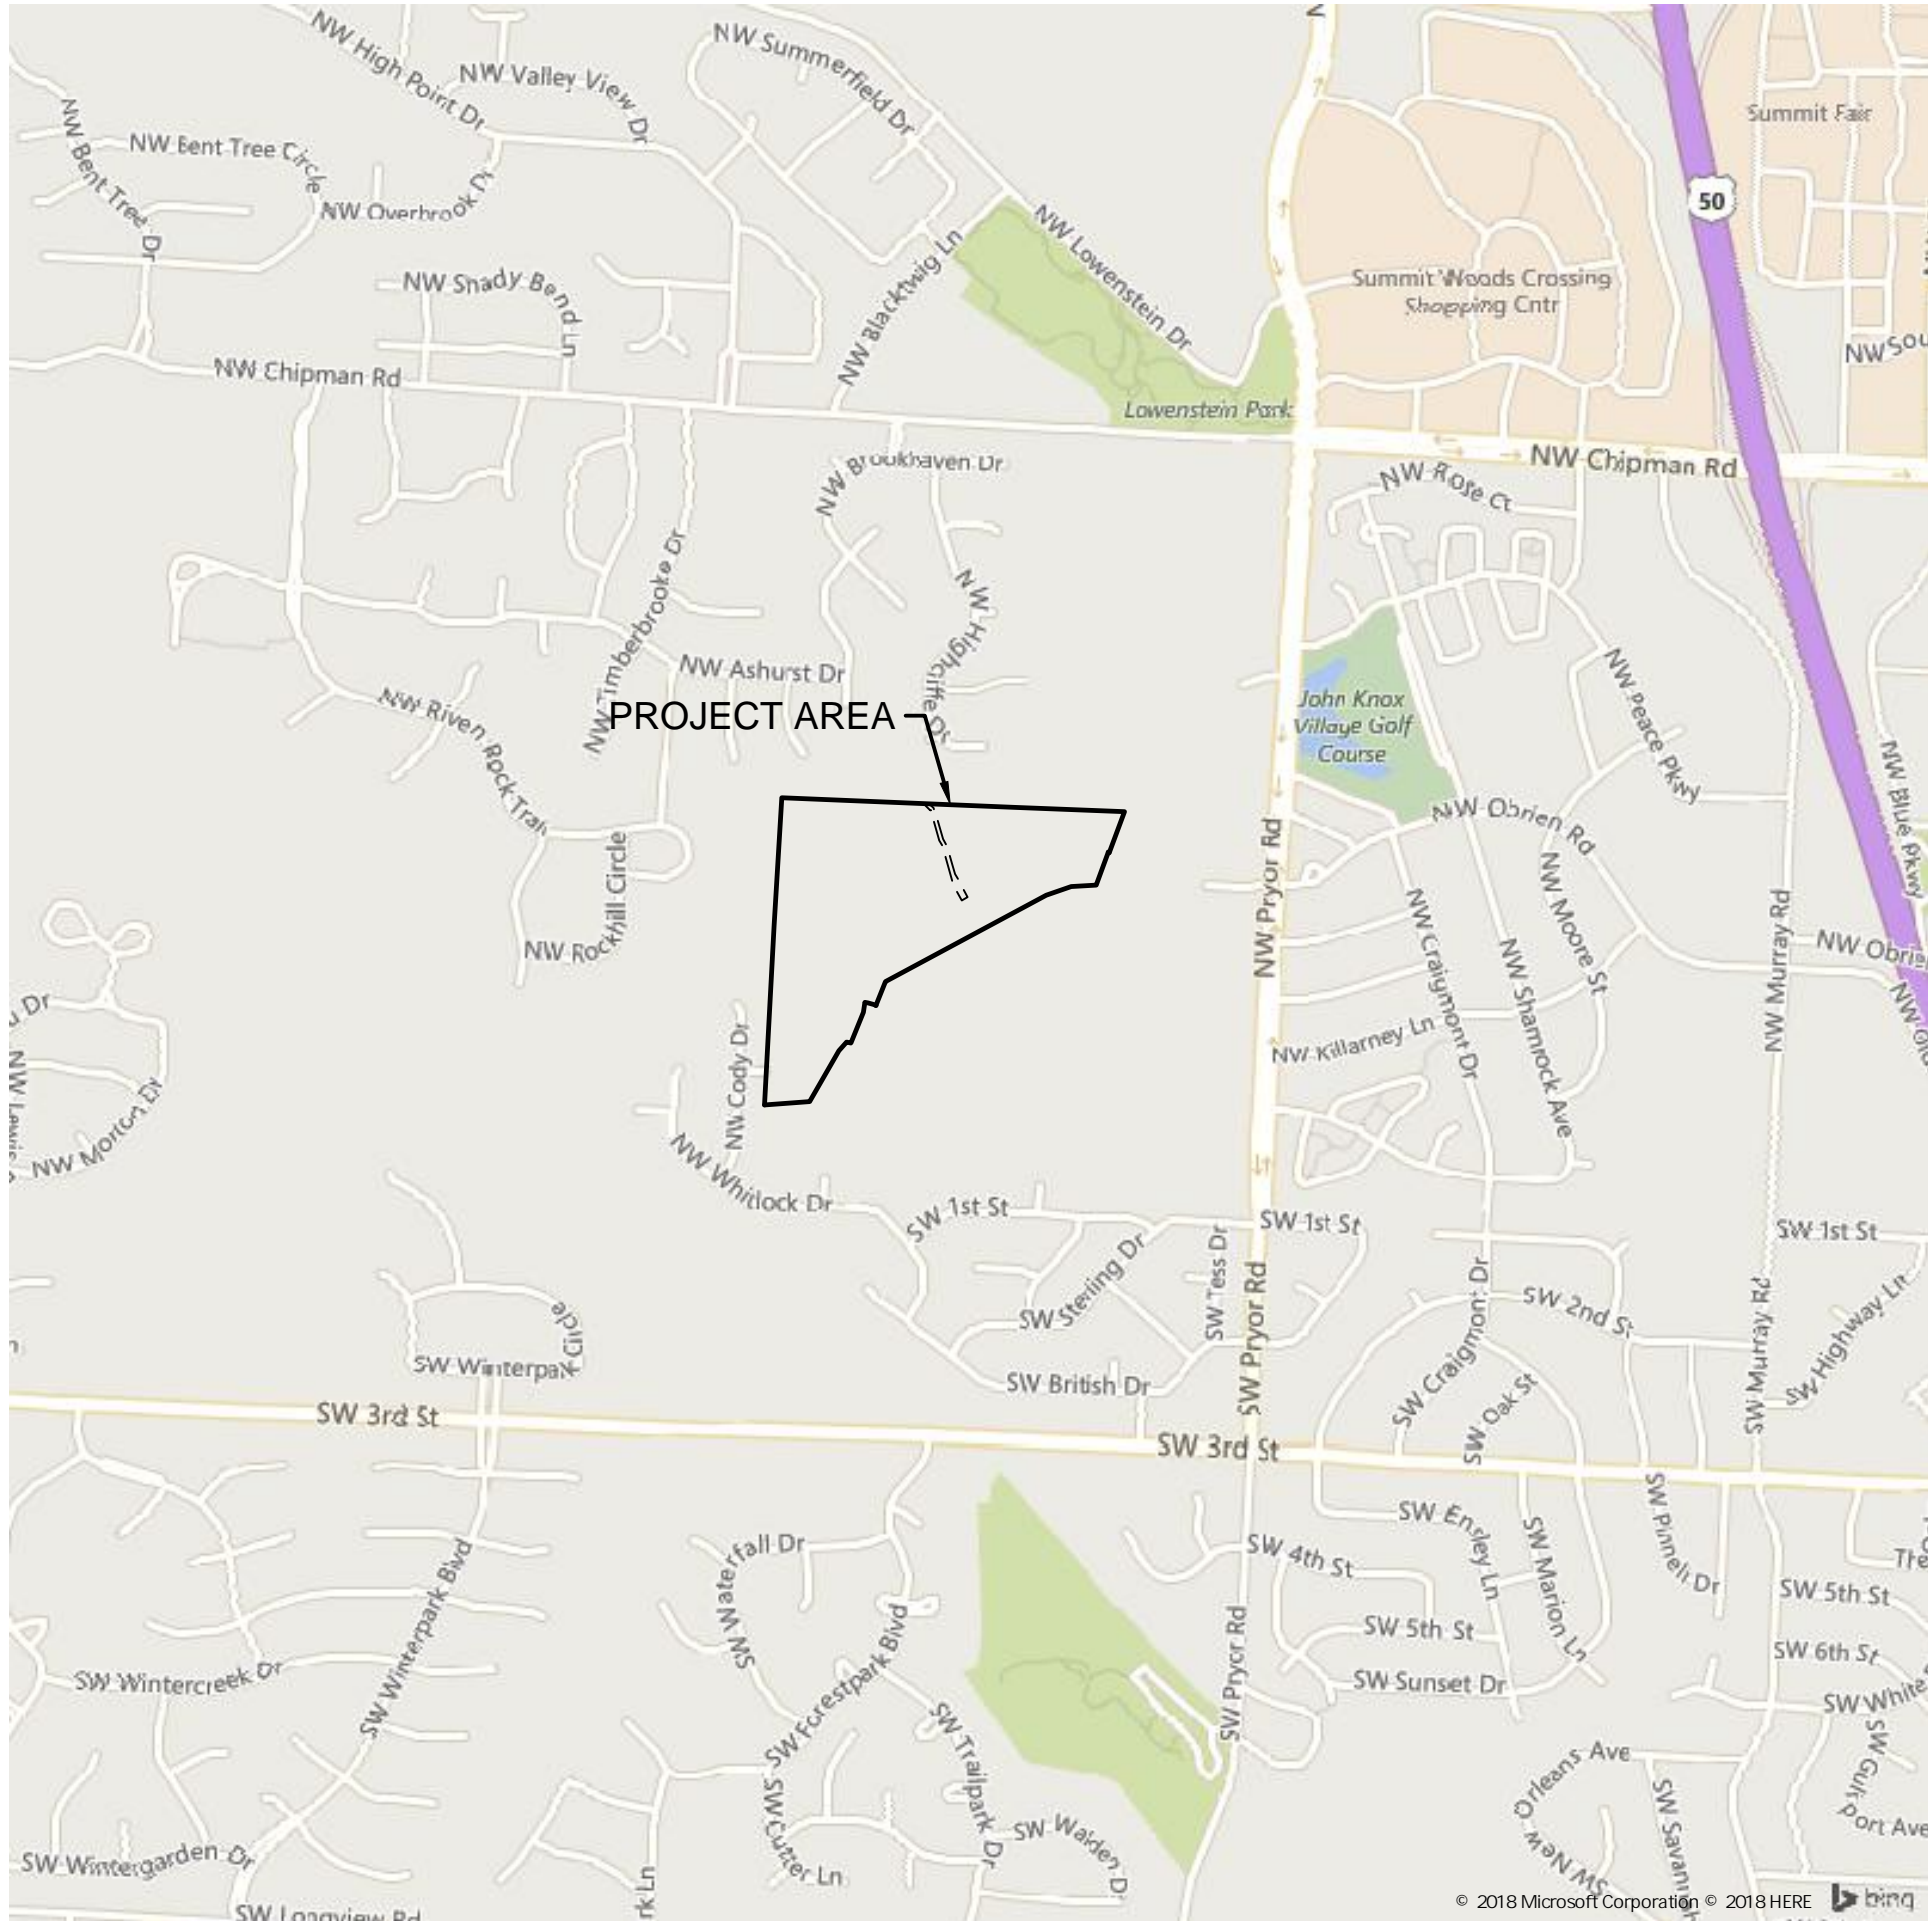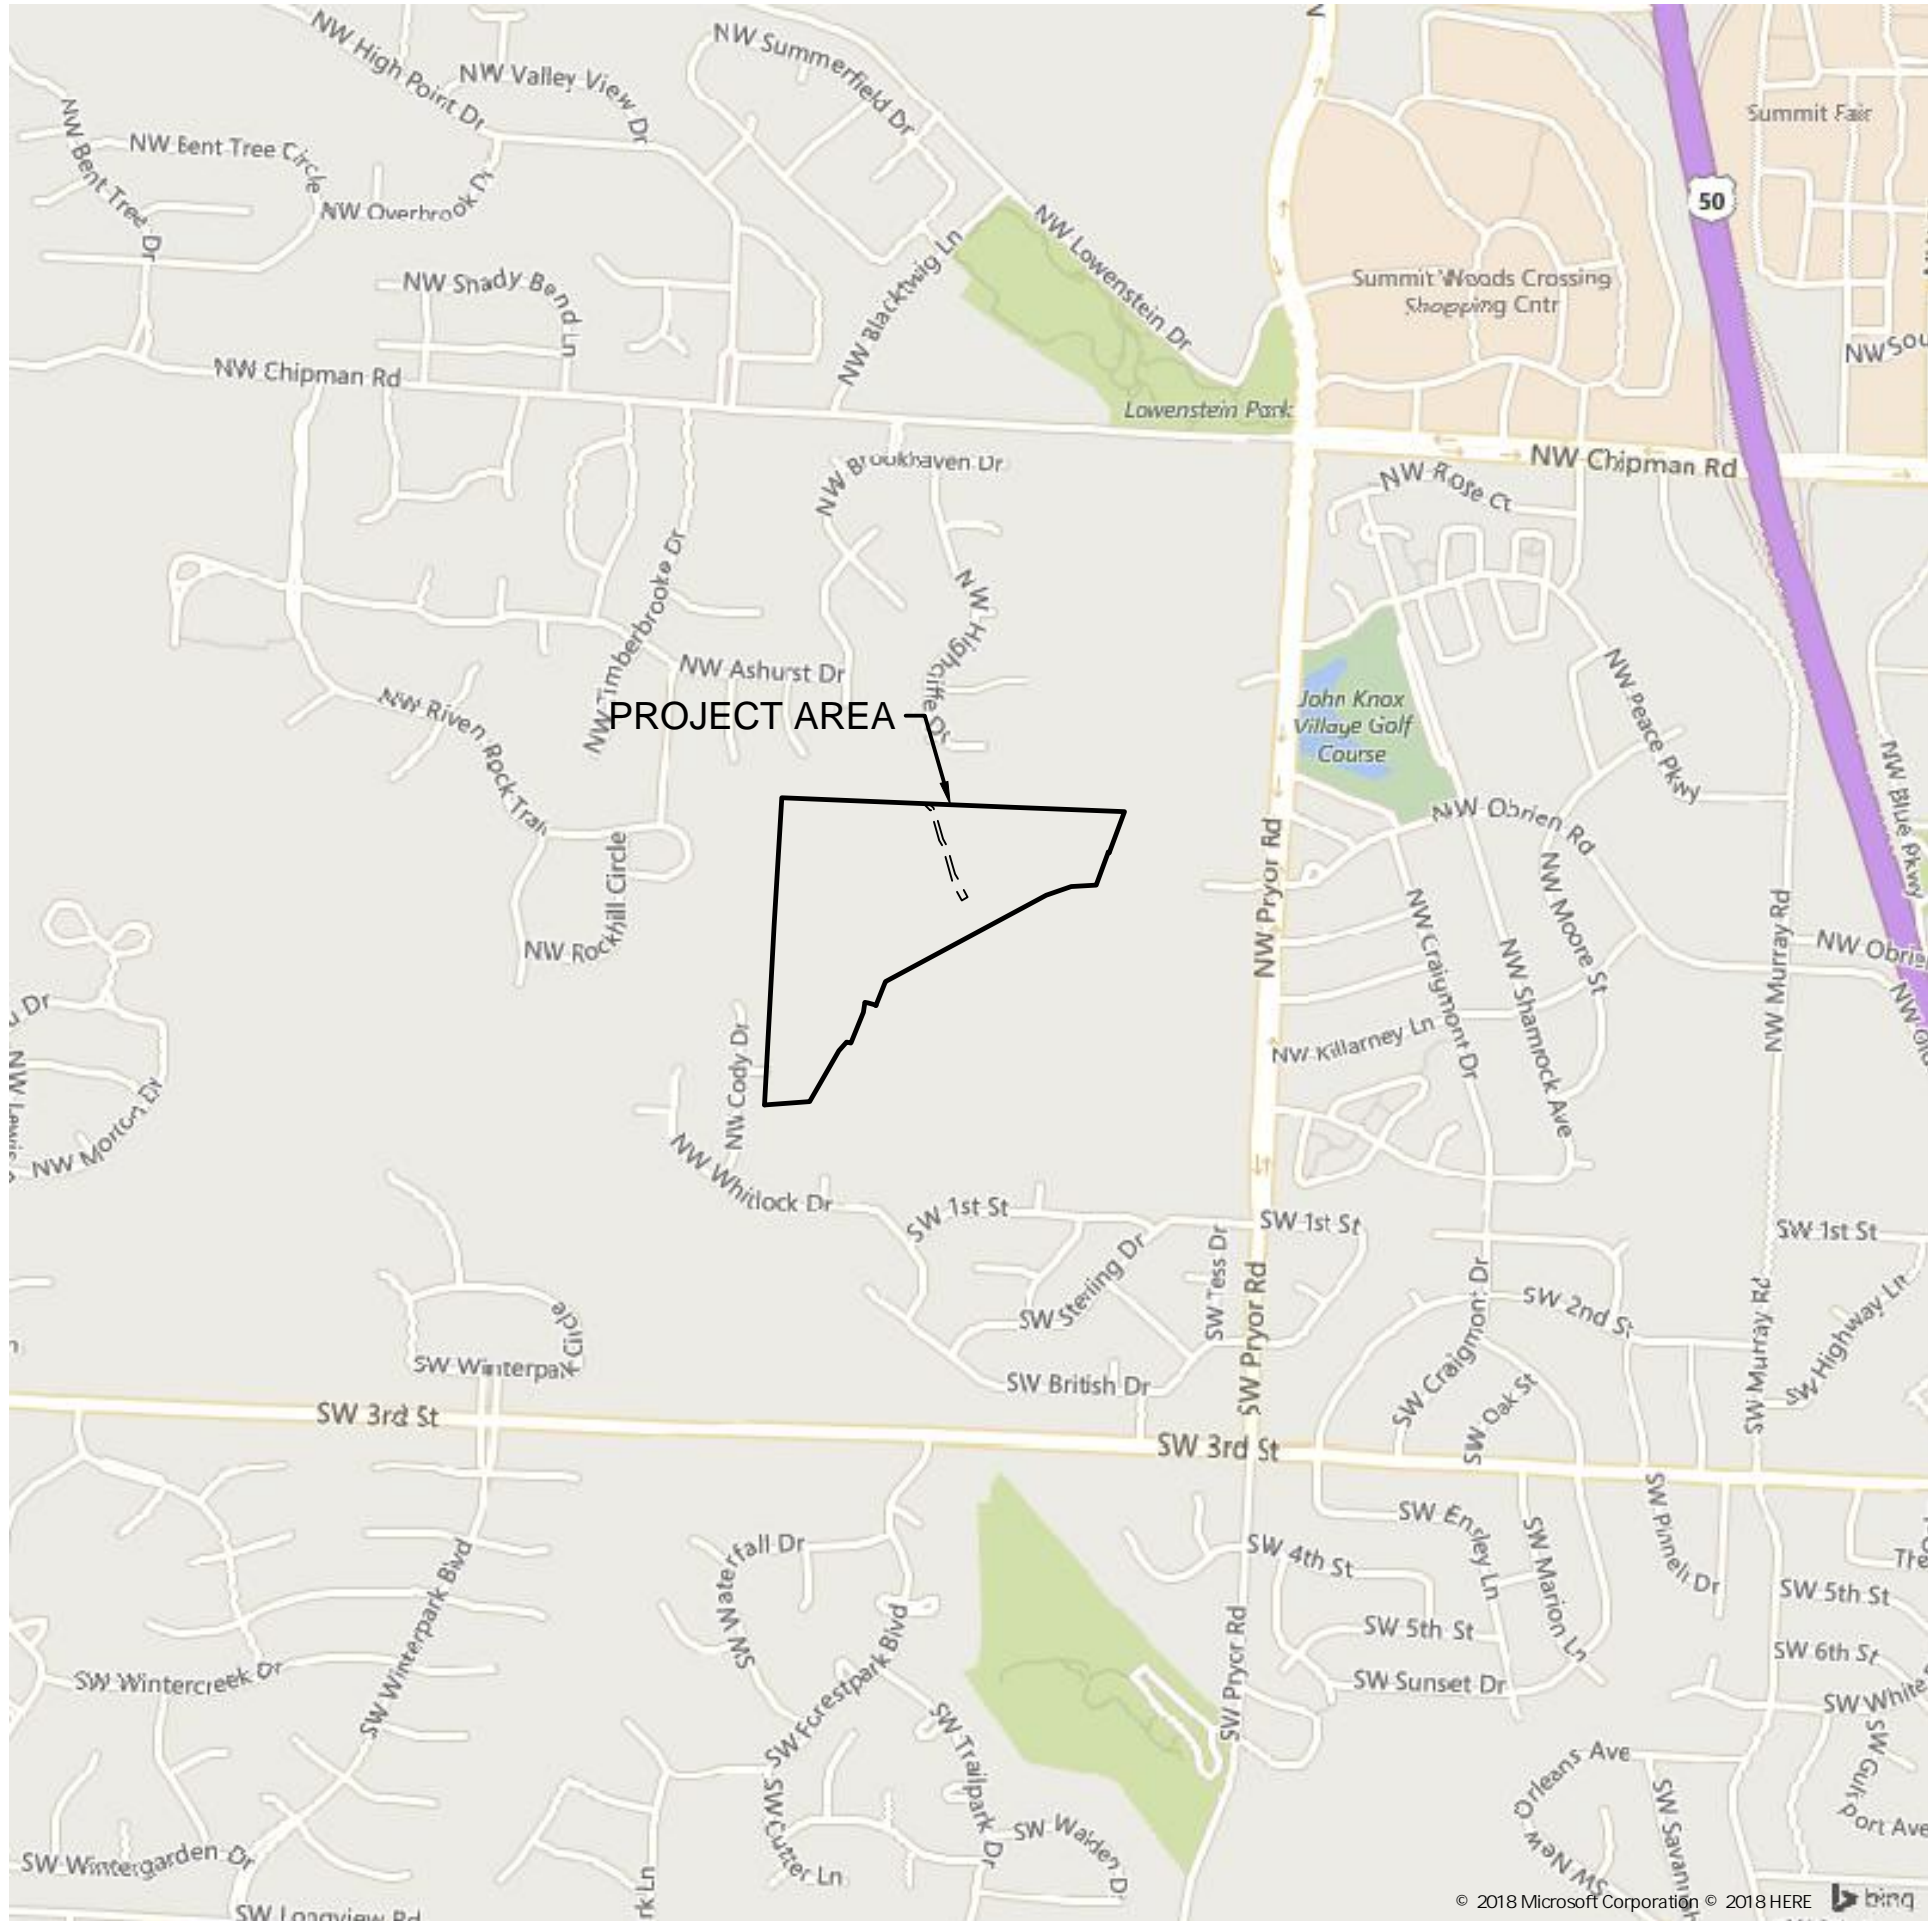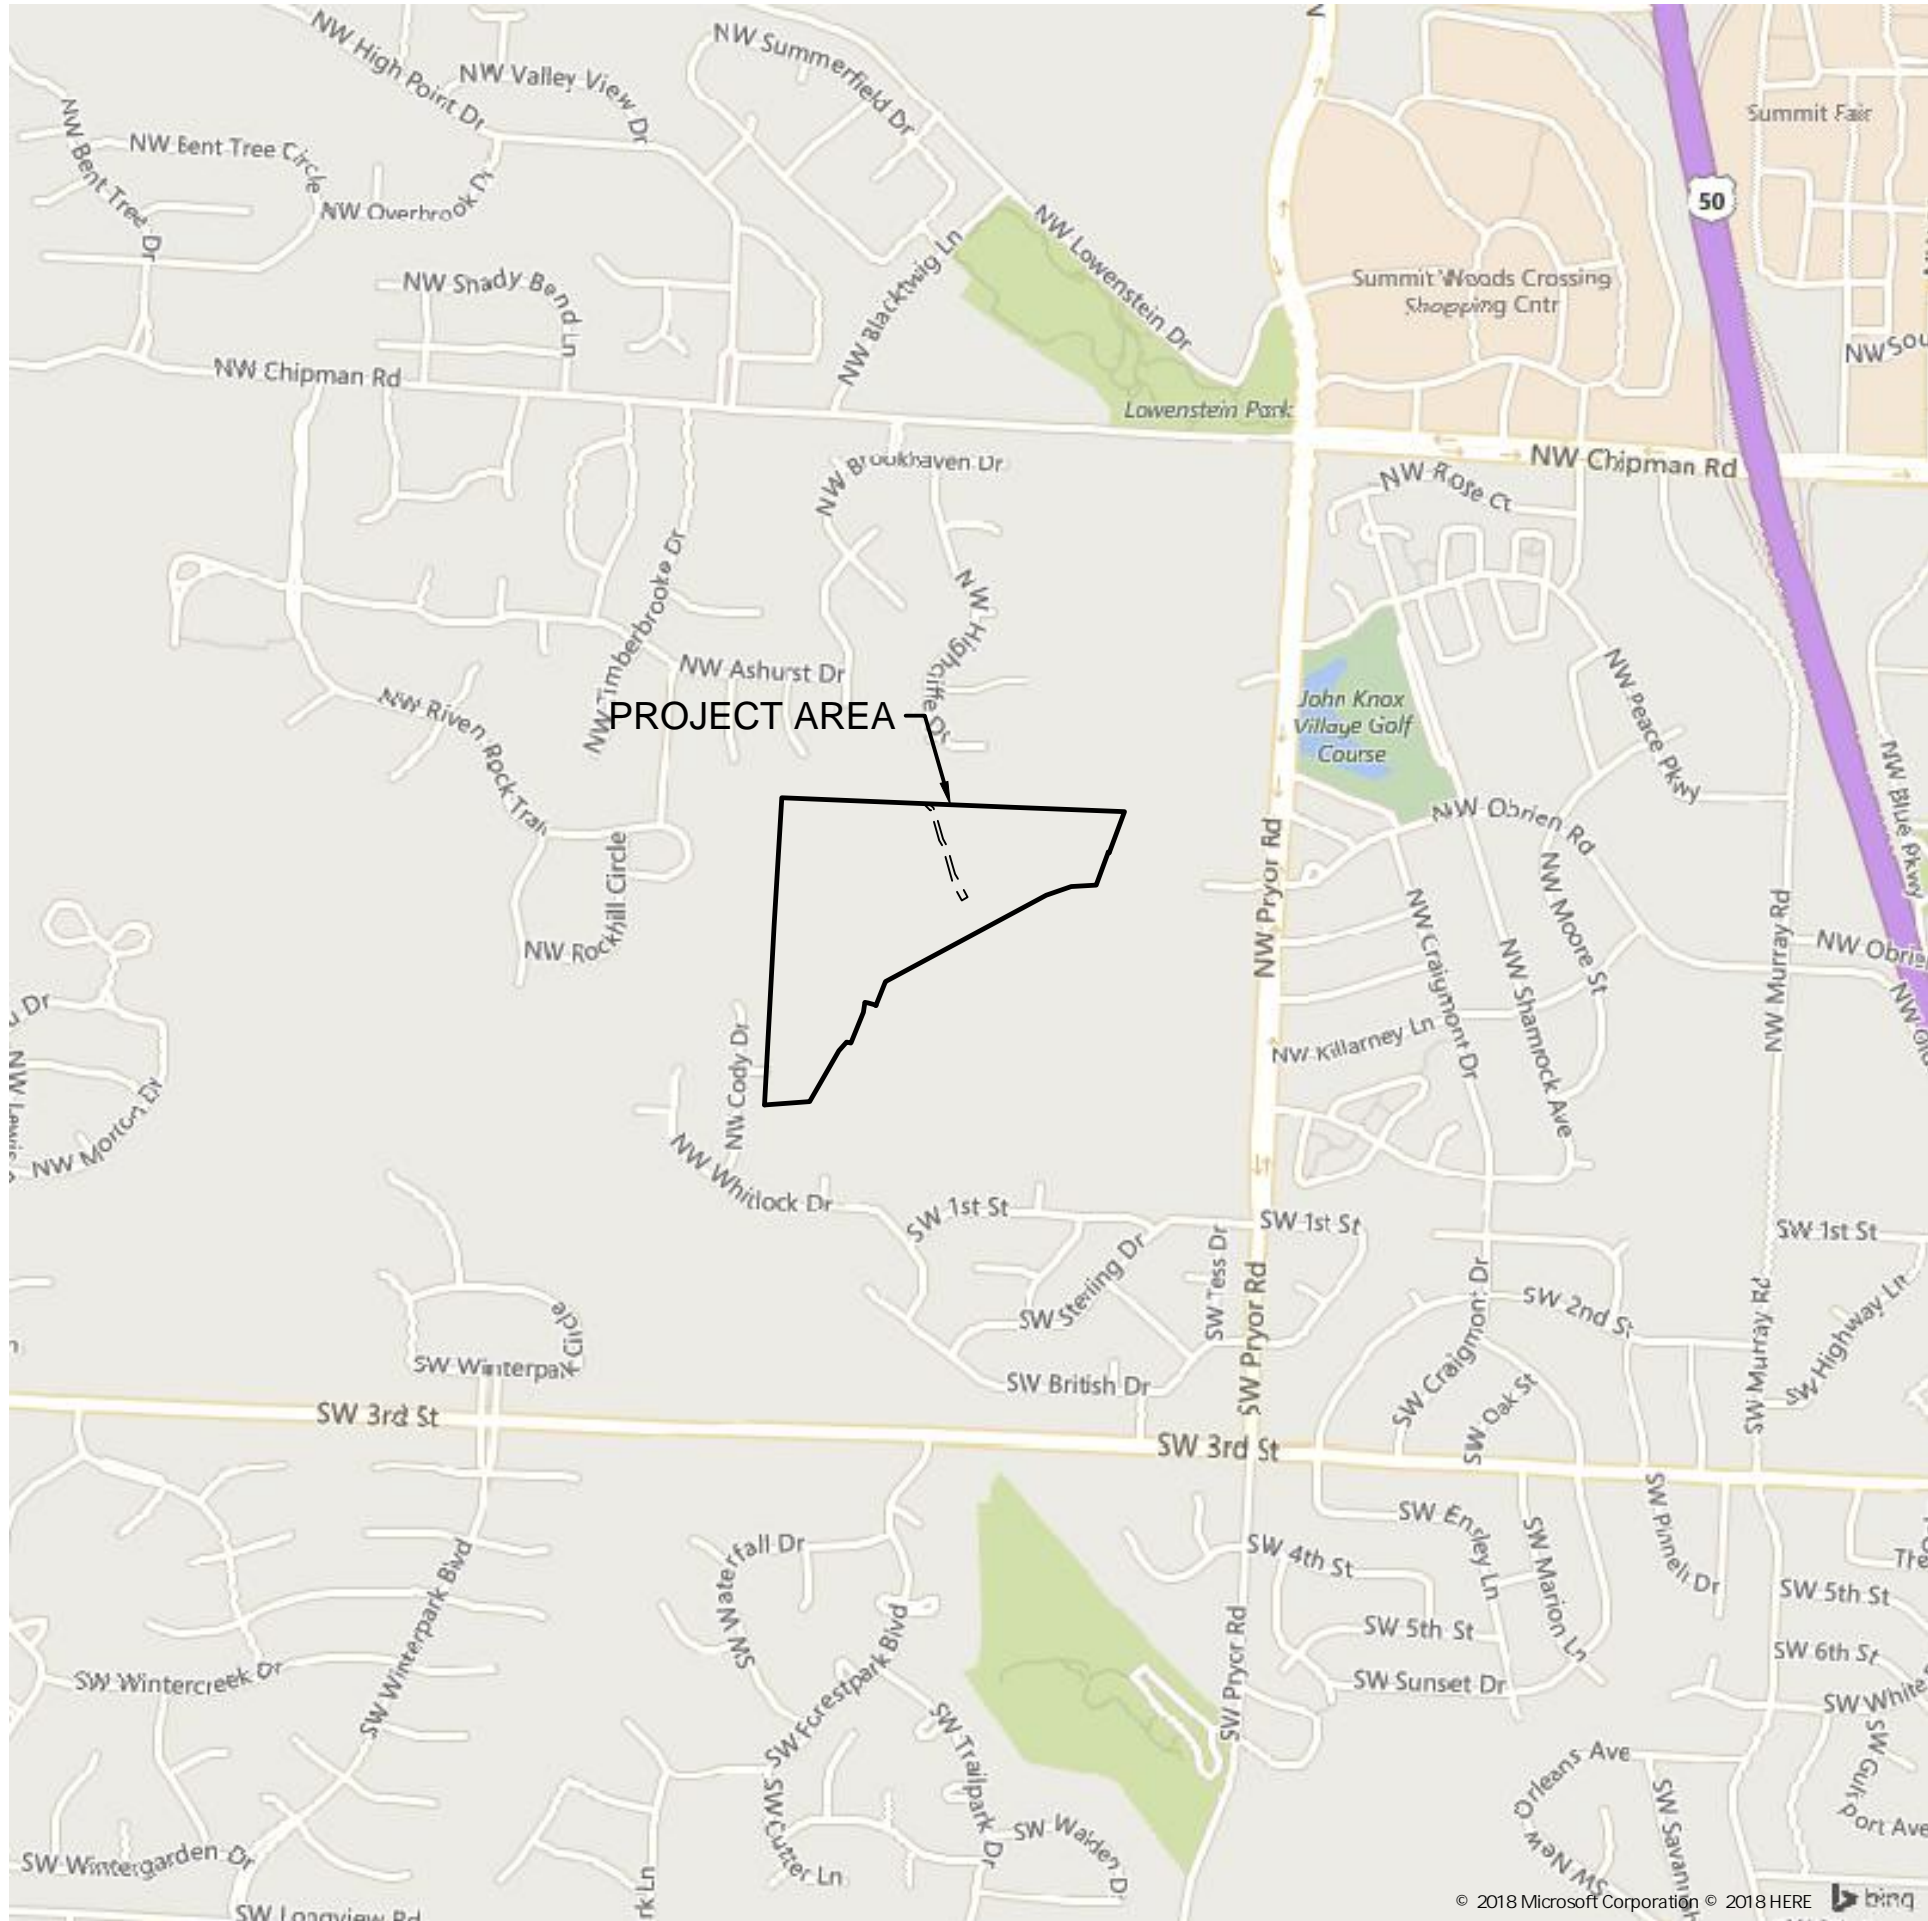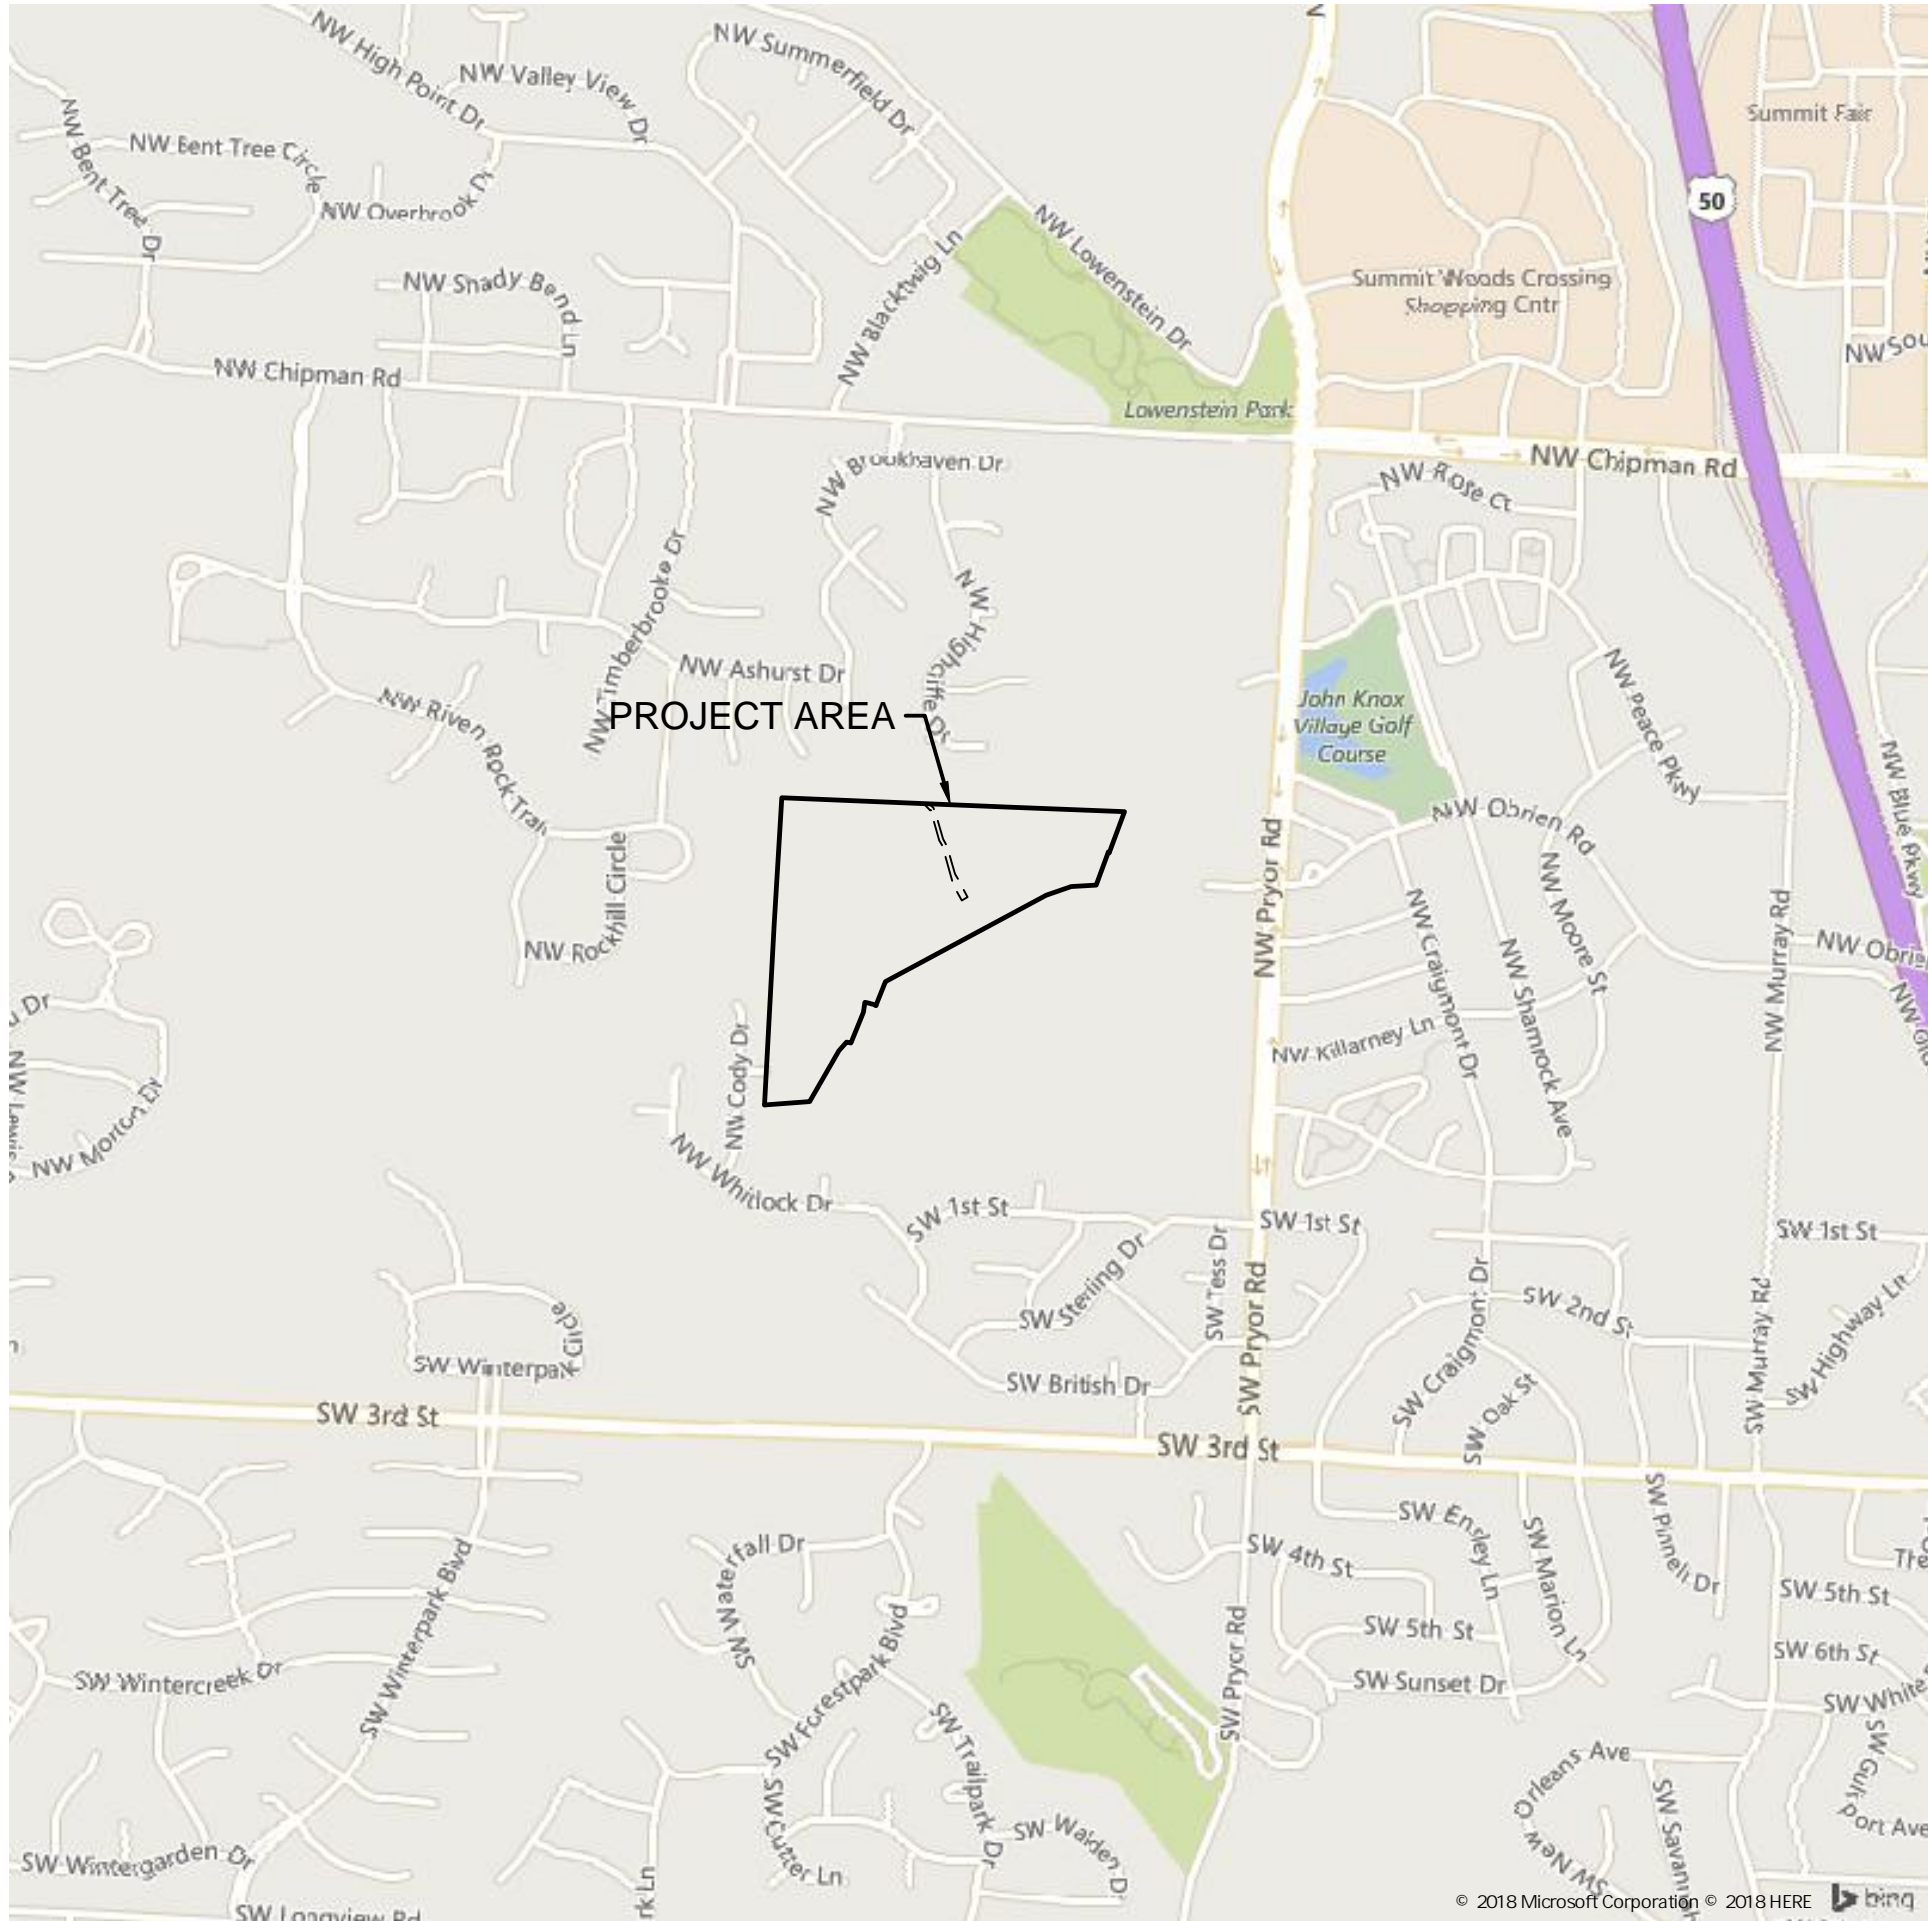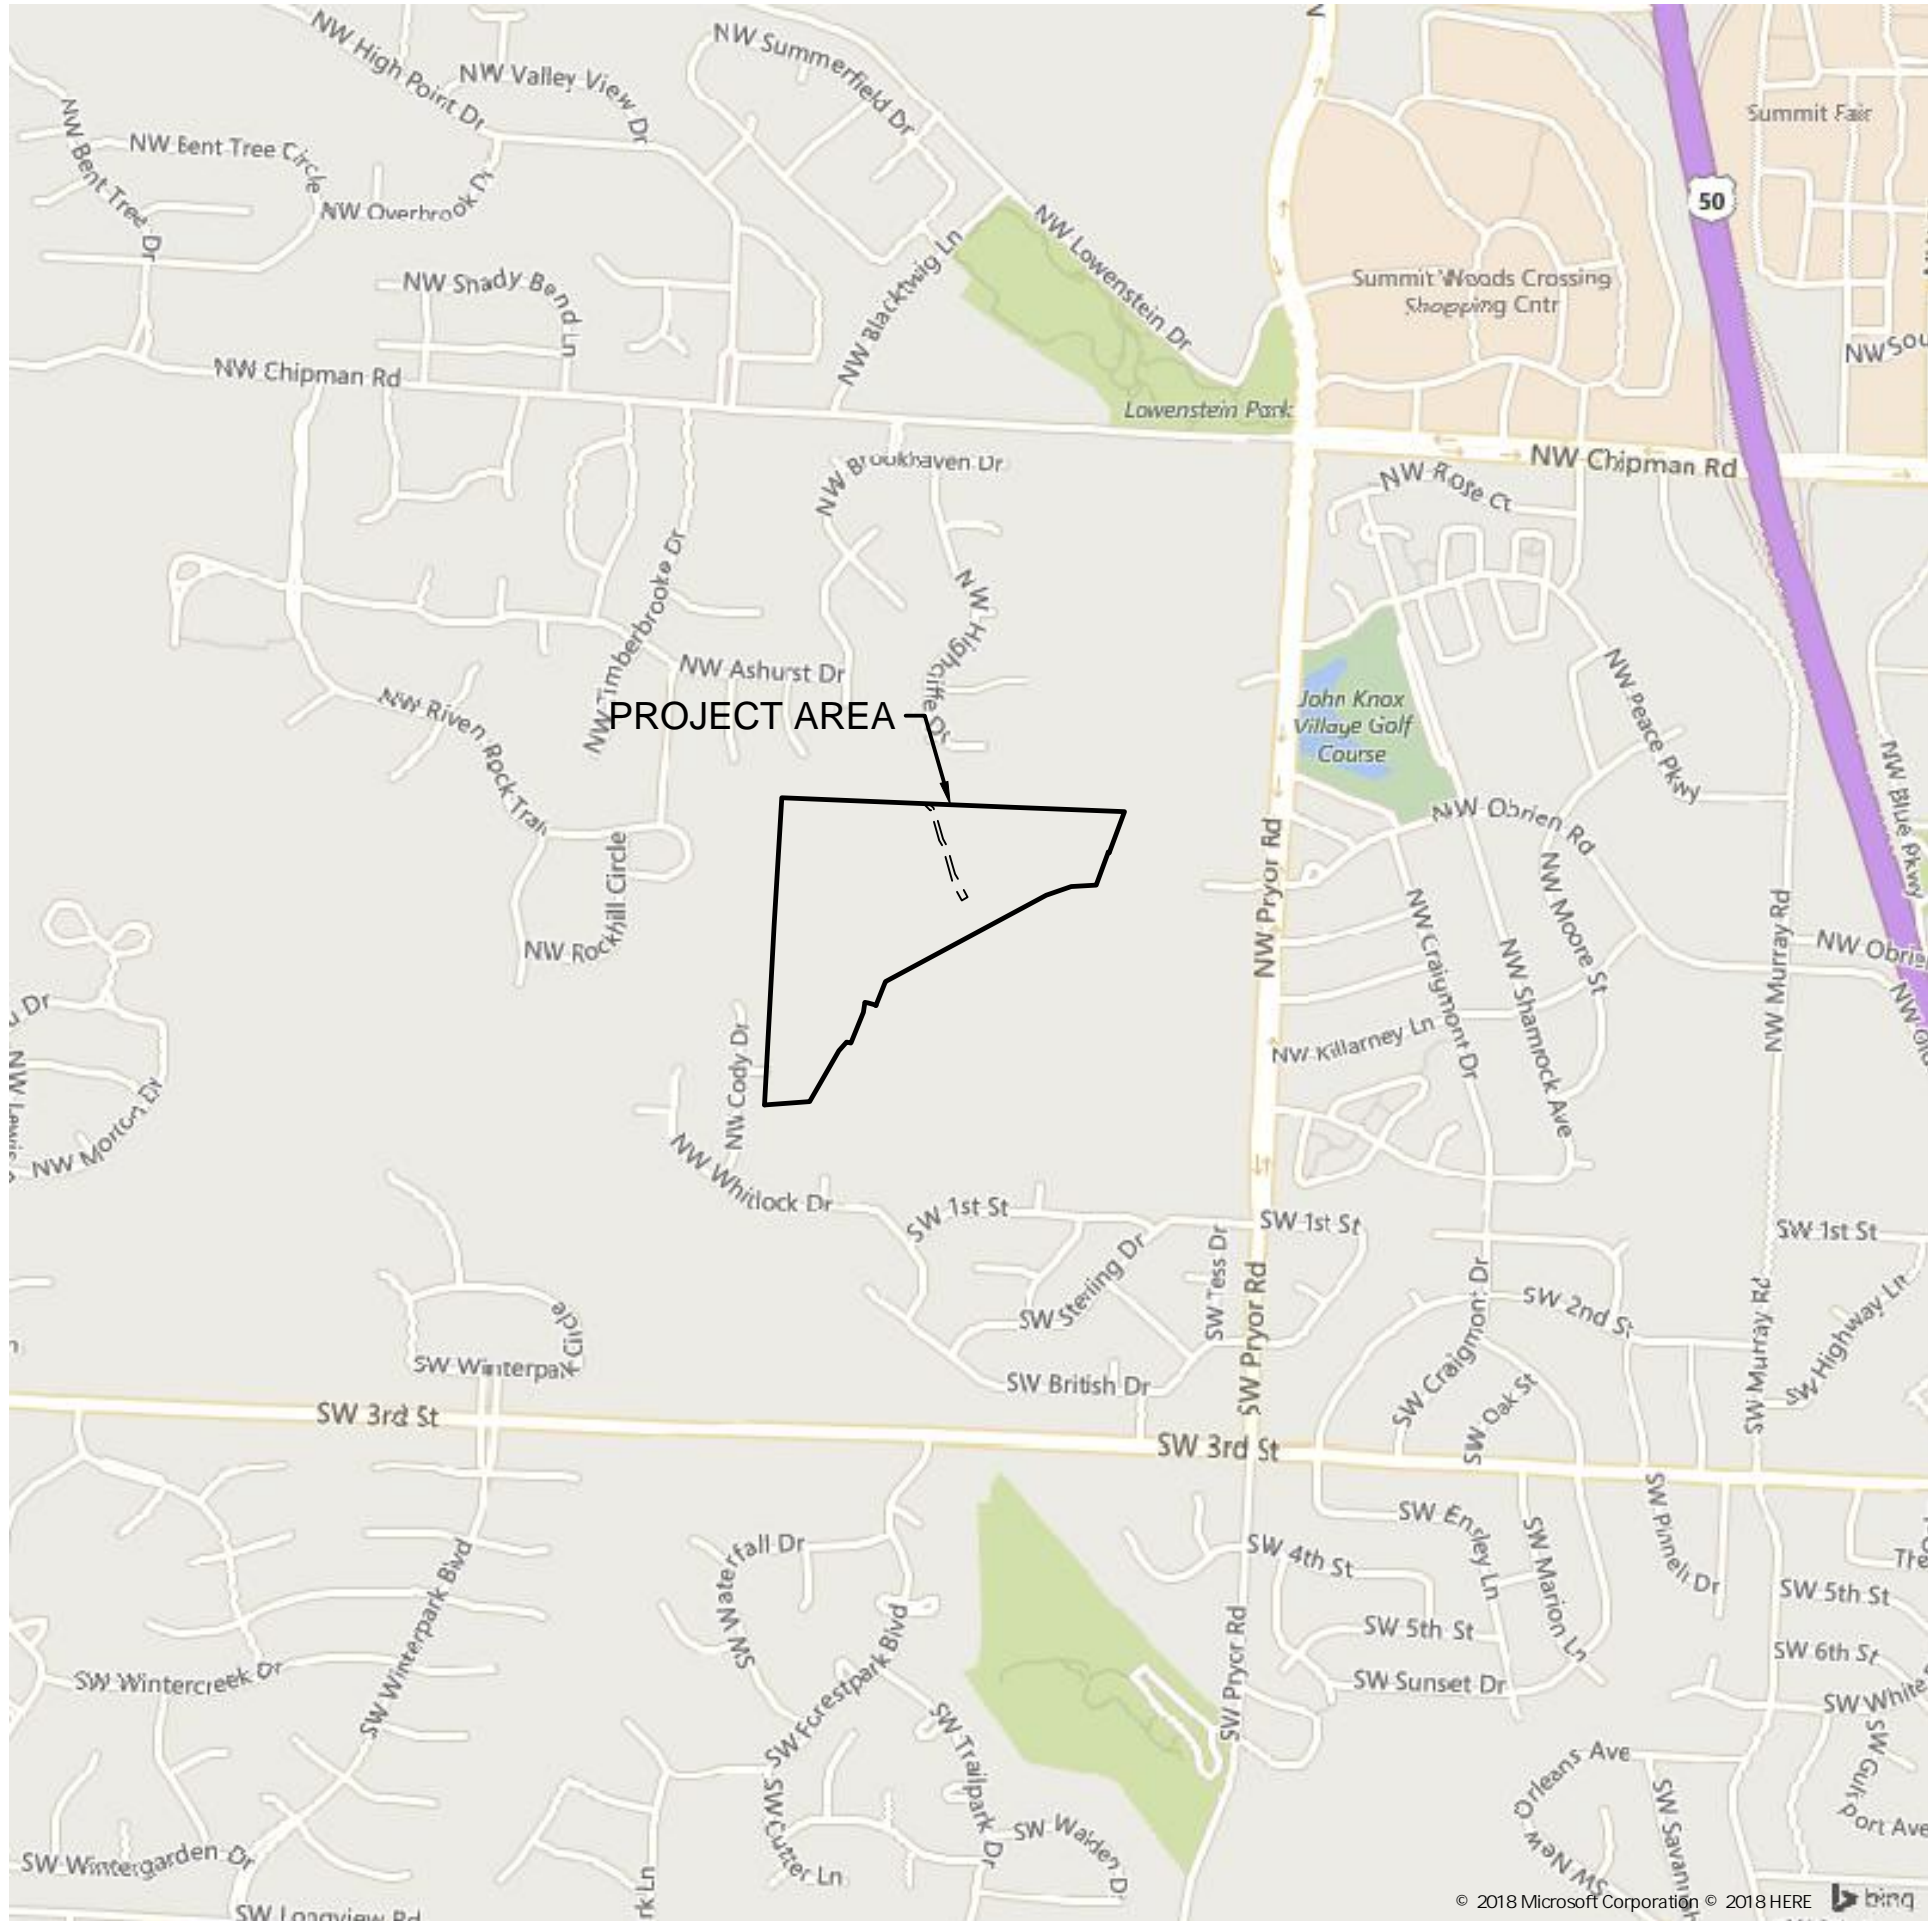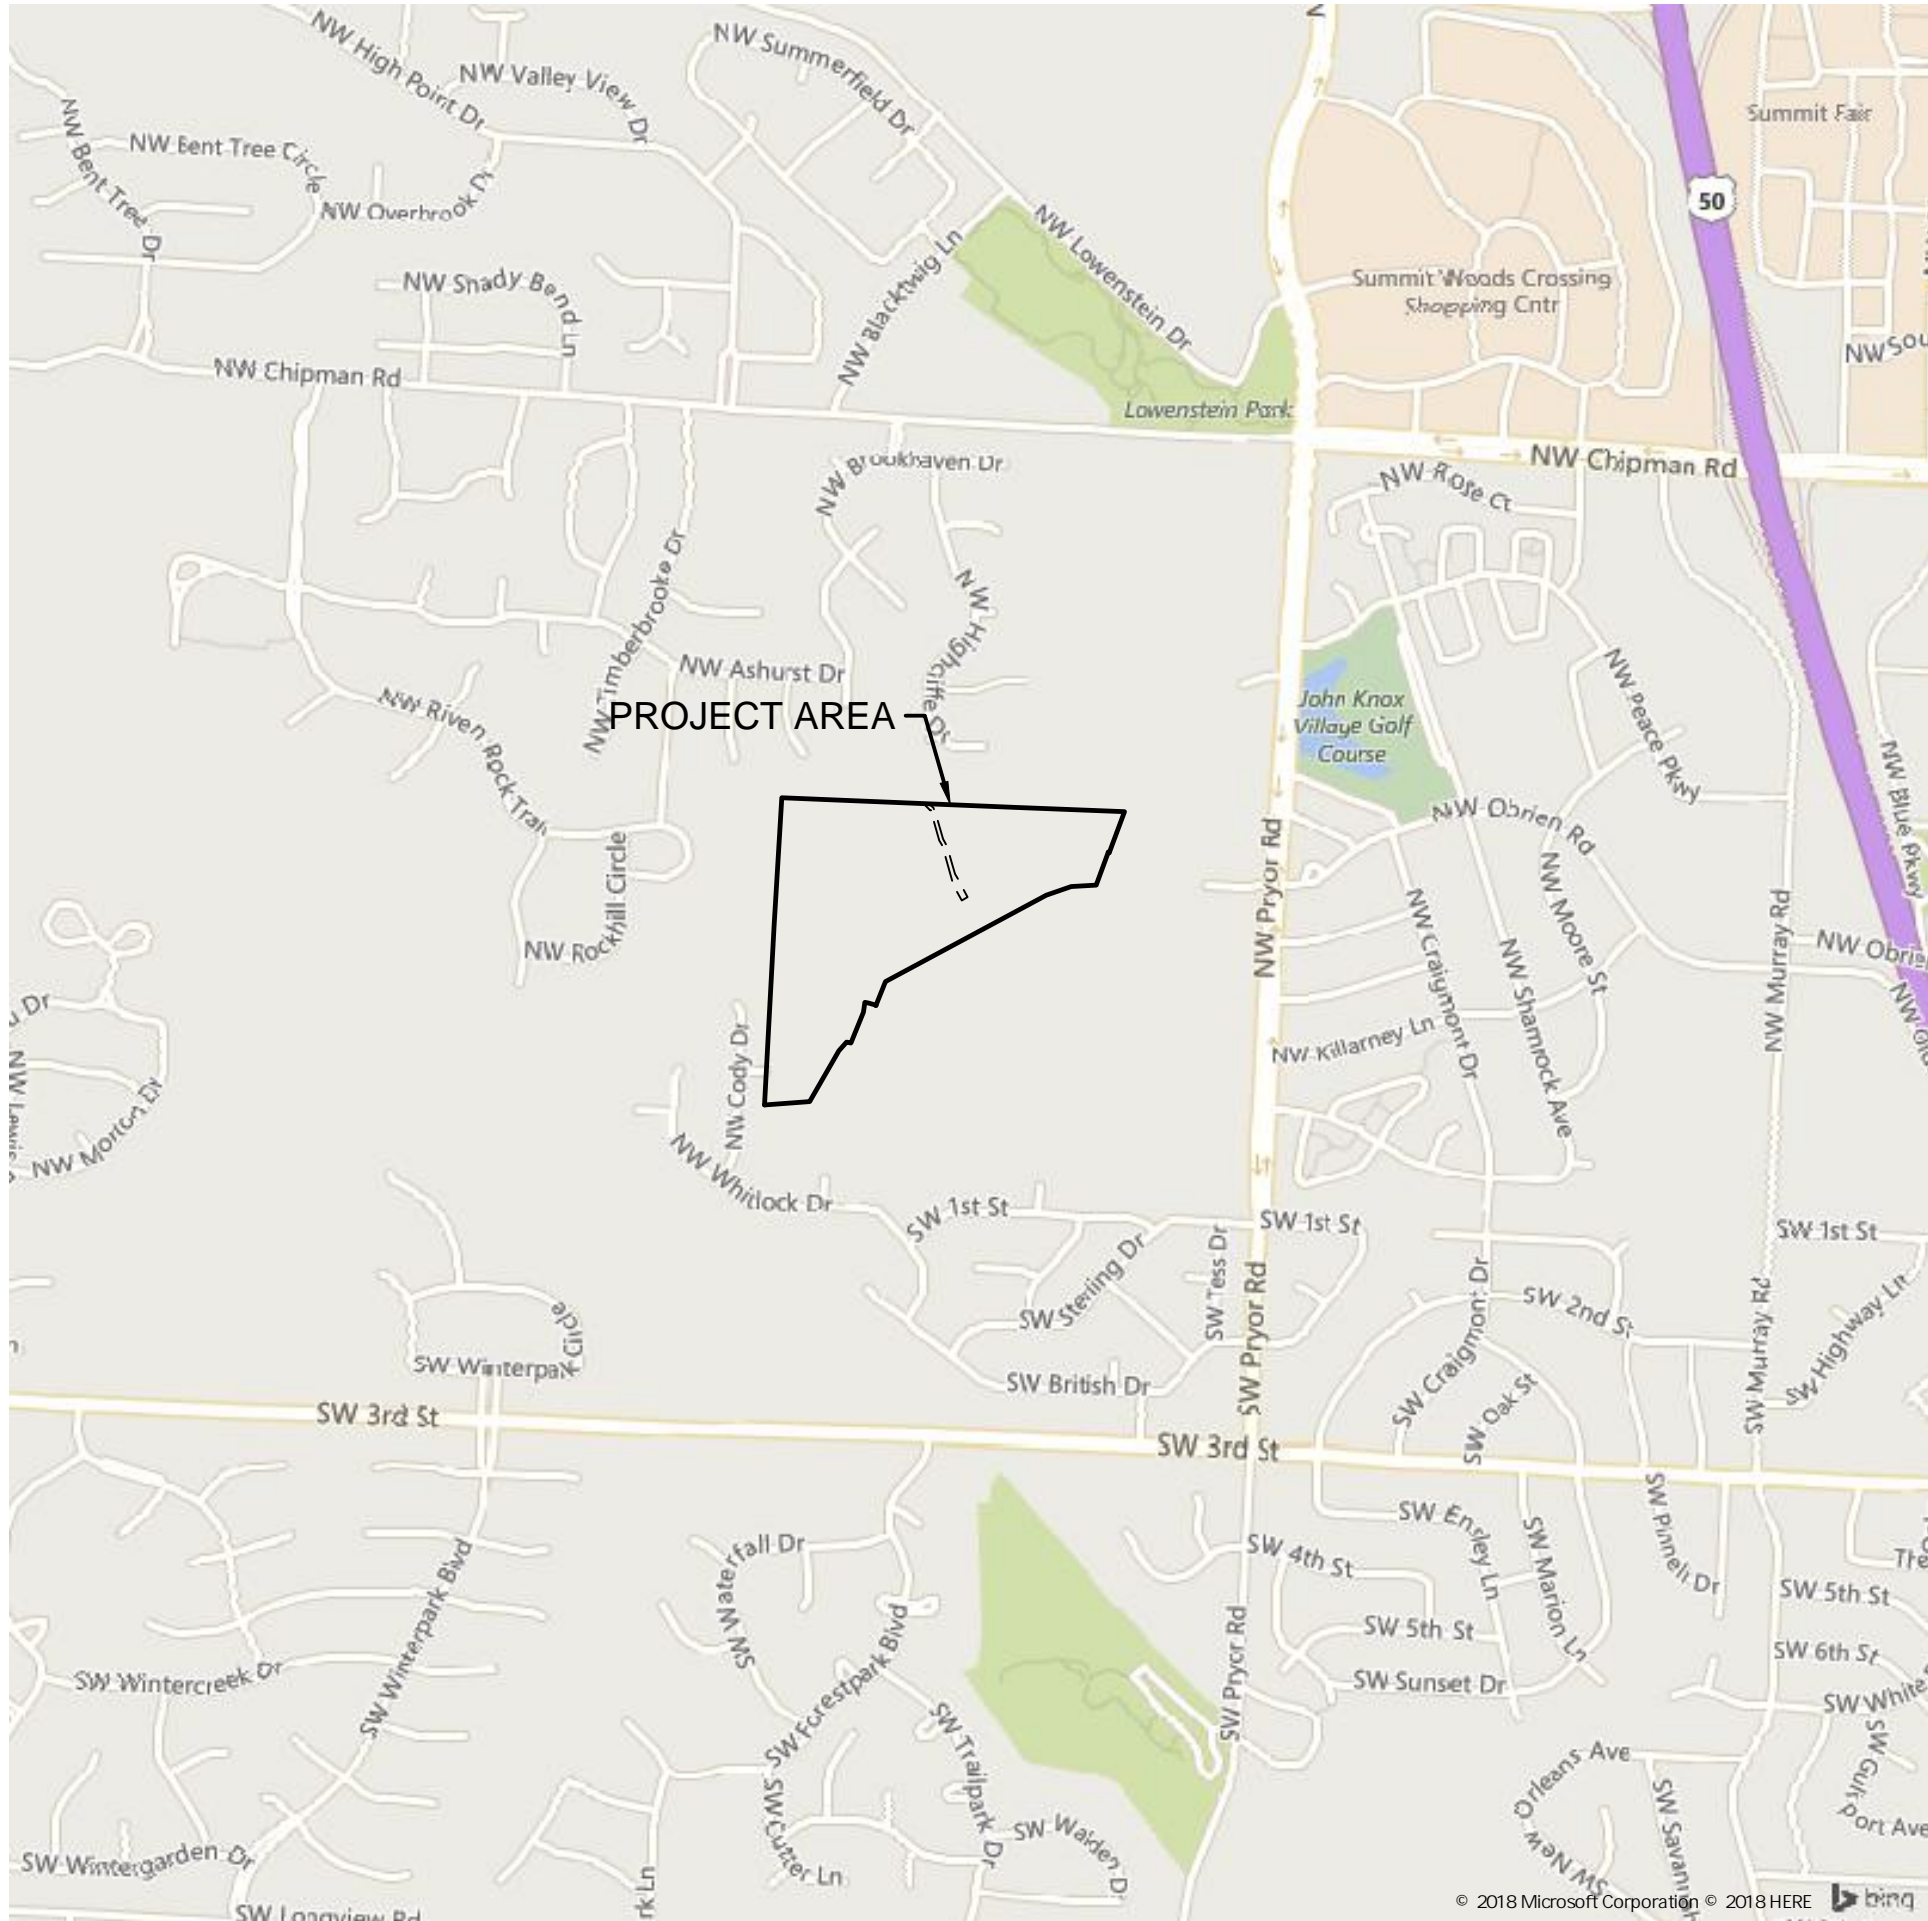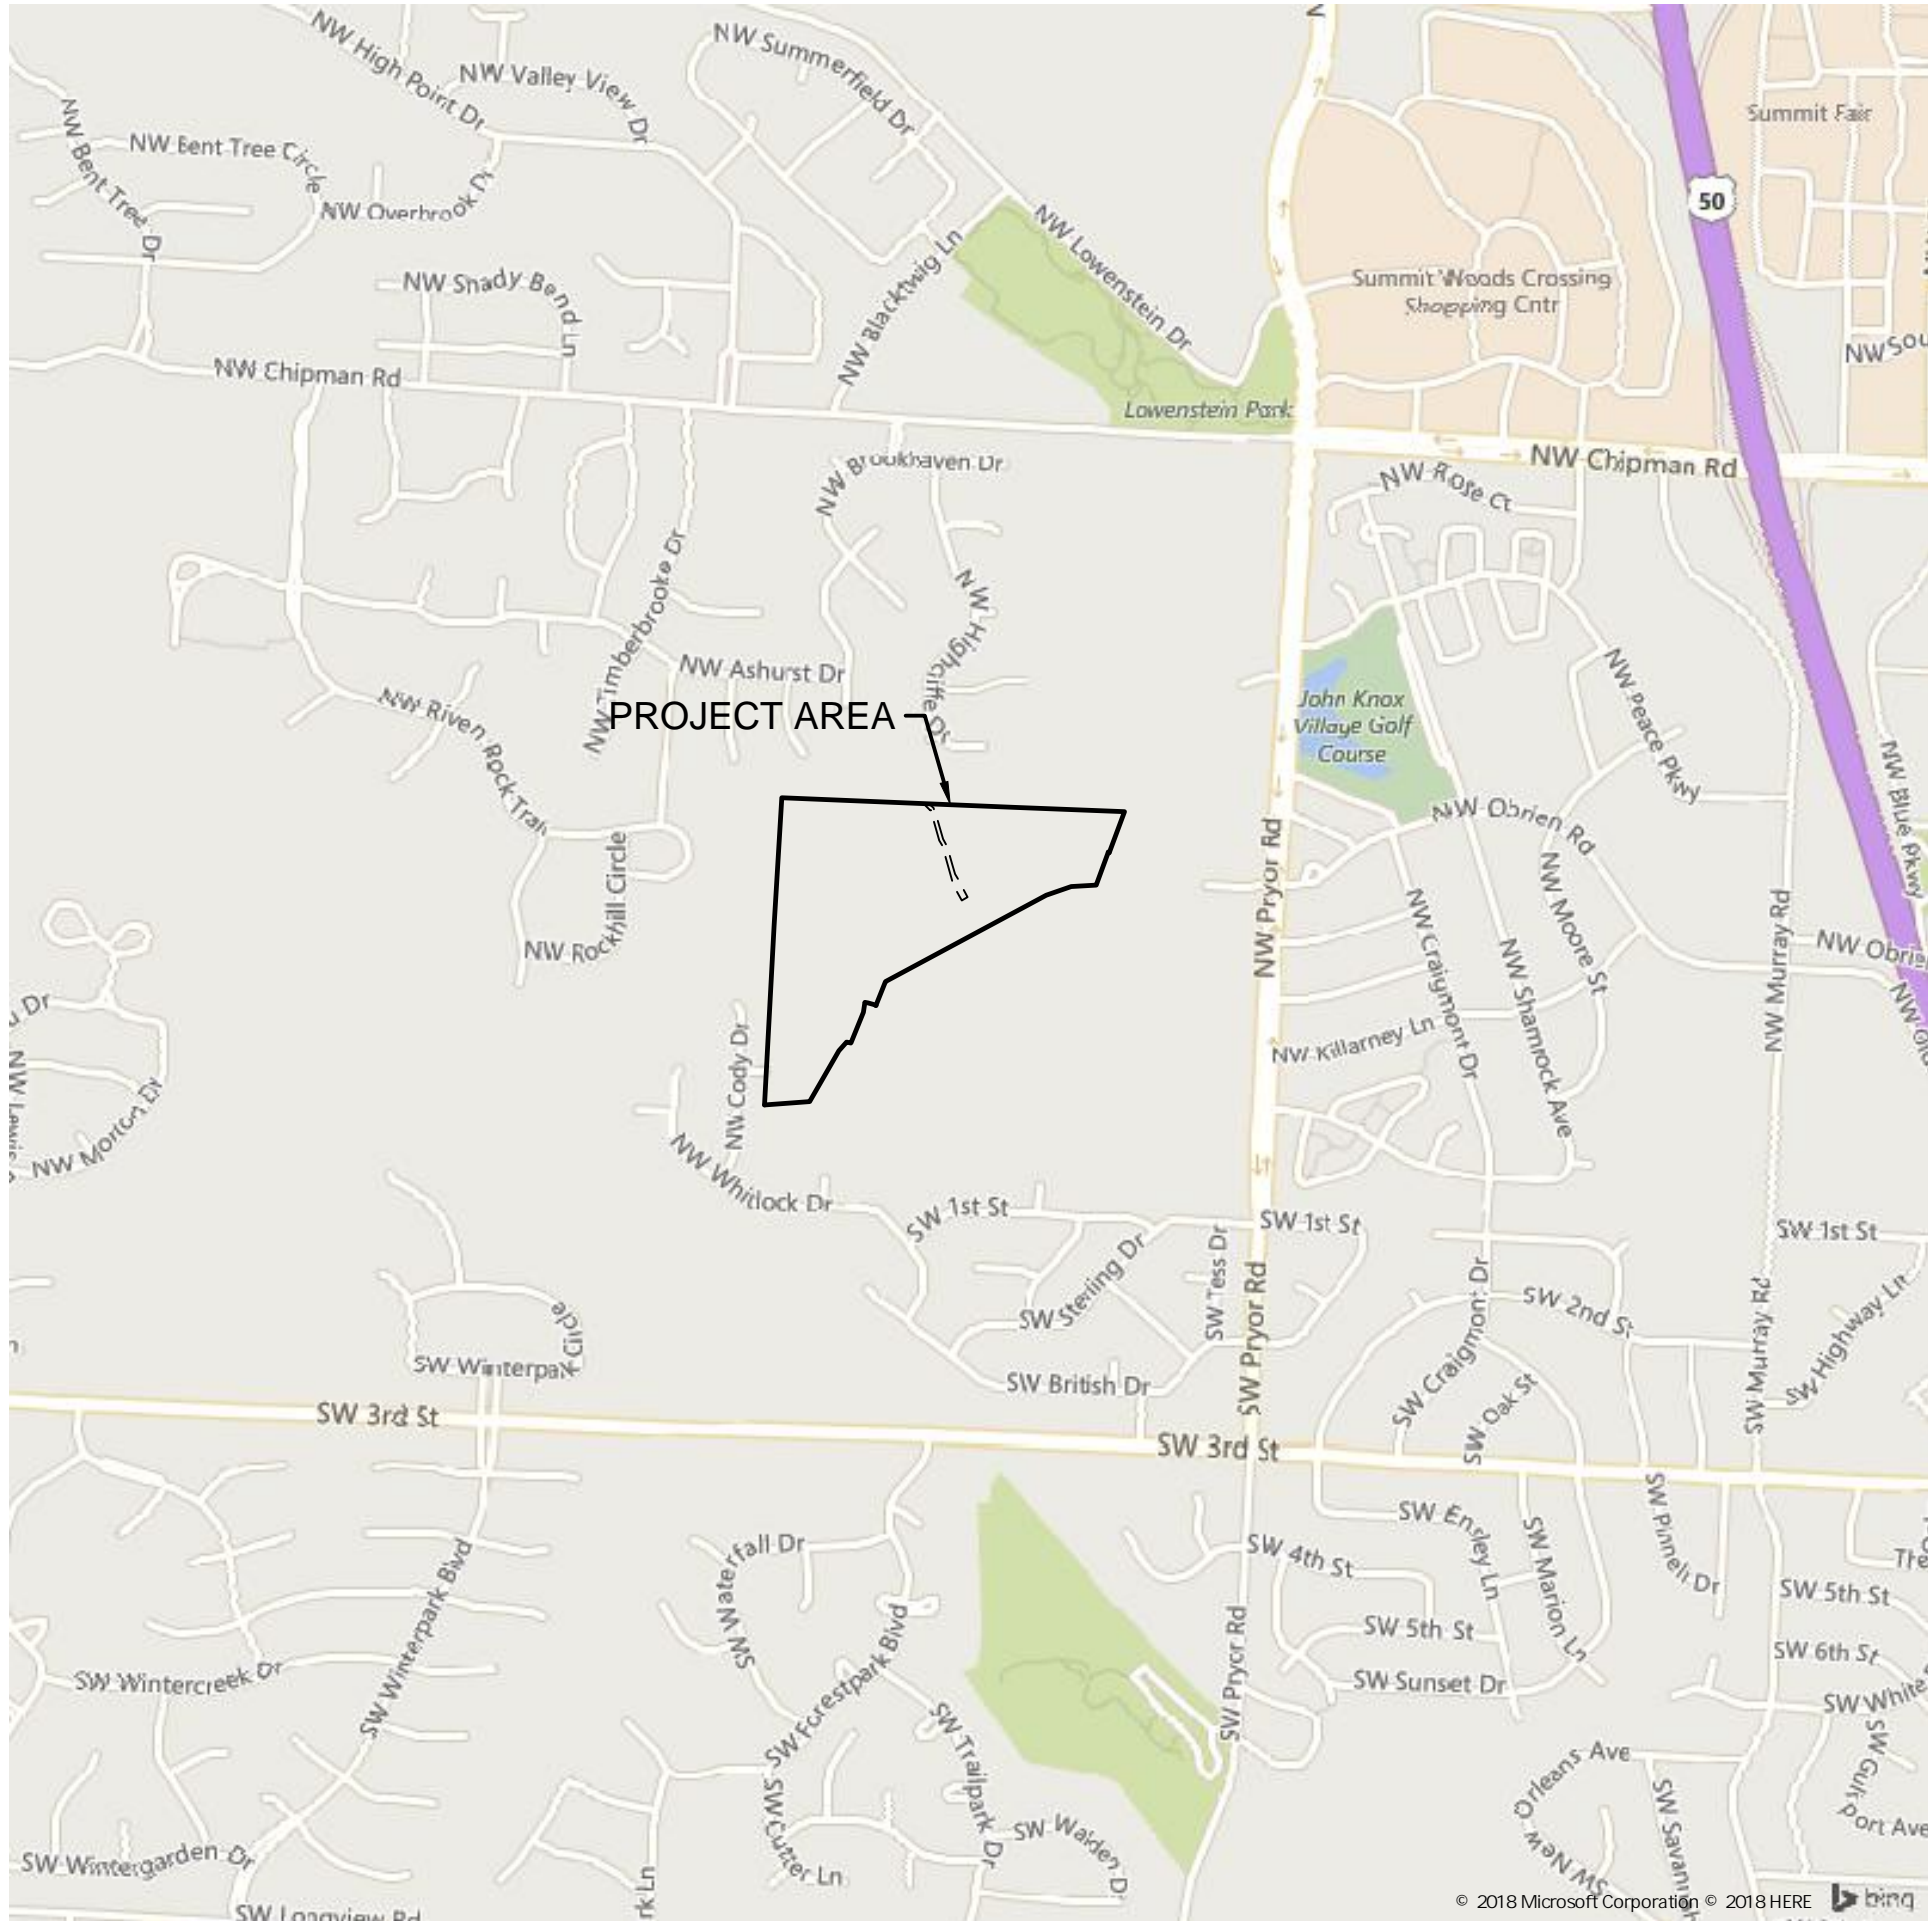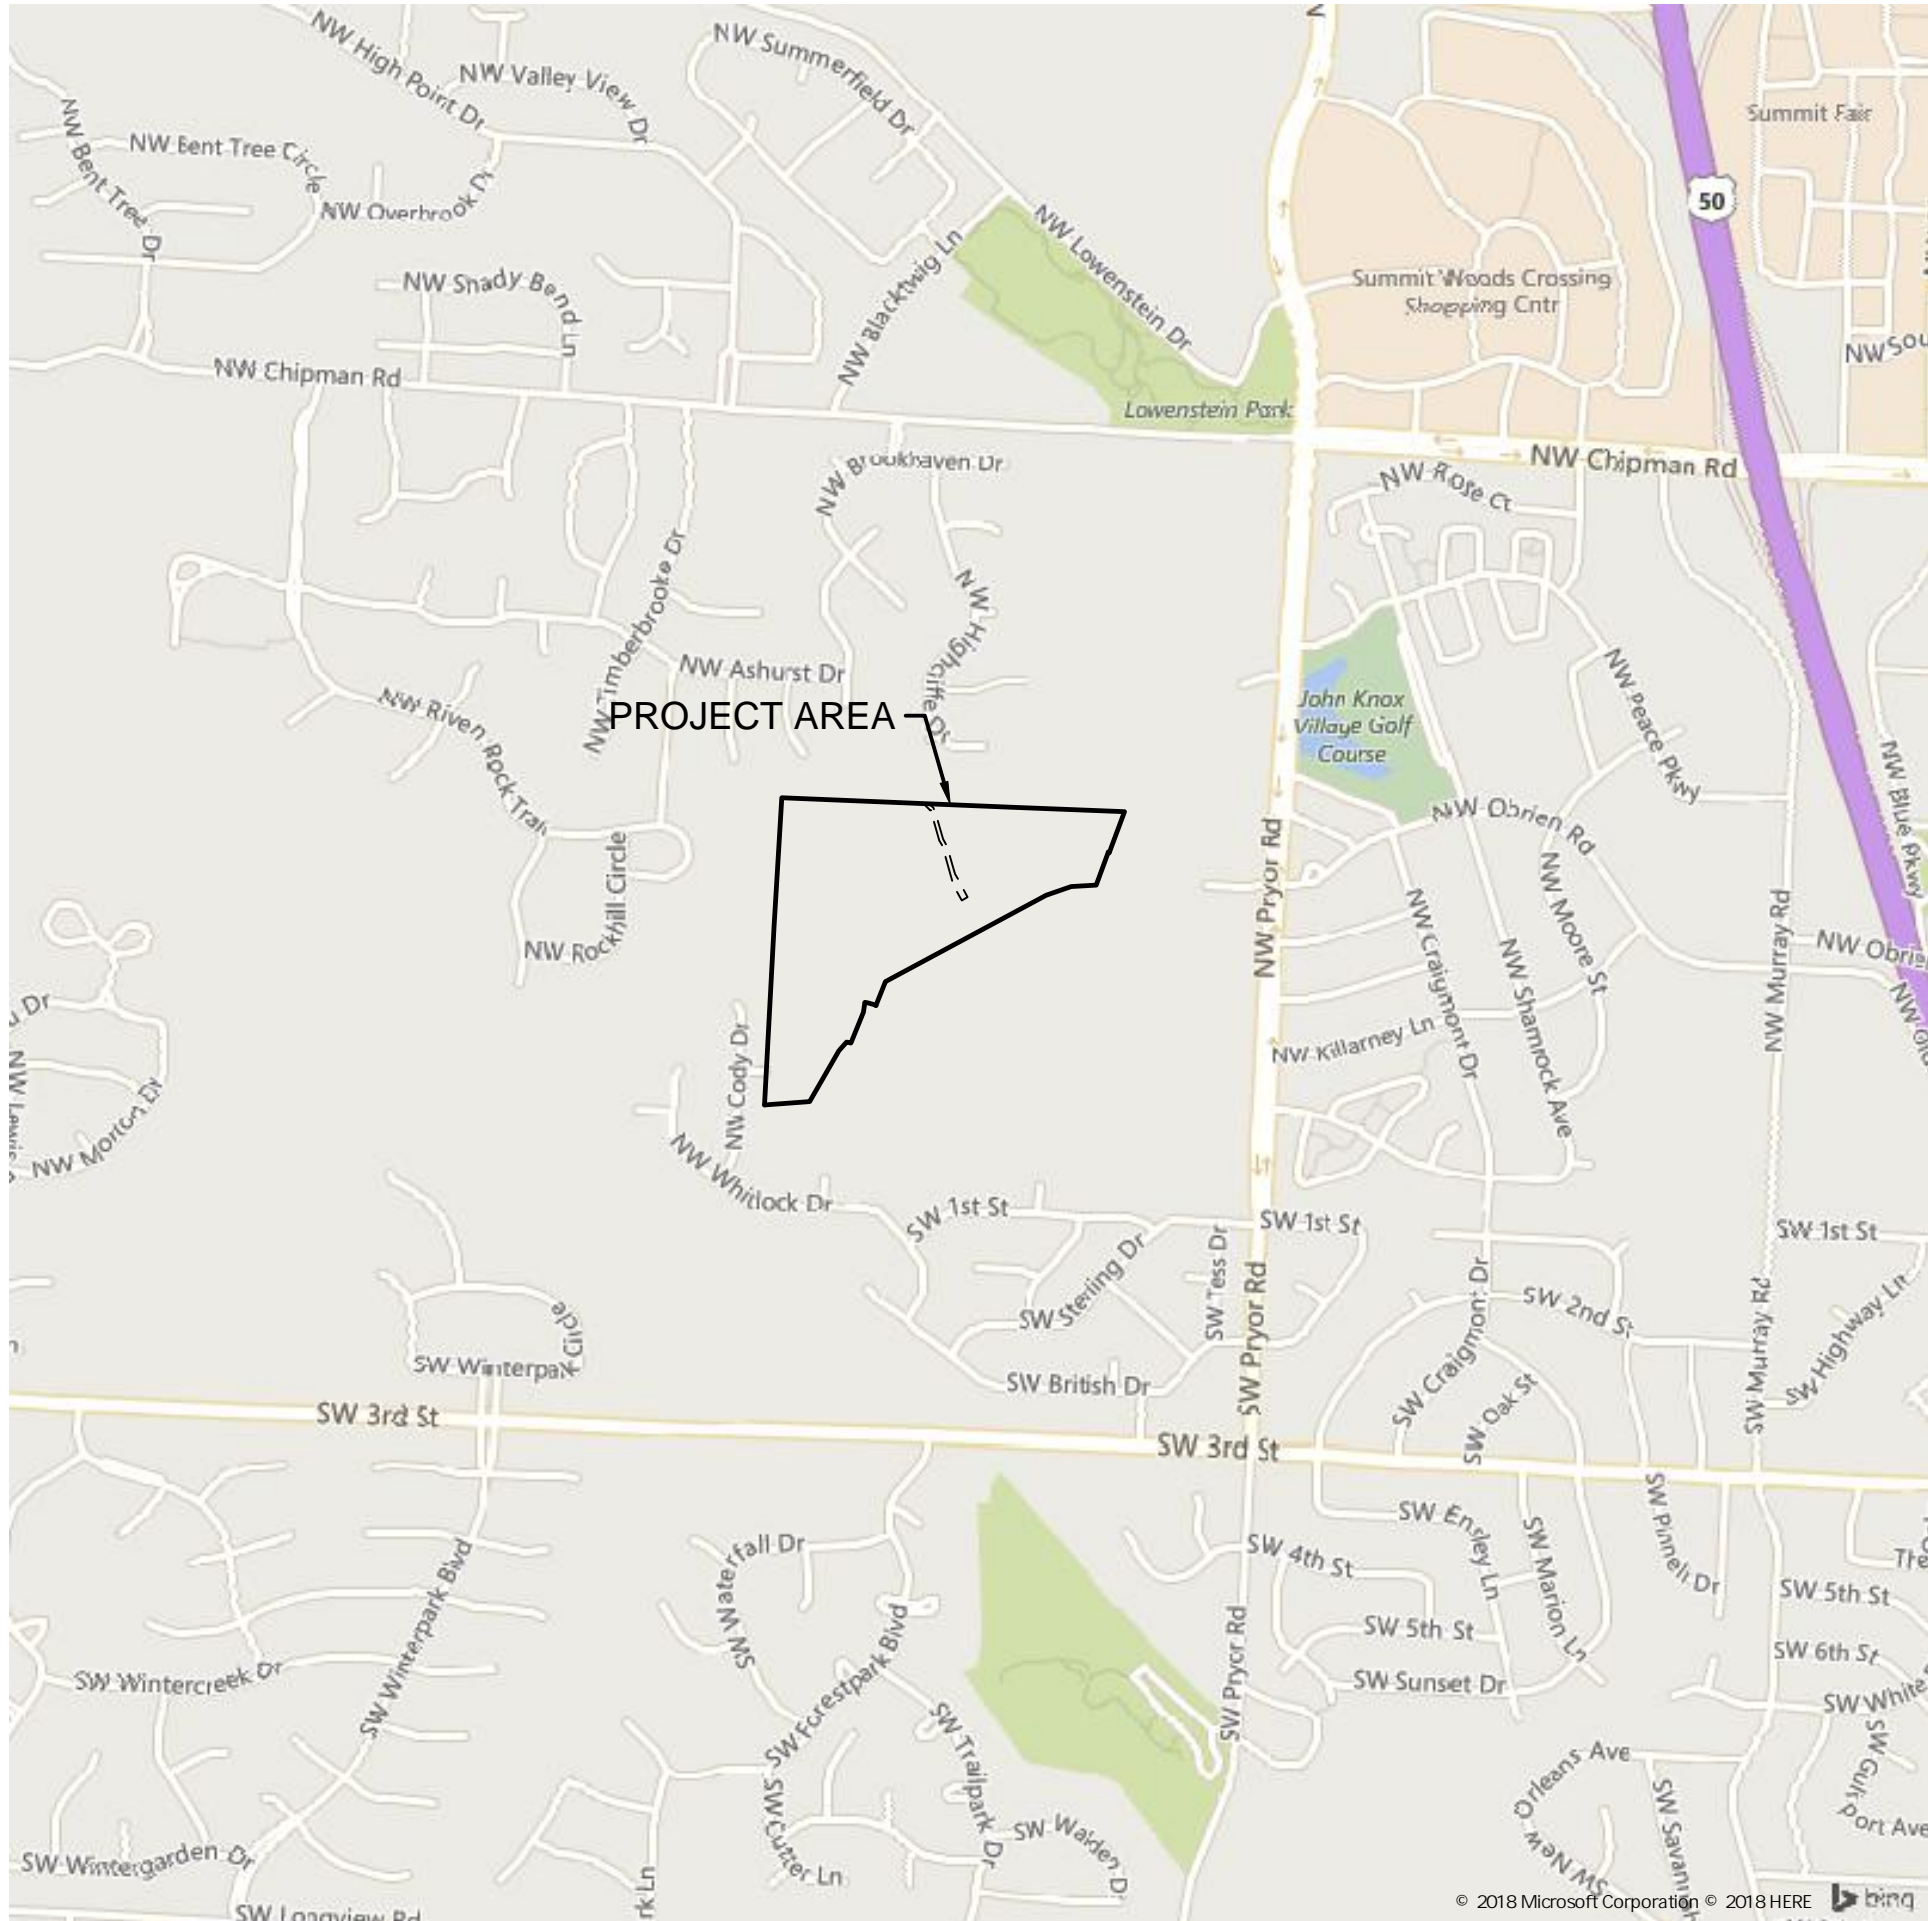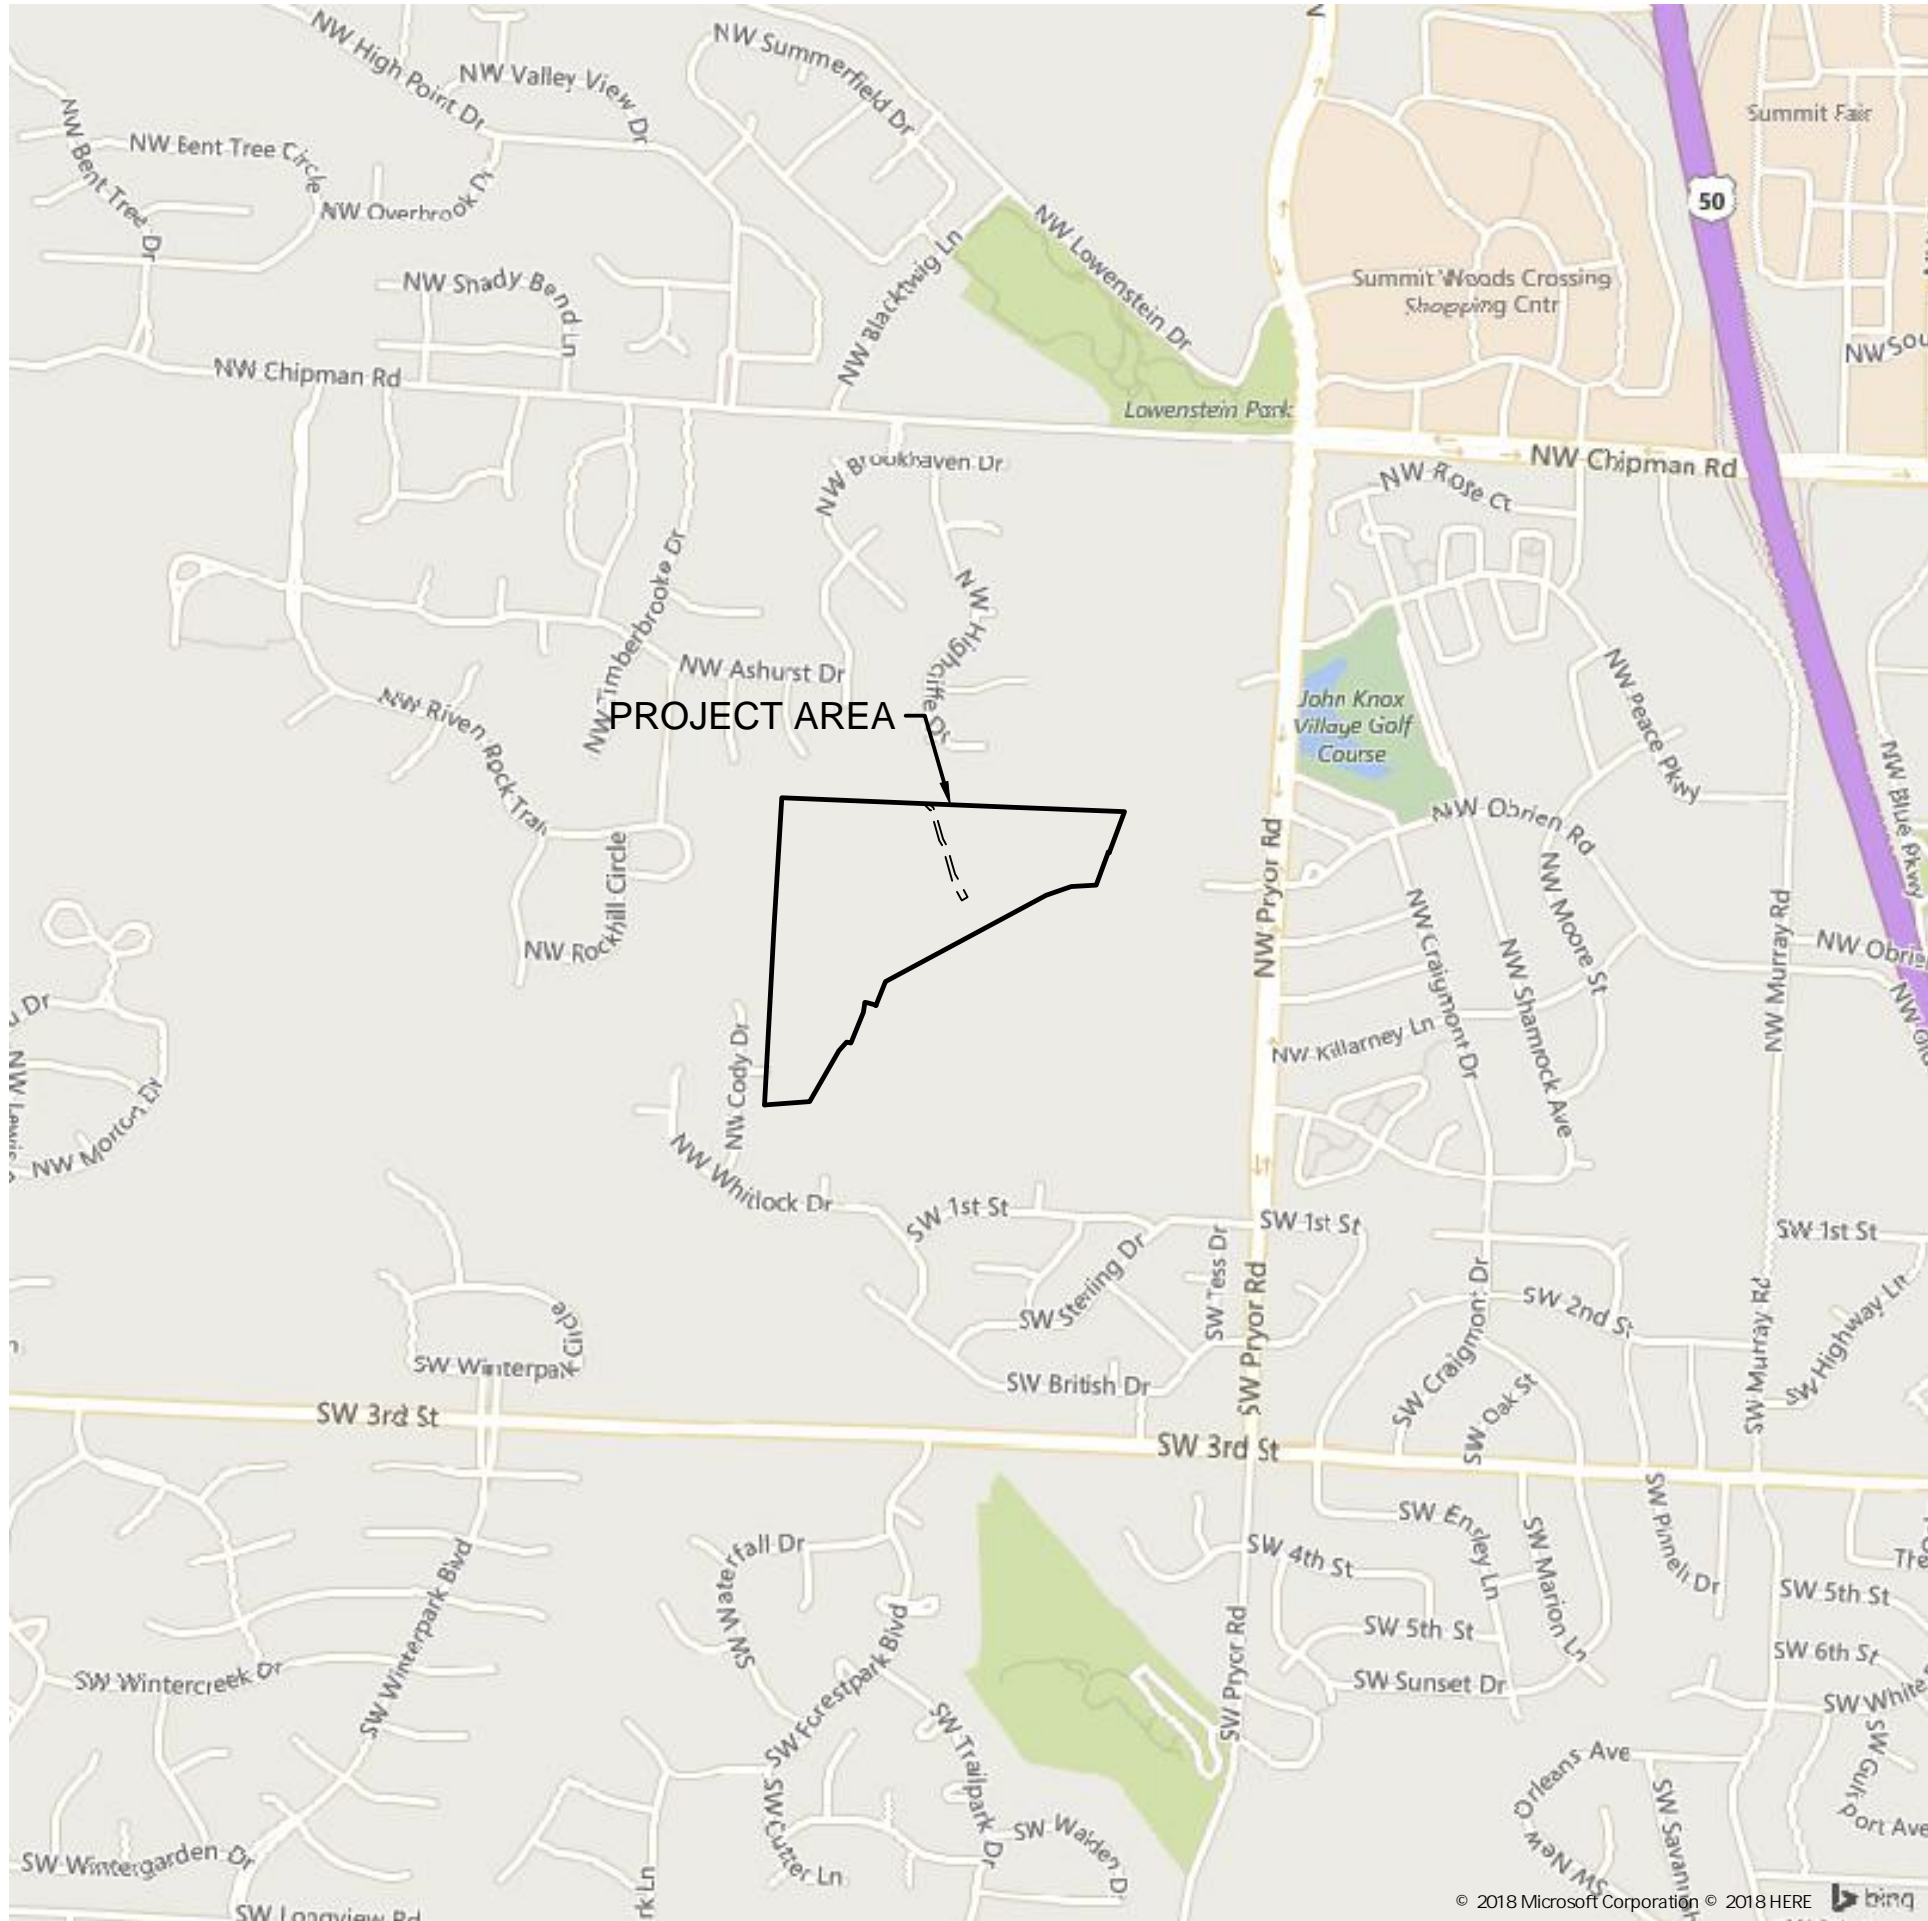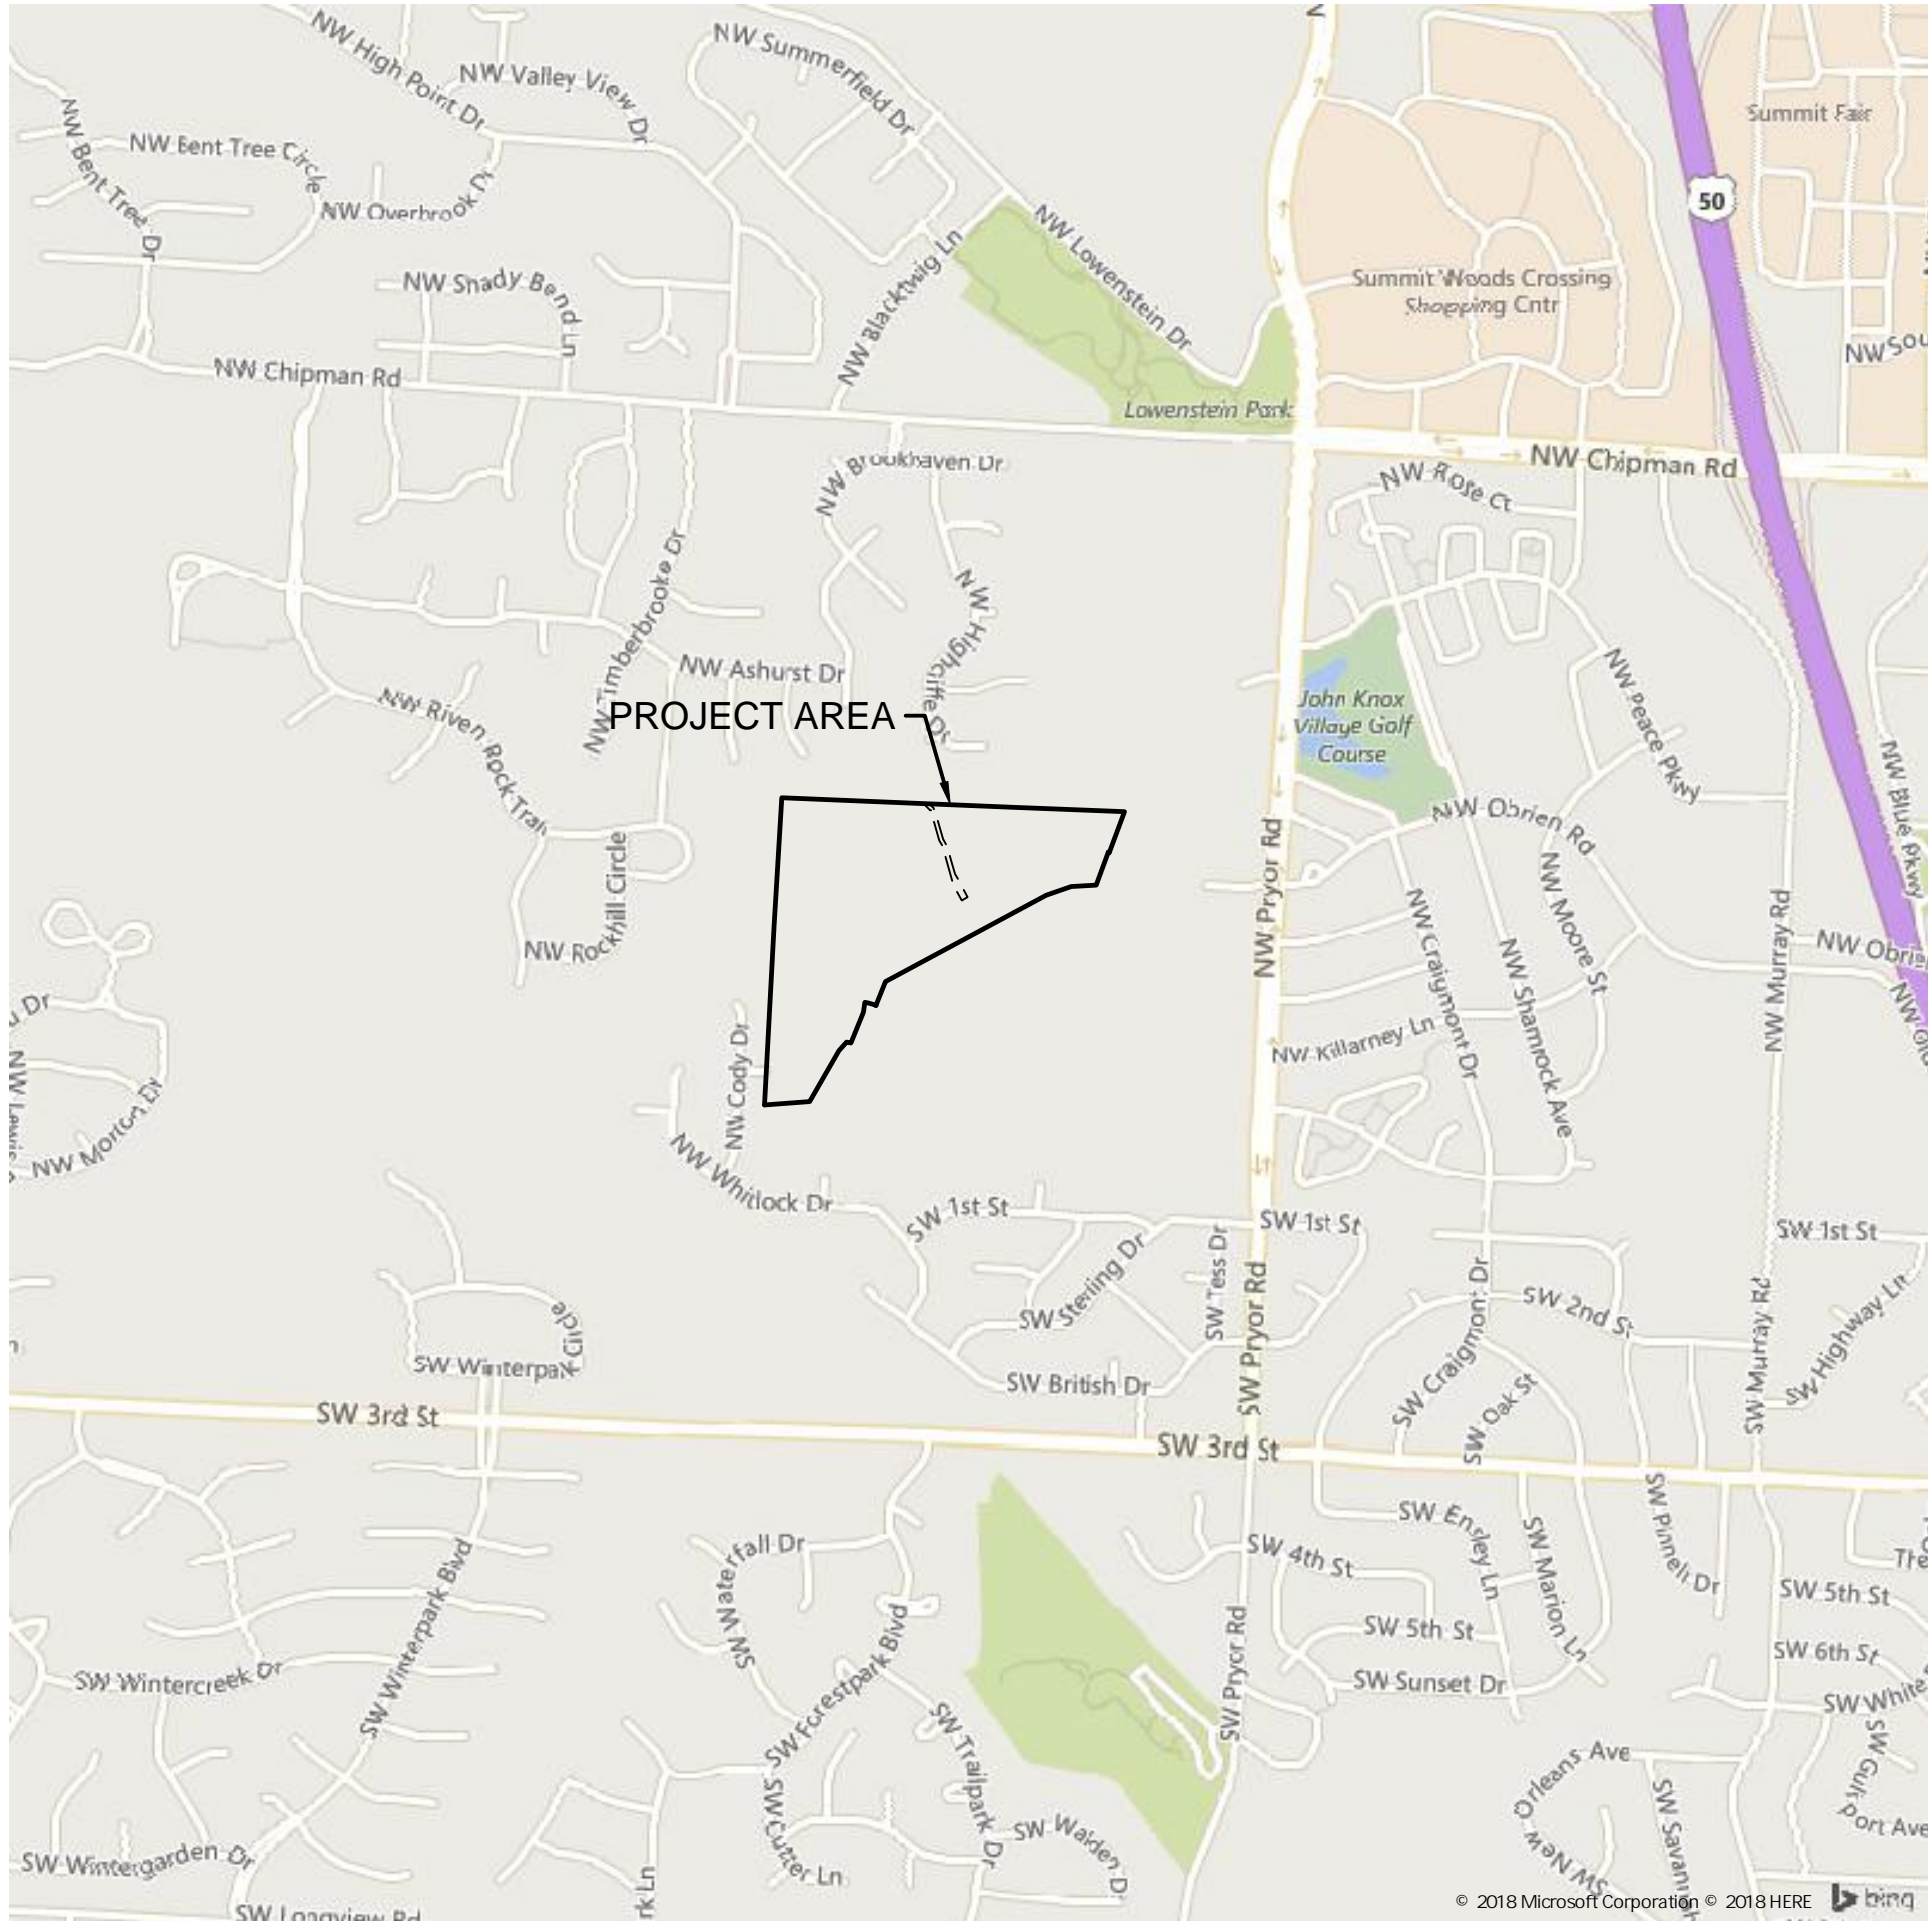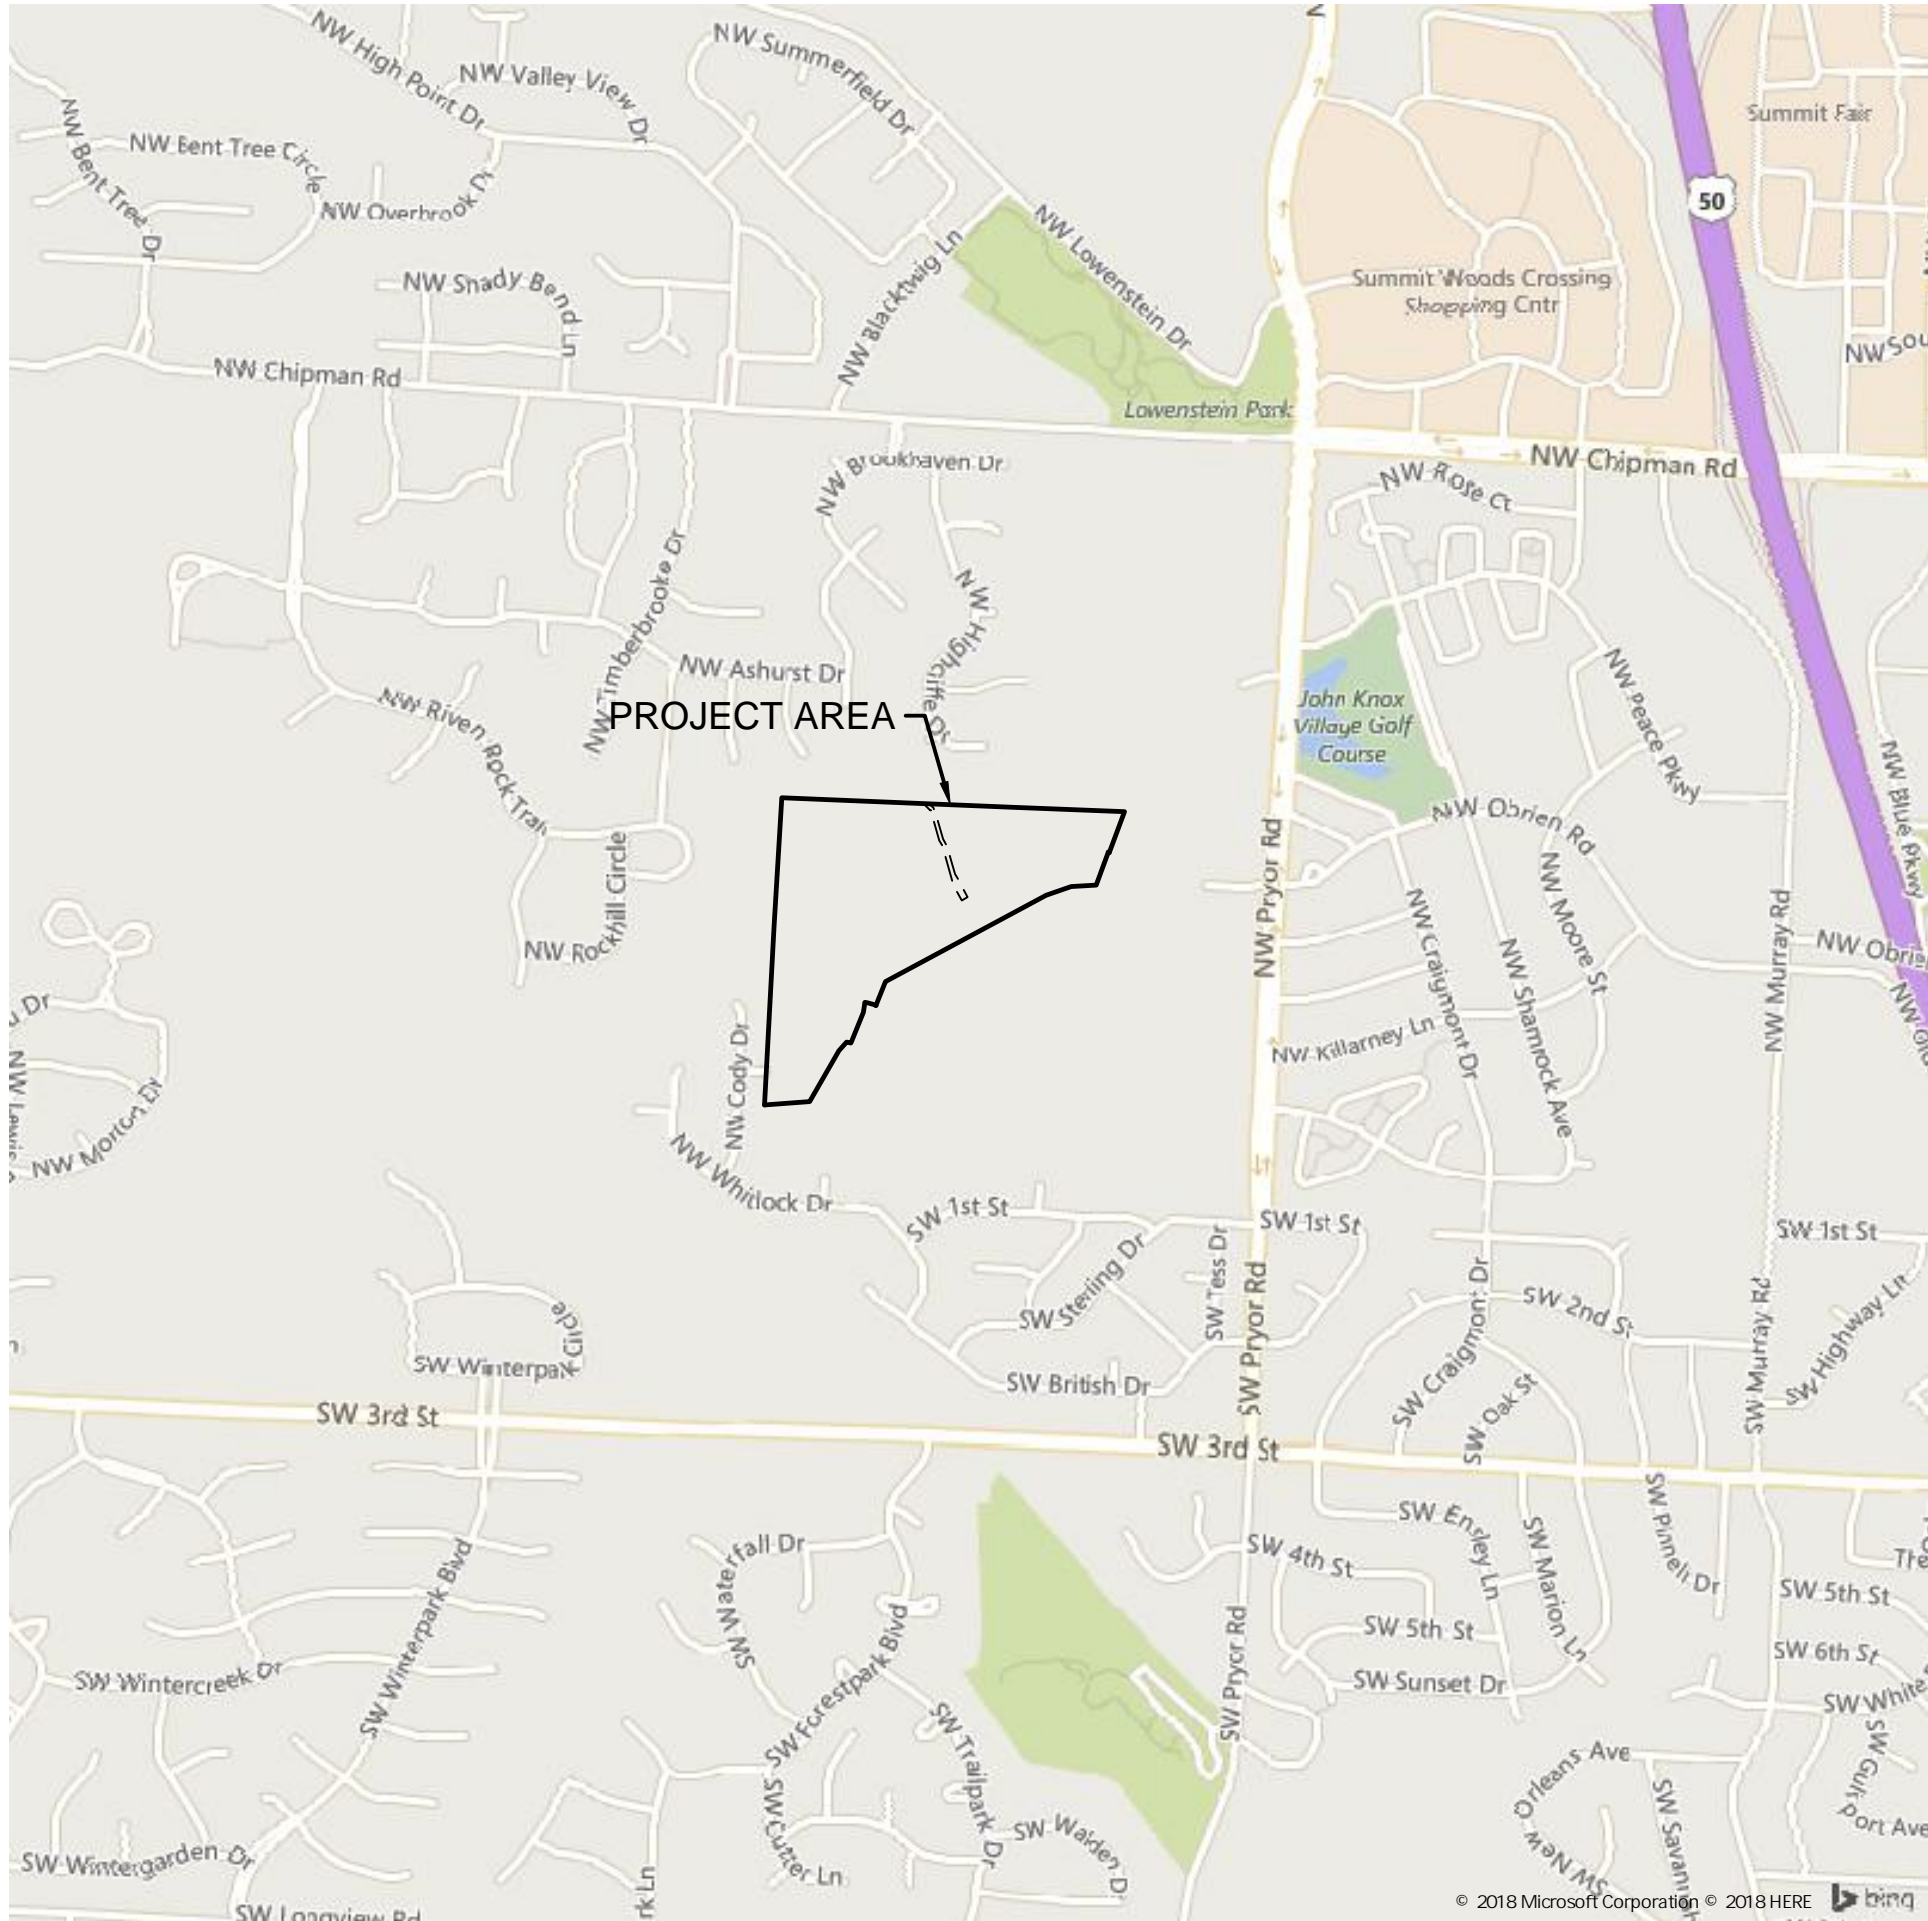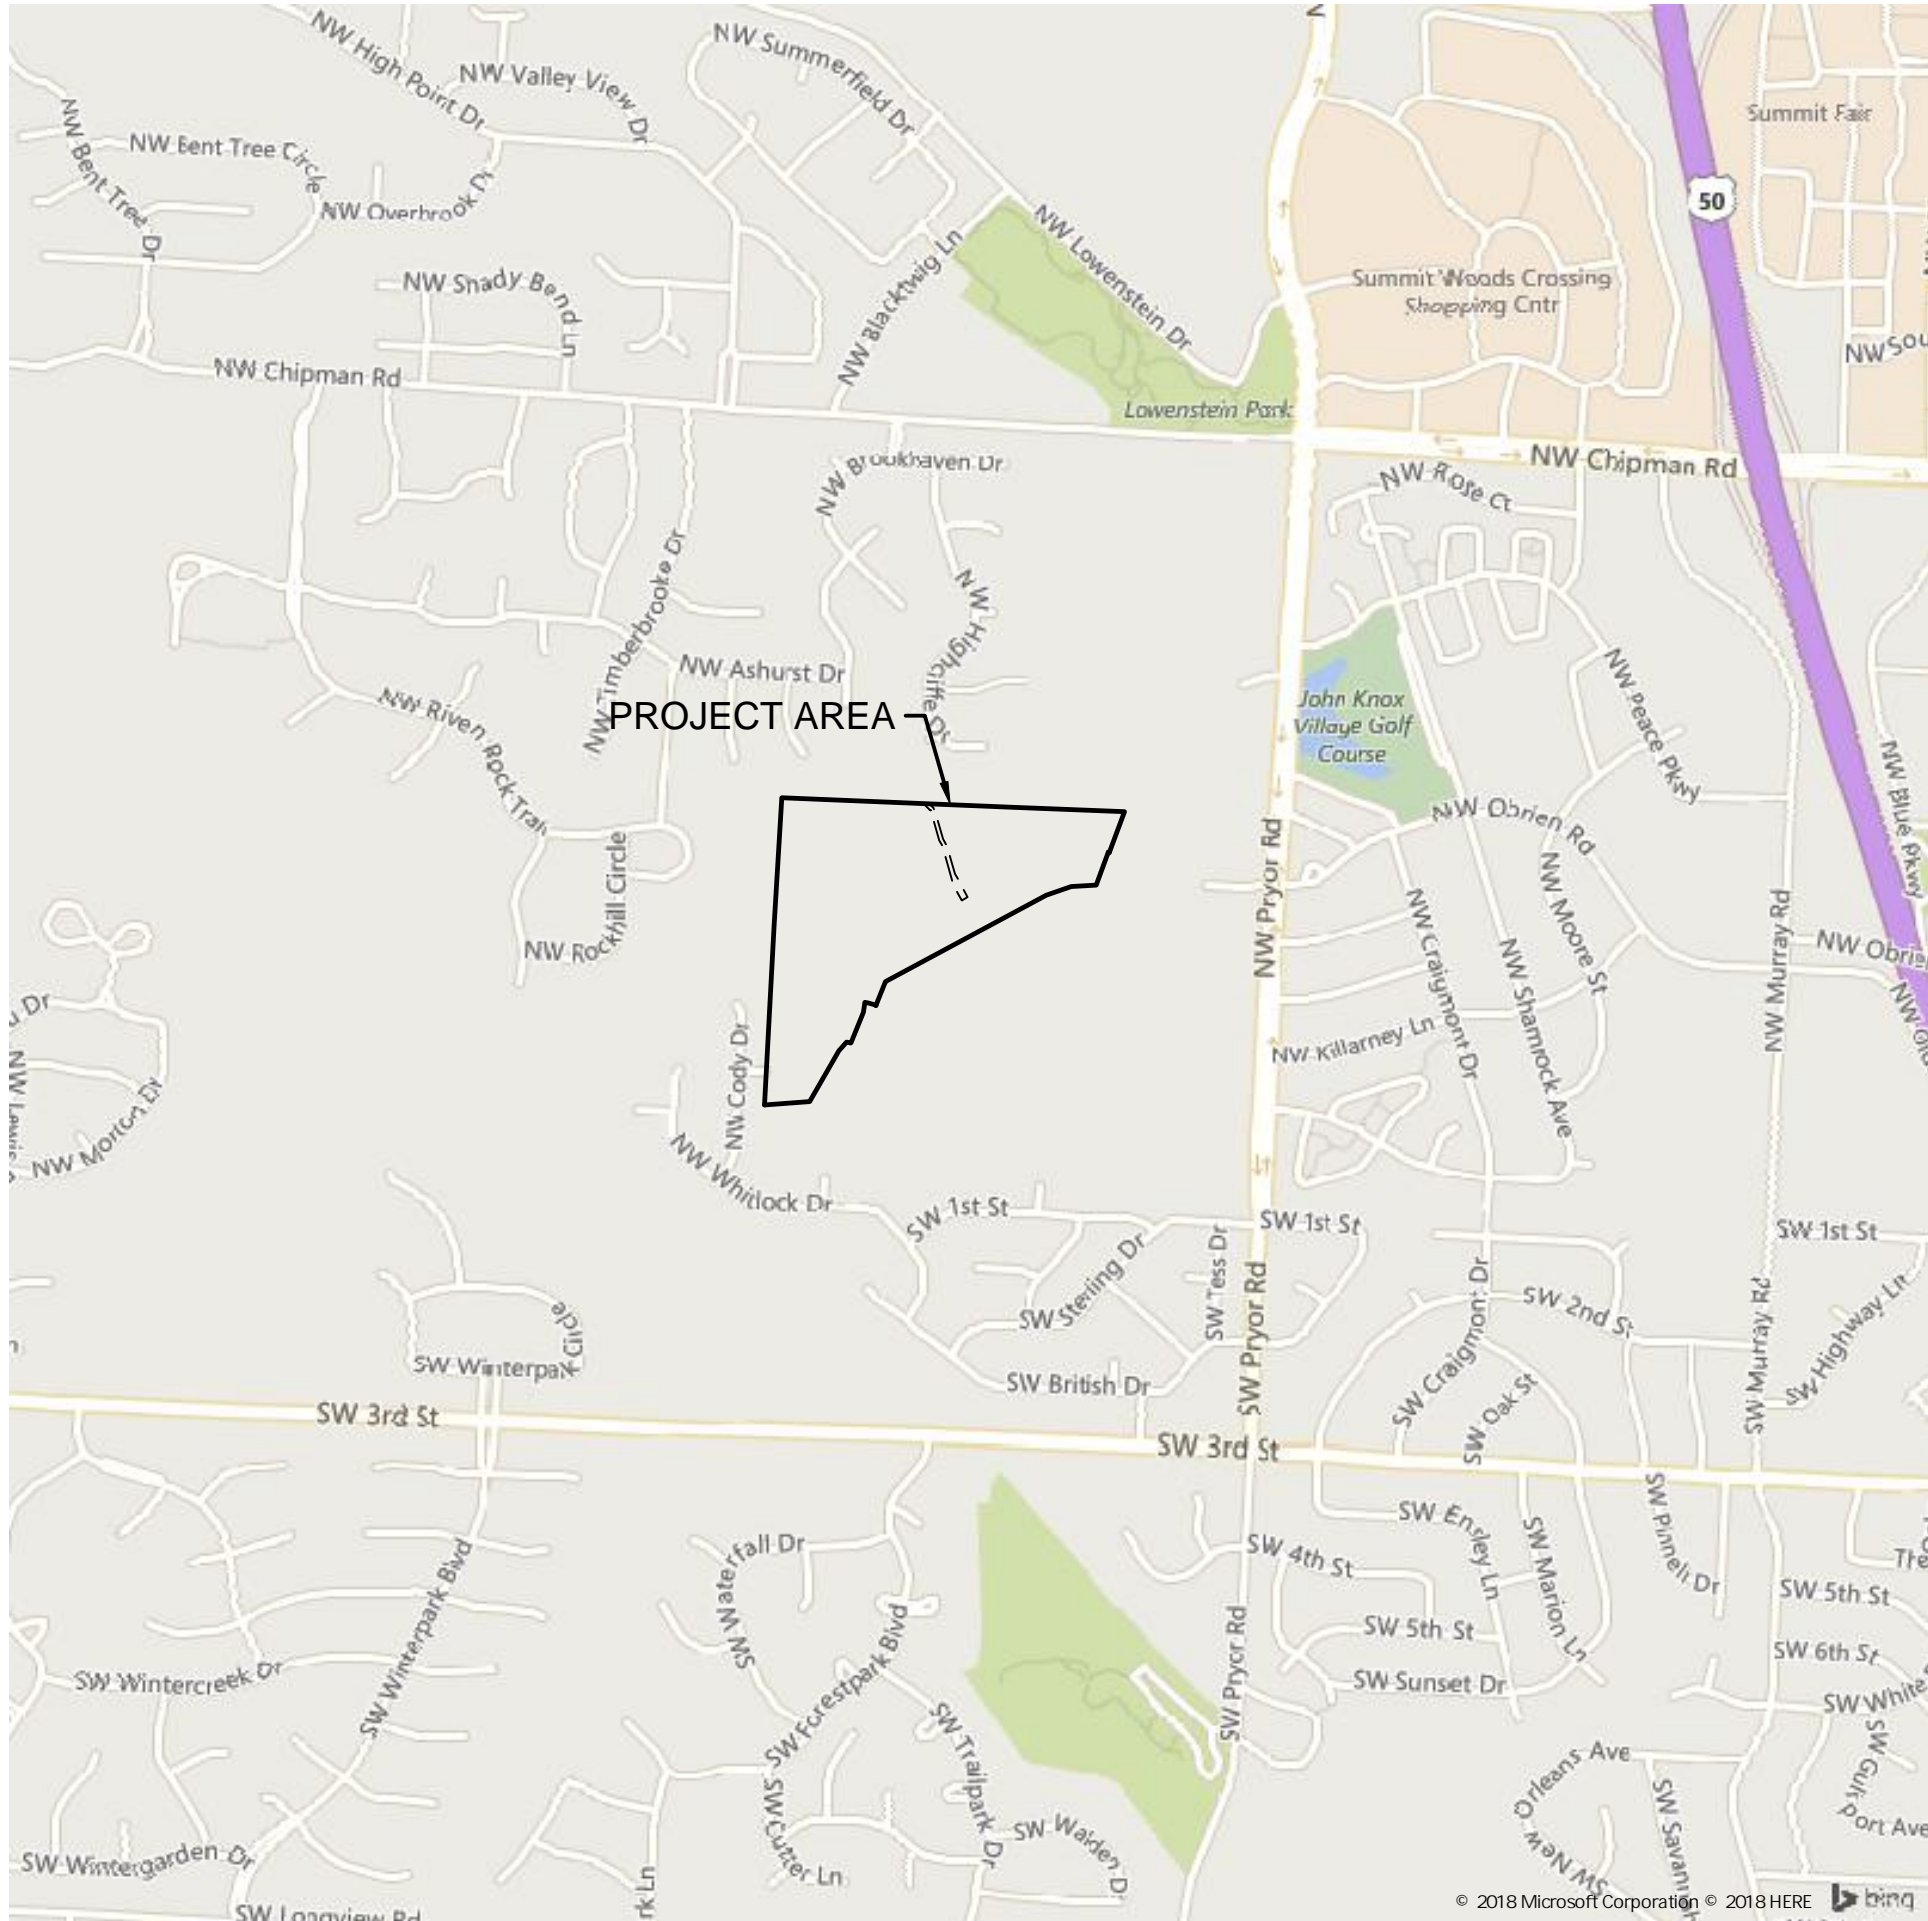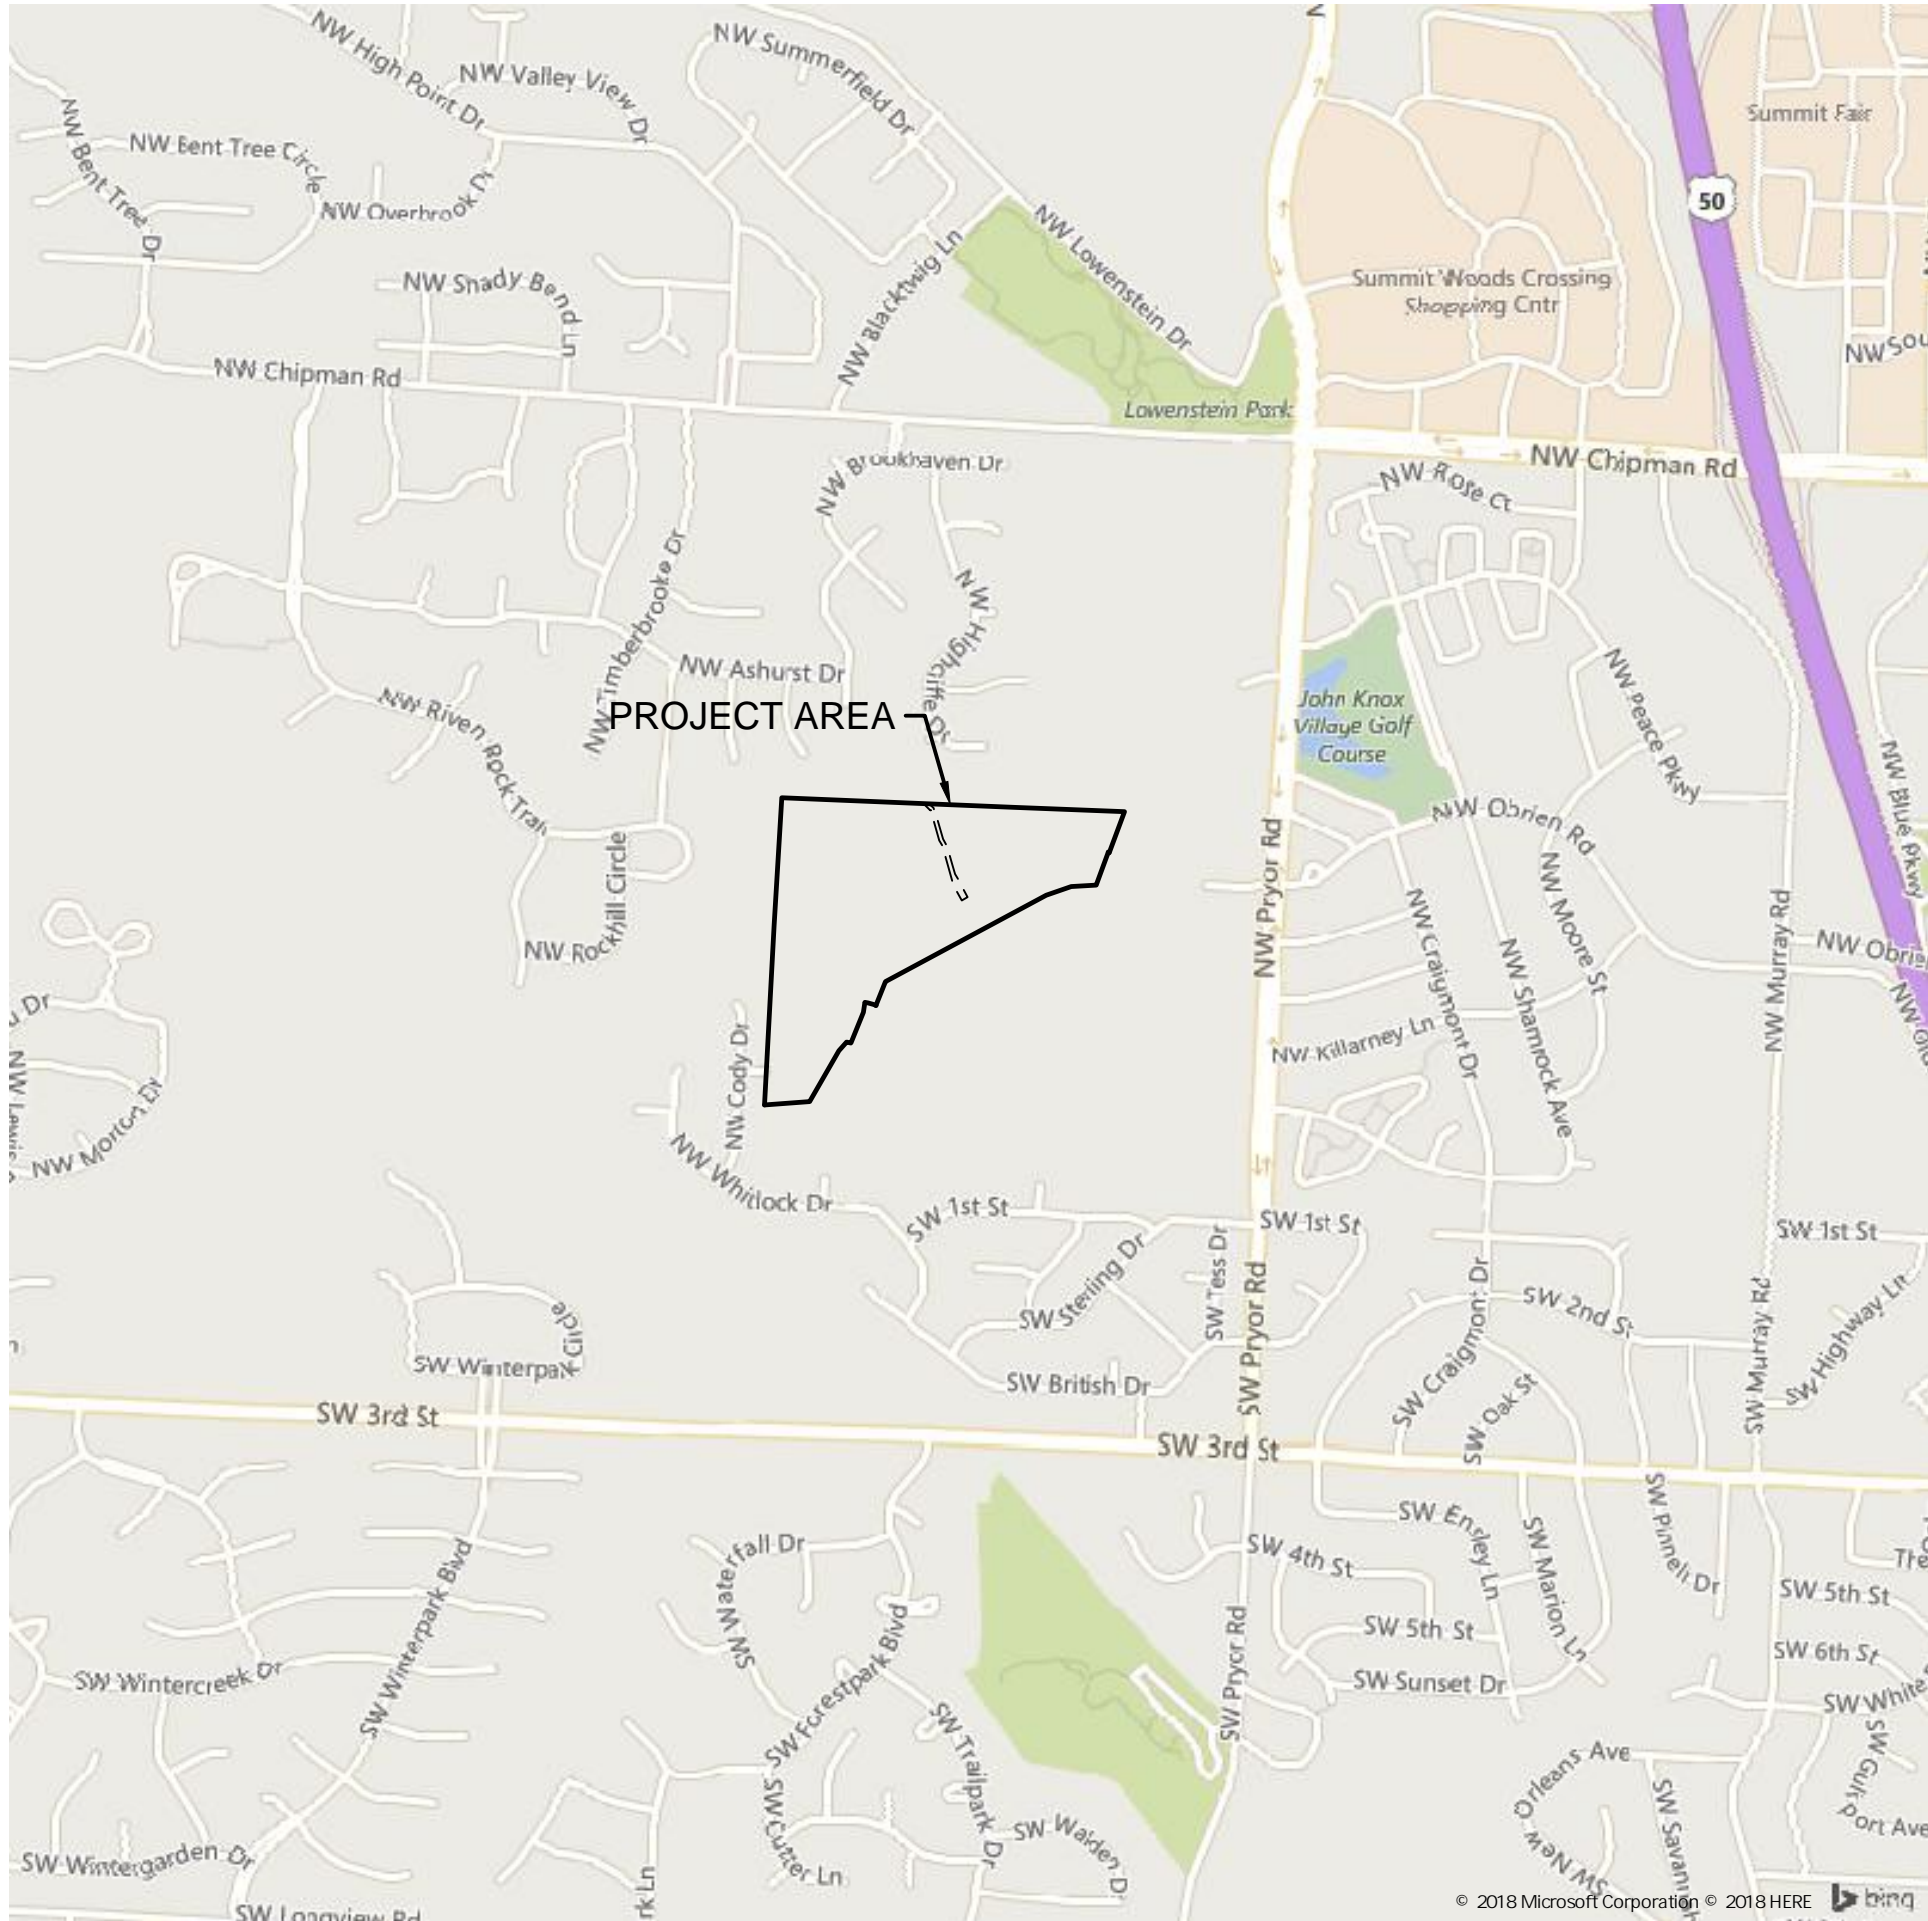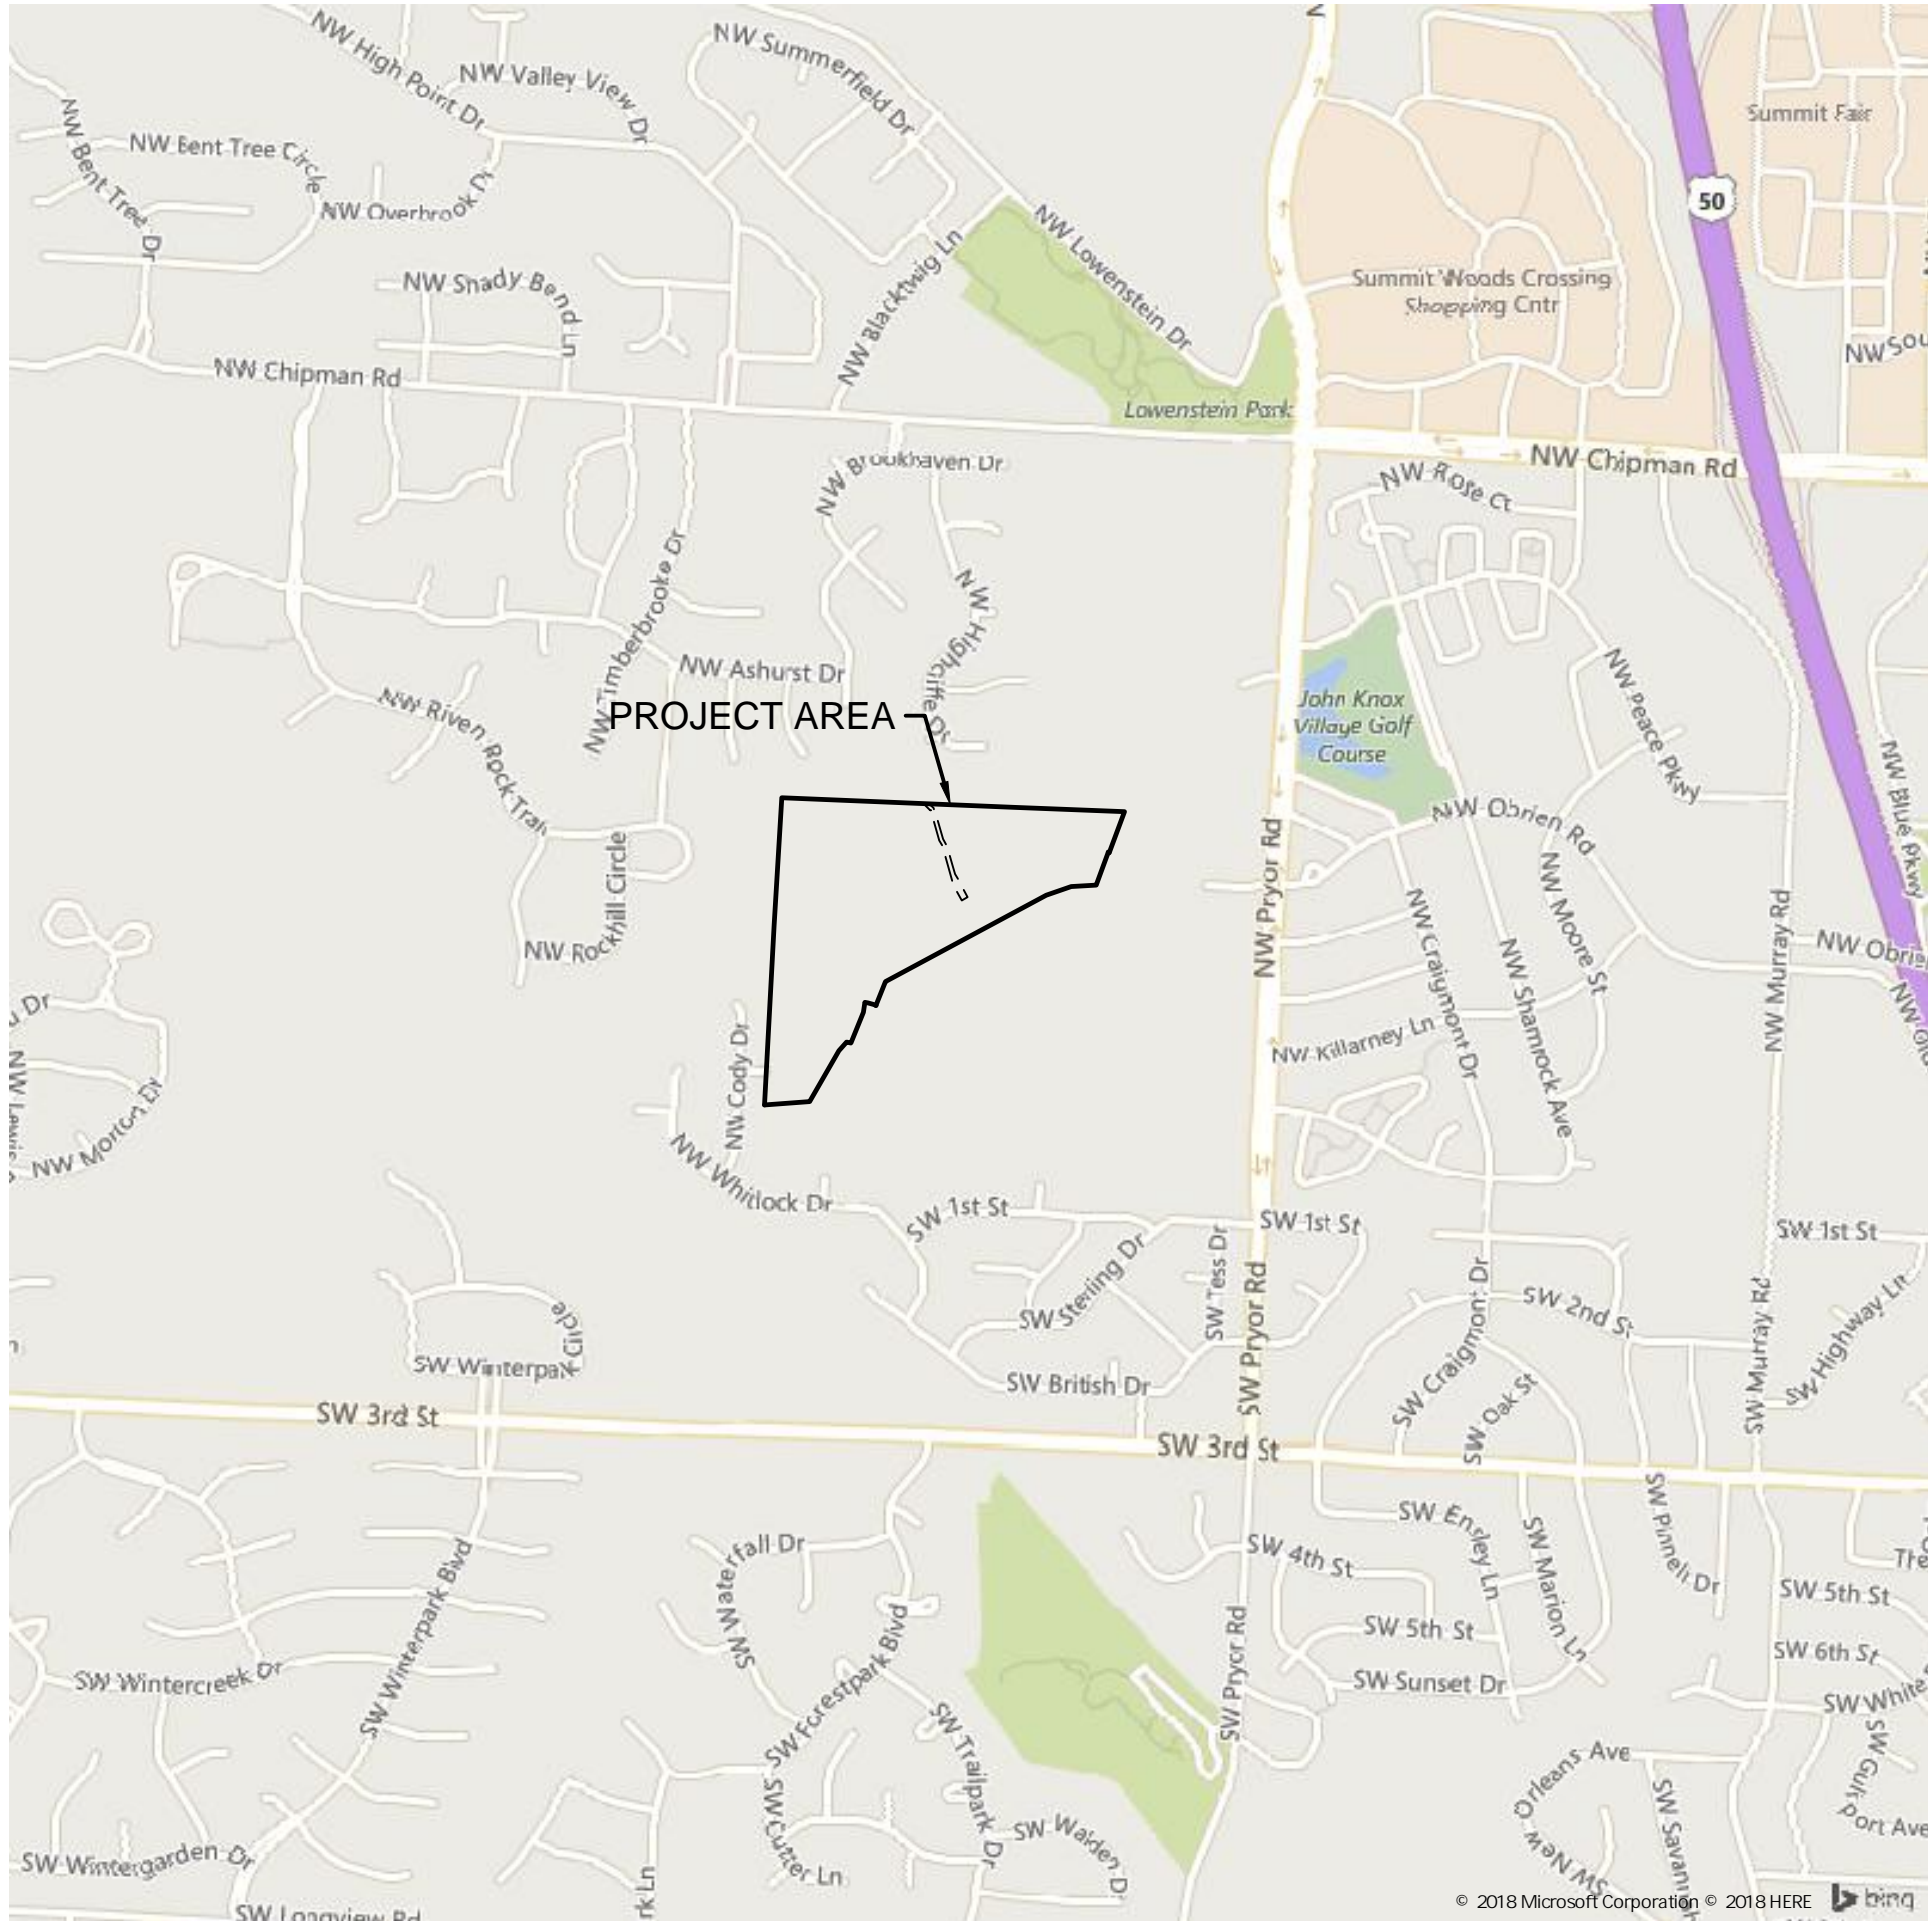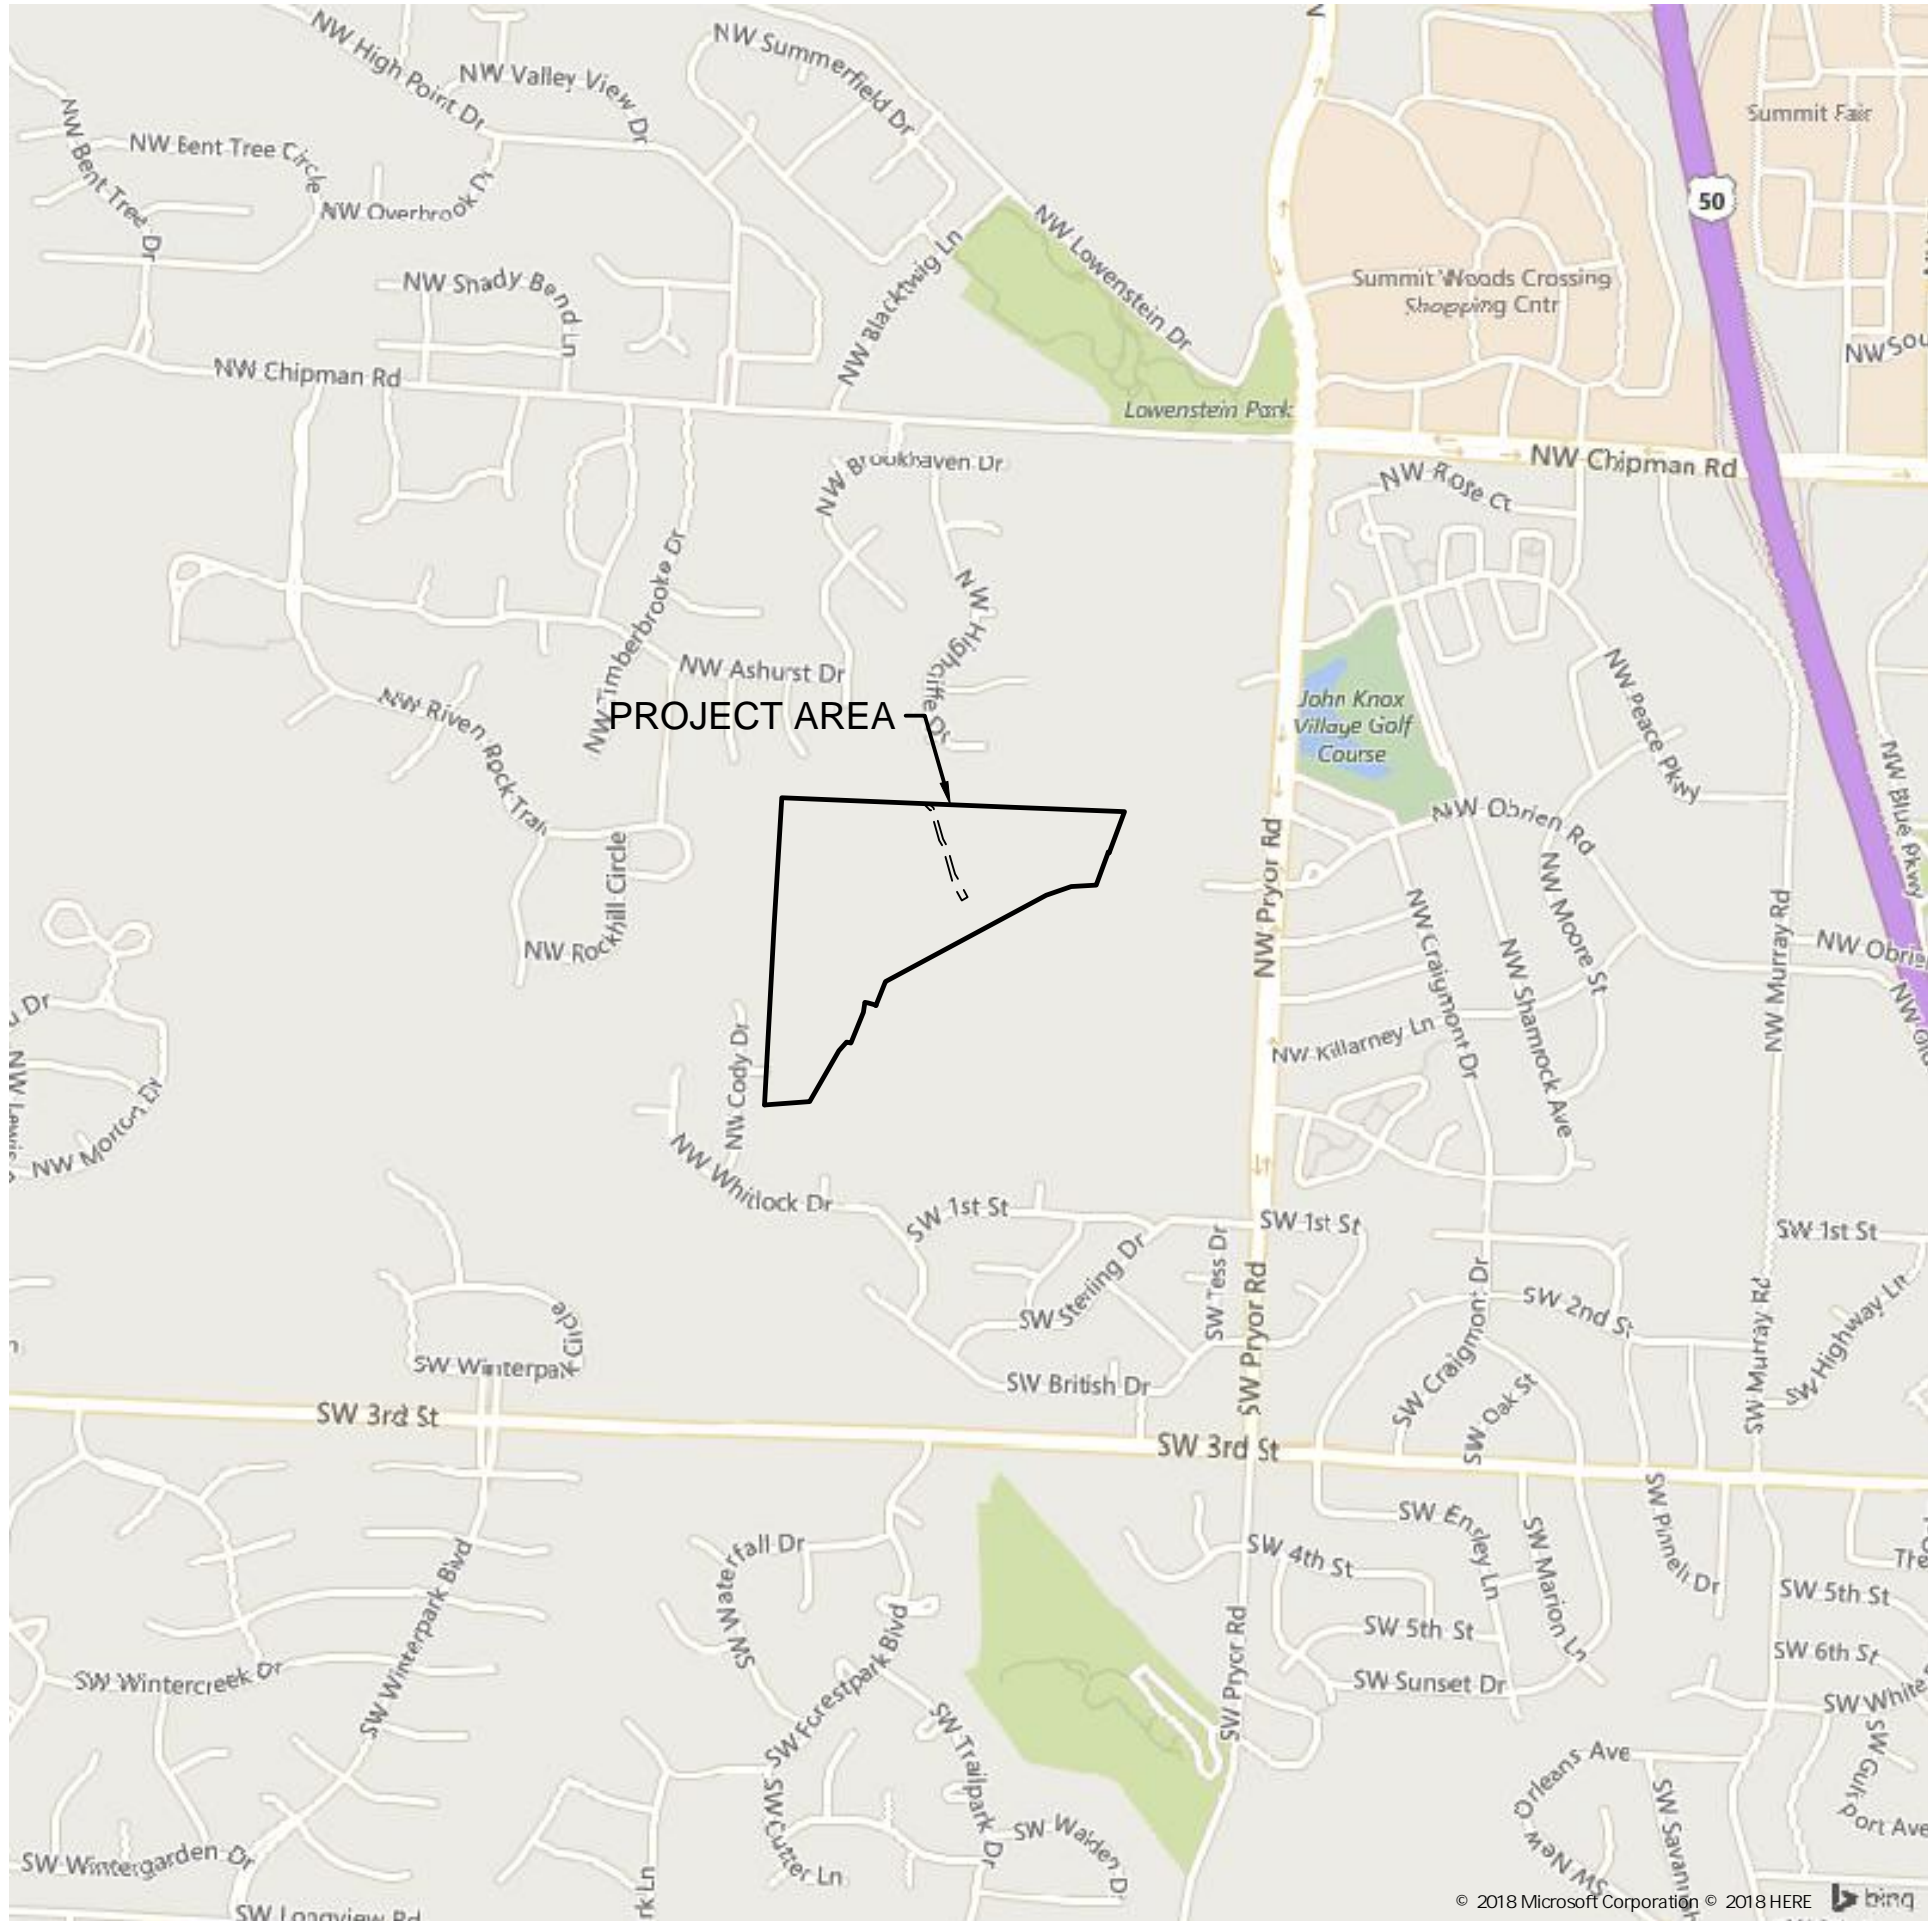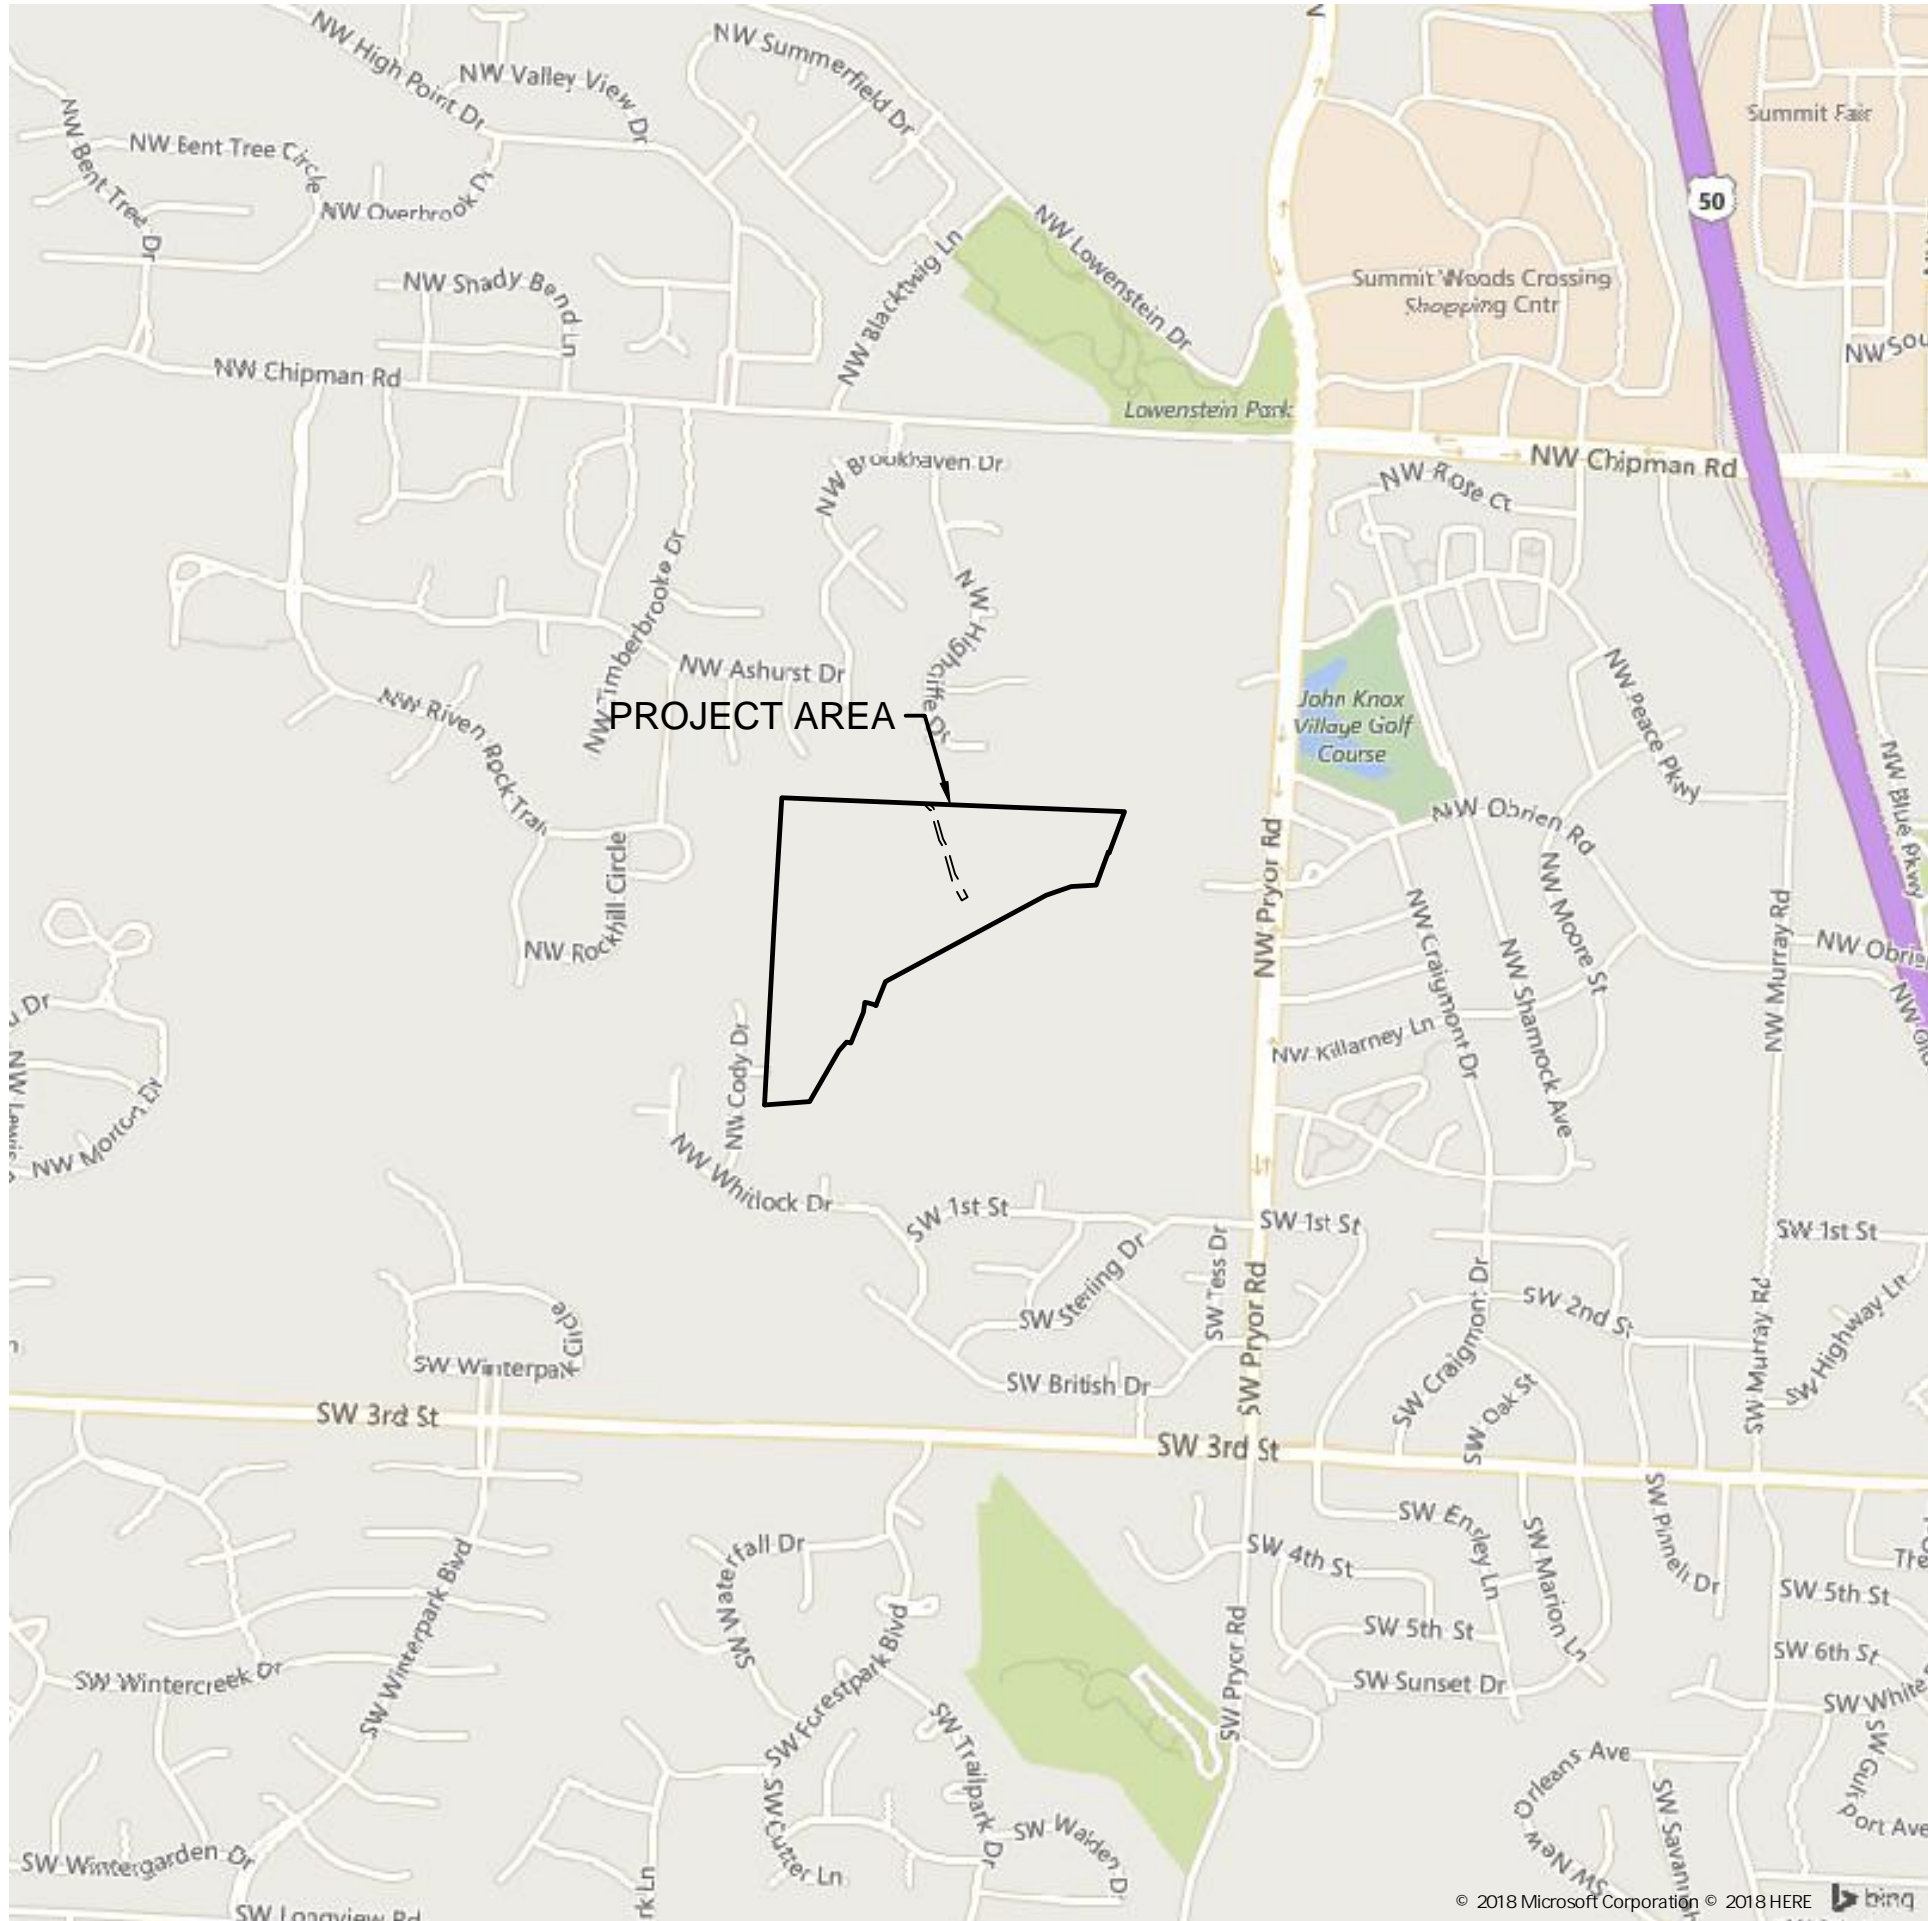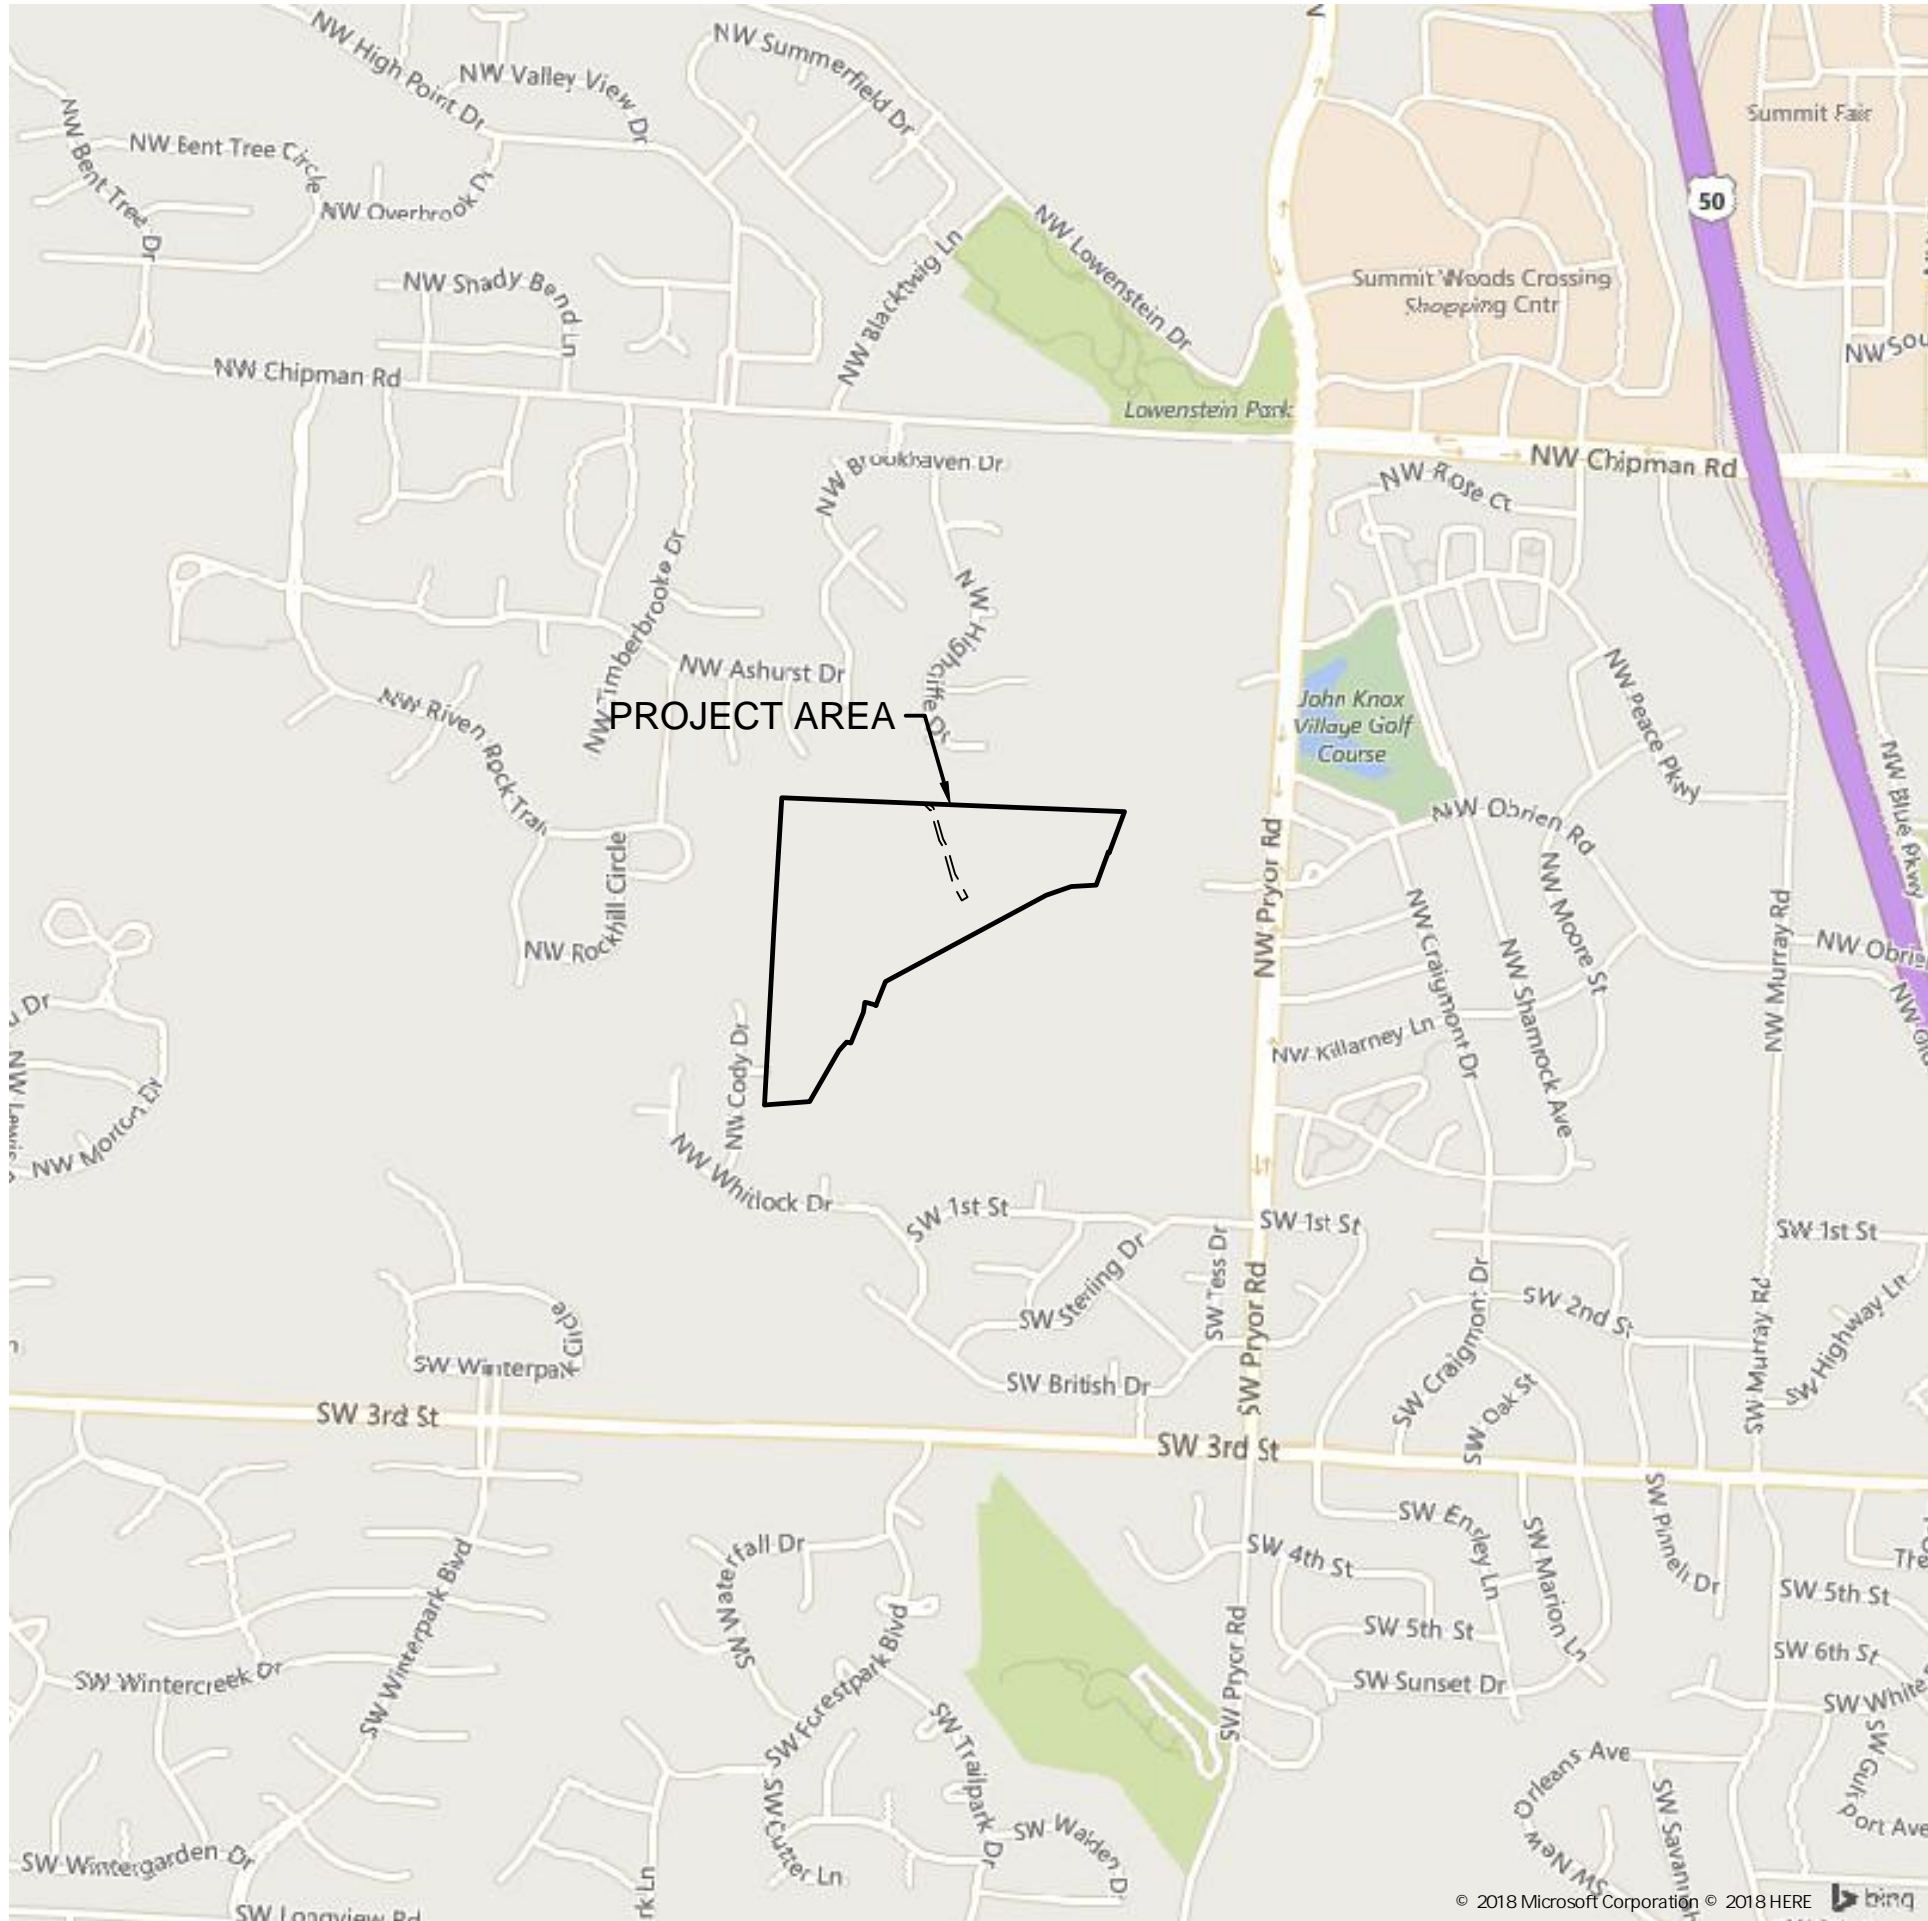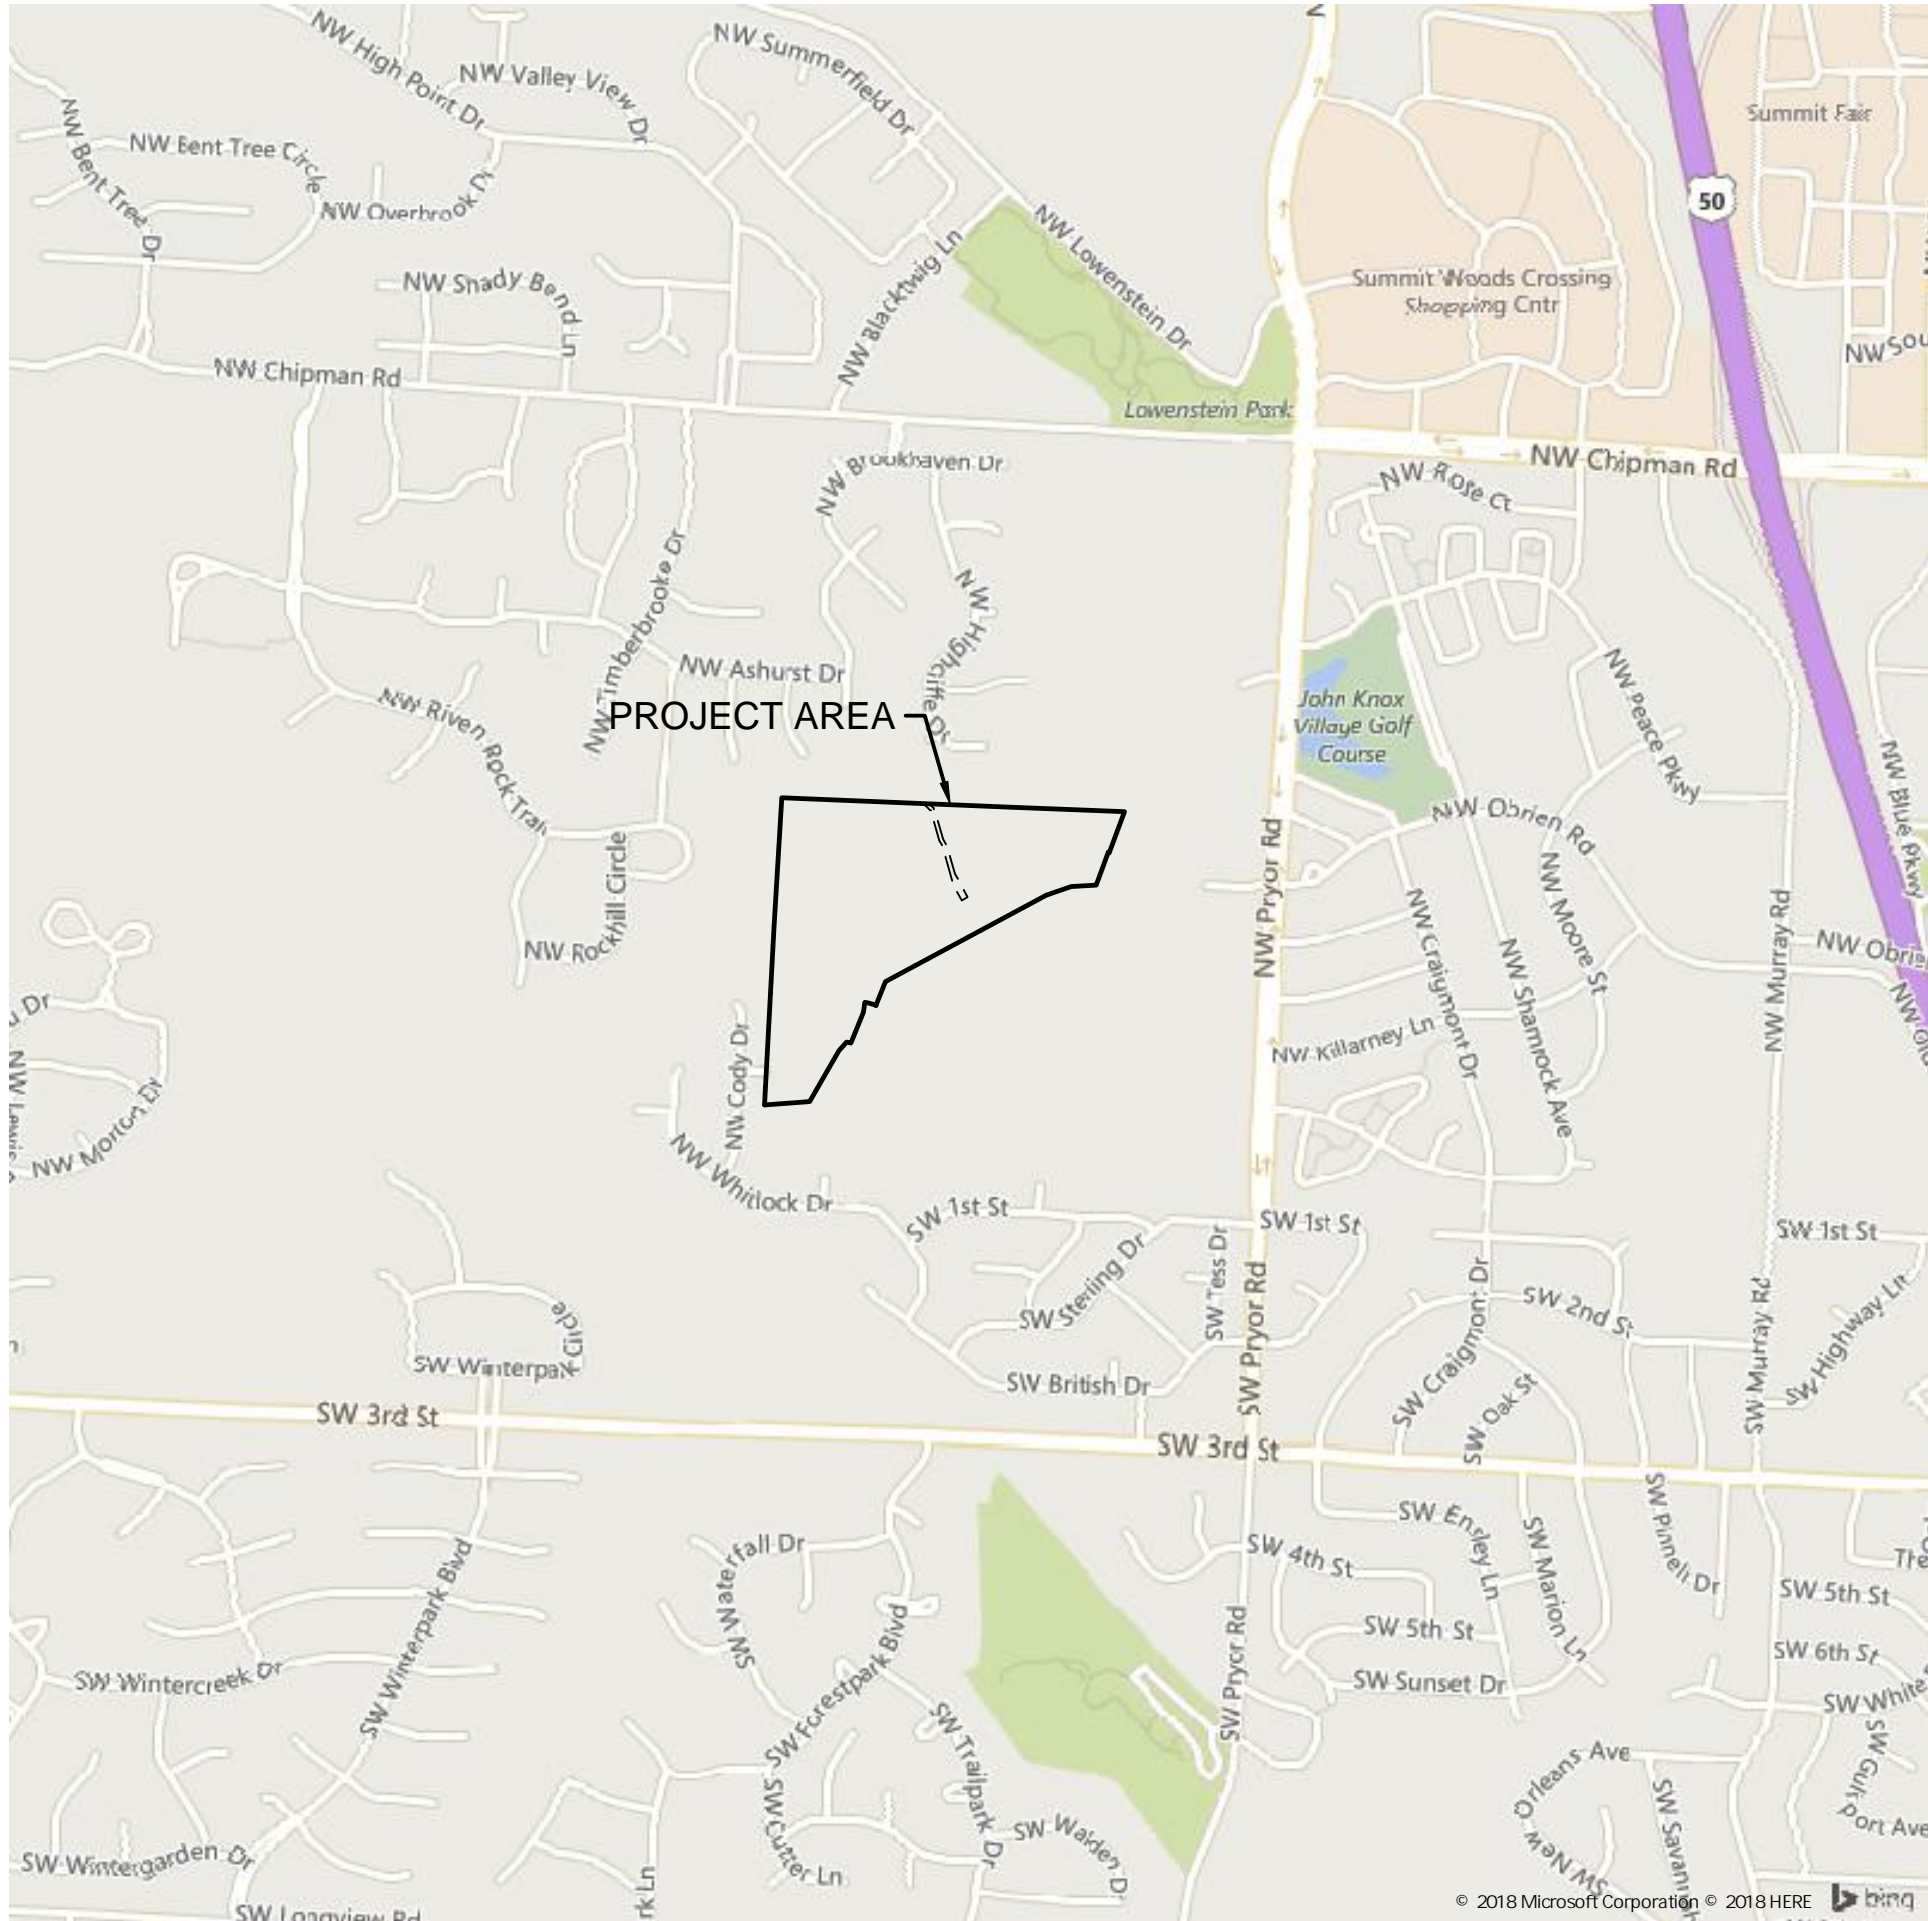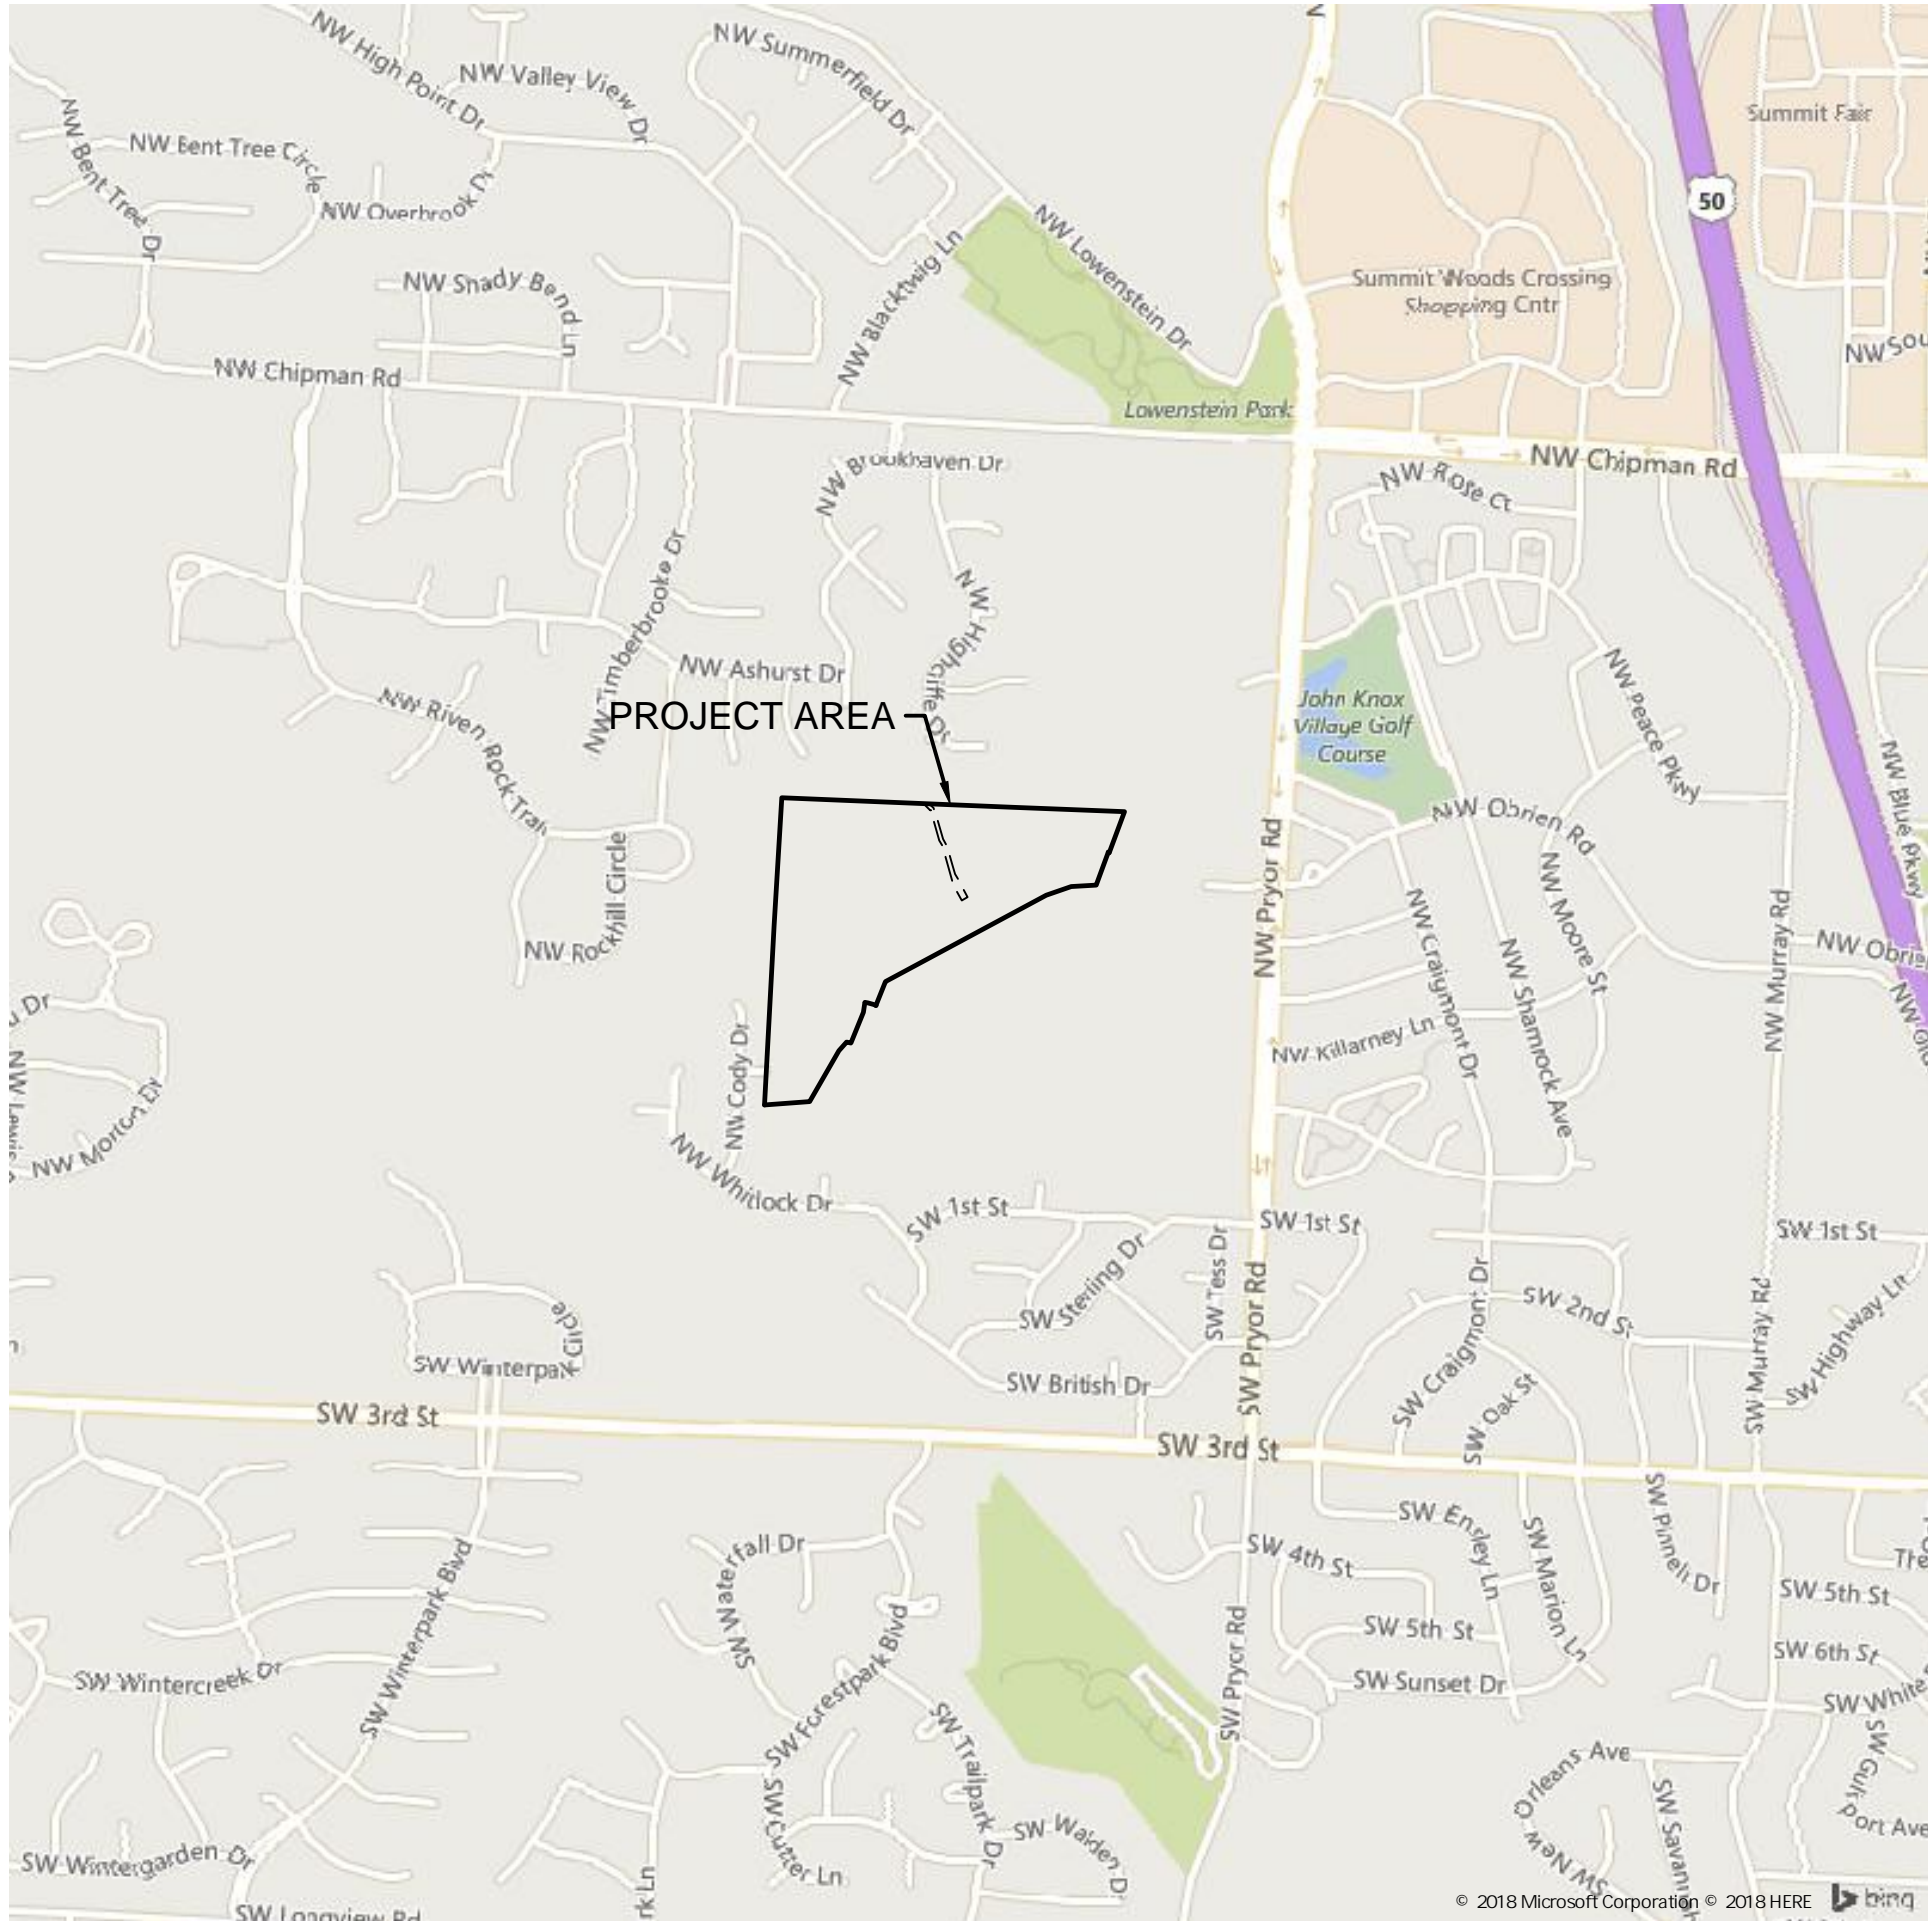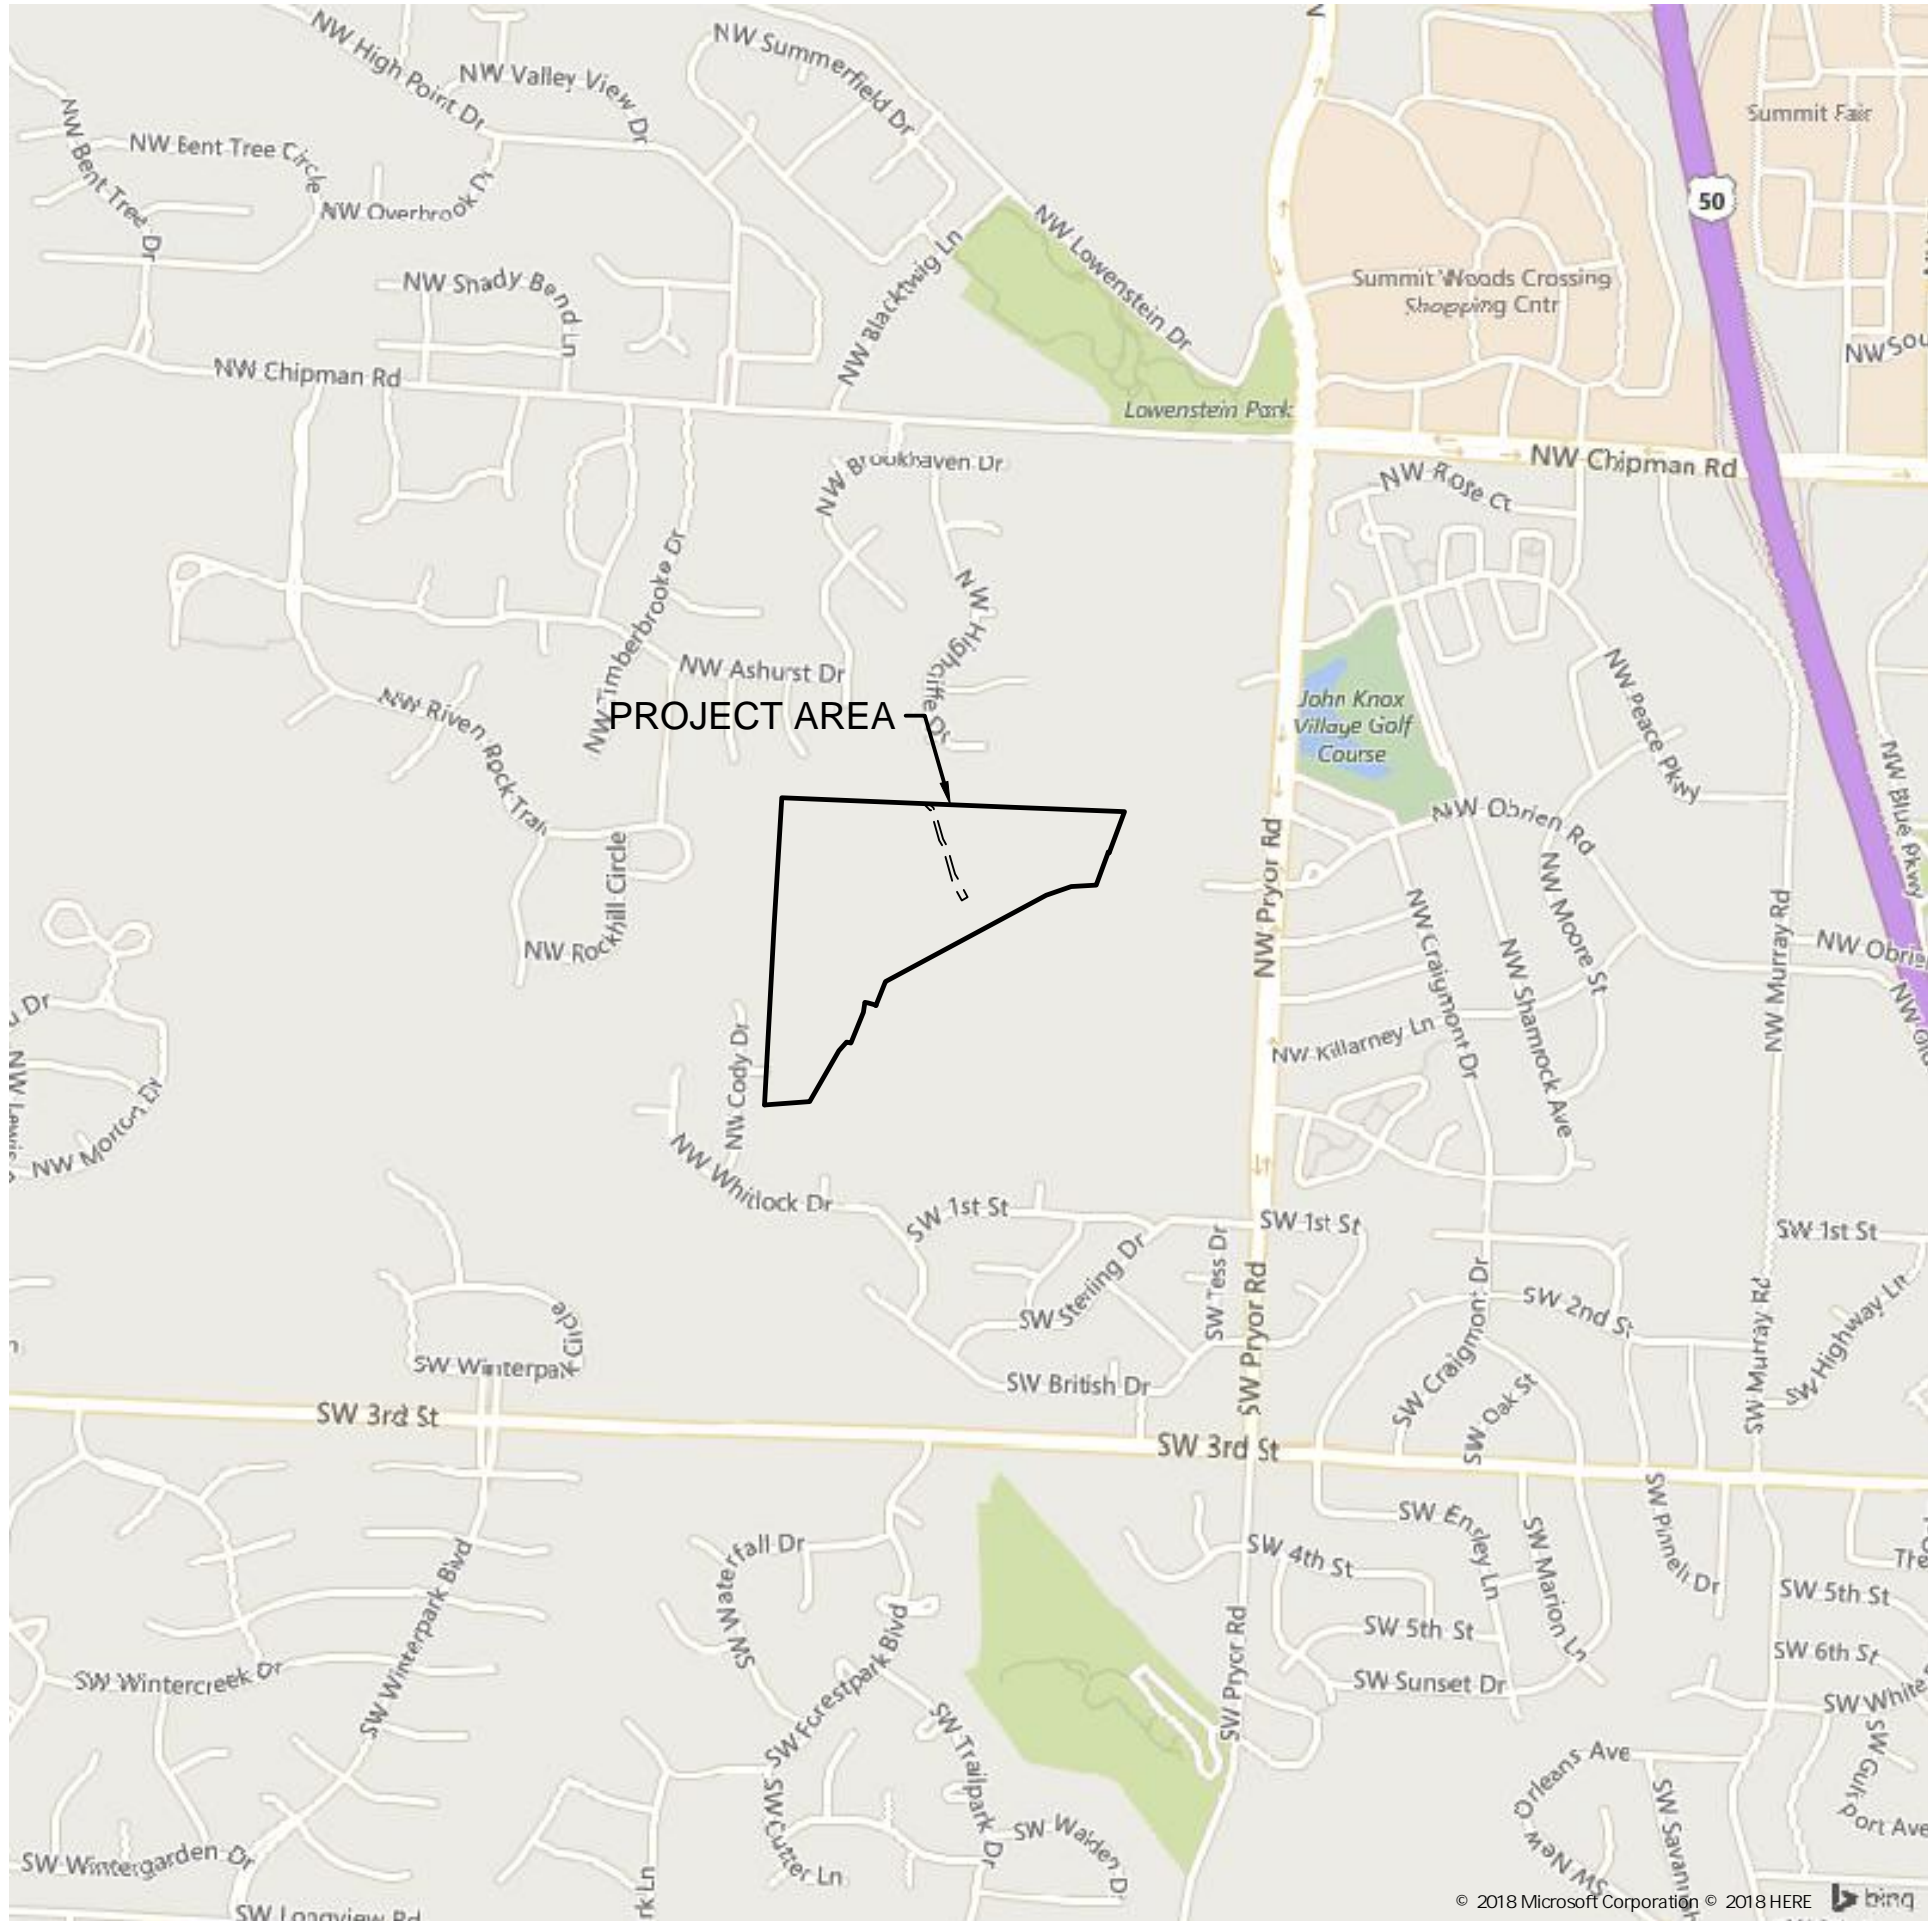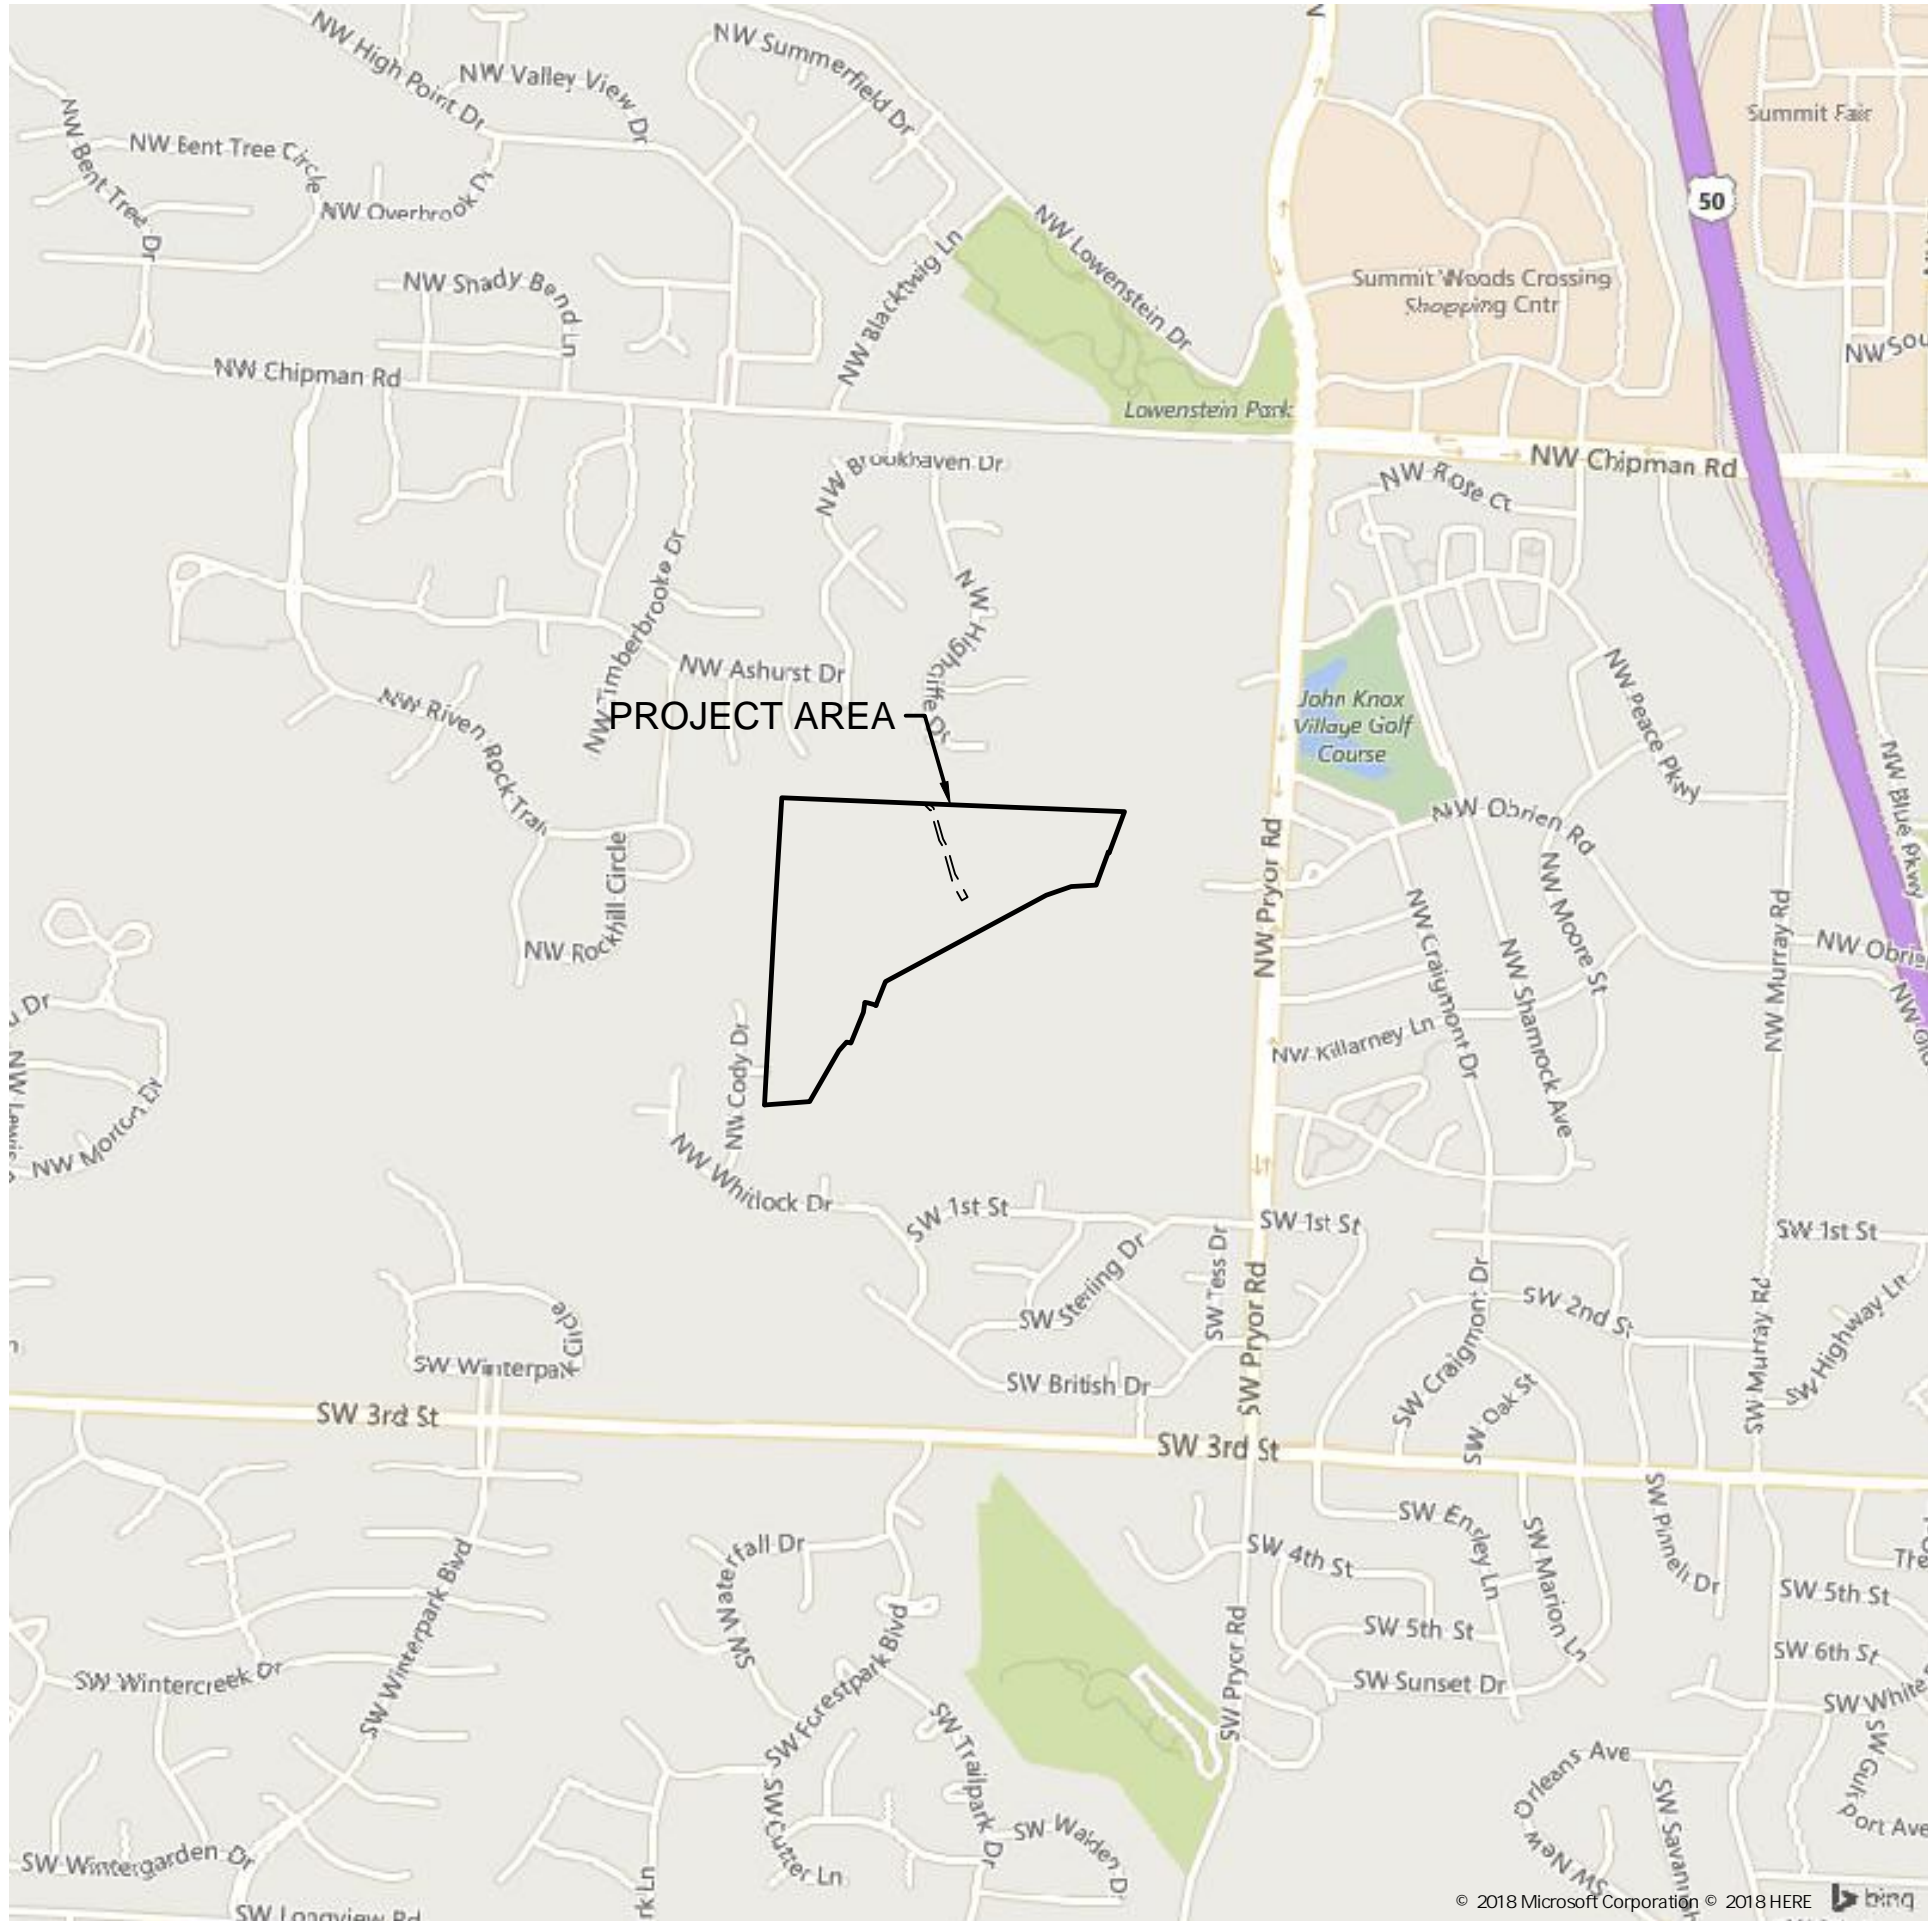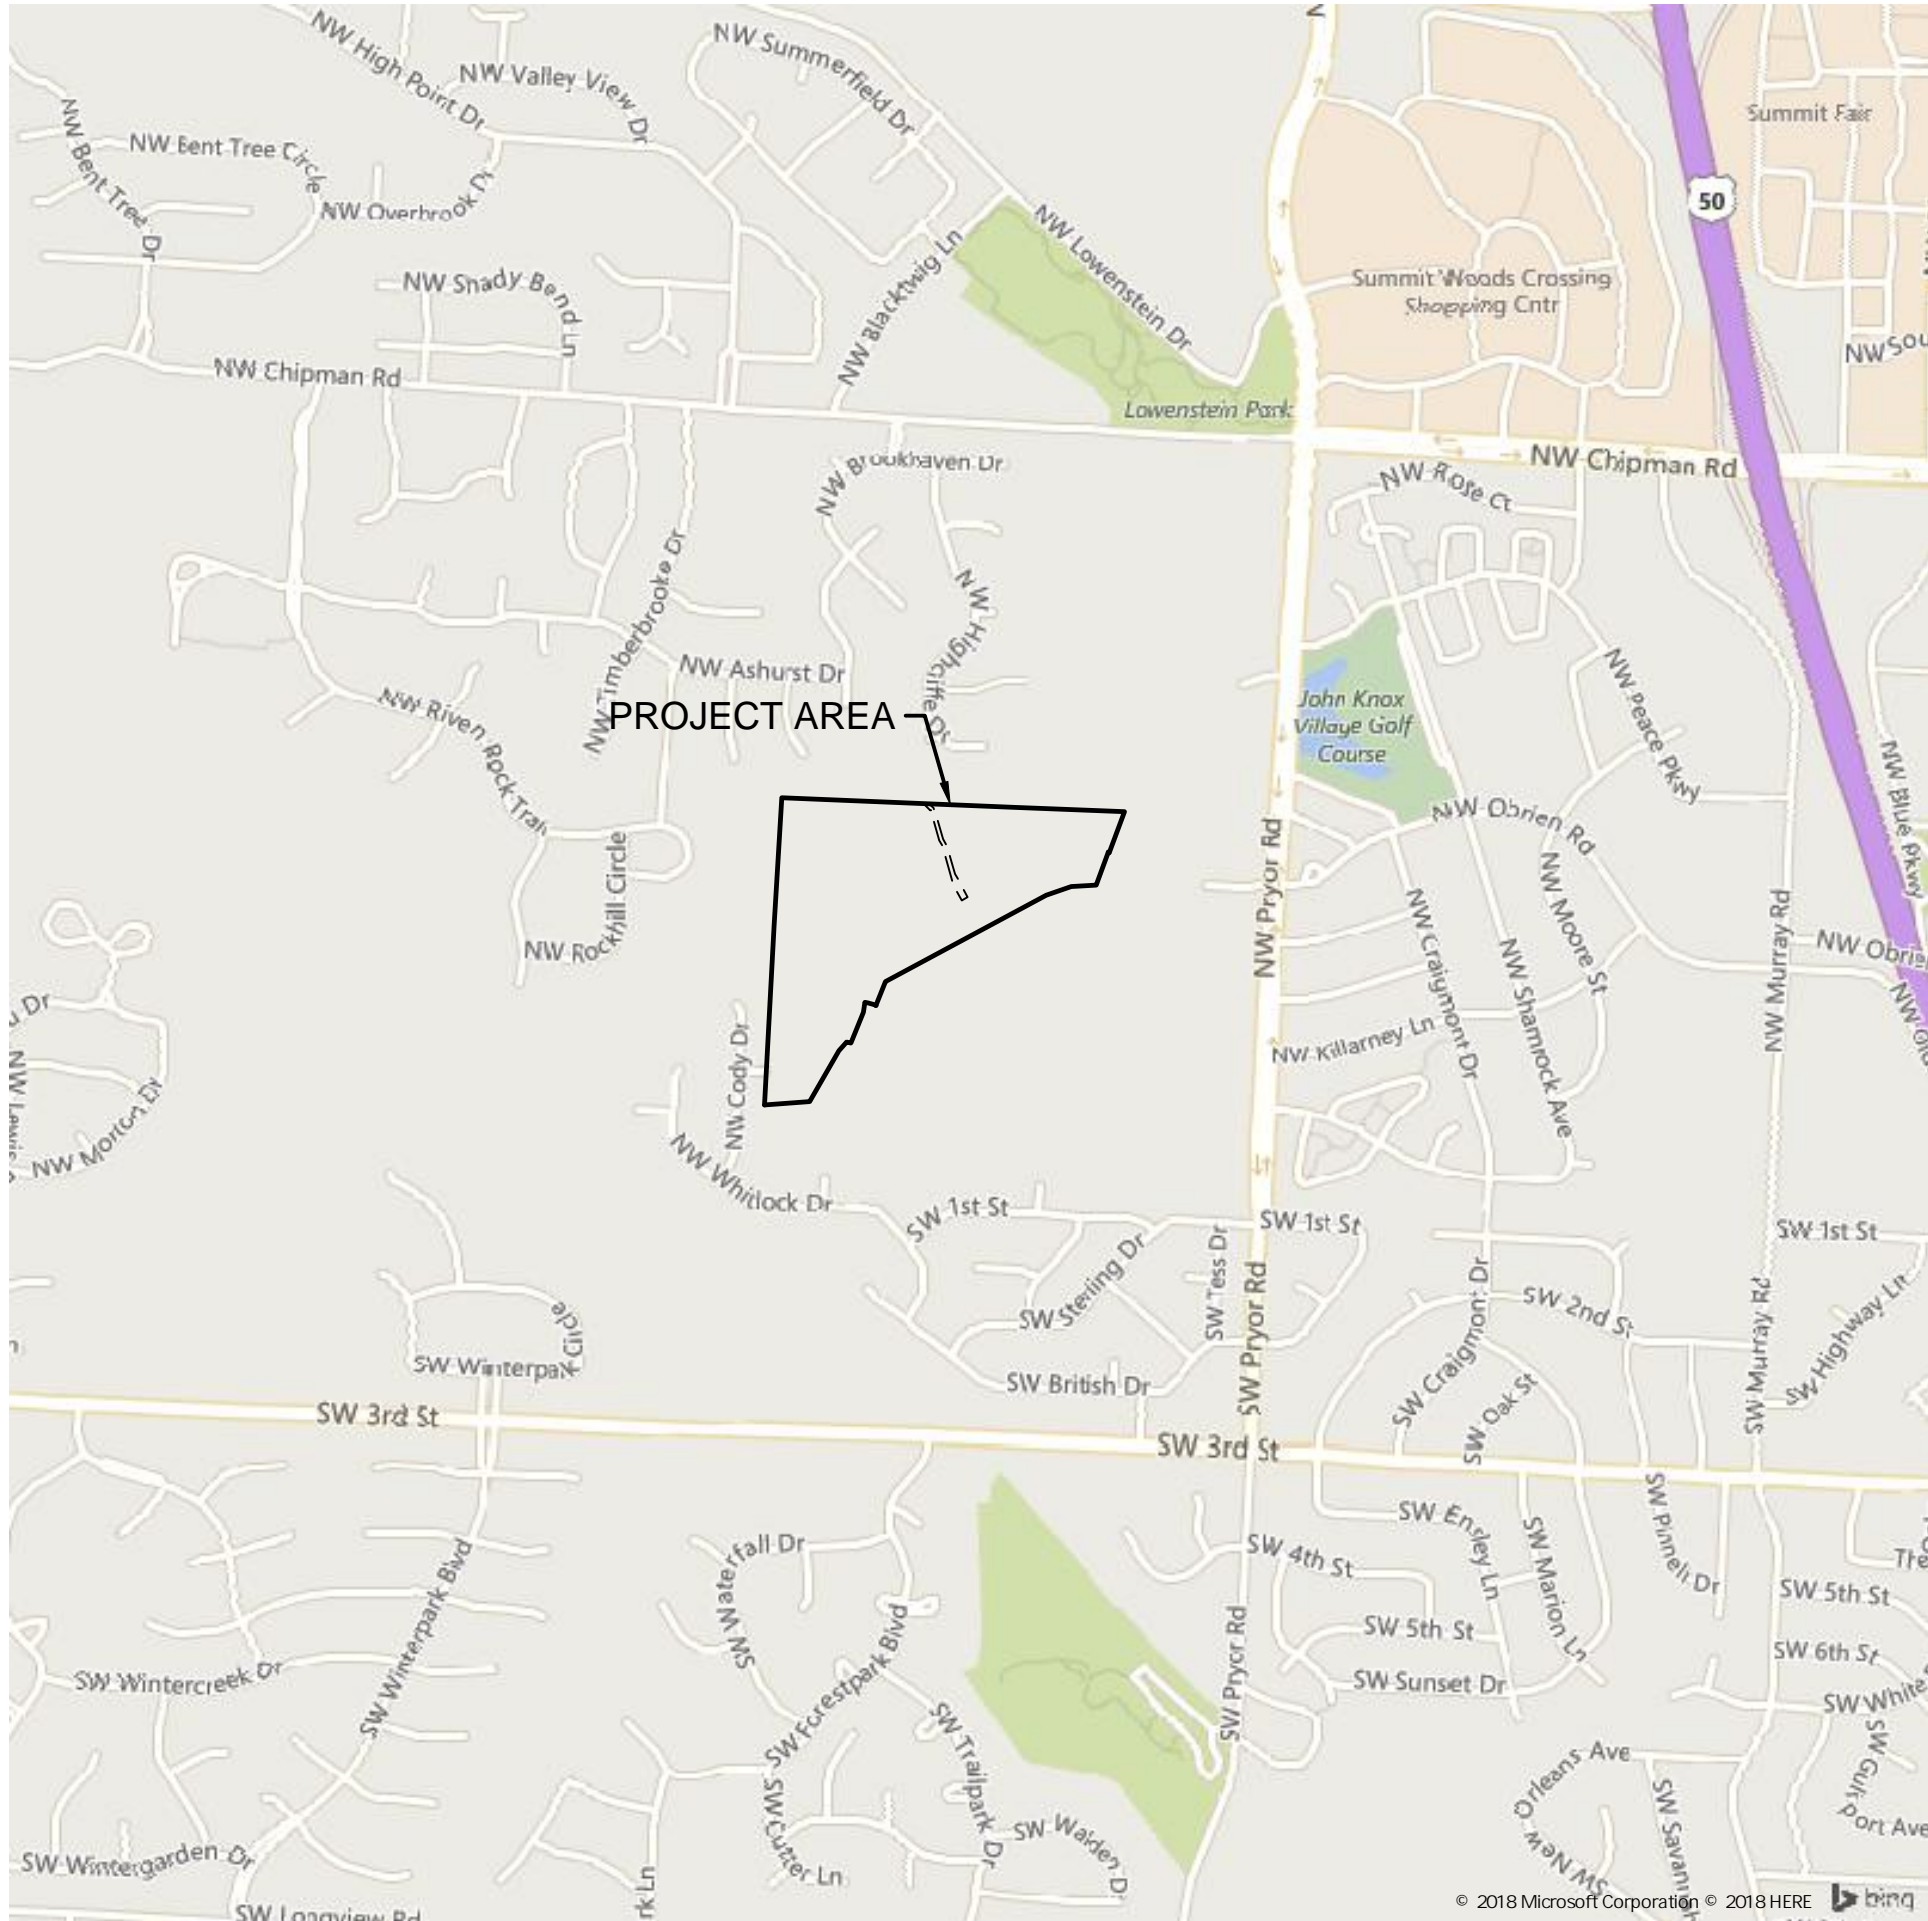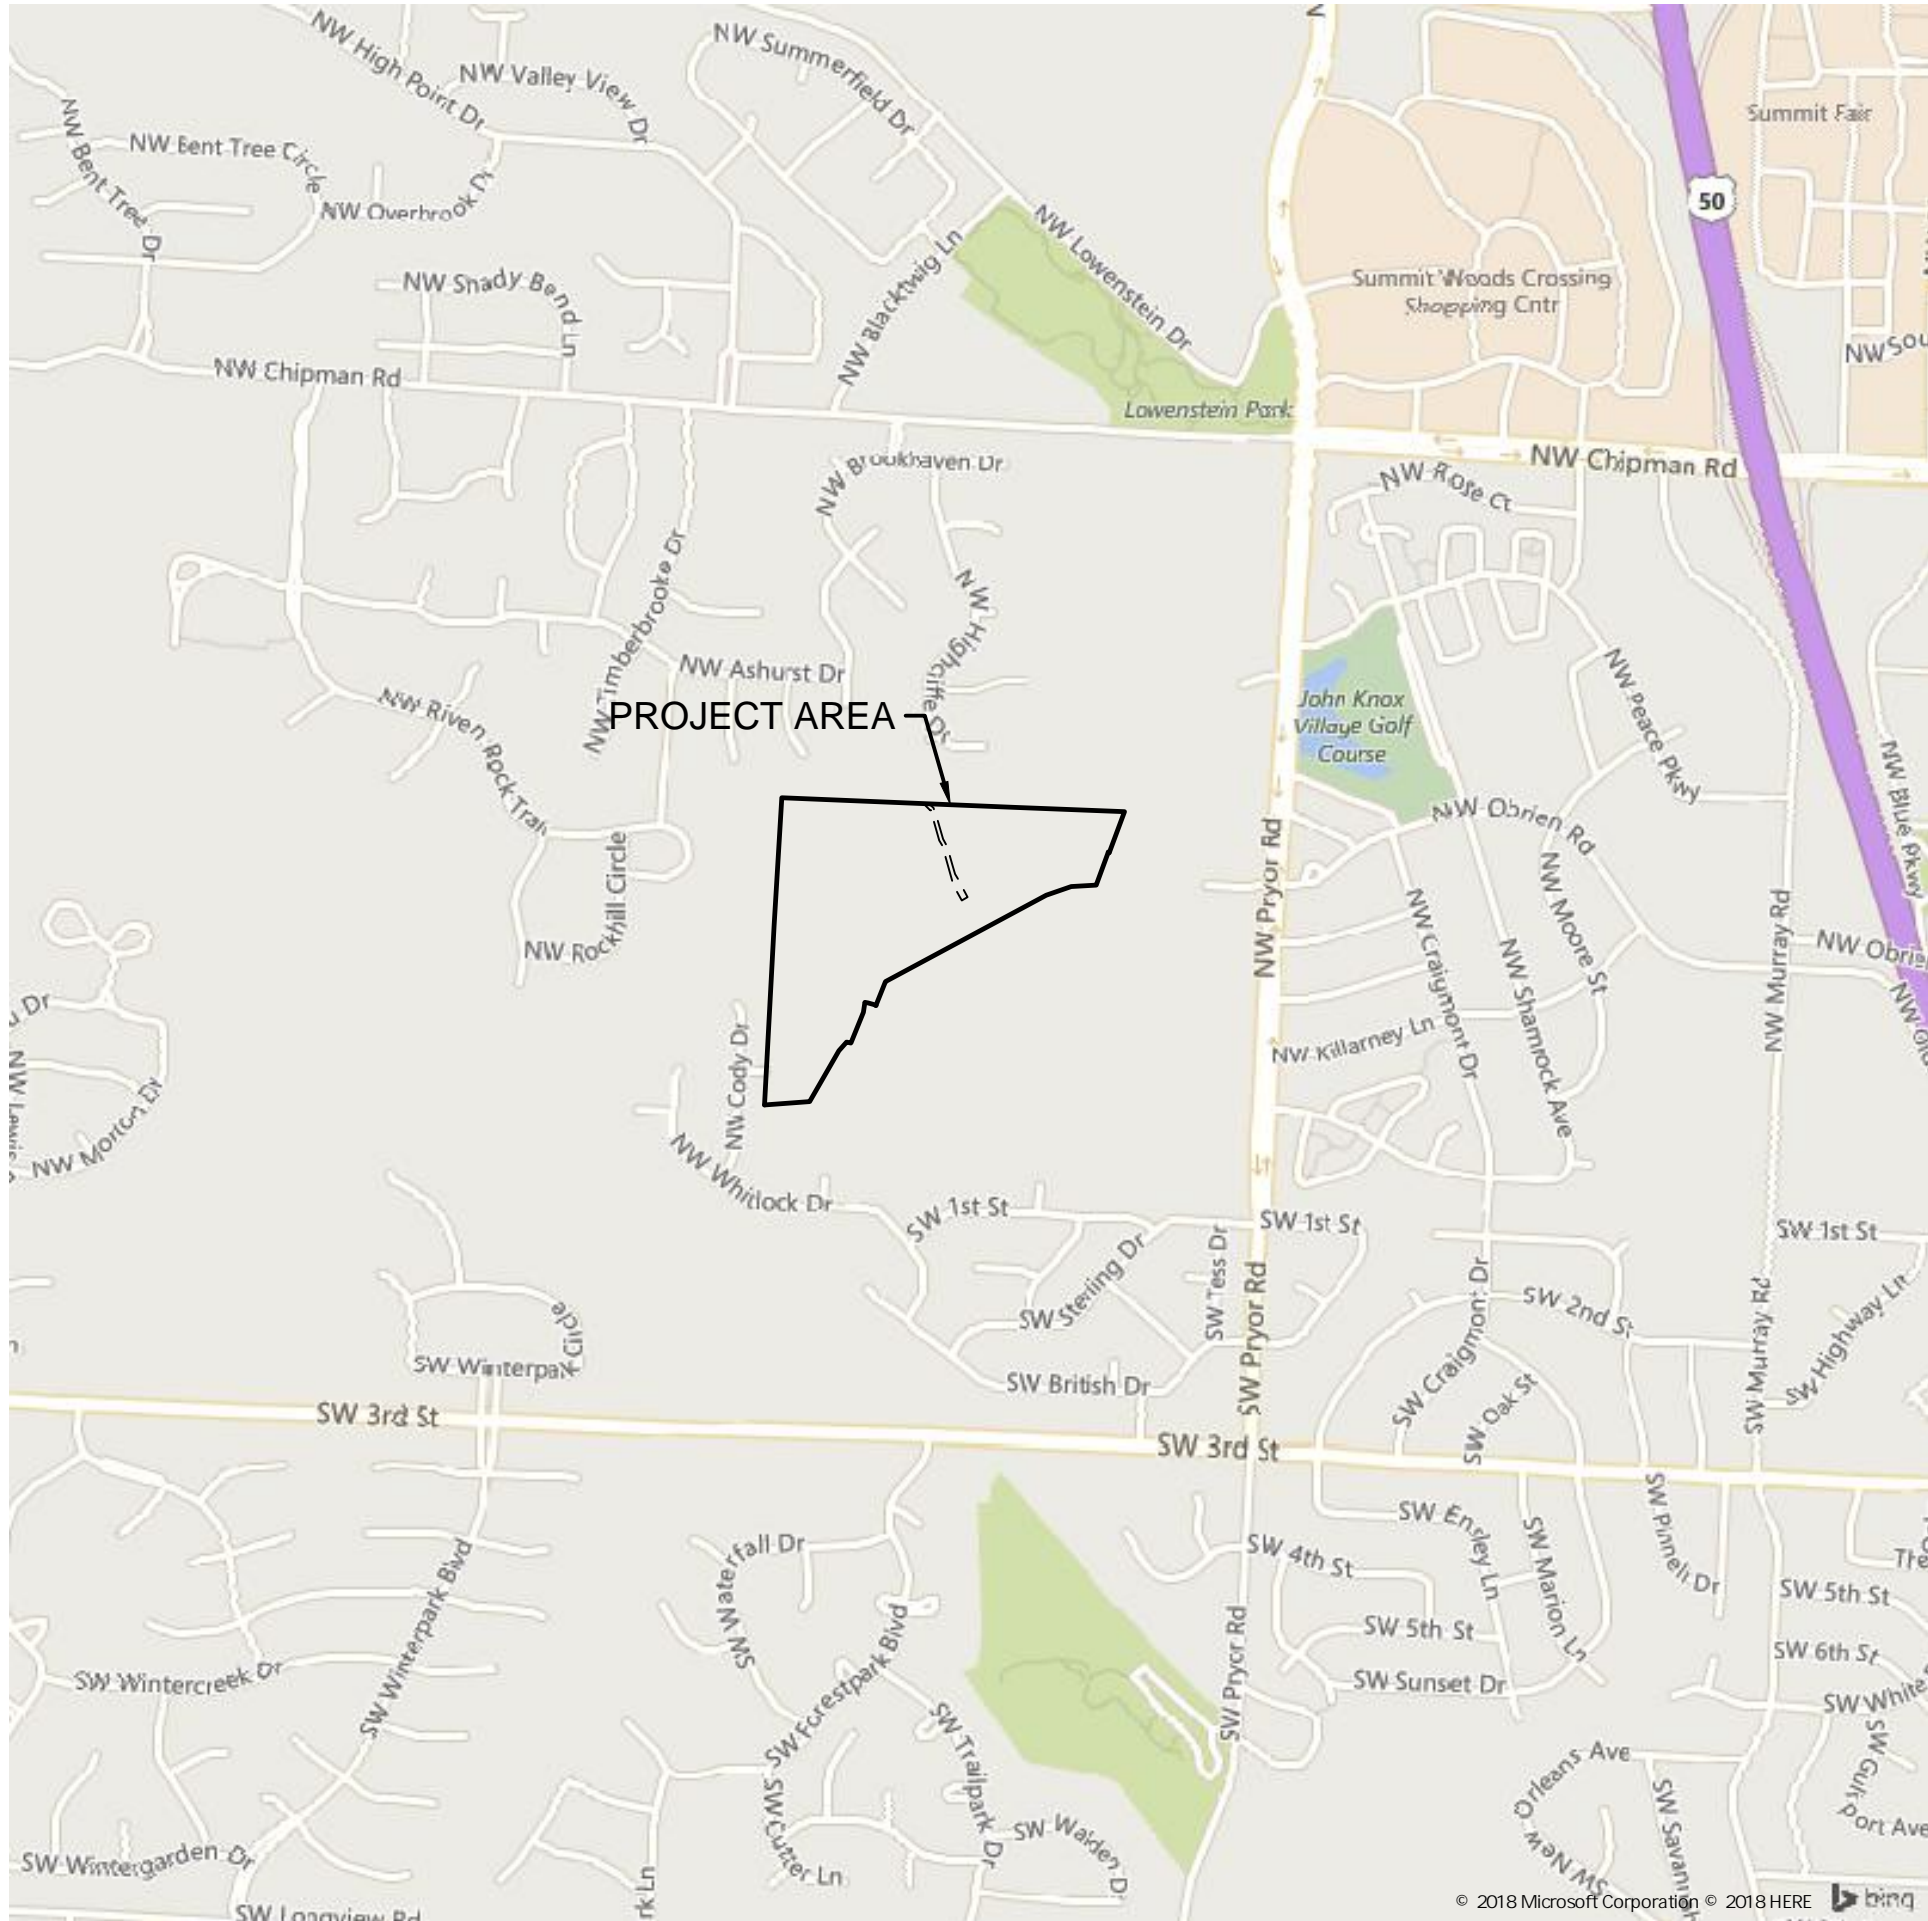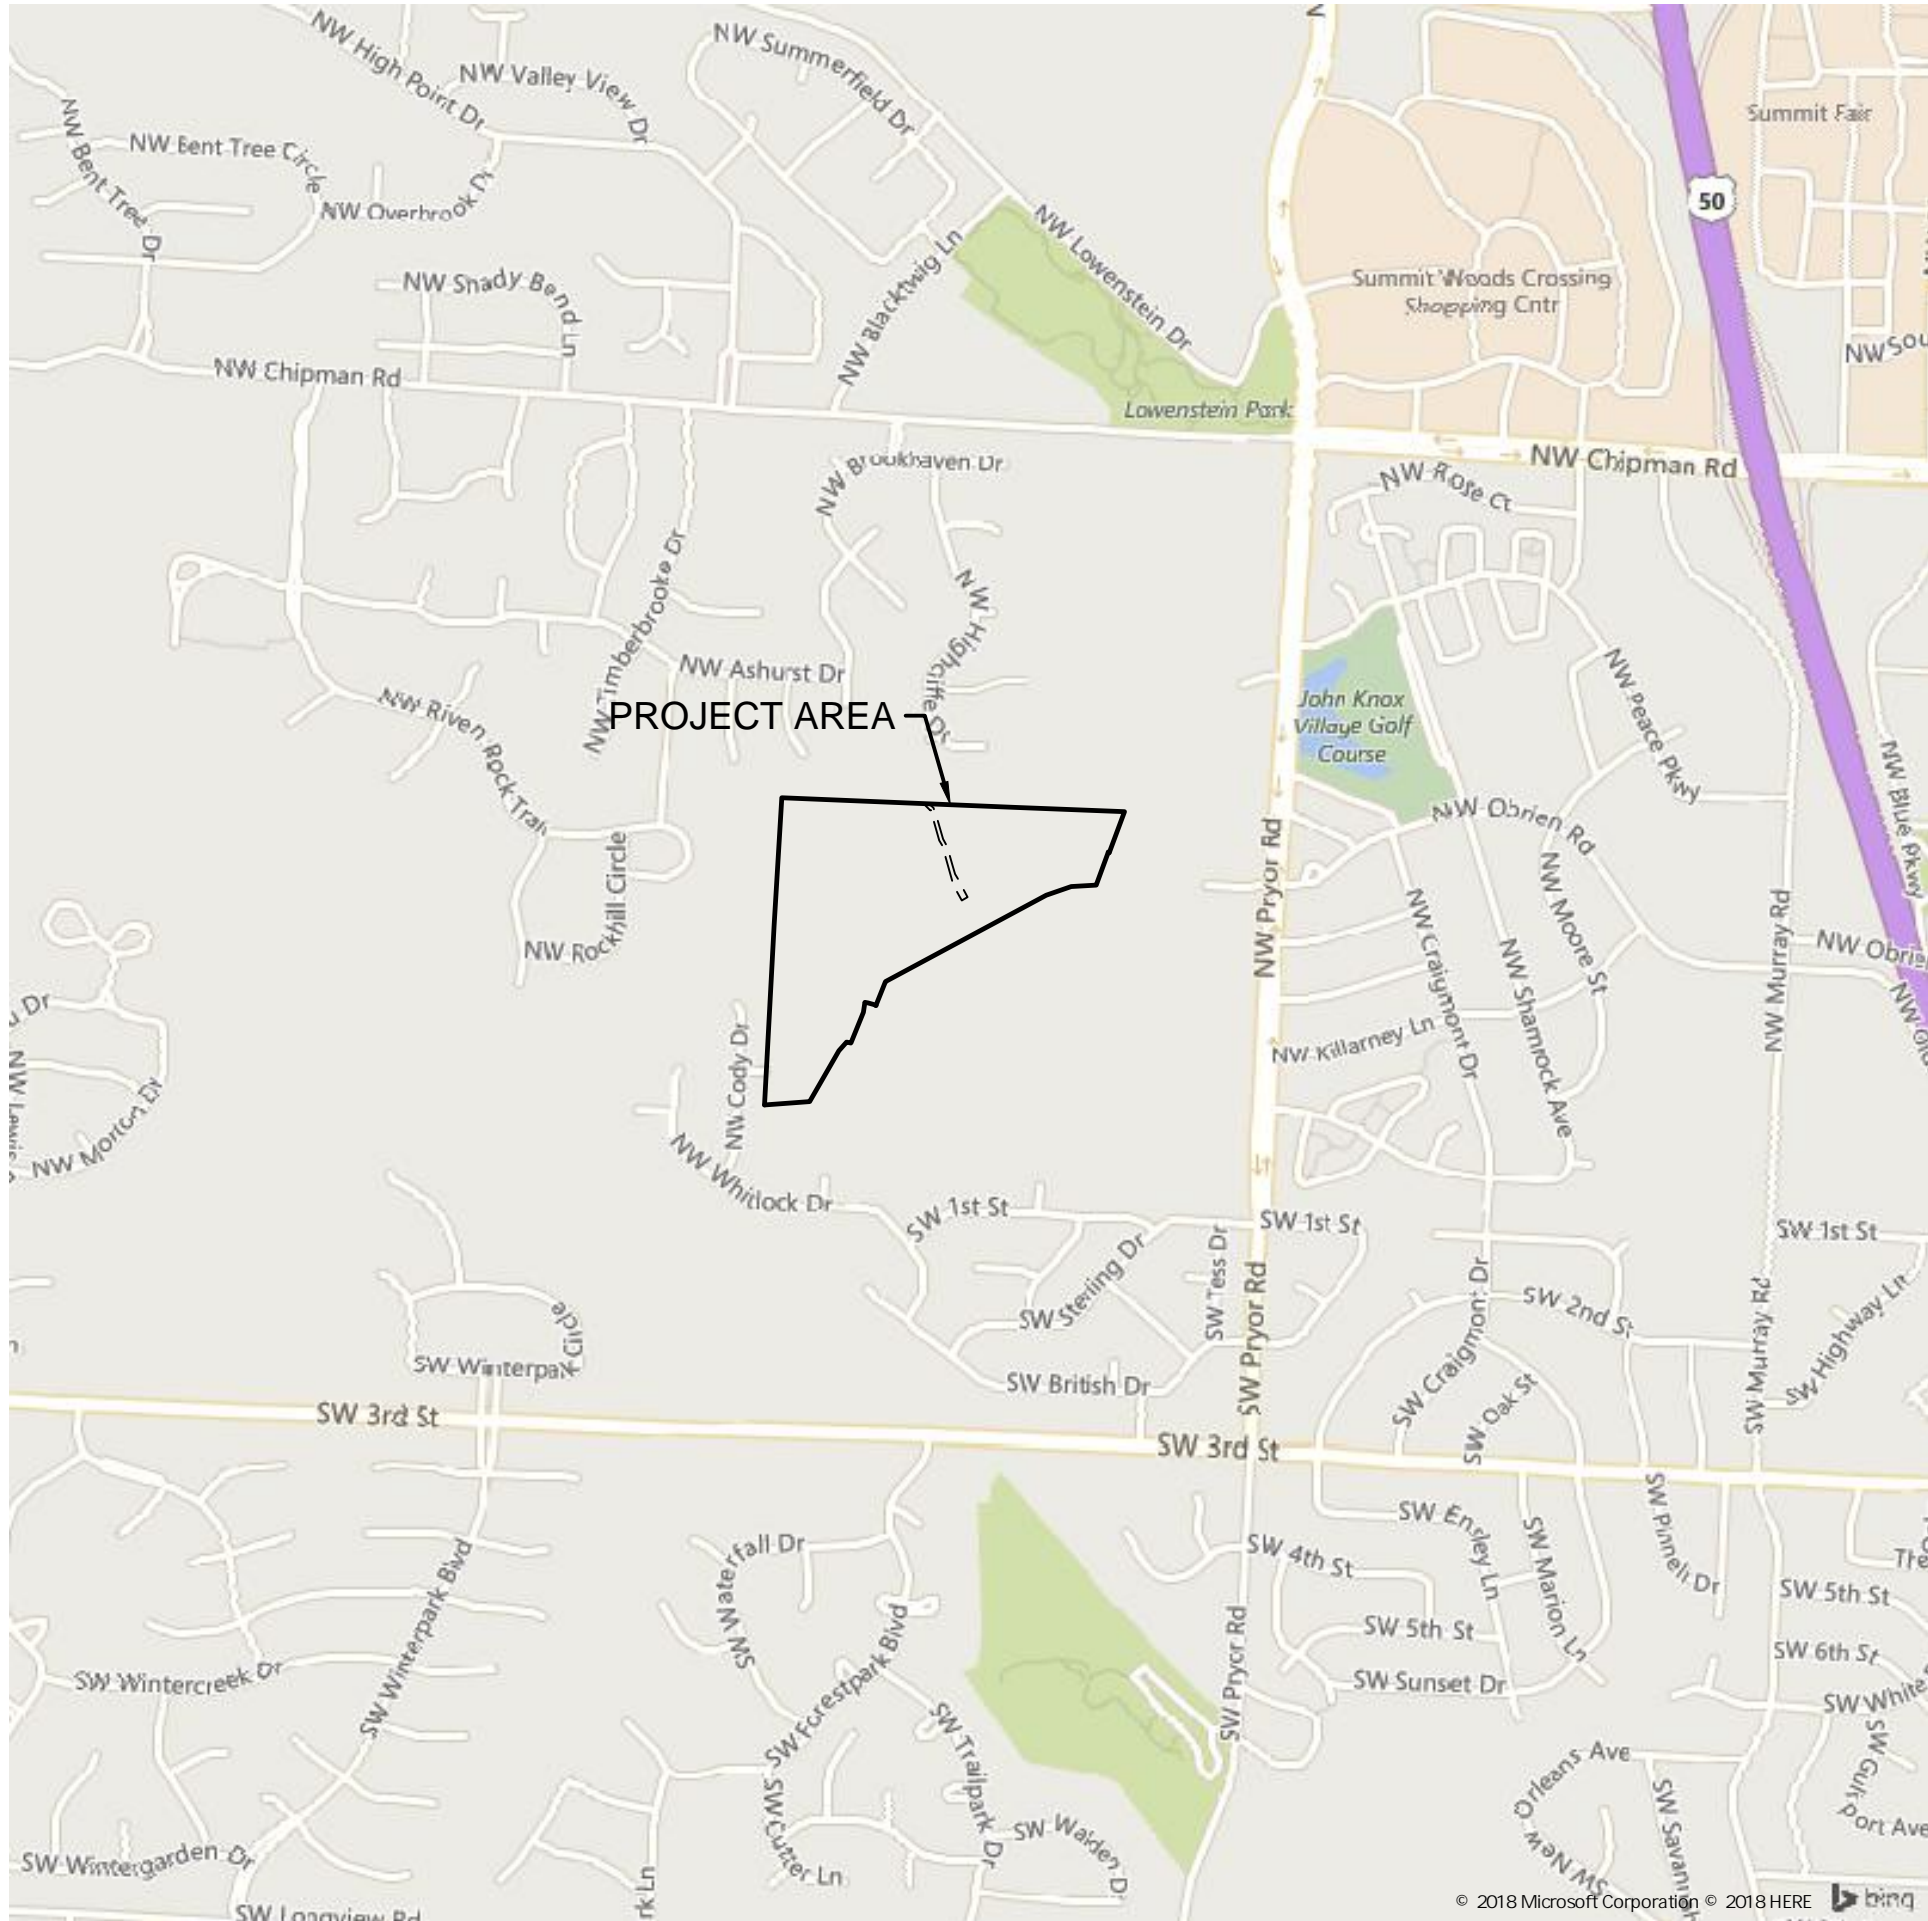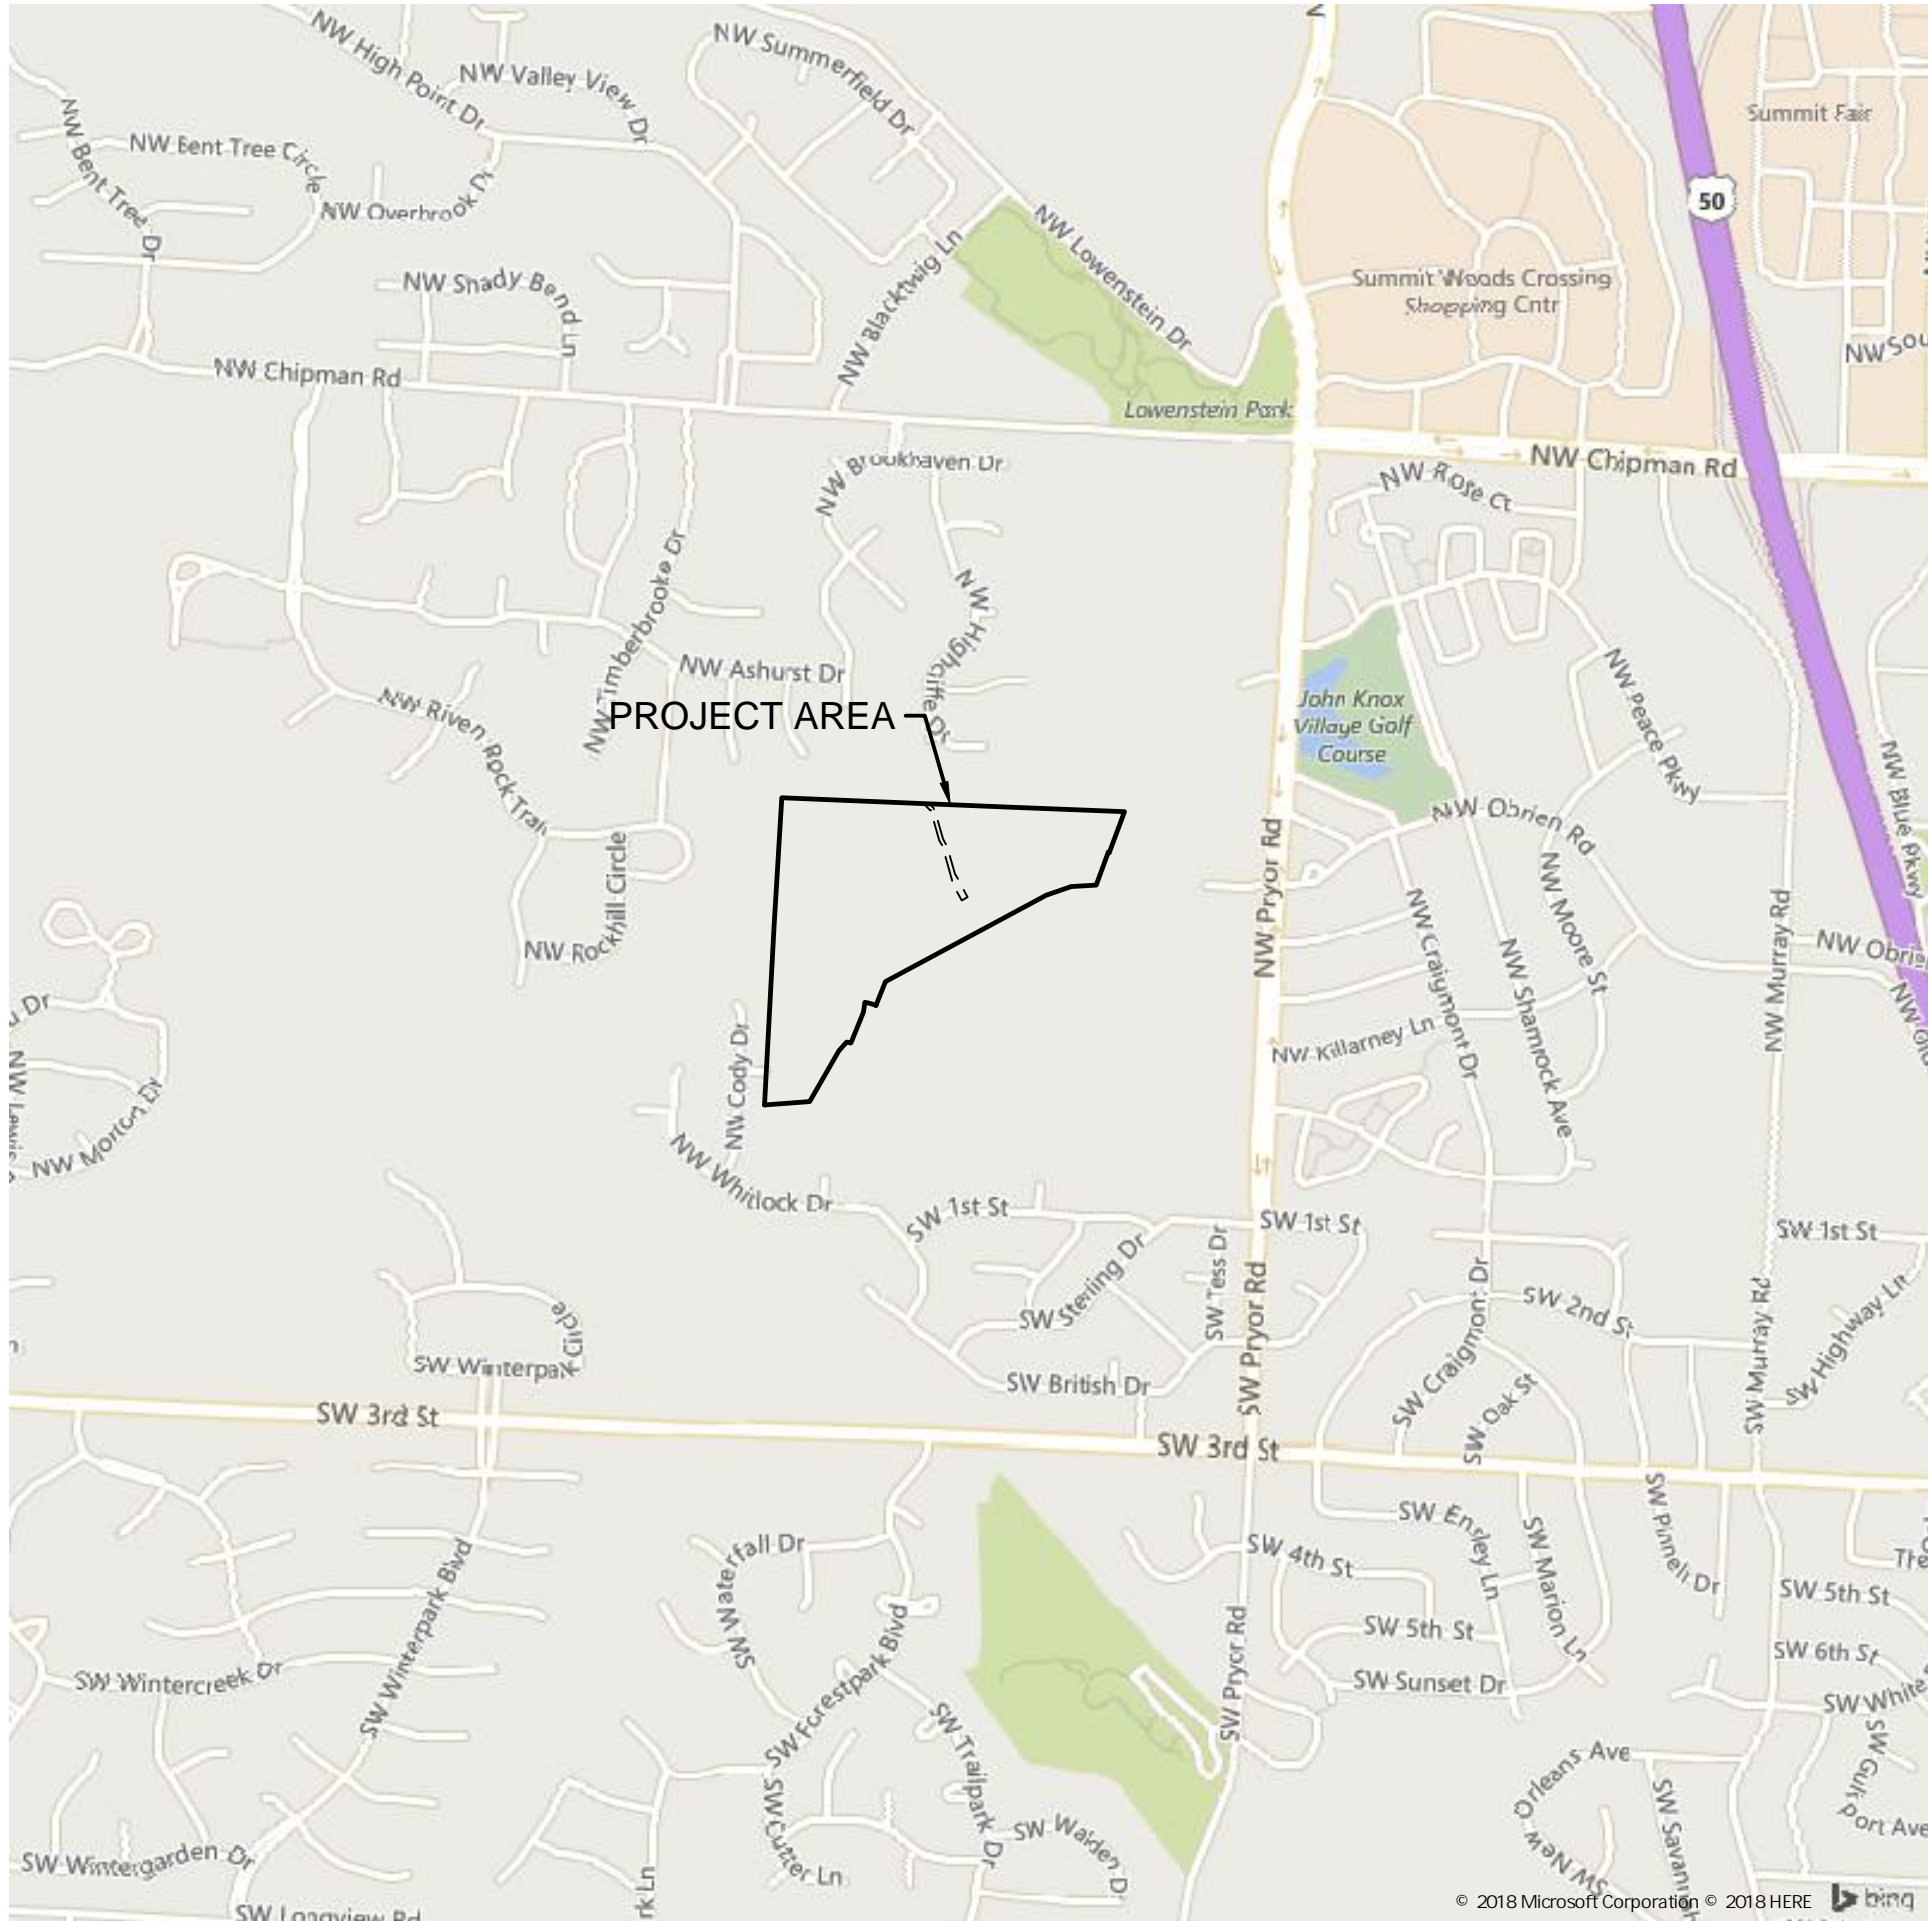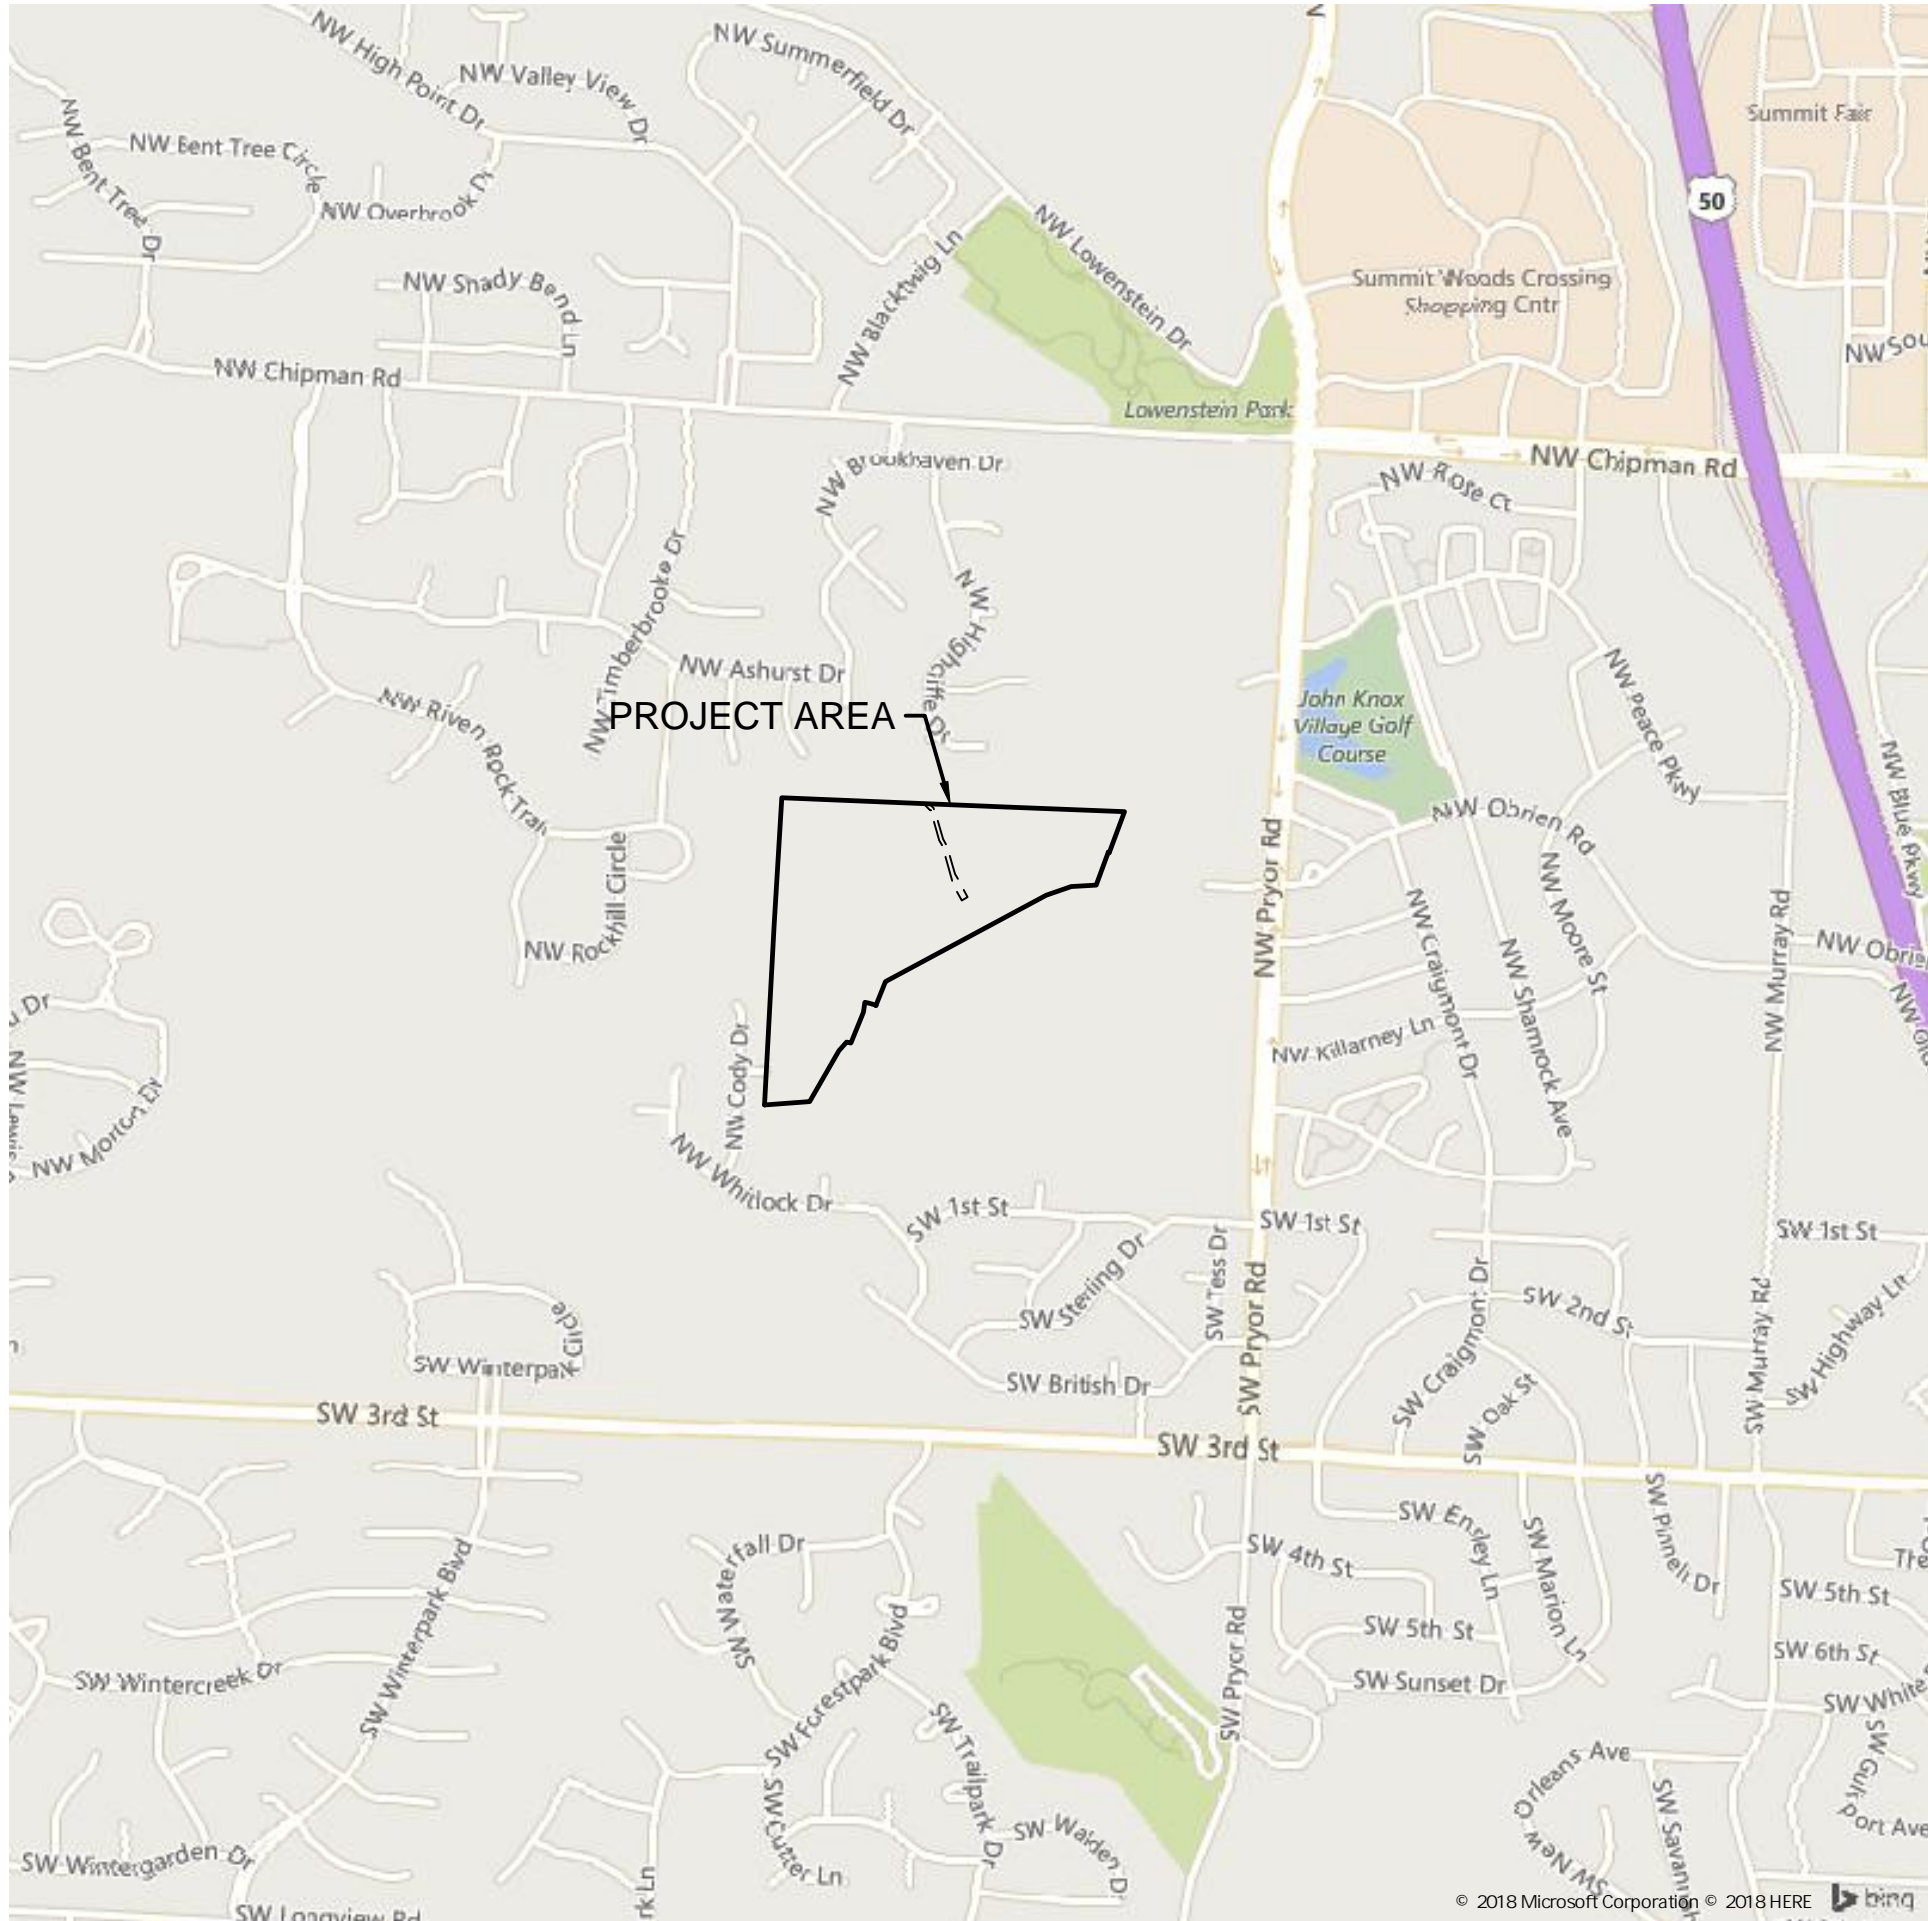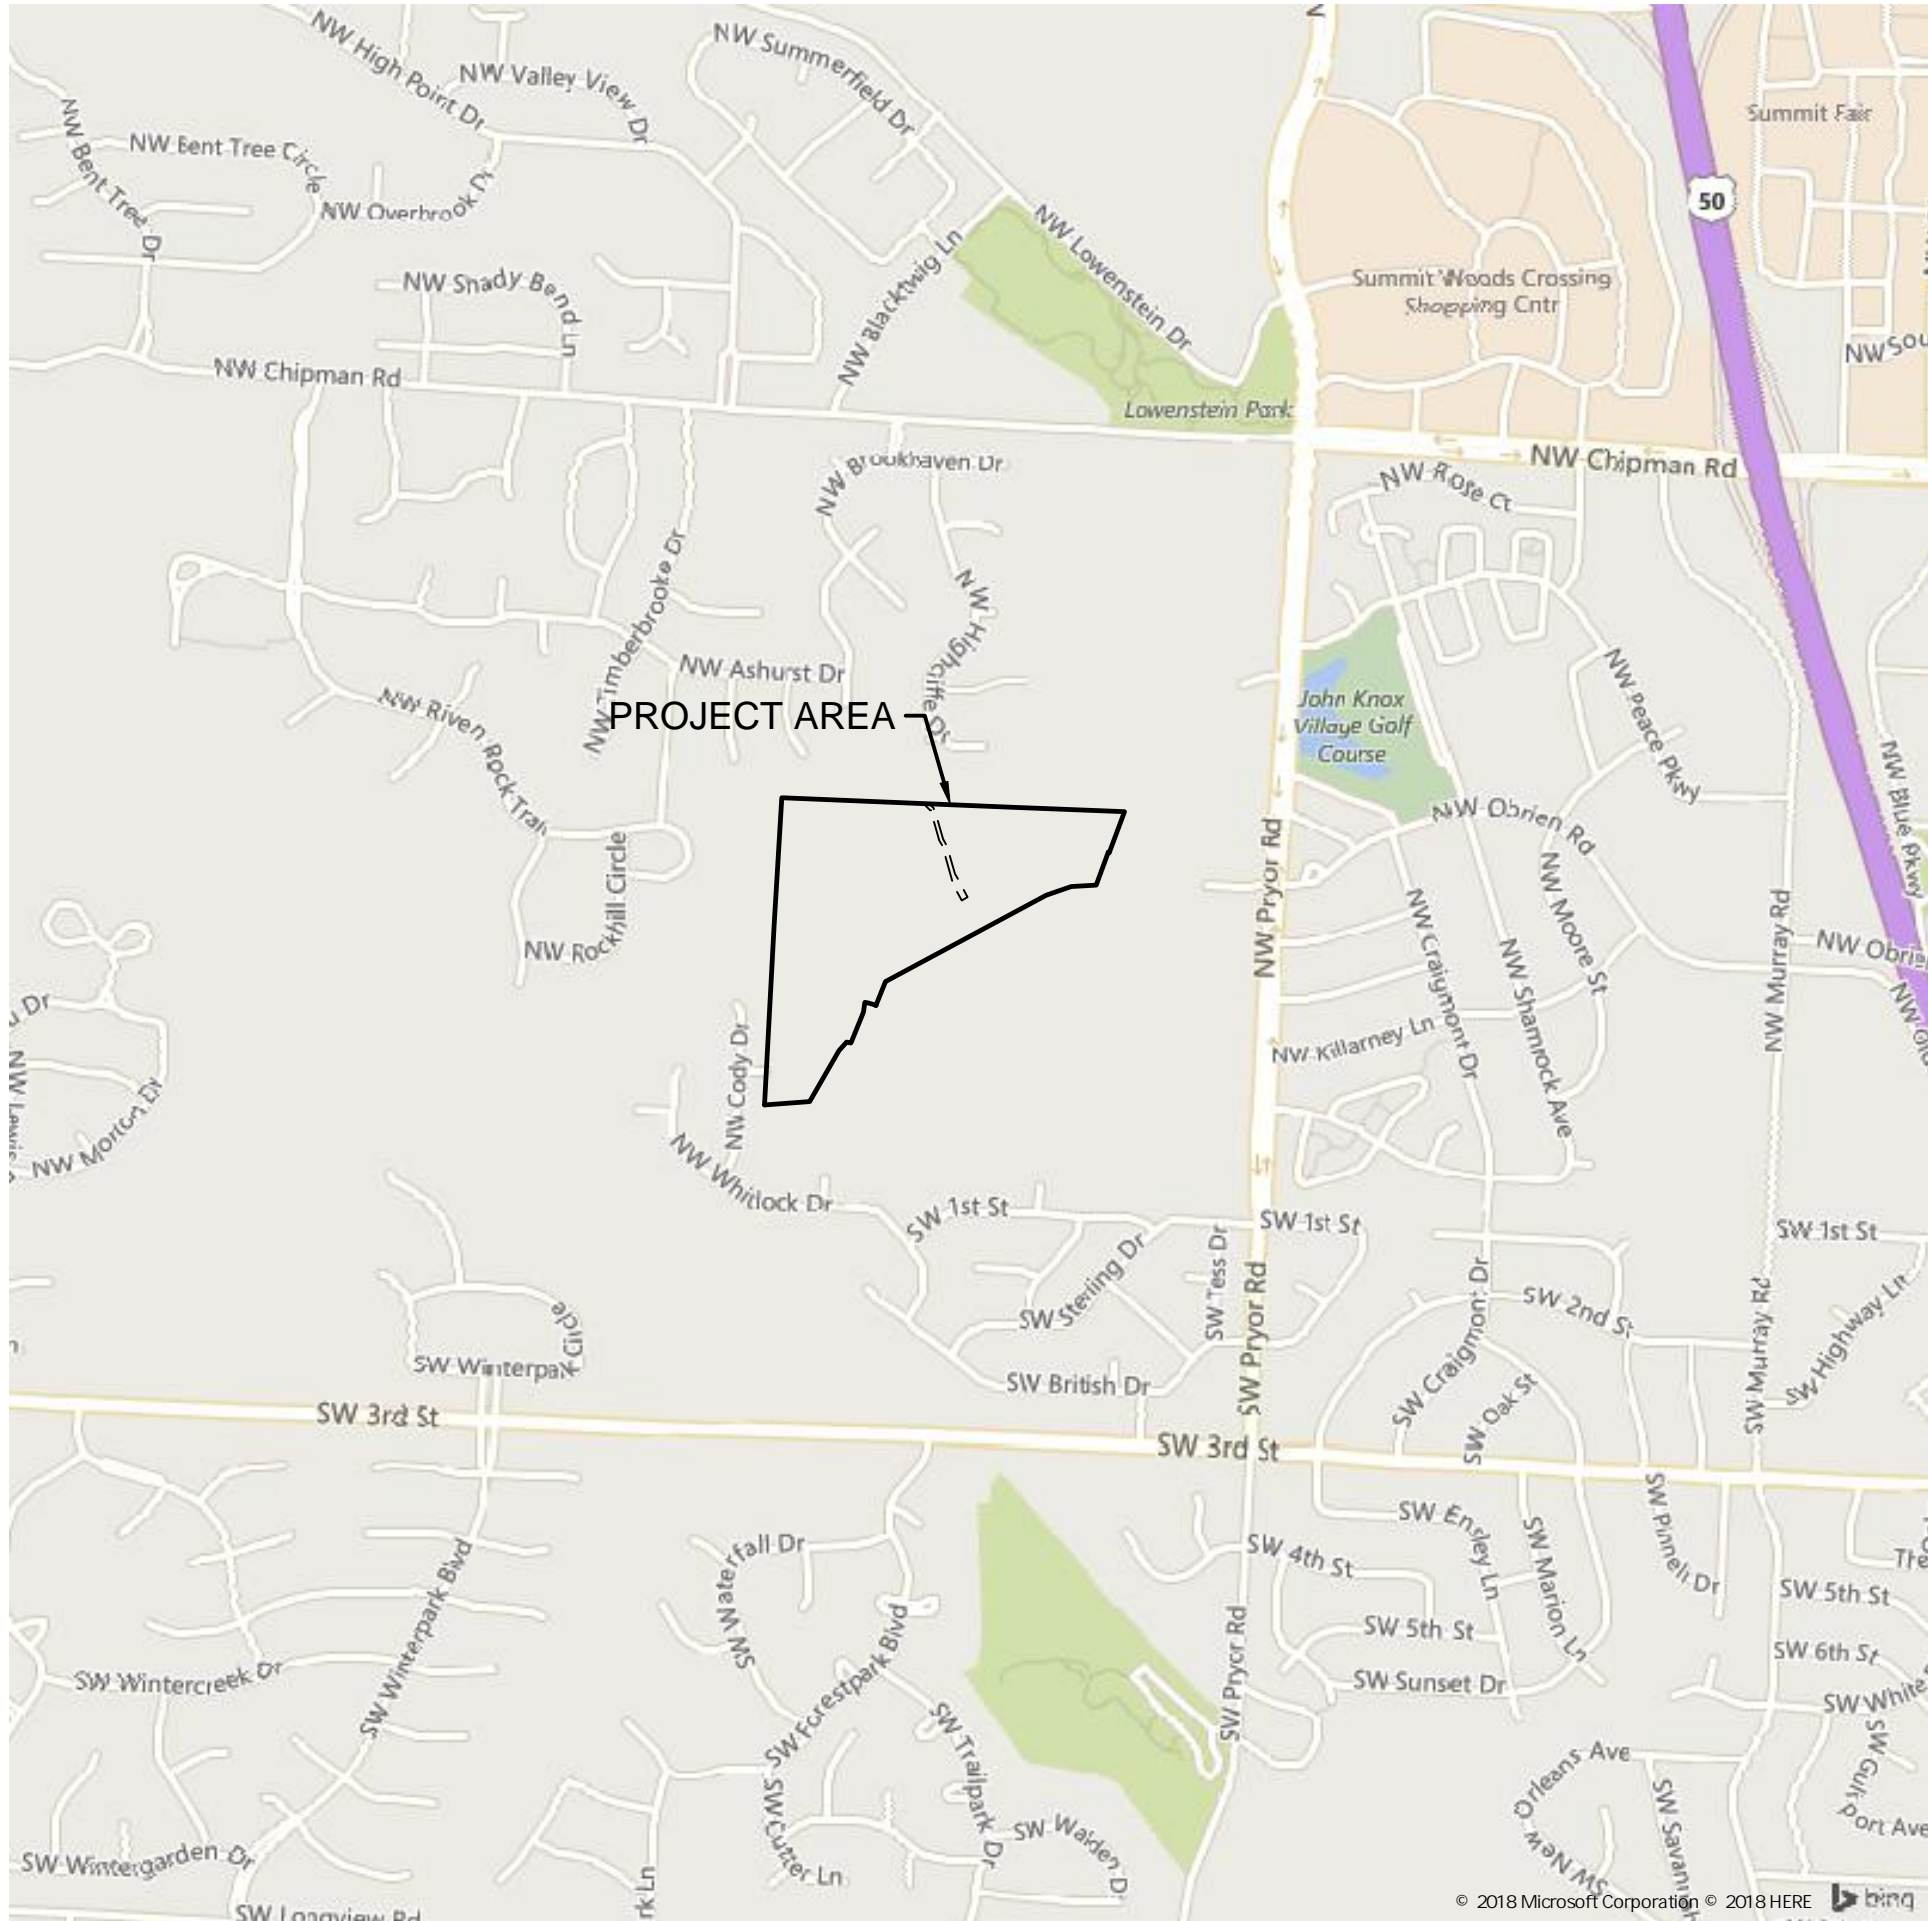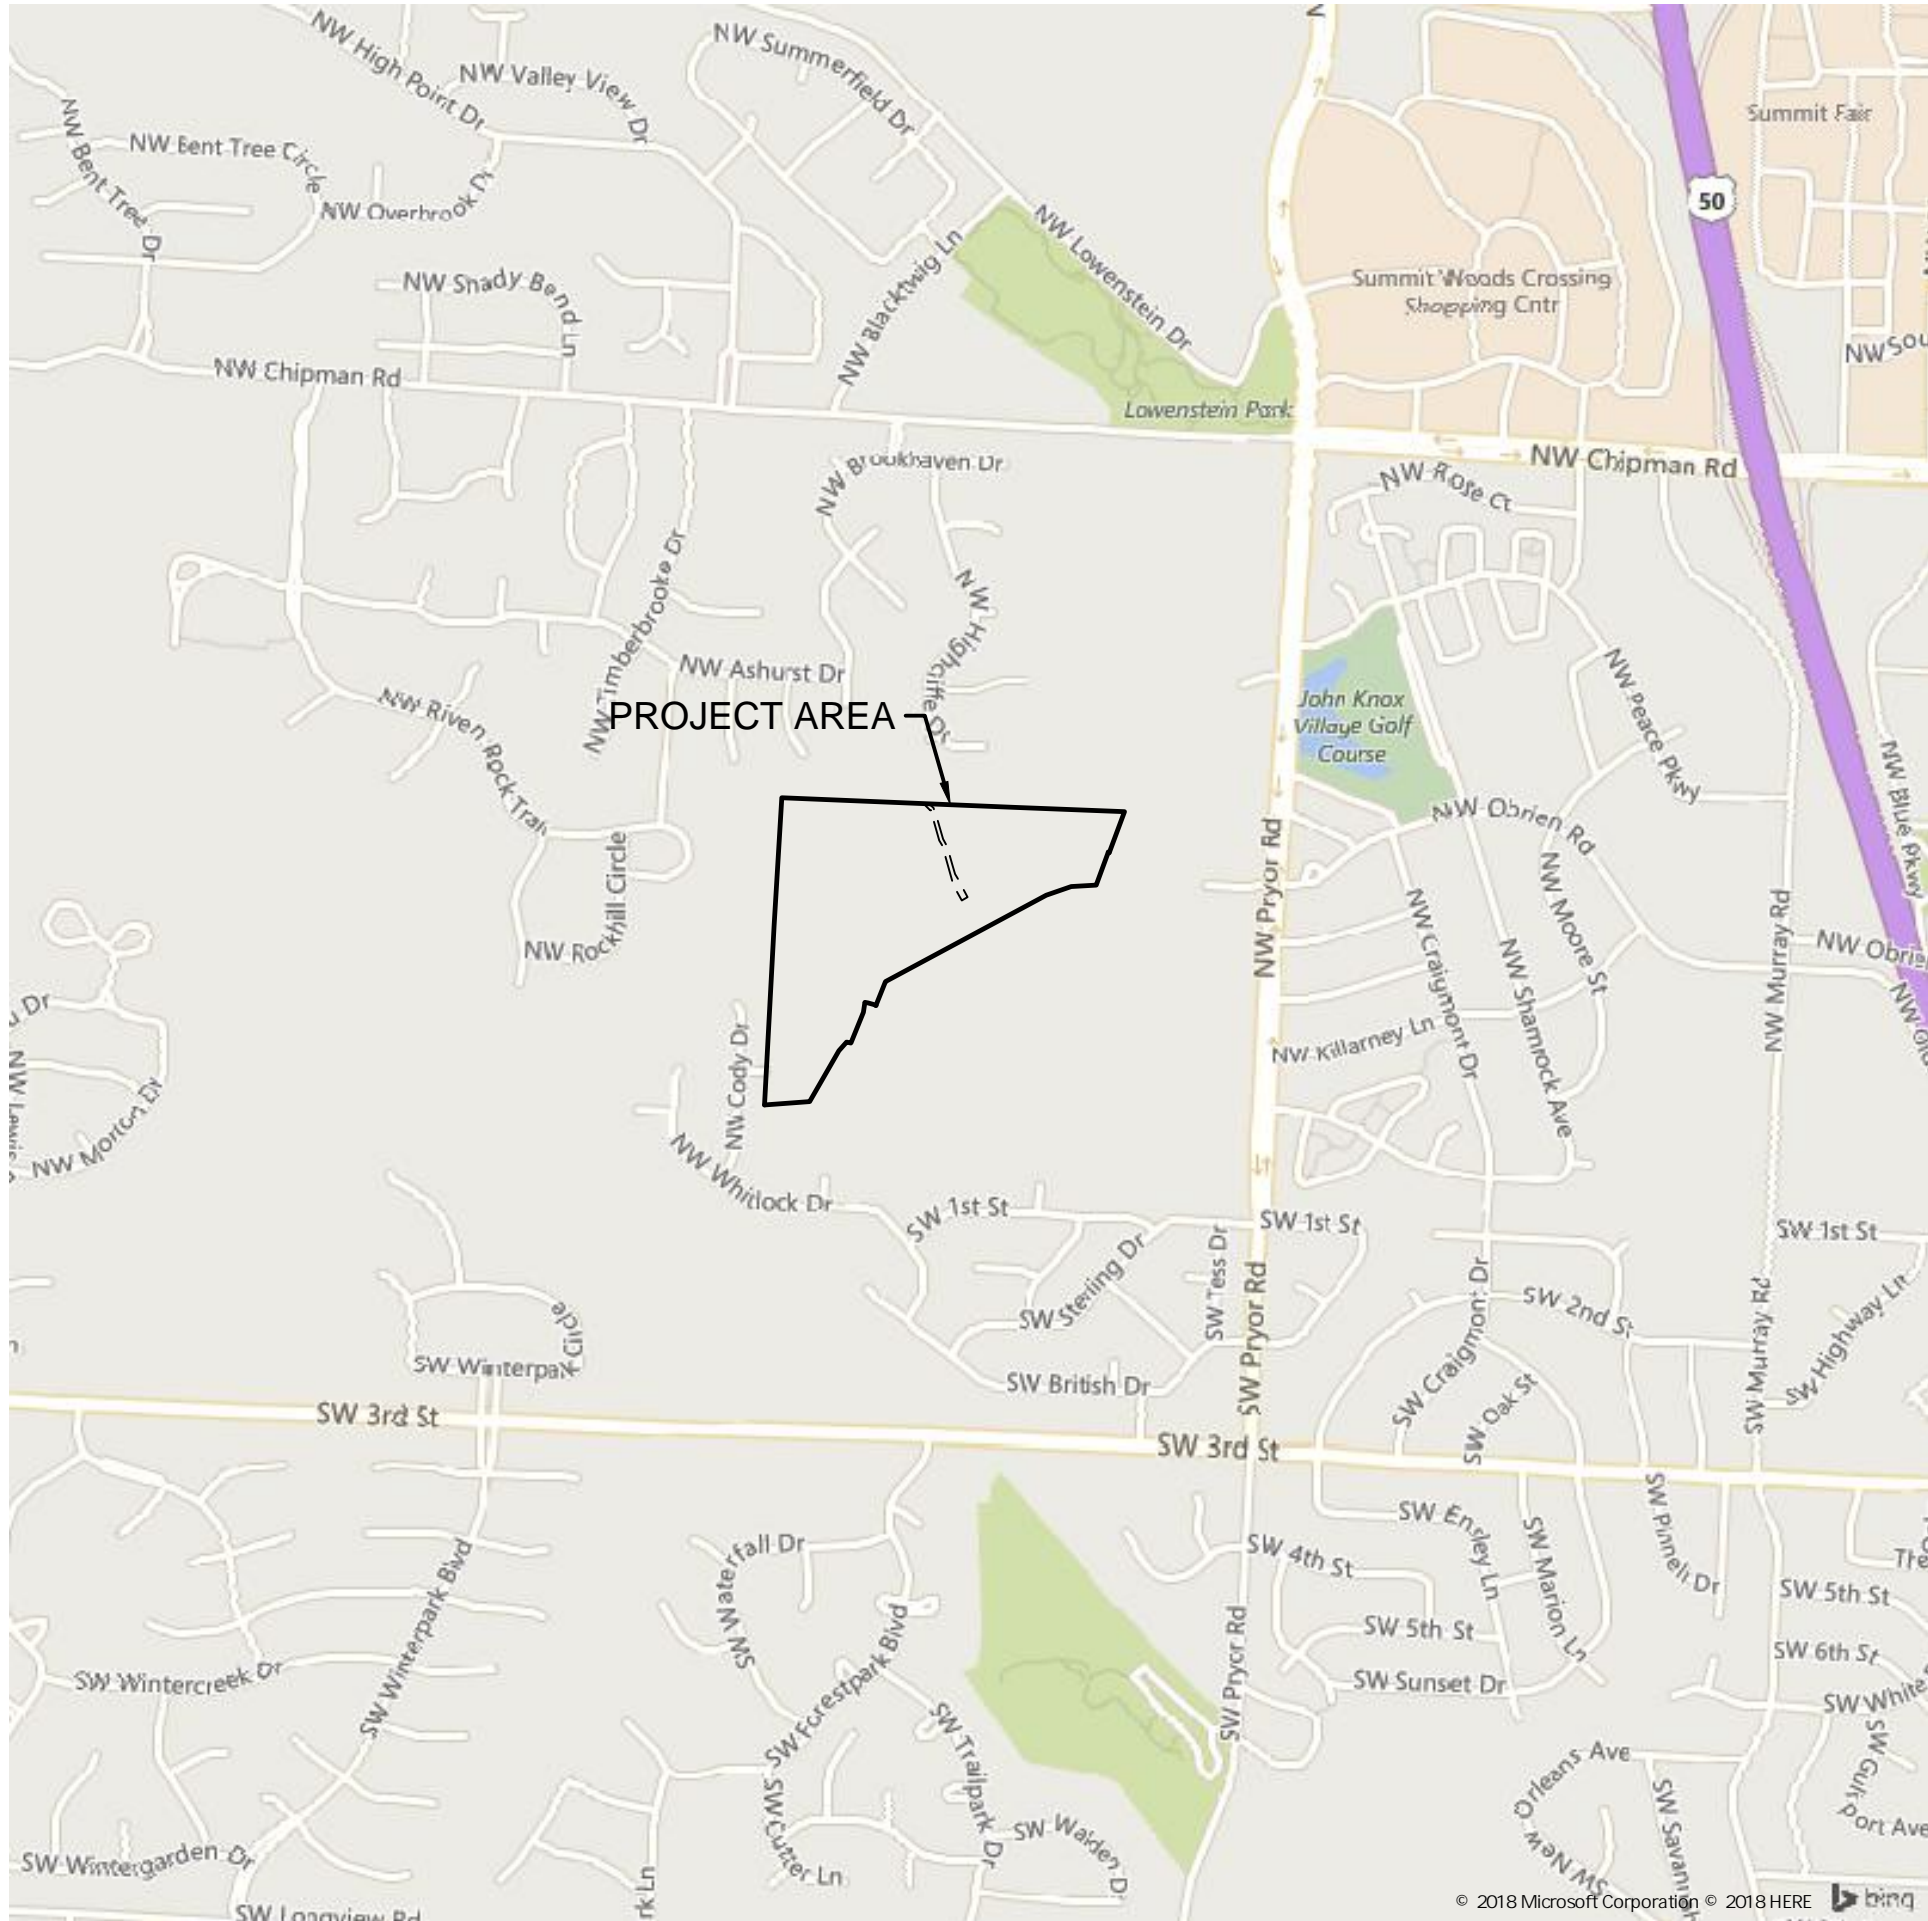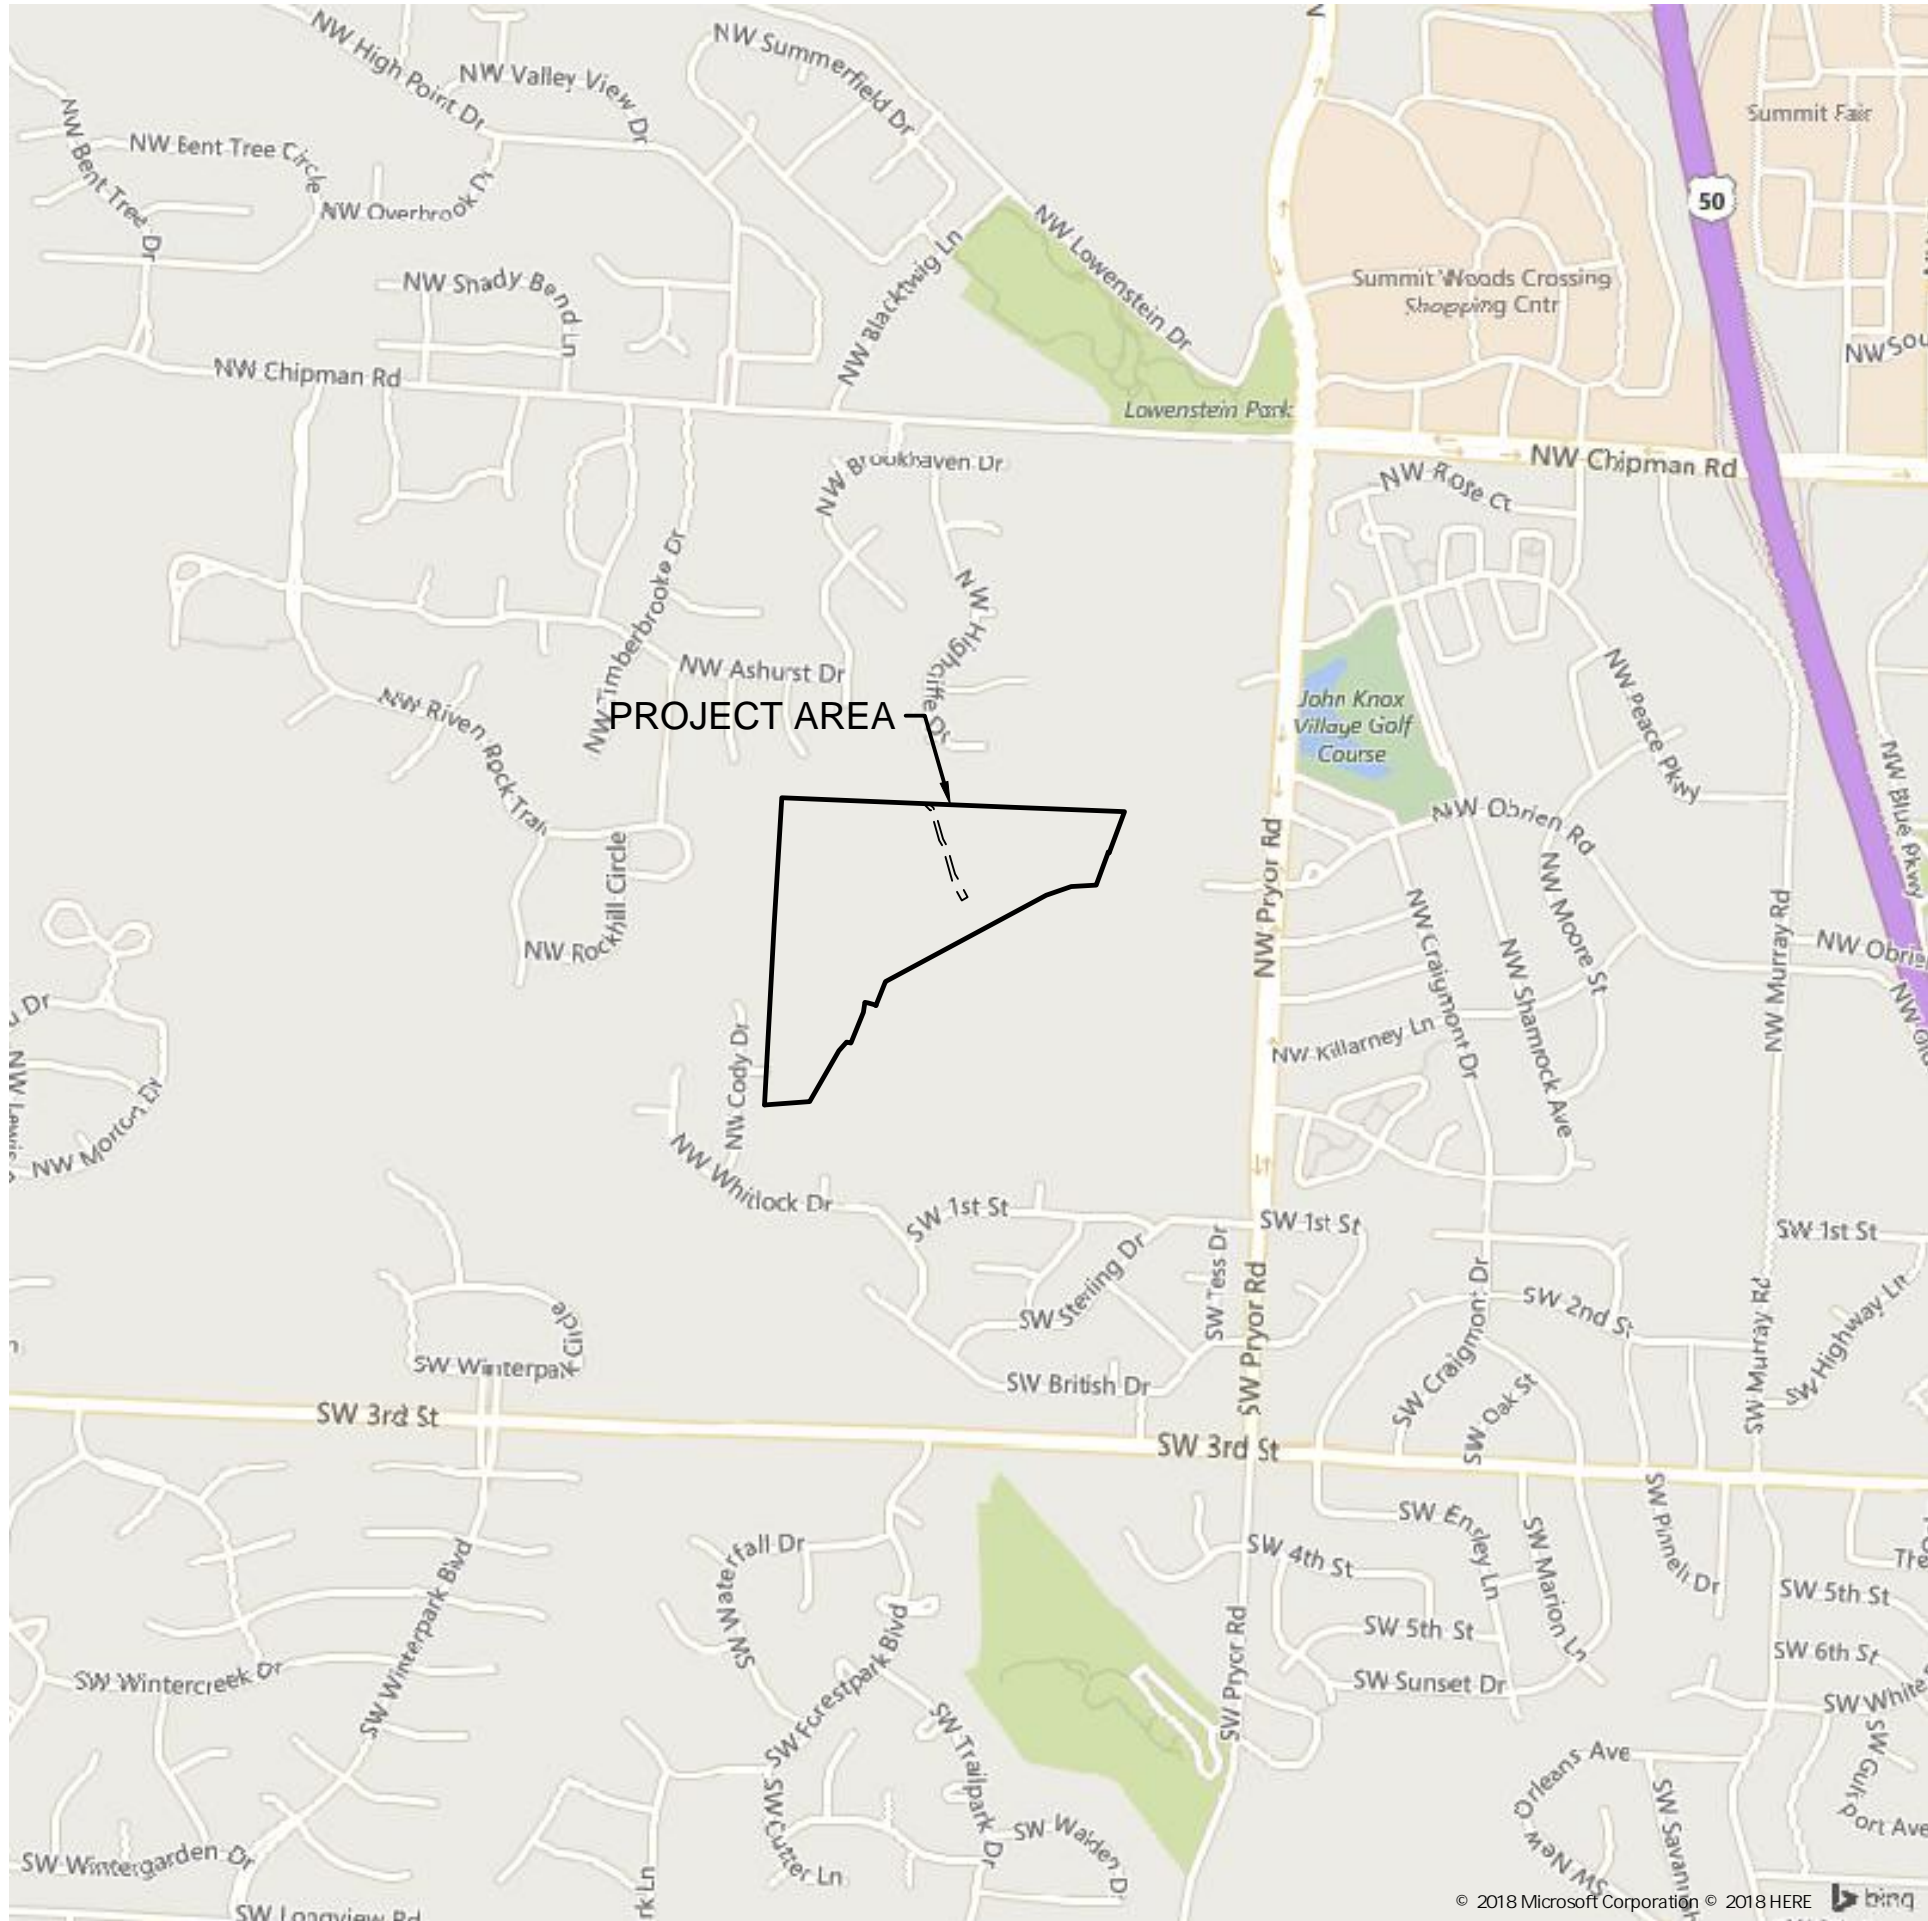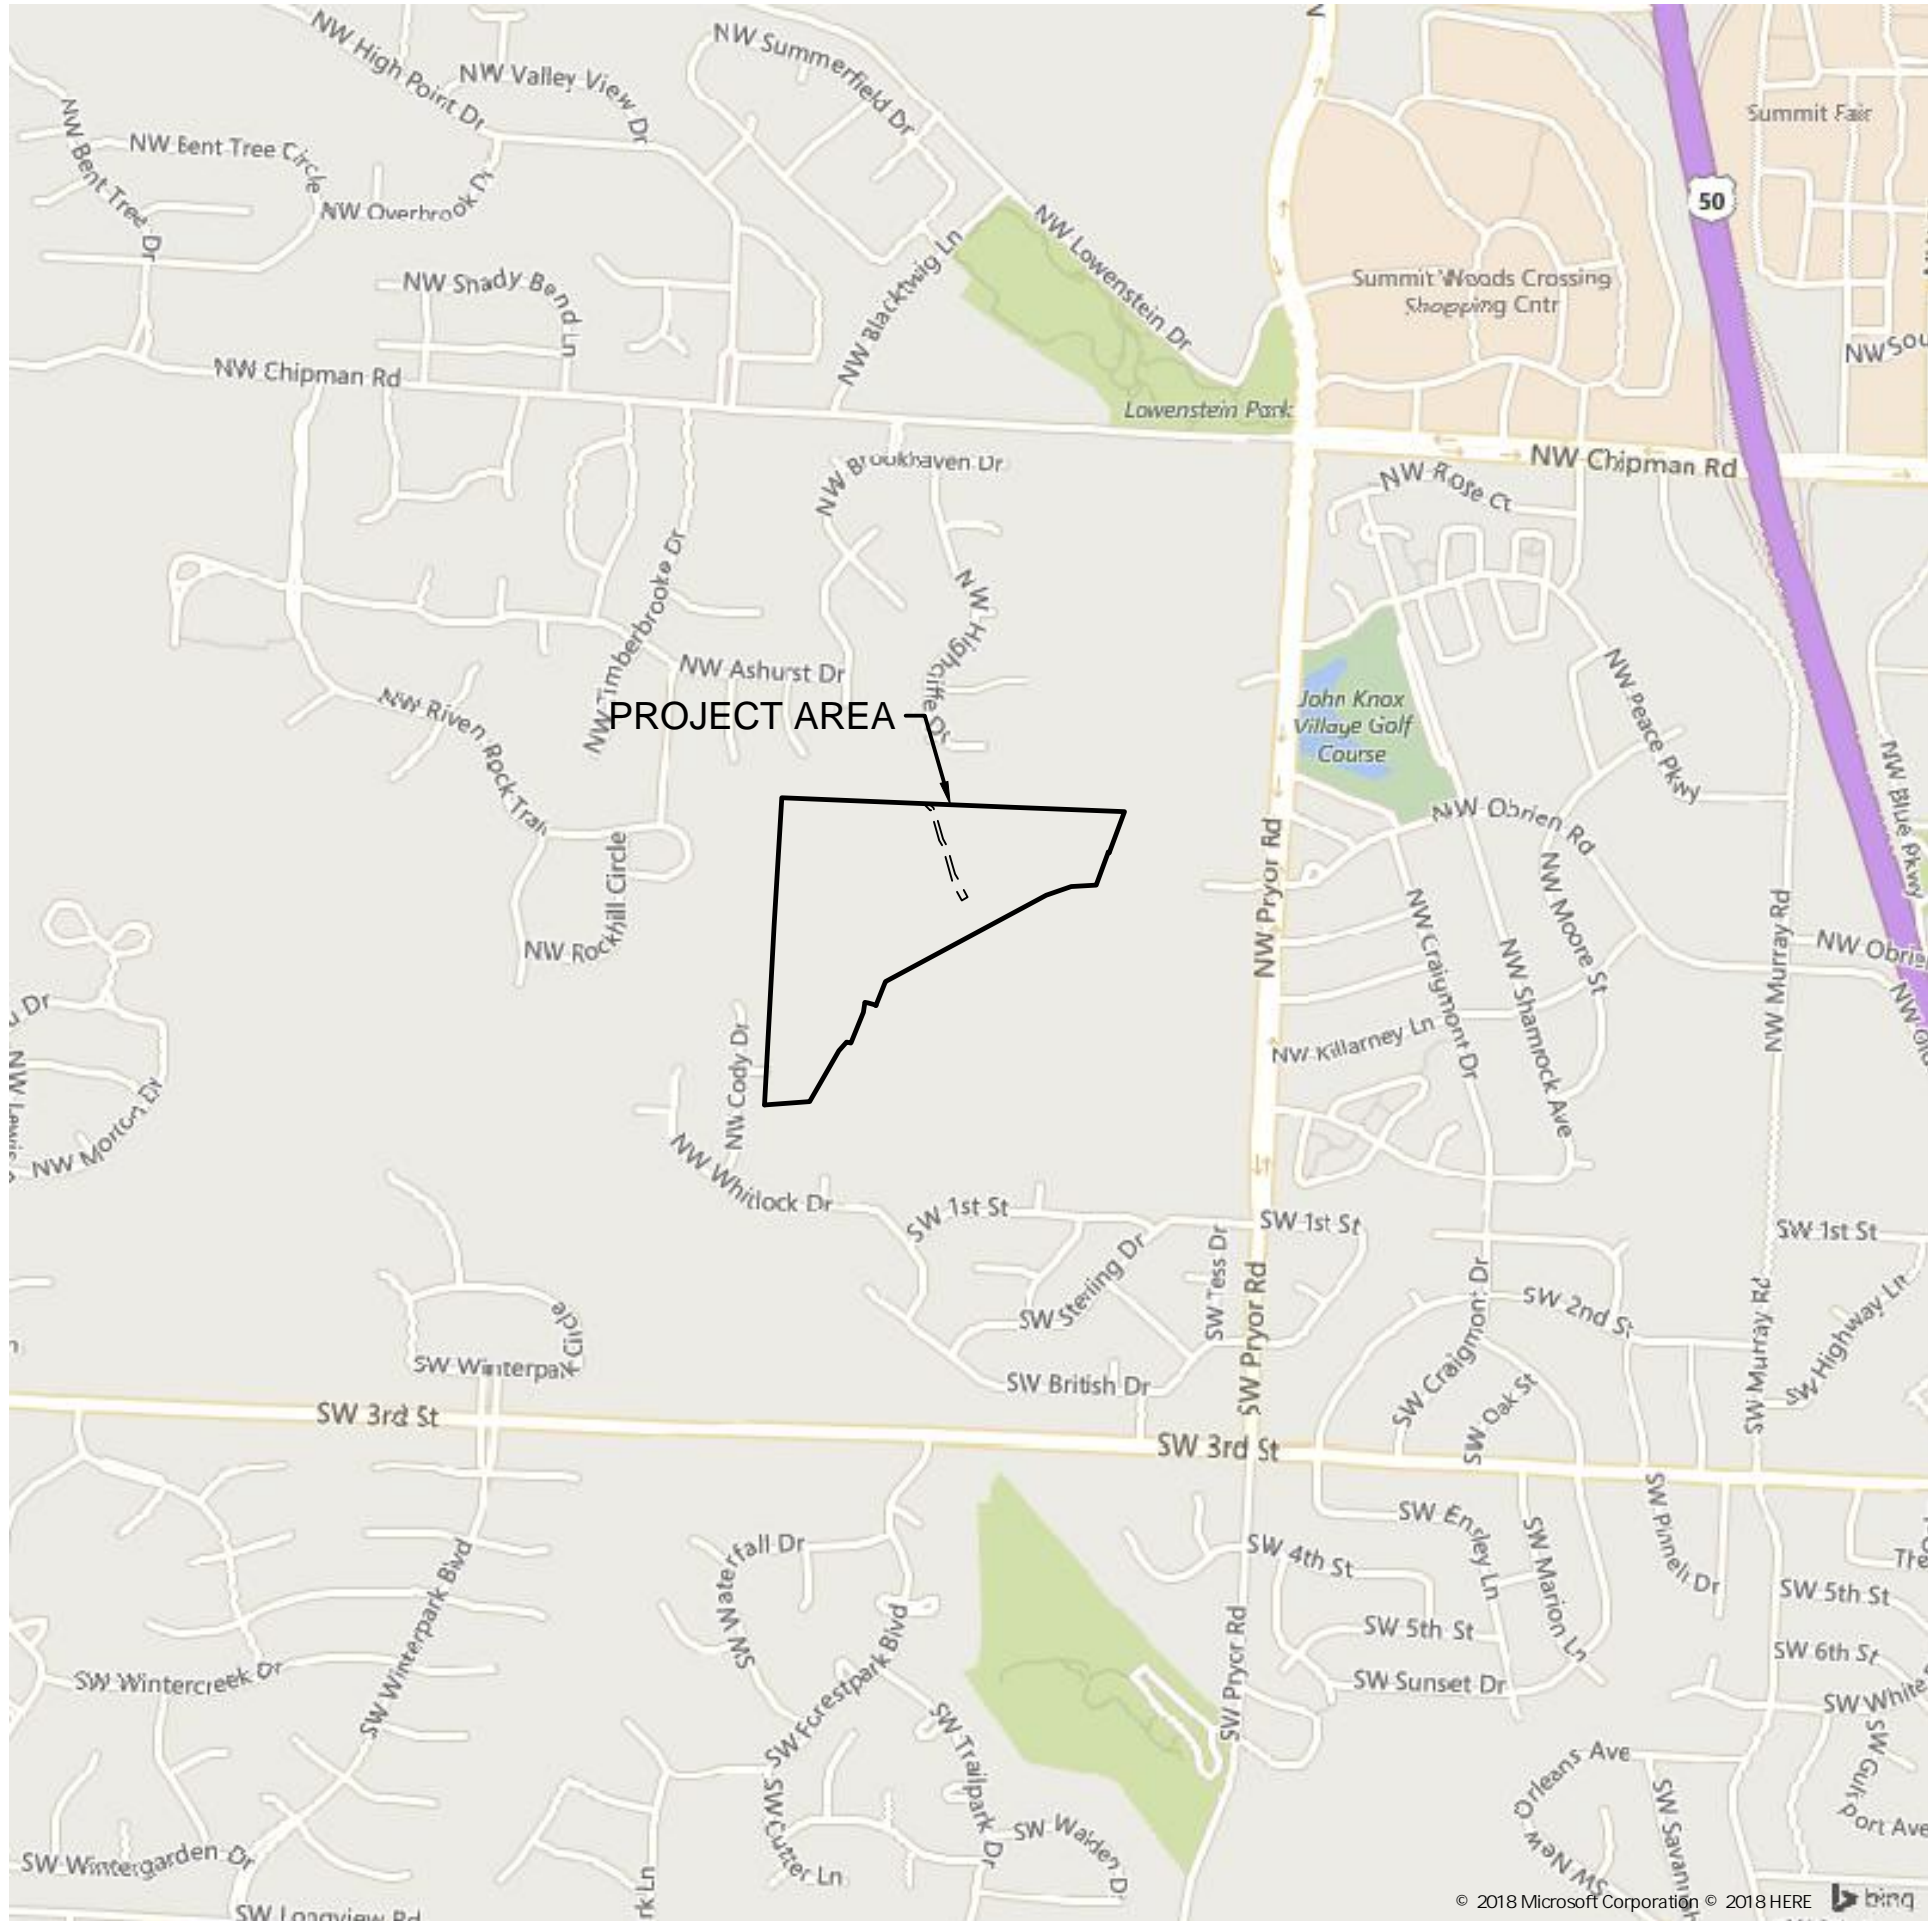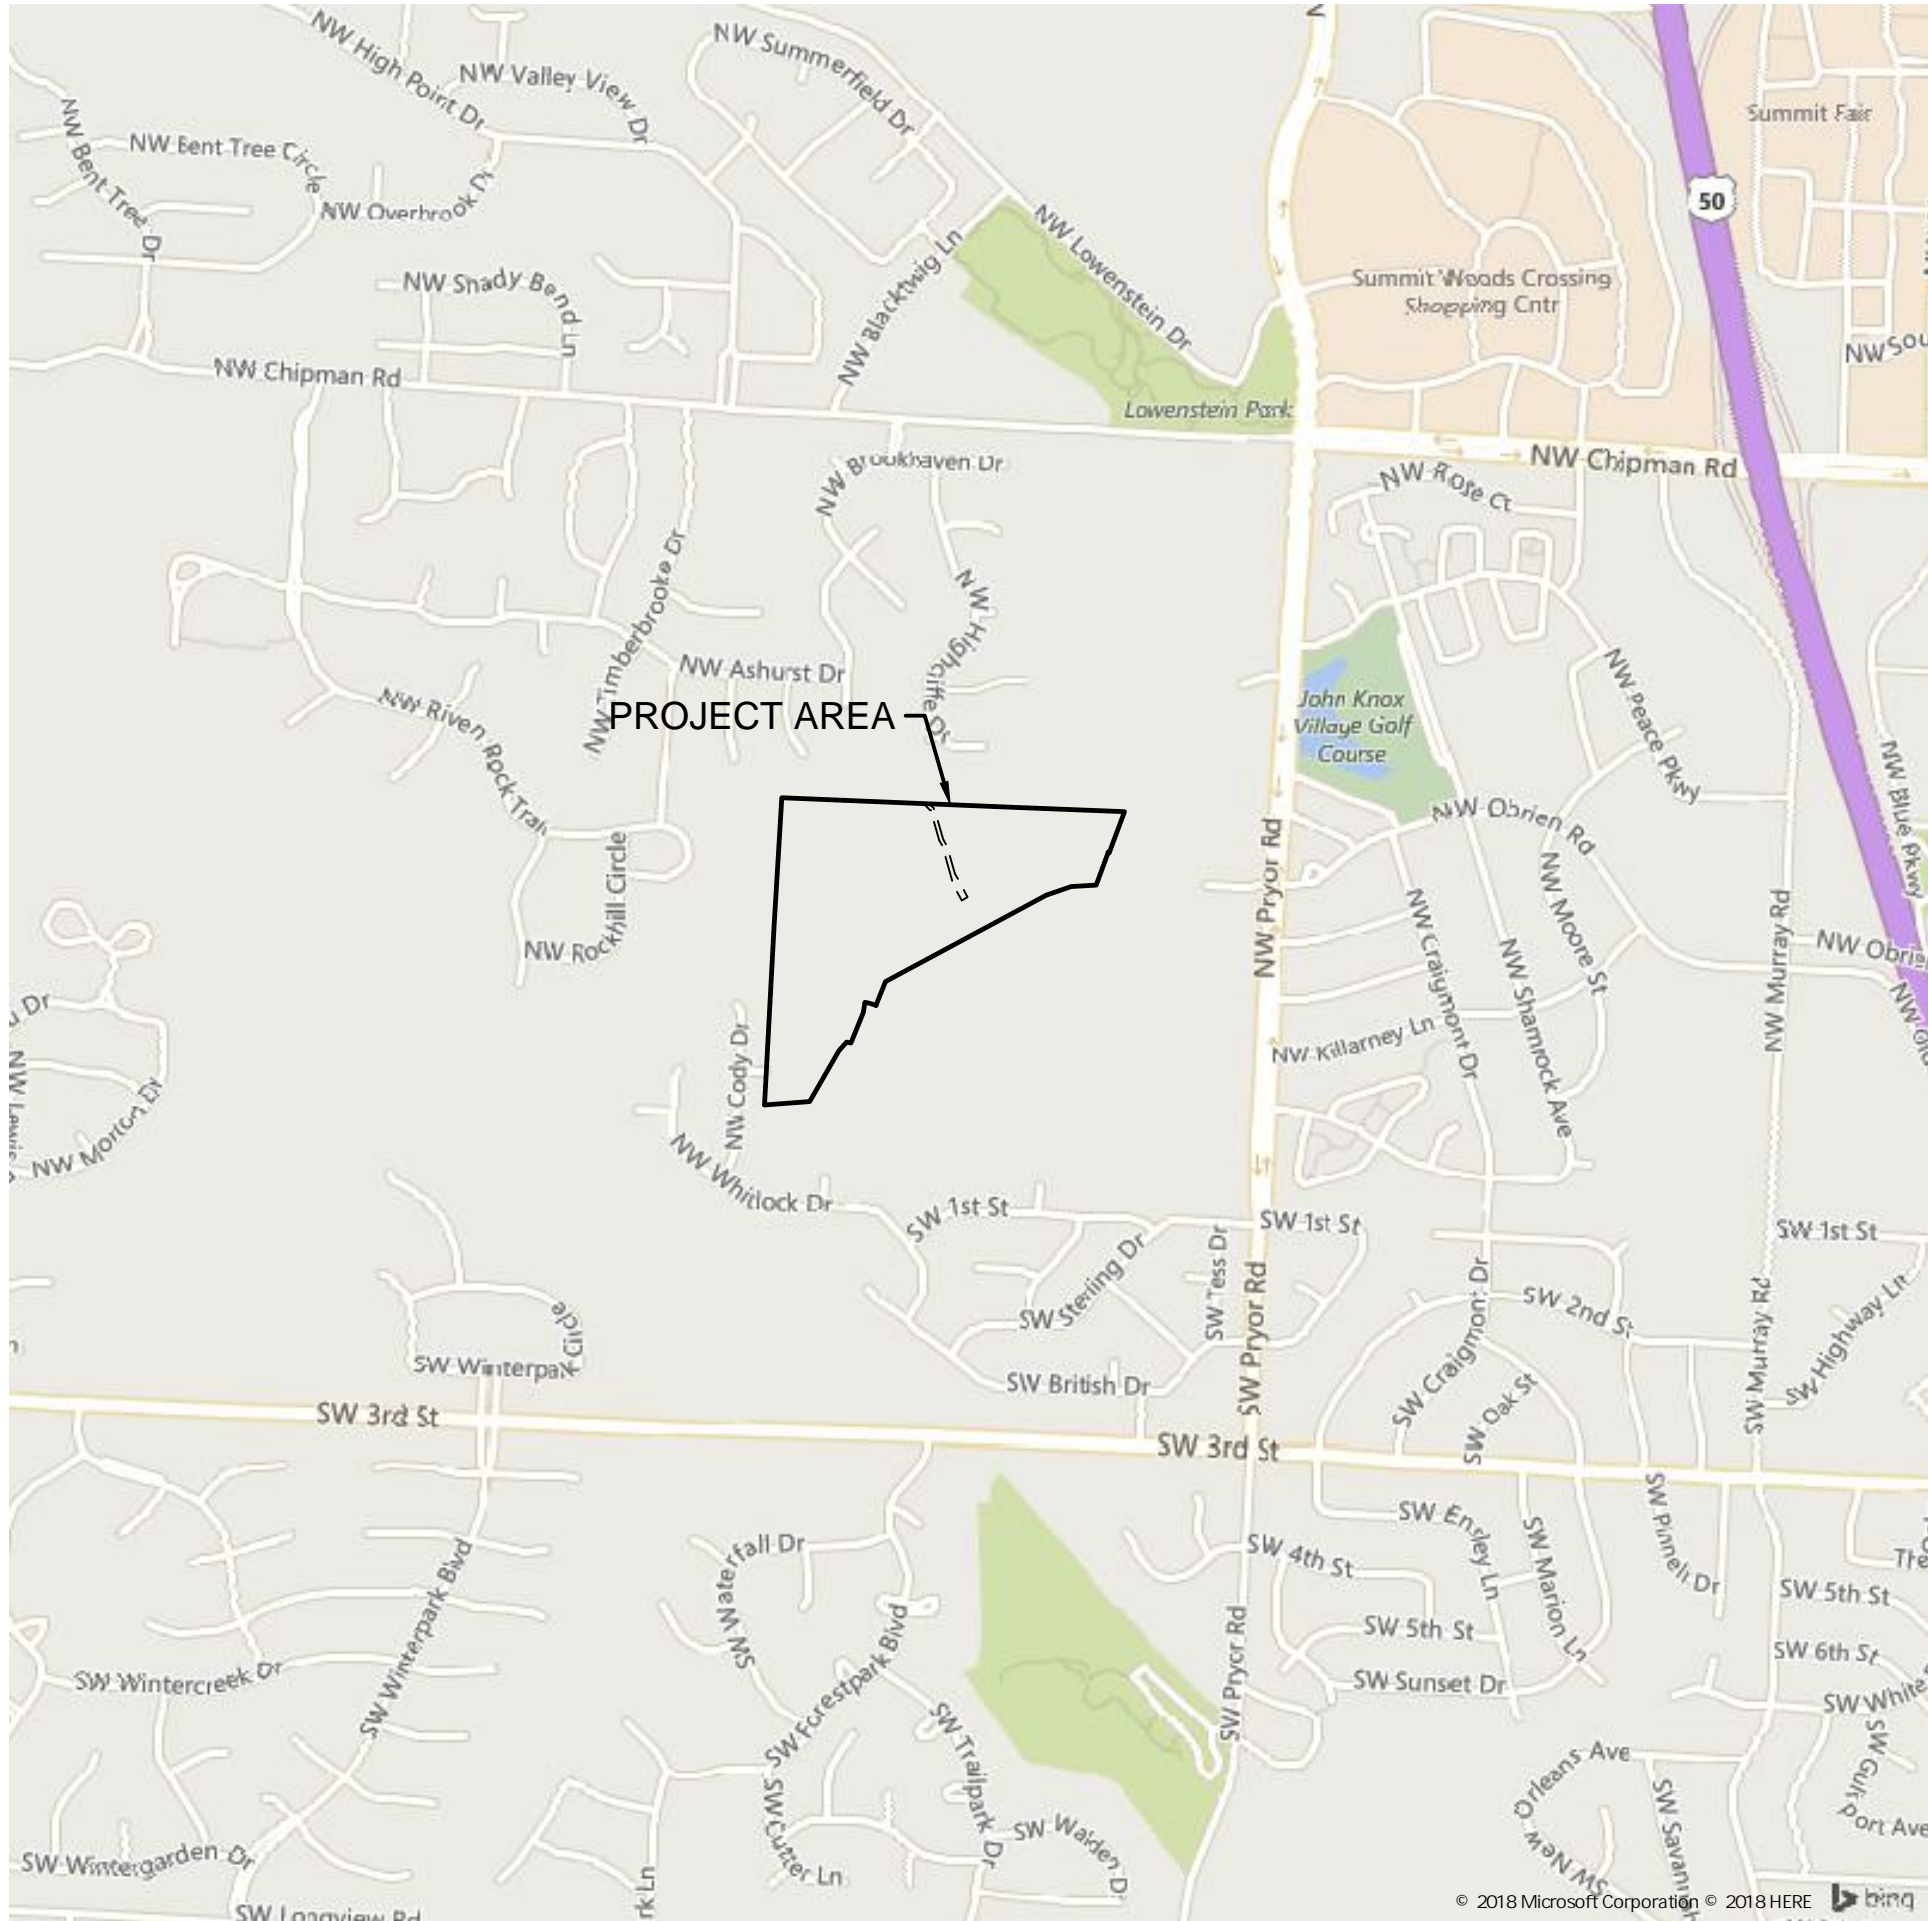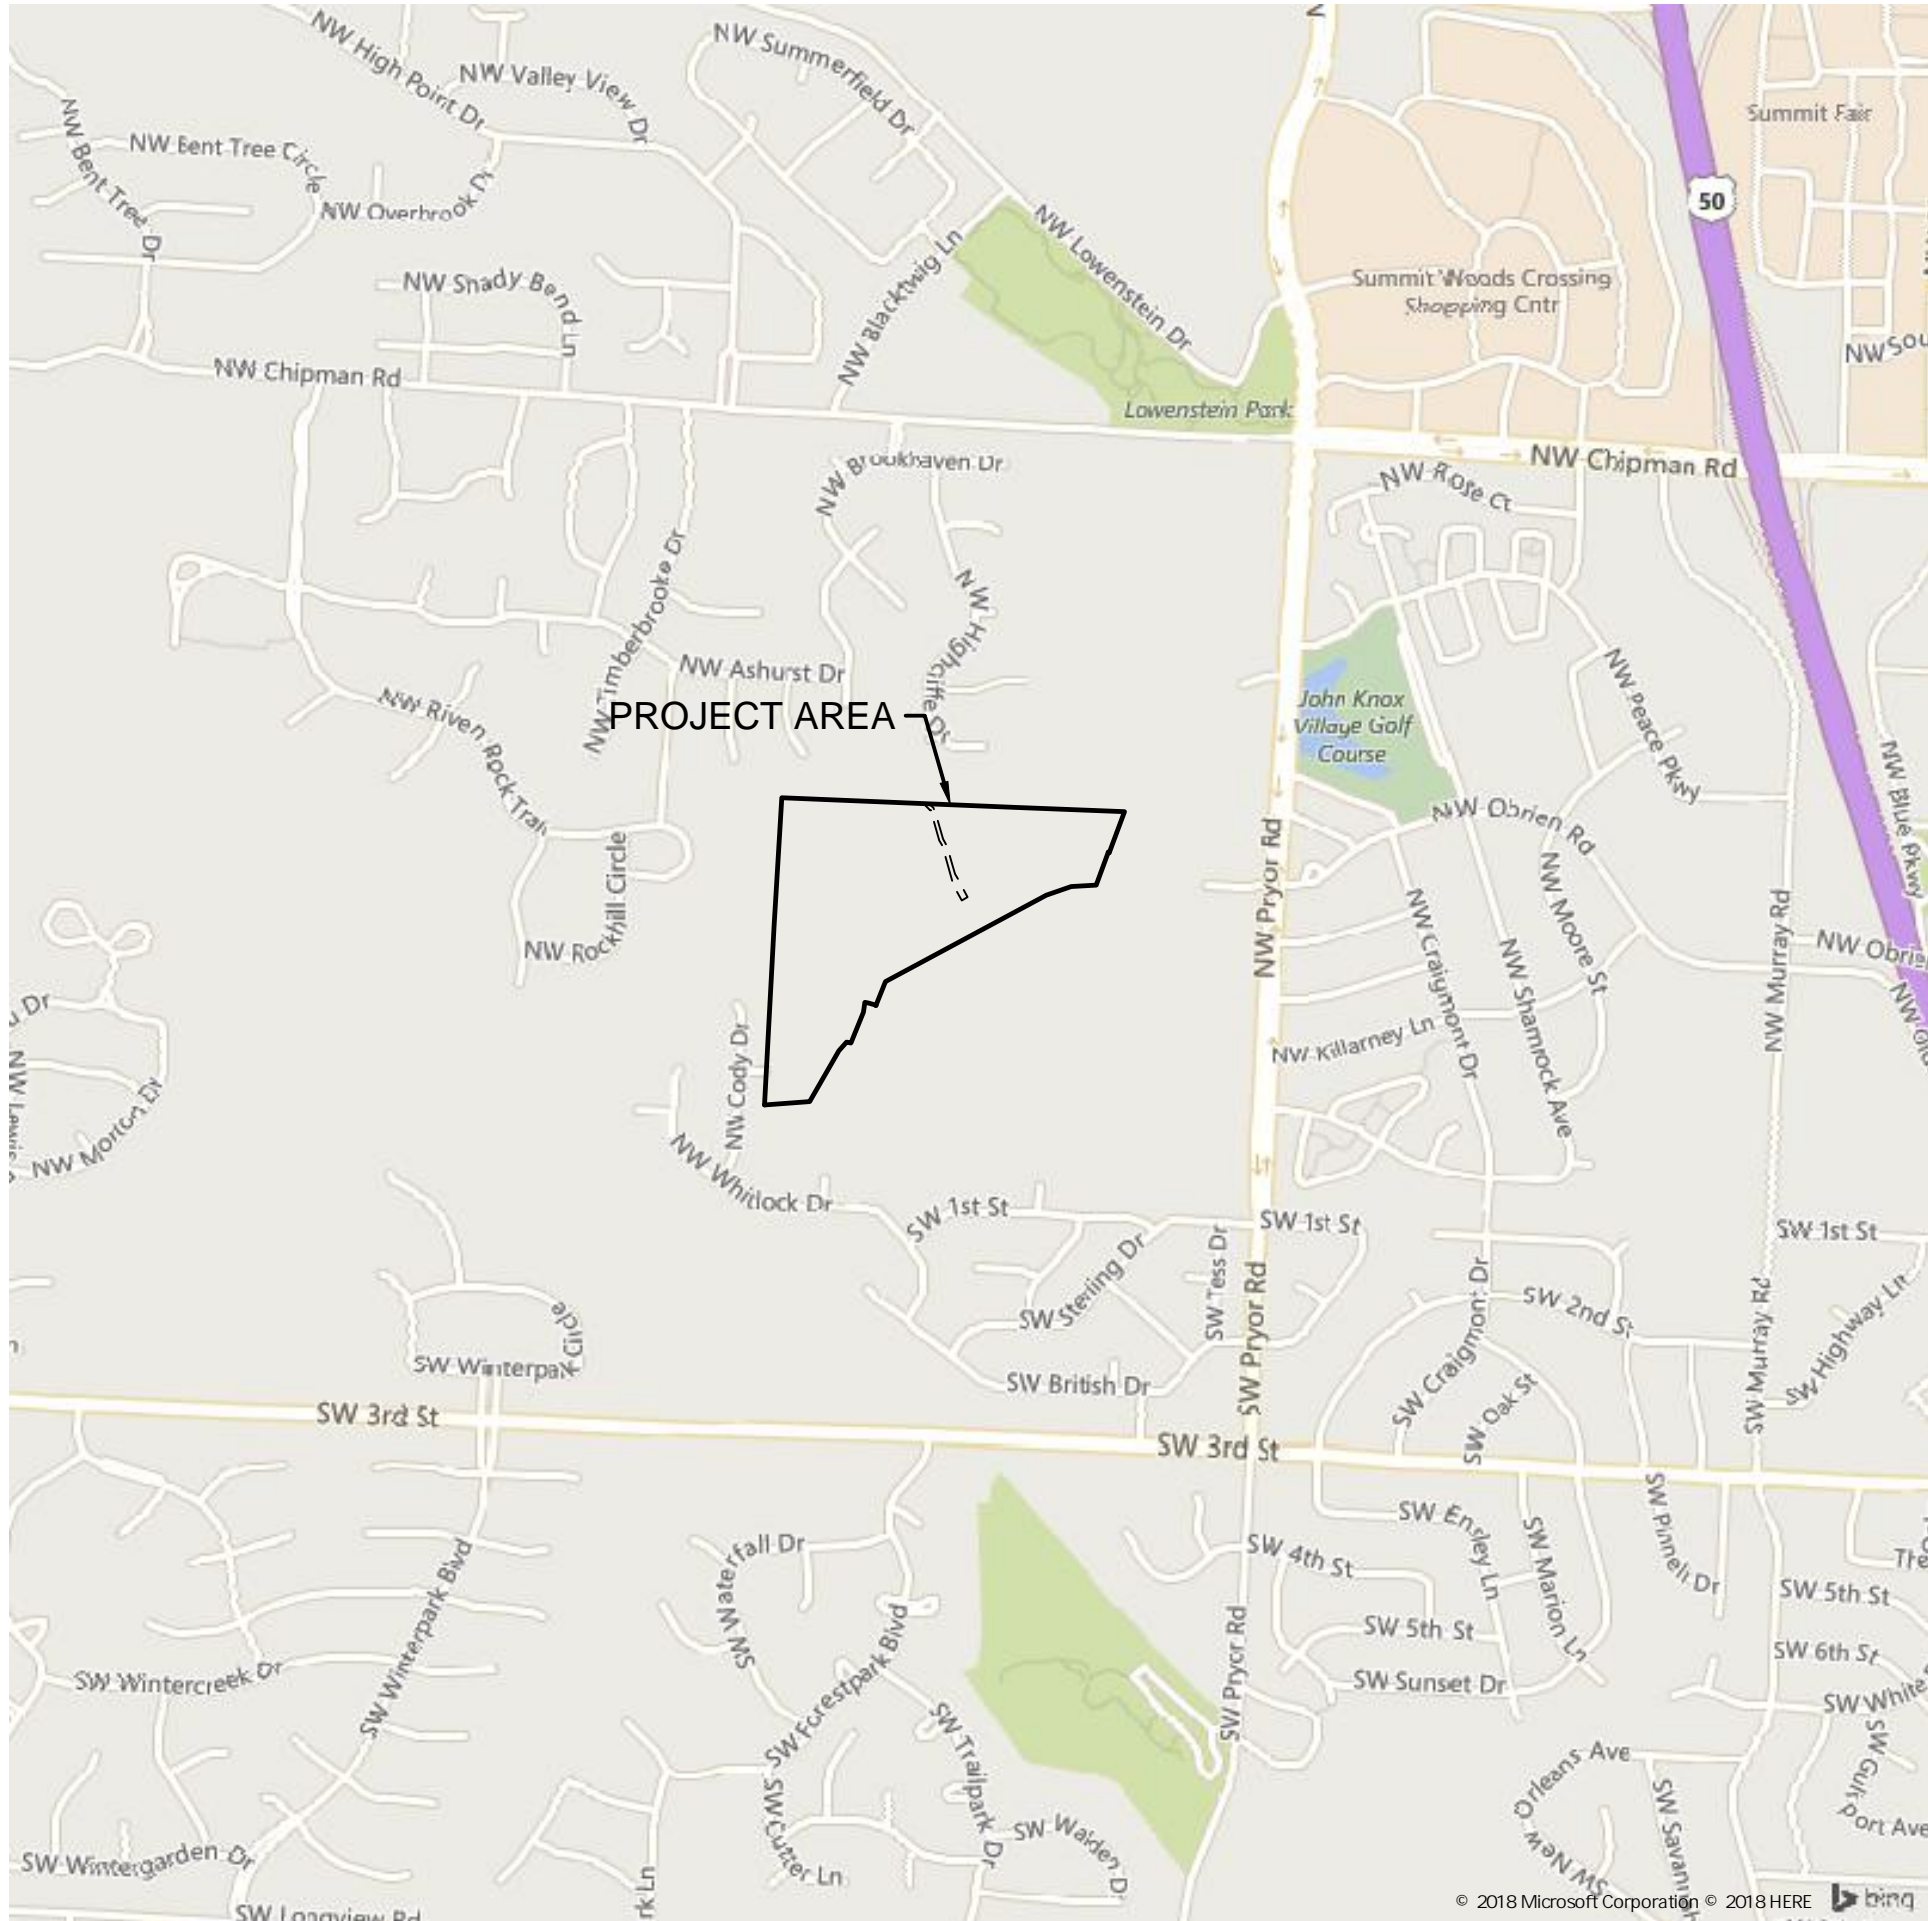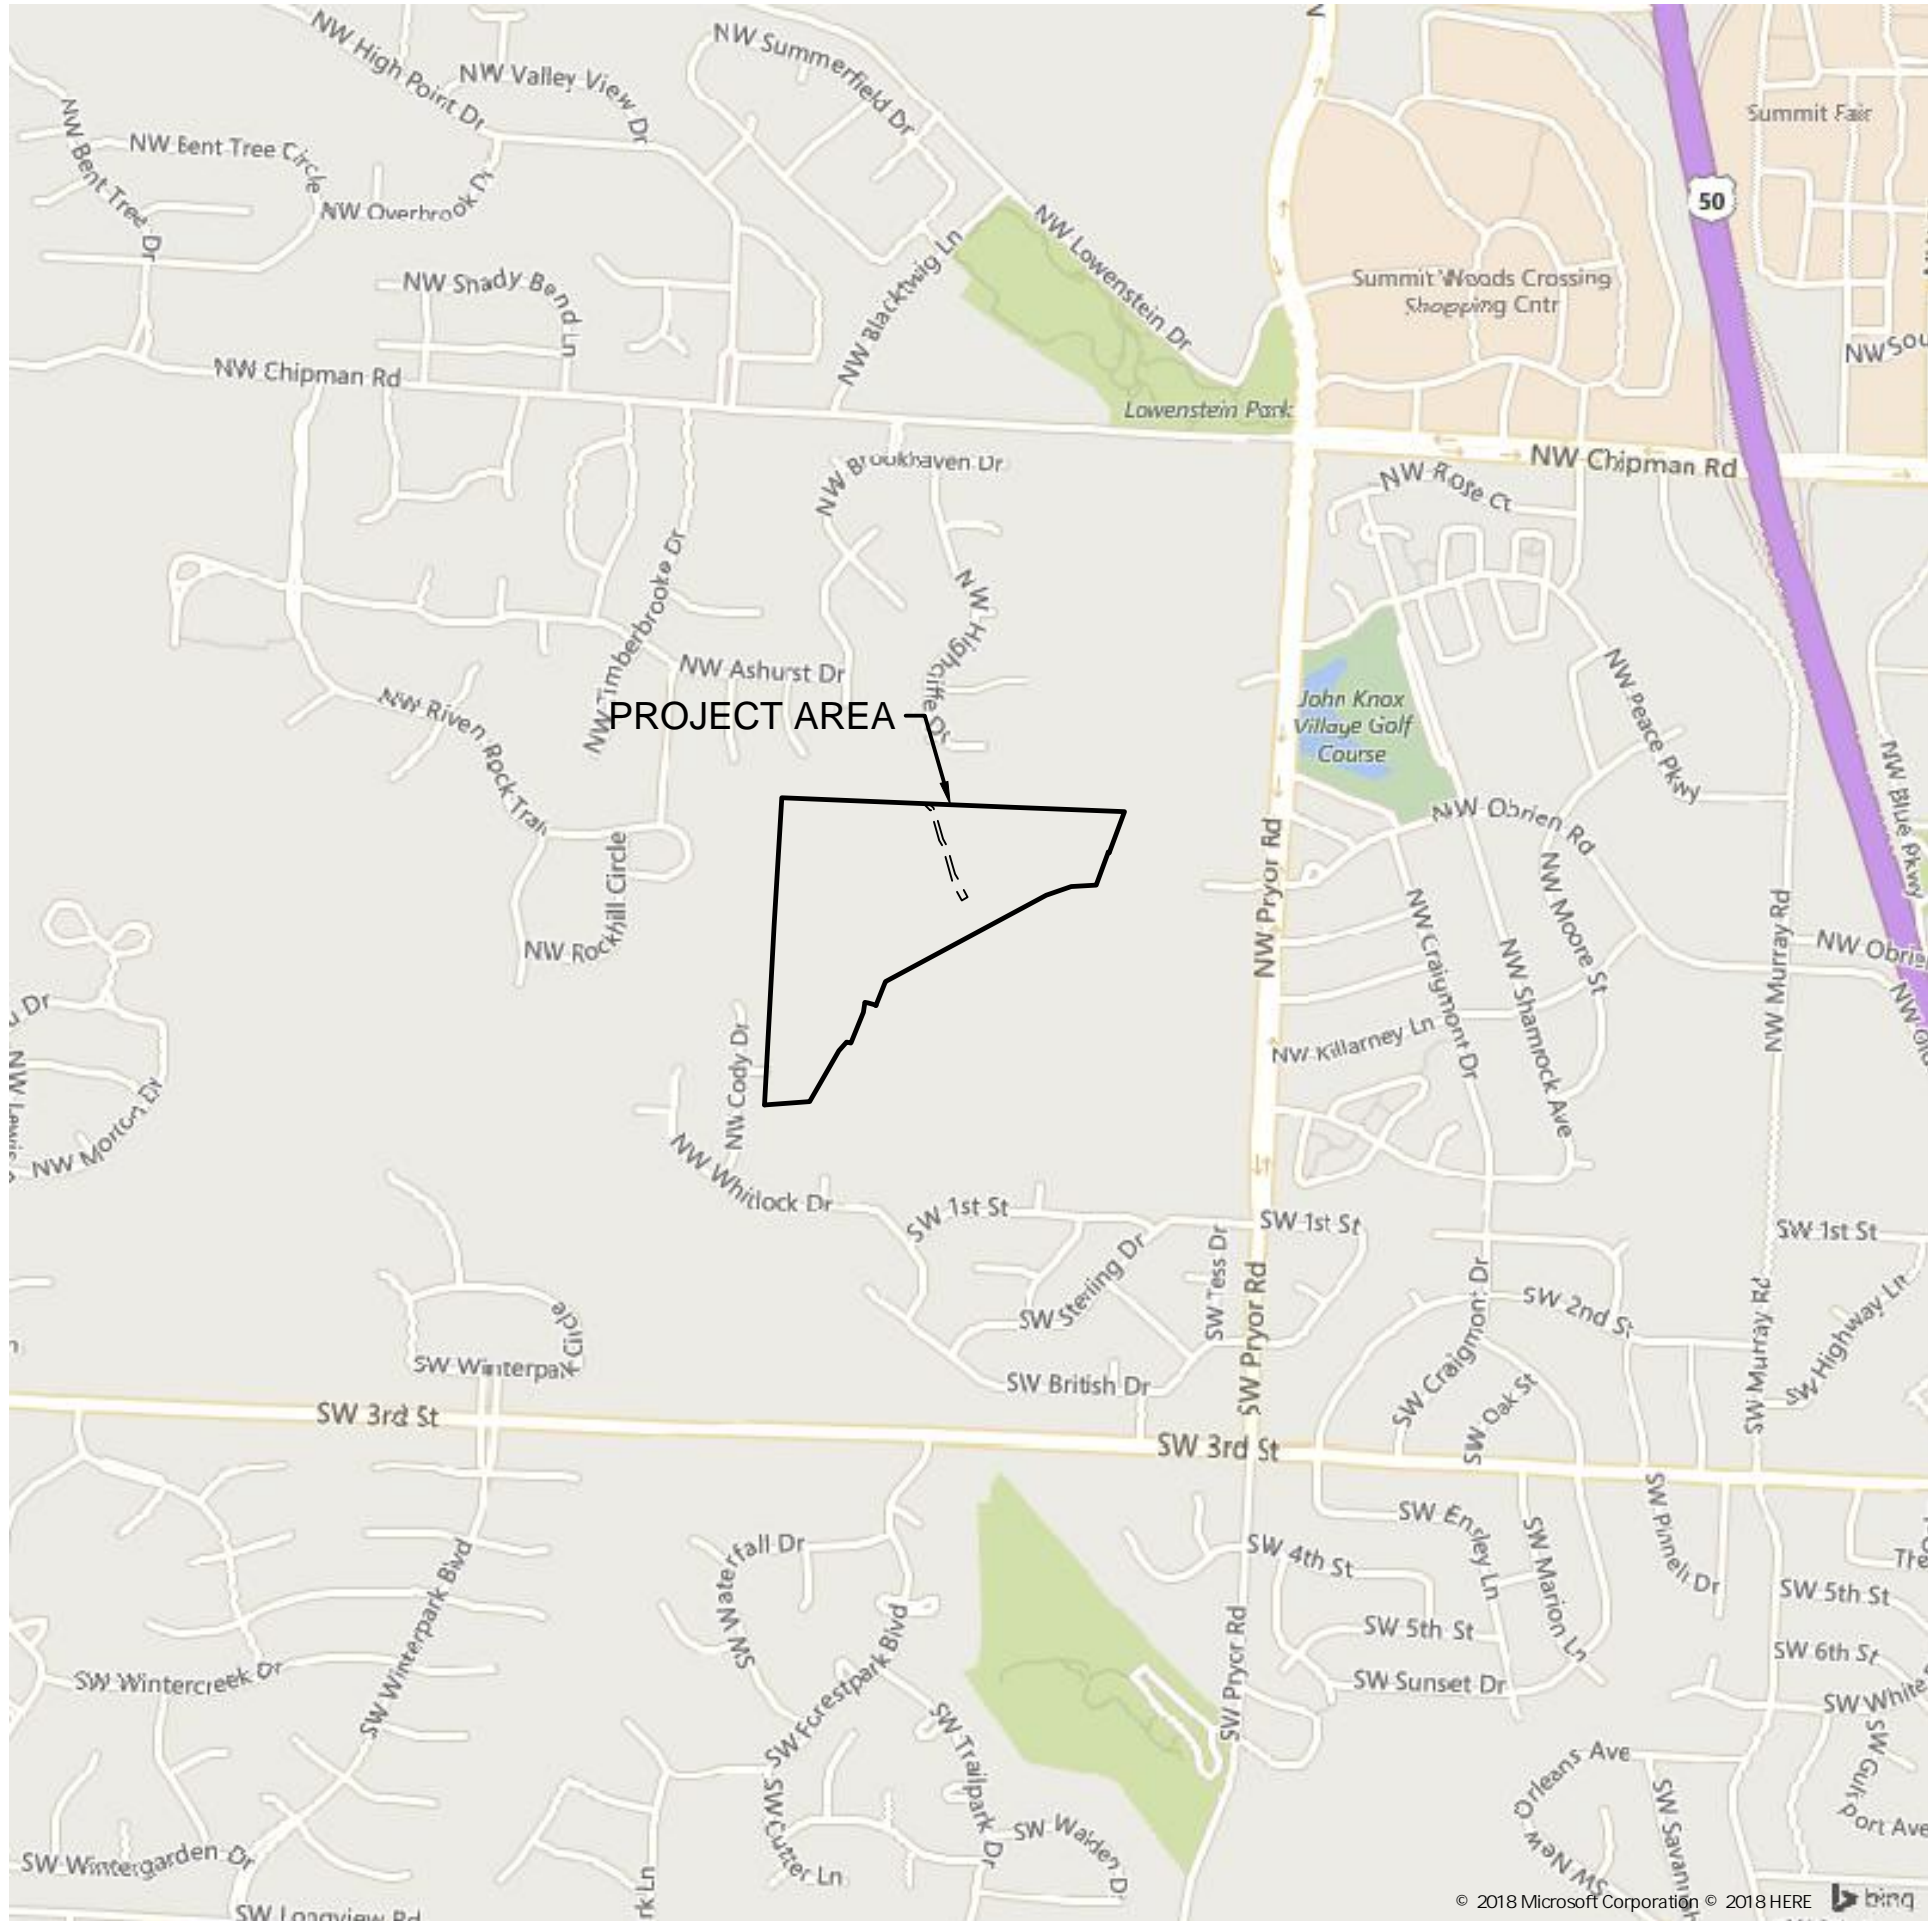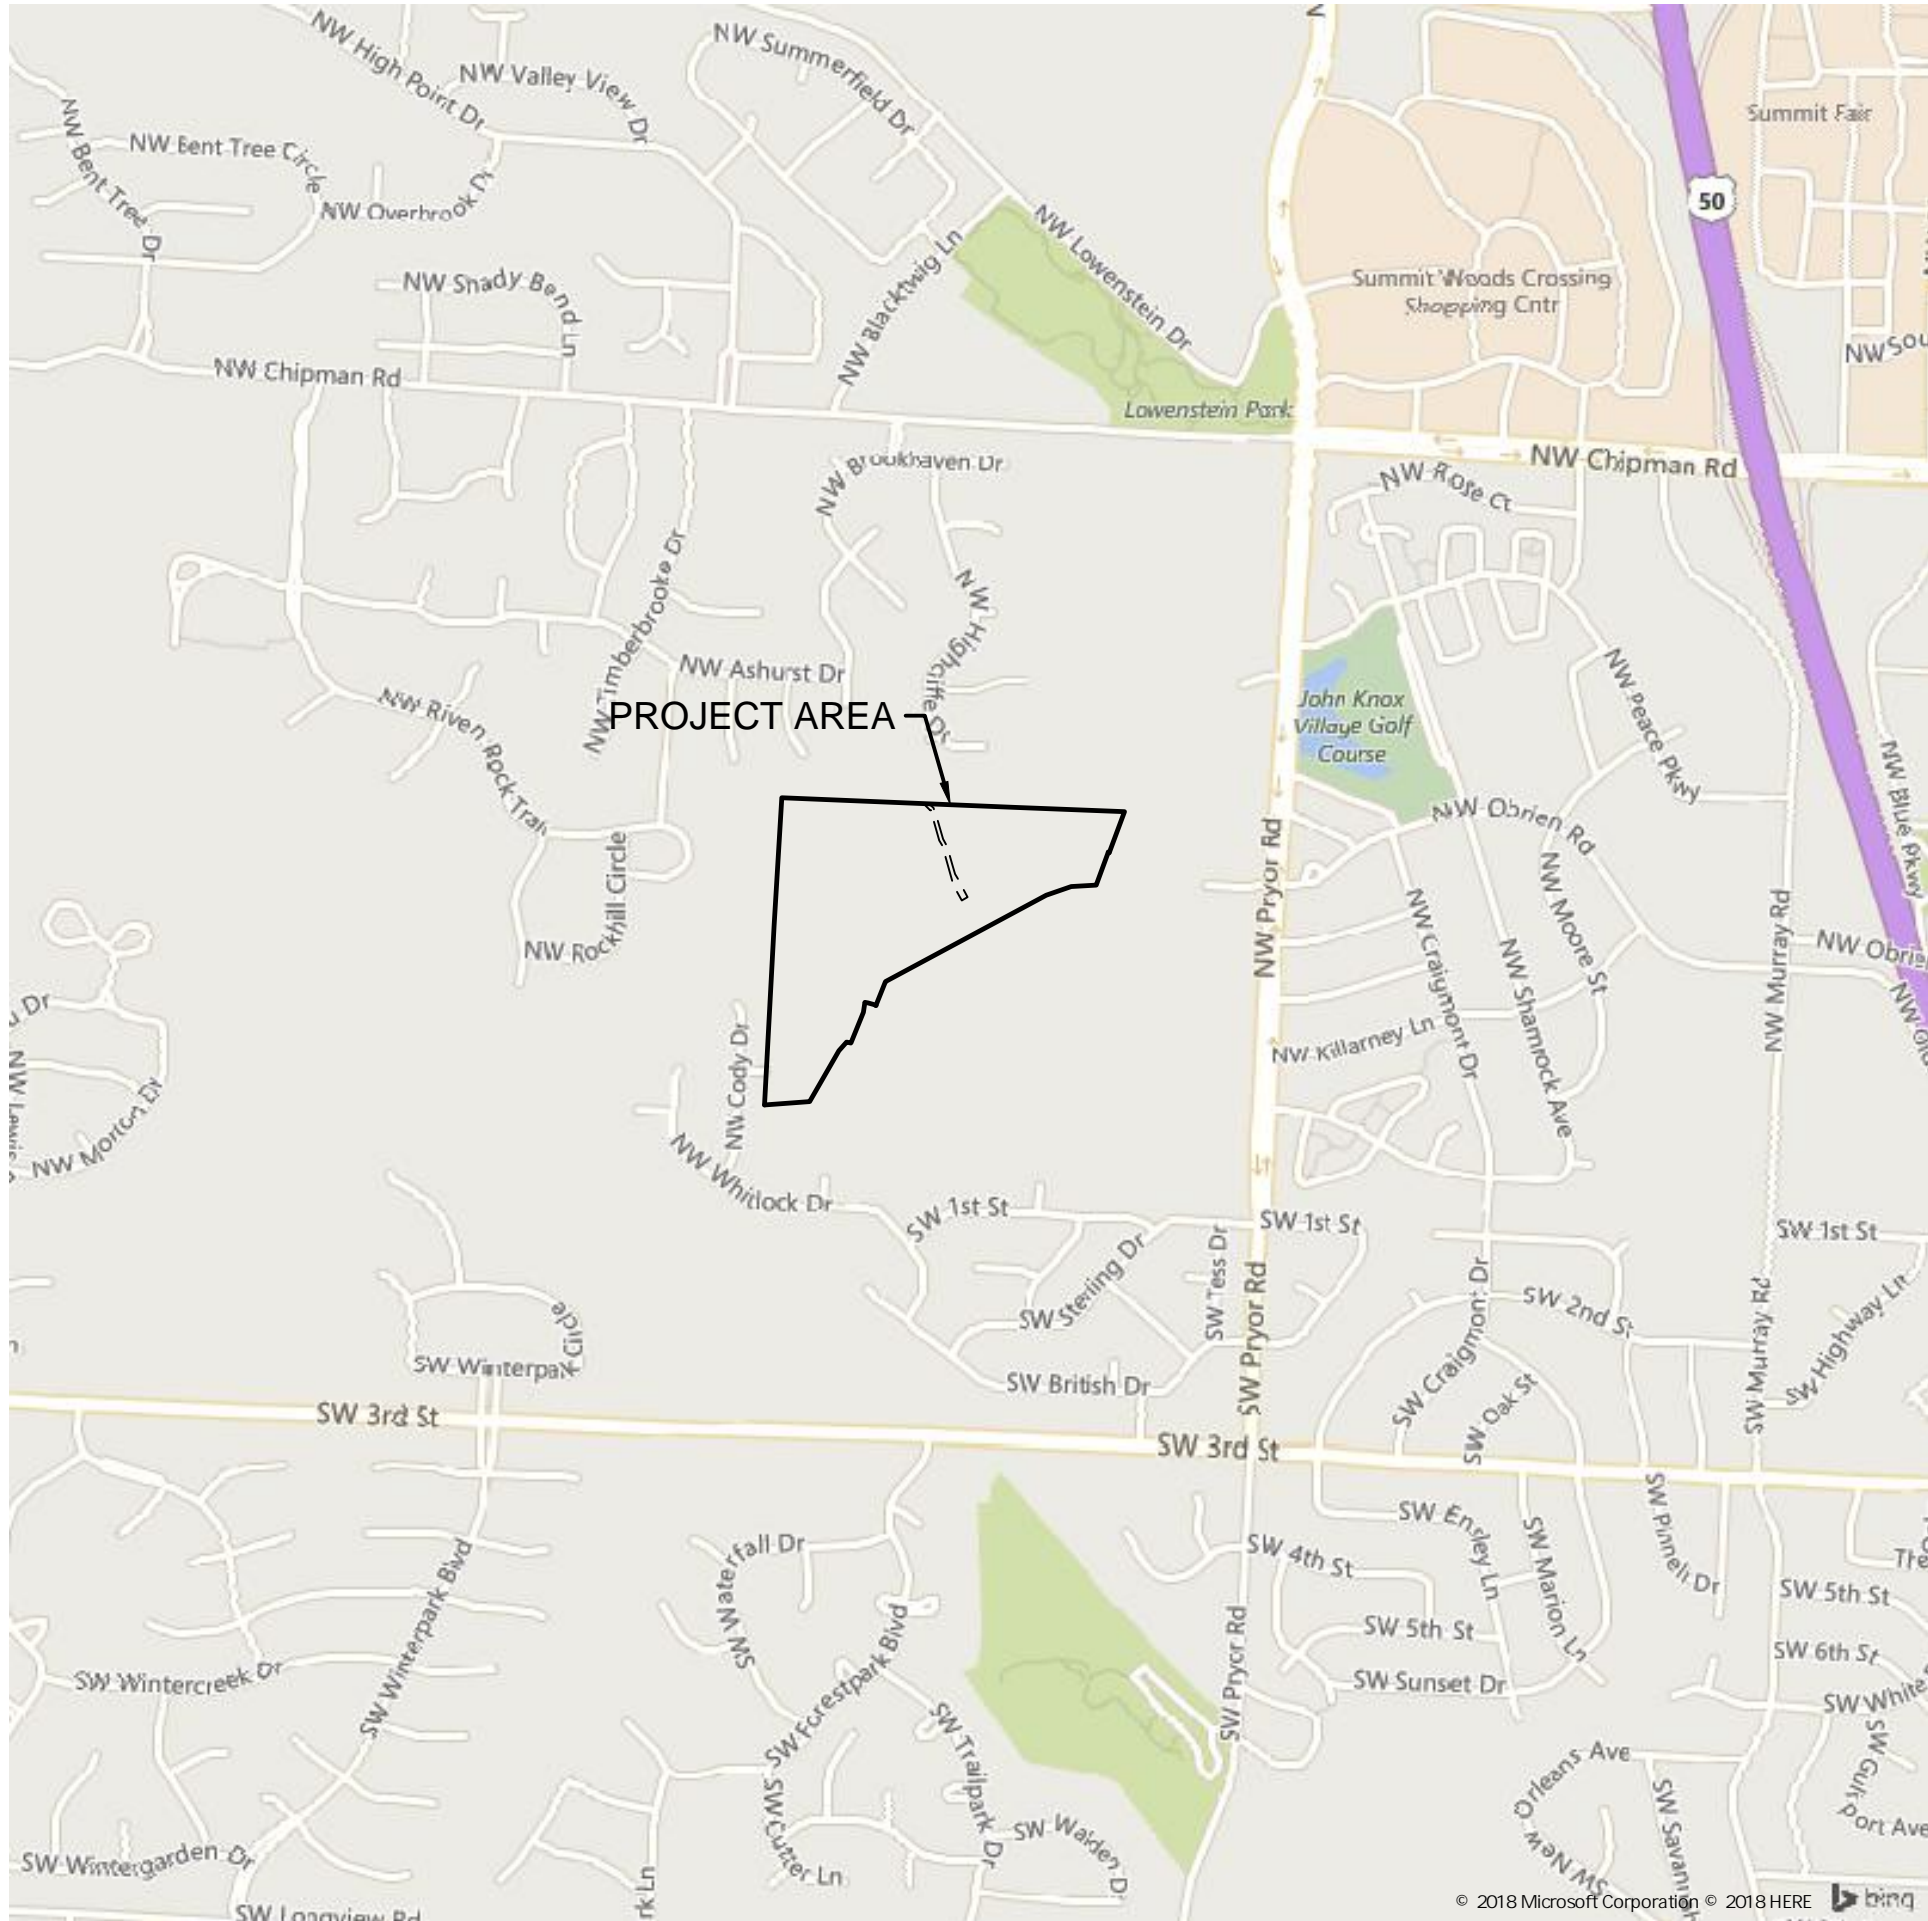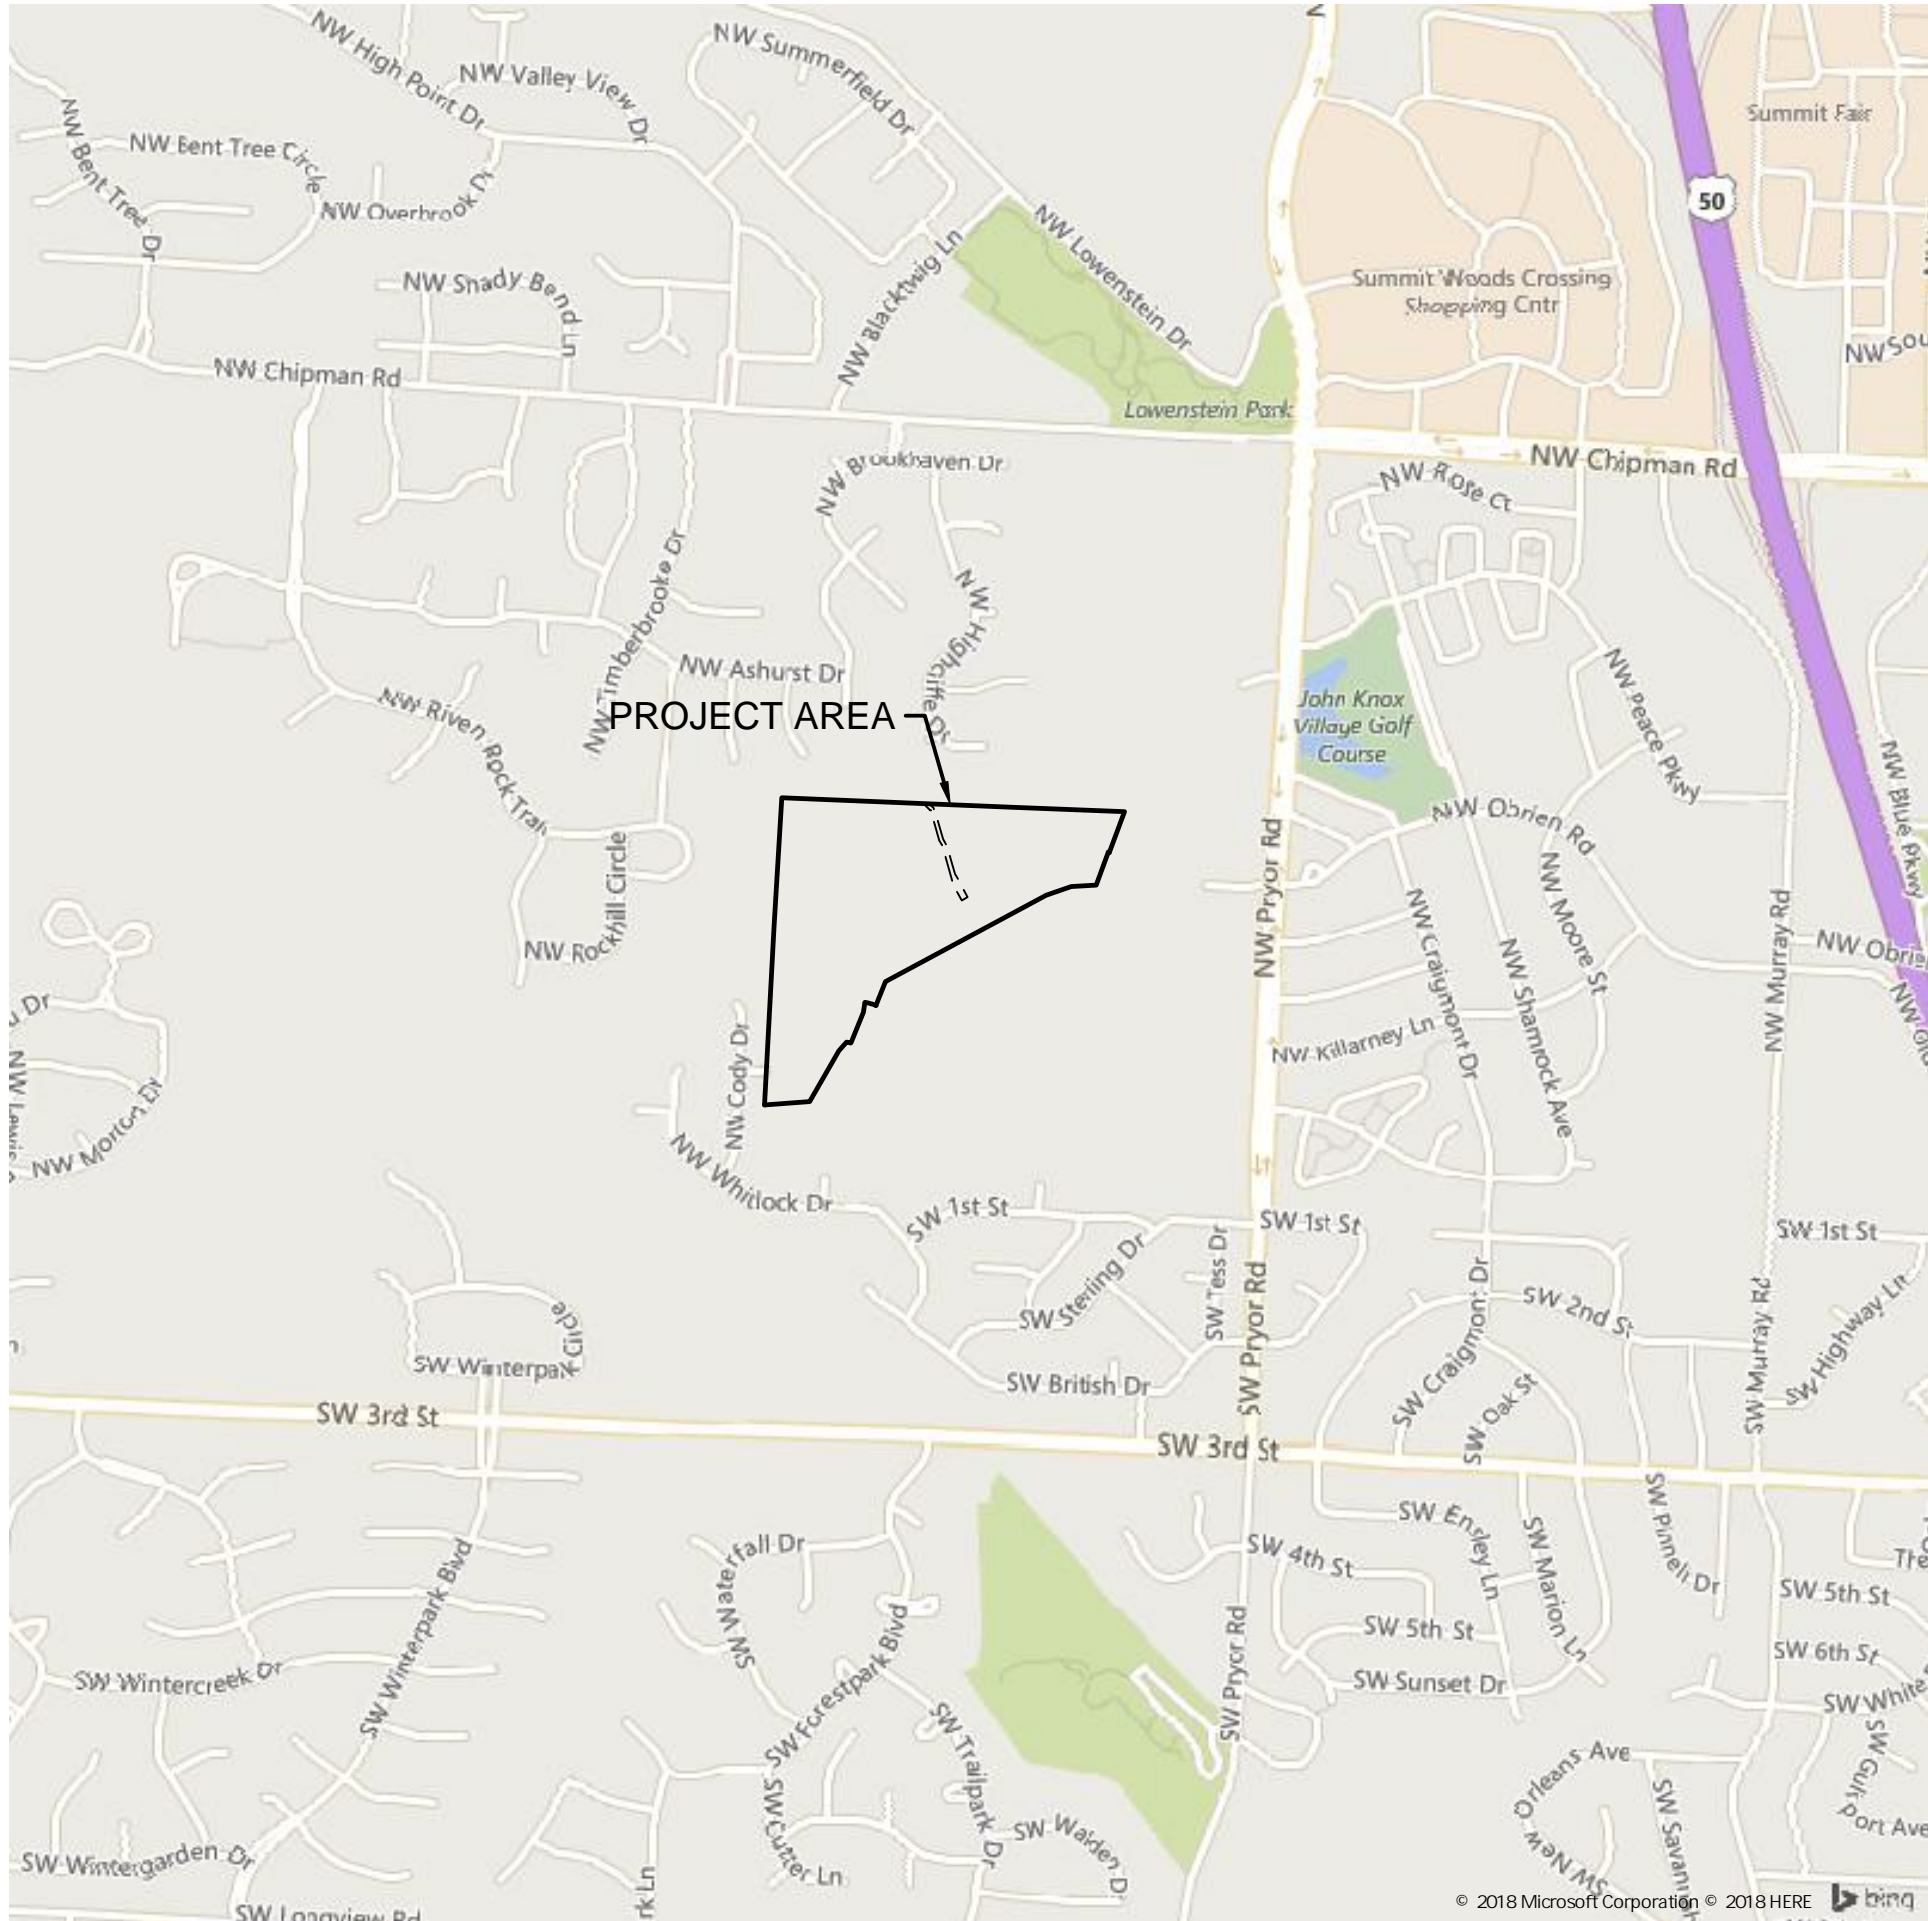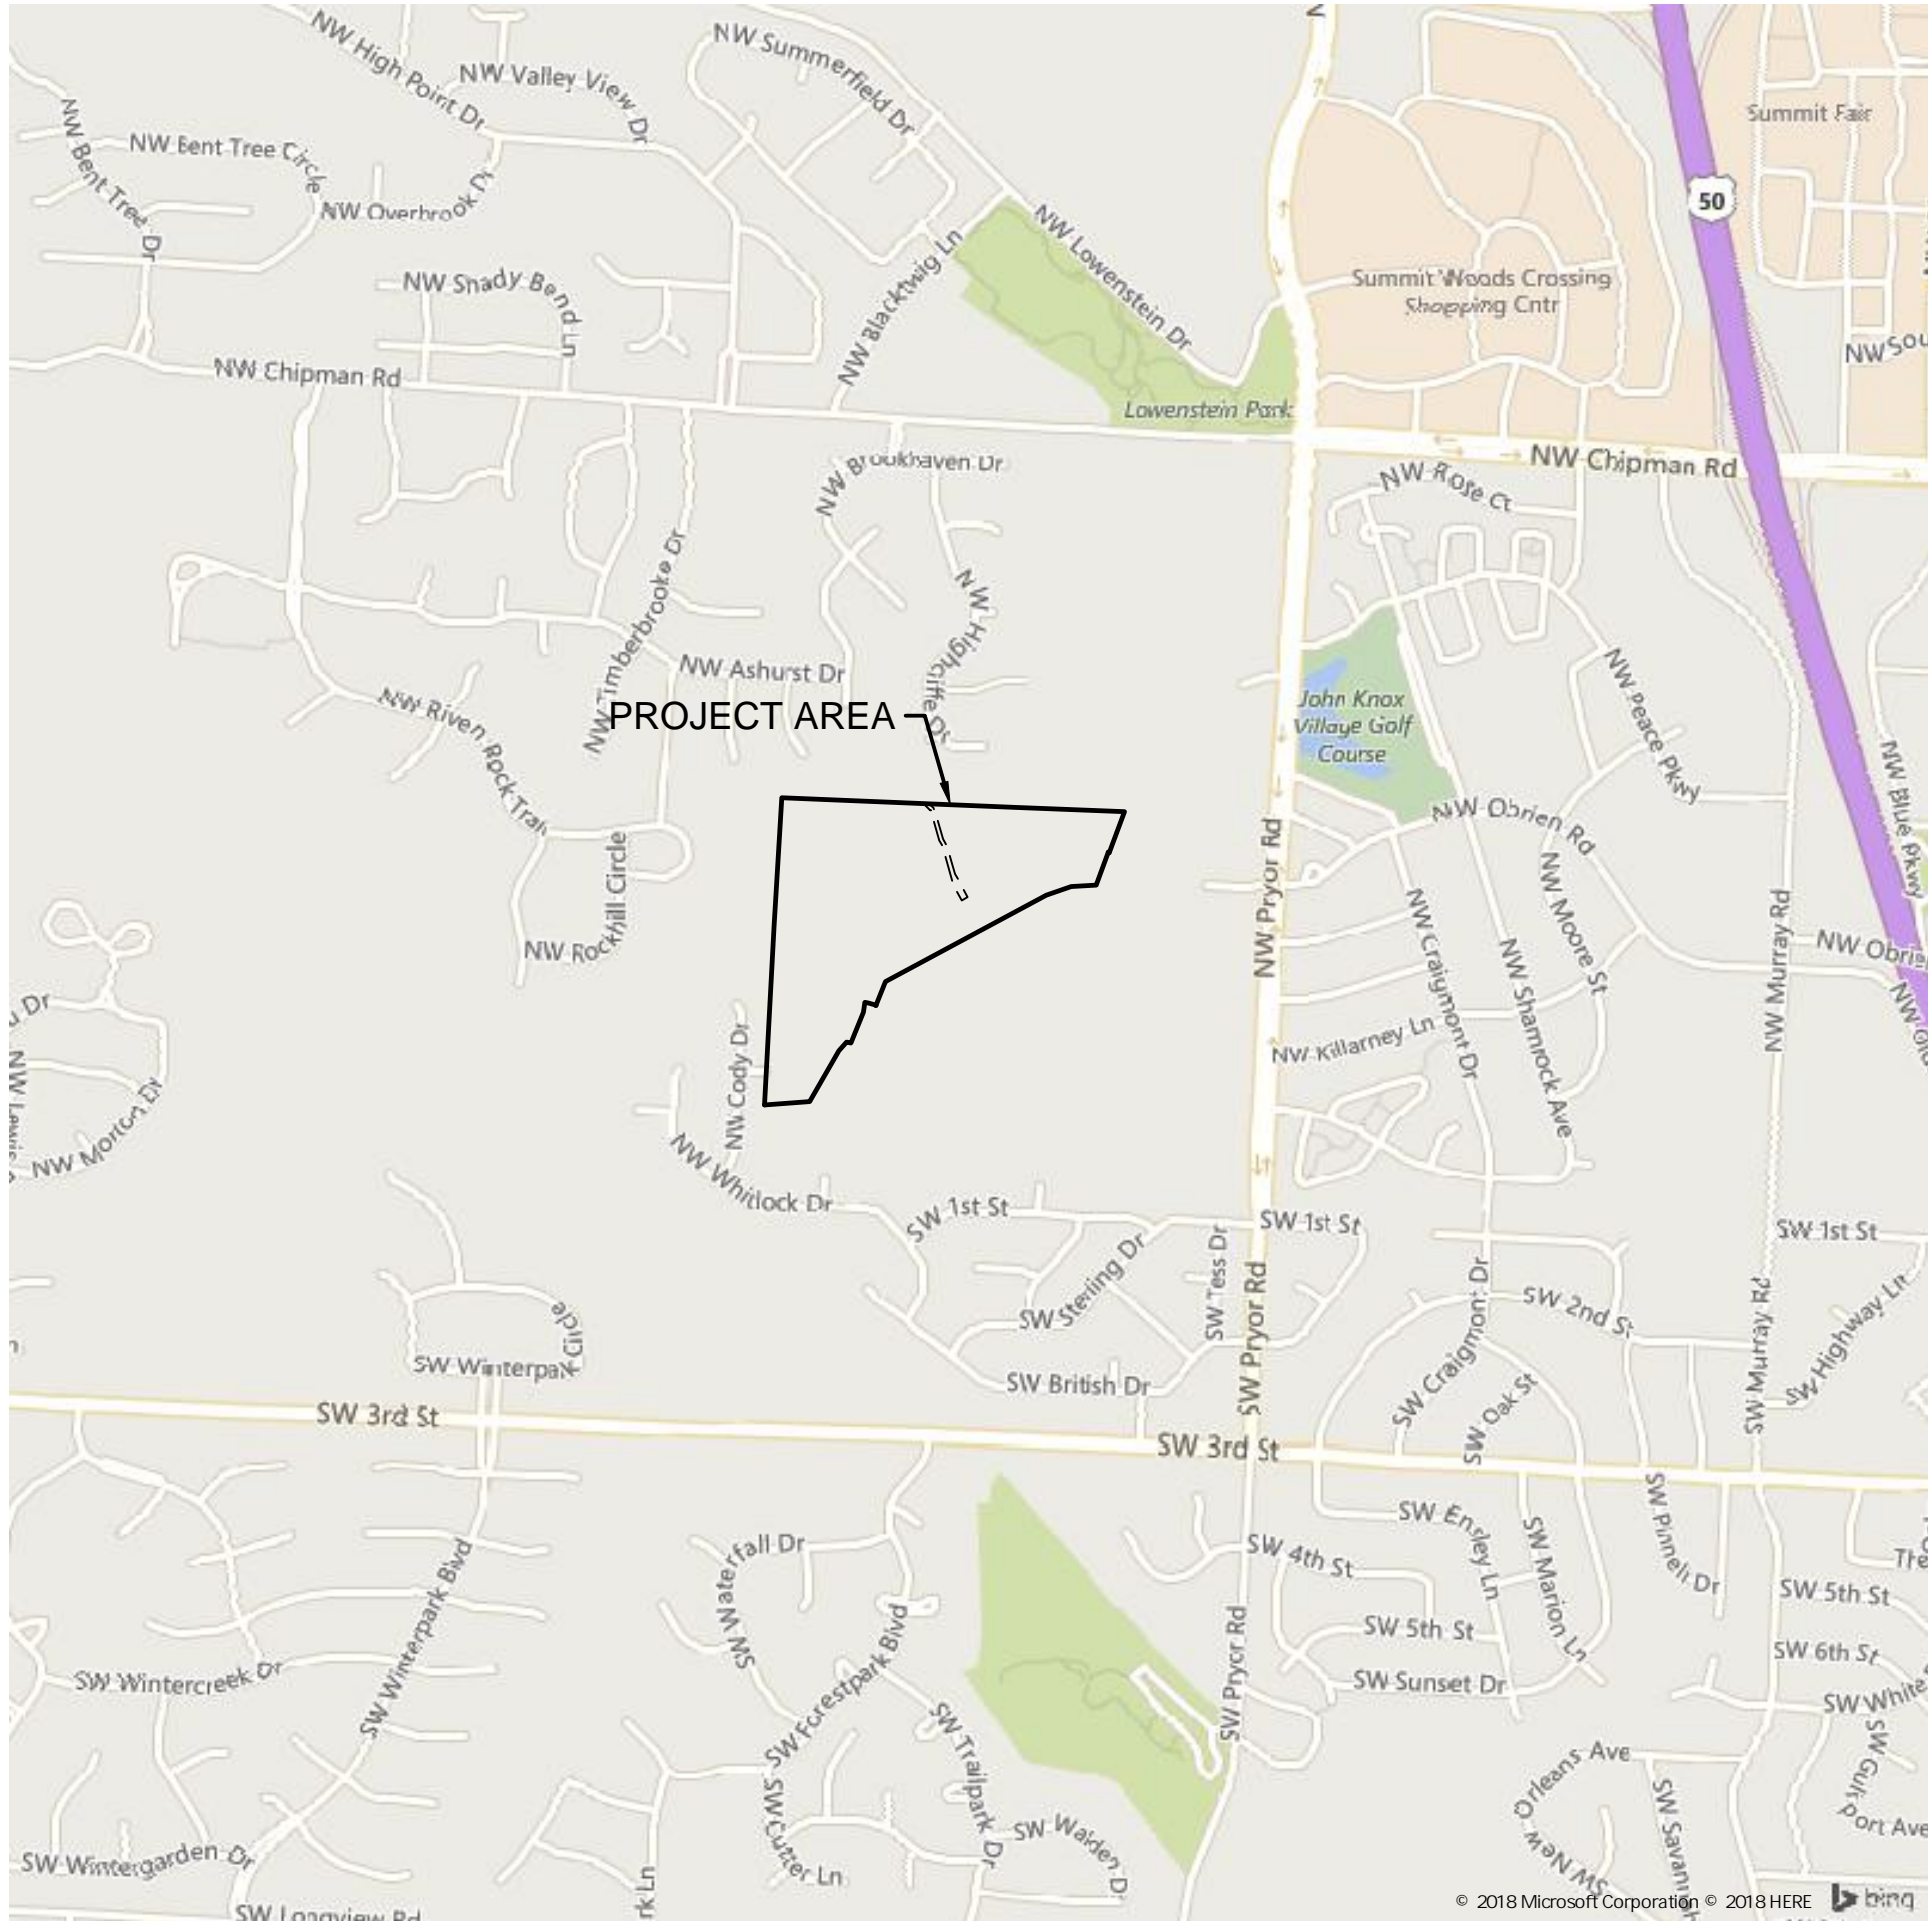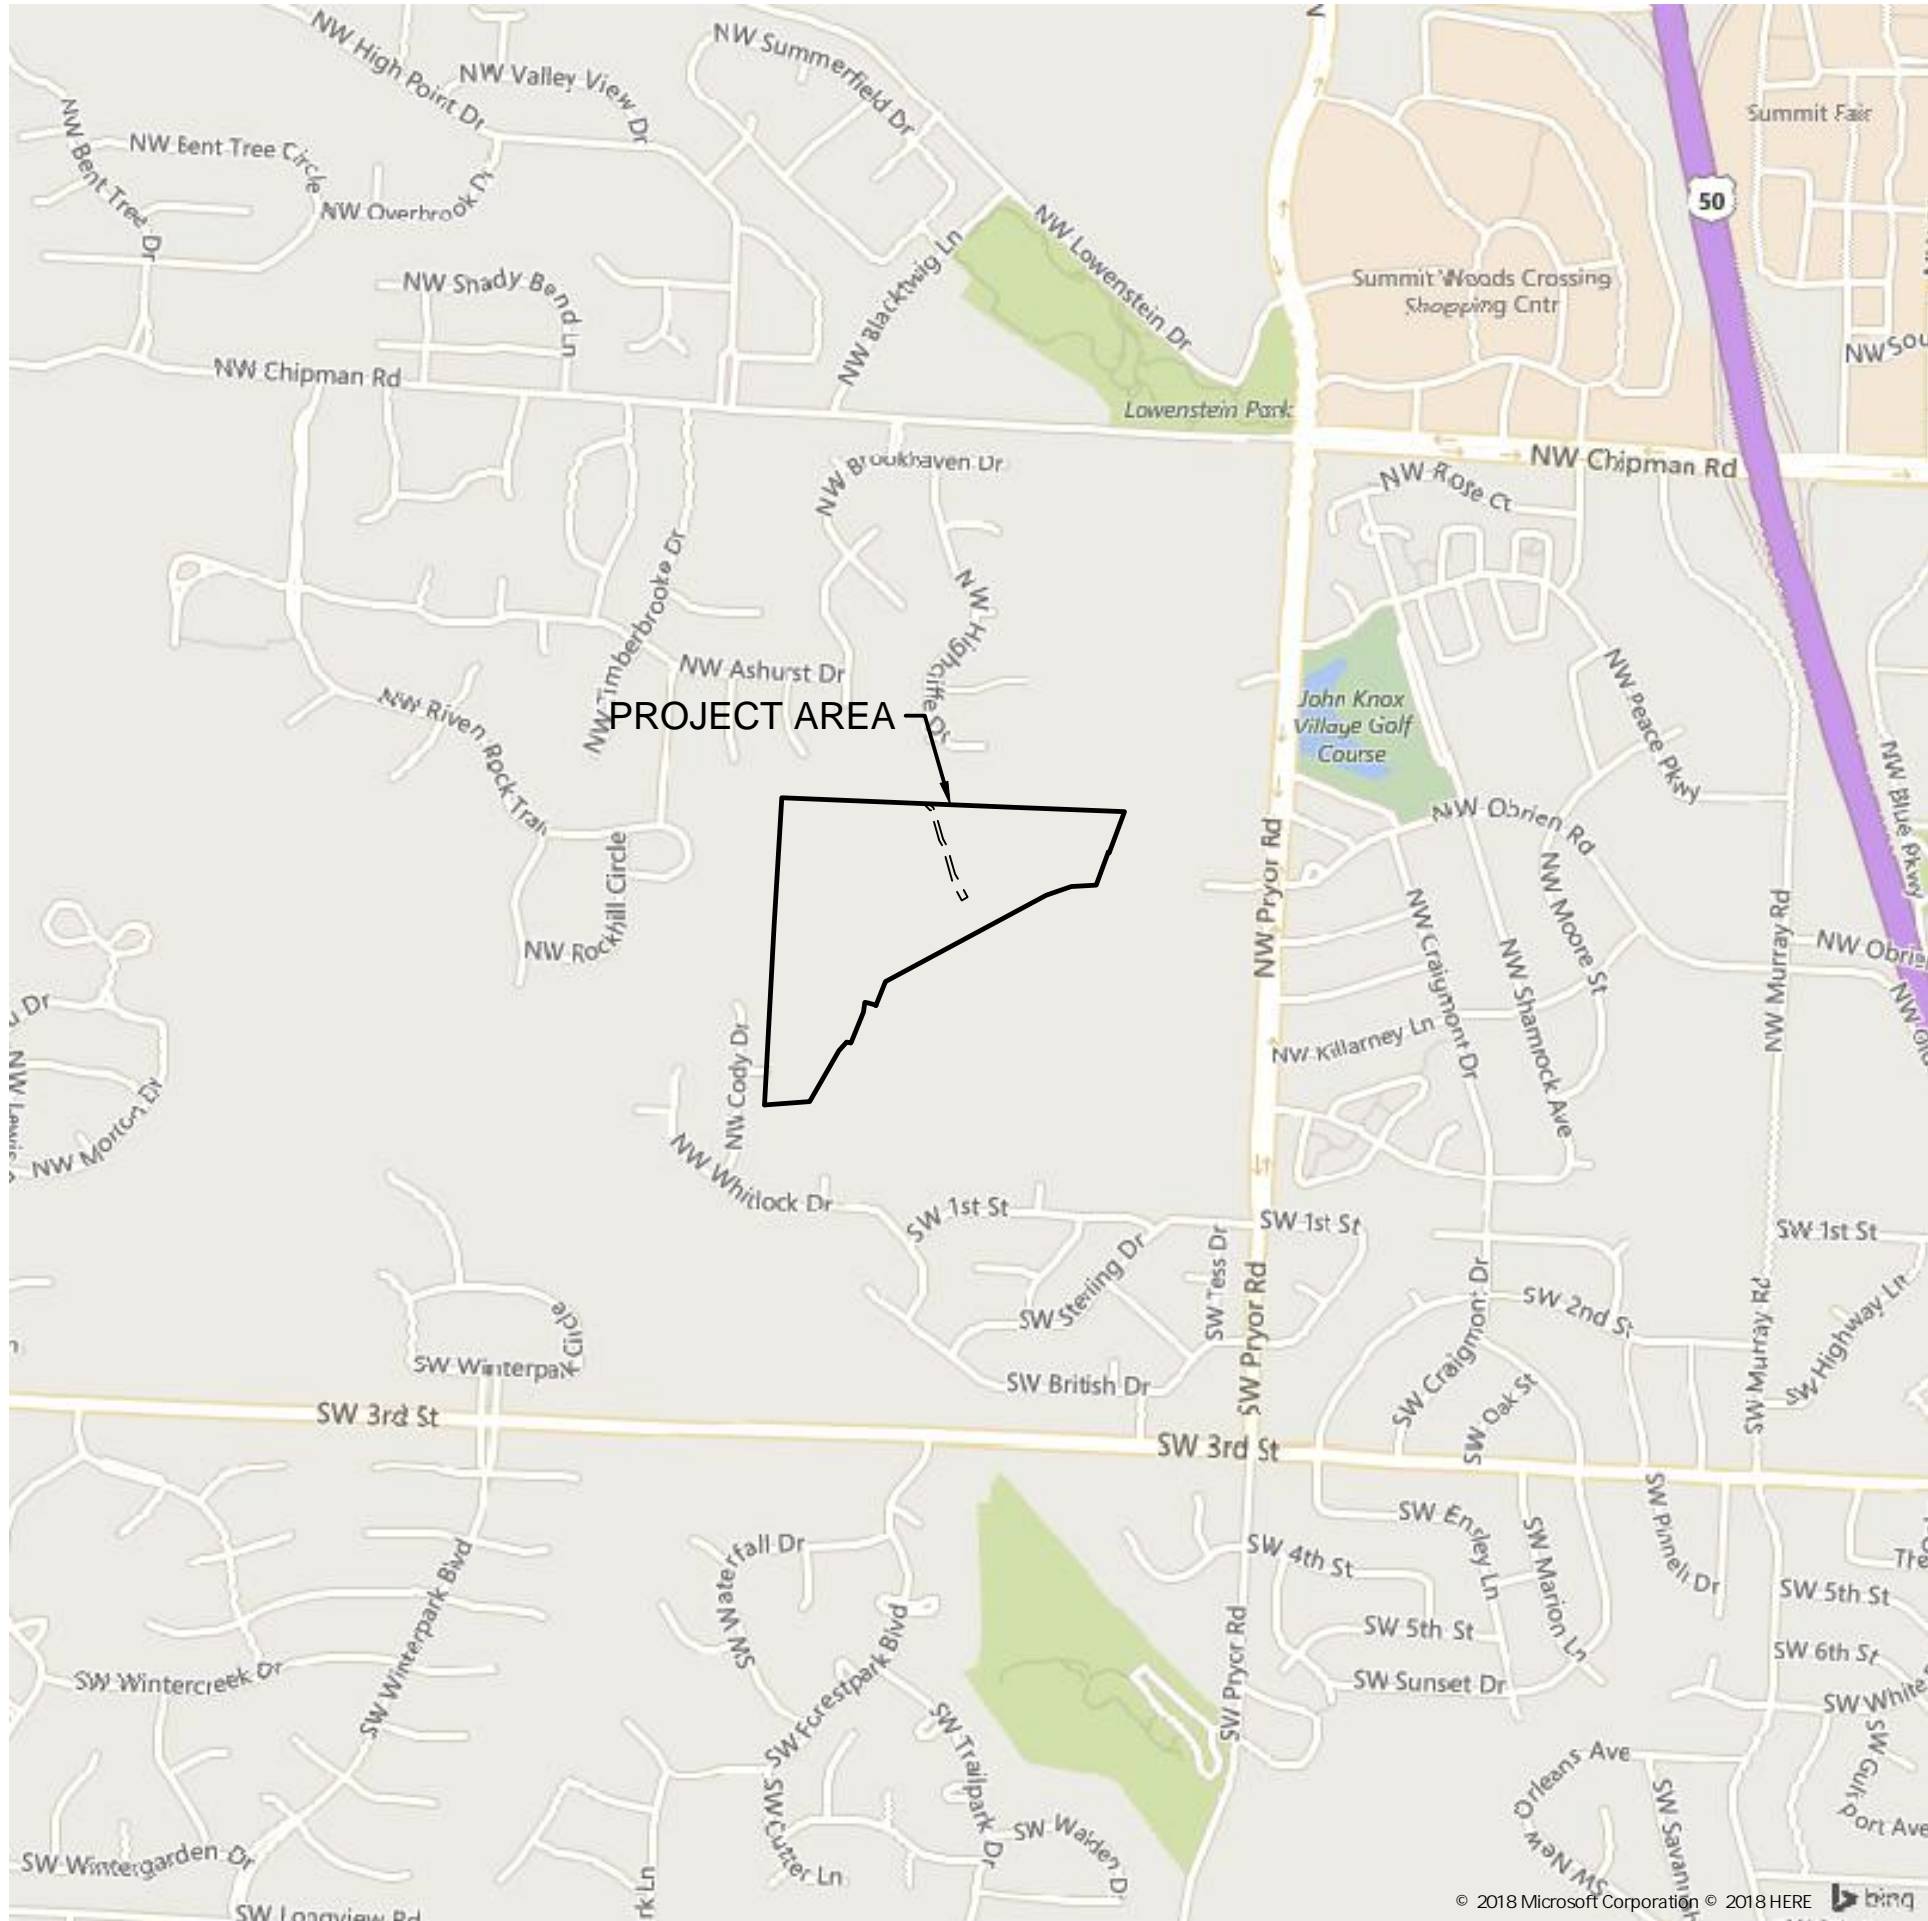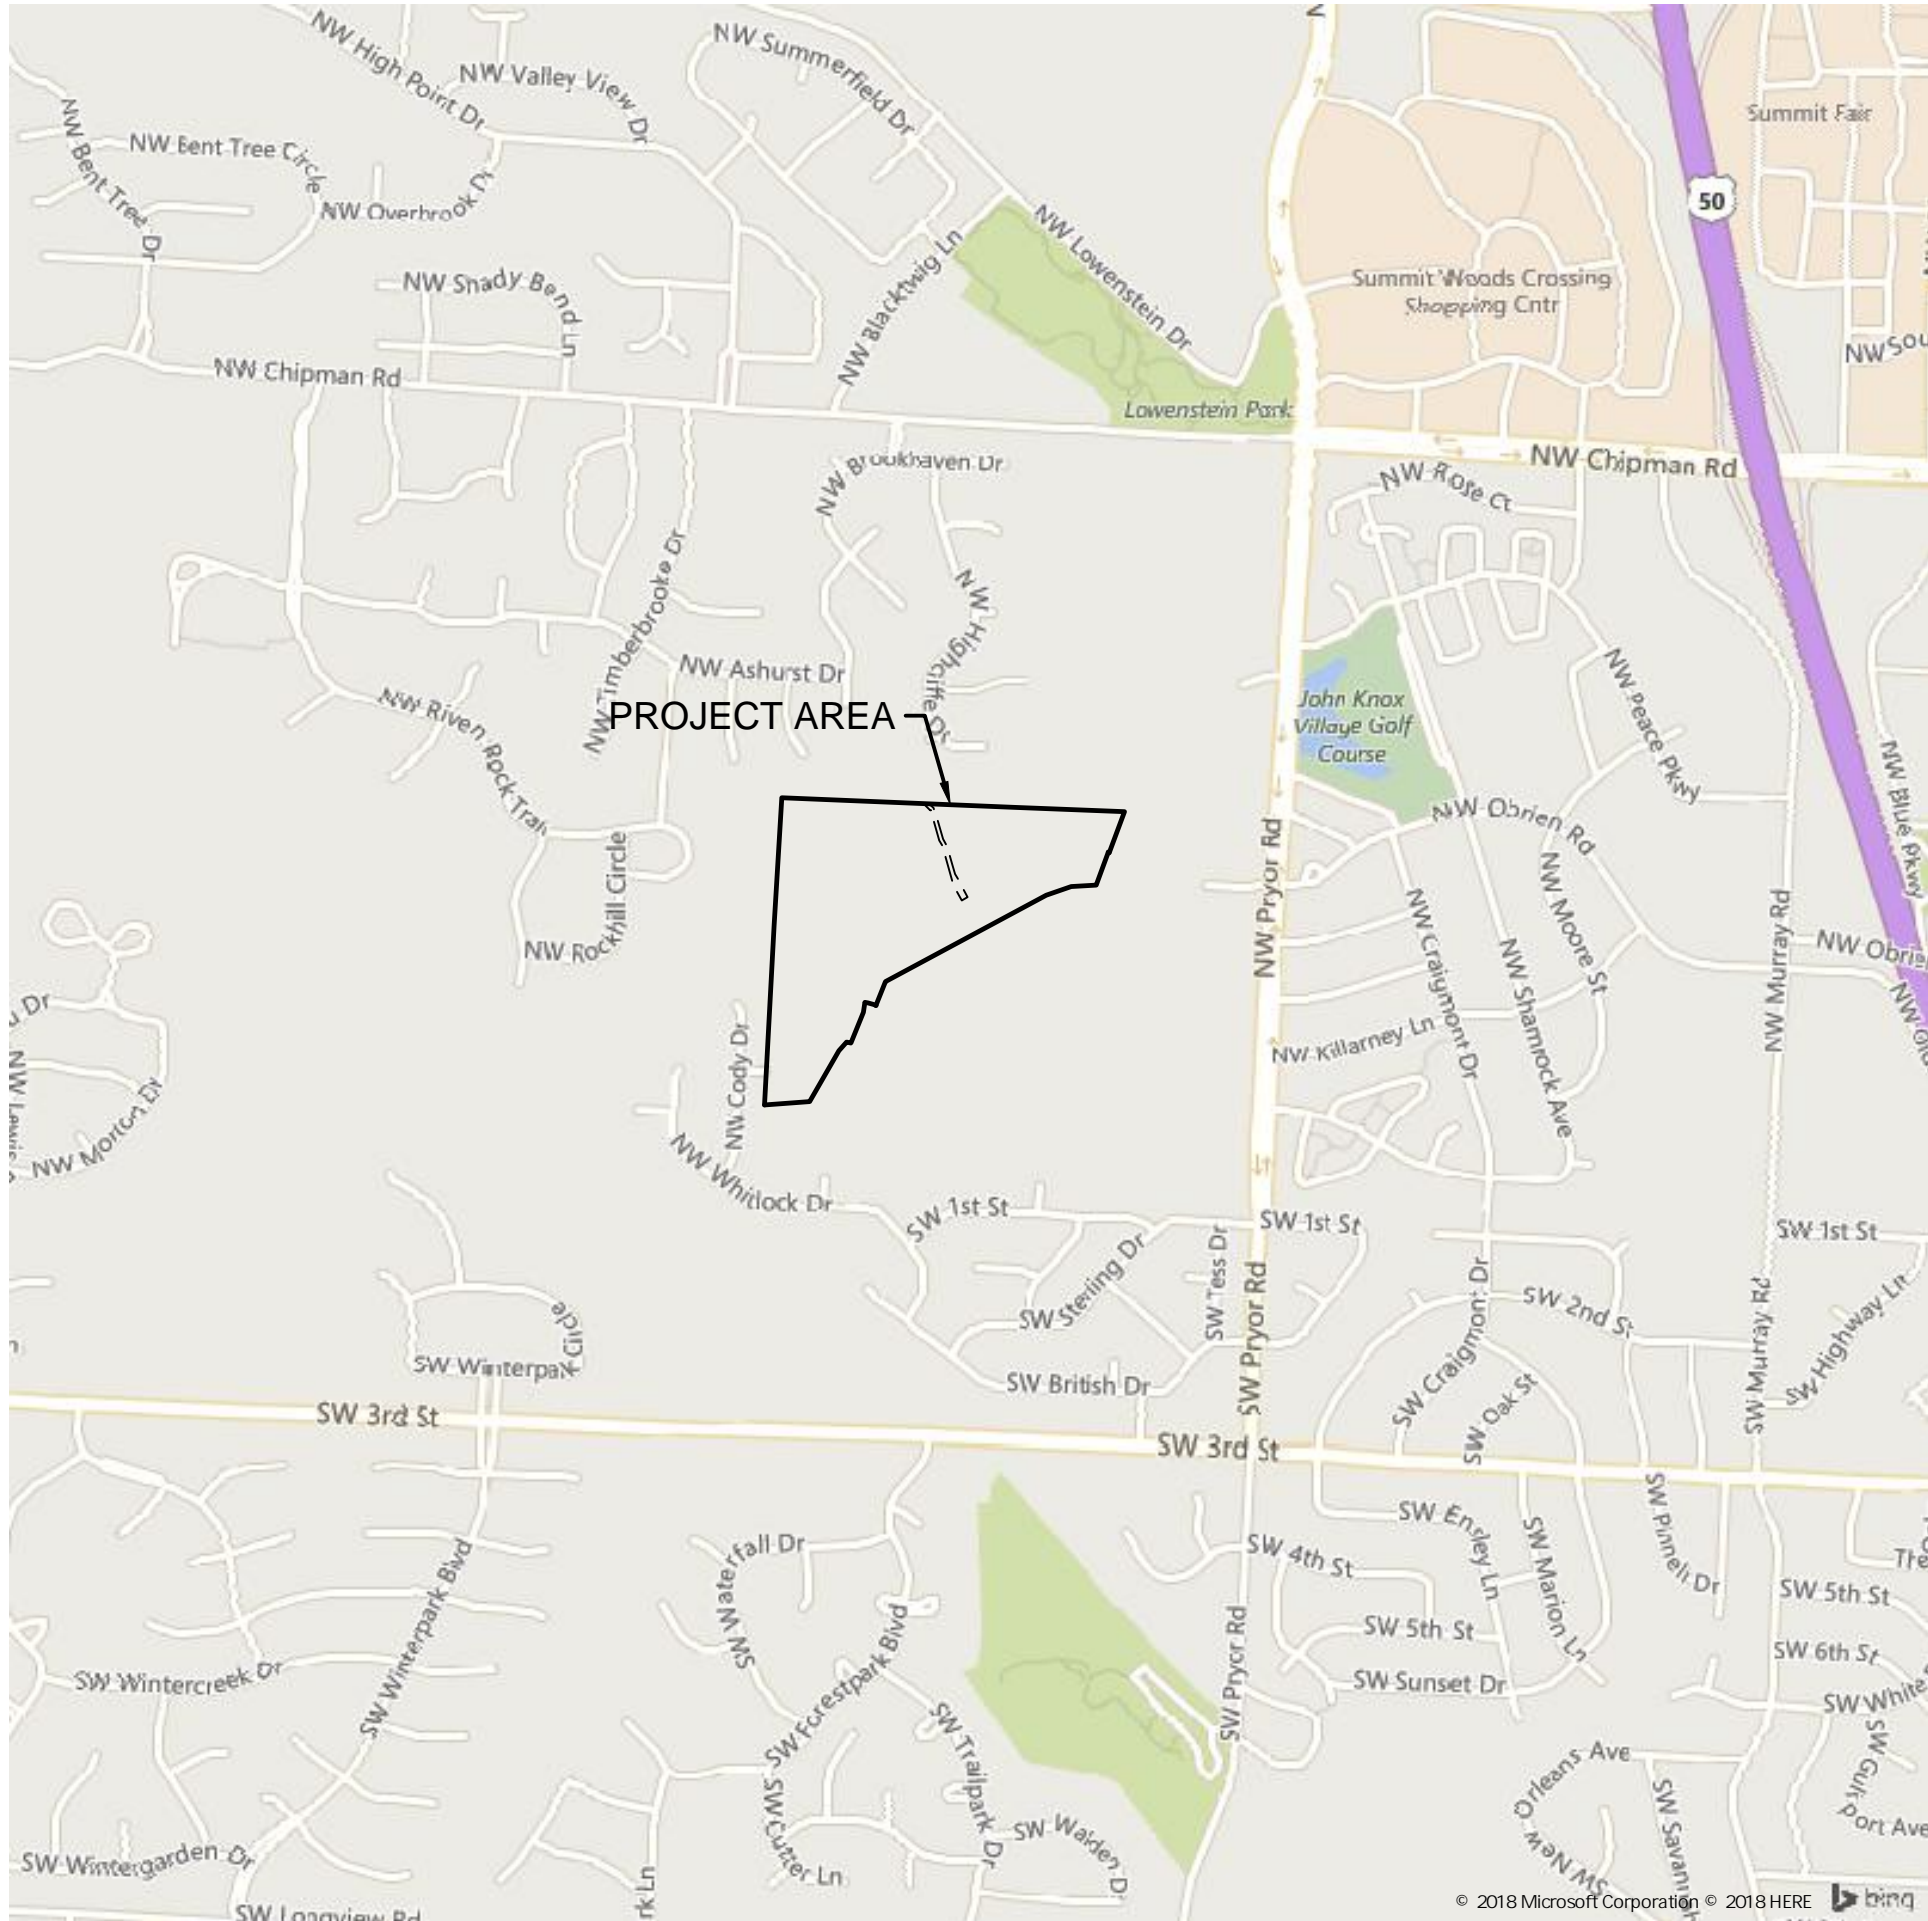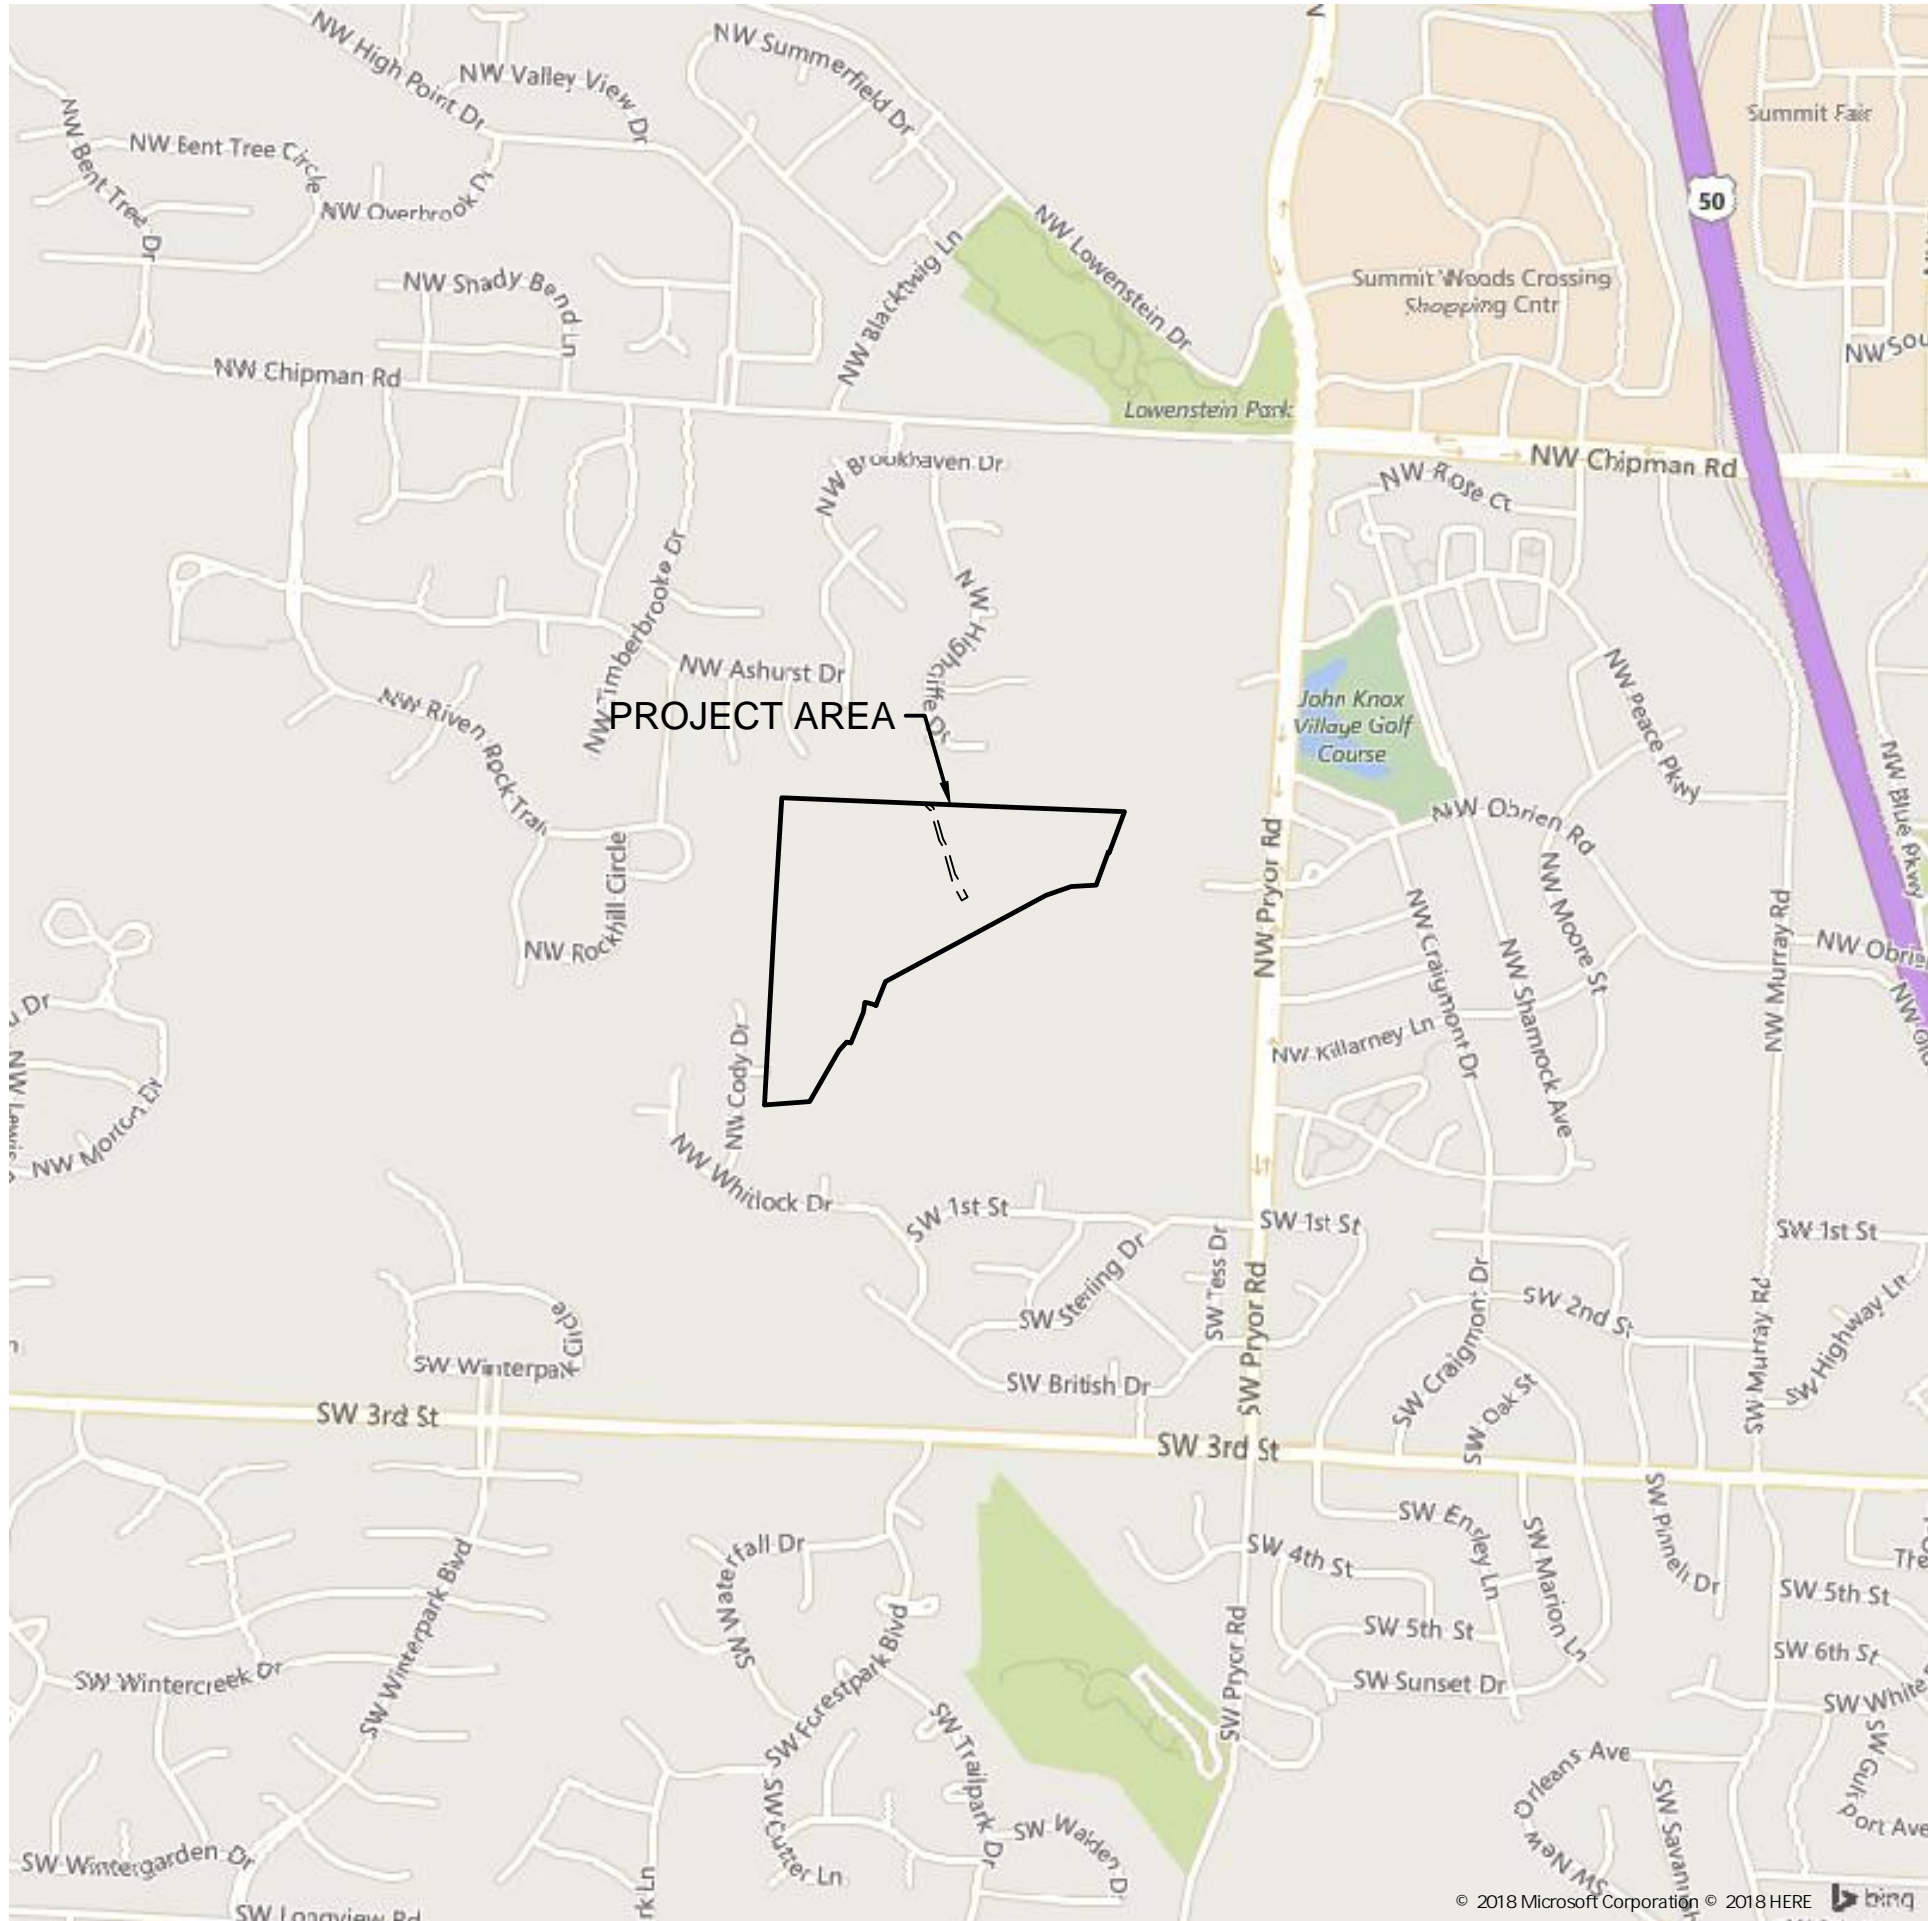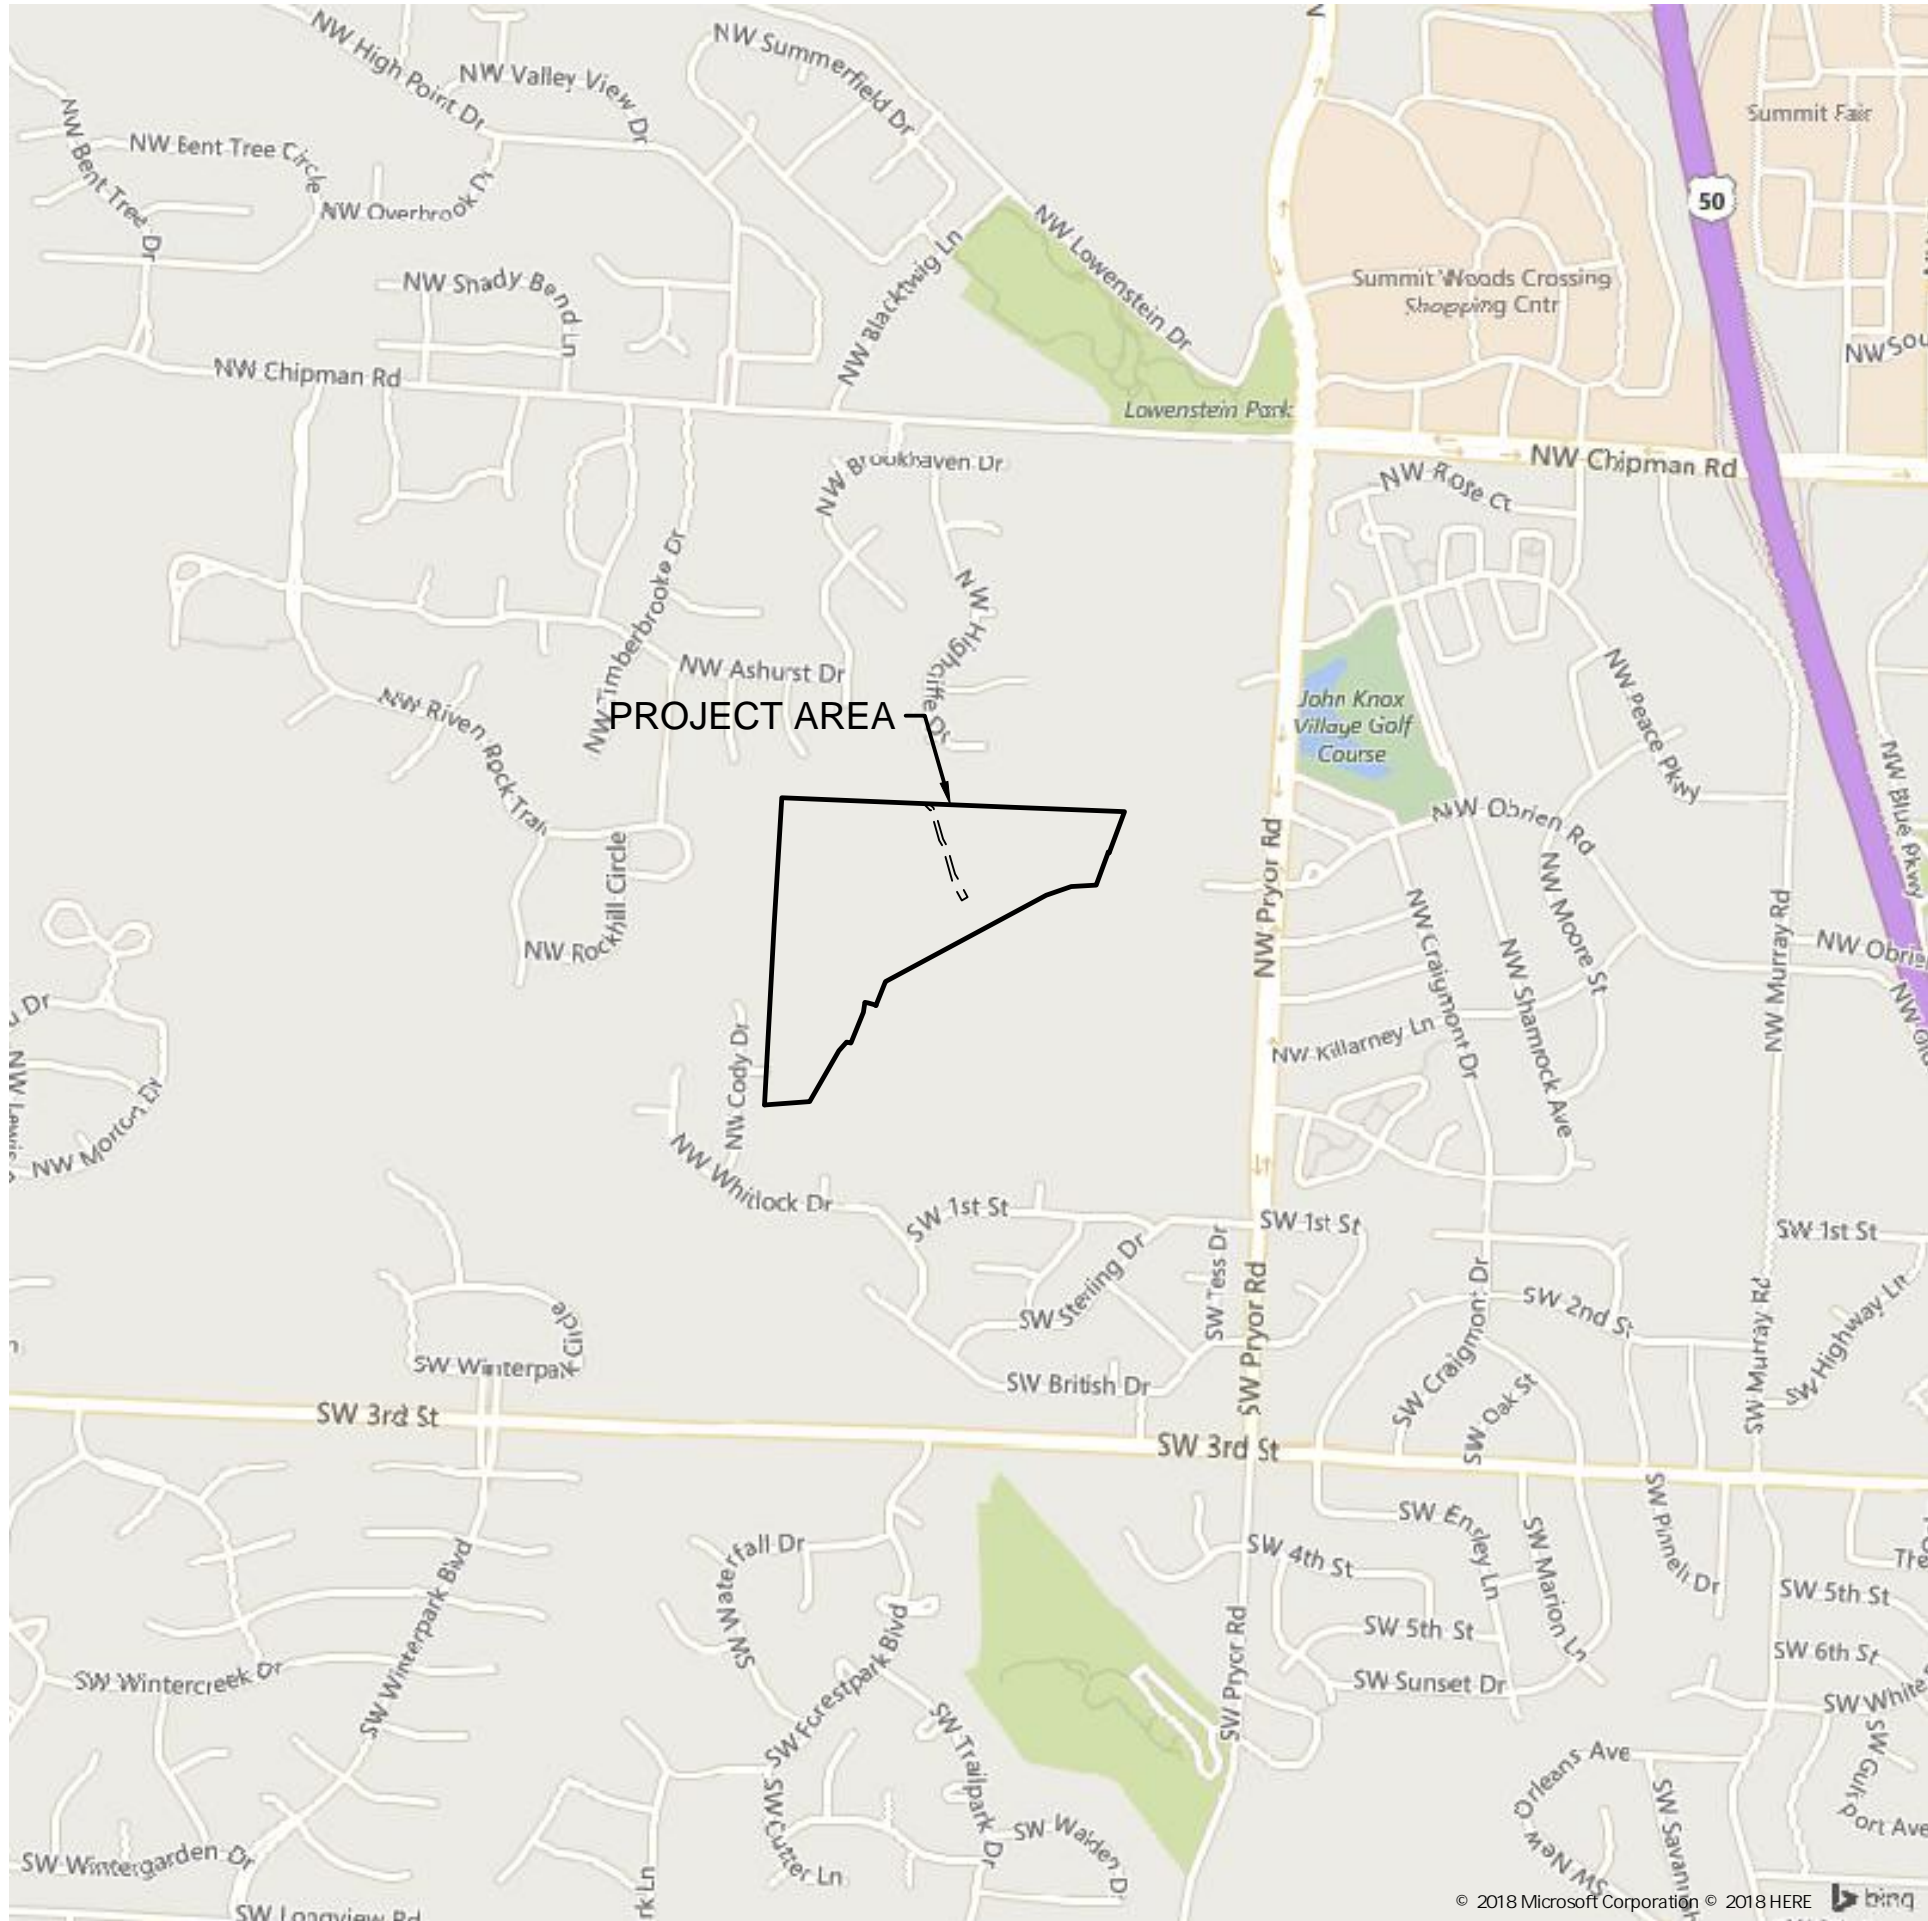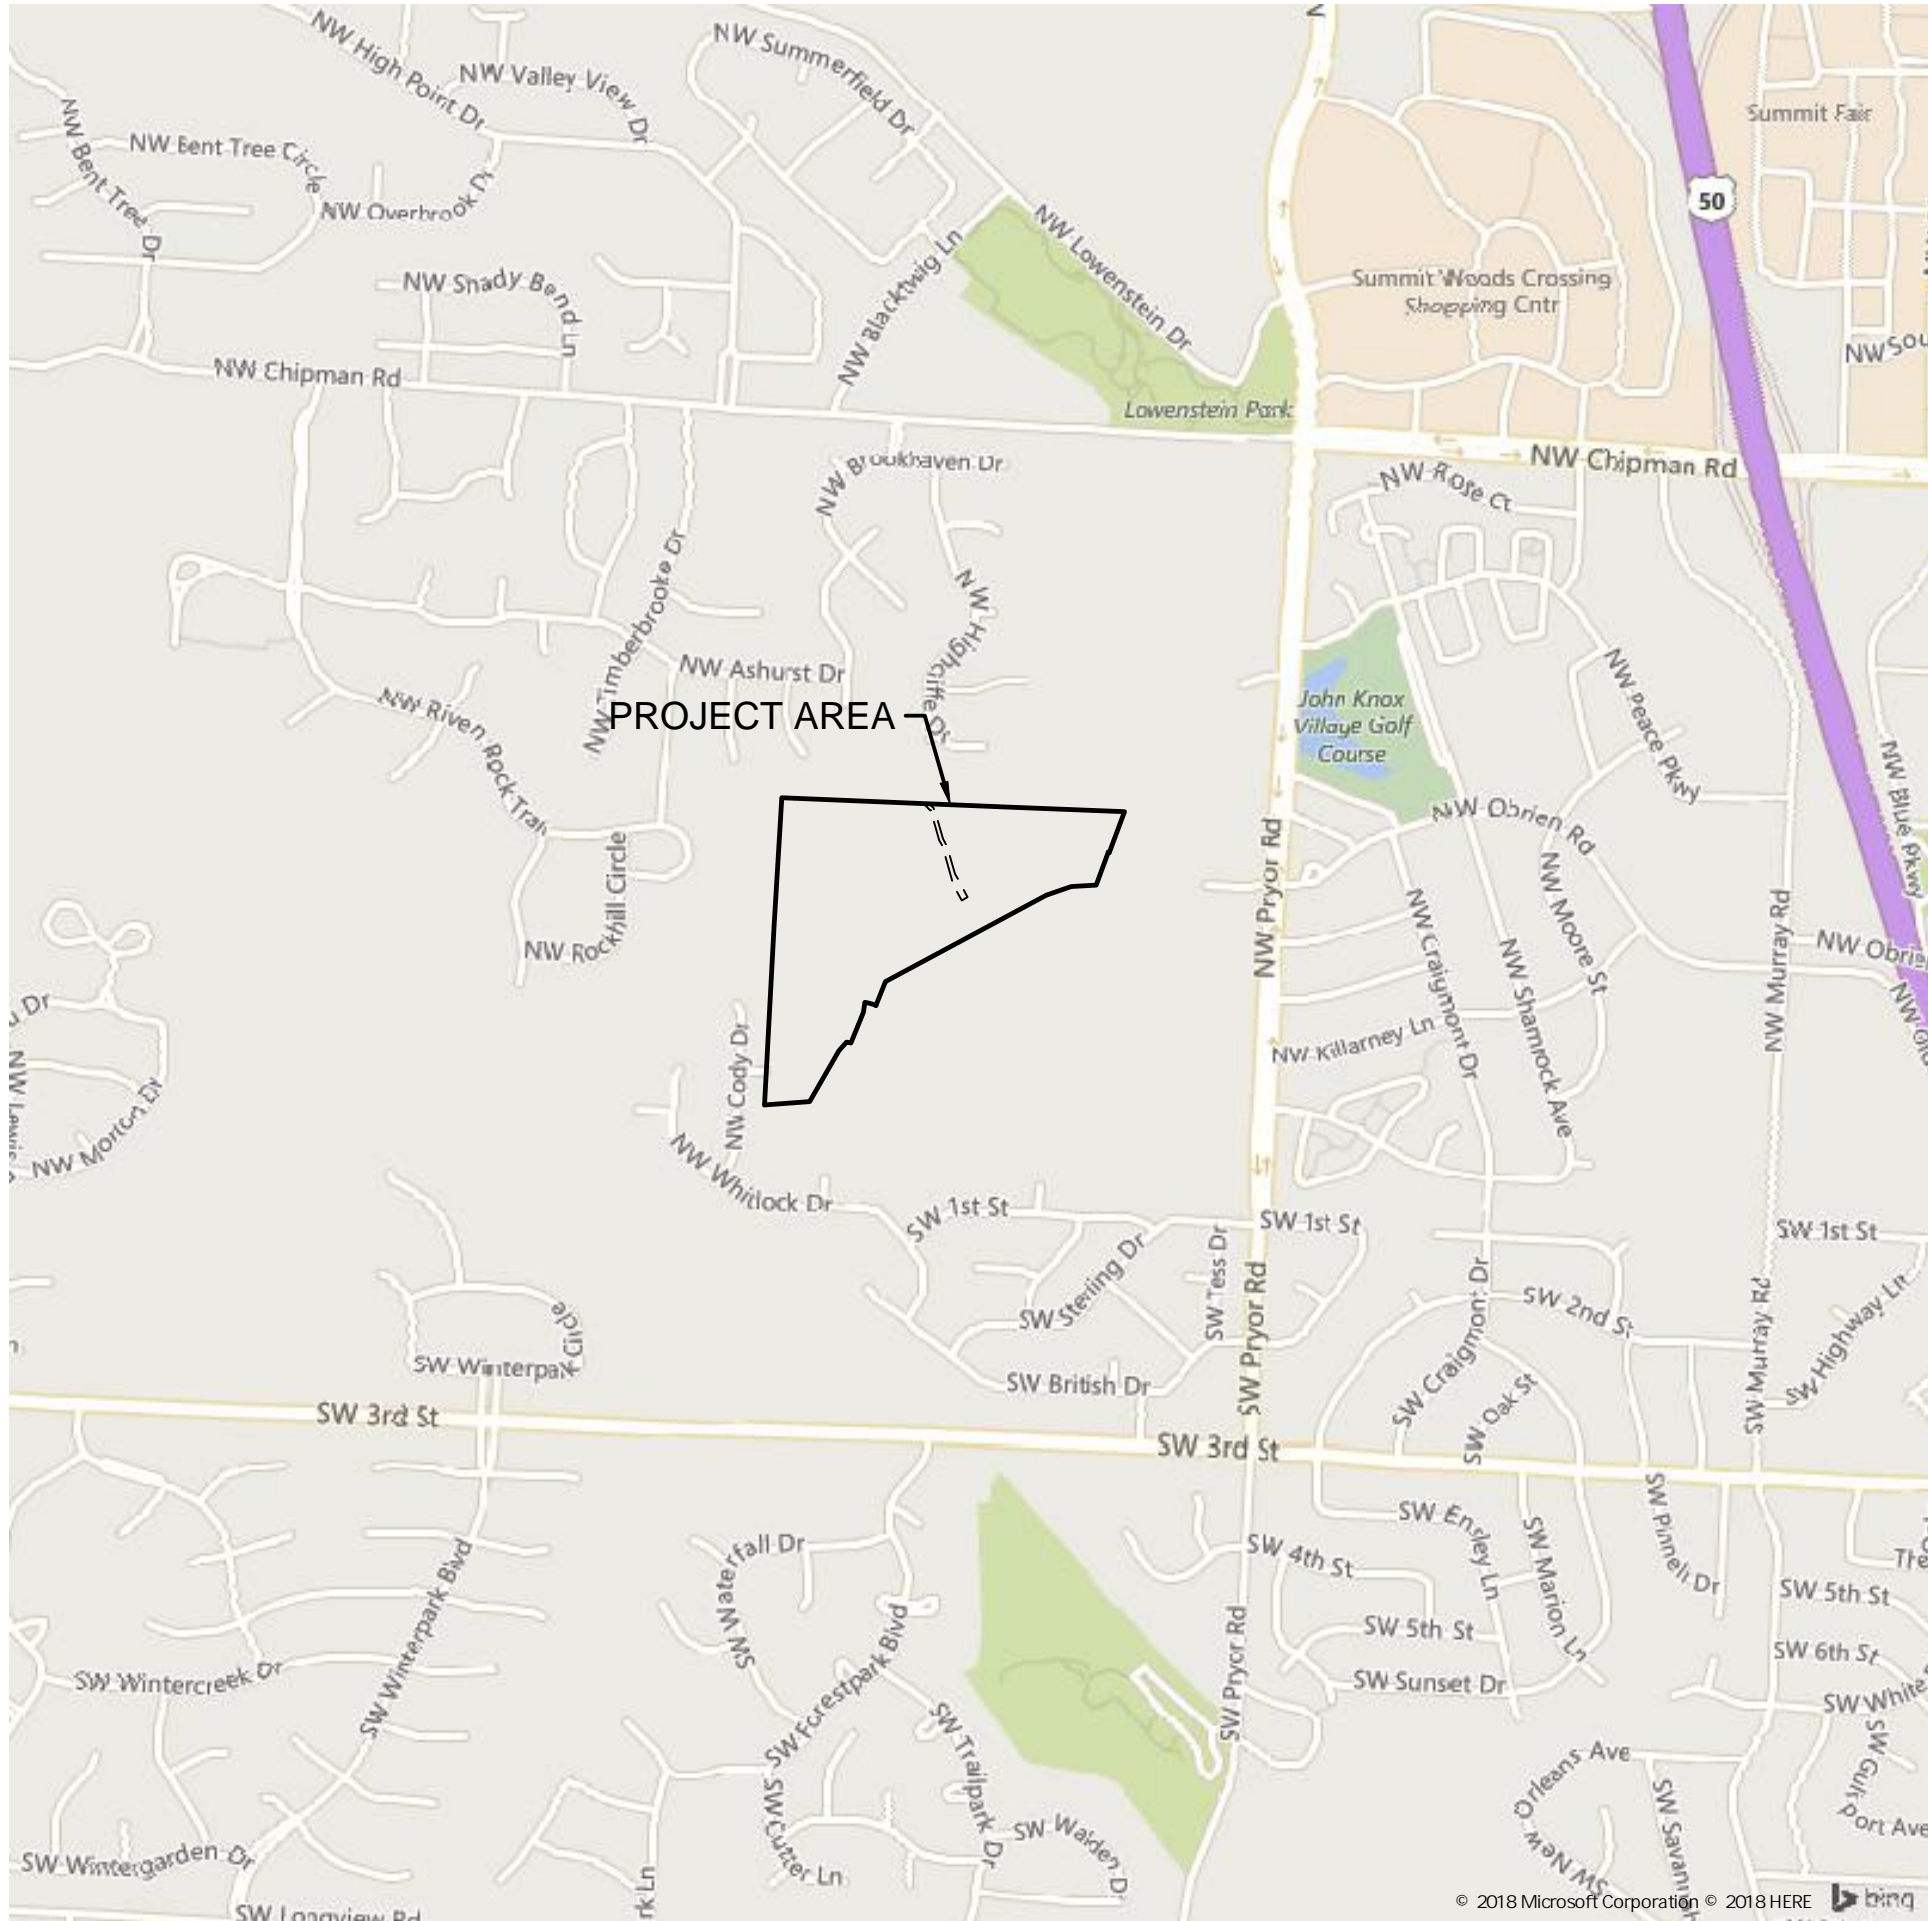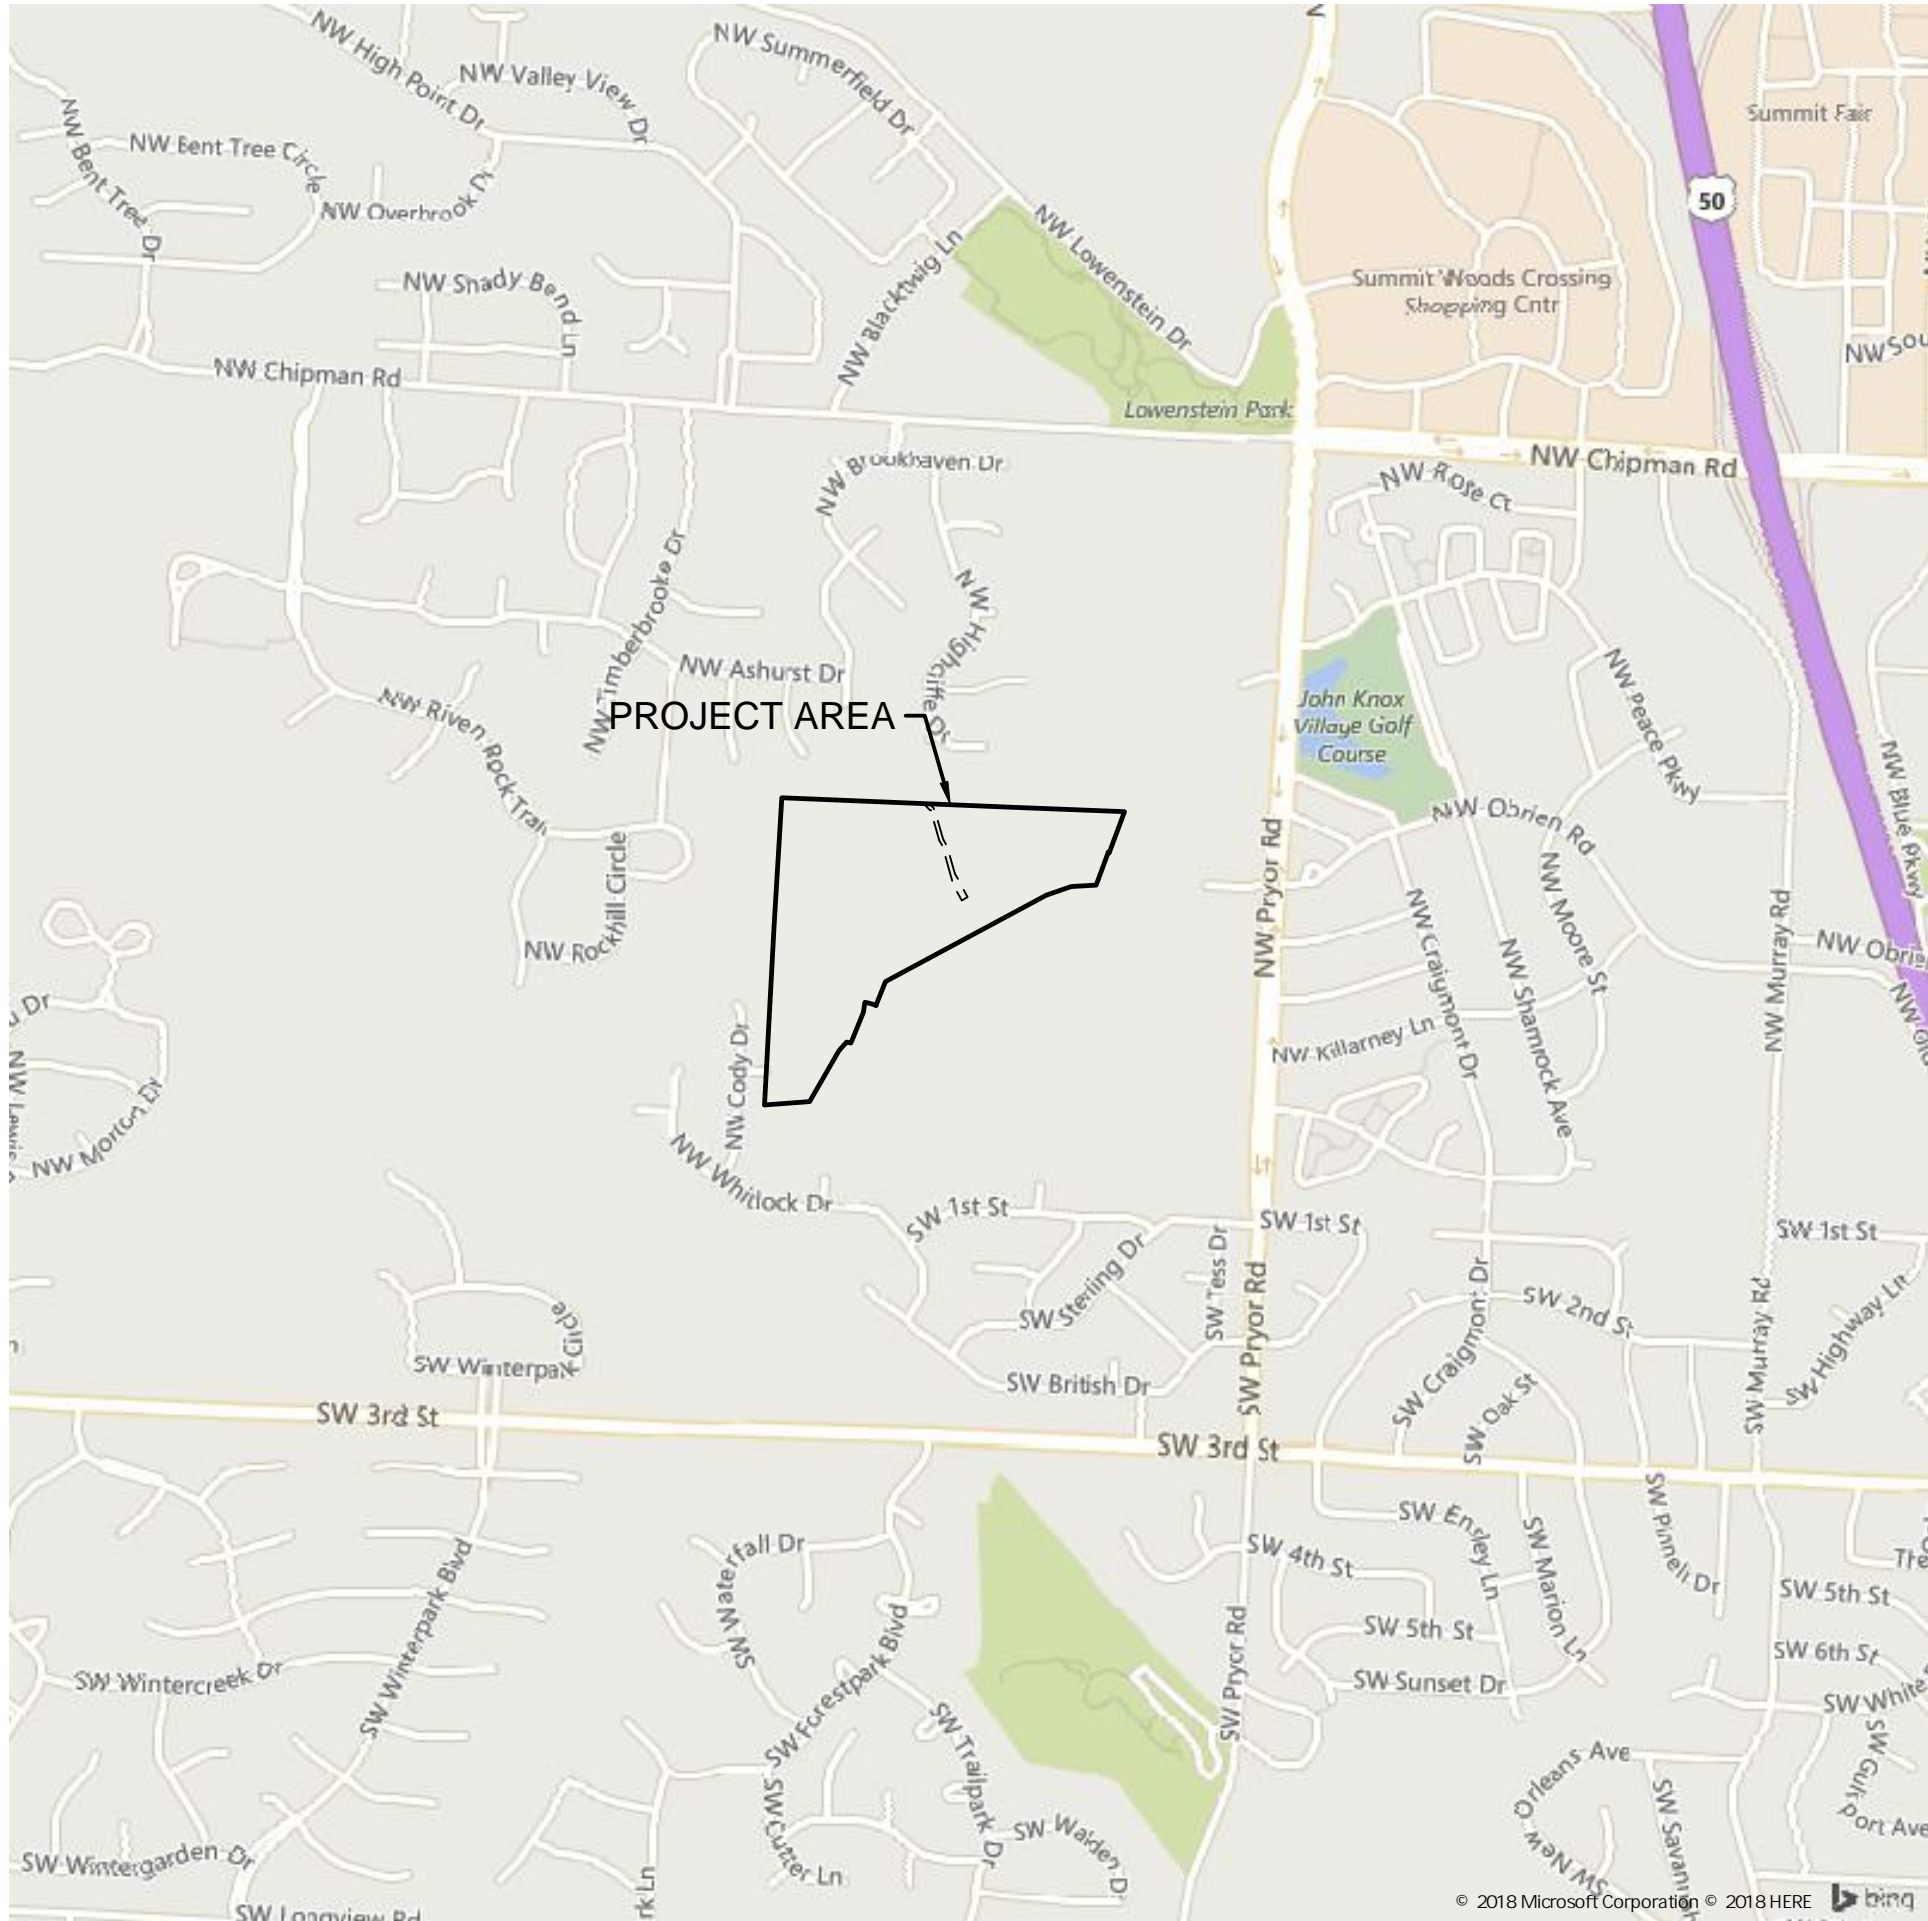



NOT ASBUILT

MASTER PLAN SANITARY SEWER PLANS


LEE'S SUMMIT, MO

2020

DATE

REVISIONS DESCRIPTION

BY

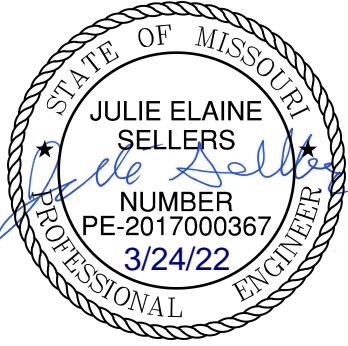


MO Certificate of Authority #:001592
1301 BURLINGTON, SUITE 100
NORTH KANSAS CITY, MO 64116

www.qlsson.com


olsson



NOT ASBUILT

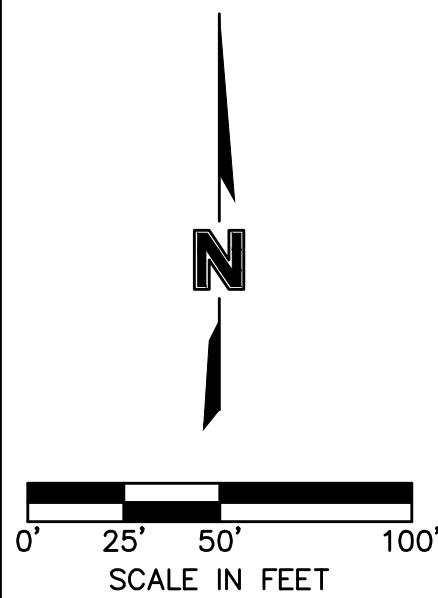


DWG: F:\2018\1001-1500\018-1140-C\40-Design\AutoCAD\Final Plans - Asbuilts\Sheets\GNCV\Sanitary Sewer Plans\C_GEN02_C181140.dwg
DATE: Mar 24, 2022 11:00am
USER: ssaylor

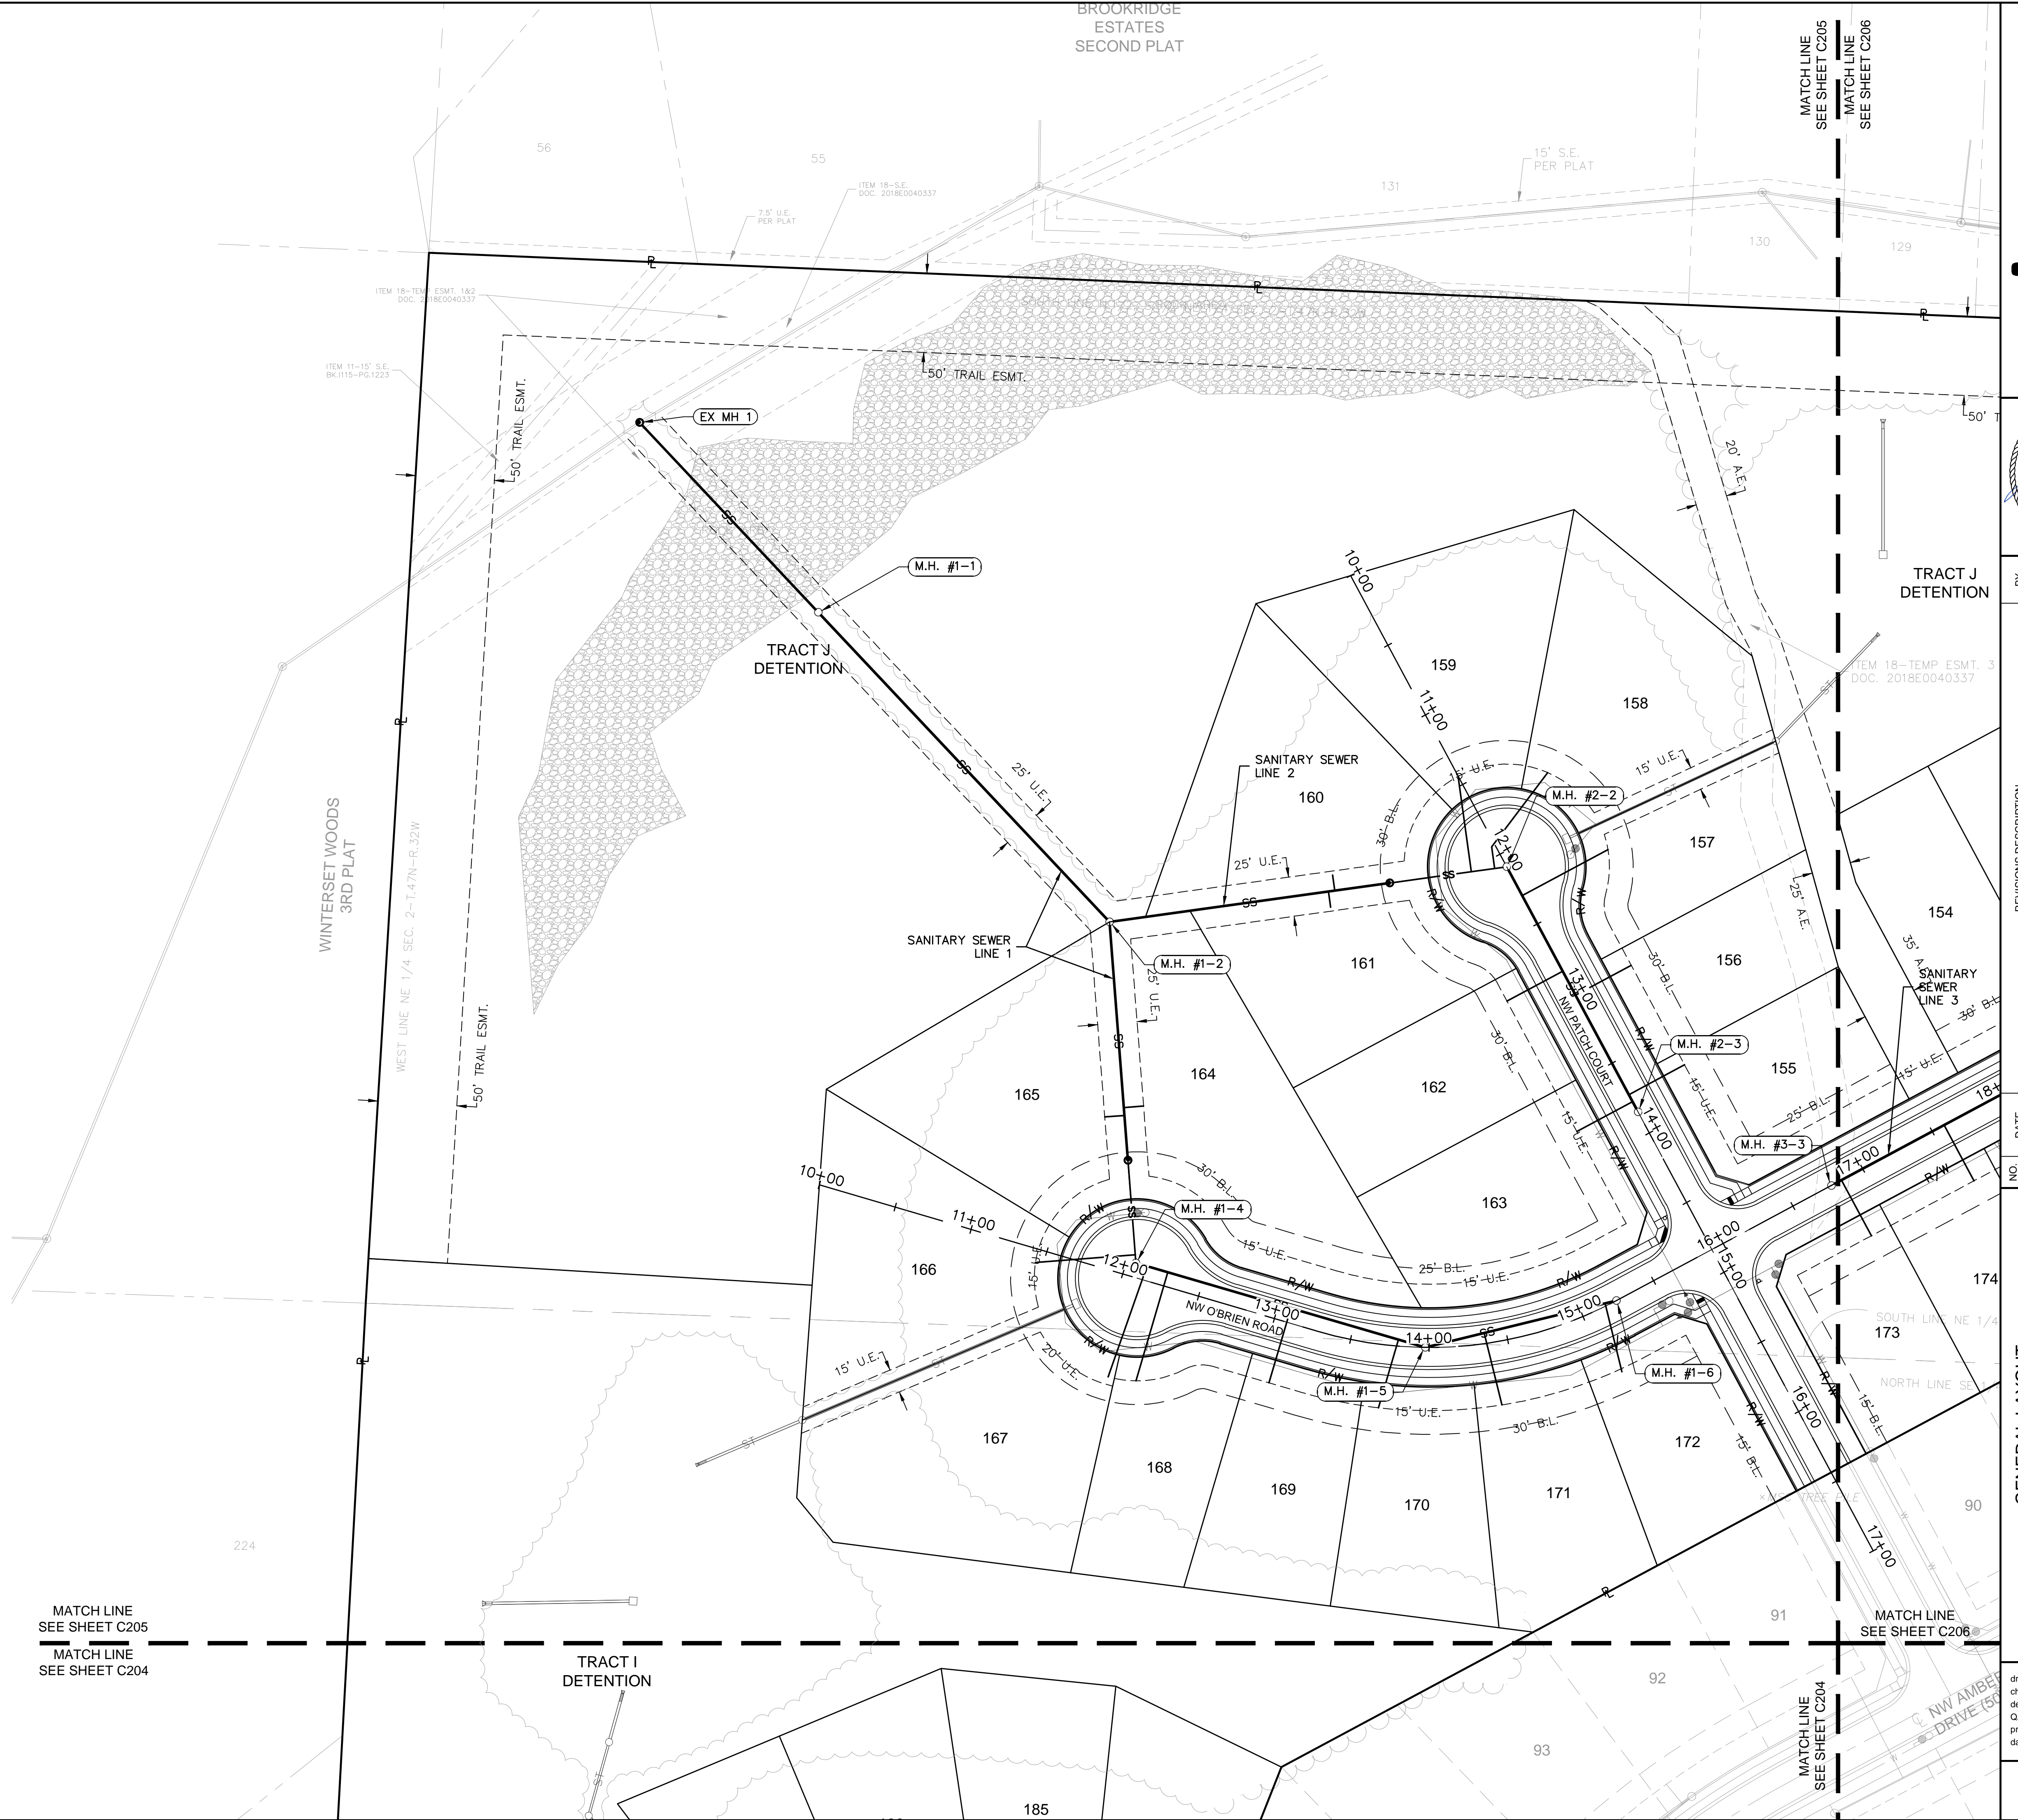


olson

1301 BURLINGTON, SUITE 100
NORTH KANSAS CITY, MO 64116
TEL 816.361.1177
www.olsson.com

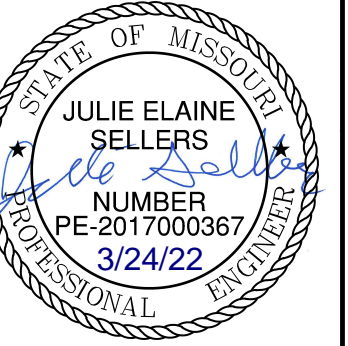
[illegible]

SHEET
C205

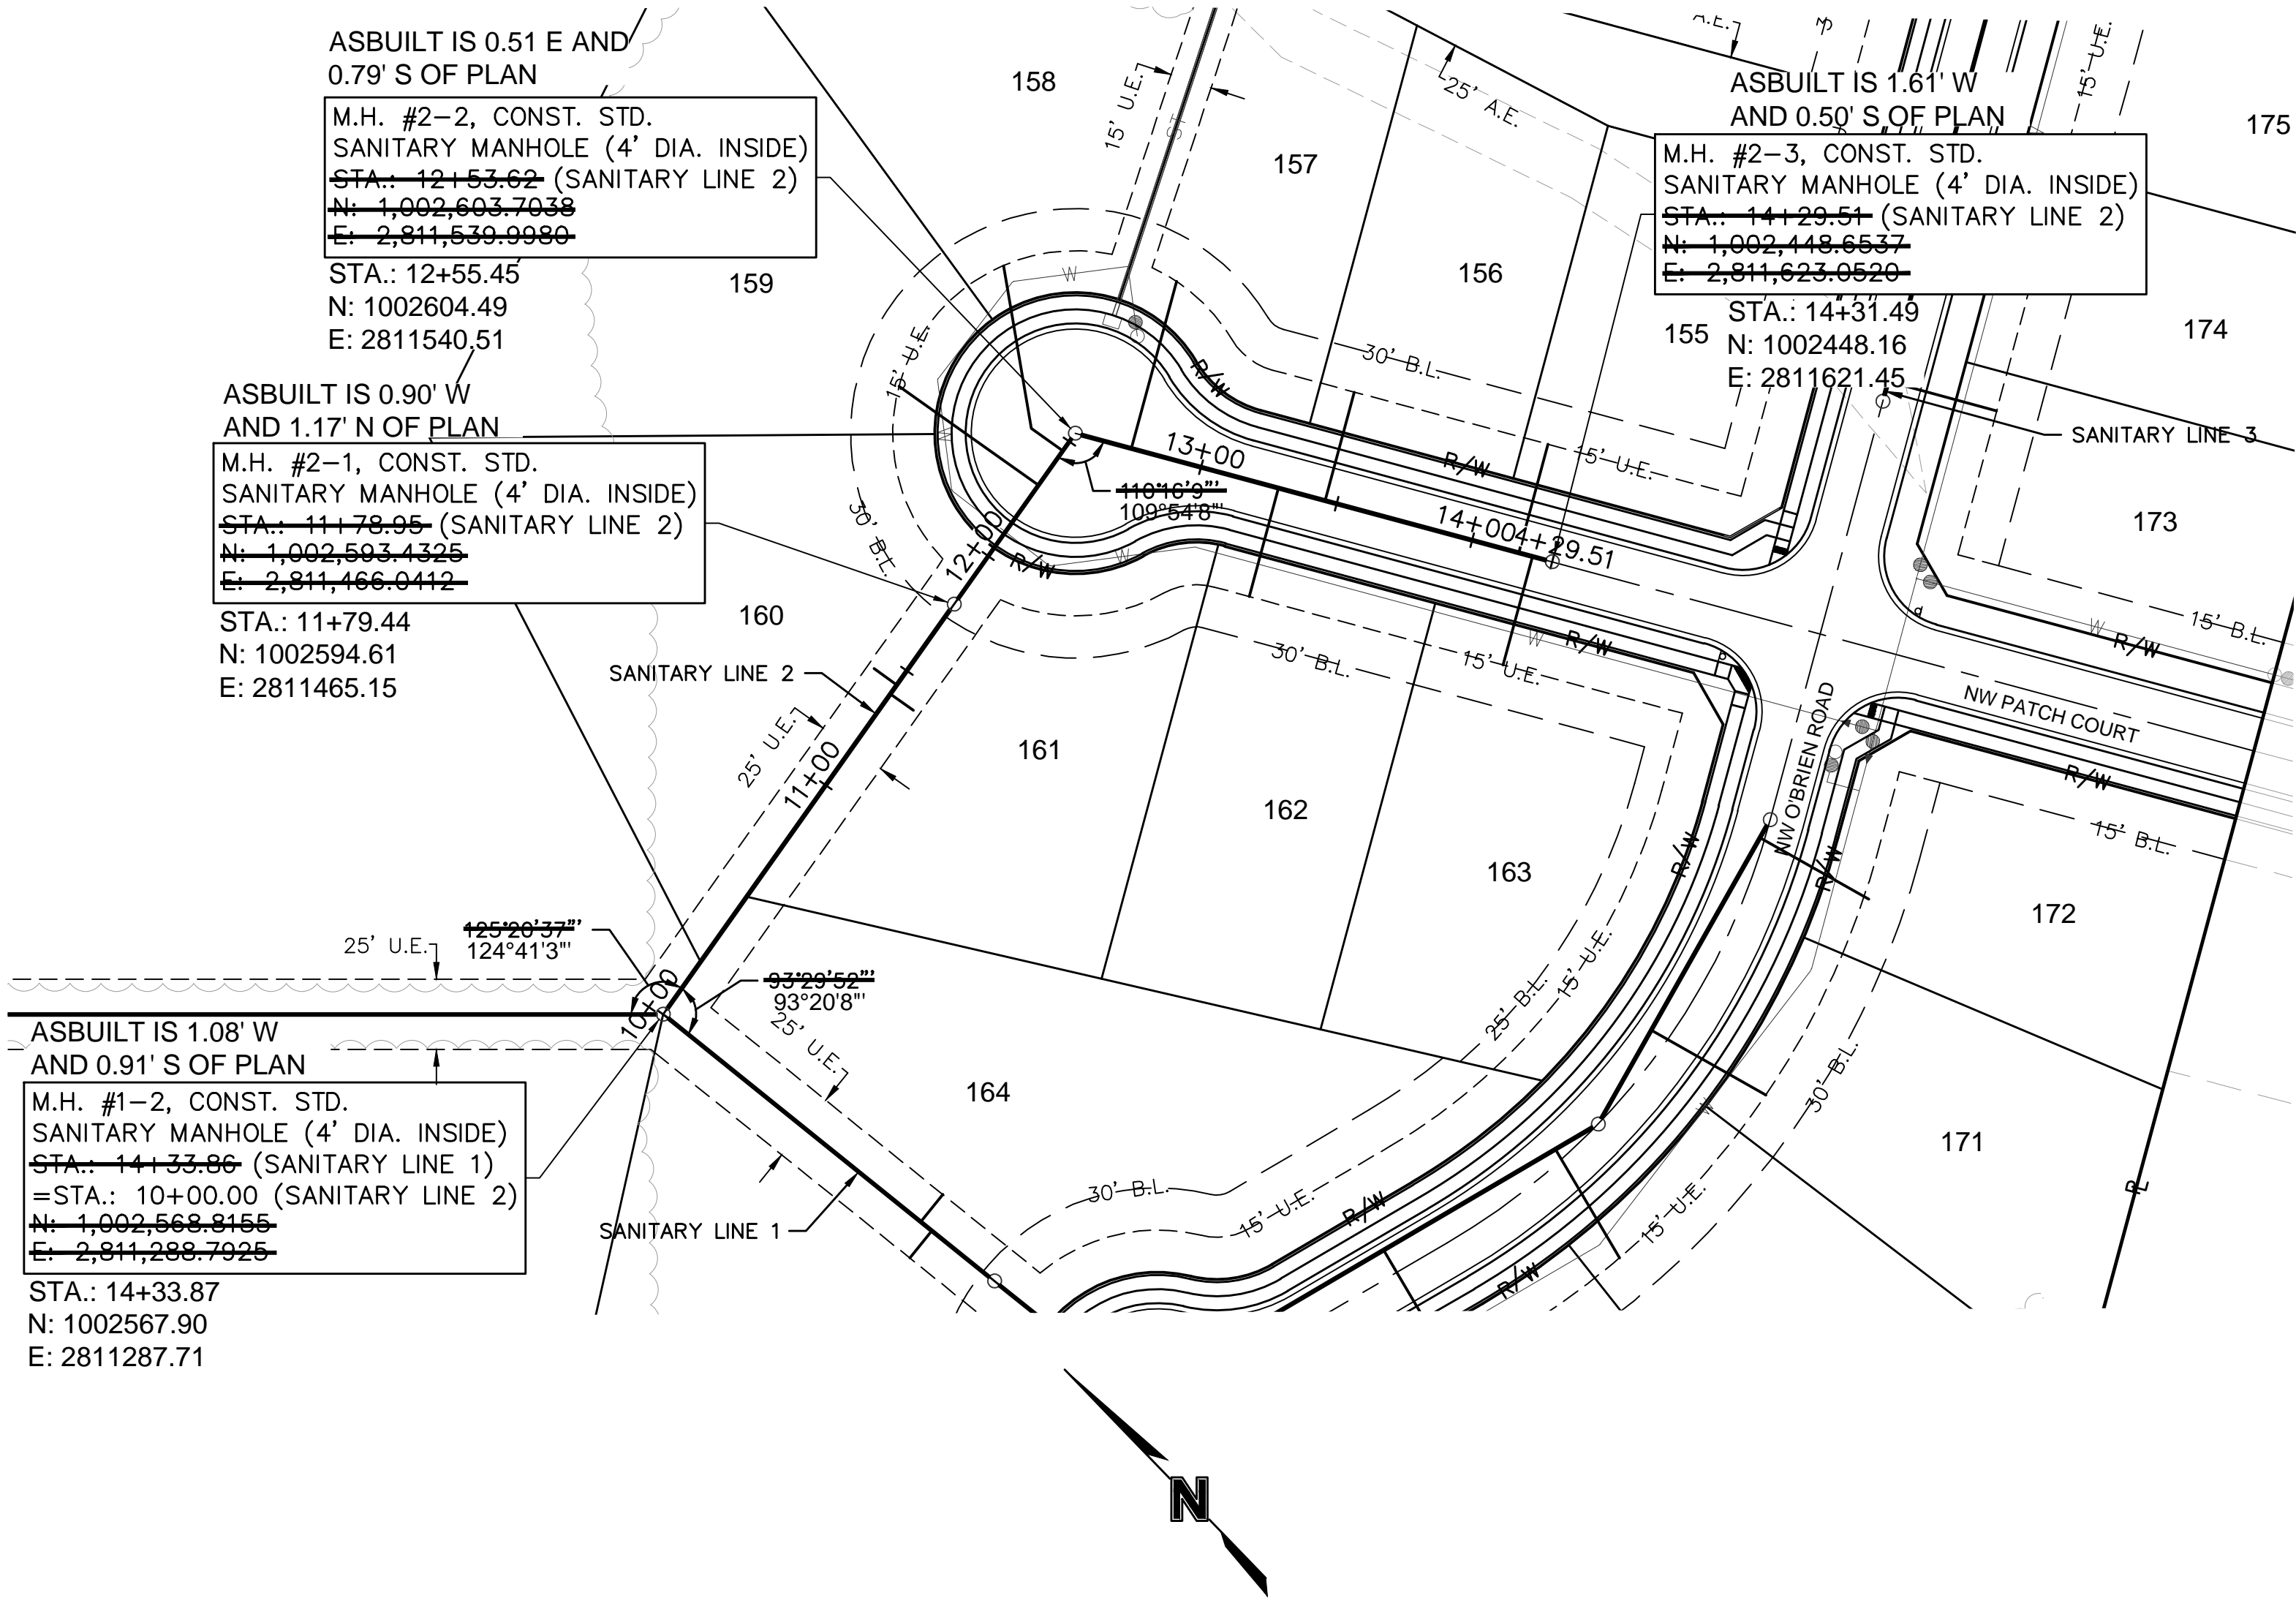

ASBUILT

03-24-2022

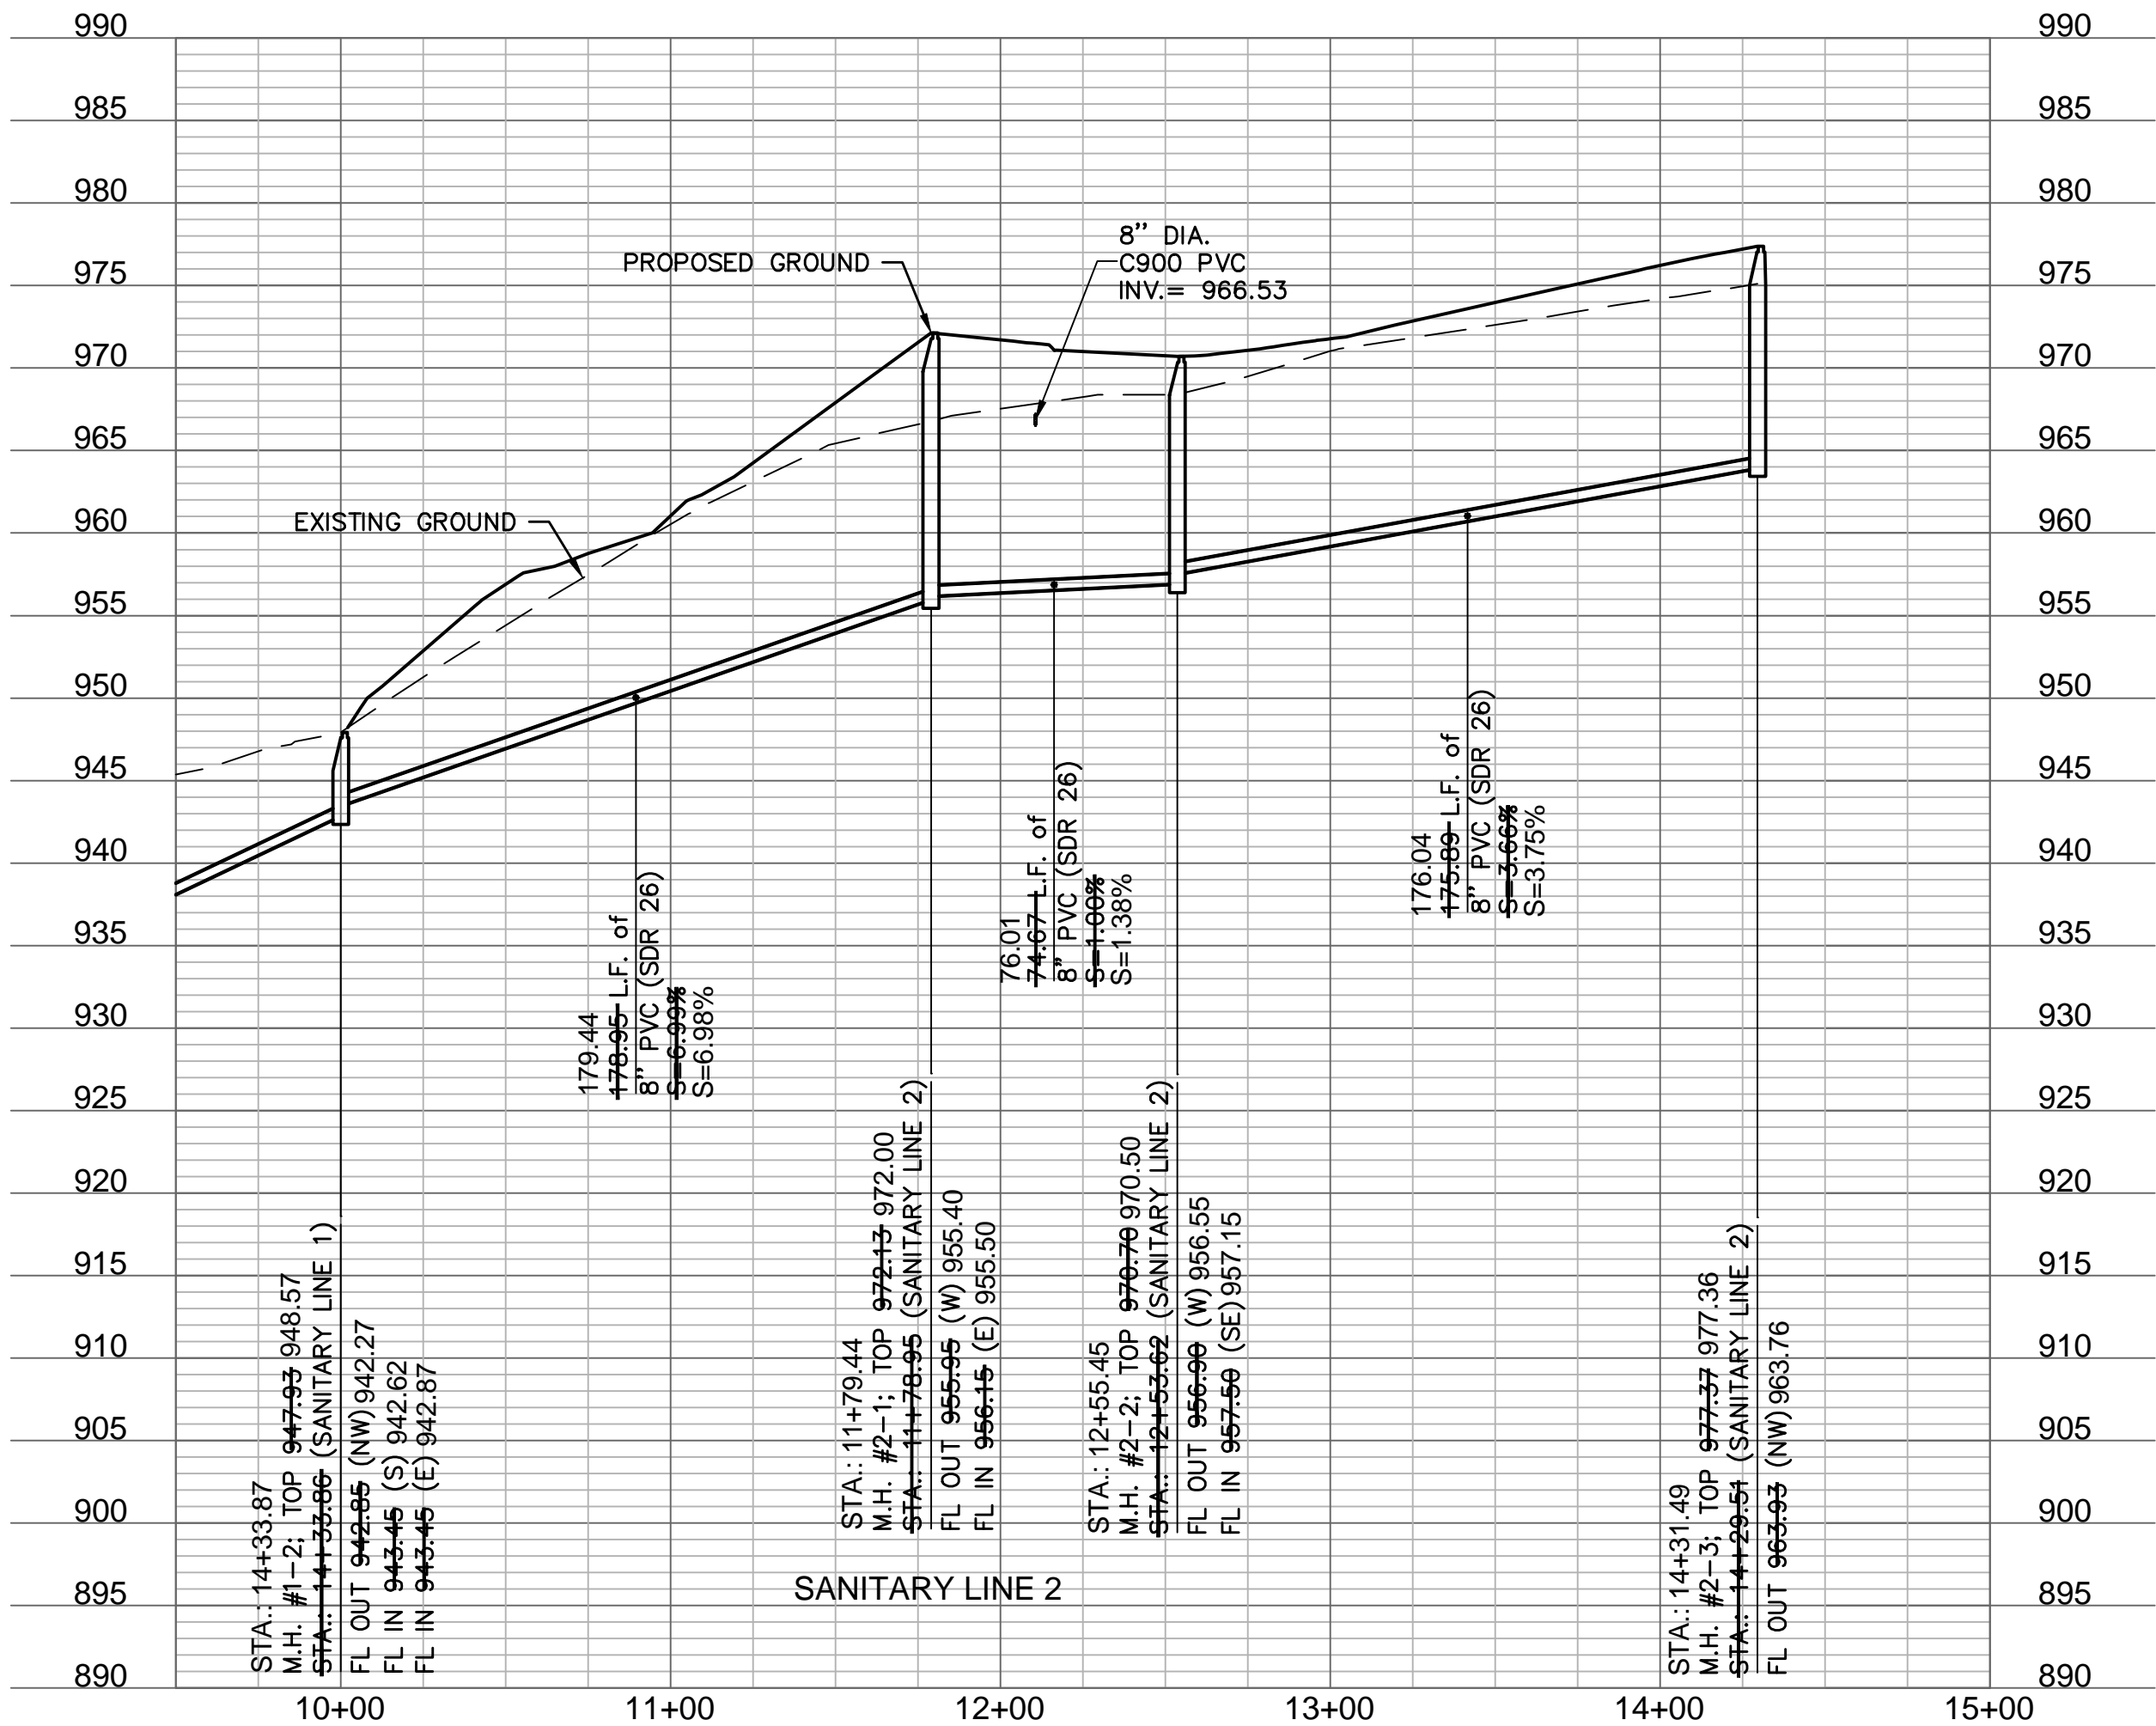

NOTES:
ALL SERVICE LINE CONNECTIONS SHALL BE MADE WITH AN 8"x4" PVC WYE, 4"PVC 45° BEND, AND THE APPROPRIATE LENGTH OF 4" PVC LATERAL (UNLESS OTHERWISE SHOWN) AND CAP.
REFER TO SHEET C211 FOR SANITARY DESIGN AND LATERAL INSTALLATION DETAILS.
MAXIMUM DEVIATION FROM LATERAL STATION LOCATIONS AS CALLED OUT SHALL BE 2.0' TO AVOID PIPE JOINT.
SANITARY LATERALS ARE DESIGNED @ 2.00% SLOPE. IF RISER IS INDICATED, IS TO BE AT THE SANITARY MAIN, UNLESS OTHERWISE NOTED.
TRENCH CHECKS SHALL BE PROVIDED IN ACCORDANCE WITH STANDARDS LEE'S SUMMIT TRENCH CHECK DETAIL (SHEET C212) ON ALL PRIVATE SANITARY SEWER SERVICE LATERALS.

NOTES:
CONTRACTOR SHALL FILL AND COMPACT TO 95% STANDARD DENSITY TO A POINT 36" MINIMUM ABOVE THE TOP OF PIPE PRIOR TO EXCAVATION FOR THE PIPE.

olsson

NO. 018-1140-001
301 E. BURLINGTON SUITE 100
NORTH KANSAS CITY, MO 64116
TEL 816.861.1177
www.olsson.com



STATE OF MISSOURI
JULIE ELAINE SELLERS
Professional Engineer
NUMBER
PE-2017000367
3/24/22

BY
NO. REV.
1
DATE
07/10/2020
REVISIONS DESCRIPTION
REVISED PER CITY COMMENTS
REVISIONS

SANITARY SEWER PLAN & PROFILE
SANITARY SEWER PLANS
WOODSIDE RIDGE
SECOND PLAT
LEE'S SUMMIT, MO
2020

drawn by: C.S.M.
checked by: S.M.S.
designed by: C.S.M.
QA/QC by: J.E.S.
project no.: C18-1140
date: 2020.07.10

SHEET
C208

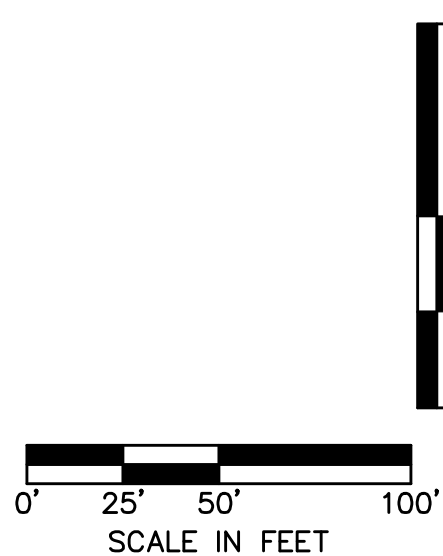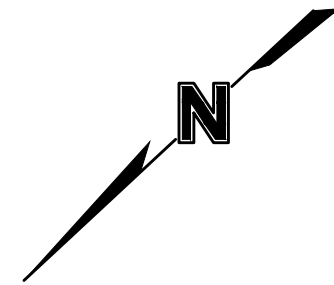

03-24-2022

NOTES:
CONTRACTOR SHALL FILL AND COMPACT TO 95%
STANDARD DENSITY TO A POINT 36" MINIMUM
ABOVE THE TOP OF PIPE PRIOR TO EXCAVATION
FOR THE PIPE.

LEE'S SUMMIT, MO

SHEET
C209

28

REVISIONS

2020


LEE'S SUMMIT, MO

STATE OF MISSOURI
JULIE ELAINE
SELLERS
NUMBER
PE-2017000367
3/24/22
PROFESSIONAL ENGINEER

Olsson

MO Certificate of Authority #:001592
1301 BURLINGTON, SUITE 100
NORTH KANSAS CITY, MO 64116

www.qlsson.com

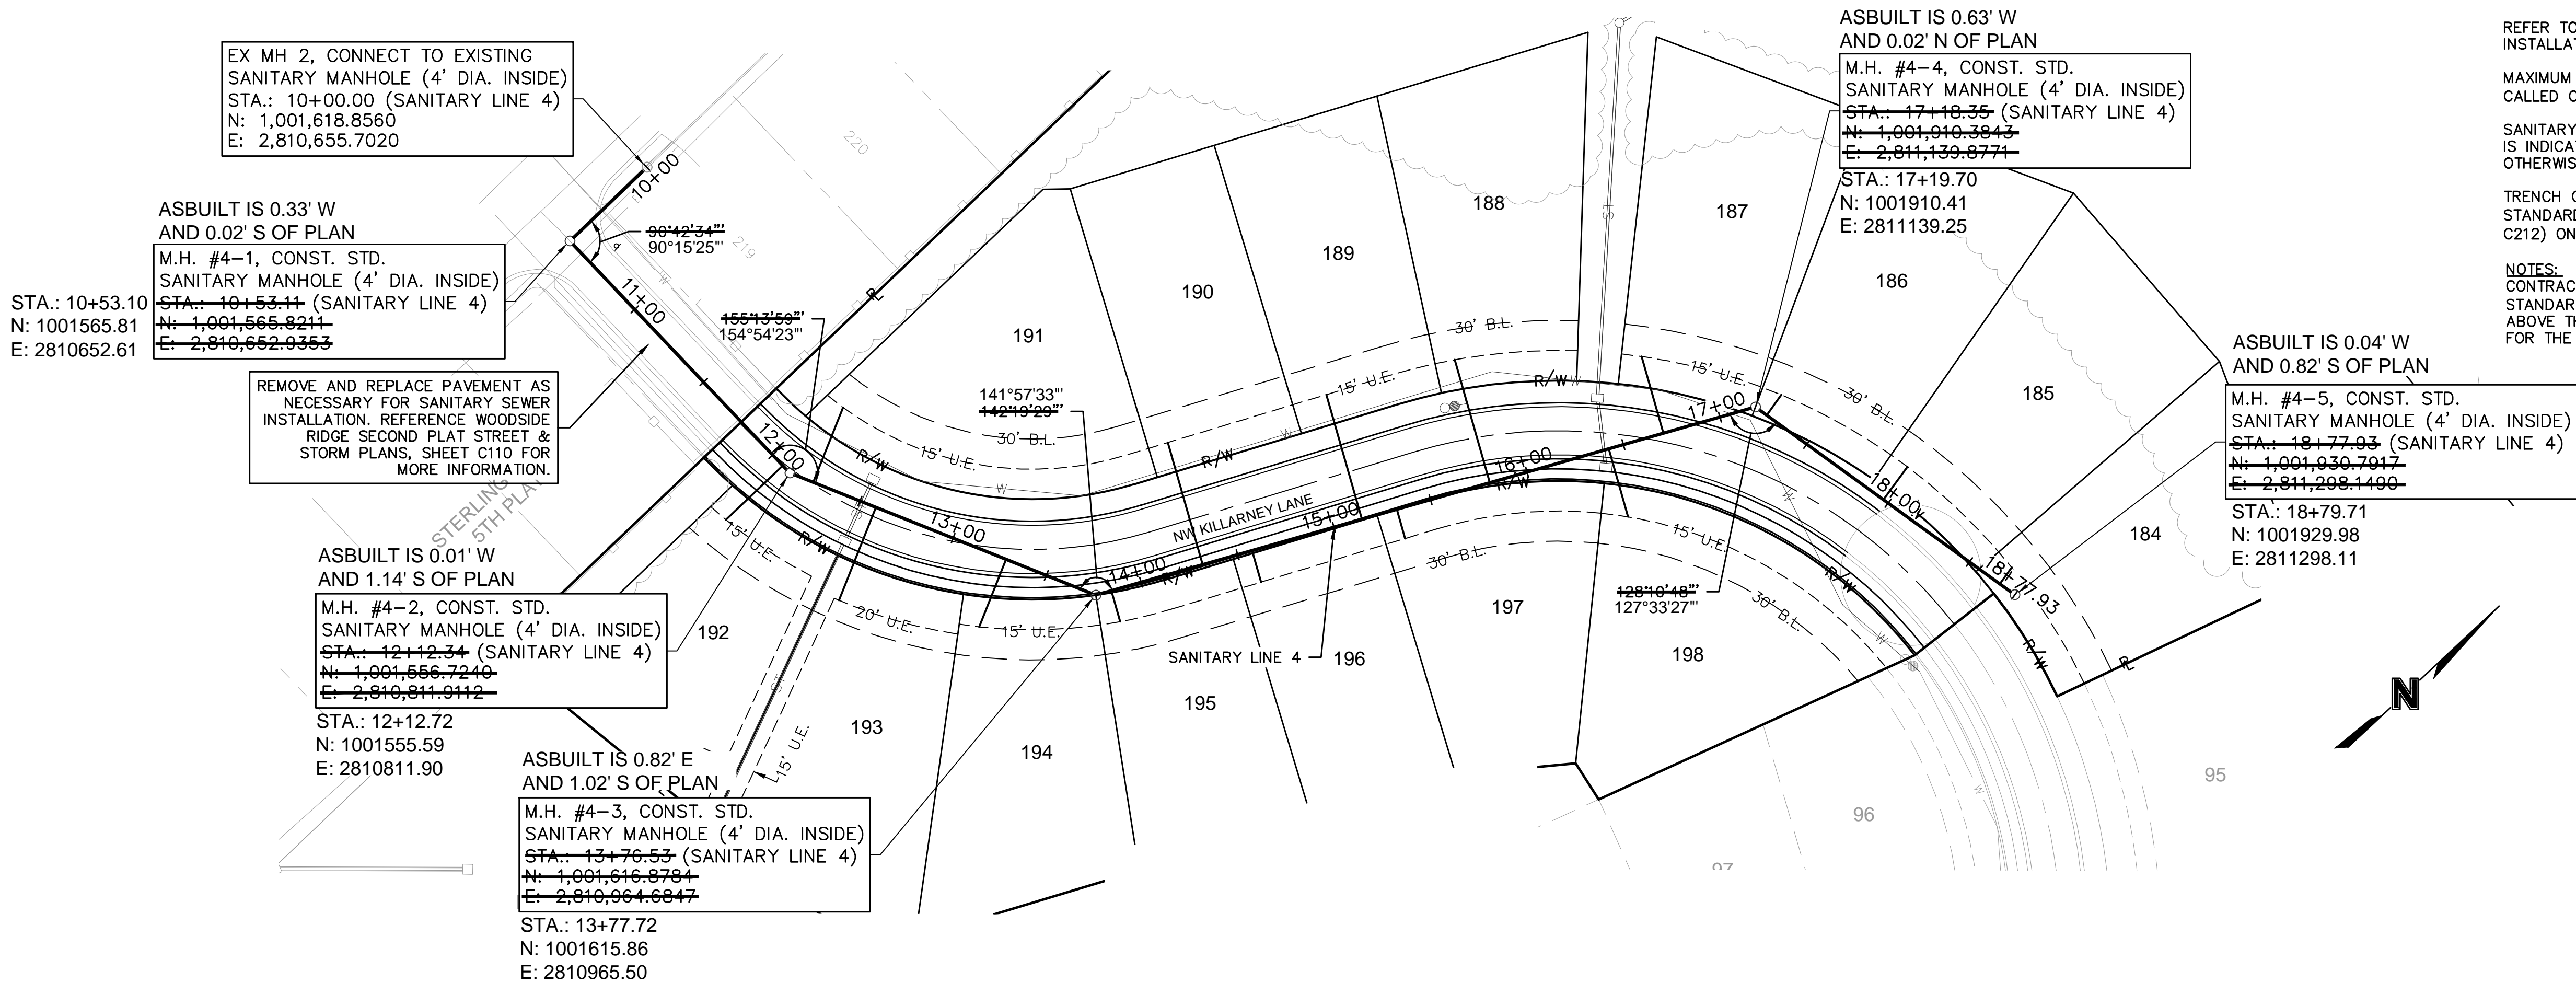

NOTES:
ALL SERVICE LINE CONNECTIONS SHALL BE MADE WITH AN 8"x4" PVC WYE, 4"PVC 45° BEND, AND THE APPROPRIATE LENGTH OF 4" PVC LATERAL (UNLESS OTHERWISE SHOWN) AND CAP.

REFER TO SHEET C211 FOR SANITARY DESIGN AND LATERAL INSTALLATION DETAILS.

MAXIMUM DEVIATION FROM LATERAL STATION LOCATIONS AS CALLED OUT SHALL BE 2.0' TO AVOID PIPE JOINT.



SANITARY LATERALS ARE DESIGNED @ 2.00% SLOPE. IF RISE/FALL IS INDICATED, IS TO BE AT THE SANITARY MAIN, UNLESS OTHERWISE NOTED.

TRENCH CHECKS SHALL BE PROVIDED IN ACCORDANCE WITH STANDARDS LEE'S SUMMIT TRENCH CHECK DETAIL (SHEET C212) ON ALL PRIVATE SANITARY SEWER SERVICE LATERALS.

NOTES:
CONTRACTOR SHALL FILL AND COMPACT TO 95% STANDARD DENSITY TO A POINT 36" MINIMUM ABOVE THE TOP OF PIPE PRIOR TO EXCAVATION FOR THE PIPE.

ASBUILT

03-24-2022

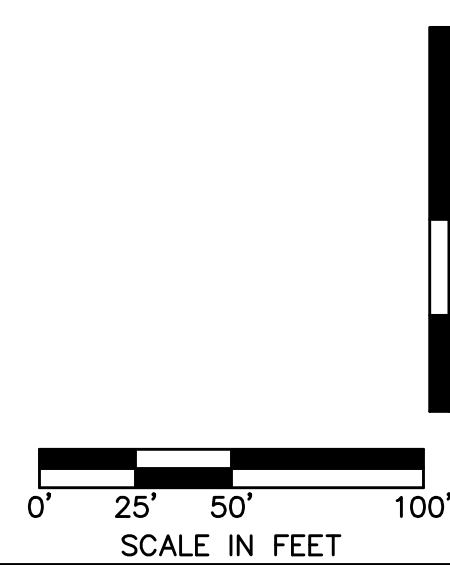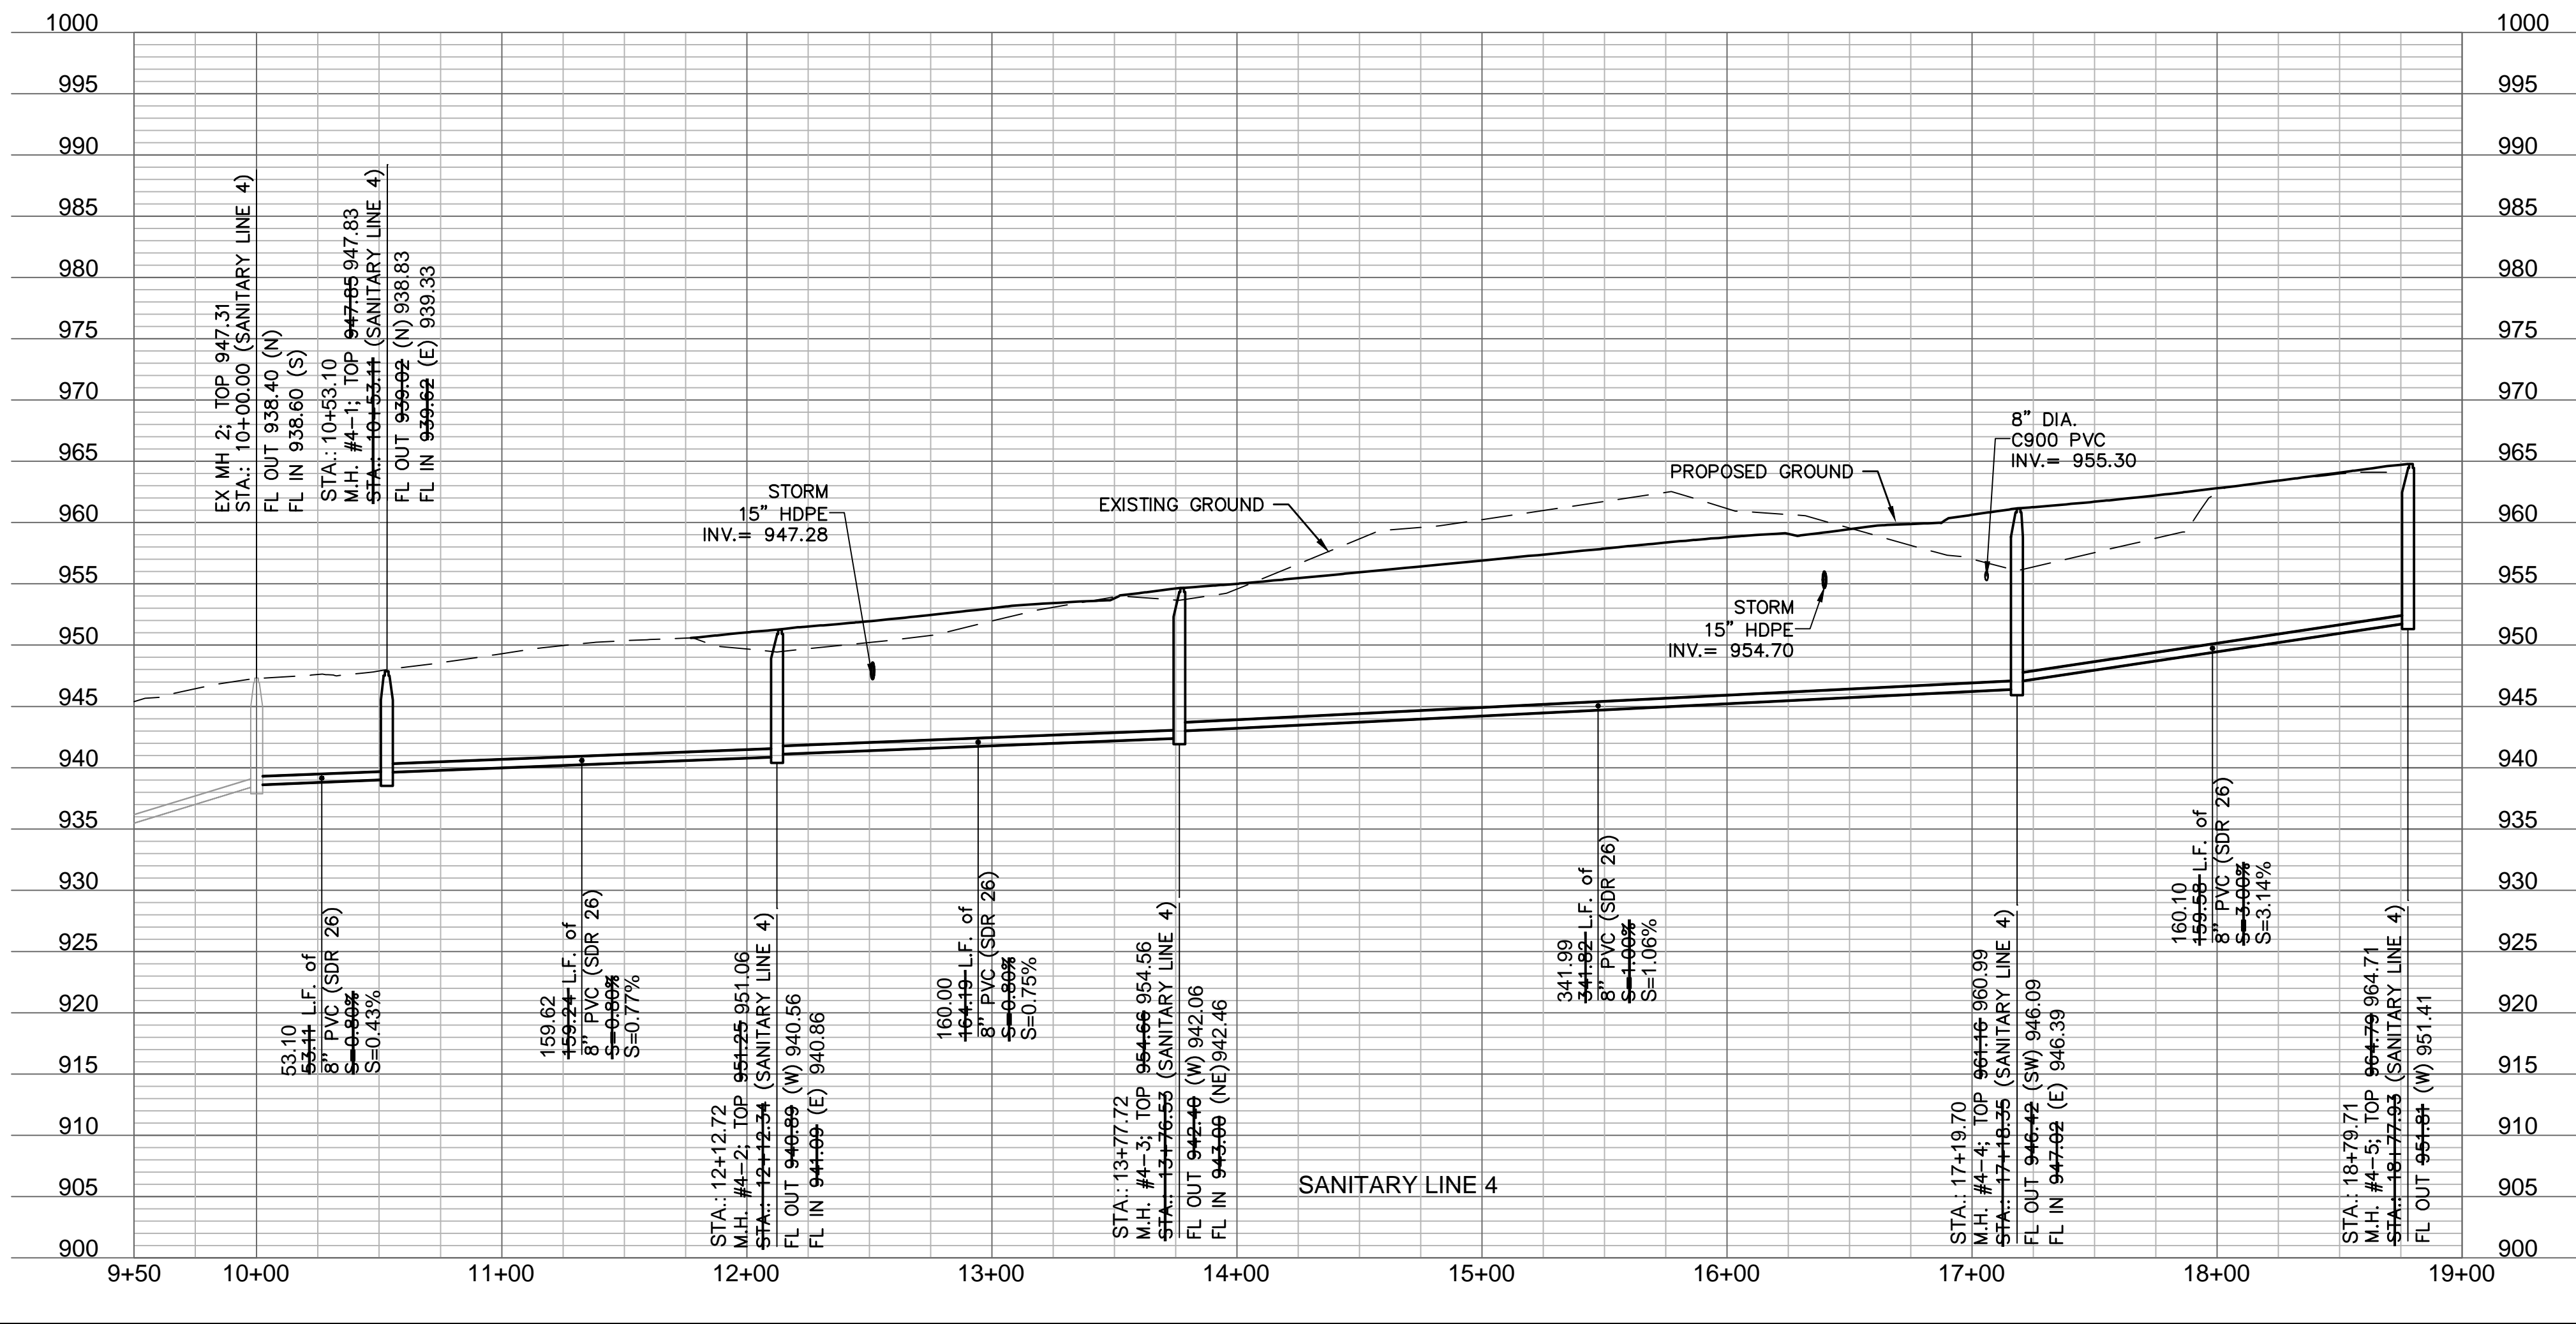

olsson

NO. 001 of 001
301 E. BURLINGTON SUITE 100
NORTH KANSAS CITY, MO 64116
TEL 816.861.1177
www.olsson.com

STATE OF MISSOURI
JULIE ELAINE SELLERS
Professional Engineer
NUMBER PE-2017000367
3/24/22

BY: _____
NO. REV. 1
DATE 07/10/2020
REVISIONS DESCRIPTION
REVISED PER CITY COMMENTS

SANITARY SEWER PLAN & PROFILE
SANITARY SEWER PLANS
WOODSIDE RIDGE
SECOND PLAT
LEE'S SUMMIT, MO
2020


drawn by: _____ C.S.M.
checked by: _____ S.M.S.
designed by: _____ C.S.M.
QA/QC by: _____ J.E.S.
project no.: C18-1140
date: 2020.07.10

SHEET C210

Sanitary Sewer Laterals						
Lot Number	Lateral Station	Lateral Length	Riser	Flowline at Main	Flowline at End of Lateral	Minimum Servicable Floor Elevation
		(ft)	(ft)	(ft)	(ft)	(ft)
150	11+65.14	40.00	4.0	956.9	962.6	965.41
151	12+40.14	40.00	4.0	959.0	964.7	967.52
152	13+15.14	40.00	2.0	961.1	964.9	967.66
153	13+90.14	40.00	1.0	963.1	965.9	968.68
154	14+70.41	40.00	1.0	963.9	966.7	969.48
155	14+17.17	40.00	1.0	963.5	966.3	969.07
156	13+45.75	40.00	1.0	960.9	963.7	966.46
157	12+73.79	61.61	0.0	958.2	960.5	963.28
158	12+45.92	72.52	0.0	956.8	959.3	962.08
159	12+30.97	60.93	1.0	956.7	959.9	962.68
160	11+43.81	10.00	5.0	953.5	959.6	962.41
161	11+39.81	10.00	6.0	953.2	960.3	963.11
162	13+28.57	40.00	1.0	960.3	963.0	965.83
163	14+22.17	40.00	1.0	963.7	966.5	969.26
164	15+51.64	10.00	5.0	950.5	956.6	959.41
165	15+56.64	10.00	4.0	950.8	955.9	958.73
166	16+45.07	63.29	0.0	953.3	955.6	958.38
167	16+54.28	85.90	0.0	954.1	956.8	959.49
168	16+71.28	71.64	0.0	954.5	956.9	959.74
169	17+52.34	49.23	1.0	956.6	959.5	962.34
170	18+23.26	44.95	1.0	958.4	961.3	964.06
171	18+79.32	46.90	2.0	960.2	964.1	966.88
172	19+57.99	44.54	2.0	962.5	966.4	969.20
173	16+23.06	40.00	1.0	965.4	968.2	971.01
174	15+49.40	40.00	1.0	964.7	967.5	970.27
175	14+75.40	40.00	1.0	964.0	966.7	969.53
176	13+95.13	40.00	1.0	963.2	965.9	968.73
177	13+20.13	40.00	2.0	961.2	965.0	967.80
178	12+45.13	40.00	4.0	959.1	964.9	967.66
179	11+70.14	40.00	4.0	957.0	962.7	965.55
180	11+06.41	40.00	3.0	955.2	960.0	962.78
184	18+68.67	10.12	1.0	951.5	953.7	956.52
185	17+97.13	20.30	1.0	949.4	951.8	954.58
186	17+25.29	12.48	2.0	947.2	950.4	953.24
187	16+70.70	39.79	1.0	945.9	948.7	951.53
188	15+80.69	63.73	1.0	945.0	948.3	951.10
189	15+14.41	64.58	0.0	944.4	946.7	949.48
190	14+31.93	63.28	0.0	943.6	945.8	948.63
191	12+24.92	40.14	0.0	941.2	943.0	945.80
192	12+07.26	39.13	0.0	940.9	942.6	945.44
193	12+58.60	49.77	0.0	941.5	943.5	946.26
194	13+28.43	36.19	0.0	942.0	943.7	946.55
195	13+84.63	16.04	0.0	943.1	944.4	947.21
196	14+57.56	16.33	0.0	943.8	945.1	947.94
197	15+32.55	15.14	1.0	944.6	946.9	949.65
198	16+42.32	35.21	3.0	945.7	950.3	953.11

Sanitary Sewer Design Information											
Upstream Manhole	Downstream Pipe Slope	Downstream Pipe Diameter	Proposed Cumulative Area	Future Cumulative Area	Peak Base Flow 50-Year Design	Peak Infiltration Flow 50-Year Design	Peak Inflow 50-Year Design	Total Peak Flow	Downstream Pipe Mannings N	Downstream Pipe Capacity	Downstream Pipe Full Flow Velocity
	(%)	(in)	(Ac.)	(Ac.)	(gpd)	(gpd)	(cfs)	(cfs)		(cfs)	(fps)
EX MH 7776	1.33%	15	346.72	0.00	520080.00	173360.000	4.251	5.324	0.014	6.92	5.64
MH 1-1	17.00%	8	7.72	0.00	11580.00	3860.000	0.228	0.252	0.014	4.63	13.25
MH 1-2	9.50%	8	7.72	0.00	11580.00	3860.000	0.228	0.252	0.014	3.46	9.91
MH 1-3	5.99%	8	3.97	0.00	5955.00	1985.000	0.124	0.136	0.014	2.75	7.87
MH 1-4	1.00%	8	2.80	0.00	4200.00	1400.000	0.089	0.098	0.014	1.12	3.21
MH 1-5	2.55%	8	2.31	0.00	3465.00	1155.000	0.075	0.082	0.014	1.79	5.13
MH 1-6	3.00%	8	0.76	0.00	1140.00	380.000	0.026	0.028	0.014	1.94	5.57
MH 1-2	9.50%	8	7.72	0.00	11580.00	3860.000	0.228	0.252	0.014	3.46	9.91
MH 2-1	6.99%	8	3.75	0.00	5625.00	1875.000	0.117	0.129	0.014	2.97	8.50
MH 2-2	1.00%	8	2.85	0.00	4275.00	1425.000	0.091	0.100	0.014	1.12	3.21
MH 2-3	3.66%	8	1.90	0.00	2850.00	950.000	0.000	0.000	0.000	0.00	0.00
EX MH 3-3	5.68%	8	9.58	0.00	14370.00	4790.000	0.277	0.307	0.014	2.67	7.66
MH 3-1	2.50%	8	4.45	0.00	6675.00	2225.000	0.137	0.151	0.014	1.77	5.08
MH 3-2	2.81%	8	4.45	0.00	6675.00	2225.000	0.137	0.151	0.014	1.88	5.39
MH 3-3	1.00%	8	1.92	0.00	2880.00	960.000	0.063	0.069	0.014	1.12	3.21
EX MH 4	5.80%	8	5.44	0.00	8160.00	2720.000	0.165	0.182	0.014	2.70	7.74
MH 4-1	0.80%	8	5.44	0.00	8160.00	2720.000	0.165	0.182	0.014	1.00	2.88
MH 4-2	0.80%	8	5.44	0.00	8160.00	2720.000	0.165	0.182	0.014	1.00	2.88
MH 4-3	0.80%	8	5.12	0.00	7680.00	2560.000	0.156	0.172	0.014	1.00	2.88
MH 4-4	1.00%	8	3.92	0.00	5880.00	1960.000	0.122	0.134	0.014	1.12	3.21
MH 4-5	3.00%	8	1.07	0.00	1605.00	535.000	0.036	0.039	0.014	1.94	5.57



NOT ASBUILT

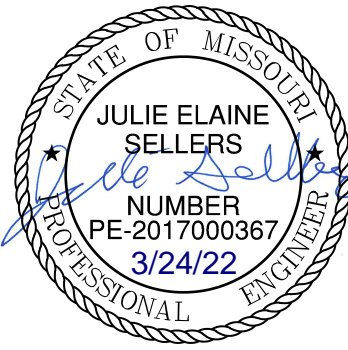





REVISIONS	
NO. REV.	DESCRIPTION

SANITARY SEWER TABLES SANITARY SEWER PLANS	
WOODSIDE RIDGE SECOND PLAT	
LEE'S SUMMIT, MO	
2020	

drawn by: _____ C.S.M
checked by: _____ S.M.S
designed by: _____ C.S.M
QA/QC by: _____ J.E.S
project no.: C18-1140
date: 2020.07.10

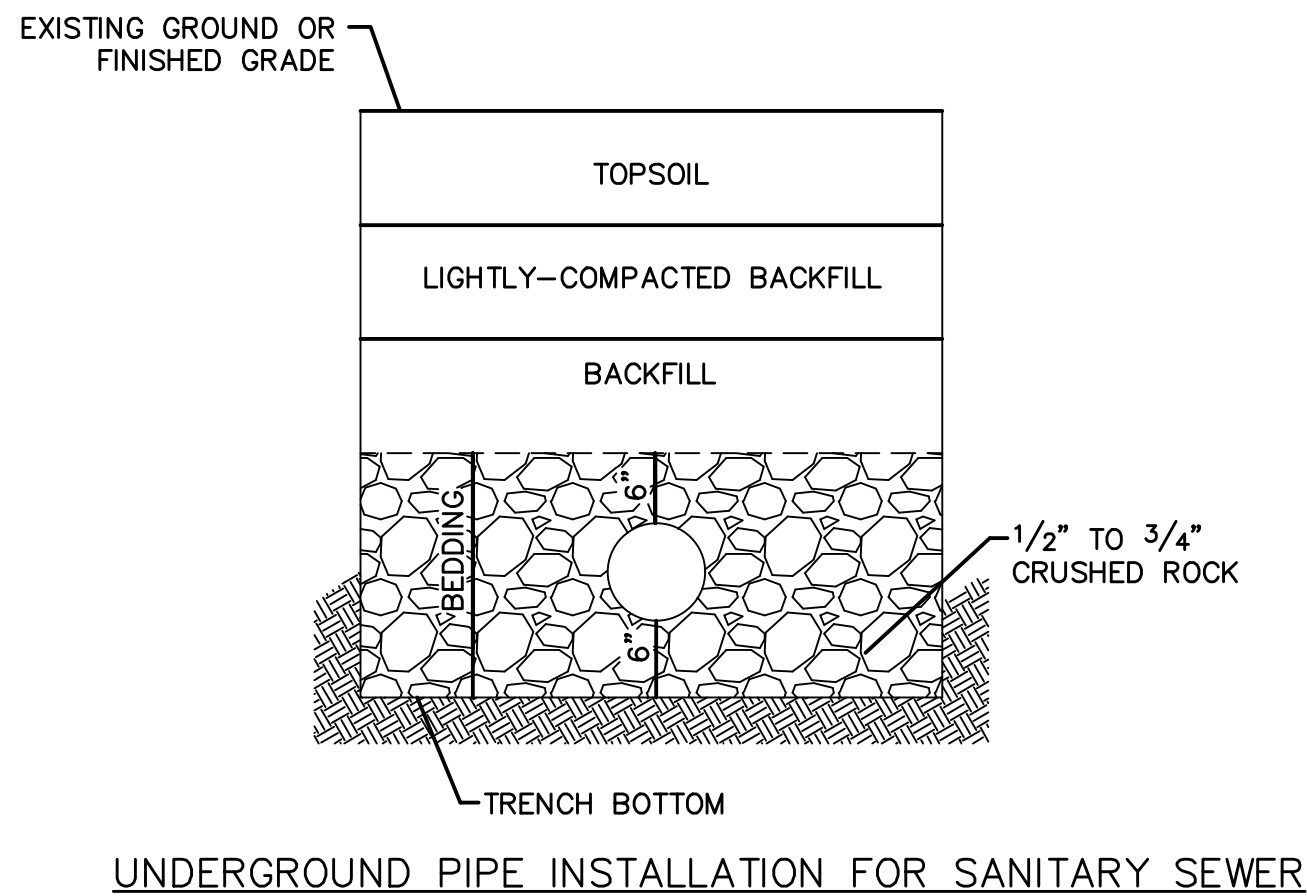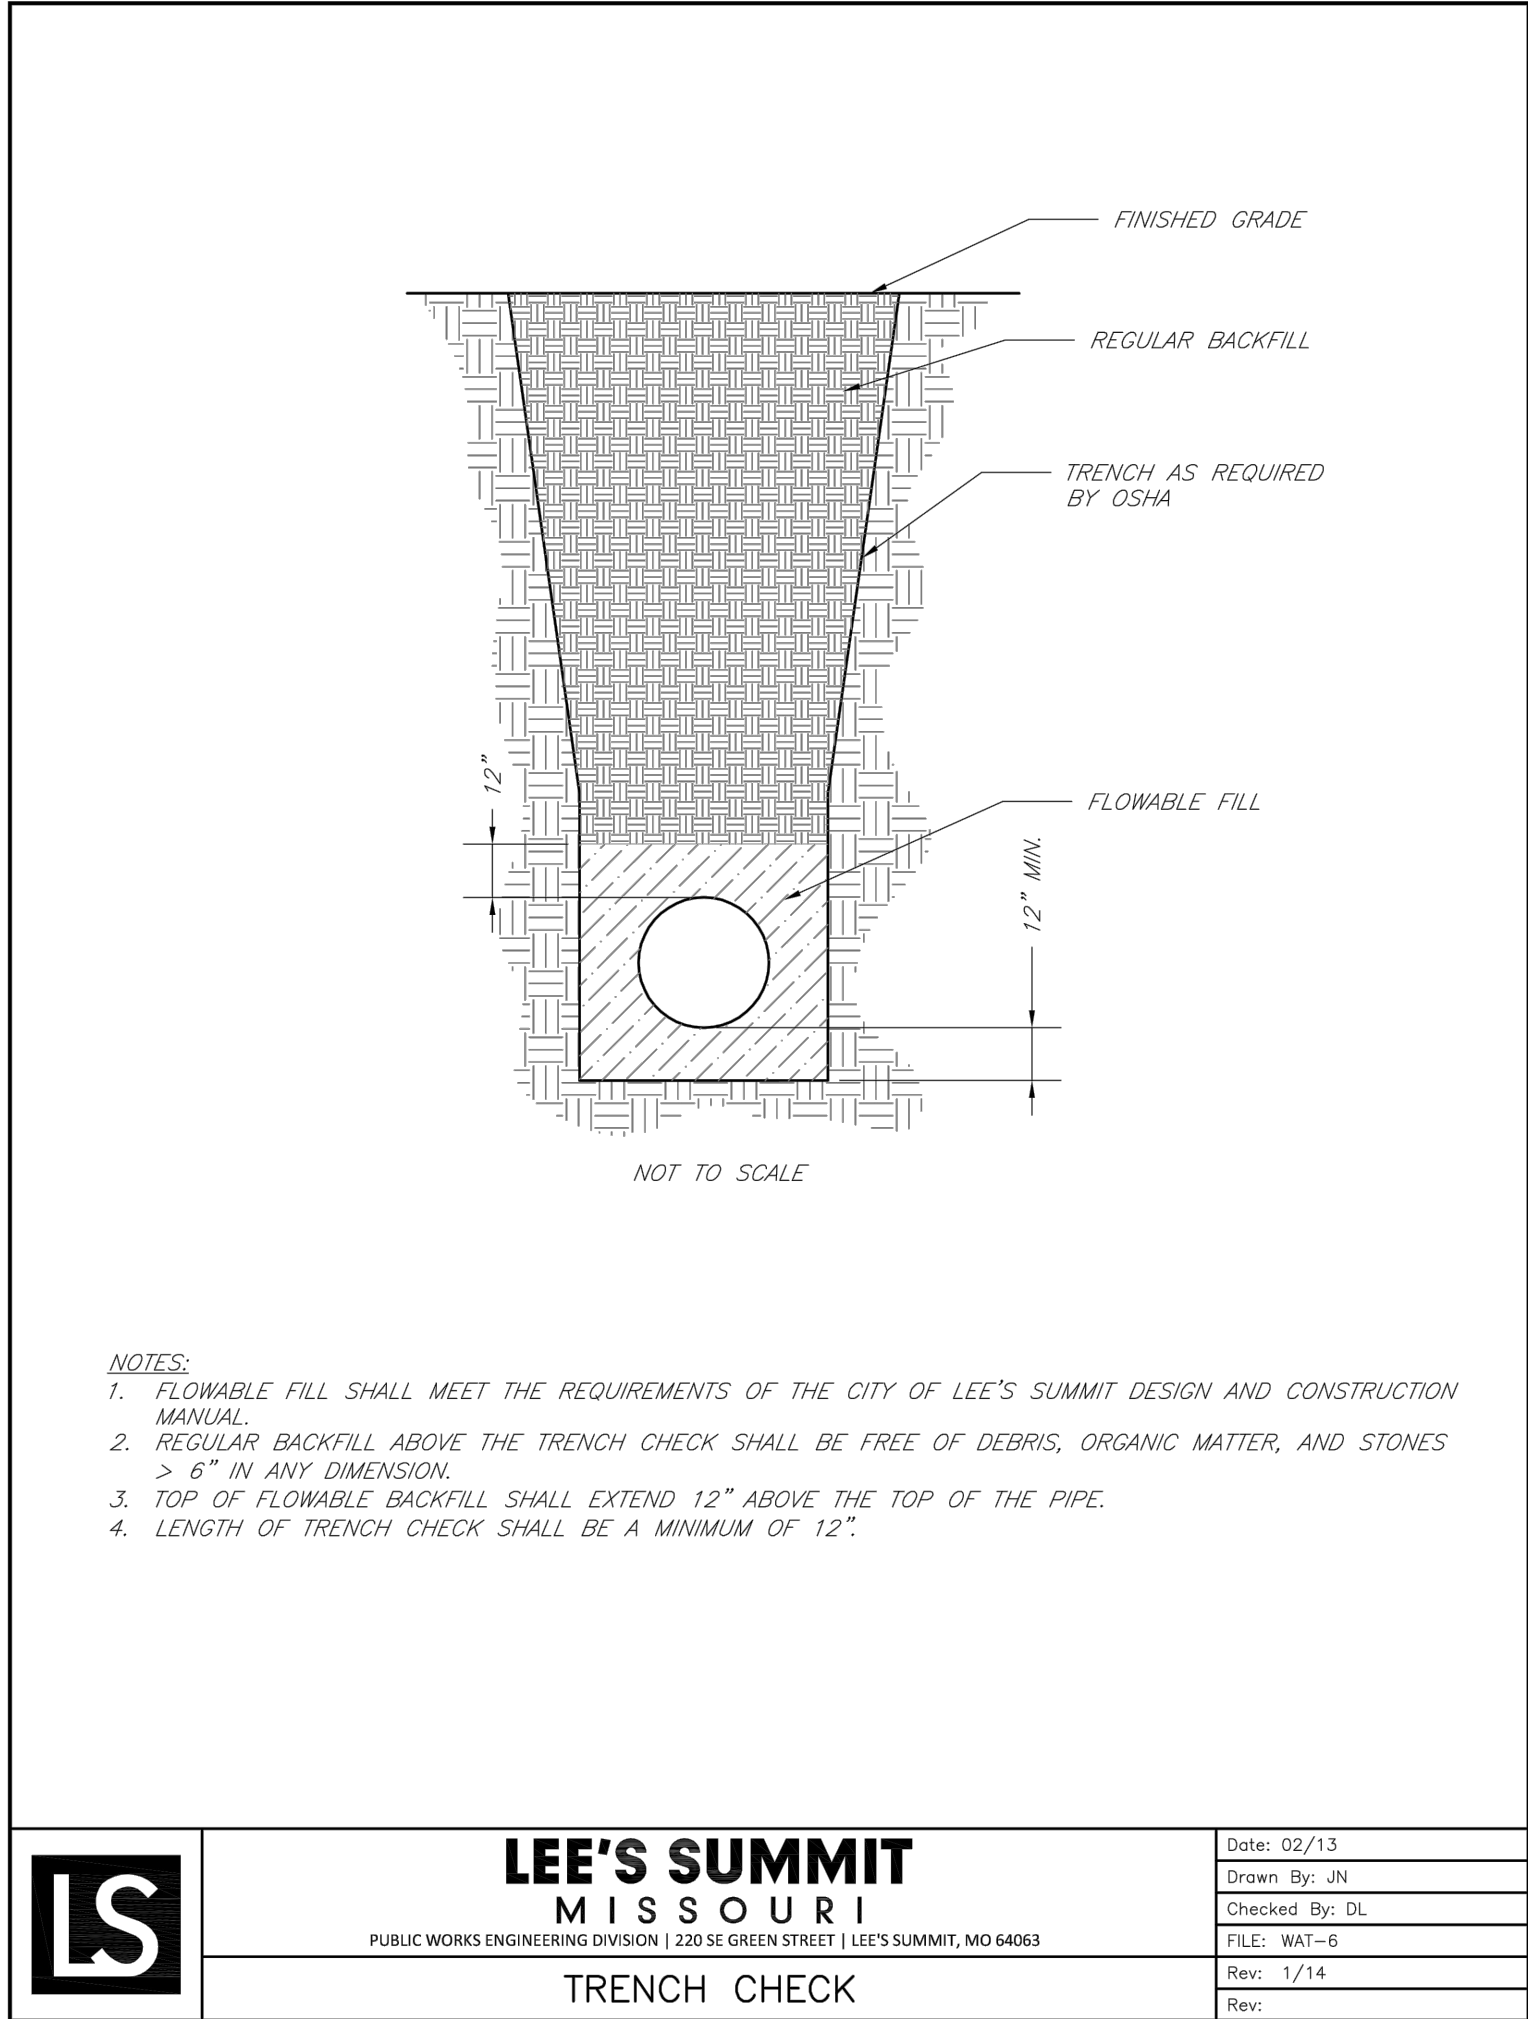

- NOTES:**
1. A MINIMUM OF 36 INCHES OF COVER SHALL BE OVER THE TOP OF THE PIPE. THIS MINIMUM OF COVER SHALL BE FROM THE TOP OF PIPE TO THE FINISHED GRADE.
 2. BEDDING AGGREGATE SHALL BE PLACED FROM A LEVEL 6 INCHES BELOW THE BOTTOM OF THE PIPE TO A LEVEL 6 INCHES ABOVE THE TOP OF THE PIPE.
 3. TRENCH BACKFILL IN PAVED AREAS WITHIN STREET OR ALLEY RIGHT OF WAYS
 - a. NARROW TRENCH: SUITABLE BACKFILL MATERIAL FOR TRENCHES 24 INCHES OR LESS IN WIDTH AND SHALL BE TYPE A FLOWABLE FILL.
 - b. STANDARD TRENCH: SUITABLE BACKFILL MATERIAL FOR TRENCHES BETWEEN 24 TO 48 INCHES WIDE SHALL BE EITHER TYPE A FLOWABLE FILL OR DENSE, WELL GRADED AGGREGATE BASE MATERIAL. AGGREGATE BASE MATERIAL SHALL MEET THE REQUIREMENTS FOR KDOT AB-3; MODOT TYPES 1 OR 5; OR APWA 2202.2.
 - c. WIDE TRENCH: SUITABLE BACKFILL MATERIAL FOR TRENCHES GREATER THAN 48 INCHES WIDE SHALL BE SUITABLE MATERIAL AS SPECIFIED FOR EARTH EMBANKMENT IN APWA STANDARD SPECIFICATIONS, SECTION 2102.2.C.
 4. SUITABLE BACKFILL MATERIAL OUTSIDE OF PAVED AREAS WITHIN RIGHT OF WAY, AND ALL AREAS OUTSIDE RIGHT OF WAY, MAY BE SUITABLE MATERIAL AS SPECIFIED FOR EARTH EMBANKMENT IN APWA STANDARD SPECIFICATIONS, SECTION 2102.2.C. SUITABLE BACKFILL MATERIAL MAY ALSO BE OTHER TRENCH BACKFILL MATERIAL (FLOWABLE FILL OR AGGREGATE BASE) DEPENDING ON SITE CONDITIONS, TRENCH WIDTHS OR AT THE DIRECTION OF THE CITY'S ON SITE INSPECTOR.

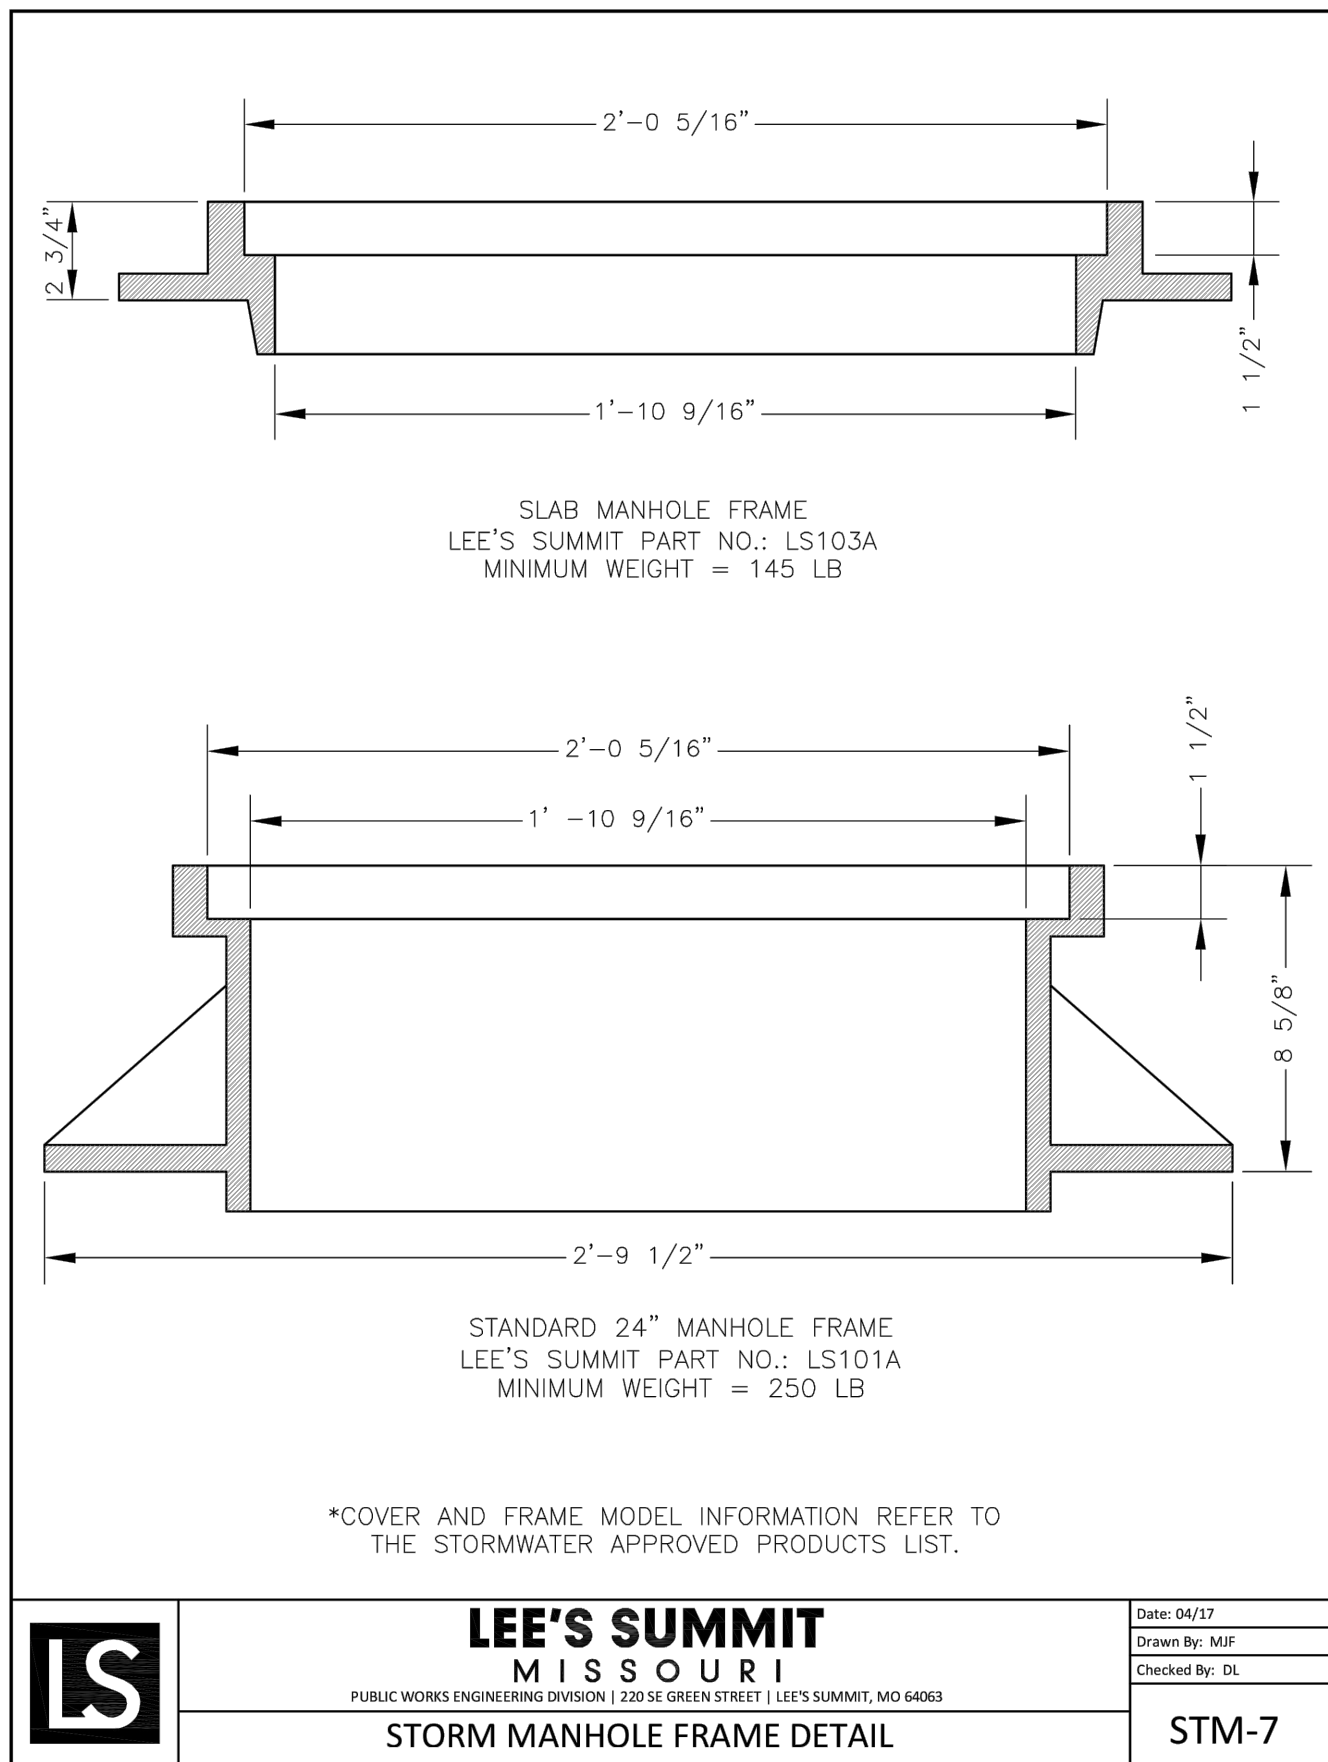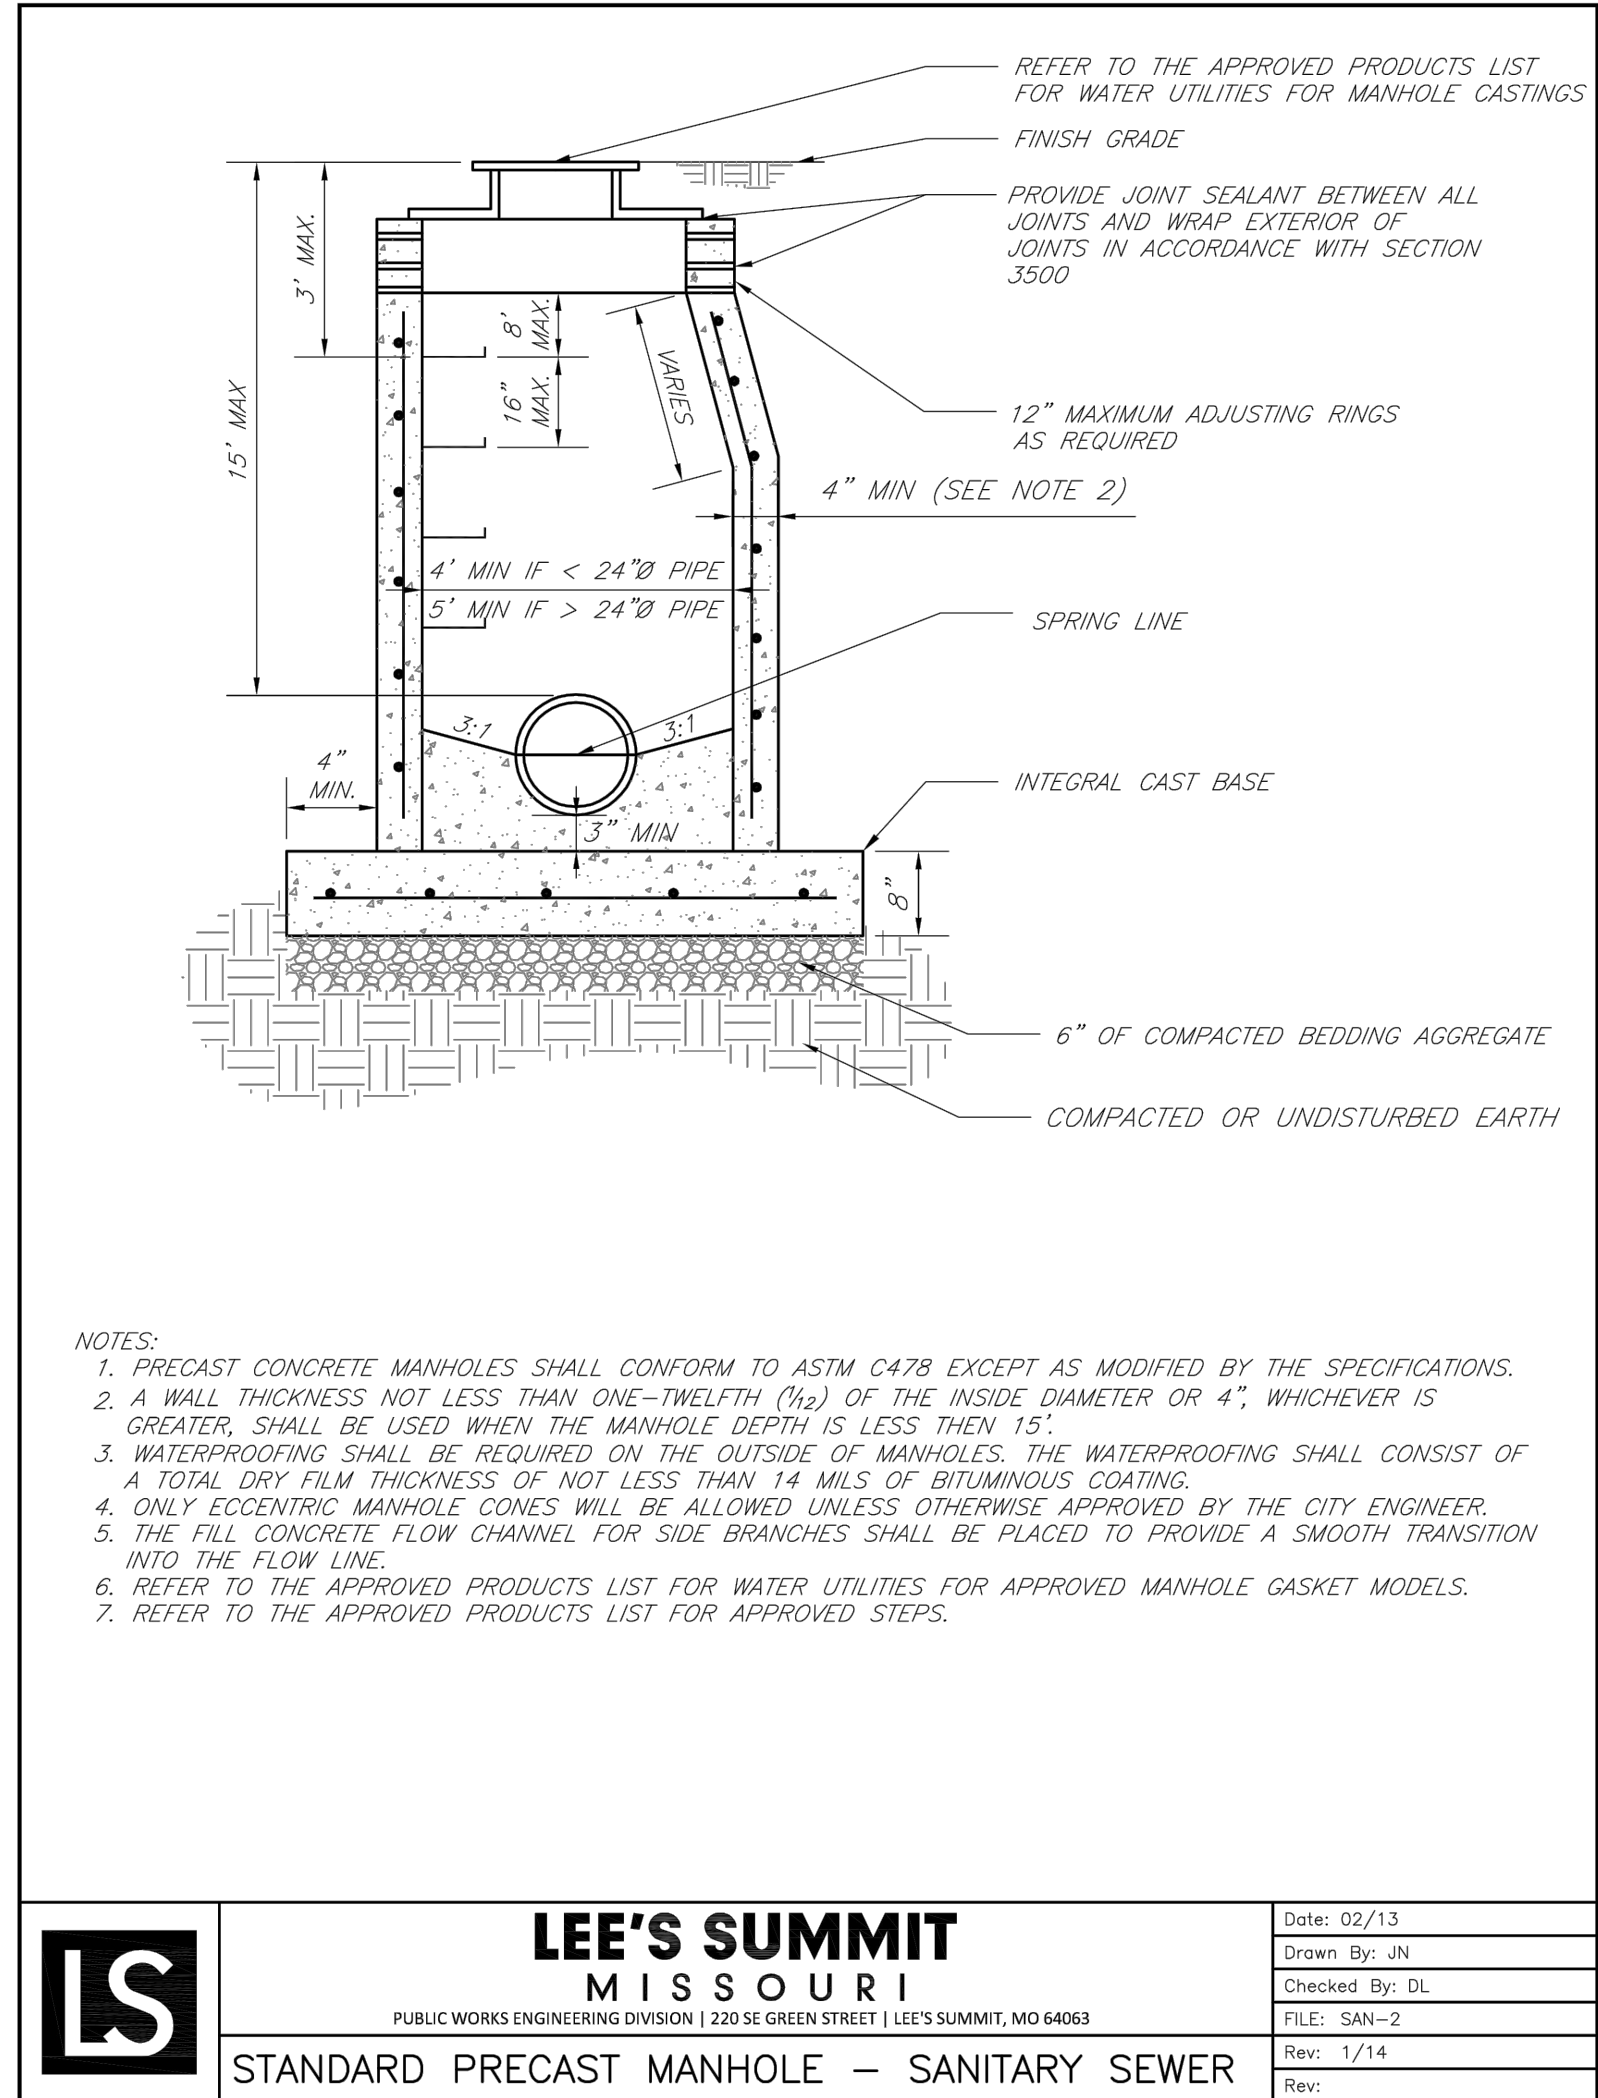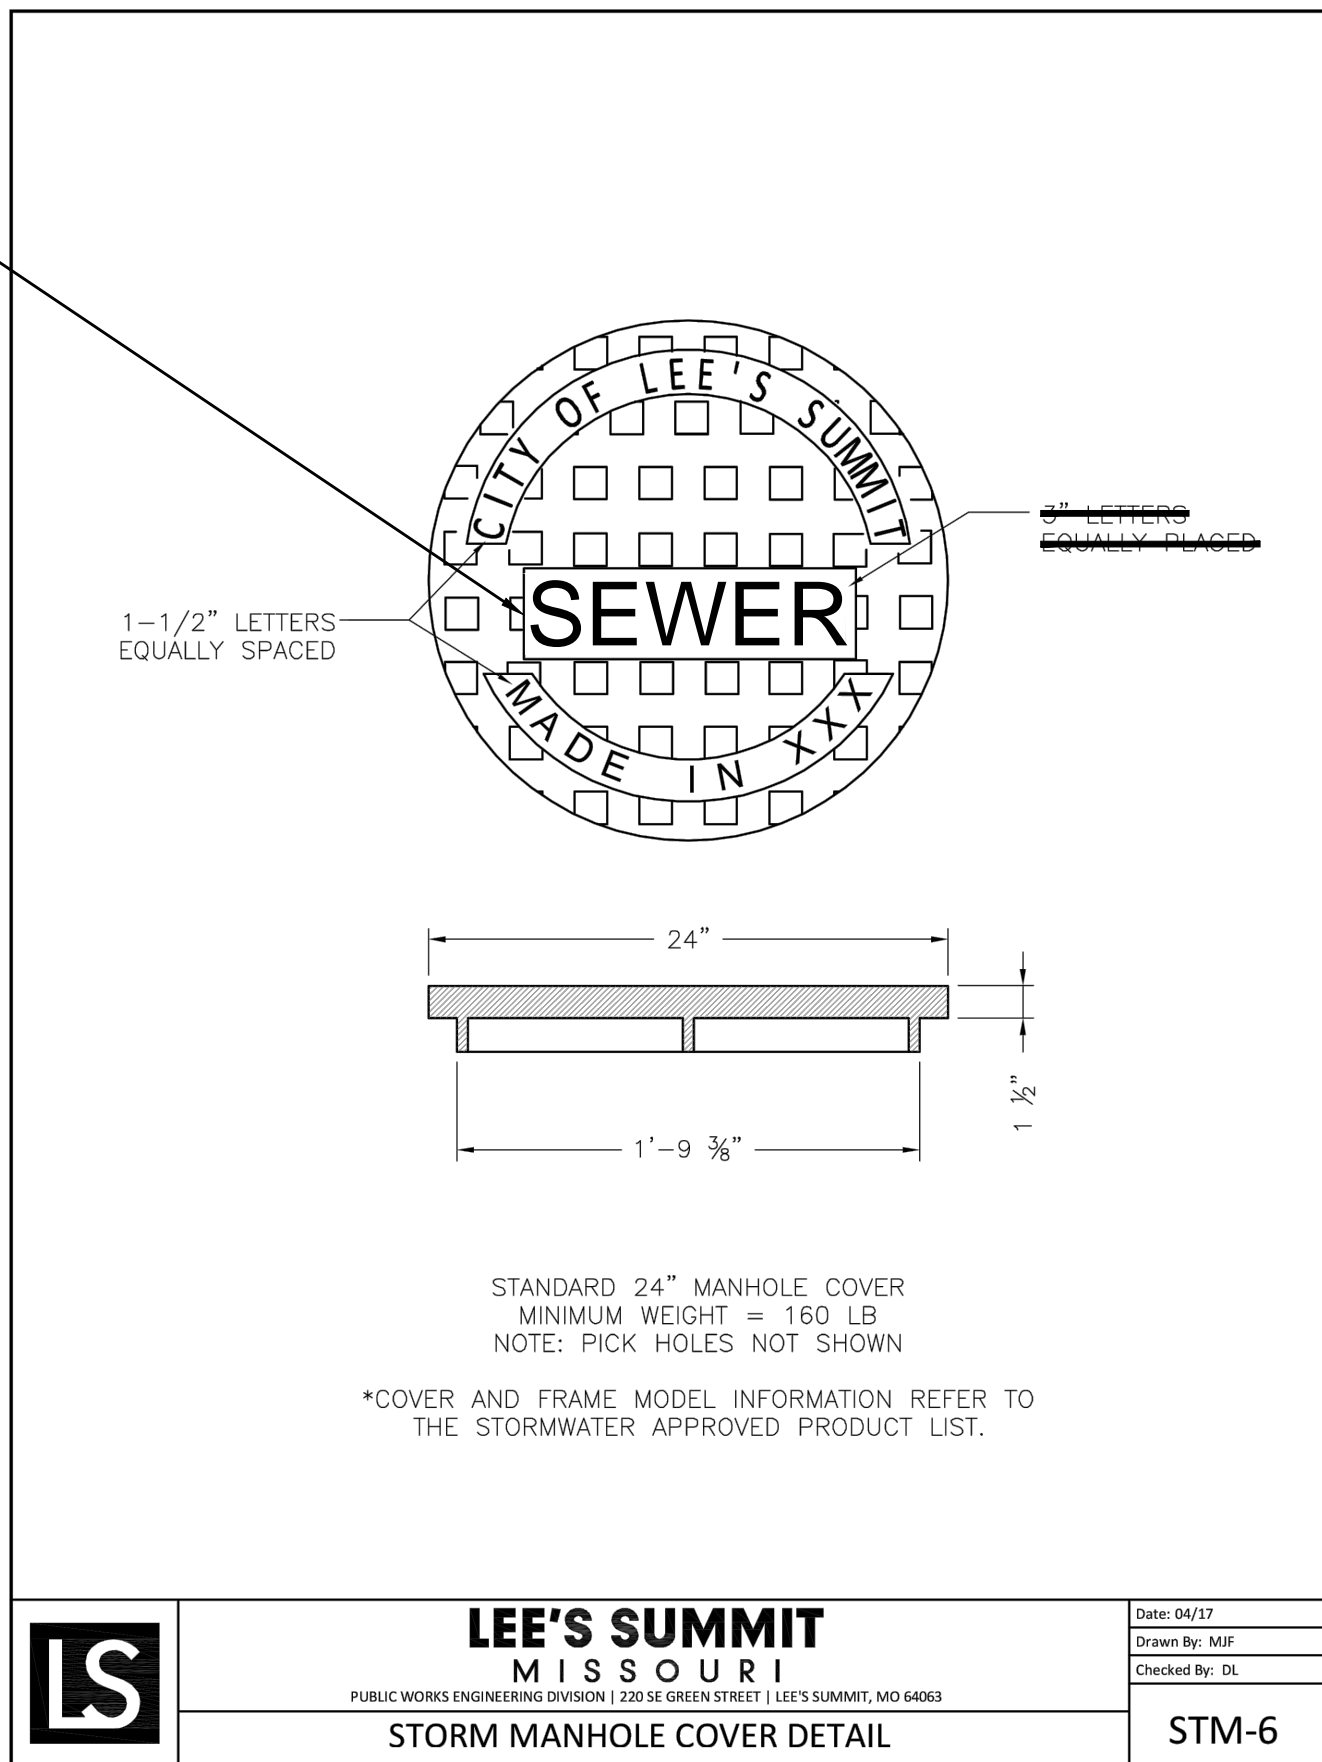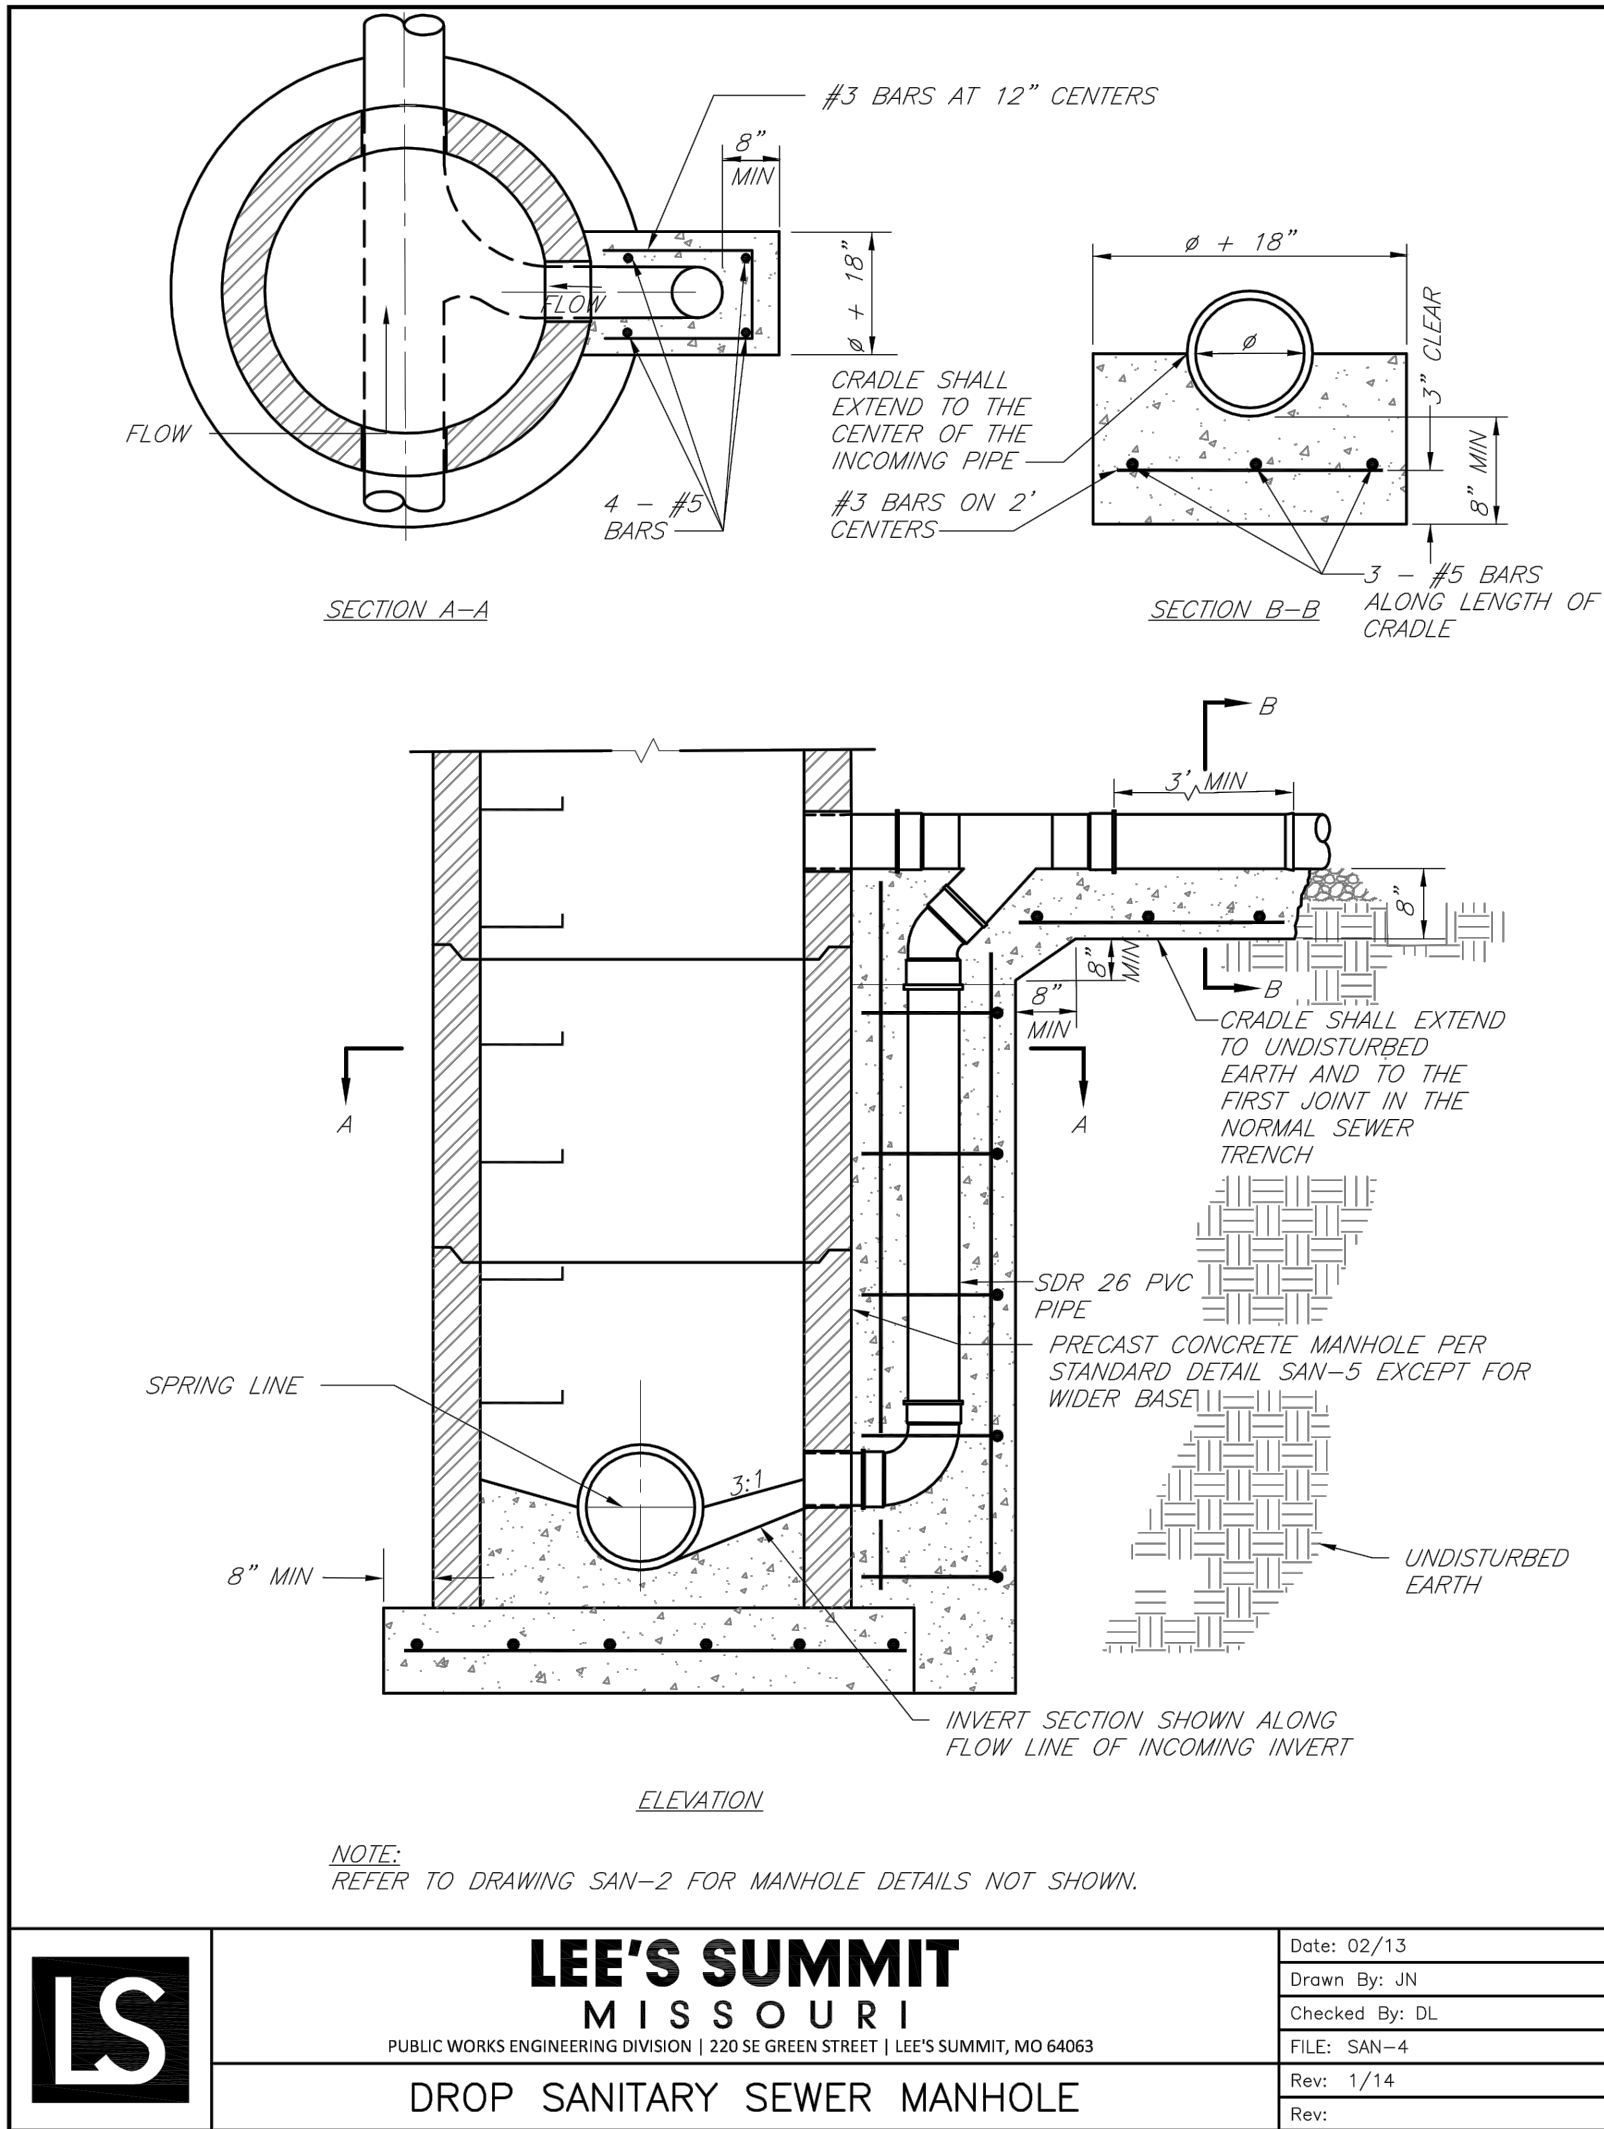

olsson

NO. 0011001 of Architects at 1011922
303 E. BURLINGTON SUITE 100
NORTH KANSAS CITY, MO 64116
TEL 816.951.1177
www.olsson.com

STATE OF MISSOURI
JULIE ELAINE SELLERS
Professional Engineer
NUMBER PE-2017000367
3/24/22

BY
REVISIONS DESCRIPTION
NO. REV. DATE REVISED PER CITY COMMENTS
1 07/10/2020
DETAILS SHEET
SANITARY SEWER PLANS
WOODSIDE RIDGE
SEWER SIDEPEAK
LEE'S SUMMIT, MO
2020

drawn by: C.S.M.
checked by: S.M.S.
designed by: C.S.M.
QA/QC by: J.E.S.
project no.: C18-1140
date: 2020.07.10

SHEET
C212

