Lee's Summit Medical Center, MOB

INFUSION CENTER

1980 SE Blue Parkway, Suite 2302, Lee's Summit, MO 64063

GENERAL NOTES


- MAINTAIN ACCESS TO EXISTING WALKWAYS, CORRIDORS, AND OTHER ADJACENT OCCUPIED OR USED FACILITIES. DO NOT CLOSE OR OBSTRUCT WALKWAYS, CORRIDORS, OR OTHER OCCUPIED OR USED FACILITIES WITHOUT PERMISSION FROM OWNER.
- 2. DEFINITIONS:
- **2**.1. REMOVE AND DISCARD: DETACH ITEMS FROM EXISTING CONSTRUCTION ND LEGALLY DISPOSE OF THEM OFF-SITE. 2.2. REMOVE AND SALVAGE: DETACH ITEMS FROM EXISTING CONSTRUCTION
- ND TURN OVER TO OWNER UNDAMAGED. RELOCATE: DETACH ITEMS FROM EXISTING CONSTRUCTION, MOVE ITEMS 2.3.
- TACT AND UNDAMAGED, AND REINSTALL THEM WHERE INDICATED. EXISTING TO REMAIN: EXISTING ITEMS OF CONSTRUCTION THAT ARE NOT 2.4.
- O BE REMOVED, BUT ARE TO REMAIN IN PLACE AND BE UNDAMAGED. 2.5. REMOVE AND RECLAIM: DETACH ITEMS FROM EXISTING CONSTRUCTION. AT CONTRACTORS OPTION ITEM MAY BE REUSED AS PART OF NEW WORK IT SHALL BE THE CONTRACTORS RESPONSIBILITY TO INVENTORY ITEMS TO DETERMINE IF ITEMS WILL FUNCTION AND APPEAR LIKE THE NEW ITEMS SPECIFIED AND CALLED OUT ON THESE DOCUMENTS. IF ITEMS ARE REUSED, CONTRACTOR IS TO CLEAN, REPAIR, OR OTHERWISE BRING ITEMS TO LIKE NEW CONDITION. MODIFY REUSED ITEMS AS REQUIRED AND SUPPLEMENT WITH MATERIALS, AND INCIDENTALS NECESSARY TO EXECUTE A COMPLETE WORKMANLIKE JOB. IF CONTRACTOR CHOOSES TO NOT REUSE ITEM, LEGALLY DISPOSE OF ITEM OFF-SITE AND REPLACE WITH NEW TO MATCH EXISTING.
- 2.6. PROVIDE: THE MEANING OF THE WORD "PROVIDED" INCLUDES, BUT IS NOT LIMITED TO, FURNISHED, DELIVERED, INSTALLED, FINISHED, MADE FULLY OPERABLE AND COMPLETE. UNLESS SPECIFICALLY NOTED OTHERWISE, ALL WORK DESCRIBED IN THESE DOCUMENTS IS TO BE PROVIDED BY THE CONTRACTOR.
- CONTRACTOR IS TO INCLUDE AS PART OF HIS SCOPE ALL CUTTING AND PATCHING REQUIRED THROUGH CAREFUL EVALUATION OF THE EXISTING SITE AND THE CONSTRUCTION DOCUMENTS. CONTRACTOR SHALL COORDINATE THE CUTTING AND PATCHING OF EXISTING CONSTRUCTION NECESSARY TO PERMIT INSTALLATION OR PERFORMANCE OF THE WORK INDICATED IN THESE CONSTRUCTION DOCUMENTS. SAW-CUT CONC. SLAB AS REQUIRED FOR UTILITIES, FOR EQUIPMENT AND SINKS. VERIFY ROUTE AND TRENCH DEPTH IN FIELD. PATCH BACK WITH MATCHING SLAB THICKNESS OVER SAME MATERIAL, COMPACT UNDERLYING MATERIALS TO MEET BEST PRACTICES. DOWEL NEW TO EXISTING WITH #4 REBAR AT 30" OC.
- WHERE WALLS, CASEWORK, FINISHES, EQUIPMENT OR OTHER ITEMS AND CONSTRUCTIONS HAVE BEEN REMOVED EXPOSING UNDERLYING WALL AND/OR FLOOR SURFACES, SUCH SURFACES ARE TO BE PATCHED AND REPAIRED AS REQUIRED TO ACCEPT NEW FINISHES. ALL HOLES, DAMAGES, DEFECTS, ETC. IN EXISTING SURFACES ARE TO BE PATCHED TO MATCH EXISTING CONDITIONS.
- EXISTING CONDITIONS SHOWN ON THESE DRAWINGS ARE BASED UPON BASE BUILDING OR OTHER CONSTRUCTION DOCUMENTS MADE AVAILABLE TO THE DESIGNER BY THE BUILDING MANAGEMENT. ALL AS-BUILT ARCHITECTURAL CONDITIONS HAVE NOT BEEN FIELD VERIFIED AND MAY VARY FROM THOSE SHOWN.
- 6. PRIOR TO BID: FIELD VERIFY ALL EXISTING CONSTRUCTION TO REMAIN AND INCLUDE COSTS FOR REPAIR AND RECONDITION OF ALL EXISTING


CONSTRUCTION TO REMAIN SO THAT IT MEETS THE AESTHETIC AND FUNCTIONAL STANDARD OF QUALITY FOR NEW CONSTRUCTION. BLEND AND MATCH EXISTING CONSTRUCTION WITH NEW CONSTRUCTION PRIOR TO BID, ADVISE TENANT OF ANY CONDITIONS WHICH CANNOT BE REPAIRED OR RECONDITIONED, BLENDED AND MATCHED. NOTE CONTRACT DOCUMENT REQUIREMENTS FOR EXISTING CONSTRUCTION AND INCLUDE COSTS FOR THIS WORK IN BID PROPOSAL.

- THE GENERAL CONTRACTOR SHALL, IN THE BIDDING PROCESS, REQUIRE THAT MECHANICAL AND ELECTRICAL SUBCONTRACTORS MAKE A THOROUGH FIELD INSPECTION OF AS-BUILT CONDITIONS OF EXISTING SYSTEMS. AFTER SUCH FIELD VERIFICATION HAS BEEN COMPLETED, THE GENERAL CONTRACTOR AND SUBCONTRACTORS SHALL PROVIDE IN THEIR BIDS, ANY MODIFICATIONS TO THE EXISTING SYSTEMS WHICH MAY BE REQUIRED TO ACCOMMODATE THE PROPOSED REQUIREMENTS FOR THIS TENANT. IF A DETERMINATION OF SUCH MODIFICATIONS CANNOT BE MADE, THE GENERAL CONTRACTOR SHALL NOTIFY THE TENANT, AND AT THE DIRECTION OF THE TENANT, PROVIDE AN AGREED UPON ALLOWANCE TO COVER SUCH WORK.
- COMMENCING WORK BY A CONTRACTOR OR SUBCONTRACTOR CONSTITUTES ACCEPTANCE OF THE UNDERLYING CONDITIONS AND SURFACES. PRIOR TO PROCEEDING WITH THE WORK, PREPARE EXISTING AND NEW UNDERLYING CONDITIONS AND SUBSTRATE TO COMPLY WITH THE CONTRACT DOCUMENTS, INDUSTRY STANDARDS AND MANUFACTURER'S RECOMMENDATION.
- FIELD VERIFY ALL ROUGH OPENINGS AND WALL WIDTHS PRIOR TO ORDERING OR FABRICATION OF MATERIALS.
- 10. DIMENSIONS ARE NOMINAL AND TO THE FACE OF PARTITIONS
- CLEAN-UP OF RUBBISH AND DEBRIS RESULTING FROM DEMOLITION AND NEW WORK SHALL BE COLLECTED REGULARLY FROM PROJECT SITE AND LEGALLY DISPOSED
- 12. ALL WEATHER EXPOSED SURFACES SHALL HAVE A WEATHER RESISTIVE BARRIER TO PROTECT THE INTERIOR WALL COVERING AND EXTERIOR OPENINGS SHALL BE FLASHED IN SUCH A MANNER AS TO MAKE THEM WEATHERPROOF
- CONTRACTORS ARE RESPONSIBLE FOR ALL MATERIALS AND QUANTITIES SHOWN IN THESE DRAWINGS GRAPHICALLY AS WELL AS THOSE CALLED FOR BY NOTE
- THE CONTRACTOR SHALL OBTAIN ALL NECESSARY PERMITS TO COMPLETE THE PROPOSED WORK AND SHALL COMPLY WITH ALL LOCAL, STATIC, AND FEDERAL REGULATIONS
- 15. THE TENANT OR THE TENANT'S DESIGNATED REPRESENTATIVE WILL PROVIDE SERVICES IN CONNECTION WITH ADMINISTRATION OF THE CONTRACT
- 16. ALL WORK SHALL BE PERFORMED IN ACCORDANCE WITH ALL LOCAL LAWS, ORDINANCES, RULES AND REGULATIONS OF THE GOVERNING AGENCIES HAVING JURISDICTION
- THE CONTRACTOR MUST TAKE ADEQUATE CARE TO PROTECT ALL AREAS OF THE BUILDING WHERE THE WORK OF THIS PROJECT IS LOCATED AS WELL AS

- 18. ONLY BES SHA 19. THE INCL CON
- 20. INST OPE
- TEN/ 22. A CC AT .
- 23. THE REC
- DRA 24. PRO INCL
- TES INST MAT TIME
- WOR 25. PRO REC ARE
- WOR 26. ALL SAT
- FOR, 27. SUBN
- ACC SUBS QUA THE

		CODE NOTES	KEY PLAN
19. 20 21. 22. 23.	THE AREAS ADJACENT TO THE AREA OF THE WORK OF THIS PROJECT SO AS TO PREVENT DAMAGE TO LIFE OR PROPERTY AS A RESULT OF THIS CONSTRUCTION PROJECT ONLY MATERIALS THAT ARE NEW, UNUSED, FREE FROM DEFECTS, AND THE BEST OF THEIR RESPECTIVE KINDS SHALL BE USED. THE BASIS OF QUALITY SHALL BE THE LATEST STANDARDS OF ASTM, ASA OR ASHRA THE CONTRACTOR SHALL COORDINATE HIS WORK WITH ALL OTHER TRADES INCLUDING THOSE OF THE TENANT WHO MAY BE ENGAGED UNDER A SEPARATE CONTRACT INSTALL ALL WORK IN SUCH A MANNER AS TO BE READILY ACCESSIBLE FOR OPERATION, MAINTENANCE AND/OR REPAIRS ALL WORK AND EQUIPMENT SHALL BE CLEANED TO THE SATISFACTION OF THE TENANT BEFORE BEING TURNED OVER FOR USE A COPY OF THE LATEST SET OF CONSTRUCTION DOCUMENTS SHALL BE KEPT AT THE JOB SITE AT ALL TIMES THE CONTRACTOR AND EACH SUBCONTRACTOR SHALL KEEP ACCURATE RECORDS OF ANY MODIFICATION OR DEVIATIONS FROM THE CONTRACT DRAVINGS	 A. TENANT FINISH B. ALL CONSTRUCTION FOR THIS PROJECT SHALL CONFORM TO THE FOLLOWING BUILDING CODES AND REQUIREMENTS ADOPTED AND AS AMENDED BY THE CITY OF LEE'S SUMMIT, MISSOURI; B.1. 2018 International Building Code B.2. 2019 International Plumbing Code B.3. 2019 International Mechanical Code B.4. 2018 International Fuel Gas Code B.5. 2019 International Fuel Gas Code B.6. 2019 International Residential Code B.6. 2019 International Residential Code B.6. 2019 International Fire Code B.7. 2017 National Electrical Code B.8. ICC/ANSI A117.1-2009, Accessible and Usable Buildings and Facilities C. OCCUPANCY GROUP: B D. CONSTRUCTION TYPE: IIB E. FULLY-SPRINKLED FIRE ALARM PROVIDED F. SQUARE FOOTAGE TENANT INFILL = 1,568 SF G. OCCUPANT LOAD = 1,568/150 = 10.45 ≈ 11 OCC H. SPACES WITH ONE EXIT OR EXIT ACCESS DOORWAY (TABLE 1006.2.1): H.1. OCCUPANCY B = MAXIMUM OCCUPANT LOAD 49. H.2. COMMON PATH OF EGRESS TRAVEL IN GROUP B OCCUPANCY WITH SPRINKLER SYSTEM HAS AN OCCUPANT LOAD 0F ±49, THE LENGTH OF COMMON EGRESS TRAVEL SHALL NOT BE MORE THAN 100 FEET. 	AREA OF WO
26	 THE MANAGEMENT IN THE PROPER USE AND MAINTENANCE OF ALL ITEMS OF WORK PROVIDED. PROVIDE WORK IN ACCORDANCE WITH THE MANUFACTURES RECOMMENDATION, EXCEPT IN THE CASE WHERE THE CONTRACT DOCUMENTS ARE MORE STRINGENT. PROVIDE ANY MISCELLANEOUS ITEMS OR MATERIALS NOT SPECIFICALLY NOTED, BUT REQUIRED FOR PROPER INSTALLATION OF THE WORK. ALL WORK SHALL BE WARRANTED BY THE CONTRACTOR TO BE SATISFACTORY, IN MATERIALS AND WORKMANSHIP, FOR A MINIMUM PERIOD OF ON (1) YEAR, OR FOR THE PERIOD OF WARRANTY CUSTOMARY, SPECIFIED FOR, THE TRADE, CRAFT OR PRODUCT, WHICHEVER IS LONGER. SUBMIT REQUESTS FOR SUBSTITUTIONS OF SPECIFIED ITEMS IN WRITING, ACCOMPANIED BY THE ALTERNATIVE PRODUCT INFORMATION, TO THE TENANT. SUBSTITUTIONS MAY BE CONSIDERED ONLY IF THEY DO NOT SACRIFICE QUALITY, APPEARANCE AND FUNCTION. ACCEPTANCE OF SUBSTITUTIONS IS AT THE SOLE DISCRETION OF THE TENANT. 	DRAMING INDEX 63 COVER SHEET, GENERAL NOTES AND CODE NOTES A1 ARCHITECTURAL SPECIFICATIONS A2 FLOOR PLAN AND FINISH SCHEDULE A3 CEILING PLAN, CASEWORK DETAILS AND DOOR SCHEDULE A4 INTERIOR ELEVATIONS, EQUIPMENT AND ACCESSORIES SCHEDULE M1 MECHANICAL AND PLUMBING SPECIFICATIONS AND SYMBOLS M1 MECHANICAL PLAN M2 WATER PLAN M2 WATER PLAN M3 ELECTRICAL SPECIFICATIONS AND SYMBOLS M4 ELECTRICAL LIGHTING PLAN M3 ELECTRICAL SCHEDULES AND DETAILS	

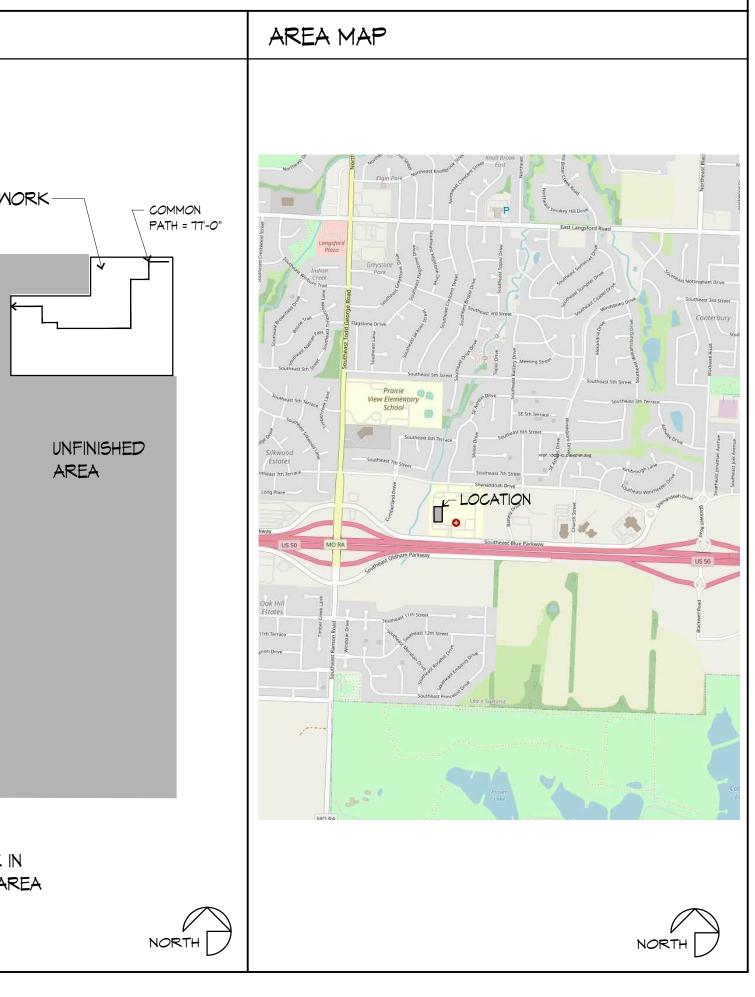

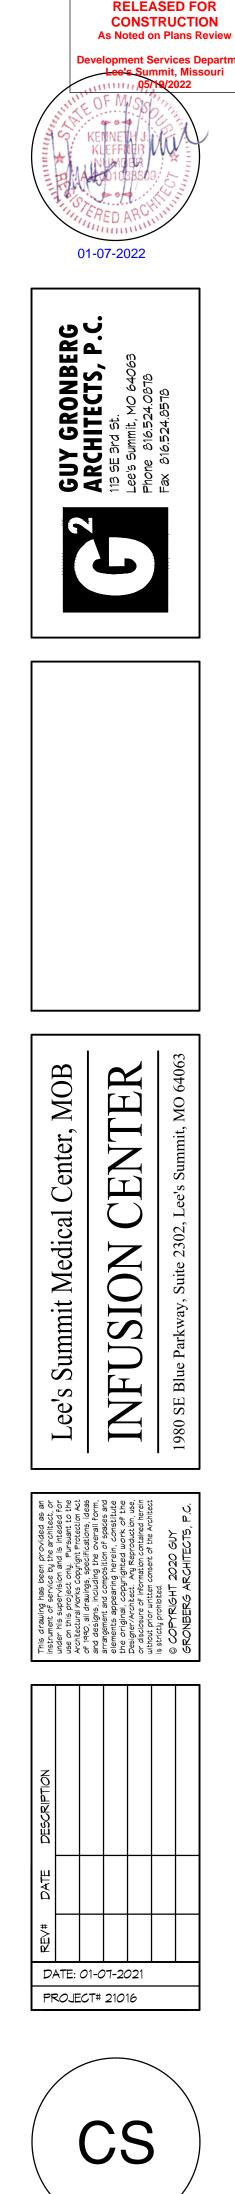

DIVISION 1 - GENERAL REQUIREMENTS

- 1. GENERAL REQUIREMENTS 01000
- 2. The General Conditions of the Contract for Construction of A.I.A. Document A201, latest edition, forms part of this contract as if herein bound.
- 3. Satisfy all applicable local codes and ordinances. Reference the cover sheet for list of codes.
- 4. Contractor to pay for Construction Permit Fees, Excise Tax, Tap Fees, Ect. as applicable to the local Municipalities and Utility Companies.
- 5. Contractor is to meet all Building Owner Standards and Instructions for work.

PRODUCTS 01600

- Where a specific manufacturer's product is named including make or model number or other designation, it has been selected to establish the significant qualities related to type, function, dimension, in-service performance, physical properties, appearance, and other characteristics of the product. Unless otherwise indicated, provided the named product or a product that is equal to or exceeds the specified product.
- 2. Deliver, store, and handle products using means and methods that will prevent damage, deterioration, and loss, including theft. Comply with manufacturer's written instructions.
- 3. Provide products complete with accessories, trim, finish, fasteners, and other items needed for a complete installation and indicated use and effect
- 4. All products, and materials used in conjuction with, are to be installed in strict conformance with manufacturers instruction.

SPECIAL CONDITIONS 01700

- General Contractor shall provide all water, light, and power necessary during construction until the completion of the building. All extensions, controls, and equipment beyond the points of temporary service shall be provided under the work of the respective Division requiring the same.
- 2. The General Contractor shall do all final cleaning of the building construction areas and wash windows.

CUTTING AND PATCHING

- Contractor is to include as part of his scope all cutting and patching required through careful evaluation of the existing site and the construction documents. All holes, damages, defects, ect. in existing surfaces are to be patched to match existing conditions. Contractor shall coordinate the cutting of existing construction necessary to permit installation or performance of other Work.
- 2. Patching: Patch construction by filling, repairing, refinishing, closing up, and similar operations. Patch with durable seams that are as invisible as possible. Use materials identical to existing materials. If identical materials are unavailable or cannot be used, use materials that, when installed. will match the visual and functional performance of existing materials. For exposed surfaces, use materials that visually match existing adjacent surfaces to the fullest extent possible. Before patching, verify compatibility with and suitability of substrates, including compatibility with existing and new finishes or primers.
- Cutting: Cut existing construction by sawing, drilling, breaking, chipping, grinding, and similar operations, including excavation, using methods least likely to damage elements retained or adjoining construction. In general, use hand or small power tools designed for sawing and grinding, not hammering and chopping. Cut holes and slots as small as possible, neatly to size required, and with minimum disturbance of adjacent surfaces. Temporarily cover openings when not in use. Provide temporary support of Work to be cut. Cut concrete using a cutting machine, such as an abrasive saw or a diamond-core drill.

DIVISION 2 - SITE WORK

NO WORK THIS SECTION

DIVISION 3 - CONCRETE

REFER TO CUTTING AND PATCHING

DIVISION 4 - MASONRY

NO WORK THIS SECTION

DIVISION 5 - METALS

METAL STUD FRAMING

- Metal Studs and Runners: shall be as manufactured by Dietrich, Inryco/Milcor, USC, or approved equal. Studs shall be sized as indicated on the drawings and of gauge recommended by the manufacturers literature. Double studs at door jambs shall be 20 gauge minimum. Standard stud spacing at no more than 16" O.C. unless otherwise noted on drawings.
- 2. At all walls indicated to extend to underside of decking provide Dietrich SLP-TRK slotted deflection track. Install and finish per manufacturer's recommendations.

DIVISION 6 - WOODS AND PLASTIC

CARPENTRY

UBC and/or FHA requirements whichever is most restrictive.

DIVISION 7 - THERMAL AND MOISTURE PROTECTION

INSULATION

3. Insulation Schedule

- match cavity depth
- 3.2. stainable.
- AcoustaTherm Batts

SEALANTS

- growth.
- and to provide a smooth, neat appearing surface.
- perimeters and flashing

DIVISION 8 - DOORS AND WINDOWS

STEEL FRAMES AND DOORS 08110

- maintain proper alignment.
- spreader bars.
- A250.10. The primer coat is to be a preparatory base for necessary finish painting.
- are to be provided per strike jamb and two for double swing heads.
- closer/pulls as indicated by hardware schedule) is to be 12 gage steel channel.

WOOD DOORS

stain color with interior designer.

FINISH HARDWARE

requirements for hardware.

Each piece of framing lumber shall be identified by the grademark of an approved inspection agency or association. Wood framing and all rough carpentry items shall be installed in accordance with

Where insulating materials listed below will not be covered with gypsum board substitute specified insulation w/ product of same thickness and R-value and similar facing, but such shall have a flame spread rating of 25 or less and a smoke developed rating of 50 or less when tested in accordance with ASTM E84 unless more stringent requirements are listed for a specific product.

2. Interior insulation shall be unfaced acoustical batt insulation in thickness to fill entire cavity.

3.1. Exterior Walls: batts of fiberglass with foil skrim kraft (FSK) vapor barrier in thickness to

Gaps and voids around door and window areas and in built up wood lintels: Minimal expanding foam insulation shall be Dow Chemical Great Stuff. It is to be Tack free in 20 minutes and with full cure in 8 hours at room temperature and 50% relative humidity. It is to be paintable and

3.3. Interior non-loadbearing walls: Unfaced Fiberglass Batts - Certainteed CertaPRO

Mildew-Resistant Silicone Rubber Sealant: Silicone rubber-based, one part elastomeric sealant. complying with FS TT-S-0021543, Class A; compounded specifically for mildew resistance and recommended by manufacturer for interior joints in wet areas; passing ANSI A136.1 test for mold

2. Silicone Sealant: One-part nonacid-curing silicone sealant complying with ASTM C920; Type S, Grade NS, Class 25, paintable, for uses at casings, window casings and hollow metal to drywall and masonry.

3. Joints and spaces to be caulked shall be clean, dry and free of dust, loose mortar or other foreign materials. After joints have been filled, they shall be neatly tooled to eliminate air pockets or voids

4. Non-Elastomeric Sealants and Caulking Compounds: 1-component acrulic sealant: FS-TT-S-00230. Class B, Type 11, solvent based solids 95% acrylic for uses at exterior window and door frame

1. Drywall frames shall be manufactured from cold-rolled 16 gauge steel conforming to ASTM A366 or A620 & A568. Frames shall be knock-down, double return back bend (to prevent cutting into wall) flush hairline miter at the corner of the head and jamb, and the corner reinforced with a concealed clip. Each jamb is to have one compression anchor to securely hold the frame between the studs and

2. Welded Frames are to be fabricated of either cold-rolled steel conforming to ASTM ASTM A366 or A620 & A568 at interior locations or hot-dipped galvanized steel conforming to ASTM A924 and A653 at exterior locations both of 16 gauge material. Fabricate frames with mitered or coped and continuously welded corners and seamless face joints. Provide welded frames with temporary

3. All Frames and Doors are to be thoroughly degreased and cleaned of all imperfections and provided with one coat of oven-cured neutral color primer paint. Primer coat shall conform with ANSI

4. Frame Hardware Provisions: Frames are to be mortised, reinforced and drilled and tapped for all mortise finish hardware. Frames are to be reinforced only for surface mounted hardware, with drilling and tapping to be done in the field by the installation contractor. Steel plates and mortising boxes are to be welded to all hinge and lock reinforcement. Frames are handed. Hinge jambs are to be mortised for hinges with 7 gage steel hinge reinforcement welded in place and drilled and tapped for fasteners in accordance with ANSI A156.7. The strike jamb is to be prepared for 4-7/8" universal strike in accordance with ANSI A 115.1 \$2. Additional hardware reinforcement (e.g. closer/holder as indicated by hardware schedule) is to be 12 gage minimum steel welded in place. Three door mutes

5. Door Hardware Provisions: Hinge preparations are handed. Hinge edges are to be mortised for hinges with 7 gage steel hinge reinforcements welded inside the door edge and drilled and tapped for fasteners in accordance with ANSI A156.7. The lock edge is to have a standard bevel (1:16) and be prepared for locks in accordance with hardware schedule. Additional hardware reinforcement (e.g.

Single swing interior doors shall be solid core premium grade laminate with matching edges. Perma-Clad doors by VT industries, Inc. Comply with requirements of ANSI/NWMA I.S. 1 and Section 1400 of AWI "Architectural Woodwork Quality Standards" except as otherwise indicated. Coordinate

Provide finish hardware for all doors in project. The Contractor shall verify all keying requirements with owner prior to installation. Finish to be 26d. Hardware mounting heights by the door and hardware institute "Recommended Locations for Builders Hardware". Comply with all ADA

DIVISION 9 - FINISHES

GYPSUM DRYWALL

- Materials shall meet the following standards:
- a. Gypsum Wallboard ASTM C36 b. Nails - ASTM C380
- c. Metal Accessories ASA A97.1
- d. Water Resistant Gypsum Backing Board ASTM C1278 (paragraph 6.1)
- 2. Use gupsum board fasteners that are recommended by gupsum board manufacturer except as otherwise indicated.
- 3. Furnish and install all trim accessories, adhesives and joint treatments per manufacturer's recommendations.
- 4. All gypsum board to be finished to Level 4 unless noted otherwise.
- 5. Schedule: (basis of design)
- 5.1. Interior partitions general: USG $\frac{5}{6}$ " Sheetrock Brand Firecode X Panels, long edges tapered. Interior ceilings and soffits: USG $\frac{5}{6}$ " Sheetrock Brand Firecode X Panels, long edges tapered. 5.2. Interior partitions in wet areas/toilet rooms: USG 5/8" Sheetrock Brand Glass-Mat Panels Mold 5.3.
- Tough Firecode X, long edges tapered. Interior partitions to recieve wall tile: USG $\frac{5}{6}$ " Fiberock Brand Aqua-Tough AR Interior Panels 5.4.

FLOORING GENERAL

- Patch, level and prepare all floors as recommended by flooring manufacturer for each type of flooring to be placed. Use trowelable leveling and patching compound to fill cracks, holes, and depressions in substrates. Trowelable Leveling and Patching Compounds shall be of Latex-modified, portland cement based or blended hydraulic cement based formulation provided or approved by floor covering manufacturer for applications indicated.
- 2. Transitions between floor finishes: Floor finishes are to be tightly butted together (unless edge protection is specified or is required by the manufacturer.) At all transitions where finished floor height of a flooring is higher then adjacent floor finish, raise adjacent flooring with ROPPE SUBLEVELER TS-1 so finish heights are equal. Where flooring is to be tightly butted against ceramic or porcelain tile in addition to subleveler installation beneath the thinner floor material, edge protection is to be provided on tile as indicated in the finish legend.

PAINTING GENERAL

1. Paint shall be as manufactured by Sherwin Williams Paints or approved equal.

SURFACE PREPARATION FOR PAINT

- General: Protect adjacent and underlying surfaces. Remove or mask electrical plates, hardware, light fixture trim, escutcheons, and fittings prior to preparing surfaces of finishing. Correct defects and clean surfaces capable of affecting work of this section. Seal marks that may bleed through surface finishes with compatible sealer.
- 2. Galvanized Steel: Remove surface contamination and oils and wash with solvent.
- 3. Uncoated Ferrous Metals: Remove grease, mill scale weld splatter, dirt and rust. Where heavy coatings of scale are evident, remove by hand or power tool wire brushing or sandblasting: wash with solvent. Apply treatment of phosphoric acid solution, ensuring weld joints, bolts and nuts are similarly cleaned. Spot Prime paint after repairs.
- 4. Shop primed ferrous Metals: Sand and scrape to remove loose primer and rust. Feather edges to make patches inconspicuous. Clean with solvent. Prime bare steel surfaces.
- 5. Other existing Surfaces: Remove loose, flaking, powdery, and peeling paints. Light sand painted surfaces. Fill holes, cracks, depressions and other imperfections with compatible patching compound; sand flush with surface. Remove oil, grease, and wax by scraping; solvent wash and thoroughly rinse. Remove rust by wire brushing to expose base metal.

PAINTING SCHEDULE

- 1. Paint all new interior gupsum board walls:
- 1.1. 1 ct. PrepRite 200 Latex Primer and 1.2. 2 cts. ProMar 200 Int. Latex Eg-Shel
- 2. Paint all new and exisiting interior gypsum board walls in wet areas (Toilet and Janitor Rooms): 2.1. 1 ct. PrepRite 200 Latex Primer and
- 2.2. 2 cts. Waterbased Catalyzed Epoxy
- 3. Interior gypsum board ceilings and soffits (unless noted otherwise):
- 3.1. 1 ct. PrepRite 200 Latex Primer
- 3.2. 2 cts. ProMar 200 Int. Latex Flat

4. Interior and Exterior Ferrous metal (metal frames, exposed steel structure, misc. metal): 4.1. Touch up factory prime coat with compatible Metal Primer or

- 4.2. 1 ct. Sprayed All Surface Enamel oil Primer
- 4.3. 2 cts. Sprayed Promar 200 Int. Alkyd Eg-Shel Enamel
- 5. All wood to receive a transparent finish (unless noted otherwise):
- 5.1. 1 ct. General Finishes Pre-Stain Wood Conditioner
- 5.2. Up to 2 cts (to obtain dark color) General Finishes Dye Concentrates 5.3. 1 ct General Finishes Oil Base Wood Stain
- 5.4. 1 ct. General Finishes EF High Performance Polyurethane Top Coat-Satin
- 5.5. Sand between coats using 180 or finer grit sandpaper.
- 5.6. 1 ct. General Finishes EF High Performance Polyurethane Top Coat-Satin

DIVISION 10 - SPECIALTIES

FIRE EXTINGUISHER

Provide fire extinguishers as indicated per plan. Fire extinguisher shall be Cosmic 5E (2A,10B,C) by J.L Industries or approved equal. Cabinets to be Ambassador by J.L Industries or approved equal, Not Fire-Rated, Tub - 10 1/2 x 24 x 5 1/2 inches. Trim Material - Steel, white epoxy primer finish, Trim Style Semi recessed 3" rolled edge. Door Style - Vertical Duo Panel with pull handle, Door Glazing - Clear Safety Glass, with Die Cut Letters - Vertical Red Reverse.

DIVISION 11 - EQUIPMENT

COORDINATE EQUIPMENT INSTALLATION WITH OWNER AND OWNER'S EQUIPMENT SUPPLIER.


DIVISION 12 - FURNISHINGS

CASEWORK


- The General Contractor or his Subcontractor shall provide all necessary work to provide plastic laminate casework at locations indicated on these documents. Work under the contract shall include all labor, materials, and incidentals necessary to execute a complete workmanlike job in accordance with the requirements of all applicable codes and ordinances including the Americans with Disabilities Act Guidelines. The General Contractor or his Subcontractor to review shop drawings with Owner to verify casework layout and dimensions.
- 2. Casework shell units are to be constructed with 3/4" particle board sides and 1/2" particle board backs with plastic laminate on all exterior exposed vertical faces and also on the bottom face of upper wall units. Exposed edges to be .020 polyvinul chloride impact/chip/mar-resistant edges. All interior surfaces on units with doors/drawers to be 85 gram melamine. For open units interiors to have plastic laminate to match exteriors unless noted otherwise. Base cabinets are to be nominal 24" deep. Upper cabinets are to 14" deep O.A. from back of cabinet at wall to face of doors. Full height cabinets are to be 26" deep unless noted otherwise. Full height cabinets are to be constructed with solid center shelf with doors above and below.
- 3. Countertops: Outside corners of all countertops to have $1\frac{1}{2}$ " radius.
- 3.1. Plastic Laminate countertops are to be $1\frac{1}{4}$ " thick with plastic laminate faces and 3mm ($\frac{1}{8}$ ") flexible PVC edges. Backsplashes are to be provided as indicated on the interior elevations, and are to have matching plastic laminate on all exposed faces.
- 3.2. Solid Surface countertops shall be as indicated on Finish Legend. Surfaces of material are to be adhesively joined with inconspicuous seams. Quartz Surfacing shall be as indicated on Finish Legend. Surfaces of material are to be epoxy
- 3.3. joined with inconspicuous seams. 3.4.
- 4. Plastic Laminate Door, Drawer, and False Front Panels to have plastic laminate faces, 85 gram melamine backs, and 3mm(1/8") high impact resistant PVC edges.
- 5. Shelving to be 1" particle board fully adjustable on 1-1/4" centers. Edge to be .020 polyvinyl chloride impact/chip/mar-resistant edge. Shelving inside units with doors to have 85 gram melamine on top and bottom. Shelving of open units are to have plastic laminate to match the exterior.
- 6. Hardware shall be heavy-duty satin chrome. Hinges shall be European concealed heavy duty hinges. All doors over 36" tall to have three hinges. All pulls are to be 4" bent wire pulls, unless otherwise noted. Finish to be 26D. Removable panels are to be secured with Hafele Keku push fit fastners.
- Drawer boxes to be Blum Meta-Box system or Grass UniDrawer (Unless noted otherwise). Slides to have 100 pound load rate. Drawer box depth is to be within 2" of drawer face panel height. Drawers indicated on drawings as FILE are to have white melamine box with KV 8505 slides and Hafele letter width file frame kit.
- 8. Provide one 2" dia standard plastic grommet with hole liner and slotted cover for every three linear feet of countertop that has knee space below. If knee space is less than three feet wide provide two grommets. Also provide one 2" dia standard plastic grommet at each location with power and/or data installed in cabinet. Color as selected by interior designer. Exact locations of grommets to be established and be confirmed by owner prior to installation.
- 9. All particle board is to be of 45-pound density particle board. All plastic laminate is to be General Purpose Type 107 HGS laminate as manufactured by Wilsonart or approved equal.
- 10. Provide fillers to match casework at sides of all casework abutting adjecent vertical surfaces. Also provide filler panels above upper cabinets where distance between upper cabinet and ceiling above is less than 8".







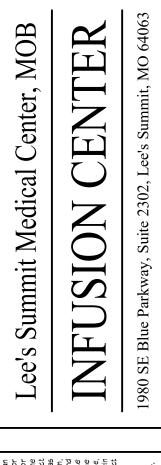




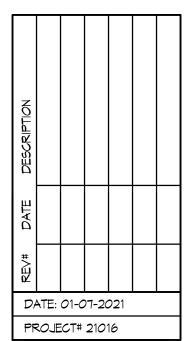

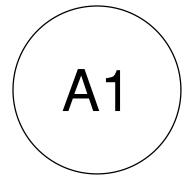

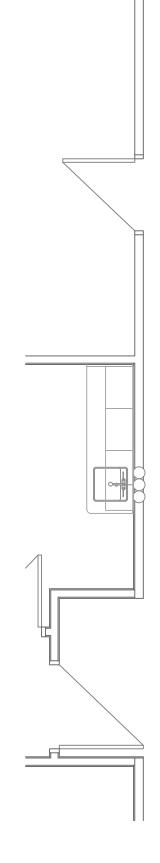

ELECTRICAL LEGEND	WALL PROTECTION	FINIS
\oplus NEW DUPLEX ELECTRICAL RECEPTACLE	CORNER GUARDS 7 CG-1	FLOORING
 NEW DUPLEX ELECTRICAL RECEPTACLE NEW ADATA OUTLET NEW ABOVE COUNTER RECEPTACLE NEW ABOVE COUNTER RECEPTACLE GROUND FAULT CIRCUIT INTERRUPTER DEVICE 	CORNER GUARDE ● C4-1 CORNER GUARDE C/S ACROVIN SEM-20AN-ACROVIN- 4000 PUMICE 1855 2° OD EGREE, ABOVE BASE TO 40° A.F.F. C4-2 CORNER GUARDE C/S ACROVIN SEM-25AN-ACROVIN 4000 PUMICE 1855 2° END MALL, ABOVE BASE TO 40° A.F.F.	FLOORINGLVTMOH.BASEB1B14" Hild DIME GREIPAINT COLONOTE:ALSOPT1PRIM VERIPT2EPOX PT3PT3ACCIPT4DOOCASEWORKL1PL/ FINL2PL/ S52

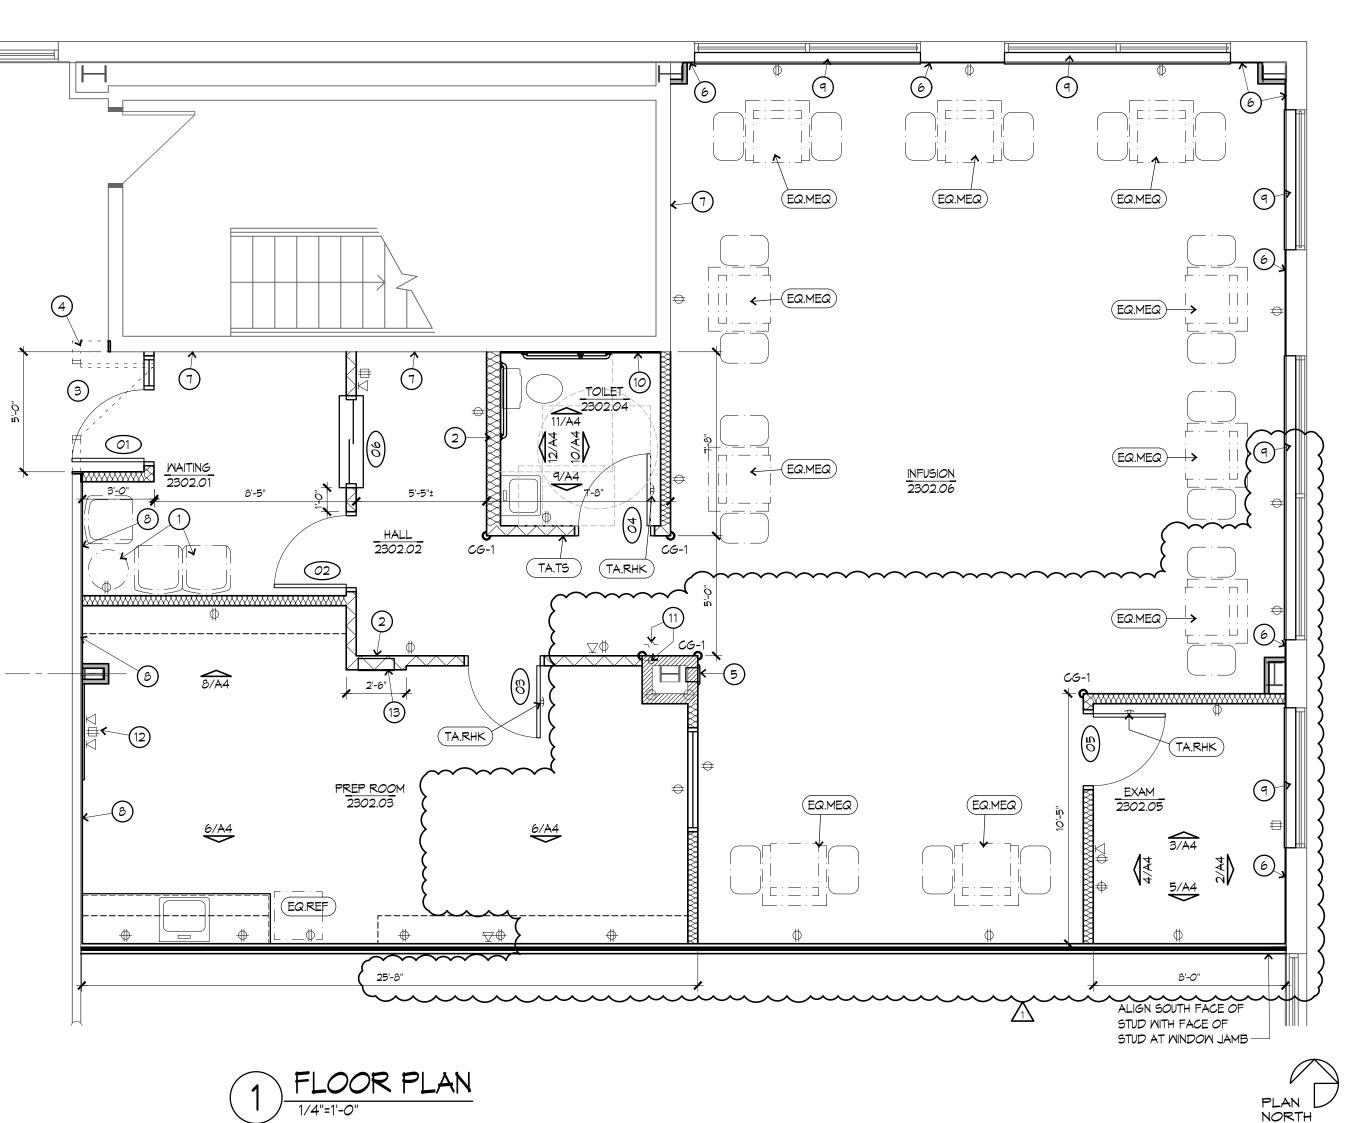

ISH MATERIAL LEGEND

G

DHAWK GROUP URBAN NATIVE WOOD 8"W X 48"L X 2.5MM, 947 YOGA

HIGH, COVED, ROLLED GOODS, TO MEET THE PERFORMANCE AND MENSIONAL REQUIREMENTS OF ASTM F-1861, TYPE TP. MOHAWK 846 REIGE

DLORS

SO REFER TO PAINT SCHEDULE IN SPECIFICATIONS FOR PAINTS.

IMARY FIELD COLOR: SHERWIN WILLIAMS, CUSTOM COLOR RIFY WITH TENANT EBA19-42111975 707531 42/11/28 7-988-9819 8rder# 811255 用的好能到限。 潮湖部隊 四 城區 MATCH 1157世 SAEL-COLAR #2121
 CCEACO_DENNT
 M2
 M2
 S4
 M2

 B1-Blact
 -1
 1
 -</td

EXTRA MADE: \$5-0865383 11911

OXY PAINT - TOILET ROOM COLOR: MATCH PT1

CENT COLOR: SHERWIN WILLIAMS SW7610 TURKISH TILE

OOR FRAME AND WINDOW TRIM COLOR: TO MATCH BUILDING STANDARD

RK AND MILLWORK FINISHES

PLASTIC LAMINATE: WILSONART DOVE GRAY PLASTIC LAMINATE: WILDONAKI, DOVE GRAT

PLASTIC LAMINATE: WILSONART, WHITE CARRARA 4924-38 FINE VELVET

SOLID SURFACE WINDOWS SILLS: MATCH BUILDING STANDARD.

- 1. FINISH MATERIALS LISTED HERE-IN ARE TO ESTABLISH THE SIGNIFICANT QUALITIES RELATED TO TYPE, FUNCTION, DIMENSION, PRICE, PHYSICAL PROPERTIES, APPEARANCE, AND OTHER CHARACTERISTICS OF THE PRODUCT. FINAL SELECTION OF ALL FINISHES ARE TO BE ESTABLISHED AND PROVIDED BY THE INTERIOR DESIGNER.
- 2. PATCH, LEVEL AND PREPARE ALL FLOORS AS RECOMMENDED BY FLOORING MANUFACTURER FOR EACH TYPE OF FLOORING TO BE PLACED. USE TROWELABLE LEVELING AND PATCHING COMPOUND TO FILL CRACKS, HOLES, AND DEPRESSIONS IN SUBSTRATES. TROWELABLE LEVELING AND PATCHING COMPOUNDS SHALL BE OF LATEX-MODIFIED, PORTLAND CEMENT BASED OR BLENDED HYDRAULIC CEMENT BASED FORMULATION PROVIDED OR APPROVED BY FLOOR COVERING MANUFACTURER FOR APPLICATIONS INDICATED.
- 3. TRANSITIONS BETWEEN FLOOR FINISHES:

FINISH GENERAL NOTES

- 3.1. ALL PORCELAIN TILE FLOORING TO HAVE SCHLUTER SCHIEN SATIN ANODIZED ALUMINUM TRIM TO MATCH TILE DEPTH. RAISE ADJACENT FLOORING WITH ROPPE SUBLEVELER TS-1 SO FINISH HEIGHTS ARE EQUAL AND BUTT ADJACENT FLOORING TO TILE TRIM PIECE. 3.2. AT ALL LOCATIONS NOT INDICATED FLOORING MATERIAL IS TO BE TIGHTLY BUTTED TOGETHER AT ALL TRANSITIONS WHERE FINISHED FLOOR HEIGHT OF A FLOORING IS HIGHER THEN ADJACENT FLOOR
- FINISH, RAISE ADJACENT FLOORING WITH ROPPE SUBLEVELER TS-1 SO FINISH HEIGHTS ARE EQUAL.
- 4. IF SUBSTITUTIONS ARE MADE WITH SUPPLIER OF PAINT, SAMPLE TO BE SUBMITTED FOR APPROVAL

	DH SCHEDL			1						
RM. #	ROOM NAME	FLOOR	BASE	MALL						
				NORTH	EAST	SOUTH	WEST			
2302.01	MAITING	LVT	B1	PT3	PT1	PT3	PT1			
2302.02	HALL	LVT	B1	PT1	PT1	PT1	PT1			
2302.03	PREP ROOM	LVT	B1	PT1	PT1	PT1	PT1			
2302.04	TOILET	LVT	B1	PT2	PT2	PT2	PT2			
2302.05	EXAM	LVT	B1	PT1	PT1	PT1	PT3			
2302.06	INFUSION	LVT	B1	PT1	PT1	PT3	PT1			


Ņ	IALL TYPES
1.	FURR-OUT AROUND THE STRUCTURAL COLUMNS AND MECHANICAL CHASES AS REQUIRED. MINIMIZE DEPTH OF FURRING.
2.	PROVIDE SOLID BLOCKING FOR DOORS, WINDOWS, TOILET PARTITION, ACCESSORIES, HANDRAILS, LAVATORY BRACES, CASEWORK, SHELVING ETC. AS REQUIRED BY MANUFACTURER AND ALL WORK DONE BY CARPENTRY AND MILLWORK TRADES. ALL WOOD REQUIRED BY BUILDING CODES SHALL MEET ALL REQUIREMENTS TO THE CODE OF UNDERWRITERS LABORATORIES, INC. VERIFY THE DEPTH OF WALLS PRIOR TO INSTALLING RECESSED FIXTURES.
З.	ALL EXPOSED EDGES AND / OR CORNER ON ALL GYPSUM WALL BOARD CONSTRUCTION SHALL HAVE A METAL CORNER TRIM, TAPED AND SPACKLED.
4.	ALL NEW GYPSUM BOARD PARTITIONS TO BE PROPERLY PREPARED, PATCHED, SPACKLED AND SANDED, ETC., TO PROVIDE A SMOOTH FINISH AND AS REQUIRED TO RECEIVE NEW FINISHES.
5.	ALL OPENINGS IN GYPSUM BOARD PARTITIONS SHALL BE DOUBLE STUDDED.
6.	WHERE INDICATED BY PLAN NOTE #3 PROVIDE 6" STUDS IN LIEU OF SIZED INDICATED BY WALL TYPE.
٦.	IN THE FOLLOWING ROOMS PROVIDE MOISTURE/MOLD RESISTANT GYPSUM BOARD IN LIEU OF THE STANDARD GYPSUM BOARD INDICATED IN WALL TYPES BELOW; TOILET 302.05
	15_{2} " 25 GAUGE MTL. STUDS @ 16" O.C. WITH 5_{2} " GYPSUM BOARD ONE SIDE. EXTEND ALL TO 4" ABOVE DROPPED CEILINGS.
	$3\frac{5}{6}$ " 25 GAUGE MTL. STUDS @ 16" O.C. WITH $\frac{5}{6}$ " GYPSUM BOARD ONE SIDE. EXTEND ALL TO 4" ABOVE DROPPED CEILINGS.
\sum	35%" 25 GAUGE MTL. STUDS @ 16" O.C. WITH 5%" GYPSUM BOARD EACH SIDE AND 3½" R-11 UNFACED ACOUSTICAL BATTS. EXTEND ALL TO 4" ABOVE DROPPED CEILINGS. PROVIDE 45° STUD KICKERS UP TO STRUCTURE AT 4'-0" O.C.
****	3%" 25 GAUGE MTL. STUDS @ 16" O.C. WITH %" GYPSUM BOARD EACH SIDE AND 3½" R-11 UNFACED ACOUSTICAL BATTS. EXTEND ALL TO UNDERSIDE OF ROOF DECK. PROVIDE DEEP LEG DEFLECTION TRACK AT TOP OF WALL INSTALLED PER MANUFACTURER'S INSTRUCTIONS. TAPE AND FINISH FROM FLOOR TO 9'-0" AFF. ABOVE 9'-0"AFF TO UNDERSIDE OF ROOF DECK FIRE TAPE ALL JOINTS AND FASTENERS. PROVIDE ACOUSTICAL SEALANT AT ALL PERIMETERS AND THRU WALL PENETRATIONS.
	3%" 25 GAUGE MTL. STUDS @ 16" O.C. WITH %" GYPSUM BOARD ON TENANT SIDE ONLY AND 3½" R-11 FSK ACOUSTICAL BATTS. EXTEND ALL TO UNDERSIDE OF ROOF DECK. PROVIDE DEEP LEG DEFLECTION TRACK AT TOP OF WALL INSTALLED PER MANUFACTURER'S INSTRUCTIONS. TAPE AND FINISH FROM FLOOR TO 9-0" AFF. ABOVE 9-0"AFF TO UNDERSIDE OF ROOF DECK FIRE TAPE ALL JOINTS AND FASTENERS. PROVIDE ACOUSTICAL SEALANT AT ALL PERIMETERS AND THRU WALL PENETRATIONS.
FL	OOR PLAN NOTES
1	OWNER PROVIDED FURNITURE NOT IN CONTRACT IS INDICATED THUS $- \cdot - \cdot - \cdot - \cdot -$
2	PROVIDE 6" STUDS IN LIEU OF SIZED INDICATED BY WALL TYPE.
3	RELOCATE DOOR AS INDICTED ON DOOR SCHEDULE. REMOVE AND RECLAIM HARDWARE. REMOVE AND SALVAGE FRAME.
4	REMOVE AND DISCARD PORTION OF WALL AND REFRAME AND FINISH WITH GYPSUM BOARD TO PROVIDE NEW OPENING.
5	PROVIDE FIRE EXTINGUISHER AND CABINET PER SPECIFICATION. EXTERIOR WALL HAS EXISTING TO REMAIN GYPSUM BOARD INSTALLED FROM WINDOW SILL HEIGHT TO UNDERSIDE OF ROOF DECK. INSTALL GYPSUM BOARD FROM FLOOR TO WINDOW SILL HEIGHT. TAPE AND FINISH FROM FLOOR TO 9'-0" AFF INCLUDING RETURNS AT JAMBS AND HEADS OF WINDOWS. ABOVE 9'-0"AFF TO UNDERSIDE OF ROOF DECK FIRE TAPE ALL JOINTS AND FASTENERS.


- EXISTING TO REMAIN STAIR WALL HAS GYPSUM BOARD INSTALLED AND HAS BEEN FIRE TAPED EINIGH MALL AS DESIGN FOR THE PARTY OF TH BEEN FIRE TAPED. FINISH WALL AS REQUIRED TO RECEIVE NEW FINISH FROM FLOOR TO 9'-0" AFF.
- B EXISTING TO REMAIN CORRIDOR FRAMING TO HAVE NEW GYPSUM BOARD INSTALLED FROM FLOOR TO UNDERSIDE OF ROOF DECK. TAPE AND FINISH FROM FLOOR TO 9'-0" AFF. ABOVE 9'-0"AFF TO UNDERSIDE OF ROOF DECK FIRE TAPE ALL JOINTS AND FASTENERS. PROVIDE ACOUSTICAL SEALANT AT ALL PERIMETERS AND THRU WALL PENETRATIONS.
- PROVIDE SOLID SURFACE 'SS2' SILL WITH LIP AT WINDOWS TO MATCH
 BUILDING STANDARD BUILDING STANDARD.
- 10 INSTALL AND FINISH WET AREA GYPSUM BOARD OVER EXISTING GYPSUM BOARD AT NORTH WALL OF TOILET ROOM.
- (11) RELOCATE WATER LINE INTO NEW CHASE AT COLUMN.
- (12) PROVIDE 4'-0" x 4'-0" x $\frac{3}{4}$ " SANDEPLY TELEPHONE BACKER BOARD. COORDINATE MOUNTING HEIGHT OF BOARD, POWER AND DATA OUTLETS WITH TENANT.
- (13) FULLY RECESSED ELECTRICAL PANEL







ENTER Center, MOB Medical \bigcirc SION Summit INFU Lee's tor for Act and orm, the the use, use, srein itect nent of service by the architect, his supervision and is intreded this supervision and is intreded this project only. Pursuant to exign works copyright Protection o, all drawings, specifications, id esigns, including the overal fo enent and composition of specifications, id and composition of specifications, of the appearing herein, constitu righnal, copyrighted work of the Archit ty prohibited. 202

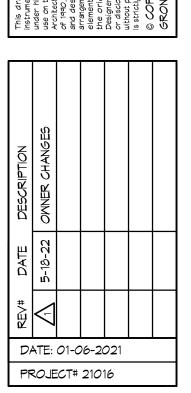

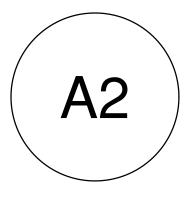

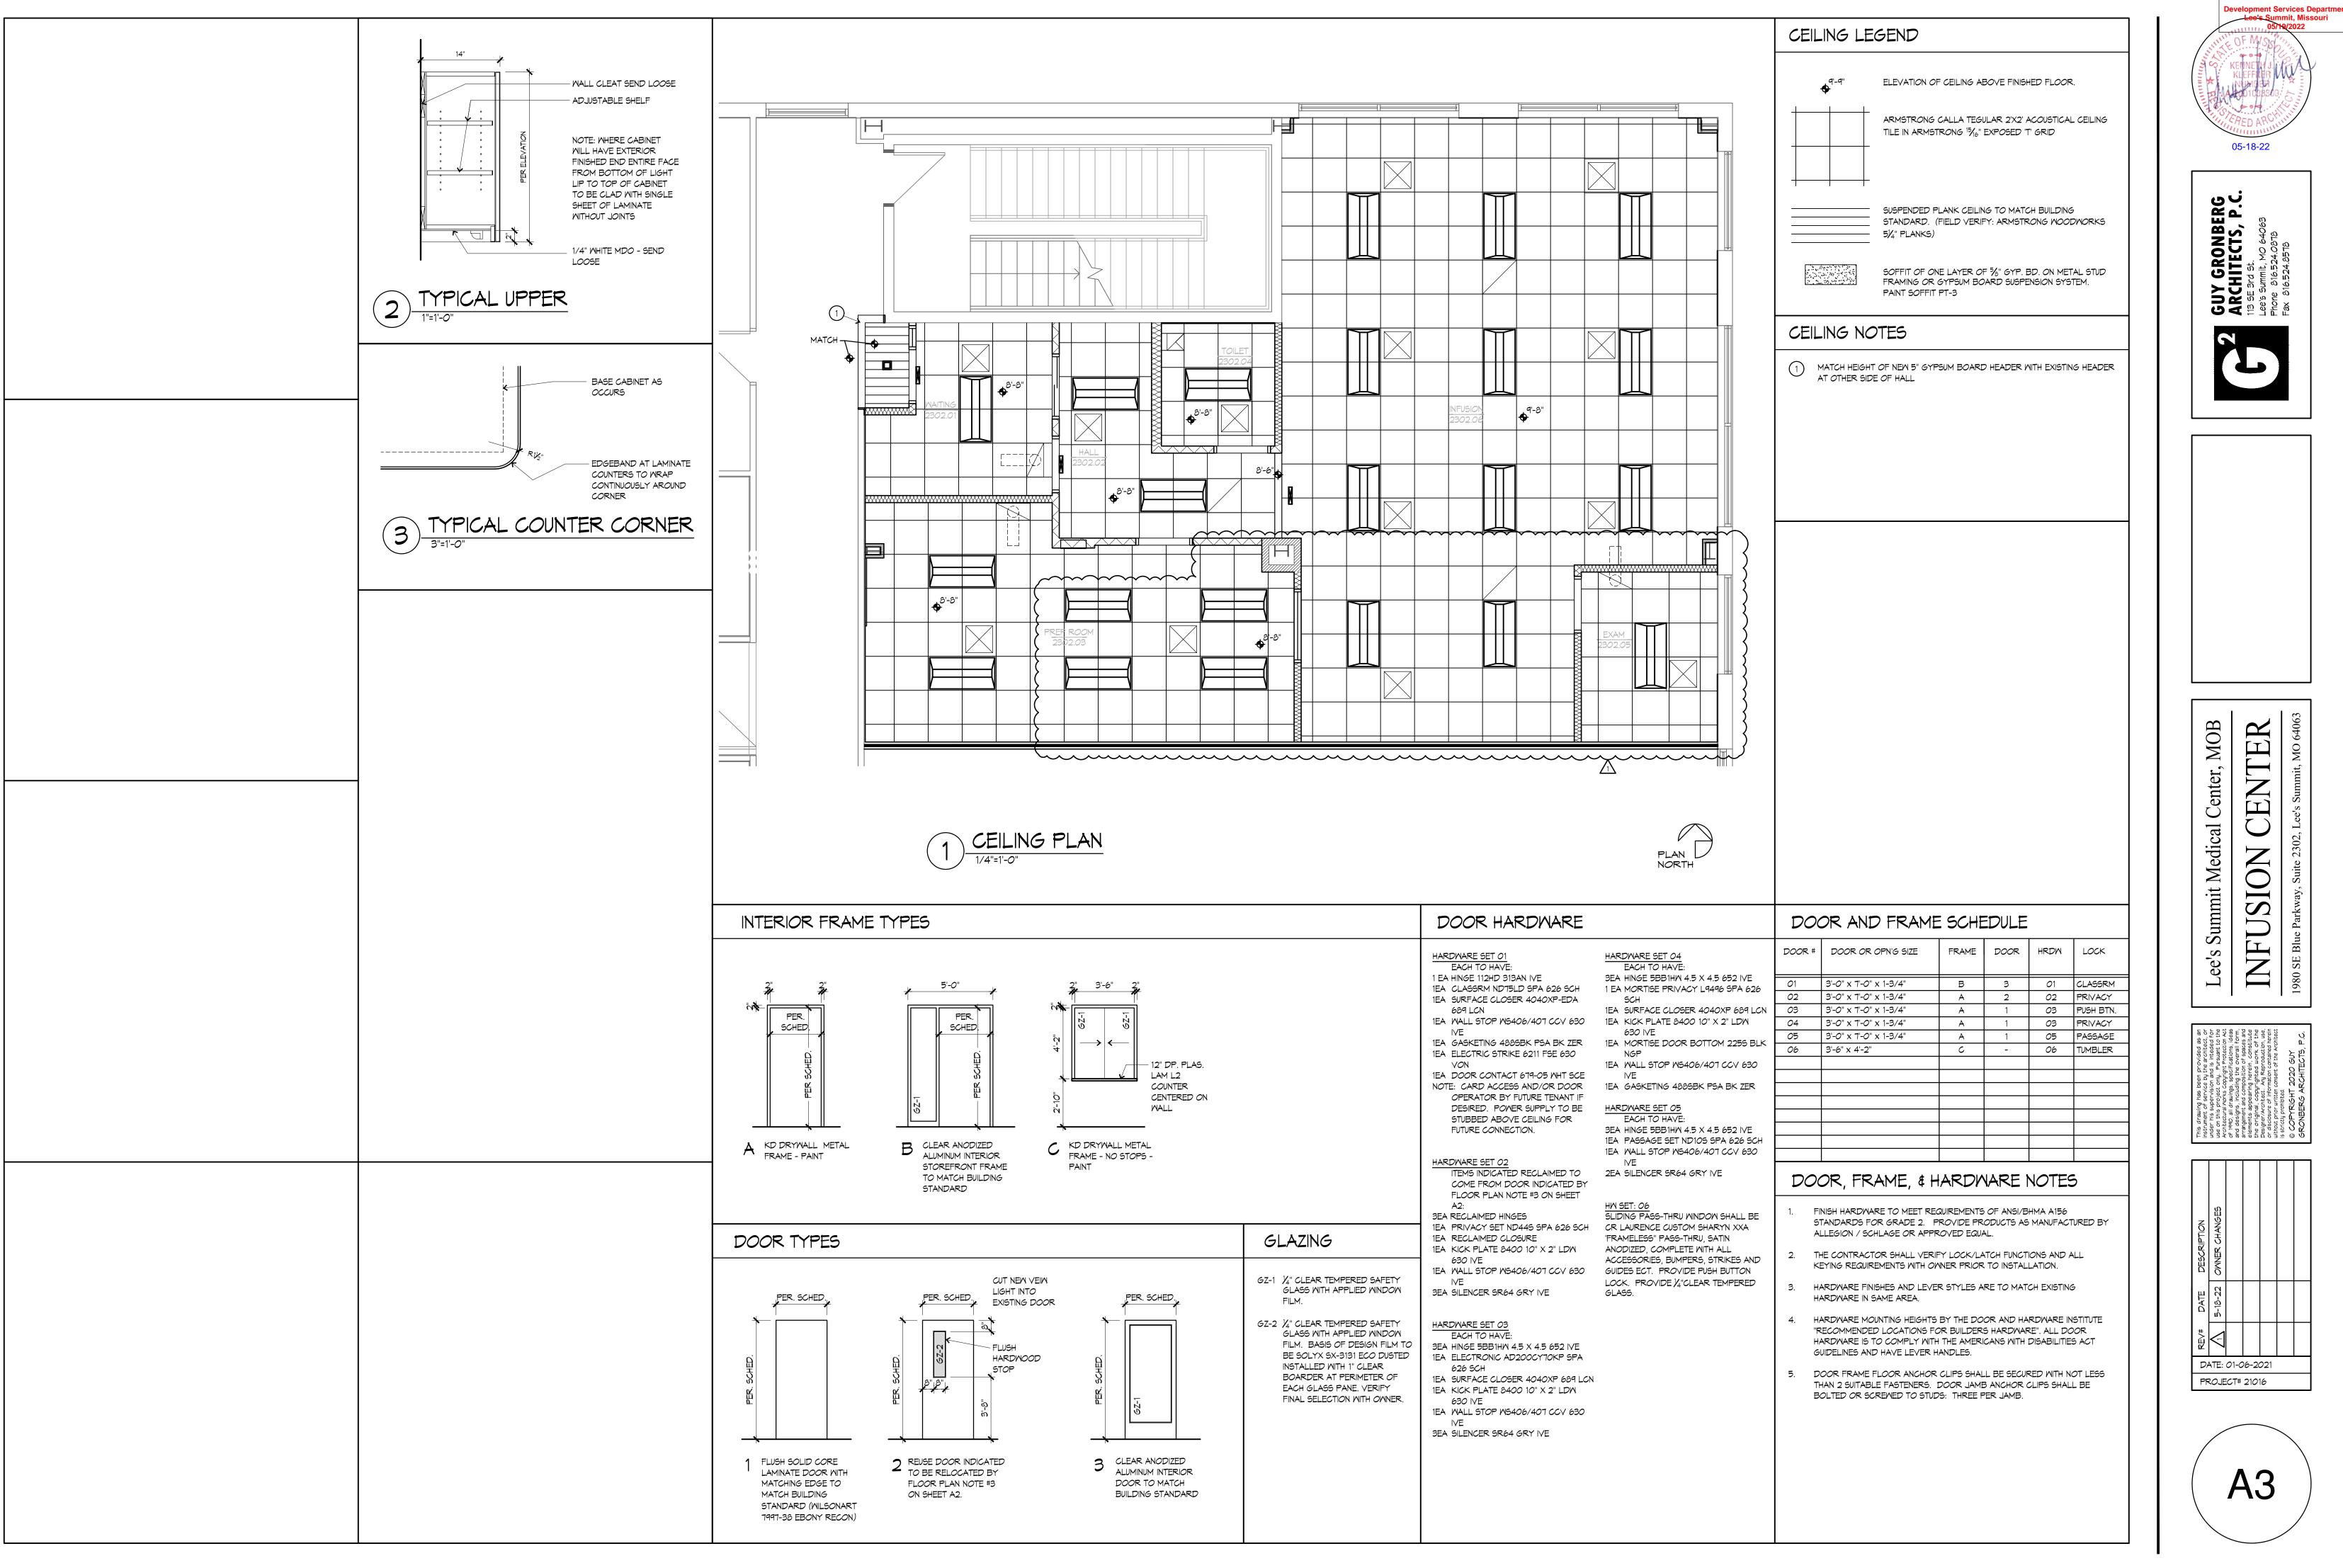


RELEASED FOR CONSTRUCTION As Noted on Plans Review

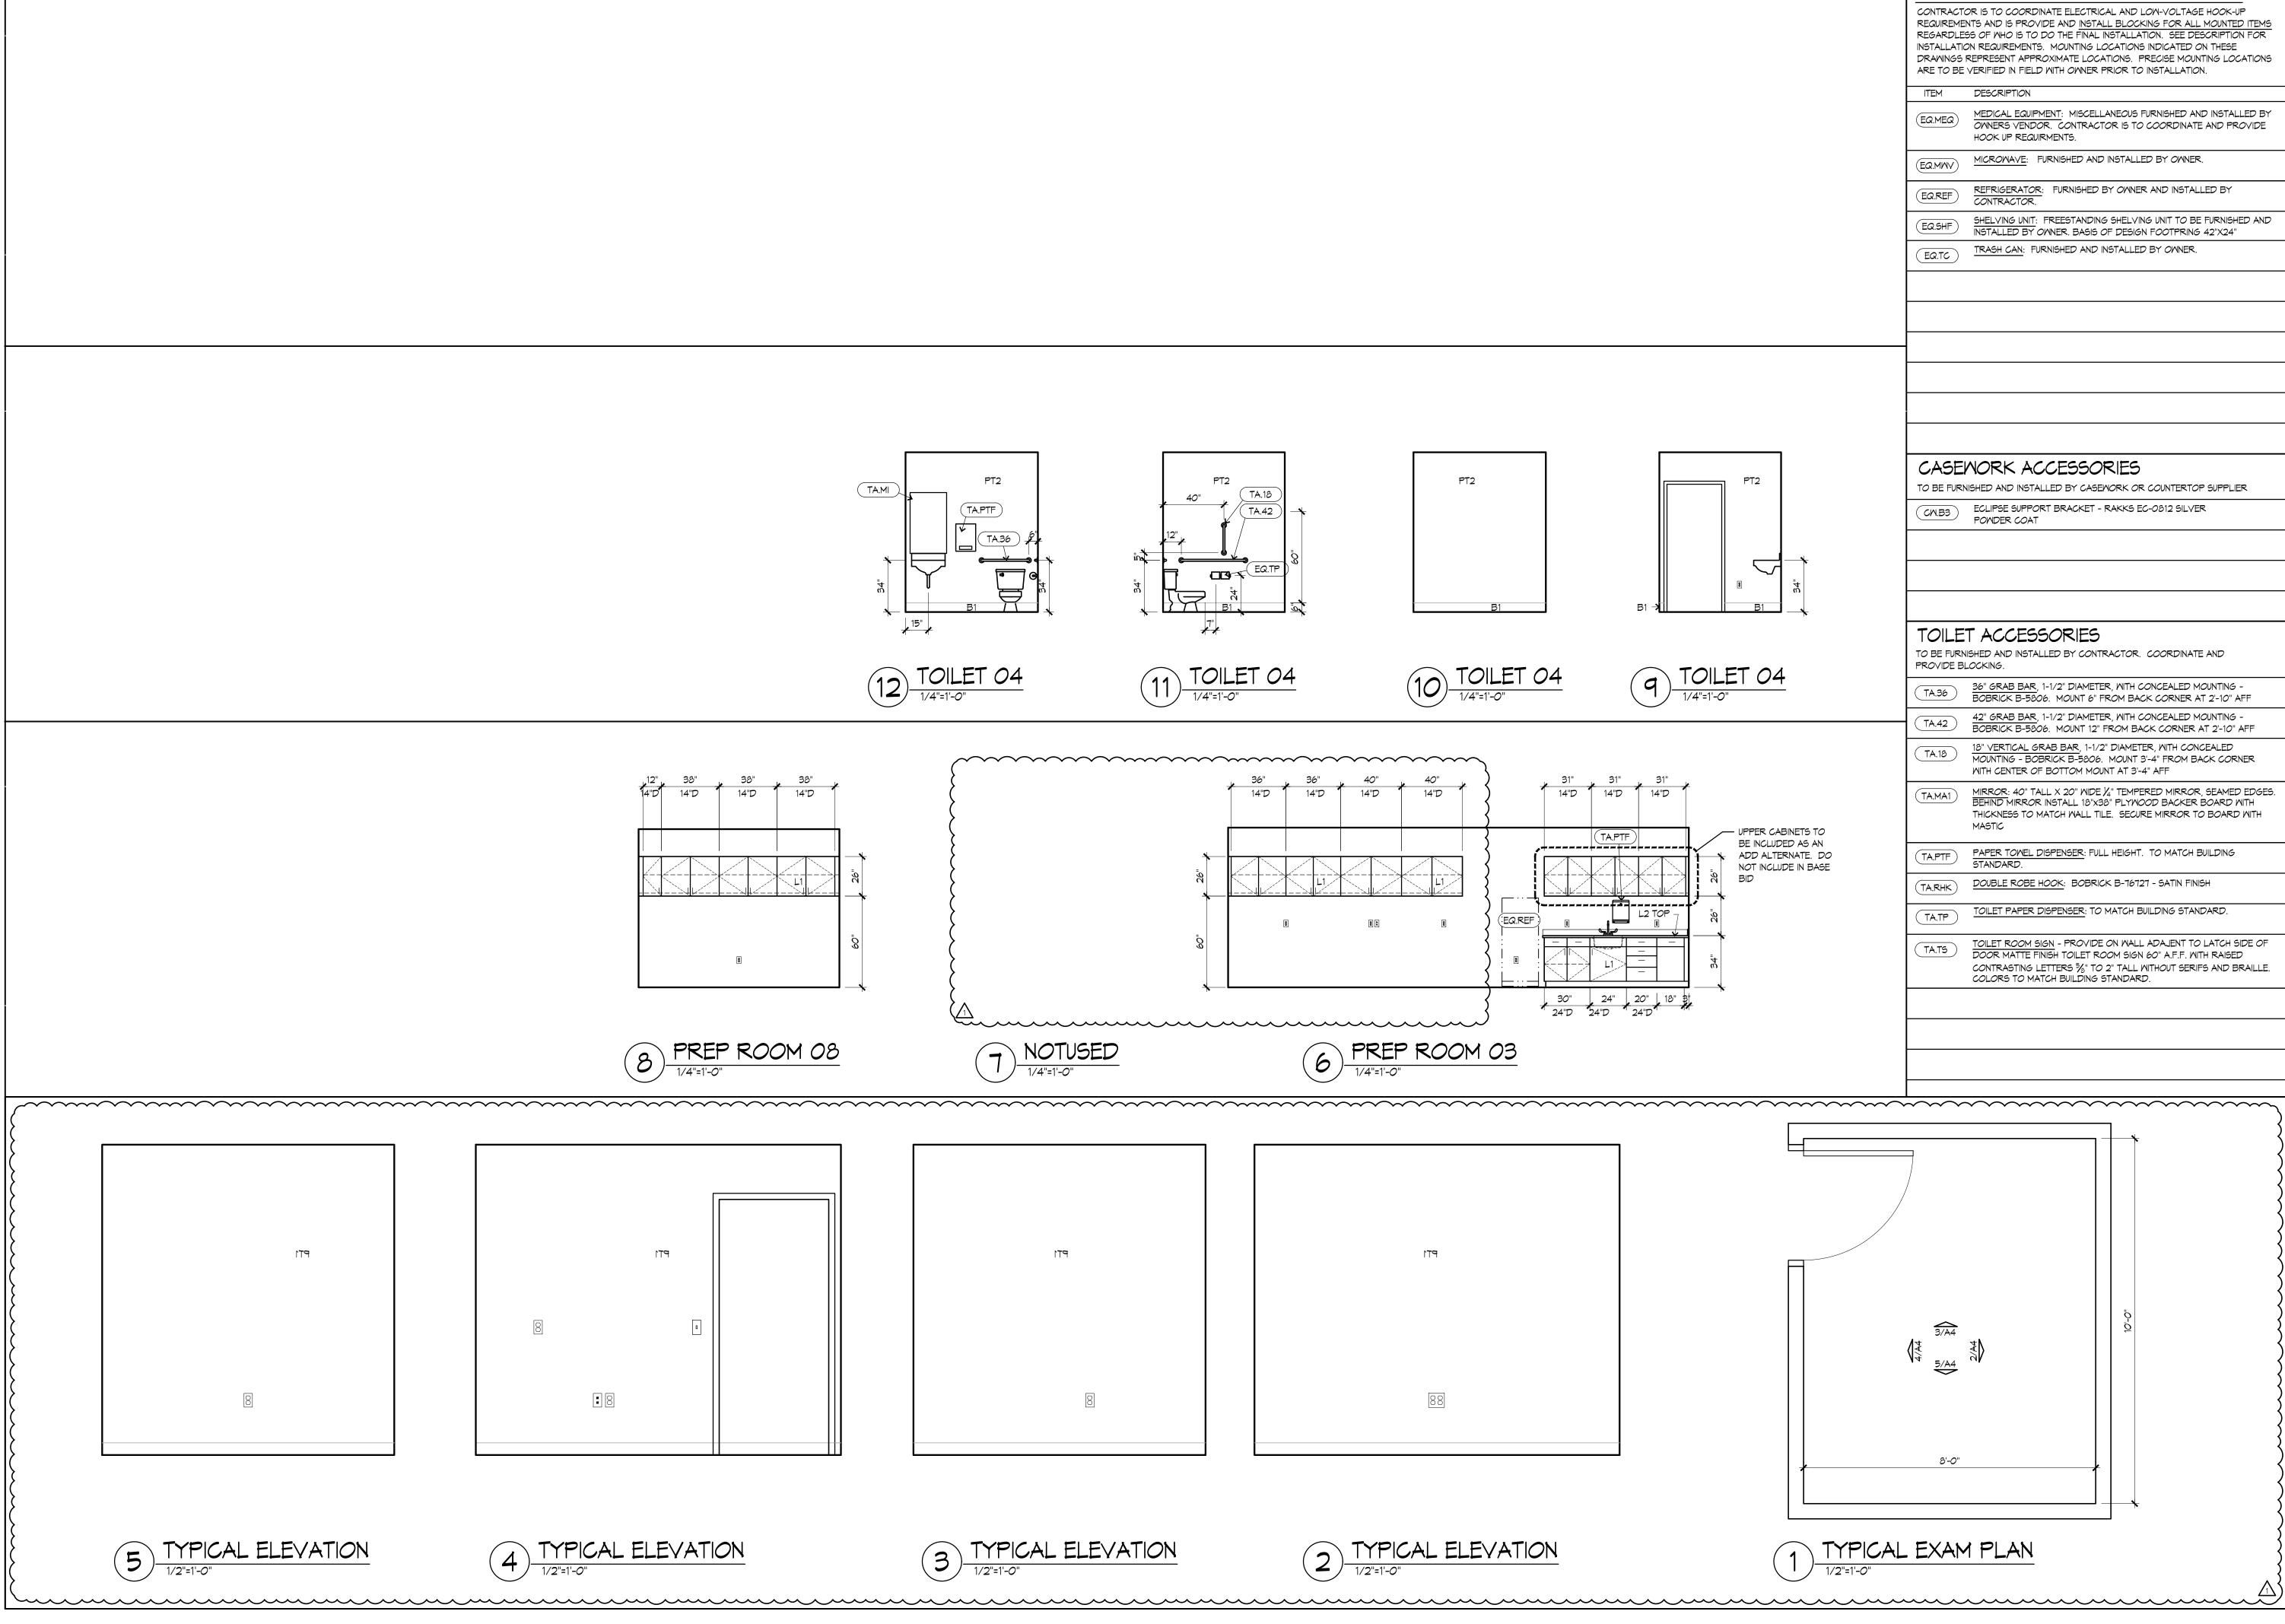

		RELEASED FOR CONSTRUCTION As Noted on Plans Review Development Services Department
	OWNER EQUIPMENT AND ACCESSORIES CONTRACTOR IS TO COORDINATE ELECTRICAL AND LOW-VOLTAGE HOOK-UP REQUIREMENTS AND IS PROVIDE AND INSTALL BLOCKING FOR ALL MOUNTED ITEMS REGARDLESS OF WHO IS TO DO THE FINAL INSTALLATION. SEE DESCRIPTION FOR INSTALLATION REQUIREMENTS. MOUNTING LOCATIONS INDICATED ON THESE DRAWINGS REPRESENT APPROXIMATE LOCATIONS. PRECISE MOUNTING LOCATIONS ARE TO BE VERIFIED IN FIELD WITH OWNER PRIOR TO INSTALLATION.	KENNETH J KLEFFNER NUMBER ANDIOBBS00
	ITEM DESCRIPTION ITEM DESCRIPTION (EQ.MEQ) MEDICAL EQUIPMENT: MISCELLANEOUS FURNISHED AND INSTALLED BY OWNERS VENDOR. CONTRACTOR IS TO COORDINATE AND PROVIDE HOOK UP REQUIRMENTS.	05-18-22
	(EQ.MMV) MICROWAVE: FURNISHED AND INSTALLED BY OWNER.	بن ق ک
	EQ.REF REFRIGERATOR: CONTRACTOR. FURNISHED BY OWNER AND INSTALLED BY EQ.SHF SHELVING UNIT: INSTALLED BY OWNER. BASIS OF DESIGN FOOTPRING 42"X24" EQ.TC TRASH CAN: INSTALLED BY OWNER.	2 GUY GRONBER ARCHITECTS, P. 113 SE 3rd st. Lee's Summit, MO 64063 Phone 816.524.0878 Fax 816.524.8578
	CASENORK ACCESSORIES TO BE FURNISHED AND INSTALLED BY CASEWORK OR COUNTERTOP SUPPLIER CVI.B3 ECLIPSE SUPPORT BRACKET - RAKKS EC-0812 SILVER POWDER COAT	
LET 04	TO BE FURNISHED AND INSTALLED BY CONTRACTOR. COORDINATE AND PROVIDE BLOCKING. TA.36 36" GRAB BAR, 1-1/2" DIAMETER, WITH CONCEALED MOUNTING - BOBRICK B-5806. MOUNT 6" FROM BACK CORNER AT 2'-10" AFF TA.42 42" GRAB BAR, 1-1/2" DIAMETER, WITH CONCEALED MOUNTING - BOBRICK B-5806. MOUNT 10" EROM BACK CORNER AT 2'-10" AFF	
UPPER CABINETS TO	TA.42 BOBRICK B-5806. MOUNT 12" FROM BACK CORNER AT 2'-10" AFF TA.18 18" VERTICAL GRAB BAR, 1-1/2" DIAMETER, WITH CONCEALED MOUNTING - BOBRICK B-5806. MOUNT 3'-4" FROM BACK CORNER WITH CENTER OF BOTTOM MOUNT AT 3'-4" FROM BACK CORNER MIRROR: 40" TALL X 20" WIDE ¼" TEMPERED MIRROR, SEAMED EDGES. BEHIND MIRROR INSTALL 18"X38" PLYWOOD BACKER BOARD WITH THICKNESS TO MATCH WALL TILE. SECURE MIRROR TO BOARD WITH MASTIC	I Center, MOB CENTER Lee's Summit, MO 64063
BE INCLUDED AS AN ADD ALTERNATE. DO NOT INCLUDE IN BASE BID	TA.PTF PAPER TOWEL DISPENSER: FULL HEIGHT. TO MATCH BUILDING STANDARD. TA.RHK DOUBLE ROBE HOOK: BOBRICK B-76727 - SATIN FINISH TA.RHK TOILET PAPER DISPENSER: TO MATCH BUILDING STANDARD. TA.TP TOILET ROOM SIGN - PROVIDE ON WALL ADAJENT TO LATCH SIDE OF	s Summit Medical FUSION C Blue Parkway, Suite 2302, 1
★ ₩	(TA.TS) TOILLT NOOM SIGN FINISH TOILET ROOM SIGN 60" A.F.F. WITH RAISED CONTRASTING LETTERS 5%" TO 2" TALL WITHOUT SERIFS AND BRAILLE. COLORS TO MATCH BUILDING STANDARD.	Lee's Su INFU 1980 SE Blue
		This drawing has been provided as an instrument of service by the architect, or under his supervision and is inteded for use on this project only. Furuauta for the Architectural Works copyright Protection Act of 1960, and casigns, specifications, ideas and designs, including the overall form, arrangement and composition of spaces and elements appearent and composition of spaces and elements appearent and composition of the Designer/Architect. Any Reproduction, use, or discourse of information contained herein without provinted work of the Designer/Architect. Any Reproduction, use, or discourse of information contained herein unthout provinted consent of the Architect.
		DATE DESCRIPTION 5-18-22 OWNER CHANGES
×	8'-0"	A A A In In In In <td< td=""></td<>
$(1) \frac{\text{TYPIC}}{\frac{1}{2^{''=1^{''}-O^{''}}}}$	CAL EXAM PLAN	

A4

  ∇



MECHANICAL & PLUMBING SPECIFICATIONS

. GENERAL PROVISIONS:

- A. PROVIDE ALL LABOR, MATERIALS, AND EQUIPMENT NECESSARY FOR THE COMPLETE INSTALLATION OF THE PLUMBING AND MECHANICAL SYSTEMS OUTLINED. B. OBTAIN ALL PERMITS, FEES, LICENSES, INSPECTIONS, AND CERTIFICATIONS OF COMPLIANCE OR
- APPROVAL AS REQUIRED BY AUTHORITIES.
- C. ALL WORK SHALL BE PERFORMED IN ACCORDANCE WITH ALL APPLICABLE LAWS, CODES AND REGULATIONS OF THE GOVERNMENTAL BODIES HAVING JURISDICTION OVER THE SITE.
- D. ALL TESTING REQUIRED BY AUTHORITIES SHALL BE CONSIDERED PART OF THIS WORK.
- E. DURING CONSTRUCTION, ALL FIXTURES, EQUIPMENT, PIPE, DUCT, ETC. SHALL BE COVERED, PLUGGED, OR CAPPED AS REQUIRED TO KEEP CLEAN AND UNDAMAGED. ALL DAMAGED ITEMS SHALL BE RESTORED TO ORIGINAL CONDITION OR REPLACED. ALL PROTECTIVE COVERING SHALL BE REMOVED BEFORE FINAL ACCEPTANCE
- F. PROVIDE ALL NECESSARY CUTTING AND PATCHING OF WALLS, FLOORS, CEILINGS, AND ROOES AS NECESSARY. PATCH AROUND ALL OPENINGS SHALL MATCH ADJACENT AREA. COORDINATE ALL ROOFING WORK WITH OWNER OR RESPONSIBLE PARTY, SO THAT THE EXISTING ROOFING WARRANTY WILL BE MAINTAINED
- G. CONTRACTOR SHALL GUARANTEE ALL WORK AND MATERIALS AGAINST DEFECT FOR A PERIOD OF ONE YEAR FROM FINAL ACCEPTANCE. H. INSPECTION OF THE SITE: THIS CONTRACTOR SHALL THOROUGHLY ACQUAINT HIMSELF WITH THE MEP DRAWINGS, SPECIFICATIONS, DETAIL, AND THE SITE. THIS CONTRACTOR SHALL NOTIFY THE ARCHITECT
- OF ANY SPECIAL OR UNUSUAL PROBLEMS, CONFLICTS, OR OBSTRUCTIONS THAT AFFECT HIS BID. I. FOR THE PURPOSE OF CLEARNESS AND LEGIBILITY, THE MECHANICAL AND PLUMBING DRAWINGS ARE ESSENTIALLY DIAGRAMMATIC AND DO NOT SHOW ALL OFFSETS AND FITTINGS REQUIRED FOR INSTALLATION. DO NOT SCALE DRAWINGS. THE SIZE AND LOCATION OF EQUIPMENT IS SHOWN TO SCALE WHEREVER POSSIBLE. THE CONTRACTOR SHALL VERIFY ALL CONDITIONS AND DATA AS INDICATED ON THE DRAWINGS AND IN THE SPECIFICATION SECTIONS WHERE MECHANICAL WORK INTERFACES WITH OTHER TRADES
- J. IN THE EVENT OF A CONFLICT OR INCONSISTENCY BETWEEN ITEMS INDICATED ON THE PLANS OR WITH CODE REQUIREMENTS. THE NOTE OR CODE WHICH PRESCRIBES AND ESTABLISHES THE MORE COMPLETE JOB OR HIGHER STANDARD SHALL PREVAIL
- K. INSTALL MATERIALS AND SYSTEMS IN ACCORDANCE WITH MANUFACTURER'S INSTRUCTIONS AND APPROVED SUBMITTALS. INSTALL MATERIALS IN PROPER RELATION WITH ADJACENT CONSTRUCTION AND WITH UNIFORM APPEARANCE FOR EXPOSED WORK. COORDINATE WITH WORK OF OTHER SECTIONS. COMPLY WITH APPLICABLE REGULATIONS AND CODE REQUIREMENTS. PROVIDE PROPER CLEARANCES FOR SERVICING.
- . INCLUDE ALL BASIC MATERIALS AND CONSTRUCTION METHODS INCLUDING PIPES, PIPE FITTINGS, AND SPECIALTIES AND SUPPORTING DEVICES, VALVES, PIPE AND VALVE IDENTIFICATION, PUMPS, VIBRATION ISOLATION. ETC.
- M. FURNISH ADEQUATE ACCESS PANELS AND DOORS TO ALLOW FOR FUTURE PIPING ALTERATIONS. REPLACEMENT, AND MAINTENANCE OF PIPING, PROPERLY IDENTIFY ALL ACCESS PANELS AND DOORS.

2. OPERATION AND MAINTENANCE MANUALS:

- A. DURING THE COURSE OF CONSTRUCTION, COLLECT AND COMPILE OPERATING INSTRUCTIONS, WIRING DIAGRAMS, CATALOG CUTS, LUBRICATION AND PREVENTIVE MAINTENANCE INSTRUCTIONS, PARTS LISTS, ETC. FOR ALL EQUIPMENT FURNISHED UNDER THIS CONTRACT.
- B. ALL LITERATURE AND INSTRUCTIONS SHIPPED WITH THE EQUIPMENT SHALL BE SAVED FOR INCLUSION IN THE OPERATING AND MAINTENANCE MANUALS AND PROVIDED TO THE BUILDING OWNER.

3. MANUFACTURERS:

A. THE ELECTRICAL SYSTEM DESIGN IS BASED IN PART ON THE SPECIFIED EQUIPMENT. IT IS THE RESPONSIBILITY OF THE CONTRACTOR TO COORDINATE THE ELECTRICAL REQUIREMENTS OF THE EQUIPMENT BEING FURNISHED. ANY CHANGES TO THE ELECTRICAL SYSTEM DUE TO HVAC EQUIPMENT OTHER THAN THE SPECIFIED EQUIPMENT BEING FURNISHED SHALL BE PROVIDED AT NO ADDITIONAL COST TO THE OWNER.

<u>4. PLUMBING</u>

- A. PROVIDE AN APPROVED WATER HAMMER ARRESTOR FOR EACH PLUMBING FIXTURE SUPPLY AS REQUIRED BY FIXTURE MANUFACTURER. B. ALL EXPOSED PIPE IN FINISHED AREAS SHALL BE CHROME PLATED BRASS PIPE. NO FERROUS PIPE.
- C. PROVIDE CLEANOUTS AT EACH CHANGE IN DIRECTION AND AT 100 FOOT INTERVALS IN STRAIGHT RUNS. D. PROVIDE ACCESS PANELS FOR ALL CONCEALED VALVES AND TRAPS.
- E. CLEANOUTS: VINYL TILE FLOOR (FCO): JR SMITH #4140, OR EQUAL.
- QUARRY TILE FLOOR (FCO): JR SMITH #4200, OR EQUAL
- CARPETED FLOOR (FCO): JR SMITH #4020-Y, OR EQUAL
- UNFINISHED FLOOR (FCO): JR SMITH #4020, OR EQUAL.
- WALL (WCO): JR SMITH #4472, OR EQUAL, 24" ABOVE THE FLOOR.
- GRADE (GCO): JR SMITH #4256. OR EQUAL. WITH HEAVY DUTY CAST IRON BODY AND COVER. F. ALL SEWER PIPING LOCATED INSIDE THE BUILDING SHALL BE INSTALLED WITH THE FOLLOWING SLOPES.
- INSTALL 2-1/2" AND SMALLER PIPE AT 1/4" PER FOOT FALL. INSTALL 3" AND LARGER PIPE AT 1/8" PER FOOT FALL. 2

<u>5. PIPING</u>

A. DOMESTIC COLD AND HOT WATER.

TYPE L HARD DRAWN COPPER TUBING, ASTM B-88 WITH WROUGHT BRONZE SOLDERED FITTINGS. BALL VALVE: CRANE #932 OR EQUAL.

- B. SANITARY SEWER AND VENTS. ABOVE SOIL: WASTE, DRAIN, VENT PIPE, AND FITTINGS ABOVE GROUND INSIDE OF THE BUILDING SHALL BE SERVICE WEIGHT HUB-AND-SPIGOT OR NO-HUB CAST IRON PIPE. MATERIALS IN THE
- CEILING AND BELOW SLAB TO BE PLENUM-RATED. SEWER LINES SHALL BE LOCATED IN GENERAL AS SHOWN ON THE DRAWINGS. THE EXACT LOCATIONS SHALL BE DETERMINED BY THE CONTRACTOR IN SUCH A MANNER AS TO MAINTAIN
- PROPER CLEARANCES AND SUFFICIENT SLOPE TO ENSURE DRAINAGE. C. ALL PIPE HANGERS AND SUPPORTS SHALL BE STANDARD PRODUCTS OF GRINNELL, FEE AND MASON, OR
- ANVIL. HANGER SPACING SHALL BE IN ACCORDANCE WITH MSS-SP-69. D. PROVIDE CHROME PLATED ESCUTCHEONS ON ALL PIPE ENTERING FINISHED AREAS.

6. INSULATION AND DUCT LINING:

A. ALL INSULATIONS AND ACCESSORIES SHALL HAVE A FIRE HAZARD CLASSIFICATION WITH A FLAME SPREAD RATING OF NOT OVER 25. A FUEL CONTRIBUTION RATING OF NOT OVER 50. AND A SMOKE

- DEVELOPMENT RATING OF NOT OVER 50, IN ACCORDANCE WITH NFPA.
- B. PIPE INSULATION (ABOVE GRADE): 1. THE PIPE INSULATION USED SHALL HAVE A THERMAL CONDUCTIVITY OF 0.27 BTU PER
- IN/HR*SQ-FT*F OR LESS. FIBERGLASS INSULATION WITH FACTORY APPLIED VAPOR BARRIER, ASJ JACKET, FACTORY APPLIED PRESSURE SEALING LONGITUDE LAP JOINT, NO STAPLES, ZESTON PREMOLDED PVC FITTING
- COVERS. INSTALLATION SHALL BE IN ACCORDANCE WITH MANUFACTURER'S RECOMMENDATIONS. 3. INSULATION SCHEDULE: 1/2"
- a. DOMESTIC COLD WATER: b. DOMESTIC HOT WATER:
- C. DUCTWORK INSULATION:
- 1. DUCT LINING: 2 LB/CF, AIR STREAM SIDE COATED, INSTALL PER SMACNA STANDARDS. PROVIDE 1/2" THICK THROUGH THE FIRST 10 FEET OF DUCT
- 2. DUCT COVERING: SUPPLY AIR DUCT SHALL HAVE 2" THICK, 3/4 LB/CF, FIBERGLASS BLANKET WITH FACTORY APPLIED VAPOR BARRIER AND FACING. INSTALLATION IN ACCORDANCE WITH MANUFACTURERS RECOMMENDATIONS. DUCT COVERING SHALL BE MINIMUM R-6.

7. TESTING, BALANCING AND CLEANING:

- A. ALL PIPING SHALL BE TESTED FOR LEAKS BEFORE BEING CONCEALED IN WALL CONSTRUCTION OR
- COVERED WITH INSULATION. B. SEWER AND VENT PIPING SHALL BE HYDROSTATICALLY TESTED WITH NO LESS THAN 10 FEET OF HEAD FOR A PERIOD OF NOT LESS THAN 15 MINUTES, PER THE LOCAL PLUMBING CODE, WITH NO LEAKS. C. DOMESTIC WATER PIPING SHALL BE HYDROSTATICALLY TESTED AT A PRESSURE OF NOT LESS THAN
- 1-1/2 TIMES THE OPERATING PRESSURE, BUT NOT LESS THAN 60 PSI, FOR A PERIOD OF NOT LESS THAN 2 HOURS. WITH NO LEAKS.
- D. BEFORE DOMESTIC WATER PIPING IS PLACED IN SERVICE, ALL DOMESTIC WATER DISTRIBUTION SYSTEMS, INCLUDING THOSE FOR COLD WATER AND HOT WATER SYSTEMS, SHALL BE FLUSHED, STERILIZED AND CHLORINATED IN ACCORDANCE WITH THE HEALTH DEPARTMENT REGULATIONS. THE SYSTEMS SHALL BE THOROUGHLY FLUSHED OF ALL DIRT AND FOREIGN MATTER, THEN FILLED WITH WATER TREATED WITH 50 PPM OF CHLORINE. DURING THE FILLING PROCESS, VALVES AND FAUCETS SHALL BE OPENED SEVERAL TIMES TO ASSURE TREATMENT OF THE ENTIRE SYSTEM. THE TREATED WATER SHALL BE LEFT IN THE SYSTEM FOR 24 HOURS AFTER WHICH TIME THE SYSTEM SHALL BE FLUSHED; IF THE RESIDUAL CHLORINE IS NOT LESS THAN 10 PPM, THE FLUSHING SHALL BE REPEATED. AFTER STERILIZATION SAMPLES OF WATER FROM THE SYSTEM SHALL BE APPROVED BY THE BOARD OF HEALTH.
- E. DUCTWORK AND PIPING SHALL BE BALANCED BY QUALIFIED BALANCING PERSONNEL WHO HAVE PREVIOUS EXPERIENCE WITH BALANCING PROCEDURES AND ARE FAMILIAR WITH TESTING AND BALANCING PROCEDURES OF THE ASSOCIATED AIR BALANCE COUNCIL (AABC) OR NATIONAL ENVIRONMENTAL BALANCING BUREAU (NEBB).
- BALANCING SHALL INCLUDE THE BALANCING OF THE EQUIPMENT AND AIR DISTRIBUTION SYSTEMS TO PROVIDE DESIGN QUANTITIES INDICATED AND VERIFICATION PERFORMANCE OF ALL EQUIPMENT AND AUTOMATIC CONTROLS.

2. WITH IN 30 DAYS OF THE COMPLETION OF THE TESTING AND BALANCING WORK, SUBMIT THE TEST AND BALANCING REPORT BEARING THE SIGNATURE OF THE TEST AND BALANCE ENGINEER. THE REPORTS SHALL BE CERTIFIED PROOF THAT THE SYSTEMS HAVE BEEN TESTED, ADJUSTED, AND BALANCED IN ACCORDANCE WITH THE REFERENCED STANDARDS; ARE AN ACCURATE REPRESENTATION OF HOW THE SYSTEMS HAVE BEEN INSTALLED AND ARE OPERATING. REPORTS SHALL BE BOUND IN A VINYL BINDER AND THE BINDER LABELLED OR MAY BE AN ELECTRONIC PDF SUBMITTAL.

8. DUCTWORK:

- COMPLYING WITH ASTM A 527, LOCKFORMING QUALITY, WITH G60 ZINC COATING IN ACCORDANCE WITH ASTM A 525, AND MILL PHOSPHATIZED FOR EXPOSED LOCATIONS.
- B. DUCTWORK METAL GAUGES, REINFORCING, ETC SHALL BE CONSTRUCTED IN ACCORDANCE WITH SMACNA "HVAC DUCT CONSTRUCTION STANDARDS," LATEST EDITION FOR A 2" WATER GAUGE STATIC PRESSURE
- C. ALL FITTINGS SHALL BE CONSTRUCTED IN ACCORDANCE WITH SMACNA "HVAC DUCT CONSTRUCTION
- STANDARDS," LATEST EDITION. D. RECTANGULAR DUCT:
- 1. ELBOWS, UNLESS INDICATED OTHERWISE, SHALL BE CONSTRUCTED WITH CENTERLINE RADIUS OF NOT LESS THAN 1.5 DUCT WIDTH OR SQUARE ELBOWS WITH DOUBLE WALL STREAMLINE ELBOWS. 2. TAKE-OFF FITTINGS: BRANCH DUCT TAKE-OFF FITTINGS FOR SUPPLY AND EXHAUST DIFFUSER/REGISTERS SHALL INCLUDE AN INTEGRAL MANUAL VOLUME DAMPER WITH LOCKING QUADRANT, DAMPER NOT REQUIRED ON RETURN AIR. FOR RECTANGULAR TO ROUND TAKE-OFFS,
- UTILIZE A "BUCKLEY" MODEL 3300 & 3300D OR EQUAL. 3. RETURN AIR ACOUSTIC ELBOWS AND SOUND BOOTS SHALL BE A SQUARE ELBOW WITH NO
- 4. SLOPES FOR TRANSITIONS OR OTHER CHANGES IN DIMENSIONS SHALL BE A MINIMUM 1 TO 3. E. ROUND AND OVAL SPIRAL SEAM DUCT:
- 1. PROVIDE RADIUS TYPE FITTINGS FABRICATED OF MULTIPLE SECTIONS WITH MAXIMUM 15 DEGREE CHANGE OF DIRECTION PER SECTION. UNLESS SPECIFICALLY DETAILED OTHERWISE, USE 45 DEGREE PROVIDE CONICAL TYPE TEES.
- ROUND LONGITUDINAL SEAM DUCT: USE FOR RIGID METAL DUCT ON LEAVING SIDE OF DUCT IN
- F. SEAL ALL CONCEALED DUCTWORK JOINTS WITH NON-HARDENING, NON-MIGRATING MASTIC SEALANT, AS BELOW:
- (1) UNCONDITIONED SPACES: CLASS B (2) CONDITIONED SPACES (PLENUM): CLASS C SUPPLY 2"WC OR LESS
- G. DUCT SIZES SHOWN ON THE DRAWINGS ARE SHEET METAL SIZES. INCREASE SHEET METAL SIZES
- ACCORDINGLY TO ACCOUNT FOR THICKNESS OF DUCT LINER. H. WHETHER SHOWN ON PLANS OR NOT, PROVIDE MANUAL VOLUME DAMPERS IN EACH RUNOUT TO EACH
- SUPPLY DIFFUSER OR REGISTER. PROVIDE ACCESS PANELS TO DAMPERS LOCATED ABOVE HARD CEILINGS
- I. PROVIDE AUXILIARY STEEL AS REQUIRED TO ADEQUATELY SUPPORT DUCTWORK. J. WHERE DUCTS PASS THROUGH FIRE-RATED FLOORS, WALLS, OR PARTITIONS, PROVIDE FIRESTOPPING BETWEEN DUCT AND WALL.
- K. WHERE DUCTS PASS THROUGH INTERIOR PARTITIONS OR EXTERIOR WALLS, AND ARE EXPOSED TO VIEW, CONCEAL SPACE BETWEEN OPENING AND DUCT OR DUCT INSULATION WITH SHEET METAL FLANGES OF SAME GAUGE AS DUCT. OVERLAP OPENING ON 4 SIDES BY AT LEAST 1-1/2". FASTEN TO DUCT AND WALL.

9. FLEXIBLE DUCT:

- A. ATCO #086 (R-6), OR EQUAL. B. FACTORY APPLIED INSULATION AND VAPOR BARRIER, 1-1/2" THICK.
- C. MAXIMUM LENGTH OF 6'-0''.

10. CONTROL WIRING

- A. ELECTRICAL WIRING AND WIRING CONNECTIONS REQUIRED FOR THE INSTALLATION OF THE TEMPERATURE CONTROL SYSTEM SHALL BE PROVIDED BY THE MECHANICAL CONTRACTOR, UNLESS SPECIFICALLY SHOWN ON THE ELECTRICAL DRAWINGS OR SPECIFICATIONS
- B. INSTALL CONTROL WIRING WITHOUT SPLICES BETWEEN TERMINAL POINTS, COLOR CODED. INSTALL IN NEAT WORKMANLIKE MANNER, SECURELY FASTENED. INSTALL IN ACCORDANCE WITH THE NATIONAL ELECTRIC CODE AND THE ELECTRICAL SPECIFICATIONS.
- INSTALL CIRCUITS OVER 25 VOLT WITH COLOR CODED NUMBER 12 WIRE. INSTALL CIRCUITS UNDER 25 VOLT WITH COLOR CODED NUMBER 18 WIRE. WITH 0.031" HIGH TEMPERATURE 105 DEGREES F PLASTIC INSULATION ON EACH CONDUCTOR AND PLASTIC SHEATH OVFR ALL
- 3. ALL WIRING IN AREAS USED AS AIR RETURN PLENUM SHALL BE IN ELECTRIC CONDUIT EXCEPT THAT LOW VOLTAGE WIRING MAY BE TEFLON COATED. ALUMINUM SHEATHED CABLE OR OTHER WIRE SPECIFICALLY APPROVED FOR INSTALLATION IN AIR PLENUMS.

11. VARIABLE AIR VOLUME TERMINALS

- A. FURNISH AND INSTALL SINGLE DUCT, VARIABLE AIR VOLUME TERMINALS OF THE SIZES AND CAPACITIES SHOWN ON THE PLANS. B. TERMINALS SHALL BE CERTIFIED UNDER THE ARI STANDARD 880 CERTIFICATION PROGRAM AND CARRY
- THE ARI SEAL. C. THE TERMINAL CASING SHALL BE MINIMUM 22 GAUGE GALVANIZED STEEL, INTERNALLY LINED WITH 1" DUAL DENSITY INSULATION WHICH COMPLIES WITH UL 181 AND NFPA 90A. ALL EXPOSED INSULATION EDGES SHALL BE COATED WITH NFPA 90A APPROVED SEALANT TO PREVENT ENTRAINMENT OF FIBERS
- IN THE AIRSTREAM. THE DISCHARGE CONNECTION SHALL BE SLIP AND DRIVE CONSTRUCTION FOR ATTACHMENT TO METAL DUCTWORK. THE CASING SHALL BE CONSTRUCTED TO HOLD LEAKAGE TO THE MAXIMUM VALUES SHOWN IN THE CASING LEAKAGE TABLE. D. THE DAMPER SHALL BE HEAVY GAUGE STEEL WITH SHAFT ROTATING IN SELF-LUBRICATING BEARINGS. NYLON BEARINGS ARE NOT ACCEPTABLE. SHAFT SHALL BE CLEARLY MARKED ON THE END TO INDICATE
- DAMPER POSITION. STICKERS OR OTHER REMOVABLE MARKINGS ARE NOT ACCEPTABLE. THE DAMPER SHALL INCORPORATE A MECHANICAL STOP TO PREVENT OVERSTROKING AND A SYNTHETIC SEAL TO LIMIT CLOSE-OFF LEAKAGE TO THE MAXIMUM VALUES SHOWN IN THE DAMPER LEAKAGE TABLE. E. ACTUATORS SHALL BE CAPABLE OF SUPPLYING AT LEAST 35 INCH-LBS. OF TORQUE TO THE DAMPER
- SHAFT AND SHALL BE MOUNTED EXTERNALLY FOR SERVICE ACCESS. TERMINALS WITH INTERNAL ACTUATOR MOUNTING OR LINKAGE CONNECTION MUST INCLUDE GASKETED ACCESS PANEL, REMOVABLE WITHOUT DISTURBING THE DUCTWORK. CASING WITH ACCESS PANEL SHALL BE CONSTRUCTED TO HOLD
- LEAKAGE TO THE MAXIMUM VALUES SHOWN IN THE CASING LEAKAGE TABLE F. AT AN INLET VELOCITY OF 2000 FPM THE MINIMUM STATIC PRESSURE REQUIRED TO OPERATE ANY
- TERMINAL SIZE SHALL NOT EXCEED 0.13-INCH W.G.. G. HVAC CONTRACTOR IS RESPONSIBLE FOR ALL COSTS ASSOCIATED WITH CONNECTION OF NEW VAV
- TERMINAL UNITS TO THE EXISTING BUILDING AUTOMATION SYSTEM. THE BUILDING'S EMS WORK IS THROUGH JOHNSON CONTROLS.


12. FIRE PROTECTION SYSTEM:


- A. THE EXISTING SPACE IS PROTECTED WITH AN EXISTING WET PIPE SPRINKLER SYSTEM. RELOCATE AND PROVIDE ADDITIONAL SPRINKLER HEADS AND PIPING AS REQUIRED FOR THE NEW CONSTRUCTION. SPRINKLER HEADS IN FINISHED CEILINGS SHALL BE SEMI-RECESSED CHROME PLATED PENDENT TYPE.
- SPRINKLER HEADS IN ROOMS WITHOUT CEILINGS SHALL BE UPRIGHT BRASS TYPE HEADS. B. SPRINKLER WORK SHALL BE PERFORMED BY A SPRINKLER CONTRACTOR PRE-APPROVED BY THE
- LANDLORD. C. REFER TO THE ARCHITECTURAL DRAWINGS FOR NEW WALL CONSTRUCTION. D. SPRINKLER PIPING SHALL MATCH EXISTING.
- E. SPRINKLER SYSTEM (SHOP DRAWINGS) SHALL BE APPROVED BY THE LOCAL FIRE AUTHORITY AND LANDLORD'S INSURANCE CARRIER PRIOR TO START OF WORK.


13. REMODELING WORK:

- A. THIS PROJECT INVOLVES CONSTRUCTION INSIDE AN EXISTING STRUCTURE. CONTRACTORS, BY SUBMITTING A BID ARE DEEMED TO BE COMPLETELY FAMILIAR WITH THE EXISTING CONDITIONS OF THE BUILDING AS IT INFLUENCES THE WORK DESCRIBED. NO CLAIMS FOR EXTRA COMPENSATION WILL BE CONSIDERED FOR EXISTING CONDITIONS VISIBLE OR REASONABLY INFERABLE FROM A CAREFUL EXAMINATION OF THE EXISTING BUILDING CONDITIONS.
- B. CONTRACTOR SHALL INSPECT THE EXISTING FIELD CONDITIONS AT THE SITE AND THE CONTRACT DOCUMENTS PRIOR TO THE START OF ANY WORK TO DETERMINE WHAT EFFECT THE EXISTING CONDITIONS WILL HAVE ON THE WORK POTENTIAL. CONTRACTOR SHALL REPORT DISCREPANCIES TO THE ARCHITECT AND INCLUDE IN THE BID ALL COSTS REQUIRED TO MAKE THE WORK MEET EXISTING CONDITIONS.
- C. PROTECT ADJACENT MATERIALS INDICATED TO REMAIN. INSTALL AND MAINTAIN DUST AND NOISE BARRIERS TO KEEP DIRT, DUST, AND NOISE FROM BEING TRANSMITTED TO ADJACENT AREAS. REMOVE PROTECTION AND BARRIERS AFTER REMODELING OPERATIONS ARE COMPLETE.

- TURNING VANES.
- LATERALS FOR BRANCH TAKEOFF CONNECTIONS. WHERE 90 DEGREE BRANCHES ARE INDICATED SLOPES FOR TRANSITIONS OR OTHER CHANGES IN DIMENSIONS SHALL BE MINIMUM 1 TO 3.
- CONCEALED LOCATIONS FOR EXTENSION TO FLEX FOR DIFFUSERS. RECOMMENDED FOR SEALING SEAMS AND JOINTS IN DUCTWORK. OIL BASED CAULKING AND GLAZING COMPOUNDS SHALL NOT BE ACCEPTABLE. DUCTS SHALL BE SEALED TO THE CLASS LEVEL LISTED

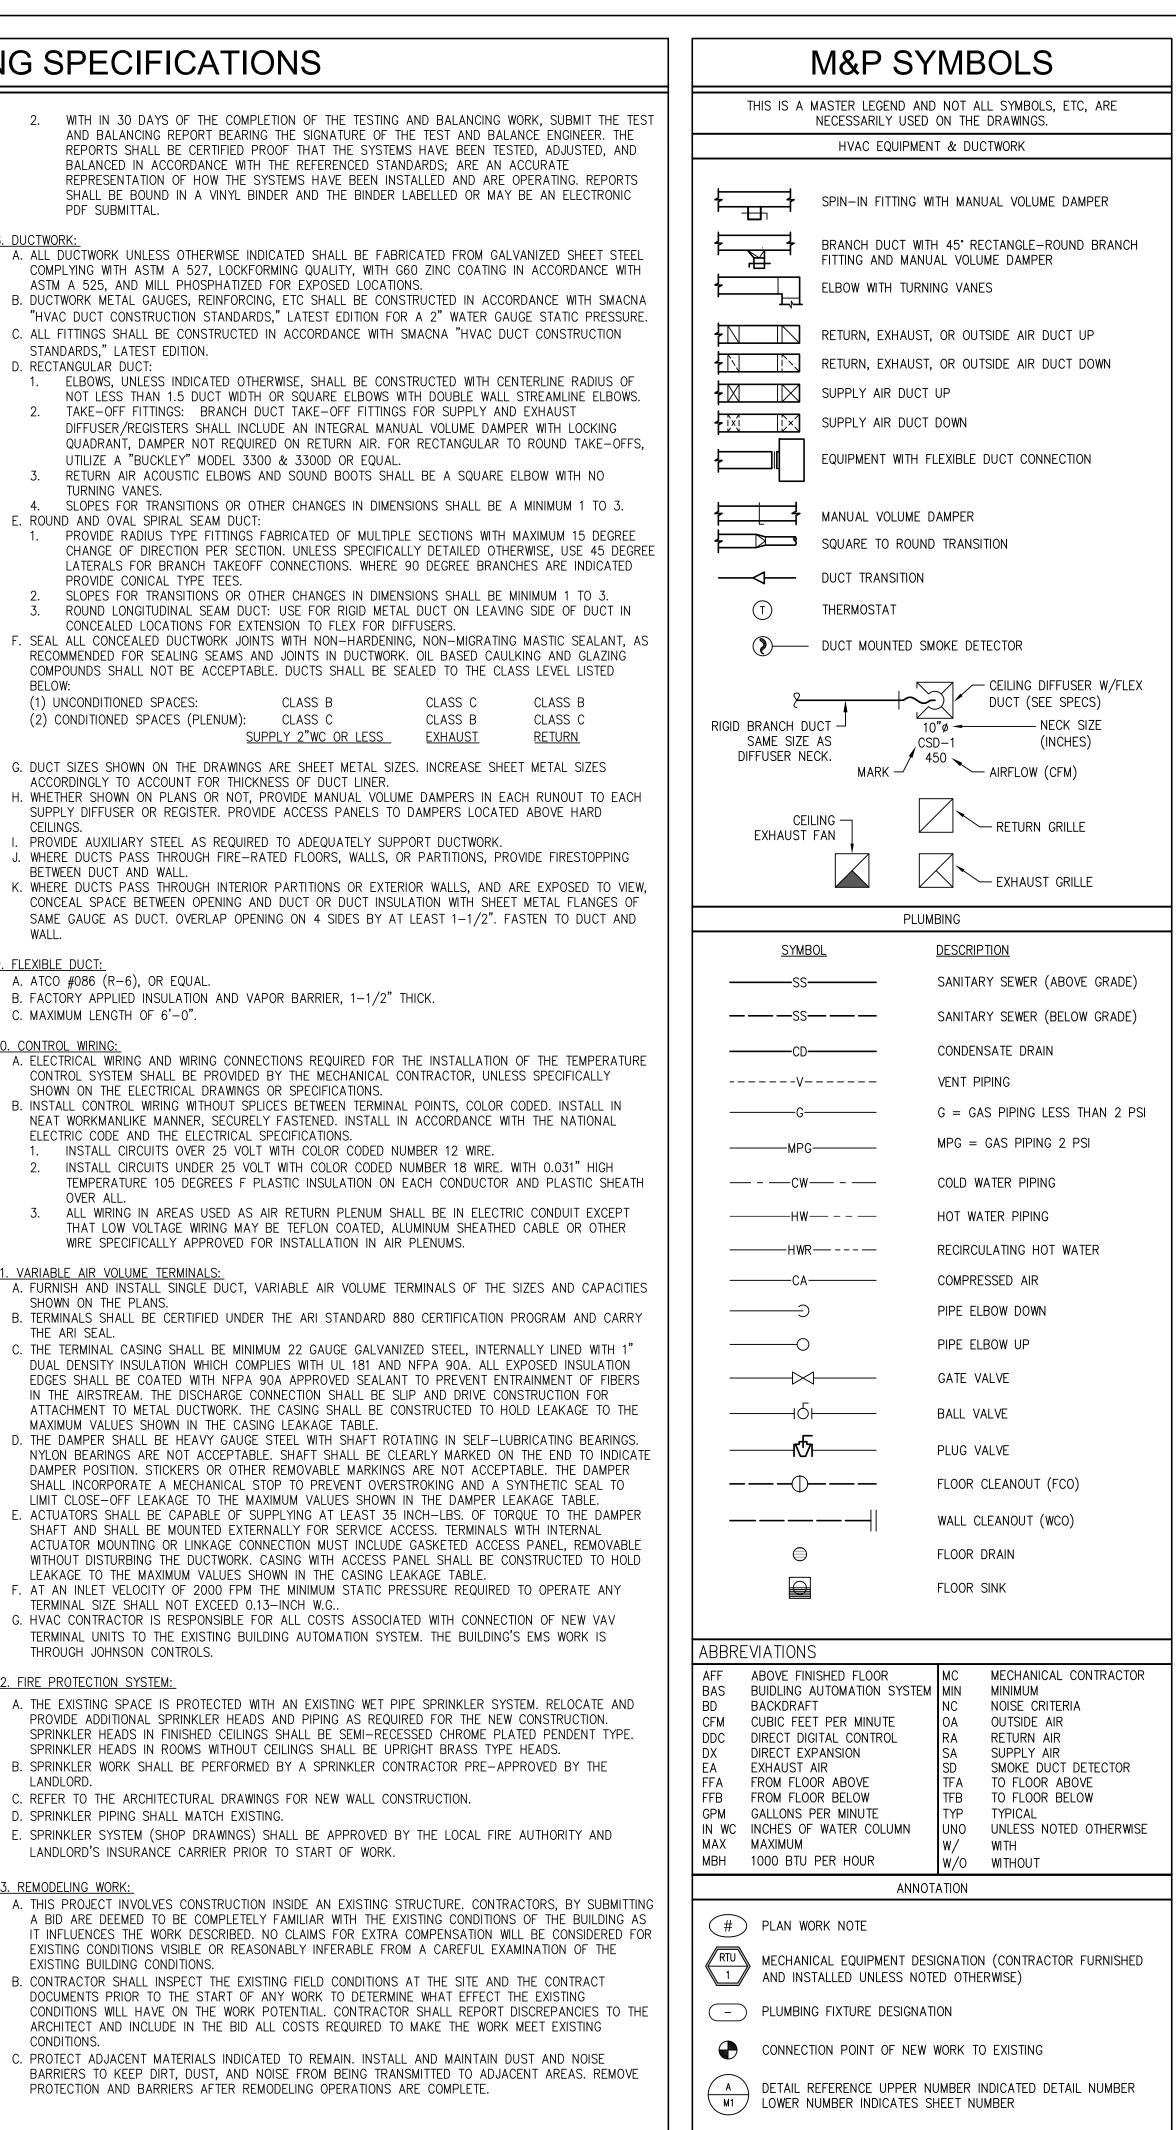


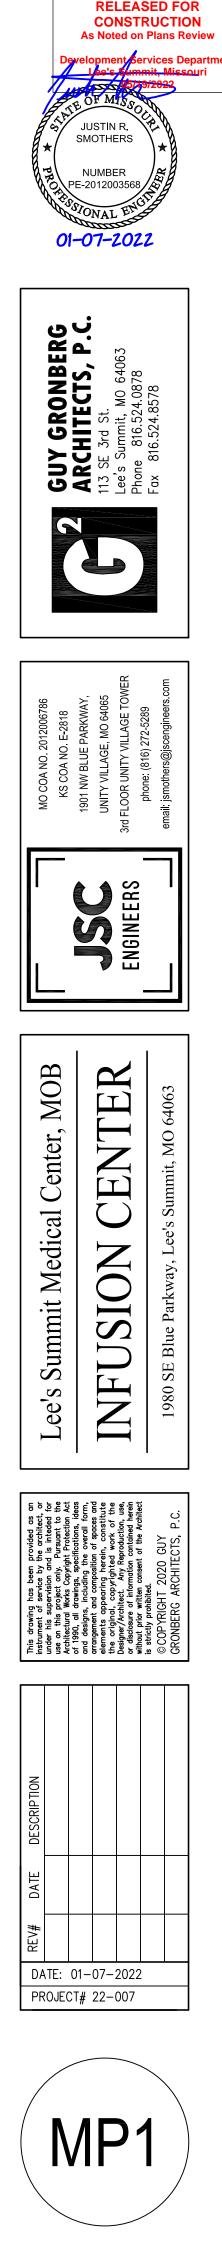

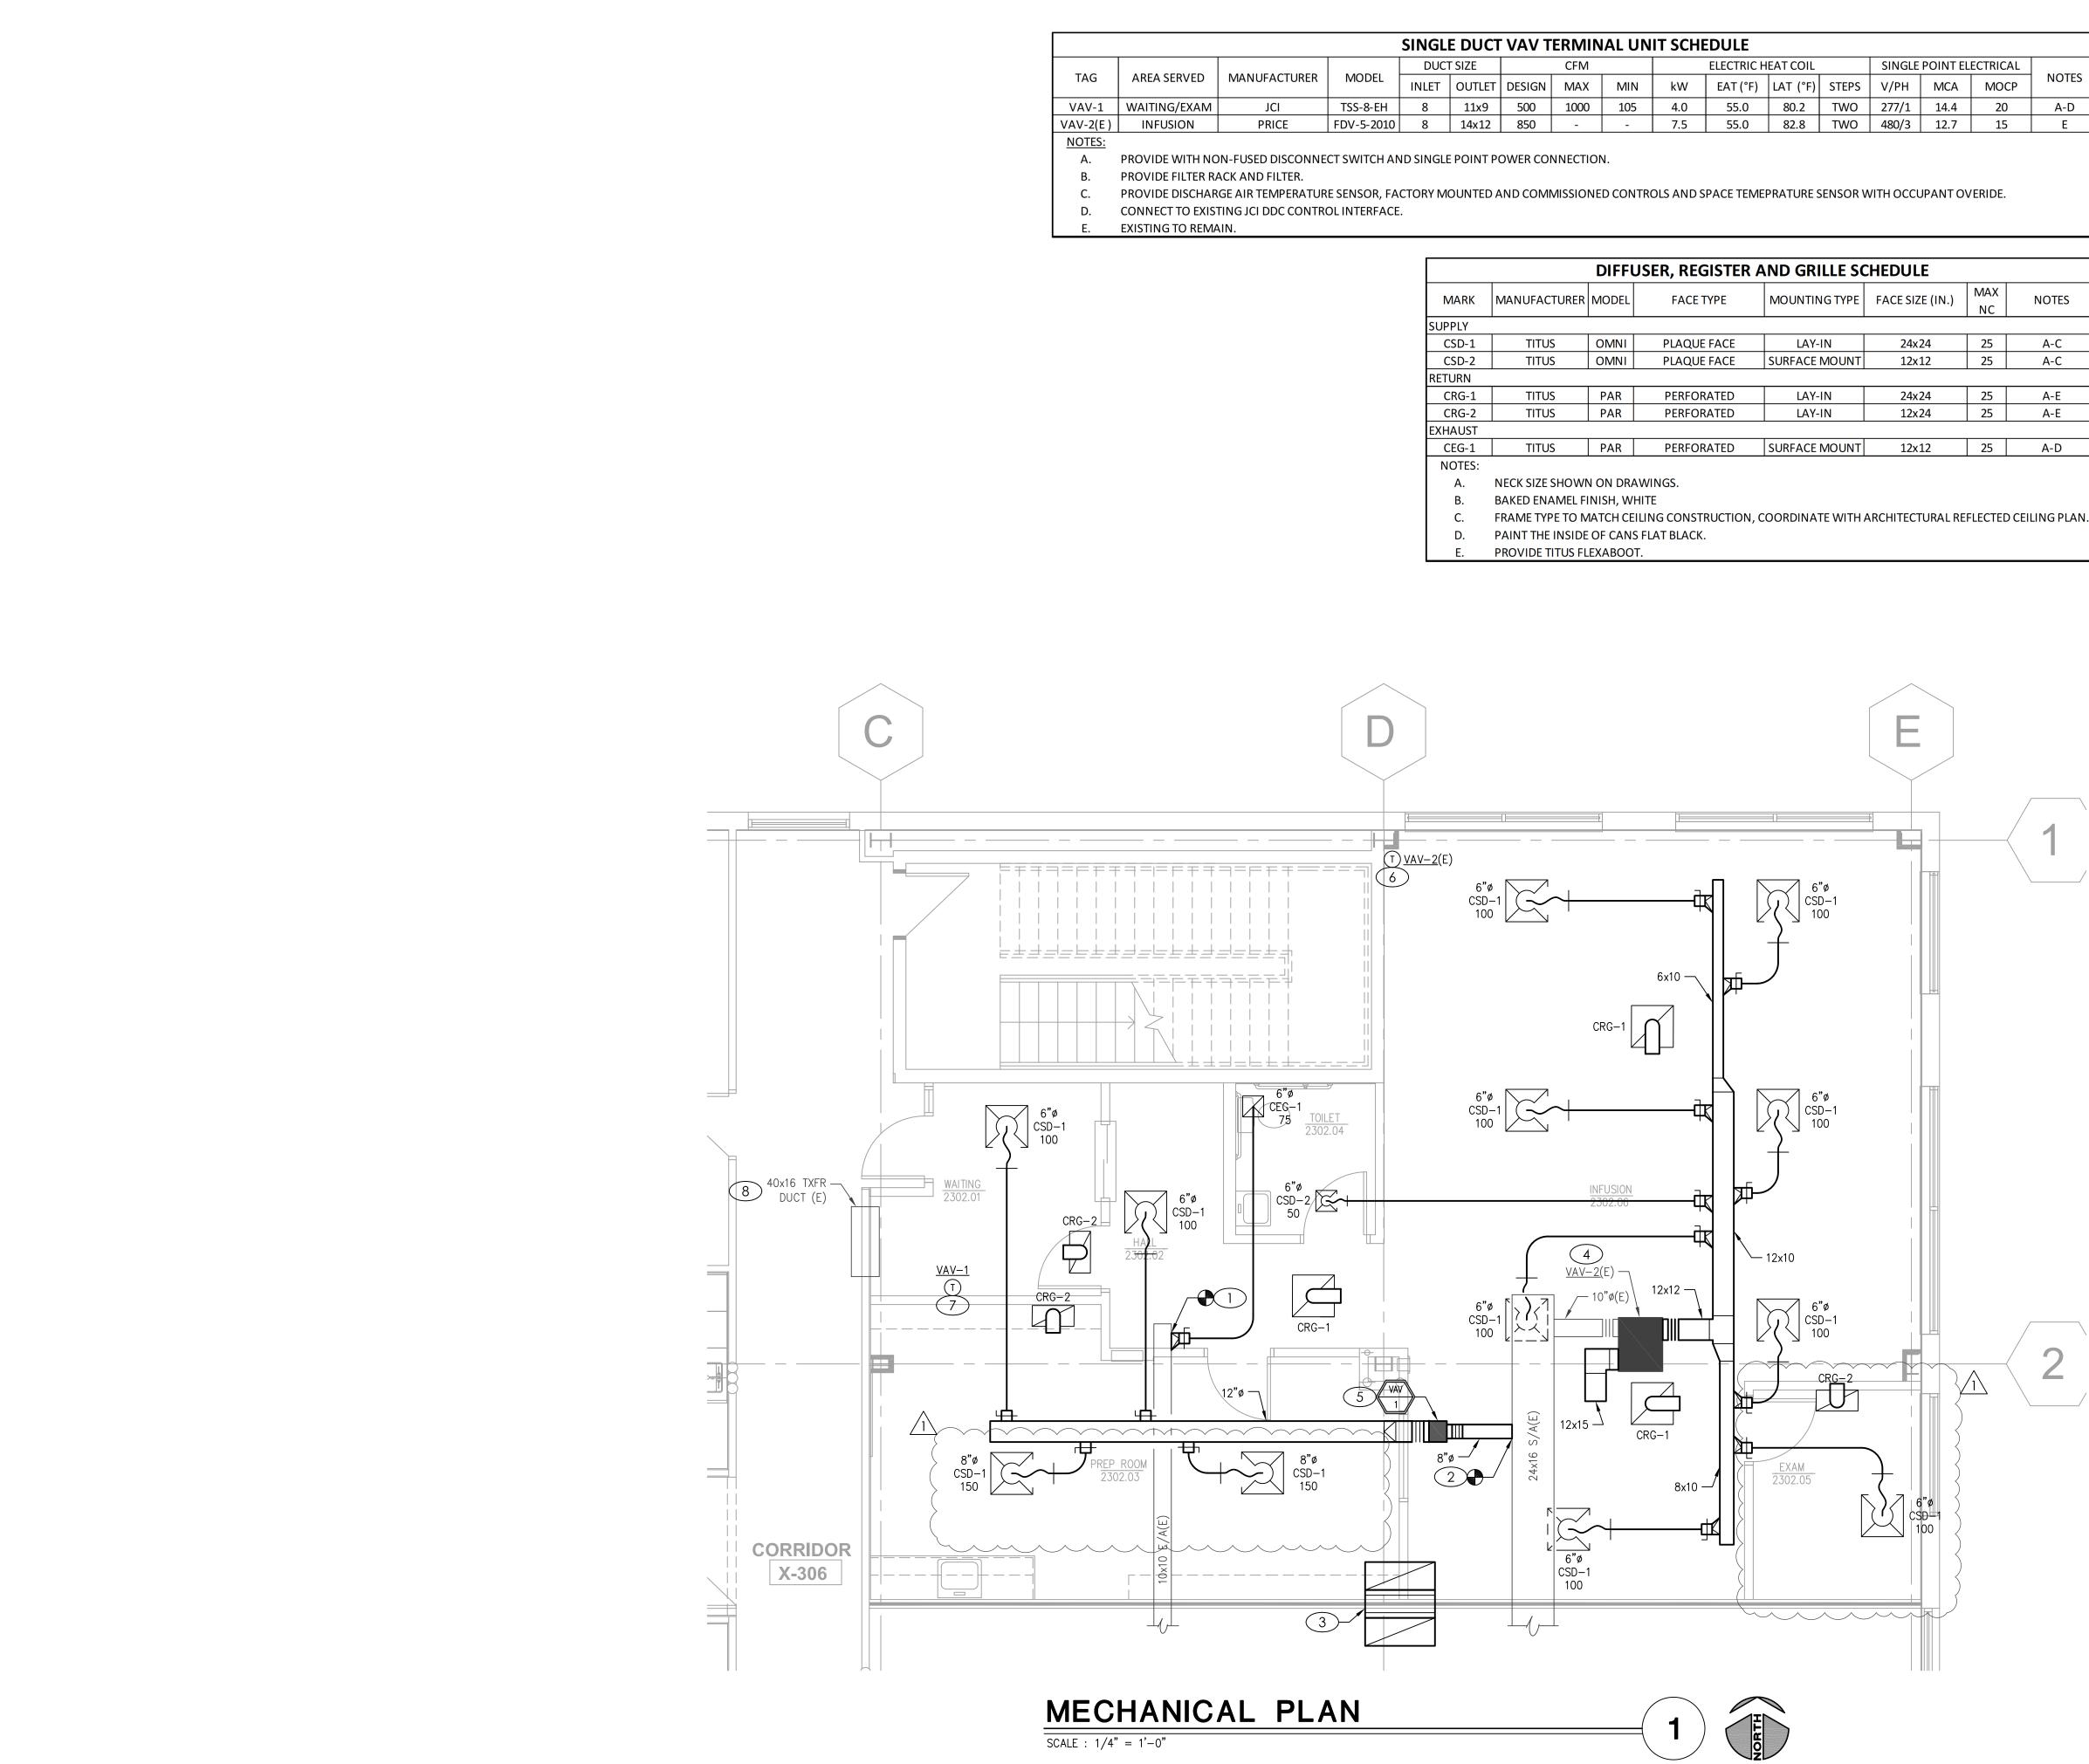

				SINGL	E DUCT	· VAV T	ERMIN	IAL UN	IT SCHE	DULE				
				DUC	T SIZE		CFM			ELECTRIC H	IEAT COIL		SINGLE	POINT EL
TAG	AREA SERVED	MANUFACTURER	MODEL	INLET	OUTLET	DESIGN	MAX	MIN	kW	EAT (°F)	LAT (°F)	STEPS	V/PH	MCA
VAV-1	WAITING/EXAM	JCI	TSS-8-EH	8	11x9	500	1000	105	4.0	55.0	80.2	TWO	277/1	14.4
VAV-2(E)	INFUSION	PRICE	FDV-5-2010	8	14x12	850	-	-	7.5	55.0	82.8	TWO	480/3	12.7
NOTES:														
Α.	PROVIDE WITH NC	N-FUSED DISCONNE	CT SWITCH AN	ND SINGLI	E POINT P	OWER CO	NECTIO	۷.						
В.	PROVIDE FILTER RA	ACK AND FILTER.												
С.	PROVIDE DISCHAR	GE AIR TEMPERATUR	E SENSOR, FA	CTORY M	OUNTED A	AND COM	VISSIONE	DCONTR	OLS AND S	PACE TEME	PRATURE S	SENSOR W	VITH OCCL	JPANT OV
D.	CONNECT TO EXIS	TING JCI DDC CONTR	OL INTERFACE											

		DIFFL	JSER, REGISTER	AND GRILLE SC	HEDULE		
MARK	MANUFACTURER	MODEL	FACE TYPE	MOUNTING TYPE	FACE SIZE (IN.)	MAX NC	NOTES
SUPPLY		· · · · ·					
CSD-1	TITUS	OMNI	PLAQUE FACE	LAY-IN	24x24	25	A-C
CSD-2	TITUS	OMNI	PLAQUE FACE	SURFACE MOUNT	12x12	25	A-C
RETURN							
CRG-1	TITUS	PAR	PERFORATED	LAY-IN	24x24	25	A-E
CRG-2	TITUS	PAR	PERFORATED	LAY-IN	12x24	25	A-E
EXHAUST							
CEG-1	TITUS	PAR	PERFORATED	SURFACE MOUNT	12x12	25	A-D
NOTES:							
Α.	NECK SIZE SHOWN	ON DRA	WINGS.				
В.	BAKED ENAMEL FI	NISH, WI	HITE				

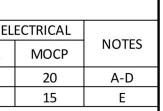

OVERIDE.

- DRAWINGS ARE DIAGRAMMATIC ONLY AND REPRESENT THE GENERAL SCOPE OF WORK. REVIEW THE GENERAL NOTES, SPECIFICATIONS AND PLANS FOR ADDITIONAL REQUIREMENTS THAT MAY NOT BE SPECIFICALLY CALLED OUT IN THIS PORTION OF THE CONSTRUCTION DOCUMENTS. NOTIFY ARCHITECT, ENGINEER AND/OR OWNER OF CONFLICTS OR DISCREPANCIES PRIOR TO SUBMISSION OF BID.
- B. COORDINATE INSTALLATION OF MECHANICAL AND PLUMBING SYSTEMS WITH OTHER TRADES TO ENSURE A NEAT AND ORDERLY INSTALLATION AND AVOID CONFLICTS. INSTALL DUCTWORK AND PIPING AS TIGHT TO STRUCTURE AS POSSIBLE. COORDINATE INSTALLATION OF DUCTWORK AND PIPING TO AVOID CONFLICTS WITH ELECTRICAL PANELS, LIGHTING FIXTURES, ETC. VERIFY DUCT SPACE AVAILABLE ABOVE ALL CEILINGS PRIOR TO ANY FABRICATION OF INSTALLATION.
- NEW MECHANICAL EQUIPMENT, DUCTWORK AND PIPING ARE SHOWN AT APPROXIMATE LOCATIONS. FIELD MEASURE FINAL DUCTWORK AND PIPING LOCATIONS PRIOR TO FABRICATION AND MAKE ADJUSTMENTS AS REQUIRED TO FIT THE DUCTWORK AND PIPING WITHIN THE AVAILABLE SPACE. VERIFY THAT FINAL EQUIPMENT LOCATIONS MEET MANUFACTURER'S RECOMMENDATIONS REGARDING SERVICE CLEARANCE AROUND EQUIPMENT.
- D. BRANCH DUCTWORK SHALL BE THE SAME SIZE AS NECK SIZE SHOWN UNLESS OTHERWISE NOTED.
- E. REFER TO SPECIFICATIONS FOR DUCTWORK AND PIPING INSULATION REQUIREMENTS. DUCT SIZES ON MECHANICAL PLANS ARE INDICATED CLEAR INSIDE AIRFLOW DIMENSIONS. INCREASE SHEET METAL SIZES ACCORDINGLY TO ACCOUNT FOR THICKNESS OF DUCT LINER.
- F. THE ELECTRICAL SYSTEM DESIGN IS BASED IN PART ON THE SPECIFIED HVAC EQUIPMENT. IT IS THE RESPONSIBILITY OF THE CONTRACTOR TO COORDINATE THE ELECTRICAL REQUIREMENTS OF THE HVAC EQUIPMENT BEING FURNISHED. ANY CHANGES TO THE ELECTRICAL SYSTEM DUE TO HVAC EQUIPMENT OTHER THAN THE SPECIFIED EQUIPMENT BEING FURNISHED SHALL BE PROVIDED AT NO ADDITIONAL COST TO THE OWNER.

KEYED PLAN NOTES


- 1. CONNECT NEW EXHAUST TAP TO EXISTING EXHAUST DUCTWORK WITH DAMPER. BALANCE TO CFM SHOWN.
- 2. CONNECT NEW SUPPLY DUCT TO EXISTING SUPPLY DUCTWORK. CONTINUE WITH DUCTWORK AS SHOWN.
- 3. PROVIDE 40x16 TRANSFER DUCT ABOVE DROP CEILING. TURN UP ON BOTH SIDES OF THE WALL. LINE INSIDE OF DUCT WITH 1/2" ACOUSTIC LINER PER SPECIFICATIONS.
- 4. EXISTING FAN POWERED TERMINAL UNIT. PROVIDE NEW SUPPLY AND RETURN DUCTWORK AS SHOWN.
- 5. PROVIDE NEW VAV TERMINAL UNIT AS SCHEDULED. MECHANICAL CONTRACTOR SHALL INCLUDE ALL COSTS AND COORDINATION EFFORTS TO CONNECT NEW VAV BOX TO EXISTING BUILDING AUTOMATION SYSTEM.
- RELOCATE EXISTING THERMOSTAT. MOUNT AT 54"AFF. COORDINATE EXACT 6. LOCATION WITH OWNER PRIOR TO INSTALLATION.
- 7. LOCATE THERMOSTAT ON WALL AT 54"AAF. COORDINATE EXACT LOCATION WITH OWNER PRIOR TO INSTALLATION.
- 8. EXISTING TRANSFER DUCT TO REMAIN.








RELEASED FOR CONSTRUCTION




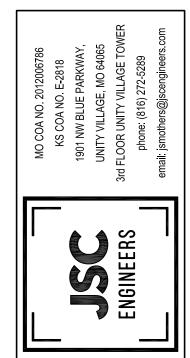

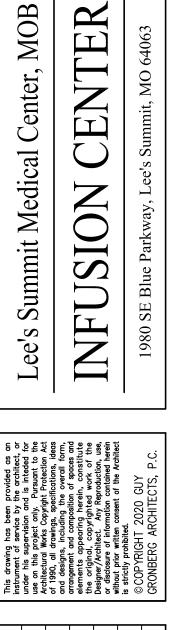

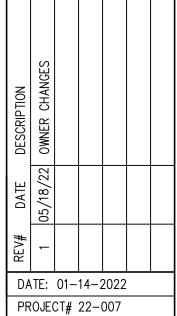

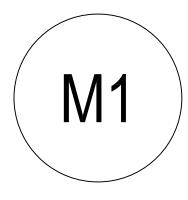

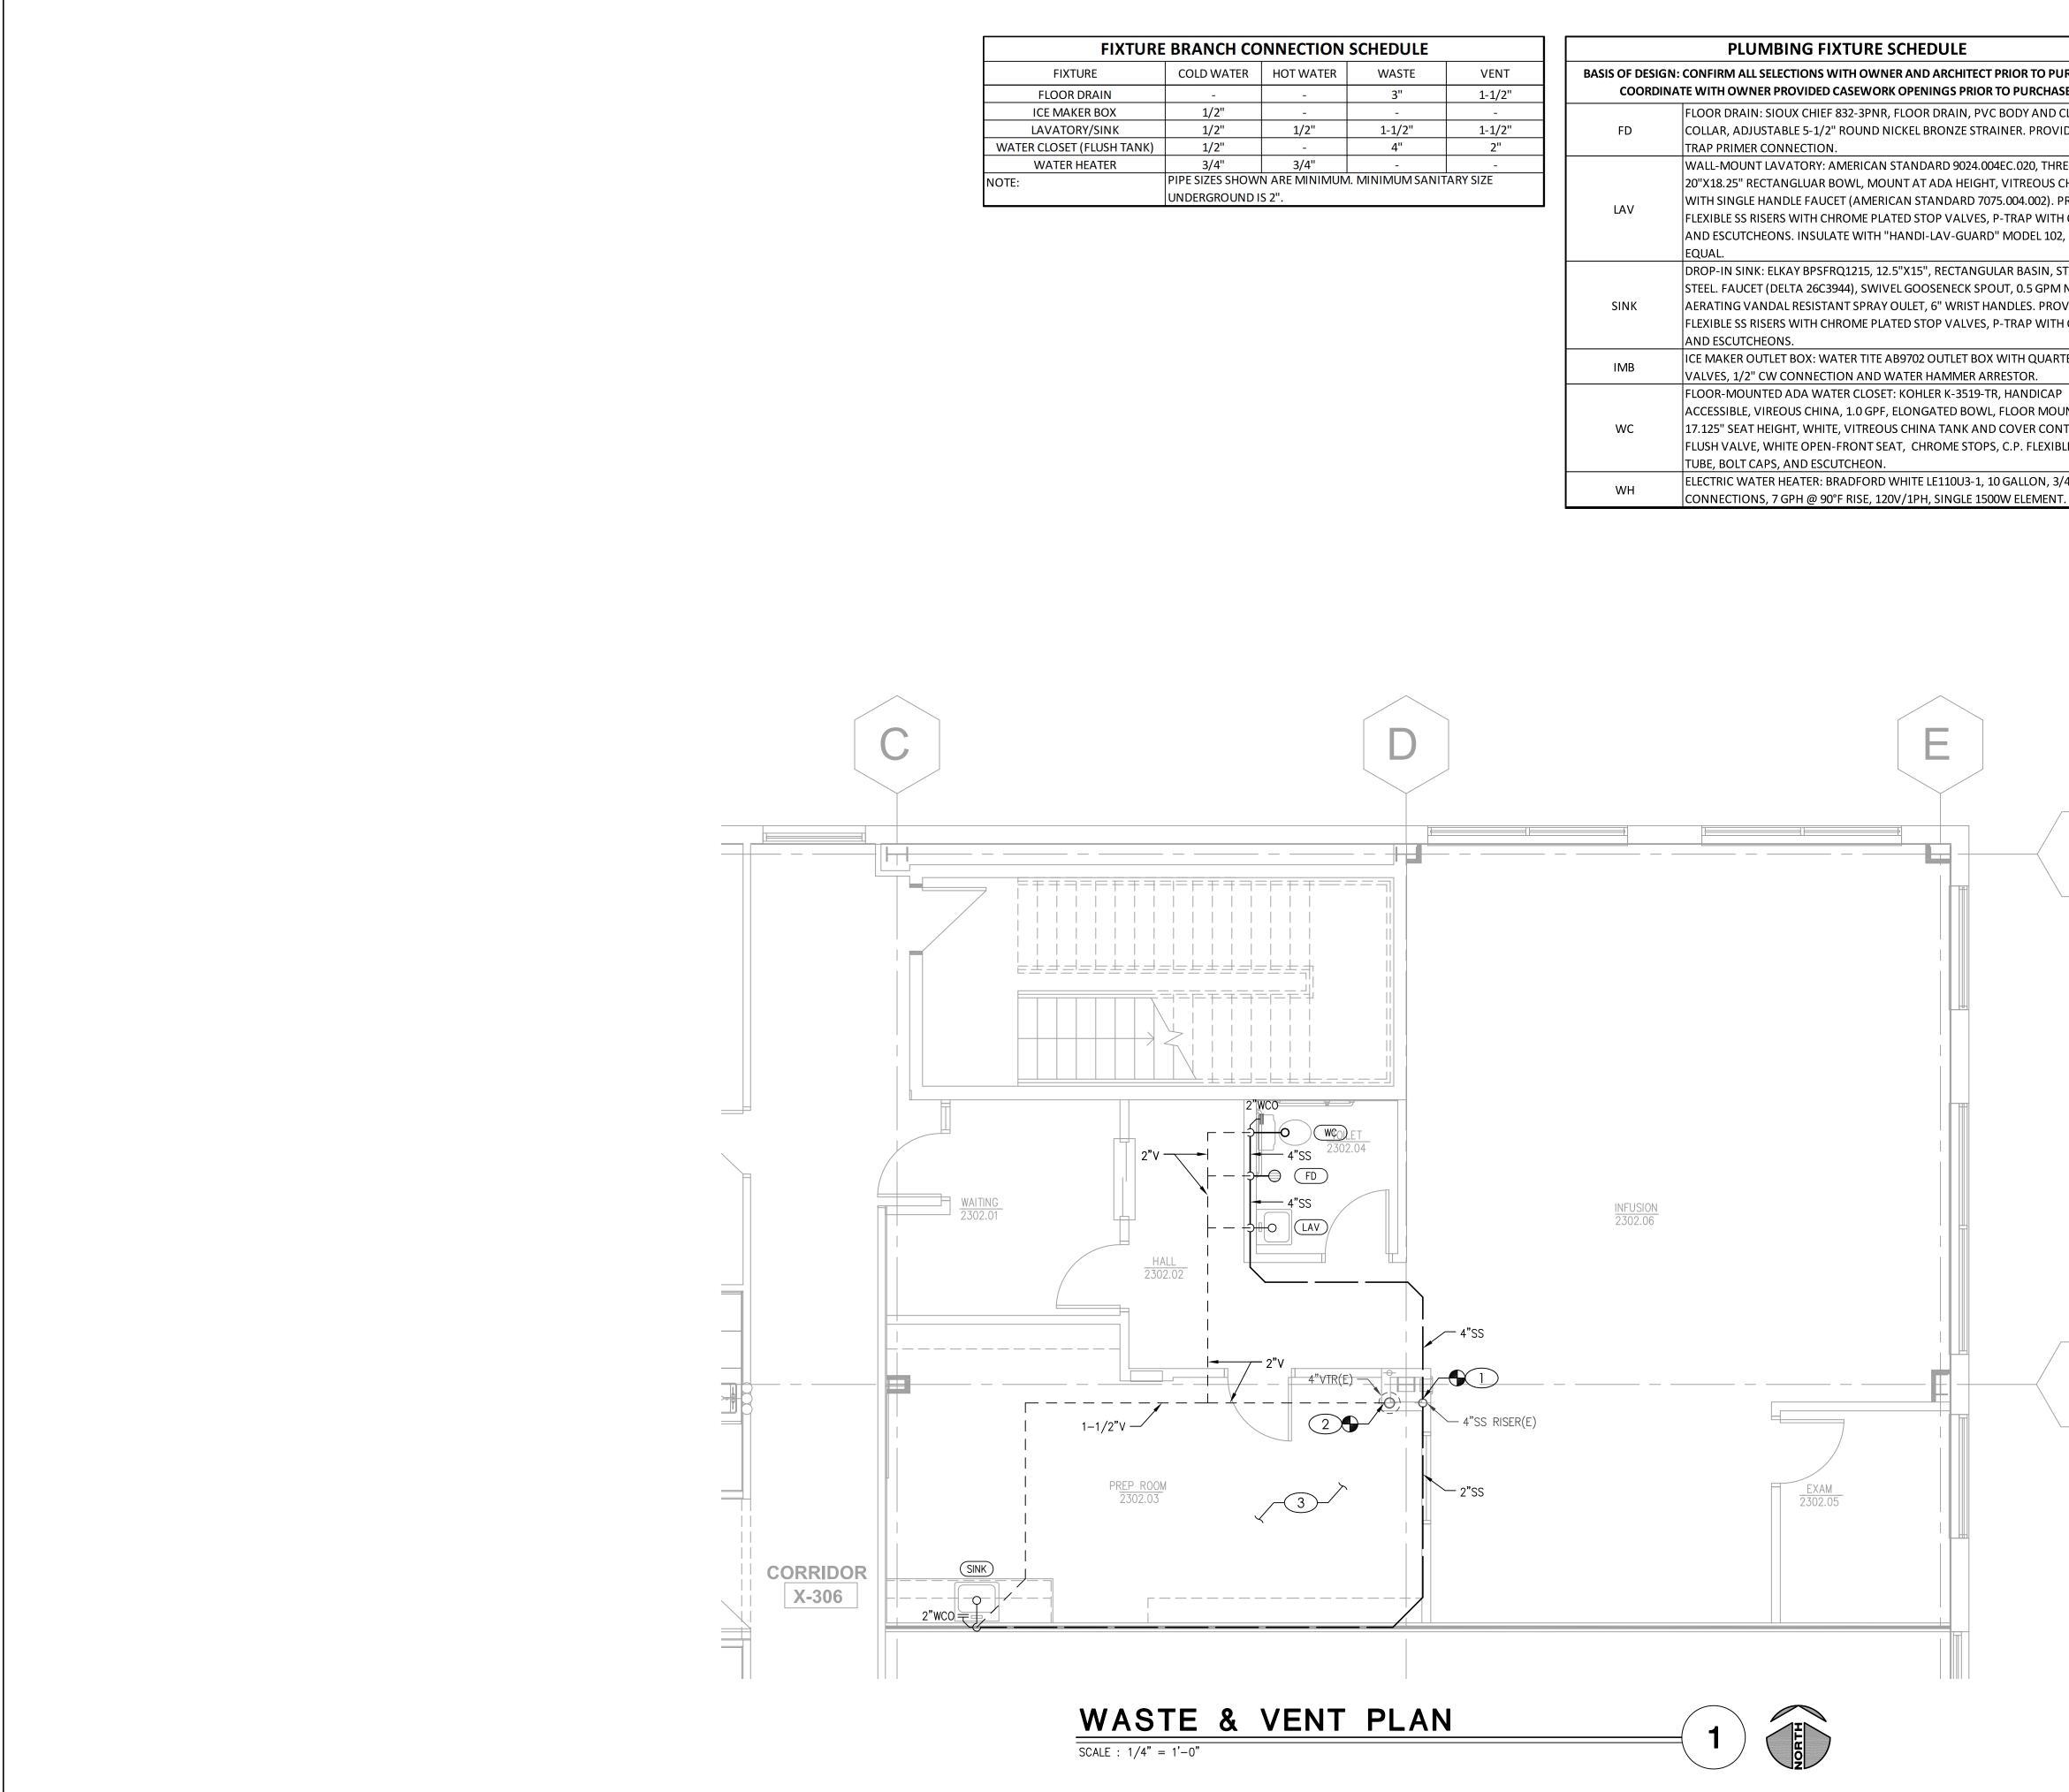

	PLUMBING FIXTURE SCHEDULE
BASIS OF DESI	GN: CONFIRM ALL SELECTIONS WITH OWNER AND ARCHITECT PRIOR TO PURCHASE.
COORD	INATE WITH OWNER PROVIDED CASEWORK OPENINGS PRIOR TO PURCHASE.
	FLOOR DRAIN: SIOUX CHIEF 832-3PNR, FLOOR DRAIN, PVC BODY AND CLAMPING
FD	COLLAR, ADJUSTABLE 5-1/2" ROUND NICKEL BRONZE STRAINER. PROVIDE WITH
	TRAP PRIMER CONNECTION.
	WALL-MOUNT LAVATORY: AMERICAN STANDARD 9024.004EC.020, THREE HOLE,
	20"X18.25" RECTANGLUAR BOWL, MOUNT AT ADA HEIGHT, VITREOUS CHINA,
	WITH SINGLE HANDLE FAUCET (AMERICAN STANDARD 7075.004.002). PROVIDE
LAV	FLEXIBLE SS RISERS WITH CHROME PLATED STOP VALVES, P-TRAP WITH CLEANOL
	AND ESCUTCHEONS. INSULATE WITH "HANDI-LAV-GUARD" MODEL 102, OR
	EQUAL.
	DROP-IN SINK: ELKAY BPSFRQ1215, 12.5"X15", RECTANGULAR BASIN, STAINLESS
	STEEL. FAUCET (DELTA 26C3944), SWIVEL GOOSENECK SPOUT, 0.5 GPM NON-
SINK	AERATING VANDAL RESISTANT SPRAY OULET, 6" WRIST HANDLES. PROVIDE
	FLEXIBLE SS RISERS WITH CHROME PLATED STOP VALVES, P-TRAP WITH CLEANOU
	AND ESCUTCHEONS.
IMB	ICE MAKER OUTLET BOX: WATER TITE AB9702 OUTLET BOX WITH QUARTER TURN
IIVID	VALVES, 1/2" CW CONNECTION AND WATER HAMMER ARRESTOR.
	FLOOR-MOUNTED ADA WATER CLOSET: KOHLER K-3519-TR, HANDICAP
	ACCESSIBLE, VIREOUS CHINA, 1.0 GPF, ELONGATED BOWL, FLOOR MOUNTED W/
WC	17.125" SEAT HEIGHT, WHITE, VITREOUS CHINA TANK AND COVER CONTAINING
	FLUSH VALVE, WHITE OPEN-FRONT SEAT, CHROME STOPS, C.P. FLEXIBLE RISER
	TUBE, BOLT CAPS, AND ESCUTCHEON.
WH	ELECTRIC WATER HEATER: BRADFORD WHITE LE110U3-1, 10 GALLON, 3/4"
VVII	

FIXTURE BRANCH CONNECTION SCHEDULE											
FIXTURE	COLD WATER	HOT WATER	WASTE	VENT							
FLOOR DRAIN	-	-	3"	1-1/2"							
ICE MAKER BOX	1/2"	-	-	-							
LAVATORY/SINK	1/2"	1/2"	1-1/2"	1-1/2"							
WATER CLOSET (FLUSH TANK)	1/2"	-	4"	2"							
WATER HEATER	3/4"	3/4"	-	-							
NOTE:	PIPE SIZES SHOW	N ARE MINIMUN	1. MINIMUM SANIT	ARY SIZE							
	UNDERGROUND IS 2".										

Α.

RIOR TO PURCHASE. PURCHASE.


R BASIN, STAINLESS , 0.5 GPM NON-DLES. PROVIDE RAP WITH CLEANOUT


- DRAWINGS ARE DIAGRAMMATIC ONLY AND REPRESENT THE GENERAL SCOPE OF WORK. REVIEW THE GENERAL NOTES, SPECIFICATIONS AND PLANS FOR ADDITIONAL REQUIREMENTS THAT MAY NOT BE SPECIFICALLY CALLED OUT IN THIS PORTION OF THE CONSTRUCTION DOCUMENTS. NOTIFY ARCHITECT, ENGINEER AND/OR OWNER OF CONFLICTS OR DISCREPANCIES PRIOR TO SUBMISSION OF BID.
- COORDINATE INSTALLATION OF MECHANICAL AND PLUMBING SYSTEMS WITH Β. OTHER TRADES TO ENSURE A NEAT AND ORDERLY INSTALLATION AND AVOID CONFLICTS. INSTALL DUCTWORK AND PIPING AS TIGHT TO STRUCTURE AS POSSIBLE. COORDINATE INSTALLATION OF DUCTWORK AND PIPING TO AVOID CONFLICTS WITH ELECTRICAL PANELS, LIGHTING FIXTURES, ETC. VERIFY DUCT SPACE AVAILABLE ABOVE ALL CEILINGS PRIOR TO ANY FABRICATION OF INSTALLATION.
- C. NEW MECHANICAL EQUIPMENT, DUCTWORK AND PIPING ARE SHOWN AT APPROXIMATE LOCATIONS. FIELD MEASURE FINAL DUCTWORK AND PIPING LOCATIONS PRIOR TO FABRICATION AND MAKE ADJUSTMENTS AS REQUIRED TO FIT THE DUCTWORK AND PIPING WITHIN THE AVAILABLE SPACE. VERIFY THAT FINAL EQUIPMENT LOCATIONS MEET MANUFACTURER'S RECOMMENDATIONS REGARDING SERVICE CLEARANCE AROUND EQUIPMENT.
- D. OVERHEAD HANGERS AND SUPPORTS FOR EQUIPMENT, DUCTWORK AND PIPING SHALL BE FASTENED TO BUILDING JOISTS OR BEAMS. DO NOT ATTACH HANGERS AND SUPPORTS TO THE ABOVE FLOOR SLAB OR ROOF.
- ALL ROOF AND WALL PENETRATIONS SHALL BE COORDINATED WITH THE Ε. GENERAL CONTRACTOR. PROVIDE ALL REQUIRED SLEEVES, FLASHINGS, CURBS, REINFORCED ANGLES, SUPPORTING FRAMES, ETC. UNLESS THEY ARE SPECIFICALLY CALLED OUT TO BE FURNISHED BY OTHERS.
- F PROVIDE THE GC WITH A COPY OF THE INSPECTION REPORTS AND APPROVAL CERTIFICATES FROM LOCAL AND STATE INSPECTIONS.
- G. EXACT LOCATION AND ELEVATIONS OF ALL EXISTING UTILITIES SHALL BE VERIFIED PRIOR TO ANY INSTALLATION OR CONNECTIONS THEREOF. ALL CONNECTIONS TO EXISTING UTILITIES (IE: WATER, SEWER & GAS) SHALL BE MADE WITH APPROVAL OF THE ADMINISTRATIVE AUTHORITY AND THE RESPECTIVE UTILITY COMPANY.
- H. REFER TO PLUMBING FIXTURE SCHEDULE FOR MINIMUM BRANCH WASTE AND VENT PIPE SIZING.


KEYED PLAN NOTES

- 1. CONNECT NEW SANITARY SEWER TO EXISTING SANITARY RISER. VERIFY SIZE, LOCATION, AND INVERT ELEVATION PRIOR TO START OF WORK.
- 2. CONNECT 2" VENT PIPE TO EXISTING VENT STACK GOING TO EXISTING 4"VTR.
- SANITARY PIPING TO BE ROUTED IN CEILING OF SPACE BELOW. COORDINATE REQUIRED SEQUENCE OF WORK WITH BUILDING OWNER PRIOR TO BID AND CONSTRUCTION.

\bigwedge
(REVISED FLOORPLAN)
REVISED FLOORPLAN

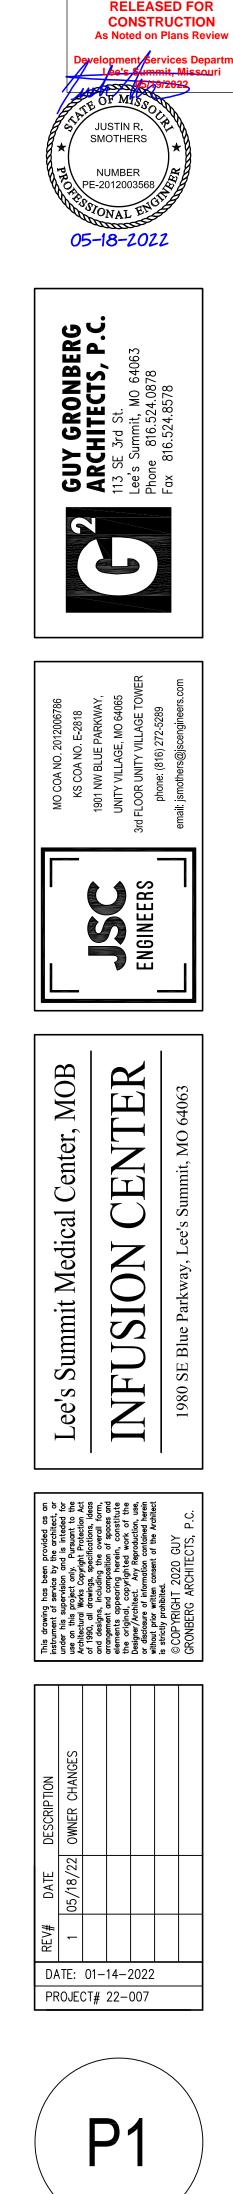

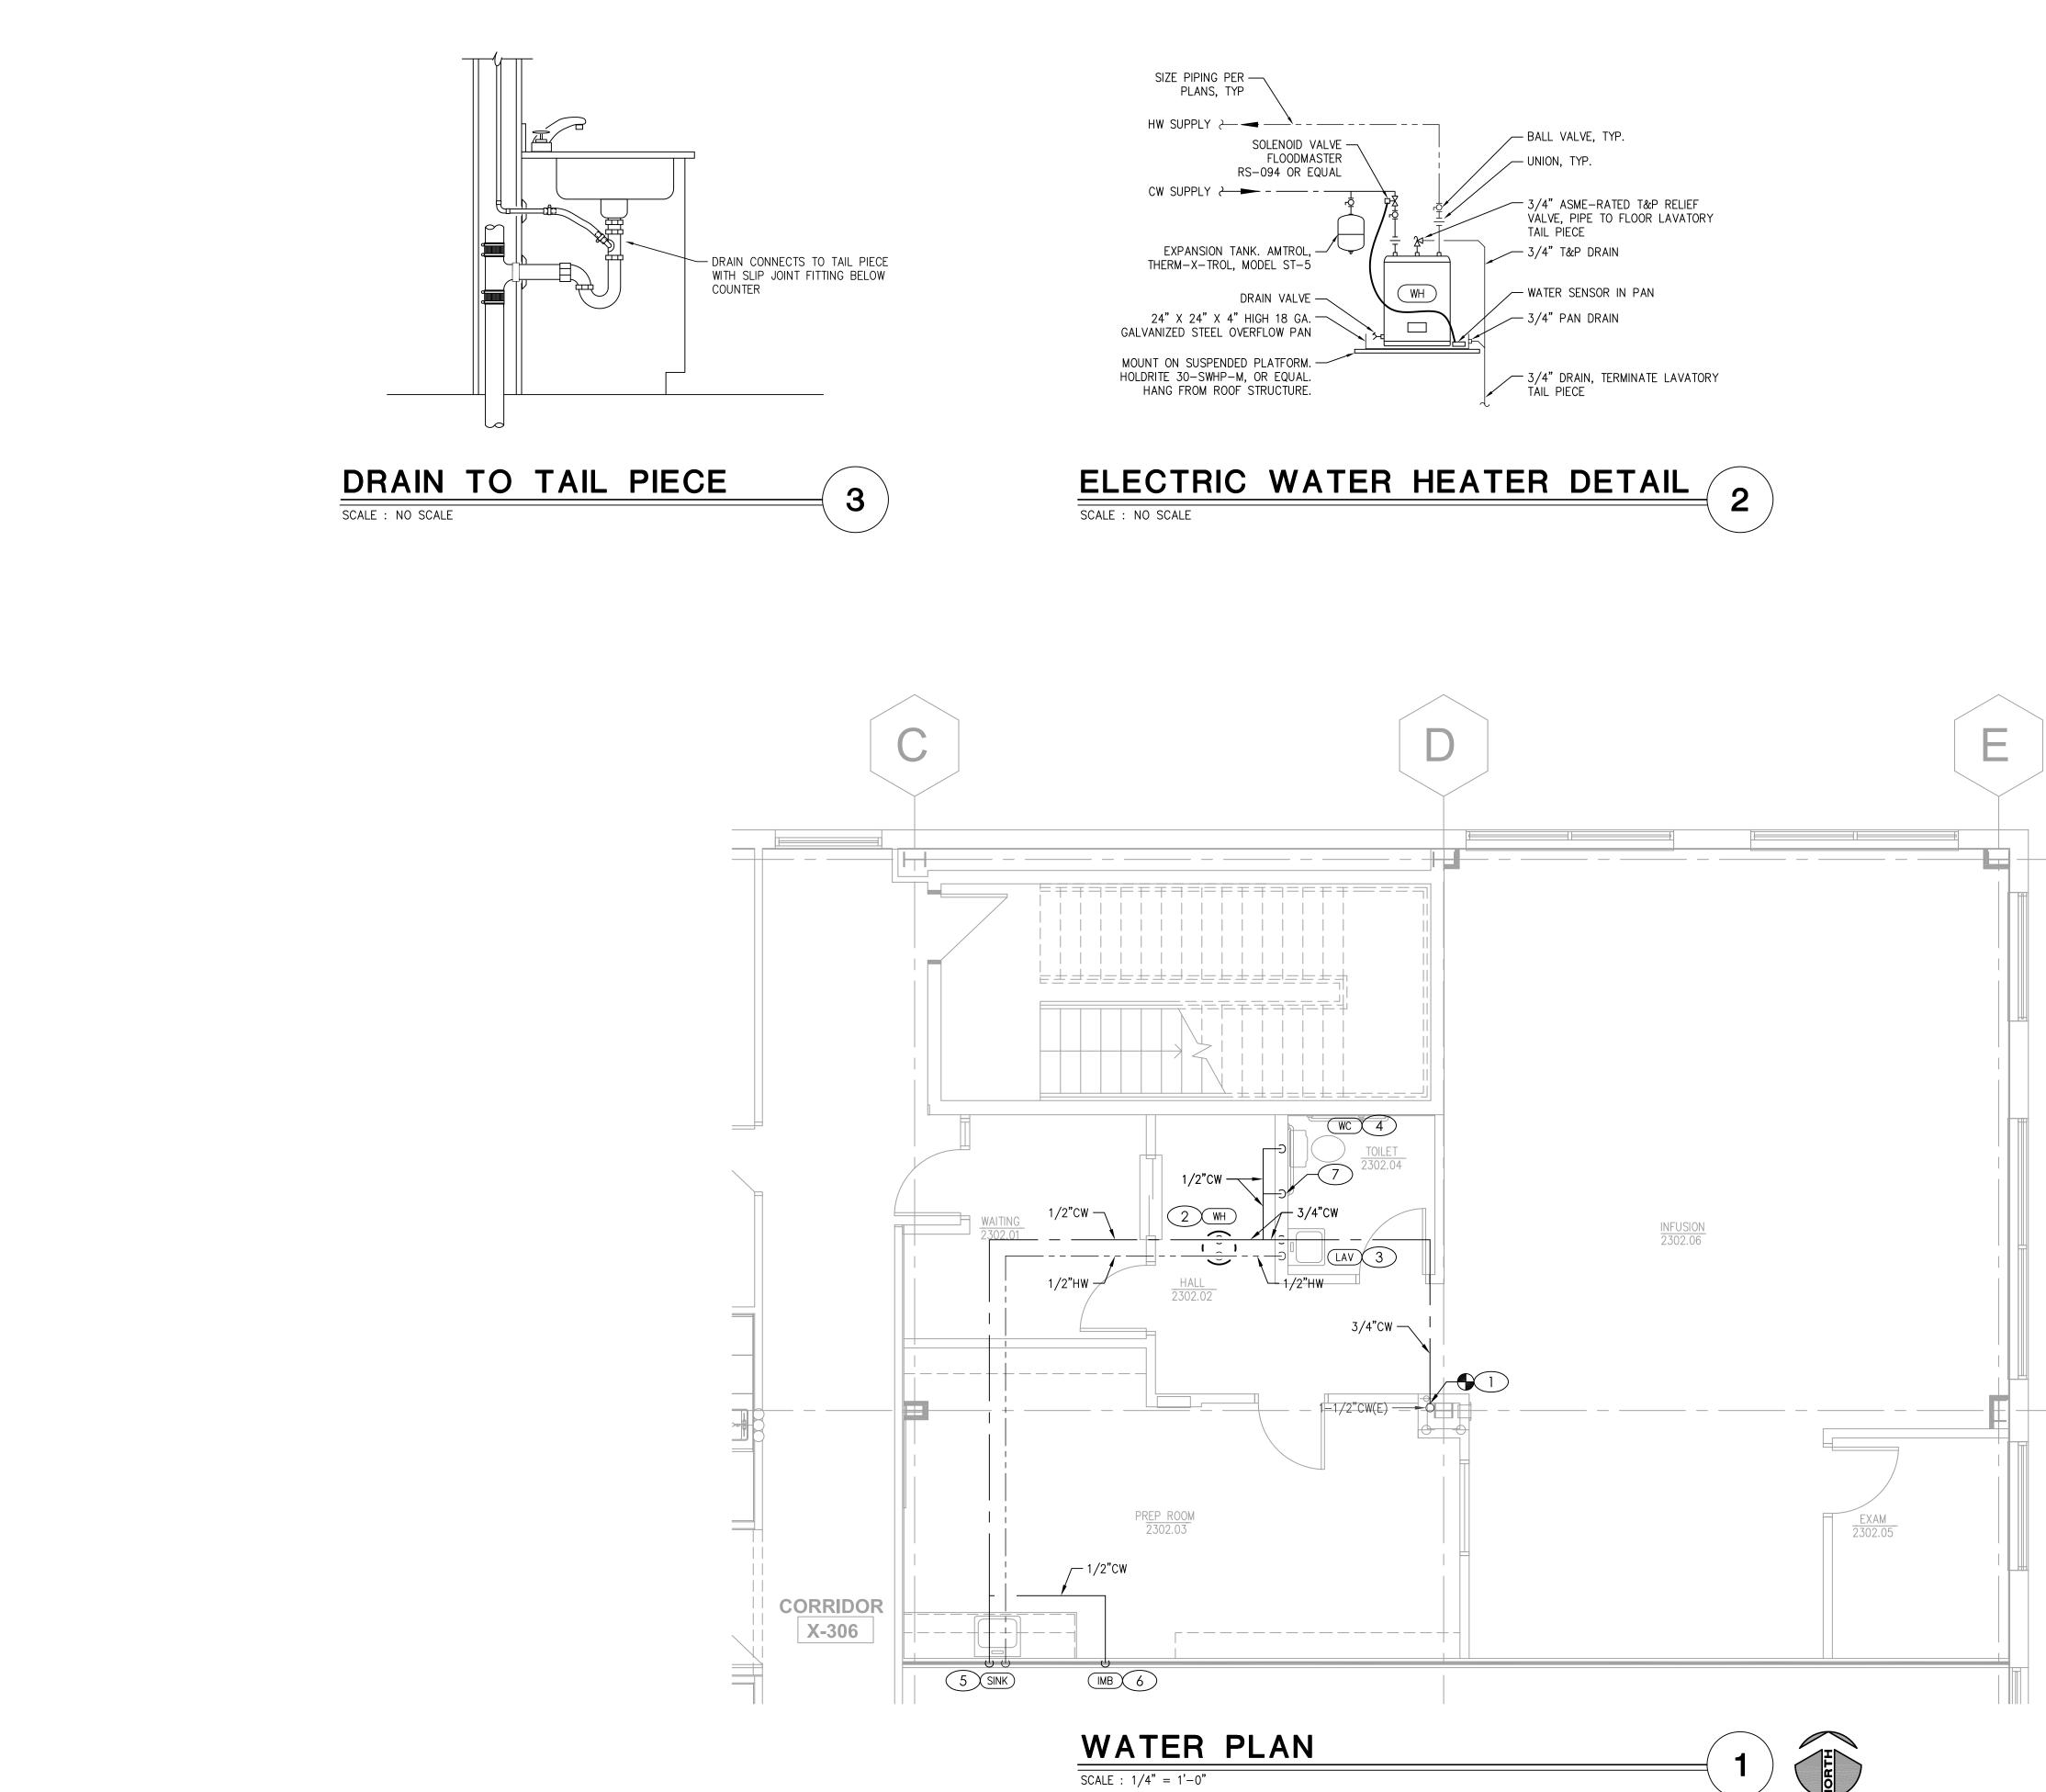

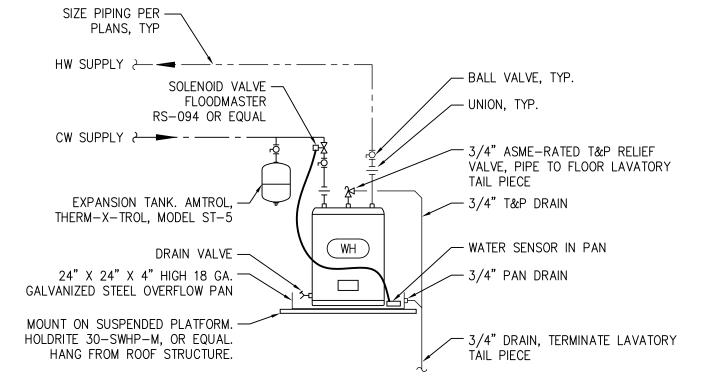



- A. DRAWINGS ARE DIAGRAMMATIC ONLY AND REPRESENT THE GENERAL SCOPE OF WORK. REVIEW THE GENERAL NOTES, SPECIFICATIONS AND PLANS FOR ADDITIONAL REQUIREMENTS THAT MAY NOT BE SPECIFICALLY CALLED OUT IN THIS PORTION OF THE CONSTRUCTION DOCUMENTS. NOTIFY ARCHITECT, ENGINEER AND/OR OWNER OF CONFLICTS OR DISCREPANCIES PRIOR TO SUBMISSION OF BID.
- B. COORDINATE INSTALLATION OF MECHANICAL AND PLUMBING SYSTEMS WITH OTHER TRADES TO ENSURE A NEAT AND ORDERLY INSTALLATION AND AVOID CONFLICTS. INSTALL DUCTWORK AND PIPING AS TIGHT TO STRUCTURE AS POSSIBLE. COORDINATE INSTALLATION OF DUCTWORK AND PIPING TO AVOID CONFLICTS WITH ELECTRICAL PANELS, LIGHTING FIXTURES, ETC. VERIFY DUCT SPACE AVAILABLE ABOVE ALL CEILINGS PRIOR TO ANY FABRICATION OF INSTALLATION.
- C. NEW MECHANICAL EQUIPMENT, DUCTWORK AND PIPING ARE SHOWN AT APPROXIMATE LOCATIONS. FIELD MEASURE FINAL DUCTWORK AND PIPING LOCATIONS PRIOR TO FABRICATION AND MAKE ADJUSTMENTS AS REQUIRED TO FIT THE DUCTWORK AND PIPING WITHIN THE AVAILABLE SPACE. VERIFY THAT FINAL EQUIPMENT LOCATIONS MEET MANUFACTURER'S RECOMMENDATIONS REGARDING SERVICE CLEARANCE AROUND EQUIPMENT.
- D. OVERHEAD HANGERS AND SUPPORTS FOR EQUIPMENT, DUCTWORK AND PIPING SHALL BE FASTENED TO BUILDING JOISTS OR BEAMS. DO NOT ATTACH HANGERS AND SUPPORTS TO THE ABOVE FLOOR SLAB OR ROOF.
- E. PROVIDE THE GC WITH A COPY OF THE INSPECTION REPORTS AND APPROVAL CERTIFICATES FROM LOCAL AND STATE INSPECTIONS.
- F. EXACT LOCATION AND ELEVATIONS OF ALL EXISTING UTILITIES SHALL BE VERIFIED PRIOR TO ANY INSTALLATION OR CONNECTIONS THEREOF. ALL CONNECTIONS TO EXISTING UTILITIES (IE: WATER, SEWER & GAS) SHALL BE MADE WITH APPROVAL OF THE ADMINISTRATIVE AUTHORITY AND THE RESPECTIVE UTILITY COMPANY.
- G. REFER TO PLUMBING FIXTURE SCHEDULE FOR MINIMUM BRANCH WASTE AND VENT PIPE SIZING.

KEYED PLAN NOTES

- 1. RELOCATE EXISTING WATER LINE INTO NEW CHASE AT COLUMN. CONNECT NEW 3/4 CW PIPING TO EXISTING 1-1/2 DOMESTIC WATER TAP IN TENANT SPACE. (PROVIDE TENANT ISOLATION VALVE ABOVE CEILING.)/1 $\overline{}$
- 2. MOUNT WATER HEATER ABOVE ACCESSIBLE CEILING. CONNECT 3/4"CW AND 3/4"HW TO WATER HEATER. PROVIDE 3/4" T&P RELIEF AND 3/4" CONTAINMENT PAN DRAINS FROM WATER HEATER TO LAVATORY TAIL PIECE IN RESTROOM. SEE WATER HEATER DETAIL ON THIS SHEET FOR ADDITIONAL REQUIRED COMPONENTS AND INSTALLATION INSTRUCTIONS.
- PROVIDE 1/2"CW AND 1/2"HW DOWN IN WALL TO LAVATORY. PROVIDE THERMOSTATIC MIXING VALVE FOR FIXTURE EQUAL TO LEONARD MODEL 170. SET HW SUPPLY WATER TEMPERATURE TO 110°F.
- 4. 1/2"CW DOWN IN WALL TO WATER CLOSET.
- 5. 1/2"CW AND 1/2"HW DOWN IN WALL TO SINK.
- 6. 1/2"CW DOWN IN WALL TO ICE MAKER BOX.


0


7. 1/2" CW DOWN TO TRAP PRIMER THEN CONTINUED TO CONNECTION AT FLOOR DRAIN. WATTS LFTP300 TRAP PRIMER, OR EQUAL. PROVIDE ACCESS PANEL.


REVISED FLOORPLAN \sim

Lee's Summit Mi JUSTIN R SMOTHERS NUMBER E-2012003568 05-18-2022 **GUY GRONBERG ARCHITECTS, P.C.** 113 SE 3rd St. Lee's Summit, M0 64063 Phone 816.524.0878 Fax 816.524.8578 Ř **GINEERS** MOB K ENTE enter, \bigcirc Lee's Summit Medical INFUSION

RELEASED FOR CONSTRUCTION As Noted on Plans Review

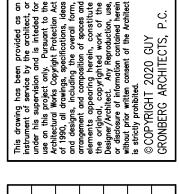

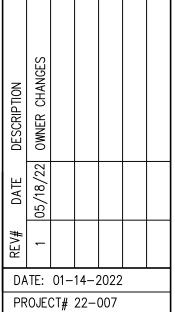

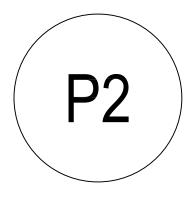

FOLLOWING ITEMS: FURNISH AND INSTALL A COMPLETELY WIRED AND OPERATIONAL ELECTRICAL SYSTEM AS SHOWN ON THE DRAWINGS AND SPECIFIED HEREIN, INCLUDING BUT NOT LIMITED TO, THESE MAJOR ITEMS. PANELS A. LIGHTING FIXTURES AS INDICATED AND SPECIFIED ON THE PLANS B. ELECTRICAL PANELS, SERVICE, CONDUIT, WIRING, ETC., FOR ALL OUTLETS AND EQUIPMENT. C. TELEPHONE, TELEVISION, AND FIRE ALARM. OUTLETS AND CONDUIT AS INDICATED. OBTAIN AND REVIEW ALL OTHER DRAWINGS INCLUDING REFLECTED CEILING PLAN, INTERIOR AND EXTERIOR ELEVATIONS, FURNITURE PLANS AND ALL MILL WORK DRAWINGS. COORDINATE INSTALLATION OF ALL ELECTRICAL DEVICES AND EQUIPMENT PRIOR TO ROUGH-IN. C. SYSTEM GROUNDING

- OBTAIN SUBMITTAL AND SHOP DRAWINGS FROM OTHER TRADES AND EQUIPMENT TO COORDINATE INSTALLATION ACCORDINGLY.
- 4. INSTALLATION SHALL COMPLY WITH ALL CURRENT APPLICABLE CODES AND GOVERNING AGENCIES HAVING JURISDICTION.
- FIRE ALARM SYSTEM, IF REQUIRED PER IBC, SHALL BE DESIGN-BUILD BY OWNER'S/GC'S FIRE ALARM CONTRACTOR. DESIGN SHALL BE IN ACCORDANCE WITH NFPA 72. FIRE ALARM CONTRACTOR SHALL SUBMIT STAMPED DRAWINGS TO AHJ FOR REVIEW AND APPROVAL. FIRE ALARM CONTRACTOR IS RESPONSIBLE FOR TESTING AND VERIFYING THAT THE AUDIBILITY OF THE FIRE ALARM SYSTEM MEETS A MINIMUM OF 15 DBA ABOVE AMBIENT NOISE LEVELS. ADD HORNS WHERE REQUIRED TO MAINTAIN MINIMUM LEVELS.
- PROVIDE FIRE STOP ON ALL PIPING THAT PENETRATES RATED WALLS. METHOD OF FIRE STOP SHALL MEET WALL RATING. REFER TO ARCHITECTURAL DRAWINGS FOR LOCATION OF FIRE RATED WALLS. THIS CONTRACTOR SHALL PROVIDE FIRE RATED ENCLOSURES AROUND ALL ROUGH-IN BOXES, PANELS, ETC. THAT ARE LOCATED IN FIRE RATED WALLS AND SHALL FIRE CAULK ALL OPENINGS IN RATED ASSEMBLIES.

B. RELATED WORK BY OTHERS

<u> PART I – GENERAL</u>

<u>A. CONDITIONS</u>

- THE ELECTRICAL CONTRACTOR SHALL PROVIDE CONDUIT, TRENCH, AND BACKFILL FOR ELECTRICAL SERVICE ENTRANCE FROM THE MAIN SERVICE TO UTILITY POINT OF ELECTRICAL SERVICE. ELECTRICAL CONTRACTOR SHALL COORDINATE THE INSTALLATION OF THE ELECTRICAL SERVICE ENTRANCE WITH
- SERVING UTILITY COMPANY. THE ELECTRICAL CONTRACTOR SHALL PROVIDE CONDUIT. TRENCH, AND BACKFILL FOR PRIMARY PHONE AND CATV SERVICE FROM THE TELEPHONE TERMINAL BOARD OR CABINET TO THE PHONE COMPANY AND CATV COMPANY POINT OF SERVICE COORDINATE WITH LOCAL UTILITY COMPANIES.

<u>C. CODES, REGULATIONS, AND STANDARDS</u>

- THE INSTALLATION SHALL COMPLY WITH APPLICABLE LOCAL AND STATE CODES AND ORDINANCES, WITH THE REGULATIONS OF THE LATEST EDITION OF THE NATIONAL ELECTRIC CODE AND WITH THE REQUIREMENTS OF THE POWER, TELEPHONE, AND CATV COMPANIES FURNISHING SERVICES TO THIS
- INSTALLATION. THE LATEST EDITIONS OF THE FOLLOWING INDUSTRY STANDARDS, SPECIFICATIONS, AND CODES ARE
- MINIMUM REQUIREMENTS: A. THE NATIONAL ELECTRICAL MANUFACTURER'S ASSOCIATION STANDARDS.
- B. THE NATIONAL ELECTRICAL CODE, INCLUDING LOCAL AMENDMENTS.
- C. UNDERWRITER LABORATORIES INCORPORATED STANDARDS.
- D. AMERICAN NATIONAL STANDARDS INSTITUTE. E. INTERNATIONAL BUILDING CODE

D. INSPECTION OF SITE

- PRIOR TO SUBMITTING A BID FOR ELECTRICAL WORK, THE CONTRACTOR SHALL VISIT THE SITE OF THE PROPOSED CONSTRUCTION AND SHALL THOROUGHLY ACQUAINT HIMSELF WITH EXISTING UTILITIES, AND WORKING CONDITIONS TO BE ENCOUNTERED, ETC. ALLOWANCE WILL NOT BE MADE FOR NONCOMPLIANCE WITH THIS CONDITION AFTER BIDDING.
- ELECTRICAL INSTALLATION SHALL MEET THE EXISTING CONDITIONS.
- E. STORAGE AND HANDLING OF MATERIAL
- DELIVER MATERIALS AND EQUIPMENT TO THE PROJECT IN THE MANUFACTURER'S ORIGINAL, UNOPENED, LABELED CONTAINERS. PROTECT AGAINST MOISTURE, TAMPERING, OR DAMAGE FROM IMPROPER HANDLING OR STORAGE. CONTRACTOR SHALL PROTECT AND BE RESPONSIBLE FOR ANY DAMAGE TO WORK OR MATERIALS UNTIL FINAL ACCEPTANCE BY THE OWNER, AND SHALL MAKE GOOD WITHOUT COST TO THE OWNER, ANY DAMAGE OR LOSS THAT MAY OCCUR DURING THIS PERIOD.
- ARRANGE FOR TIMELY DELIVERY OF MATERIALS AND EQUIPMENT TO THE JOB SITE IN ORDER TO MINIMIZE THE LENGTH OF TIME BETWEEN DELIVERY AND INSTALLATION. COVER AND PROTECT ANY MATERIAL WHICH MAY BE AFFECTED BY THE WEATHER WHILE IN TRANSIT OR
- STORED AT THE PROJECT SITE. ANY MATERIAL FOUND DEFECTIVE OR NOT INSTALLED IN ACCORDANCE WITH THE CONTRACT DOCUMENTS MAY BE REJECTED BY THE ENGINEER. CLEANUP
- KEEP THE PREMISES FREE FROM ACCUMULATION OF WASTE MATERIALS. OR RUBBISH CAUSED BY EMPLOYEES OR WORK UNDER THIS DIVISION OF THE SPECIFICATIONS. AT THE COMPLETION OF THE WORK REMOVE ALL SURPLUS MATERIALS, TOOLS, ETC., AND LEAVE THE PREMISES BROOM-CLEAN.

<u>G. EXCAVATION, CUTTING, AND FITTING</u>

- PERFORM ALL EXCAVATION AND BACK FILLING REQUIRED FOR WORK PERFORMED UNDER THIS DIVISION OF THE SPECIFICATIONS. USE EXCAVATED MATERIALS FOR BACKFILL UNLESS OFF SITE MATERIALS ARE DEEMED NECESSARY.
- PERFORM THE EXCAVATION, CUTTING, FITTING, REPAIRING, AND FINISHING OF THE WORK NECESSARY FOR THE INSTALLATION OF THE EQUIPMENT OF THIS SECTION. HOWEVER, NO CUTTING OF THE WORK OF OTHER TRADES OR OF ANY STRUCTURAL MEMBERS SHALL BE DONE WITHOUT THE CONSENT OF THE ARCHITECT.
- H. DRAWINGS
- THE DRAWINGS INDICATE THE GENERAL ARRANGEMENT AND LOCATIONS OF THE ELECTRICAL WORK DATA PRESENTED ON THESE DRAWINGS ARE AS ACCURATE AS PLANNING CAN DETERMINE, BUT FIELD VERIFICATION OF ALL DIMENSIONS, LOCATIONS, LEVELS, ETC., TO SUIT FIELD CONDITIONS IS REQUIRED. REVIEW ALL ARCHITECTURAL, STRUCTURAL, AND MECHANICAL DRAWINGS AND ADJUST ALL WORK TO MEET THE REQUIREMENTS OF CONDITIONS SHOWN. THE ARCHITECTURAL DRAWINGS SHALL TAKE PRECEDENCE OVER ALL OTHER DRAWINGS. DISCREPANCIES BETWEEN DIFFERENT PLANS, OR BETWEEN DRAWINGS AND SPECIFICATIONS, OR REGULATIONS AND CODES GOVERNING THE INSTALLATION SHALL BE BROUGHT TO THE ATTENTION OF THE ENGINEER IN WRITING BEFORE THE DATE OF BID OPENING. IF DISCREPANCIES ARE NOT REPORTED, THE CONTRACTOR SHALL BID THE GREATER QUANTITY OR BETTER QUALITY, AND APPROPRIATE ADJUSTMENTS WILL BE MADE AFTER CONTRACT AWARD. CONTRACTOR SHALL BE RESPONSIBLE TO FIELD MEASURE AND CONFIRM MOUNTING HEIGHTS AND LOCATION OF ELECTRICAL EQUIPMENT WITH RESPECT TO COUNTERS, RADIATION, ETC. DO NOT SCALE DISTANCES OFF THE ELECTRICAL DRAWINGS, USE ACTUAL BUILDING DIMENSIONS.

. COOPERATION WITH OTHER CONTRACTORS

- COOPERATE WITH THE OTHER TRADES SO THAT THE INSTALLATION OF THE ELECTRICAL OUTLETS AND EQUIPMENT WILL BE PROPERLY COORDINATED. CONDUIT, LIGHTING FIXTURES, AND OTHER EQUIPMENT LOCATIONS SHALL BE VERIFIED WITH OTHER TRADES TO AVOID CONFLICT WITH THE PIPING, DUCTWORK, STEEL, BEAMS, OR OTHER OBSTRUCTIONS.
- CAREFULLY VERIFY THE LOCATIONS OF THE OUTLET BOXES AND DETERMINE THAT THEY HAVE NOT BEEN DISTURBED DURING THE INSTALLATION OF MATERIALS OF OTHER TRADES.
- COORDINATE THE LOCATION OF THE TRENCHES AND CONDUITS FOR ELECTRICAL AND TELEPHONE UTILITY SERVICES WITH THE GENERAL CONTRACTOR. COORDINATE HVAC AND PLUMBING EQUIPMENT CONNECTION REQUIREMENTS WITH HVAC AND PLUMBING
- CONTRACTORS.
- I. RECORD DRAWINGS THE ELECTRICAL CONTRACTOR SHALL MAINTAIN A SET OF DRAWINGS AT THE JOB SITE FOR THE EXCLUSIVE PURPOSE OF MAINTAINING A RECORD OF ALL WORK INSTALLED AND TO SHOW ANY DEVIATIONS FROM THE WORK INDICATED ON THE DRAWINGS.
- AT THE COMPLETION OF THE PROJECT, ONE SET OF REPRODUCIBLE DRAWINGS, SHOWING ALL RECORD CONDITIONS, SHALL BE DELIVERED TO THE OWNER FOR ACCEPTANCE PRIOR TO FINAL PAYMENT.

PART II - PRODUCTS AND EXECUTION

- A. MATERIALS
- ALL MATERIALS SHALL BE NEW AND OF QUALITY AS SPECIFIED ON THE PLANS OR SPECIFICATIONS AND MUST CARRY THE UNDERWRITER'S LABORATORIES APPROVAL COVERING THE PURPOSE FOR WHICH THEY ARE USED, IN ADDITION TO MEETING ALL REQUIREMENTS OF THE CURRENT APPLICABLE CODES AND REGULATIONS.
- **B. SHOP DRAWINGS AND APPROVALS**
- THE ITEMS SPECIFIED HEREIN AND ON DRAWINGS ARE USED AS A STANDARD OF QUALITY. ANY MATERIALS OF EQUAL QUALITY AND AESTHETIC VALUE WILL BE GIVEN CONSIDERATION AS A SUBSTITUTE FOR THE MATERIALS SPECIFIED. NO APPROVAL WILL BE GIVEN TO A SPECIFIC CATALOG NUMBER, MODEL, OR TYPE OF EQUIPMENT, PRIOR TO BIDDING. AFTER BIDDING, THE DECISION OF THE ARCHITECT AND/OR ENGINEER DETERMINING EQUAL MATERIALS WILL BE FINAL.

- A. LIGHTING FIXTURE CUTS AND PERFORMANCE DATA.
- B. OUTLINE DRAWINGS AND DATA SHEETS OF EACH PANELBOARD, LOAD CENTERS, AND DISTRIBUTION
- C. OUTLINE DRAWINGS OF ALL SWITCH GEAR COMPONENTS.
- D. WIRING DEVICES AND COVERPLATES. E. ALL CIRCUIT BREAKERS INSTALLED IN PANELBOARDS, LOAD CENTERS, AND DISTRIBUTION PANELS. 3. SUBMIT ITEMS AT ONE TIME IN A NEAT AND ORDERLY MANNER WITHIN 15 DAYS OF AWARD OF CONTRACT. PARTIAL SUBMITTALS WILL NOT BE ACCEPTABLE.

- GROUNDING CONDUCTOR AT A SINGLE PLACE IN EACH SYSTEM BY REMOVABLE BONDING JUMPERS, SIZED ACCORDING TO THE APPLICABLE PROVISIONS OF THE NATIONAL ELECTRICAL CODE. THE GROUNDED CONDUCTOR (NEUTRAL) TO THE GROUNDING CONDUCTOR CONNECTION SHALL BE LOCATED IN THE ENCLOSURE FOR THE SYSTEM'S OVERCURRENT PROTECTION OR WHERE OTHERWISE INDICATED ON THE PLANS OR SPECIFICATIONS.
- 3. A GROUND BUS SEPARATE FROM THE NEUTRAL BUS SHALL BE PROVIDED IN ALL DISTRIBUTION PANELS AND PANELBOARDS. PROPER TORQUE ON GROUND BUS SHALL BE VERIFIED, PER MANUFACTURER'S RECOMMENDATIONS, PRIOR TO ENERGIZING EQUIPMENT. 4. GROUND BUSES AND NEUTRAL BUSES IN ALL DISTRIBUTION PANELS, LOAD CENTERS, PANELBOARDS, AND
- THOSE PROVIDED IN ANY EQUIPMENT SHALL BE ISOLATED EXCEPT WHERE REQUIRED TO BE CONNECTED AS SPECIFIED ABOVE FOR THE SERVICE ENTRANCE WHEN INDICATED ON THE DRAWINGS, EQUIPMENT GROUNDING CONDUCTORS SHALL BE EXTENDED FROM THE GROUND BUS IN THE DISTRIBUTION EQUIPMENT TO THE RECEPTACLE, FIXTURE OR DEVICE LUGS WHERE THEY ARE PROVIDED. WHERE LUGS ARE NOT PROVIDED, EQUIPMENT GROUNDING CONDUCTORS SHALL BE CONNECTED TO EQUIPMENT ENCLOSURES. THE CONNECTIONS SHALL BE ARRANGED SUCH THAT REMOVAL OF THE RECEPTACLE, EQUIPMENT GROUND CONDUCTORS, OR GROUND JUMPERS FROM GROUND
- BUSING SHALL NOT AFFECT THE GROUND SYSTEM.
- RACEWAYS MAY NOT BE USED AS A GROUNDING CONDUCTOR FOR POWER AND LIGHTING CIRCUITS. ALL CONDUIT SHALL HAVE SEPARATE CODE SIZED GREEN GROUND WIRE INSTALLED IN THE CONDUIT TO INSURE A CONTINUOUS GROUNDING PATH.
- IN INACCESSIBLE LOCATIONS, MAKE CONNECTIONS BY EXOTHERMIC WELD PROCESS. IN ACCESSIBLE LOCATIONS, CONNECTIONS SHALL BE MADE WITH BOLTED THROUGH, APPROVED
- SOLDERLESS BRONZE GROUNDING DEVICES.
- CONDUCTOR SIZES SHOWN ON THE DRAWINGS ARE BASED ON COPPER WIRE. UNLESS OTHERWISE SPECIFIED, ALL WIRE SHALL BE TYPE XHHW OR SE FOR FEEDERS OR BRANCH CIRCUITS LARGER THAN 4 AWG, TYPE THHN/THWN INSULATION FOR FEEDERS AND BRANCH CIRCUITS 4 AWG AND SMALLER. ALL BRANCH CIRCUIT WIRING SHALL BE COPPER.
- ALUMINUM CONDUCTORS MAY BE UTILIZED FOR SERVICE ENTRANCE AND PANEL FEEDERS. CONDUCTORS SHALL BE ALUMINUM ALLOW AA-8000 SERIES.
- THE WIRES SHALL BE MARKED WITH COLOR TO SIMPLIFY CIRCUIT IDENTIFICATION. UNLESS OTHERWISE REQUIRED BY LOCAL ORDINANCES GROUND WIRES SHALL BE GREEN, NEUTRAL WIRES SHALL BE 120V-WHITE, AND LIVE WIRES 208Y/120V AND 120/240 SHALL BE BLACK (PHASE A), RED (PHASE B), AND BLUE (PHASE C). CIRCUIT SHALL BE LABELED IN EACH J-BOX.
- ALL CONDUCTORS SHALL BE RATED 600 VOLT. SPLICES IN EXTERIOR PULL BOXES AND MANHOLES SHALL BE WEATHERPROOF USING "SCOTCHCAST" SPLICE KIT OR APPROVED EQUAL. SEAL ENDS OF CONDUITS AND DUCTS WITH "DUCTSEAL" OR APPROVED EQUAL.
- PROVIDE SOLID CONDUCTOR FOR 12 AWG AND SMALLER. ALL WIRING WITHIN RESIDENTIAL UNITS ONLY MAY BE TYPE NM CABLE. NO WIRE SHALL BE INSTALLED IN THE CONDUIT SYSTEM UNTIL THE CONDUIT SYSTEM IS COMPLETE. USE MINERALAC NO. 100 OR EQUIVALENT AS A LUBRICANT TO FACILITATE THE INSTALLATION OF THE CONDUCTORS IN THE CONDUIT SYSTEM. MC CABLE WITH COPPER CONDUCTORS AND GROUND WIRE MAY BE USED WHERE PERMITTED.
- <u>CONDUIT</u>
- ALL WIRING SHALL BE INSTALLED IN LISTED METALLIC CONDUIT EXCEPT AS PERMITTED IN OTHER SECTIONS. RGS, WITH A 20 MIL PVC COATING WILL BE USED WHEN IN CONTACT WITH EARTH. IMC MAY BE USED IN INDOOR LOCATIONS NOT IN CONTACT WITH THE EARTH. EMT MAY BE USED IN INDOOR LOCATIONS NOT IN CONTACT WITH EARTH, NOT IN CONCRETE SLABS OR WALLS AND NOT SUBJECT TO DAMAGE. PVC MAY BE USED IN OR BELOW CONCRETE AND DIRECT BURIED IN EARTH. FLEXIBLE STEEL CONDUIT SHALL BE USED FOR INDOOR FINAL CONNECTIONS TO EQUIPMENT IN LENGTHS NOT TO EXCEED 72". LIQUID-TIGHT FLEXIBLE STEEL CONDUIT SHALL BE FOR OUTDOOR FINAL CONNECTIONS TO EQUIPMENT NOT TO EXCEED 48".
- 2. WHERE CONDUIT ENTERS OUTLET BOXES, FIXTURES OR CABINETS, FIRMLY FASTEN WITH STEEL SET SCREW, COMPRESSION CONNECTORS, OR DOUBLE LOCKNUTS FOR GRC. ALL CONNECTIONS SHALL HAVE BUSHINGS OR INSULATED THROAT CONNECTORS. FIRMLY FASTEN CONDUIT TO THE BUILDING CONSTRUCTION. RUN EXPOSED CONDUIT PARALLEL TO THE BUILDING LINES, SUPPORTED BY APPROPRIATE HANGERS (UNISTRUT,
- T & B OR APPLETON, OR EQUAL). COVER METALLIC CONDUIT IN CONTACT WITH EARTH WITH POLYETHYLENE TAPED SPIRAL WRAPPED, 1/2 LAPPED TO PROVIDE 20 MIL. THICKNESS. TAPE SHALL BE SCOTCH NO. 50 TAPE. CONDUIT AND DUCTS NOT UNDER BUILDINGS AND FEEDER DUCTS SHALL BE INSTALLED PER N.E.C. 300-5. MAKE JOINTS WITH
- COMPOUND TO BE WATERTIGHT. 4. SCHEDULE 40 PVC CONDUIT SHALL BE PERMITTED UNDERGROUND WITH PROPER FITTINGS, ALL UL APPROVED AND CEMENTED JOINTS. PENETRATIONS THROUGH FLOOR SLABS AND BENDS GREATER THAN 22° SHALL BE WRAPPED RIGID GALVANIZED STEEL ELBOWS.
- FITTINGS AND CONDUIT BODIES SHALL BE STEEL. DIECAST FITTINGS ARE NOT ACCEPTABLE. CONDUIT SIZES SHALL BE AS REQUIRED BY CODE AND AS INDICATED OR SPECIFIED.
- ALL EMPTY CONDUIT SYSTEMS SHALL HAVE A 200 LB. TEST NYLON PULL STRING TO FACILITATE
- INSTALLATION OF FUTURE WIRE. WIRING, CONDUITS, AND OUTLETS SHALL BE CONCEALED WITH THE BUILDING STRUCTURE, EXCEPT THAT 8. CERTAIN MOTOR AND LIGHTING FEEDER CONDUITS MAY BE RUN EXPOSED IN CERTAIN AREAS AS
- INDICATED ON THE DRAWINGS. CONDUIT PENETRATION THROUGH ROOF SHALL HAVE ROOF FLASHING WITH CAULK TYPE COUNTER FLASHING SLEEVE. INSTALLATION SHALL BE WATERTIGHT

10. CONDUITS SHALL BE ROUTED PARALLEL AND PERPENDICULAR TO THE STRUCTURE.

F. OUTLET, PULL, AND JUNCTION BOXES

- EACH SWITCH, LIGHT. RECEPTACLE OR OTHER OUTLET, INSTALLED IN RESIDENTIAL UNITS, SHALL BE PROVIDED WITH A CODE SIZED, PLASTIC OUTLET BOX. JUNCTION AND PULL BOXES SHALL BE CODE SIZED, PLASTIC OR METAL OUTLET BOX. ALL OTHER OUTLET BOXES SHALL BE STEEL BOXES INSTALLED IN POURED CEMENT FLOORS SHALL BE FLUSH TYPE CAST IRON OR STEEL WITH WATERTIGHT GASKETED COVERS. WHERE BOXES ARE INSTALLED IN FLOORS WITH TILE OR CARPET FLOOR COVERING, COVERS SHALL BE OF THE RECESSED TYPE TO ACCOMMODATE THE FLOOR COVERING.
- 3
- BOXES INSTALLED FOR THE ALARM, COMPUTER, AND SECURITY SYSTEM SHALL BE PROVIDED WITH
- APPROPRIATE COVER PLATES. 4. BOXES FOR TELEPHONE, COMPUTER, T.V., FIRE ALARM, SECURITY, AND SIMILAR SYSTEMS SHALL BE
- MINIMUM 2-1/8" DEEP.

<u>G WIRING DEVICES</u>

- WALL SWITCHES SHALL BE SPECIFICATION GRADE AC SILENT TYPE SWITCHES, 20A 120/277 VOLT. RECEPTACLES SHALL BE SPECIFICATION GRADE, DUPLEX TYPE. NEMA5-20R, 20 AMPERE, 120VOLT GROUNDED TYPE. SPECIAL APPLICATION RECEPTACLES SHALL BE INDICATED ON PLANS. MOUNT WITH THE GROUND DOWN.
- DEVICE PLATES SHALL BE EQUAL TO SIERRA SMOOTH-LINE PLASTIC WALL PLATES. COLOR SHALL BE WHITE, UNLESS OTHERWISE NOTED.
- 4. RECEPTACLES IN OUTDOOR AND WET LOCATIONS SHALL BE INSTALLED WITH A HINGED OUTLET COVER/ENCLOSURE CLEARLY MARKED AND U.L. LISTED SUITABLE FOR WET LOCATIONS WHILE IN USE, EQUAL TO TAYMAC SPECIFICATION GRADE.
- H. SERVICE ENTRANCE SECTION
- THE SERVICE ENTRANCE EQUIPMENT SHALL BE AS INDICATED ON THE DRAWINGS. EQUIPMENT SHALL CARRY THE U.L. LABEL AND SHALL CONFORM TO THE POWER COMPANY REGULATIONS. SERVICE ENTRANCE EQUIPMENT SHALL BE PROVIDED WITH A FULLY RATED COPPER OR ALUMINUM BUS. HORIZONTALLY TAPERED BUSSING SHALL NOT BE ALLOWED.

I. DISTRIBUTION PANELS

- DISTRIBUTION PANELS SHALL BE PROVIDED WITH FULLY RATED COPPER OR ALUMINUM BUS. HORIZONTAL TAPERED BUSSING SHALL NOT BE ALLOWED
- ACCEPTABLE MANUFACTURERS CUTLER HAMMER, SEIMENS, SQUARE D OR GENERAL ELECTRIC FACTORY ASSEMBLED DEAD FRONT, METAL ENCLOSED, AND SELF-SUPPORTING SWITCH BOARD ASSEMBLY CONFORMING T NEMA PB 2 AND UL 891, AND COMPLETE FROM INCOMING LINE TERMINALS TO LOAD SIDE TERMINATIONS.
- 4. LINE AND LOAD TERMINATIONS: ACCESSIBLE FROM FRONT ONLY OF THE SWITCH BOARD. SUITABLE FOR
- CONDUCTOR MATERIALS AND NUMBER OF CONDUCTORS USED.

ELECTRICAL SPECIFICATIONS


2. THE CONTRACTOR SHALL SUBMIT SEVEN (7) IDENTICAL BOUND SETS OF SHOP DRAWINGS ON THE

- GROUNDING SHALL COMPLY WITH REQUIREMENTS OF ARTICLE 250. ALL EXPOSED NONCURRENT CARRYING
- METALLIC PARTS OF ELECTRICAL EQUIPMENT, METALLIC RACEWAY SYSTEMS, METALLIC CABLE ARMOR, GROUNDING CONDUCTOR OF NONMETALLIC SHEATHED CABLES, GROUNDING CONDUCTOR IN NONMETALLIC RACEWAYS, AND GROUNDED CONDUCTORS OF THE WIRING SYSTEM SHALL BE GROUNDED. GROUNDING CONDUCTOR (NEUTRAL) OF THE WIRING SYSTEM SHALL BE CONNECTED TO THE SYSTEM

- 5. BUS CONNECTIONS: BOLTED. ACCESSIBLE FROM FRONT FOR MAINTENANCE. PROVIDE BELLEVILLE WASHERS FOR PROPERLY TORQUE ALL CONNECTIONS
- PROVIDE FULLY-RATED NEUTRAL BUS AND FULLY RATED GROUND BUS MATCHING MATERIAL USED FOR MAIN BUS.
- 7. FUTURE PROVISIONS: FULLY EQUIP SPACES FOR FUTURE DEVICES WITH BUSSING AND BUS CONNECTIONS SUITABLY INSULATED AND BRACED FOR SHORT CIRCUIT CURRENTS. CONTINUOUS CURRENT RATING AS INDICATED ON DRAWINGS.
- 8. ALL CIRCUIT BREAKERS SHALL BE BOLT-ON TYPE.
- J. PANEL BOARDS 1. CIRCUIT BREAKER TYPE AS INDICATED ON DRAWINGS. UNLESS INDICATED OTHERWISE, ALL PANELS SHALL HAVE PANEL HAVE PANEL BOARD TYPE CONSTRUCTION WITH BOLT-ON CIRCUIT BREAKERS FOR 30
- PANELS 2. MANUFACTURERS SHALL BE GENERAL ELECTRIC. SQUARE D. SEIMENS. CUTLER-HAMMER WITH VOLTAGE. SIZES, AND RATINGS AS INDICATED ON DRAWINGS.
- THE CIRCUIT BREAKERS SHALL BE OPERABLE IN ANY POSITION AND BE REMOVABLE FROM THE FRONT OF THE PANEL BOARD WITHOUT DISTURBING THE ADJACENT UNITS. BRANCH BREAKERS SHALL BE OF SUCH DESIGN THAT COMBINATION OF SINGLE-POLE, DOUBLE-POLE, AND THREE-POLE BREAKERS CAN BE ASSEMBLED ON THE SAME PANEL. EACH BRANCH CIRCUIT SHALL BE CLEARLY NUMBERED. BRANCH AND MAN TERMINALS SHALL BE SOLDERLESS TYPE. HANDLE TIES TO FORM MULTI-POLE BREAKERS NOT ACCEPTABLE.
- L. LIGHTING FIXTURES 1. PROVIDE ALL LIGHTING FIXTURES, WIRED AND CONNECTED. THE DRAWINGS INDICATE THE FIXTURES FOR EACH LOCATION. PROVIDE LAMPS FOR ALL FIXTURES. THE LAMPS SHALL BE BY THE SAME MANUFACTURER. VERIFY CEILING CONSTRUCTION BEFORE ORDERING RECESSED UNITS. PROVIDE PLASTER FRAMES AND HANGERS AS REQUIRED. CEILING CONSTRUCTION, ARCHITECTURAL ACCESSORIES, VOLTAGE, AND BALLASTS TO MEET THE EXISTING CEILING CONDITION.
- M. LIGHTING CONTROL FURNISH AND INSTALL TIME SWITCHES, PHOTOCELLS, CONTRACTORS AND FULL LIGHTING CONTROL
- SYSTEMS AS REQUIRED FOR LIGHTING CONTROLS INDICATED ON THE DRAWINGS. TIME SWITCHES SHALL BE EQUAL TO PARAGON, GENERAL ELECTRIC, TORK, OR INTERMATIC AND SHALL
- HAVE SIZE AND NUMBER OF POLES AS REQUIRED. 3. PHOTOCELLS SHALL BE EQUAL TO TORK OR INTERMATIC WITH VOLTAGE AS INDICATED.
- N. TELEPHONE AND CABLE TELEVISION SYSTEMS
- TELEPHONE WALL OUTLETS SHALL CONSIST OF STANDARD BOXES MOUNTED 18" ABOVE THE FLOOR UNLESS OTHERWISE INDICATED. PROVIDE A TERMINAL MOUNTING BOARD FOR THE INCOMING SERVICE CABLE
- CABLE TELEVISION OUTLETS SHALL CONSIST OF STANDARD BOXES MOUNTED 18" ABOVE THE FLOOR UNLESS OTHERWISE INDICATED. PROVIDE A TERMINAL MOUNTING BOARD FOR THE INCOMING SERVICE CABLE
- <u>O. GUARANTE</u>L
- GUARANTEE ALL MATERIAL FURNISHED AND ALL WORKMANSHIP PERFORMED FOR A PERIOD OF ONE YEAR FROM DATE OF FINAL ACCEPTANCE OF WORK. ANY DEFECTS DEVELOPING WITHIN THIS PERIOD, TRACEABLE TO MATERIAL FURNISHED AS A PART OF THIS SECTION OR WORKMANSHIP PERFORMED HEREUNDER, SHALL BE MADE GOOD AT NO EXPENSE TO THE OWNER.
- P. REMODELING WORK 1. THIS PROJECT INVOLVES CONSTRUCTION INSIDE AN EXISTING STRUCTURE. CONTRACTORS, BY SUBMITTING A BID ARE DEEMED TO BE COMPLETELY FAMILIAR WITH THE EXISTING CONDITIONS OF THE BUILDING AS IT INFLUENCES THE WORK DESCRIBED. NO CLAIMS FOR EXTRA COMPENSATION WILL BE CONSIDERED FOR EXISTING CONDITIONS VISIBLE OR REASONABLY INFERABLE FROM A CAREFUL EXAMINATION OF THE EXISTING BUILDING CONDITIONS.
- CONTRACTOR SHALL INSPECT THE EXISTING FIELD CONDITIONS AT THE SITE AND THE CONTRACT DOCUMENTS PRIOR TO THE START OF ANY WORK TO DETERMINE WHAT EFFECT THE EXISTING CONDITIONS WILL HAVE ON THE WORK POTENTIAL. CONTRACTOR SHALL REPORT DISCREPANCIES TO THE ARCHITECT AND INCLUDE IN THE BID ALL COSTS REQUIRED TO MAKE THE WORK MEET EXISTING CONDITIONS.
- 3. DEMOLITION: DISCONNECT, DEMOLISH, AND REMOVE ABANDONED MATERIALS AND EQUIPMENT INDICATED TO BE REMOVED AND NOT INDICATED TO BE SALVAGED OR REMAIN. DISPOSAL AND CLEANUP: REMOVE FROM THE SITE AND LEGALLY DISPOSE OF DEMOLISHED MATERIALS
- AND EQUIPMENT NOT INDICATED TO BE SALVAGED. PROTECT MATERIALS INDICATED TO REMAIN.
- Q. FIRE SEALING NOTES COORDINATE CONSTRUCTION OF OPENINGS AND PENETRATING ITEMS TO ENSURE THAT THROUGH-PENETRATION FIRESTOP SYSTEMS ARE INSTALLED ACCORDING TO SPECIFIED AND APPLICABLE
- UL REQUIREMENTS. COORDINATE SIZING OF SLEEVES, OPENINGS, CORE-DRILLED HOLES, OR CUT OPENINGS TO ACCOMMODATE THROUGH-PENETRATION FIRESTOP SYSTEMS. 3. DO NOT COVER UP THROUGH-PENETRATION FIRESTOP SYSTEM INSTALLATIONS UNTIL EXAMINED BY
- INSPECTOR, IF REQUIRED BY AUTHORITIES HAVING JURISDICTION. 4. COMPATIBILITY: PROVIDE THROUGH-PENETRATION FIRESTOP SYSTEMS THAT ARE COMPATIBLE WITH ONE ANOTHER; WITH THE SUBSTRATES FORMING OPENINGS; AND WITH THE ITEMS, IF ANY, PENETRATING
- THROUGH-PENETRATION FIRESTOP SYSTEMS, UNDER CONDITIONS OF SERVICE AND APPLICATION, AS DEMONSTRATED BY THROUGH-PENETRATION FIRESTOP SYSTEM MANUFACTURER BASED ON TESTING AND FIELD EXPERIENCE. PROVIDE COMPONENTS FOR EACH THROUGH-PENETRATION FIRESTOP SYSTEM THAT ARE NEEDED TO
- INSTALL FILL MATERIALS. USE ONLY COMPONENTS SPECIFIED BY THROUGH-PENETRATION FIRESTOP SYSTEM MANUFACTURER AND APPROVED BY QUALIFIED TESTING AND INSPECTING AGENCY FOR FIRESTOP SYSTEMS INDICATED PROVIDE SLEEVES THROUGH ALL FIRE-RATED WALLS AND FILL VOIDS SURROUNDING SLEEVES AND
- INTERIOR TO SLEEVES AROUND PIPING WITH FIRE STOP PUTTY WITH U.L. LISTED 3 HOUR RATING INSTALLED AS PER MANUFACTURERS RECOMMENDATIONS. FIRE SEAL ALL PIPING, CONDUIT, CABLE, ETC PENETRATIONS ROUTED THROUGH FIRE RATED WALLS.
- PROVIDE FIRE RATED ENCLOSURES OR WRAPS ON LIGHT FIXTURES AND OTHER ITEMS PENETRATING FIRE RATED CEILINGS, FLOOR/CEILING/ CEILING/ROOF ASSEMBLIES TO MAINTAIN UL LISTING FOR CONSTRUCTION.

		Development/Services Departme
	SYMBOLS LEGEND	JUSTIN R. SMOTHERS
	NOTE: THIS IS A MASTER LEGEND AND NOT ALL SYMBOLS, ETC,	NUMBER
	ARE NECESSARILY USED ON THE DRAWINGS. LED FIXTURE (SEE SCHEDULE)	PE-2012003568/20 B
		01-07-2022
	FIXTURE WITH EMERGENCY BATTERY DRIVER UNIT TRACK LIGHT	ن ي
⊘ ⊘H	DOWNLIGHT FIXTURE WITH EMERGENCY BATTERY DRIVER UNIT WALL MOUNTED FIXTURE WITH EMERGENCY BATTERY DRIVER UNIT	S, P
X O	PENDANT MOUNTED FIXTURE WITH EMERGENCY BATTERY DRIVER UNIT	Lt MO 524.08 4.8578
Ю	WALL MOUNTED FIXTURE	E 3rd 5 816.52/816.52
X D	PENDANT MOUNTED FIXTURE WALL WASHER	GGU Fax Fax
€ €	SINGLE FACE EXIT SIGN - UNIVERSAL MOUNTED SINGLE FACE EXIT SIGN W/ DIRECTIONAL ARROWS -	R
I® I⊕I	UNIVERSAL MTD DOUBLE FACE EXIT SIGN W/ DIRECTIONAL ARROWS - UNIVERSAL MTD	
	UNIVERSAL MTD DUAL HEADED EMERGENCY UNIT	
	COMBO DUAL HEADED EMERGENCY AND EXIT SIGN UNIT LETTER INDICATES LIGHT FIXTURE AS INDICATED ON FIXTURE SCHED	
S Sabc	SINGLE POLE SWITCH @ +48" UNLESS NOTED SWITCH BANK @ +48" UNLESS NOTED. LOWER CASE	MO COA NO. 2012006786 KS COA NO. 2012006786 KS COA NO. E-2818 1901 NW BLUE PARKWAY, UNITY VILLAGE, MO 64065 rd FLOOR UNITY VILLAGE TOWER phone: (816) 272-5289 email: jsmothers@jscengineers.com
S2	LETTER INDICATES FIXTURE CONTROLLED. 2 POLE SWITCH @ +48" UNLESS NOTED	MO COA NO. 2012006786 KS COA NO. E-2818 1901 NW BLUE PARKWAY, UNITY VILLAGE, MO 64065 LOOR UNITY VILLAGE TO phone: (816) 272-5289 ili: jsmothers@jscengineers.
S3 S4	3-WAY SWITCH @ +48" UNLESS NOTED 4-WAY SWITCH @ +48" UNLESS NOTED	6 COA NO. 20 KS COA NO. 20 KS COA NO. 21 KY VILLAGE, TY VILLAGE, None: (816) 2 mothers@jso
Sd Sjd	DIMMER SWITCH – SIZE AS REQUIRED @ +48" UNLESS NOTED 3–WAY DIMMER SWITCH – SIZE AS REQUIRED @ +48" UNLESS NOTED	MO MO 1907 3rd FLOC email: js
S3D×y	3-WAY DIMMER SWITCH BANK @ +48" UNLESS NOTED. LOWER CASE LETTER INDICATES FIXTURE CONTROLLED.	
Ss Sm	SWITCH SENSOR @ +48" UNLESS NOTED MANUAL MOTOR STARTER	
OS	OCCUPANCY SENSOR	
Sos	WALL SWITCH WITH OCCUPANCY SENSOR. TWO BUTTON DIGITAL LOW VOLTAGE WALL SWITCH. SWITCH @ +48" UNLESS NOTED.	
Sd	TWO BUTTON DIGITAL LOW VOLTAGE WALL SWITCH. PROVIDES ON/OFF/0-10V DIMMING. SWITCH @ +48" UNLESS NOTED. PROVIDE EXTRA CONTROL CABLES NEEDED TO FIXTURE CONTROLLED.	
2] (19)	LIGHTING CONTACTOR LIGHTING CONTROLS POWER PACK	
PC	PHOTOCELL	ER MOB
TC	TIMECLOCK	10 64
Ē	CAMERA	Center, MC (ENTE) ummit, MO 64063
© ►	SPEAKER TELEPHONE OUTLET@ +18" UNLESS NOTED	
\triangleright	DATA OUTLET @ +18" UNLESS NOTED	, Lee
► ™	COMBINATION TELEPHONE/DATA OUTLET @ +18" UNLESS NOTED TELEVISION OUTLET @ +18" UNLESS NOTED	
	SMOKE DETECTOR	Summit Medica USION (SE Blue Parkway, Lee's
	HEAT DETECTOR DUCT SMOKE DETECTOR	FU Sum
RT	REMOTE TEST STATION WITH INDICATING LIGHT. MOUNT AT 48" AFF UNO.	
	AUXILIARY SYSTEM TERMINAL CABINET SWITCHBOARD, MOTOR CONTROL CENTER OR DISTRIBUTION BOARD	
_	120/240V, 1 PHASE, 3 WIRE PANELBOARD, UNO	
	CARD READER. PROVIDE 2-GANG OUTLET BOX WITH SINGLE GANG RING AND 3/4" CONDUIT STUBBED UP IN WALL TO ABOVE ACCESSIBLE CEILING WITH BUSHING ON END OF CONDUIT @ 48" UNLESS NOTED OTHERWISE.	rid as an hited, or teded for to the ection the confitute on fitute and herein P.C.
3	GENERATOR	en provide by the arc and is initiation the arc approximation settion of s herein, or herein, or he
	TRANSFORMER MOTOR OUTLET	ng has be of service supervision projection to project of the and comp of compar- comparing comparing to compar- chited. ARCI 20 CG ARCI CG ARCI
R R	DISCONNECT SWITCH – SIZE AND TYPE NOTED COMBINATION FUSED STARTER DISCONNECT SWITCH FUSE SIZE AS INDICATED, STARTER SIZE '1'	This drawin instrument instrument instrument instrument of 1990, al of 1990, a
$\left\langle \frac{\text{EF}}{1} \right\rangle$	MECHANICAL EQUIP. CONNECTION, SEE SCHED. ON MECH. PLAN	
	JUNCTION BOX CONDUIT RUN CONCEALED IN WALL OR ABOVE CEILING	
	CONDUIT RUN BELOW FLOOR OR GRADE SPECIAL HEAVY DUTY RECEPTACLE – SIZE AS NOTED, @ +18" UNLESS NOTED	
Ģ-	1/2 SWITCHED RECEPTACLE @ +18" UNLESS NOTED	
•	FIRE RATED POKE THRU WITH TYPE INDICATED	DESCRI
\oplus	SINGLE RECEPTACLE @ +18" UNLESS NOTED	DATE
⊕	DUPLEX RECEPTACLE @ +18" UNLESS NOTED DOUBLE DUPLEX RECEPTACLE @ +18" UNLESS NOTED	
⇔	GFI DUPLEX RECEPTACLE DUPLEX RECEPTACLE INSTALLED ABOVE COUNTERTOP	KEV#
↔ GFI	GFCI-RATED DUPLEX RECEPTACLE	DATE: 01-07-2022 PROJECT# 22-007
⊖AF	ARC FAULT RATED DUPLEX RECEPTACLE	
⊕= WP	DUPLEX RECEPTACLE WITH WEATHERPROOF COVERPLATE @ 18" UNLESS NOTED	
P1-3,5,7	HOMERUN TO PANELBOARD, INFORMATION AT ARROWS ARE CIRCUIT NUMBERS AND PANELBOARD FOR TERMINATION. REFER TO ASSOCIATED NOTE FOR BRANCH CIRCUIT CONDUCTOR SIZES.	
	(1) NEUTRAL AND (1) GROUND WIRE. ALL ARE #12 AWG UNLESS NOTED OTHERWISE. DENOTES EXISTING ITEM/EQUIPMENT TO REMAIN	

RELEASED FOR CONSTRUCTION

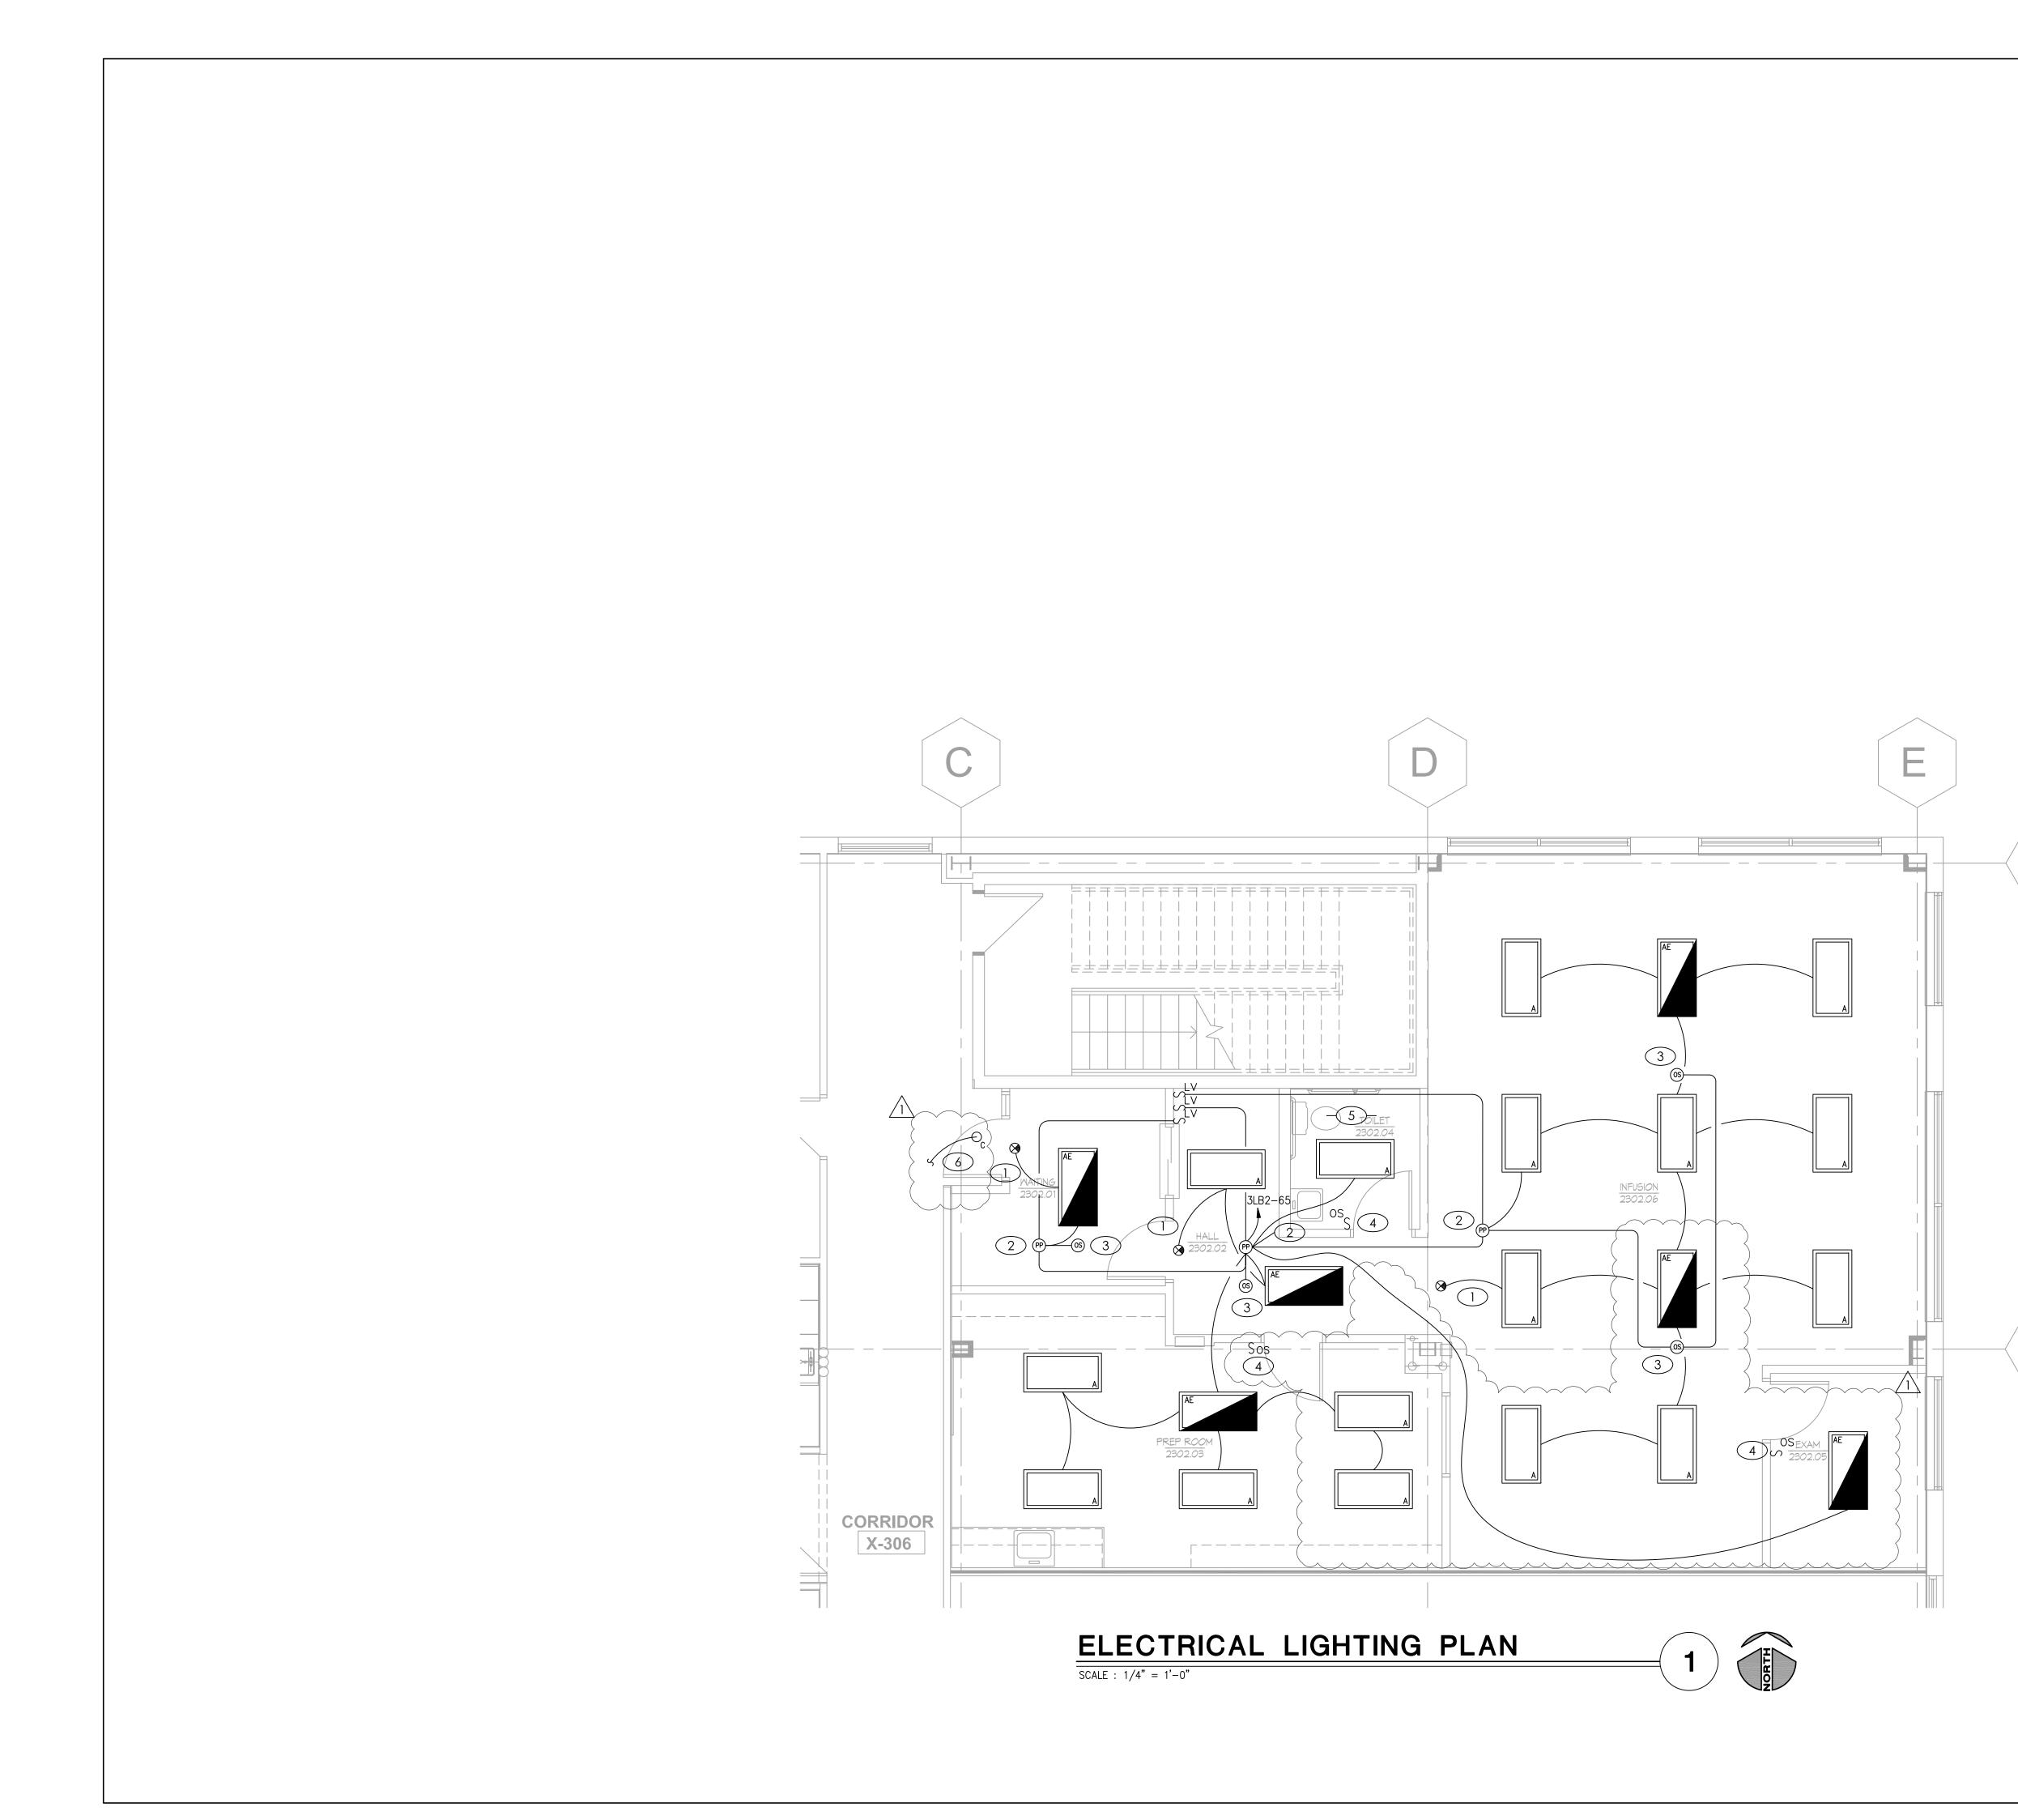

A. DRAWINGS ARE DIAGRAMMATIC AND SHALL NOT BE SCALED. REFER TO ARCHITECTURAL PLANS OR FIELD MEASUREMENTS FOR DIMENSIONS.

RELEASED FOR CONSTRUCTION As Noted on Plans Review

JUSTIN R SMOTHERS

NUMBER

E-201200356

05-18-2022

GUY GRONBERG ARCHITECTS, P.(113 SE 3rd St. Lee's Summit, MO 64063 Phone 816.524.0578 Fax 816.524.8578

С Ú

Š

MOB

inter,

(

Medical

Summit

Lee's

SINEERS

K

NTE]

Ē

 \bigcirc

SION

INFU

t, or the the the and tute the the the treein icect

O O Structure without a structure of the structure of the


DATE: 01-14-2022 PROJECT# 22-007

E2

- B. ALL WORK SHALL COMPLY WITH THE LATEST ADOPTED EDITION OF THE NATIONAL ELECTRICAL CODE (NFPA 70) AND ALL LOCAL BUILDING CODES AND AMENDMENTS.
- C. ALL ROOF AND WALL PENETRATIONS SHALL BE COORDINATED WITH THE GENERAL CONTRACTOR. PROVIDE ALL REQUIRED SLEEVES, FLASHINGS, CURBS, REINFORCED ANGLES, SUPPORTING FRAMES, ETC. UNLESS THEY ARE SPECIFICALLY CALLED OUT TO BE FURNISHED BY OTHERS.
- D. COORDINATE ALL WORK WITH OTHER TRADES AND EXISTING CONDITIONS AS REQUIRED TO PROPERLY INSTALL ALL SYSTEMS AS INTENDED, WITHIN THE CONFINES OF THE SPACE AVAILABLE, AND WITHOUT INTERFERENCES.
- E. THIS CONTRACTOR SHALL PERFORM ALL WORK INDICATED AND/OR AS REQUIRED FOR THE PROPER INSTALLATION AND OPERATION OF THE ELECTRICAL SYSTEMS.
- F. PROVIDE CONSTANT UNSWITCHED HOT LEG TO ALL LIGHTS WITH EMERGENCY BATTERY PACKS AND ALL OUTDOOR SCONCES.
- G. THE ELECTRICAL SYSTEM DESIGN IS BASED IN PART ON THE SPECIFIED HVAC EQUIPMENT. IT IS THE RESPONSIBILITY OF THE CONTRACTOR TO COORDINATE THE EXACT LOCATIONS AND ELECTRICAL REQUIREMENTS OF ALL HVAC EQUIPMENT BEING FURNISHED. ANY CHANGES TO THE ELECTRICAL SYSTEM DUE TO HVAC EQUIPMENT SUBSTITUTIONS SHALL BE PROVIDED AT NO ADDITIONAL COST TO THE OWNER.
- H. ALL WIRING SHALL BE IN APPROVED RACEWAY.
- I. WIRE SIZE SHALL BE MINIMUM #12 AWG, THWN SOLID COPPER UNLESS OTHERWISE NOTED. PROVIDE GROUND WIRE WHERE REQUIRED BY CODE. INCREASE WIRE SIZE TO COMPENSATE FOR VOLTAGE DROP WHERE TOTAL LENGTH OF ANY BRANCH EXCEEDS 100 FEET.
- MAXIMUM NUMBER OF UNGROUNDED WIRES IN ANY CONDUIT SHALL BE THREE. ADDITIONAL WIRES ARE ACCEPTABLE IF WIRE SIZE IS INCREASED TO ALLOW FOR DERATING PER CODE. PROVIDE ADDITIONAL WIRES FOR SWITCHING AS REQUIRED.
- K. FIRE ALARM, AUDIO/VIDEO AND SURVEILLANCE SYSTEMS BY OTHERS.
- J. ALL CIRCUIT NUMBERS SHOWN NEXT TO DEVICES ARE ASSOCIATED WITH THE HOMERUN SHOWN AT A NEARBY DEVICE AND SHALL TERMINATE AT THE DESIGNATED PANELBOARD CIRCUIT BREAKER.
- K. EC TO PROVIDE AND INSTALL RECEPTACLES, CAPS, AND CORDS AS REQUIRED. CAPS AND CORDS ARE TO BE INSTALLED ACCORDING TO THE MANUFACTURER'S INSTRUCTIONS.
- ALL ELECTRICAL WIRING, CONDUITS, AND CABLING IN PATIENT CARE L. AREAS (INCLUDING, BUT NOT LIMITED TO, "EXAM" AND "OFFICE" ROOMS) ARE TO BE MEDICAL GRADE PER NEC REQUIREMENTS.
- M. ELECTRICAL PANELBOARDS EXIST ROUGHLY 50' SOUTH OF SOUTHEAST CORNER OF SCOPE AREA ON OPPOSITE SIDE OF CORRIDOR X-306 IN ELEC (COMMUNICATIONS) 309 ROOM.

KEYED PLAN NOTES

- 1. CONNECT EXIT/EMERGENCY LIGHT VIA UNSWITCHED HOT CONDUCTOR.
- 2. LIGHTING CONTROLS POWER PACK. SENSORWORX SWX-900 SERIES OR PRE-BID APPROVED EQUAL. PROVIDE AND MAKE ALL CONNECTIONS PER MANUFACTURER'S RECOMMENDATIONS AND NEC REQUIREMENTS.
- 3. LIGHTING CONTROLS CEILING MOUNTED OCCUPANCY SENSOR. SENSORWORX SWX-200 SERIES OR PRE-BID APPROVED EQUAL. PROGRAM FOR VACANCY-SENSING OPERATION. PROVIDE AND MAKE ALL CONNECTIONS PER MANUFACTURER'S RECOMMENDATIONS AND NEC REQUIREMENTS.
- 4. WALL SWITCH OCCUPANCY SENSOR. SENSORWORX SWX-100 SERIES OR PRE-BID APPROVED EQUAL. PROGRAM FOR VACANCY-SENSING OPERATION. PROVIDE AND MAKE ALL CONNECTIONS PER MANUFACTURER'S RECOMMENDATIONS AND NEC REQUIREMENTS.
- WIRE SO THAT ON/OFF OPERATION OF EXHAUST FAN COORDINATES WITH 5. LIGHTING FIXTURE IN ROOM.
- MATCH BUILDING SUITE ENTRY SQUARE DOWNLIGHT STANDARD AND WIRE TO EXISTING HALLWAY LIGHTING CIRCUIT.

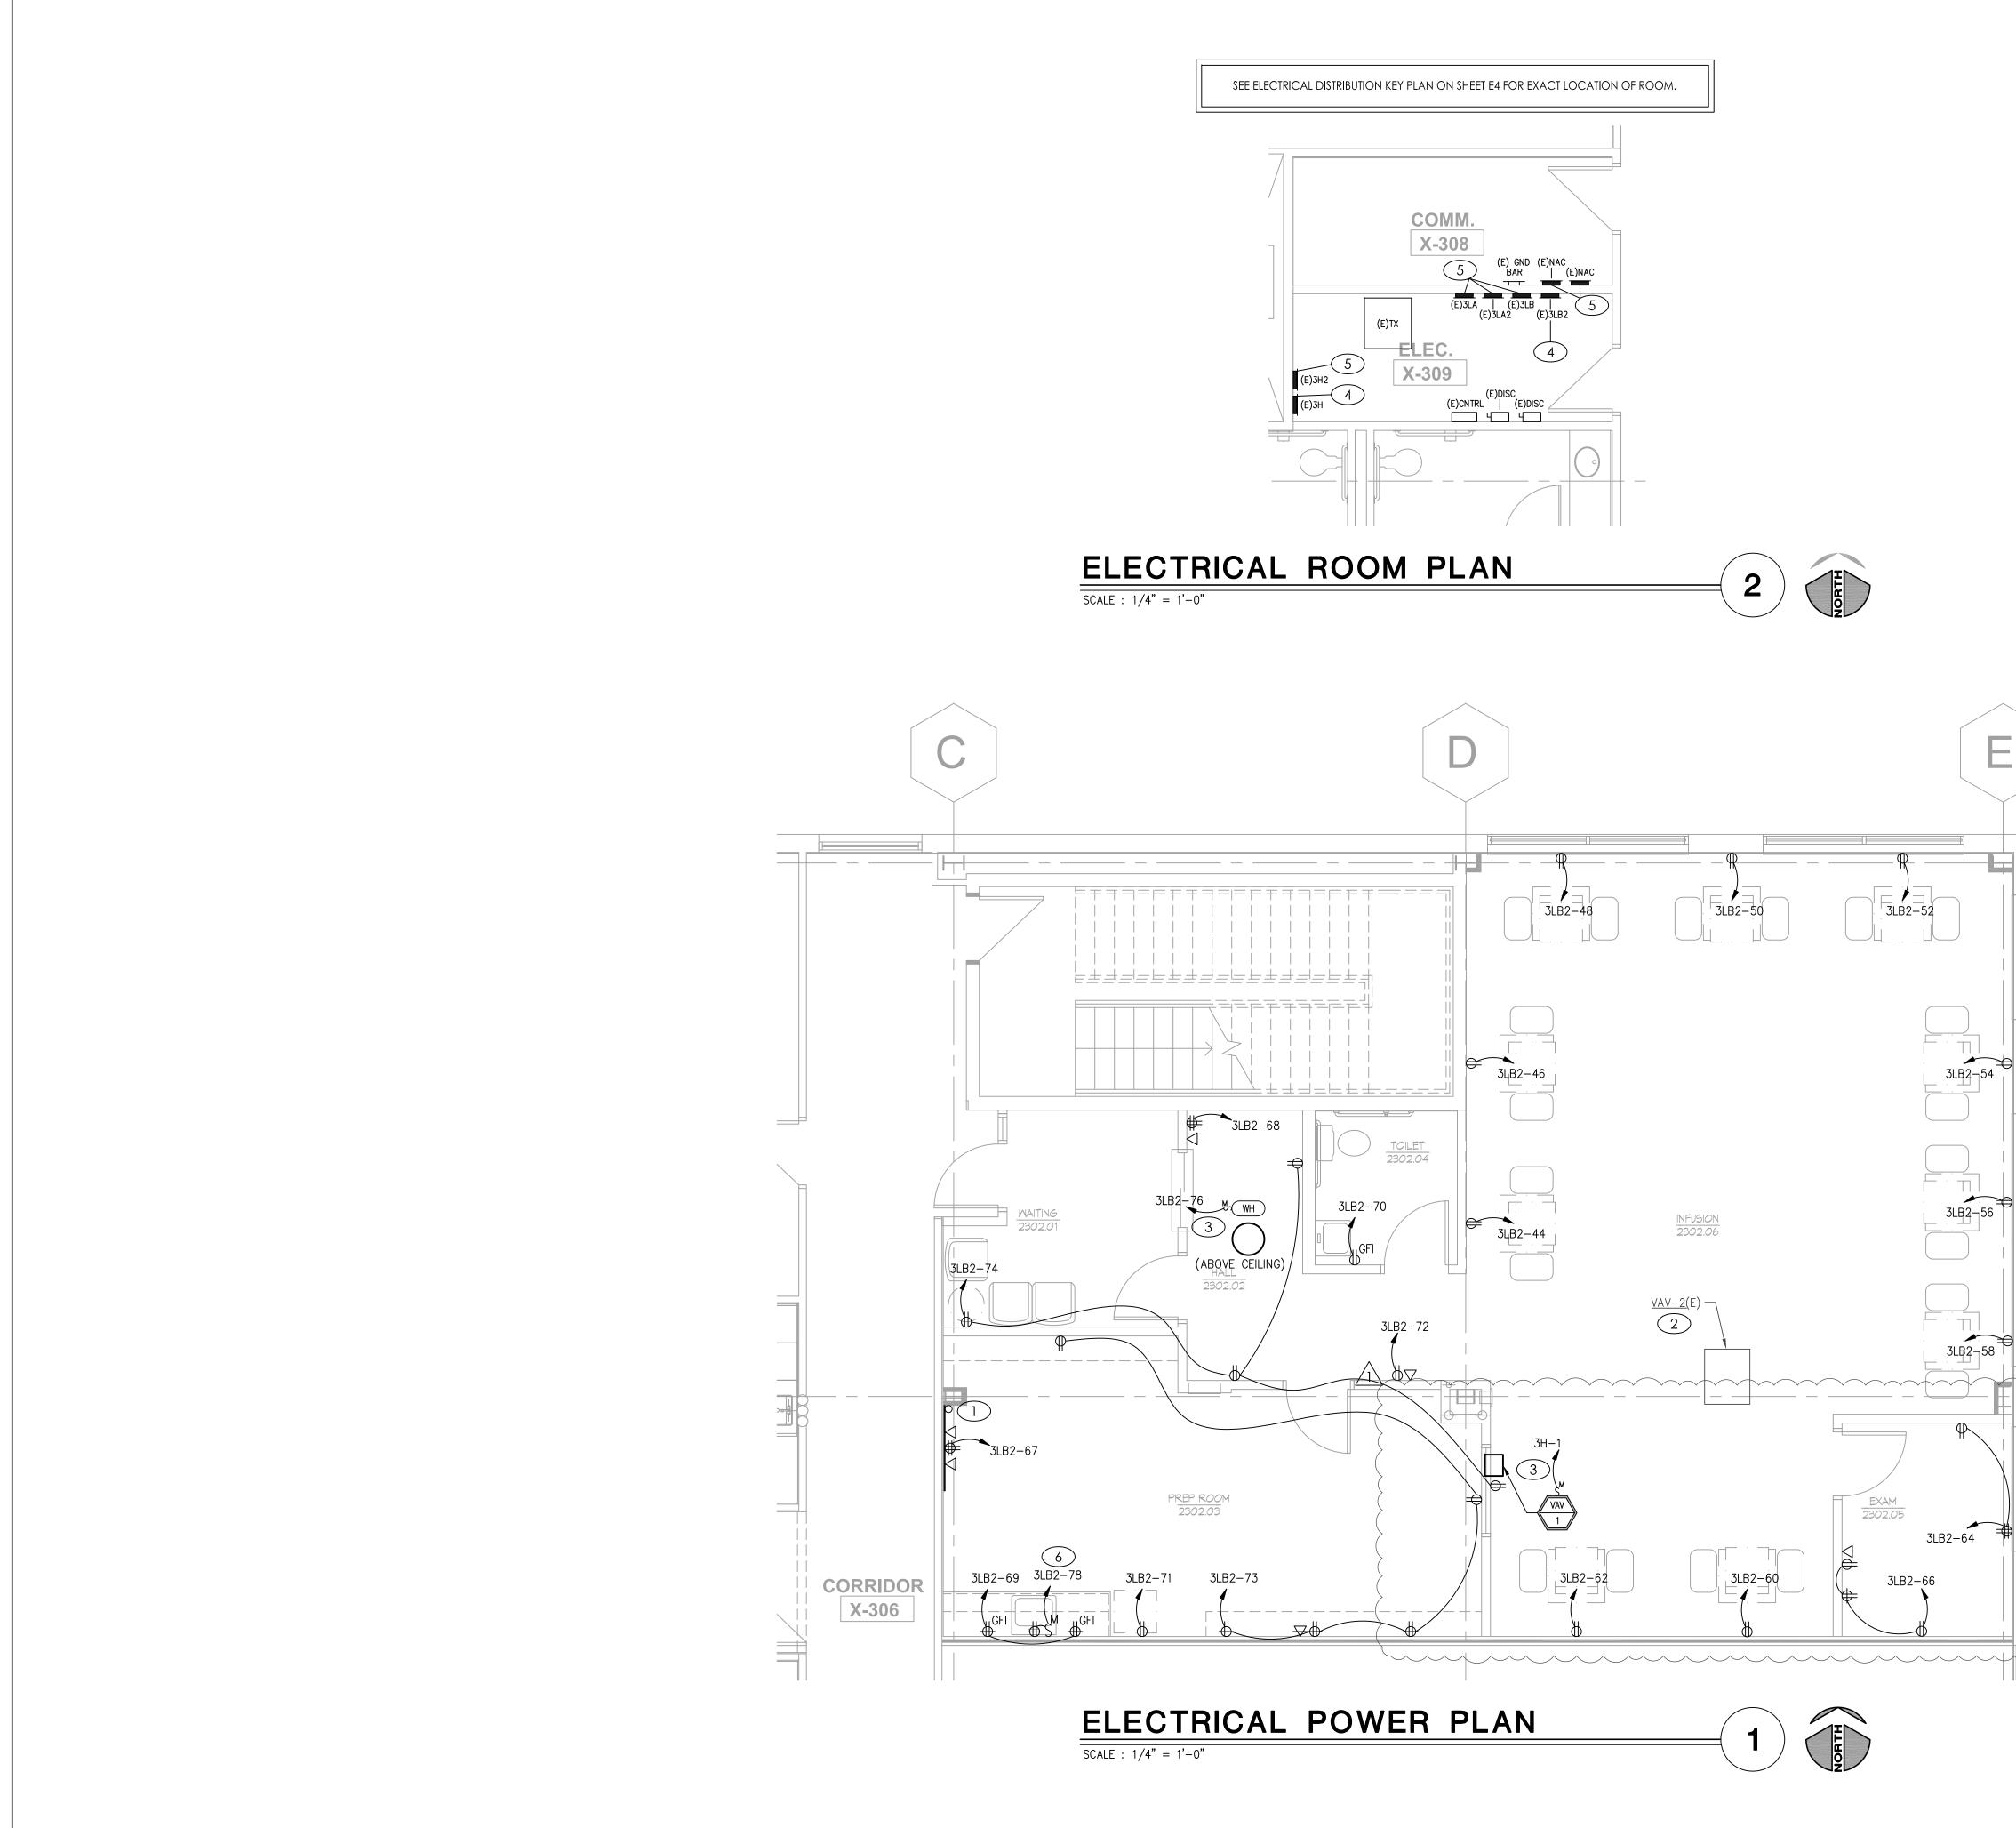

- A. DRAWINGS ARE DIAGRAMMATIC AND SHALL NOT BE SCALED. REFER TO ARCHITECTURAL PLANS OR FIELD MEASUREMENTS FOR DIMENSIONS.
- B. ALL WORK SHALL COMPLY WITH THE LATEST ADOPTED EDITION OF THE NATIONAL ELECTRICAL CODE (NFPA 70) AND ALL LOCAL BUILDING CODES AND AMENDMENTS.
- C. ALL ROOF AND WALL PENETRATIONS SHALL BE COORDINATED WITH THE GENERAL CONTRACTOR. PROVIDE ALL REQUIRED SLEEVES, FLASHINGS, CURBS, REINFORCED ANGLES, SUPPORTING FRAMES, ETC. UNLESS THEY ARE SPECIFICALLY CALLED OUT TO BE FURNISHED BY OTHERS.
- D. COORDINATE ALL WORK WITH OTHER TRADES AND EXISTING CONDITIONS AS REQUIRED TO PROPERLY INSTALL ALL SYSTEMS AS INTENDED, WITHIN THE CONFINES OF THE SPACE AVAILABLE, AND WITHOUT INTERFERENCES.
- E. THIS CONTRACTOR SHALL PERFORM ALL WORK INDICATED AND/OR AS REQUIRED FOR THE PROPER INSTALLATION AND OPERATION OF THE ELECTRICAL SYSTEMS.
- F. PROVIDE CONSTANT UNSWITCHED HOT LEG TO ALL LIGHTS WITH EMERGENCY BATTERY PACKS AND ALL OUTDOOR SCONCES.
- G. THE ELECTRICAL SYSTEM DESIGN IS BASED IN PART ON THE SPECIFIED HVAC EQUIPMENT. IT IS THE RESPONSIBILITY OF THE CONTRACTOR TO COORDINATE THE EXACT LOCATIONS AND ELECTRICAL REQUIREMENTS OF ALL HVAC EQUIPMENT BEING FURNISHED. ANY CHANGES TO THE ELECTRICAL SYSTEM DUE TO HVAC EQUIPMENT SUBSTITUTIONS SHALL BE PROVIDED AT NO ADDITIONAL COST TO THE OWNER.
- H. ALL WIRING SHALL BE IN APPROVED RACEWAY.
- WIRE SIZE SHALL BE MINIMUM #12 AWG, THWN SOLID COPPER UNLESS OTHERWISE NOTED. PROVIDE GROUND WIRE WHERE REQUIRED BY CODE. INCREASE WIRE SIZE TO COMPENSATE FOR VOLTAGE DROP WHERE TOTAL LENGTH OF ANY BRANCH EXCEEDS 100 FEET.
- MAXIMUM NUMBER OF UNGROUNDED WIRES IN ANY CONDUIT SHALL BE THREE. ADDITIONAL WIRES ARE ACCEPTABLE IF WIRE SIZE IS INCREASED TO ALLOW FOR DERATING PER CODE. PROVIDE ADDITIONAL WIRES FOR SWITCHING AS REQUIRED.
- K. FIRE ALARM, AUDIO/VIDEO AND SURVEILLANCE SYSTEMS BY OTHERS.
- J. ALL CIRCUIT NUMBERS SHOWN NEXT TO DEVICES ARE ASSOCIATED WITH THE HOMERUN SHOWN AT A NEARBY DEVICE AND SHALL TERMINATE AT THE DESIGNATED PANELBOARD CIRCUIT BREAKER.
- K. EC TO PROVIDE AND INSTALL RECEPTACLES, CAPS, AND CORDS AS REQUIRED. CAPS AND CORDS ARE TO BE INSTALLED ACCORDING TO THE MANUFACTURER'S INSTRUCTIONS.
- ALL ELECTRICAL WIRING, CONDUITS, AND CABLING IN PATIENT CARE AREAS (INCLUDING, BUT NOT LIMITED TO, "EXAM" AND "OFFICE" ROOMS) ARE TO BE MEDICAL GRADE PER NEC REQUIREMENTS.
- M. ELECTRICAL PANELBOARDS EXIST ROUGHLY 50' SOUTH OF SOUTHEAST CORNER OF SCOPE AREA ON OPPOSITE SIDE OF CORRIDOR X-306 IN ELEC (COMMUNICATIONS) 309 ROOM.

KEYED PLAN NOTES

- 1. PROVIDE (1) 4" CONDUIT TO LANDLORD TELECOMMUNICATION EQUIPMENT FOR ROUTING OF TENANT TELECOMMUNICATIONS CABLING. PROVIDE 4'X4'X1/2" PLYWOOD BACKBOARD FOR TENANT TELECOM EQUIPMENT MOUNTING. COORDINATE MOUNTING HEIGHT OF BOARD, POWER, AND DATA OUTLETS WITH TENANT PRIOR TO CONSTRUCTION.
- 2. EXISTING FAN-POWERED VAV UNIT TO REMAIN. CONFIRM ALL ELECTRICAL CONNECTIONS ARE MADE PER MANUFACTURER'S RECOMMENDATIONS AND NEC REQUIREMENTS.
- 3. MAKE CONNECTION TO DIVISION 22/23 EQUIPMENT PER MANUFACTURER'S RECOMMENDATIONS AND NEC REQUIREMENTS. COORDINATE WORK WITH DIVISION 22/23 CONTRACTOR PRIOR TO CONSTRUCTION.
- 4. EXISTING PANELBOARD TO REMAIN. REFER TO PANELBOARD SCHEDULE ON SHEET E-201 FOR MORE INFORMATION.
- 5. EXISTING PANELBOARD TO REMAIN WITH NO MODIFICATIONS IN THIS SCOPE.

6. RECEPTACLE AND SWITCH FOR CONNECTION TO GARBAGE DISPOSAL. COORDINATE EXACT LOCATION AND SWITCH STYLE WITH OWNER PRIOR TO CONSTRUCTION.

05-18-2022 С Ú GUY GRONBERG ARCHITECTS, P.(113 SE 3rd St. Lee's Summit, MO 64063 Phone 816.524.0878 Fax 816.524.8578 . МО 640 24.0878 `578 ş **ISC** IGINEERS MOB K ENTE inter, Medical \bigcirc SION Summit INFU Lee's


RELEASED FOR CONSTRUCTION As Noted on Plans Review

JUSTIN R SMOTHERS

NUMBER

E-201200356



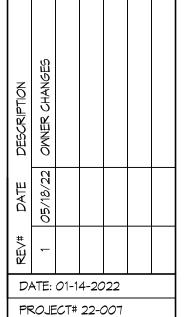

E3

BUS MAIN VOLT	NELBOARD: 3LB2 (EX AMPS: 400A SIZE/TYPE: MLO TS/PHASE: 208Y/120V, 3PH, 4W	XISTIN	IG)		AIC R SER\ MOUI	ROM: ATING ES: 3F	RD : SL	FLO JRF/	00 FUL OOR ACE					LINE-SIDE LUGS: MECHAN EQUIPMENT GROUND	
CKT	DESCRIPTION	VOL	LOCATION: COMMUNICATIONS X-309 AMPS/PHASE WREBKR P P BKR WRE VOLTAMPS/PHAS									ASE	DESCRIPTION	CK	
NO.		Α	В	С	NO.	AMP			AMP	NO.	Α	В	С		NC
43	SPARE					20	1	1	20	12	1,200			RCPT - INFUSION EQ 1	44
45	SPARE					20	1	1	20	12		1,200		RCPT - INFUSION EQ 2	4
47	ADA DOOR ACCESS PWR			200	EX	20	1	1	20	12			1,200	RCPT - INFUSION EQ 3	4
49	SPARE					20	1	1	20	12	1,200			RCPT - INFUSION EQ 4	5
51	RCPT - PROV #1; PROV #2	Í	720		EX	20	1	1	20	12		1,200		RCPT - INFUSION EQ 5	5
53	SPARE					20	1	1	20	12			1,200	RCPT - INFUSION EQ 6	5
55	SPARE					20	1	1	20	12	1,200			RCPT - INFUSION EQ 7	5
57	SPARE					20	1	1	20	12		1,200		RCPT - INFUSION EQ 8	5
59	SPARE					20	1	1	20	12			1,200	RCPT - INFUSION EQ 9	6
61	RCPT - PROCED. STRETCHER	500			EX	20	1	1	20	12	1,200			RCPT - INFUSION EQ 10	6
63	RCPT - PROCEDURE		540		EX	20	1	1	20	12		540		RCPT - EXAM 1	6
65	LTG - INFUSION/EXAM/WAITING			1,023	12	20	1	1	20	12			540	RCPT - EXAM 2	6
67	RCPT - TELECOM QUAD	360			12	20	1	1	20	12	360			RCPT - HALL QUAD	6
69	RCPT - PREP RM COUNTER GFI		360		12	20	1	1	20	12		<mark>18</mark> 0		RCPT - RESTROOOM GFI	7
71	RCPT - PREP RM FRIDGE			1,000	12	20	1	1	20	12			1,200	RCPT - PRINTER	7
73	RCPT - PREP RM GEN	720			12	20	1	1	20	12	720			RCPT - WAIT/HALL/INFUS GEN	7
75	SPARE					20	1	1	20	12		1,500		PWR - WH	7
77	PROVISIONAL SPACE						1	1	20	12			580	RCPT - GARBAGE DISPOSAL	7
79	PROVISIONAL SPACE						1	1						PROVISIONAL SPACE	8
81	PROVISIONAL SPACE						1	1						PROVISIONAL SPACE	8
83	PROVISIONAL SPACE						1	1						PROVISIONAL SPACE	8
	SUBTOTAL	1,580	1,620	2,223							<mark>5,880</mark>	5,820	5,920	SUBTOTAL	
	TOTAL PHASE A - VA 7,460	LOAD		CONN. \	/A	DF		LO/	AD		C	ONN. VA	DF		
	AMPS 62	COOLIN	G			1.00			FRIG				1.00	1	
	TOTAL PHASE B - VA 7,440	HEATING	3			0		SIG	N/DIS	SP			1.25	1	
	AMPS 62	LIGHTIN	G	1,023		1.25		KIT	CHEN	1			1.00	1	
	TOTAL PHASE C - VA 8,143	RECEPT	ACLES	17,980		1.0/.5		EXI:	STINC	G		1,960	1.00	1	_
	AMPS 68	MOTORS	S	580		1.00		LRC	g Mot	FOR			1.25	TOTAL DEMAND	1
	TOTAL PNLBD - VA 23,043	SUPP HE	EAT	1,500		1.00		100 March 100 Ma	OWW				1.25	19,309 VA	
20,010		MISC EQ		1,000		1.00		ITC	TGTRACK				1.00	54 A	

BUS MAIN VOL ⁻	NELBOARD: 3H (EXIS AMPS: 400A I SIZE/TYPE: MLO IS/PHASE: 480Y/277V, 3PH, 4W	STING))		AIC R SER\ MOUI	ROM: ATING ES: 3F	RD : SI	FLC JRF	DOR FACE		TED			LINE-SIDE LUGS: MECHAN EQUIPMENT GROUND	
	ΓΙΟΝ: 1					ATION:									-
СКТ	DESCRIPTION		TAMPS/P	-		BKR	Ρ	Р				TAMPS/PH		DESCRIPTION	CK
NO.		A	В	С	NO.	AMP			AMP	NO.	A	В	С		NC
1	^^PWR - VAV-1	4,000			12	20	1		20	EX	1,500			VAV 1-3-3, 1-3-2	2
3	SPARE					20	1	1	20					SPARE	4
5	SPARE					15	1	1	20					SPARE	6
7		1,000	4 000			4.5	1	1	4-		1,000	4 0 0 0			8
9	FPB 3-8		1,000	1 000	EX	15	1	1	15	EX		1,000		FPB 3-7	10
11		1.000		1,000			1	1			4 0 0 0		1,000		12
13		1,000	4 000			45	1	1			1,000	4.000			14
15	FPB 3-6		1,000	4 000	EX	15	1	1	15	EX		1,000	4.000	FPB 2-3-4	16
17	SPARE			1,000			1	1			4 000		1,000		18
19	VAV 1-3-3		4 500			20	1	1	20	EX	1,200	4.000		LTG - CORRIDOR/RESTROOM	20
21	SPARE		1,500		EX	20	1	1	20	EX		1,200	5.000	LTG - EMERGENCY	22
23	SPARE FPB 1-3-3	4.000				20	1	1	175		00.000		5,000	T3L	
25	FPB 1-3-3	1,000	1 000		EX	15	1	1	175	EX	20,000	00.000			26
27	FPB 3-4		1,000	1 000		45	1	1				20,000	20.000		28
29	<i>FFB</i> 3-4	1.000		1,000	00 EX	15	1	· ·	15	EX	1.000		20,000	FPB 1-3-1	30
31 33	SPARE	1,000				20	1				1,000	1.000			34
	SPARE			_		20 20	1					1,000			34
	PROVISIONAL SPACE					20	1	1						PROVISIONAL SPACE	38
	PROVISIONAL SPACE						1	1						PROVISIONAL SPACE	40
	PROVISIONAL SPACE			-	<u> </u>		1	1							40
41	SUBTOTAL	8,000	4,500	3,000			I				25,700	24.200	27,000	SUBTOTAL	42
			4,500	,									,	SOBIOTAL	
	AMPS 122 COOLING			CONN. \	/A	DF		LOAD REFRIG			CONN. VA DF				
				1 0 0 0		0					1		1.00		
	TOTAL PHASE B - VA 28,700	HEATING		4,000		1.00		SIGN/DISP KITCHEN				1.25			
AMPS 104 LIGHTING TOTAL PHASE C - VA 30,000 RECEPTACL AMPS 108 MOTORS TOTAL PNLBD - VA 92,400 SUPP HEAT			-			1.25		EXISTING			1.00				
					1.0/.5			G MO		88,400 1.00		1.00		1	
					1.00								TOTAL DEMAND		
	TOTAL PNLBD - VA 92,400 AMPS 111					1.00					1.25			92,400 VA 111 A	
	AMPS 111					11.00		LTG TRACK			1.00		1.00	111A	


^^ = HACR-TYPE BREAKER

ELECTRICAL PANEL SCHEDULES

					ELECTRICAL	LIGHTING SCHE	DULE (or equal. verify all selections and finishes with owner and architect prior to ordering	IG).		
	FIXTURE TYPE	MANUFACTURER NAME CATALOG NUMBER		volt amps	MOUNTING	LAMP TYPE	REMARKS			
	А	LITHONIA 2BLT4-60L-ADP-EZ1-LP840 48 GRID		GRID	INCLUDED 4000K LED	2' X 4' DIMMABLE LED TROFFER - VOLUMETRIC RECESSED	MVOLT			
	AE		2BLT4-60L-ADP-EZ1-LP840-EL14LSD	48	GRID	INCLUDED 4000K LED	2' X 4' DIMMABLE LED TROFFER - VOLUMETRIC RECESSED - WITH EMERGENCY BATTERY PACK OPTION 6'' SQUARE DOWNLIGHT - VERIFY AND MATCH EXISTING BUILDING SUITE ENTRY STANDARD FIXTURE			
	C		LDN6SQ-40/15-LS6AR-LSS-MVOLT-EZ10	18	RECESSED	INCLUDED 4000K LED				
	۲	LITHONIA	lqm-s-w-3-r-mvolt-el-n-sd	5	WALL	INCLUDED LED	LED RED LETTER EXIT SIGN LUMINAIRE WITH 90 MIN EMERGENCY BATTERY PACK	MVOLT		

LIGHTING FIXTURE SCHEDULE

SCALE : NO SCALE

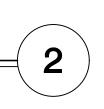



 $\langle 2 \rangle$


3---

4----


6 ----

7)----

SCALE : 1/32" = 1'-0"

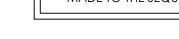

ELECTRICAL SINGLE LINE DIAGRAM SCALE : NO SCALE

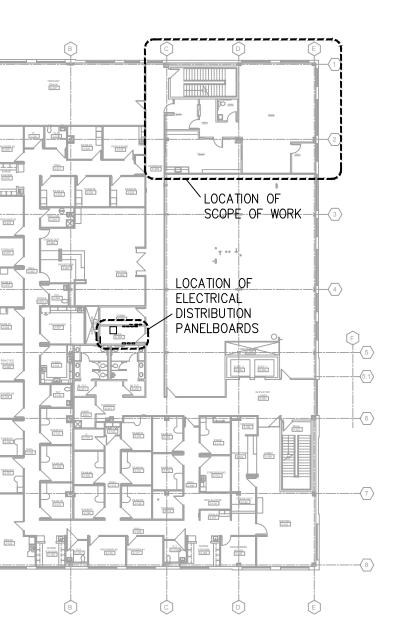

4

ELECTRICAL DISTRIBUTION KEY PLAN

3

ELECTRIC SERVICE SINGLE LINE DIAGRAM IS EXISTING TO REMAIN. NO MODIFICATIONS ARE BEING MADE TO THE SEQUENCE OFELECTRICAL SERVICE DISTRIBUTION EQUIPMENT IN THIS SCOPE.

