



# AS GRADED PLOT PLAN

ORDERED BY: SPELLERBERG ENT.  
DESCRIPTION: LOT 7, COBEY CREEK - 1ST PLAT IN LEE'S SUMMIT, MO  
528 SE DAVID ROAD

RELEASE FOR CONSTRUCTION  
AS NOTED FOR PLAN REVIEW  
DEVELOPMENT SERVICES  
LEE'S SUMMIT, MISSOURI  
06/09/2022

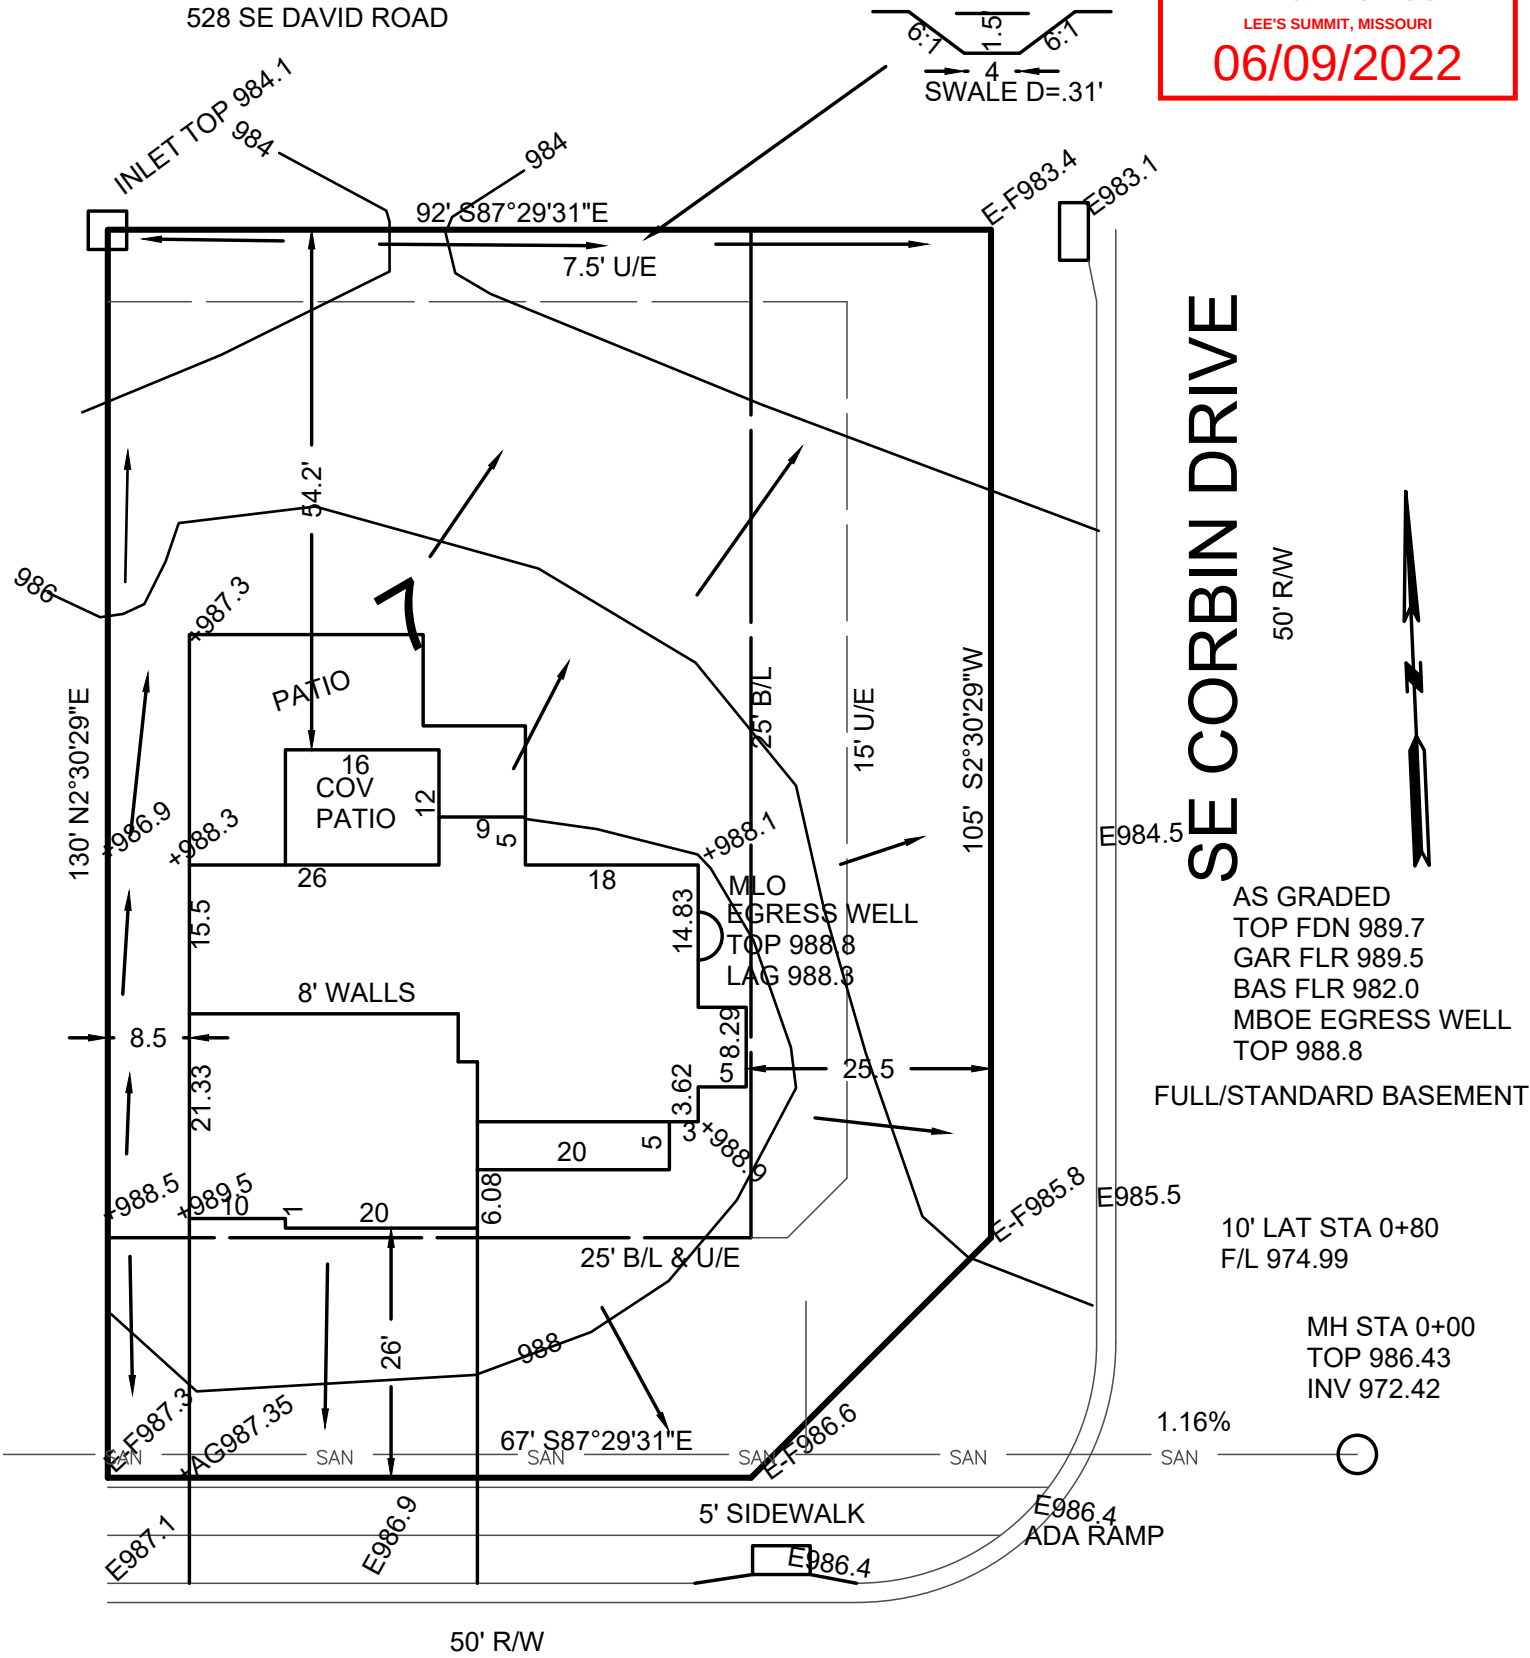

→ = DRAINAGE PATTERN

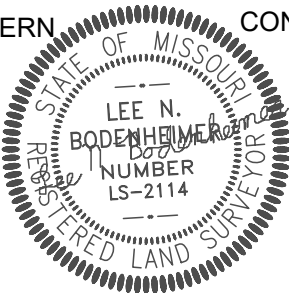

CONSTRUCTION ENGINEERING SERVICES, INC.

16810-C East 40 Highway  
Independence, MO 64055  
(816)478-2323  
lee@engineeringkc.com

SCALE: 1"=20'

DATE: 05-24-2021

JOB NO: 17759

06-02-2022

18379

LEE BODENHEIMER, L.S.  
Land Surveyor