


AS GRADED PLOT PLAN

ORDERED BY: SPELLERBERG ENT.
DESCRIPTION: LOT 7, COBEY CREEK - 1ST PLAT IN LEE'S SUMMIT, MO
528 SE DAVID ROAD


RELEASE FOR CONSTRUCTION
AS NOTED FOR PLAN REVIEW
DEVELOPMENT SERVICES
LEE'S SUMMIT, MISSOURI
06/09/2022

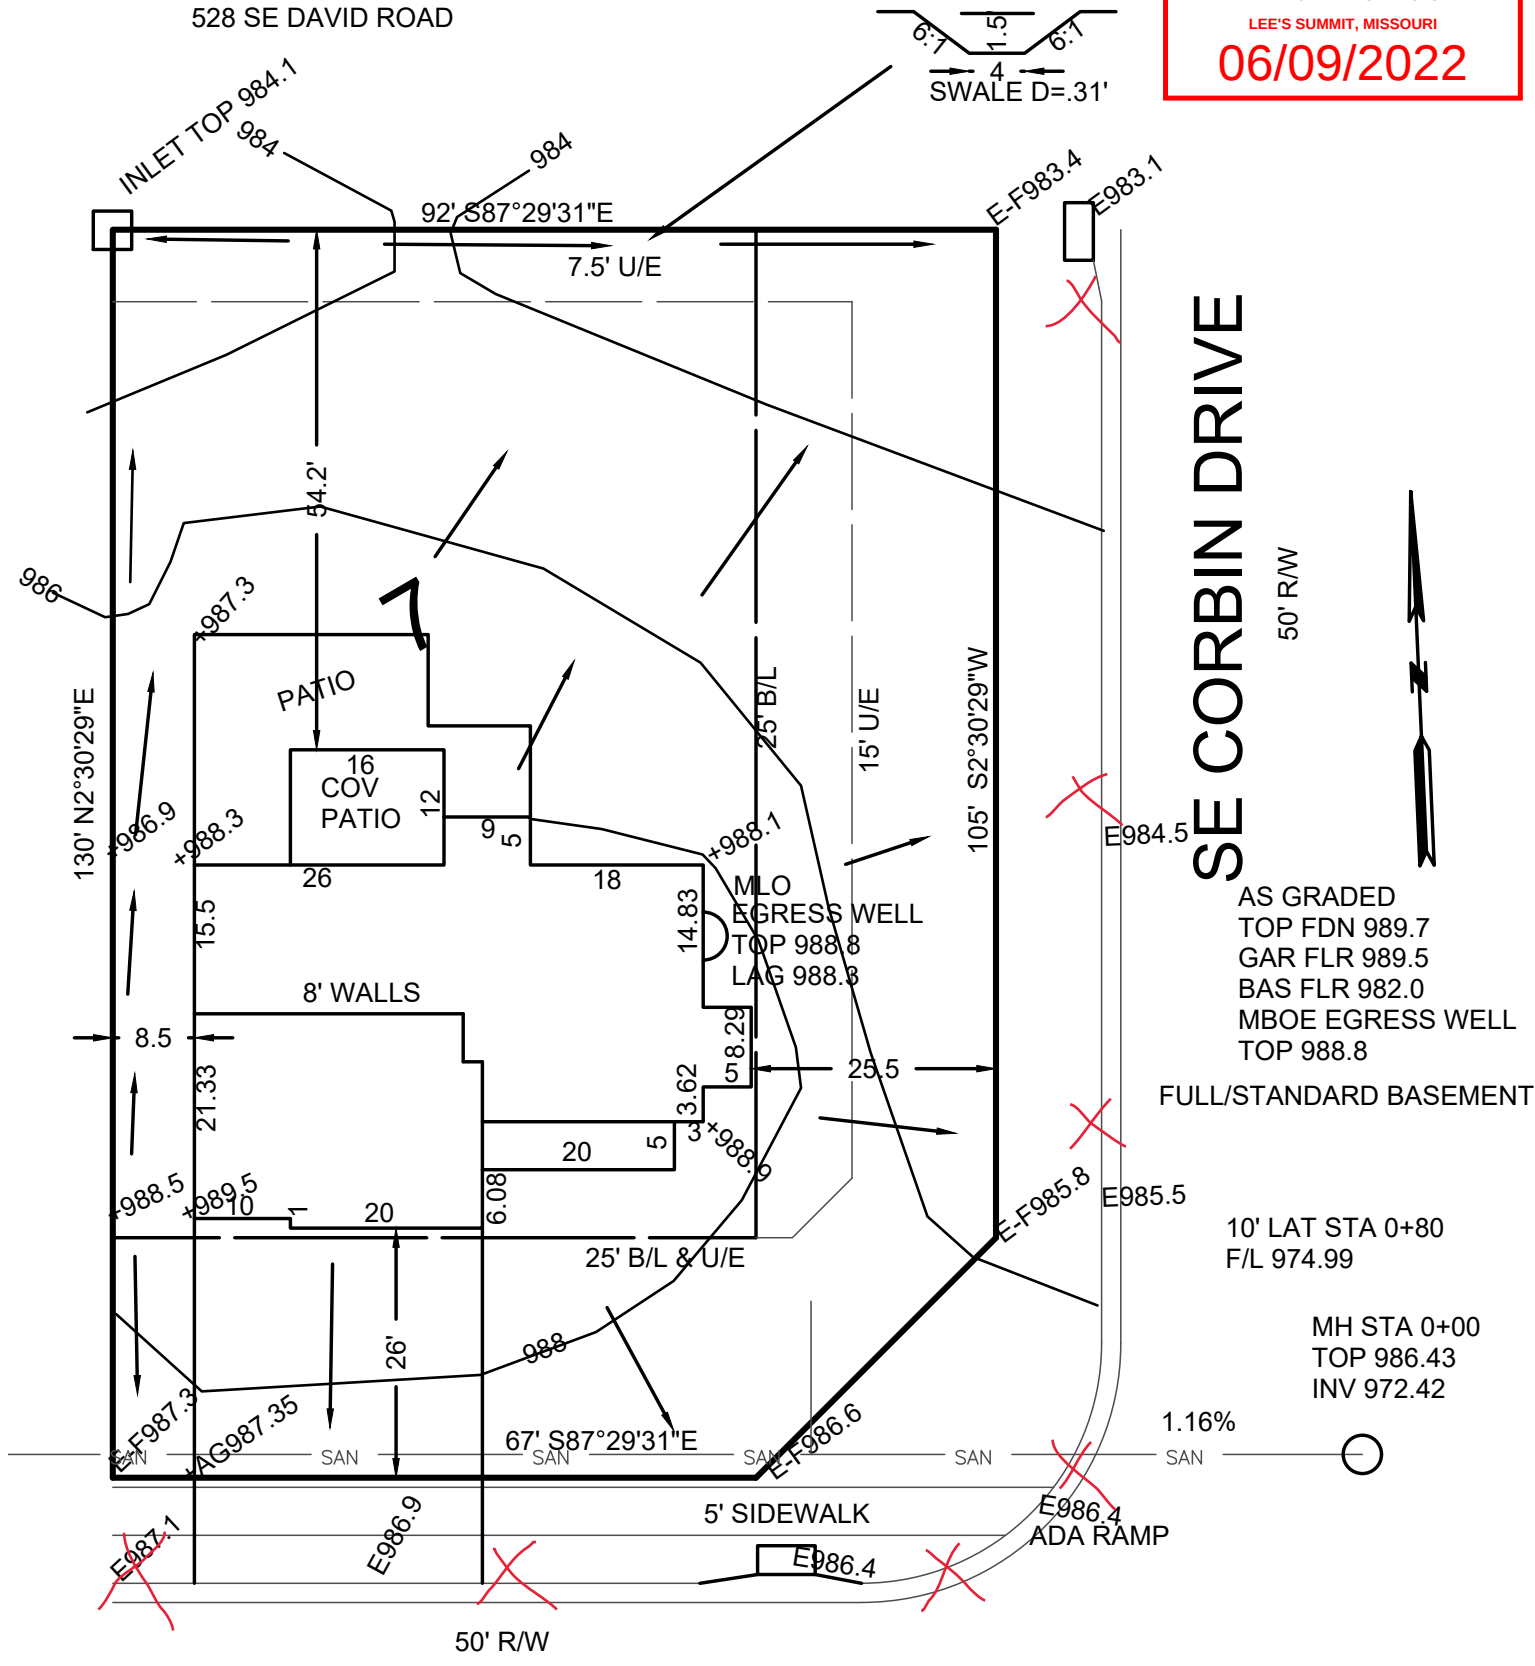

SE DAVID ROAD

EL AND CONTOURS SHOWN ARE
AS OF 06-02-2022

→ = DRAINAGE PATTERN

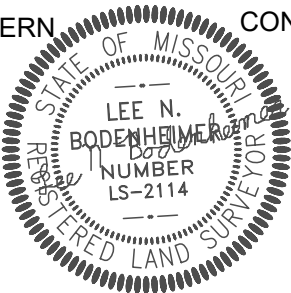

CONSTRUCTION ENGINEERING SERVICES, INC.

16810-C East 40 Highway
Independence, MO 64055
(816)478-2323
lee@engineeringkc.com

SCALE: 1"=20'

DATE: 05-24-2021

JOB NO: 17759

06-02-2022

18379

LEE BODENHEIMER, L.S.
Land Surveyor