


AS GRADED PLOT PLAN

ORDERED BY: TRUMARK HOMES

DESCRIPTION: LOT 21, COBEY CREEK 1st PLAT, IN LEE'S SUMMIT, MO
505 SE CARTER ROAD

RELEASE FOR CONSTRUCTION
AS NOTED FOR PLAN REVIEW
DEVELOPMENT SERVICES
LEE'S SUMMIT, MISSOURI

06/21/2022

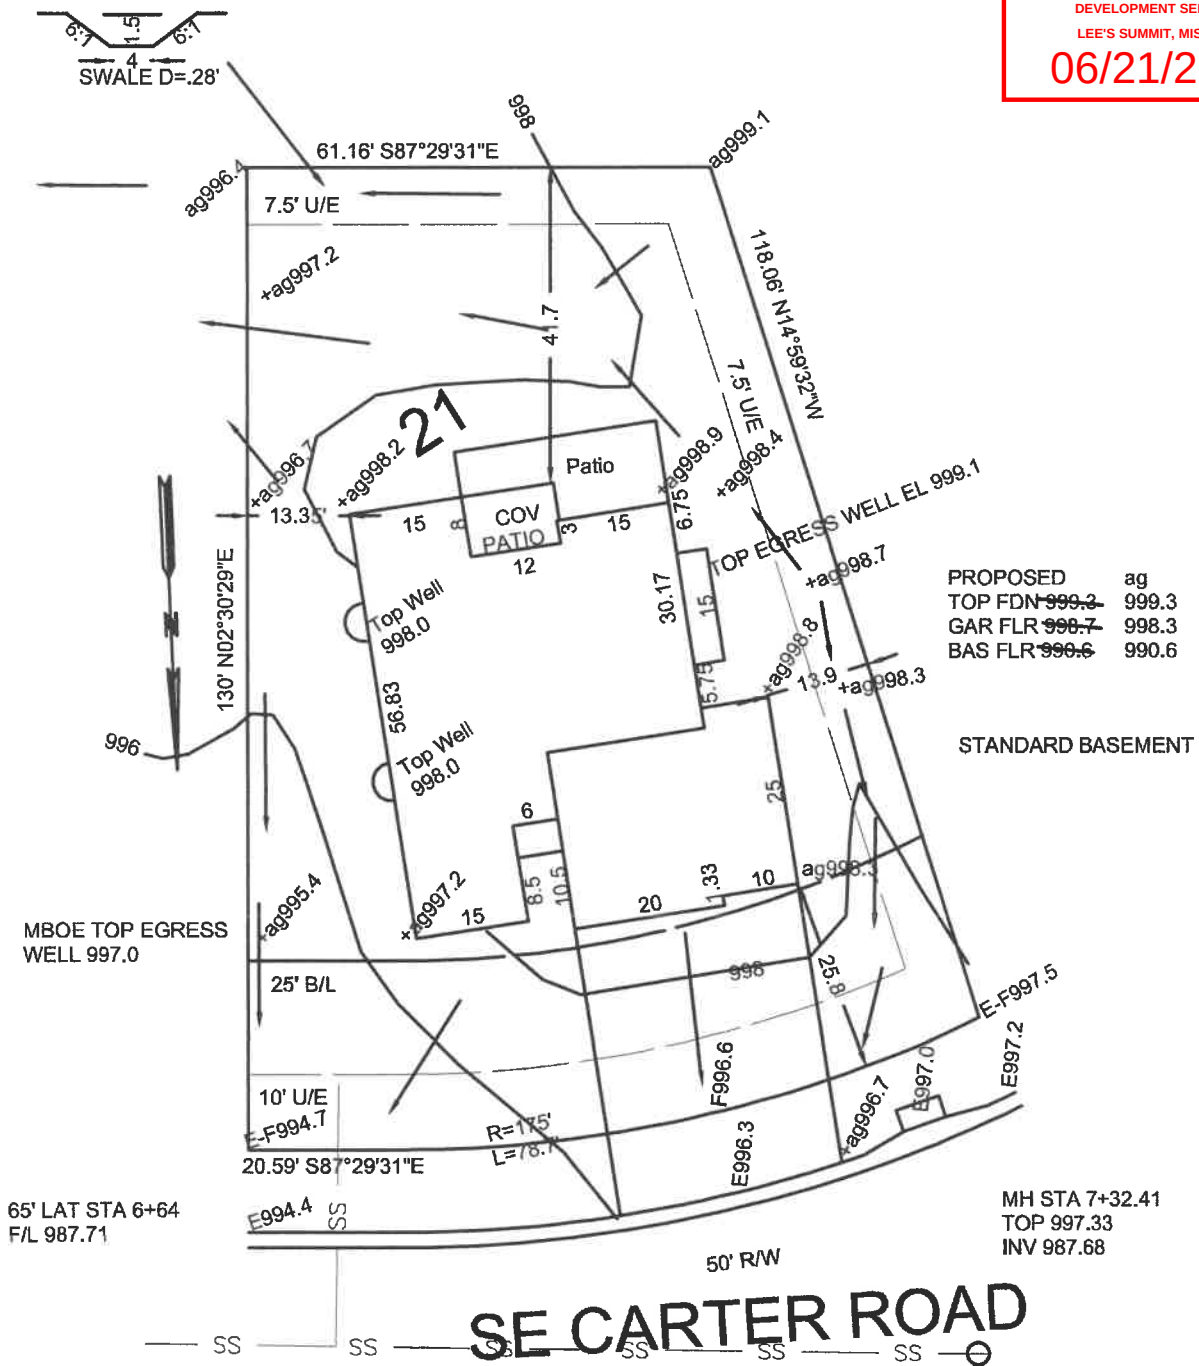

ag= grades on 06-16-2022
Lot is not yet sodded

→ = DRAINAGE PATTERN

CONSTRUCTION ENGINEERING SERVICES, INC.

16810-C East 40 Highway
Independence, MO 64055

(816)478-2323

lee@engineeringkc.com

SCALE: 1"=20'

DATE: 3/25/2021 & 06-16-2022

JOB NO: 17644 18408

LEE BODENHEIMER, L.S.
Land Surveyor

