


AS GRADED PLOT PLAN


ORDERED BY: TRUMARK HOMES
DESCRIPTION: LOT 128, MONTICELLO 4TH PLAT IN LEE'S SUMMIT, MO
4805 NE FREEHOLD CT.

RELEASE FOR CONSTRUCTION
AS NOTED FOR PLAN REVIEW
DEVELOPMENT SERVICES
LEE'S SUMMIT, MISSOURI
07/05/2022

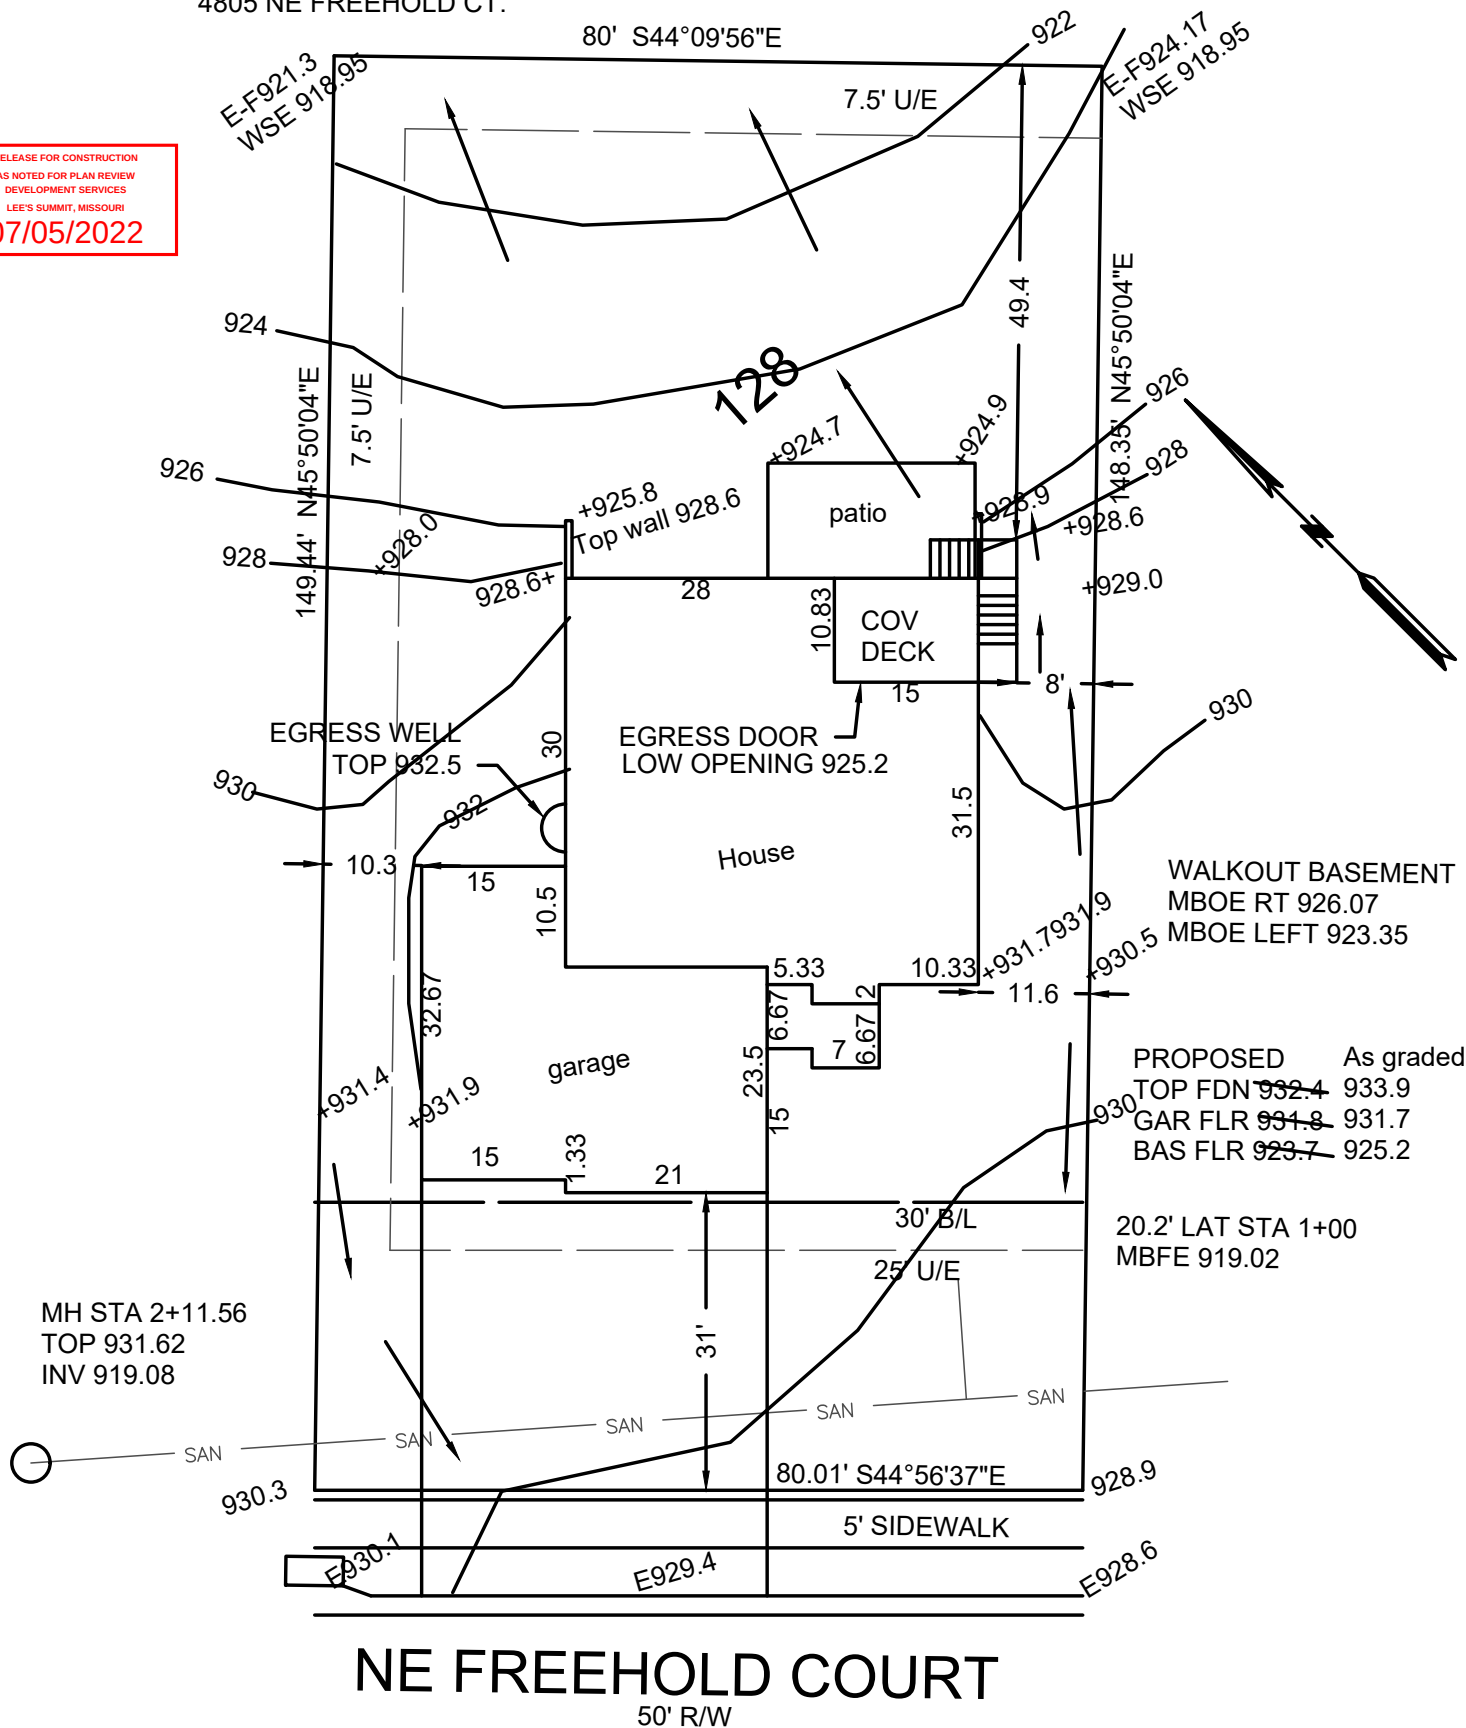

Grades shown are as of 06-27-2022

→ = DRAINAGE PATTERN

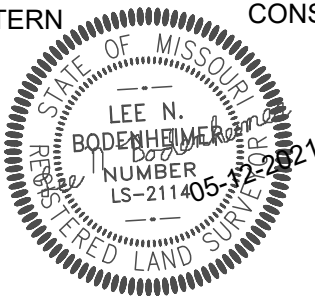

CONSTRUCTION ENGINEERING SERVICES, INC.
16810-C East 40 Highway
Independence, MO 64055
(816)478-2323
lee@engineeringkc.com
SCALE: 1"=20'
DATE: 05-12-2021 & 06-27-2022
JOB NO: 17744 18438

LEE BODENHEIMER, L.S.
Land Surveyor