


AS GRADED PLOTPLAN

Ordered by: TRUMARK HOMES

Description: LOT 133 MONTICELLO 4th PLAT, LEES SUMMIT, MO.

Address: 4808 NE FREEHOLD CT

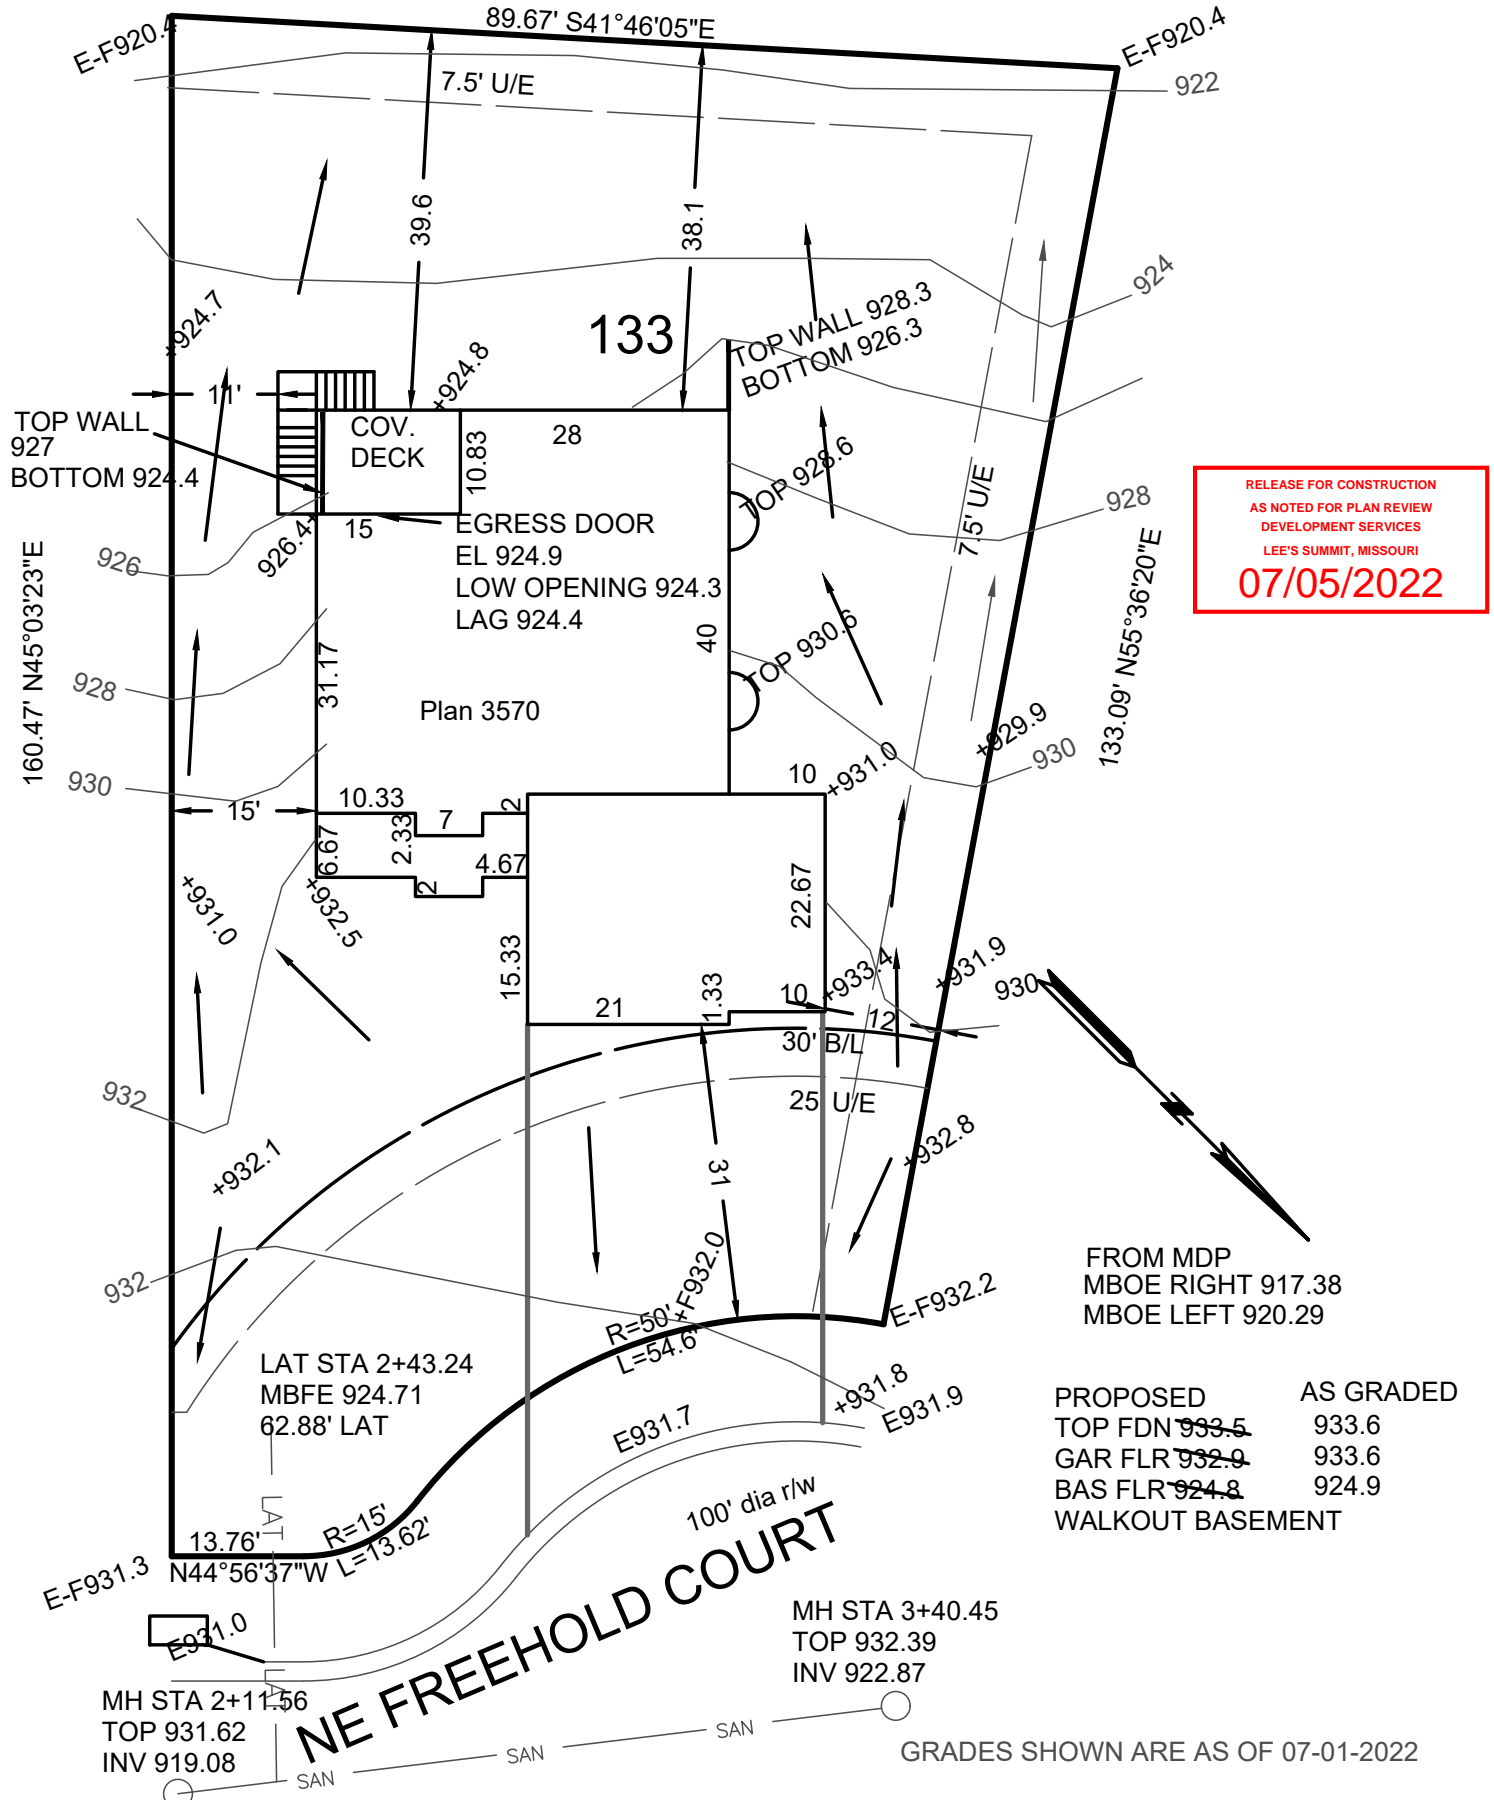

RELEASE FOR CONSTRUCTION
 AS NOTED FOR PLAN REVIEW
 DEVELOPMENT SERVICES
 LEE'S SUMMIT, MISSOURI
07/05/2022

FROM MDP
 MBOE RIGHT 917.38
 MBOE LEFT 920.29

| PROPOSED | AS GRADED |
|--------------------------|-----------|
| TOP FDN 933.5 | 933.6 |
| GAR FLR 932.9 | 933.6 |
| BAS FLR 924.8 | 924.9 |
| WALKOUT BASEMENT | |


MH STA 2+11.56
 TOP 931.62
 INV 919.08

MH STA 3+40.45
 TOP 932.39
 INV 922.87

GRADES SHOWN ARE AS OF 07-01-2022

→ = DRAINAGE PATTERN

CONSTRUCTION ENGINEERING SERVICES, INC.

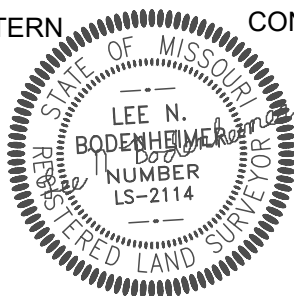

16810-C East 40 Highway
 Independence, MO 64055
 (816)478-2323
 lee@engineeringkc.com
 SCALE: 1"=20'
 DATE: 7/9/2021 & 06-23-22
 JOB NO: 17815 18430

LEE BODENHEIMER, L.S.
 Land Surveyor