


RELEASE FOR CONSTRUCTION
AS NOTED FOR PLAN REVIEW
DEVELOPMENT SERVICES
LEE'S SUMMIT, MISSOURI
07/19/2022

PROPOSED
CONTOURS
AS-GRADED
CONTOURS
X=###.## = Actual asbuilt ground shots
taken on July 15, 2022.
Contours shown are asbuilt.

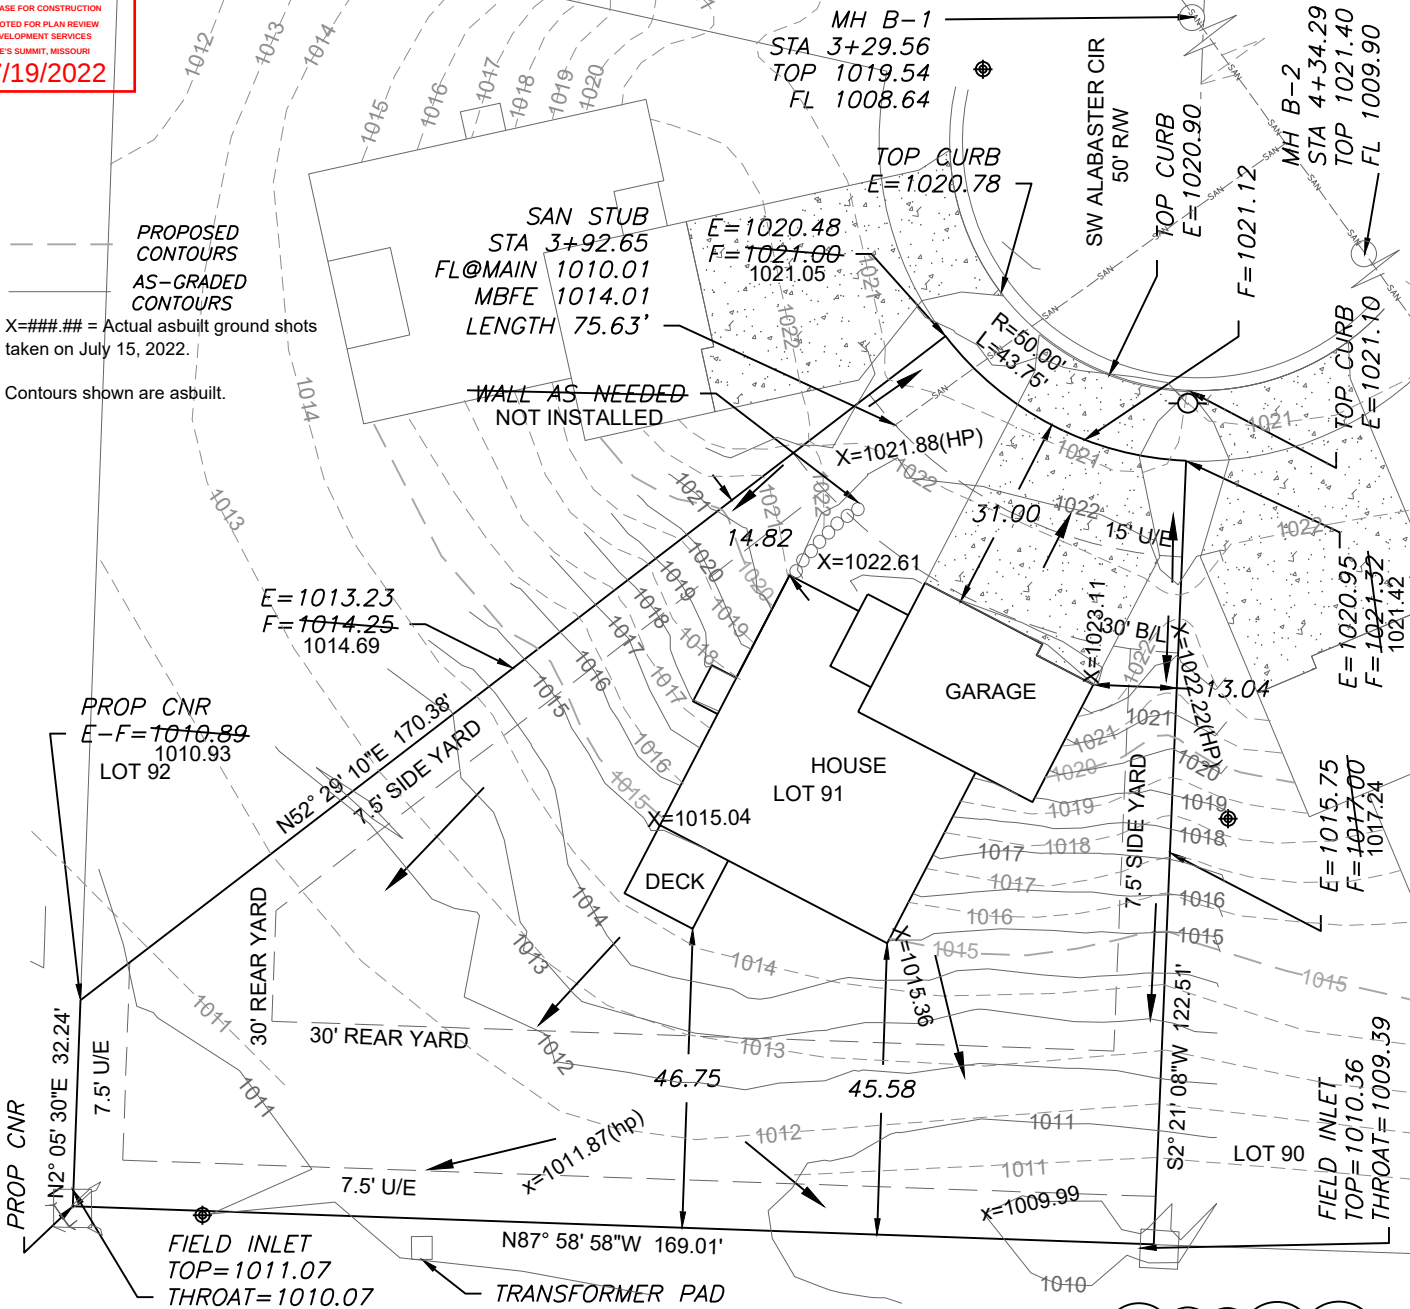

LEGEND

- Gas Meter
- Telephone or Fiber-Optic Pedestal
- Cable TV Pedestal
- Electric Pedestal
- Light Pole
- Mailbox
- Fire Hydrant
- Water Valve

PROPOSED HOUSE

TOP FOUNDATION = 1023.75
GARAGE FLOOR = 1022.75
TOP FOOTING = 1014.75
BASEMENT FLOOR = 1015.08
DRIVE SLOPE = 5.3%


E = EXISTING ELEVATION
F = PROPOSED FINAL ELEVATION
G = ADJACENT GRADE AT EGRESS
U/E = UTILITY EASEMENT
B/L = BUILDING LINE
S/Y/S = SIDE YARD SETBACK
R/Y/S = REAR YARD SETBACK

NOTES

1. BUILDER TO VERIFY ALL BUILDING ELEVATIONS AND DIMENSIONS.
2. THIS PLOT PLAN DOES NOT CONSTITUTE A BOUNDARY SURVEY.
3. THE EASEMENTS SHOWN ON THIS PLOT PLAN ARE TAKEN FROM THE FINAL PLAT. EASEMENTS MAY EXIST.

EXTENDED LOT AREA = 16649.3 SF
DRIVE AREA = 938.3 SF
APPROACH AREA = 236.6 SF
SIDEWALK AREA = N/A

AS-GRADED PLOT PLAN
REQUIRED PRIOR TO SODDING

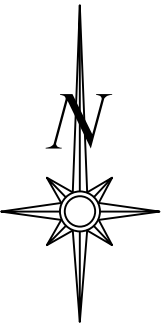


Scale 1"=30'

LOT INFORMATION

16,221.03 SQ. FT.
MBOE(LEFT)=1011.47
MBOE(RIGHT)=1012.20
MBFE =1014.01
ADDRESS
4420 SW ALABASTER CIR

LEGAL DESCRIPTION

LOT 91, THE MANOR AT STONEY CREEK 3RD PLAT, A SUBDIVISION AS RECORDED IN LEE'S SUMMIT, JACKSON COUNTY, MISSOURI.

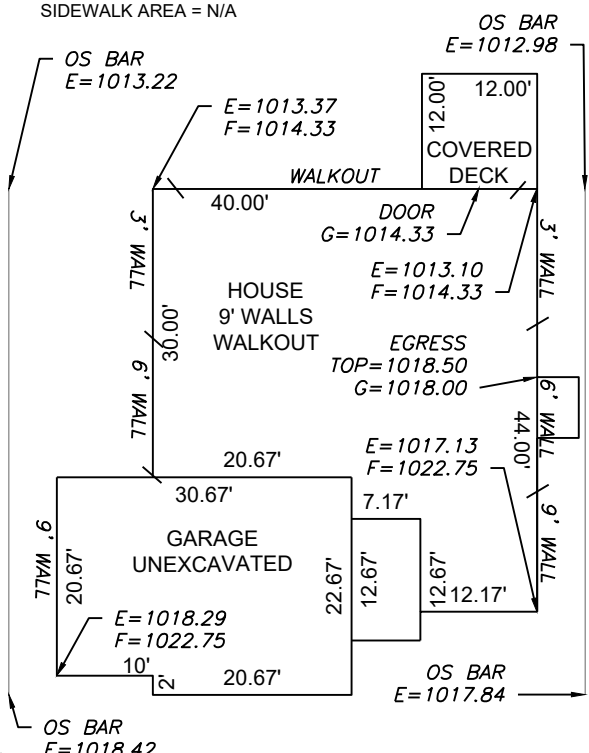

Scale 1"=20'
PLAN: CHARLOTTE

ENGINEERING SOLUTIONS
ENGINEERING & SURVEYING
50 SE 30TH STREET
LEE'S SUMMIT, MO 64082
P:(816) 623-9888 F:(816)623-9849
WWW.ENGINEERINGSOLUTIONKCC.COM

STATE OF MISSOURI
MATTHEW J. SCHLICHT
NUMBER
PE-2006019708
7/15/2022
PROFESSIONAL ENGINEER

AS-GRADED PLOT PLAN - LOT 91
THE MANOR AT STONEY CREEK - 3RD PLAT
LEE'S SUMMIT, JACKSON COUNTY, MISSOURI
SUMMIT HOMES
120 SE 30TH STREET
LEE'S SUMMIT, MO 64082
PROJECT NO. FILE NAME DATE SHEET OF
1 LOT 91, MANOR AT STONEY CREEK 4/23/2021 1 1
Rev:

THIS DRAWING IS NOT VALID UNLESS THE SIGNATURE, DATE AND SEAL OF THE ENGINEER WHO SUPERVISED THE PREPARATION OF THIS DRAWING HAS BEEN AFFIXED HERETO.