


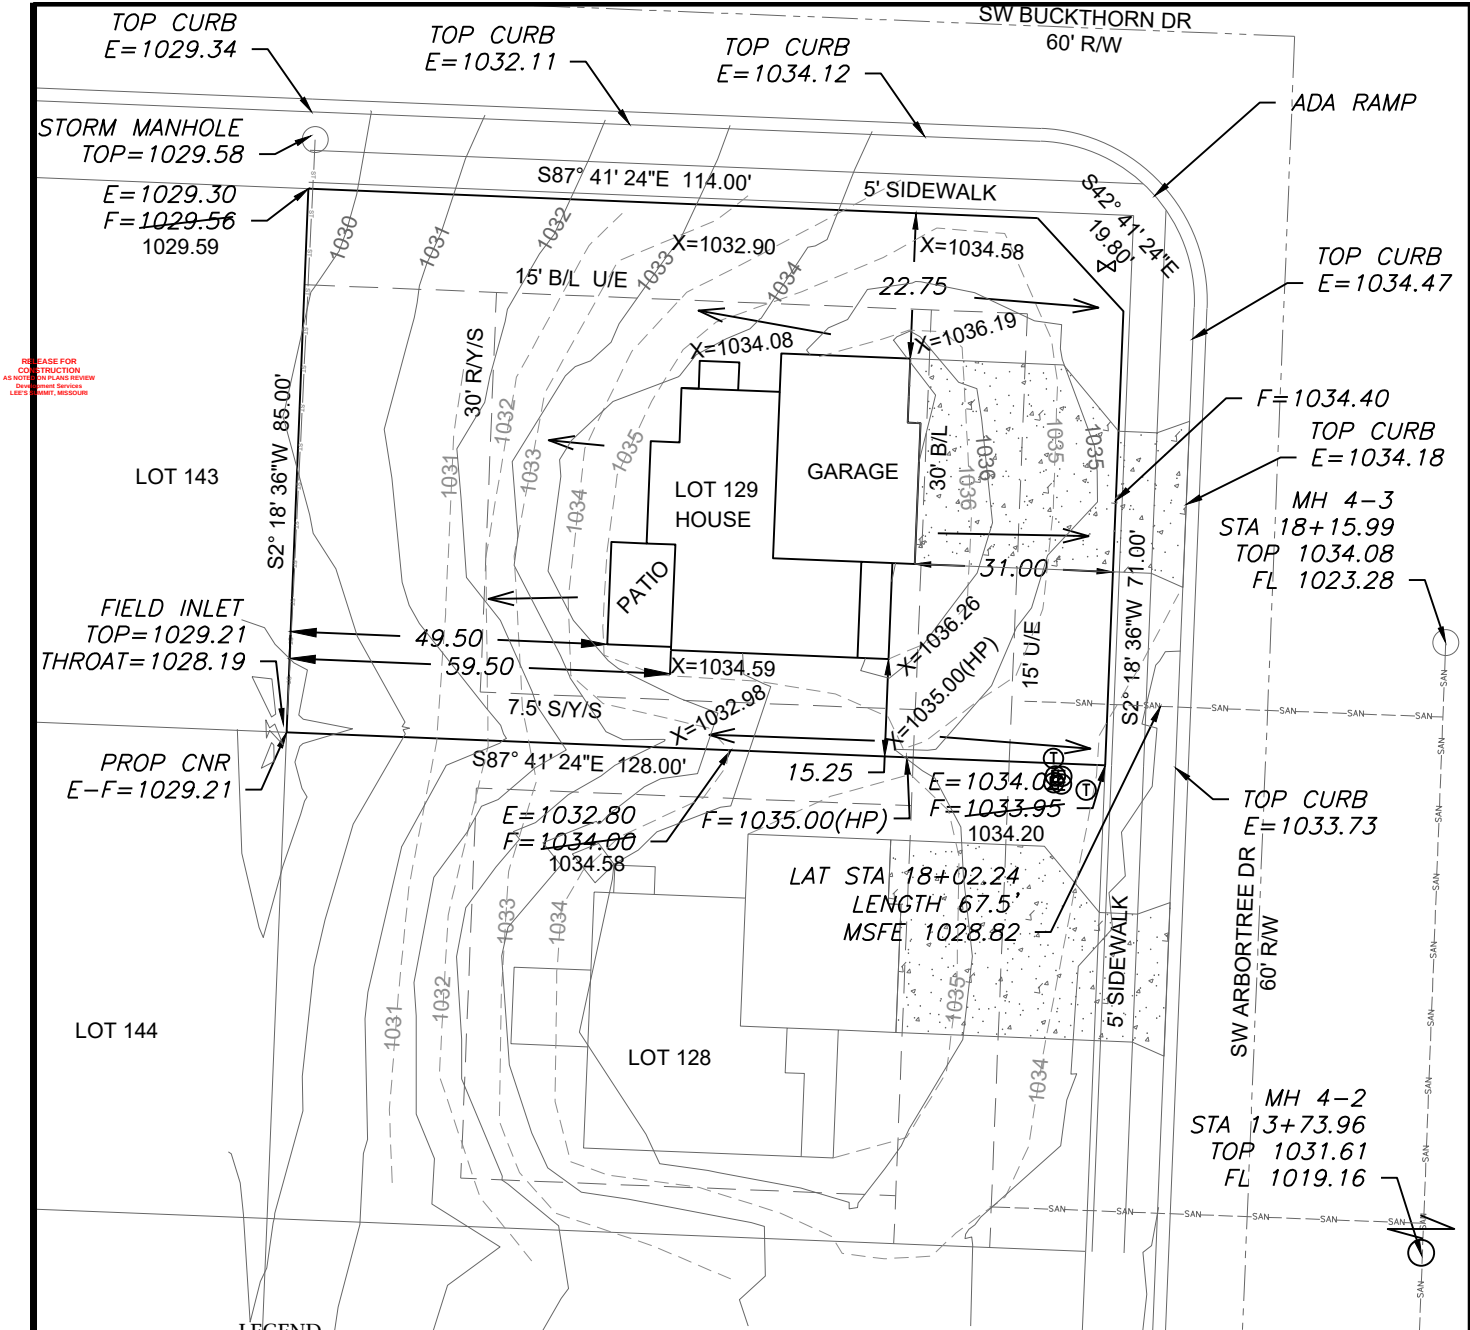

RELEASE FOR
CONSTRUCTION
AS NOTED ON PLANS REVIEW
Engineering Services
LEE'S SUMMIT, MISSOURI

LEGEND


- Gas Meter
- Telephone or Fiber-Optic Pedestal
- Cable TV Pedestal
- Electric Pedestal
- Light Pole
- Mailbox
- Fire Hydrant
- Water Valve

X=###.## = Actual asbuilt ground shots taken on July 19, 2022

Contours shown are asbuilt.

EXTENDED LOT AREA =13349.0 SF
DRIVEWAY AREA=967.0 SF
DRIVEWAY APPROACH=252.0 SF
SIDEWALK AREA=982.5 SF

As-Graded Plot Plan Required prior to Occupancy

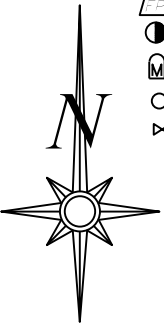

Scale 1"=30'

LOT INFORMATION

10,782 SQ. FT.
MSFE = 1028.82
MBOE (REAR LEFT) = 1029.26
MBOE (REAR RIGHT) = 1030.88
ADDRESS
3200 SW ARBORTREE DR

LEGAL DESCRIPTION

LOT 129, HAWTHORN RIDGE 2ND PLAT, A SUBDIVISION AS RECORDED IN LEE'S SUMMIT, JACKSON COUNTY, MISSOURI.

PROPOSED HOUSE


TOP FOUNDATION = 1038.00
GARAGE FLOOR = 1036.50
TOP FOOTING = 1029.00
BASEMENT FLOOR = 1029.33
DRIVEWAY SLOPE = 6.8%

E = EXISTING ELEVATION
F = PROPOSED FINAL ELEVATION
G = ADJACENT GRADE AT EGRESS
U/E = UTILITY EASEMENT
B/L = BUILDING LINE
S/Y/S = SIDE YARD SETBACK
R/Y/S = REAR YARD SETBACK

NOTES


- BUILDER TO VERIFY ALL BUILDING ELEVATIONS AND DIMENSIONS.
- THIS PLOT PLAN DOES NOT CONSTITUTE A BOUNDARY SURVEY.
- THE EASEMENTS SHOWN ON THIS PLOT PLAN ARE TAKEN FROM THE FINAL PLAT. OTHER EASEMENTS MAY EXIST.

PROPOSED CONTOURS
AS-GRADED CONTOURS

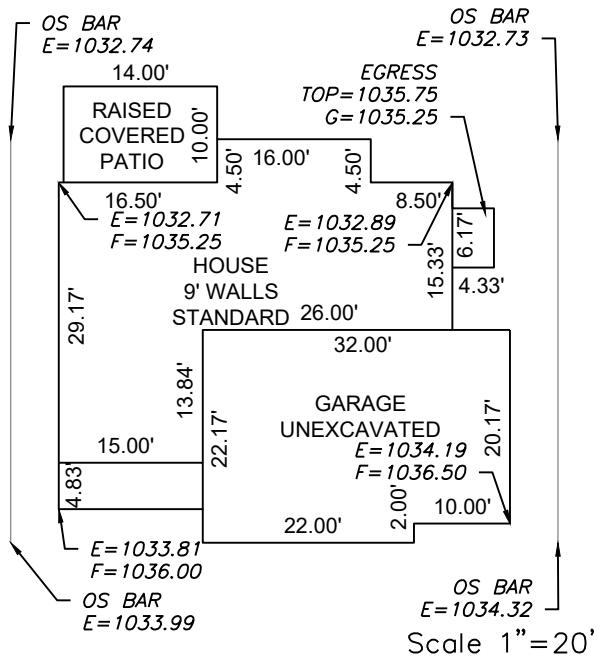

Scale 1"=20'

ENGINEERING SOLUTIONS
ENGINEERING & SURVEYING
50 SE 30TH STREET
LEE'S SUMMIT, MO 64082
P(816) 623-9888 F(816)623-9849
WWW.ENGINEERINGSOLUTIONKCC.COM

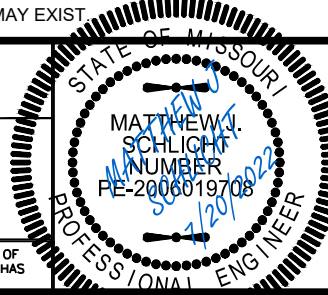

AS-GRADED PLOT PLAN - LOT 129

HAWTHORN RIDGE 2ND PLAT
LEE'S SUMMIT, JACKSON COUNTY, MISSOURI

SUMMIT HOMES
120 SE 30TH STREET
LEE'S SUMMIT, MO 64082

PROJECT NO.	FILE NAME	DATE	SHEET	OF
1	LOT 128, 129, HAWTHORN RIDGE	2/19/21	1	1

Rev:

THIS DRAWING IS NOT VALID UNLESS THE SIGNATURE, DATE AND SEAL OF THE ENGINEER WHO SUPERVISED THE PREPARATION OF THIS DRAWING HAS BEEN AFFIXED HERETO.