


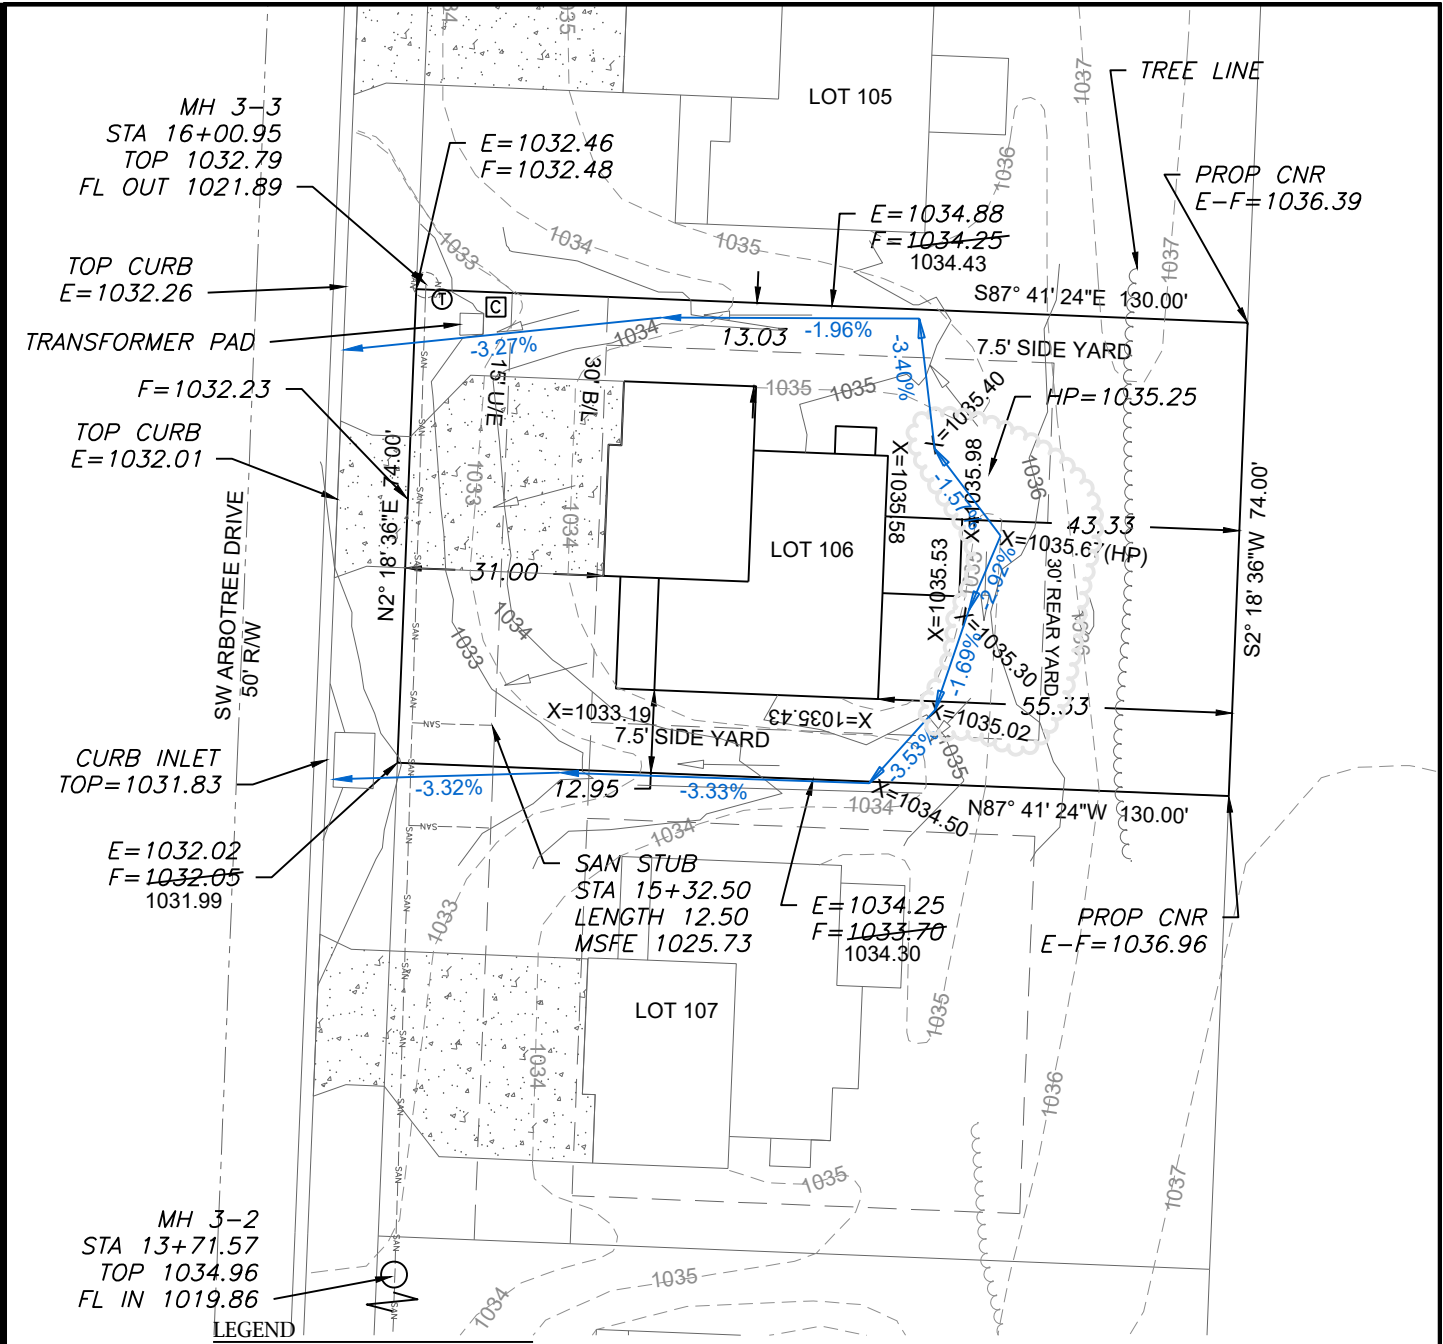

LEGEND

- Gas Meter
- Telephone or Fiber-Optic Pedestal
- Cable TV Pedestal
- Electric Pedestal
- Light Pole
- Mailbox
- Fire Hydrant
- Water Valve

EXTENDED LOT AREA = 10,434.0 SF
DRIVE AREA = 920.5 SF
APPROACH AREA = 235.5 SF
SIDEWALK AREA = N/A
NOTE : DECK APPROVAL WILL BE REQUIRED PRIOR TO (FUTURE) DECK CONSTRUCTION

PROPOSED CONTOURS
AS-GRADED CONTOURS
X=###.## = Actual asbuilt ground shots taken on August 1, 2022.
Contours shown are asbuilt.



Scale 1"=30'

LOT INFORMATION

9620.0 SQ. FT.
MSFE = 1025.73
ADDRESS
3121 SW ARBORTREE DR
LEGAL DESCRIPTION
LOT 106, HAWTHORN RIDGE 2ND PLAT A SUBDIVISION AS RECORDED IN LEE SUMMIT, JACKSON COUNTY, MISSOURI.


PROPOSED HOUSE

TOP FOUNDATION = 1036.50
GARAGE FLOOR = 1034.50
TOP FOOTING = 1027.50
BASEMENT FLOOR = 1027.83
DRIVE SLOPE = 7.3%

E = EXISTING ELEVATION
F = PROPOSED FINAL ELEVATION
G = ADJACENT GRADE AT EGRESS
U/E = UTILITY EASEMENT
B/L = BUILDING LINE
S/Y/S = SIDE YARD SETBACK
R/Y/S = REAR YARD SETBACK

NOTES

- BUILDER TO VERIFY ALL BUILDING ELEVATIONS AND DIMENSIONS.
- THIS PLOT PLAN DOES NOT CONSTITUTE A BOUNDARY SURVEY.
- THE EASEMENTS SHOWN ON THIS PLOT PLAN ARE TAKEN FROM THE FINAL PLAT. OTHER EASEMENTS MAY EXIST.

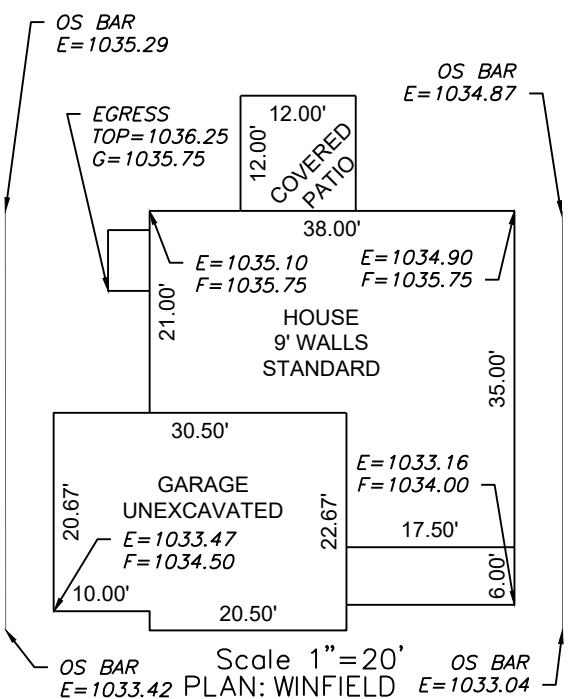

ENGINEERING
ENGINEERING & SURVEYING
SOLUTIONS
50 SE 30TH STREET
LEE'S SUMMIT, MO 64082
P:(816) 623-9888 F:(816)623-9849
WWW.ENGINEERINGSOLUTIONSKC.COM

THIS DRAWING IS NOT VALID UNLESS THE SIGNATURE, DATE AND SEAL OF THE ENGINEER WHO SUPERVISED THE PREPARATION OF THIS DRAWING HAS BEEN AFFIXED HERETO.

AS-GRADED PLOT PLAN - LOT 106

HAWTHORN RIDGE 2ND PLAT
LEE SUMMIT, JACKSON COUNTY, MISSOURI

SUMMIT HOMES
120 SE 30TH STREET
LEE SUMMIT, MO, 64082

PROJECT NO.	FILE NAME	DATE	SHEET	OF
1	LOT 106, HAWTHORN RIDGE	7/14/2021	1	1