


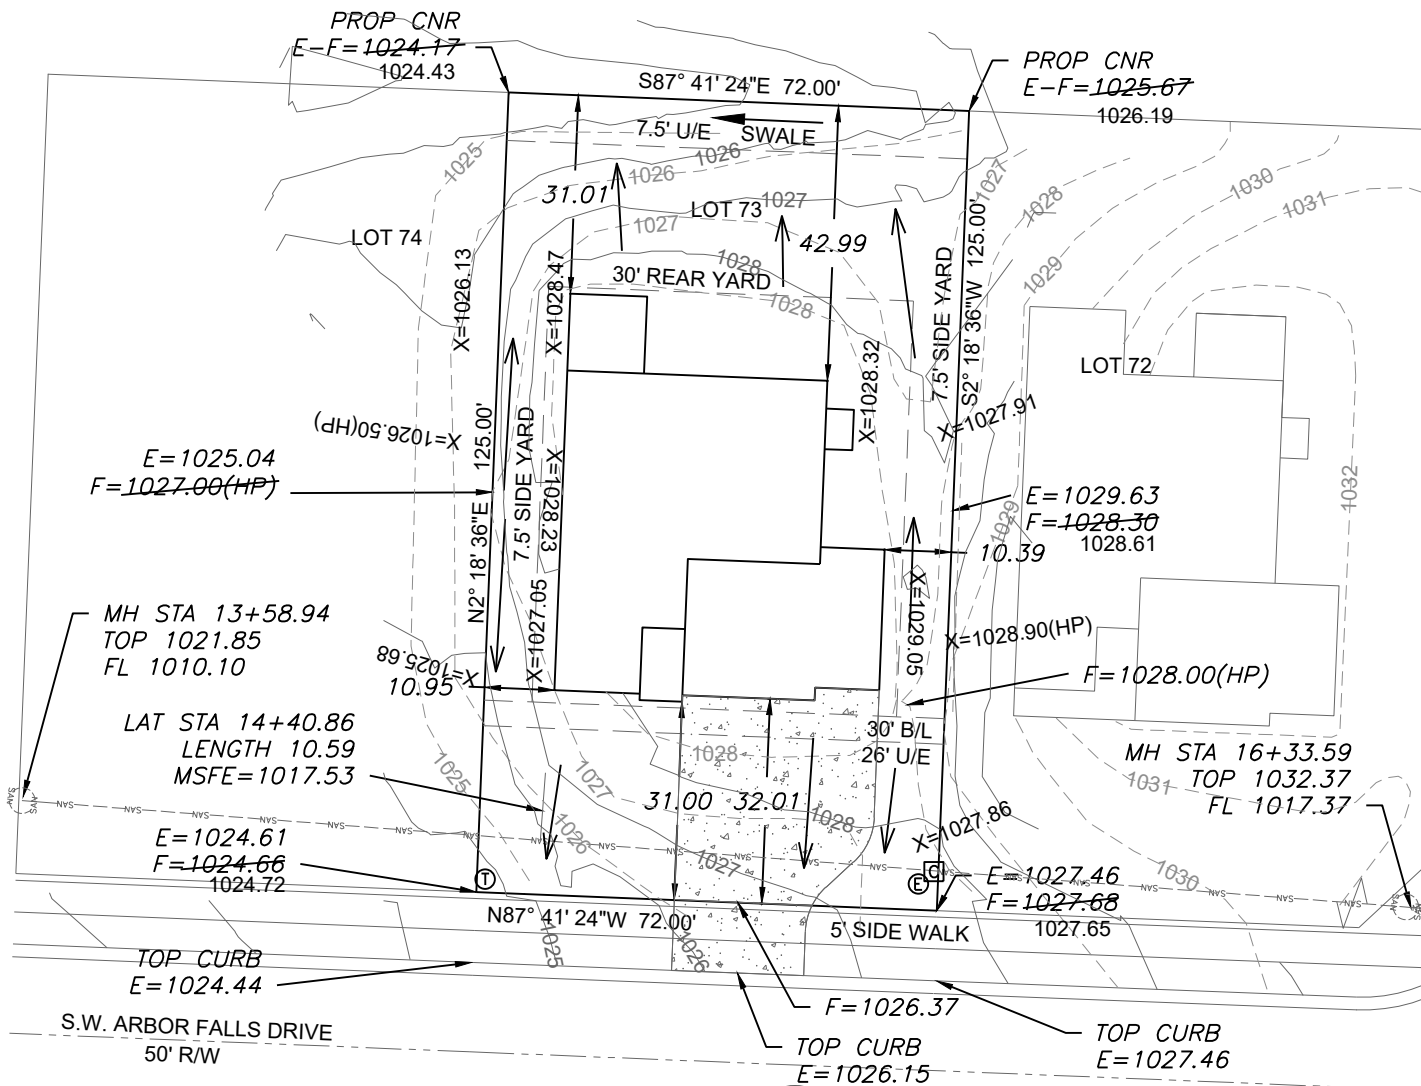

LEGEND

- Gas Meter
- Telephone or Fiber-Optic Pedestal
- Cable TV Pedestal
- Electric Pedestal
- Light Pole
- Mailbox
- Fire Hydrant
- Water Valve

PROPOSED HOUSE

TOP FOUNDATION = 1029.50
GARAGE FLOOR = 1028.50
TOP FOOTING = 1020.50
BASEMENT FLOOR = 1020.83
DRIVE SLOPE = 6.7%

E = EXISTING ELEVATION
F = PROPOSED FINAL ELEVATION
G = ADJACENT GRADE AT EGRESS
U/E = UTILITY EASEMENT
B/L = BUILDING LINE
S/Y/S = SIDE YARD SETBACK
R/Y/S = REAR YARD SETBACK

NOTES

- BUILDER TO VERIFY ALL BUILDING ELEVATIONS AND DIMENSIONS.
- THIS PLOT PLAN DOES NOT CONSTITUTE A BOUNDARY SURVEY.
- THE EASEMENTS SHOWN ON THIS PLOT PLAN ARE TAKEN FROM THE FINAL PLAT. OTHER EASEMENTS MAY EXIST.

EXTENDED LOT AREA = 9,792 SF
DRIVE AREA = 950 SF
APPROACH AREA = 230 SF
SIDEWALK AREA = 257 SF

X=###.## = Actual asbuilt ground shots taken on July 26, 2022

Contours shown are asbuilt.

PROPOSED CONTOURS
AS-GRADED CONTOURS

Scale 1"=30'

LOT INFORMATION


9,000 SQ. FT.
MBOE (RIGHT) = 1027.93
MBOE (LEFT) = 1026.38
MSFE = 1017.53
ADDRESS
1522 SW ARBOR FALLS DR

LEGAL DESCRIPTION


LOT 73, HAWTHORN RIDGE - 1ST PLAT, A SUBDIVISION AS RECORDED IN LEE'S SUMMIT, JACKSON COUNTY, MISSOURI.

PLAN: WESTPORT

Scale 1"=20'

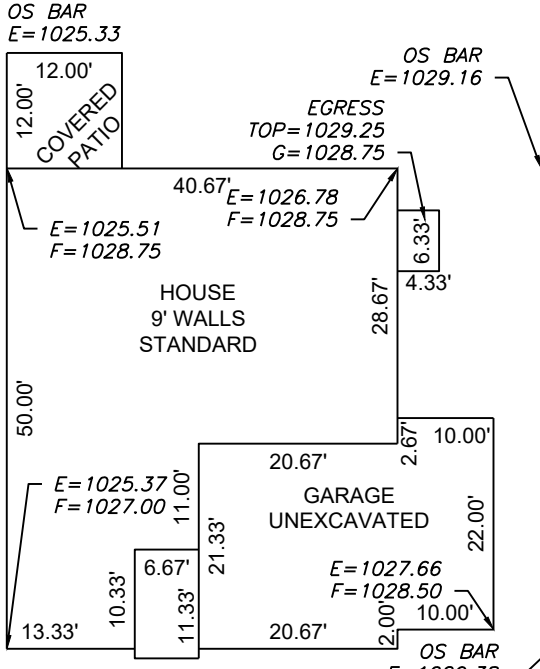

ENGINEERING & SURVEYING SOLUTIONS
50 SE 30TH STREET
LEE'S SUMMIT, MO 64082
P:(816) 623-9888 F:(816) 623-9849
WWW.ENGINEERINGSSOLUTIONSKC.COM

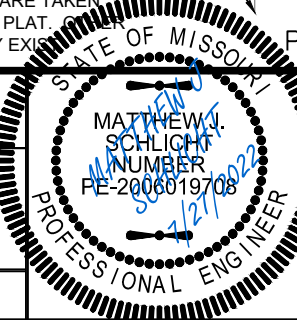

AS-GRADED PLOT PLAN - LOT 73

HAWTHORN RIDGE - 1ST PLAT
LEE'S SUMMIT, JACKSON COUNTY, MISSOURI

SUMMIT HOMES
120 SE 30TH STREET
LEE'S SUMMIT, MO, 64082

PROJECT NO.	FILE NAME	DATE	SHEET	OF
1	LOT 73, HAWTHORN RIDGE - 1ST PLAT	8/12/2021	1	1

THIS DRAWING IS NOT VALID UNLESS THE SIGNATURE, DATE AND SEAL OF THE ENGINEER WHO SUPERVISED THE PREPARATION OF THIS DRAWING HAS BEEN AFFIXED HERETO.