


Houston Richards
1221 NE GOSHEN DR
Lee's Summit MO

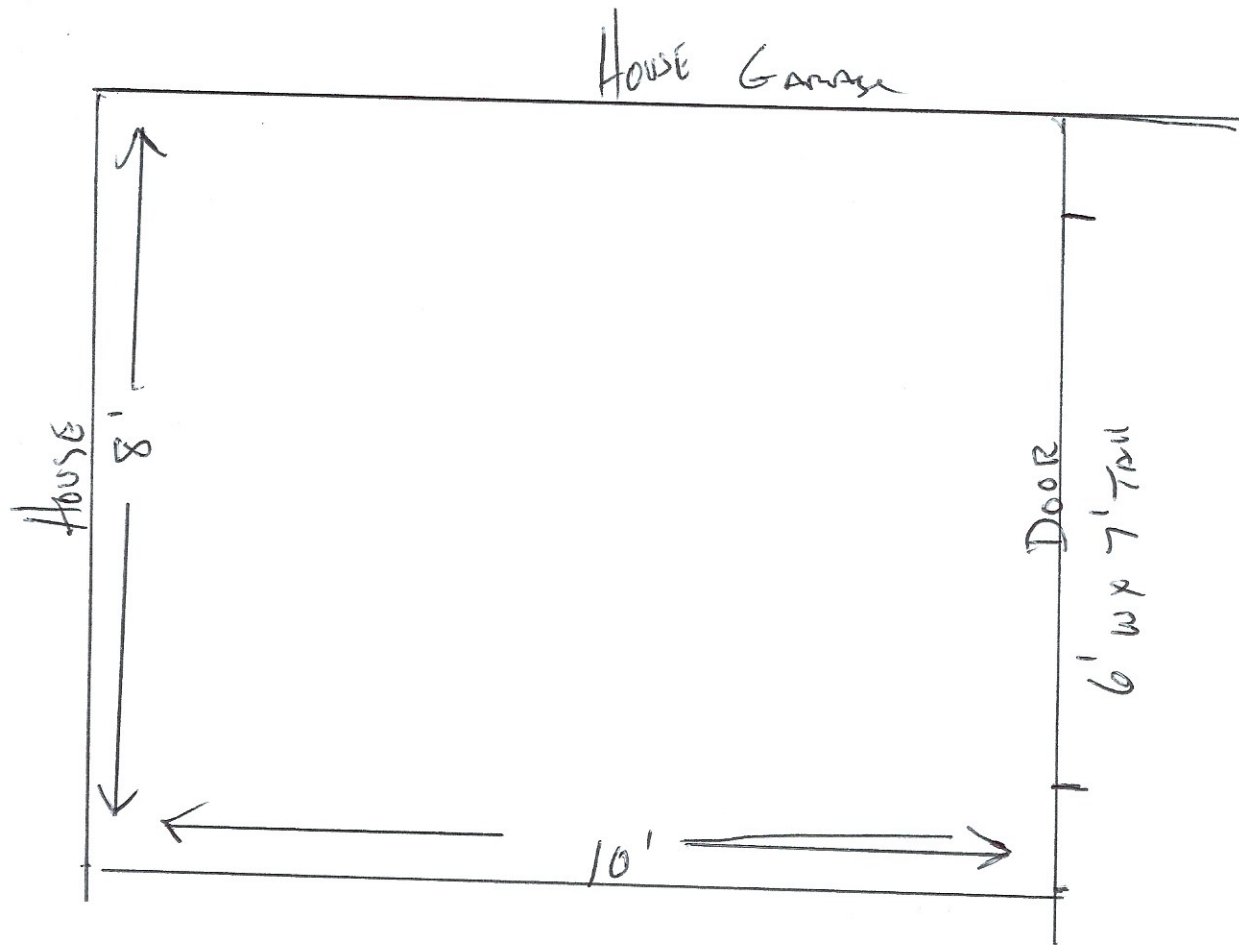



Roof Shed Roof Back to House Garage 6/12
2x6 RAFTERS on 16" centers
WALLS 2x4 on 16" centers
Header Dabled 2x10
Smart Siding
4" concrete pad
Rebar drilled to existing Foundation

PROPERTY ADDRESS: 1221 NE GOSHEN DRIVE

LAND SURVEY COMPANY

Quality since 1959
P.O. BOX 528, GRANDVIEW, MISSOURI 64030
PHONE: (816) 966-0839 FAX: (816) 763-1761

As-Graded Plot Plan.

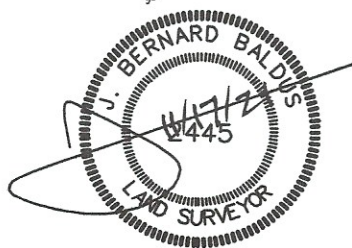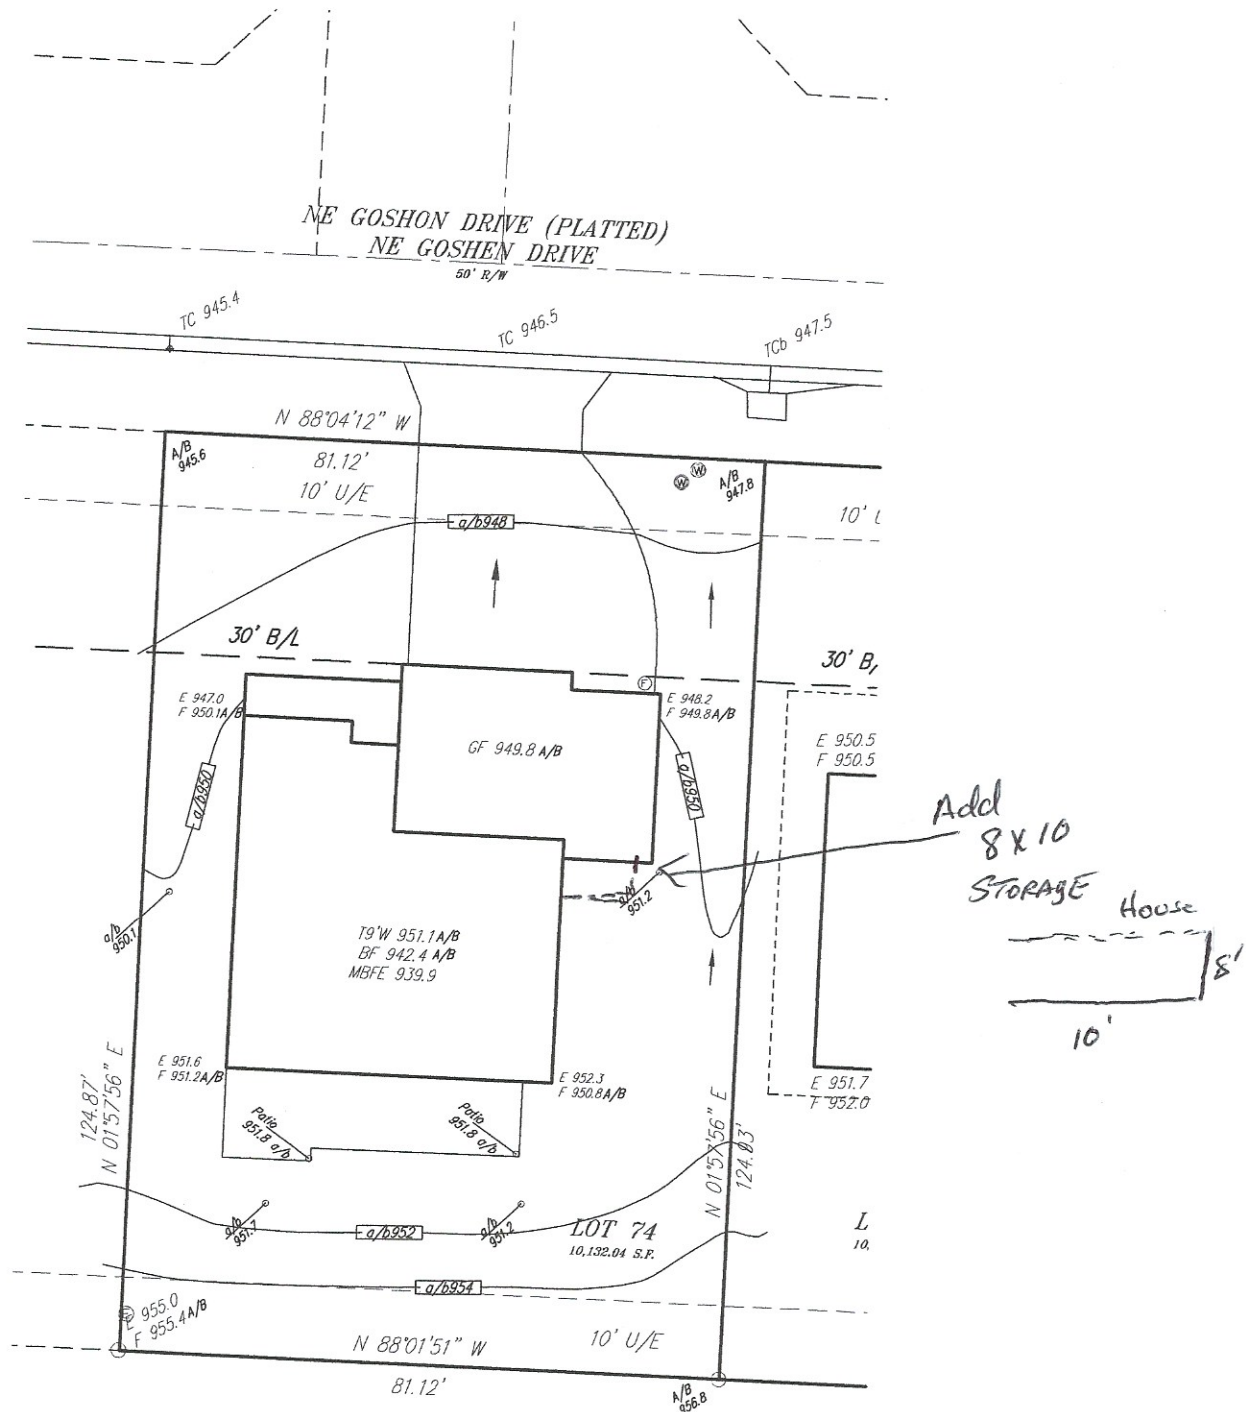

Scale: 1" = 20'
Date: 1/15/21
Rev: 1/18/21, 1/26/21
Final: 1/22/21
FG: 11/17/21

Attention: This Plot Plan was prepared for use before and during foundation construction ONLY. This house is staked as shown on this drawing. The Contractor is to check and verify house dimensions and elevations at the job site. We are not responsible for unknown or unplaced assessments of any kind unless we are furnished with the description of said assessment prior to the time we are contacted. Elevations shown hereon are for a guide only, and final elevations are the responsibility of the on-site Contractor. Unless otherwise noted, THIS IS NOT AN AS-BUILT SURVEY and we can not guarantee the construction of anything shown on this "Plan." Boundary and Improvement Surveys and "As-Built" Grading Certifications serve the purpose of showing "Actual" construction.