


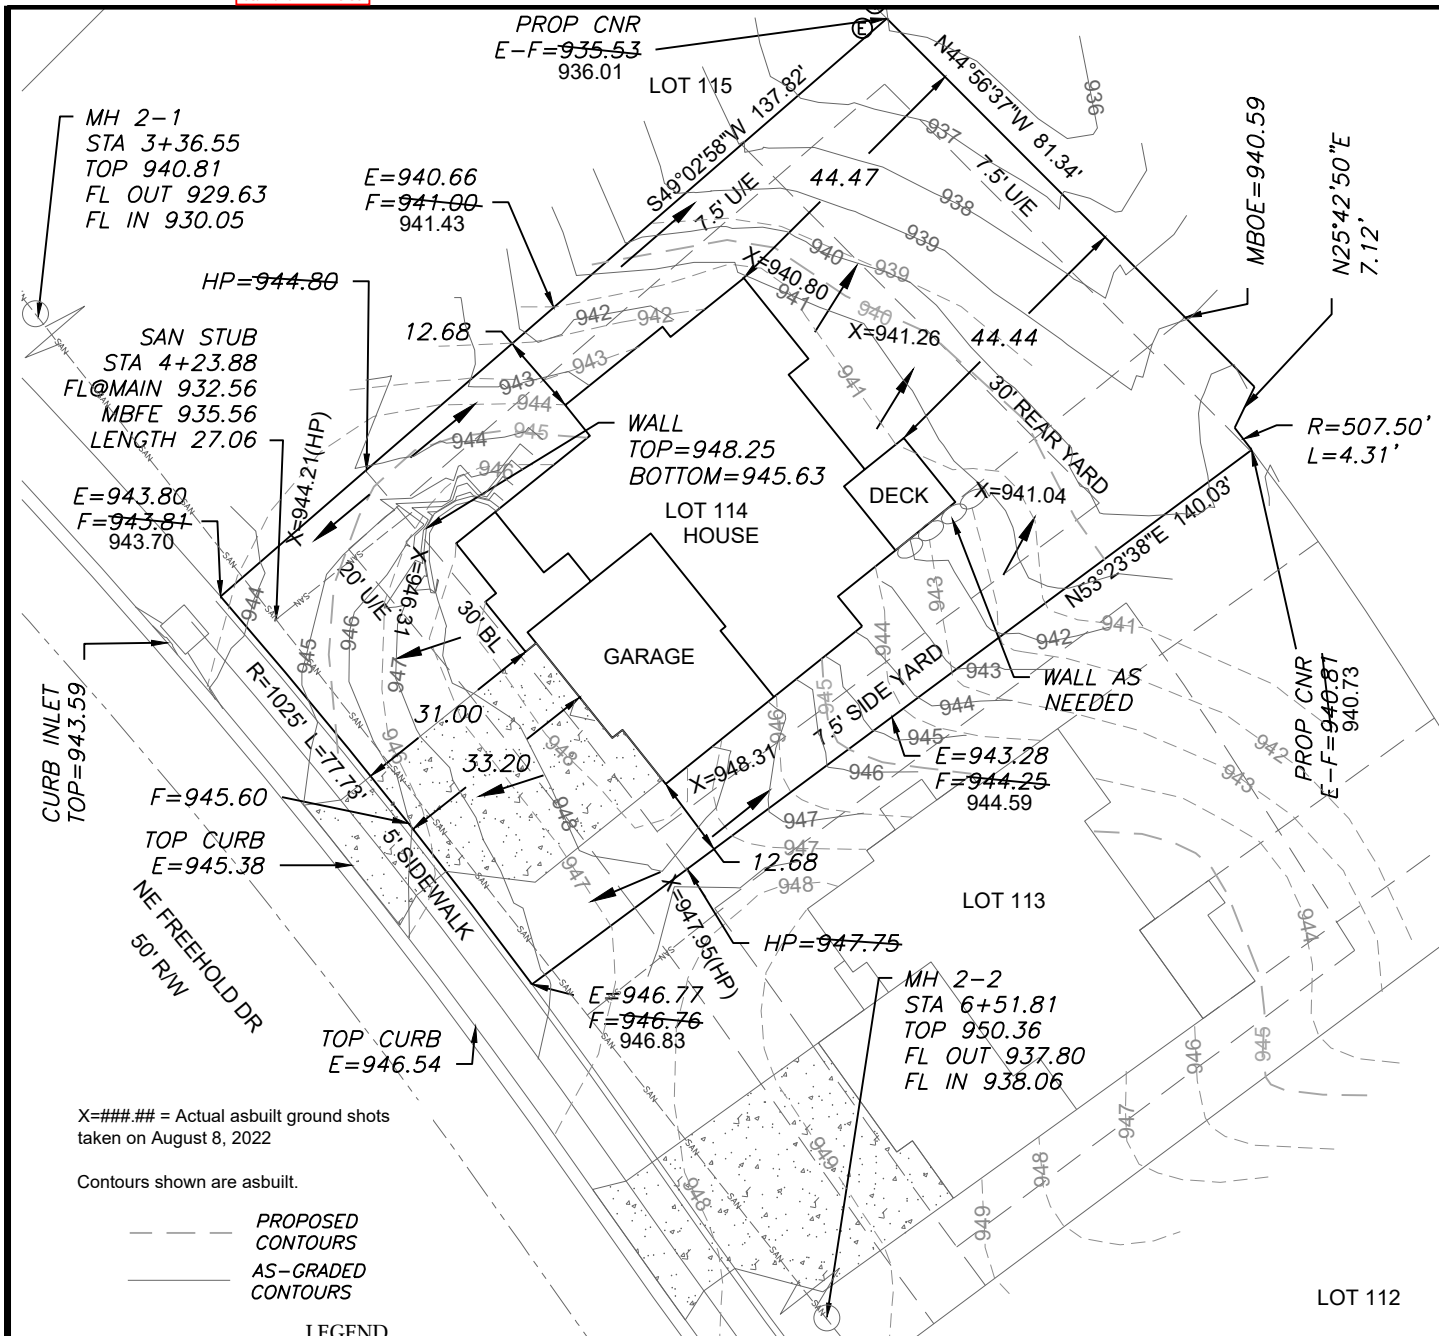

X=###.## = Actual asbuilt ground shots
taken on August 8, 2022

Contours shown are asbuilt.

--- PROPOSED
CONTOURS
--- AS-GRADED
CONTOURS

LEGEND


- Gas Meter
- Telephone or Fiber-Optic Pedestal
- Cable TV Pedestal
- Electric Pedestal
- Light Pole
- Mailbox
- Fire Hydrant
- Water Valve

PROPOSED HOUSE

TOP FOUNDATION = 950.00
GARAGE FLOOR = 948.50
TOP FOOTING = 941.00
BASEMENT FLOOR = 941.33
DRIVEWAY SLOPE = 8.7%
E = EXISTING ELEVATION
F = PROPOSED FINAL ELEVATION
G = ADJACENT GRADE AT EGRESS
U/E = UTILITY EASEMENT
B/L = BUILDING LINE
S/Y/S = SIDE YARD SETBACK
R/Y/S = REAR YARD SETBACK

NOTES

- BUILDER TO VERIFY ALL BUILDING ELEVATIONS AND DIMENSIONS.
- THIS PLOT PLAN DOES NOT CONSTITUTE A BOUNDARY SURVEY.
- THE EASEMENTS SHOWN ON THIS PLOT PLAN ARE TAKEN FROM THE FINAL PLAT. EASEMENTS MAY EXIST.

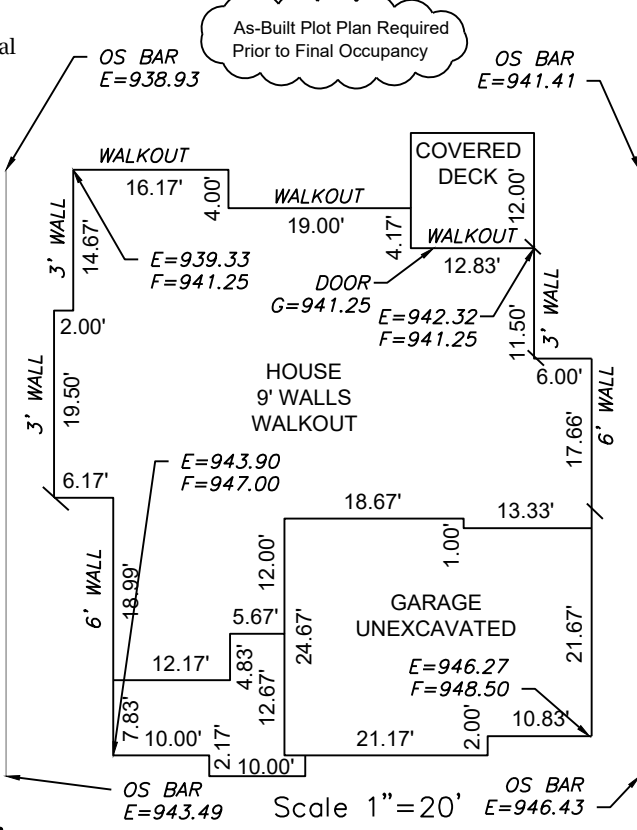

Scale 1"=20'


LOT INFORMATION

11,763.11 SQ. FT.
MBOE (RIGHT)=941.54
MBOE (LEFT)=937.4
MBFE=935.56
ADDRESS
4725 NE FREEHOLD DR

LEGAL DESCRIPTION

LOT 114, MONTICELLO - 4TH
PLAT, A SUBDIVISION AS
RECORDED IN LEE'S SUMMIT,
JACKSON COUNTY, MISSOURI.

ENGINEERING SOLUTIONS
ENGINEERING & SURVEYING
50 SE 30TH STREET
LEE'S SUMMIT, MO 64082
P:(816) 623-9888 F:(816)623-9849
WWW.ENGINEERINGSOLUTIONKCC.COM

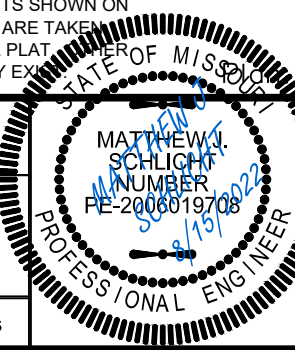

AS-GRADED PLOT PLAN - LOT 114

MONTICELLO - 4TH PLAT
LEE'S SUMMIT, JACKSON COUNTY, MISSOURI

SAB HOMES
200 NW COMMERCE COURT
LEE'S SUMMIT, MO 64086

PROJECT NO.	FILE NAME	DATE	SHEET	OF
1	LOT 113 & 114, MONTICELLO	7/28/2021	1	1

THIS DRAWING IS NOT VALID UNLESS THE SIGNATURE, DATE AND SEAL OF THE ENGINEER WHO SUPERVISED THE PREPARATION OF THIS DRAWING HAS BEEN AFFIXED HERETO.