


RELEASE FOR
CONSTRUCTION
NO OTHER REVISIONS
DATE: 9/17/2022

PROPOSED
CONTOURS
AS-GRADED
CONTOURS

X=#### = Actual asbuilt ground shots
taken on September 1, 2022.

Contours shown are asbuilt.

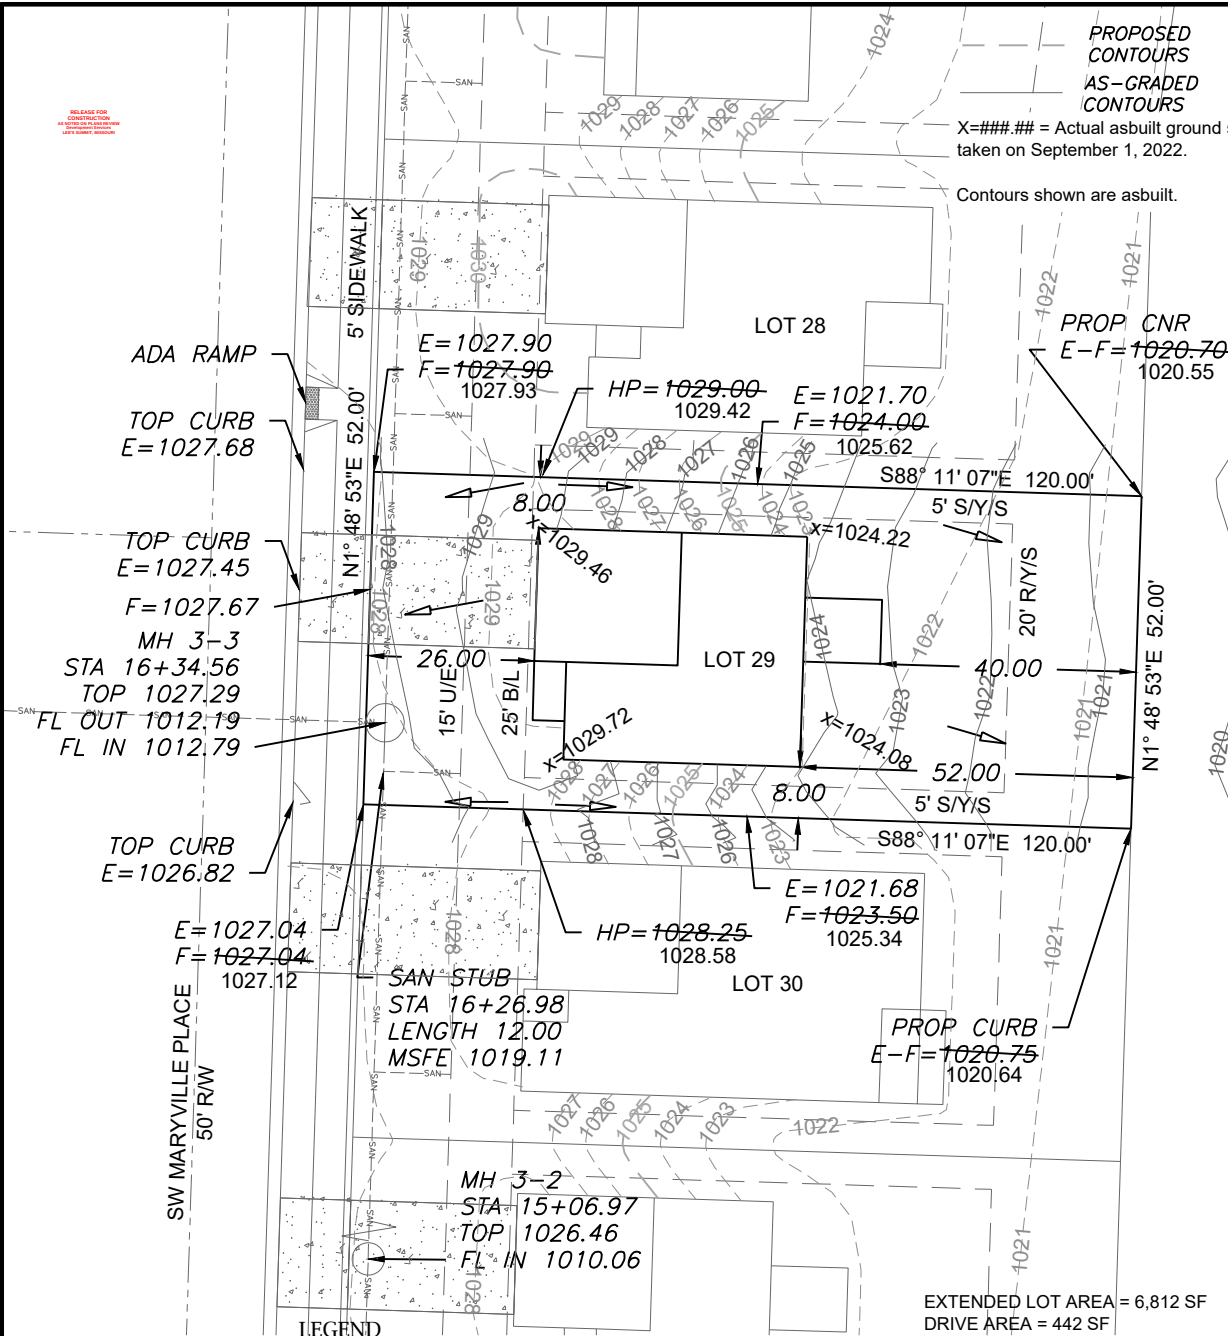

LEGEND

- Gas Meter
- Telephone or Fiber-Optic Pedestal
- Cable TV Pedestal
- Electric Pedestal
- Light Pole
- Mailbox
- Fire Hydrant
- Water Valve

PROPOSED HOUSE


TOP FOUNDATION = 1031.50
GARAGE FLOOR = 1029.50
TOP FOOTING = 1023.50
BASEMENT FLOOR = 1023.83
DRIVE SLOPE = 7.0%

E = EXISTING ELEVATION
F = PROPOSED FINAL ELEVATION
G = ADJACENT GRADE AT EGRESS
U/E = UTILITY EASEMENT
B/L = BUILDING LINE
S/Y/S = SIDE YARD SETBACK
R/Y/S = REAR YARD SETBACK

NOTES

- BUILDER TO VERIFY ALL BUILDING ELEVATIONS AND DIMENSIONS.
- THIS PLOT PLAN DOES NOT CONSTITUTE A BOUNDARY SURVEY.
- THE EASEMENTS SHOWN ON THIS PLOT PLAN ARE TAKEN FROM THE FINAL PLAT. EASEMENTS MAY EXIST.

AS-GRADED PLOT PLAN IS
REQUIRED PRIOR TO SODDING.

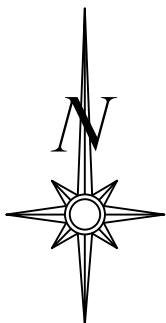


Scale 1"=30'

LOT INFORMATION

6,240 SQ. FT.
REAR LEFT MBOE = 1021.64
REAR RIGHT MBOE = 1021.65
MSFE = 1019.11
ADDRESS
3821 SW MARYVILLE PLACE


LEGAL DESCRIPTION

LOT 29, OSAGE FIRST PLAT, A
SUBDIVISION AS RECORDED IN
LEE'S SUMMIT, JACKSON
COUNTY, MISSOURI.

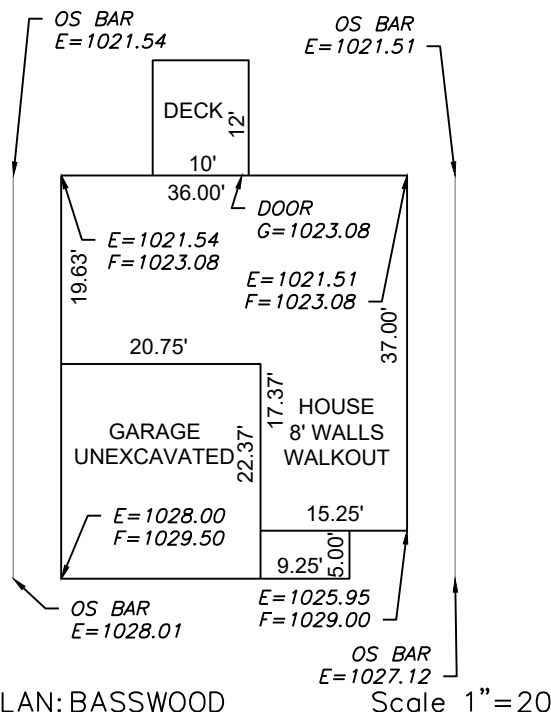

PLAN: BASSWOOD

ENGINEERING SOLUTIONS
ENGINEERING & SURVEYING
50 SE 30TH STREET
LEE'S SUMMIT, MO 64082
P:(816) 623-9888 F:(816) 623-9849
WWW.ENGINEERINGSOLUTIONSKC.COM

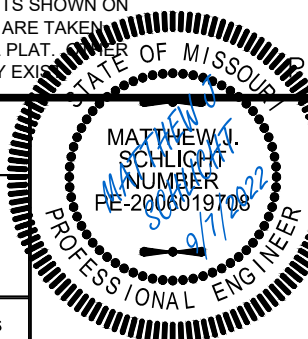

AS-GRADED PLOT PLAN - LOT 29

OSAGE FIRST PLAT
LEE'S SUMMIT, JACKSON COUNTY, MISSOURI

CLOVER AND HIVE
120 SE 30TH STREET
LEE'S SUMMIT, MO 64082

PROJECT NO.	FILE NAME	DATE	SHEET	OF
1	LOT 26, 27 28, 29, 30, 31, OSAGE	6/18/21	1	1

THIS DRAWING IS NOT VALID UNLESS THE SIGNATURE, DATE AND SEAL OF THE ENGINEER WHO SUPERVISED THE PREPARATION OF THIS DRAWING HAS BEEN AFFIXED HERETO.