

SANITARY SEWER IMPROVEMENTS
TO SERVE
LOT 7A & 7B
STREETS OF WEST PRYOR

UTILITIES
Electric Service
Evergy
Nathan Michael
913-347-4310
Nathan.michael@evergy.com

Gas Service
Spire
Katie Darnell
816-969-2247
Katie.darnell@spireenergy.com

Water/Sanitary Sewer
Water Utilities Department
1200 SE Hamblen Road
Lee's Summit, Mo 64081
Jeff Thorn
816-969-1900
jeff.thorn@cityofls.net

Communication Service
AT&T Carrie Cilke
816-703-4386
cc3527@att.com

Time Warner Cable
Steve Baxter
913-643-1928
steve.baxter@charter.com

Comcast
Ryan Alkire
816-795-2218
ryan.alkire@cable.comcast.com

Google Fiber
Becky Davis
913-725-8745
rebeccadavis@google.com



UTILITY STATEMENT:
THE UNDERGROUND UTILITIES SHOWN HEREON ARE FROM FIELD SURVEY INFORMATION OF ONE-CALL LOCATED UTILITIES, FIELD SURVEY INFORMATION OF ABOVE GROUND OBSERVABLE EVIDENCE, AND/OR THE SCALING AND PLOTTING OF EXISTING UTILITY MAPS AND DRAWINGS AVAILABLE TO THE SURVEYOR AT THE TIME OF SURVEY. THE SURVEYOR MAKES NO GUARANTEE THAT THE UNDERGROUND UTILITIES SHOWN COMPRISE ALL SUCH UTILITIES IN THE AREA, EITHER IN SERVICE OR ABANDONED. FURTHERMORE, THE SURVEYOR DOES NOT WARRANT THAT THE UNDERGROUND UTILITIES SHOWN ARE IN THE EXACT LOCATION INDICATED ALTHOUGH HE DOES CERTIFY THAT THEY ARE LOCATED AS ACCURATELY AS POSSIBLE FROM INFORMATION AVAILABLE. THE SURVEYOR HAS NOT PHYSICALLY LOCATED THE UNDERGROUND UTILITIES BY EXCAVATION UNLESS OTHERWISE NOTED ON THIS SURVEY.
SAFETY NOTICE TO CONTRACTOR
IN ACCORDANCE WITH GENERALLY ACCEPTED CONSTRUCTION PRACTICE, THE CONTRACTOR WILL BE SOLELY AND COMPLETELY RESPONSIBLE FOR CONDITIONS OF THE JOB SITE, INCLUDING SAFETY OF ALL PERSONS AND PROPERTY DURING PERFORMANCE OF THE WORK. THIS REQUIREMENT WILL APPLY CONTINUOUSLY AND NOT BE LIMITED TO NORMAL WORKING HOURS.

WARRANTY/DISCLAIMER
THE DESIGNS REPRESENTED IN THESE PLANS ARE IN ACCORDANCE WITH ESTABLISHED PRACTICES OF CIVIL ENGINEERING FOR THE DESIGN FUNCTIONS AND USES INTENEDED BY THE OWNER AT THIS TIME. HOWEVER, NEITHER SM ENGINEERING NOR ITS PERSONNEL CAN OR DO WARRANTY THESE DESIGNS OR PLANS AS CONSTRUCTED, EXCEPT IN THE SPECIFIC CASES WHERE SM ENGINEERING PERSONNEL INSPECT AND CONTROL THE PHYSICAL CONSTRUCTION ON A CONTEMPORARY BASIS AT THE SITE.

CAUTION- NOTICE TO CONTRACTOR
THE CONTRACTOR IS SPECIFICALLY CAUTIONED THAT THE LOCATION AND/OR ELEVATION OF EXISTING UTILITIES AS SHOWN ON THESE PLANS IS BASED ON RECORDS OF THE VARIOUS UTILITY COMPANIES AND, WHERE POSSIBLE, MEASUREMENTS TAKEN IN THE FIELD. THE INFORMATION IS NOT TO BE RELIED ON AS BEING EXACT OR COMPLETE. THE CONTRACTOR MUST CALL THE APPROPRIATE UTILITY COMPANY AT LEAST 72 HOURS BEFORE ANY EXCAVATION TO REQUEST EXACT FIELD LOCATION OF UTILITIES. IT SHALL BE THE RESPONSIBILITY OF THE CONTRACTOR TO RELOCATE ALL EXISTING UTILITIES WHICH CONFLICT WITH PROPOSED IMPROVEMENTS SHOWN ON THE PLANS. THE CONTRACTOR SHALL EXPOSE EXISTING UTILITIES AT LOCATIONS OF POSSIBLE CONFLICTS PRIOR TO ANY CONSTRUCTION.



LOCATION MAP

LEGAL DESCRIPTION:
LOT 7 & TRACT C STREET OF WEST PRYOR
LOTS 1 THRU 14, TRACTS A, B, C, & D TO LEE'S SUMMIT, MO, JACKSON COUNTY MISSOURI

ALL EXISTING TOPOGRAPHIC DATA AND INFRASTRUCTURE IMPROVEMENTS SHOWN BASED ON INFORMATION BY KAW VALLEY ENGINEERING

BENCHMARKS:
#1 CHISELED "SQUARE" ON TOP OF CURB POINT OF INTERSECTION OF WEST PARK PARKING LOT AT EAST DRIVE ENTRANCE
ELEVATION 985.05

#2 CHISELED "SQUARE" ON NORTHWEST CORNER AREA INLET, 25' EAST OF CURB LINE AND ON-LINE WITH SOUTH CURB OF LOWENSTEIN DRIVE AT 90° BEND IN ROAD
ELEVATION 971.06

FLOODPLAIN NOTE:
SUBJECT PROPERTY IS SHOWN TO BE LOCATED IN "OTHER AREAS ZONE X" ON THE FLOOD INSURANCE RATE MAP FOR JACKSON COUNTY, MISSOURI AND INCORPORATED AREAS. COMMUNITY PANEL NO. 29095C0416G, REVISED JANUARY 20, 2017. "OTHER AREAS ZONE X" IS DEFINED AS "AREAS DETERMINED TO BE OUTSIDE THE 0.2% ANNUL CHANCE FLOODPLAIN". LOCATION DETERMINED BY A SCALED GRAPHICAL PLOT OF THE FLOOD INSURANCE RATE MAP.

NOTE
ALL CONSTRUCTION SHALL FOLLOW THE CITY OF LEE'S SUMMIT DESIGN AND CONSTRUCTION MANUAL AS ADOPTED BY ORDINANCE 5813. WHERE DISCREPANCIES EXIST BETWEEN THESE PLANS AND THE DESIGN AND CONSTRUCTION MANUAL, THE MORE STRINGENT SHALL PREVAIL.

THERE ARE NO GAS/OIL WELLS PER MDNR DATABASE OF OIL AND GAS PERMITS.

AS-BUILTS
9-20-22 SDM



SAMUEL D. MALINOWSKY
PROFESSIONAL ENGINEER

INDEX OF SHEETS

- C-1 COVER SHEET
- C-2 EXISTING CONDITIONS
- C-3 GENERAL NOTES & TABLE OF SERVICE LOCATIONS
- C-4 OVERALL SITE PLAN
- C-5 GRADING PLAN
- C-6 SANITARY LINE A PLAN AND PROFILE
- C-7 DETAILS
- C-8 DETAILS

RECORD DRAWING

The information provided on this drawing conforms to construction records; it is not intended for construction, implementation or recording purposes; and is solely based on information provided by others.

"~~100.00~~ 100.10", "~~1.00%~~ 1.15% slope", "8-inch HDPE PVC pipe" or text that is blue in color are all typical examples of revisions that indicate that design data has been replaced with "as-built" information. All other data is as designed and has not been field verified.

Date: 9-20-22
Certified by: Samuel D. Malinowsky
Title: Owner
Firm: SM Engineering

DEVELOPER

SWP III, LLC
C/O DRAKE DEVELOPMENT, LLC
7200 W 132nd ST, SUITE 150
OVERLAND PARK, KS 66213
913-662-2630

ENGINEER

SM ENGINEERING
SAM MALINOWSKY
5507 HIGH MEADOW CIRCLE
MANHATTAN KANSAS, 66503
SMCIVILENGR@GMAIL.COM
785.341.9747


SM Engineering
5507 High Meadow Circle
Manhattan Kansas, 66503
smcivilengr@gmail.com
785.341.9747

Drawings and/or Specifications are original proprietary work and property of the Engineer and intended specifically for this project. Use of items contained herein without consent of the Engineer is prohibited. Drawings illustrate best information available to the Engineer. Field verification of actual elements, conditions, and dimensions is required.

Revisions
8-19-21 CITY COMMENTS
9-13-21 CITY COMMENTS
10-21-21 ADDED STUB
1-6-22 STUB TABLE
9-20-22 AS-BUILTS

STREETS OF W. PRYOR
LOT 7A & 7B
LEE'S SUMMIT, MO.

s h e e t
C1.0
Civil
Site Improvement Plan
permit
16 JULY 2021

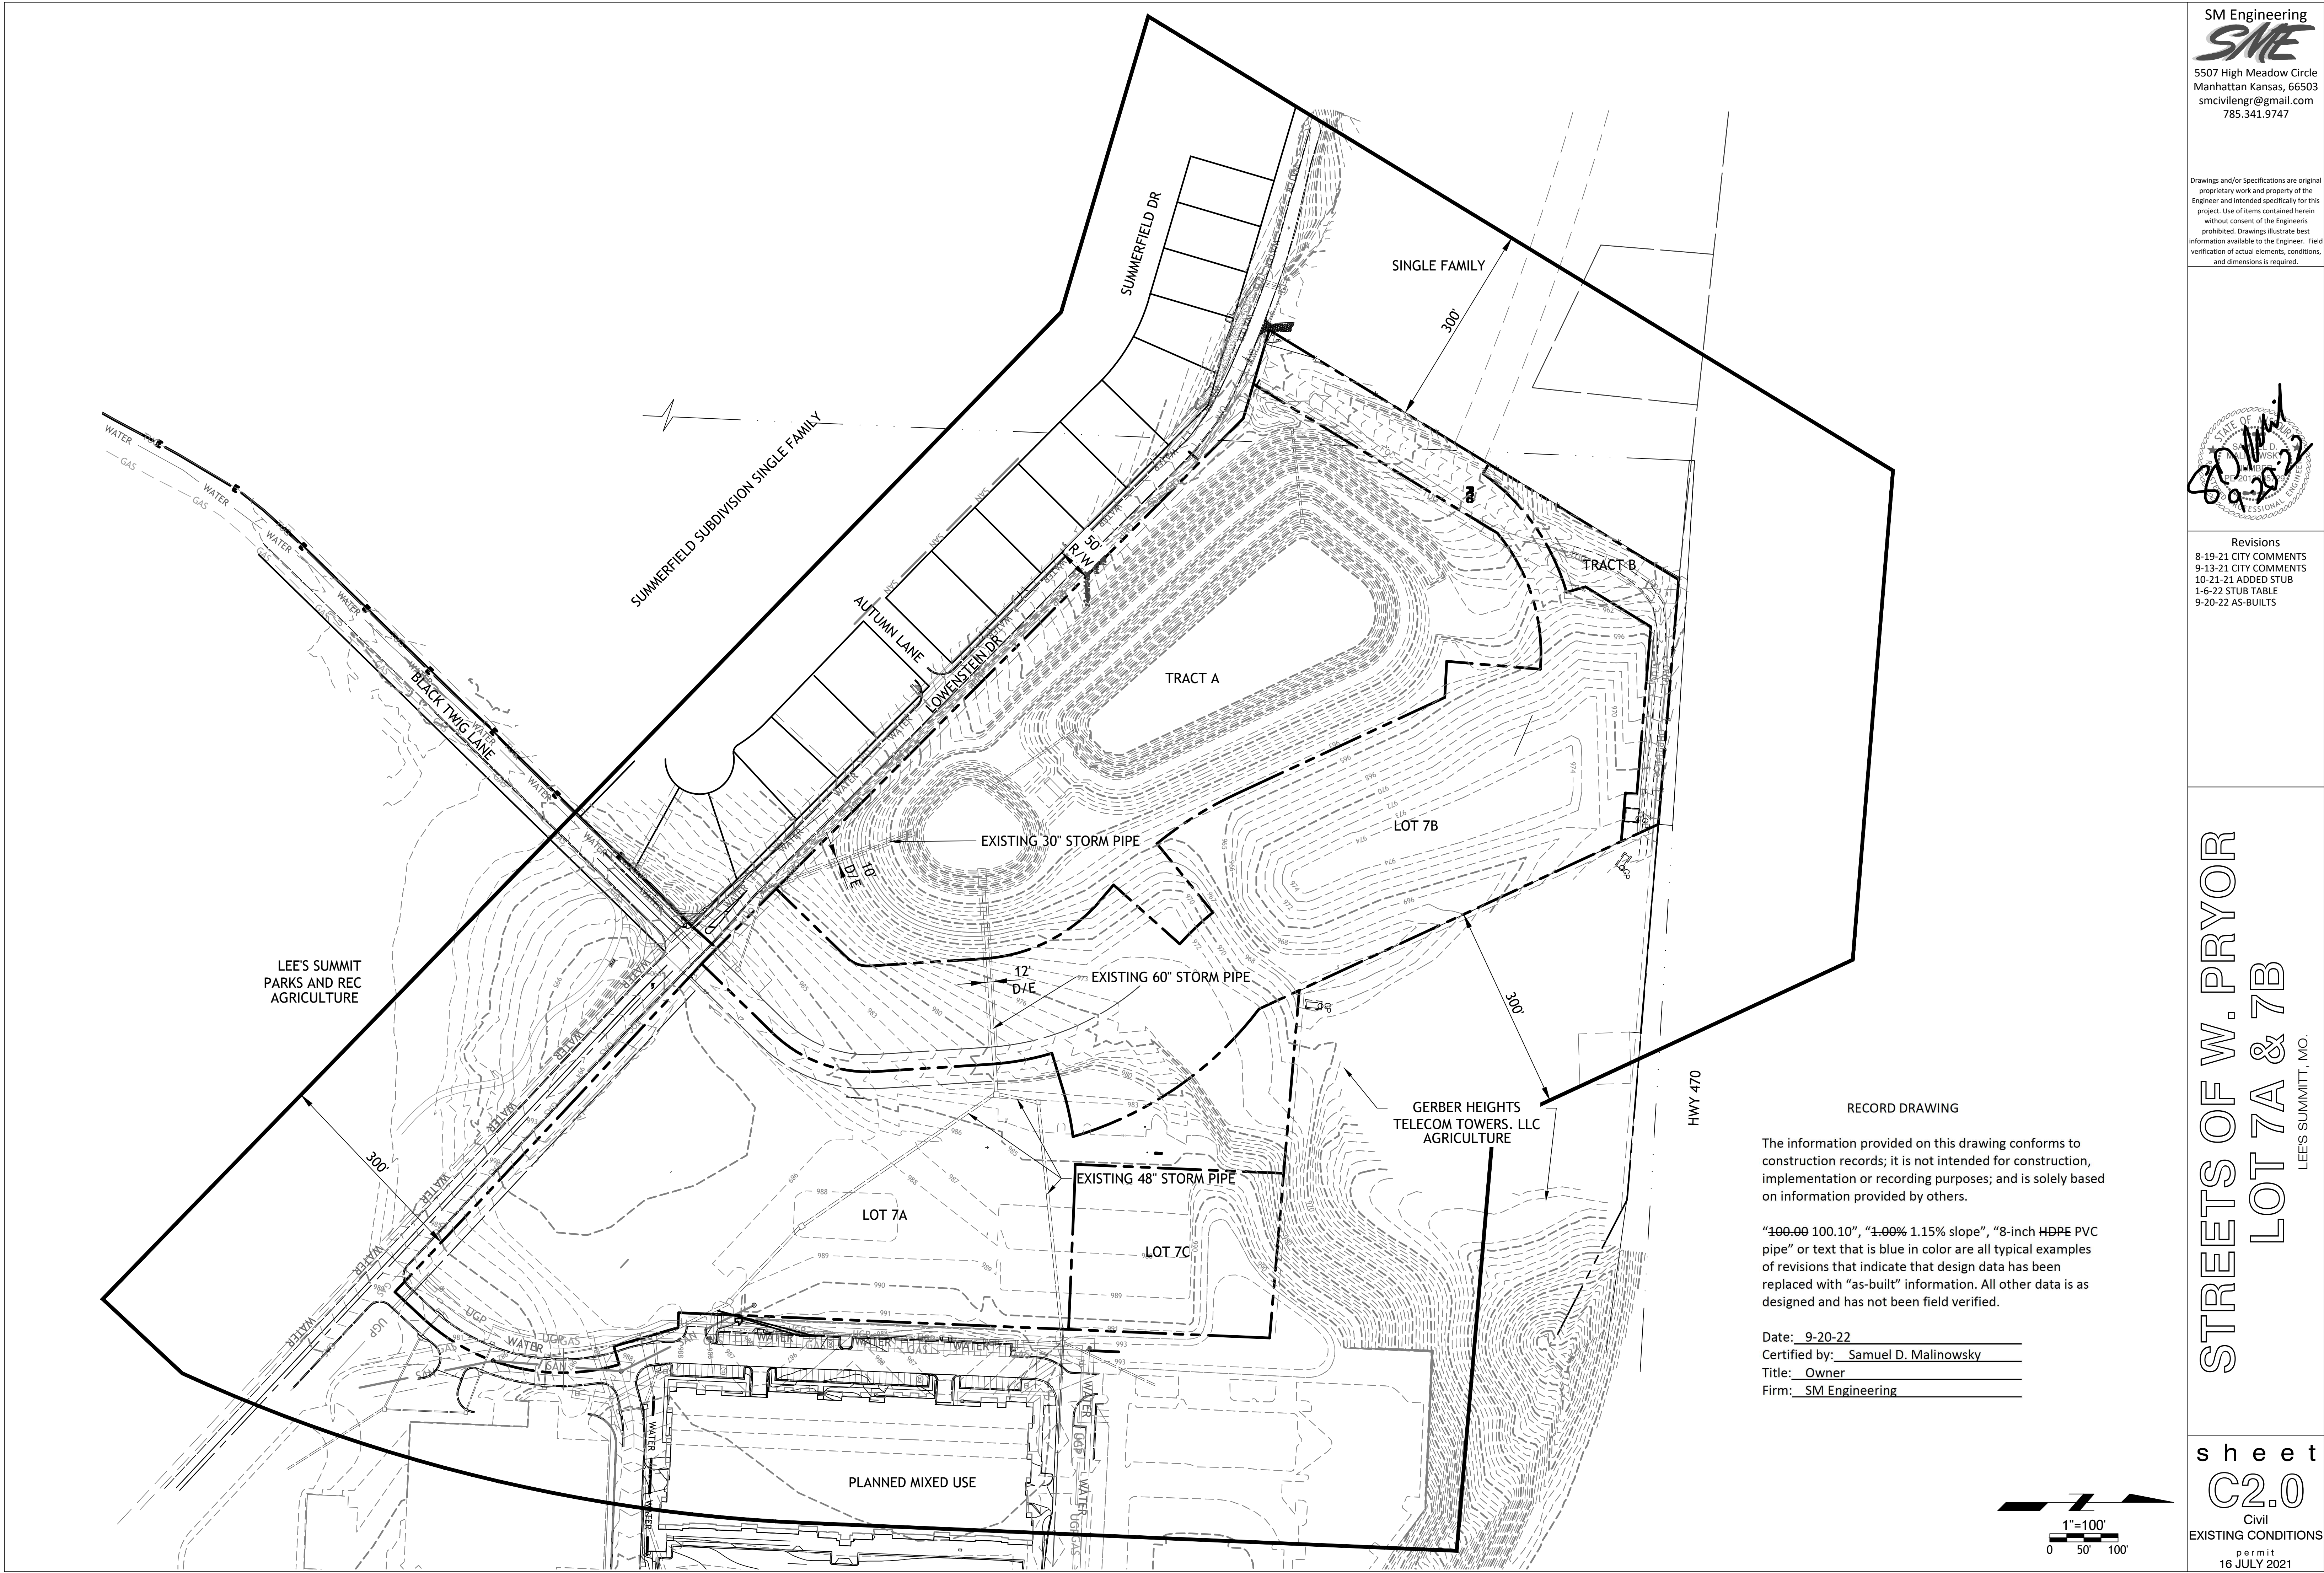

SM Engineering
SME
5507 High Meadow Circle
Manhattan Kansas, 66503
smcivilengr@gmail.com
785.341.9747

Drawings and/or Specifications are original proprietary work and property of the Engineer and intended specifically for the project. Use of items contained herein without consent of the Engineer's prohibited. Drawings illustrate best information available to the Engineer. Field verification of actual elements, conditions, and dimensions is required.

Revisions
8-19-21 CITY COMMENTS
9-13-21 CITY COMMENTS
10-21-21 ADDED STUB
1-6-22 STUB TABLE
9-20-22 AS-BUILTS

STREETS OF W. PRYOR
LOT 7A & 7B
LEES SUMMITT, MO.

RECORD DRAWING

The information provided on this drawing conforms to construction records; it is not intended for construction, implementation or recording purposes; and is solely based on information provided by others.

"100.00 100.10", "1.00% 1.15% slope", "8-inch HDPE PVC pipe" or text that is blue in color are all typical examples of revisions that indicate that design data has been replaced with "as-built" information. All other data is as designed and has not been field verified.

Date: 9-20-22
Certified by: Samuel D. Malinowsky
Title: Owner
Firm: SM Engineering

sheet
C2.0
Civil
EXISTING CONDITIONS
permit
16 JULY 2021

SANITARY SEWERS

1. ALL EXISTING UTILITIES INDICATED ON THE DRAWINGS ARE ACCORDING TO THE BEST INFORMATION AVAILABLE TO THE ENGINEER; HOWEVER, ALL UTILITIES ACTUALLY EXISTING MAY NOT BE SHOWN. UTILITIES DAMAGED THROUGH THE NEGLIGENCE OF THE CONTRACTOR TO OBTAIN THE LOCATION OF SAME SHALL BE REPAIRED OR REPLACED IMMEDIATELY BY THE CONTRACTOR AT THEIR EXPENSE.
2. RELOCATION OF ANY WATER LINE, SEWER LINE OR SERVICE LINE THEREOF REQUIRED FOR THE CONSTRUCTION OF THIS PROJECT SHALL BE THE RESPONSIBILITY OF THE CONTRACTOR AND SHALL BE AT THEIR EXPENSE.
3. ALL ROADS TO BE KEPT FREE FROM CONSTRUCTION DEBRIS AND SEDIMENT
4. THE CONTRACTOR SHALL TAKE CARE IN PROTECTING EXISTING TREES AND SHRUBS
5. OUTSIDE OF THE PROPOSED CONSTRUCTION. CARE SHALL BE TAKEN NOT TO DISTURB
6. LAWNS OR EXISTING STRUCTURES OUTSIDE OF THE CONSTRUCTION LIMITS.
7. CONTRACTOR SHALL SEED ALL DISTURBED AREAS
8. PIPE LENGTHS ARE CENTER TO CENTER OF STRUCTURE OR TO END OF PIPE.

EROSION CONTROL NOTES

1. PROTECT ALL STORM INLETS AND DRAINAGE CONVEYANCE FROM CONSTRUCTION DEBRIS AND SEDIMENT
2. DO NOT WASH CONCRETE TRUCKS INTO THE STORM SYSTEM.
3. DO NOT ALLOW SEDIMENT TO LEAVE CONSTRUCTION SITE.
4. KEEP ALL ROADS FREE FROM CONSTRUCTION DEBRIS AND SEDIMENT.

| TABLE OF SERVICE LOCATIONS | | | | | | |
|----------------------------|-----------------|----------|-------------------------|----------------|--------------|--------------------------|
| LINE A | | | | | | |
| STUB | CONNECTION TYPE | STATION | DIST. FROM D.S. M.H. | STUB LENGTH | FLOW AT MAIN | END OF STUB ELEVATION |
| 1 | "Y" | 6+73.33 | 19' | 57 | 958.14 | 959.28 |
| | | | | | | |
| 2 | "Y" | 6+89.41 | 35' | 10' | 960.02 | 960.22 |
| | | | | | | |
| 3 | Y" | 8+05.90 | 70' | 50' | 969.31 | 970.31 |
| | | | | | | |
| 4 | "Y" | 8+55.90 | 120' | 15' | 971.90 | 972.20 |
| | | | | | | |
| 5 | "Y" | 10+10.09 | 88' | 22 | 976.70 | 978.46 |
| | | | | | | |
| 6 | "Y" | 10+75.27 | 153' | 44 | 977.35 | 978.23 |
| | | | | | | |
| 7 | MH CONNECTION | 11+70.38 | 0' | 10' | 978.30 | 978.50 |
| | | | | | | |

ALL SERVICE STUB CONNECTION ARE 6"

RECORD DRAWING

The information provided on this drawing conforms to construction records; it is not intended for construction, implementation or recording purposes; and is solely based on information provided by others.

~~"100.00~~ 100.10", ~~"1.00%~~ 1.15% slope", "8-inch HDPE PVC pipe" or text that is blue in color are all typical examples of revisions that indicate that design data has been replaced with "as-built" information. All other data is as designed and has not been field verified.

Date: 9-20-22
Certified by: Samuel D. Malinowsky
Title: Owner
Firm: SM Engineering


Drawings and/or Specifications are original proprietary work and property of the Engineer and intended specifically for this project. Use of items contained herein without consent of the Engineer is prohibited. Drawings illustrate best information available to the Engineer. Field verification of actual elements, conditions, and dimensions is required.



Revisions
8-19-21 CITY COMMENTS
9-13-21 CITY COMMENTS
10-21-21 ADDED STUB
1-6-22 STUB TABLE
9-20-22 AS-BUILTS

STREETS OF W. PRYOR
LOT 7A & 7B
LEES SUMMITT, MO.

Drawings and/or Specifications are original proprietary work and property of the Engineer and intended specifically for this project. Use of items contained herein without consent of the Engineer is prohibited. Drawings illustrate best information available to the Engineer. Field verification of actual elements, conditions, and dimensions is required.

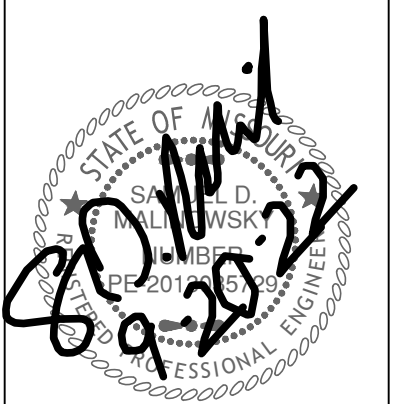

Revisions
8-19-21 CITY COMMENTS
9-13-21 CITY COMMENTS
10-21-21 ADDED STUB
1-6-22 STUB TABLE
9-20-22 AS-BUILTS

RECORD DRAWING

The information provided on this drawing conforms to construction records; it is not intended for construction, implementation or recording purposes; and is solely based on information provided by others.

"100.00 100.10", "1.00% 1.15% slope", "8-inch HDPE PVC pipe" or text that is blue in color are all typical examples of revisions that indicate that design data has been replaced with "as-built" information. All other data is as designed and has not been field verified.


Date: 9-20-22
Certified by: Samuel D. Malinowsky
Title: Owner
Firm: SM Engineering

CONSTRUCTION NOTES:


1. COORDINATE START-UP AND ALL CONSTRUCTION ACTIVITIES WITH OWNER.
2. CONSTRUCTION METHODS AND MATERIALS NOT SPECIFIED IN THESE PLANS ARE TO MEET OR EXCEED THE STANDARD SPECIFICATIONS.
3. ALL CONSTRUCTION WORK AND UTILITY WORK OUTSIDE OF PROPERTY BOUNDARIES SHALL BE PERFORMED IN COOPERATION WITH AND IN ACCORDANCE WITH REGULATIONS OF THE AUTHORITIES CONCERNED.
4. PUBLIC CONVENIENCE AND SAFETY: THE CONTRACTOR SHALL CONDUCT THE WORK IN A MANNER THAT WILL INSURE, AS FAR AS PRACTICABLE, THE LEAST OBSTRUCTION TO TRAFFIC, AND SHALL PROVIDE FOR THE CONVENIENCE AND SAFETY OF THE GENERAL PUBLIC AND RESIDENTS ALONG AND ADJACENT TO STREETS IN THE CONSTRUCTION AREA.

NOTE:

1. CONTRACTOR SHALL CONTACT THE CITY'S DEVELOPMENT SERVICES ENGINEERING INSPECTION TO SCHEDULE A PRE-CONSTRUCTION MEETING WITH A FIELD ENGINEERING INSPECTOR PRIOR TO ANY LAND DISTURBANCE WORK AT 816-969-1200

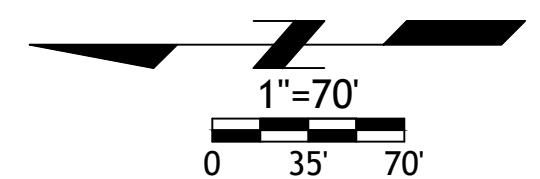

STREETS OF W. PRYOR
LOT 7A & 7B
LEES SUMMITT, MO.

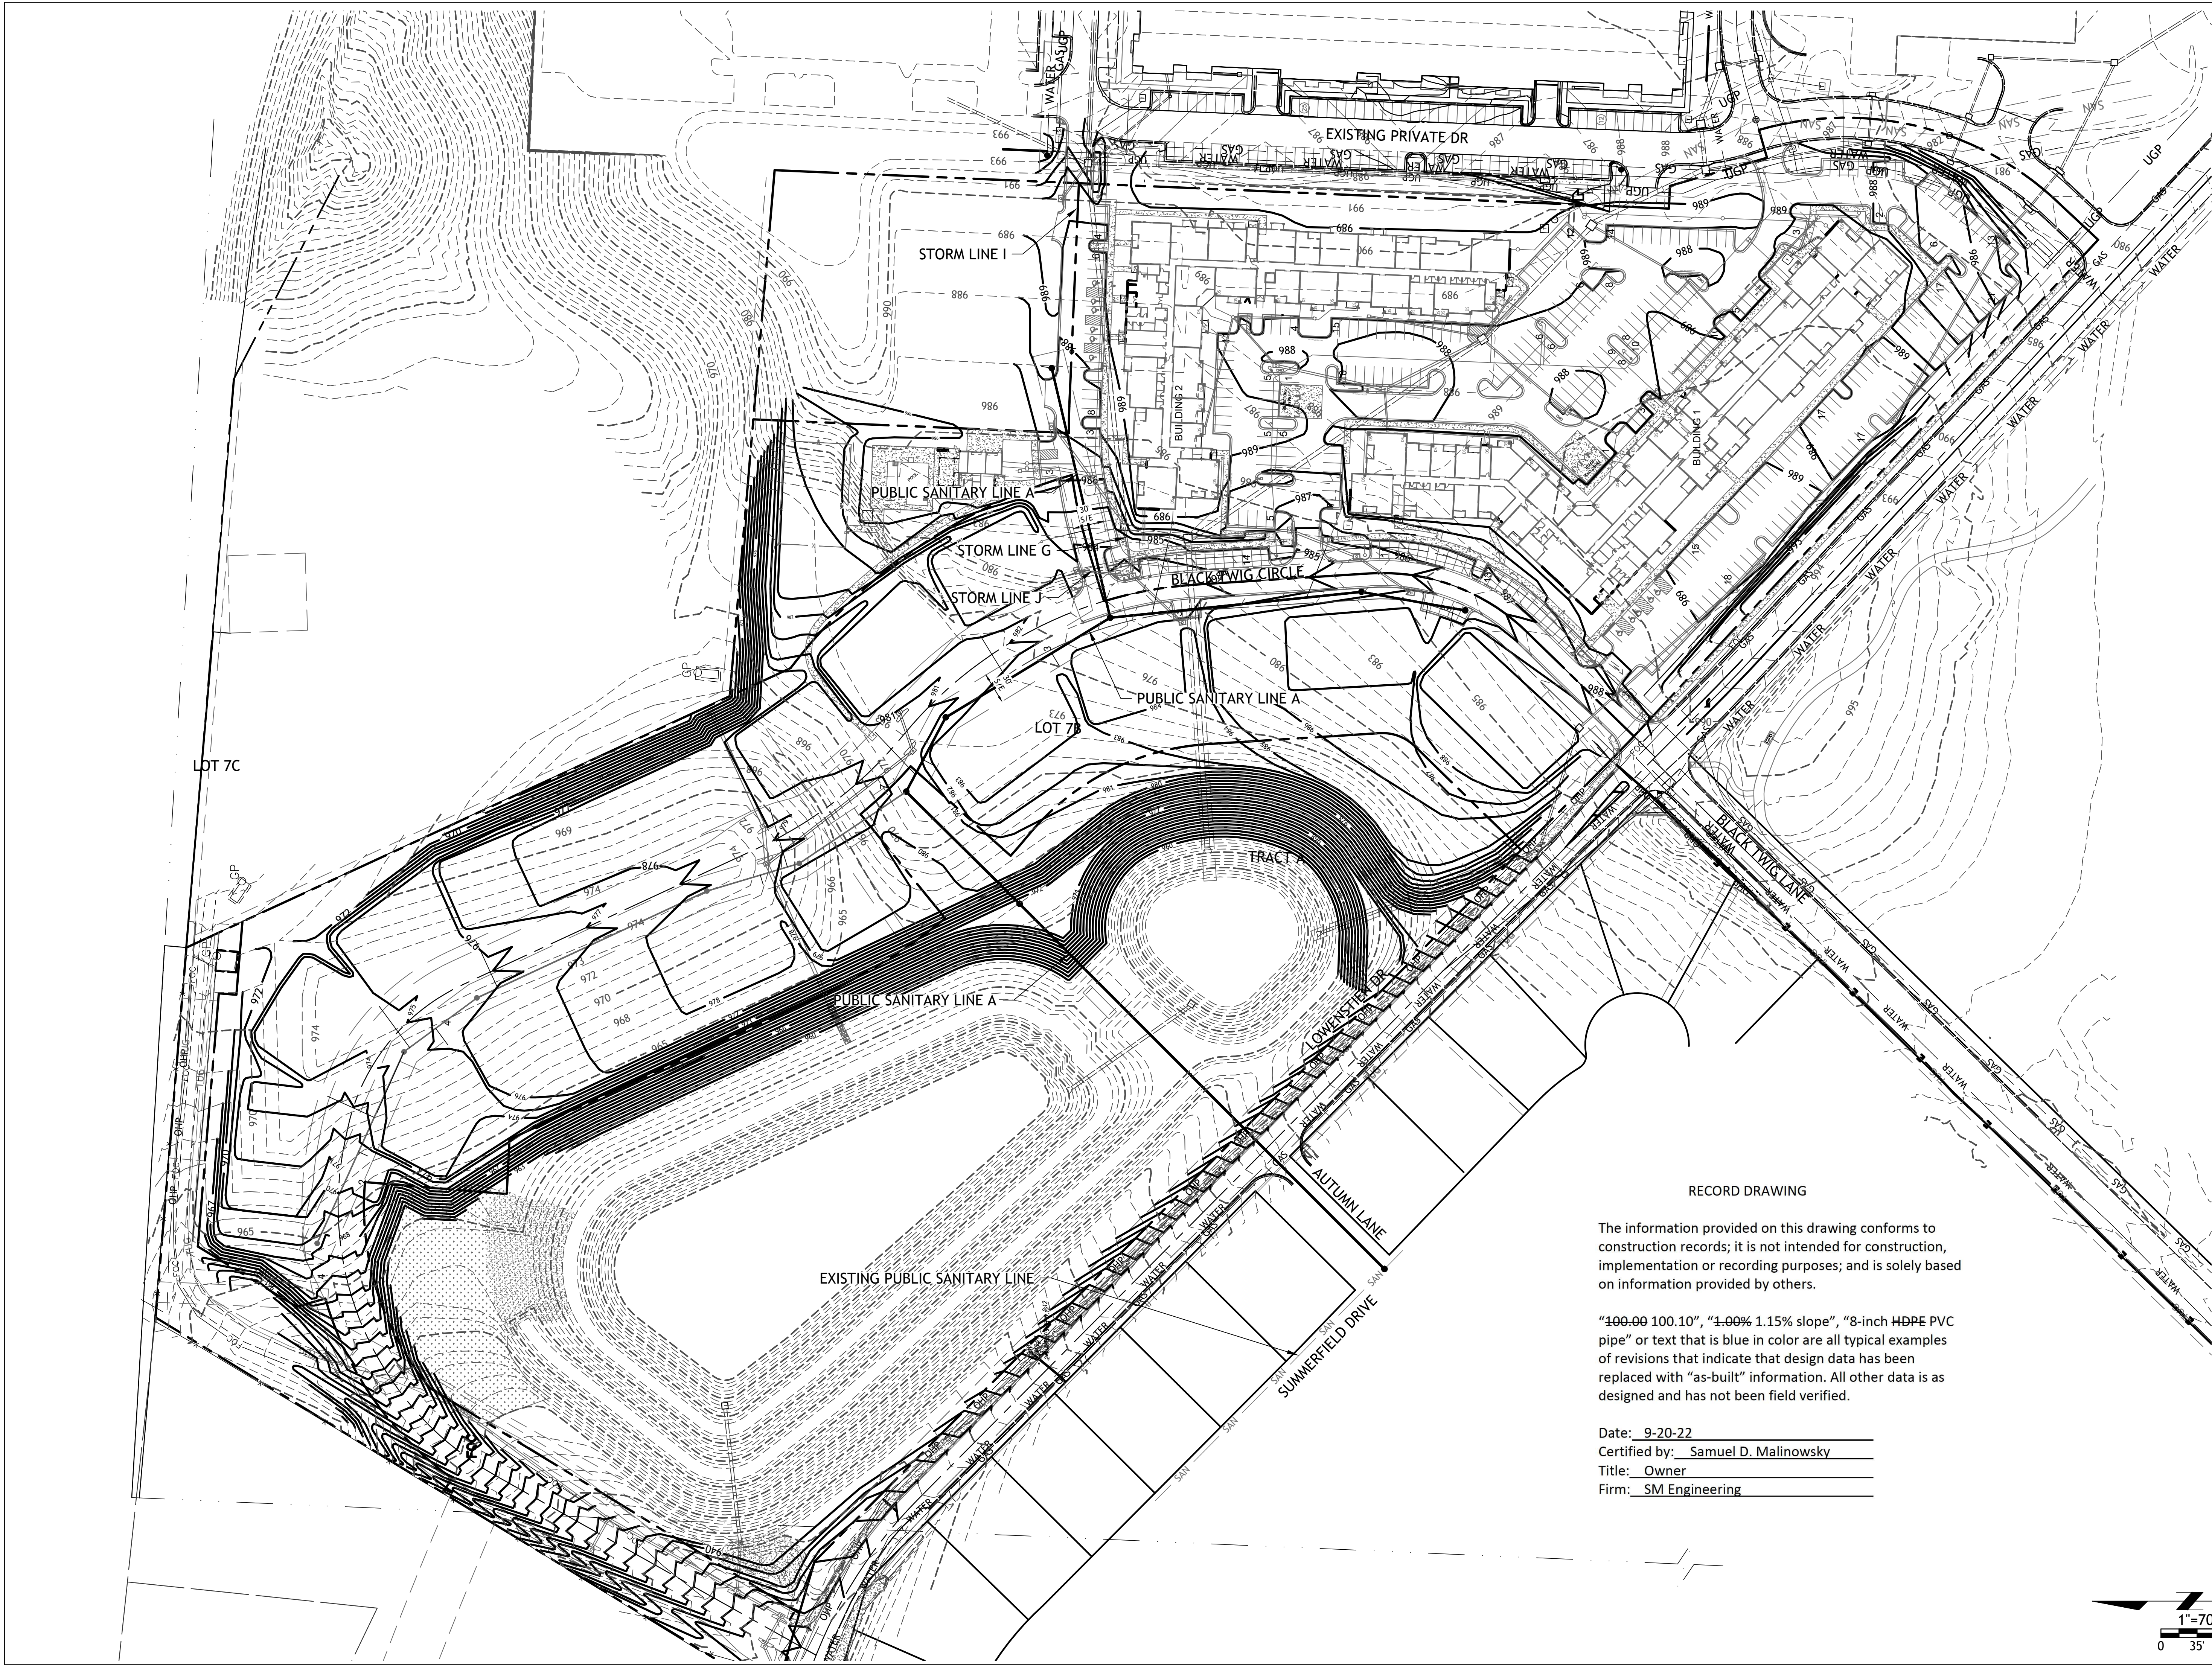


RECORD DRAWING

The information provided on this drawing conforms to construction records; it is not intended for construction, implementation or recording purposes; and is solely based on information provided by others.

“100.00 100.10”, “1.00% 1.15% slope”, “8-inch HDPE PVC pipe” or text that is blue in color are all typical examples of revisions that indicate that design data has been replaced with “as-built” information. All other data is as designed and has not been field verified.

Date: 9-20-22
Certified by: Samuel D. Malinowsky
Title: Owner
Firm: SM Engineering



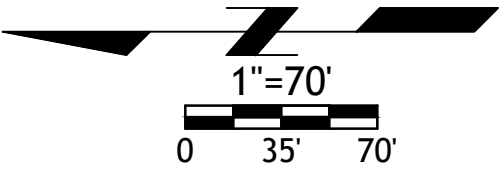


Drawings and/or Specifications are original proprietary work and property of the Engineer and intended specifically for this project. Use of items contained herein without consent of the Engineer's prohibited. Drawings illustrate best information available to the Engineer. Field verification of actual elements, conditions, and dimensions is required.



- Revisions
- 8-19-21 CITY COMMENTS
 - 9-13-21 CITY COMMENTS
 - 10-21-21 ADDED STUB
 - 1-6-22 STUB TABLE
 - 9-20-22 AS-BUILTS

STREETS OF W. PRYOR
LOT 7A & 7B
LEES SUMMITT, MO.

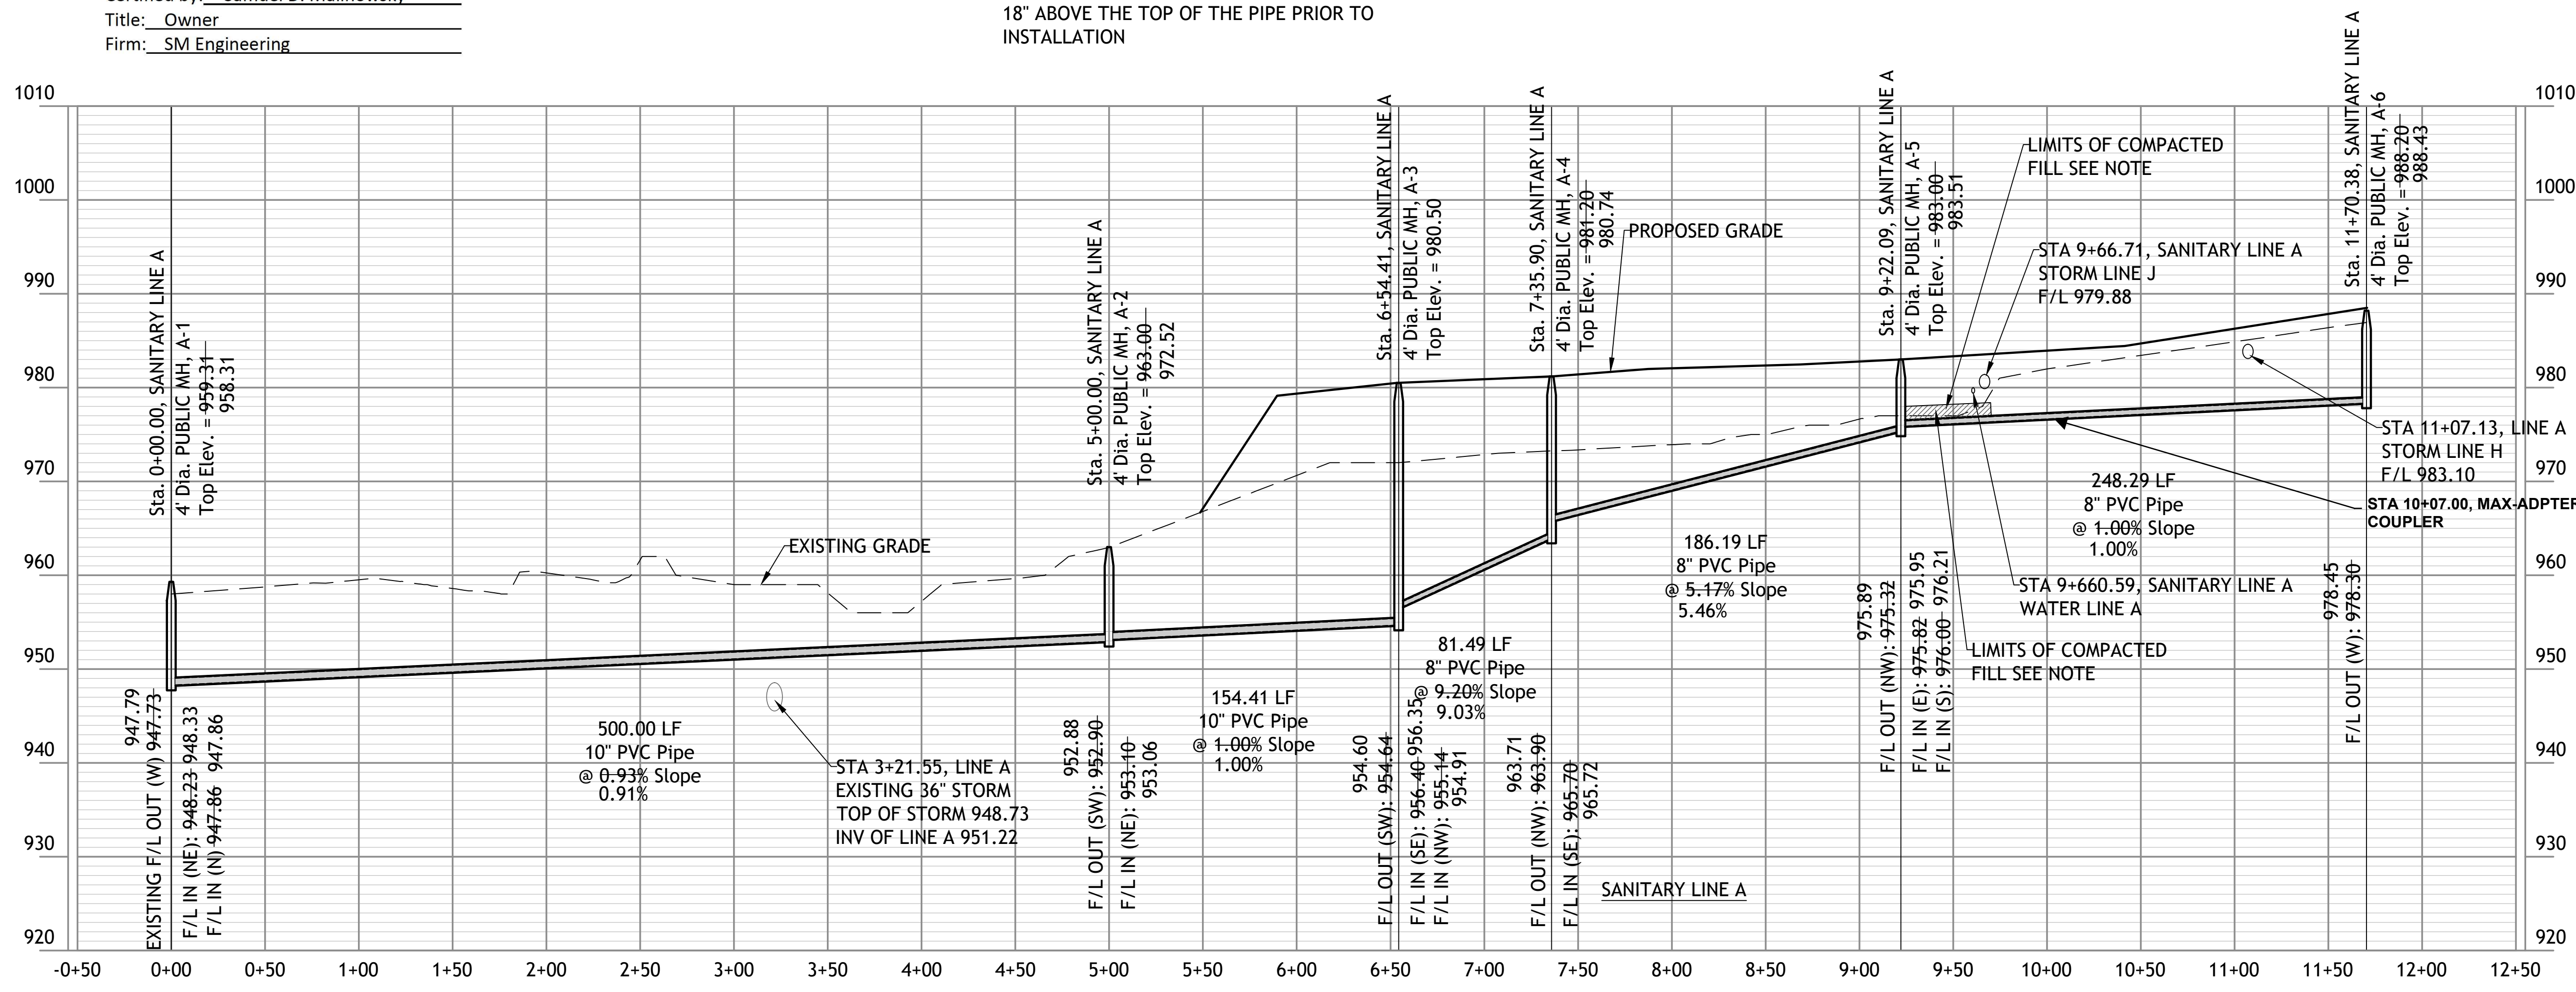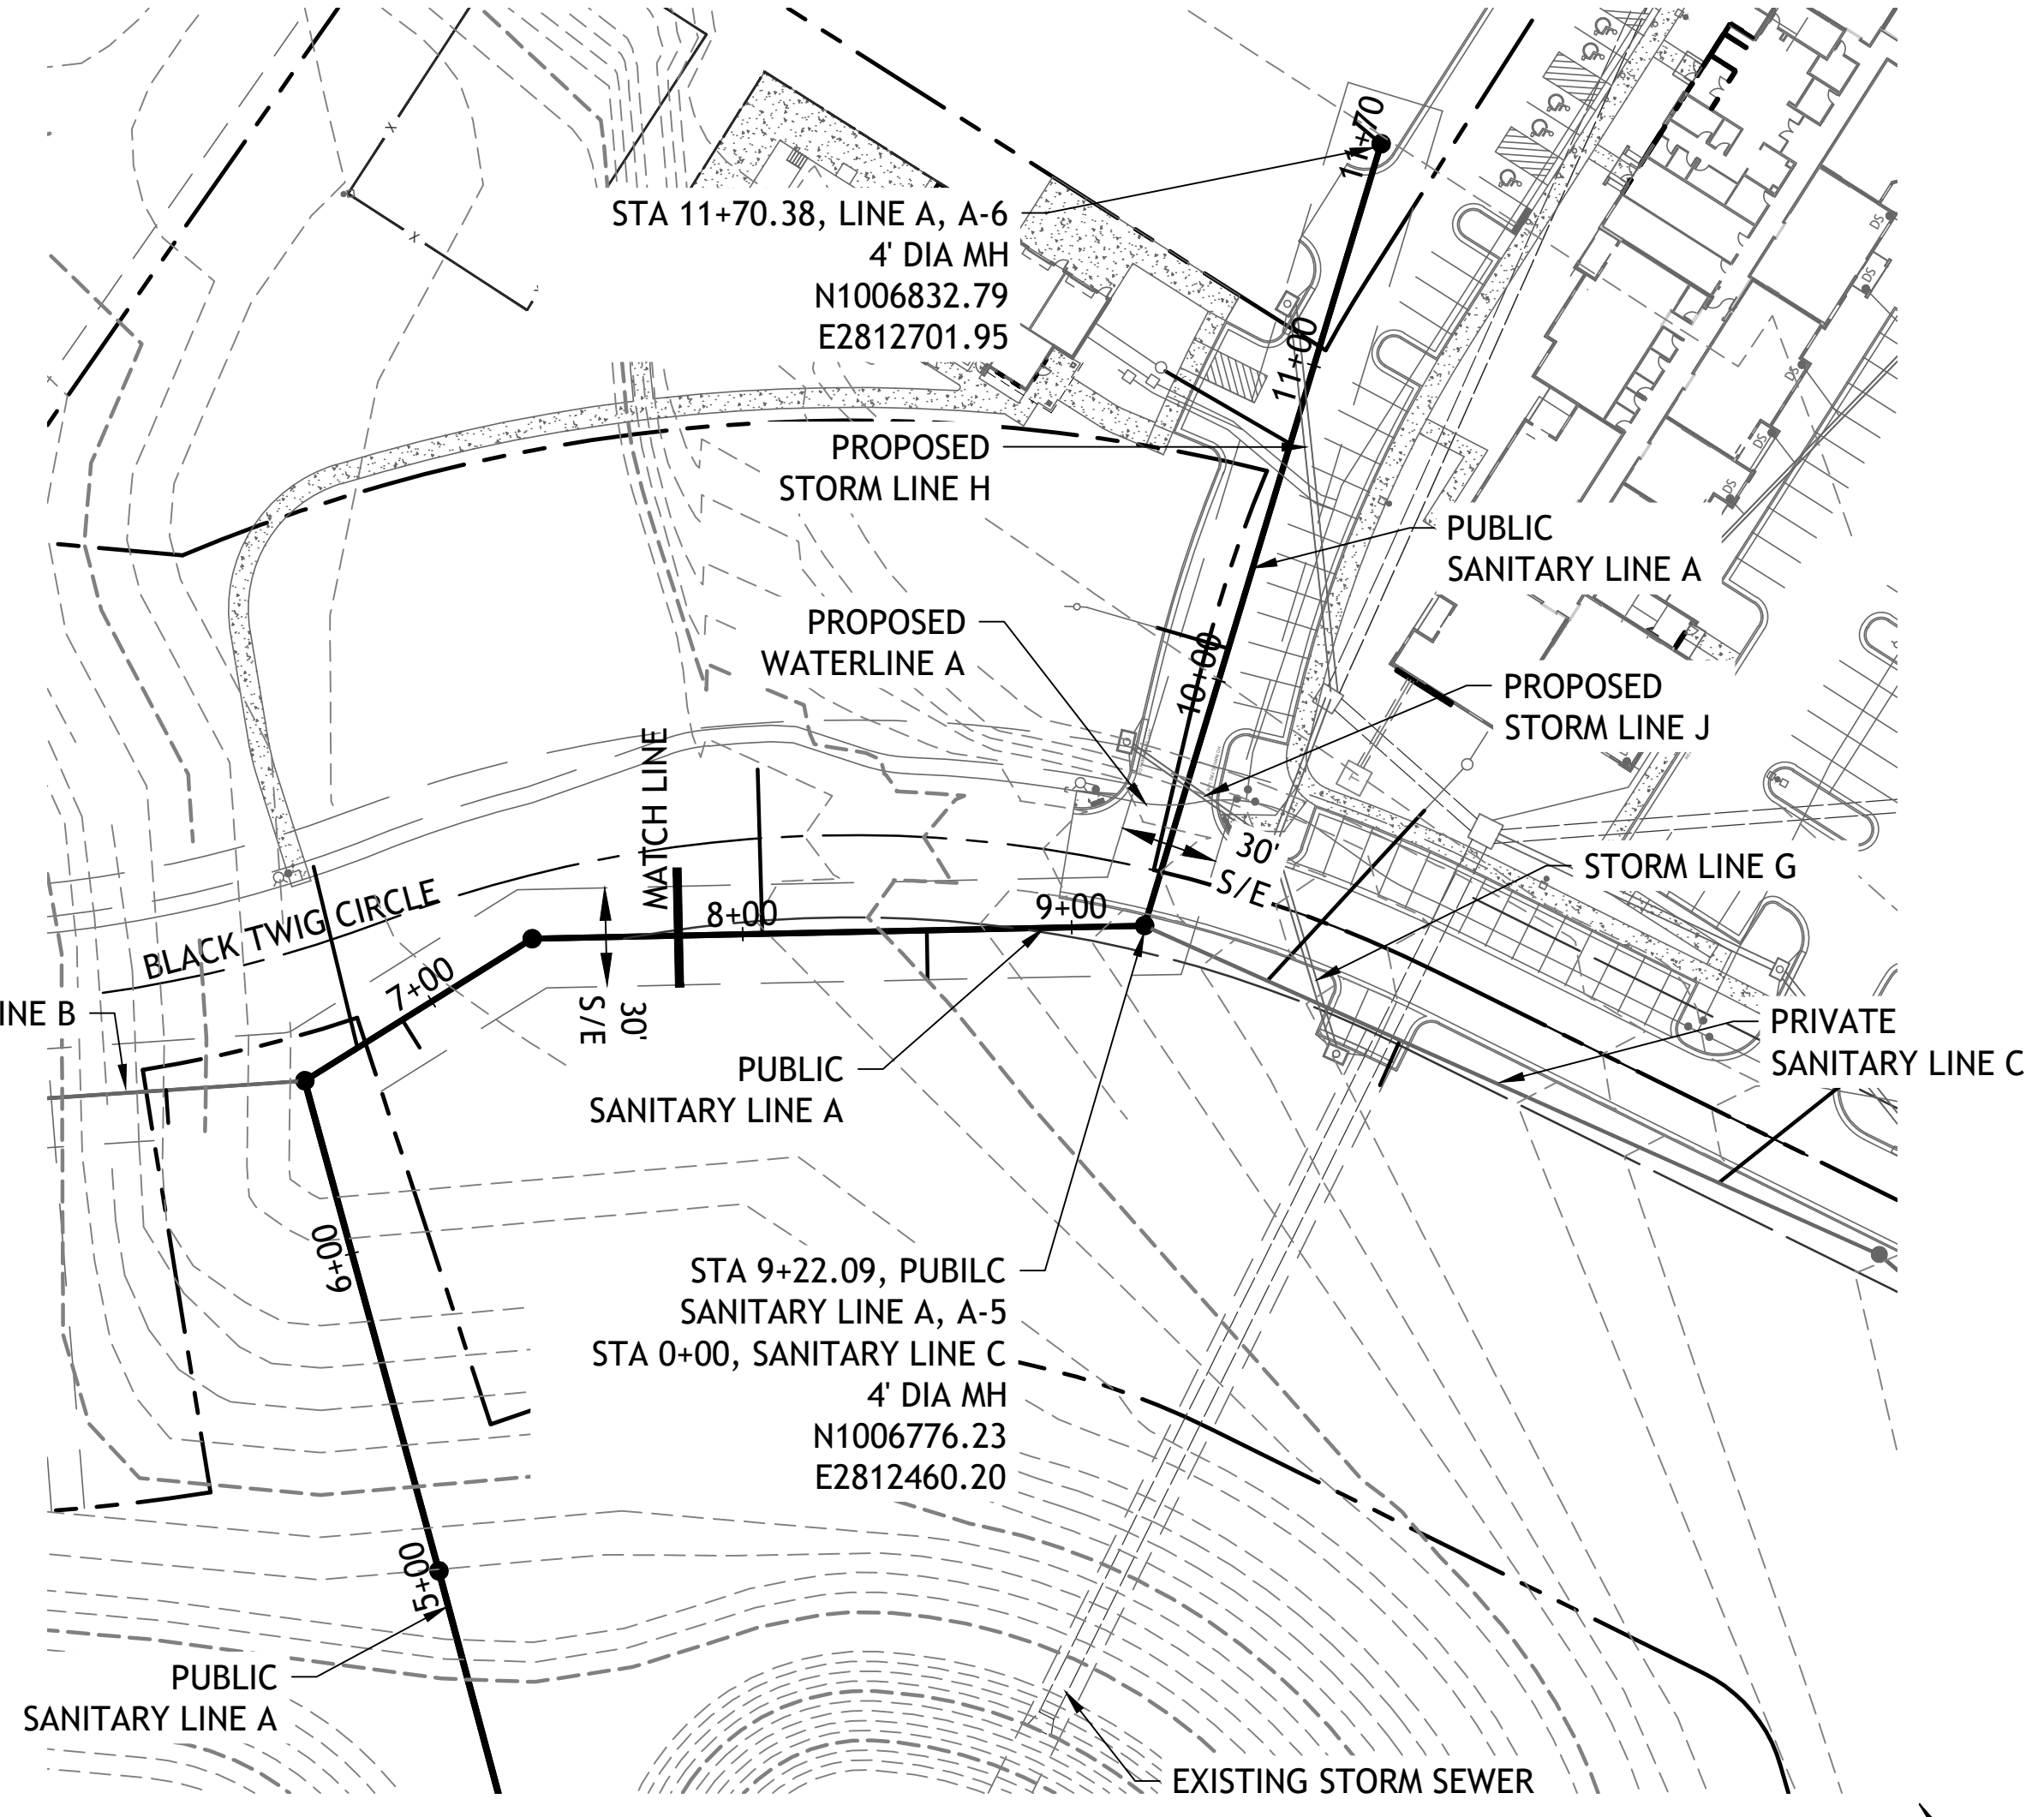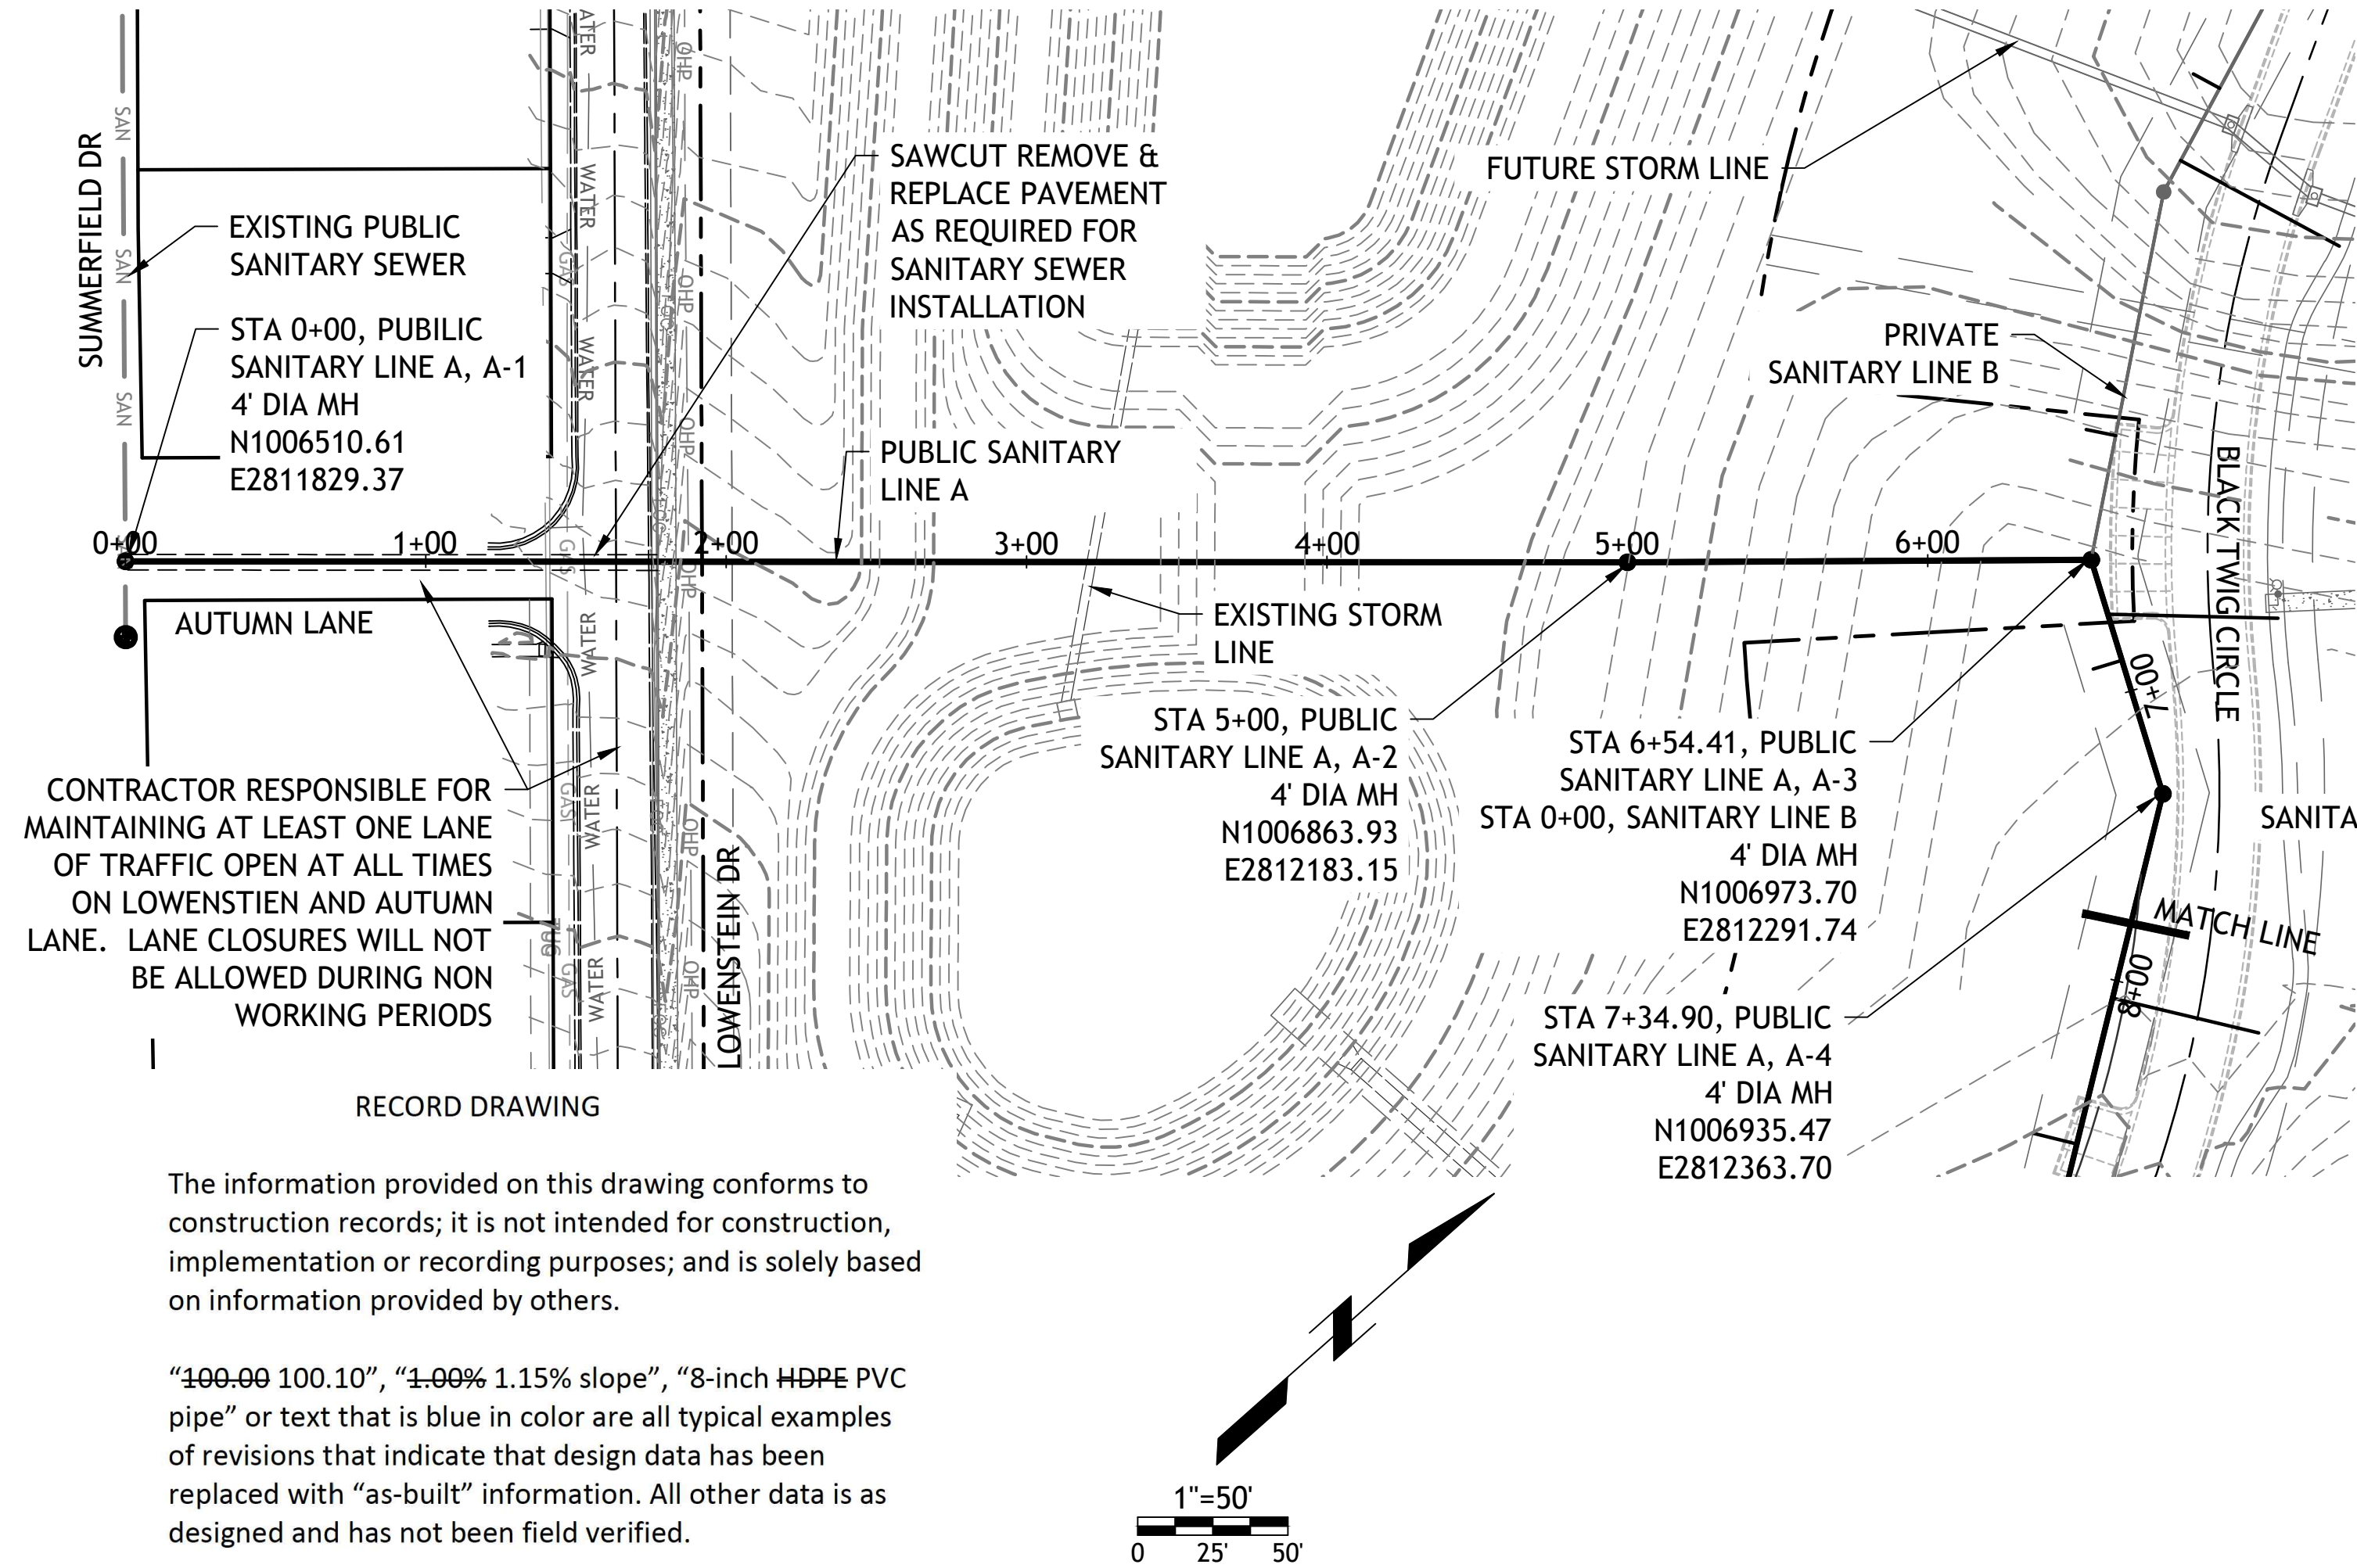

AS-BUILTS
9-20-22 SDM






SM Engineering
SM E
5507 High Meadow Circle
Manhattan Kansas, 66503
smcivilengr@gmail.com
785.341.9747

Drawings and/or Specifications are original proprietary work and property of the Engineer and intended specifically for this project. Use of items contained herein without consent of the Engineer is prohibited. Drawings illustrate best information available to the Engineer. Field verification of actual elements, conditions, and dimensions is required.

Revisions
8-19-21 CITY COMMENTS
9-13-21 CITY COMMENTS
10-21-21 ADDED STUB
1-6-22 STUB TABLE
9-20-22 AS-BUILTS

STREETS OF W. PRYOR
LOT 7A & 7B
LEES SUMMITT, MO.

sheet
C6.0
Civil
SANITARY LINE A
permit
16 JULY 2021

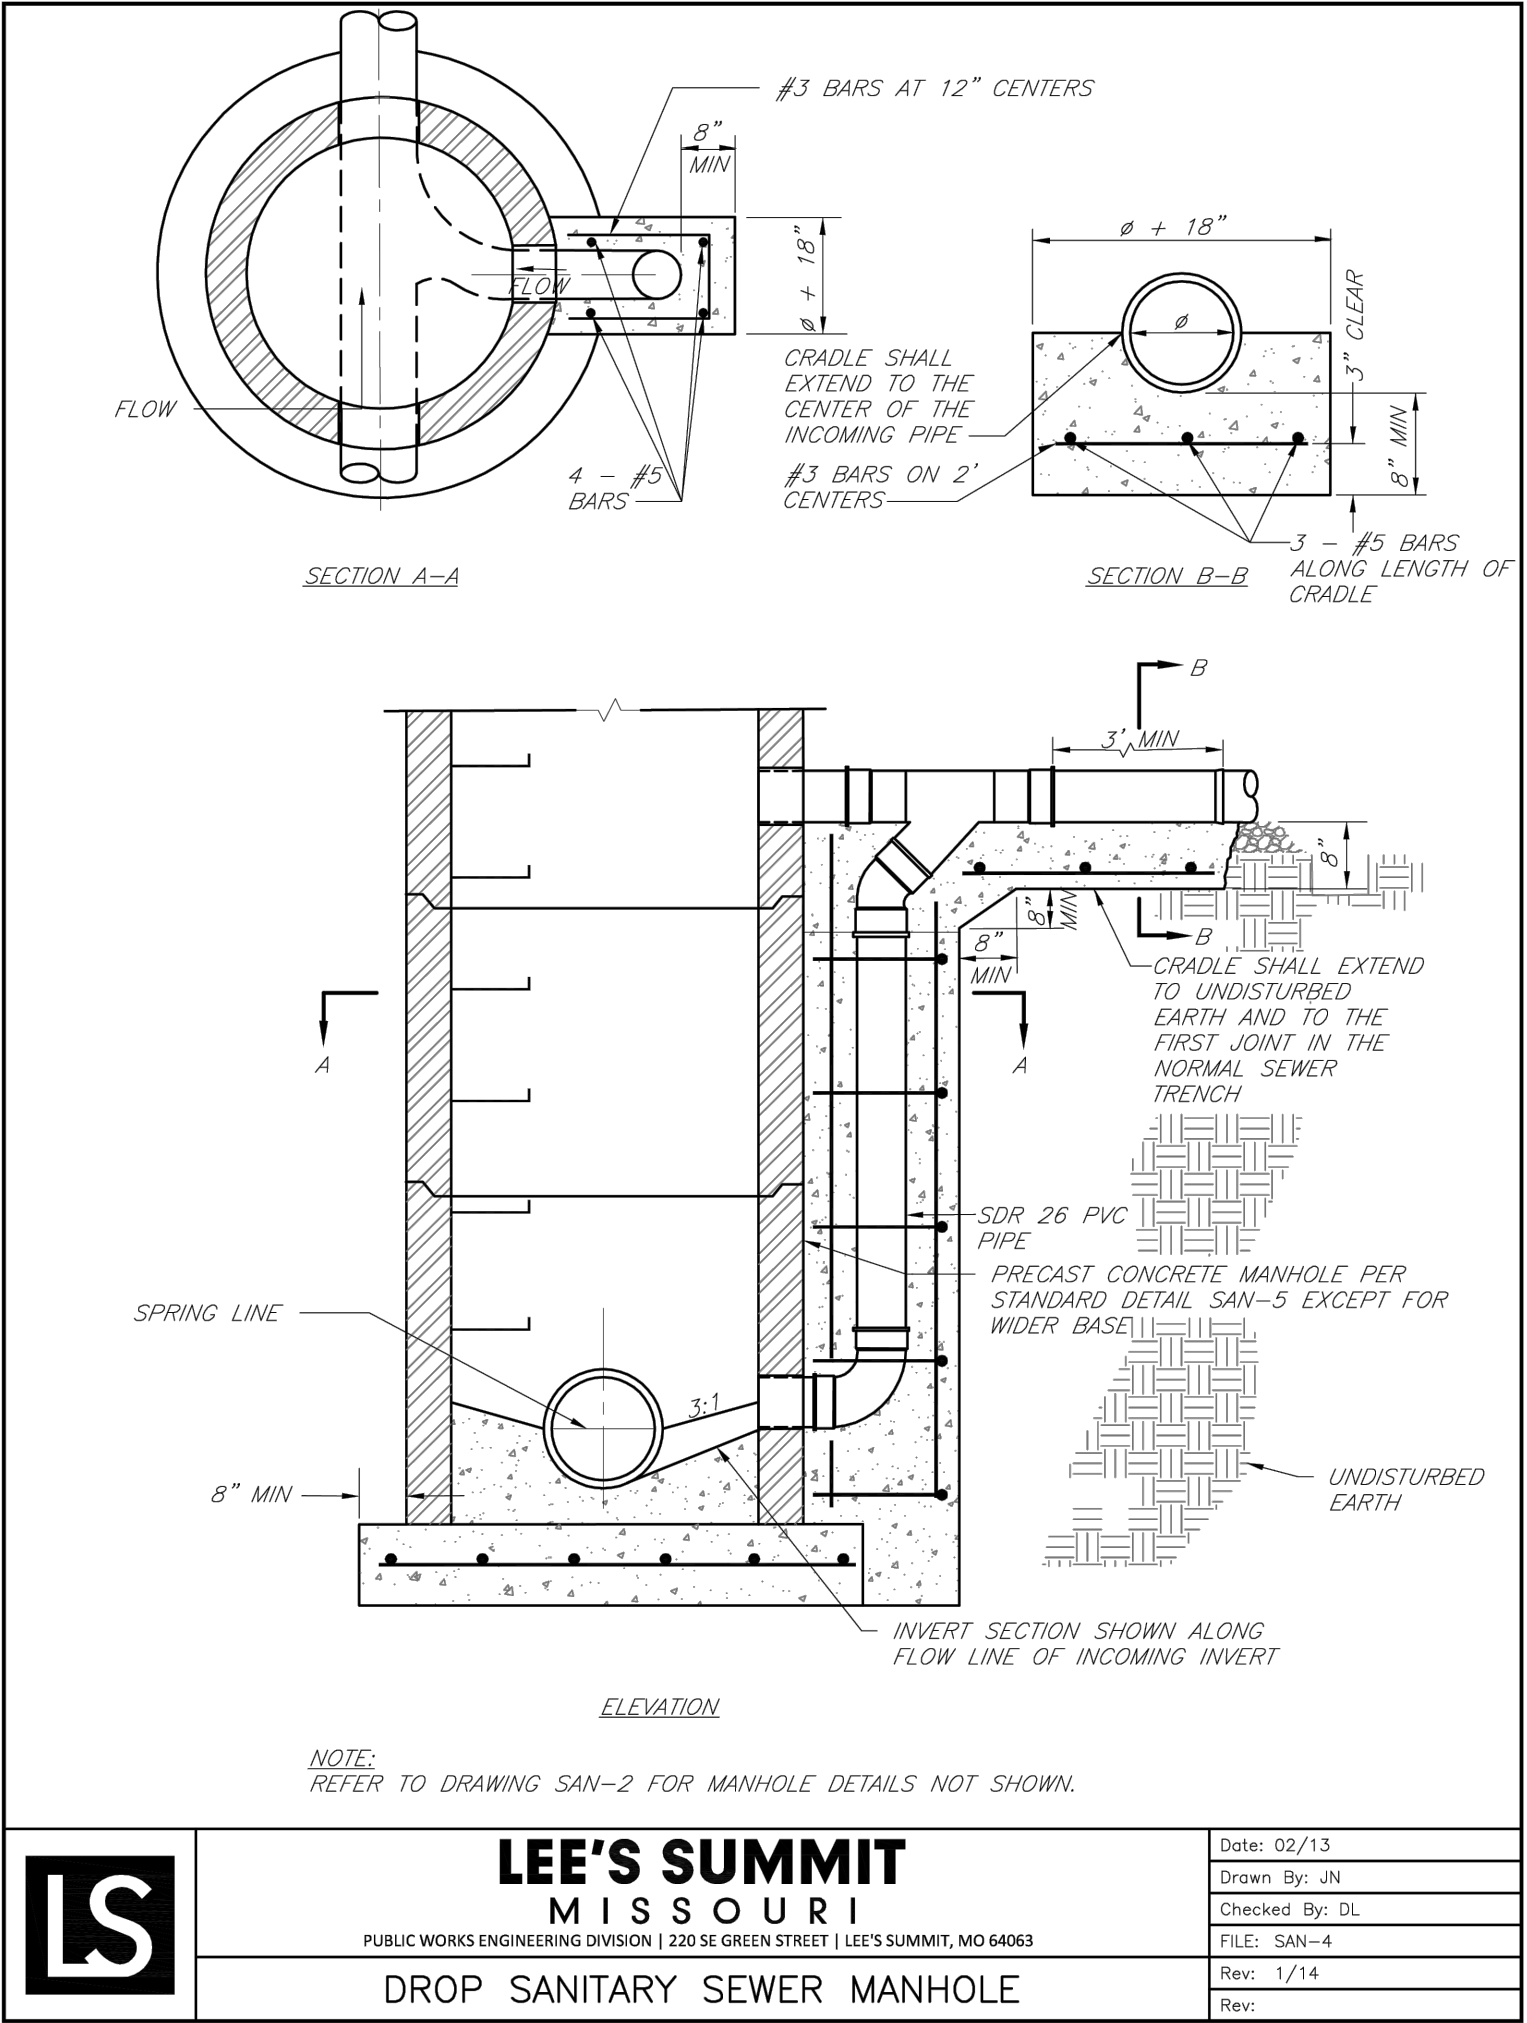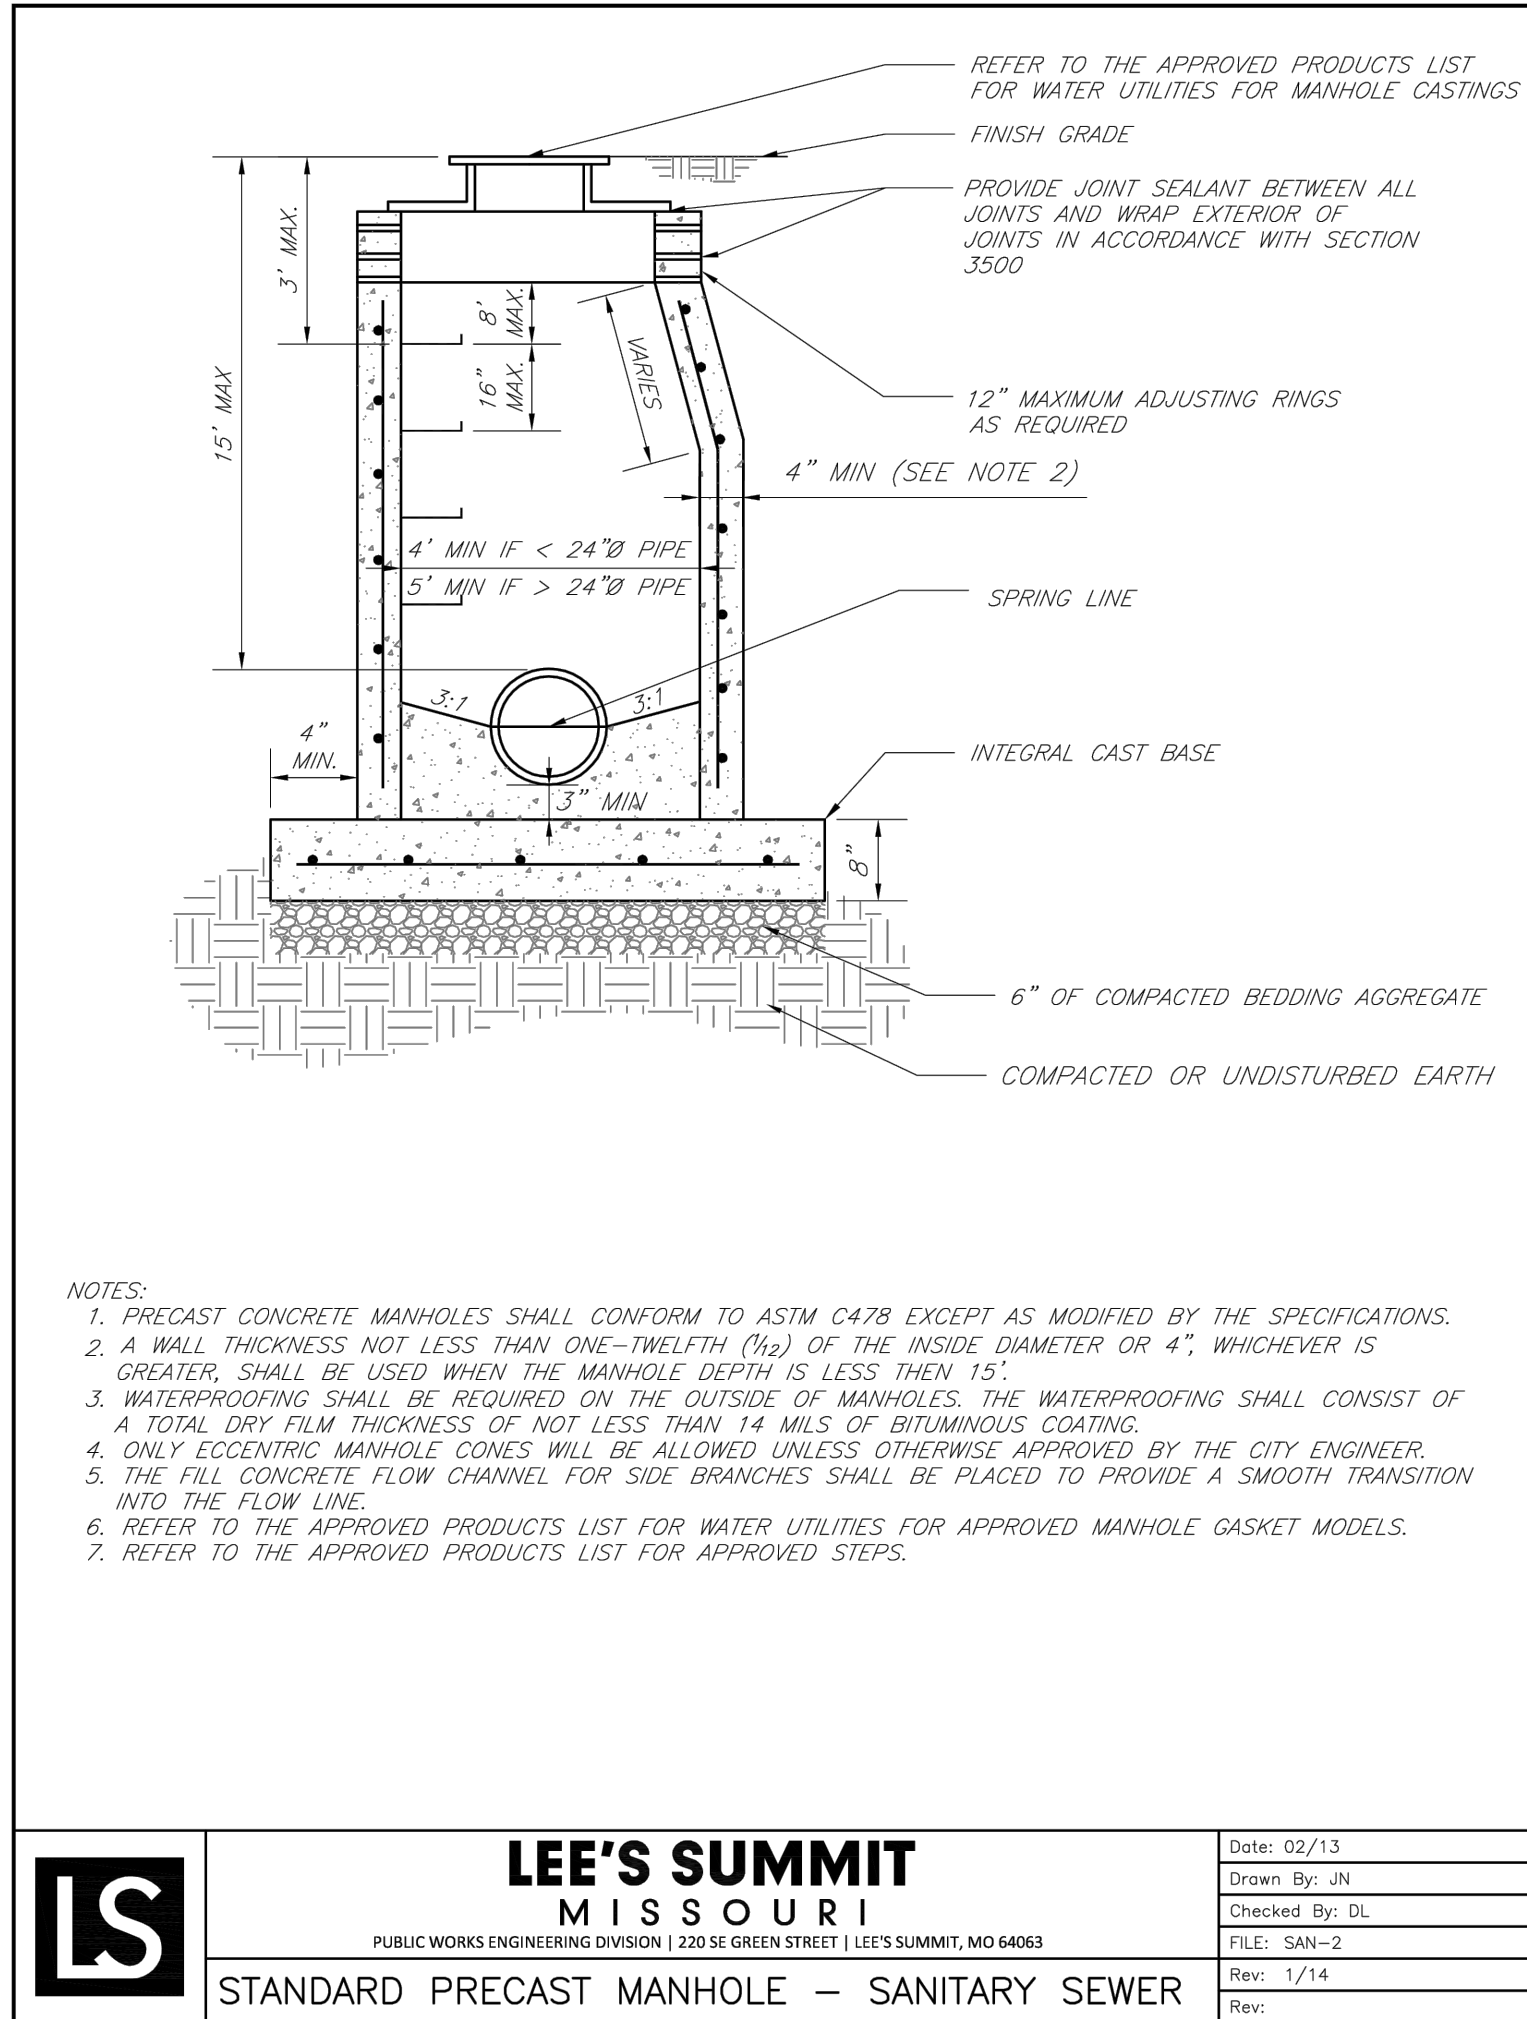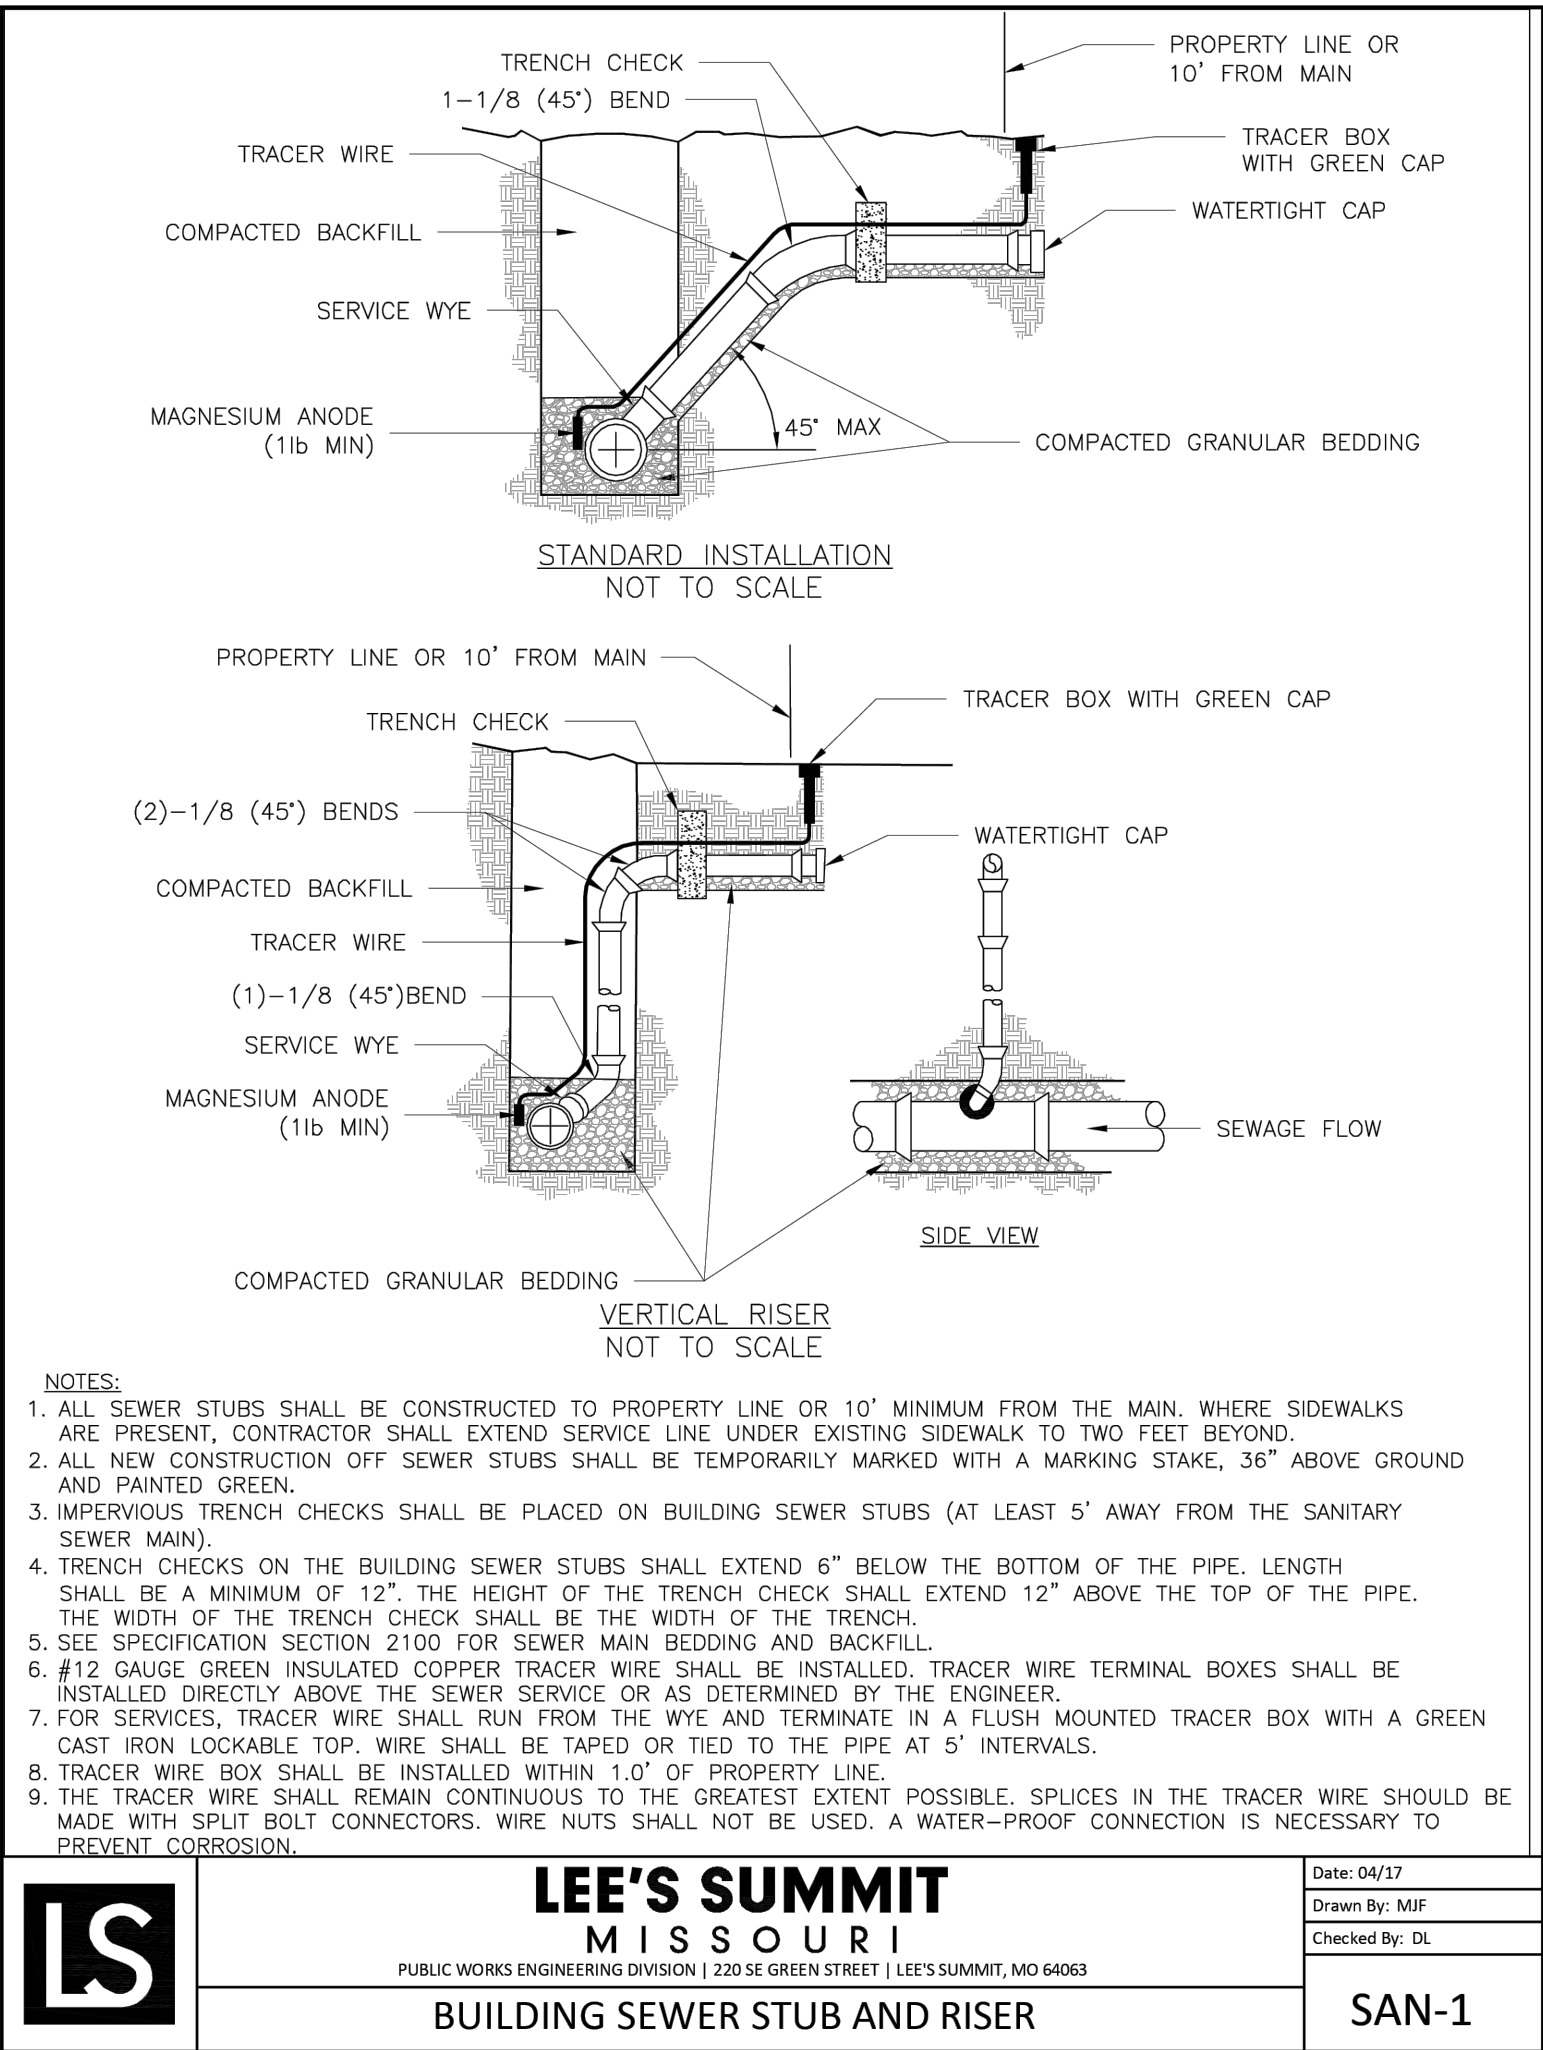
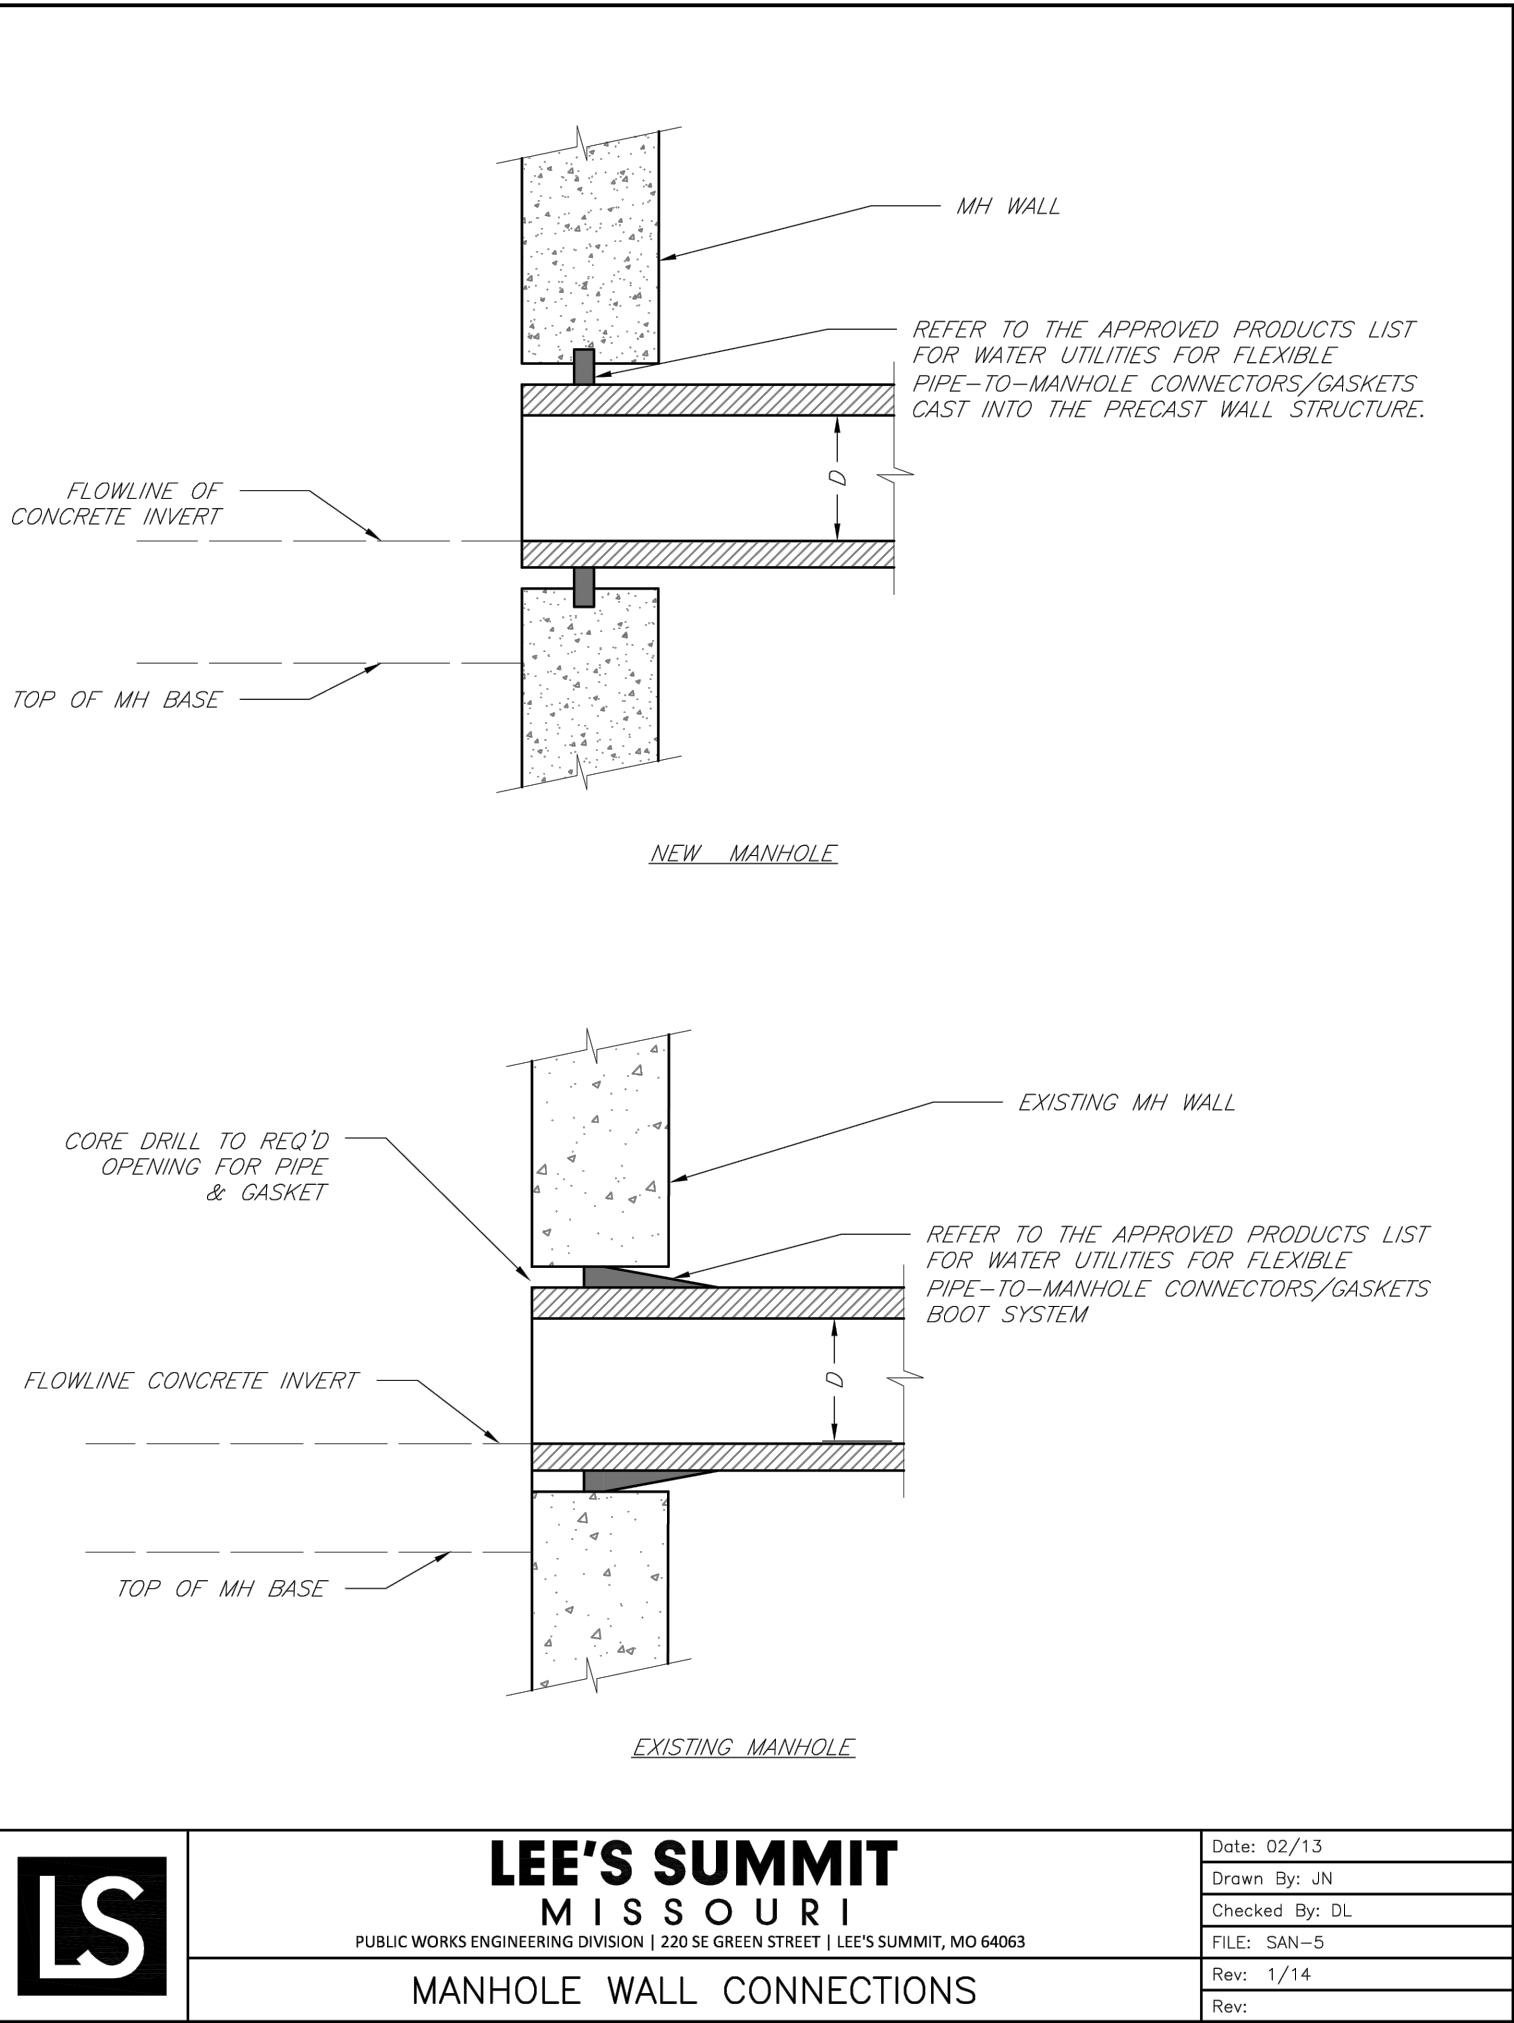
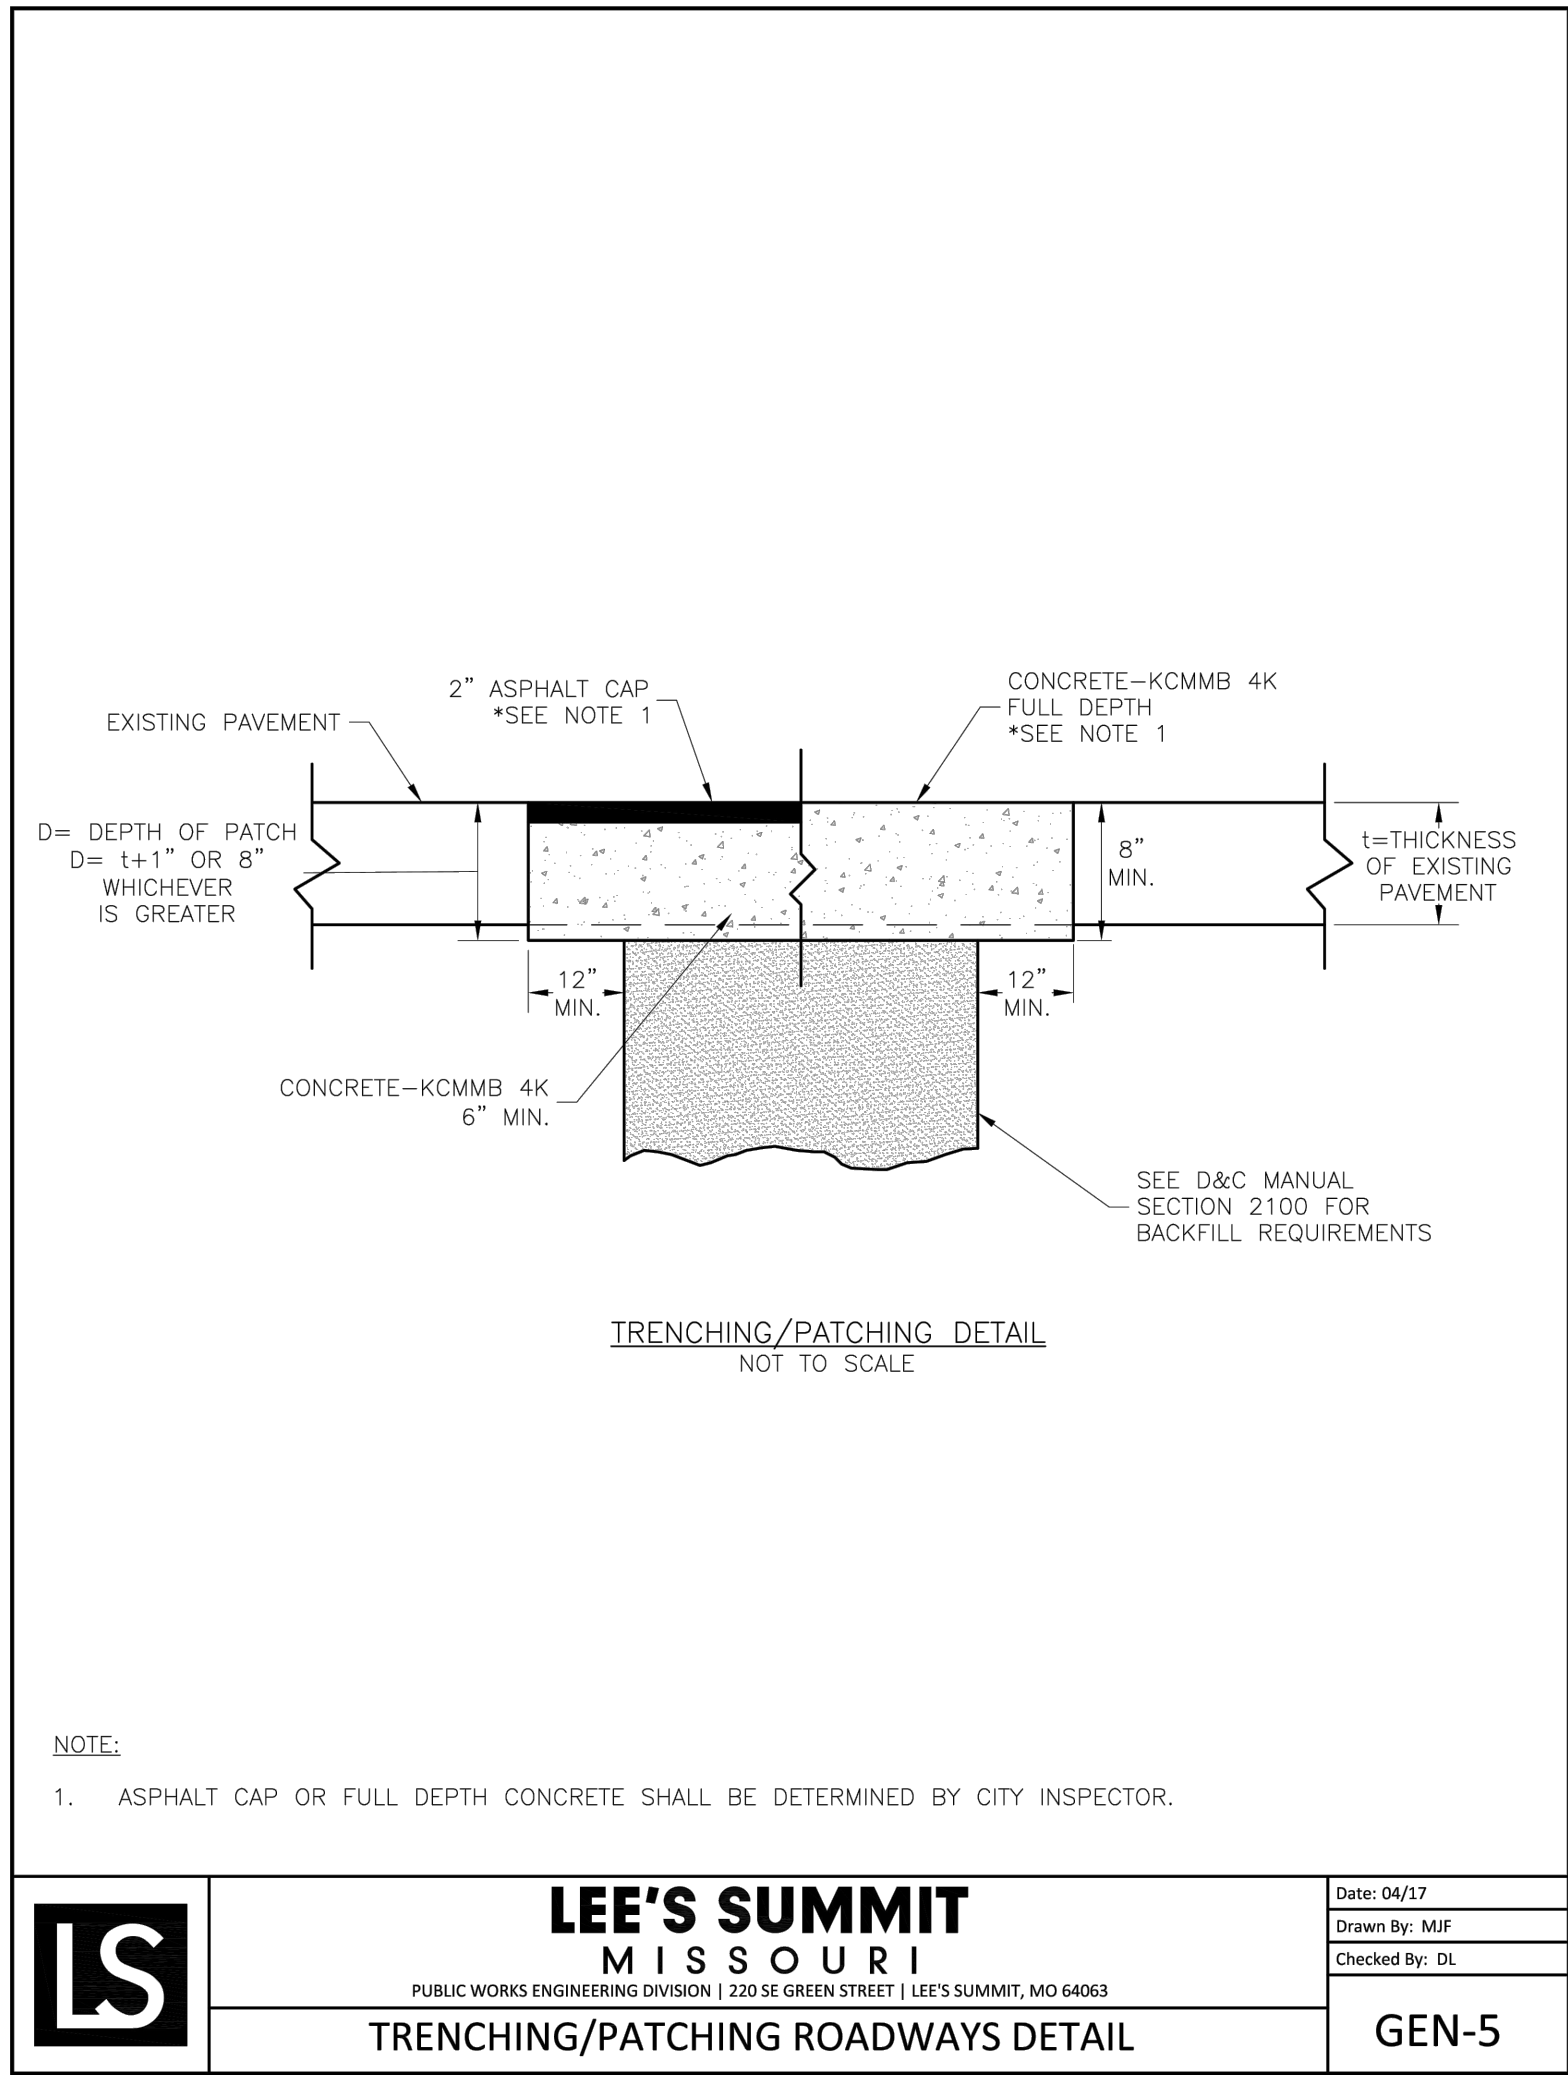


RECORD DRAWING

The information provided on this drawing conforms to construction records; it is not intended for construction, implementation or recording purposes; and is solely based on information provided by others.


“100.00 100.10”, “1.00% 1.15% slope”, “8-inch HDPE PVC pipe” or text that is blue in color are all typical examples of revisions that indicate that design data has been replaced with “as-built” information. All other data is as designed and has not been field verified.

Date: 9-20-22
Certified by: Samuel D. Malinowsky
Title: Owner
Firm: SM Engineering

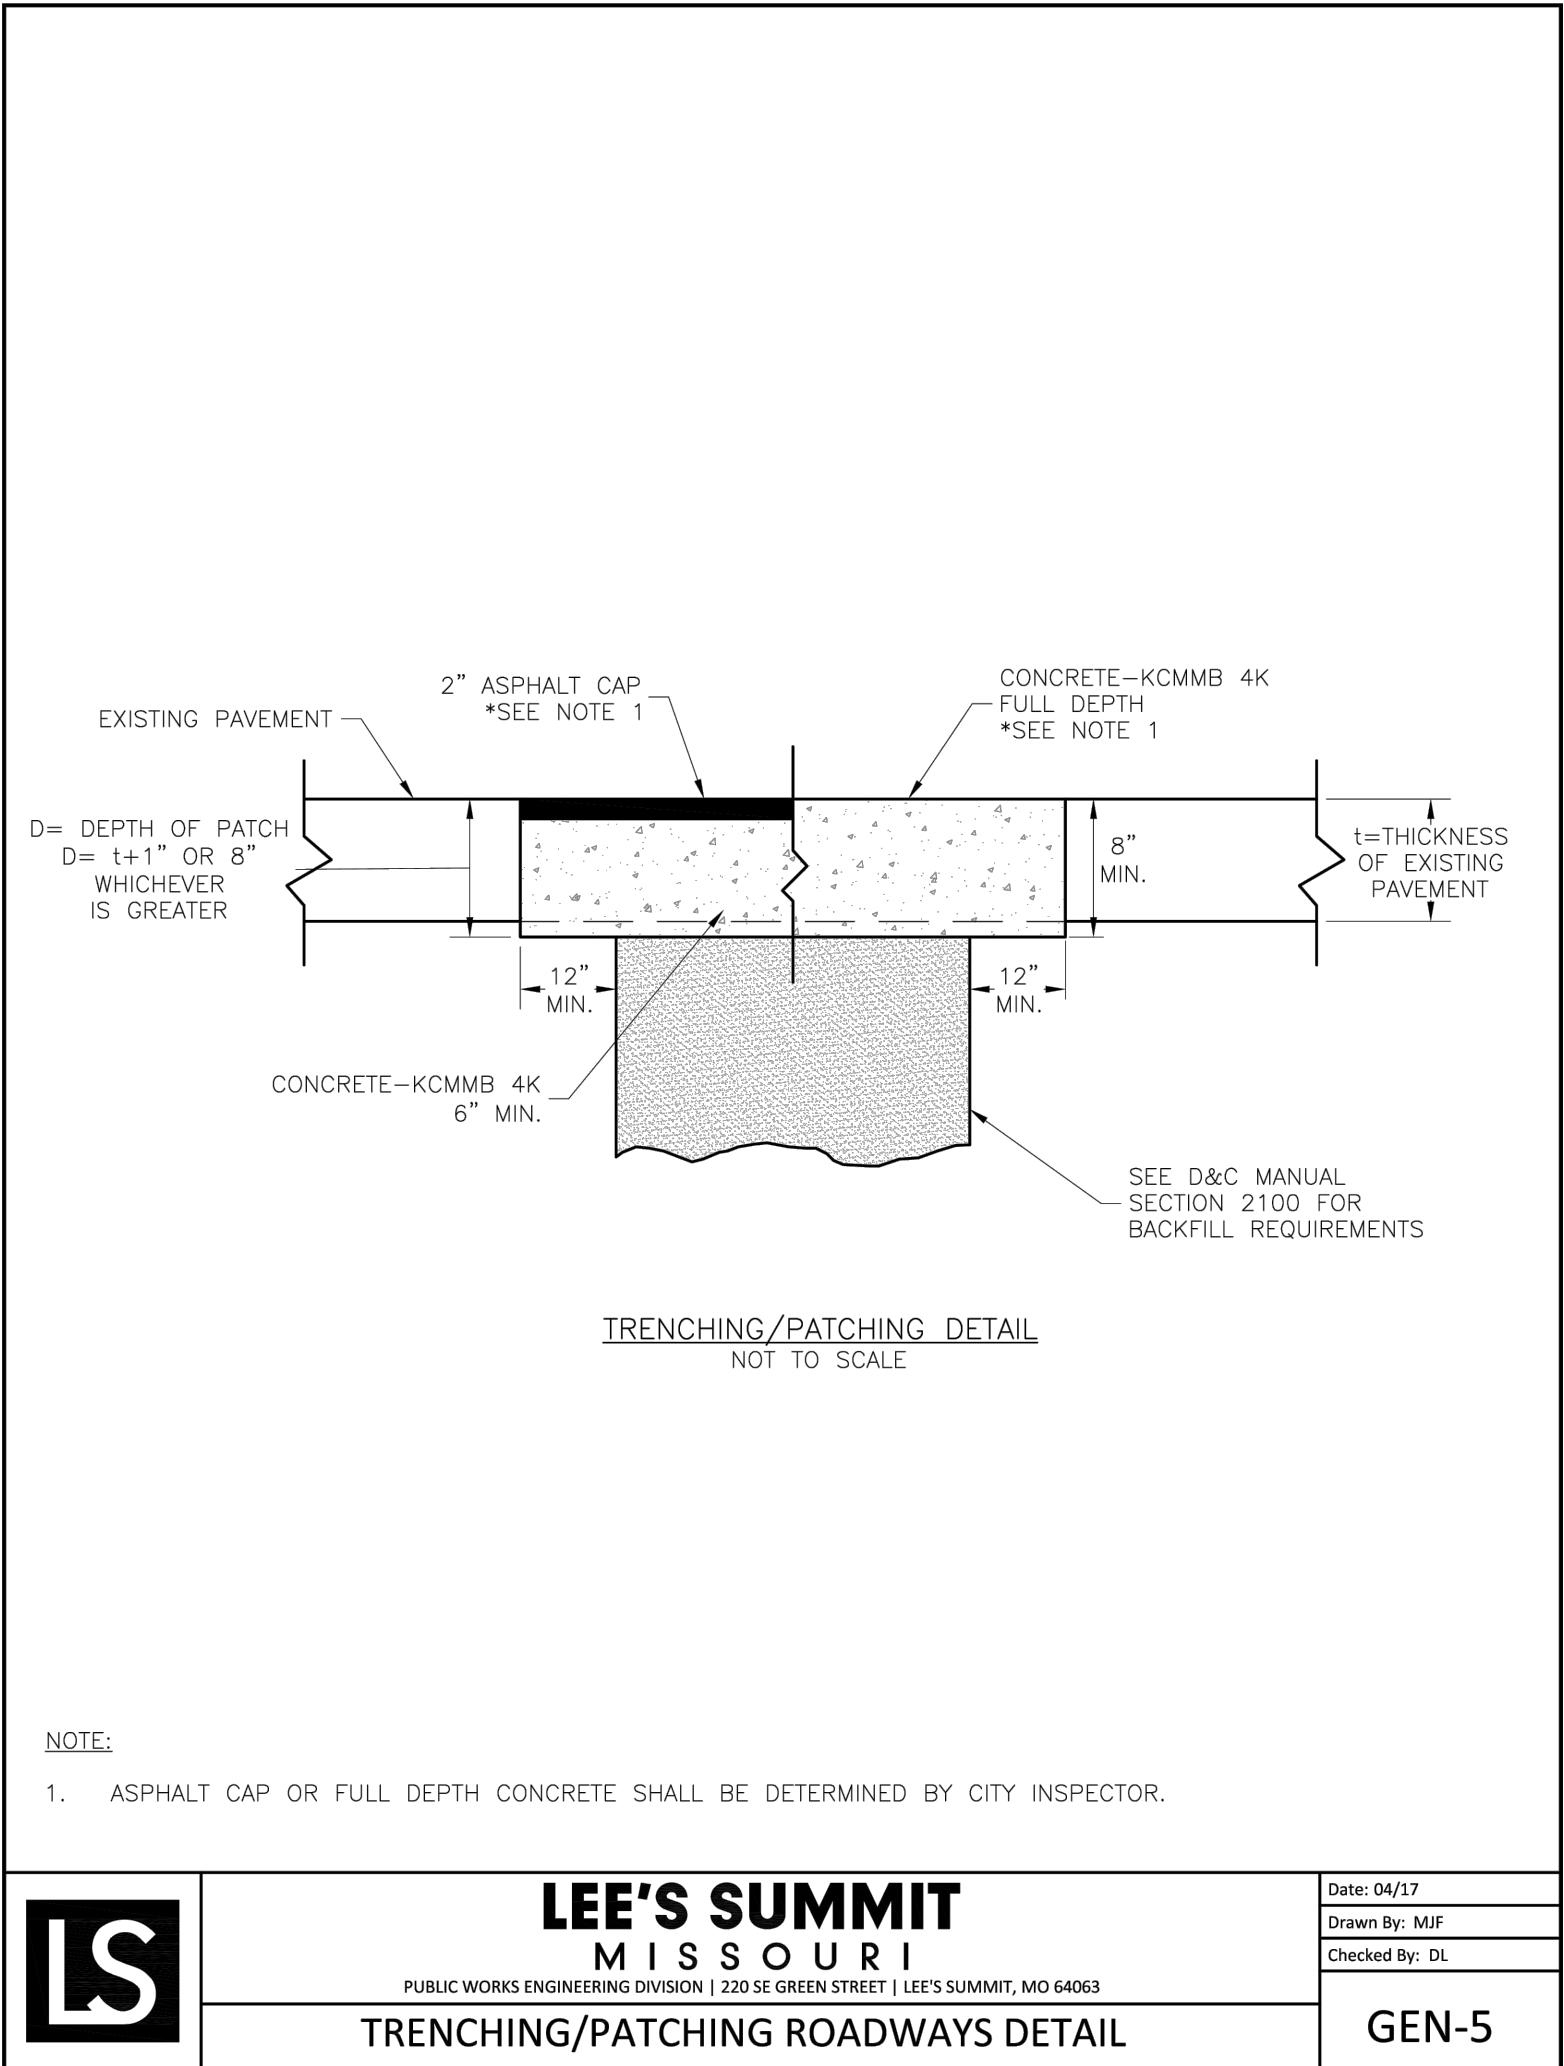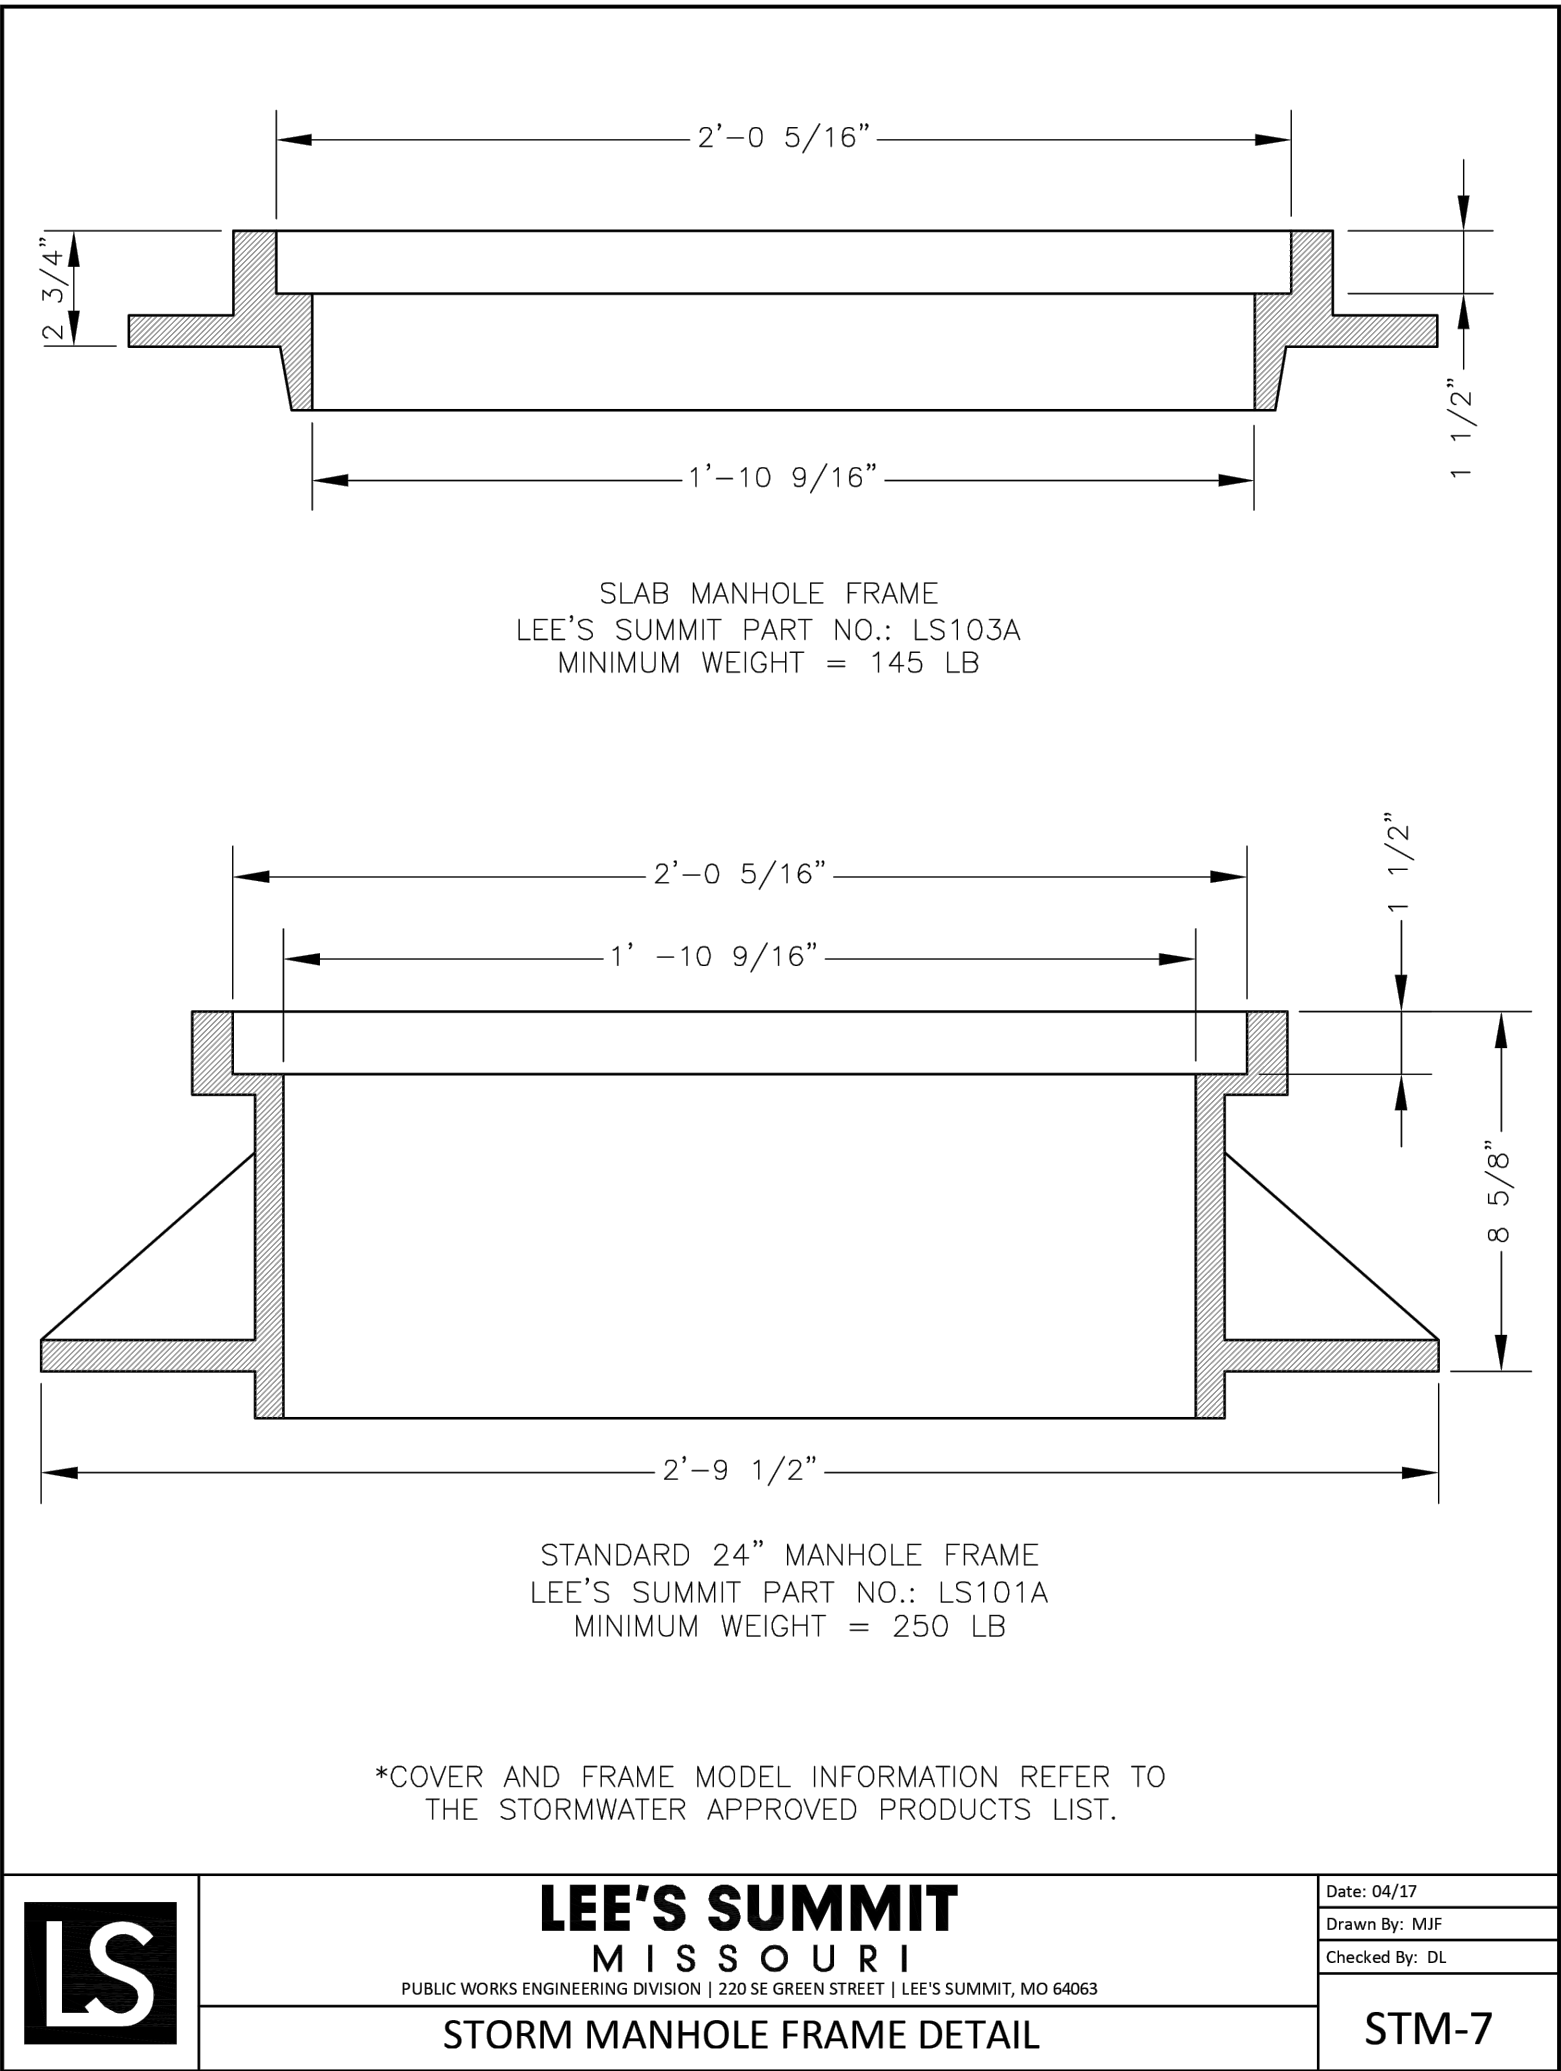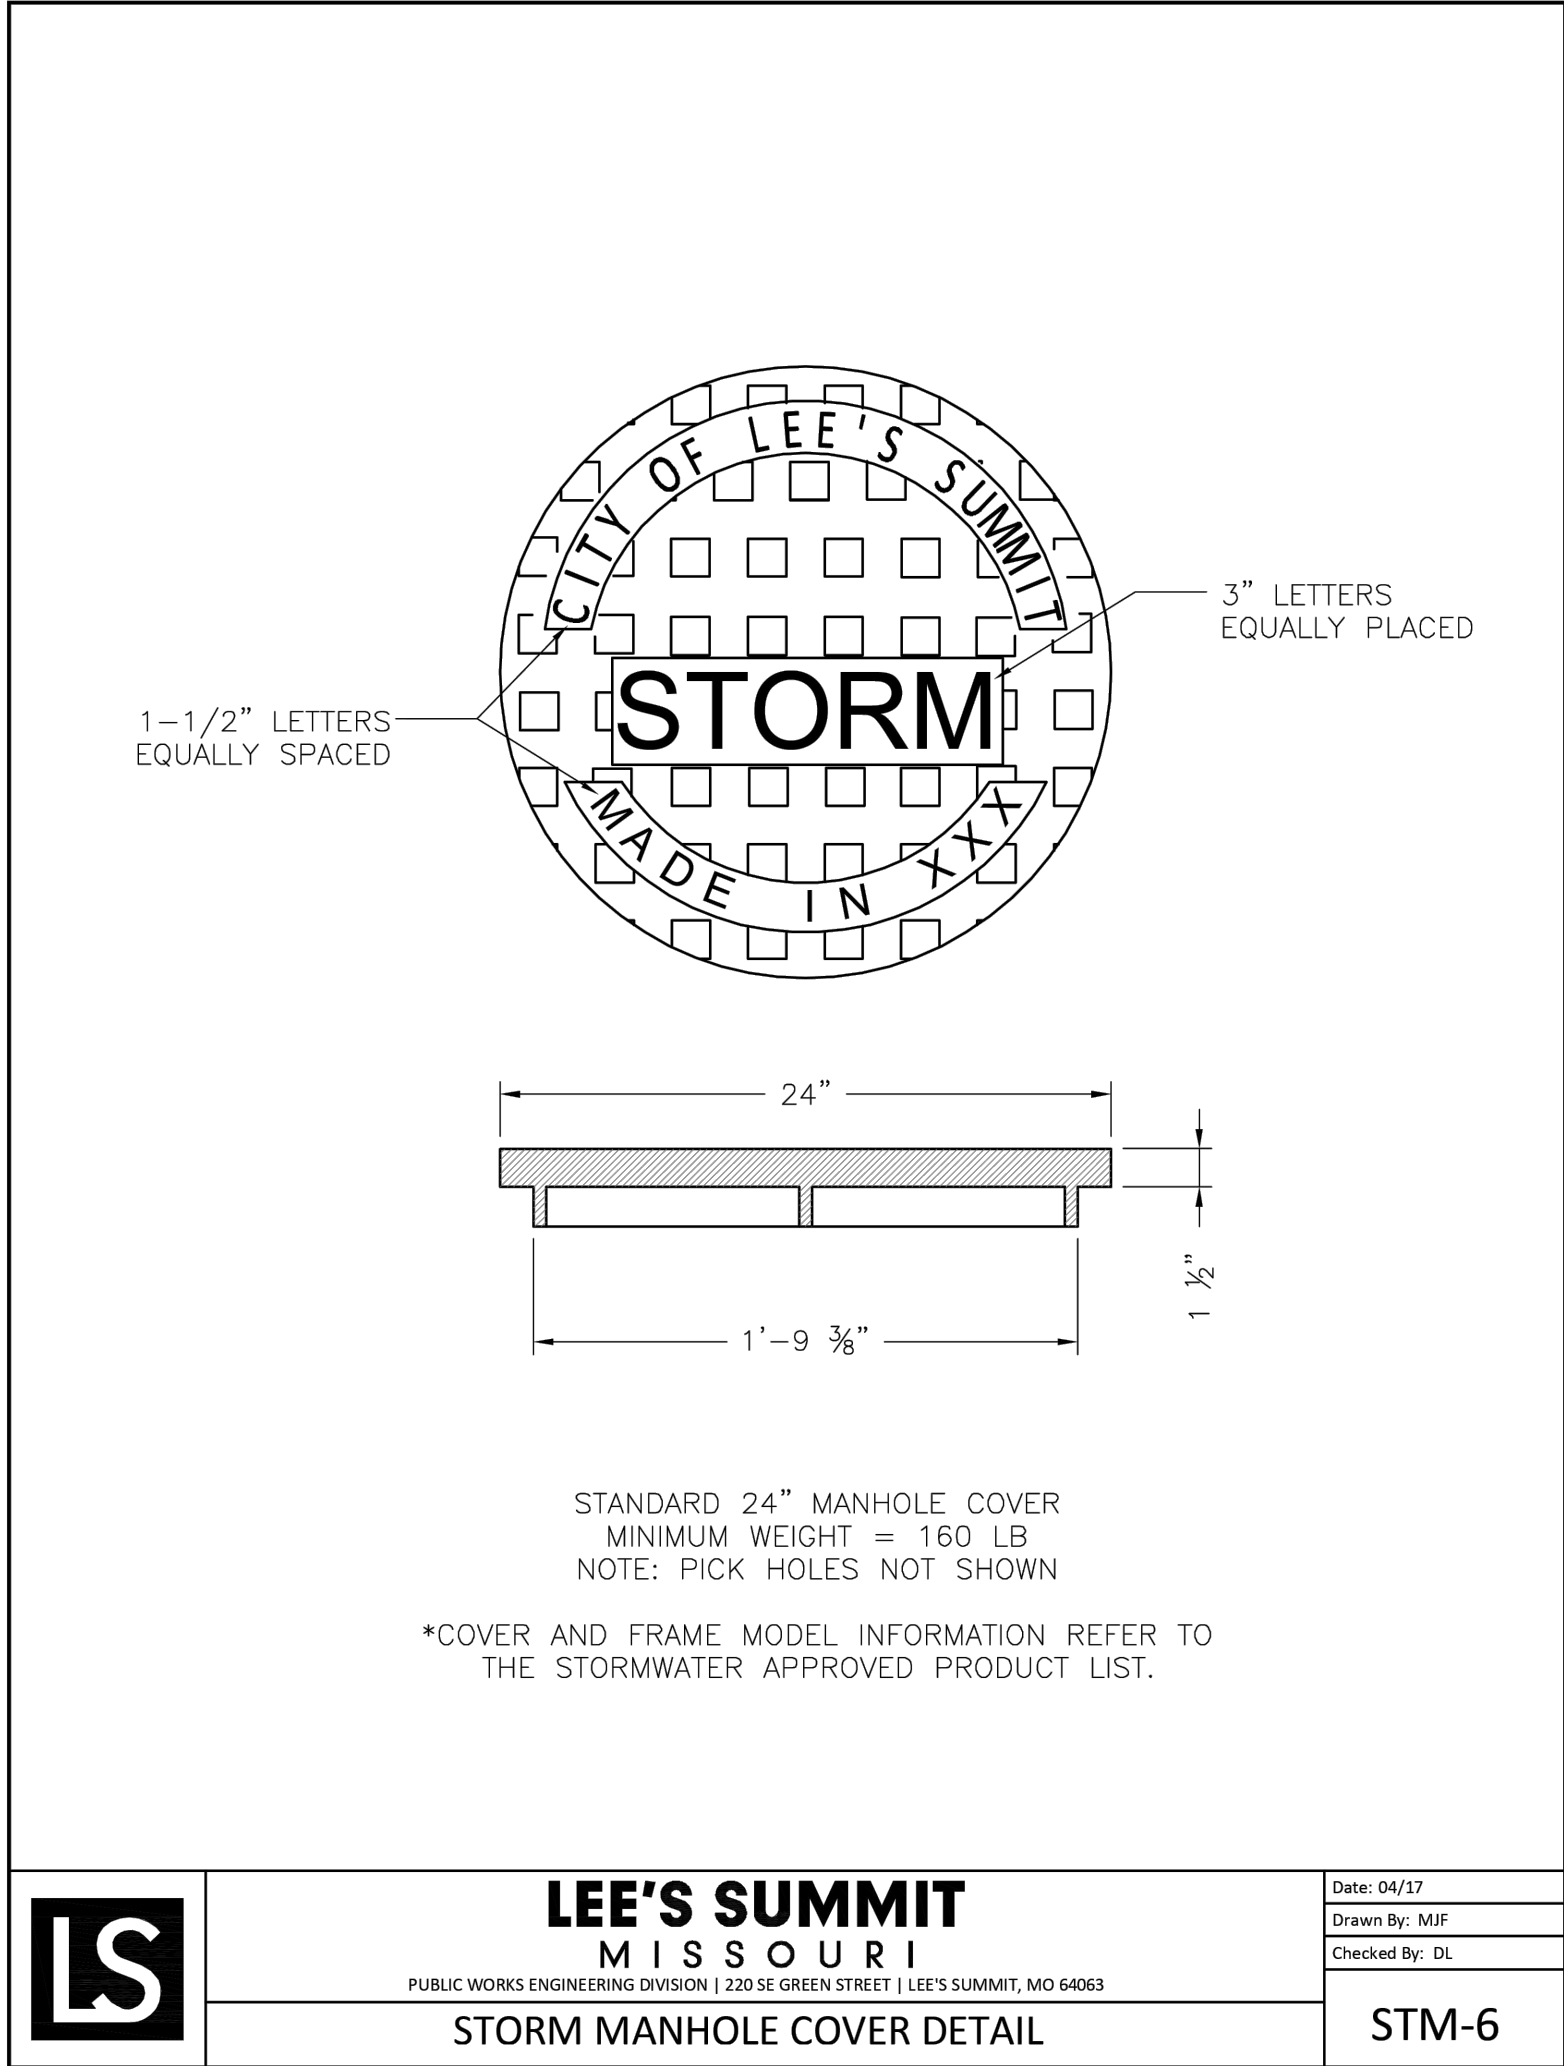

BEDDING
1/2"-3/4" CLEAN AGGREGATE, HAND TAMPED OR MECHANICALLY
COMPACTED IN MAX. 4" LIFTS
INITIAL BACKFILL
-UNDER PAVED AREAS OR WITHIN 4' HORIZONTAL OF PAVED AREAS
1/2"-3/4" CLEAN AGGREGATE, HAND TAMPED OR MECHANICALLY
COMPACTED IN MAX. 4" LIFTS
-UNDER OPEN AREAS
1/2"-3/4" CLEAN AGGREGATE, HAND TAMPED OR MECHANICALLY
COMPACTED IN MAX. 4" LIFTS
FINAL BACKFILL
-UNDER PAVED AREAS OR WITHIN 4' HORIZONTAL OF PAVED AREAS
ON-SITE OR IMPORTED MATERIAL FREE OF MUCK, FROZEN
MATERIAL, EXCESS MOISTURE, ORGANICS, TOPSOIL, RUBBISH,
CONSTRUCTION DEBRIS, ROCK OR BRICK LARGER THAN 8",
COMPACTED TO 95% OF STANDARD DENSITY PER ASTM D-698
-UNDER OPEN AREAS
ON-SITE OR IMPORTED MATERIAL FREE OF MUCK, FROZEN
MATERIAL, EXCESS MOISTURE, ORGANICS, TOPSOIL, RUBBISH,
CONSTRUCTION DEBRIS, ROCK OR BRICK LARGER THAN 8",
COMPACTED TO 90% OF STANDARD DENSITY PER ASTM D-698

| BEDDING DEPTH BELOW PIPE | | |
|--------------------------|---------|---------|
| PIPE DIAMETER | IN SOIL | IN ROCK |
| 24" AND LESS | 4" | 6" |
| 27" THRU 60" | 4" | 9" |

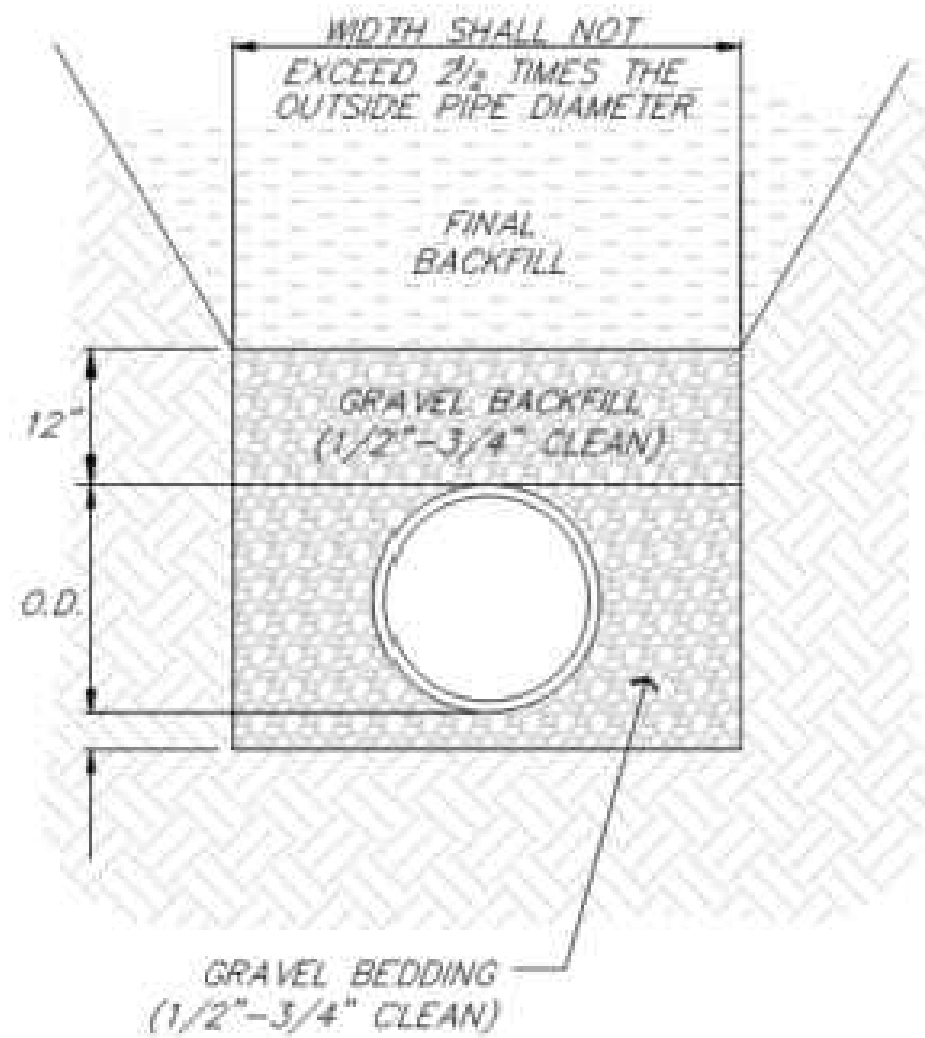

PIPE BEDDING DETAIL
NOT TO SCALE

RECORD DRAWING

The information provided on this drawing conforms to construction records; it is not intended for construction, implementation or recording purposes; and is solely based on information provided by others.

~~"100.00 100.10"~~, ~~"1.00% 1.15% slope"~~, "8-inch HDPE PVC pipe" or text that is blue in color are all typical examples of revisions that indicate that design data has been replaced with "as-built" information. All other data is as designed and has not been field verified.

Date: 9-20-22
Certified by: Samuel D. Malinowsky
Title: Owner
Firm: SM Engineering

Drawings and/or Specifications are original proprietary work and property of the Engineer and intended specifically for this project. Use of items contained herein without consent of the Engineer's prohibited. Drawings illustrate best information available to the Engineer. Field verification of actual elements, conditions, and dimensions is required.



Revisions
8-19-21 CITY COMMENTS
9-13-21 CITY COMMENTS
10-21-21 ADDED STUB
1-6-22 STUB TABLE
9-20-22 AS-BUILTS

STREETS OF W. PRYOR
LOT 7A & 7B
LEES SUMMIT, MO.