# FIRE PROTECTION PLANS

F. E. MORAN, INC. FIRE PROTECTION 16815 COLLEGE BLVD. LENEXA, KS 66219 (217) 356-0700 (217) 356-0777 FAX

MISSOURI COA: E-2022012018

# SCOPE OF WORK

- SCOPE OF WORK: \*\* FURNISH & INSTALL (11) NEW WET PIPE SPRINKLER SYSTEM FOR THE NEW BUILDING.
- \*\* FURNISH & INSTALL À NEW FIRE PUMP AND ACCESSORIES \*\* FIRE PUMP ROOM POINT OF CONNECTION (START OF CONTRACT): 10" FLANGE, 12"
- ABOVE THE FINISHED FLOOR IN THE FIRE PUMP ROOM. \*\*FEED RISER POINT OF CONNECTION (START OF CONTRACT): 8" FLANGE, 12" ABOVE THE FINISHED FLOOR IN THE FIRE PUMP ROOM. TWO LOCATED ON EACH END OF THE

BUILDING AND ONE ON EACH SIDE. \*\* INSTALL (18) 21/2" HOSE VALVES LOCATED AT MAN DOORS AND FED FROM ADJACENT SYSTEMS

- NOT INCLUDED:
- \*\* WIRING OF ELECTRICAL DEVICES \*\* FIRE EXTINGUISHERS
- \*\* STANDPIPES AND HOSE STATIONS
- \*\* FIRE PUMP CONTROLLER AUTO TRANSFER SWITCH \*\* UNDERGROUND PIPING AND TESTING
- \*\* COLUMN SPRINKLERS
- \*\* SEISMIC BRACING \*\* PAINTED PIPING
- \*\* CONCRETE PADS
- \*\* COMPONENT IDENTIFICATION BEYOND NFPA 13 REQUIREMENTS \*\* ACCESS PANELS
- \*\* CUTTING AND PATCHING
- \*\* PIPE SLEEVES \*\* WALL POST INDICATOR VALVE
- \*\* PUMP CONTROLLER AUTOMATIC TRANSFER SWITCH

### CODE INFORMATION

CODE INFORMATION:

\*\*LOCAL AMENDMENTS

\*\*NFPA 13, 2016 EDITION: INSTALLATION OF SPRINKLER SYSTEMS \*\*NFPA 20, 2016 EDITION: INSTALLATION OF CENTRIFUGAL FIRE PUMPS \*\*INTERNATIONAL BUILDING & FIRE CODE, 2018 EDITION

**BUILDING INFO:** 

**IBC OCCUPANCY CLASSIFICATION: S-1** 

IBC CONSTRUCTION TYPE: II-B **IBC SEISMIC DESIGN CATEGORY: E** 

HIGHEST FLOOR ELEVATION FROM FIRE DEPARTMENT VEHICLE ACCESS: GRADE NUMBER OF STORIES: 1 BUILDING AREA: 433,364 S.F.

# GENERAL REQUIREMENTS

\*\* SUPPLY A SPARE SPRINKLER CABINET WITH WRENCH FOR EACH SPRINKLER TYPE AS **REQUIRED BY NFPA 13.** \*\* IDENTIFY ALL HYDRAULICALLY CALCULATED SYSTEMS WITH A PERMANENTLY MARKED IN-RACK SPRINKLERS: NO

AND WEATHERPROOF SIGN. \*\* ALL NEW PIPING OR PIPING MODIFICATIONS WHICH AFFECT MORE THAN 20 SPRINKLERS SHALL BE HYDROSTATICALLY TESTED AT 200 PSI OR 50 PSI OVER THE

SYSTEM WORKING PRESSURE. THE SYSTEM SHALL MAINTAIN THIS PRESSURE WITHOUT LOSS FOR 2 HOURS. \*\* \*\* ALL NEW PIPING OR PIPING MODIFICATIONS WHICH AFFECT 20 SPRINKLERS OR LESS

SHALL BE TESTED AT THE SYSTEM WORKING PRESSURE. \*\* ALL PIPING MODIFICATIONS WHICH CANNOT BE ISOLATED FROM THE EXISTING SYSTEM. SHALL BE TESTED AT THE SYSTEM WORKING PRESSURE.

\*\* THE LOCAL FIRE/BUILDING INSPECTOR IS TO BE NOTIFIED 48 HOURS IN ADVANCE OF ALL TESTING. UNDERGROUND TESTING AND FLUSHING

\*\* ALL UNDERGROUND PIPE SHALL BE TESTED AND FLUSHED BY THE INSTALLING CONTRACTOR AS REQUIRED BY NFPA 24 BEFORE ANY OVERHEAD SPRINKLER PIPING IS CONNECTED.

## VALVES

\*\* ALL VALVES CONTROLLING WATER FLOW TO SPRINKLERS SHALL BE INDICATING & SUPERVISED. \*\* ALL VALVES SHALL BE ACCESSIBLE AT ALL TIMES AND PERMANENTLY IDENTIFIED.

\*\* THE IDENTIFICATION OF CONTROL VALVES SHALL INCLUDE A DESCRIPTION OR DIAGRAM OF WHAT THEY CONTROL.

\*\* ALL TRAPPED PORTIONS OF SPRINKLER PIPING SHALL BE PROVIDED WITH A LOW POINT DRAIN AS REQUIRED BY NFPA 13.

### **PIPE HANGERS**

\*\* 21/2"-6" HANGER RINGS ARE TO BE ADJUSTABLE SWIVEL RINGS, ZINC PLATED, MANUFACTURED TO ANSI/MSS SP-69 STANDARDS. \*\* 2<sup>1</sup>/<sub>2</sub>"-6" CLEVIS HANGERS ARE TO BE ADJUSTABLE CLEVIS RINGS, PLAIN,

MANUFACTURED TO ANSI/MSS SP-69 STANDARDS.

\*\* HANGERS AND SEISMIC BRACING ARE TO BE INSTALLED PER NFPA 13 REQUIREMENTS. \*\* HANGER ROD SIZES AND LOCATIONS ARE TO BE AS REQUIRED BY NFPA 13.


# **DESIGN CRITERIA - LIGHT HAZARD**

# SPRINKLER SYSTEM DESIGN CRITERIA - LIGHT HAZARD AREA/DENSITY (WET & SINGLE

INTERLOCKED PREACTION SYSTEMS): THE NEW SYSTEM HAS BEEN DESIGNED WITH A DESIGN DENSITY OF .10 GPM/S.F. OVER THE MOST REMOTE AND DEMANDING DESIGN AREA OF 1500 S.F. WITH 225 S.F. (15') MAXIMUM SPRINKLER HEAD SPACING AND 100 GPM OUTSIDE HOSE ALLOWANCE. WHERE ROOF OR CEILING SLOPES EXCEED A PITCH OF 2:12, THE DESIGN AREA HAS BEEN INCREASED IN SIZE BY 30% TO 1950 S.F. THE DESIGN AREA MAY BE REDUCED IN SIZE IN ACCORDANCE WITH NFPA 13 DUE TO THE USE OF QUICK RESPONSE SPRINKLERS BUT SHALL NEVER CONTAIN LESS THAN 5 SPRINKLERS. TOTAL SYSTEM SIZE SHALL NOT EXCEED 52,000 S.F.

WHERE EXTENDED COVERAGE SPRINKLERS ARE UTILIZED, THE MINIMUM DESIGN AREA SHALL BE 5 SPRINKLERS WITH 400 S.F. (20') MAXIMUM SPRINKLER HEAD SPACING. EXTENDED COVERAGE SPRINKLERS SHALL NOT BE USED WHERE ROOF OR CEILING SLOPES EXCEED A PITCH OF 2:12. WHERE SPECIFICALLY LISTED FOR SUCH USE, EXTENDED COVERAGE SPRINKLERS MAY BE USED FOR ROOF OR CEILING SLOPES UP TO A 4:12 PITCH.

WHEN A REDUCTION IN THE DESIGN AREA IS NOT USED, SPRINKLER DISCHARGE IN SMALL ROOMS SUCH AS CLOSETS AND WASHROOMS CONTAINING A SINGLE SPRINKLER MAY BE OMITTED FROM THE HYDRAULIC CALCULATIONS.

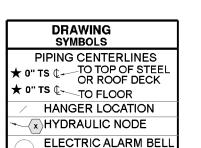

# WET SYSTEM PIPE & FITTINGS

WET-PIPE SPRINKLER SYSTEM BLACK PIPE: \*\* 1" LINE PIPING SHALL BE BLACK STEEL SCH. 40 PIPE, MANUFACTURED TO ASTM A53 OR A795 STANDARDS. \*\* 21/2" LINE PIPING SHALL BE BLACK STEEL SCH. 7 PIPE, MANUFACTURED TO ASTM A795 STANDARDS.

\*\* 8" MAIN PIPING SHALL BE BLACK STEEL SCH. 10 PIPE, MANUFACTURED TO ASTM A135 STANDARDS. \*\* 2"-6" MAIN PIPING SHALL BE BLACK STEEL SCH. 7 PIPE, MANUFACTURED TO ASTM A795 STANDARDS.

WET-PIPE SPRINKLER SYSTEM BLACK FITTINGS: \*\* 1" BRANCH LINE FITTINGS SHALL BE BLACK DUCTILE IRON THREADED, CLASS 150 STANDARD, MANUFACTURED PER ANSI/ASME B16.3, U.L. LISTED FOR FIRE PROTECTION USE UP TO 175 PSI WORKING PRESSURE. \*\* 1/2" - 3" BRANCH LINE PIPE OUTLETS TO BE WELDED MANUFACTURED TO ASTM A53 & ANSI B1.20.1 STANDARDS. \*\* 1 1/4"-3" BRANCH LINE FITTINGS SHALL BE STANDARD GROOVED DUCTILE IRON, MANUF. TO ASTM A536 STANDARDS.

\*\* 21/2"-8" MAIN PIPE BRANCH OUTLETS TO BE WELDED MANUFACTURED TO ASTM A53 & ANSI B1.20.1 STANDARDS. \*\* 21/2"-8" MAIN PIPE FITTINGS SHALL BE STANDARD GROOVED DUCTILE IRON, MANUF. TO

ASTM A536 STANDARDS. \*\* 21/2"-8" MAIN PIPE FITTINGS SHALL BE STANDARD GROOVED STEEL, MANUF. TO ASTM A958/A53 STANDARDS.

# **DESIGN CRITERIA - ESFR**

SPRINKLER SYSTEM DESIGN CRITERIA (ESFR)-PALLETIZED/SOLID-PILE/RACK STORAGE:

FROM NFPA 13, 2016 EDITION TABLE 16.3.3.1 COMMODITY CLASSIFICATION: CLASS I, II, III OR IV, ENCAPSULATED OR UNENCAPSULATED, NO OPEN TOP CONTAINERS STORAGE ARRANGEMENT: PALLETIZED/SOLID-PILE/SINGLE & DOUBLE ROW RACKS

WITH NO SOLID SHELVING

CONSTRUCTION TYPE: ALL TYPES MAXIMUM STORAGE HEIGHT: 35 FEET

MAXIMUM CEILING/ROOF HEIGHT: 40 FEET

MINIMUM CLEARANCE FROM SPRINKLER DEFLECTOR TO TOP OF STORAGE: 36 INCHES SPRINKLER TYPE: ESFR (EARLY SUPPRESSION FAST-RESPONSE) SPRINKLER K-FACTOR: 16.8

SPRINKLER TEMPERATURE RATING: 205°F

SPRINKLER ORIENTATION: PENDENT

MAXIMUM SPRINKLER DEFLECTOR DISTANCE BELOW CEILING: 14 INCHES MINIMUM SPRINKLER DEFLECTOR DISTANCE BELOW CEILING: 6 INCHES MAXIMUM SPRINKLER SPACING/AREA: 10 FEET/100 S.F.

MINIMUM SPRINKLER SPACING: 8 FEET/64 S.F. TYPE OF SYSTEM: WET

NUMBER OF DESIGN SPRINKLERS: 12 MINIMUM SPRINKLER OPERATING PRESSURE: 52 PSI

INSIDE HOSE STREAM ALLOWANCE: 0 GPM

OUTSIDE HOSE STREAM ALLOWANCE: 250 GPM

TOTAL HOSE STREAM ALLOWANCE: 250 GPM

SPRINKLER SYSTEM DESIGN CRITERIA (ESFR)-PALLETIZED/SOLID-PILE/RACK STORAGE:

FROM NFPA 13, 2016 EDITION TABLE 16.3.3.1 COMMODITY CLASSIFICATION: CLASS I, II, III OR IV, ENCAPSULATED OR

UNENCAPSULATED, NO OPEN TOP CONTAINERS STORAGE ARRANGEMENT: PALLETIZED/SOLID-PILE/SINGLE & DOUBLE ROW RACKS WITH NO SOLID SHELVING CONSTRUCTION TYPE: ALL TYPES

MAXIMUM STORAGE HEIGHT: 40 FEET

MAXIMUM CEILING/ROOF HEIGHT: 45 FEET

MINIMUM CLEARANCE FROM SPRINKLER DEFLECTOR TO TOP OF STORAGE: 36 INCHES SPRINKLER TYPE: ESFR (EARLY SUPPRESSION FAST-RESPONSE) SPRINKLER K-FACTOR: 22.4

SPRINKLER TEMPERATURE RATING: 205°F

SPRINKLER ORIENTATION: PENDENT MAXIMUM SPRINKLER DEFLECTOR DISTANCE BELOW CEILING: 18 INCHES

MINIMUM SPRINKLER DEFLECTOR DISTANCE BELOW CEILING: 6 INCHES MAXIMUM SPRINKLER SPACING/AREA: 10 FEET/100 S.F. MINIMUM SPRINKLER SPACING: 8 FEET/64 S.F.

TYPE OF SYSTEM: WET

NUMBER OF DESIGN SPRINKLERS: 12 MINIMUM SPRINKLER OPERATING PRESSURE: 40 PSI

INSIDE HOSE STREAM ALLOWANCE: 0 GPM


OUTSIDE HOSE STREAM ALLOWANCE: 250 GPM

TOTAL HOSE STREAM ALLOWANCE: 250 GPM IN-RACK SPRINKLERS: NO

SYSTEMS SHALL BE WET ONLY.


ROOF OR CEILING SLOPES SHALL NOT EXCEED A PITCH OF 2:12. TOTAL SYSTEM SIZE SHALL NOT EXCEED 40,000 S.F. COMBINED HIGH PILED/RACK STORAGE & LIGHT/ORDINARY HAZARD SYSTEMS MAY COVER UP TO 52,000 S.F.


# HEAD DEFLECTOR MAXIMUN STORAGE STORAGE CLEARANCE

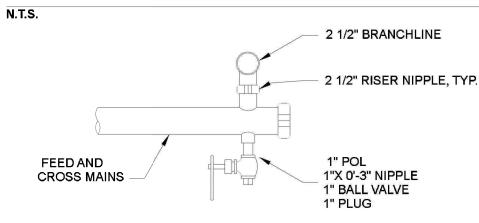


# **TYPICAL DRAIN DETAIL**

N.T.S.

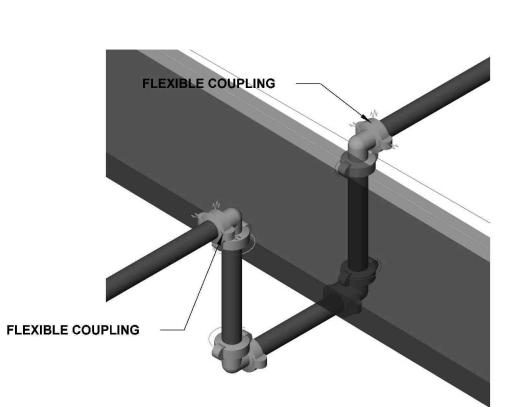


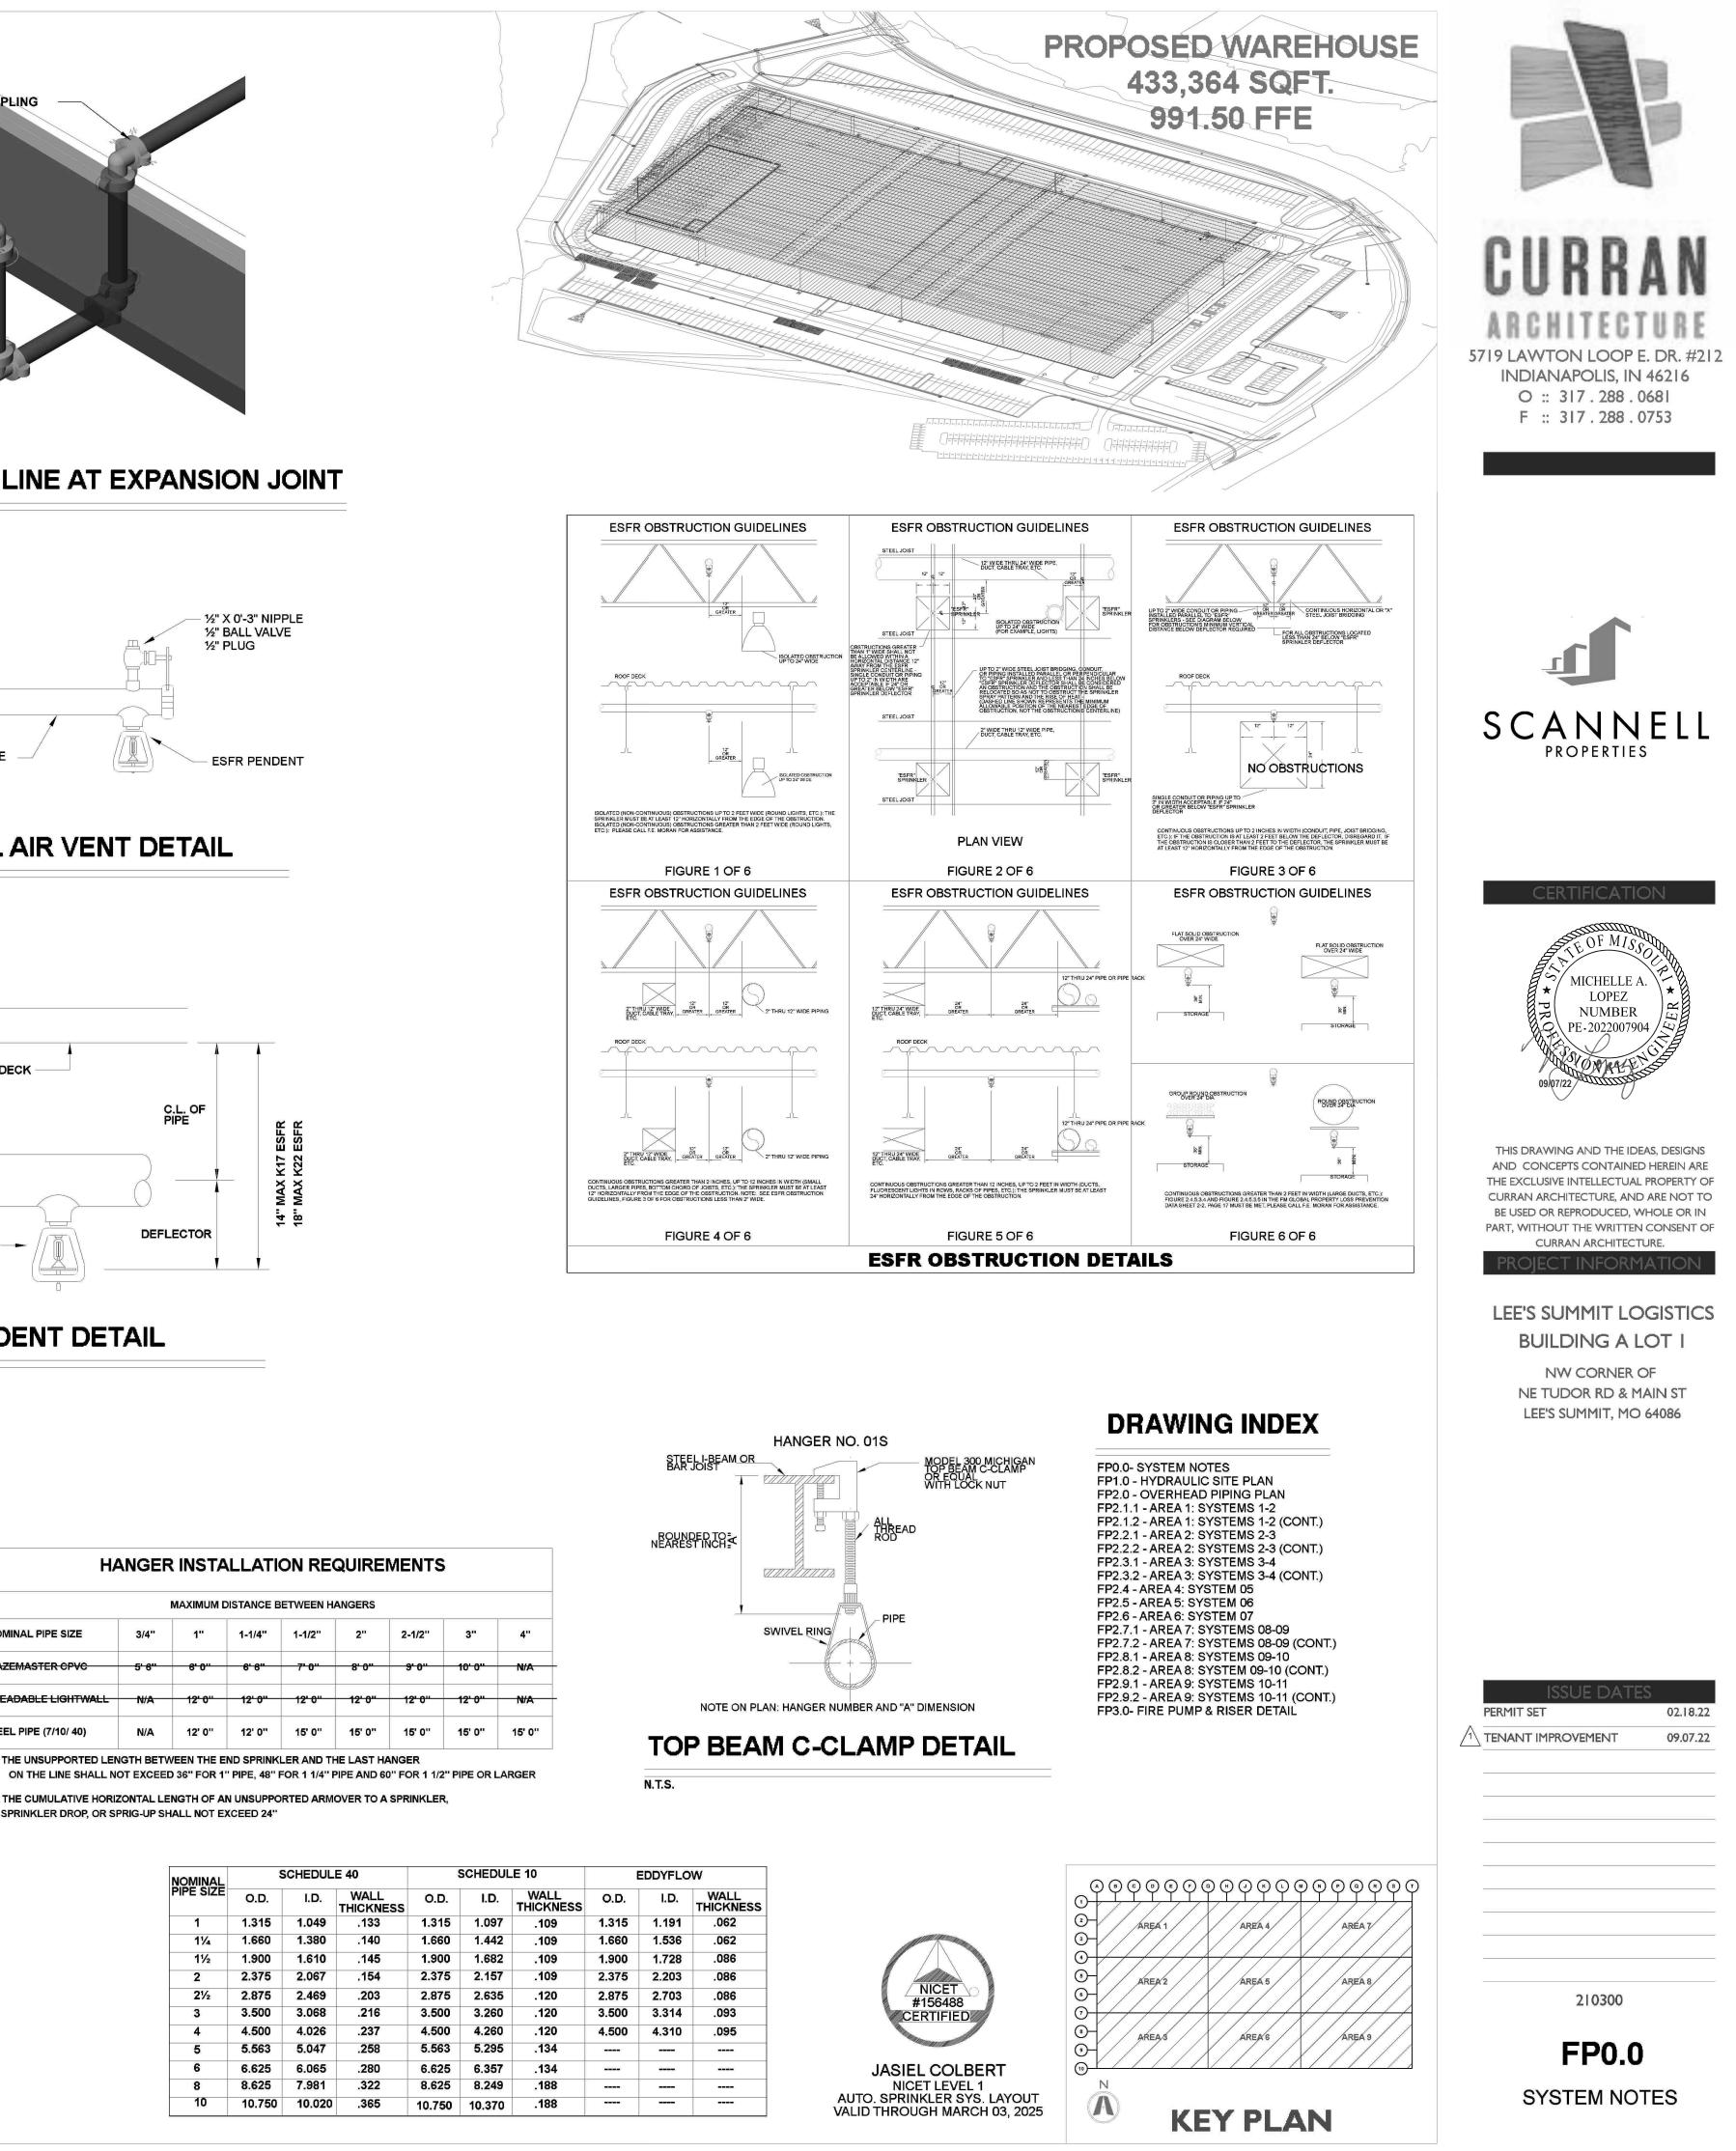


# TYPICAL LINE AT EXPANSION JOINT

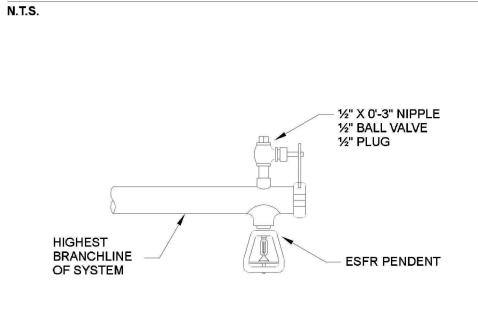


# MANUAL AIR VENT DETAIL

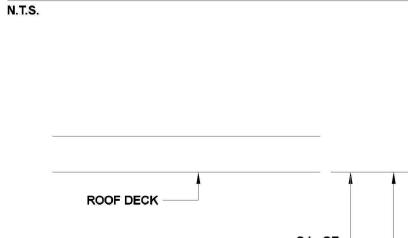

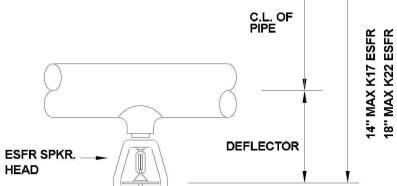

# ESFR PENDENT DETAIL

N.T.S.

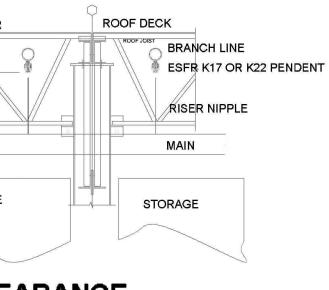



HA	NGEF	RINSTA	LLATI	ON RE	QUIRE	MENTS	6	
		MAXIMUM	DISTANCE E	BETWEEN H	ANGERS			
NOMINAL PIPE SIZE	3/4"	1"	1-1/4''	1-1/2''	2"	2-1/2"	3"	
BLAZEMASTER CPVC	<del>5' 6''</del>	6' 0''	6' 6"	7' 0"	<del>8' 0''</del>	9' 0''	<del>10' 0"</del>	
THREADABLE LIGHTWALL	N/A	12' 0''	12' 0"	12' 0''	12' 0"	12' 0"	<u>12' 0"</u>	
STEEL PIPE (7/10/ 40)	N/A	12' 0''	12' 0''	15' 0''	15' 0''	15' 0''	15' 0''	1


THE CUMULATIVE HORIZONTAL LENGTH OF AN UNSUPPORTED ARMOVER TO A SPRINKLER,


SPRINKLER DROP, OR SPRIG-UP SHALL NOT EXCEED 24"

SCHEDULE 10 **SCHEDULE 40** PIPE SIZE O.D. 0.D. I.D. I.D. **HICKNESS** 1.315 1.049 .133 1.315 1.097 1.660 11/4 1.660 11/2 1,900 2.375 2.37521/2 2.875 2 469 .203 2.875 .216 4,500 .237 4.500 5.563 5.047 5.563 .258 6.625 6 065 .280 6.625 8.625 7.981 .322 8.625 8.249 10 10.750 10.020 .365 10.750 10.370

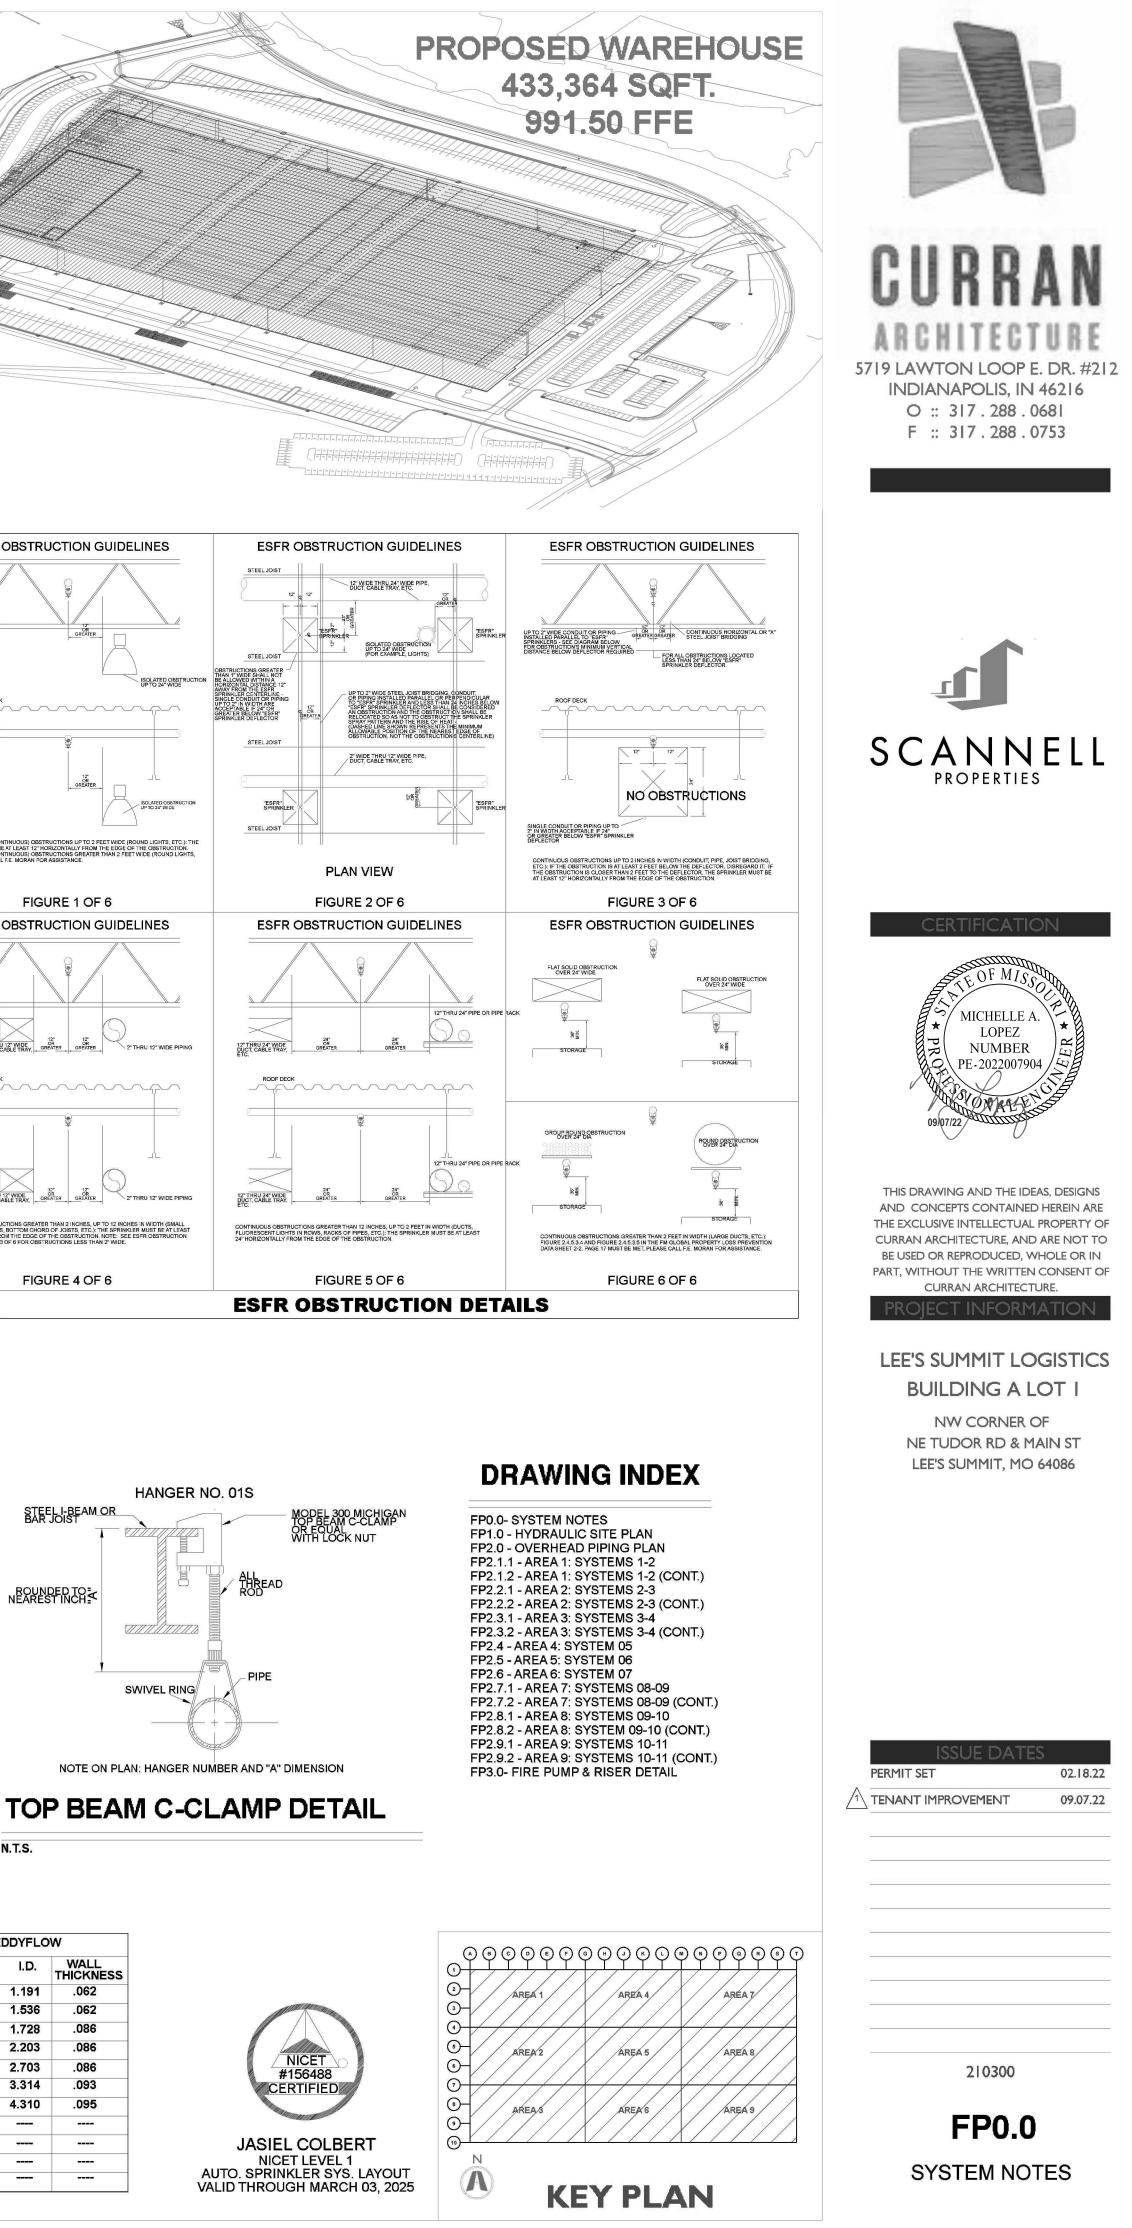

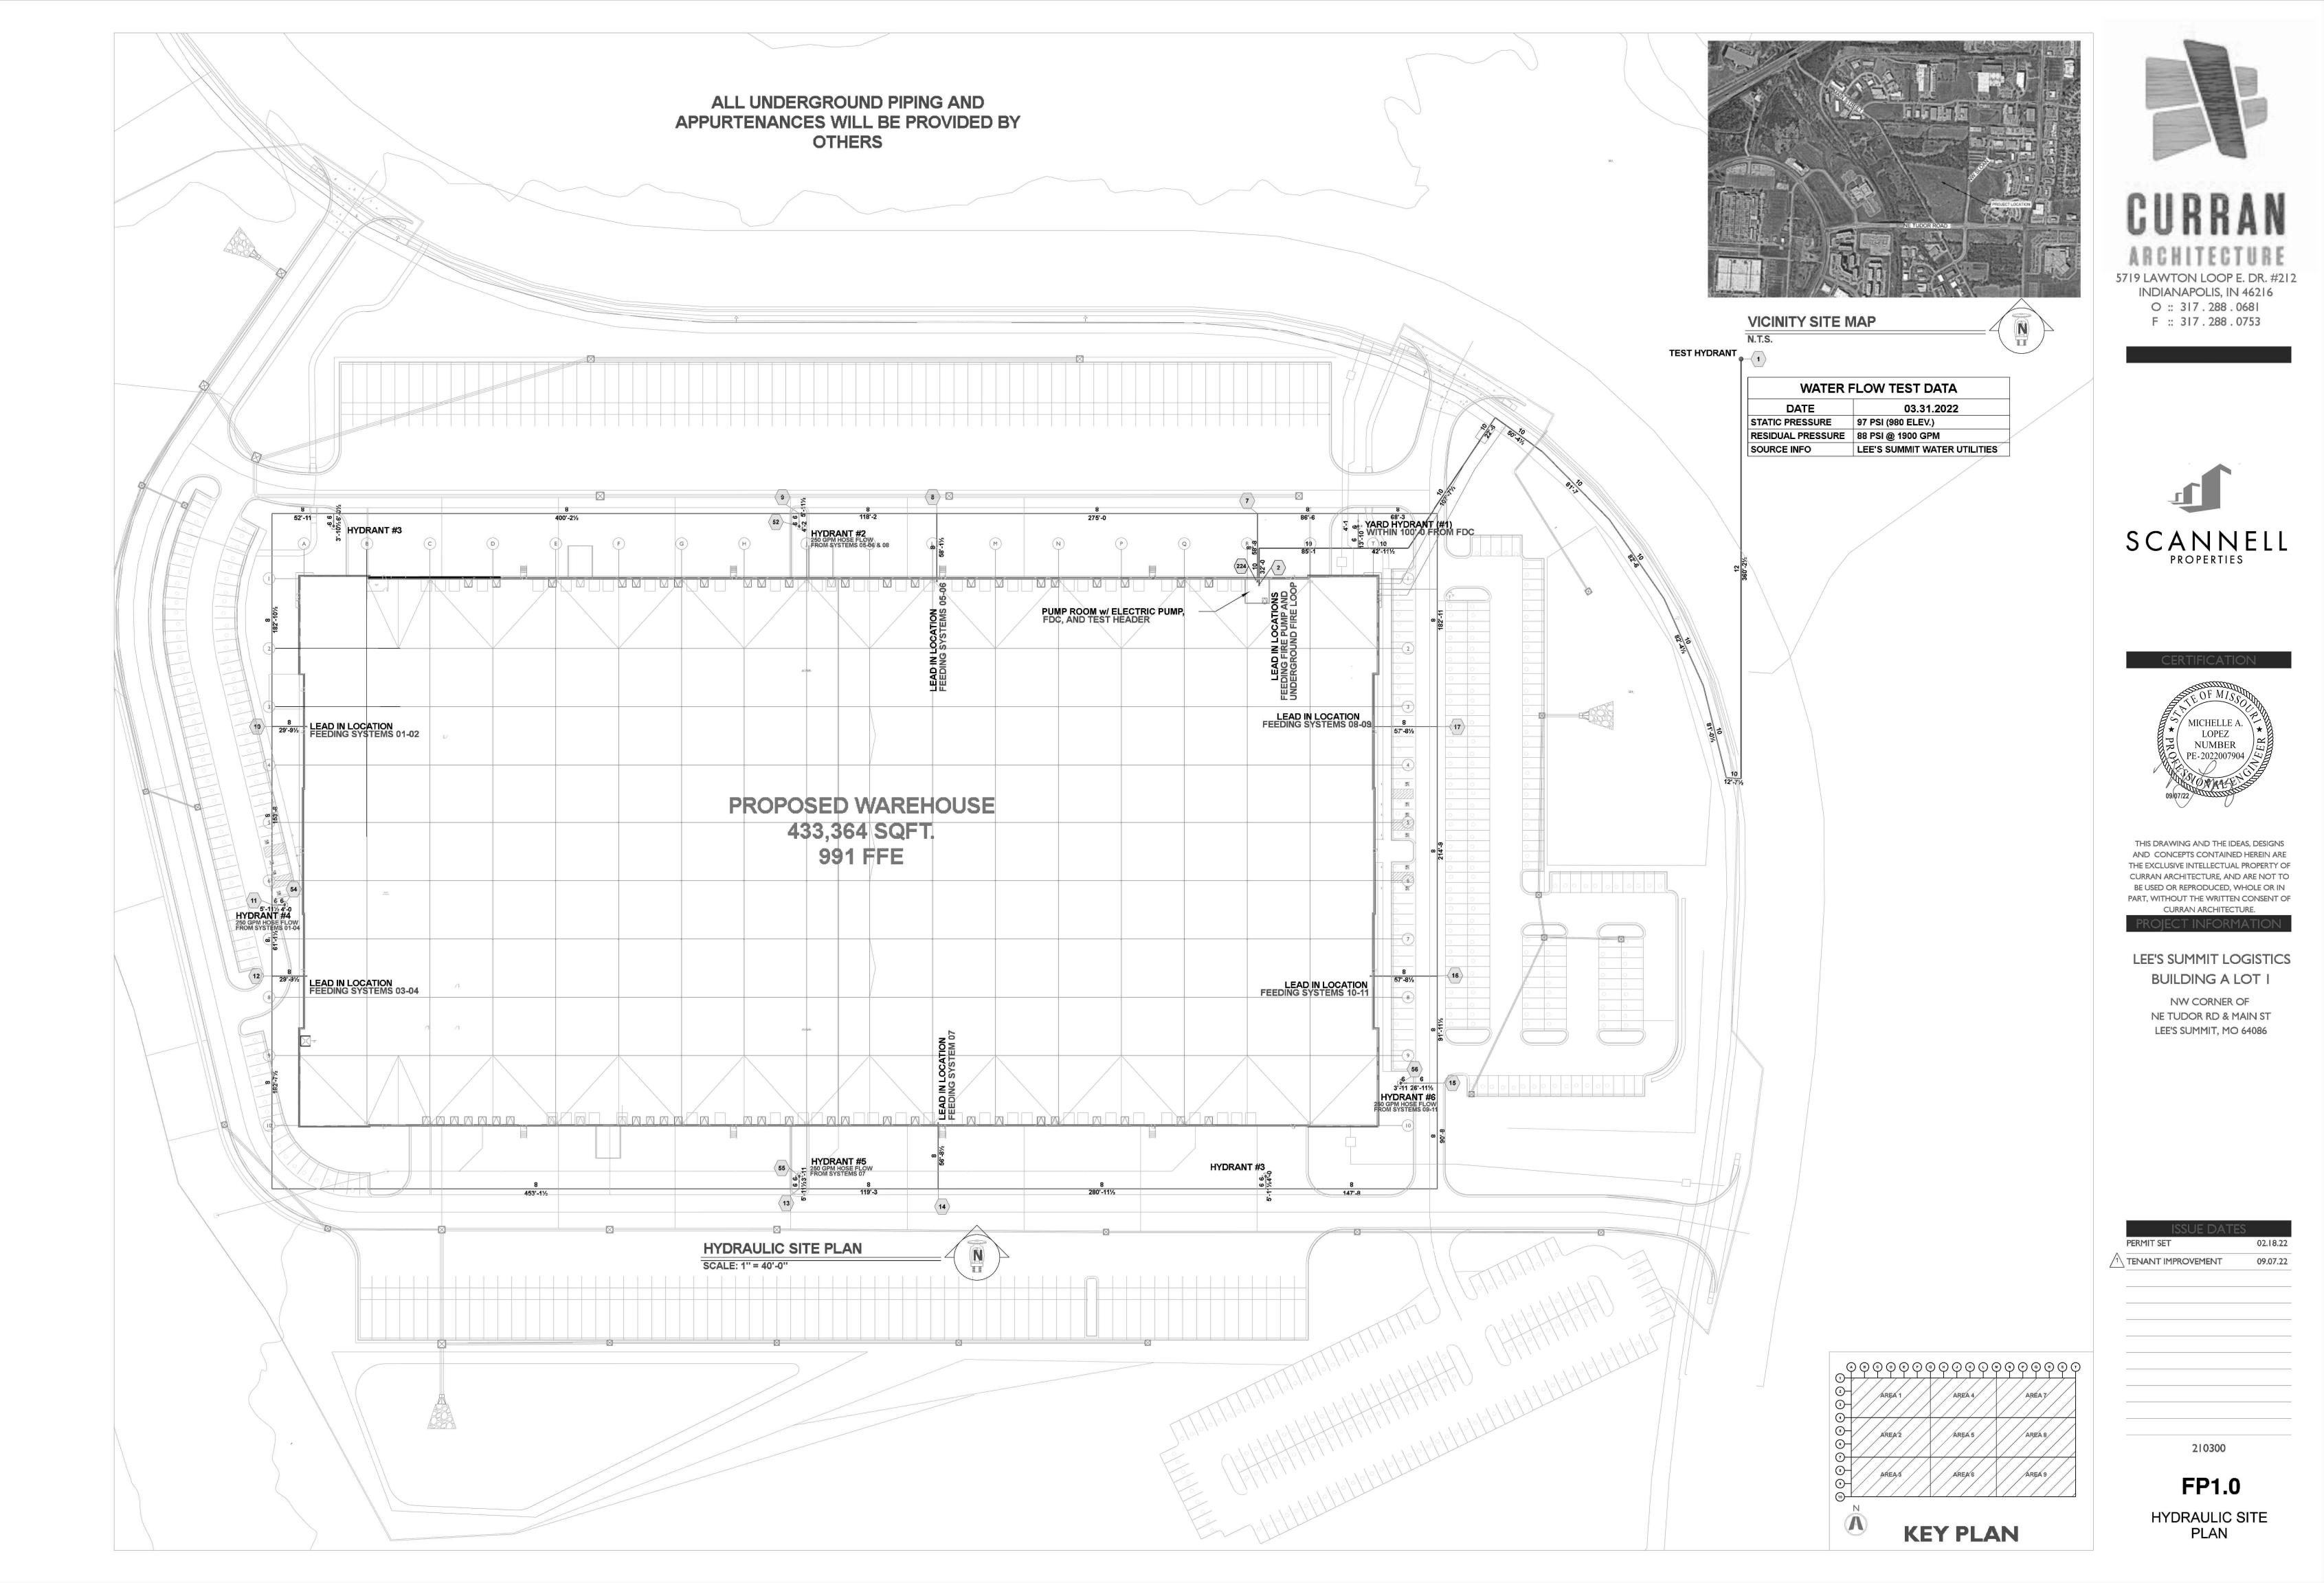


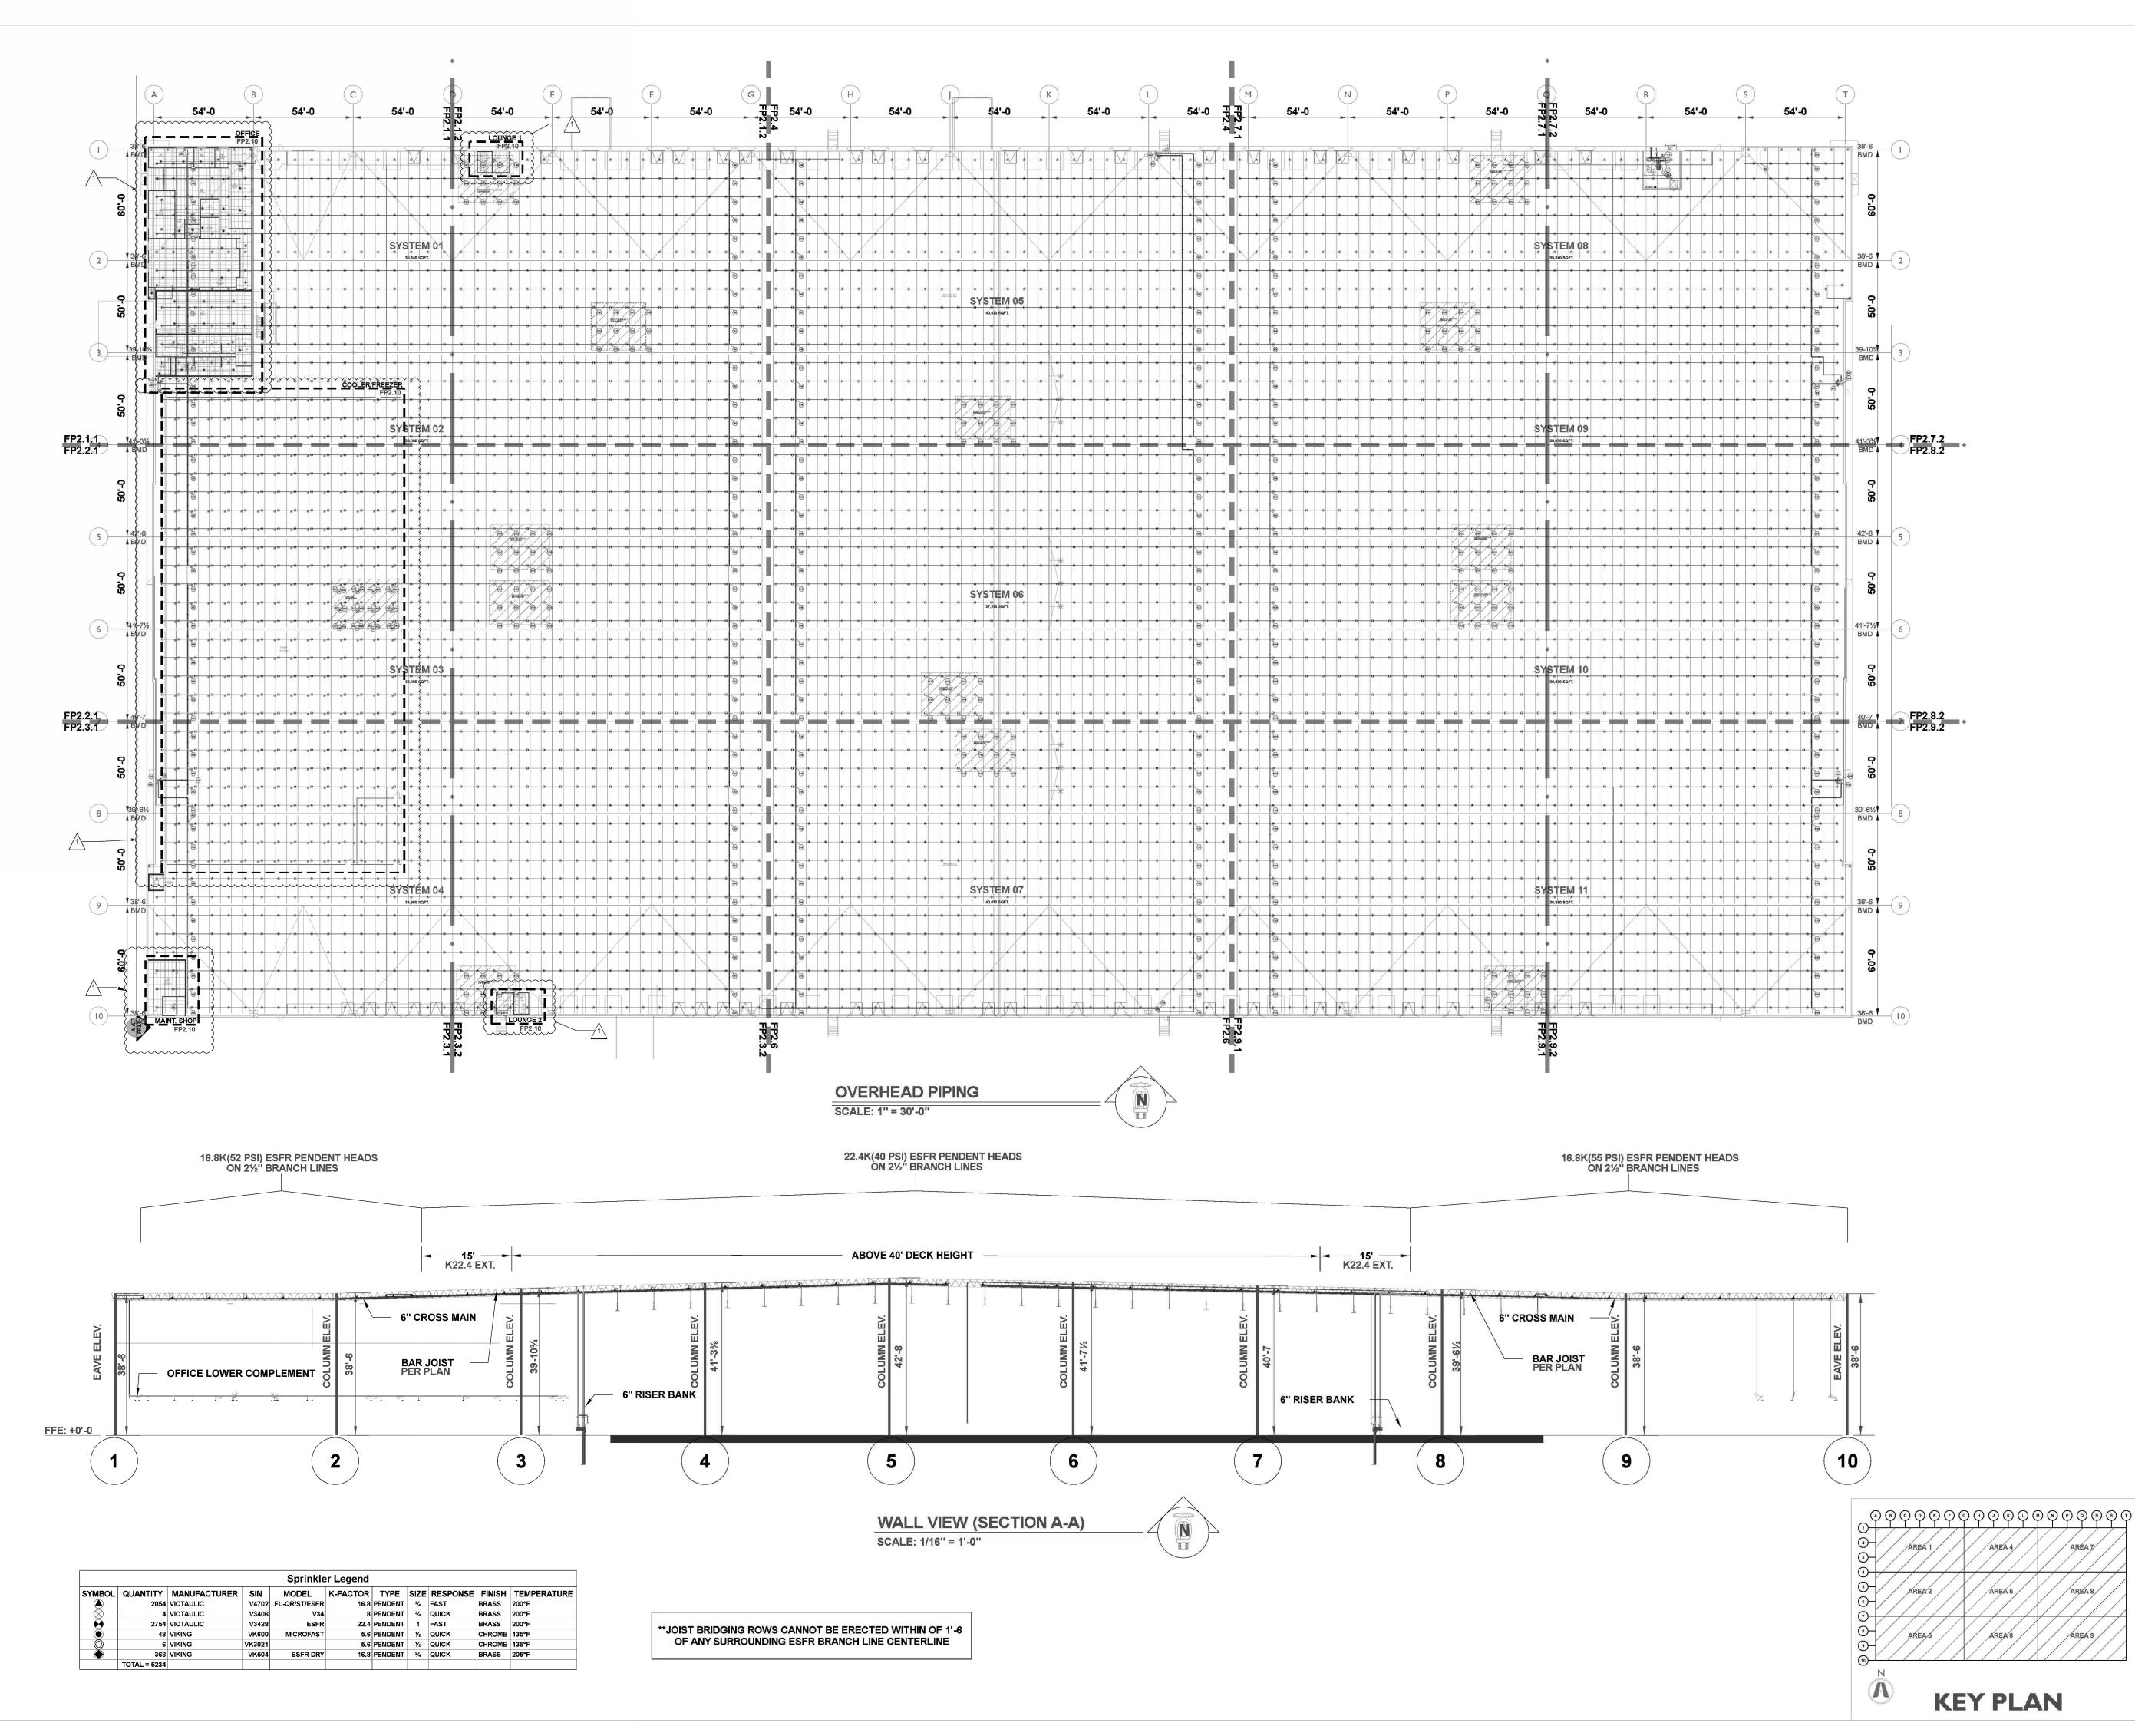

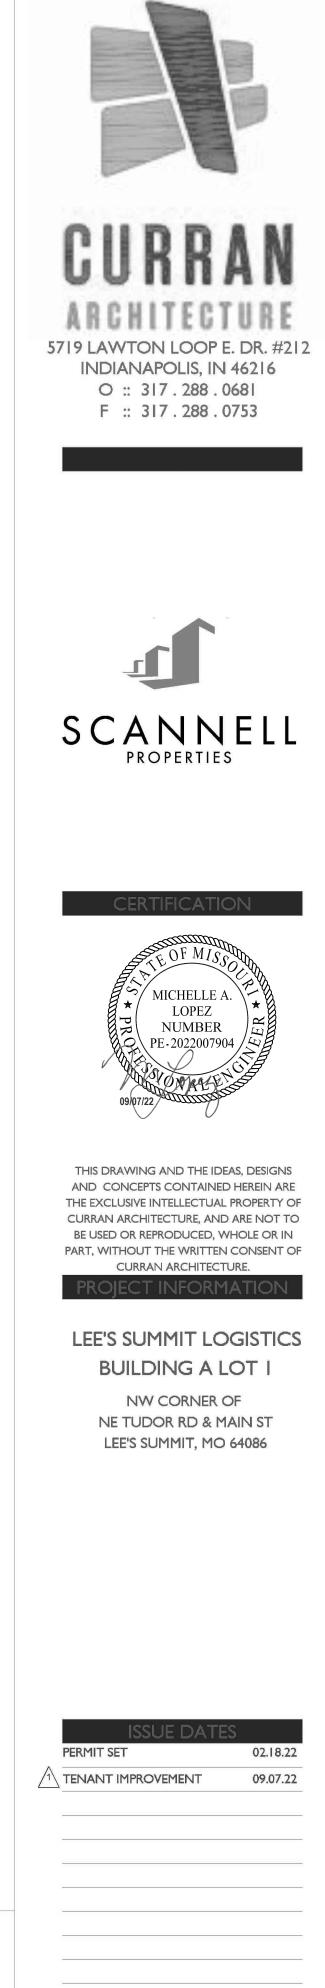


210300

**FP2.0** OVERHEAD PIPING LAYOUT

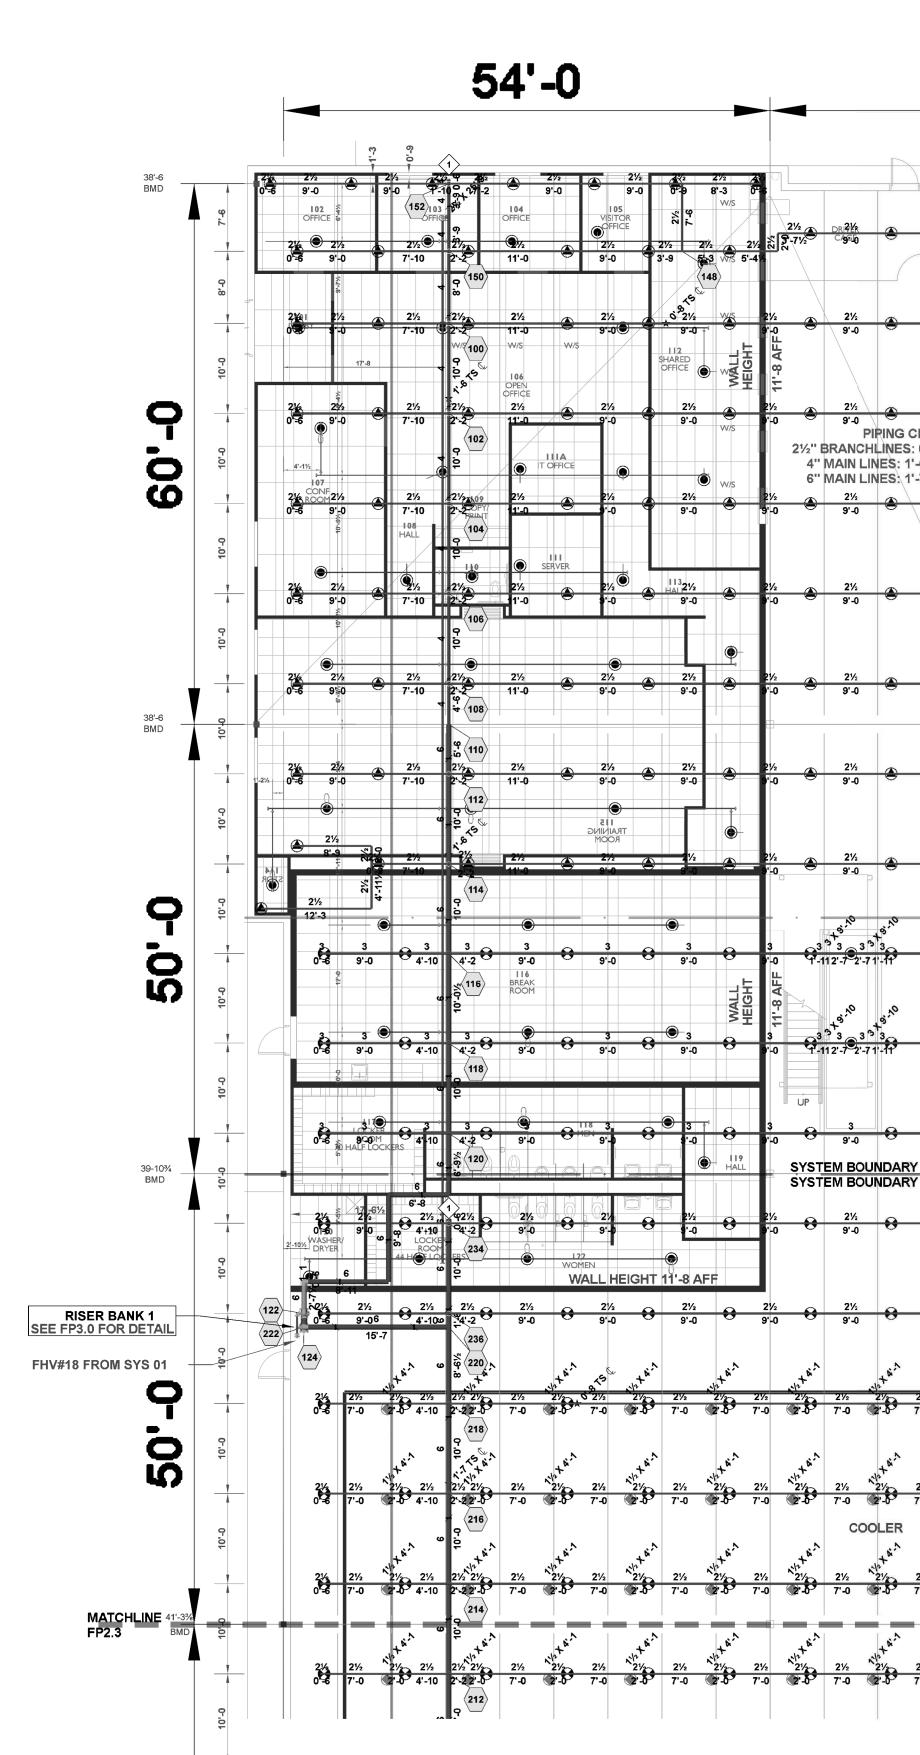


Hydraulic Information								
Remote Area 01 (K16.8)								
OCCUPANCY CLASSIFICATION	ESFR							
MIN. END HEAD PRESSURE	52.000 (ESFR)							
TOTAL HOSE STREAMS	250.00							
TOTAL HEADS FLOWING	12							
K-FACTOR	16.8							
TOTAL WATER REQUIRED	1711.60							
TOTAL PRESSURE REQUIRED	75.095							
BASE OF RISER (GPM)	1711.60							
BASE OF RISER (PSI)	75.095							
SAFETY MARGIN (PSI)	+14.486 (16.2%)							

Hydraulic Information							
Remote Area 01							
OCCUPANCY CLASSIFICATION	ESFR						
MIN. END HEAD PRESSURE	40.000 (ESFR)						
TOTAL HOSE STREAMS	250.00						
TOTAL HEADS FLOWING	12						
K-FACTOR	22.4						
TOTAL WATER REQUIRED	1959.70						
TOTAL PRESSURE REQUIRED	68.043						
BASE OF RISER (GPM)	1959.70						
BASE OF RISER (PSI)	68.043						
SAFETY MARGIN (PSI)	+19.427 (22.2%)						

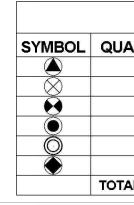

54'-0		54'-0	FP2.2 MATCHLINE	54'-0
FHV#01 FROM SYS 0		21/2 21/2 21/2	21/2 21/2 21/2	21/2 21/2 8 21/2 21/2 21/2
9°.0 9°.0 9°.0 5 2°/2 2°/2 2°/2	2 <sup>1</sup> / <sub>2</sub> 2 <sup>1</sup> / <sub>2</sub> 2 <sup>1</sup> / <sub>2</sub>	9'-0 9'-0 9'-0 21/2 21/2 21/2 9'-0 9'-0 9'-0	9'-0 21/2 59'-7 21/2 21/2 9'-0 9'-0 9'-0 9'-0 9'-0 9'-0 9'-0	7/46         1         9'-0         9'-0           1131         1127         1127         1129           2½         2½         2½         2½           9'-0         9'-0         9'-0         9'-0
9'0 9'0 9'0 9'0 S CENTERLINES:		21/2 21/2 21/2 9'-0 9'-0 9'-0	2½ 2½ 2½ 9'-0 9'-0 9'-0 (1123)	1113 1111 REMOTE AREA 01 (16.8K) ESFR:52.000 21/2 21/2 9'-0 9'-0 9'-0 1112 12/2 9'-0 1112 11117 11117 1 1 1 1 1 1 1 1 1 1 1 1 1
		<sup>52</sup> /45 2½ 2½ 9 <sup>1</sup> −0 9 <sup>1</sup> −0 9 <sup>1</sup> −0	2½ 2½ 2½ 2½ 9'-0 9'-0 9'-0	2 <sup>1</sup> / <sub>2</sub> 2 <sup>1</sup> / <sub>2</sub> 2 <sup>1</sup> / <sub>2</sub> 3 <sup>1</sup> -0 9 <sup>1</sup> -0 9 <sup>1</sup> -0
	2 <sup>1/2</sup> 2 <sup>1/2</sup> 2 <sup>1/2</sup> 9'-0 9'-0 9'-0 9'-0	2½ 2½ 2½ 90 90 90 90 0 SYSTEM	2½ 2½ 2½ 9'-0 9'-0 9'-0	2 <sup>1</sup> / <sub>2</sub> 2 <sup>1</sup> / <sub>2</sub> 2 <sup>1</sup> / <sub>2</sub> 3 <sup>1</sup> -0 9 <sup>1</sup> -0 9 <sup>1</sup> -0
3.0     3.0     3.0     3.0     3.0	9'-0 9'-0 9'-0 9'-0 9'-0	2 <sup>1/2</sup> 2 <sup>1/2</sup> 2 <sup>1/2</sup> 9 <sup>1</sup> 0 9 <sup>1</sup> 0 9 <sup>1</sup> 0 9 <sup>1</sup> 0 35,640 SQFT.	2½ 2½ 2½ 9'-0 9'-0 9'-0 2½ 2½ 2½	$\begin{array}{c c c c c c c c c c c c c c c c c c c $
9'-0 9'-0 9'-0 9'-0 9'-0 9'-0 9'-0 9'-0	2 <sup>1</sup> $\begin{array}{c ccccccccccccccccccccccccccccccccccc$	0 @2 <sup>-</sup> . <sup>6</sup> <sup>9</sup> 7'-0 @2 <sup>-</sup> . <sup>6<sup>9</sup></sup> 7'-0 @2 <sup>-</sup> . <sup>6<sup>9</sup></sup> 8'	SASTEM 2½ 2½ 2½ 2½ 1→ 38,880 SQFT.	02 2½ 8 2½ 8 2½ 9'-0 8 9'-0 9'-0	2½     2½     2½     2½       9'-0     9'-0     9'-0     9'-0
$\begin{array}{c ccccccccccccccccccccccccccccccccccc$		$\frac{1}{2^{1/2}} + \frac{1}{2^{1/2}} + \frac{2^{1/2}}{2^{1/2}} + \frac{2^{1/2}}$	2½ 2½ 2½ 9'-0 9'-0 9'-0	2 <sup>1</sup> / <sub>2</sub> 2 <sup>1</sup> / <sub>2</sub> 2 <sup>1</sup> / <sub>2</sub> 2 <sup>1</sup> / <sub>2</sub> 9 <sup>1</sup> -0 9 <sup>1</sup> -0 9 <sup>1</sup> -0 9 <sup>1</sup> -0


AREA 1: SYSTEMS 01-02 SCALE: 3/32" = 1'-0"

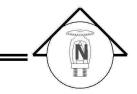

	Sprinkler Legend										
QUANTITY MANUFACTURER SIN MODEL K-FACTOR T					TYPE	SIZE	RESPONSE	FINISH	TEMPERATURE	NOTE	
	2054	VICTAULIC	V4702	FL-QR/ST/ESFR	16.8	PENDENT	3/4	FAST	BRASS	200°F	
	4	VICTAULIC	V3406	V34	8	PENDENT	3⁄4	QUICK	BRASS	200°F	
	2754	VICTAULIC	V3428	ESFR	22.4	PENDENT	1	FAST	BRASS	200°F	
	48	VIKING	VK600	MICROFAST	5.6	PENDENT	1/2	QUICK	CHROME	135°F	
	6	VIKING	VK3021		5.6	PENDENT	1/2	QUICK	CHROME	135°F	
	368	VIKING	VK504	ESFR DRY	16.8	PENDENT	3/4	QUICK	BRASS	205°F	
	TOTAL = 5234										

\*\*JOIST BRIDGING ROWS CANNOT BE ERECTED WITHIN OF 1'-6 OF ANY SURROUNDING ESFR BRANCH LINE CENTERLINE

> - AUXILIARY DRAIN SEE FP0.0 FOR DETAIL 2 - AIR VENT SEE FP0.0 FOR DETAIL

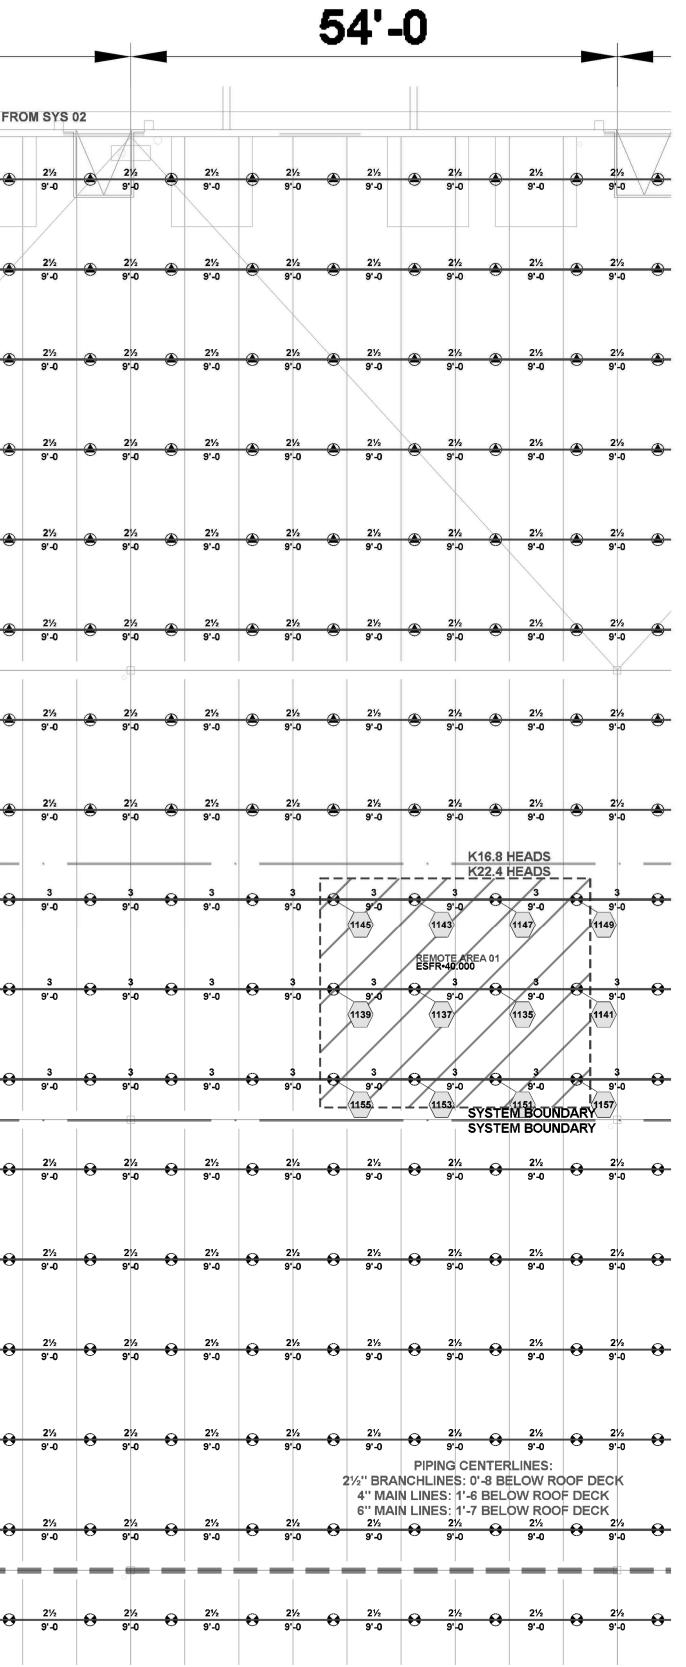



ECTURE ARCH 5719 LAWTON LOOP E. DR. #212 INDIANAPOLIS, IN 46216 O :: 317.288.0681 F :: 317.288.0753






THIS DRAWING AND THE IDEAS, DESIGNS AND CONCEPTS CONTAINED HEREIN ARE THE EXCLUSIVE INTELLECTUAL PROPERTY OF CURRAN ARCHITECTURE, AND ARE NOT TO BE USED OR REPRODUCED, WHOLE OR IN PART, WITHOUT THE WRITTEN CONSENT OF CURRAN ARCHITECTURE.


OJECT INFORMATION

LEE'S SUMMIT LOGISTICS BUILDING A LOT I NW CORNER OF NE TUDOR RD & MAIN ST LEE'S SUMMIT, MO 64086

PERMIT SET 02.18.22 09.07.22

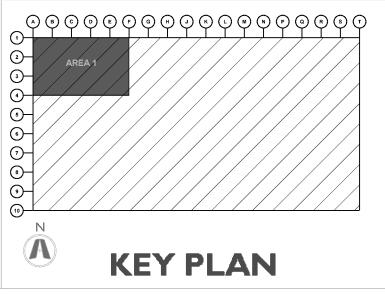


FP2.1.1 AREA 1: SYSTEMS 01-02

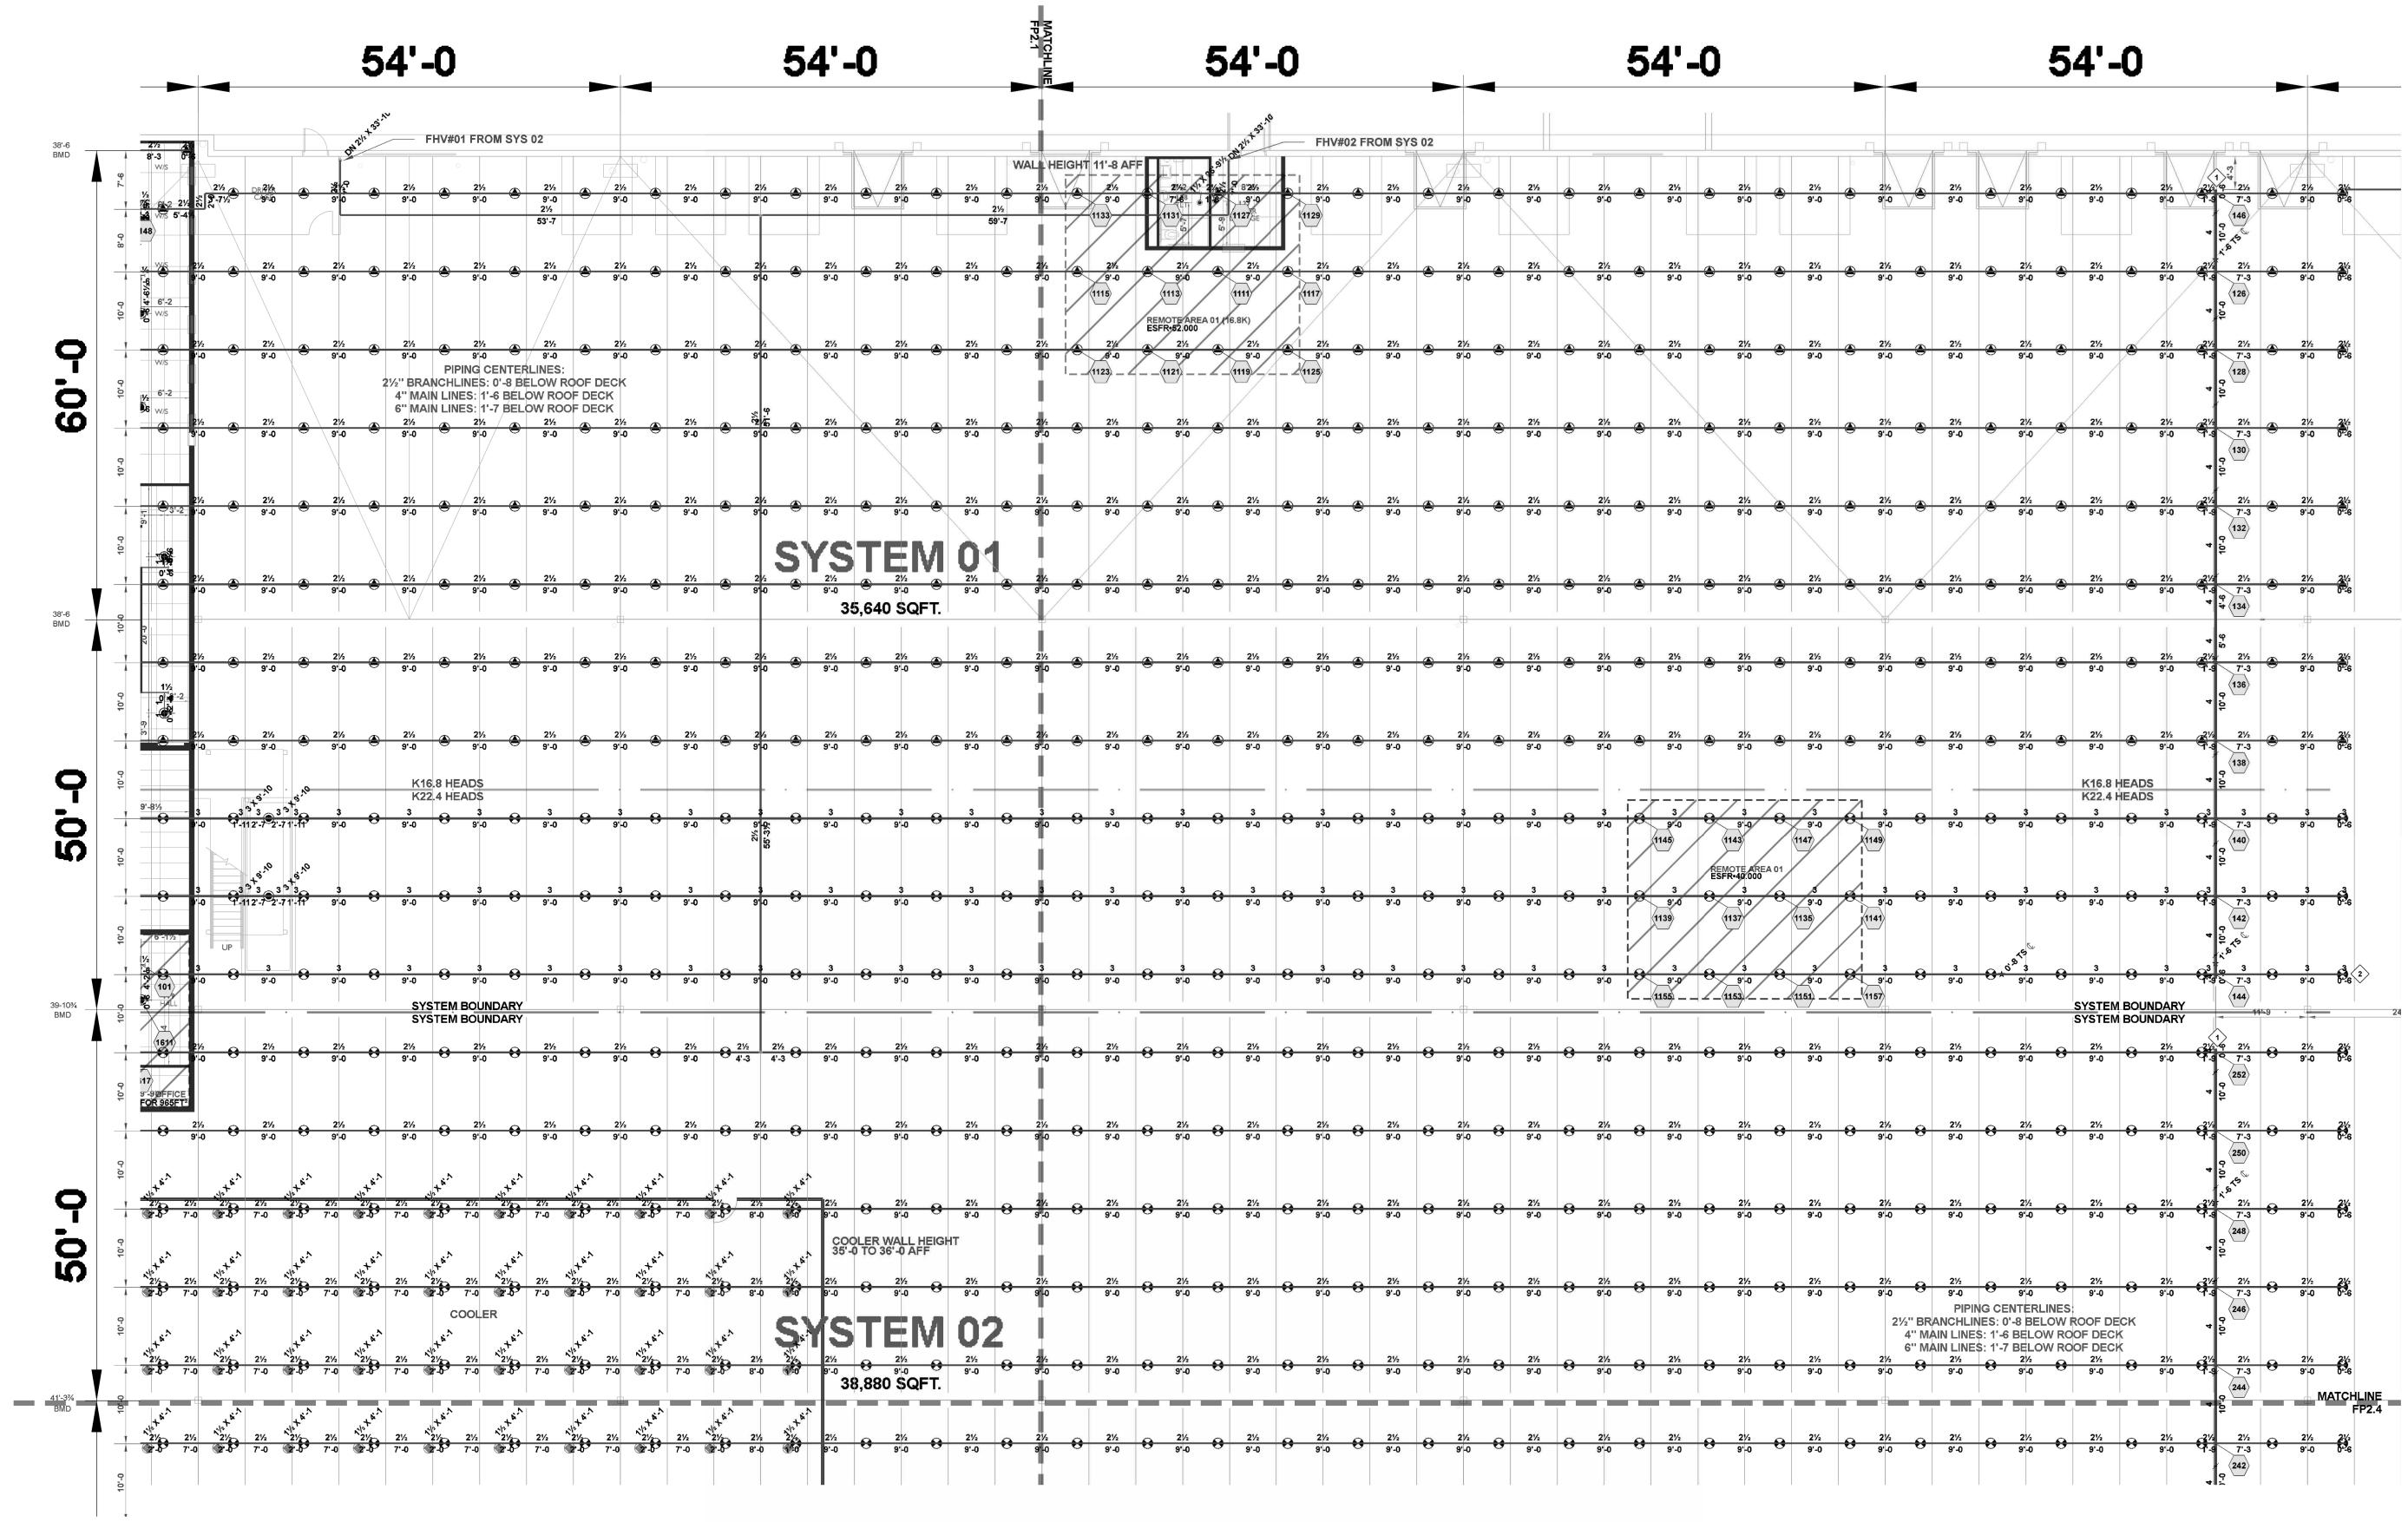

Hydraulic Information						
Remote Area 01 (K	16.8)					
OCCUPANCY CLASSIFICATION	ESFR	oc				
MIN. END HEAD PRESSURE	52.000 (ESFR)	MI				
TOTAL HOSE STREAMS	250.00	ТО				
TOTAL HEADS FLOWING	12	ТО				
K-FACTOR	16.8	K-F				
TOTAL WATER REQUIRED	1711.60	то				
TOTAL PRESSURE REQUIRED	75.095	то				
BASE OF RISER (GPM)	1711.60	BA				
BASE OF RISER (PSI)	75.095	BA				
SAFETY MARGIN (PSI)	+14.486 (16.2%)	SA				

Remote Area 01								
OCCUPANCY CLASSIFICATION	ESFR							
MIN. END HEAD PRESSURE	40.000 (ESFR)							
TOTAL HOSE STREAMS	250.00							
TOTAL HEADS FLOWING	12							
K-FACTOR	22.4							
TOTAL WATER REQUIRED	1959.70							
TOTAL PRESSURE REQUIRED	68.043							
BASE OF RISER (GPM)	1959.70							
BASE OF RISER (PSI)	68.043							
SAFETY MARGIN (PSI)	+19.427 (22.2%)							

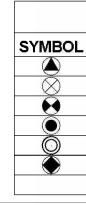

 $\triangle$ AREA 1 (CONT.): SYSTEMS 01 SCALE: 3/32" = 1'-0"

-02	

	Sprinkler Legend											
L QUANTITY MANUFACTURER SIN MODEL K-FACTOR TY				TYPE	SIZE	RESPONSE	FINISH	TEMPERATURE	NOTE			
	2054	VICTAULIC	V4702	FL-QR/ST/ESFR	16.8	PENDENT	3/4	FAST	BRASS	200°F		
	4	VICTAULIC	V3406	V34	8	PENDENT	3/4	QUICK	BRASS	200°F		
	2754	VICTAULIC	V3428	ESFR	22.4	PENDENT	1	FAST	BRASS	200°F		
	48	VIKING	VK600	MICROFAST	5.6	PENDENT	1/2	QUICK	CHROME	135°F		
	6	VIKING	VK3021		5.6	PENDENT	1/2	QUICK	CHROME	135°F		
	368	VIKING	VK504	ESFR DRY	16.8	PENDENT	3/4	QUICK	BRASS	205°F		
	TOTAL = 5234											

- AUXILIARY DRAIN SEE FP0.0 FOR DETAIL 2 - AIR VENT SEE FP0.0 FOR DETAIL



:11 9 LAWTON LOOP E. DR. #212 INDIANAPOLIS, IN 46216 O :: 317.288.0681 F :: 317.288.0753



 $\sim$ / MICHELLE A. \* LOPEZ NUMBER PE-2022007904 THIS DRAWING AND THE IDEAS, DESIGNS

AND CONCEPTS CONTAINED HEREIN ARE THE EXCLUSIVE INTELLECTUAL PROPERTY OF CURRAN ARCHITECTURE, AND ARE NOT TO BE USED OR REPRODUCED, WHOLE OR IN PART, WITHOUT THE WRITTEN CONSENT OF CURRAN ARCHITECTURE.

OIECT INFORMATION


LEE'S SUMMIT LOGISTICS BUILDING A LOT I NW CORNER OF NE TUDOR RD & MAIN ST LEE'S SUMMIT, MO 64086


ISSUE DATES PERMIT SET 02.18.22 1 TENANT IMPROVEMENT 09.07.22

\*\*JOIST BRIDGING ROWS CANNOT BE ERECTED WITHIN OF 1'-6 OF ANY SURROUNDING ESFR BRANCH LINE CENTERLINE

(2)-AREA <u>\_</u> <u>(</u>)-(10)- $(\mathbf{A})$ **KEY PLAN** 



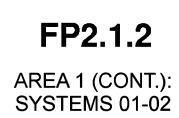

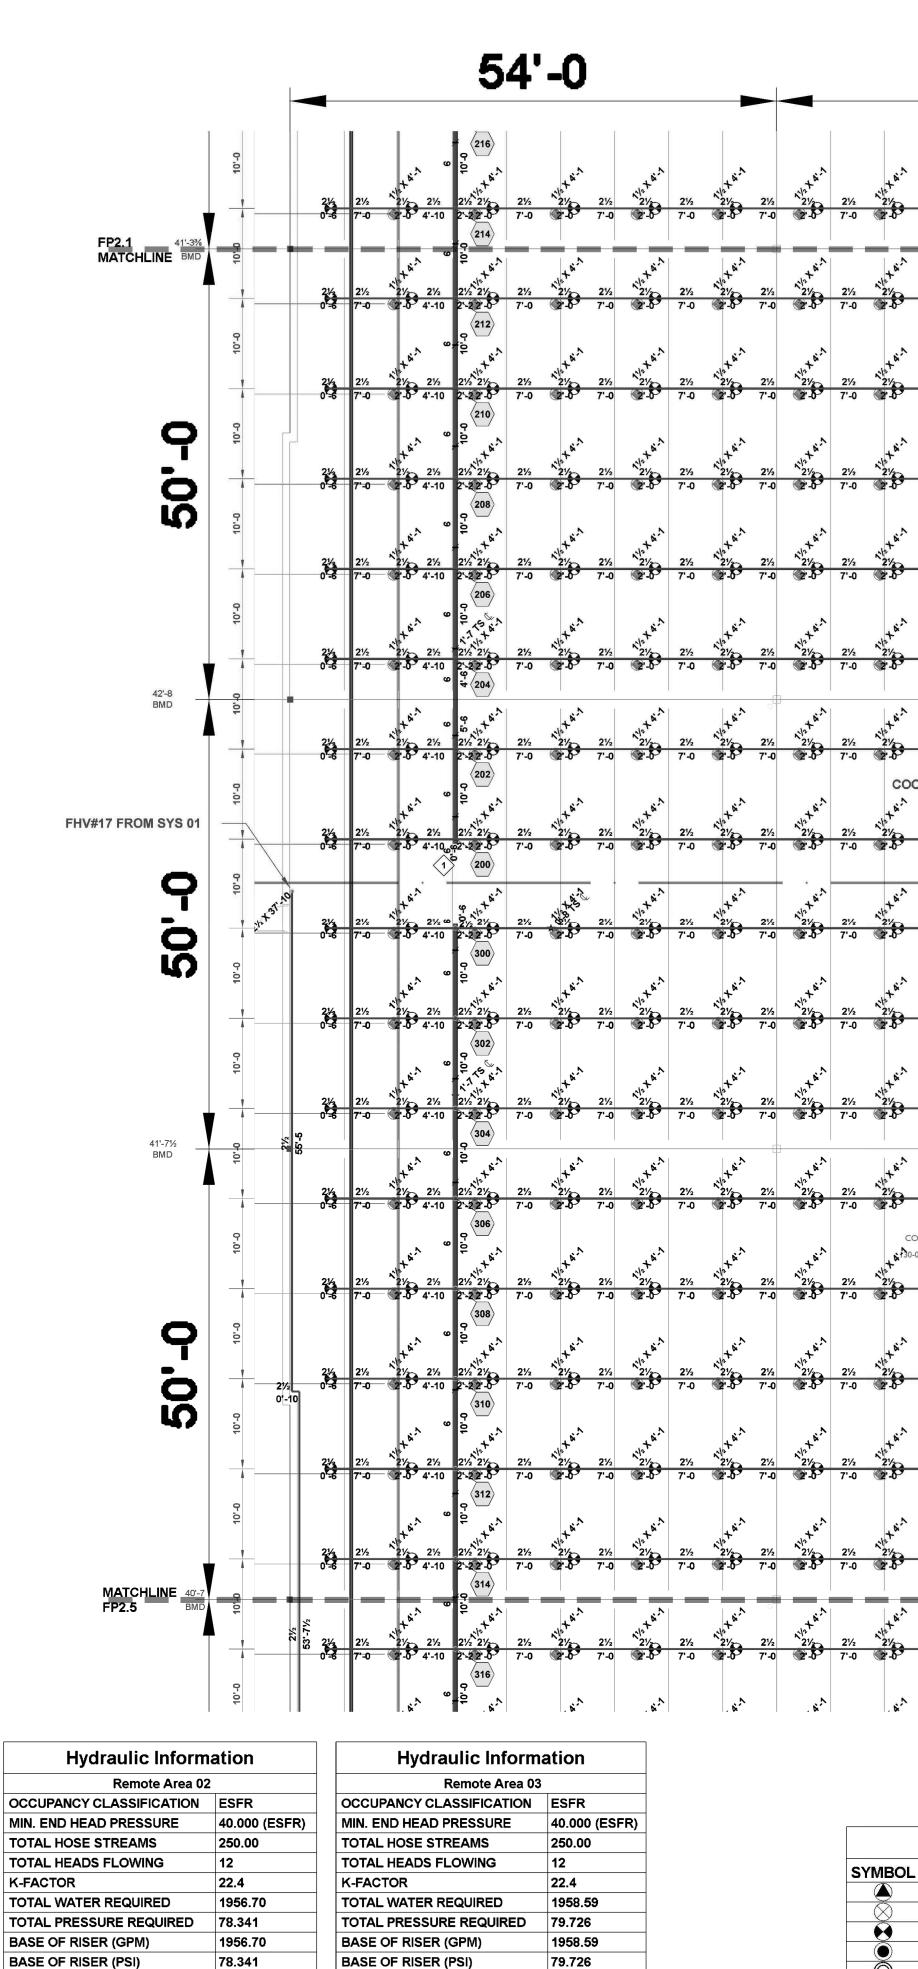

BASE OF RISER (PSI)

SAFETY MARGIN (PSI)

+9.156 (10.5%)

SAFETY MARGIN (PSI)

+7.754 (8.9%)

54'-0

54'-0

54'-0

J4 -U ►						<> →																							
2½ 7'-0	121 A	<u>2½</u> 7'-0	1/2 1/2 1/2 1/2 1/2 1/2 1/2 1/2 1/2 1/2	2½ 7'-0	1/2 / 1/2 /	2½	×121 ×1	2½ 7'-0	1/21/2 21/2 2-0-	2½ 7'-0	12 1 1 1 1 1 1 1 1 1 1 1 1 1 1 1 1 1 1	2½ 8'-0	State	21/2 9'-0	5		SQFT.	<b>0</b> 2½ 9'-0	2	2½ 9'-0	8	<u>2½</u> 9'-0	8	2½	8	<u>2½</u> 9'-0		2½ 9'-0	0
			1 a .^				1 <sup>1</sup>				1. <sup>1</sup>	-			38,	880	SQFT.				_								-
2½ 7'-0	1/2 / 2/2 2/2 2/2	2½ 7'-0	**************************************	2½ 7'-0	1/21/2 21-0	2½ 7'-0	N1/21/20	2½ 7'-0	121/2 2-03	2½ 7'-0	**************************************	2½ 8'-0	12 12 12 12 12 12 12 12 12 12 12 12 12 1	2½ 9'-0			2½ '-0	2½ 9'-0	8	21/2 9 MA	8	2½ 9'-0	0	2½ 9'-0	8	2½ 9'-0		2½ 9'-0	8
21/2	11/2 t 4:-1 21/2	21/2	11/2 × 20	<b>2½</b>	11/1 tain 21/2	21/2	11/2 × 21/2	21/2	11/2 21/2 2-0	21/2	1/21/20	21/2	21/3	2½		<b>a</b> 2		21/2		→FP2.4 →MATCHLINE		21/2		21/2		2½		21/2	•
7'-0	<del>ه</del> -۶ <sup>9</sup>	7'-0	(2°-0-5)	7'-0	Nat and	7'-0	.5°			7'-0	_6 <sup>*</sup> ,	8'-0	<b>1</b> 0	9'-0		<u>و</u> و	r-0 •	9'-0		9'-0	4"	BRANCI MAIN L	INES: 1	: 0'-8 B '-6 BEL	ELOW	9'-0 S: / ROOF OOF DE OOF DE	DECK	9'-0	0
2½ 7'-0	121/2 -0	2½ 7'-0	11/1 21/2 21-0	2½ 7'-0	N <sup>1/2</sup> 21/2 2'-0	2½ 7'-0	x1/2 21/2	2½ 7'-0	1 <sup>1</sup> / <sub>2</sub>	2½ 7'-0	N <sup>1</sup> <sup>1</sup> 21/2 2-0	2½ 8'-0	12200	2½ 9'-0		9 <u>:</u>	2½ Y-0	2½ 9'-0	8	2½ 9'-0	8	2½ 9'-0	<del>0</del>	-/ DEL 2½ 9'-0	8	2½ 9'-0		2½ 9'-0	8
2½ 7'-0	N121/20	2½ 7'-0	1/21/2 21/2 21/2	2½ 7'-0	121/2 21/2	2½ 7'-0	1 <sup>1/2</sup> 2 <sup>1/2</sup>	272	1/2 /2 /2 /2 /2 /2 /2 /2 /2 /2 /2 /2 /2 /	<u>2½</u> 7'-0	1/21/2 2.0	2½ 8'-0	12/3 2/3	2½ 9'-0			21/2	2½ 9'-0	0	2½ 9'₌0	8	2½ 9'-0	8	2½ 9'-0		2½ 9'-0		2½ 9'-0	8
	121/20		. + Å.^		a la tain		+4.1		11/2 × 21/2		tein		11/2 A A A		8														
2½ 7'-0	×12 21/2	2½ 7'-0	21/2 21-0	2½ 7'-0	21/2	2½ 7'-0	21/2 2-5	2½ 7'-0	21/2 2-0	2½ 7'-0	21/2 2-0	2½ 8'-0	21/2 10-0	2½ 9'-0		8 i	2½ '-0	2½ 9'-0	8	2½ 9'-0	-8	2½ 9'-0	8	2½ 9'-0	8	2½ 9'-0 2129	2127		
2½ 7'-0	1/2 + 4 · · · · · · · · · · · · · · · · · ·	2½ 7'-0	121/2 21-0	2½ 7'-0	×1/2 21/2	2½ 7'-0	11/2 -0	2½ 7'-0	11/1 Ai.A	2½ 7'-0	11/2 1/2 21/2 2-0	2½ 8'-0	12/3 2/3	2½ 9'-0	•	Contraction of the local distance of the loc	2½ '-0	2½ 9'-0	8	21⁄2 9'-0	-9	2½ 9'-0	8	2½ 9'-0	8	<u>21/2</u> 9'-0		AREA 02 .000 21/2	0
OOLEF	n'stain		alle tain		N'Int an		N/2 think		a la tain		NIP T AL		n'stan												2	121	2119		2
2½ 7'-0	27/2 @2-5	7'-0	21/2	2½ 7'-0	21/2	2½ 7'-0	21/2	2½ 7'-0	21/2	2½ 7'-0	21/2	2½ 8'-0	21/2	_	STE			2½ 9'-0	8	21⁄2 9'-0		2½ 9'-0	0	2½ 9'-0	2	2½ 9'-0 2113		2½ 3'0	2
2½ 7'-0	1/21/A	2½ 7'-0	11/2 × 0	2½ 7'-0	11/2 / 0 2-0	21/2	1 <sup>1/2</sup> 21/2 22-50	- 7	11/21/2	2½ 7'-0	14 1 1 1 1 1 1 1 1 1 1 1 1 1 1 1 1 1 1 1	21/2 8'-0	23 3617	2½ 9'-0				2½ 9'-0	8	2½ 9'-0	-9	2½ 9'-0	8	2½ 9'-0	6	21/ 9'-0 9115		21/2	8
21/2	1/2 t à 21/2	21/2	1/2 / A	21/2	1/2 /2 21/2	21/2	21/20	OLER R•52.000 2½	311 0010 1121/2	303 3 21/2	3611 101 3611 101 + A 101 +	21/2	321 321	2½			21/2 0	21/2		21⁄2	0	21/2	0	21/2	2	21/2	REMO ESFR•	TE AREA 40.000 21/2	.03
7'-0	<u>م</u>	7'-0	<u>م.</u> ه	7'-0	@ <u>-</u> 8 <sup>-</sup>	319	3631 47	317	3619 325			8'-0 32	29 3621 327	9'-0			r'-0 ••	9'-0		9'-0	0	9'-0		9'-0     	3	9/-0 123	3121	9'-0	
2½ 7'-0	121/2 -0	2½ 7'-0	21/2 2'-0	2½ 7'-0	1/21/2 21-0	2½ 7'-0	21-0 9-0 9-0	2½ 7'-0 335	+ <sup>1</sup> / <sub>2</sub> 2-0 3625	21/2 7'-0 333	21/2 3623	21/2 8'-0	343 341 341	2½ 9'-0	•		2½ '-0	2½ 9'-0	8	2½ 9'-0	-9	2½ 9'-0	8	2½   9'-0   _	2	2½ 9'-0 129		2½ 9'-0	
2½ 7'-0	1/21/21/2	2½ 7'-0	1/2 /2 /2 /2 /2 /2 /2 /2 /2 /2 /2 /2 /2 /	2½ 7'-0	1/2 / 1/2 /	21/2	121/2 121/2 2.0	21/2	139 139 14 12 1/2 2 2 -0	2½ 7'-0	31 +*** **** ****	21/2	22/3	2½ 9'-0			21/2	2½ 9'-0	8	2½ 9'-0	-8	2½ 9'-0	8	2½ 9'-0	8			2½ 9'-0	
COOLER 30-0X240-0		/~	+		, + <sup>à</sup> ,		+0.1	/-0	, + <sup>à, 1</sup>	7-0	+41.7		. + <sup>6</sup>			c		3-0				3-0				5-0			
2½ 7'-0	21/2 21/2 21/2	2½ 7'-0	21/2	2½ 7'-0	21/2	2½ 7'-0		2½ 7'-0	21/2 21/2 2 - 0	2½ 7'-0	21/2 2-0	2½ 8'-0	2%	2½ 9'-0	•		2 <sup>1</sup> / <sub>2</sub> 1'-0	2½ 9'-0	8	2½ 9'≟0	9	2½ 9'-0	8	2½ 9'-0	8	<u>2½</u> 9'-0		2½ 9'-0	8
2½ 7'-0	11/2 / A A A A A A A A A A A A A A A A A A	2½ 7'-0	121/20 21-0	2½ 7'-0	N1/21/2	2½ 7'-0	1/2 / A	21/2	14:1 21/2 2-0	2½ 7'-0	121/2 A	2½ 8'-0	21/2 1/2	2½ 9'-0		<del>ر</del> و		<b>0</b> 2½ 9'-0	3 8	2½ 9'-0		2½ 9'-0	0	2½ 9'-0	8	2½ 9'-0		2½ 9'-0	8
	NIZ TAIN		Not ain		xite an		rut ain		NIA AN		Not and		it and		38,		SQFT.			I									
2½ 7'-0	2½ © 5	2½ 7'-0	21/2	2½ 7'-0	2½ 2'-5	2½ 7'-0	21/2	7'-0	2½ 2-5	<u>2½</u> 7'-0	21/2	<u>21/2</u> 8'-0	2/2	2½ 9'-0 C(		<b>9</b> 8		2½ 9'-0	8	2½ 9'-0	9	2½ 9'-0	0	2½ 9'-0	8	2½ 9'-0		<u>2½</u> 9'-0	8
2½ 7'-0	121/2 21/2 21/2	2½ 7'-0	1/1 + 4 · · · · · · · · · · · · · · · · · ·	2½ 7'-0	1/2 21/2 2-0	2½ 7'-0	121/2 22-0	21/2	1 <sup>1/2</sup> 2'-0	2½ 7'-0	11/2 1/2 1/2 1/2 1/2 1/2 1/2 1/2 1/2 1/2	2½ 8'-0	1/2 /2 1/2 1/2 1/2 1/2 1/2 1/2	2½ 9'-0				<u>2½</u> 9'-0	8	2½ 9'-0	-9	2½ 9'-0	8	2½ 9'-0	8	2½ 9'-0		2½ 9'-0	8
21/2	121/20	21/2	N/2 1/20	21/2	1/2 × 21/2	21/2	11/2 1/2	21/2	1 <sup>1/2</sup>	21/2	11/2 1/2	21/2	22/2	21/2			21/2	21/2		21/2		21/2		21/2		21/2		21/2	
7'-0	<u>م</u> .»	7'-0	@-6 <sup>3</sup>	7'-0	@2-5 <sup>2</sup>	7'-0	(2-5) . k <sup>*</sup>	7'-0	· 6.1	7'-0	(2-5°	8'-0	<b>*</b> 0	9'-0			r-0	9'-0		9'-0	0	9'-0	0	9'-0	0	9'-0	<u> </u>	9'-0	
							REA 2	2: 5)	(STF	EMS	02-0	)3			/	Canada and											ging Ro Urroun		

AREA 2: SYSTEMS 02-03 SCALE: 3/32" = 1'-0"

Sprinkler Legend SYMBOL QUANTITY MANUFACTURER SIN MODEL K-FACTOR TYPE SIZE RESPONSE FINISH TEMPERATURE NOTE 2054 VICTAULIC V4702 FL-QR/ST/ESFR 16.8 PENDENT 34 FAST BRASS 200°F 4 VICTAULIC V3406 V34 8 PENDENT 34 QUICK BRASS 200°F 2754 VICTAULIC V3428 ESFR 22.4 PENDENT 1 FAST BRASS 200°F 48 VIKING VK600 MICROFAST 5.6 PENDENT 1/2 QUICK CHROME 135°F 6 VIKING VK3021 5.6 PENDENT 1/2 QUICK CHROME 135°F 368 VIKING VK504 ESFR DRY 16.8 PENDENT 3/4 QUICK BRASS 205°F TOTAL = 5234

\_4 🔊 >

- AUXILIARY DRAIN SEE FP0.0 FOR DETAIL

- AIR VENT SEE FP0.0 FOR DETAIL



СU ECTURE ARCH 5719 LAWTON LOOP E. DR. #212 INDIANAPOLIS, IN 46216 O :: 317.288.0681 F :: 317.288.0753





THIS DRAWING AND THE IDEAS, DESIGNS AND CONCEPTS CONTAINED HEREIN ARE THE EXCLUSIVE INTELLECTUAL PROPERTY OF CURRAN ARCHITECTURE, AND ARE NOT TO BE USED OR REPRODUCED, WHOLE OR IN PART, WITHOUT THE WRITTEN CONSENT OF CURRAN ARCHITECTURE.


OJECT INFORMATION

LEE'S SUMMIT LOGISTICS **BUILDING A LOT I** NW CORNER OF NE TUDOR RD & MAIN ST LEE'S SUMMIT, MO 64086

ISSLIF DATE PERMIT SET 02.18.22 09.07.22




FP2.2.1 AREA 2: SYSTEM 02-03

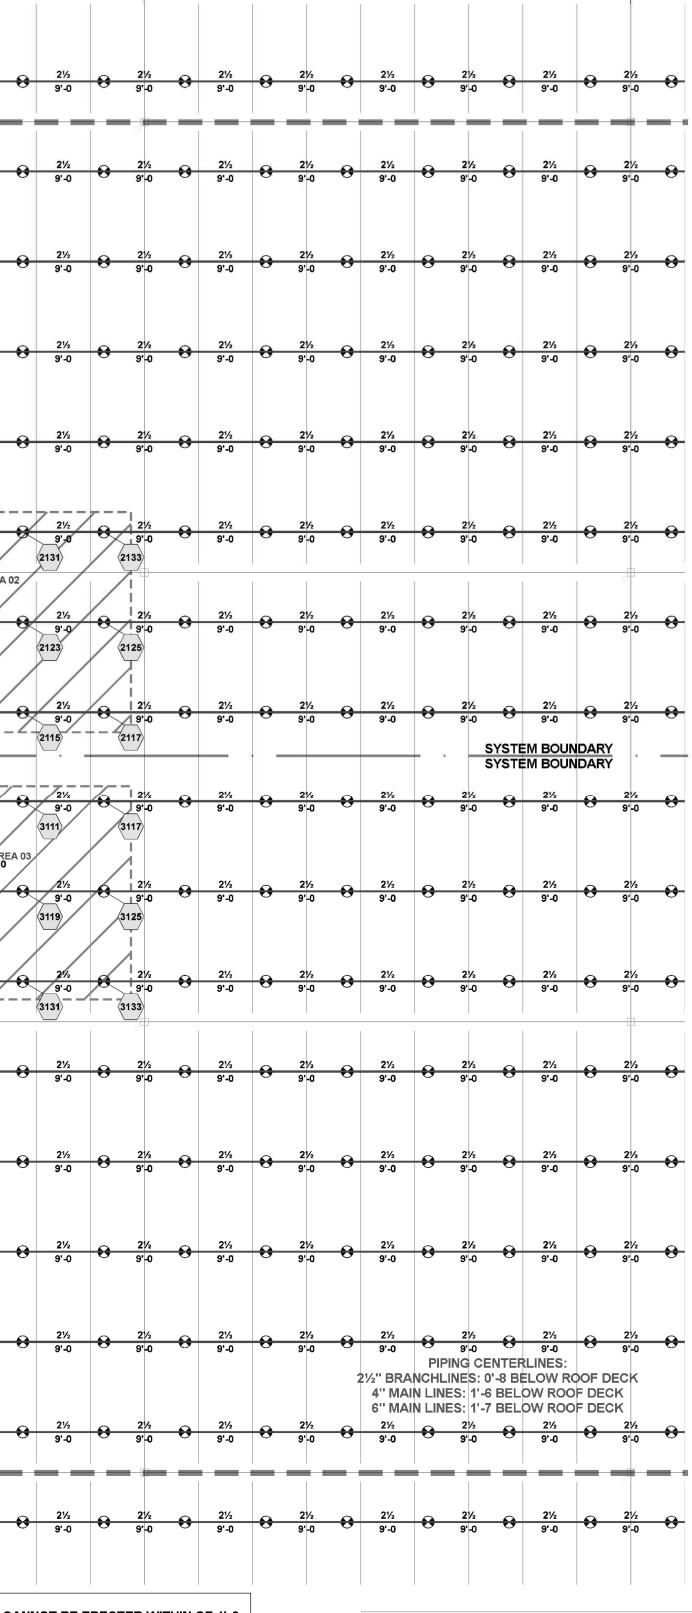


54'-0

CANNOT BE ERECTED WITHIN OF 1'-6 OF ANY SURROUNDING ESFR BRANCH LINE CENTERLINE

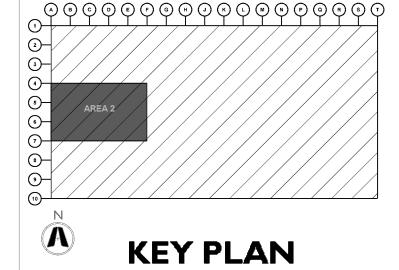




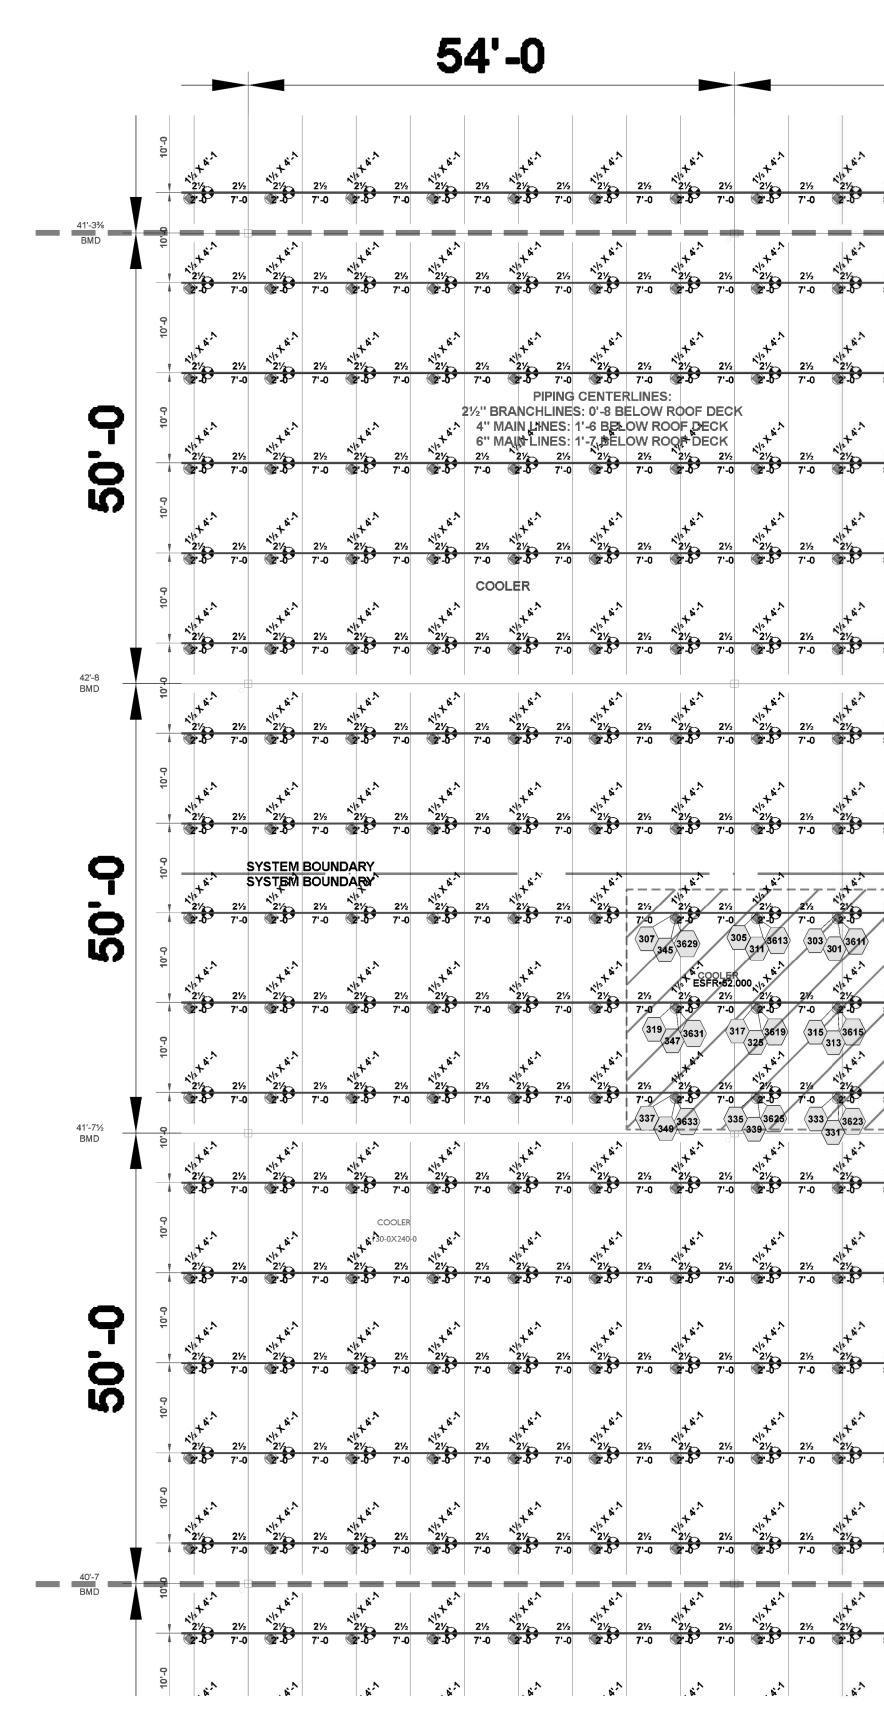

Hydraulic Information							
Remote Area 02							
OCCUPANCY CLASSIFICATION	ESFR						
MIN. END HEAD PRESSURE	40.000 (ESFR)						
TOTAL HOSE STREAMS	250.00						
TOTAL HEADS FLOWING	12						
K-FACTOR	22.4						
TOTAL WATER REQUIRED	1956.70						
TOTAL PRESSURE REQUIRED	78.341						
BASE OF RISER (GPM)	1956.70						
BASE OF RISER (PSI)	78.341						
SAFETY MARGIN (PSI)	+9.156 (10.5%)						

[							
Hydraulic Information							
Remote Area 03							
OCCUPANCY CLASSIFICATION	ESFR						
MIN. END HEAD PRESSURE	40.000 (ESFR)						
TOTAL HOSE STREAMS	250.00						
TOTAL HEADS FLOWING	12						
K-FACTOR	22.4						
TOTAL WATER REQUIRED	1958.59						
TOTAL PRESSURE REQUIRED	79.726						
BASE OF RISER (GPM)	1958.59						
BASE OF RISER (PSI)	79.726						
SAFETY MARGIN (PSI)	+7.754 (8.9%)						
	·						

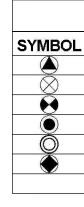


54'-0 54'-0 54'-0 SYSTEM 02 <sup>-</sup>38,880 <sup>\$</sup>QFT. 9'-0 9'-0 COOLER WALL HEIGHT 35'-0 TO 36'-0 AFF 9'-0 REMOTE AREA 02 ESFR•40.000 9'-0 9'-0 - 2113 - 2 9'-0 2<sup>1</sup>/<sub>2</sub> 2<sup>1</sup> 9'-0 9'-0 REMOTE AREA 03 ESFR•40.000 9'-0 9'-0 9'-0 3129 3129 9'-0 3127 3131 3133 9'-0 9'-0 9'-0 9'-0 9'-0 9'-0 9'-0 9'-0 9'-0 9'-0 9'-0 9'-0 9'-0 9'-0 9'-0 9'-0 9'-0 9'-0 38,880 SQFT. 9'-0 9'-0 9'-0 9'-0 9'-0 9'-0 9'-0 9'-0 9'-0 COOLER WALL HEIGHT 35'-0 TO 36'-0 AFF

AREA 2(CONT): SYSTEMS 02-03 SCALE: 3/32" = 1'-0"

OF ANY SURROUNDING ESFR BRANCH LINE CENTERLINE

				Sprin	kler Legen	nd					
L	QUANTITY	MANUFACTURER	SIN	MODEL	K-FACTOR	TYPE	SIZE	RESPONSE	FINISH	TEMPERATURE	NOTE
	2054	VICTAULIC	V4702	FL-QR/ST/ESFR	16.8	PENDENT	3/4	FAST	BRASS	200°F	
	4	VICTAULIC	V3406	V34	8	PENDENT	3/4	QUICK	BRASS	200°F	
	2754	VICTAULIC	V3428	ESFR	22.4	PENDENT	1	FAST	BRASS	200°F	
	48	VIKING	VK600	MICROFAST	5.6	PENDENT	1/2	QUICK	CHROME	135°F	
	6	VIKING	VK3021		5.6	PENDENT	1/2	QUICK	CHROME	135°F	
	368	VIKING	VK504	ESFR DRY	16.8	PENDENT	3/4	QUICK	BRASS	205°F	
	TOTAL = 5234										




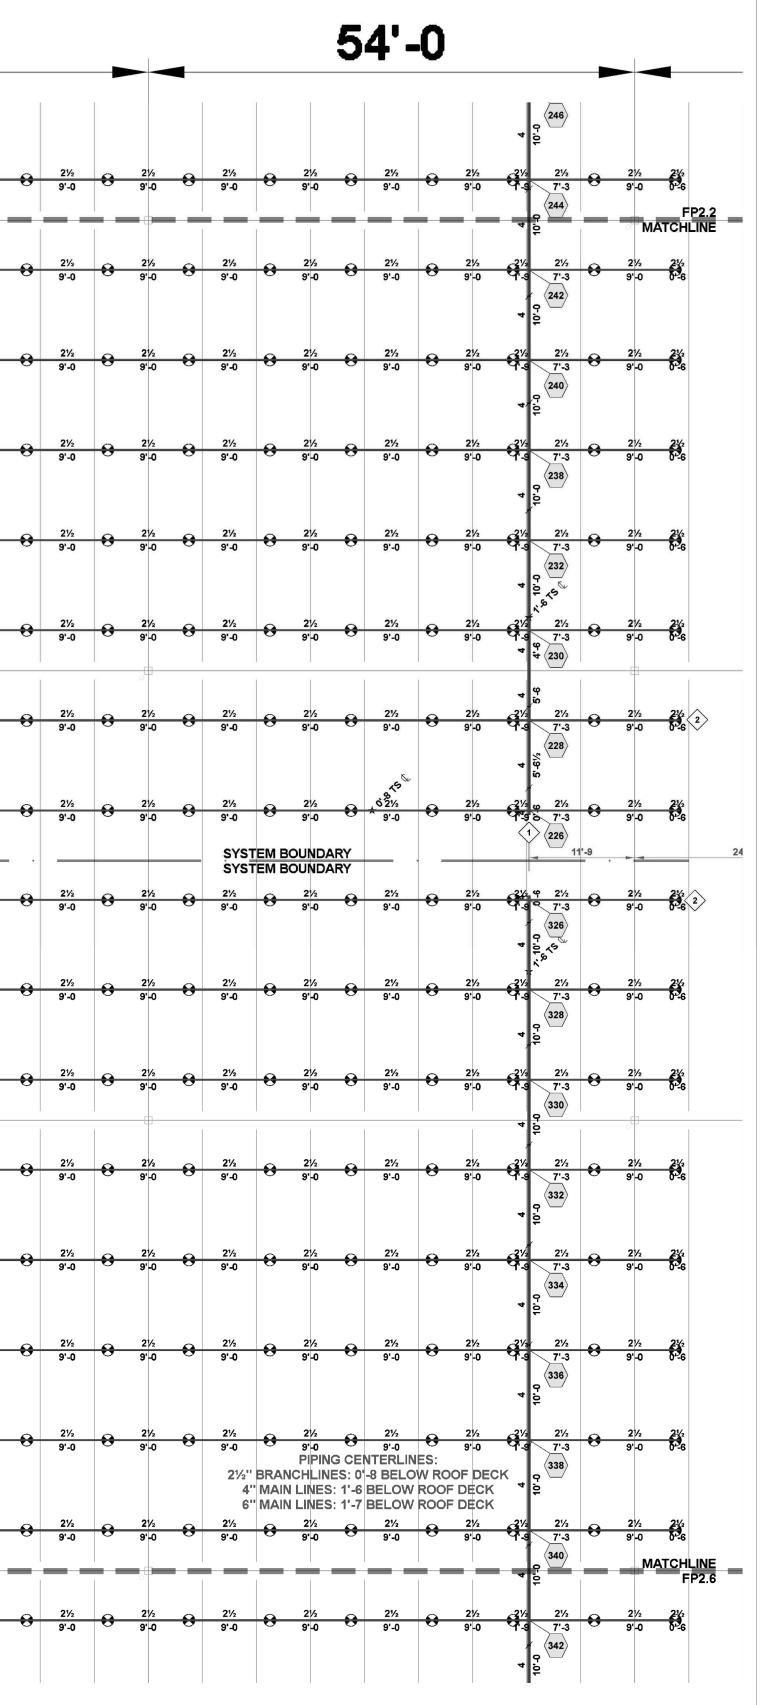

\*\*JOIST BRIDGING ROWS CANNOT BE ERECTED WITHIN OF 1'-6

ႍၜၜၜၜၜၜၜၜၜၜၜၜၜၜၜၜ  $( \mathbf{A} )$ <u>\_</u> AREA 2 (CONT. 6 **KEY PLAN** 

210300 FP2.2.2

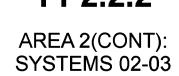








THIS DRAWING AND THE IDEAS, DESIGNS AND CONCEPTS CONTAINED HEREIN ARE THE EXCLUSIVE INTELLECTUAL PROPERTY OF CURRAN ARCHITECTURE, AND ARE NOT TO BE USED OR REPRODUCED, WHOLE OR IN PART, WITHOUT THE WRITTEN CONSENT OF

CURRAN ARCHITECTURE. OIECT INFORMATION

LEE'S SUMMIT LOGISTICS **BUILDING A LOT I** NW CORNER OF NE TUDOR RD & MAIN ST LEE'S SUMMIT, MO 64086

ISSUE DATES PERMIT SET 02.18.22 09.07.22 

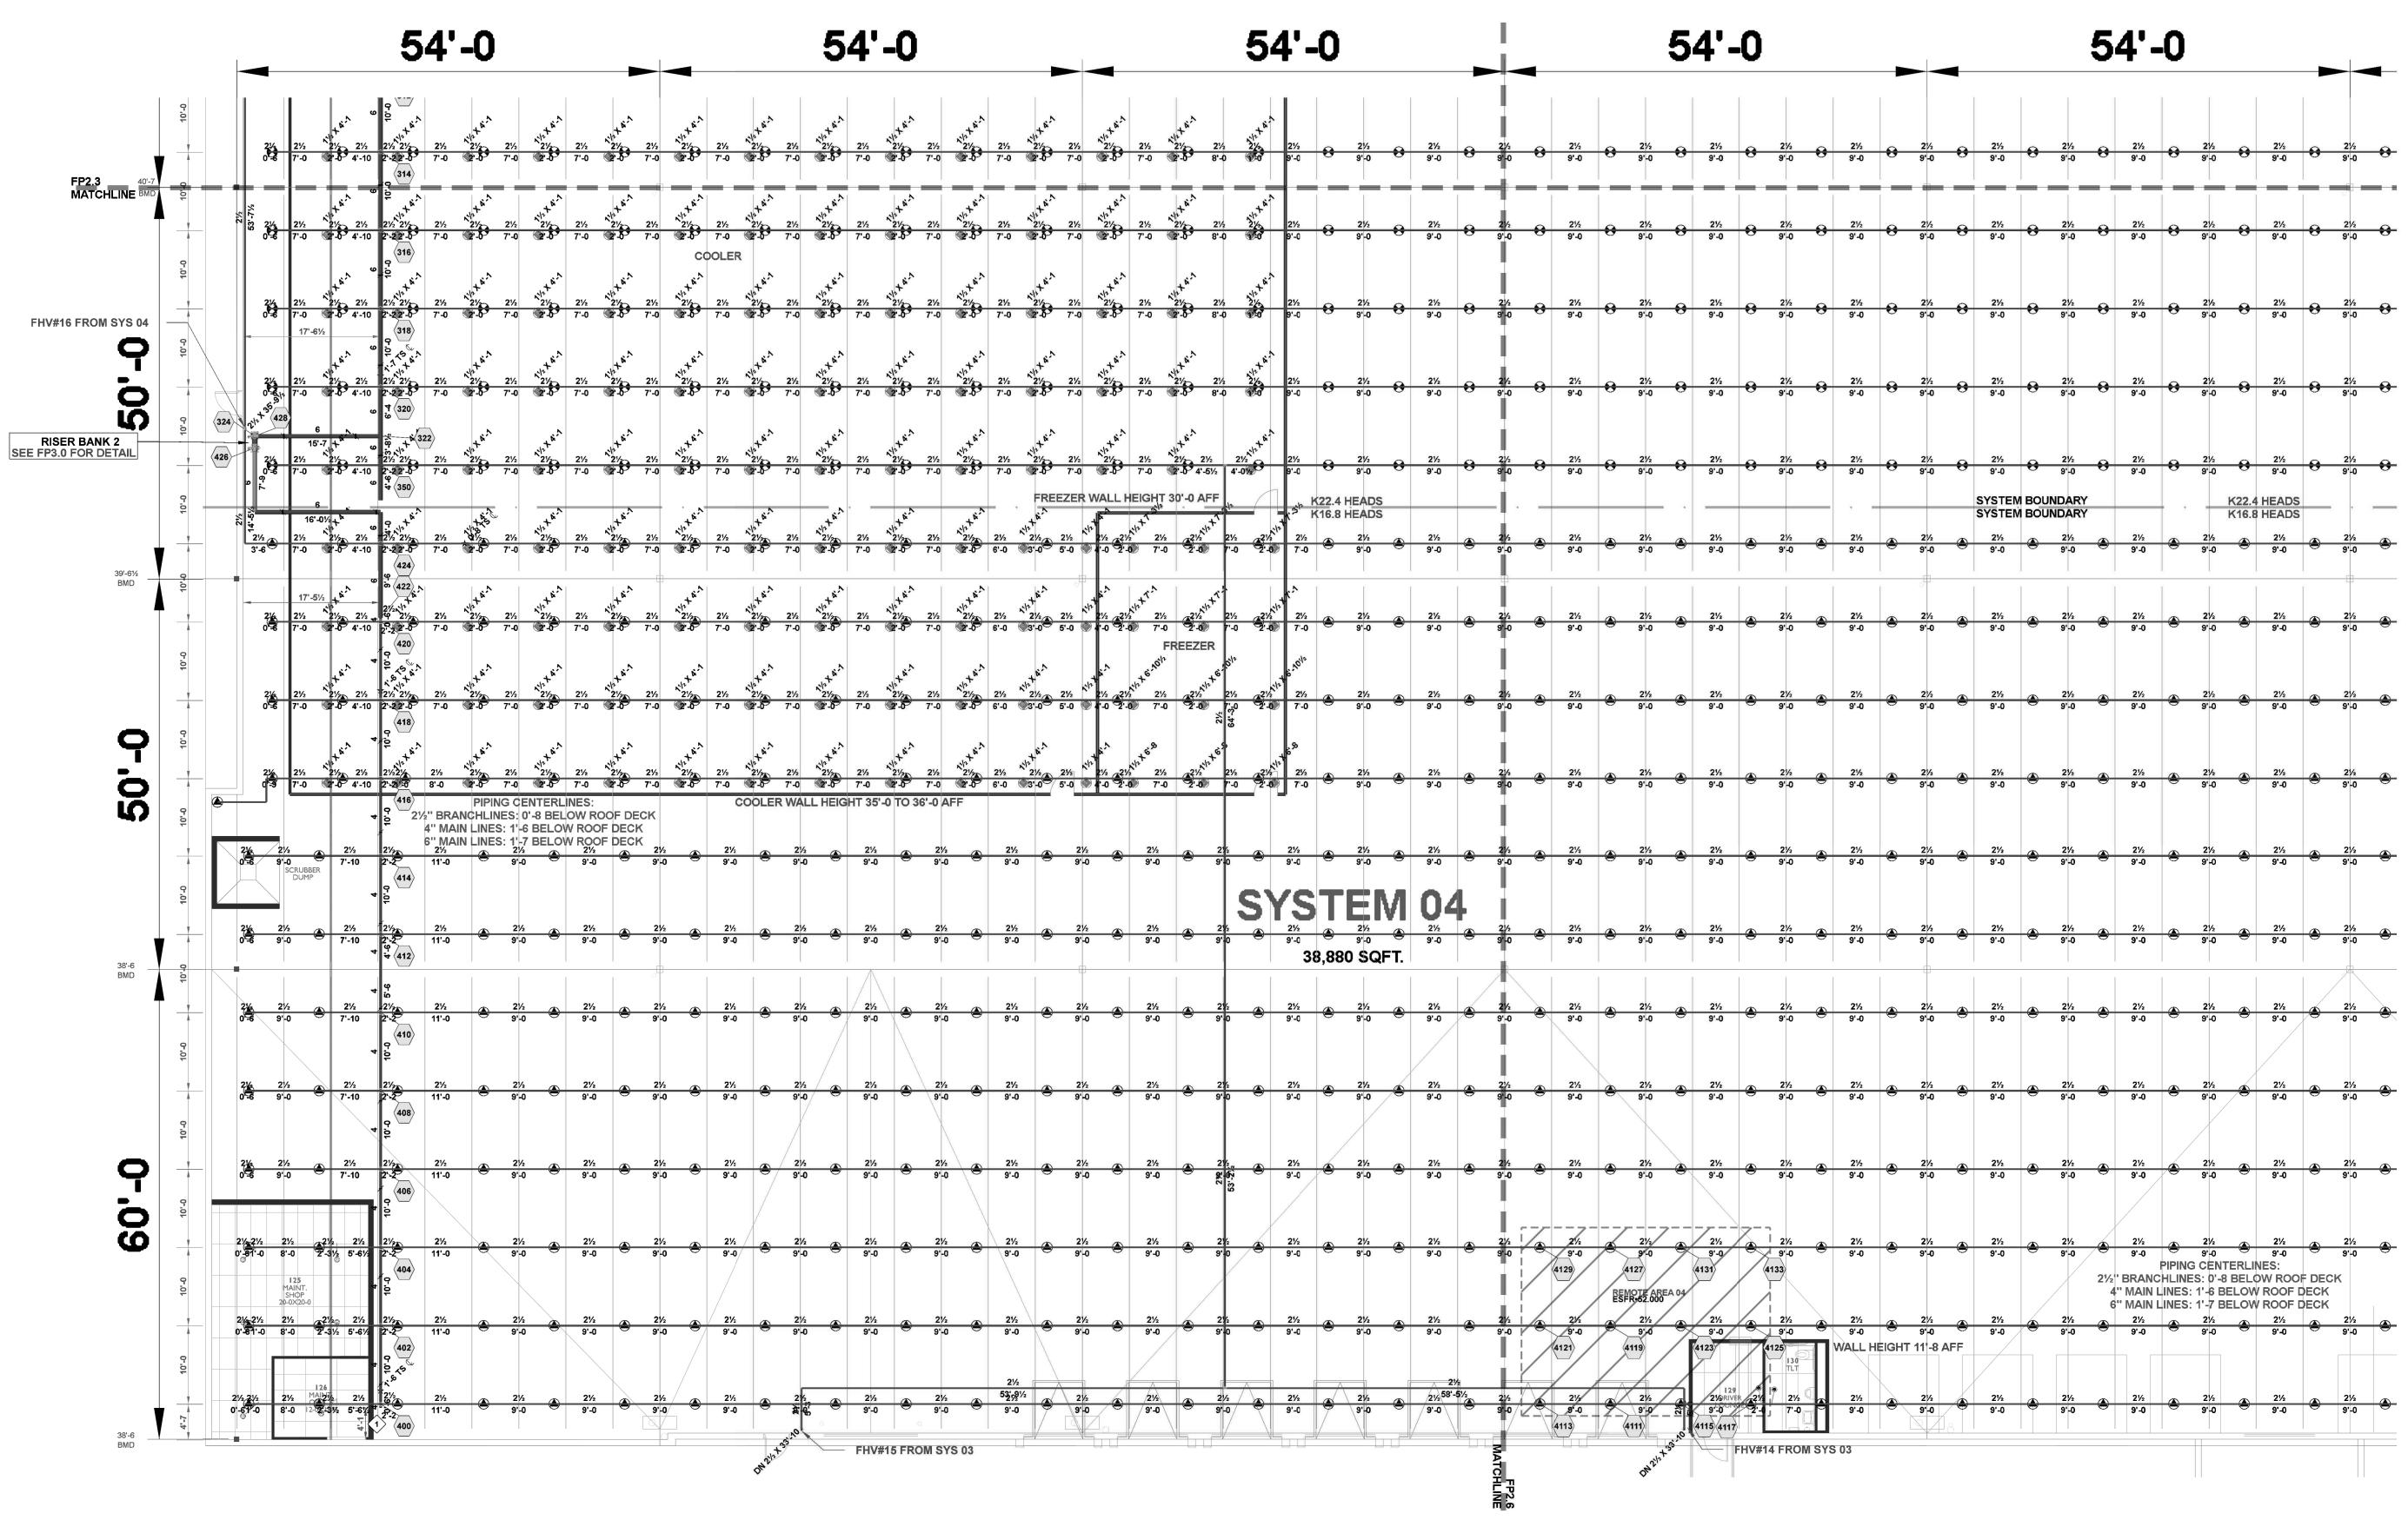

Remote Area 04	
OCCUPANCY CLASSIFICATION	ESFR
MIN. END HEAD PRESSURE	52.000 (ESFR)
TOTAL HOSE STREAMS	250.00
TOTAL HEADS FLOWING	12
K-FACTOR	16.8
TOTAL WATER REQUIRED	1708.55
TOTAL PRESSURE REQUIRED	80.726
BASE OF RISER (GPM)	1708.55
BASE OF RISER (PSI)	80.726
SAFETY MARGIN (PSI)	+8.879 (9.9%)

C

	1	$ \land $	
		arneghannand (	
<u> </u>			
	1		

	Sprinkler Legend										
L	QUANTITY	MANUFACTURER	SIN	MODEL	K-FACTOR	TYPE	SIZE	RESPONSE	FINISH	TEMPERATURE	NOTE
	2054	VICTAULIC	V4702	FL-QR/ST/ESFR	16.8	PENDENT	3/4	FAST	BRASS	200°F	
	4	VICTAULIC	V3406	V34	8	PENDENT	3/4	QUICK	BRASS	200°F	
	2754	VICTAULIC	V3428	ESFR	22.4	PENDENT	1	FAST	BRASS	200°F	
	48	VIKING	VK600	MICROFAST	5.6	PENDENT	1/2	QUICK	CHROME	135°F	
	6	VIKING	VK3021		5.6	PENDENT	1/2	QUICK	CHROME	135°F	
	368	VIKING	VK504	ESFR DRY	16.8	PENDENT	3/4	QUICK	BRASS	205°F	
	TOTAL = 5234										
	TOTAL = 5234								12		

AREA 3: SYSTEMS 03-04

SCALE: 3/32" = 1'-0"





5719 LAWTON LOOP E. DR. #212 INDIANAPOLIS, IN 46216 O :: 317.288.0681 F :: 317.288.0753



✓ MICHELLE A. \* LOPEZ NUMBER PE-2022007904


THIS DRAWING AND THE IDEAS, DESIGNS AND CONCEPTS CONTAINED HEREIN ARE THE EXCLUSIVE INTELLECTUAL PROPERTY OF CURRAN ARCHITECTURE, AND ARE NOT TO BE USED OR REPRODUCED, WHOLE OR IN PART, WITHOUT THE WRITTEN CONSENT OF CURRAN ARCHITECTURE.

OIECT INFORMATION


LEE'S SUMMIT LOGISTICS BUILDING A LOT I NW CORNER OF NE TUDOR RD & MAIN ST LEE'S SUMMIT, MO 64086

PERMIT SET 02.18.22 1 TENANT IMPROVEMENT 09.07.22

\*\*JOIST BRIDGING ROWS CANNOT BE ERECTED WITHIN OF 1'-6 OF ANY SURROUNDING ESFR BRANCH LINE CENTERLINE

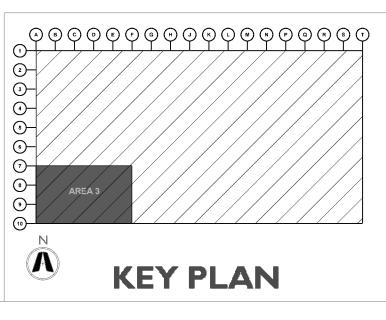

FP2.3.1 AREA 3: SYSTEMS 03-04

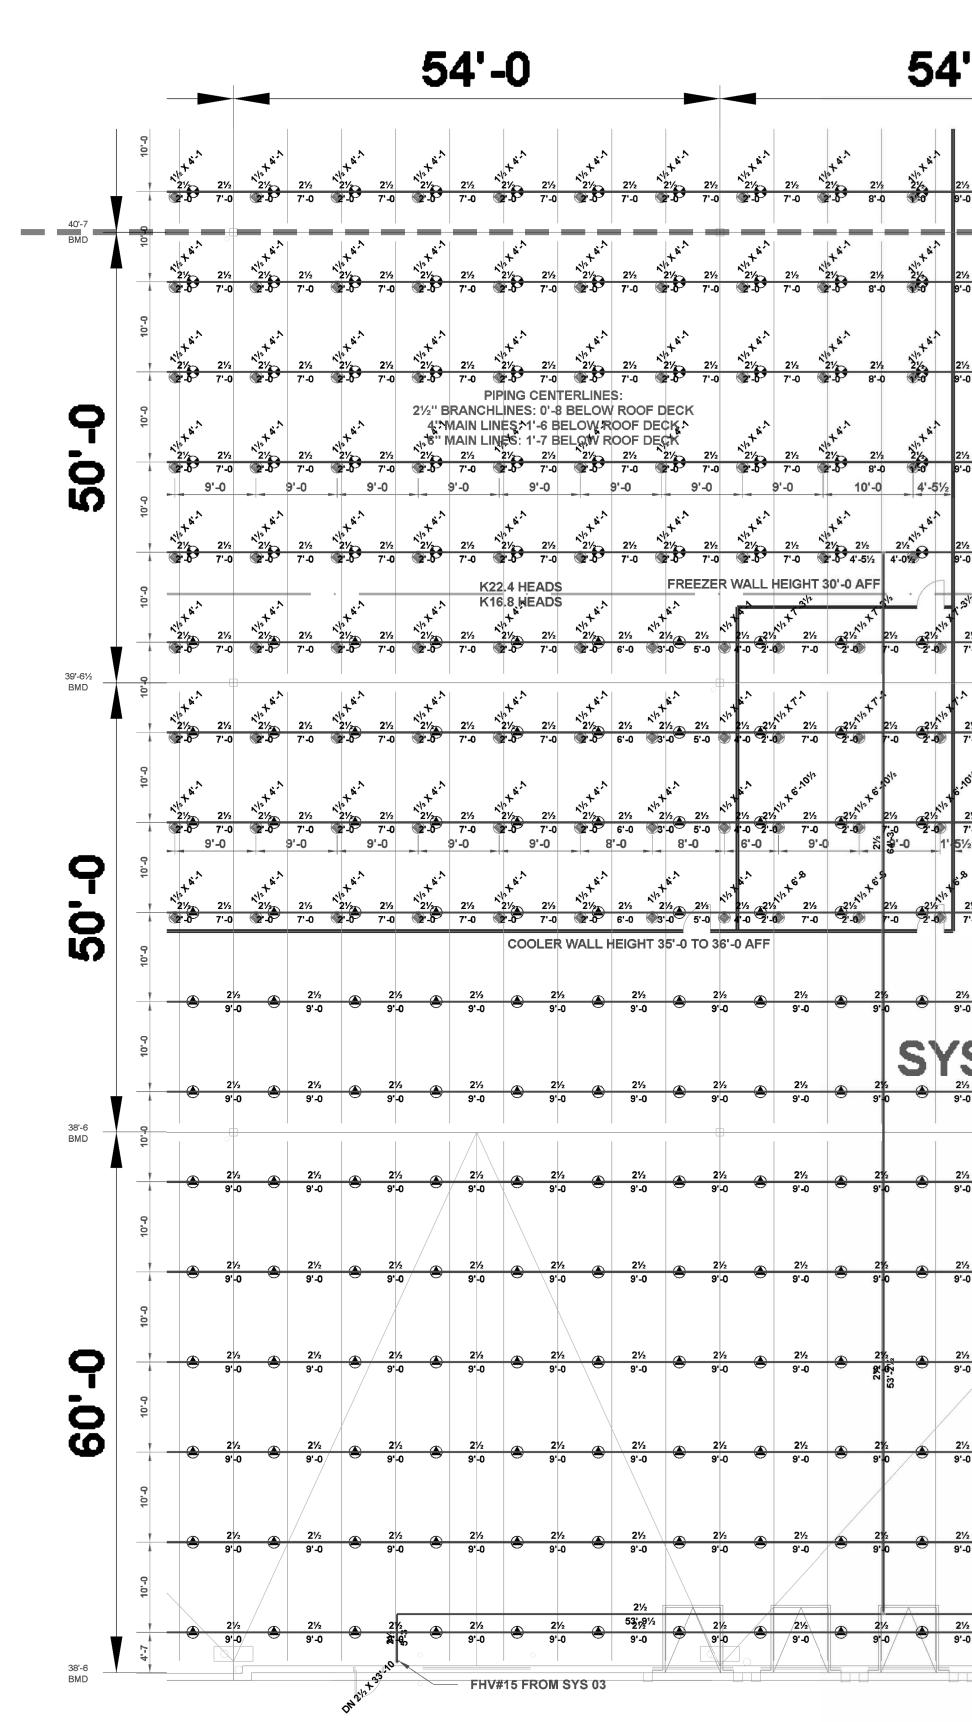

### Hydraulic Information Remote Area 04

1
ESFR
52.000 (ESFR)
250.00
12
16.8
1708.55
80.726
1708.55
80.726
+8.879 (9.9%)

S	YMI	BC
	Ř	Ś
	Ř	Ì
	Õ	)
	Č	)
	Č	

54'-0 54'-0 54'-0 9'-0 9'-0 9'-0 9'-0 9'-0 9'-0 9'-0 9'-0 SYSTEM BOUNDARY SYSTEM BOUNDARY 9'-0 9'-0 9'-0 9'-0 9'-0 9'-0 9'-0 9'-0 9'-0 SYSTEM 04 9'-0 9'-0 9 9'-0 9'-0 38,880 SQFT. 9'-0 9'-0 9'-0 9'-0 9'-0 9'-0 9'-0 9'-0 9'-0 9'-0 9'-0 9'-0 9'-0 9'-0 2<sup>1</sup>/<sub>2</sub> 2<sup>1</sup> 9'-0 9'-0 9'-0 4129 4127 REMOTE AREA 04 9'-0 9'-0 9'-0 9'-0 9'-0 9'-0 9'-0 9'-0 9'-0 9'-0 \_\_\_\_9'-0 WALL HEIGHT 11'-8 AFF 21/2 2<sup>1</sup>/<sub>2</sub> 2<sup>1</sup> 21/2 9 0 21/2 21/2 9 0 5 0 8 0 21/2 RIVE 9-0 2'- 9<sup>1/2</sup> 7'-0 9'-0 9'-0 9'-0 9'-0 9'-0 9'-0 4113 115 4117 (4111) FHV#14 FROM SYS 03 AREA 3(CONT.): SYSTEMS 03-04 SCALE: 3/32" = 1'-0" Sprinkler Logend

	Sprinkler Legend										
L	QUANTITY	MANUFACTURER	SIN	MODEL	K-FACTOR	TYPE	SIZE	RESPONSE	FINISH	TEMPERATURE	NOTE
	2054	VICTAULIC	V4702	FL-QR/ST/ESFR	16.8	PENDENT	3⁄4	FAST	BRASS	200°F	
	4	VICTAULIC	V3406	V34	8	PENDENT	3/4	QUICK	BRASS	200°F	
	2754	VICTAULIC	V3428	ESFR	22.4	PENDENT	1	FAST	BRASS	200°F	
	48	VIKING	VK600	MICROFAST	5.6	PENDENT	1/2	QUICK	CHROME	135°F	
	6	VIKING	VK3021		5.6	PENDENT	1/2	QUICK	CHROME	135°F	
	368	VIKING	VK504	ESFR DRY	16.8	PENDENT	3/4	QUICK	BRASS	205°F	
	TOTAL = 5234										

- AUXILIARY DRAIN SEE FP0.0 FOR DETAIL 2 - AIR VENT SEE FP0.0 FOR DETAIL



5719 LAWTON LOOP E. DR. #212 INDIANAPOLIS, IN 46216 O :: 317.288.0681 F :: 317.288.0753



THIS DRAWING AND THE IDEAS, DESIGNS AND CONCEPTS CONTAINED HEREIN ARE THE EXCLUSIVE INTELLECTUAL PROPERTY OF CURRAN ARCHITECTURE, AND ARE NOT TO

 $^{\circ}$  MICHELLE A. LOPEZ NUMBER PE-2022007904


CERTIFICATION

BE USED OR REPRODUCED, WHOLE OR IN PART, WITHOUT THE WRITTEN CONSENT OF CURRAN ARCHITECTURE.

OIECT INFORMATION

LEE'S SUMMIT LOGISTICS **BUILDING A LOT I** NW CORNER OF NE TUDOR RD & MAIN ST LEE'S SUMMIT, MO 64086


ISSUE DATE PERMIT SET 02.18.22 TENANT IMPROVEMENT 09.07.22 210300

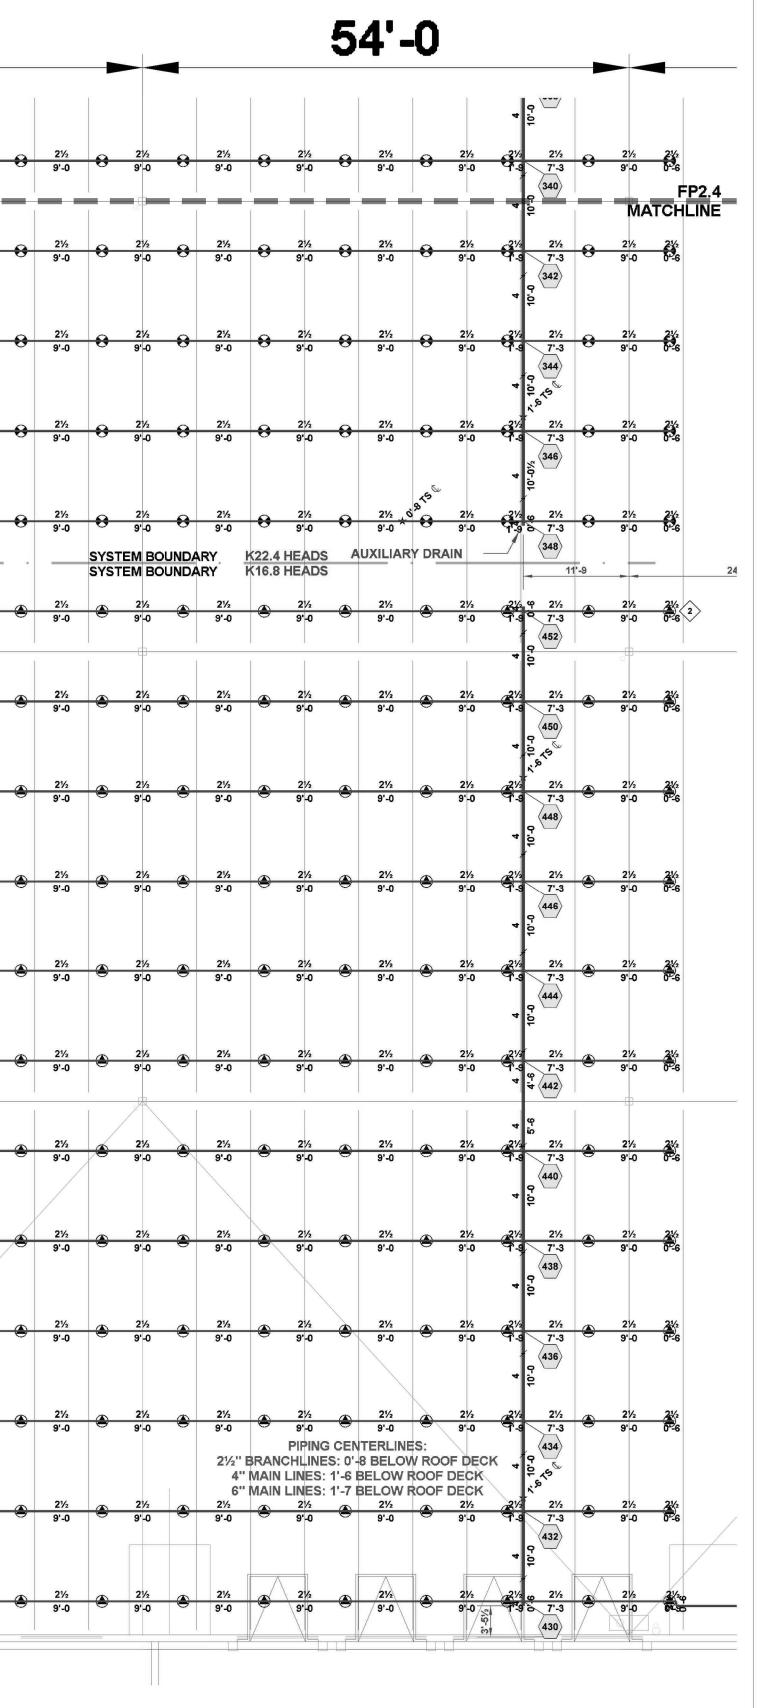


\*\*JOIST BRIDGING ROWS CANNOT BE ERECTED WITHIN OF 1'-6 OF ANY SURROUNDING ESFR BRANCH LINE CENTERLINE


ႍၜၜၜၜၜၜၜၜၜၜၜၜၜၜၜၜၜၜ  $\bigcirc$ 6 6- $\odot$ ()- $(\mathbf{A})$ **KEY PLAN** 



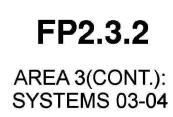

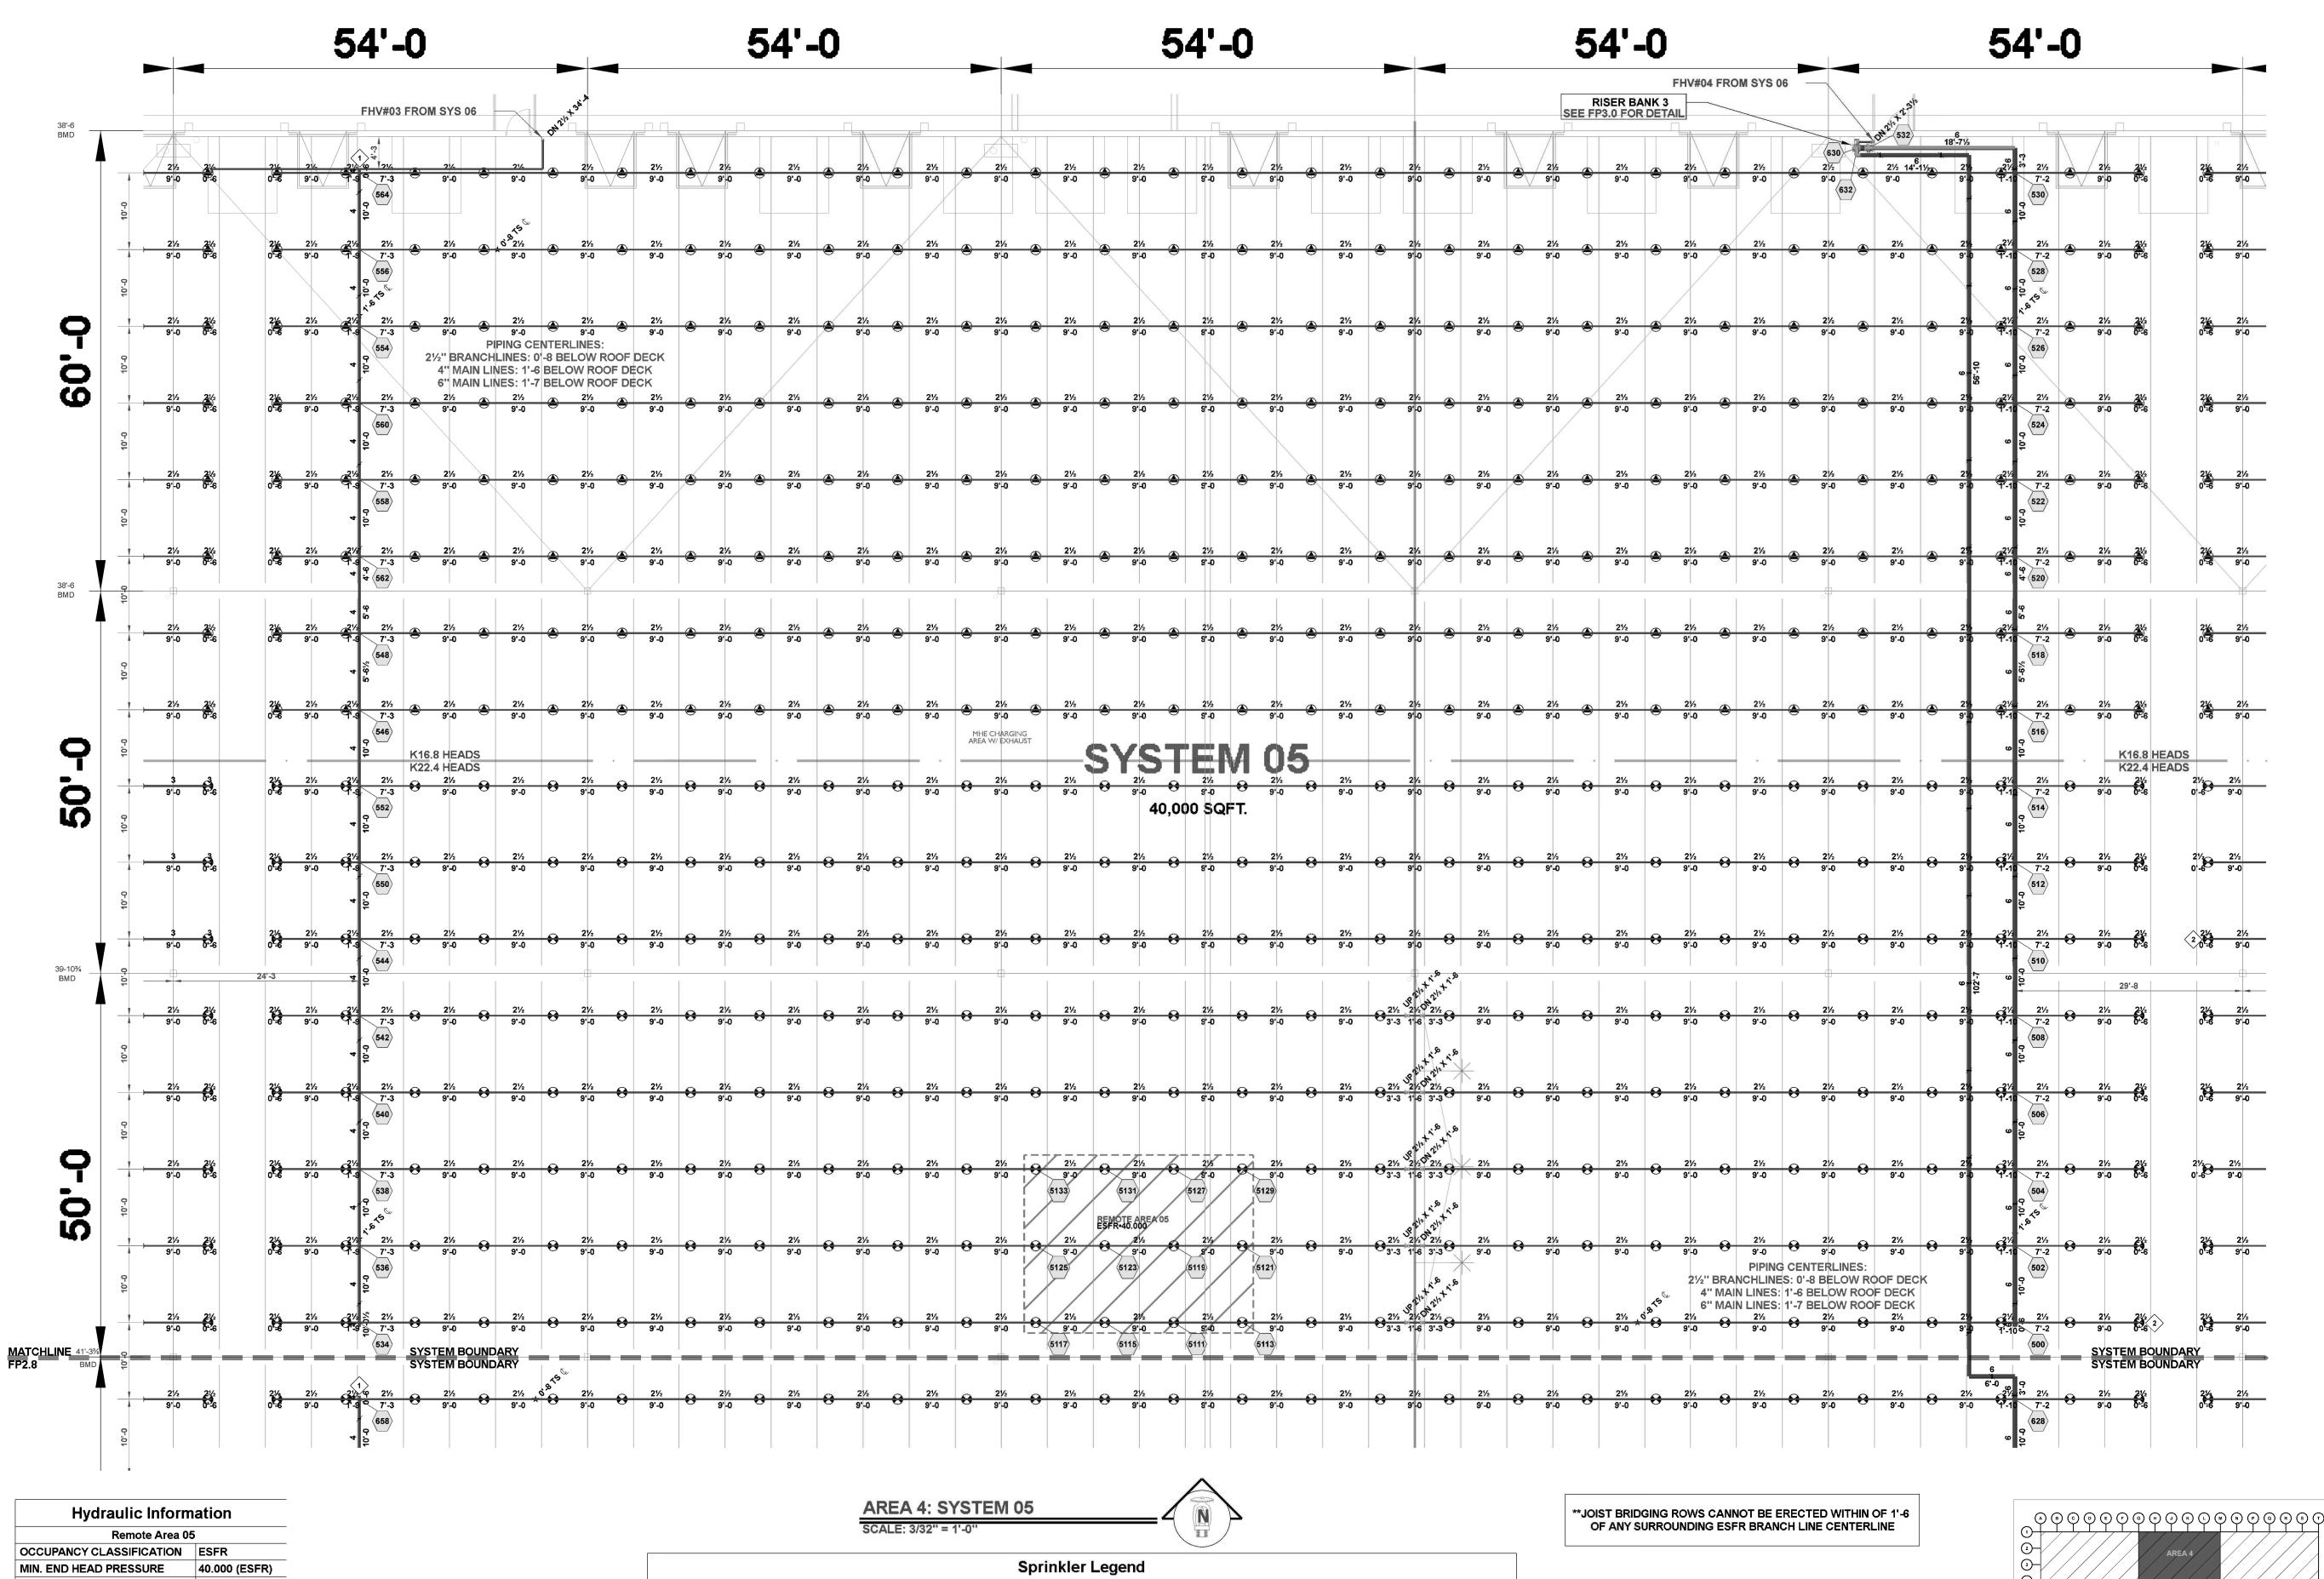

Remote Area 0	5
OCCUPANCY CLASSIFICATION	ESFR
MIN. END HEAD PRESSURE	40.000 (ESFR)
TOTAL HOSE STREAMS	250.00
TOTAL HEADS FLOWING	12
K-FACTOR	22.4
TOTAL WATER REQUIRED	1959.12
TOTAL PRESSURE REQUIRED	73.843
BASE OF RISER (GPM)	1959.12
BASE OF RISER (PSI)	73.843
SAFETY MARGIN (PSI)	+13.633 (15.6%)

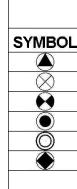

				Sprin	kler Leger	ld					
)L	QUANTITY	MANUFACTURER	SIN	MODEL	K-FACTOR	TYPE	SIZE	RESPONSE	FINISH	TEMPERATURE	NOTE
	2054	VICTAULIC	V4702	FL-QR/ST/ESFR	16.8	PENDENT	3/4	FAST	BRASS	200°F	
	4	VICTAULIC	V3406	V34	8	PENDENT	3/4	QUICK	BRASS	200°F	
	2754	VICTAULIC	V3428	ESFR	22.4	PENDENT	1	FAST	BRASS	200°F	
	48	VIKING	VK600	MICROFAST	5.6	PENDENT	1/2	QUICK	CHROME	135°F	
	6	VIKING	VK3021		5.6	PENDENT	1/2	QUICK	CHROME	135°F	
	368	VIKING	VK504	ESFR DRY	16.8	PENDENT	3⁄4	QUICK	BRASS	205°F	
	TOTAL = 5234										

- AUXILIARY DRAIN SEE FP0.0 FOR DETAIL 2 - AIR VENT SEE FP0.0 FOR DETAIL

SCANNELL PROPERTIES CERTIFICATION  $\sim$ / MICHELLE A. LOPEZ NUMBER PE-2022007904 / THIS DRAWING AND THE IDEAS, DESIGNS AND CONCEPTS CONTAINED HEREIN ARE THE EXCLUSIVE INTELLECTUAL PROPERTY OF CURRAN ARCHITECTURE, AND ARE NOT TO BE USED OR REPRODUCED, WHOLE OR IN PART, WITHOUT THE WRITTEN CONSENT OF CURRAN ARCHITECTURE. OIECT INFORMATION LEE'S SUMMIT LOGISTICS **BUILDING A LOT I** NW CORNER OF NE TUDOR RD & MAIN ST LEE'S SUMMIT, MO 64086

719 LAWTON LOOP E. DR. #212

INDIANAPOLIS, IN 46216 O :: 317.288.0681 F :: 317.288.0753


PERMIT SET 02.18.22 1 TENANT IMPROVEMENT


210300

**FP2.4** AREA 4: SYSTEM 05

 $\odot$ ())- $(\mathbf{A})$ **KEY PLAN** 



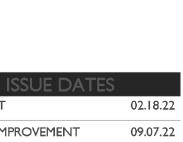

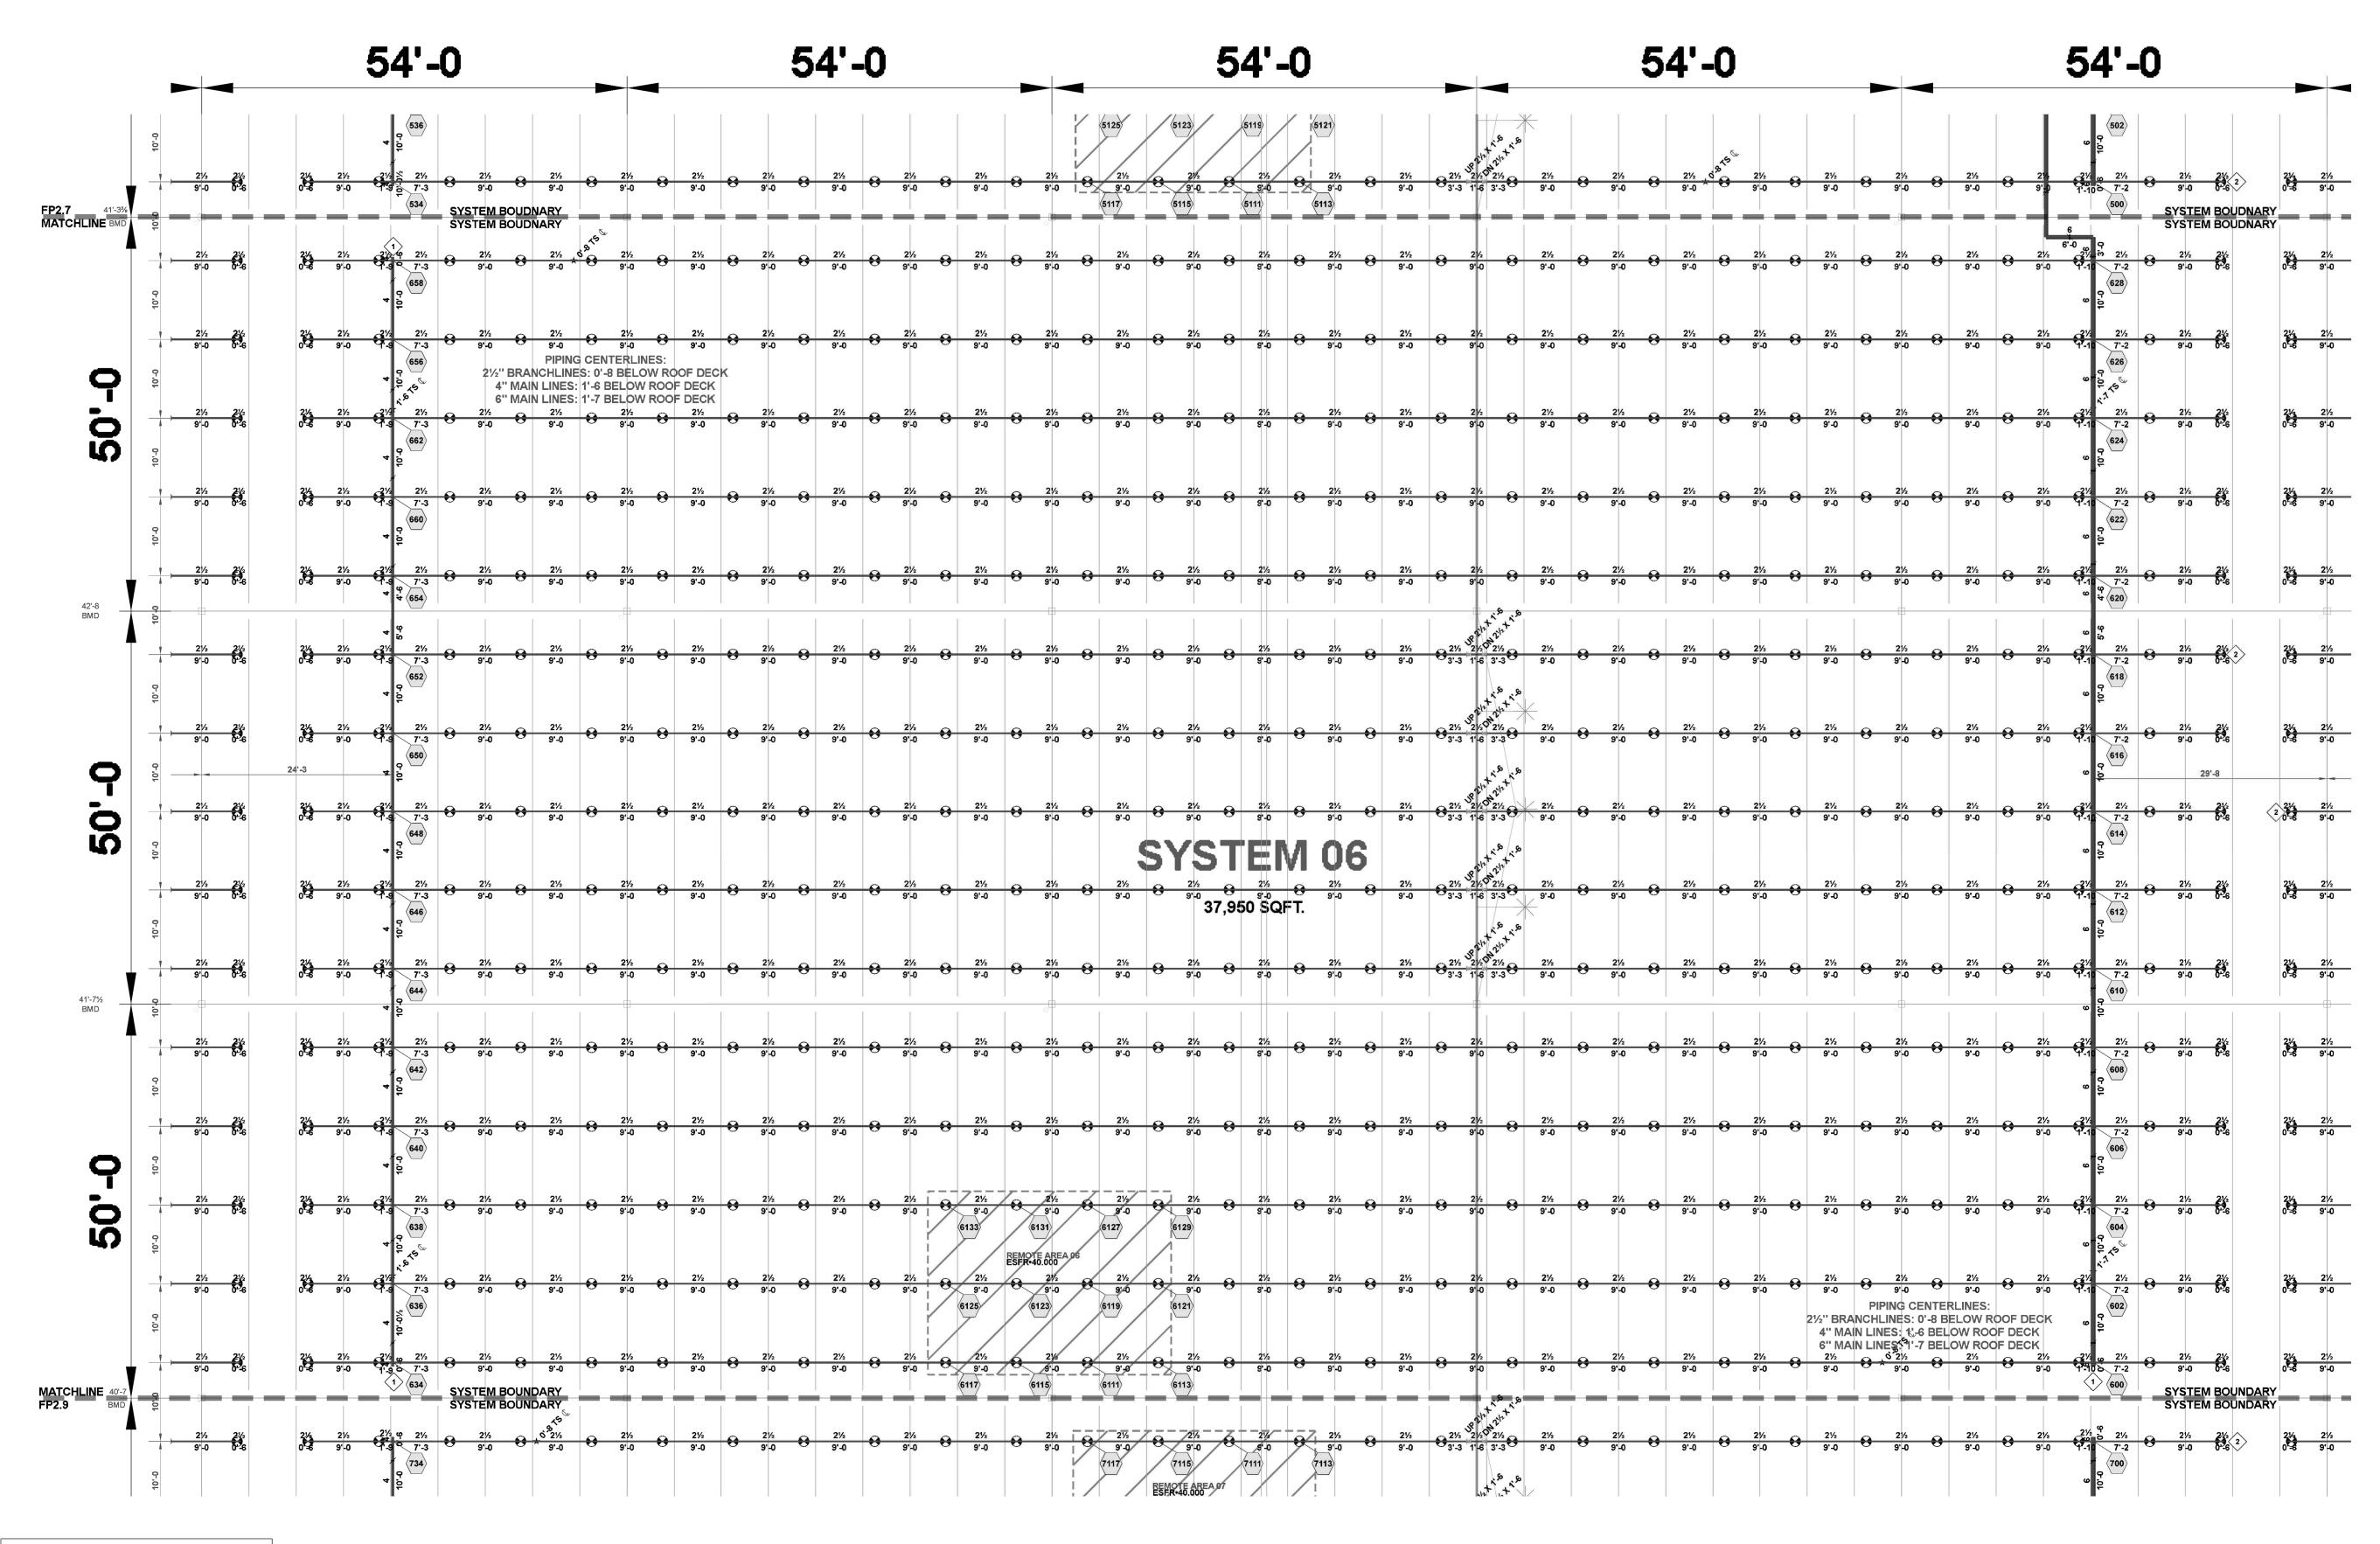


Remote Area 06	
OCCUPANCY CLASSIFICATION	ESFR
MIN. END HEAD PRESSURE	40.000 (ESFR)
TOTAL HOSE STREAMS	250.00
TOTAL HEADS FLOWING	12
K-FACTOR	22.4
TOTAL WATER REQUIRED	1956.47
TOTAL PRESSURE REQUIRED	80.319
BASE OF RISER (GPM)	1956.47
BASE OF RISER (PSI)	80.319
SAFETY MARGIN (PSI)	+7.179 (8.2%)

	SYMBC
Ī	Ň
ľ	Ŏ
ľ	Ŏ
ľ	Õ
ľ	Ŏ

\*\*JOIST BRIDGING ROWS CANNOT BE ERECTED WITHIN OF 1'-6

- AUXILIARY DRAIN SEE FP0.0 FOR DETAIL
2 - AIR VENT SEE FP0.0 FOR DETAIL

AREA	5:	SYS	STE	M 06	
SCALE:	3/32	'' = 1'-	0''		

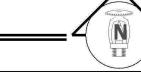


	Sprinkler Legend											
DL	QUANTITY	MANUFACTURER	SIN	MODEL	K-FACTOR	TYPE	SIZE	RESPONSE	FINISH	TEMPERATURE	NOTE	
	2054	VICTAULIC	V4702	FL-QR/ST/ESFR	16.8	PENDENT	3/4	FAST	BRASS	200°F		
	4	VICTAULIC	V3406	V34	8	PENDENT	3⁄4	QUICK	BRASS	200°F		
	2754	VICTAULIC	V3428	ESFR	22.4	PENDENT	1	FAST	BRASS	200°F		
	48	VIKING	VK600	MICROFAST	5.6	PENDENT	1/2	QUICK	CHROME	135°F		
	6	VIKING	VK3021		5.6	PENDENT	1/2	QUICK	CHROME	135°F		
	368	VIKING	VK504	ESFR DRY	16.8	PENDENT	3/4	QUICK	BRASS	205°F		
	TOTAL = 5234											



5719 LAWTON LOOP E. DR. #212 INDIANAPOLIS, IN 46216 O :: 317.288.0681 F :: 317.288.0753



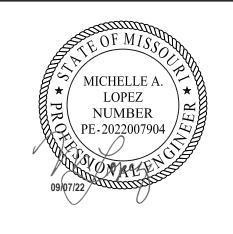

CERTIFICATION

THIS DRAWING AND THE IDEAS, DESIGNS AND CONCEPTS CONTAINED HEREIN ARE THE EXCLUSIVE INTELLECTUAL PROPERTY OF CURRAN ARCHITECTURE, AND ARE NOT TO BE USED OR REPRODUCED, WHOLE OR IN PART, WITHOUT THE WRITTEN CONSENT OF CURRAN ARCHITECTURE.

OIECT INFORMATION


LEE'S SUMMIT LOGISTICS **BUILDING A LOT I** NW CORNER OF NE TUDOR RD & MAIN ST LEE'S SUMMIT, MO 64086


02.18.22 PERMIT SET 09.07.22

210300

FP2.5 AREA 5: SYSTEM 06

OF ANY SURROUNDING ESFR BRANCH LINE CENTERLINE

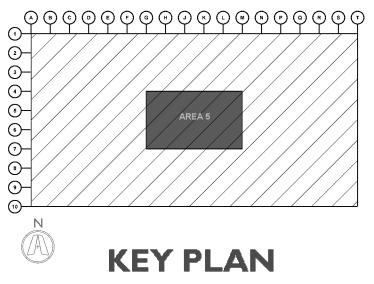


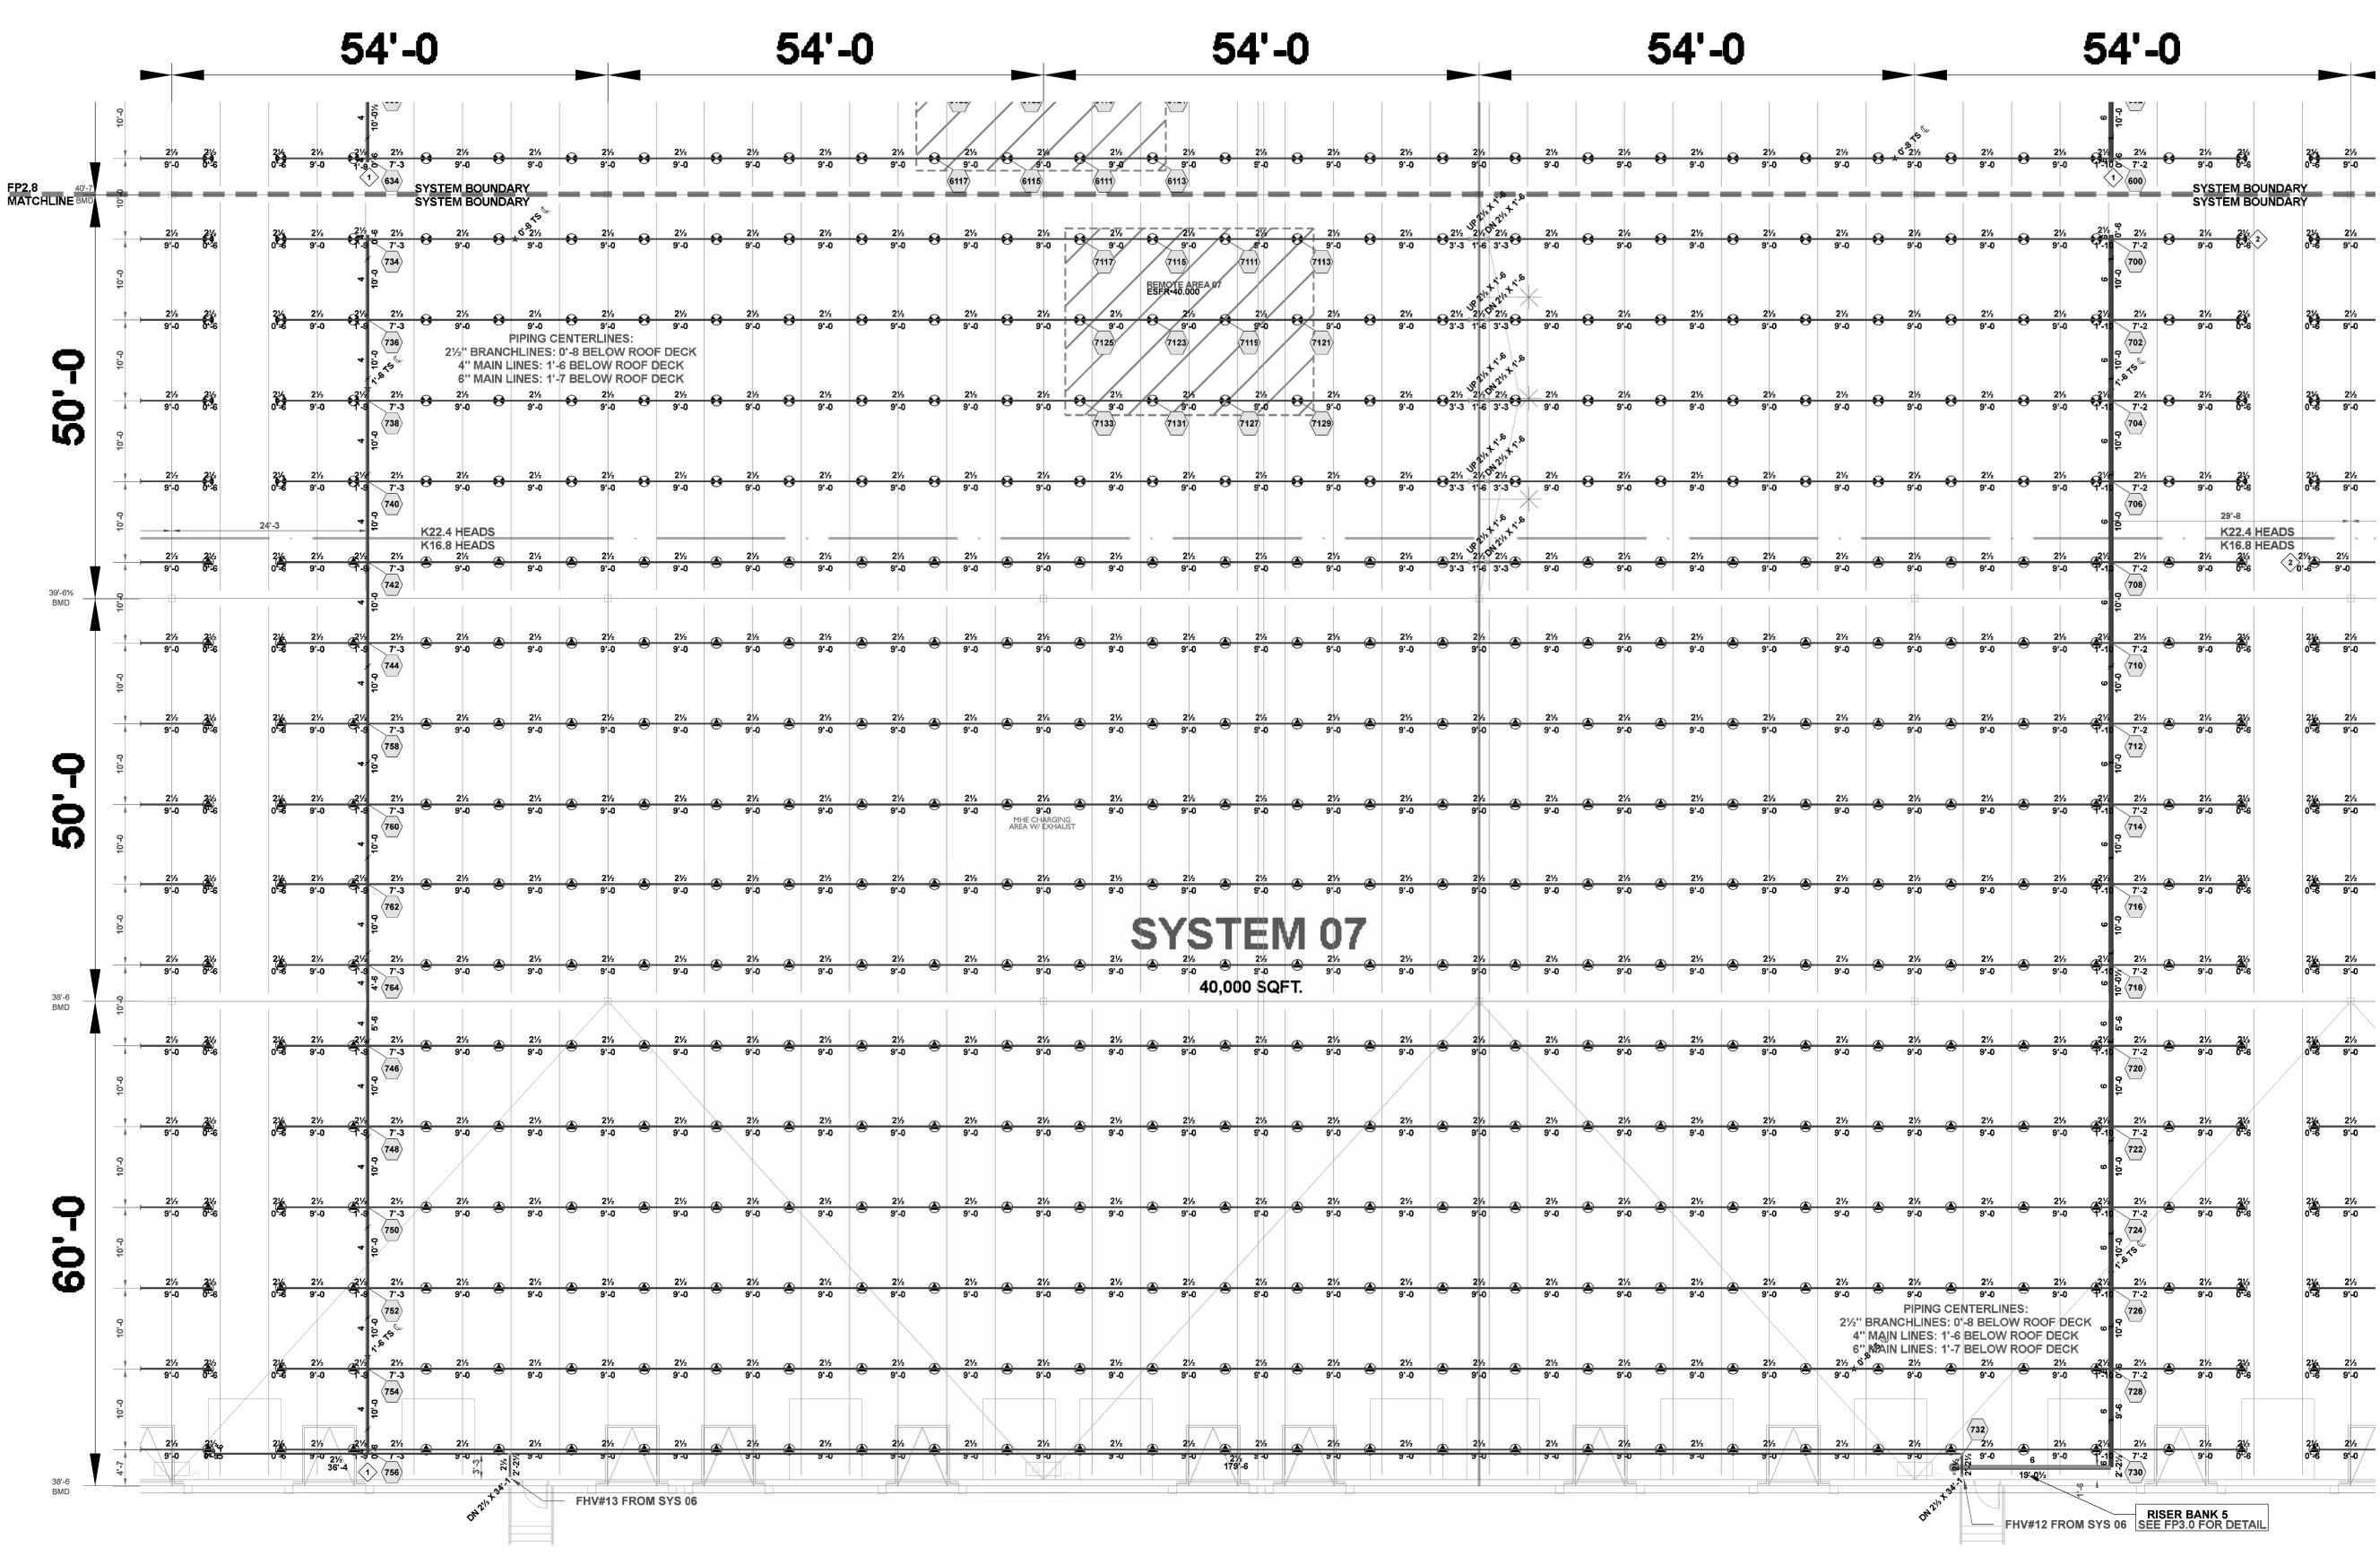

Remote Area 07							
OCCUPANCY CLASSIFICATION	ESFR						
MIN. END HEAD PRESSURE	40.000 (ESFR)						
TOTAL HOSE STREAMS	250.00						
TOTAL HEADS FLOWING	12						
K-FACTOR	22.4						
TOTAL WATER REQUIRED	1958.72						
TOTAL PRESSURE REQUIRED	74.363						
BASE OF RISER (GPM)	1958.72						
BASE OF RISER (PSI)	74.363						
SAFETY MARGIN (PSI)	+13.116 (15.0%)						

~		~
2	YMB	L
	$\bigotimes$	
	Ň	
	Ŏ	
	Õ	
	ŏ	

\*\*JOIST BRIDGING ROWS CANNOT BE ERECTED WITHIN OF 1'-6 OF ANY SURROUNDING ESFR BRANCH LINE CENTERLINE

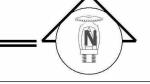

AREA 6: SYSTEM 07 SCALE: 3/32" = 1'-0"


	Sprinkler Legend											
)L	QUANTITY	MANUFACTURER	SIN	MODEL	K-FACTOR	TYPE	SIZE	RESPONSE	FINISH	TEMPERATURE	NOTE	
	2054	VICTAULIC	V4702	FL-QR/ST/ESFR	16.8	PENDENT	3/4	FAST	BRASS	200°F		
	4	VICTAULIC	V3406	V34	8	PENDENT	3/4	QUICK	BRASS	200°F		
	2754	VICTAULIC	V3428	ESFR	22.4	PENDENT	1	FAST	BRASS	200°F		
	48	VIKING	VK600	MICROFAST	5.6	PENDENT	1/2	QUICK	CHROME	135°F		
	6	VIKING	VK3021		5.6	PENDENT	1/2	QUICK	CHROME	135°F		
	368	VIKING	VK504	ESFR DRY	16.8	PENDENT	3/4	QUICK	BRASS	205°F		
	TOTAL = 5234											

- AUXILIARY DRAIN SEE FP0.0 FOR DETAIL 2 - AIR VENT SEE FP0.0 FOR DETAIL



5719 LAWTON LOOP E. DR. #212 INDIANAPOLIS, IN 46216 O:: 317.288.0681 F :: 317.288.0753



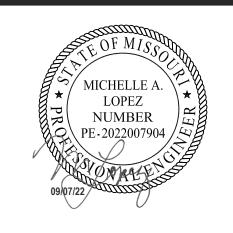

THIS DRAWING AND THE IDEAS, DESIGNS AND CONCEPTS CONTAINED HEREIN ARE THE EXCLUSIVE INTELLECTUAL PROPERTY OF CURRAN ARCHITECTURE, AND ARE NOT TO BE USED OR REPRODUCED, WHOLE OR IN PART, WITHOUT THE WRITTEN CONSENT OF CURRAN ARCHITECTURE.


OIECT INFORMATION


LEE'S SUMMIT LOGISTICS BUILDING A LOT I NW CORNER OF NE TUDOR RD & MAIN ST LEE'S SUMMIT, MO 64086


PERMIT SET 02.18.22 1 TENANT IMPROVEMENT 09.07.22

210300


FP2.6 AREA 6: SYSTEM 07

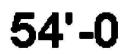

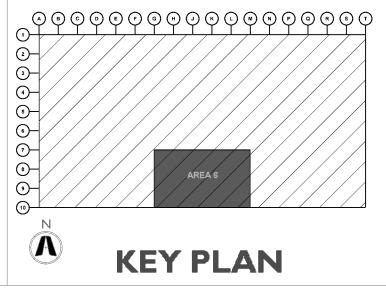

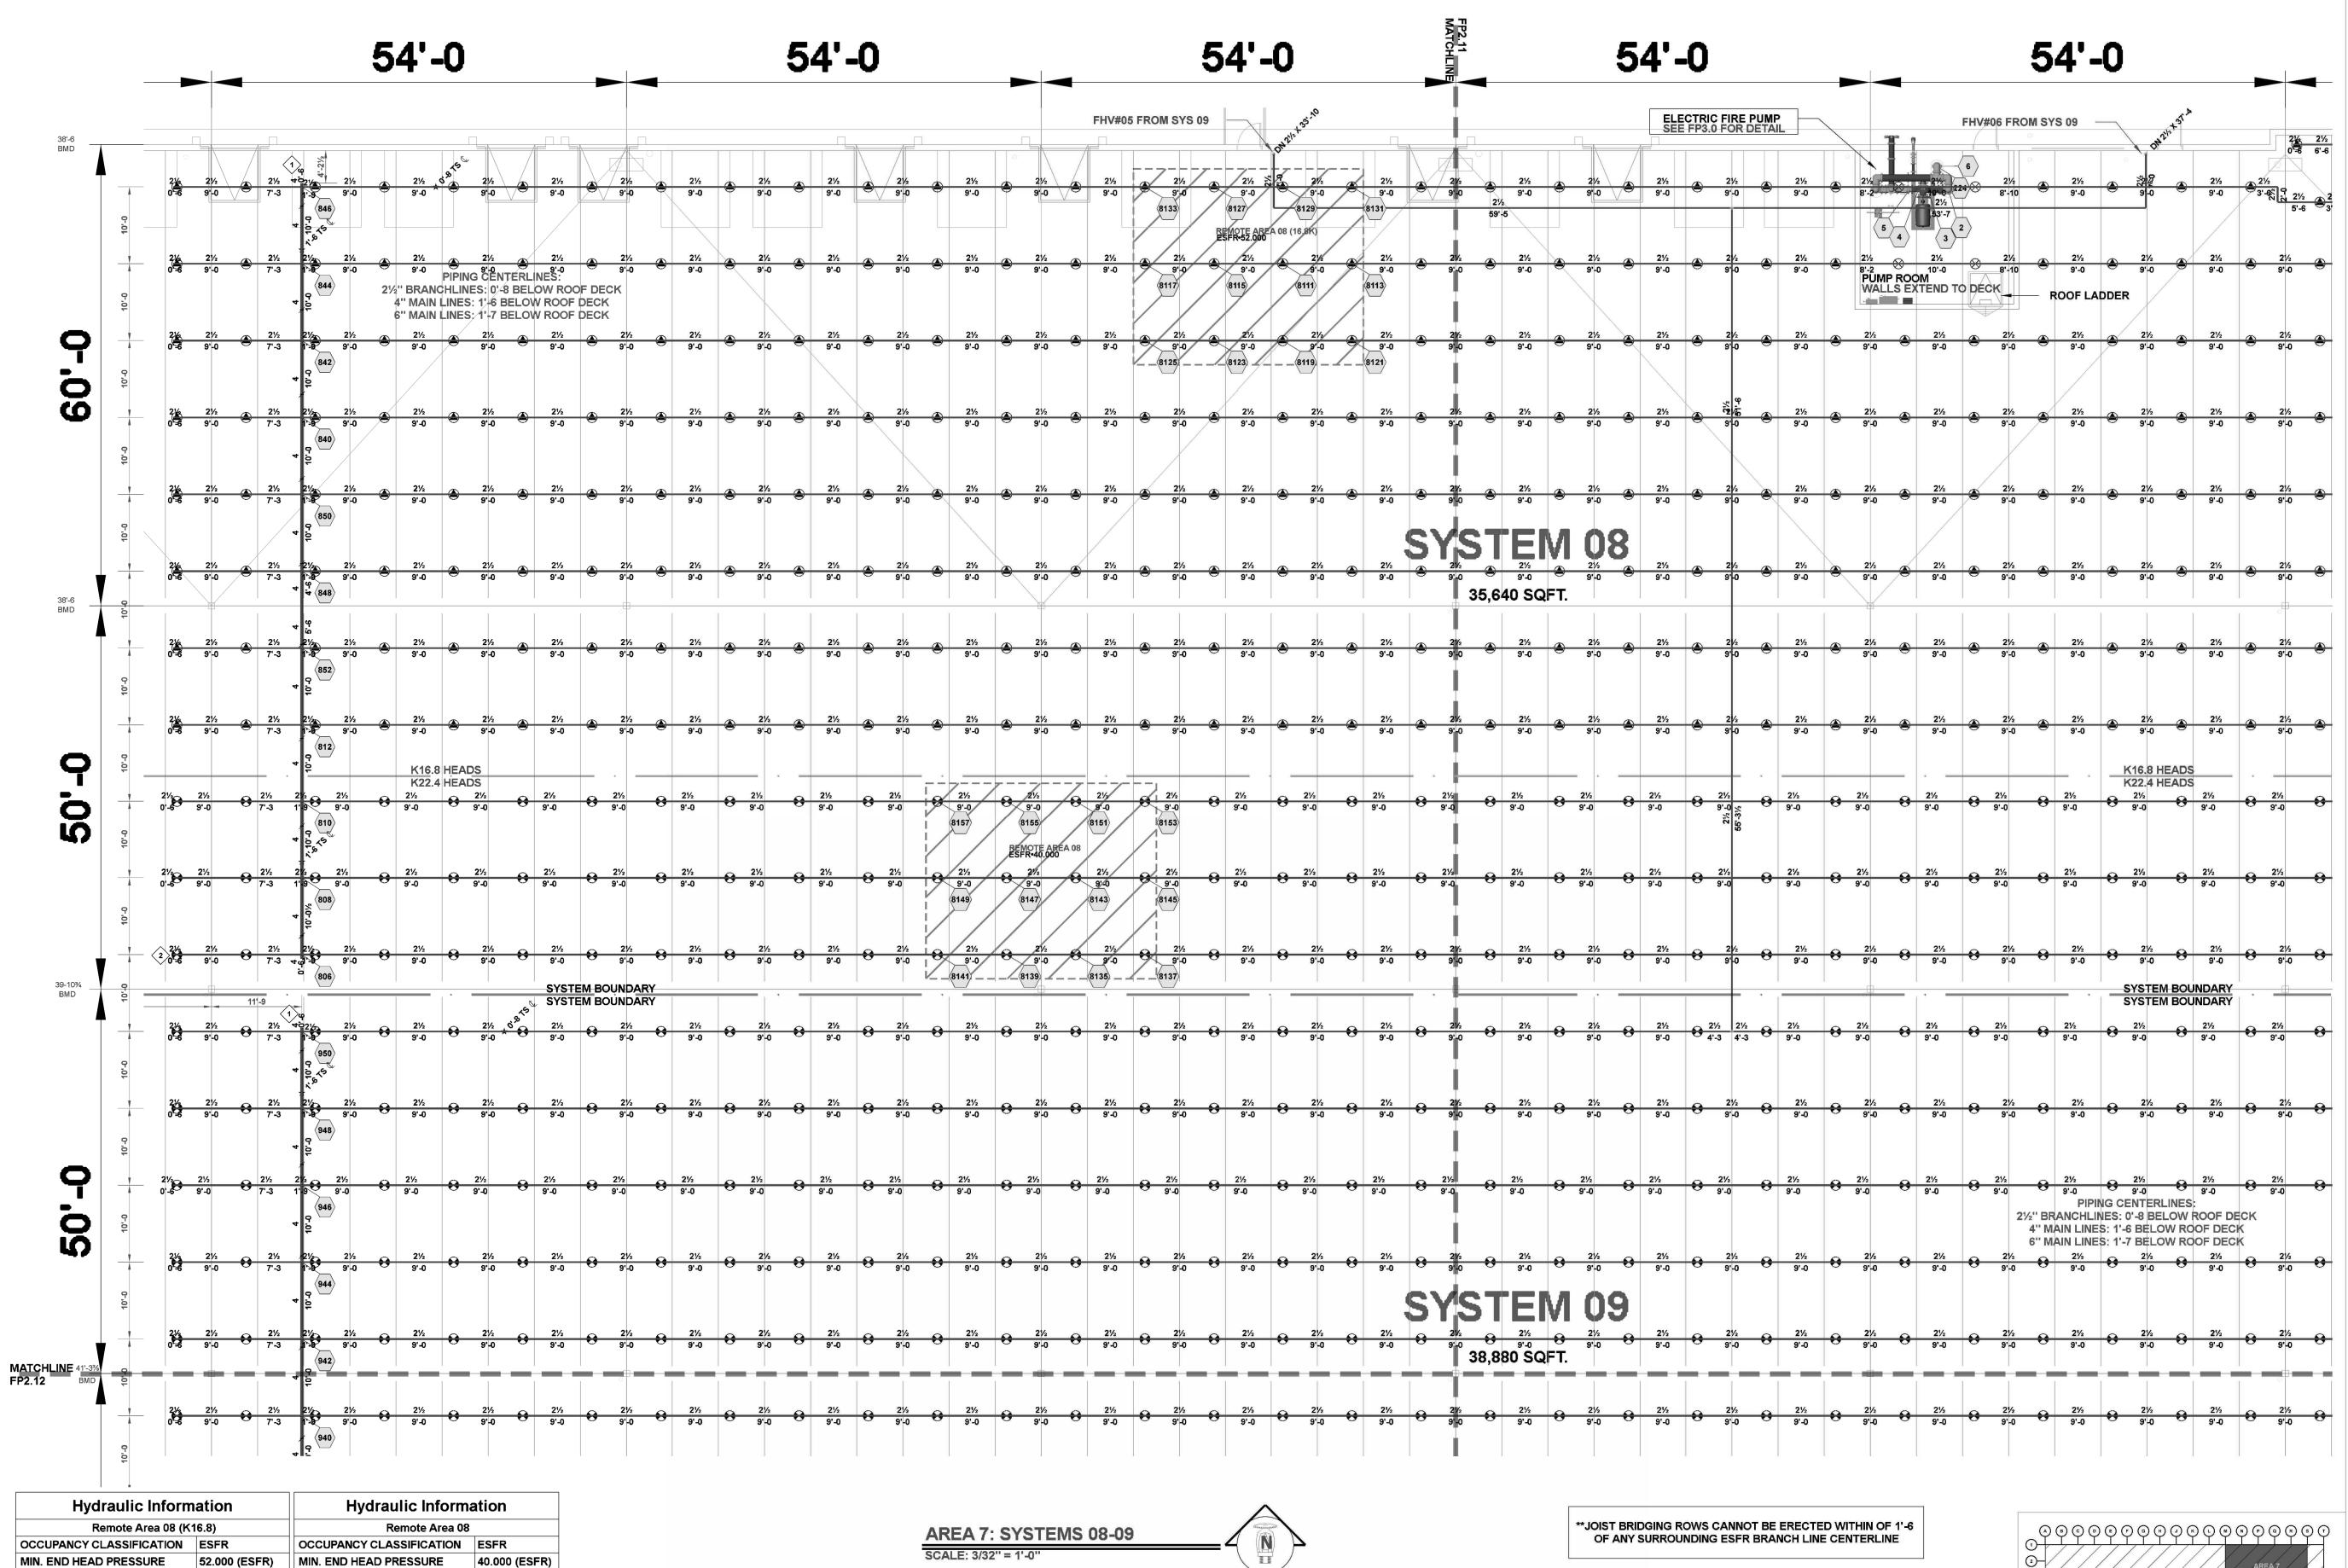

Hydraulic Inform	nation	Hydraulic Inform	ation	
Remote Area 08 (K	16.8)	Remote Area 08		
OCCUPANCY CLASSIFICATION	ESFR	OCCUPANCY CLASSIFICATION	ESFR	
MIN. END HEAD PRESSURE	52.000 (ESFR)	MIN. END HEAD PRESSURE	40.000 (ESFR)	
TOTAL HOSE STREAMS	250.00	TOTAL HOSE STREAMS	250.00	
TOTAL HEADS FLOWING	12	TOTAL HEADS FLOWING	12	
K-FACTOR	16.8	K-FACTOR	22.4	
TOTAL WATER REQUIRED	1711.62	TOTAL WATER REQUIRED	1956.80	
TOTAL PRESSURE REQUIRED	73.476	TOTAL PRESSURE REQUIRED	81.616	
BASE OF RISER (GPM)	1711.62	BASE OF RISER (GPM)	1956.80	
BASE OF RISER (PSI)	73.476	BASE OF RISER (PSI)	81.616	
SAFETY MARGIN (PSI)	+16.104 (18.0%)	SAFETY MARGIN (PSI)	+5.880 (6.7%)	

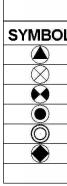

Sprinkler Legend MODEL K-FACTOR TYPE SIZE RESPONSE FINISH TEMPERATURE NOTE SYMBOL QUANTITY MANUFACTURER SIN 16.8 PENDENT 3/4 FAST 2054 VICTAULIC V4702 FL-QR/ST/ESFR BRASS 200°F V3406 8 PENDENT 34 QUICK BRASS 200°F V34 2754 VICTAULIC V3428 ESFR 22.4 PENDENT 1 FAST BRASS 200°F MICROFAST 48 VIKING VK600 5.6 PENDENT 1/2 QUICK CHROME 135°F 6 VIKING VK3021 5.6 PENDENT 1/2 QUICK CHROME 135°F 16.8 PENDENT 34 QUICK 368 VIKING VK504 ESFR DRY BRASS 205°F TOTAL = 5234

- AUXILIARY DRAIN SEE FP0.0 FOR DETAIL



5719 LAWTON LOOP E. DR. #212 INDIANAPOLIS, IN 46216 O :: 317.288.0681 F :: 317.288.0753





CERTIFICATION

THIS DRAWING AND THE IDEAS, DESIGNS AND CONCEPTS CONTAINED HEREIN ARE THE EXCLUSIVE INTELLECTUAL PROPERTY OF CURRAN ARCHITECTURE, AND ARE NOT TO BE USED OR REPRODUCED, WHOLE OR IN PART, WITHOUT THE WRITTEN CONSENT OF CURRAN ARCHITECTURE.

OIECT INFORMATION


LEE'S SUMMIT LOGISTICS **BUILDING A LOT I** NW CORNER OF NE TUDOR RD & MAIN ST LEE'S SUMMIT, MO 64086


PERMIT SET	02.18.22
TENANT IMPROVEMENT	09.07.22
210300	

AREA 7: SYSTEMS

08-09

2 - AIR VENT SEE FP0.0 FOR DETAIL

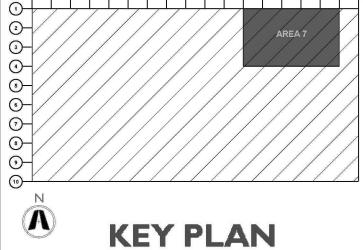

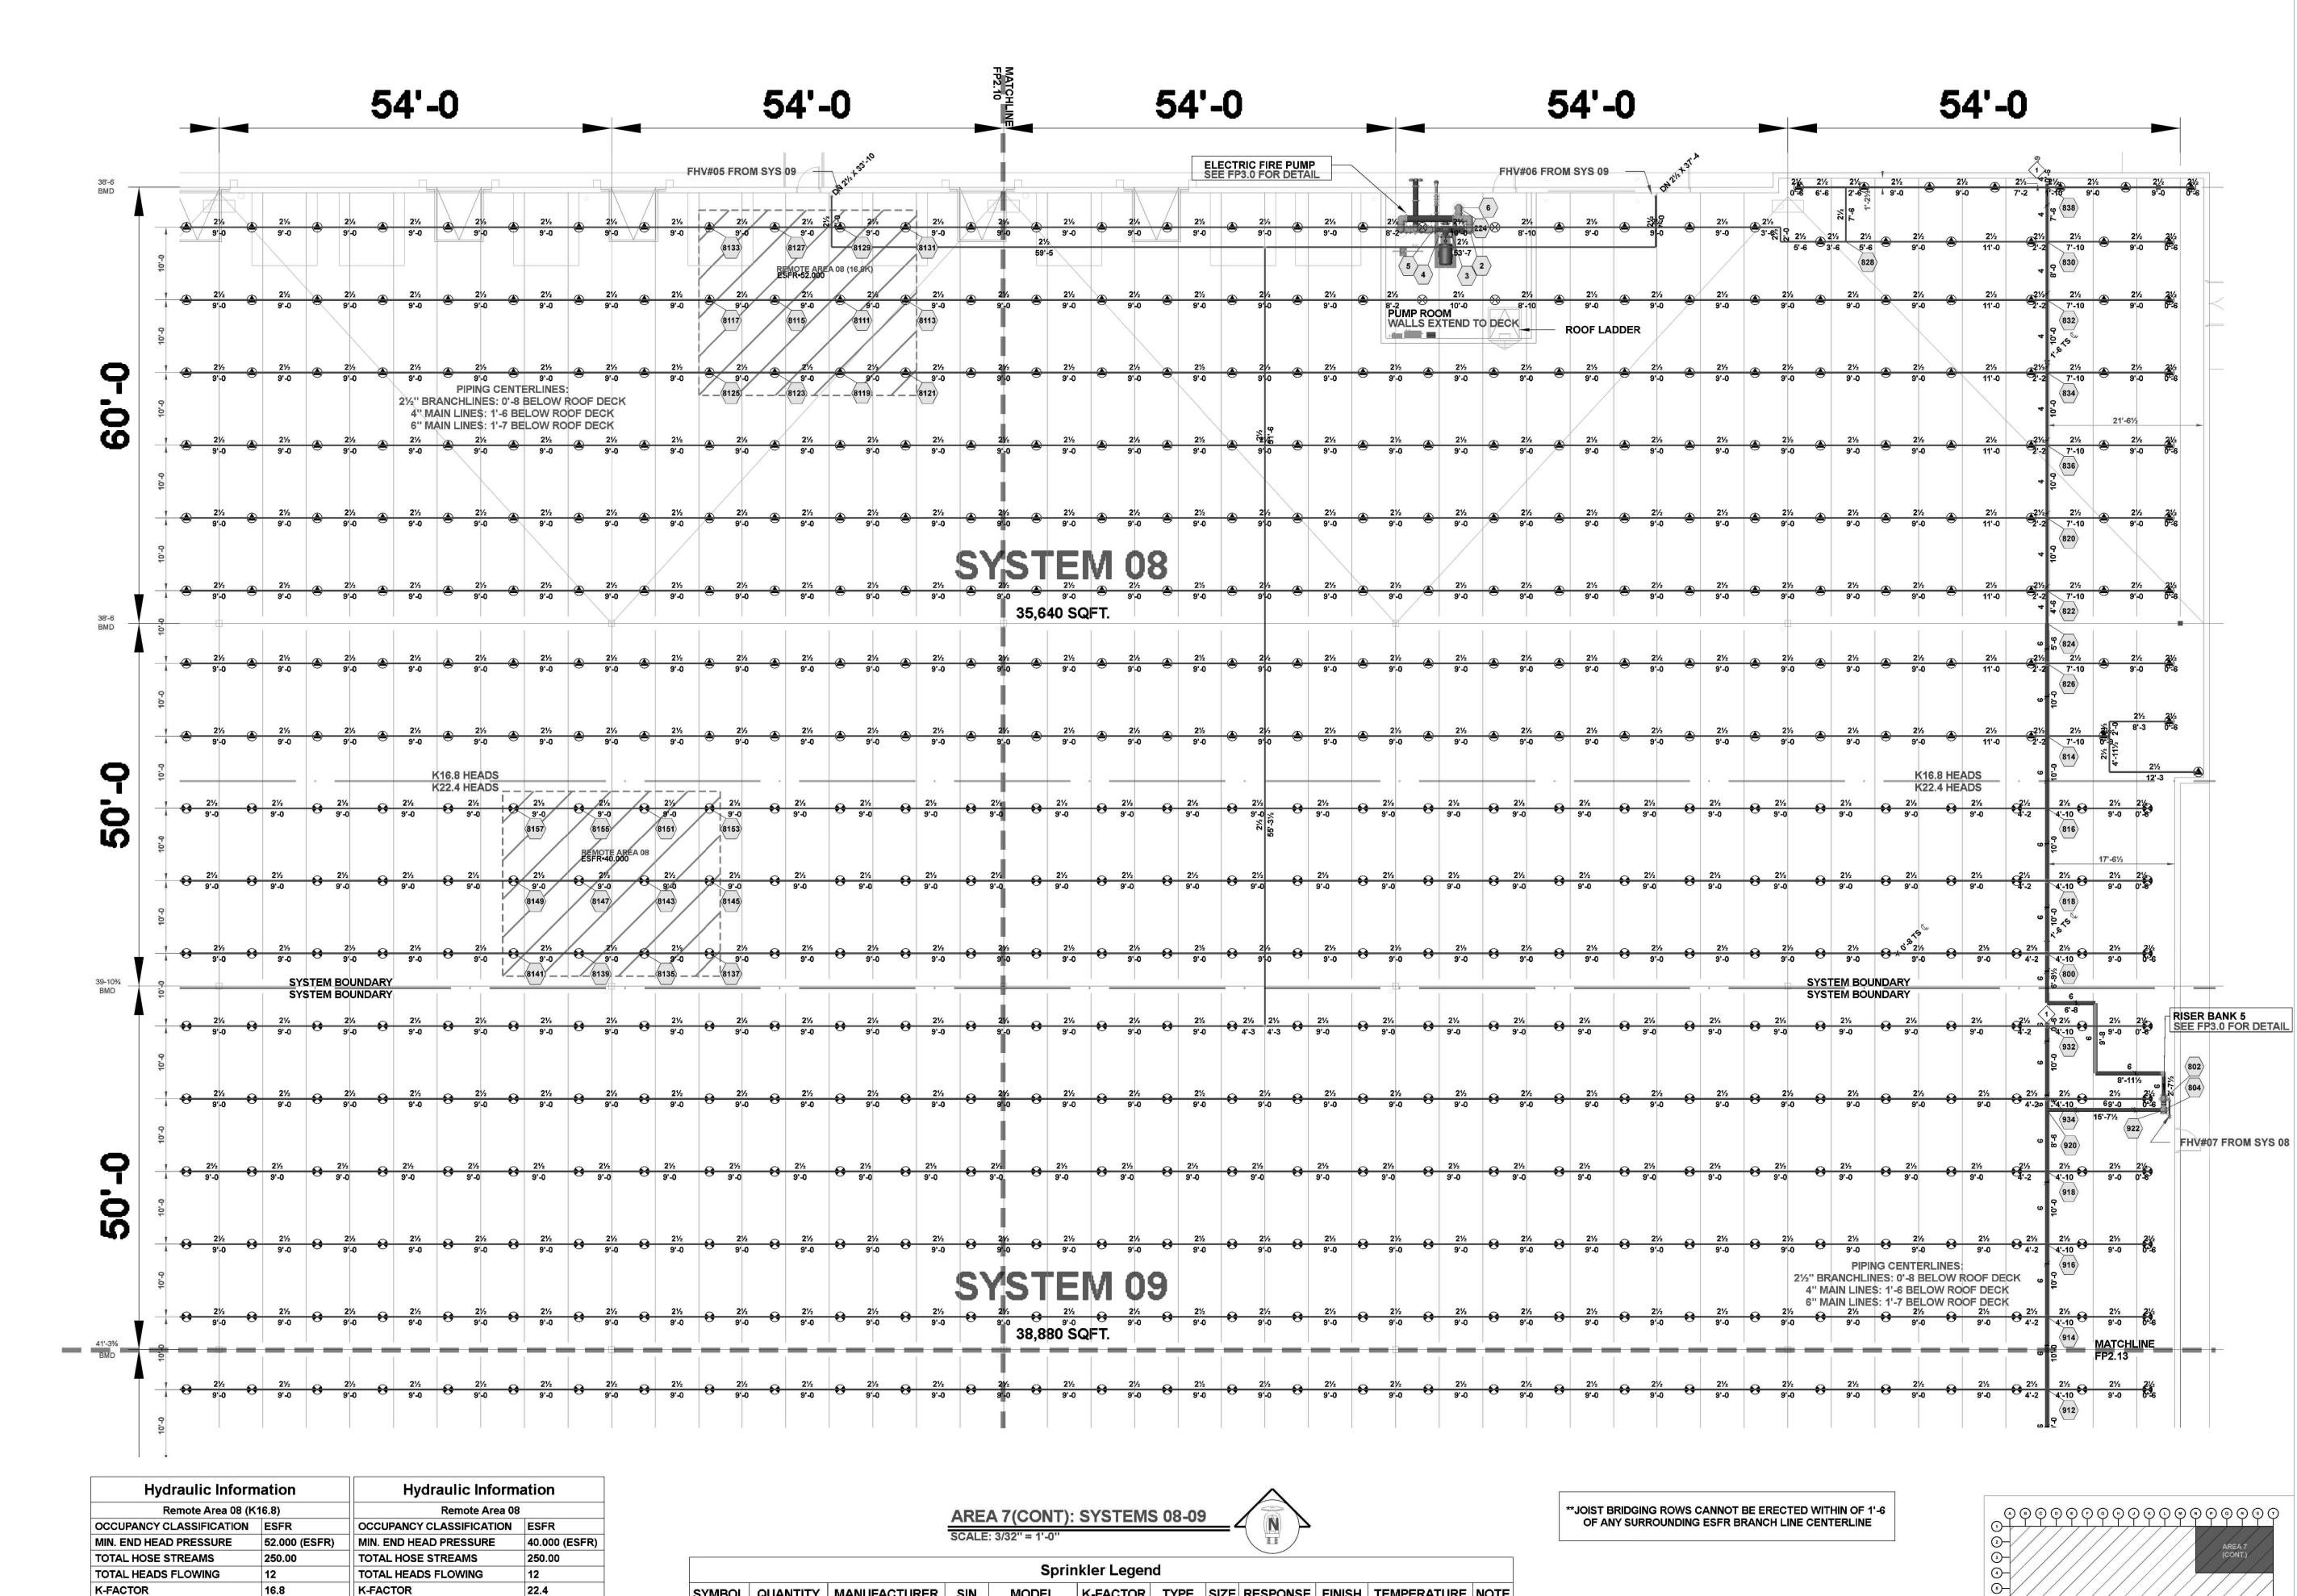

SYMBOL 

TOTAL WATER REQUIRED

BASE OF RISER (GPM)

BASE OF RISER (PSI)

+16.104 (18.0%) SAFETY MARGIN (PSI)

TOTAL PRESSURE REQUIRED 81.616

1956.80

1956.80

+5.880 (6.7%)

81.616

TOTAL WATER REQUIRED

BASE OF RISER (GPM)

BASE OF RISER (PSI)

SAFETY MARGIN (PSI)

TOTAL PRESSURE REQUIRED

1711.62


1711.62

73.476

73.476

		Sprinkler Legend												
MANUFACTURER	SIN	MODEL	K-FACTOR	TYPE	SIZE	RESPONSE	FINISH	TEMPERATURE	NOTE					
4 VICTAULIC	V4702	FL-QR/ST/ESFR	16.8	PENDENT	3/4	FAST	BRASS	200°F						
4 VICTAULIC	V3406	V34	8	PENDENT	3/4	QUICK	BRASS	200°F						
4 VICTAULIC	V3428	ESFR	22.4	PENDENT	1	FAST	BRASS	200°F						
8 VIKING	VK600	MICROFAST	5.6	PENDENT	1/2	QUICK	CHROME	135°F						
6 VIKING	VK3021		5.6	PENDENT	1/2	QUICK	CHROME	135°F						
8 VIKING	VK504	ESFR DRY	16.8	PENDENT	3⁄4	QUICK	BRASS	205°F						
4					6				Í					
	3 VIKING 5 VIKING 3 VIKING	3         VIKING         VK600           5         VIKING         VK3021           3         VIKING         VK504	3VIKINGVK600MICROFAST5VIKINGVK30213VIKINGVK504ESFR DRY	3         VIKING         VK600         MICROFAST         5.6           5         VIKING         VK3021         5.6           3         VIKING         VK504         ESFR DRY         16.8	3VIKINGVK600MICROFAST5.6PENDENT5VIKINGVK30215.6PENDENT3VIKINGVK504ESFR DRY16.8PENDENT	3         VIKING         VK600         MICROFAST         5.6         PENDENT         1/2           5         VIKING         VK3021         5.6         PENDENT         1/2           3         VIKING         VK504         ESFR DRY         16.8         PENDENT         3/4	3VIKINGVK600MICROFAST5.6PENDENT½QUICK5VIKINGVK30215.6PENDENT½QUICK3VIKINGVK504ESFR DRY16.8PENDENT¾QUICK	3VIKINGVK600MICROFAST5.6PENDENT½QUICKCHROME5VIKINGVK30215.6PENDENT½QUICKCHROME8VIKINGVK504ESFR DRY16.8PENDENT¾QUICKBRASS	3       VIKING       VK600       MICROFAST       5.6       PENDENT       ½       QUICK       CHROME       135°F         5       VIKING       VK3021       5.6       PENDENT       ½       QUICK       CHROME       135°F         8       VIKING       VK504       ESFR DRY       16.8       PENDENT       ¾       QUICK       BRASS       205°F					

- AUXILIARY DRAIN SEE FP0.0 FOR DETAIL 2 - AIR VENT SEE FP0.0 FOR DETAIL

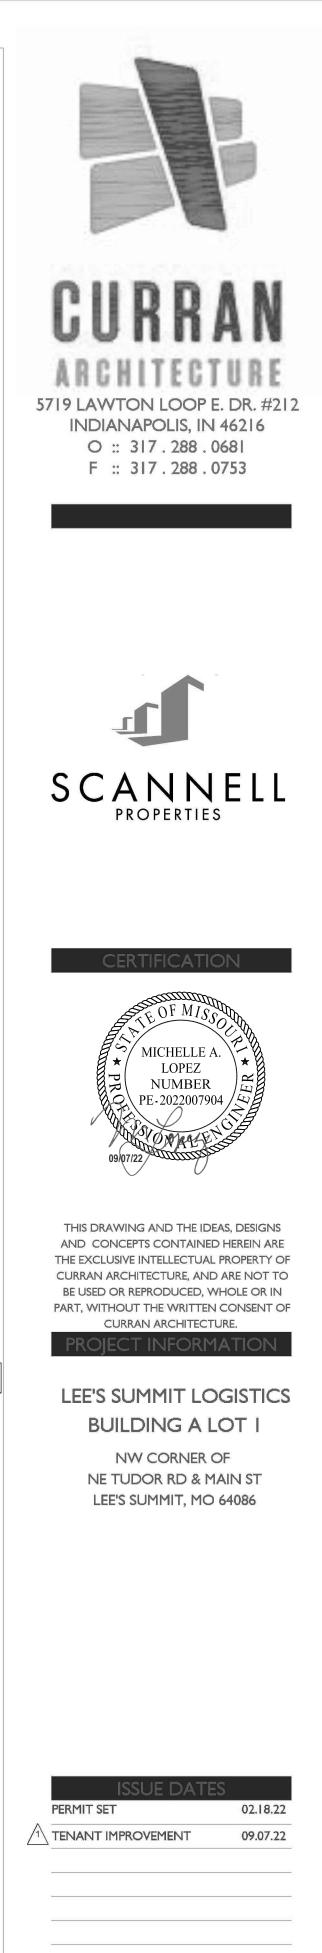



9-

(10)-


 $(\mathbf{A})$ 

**KEY PLAN** 

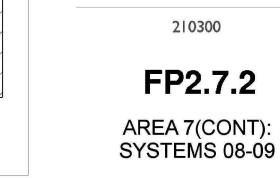

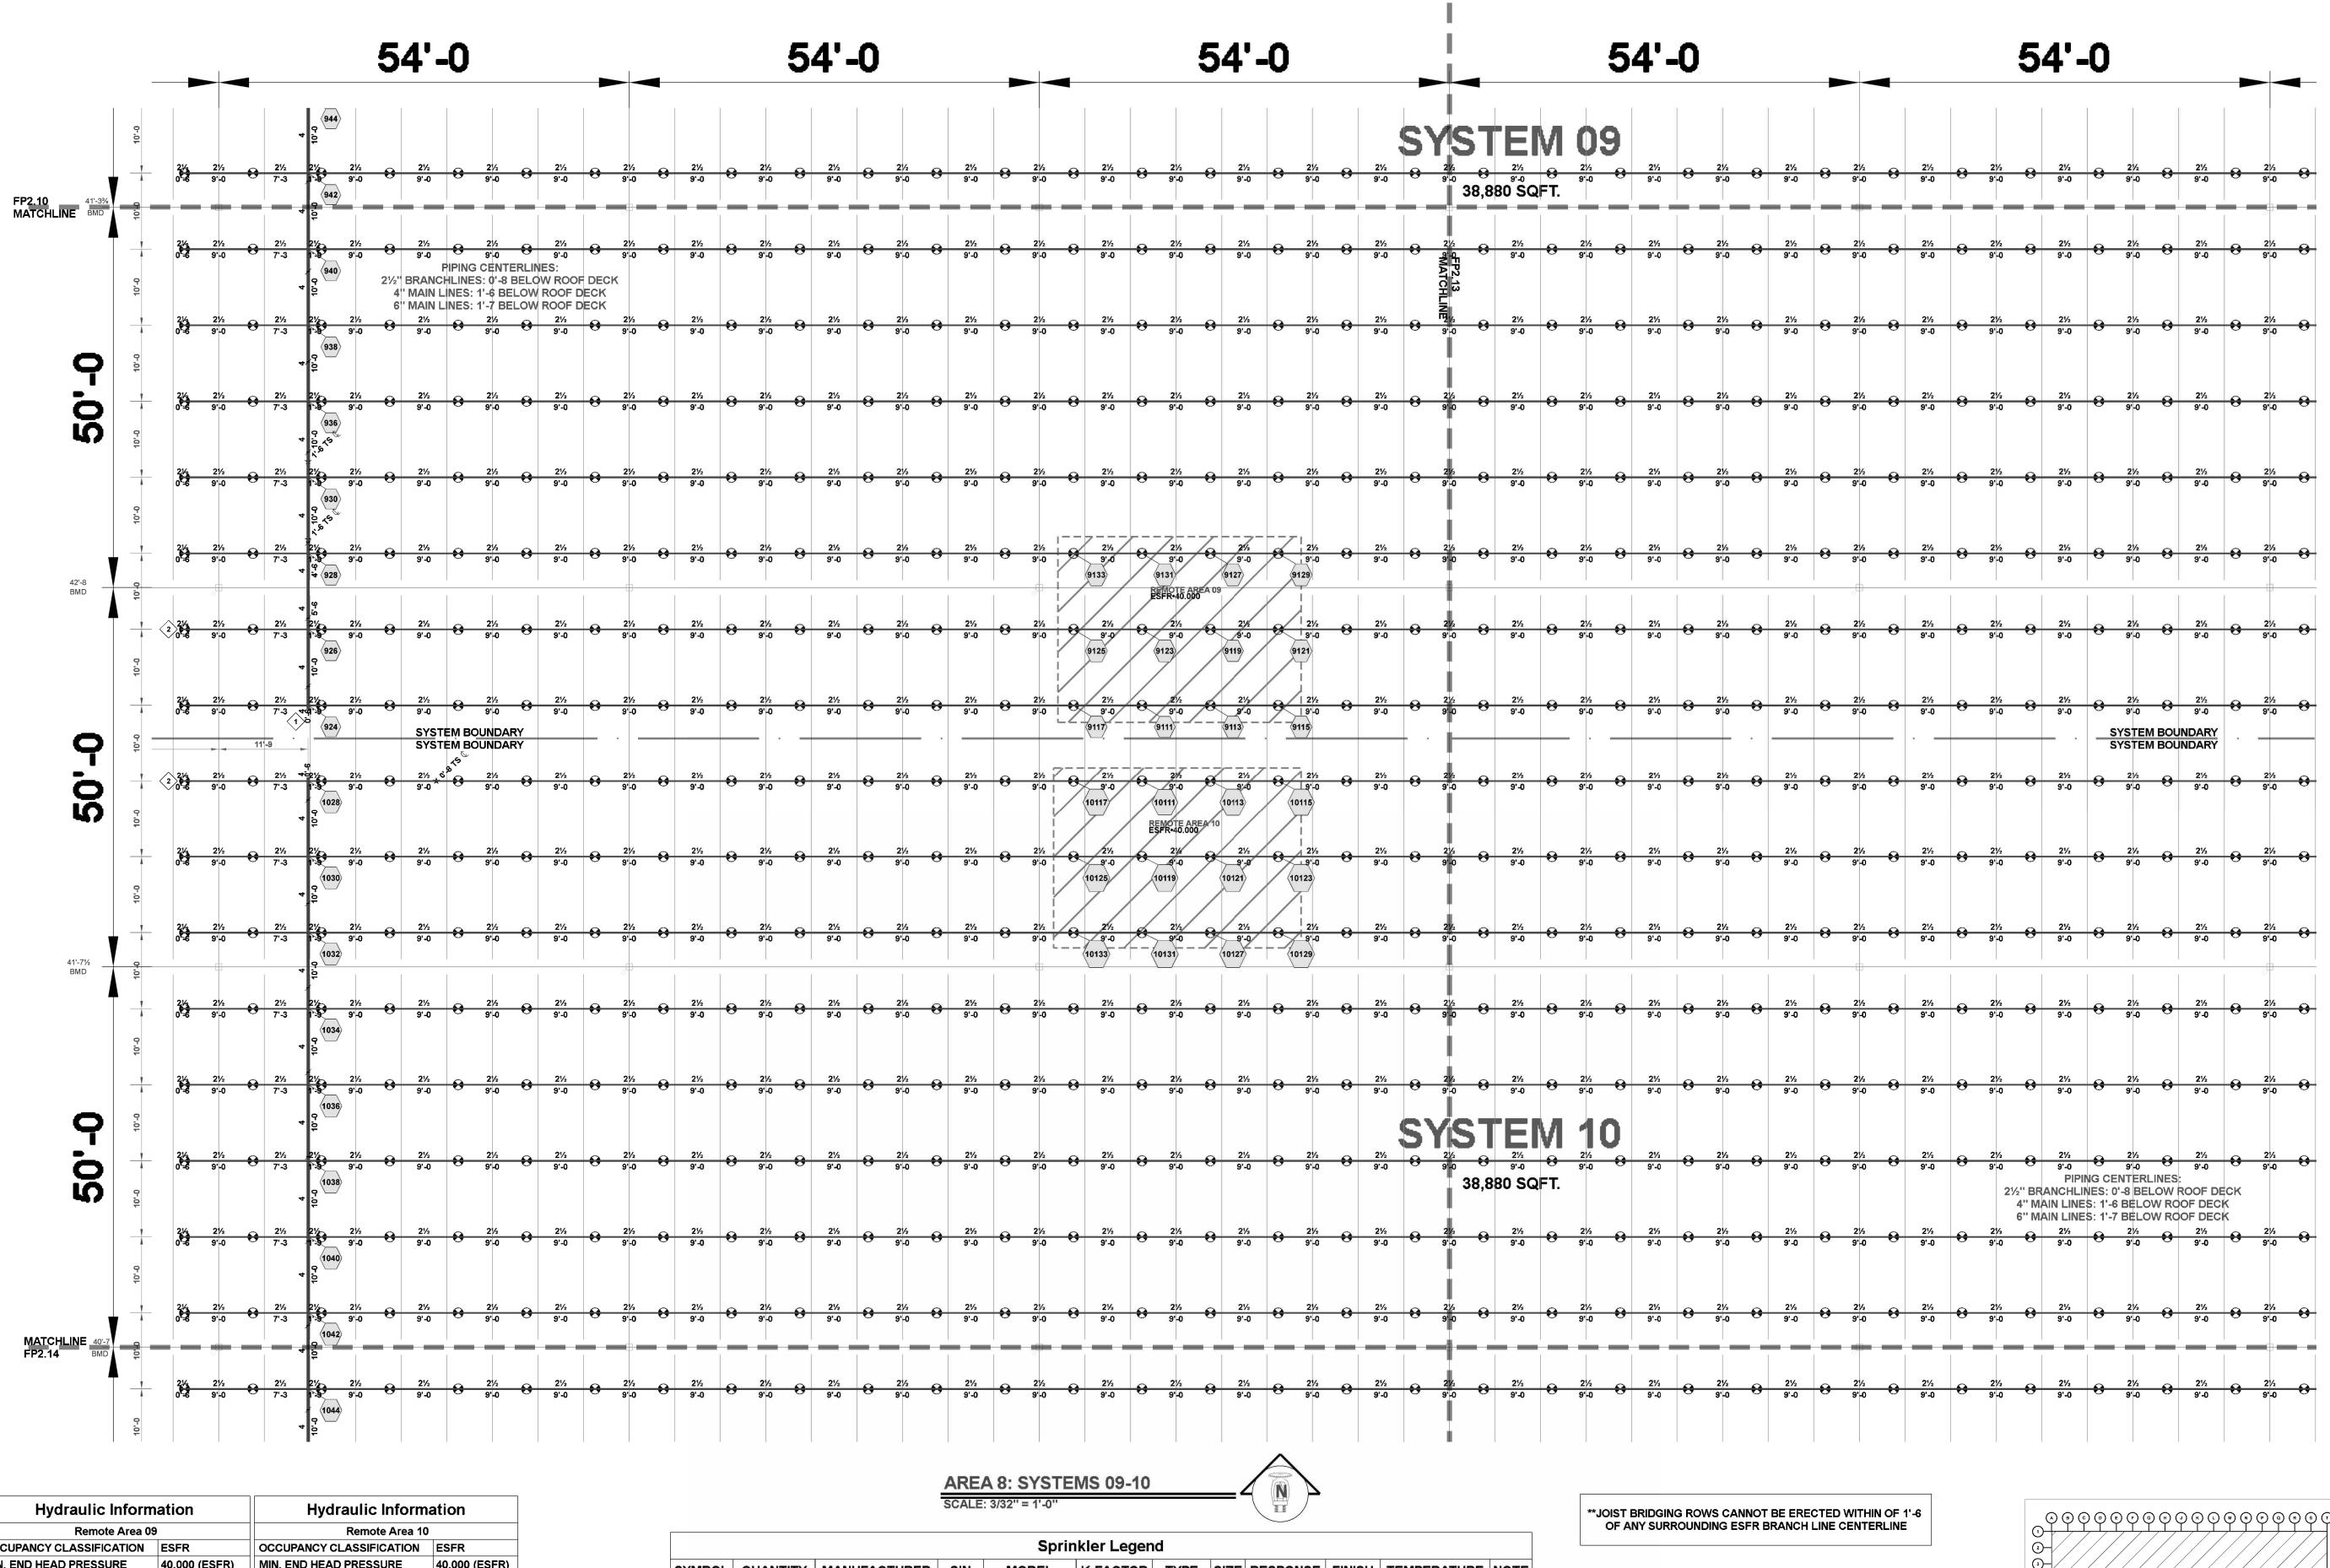

Hydraulic Inform	ation	Hydraulic Information				
Remote Area 09	)	Remote Area 10				
OCCUPANCY CLASSIFICATION	ESFR	OCCUPANCY CLASSIFICATION	ESFR			
MIN. END HEAD PRESSURE	40.000 (ESFR)	MIN. END HEAD PRESSURE	40.000 (ESFR)			
TOTAL HOSE STREAMS	250.00	TOTAL HOSE STREAMS	250.00			
TOTAL HEADS FLOWING	12	TOTAL HEADS FLOWING	12			
K-FACTOR	22.4	K-FACTOR	22.4			
TOTAL WATER REQUIRED	1956.70	TOTAL WATER REQUIRED	1958.59			
TOTAL PRESSURE REQUIRED	75.314	TOTAL PRESSURE REQUIRED	77.654			
BASE OF RISER (GPM)	1956.70	BASE OF RISER (GPM)	1958.59			
BASE OF RISER (PSI)	75.314	BASE OF RISER (PSI)	77.654			
SAFETY MARGIN (PSI)	+12.183 (13.9%)	SAFETY MARGIN (PSI)	+9.826 (11.2%)			

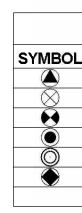

	Sprinkler Legend												
L	QUANTITY	MANUFACTURER	SIN	MODEL	K-FACTOR	TYPE	SIZE	RESPONSE	FINISH	TEMPERATURE	NOTE		
	2054	VICTAULIC	V4702	FL-QR/ST/ESFR	16.8	PENDENT	3/4	FAST	BRASS	200°F			
	4	VICTAULIC	V3406	V34	8	PENDENT	3/4	QUICK	BRASS	200°F			
	2754	VICTAULIC	V3428	ESFR	22.4	PENDENT	1	FAST	BRASS	200°F			
	48	VIKING	VK600	MICROFAST	5.6	PENDENT	1/2	QUICK	CHROME	135°F			
	6	VIKING	VK3021		5.6	PENDENT	1/2	QUICK	CHROME	135°F			
	368	VIKING	VK504	ESFR DRY	16.8	PENDENT	3/4	QUICK	BRASS	205°F			
	TOTAL = 5234												
	50 (S)	50. St. St. St. St. St. St. St. St. St. St	10 TA							0 			

- AUXILIARY DRAIN SEE FP0.0 FOR DETAIL 2 - AIR VENT SEE FP0.0 FOR DETAIL



5719 LAWTON LOOP E. DR. #212 INDIANAPOLIS, IN 46216 O :: 317.288.0681 F :: 317.288.0753





CERTIFICATION

THIS DRAWING AND THE IDEAS, DESIGNS AND CONCEPTS CONTAINED HEREIN ARE THE EXCLUSIVE INTELLECTUAL PROPERTY OF CURRAN ARCHITECTURE, AND ARE NOT TO BE USED OR REPRODUCED, WHOLE OR IN PART, WITHOUT THE WRITTEN CONSENT OF CURRAN ARCHITECTURE.


OIECT INFORMATION

LEE'S SUMMIT LOGISTICS **BUILDING A LOT I** NW CORNER OF NE TUDOR RD & MAIN ST LEE'S SUMMIT, MO 64086


PERMIT SET 02.18.22 09.07.22




FP2.8.1 AREA 8: SYSTEMS 09-10

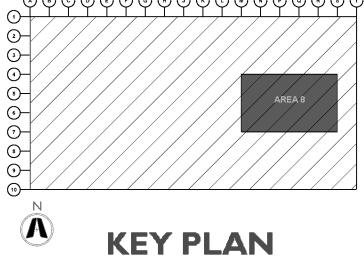



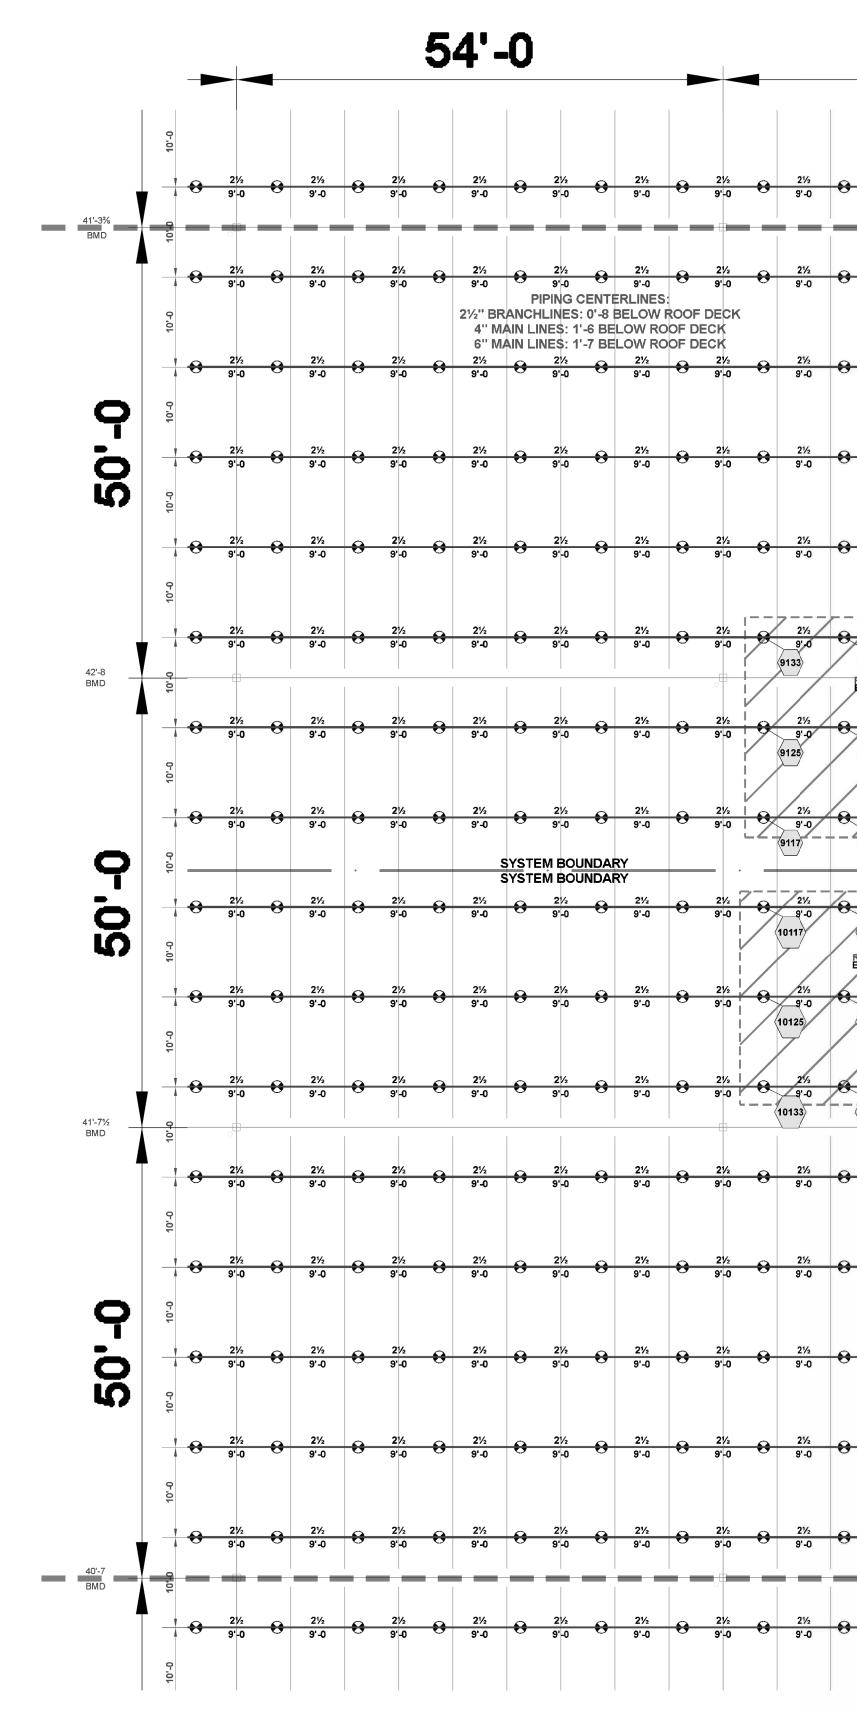

Hydraulic Inform	ation	Hydraulic Informa	ation
Remote Area 09	)	Remote Area 10	
OCCUPANCY CLASSIFICATION	ESFR	OCCUPANCY CLASSIFICATION	ESFR
MIN. END HEAD PRESSURE	40.000 (ESFR)	MIN. END HEAD PRESSURE	40.000 (ESFR)
TOTAL HOSE STREAMS	250.00	TOTAL HOSE STREAMS	250.00
TOTAL HEADS FLOWING	12	TOTAL HEADS FLOWING	12
K-FACTOR	22.4	K-FACTOR	22.4
TOTAL WATER REQUIRED	1956.70	TOTAL WATER REQUIRED	1958.59
TOTAL PRESSURE REQUIRED	75.314	TOTAL PRESSURE REQUIRED	77.654
BASE OF RISER (GPM)	1956.70	BASE OF RISER (GPM)	1958.59
BASE OF RISER (PSI)	75.314	BASE OF RISER (PSI)	77.654
SAFETY MARGIN (PSI)	+12.183 (13.9%)	SAFETY MARGIN (PSI)	+9.826 (11.2%)

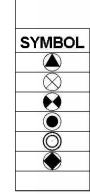

Ę	54'·	-0							Ę	54'	-0									5	4'-	0	
21/2	21/2	0 21/		2½	SY			Μ	09	01/		21/2		21⁄2	0	21/2	21/2		21/2	0	21⁄2		21/2
9-0	9'-0	9'-(	8	9'-0	9	38,8	2½ 9'-0 80 SG	₽FT.	2½ 9'-0	9'-0		9'-0	•	9'-0		2/2 9'-0	9'-0		9'-0		9'-0		9'-0
2½ 9'-0	€ 2½ 9'-0	€ 2½ 9'-0		2½ 9'-0	2 <sup>9</sup> FP2.12		2½ 9'-0	8	2½ 9'-0	2½ 9'-0	•	2½ 9'-0	•	2½ 9'-0	8	2½ 9'-0 €	2½ 9'-0	0	2½ 9'-0	8	2½ 9'-0	8	2½ 9'-0
2½ 9'-0	<del>2½</del> 9'-0	<del>21/</del> 9'-0	8	2½ 9'-0	<del>8</del> 9		2½ 9'-0	8	2½ 9'-0	2½ 9'-0	•	2½ 9'-0	-8-	2½ 9'-0	8	2½ 9'-0 €	2½ 9'-0	8	2½ 9'-0	8	2½ 9'-0	8	2½ 9'-0
2½ 9'-0	€ 2½ 9'-0	2½ 9'-(		2½ 9'-0	2 9 9	<sup>1/2</sup> -0 😯	2½ 9'-0	8	2½ 9'-0	2½ 9'-0	8	2½ 9'-0	•	2½ 9'-0		2½ 9'-0 €	2½ 9'-0	8	2½ 9'-0	8	2½ 9'-0	8	2½ 9'-0
2½ 9'-0	€ 2½ 9'-0	€ 2½ 9'-0		<u>2½</u> 9'-0		<sup>½</sup> -0 €	2½ 9'-0	8	2½ 9'-0	2½ 9'-0	•	2½ 9'-0	•	2½ 9'-0		2½ 9'-0	2½ 9'-0	8	2½ 9'-0	8	2½ 9'-0	8	2½ 9'-0
21/2 9-0 9131 BEMOLE ARE ESFR-40.000	2 <sup>1</sup> / <sub>2</sub> 9'-0 9127 A 09	9'-0 9129		2½ 9'-0		<sup>½</sup> ₂ ↔	2½ 9'-0	8	2½ 9'-0	2½ 9'-0	0	2½ 9'-0	•	2½ 9'-0		2½ 9'-0 €	2½ 9'-0	8	2½ 9°-0	8	2½ 9'-0	0	2½ 9'-0
9'-0 9123	9119 9119	9121 I		2½ 9'-0	<del>9</del> 9'	<sup>₩</sup> 2 ↔	2½ 9'-0	8	2½ 9'-0	2½ 9'-0	8	2½ 9'-0	•	2½ 9'-0		2½ 9'-0	2½ 9'-0	8	2½ 9'-0	8	2½ 9'-0	8	2½ 9'-0
9111 9111	9113 9113	9115		2½ 9'-0	€ 2 9	<sup>1⁄2</sup> −0 ↔	2½ 9'-0		2½ 9'-0	2½ 9'-0	•	21⁄2 9'-0	•	21/2 9'-0		2½ 9'-0	2½ 9'-0	•	2½ 9'-0	8	2½ 9'-0	•	2½ 9'-0
24/2 9-0 10111 REMOTE ARE/ ESFR-40.000	2½ 9'-0 10113	10115		2½ 9'-0	<mark>€ 2</mark> 9	<sup>¥₂</sup> ↔	2½ 9'-0	8	21/2 9'-0	3-0	•	2½ 9'-0	8	2½ 9'-0		2½ 9'-0 €	3-0	8	2½ 9'-0	8	2½ 9'-0	8	2½ 9'-0
21/2 3 5 0 10119	2½ 9°-0 10121	10123		2½ 9'-0	<del>9</del> 9	<sup>½</sup> 2 ↔	<u>2½</u> 9'-0	8	2½ 9'-0 €		•	2½ 9'-0	•	<u>2½</u> 9'-0		2½ 9'-0 €		8	2½ 9'-0	8	2½ 9'-0	8	2½ 9'-0
21/2 9 9 0 - 10131	9'-0 10127	10129		<u>2½</u> 9'-0	€ 2 9'	<sup>½</sup> -0 ↔	<u>2½</u> 9'-0	8	2½ 9'-0		•	2½ 9'-0	•	<u>2½</u> 9'-0		2½ 9'-0 €		•	2½ 9'-0	8	2½ 9'-0	•	<u>2½</u> 9'-0
2½ 9'-0	9'-0	2½ 9'-(		2½ 9'-0	<del>9</del> 9	<sup>1/2</sup> -0 😌	<u>2½</u> 9'-0	8	2½ 9'-0 €	2½ 9'-0	8	2½ 9'-0	•	2½ 9'-0		2½ 9'-0 €	<u>2½</u> 9'-0	8	2½ 9'-0	8	<u>2½</u> 9'-0	8	2½ 9'-0
2½ 9'-0	€ 2½ 9'-0	2½ 9'-(		2½ 9'-0	。 SY	° ST	2½ 9'-0	• M	<sup>2½</sup> 9'-0 <b>10</b>	<u>2½</u> 9'-0	•	2½ 9'-0	•	<u>2½</u> 9'-0		2½ 9'-0 €	2½ 9'-0	8	2½ 9'-0	8	<u>2½</u> 9'-0	8	2½ 9'-0
2½ 9'-0	€ 2½ 9'-0	2½ 9'-(		2½ 9'-0	€ 9 9	<sup>½</sup> 38,8	2½ 9'-0 80 SG	₽ RFT.	2½ 3'-0 €	<u>2½</u> 9'-0	•	2½ 9'-0	•	<u>2½</u> 9'-0		2½ 9'-0 €	2½ 9'-0	8	2½ 9'-0	8	<u>2½</u> 9'-0	8	2½ 9'-0
2½ 9'-0	€ 2½ 9'-0	2½ 9'-(		2½ 9'-0	2 9'	<sup>₩</sup> 2 -0 ↔	2½ 9'-0	8	2½ 9'-0	2½ 9'-0	8	2½ 9'-0	•	2½ 9'-0		2½ 9'-0 €	2½ 9'-0	8	2½ 9'-0	8	2½ 9'-0	8	2½ 9'-0
2½ 9°-0	2½           9'-0	2½ 9'-0		2½ 9'-0	2 9		2½ 9'-0	8	2½ 9'-0	2½ 9'-0	8	2½ 9'-0	8	2½ 9'-0		2½ 9'-0 €	2½ 9'-0	8	2½ 9'-0	8	2½ 9'-0	8	2½ 9'-0
2 <sup>1</sup> /2 9 <sup>1</sup> -0	€ 2½ 9'-0	9°-0		2½ 9'-0	2 9'	<sup>1</sup> ⁄₂ -0 ↔	2½ 9'-0	8	2½ 9'-0	2½ 9'-0	8	2½ 9'-0	8	2½ 9'-0		2½ 9'-0 €	2½ 9'-0	8	2½ 9'-0	8	2½ 9'-0	8	21/2 9'-0


\*\*JOIST BRIDGING ROWS CANNOT BE ERECTED WITHIN OF 1'-6 OF ANY SURROUNDING ESFR BRANCH LINE CENTERLINE




	Sprinkler Legend										
L	QUANTITY	MANUFACTURER	SIN	MODEL	K-FACTOR	TYPE	SIZE	RESPONSE	FINISH	TEMPERATURE	NOTE
	2054	VICTAULIC	V4702	FL-QR/ST/ESFR	16.8	PENDENT	3⁄4	FAST	BRASS	200°F	
	4	VICTAULIC	V3406	V34	8	PENDENT	3/4	QUICK	BRASS	200°F	
	2754	VICTAULIC	V3428	ESFR	22.4	PENDENT	1	FAST	BRASS	200°F	
	48	VIKING	VK600	MICROFAST	5.6	PENDENT	1/2	QUICK	CHROME	135°F	
	6	VIKING	VK3021		5.6	PENDENT	1/2	QUICK	CHROME	135°F	
	368	VIKING	VK504	ESFR DRY	16.8	PENDENT	3/4	QUICK	BRASS	205°F	
	TOTAL = 5234										

SCALE: 3/32" = 1'-0"


- AUXILIARY DRAIN SEE FP0.0 FOR DETAIL 2 - AIR VENT SEE FP0.0 FOR DETAIL

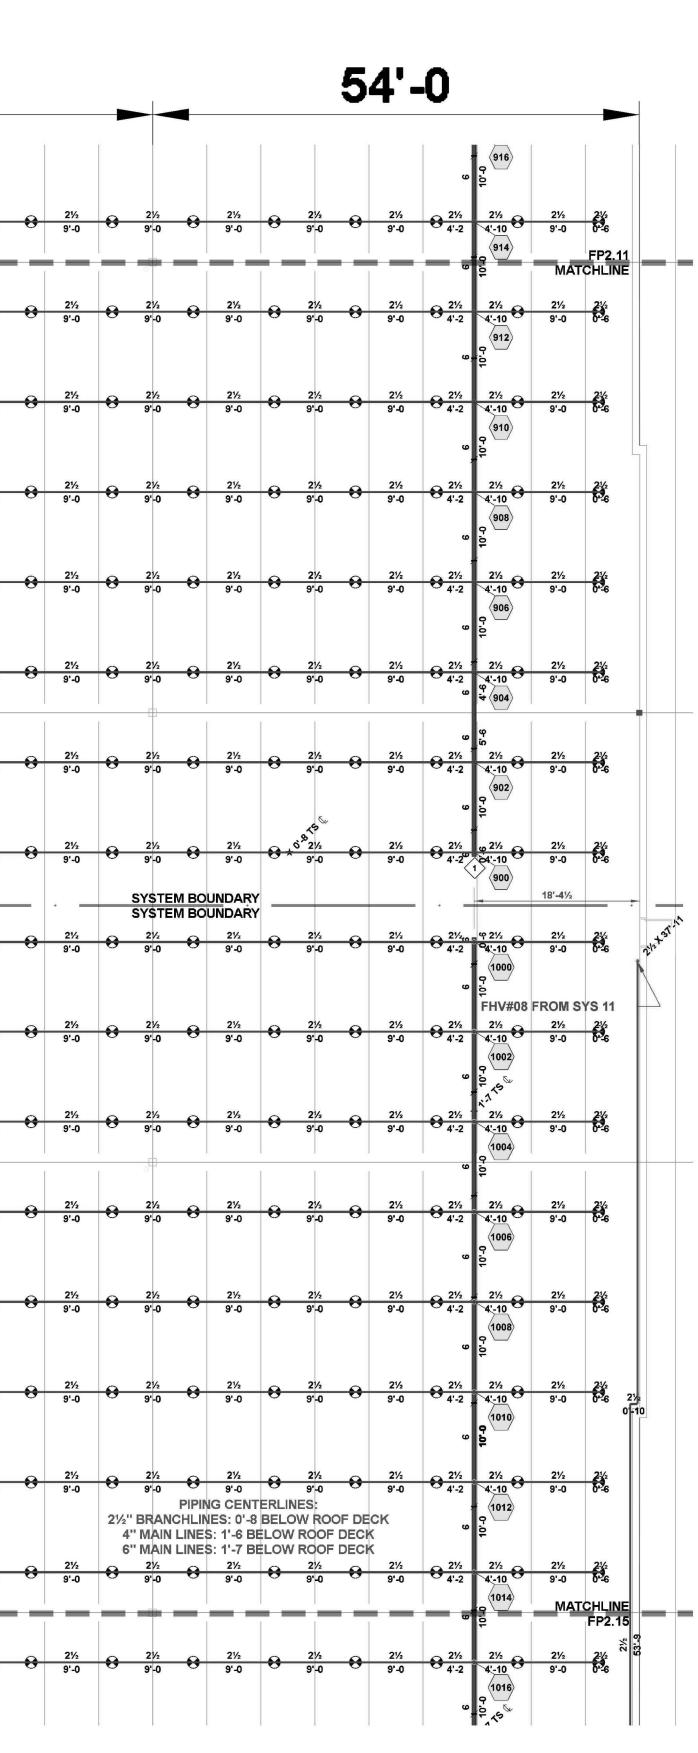

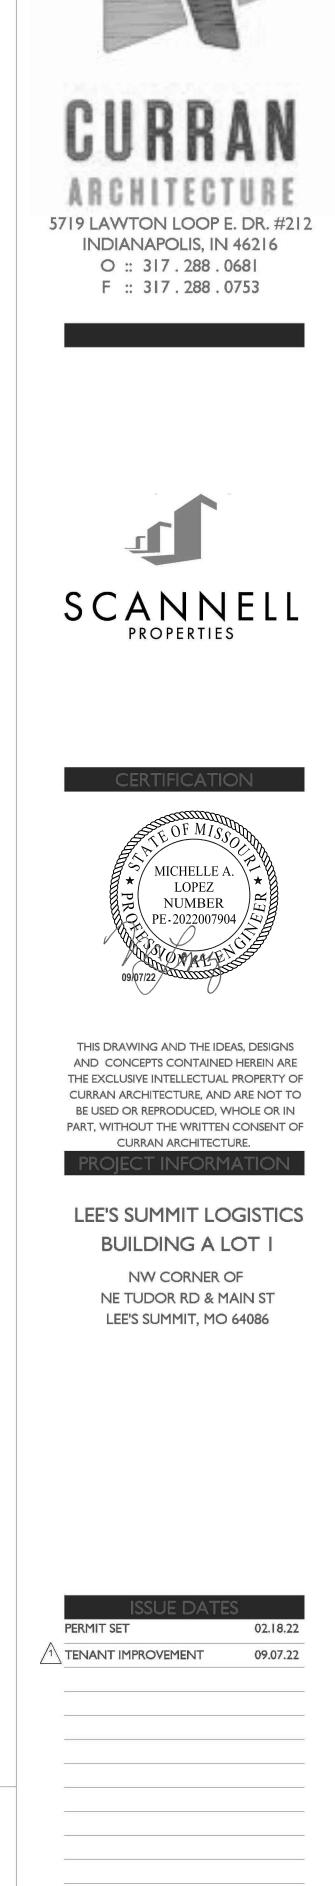


210300


FP2.8.2 AREA 8 (CONT.): SYSTEMS 09-10

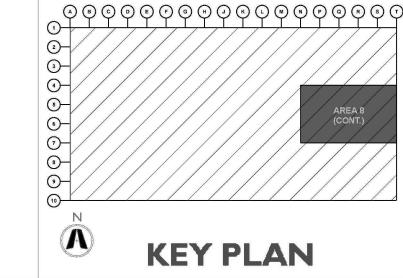



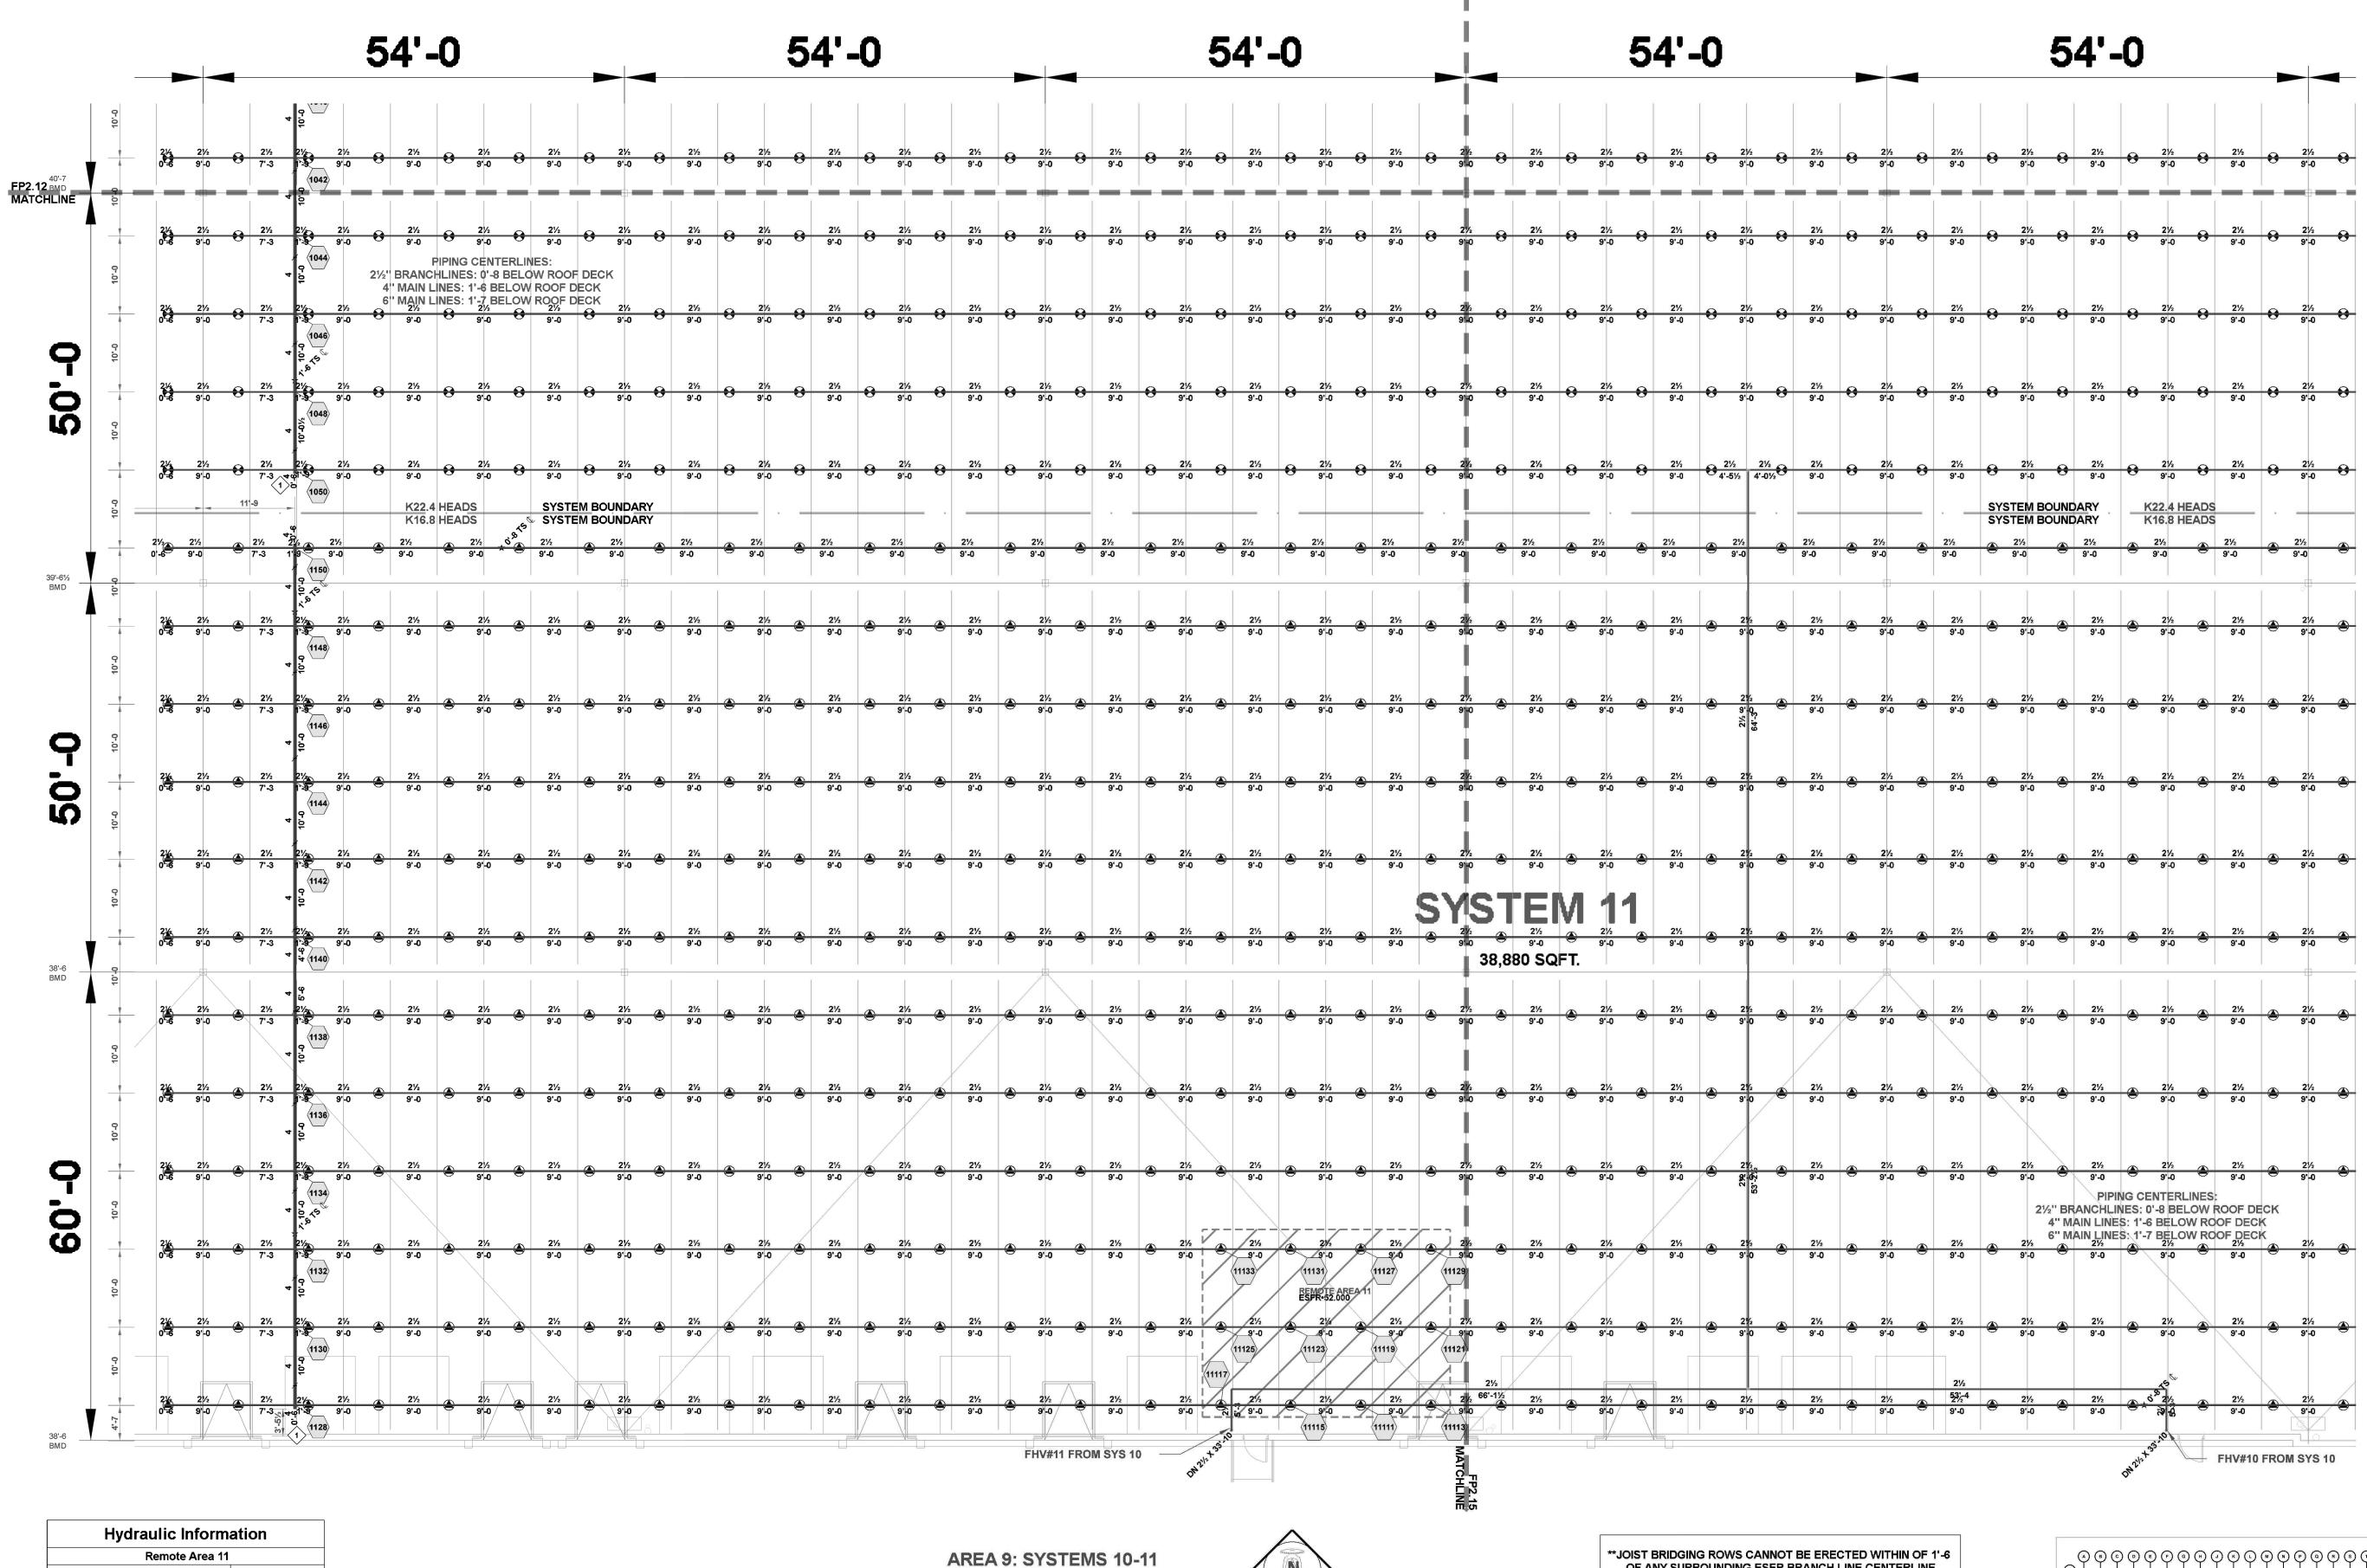


Hydraulic Inform	nation					
Remote Area 11						
OCCUPANCY CLASSIFICATION	ESFR					
MIN. END HEAD PRESSURE	52.000 (ESFR)					
TOTAL HOSE STREAMS	250.00					
TOTAL HEADS FLOWING	12					
K-FACTOR	16.8					
TOTAL WATER REQUIRED	1708.55					
TOTAL PRESSURE REQUIRED	79.115					
BASE OF RISER (GPM)	1708.55					
BASE OF RISER (PSI)	79.115					
SAFETY MARGIN (PSI)	+10.490 (11.7%)					

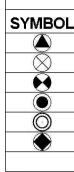

SCALE: 3/32" = 1'-0"

	Sprinkler Legend										
C	QUANTITY	ITY MANUFACTURER SIN MODEL K-FACTOR TYPE SIZE RESPONSE FINISH TEMPERATURE									NOTE
	2054	VICTAULIC	V4702	FL-QR/ST/ESFR	16.8	PENDENT	3/4	FAST	BRASS	200°F	
	4	VICTAULIC	V3406	V34	8	PENDENT	3/4	QUICK	BRASS	200°F	
	2754	VICTAULIC	V3428	ESFR	22.4	PENDENT	1	FAST	BRASS	200°F	
	48	VIKING	VK600	MICROFAST	5.6	PENDENT	1/2	QUICK	CHROME	135°F	
	6	VIKING	VK3021		5.6	PENDENT	1/2	QUICK	CHROME	135°F	
	368	VIKING	VK504	ESFR DRY	16.8	PENDENT	3⁄4	QUICK	BRASS	205°F	
	TOTAL = 5234										



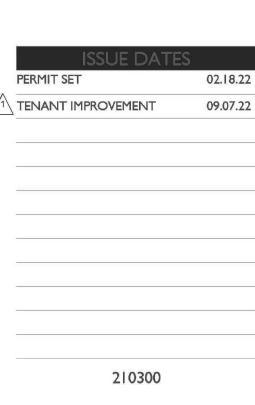

LEE'S SUMMIT LOGISTICS **BUILDING A LOT I** NW CORNER OF NE TUDOR RD & MAIN ST LEE'S SUMMIT, MO 64086

∽∕ MICHELLE A. LOPEZ NUMBER } Q\PE-2022007904 /

THIS DRAWING AND THE IDEAS, DESIGNS AND CONCEPTS CONTAINED HEREIN ARE THE EXCLUSIVE INTELLECTUAL PROPERTY OF

CURRAN ARCHITECTURE, AND ARE NOT TO

BE USED OR REPRODUCED, WHOLE OR IN

PART, WITHOUT THE WRITTEN CONSENT OF

CURRAN ARCHITECTURE. OIECT INFORMATION




CERTIFICATION

SCANNELL PROPERTIES


5719 LAWTON LOOP E. DR. #212 INDIANAPOLIS, IN 46216 O :: 317.288.0681

F :: 317.288.0753


OF ANY SURROUNDING ESFR BRANCH LINE CENTERLINE

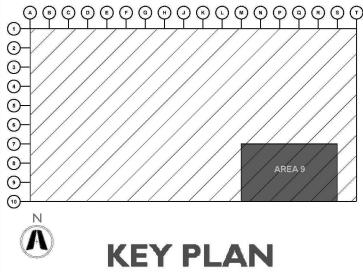

FP2.9.1 AREA 9: SYSTEMS 10-11

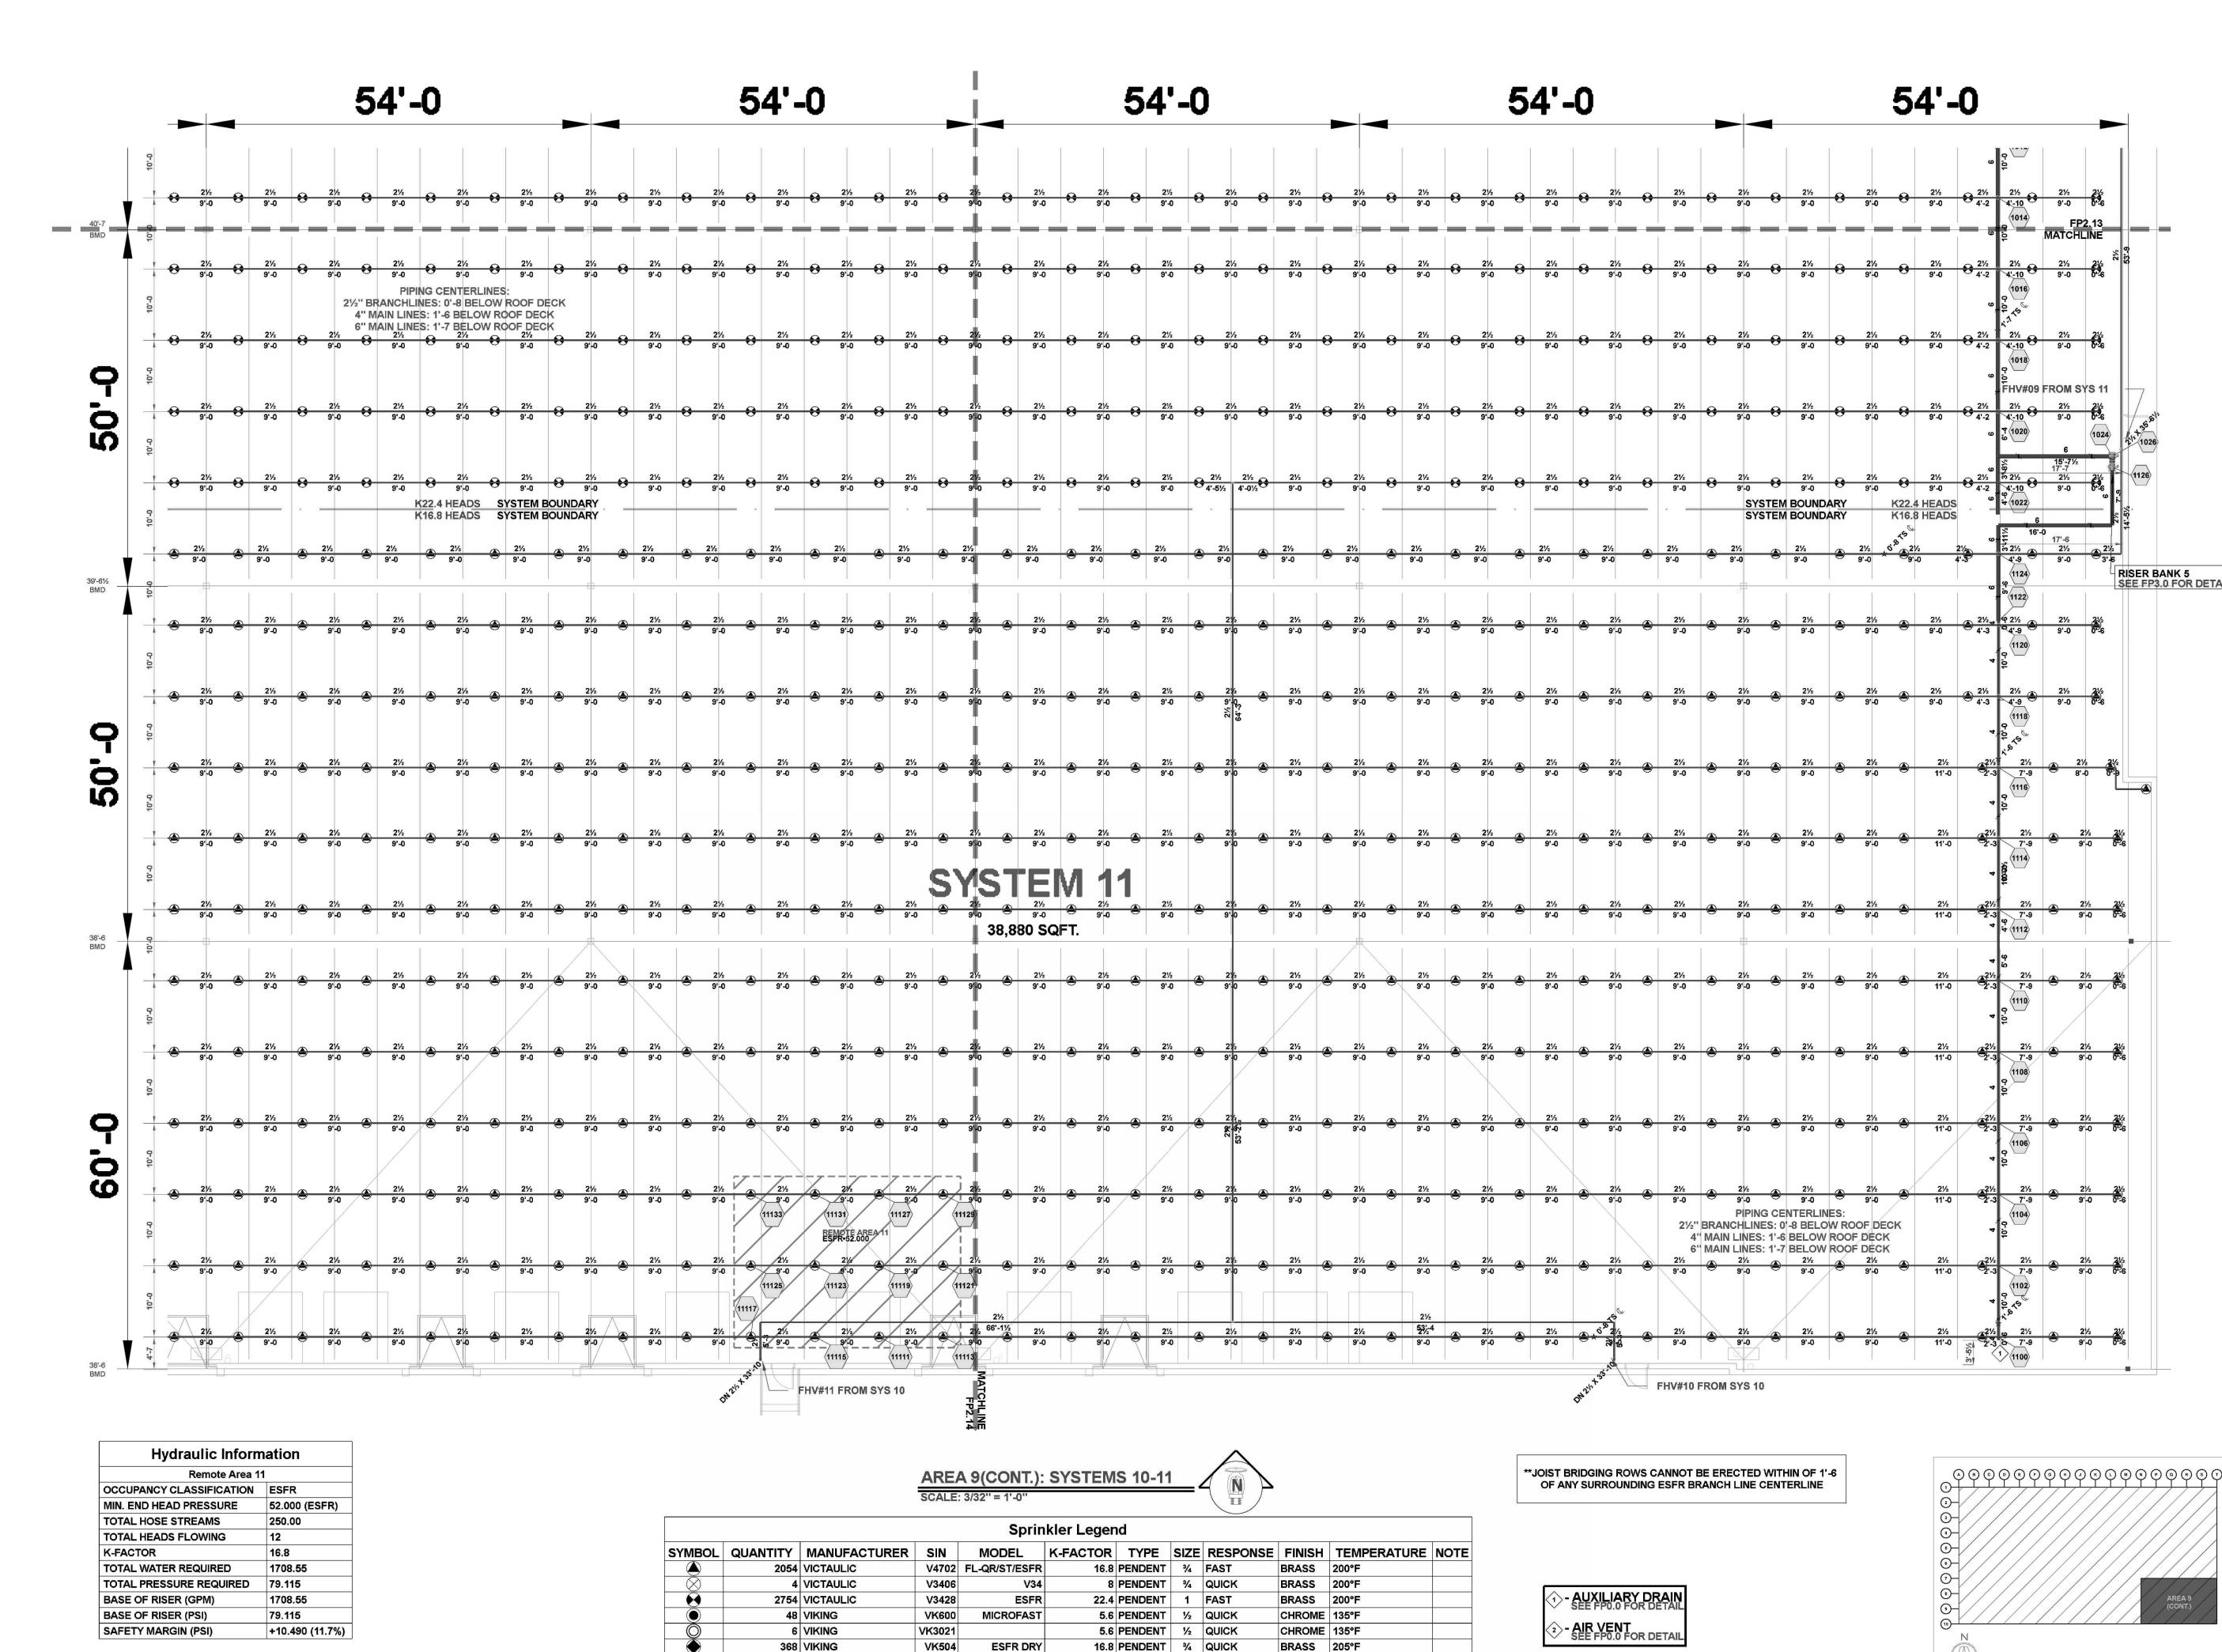


Hydraulic Information						
Remote Area 11						
OCCUPANCY CLASSIFICATION	ESFR					
MIN. END HEAD PRESSURE	52.000 (ESFR)					
TOTAL HOSE STREAMS	250.00					
TOTAL HEADS FLOWING	12					
K-FACTOR	16.8					
TOTAL WATER REQUIRED	1708.55					
TOTAL PRESSURE REQUIRED	79.115					
BASE OF RISER (GPM)	1708.55					
BASE OF RISER (PSI)	79.115					
SAFETY MARGIN (PSI)	+10.490 (11.7%)					

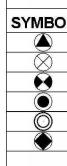


TOTAL = 5234




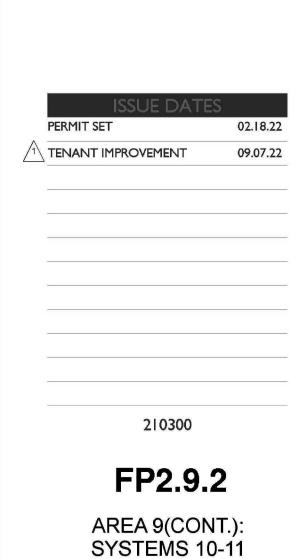

**KEY PLAN** 

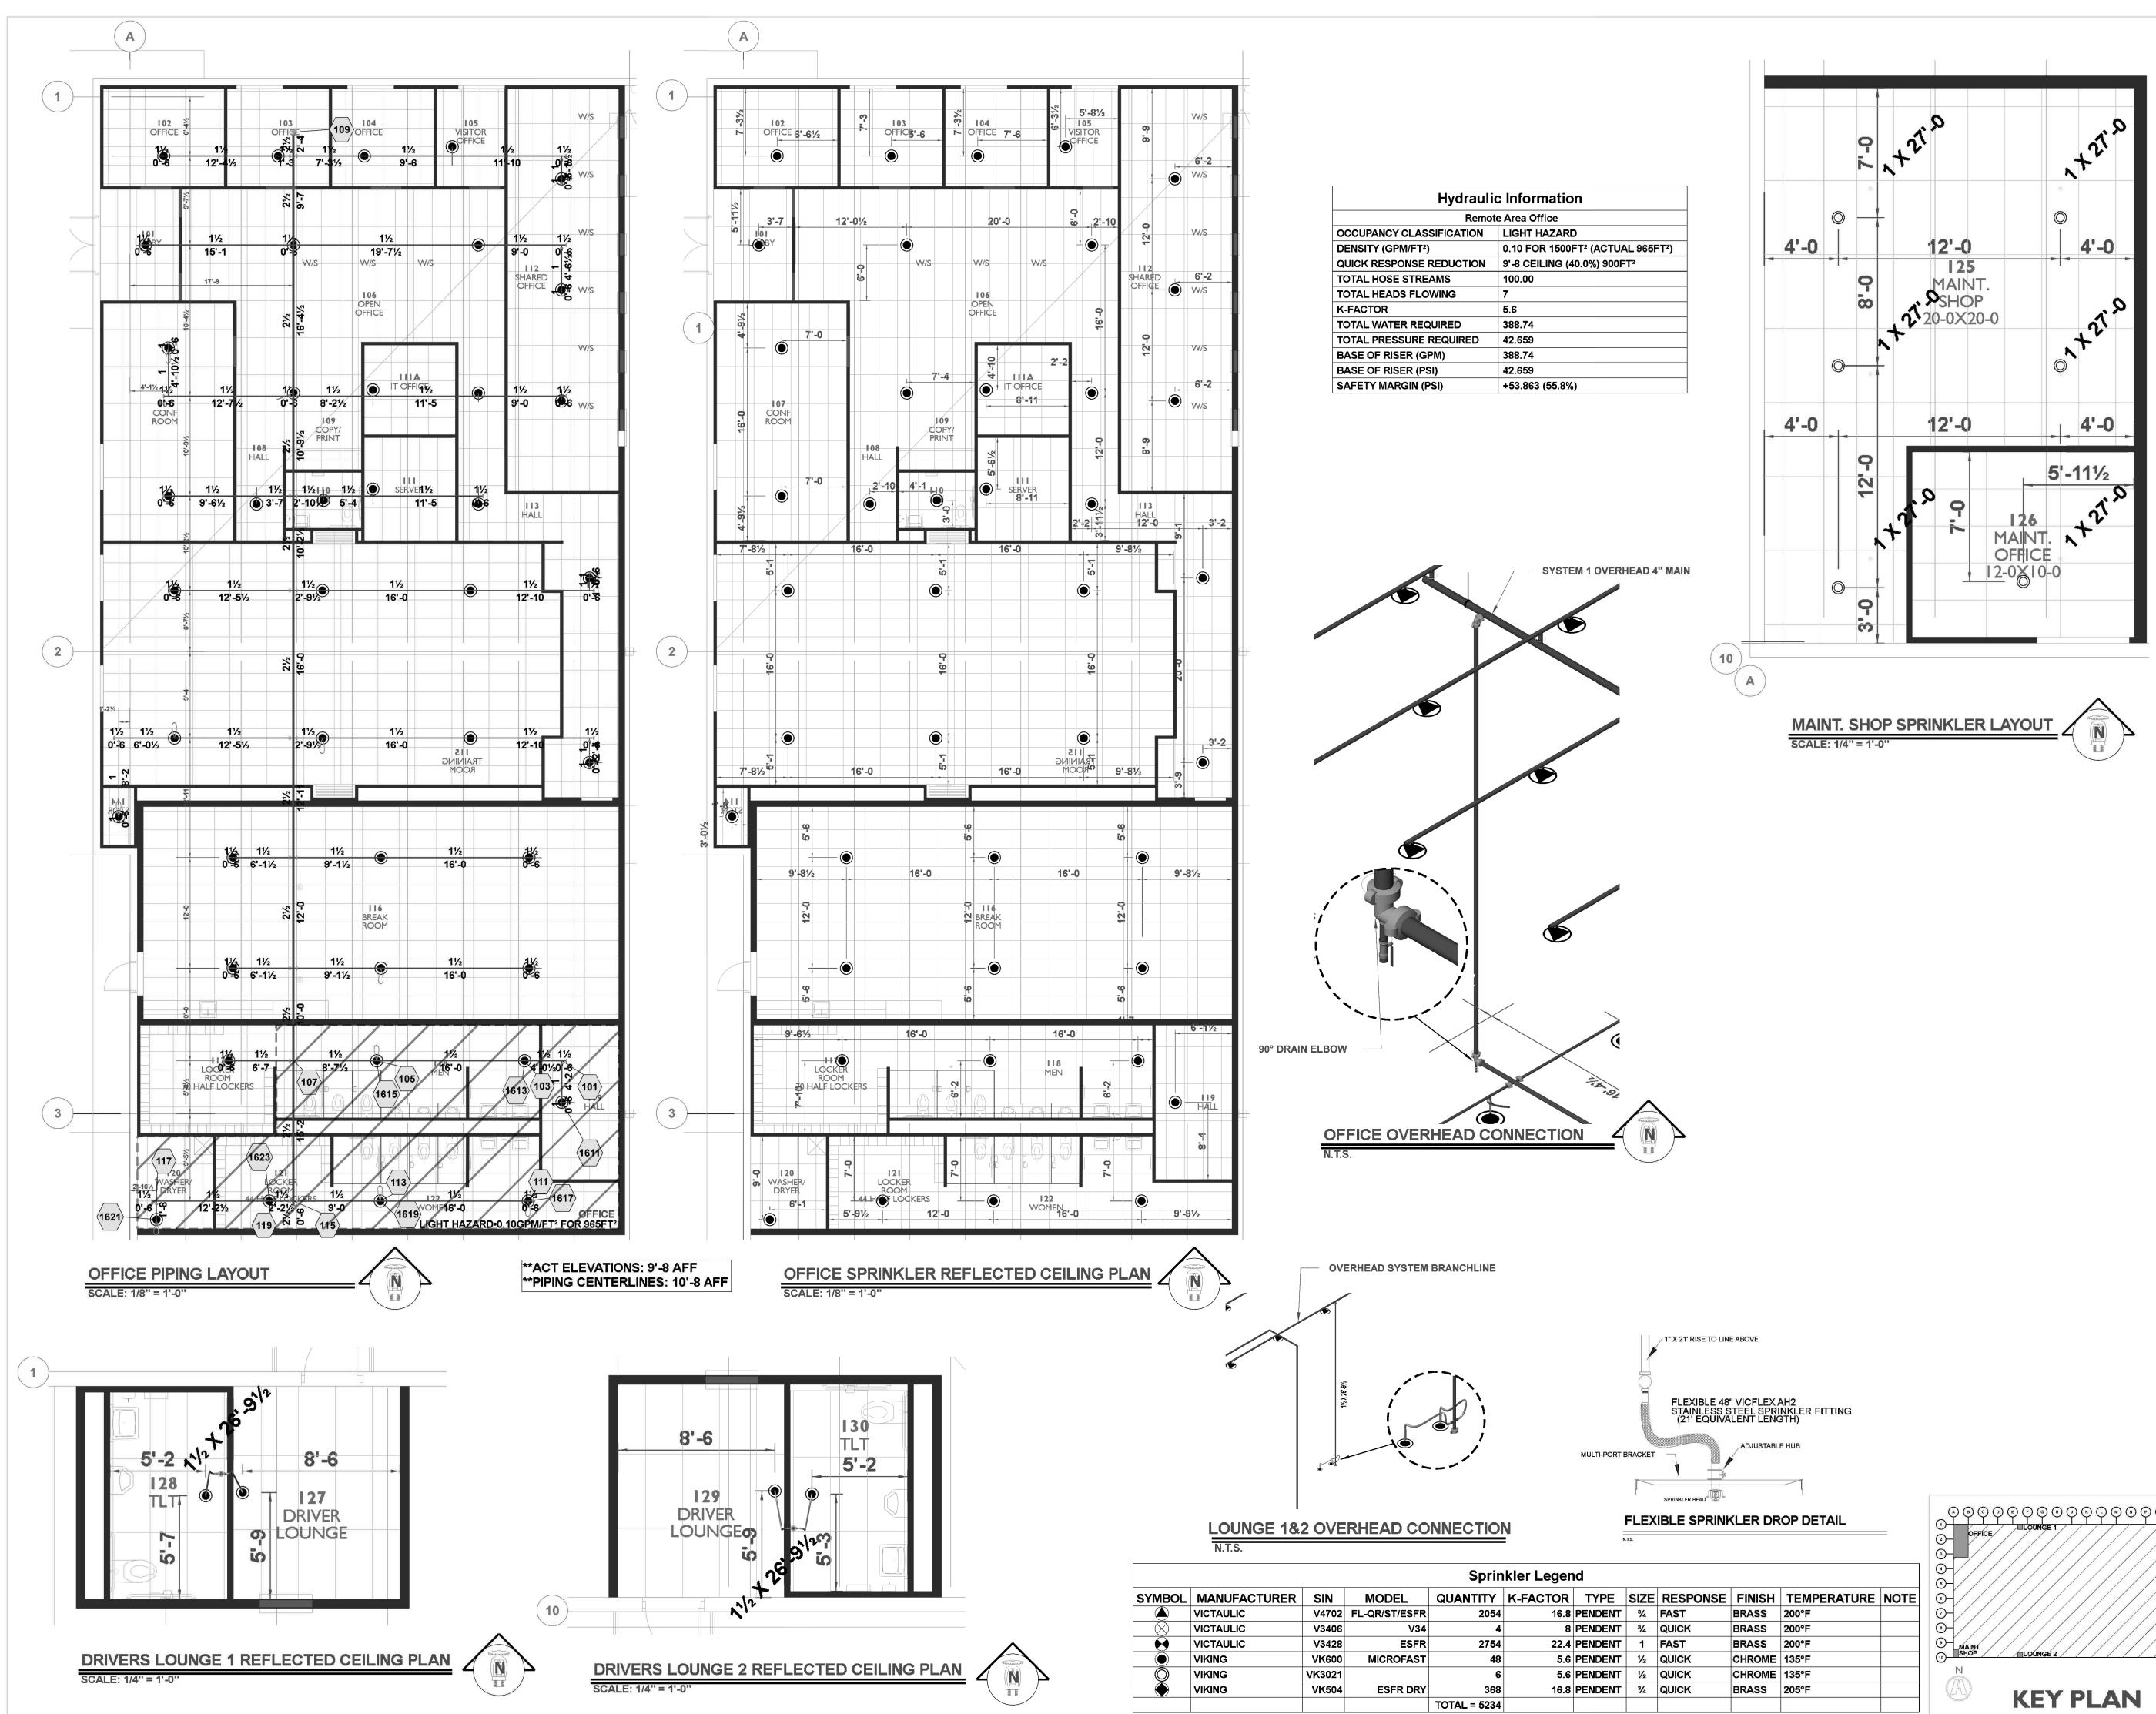

RESPONSE	FINISH	TEMPERATURE	NOTE
AST	BRASS	200°F	
UICK	BRASS	200°F	
AST	BRASS	200°F	
UICK	CHROME	135°F	
UICK	CHROME	135°F	
UICK	BRASS	205°F	

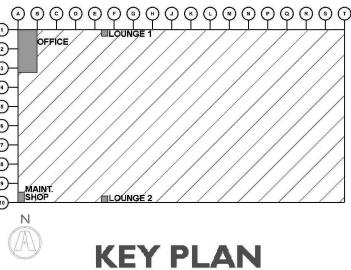

**ISSUE DATES** PERMIT SET 02.18.22 1 TENANT IMPROVEMENT 09.07.22

210300

FP2.10

TENANT

IMPROVEMENT


OFFICE PLAN


BUILDING A LOT I NW CORNER OF NE TUDOR RD & MAIN ST LEE'S SUMMIT, MO 64086


LEE'S SUMMIT LOGISTICS

THIS DRAWING AND THE IDEAS, DESIGNS AND CONCEPTS CONTAINED HEREIN ARE THE EXCLUSIVE INTELLECTUAL PROPERTY OF CURRAN ARCHITECTURE, AND ARE NOT TO BE USED OR REPRODUCED, WHOLE OR IN PART, WITHOUT THE WRITTEN CONSENT OF CURRAN ARCHITECTURE. PROJECT INFORMATION




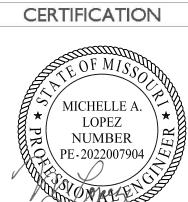

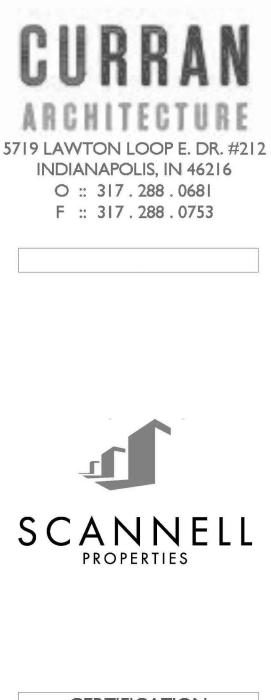

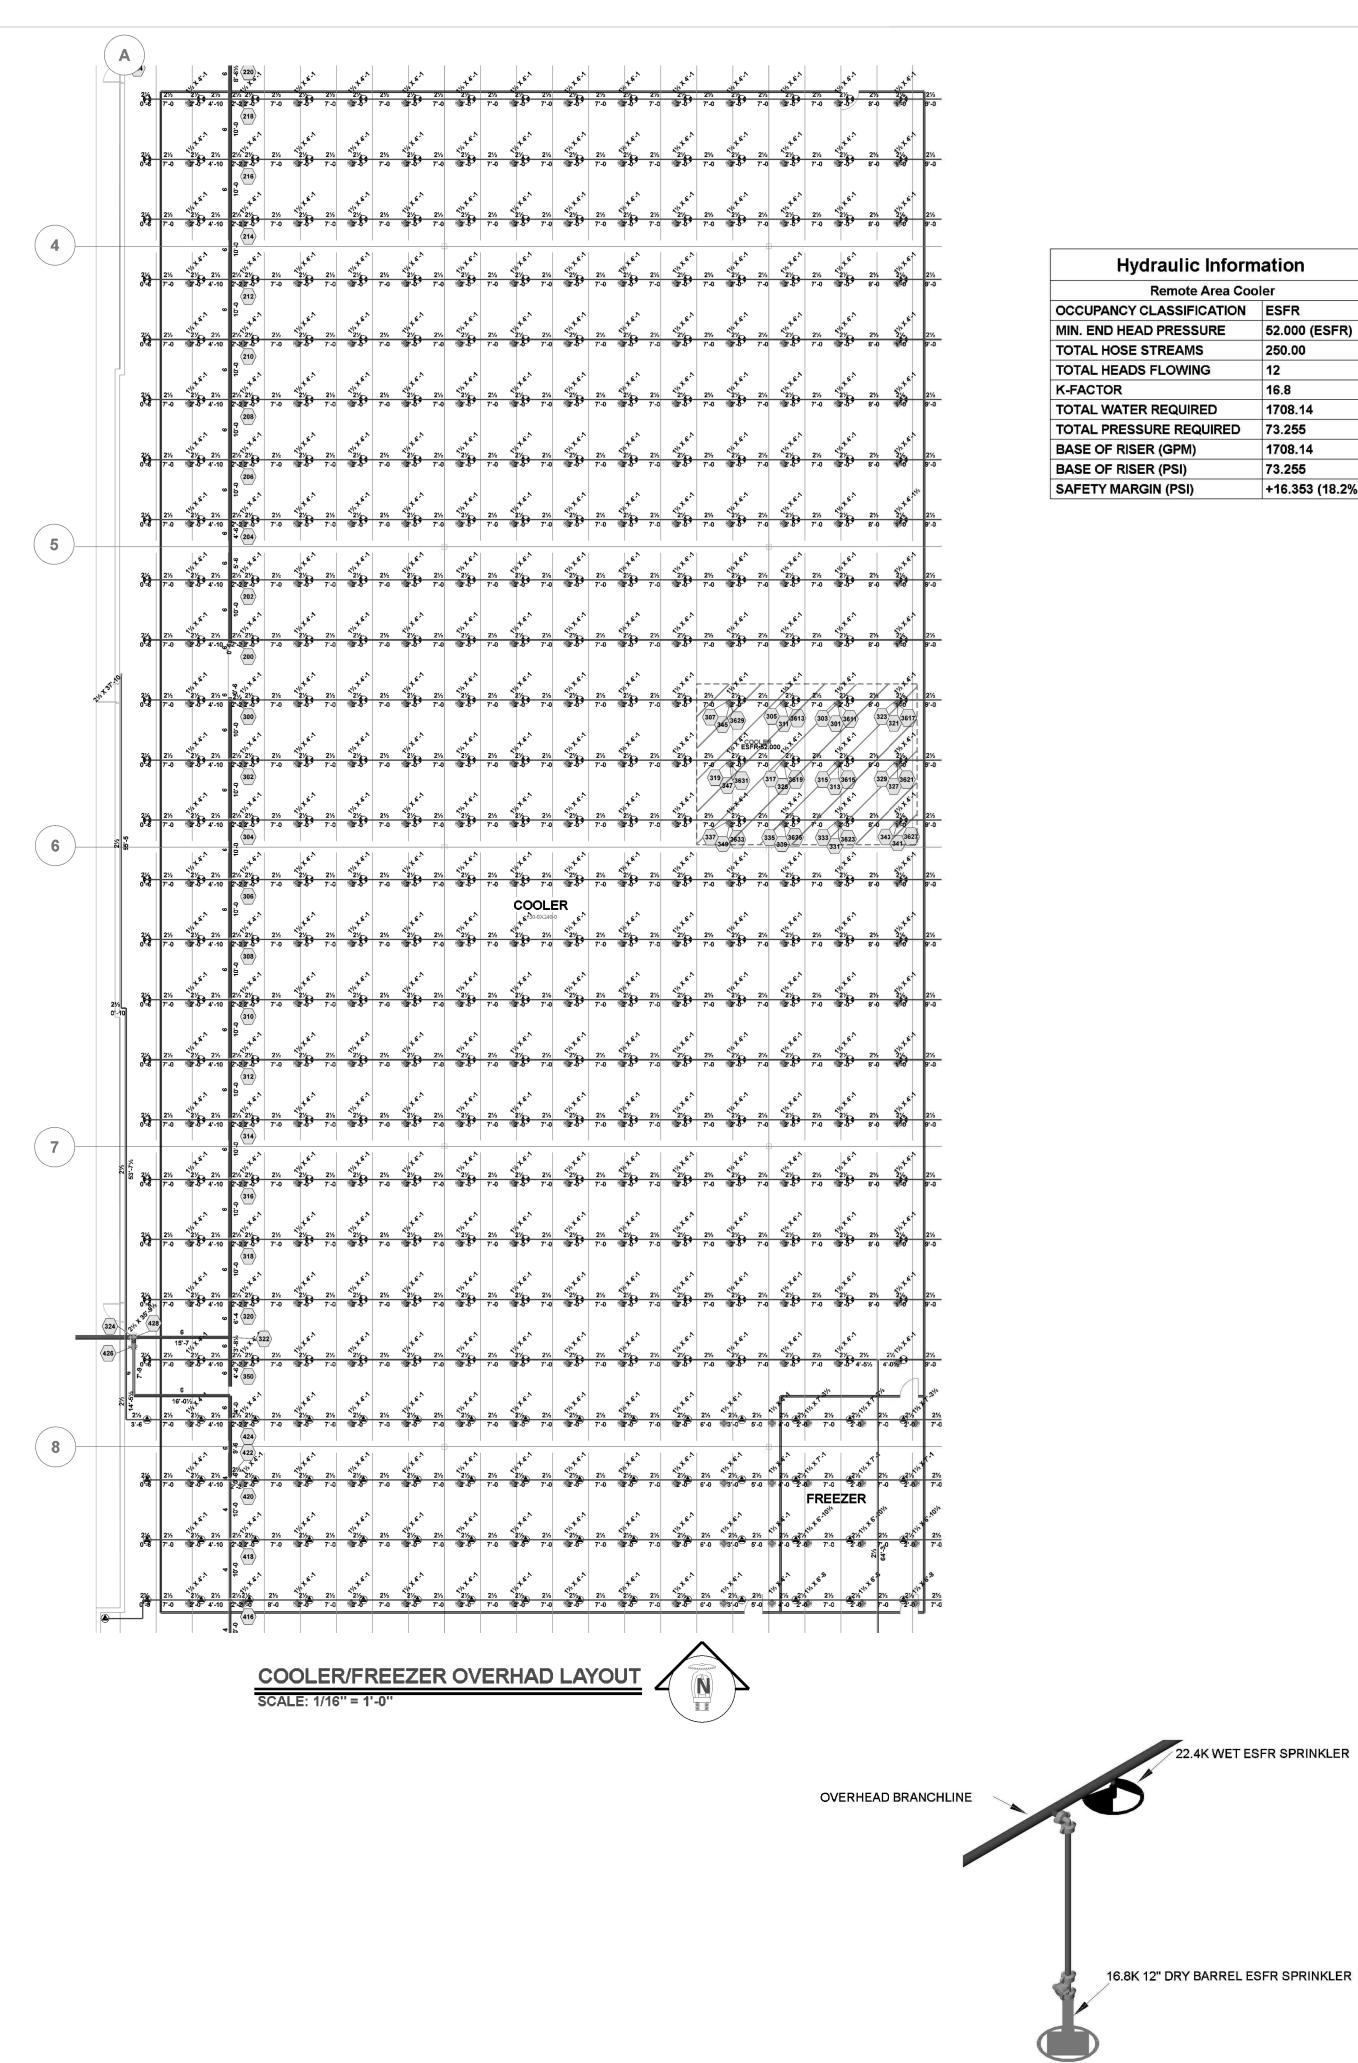


Hydraulic Inform	nation
Remote Area Coo	oler
OCCUPANCY CLASSIFICATION	ESFR
MIN. END HEAD PRESSURE	52.000 (ESFR)
TOTAL HOSE STREAMS	250.00
TOTAL HEADS FLOWING	12
K-FACTOR	16.8
TOTAL WATER REQUIRED	1708.14
TOTAL PRESSURE REQUIRED	73.255
BASE OF RISER (GPM)	1708.14
BASE OF RISER (PSI)	73.255
SAFETY MARGIN (PSI)	+16.353 (18.2%)

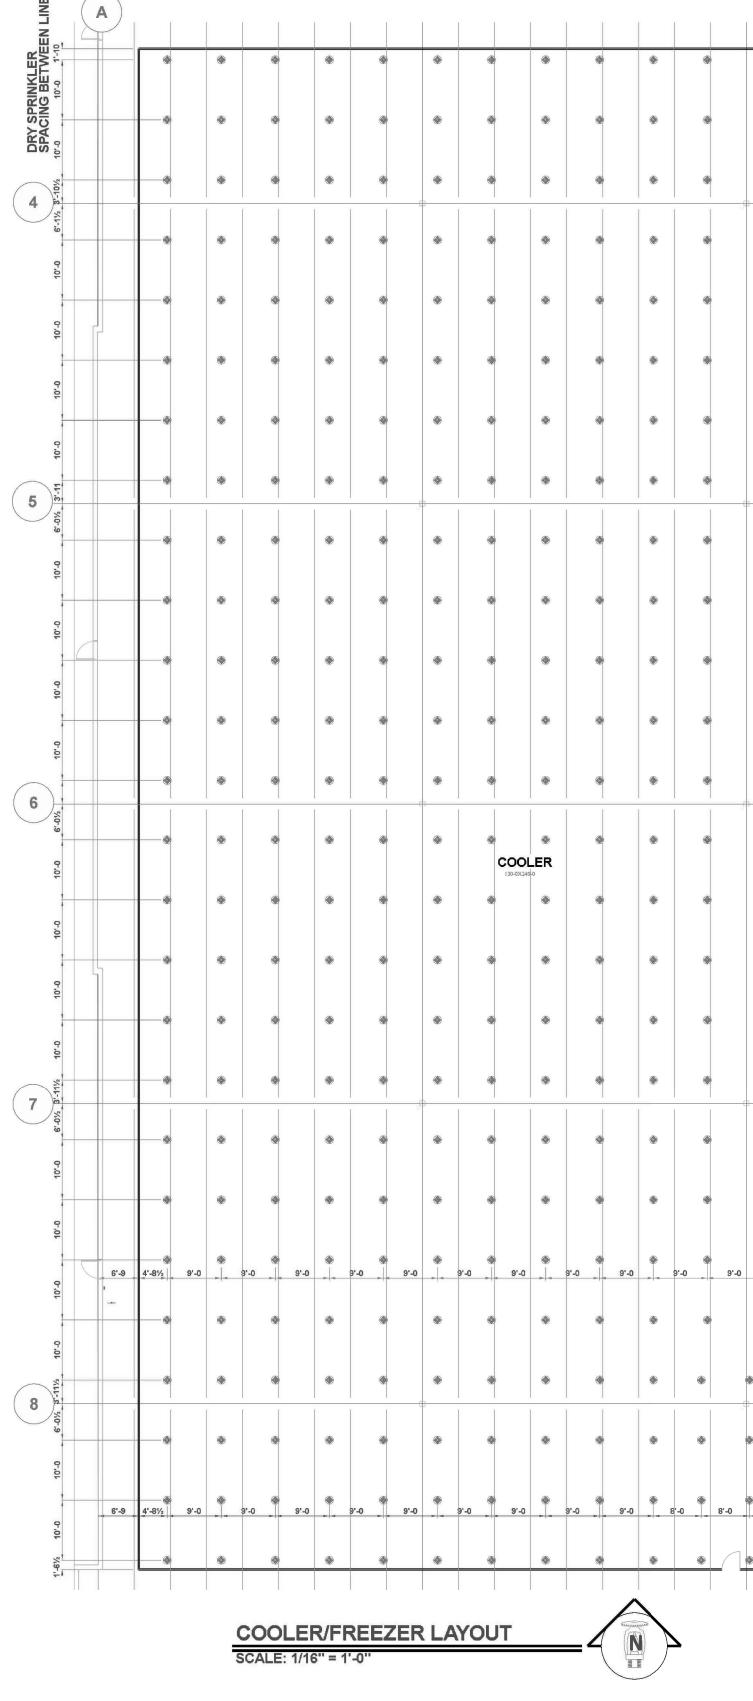

DRY BARREL OVERHEAD CONNECTION


				Sprin	kler Leger	nd					
SYMBOL	MANUFACTURER	SIN	MODEL	QUANTITY	K-FACTOR	TYPE	SIZE	RESPONSE	FINISH	TEMPERATURE	NOTE
	VICTAULIC	V4702	FL-QR/ST/ESFR	2054	16.8	PENDENT	3⁄4	FAST	BRASS	200°F	
Ň	VICTAULIC	V3406	V34	4	8	PENDENT	3⁄4	QUICK	BRASS	200°F	
Ŏ	VICTAULIC	V3428	ESFR	2754	22.4	PENDENT	1	FAST	BRASS	200°F	
Ŏ	VIKING	VK600	MICROFAST	48	5.6	PENDENT	1/2	QUICK	CHROME	135°F	
Õ	VIKING	VK3021		6	5.6	PENDENT	1/2	QUICK	CHROME	135°F	
Ŏ	VIKING	VK504	ESFR DRY	368	16.8	PENDENT	3⁄4	QUICK	BRASS	205°F	
				TOTAL = 5234							


*	•	•			
۲	۲	۲			
<u>ب</u>	۲	۲			CURRAN
۲	۲	۲			ARCHITECTURE
۲	۲	۲			5719 LAWTON LOOP E. DR. #212 INDIANAPOLIS, IN 46216 O :: 317 . 288 . 0681
۲	۹	۲			F :: 317.288.0753
۲	۲	۲			
•	۲	•			
۲	۲	۲			
۲	۲	۲			T
۲	۲	۲			SCANNELL
•	۲				PROPERTIES
۲	۲	۲			
۲	۲	۲			CERTIFICATION
۲	*	۲			MICHELLE A. LOPEZ NUMBER PE-2022007904
•	۲	•			09/07/22 000000000000000000000000000000000
۲	۲	۲		1-1/2" GROOVED SIDE OUTLET	THIS DRAWING AND THE IDEAS, DESIGNS AND CONCEPTS CONTAINED HEREIN ARE THE EXCLUSIVE INTELLECTUAL PROPERTY OF CURRAN ARCHITECTURE, AND ARE NOT TO
<u>ک</u>	9'-0 <u>10'</u>	-0 4'-5½	COOLER DRY SPRINKLER LINE SPACING	1-1/2" GROOVED PIPE (FIELD VERIFY LENGTH)	BE USED OR REPRODUCED, WHOLE OR IN PART, WITHOUT THE WRITTEN CONSENT OF CURRAN ARCHITECTURE. PROJECT INFORMATION
۲	۲	•			LEE'S SUMMIT LOGISTICS
				APPLY CRESCENT WRENOH OVER A COUPLING TO INSTALL	BUILDING A LOT I NW CORNER OF
	FREEZEF	र		BARREL IS MARKED TO BARREL IS MARKED TO INFORMATION OF SPRINKLER FRAME ARMS. (NOT PART OF A REQUIREMENT)	NE TUDOR RD & MAIN ST LEE'S SUMMIT, MO 64086
6'-0	9'-0	9'-0 1'	2 <sup>1/2</sup> COOLER/FREEZER DRY SPRINKLER LINE SPACING		
•				12" DRY BARREL ESFR PENDANT	
				5"	ISSUE DATES
				14" MAXIMUM MINIMUM CLEARANCE OPENING 2-11/16"	PERMIT SET         02.18.22           1         TENANT IMPROVEMENT         09.07.22

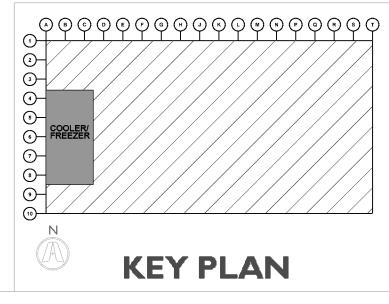

FP2.11 TENANT IMPROVEMENT



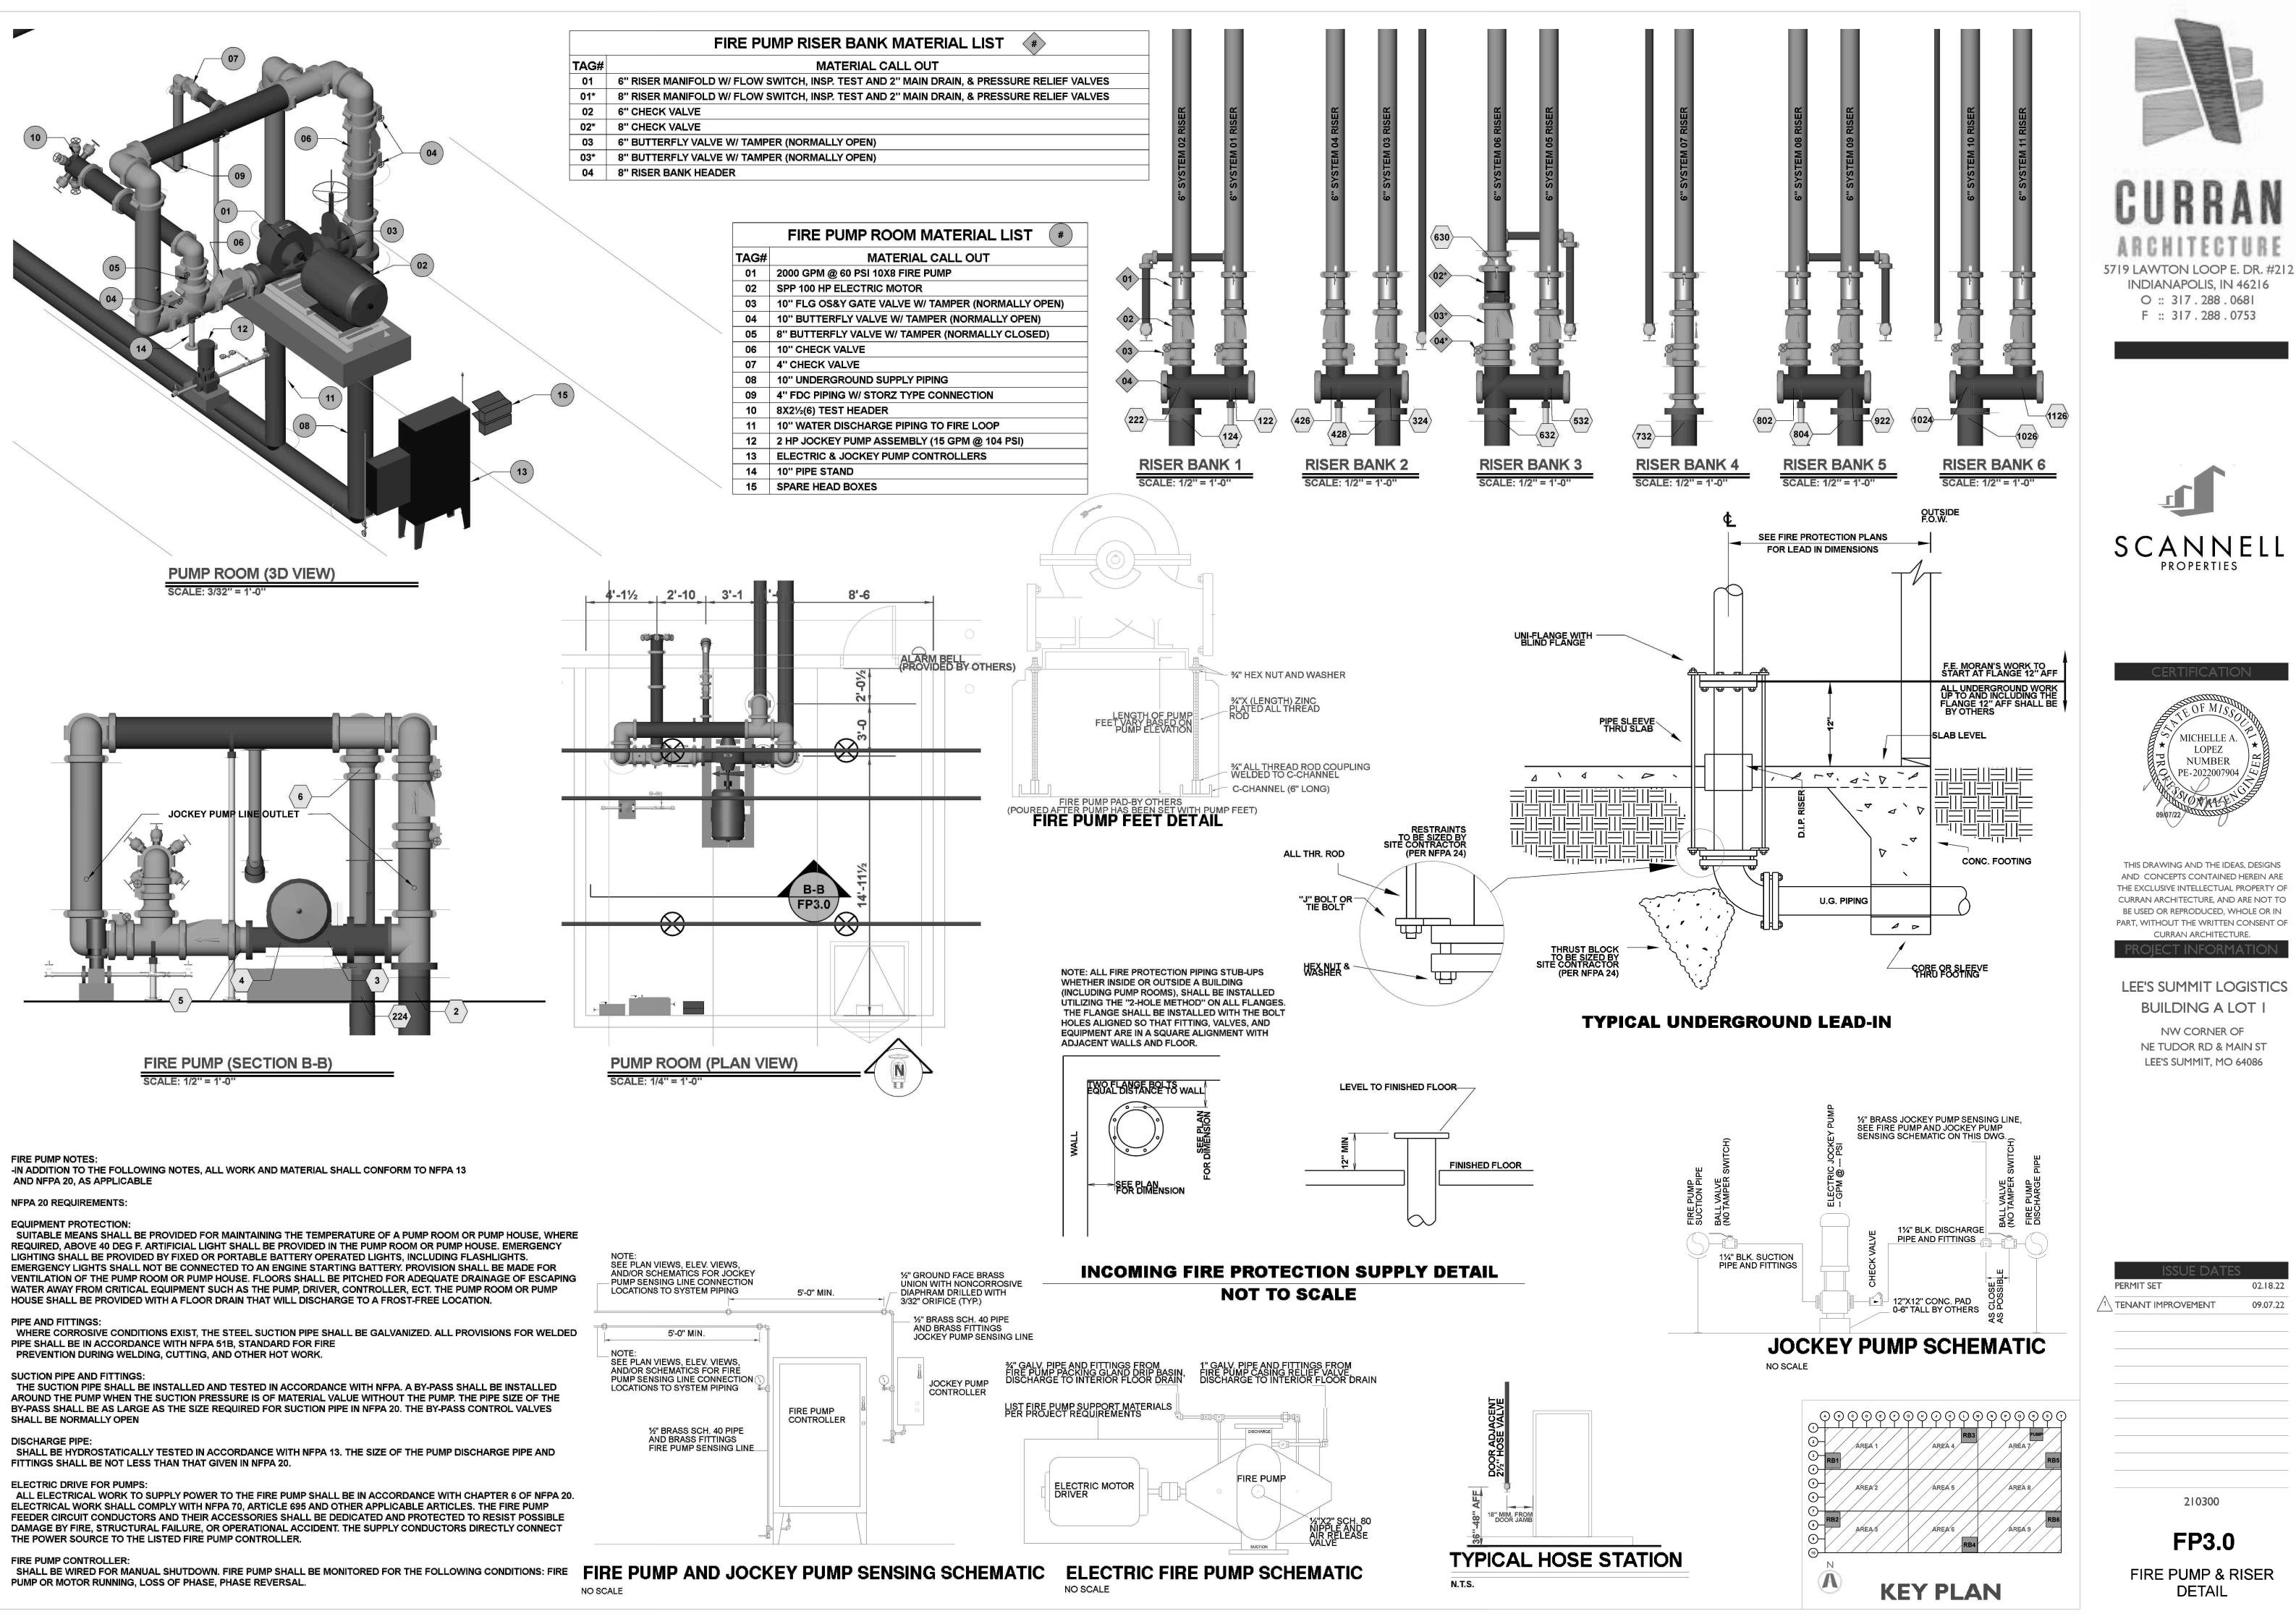

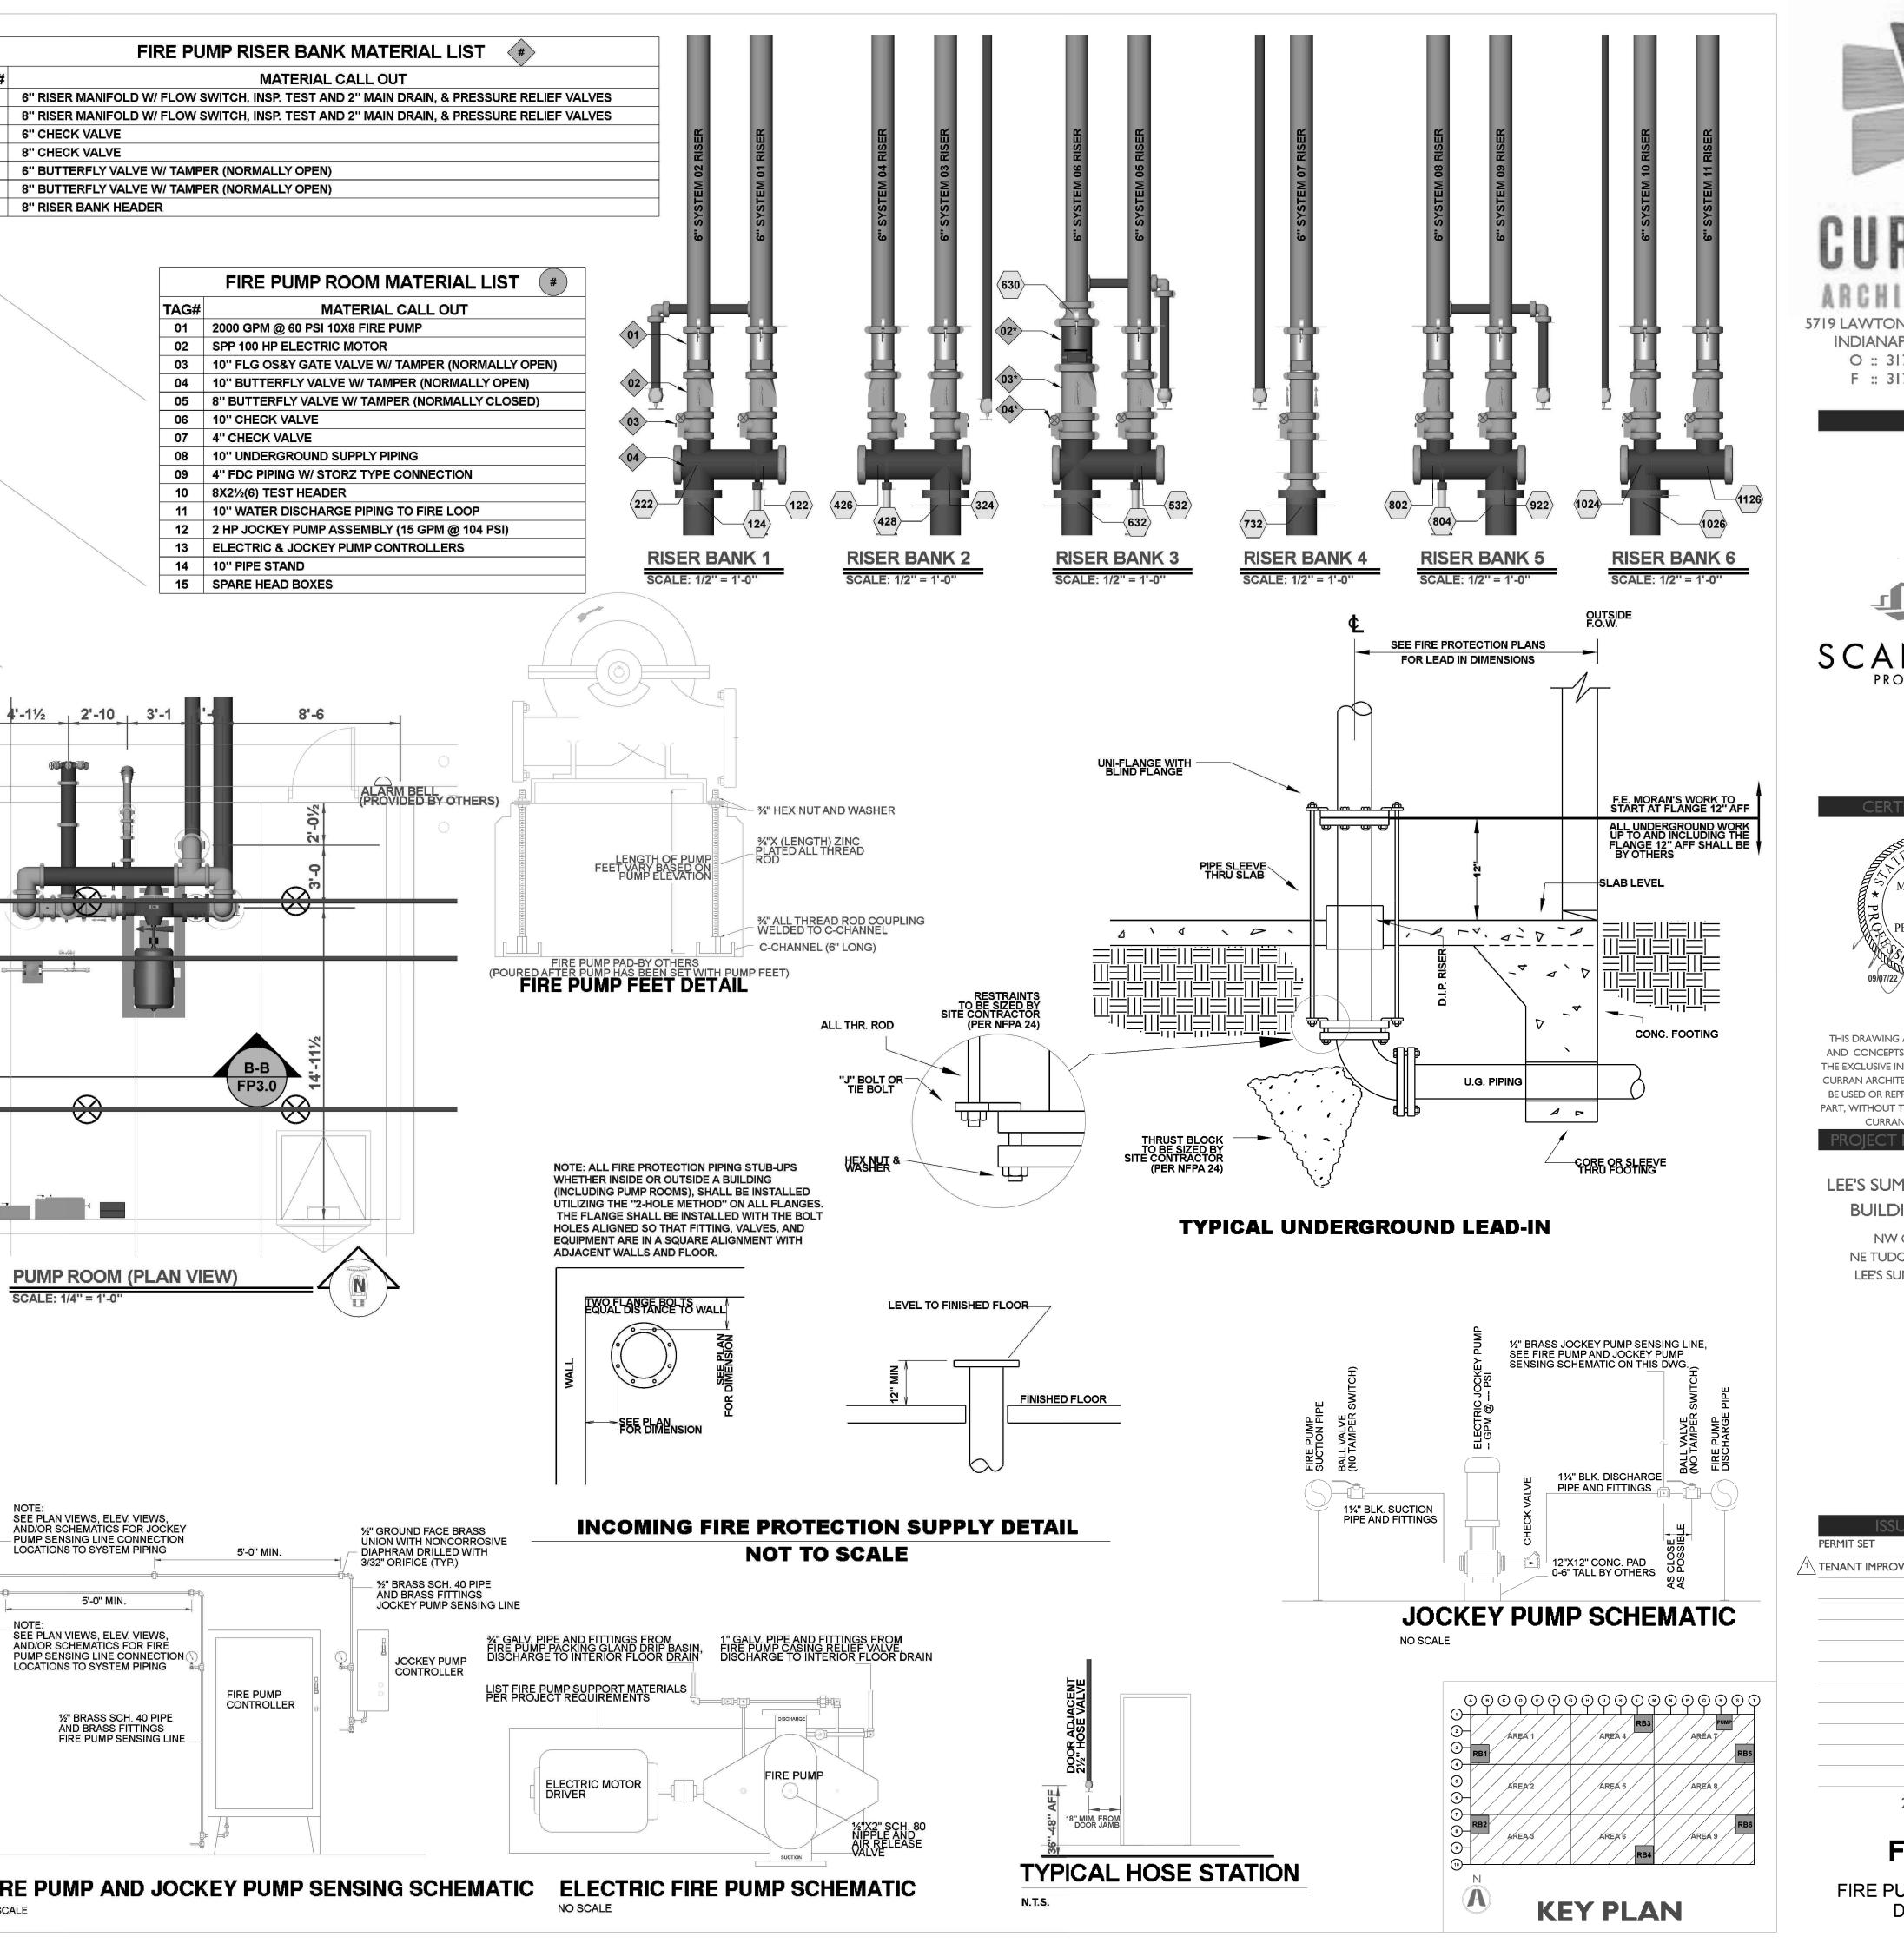

-	8
	5'-0" N
	NOTE:
_	SEE PLAN VIEWS, E
	AND/OR SCHEMATIC
	PUMP SENSING LINI
	LOCATIONS TO SYS

210300 **FP3.0 FIRE PUMP & RISER** DETAIL

02.18.22

09.07.22

LOPEZ