



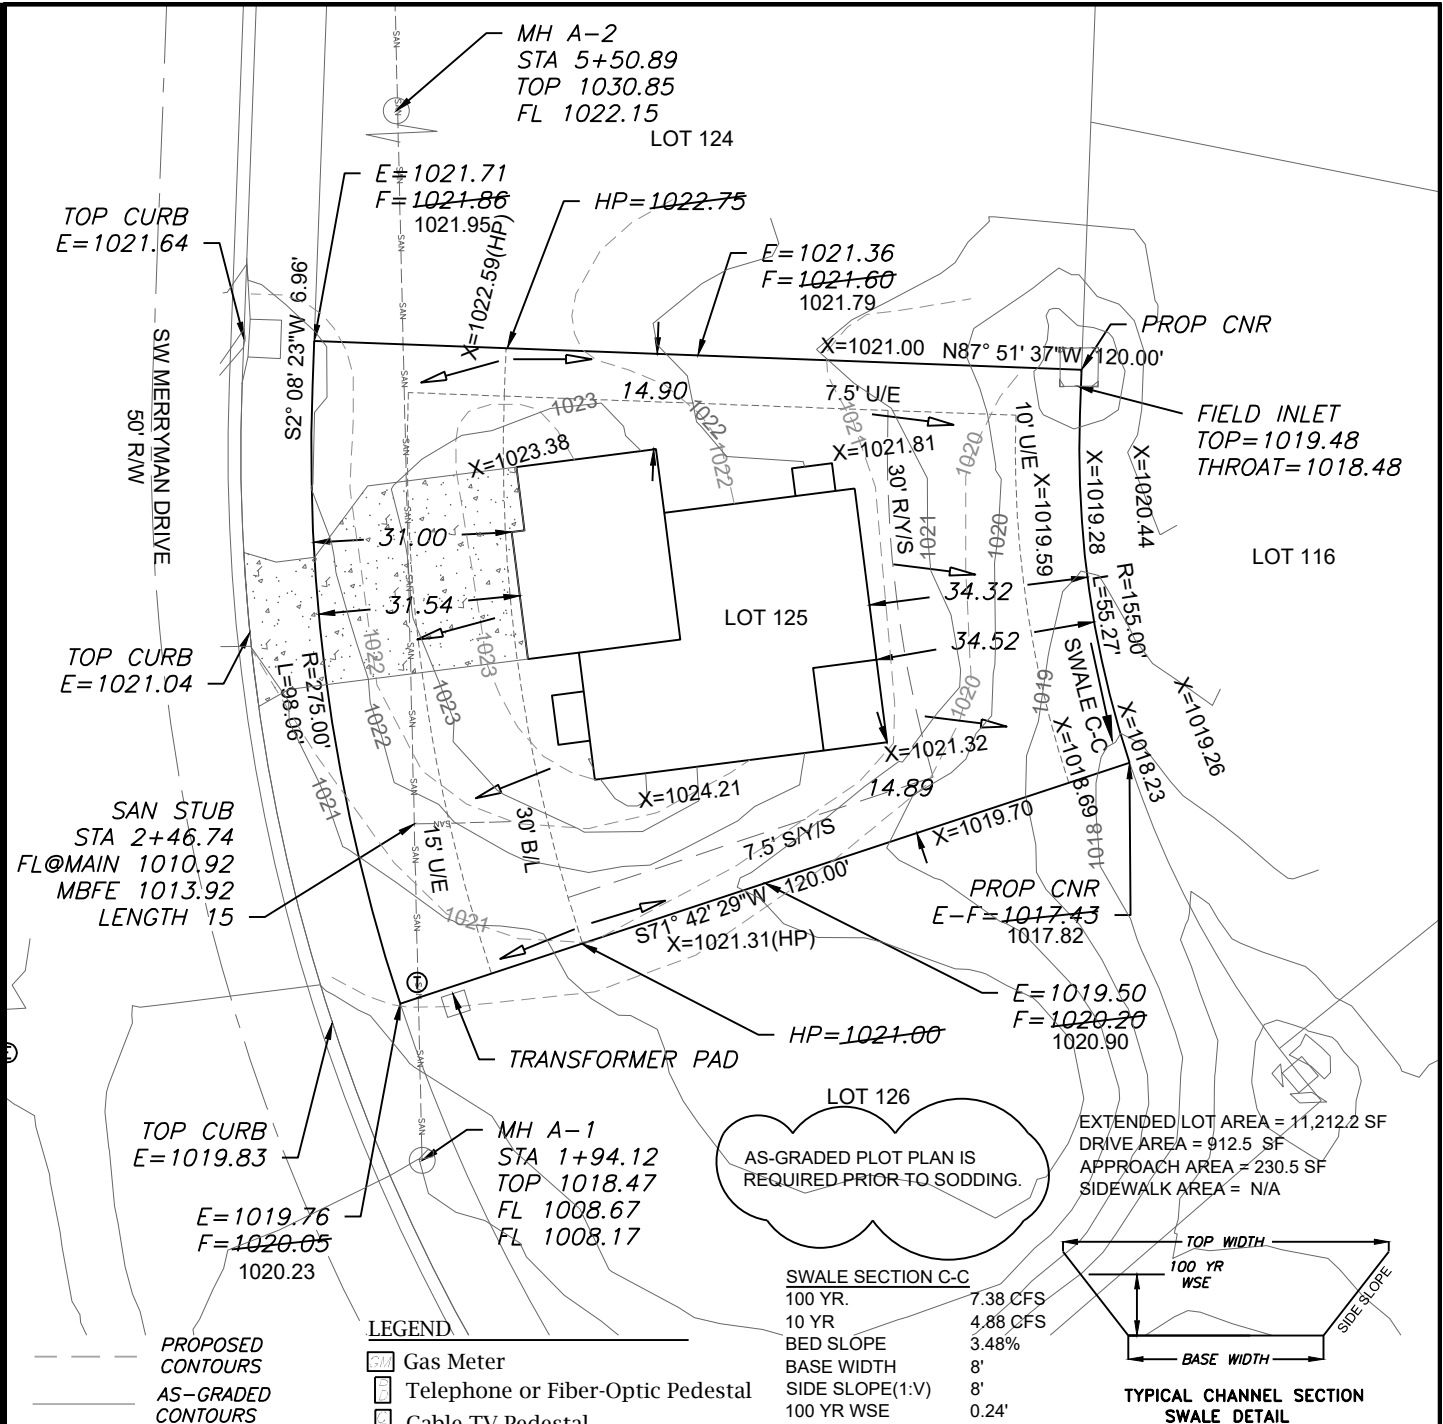

X=###.## = Actual asbuilt ground shots taken on August 10, 2022.

Contours shown are asbuilt.

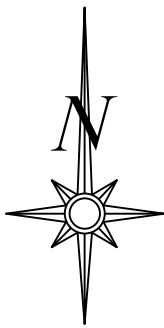

Scale 1"=30'

LOT INFORMATION

10,035.35 SQ. FT.
MBOE LT=1021.20
MBOE RT=1019.90
MBFE=1013.92
ADDRESS
1920 SW MERRYMAN DR

LEGAL DESCRIPTION

LOT 125, THE MANOR AT STONEY CREEK 4TH PLAT, A SUBDIVISION AS RECORDED IN LEE'S SUMMIT, JACKSON COUNTY, MISSOURI.

LEGEND

- Gas Meter
- Telephone or Fiber-Optic Pedestal
- Cable TV Pedestal
- Electric Pedestal
- Light Pole
- Mailbox
- Fire Hydrant
- Water Valve

PROPOSED HOUSE


TOP FOUNDATION = 1025.25
GARAGE FLOOR = 1023.25
TOP FOOTING = 1016.25
BASEMENT FLOOR = 1016.58
DRIVE SLOPE = 6.3%

E = EXISTING ELEVATION
F = PROPOSED FINAL ELEVATION
G = ADJACENT GRADE AT EGRESS
U/E = UTILITY EASEMENT
B/L = BUILDING LINE
S/Y/S = SIDE YARD SETBACK
R/Y/S = REAR YARD SETBACK

NOTES


- BUILDER TO VERIFY ALL BUILDING ELEVATIONS AND DIMENSIONS.
- THIS PLOT PLAN DOES NOT CONSTITUTE A BOUNDARY SURVEY.
- THE EASEMENTS SHOWN ON THIS PLOT PLAN ARE TAKEN FROM THE FINAL PLAT. OTHER EASEMENTS MAY EXIST.

SWALE SECTION C-C
100 YR. 7.38 CFS
10 YR 4.88 CFS
BED SLOPE 3.48%
BASE WIDTH 8'
SIDE SLOPE(1:V) 8'
100 YR WSE 0.24'

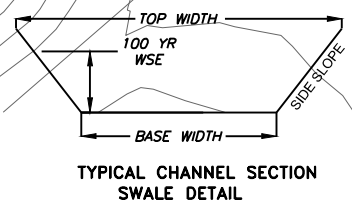

OS BAR
E=1021.22

OS BAR
E=1019.68

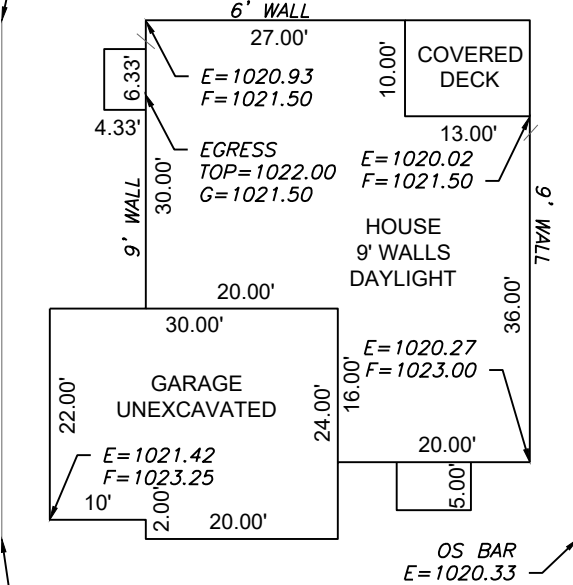


OS BAR
E=1021.51

PLAN: WATERFORD
Scale 1"=20'

RELEASE FOR CONSTRUCTION
AS NOTED FOR PLAN REVIEW
DEVELOPMENT SERVICES
LEE'S SUMMIT, MISSOURI
10/18/2022

ENGINEERING SOLUTIONS
ENGINEERING & SURVEYING
50 SE 30TH STREET
LEE'S SUMMIT, MO 64082
P:(816) 623-9888 F:(816) 623-9849
WWW.ENGINEERINGSOLUTIONKCC.COM

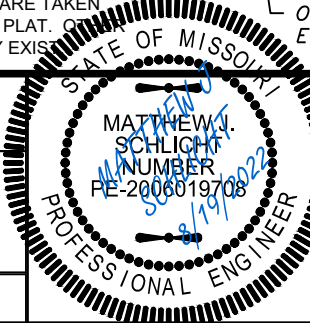

AS-GRADED PLOT PLAN - LOT 125

THE MANOR AT STONEY CREEK 4TH PLAT
LEE'S SUMMIT, JACKSON COUNTY, MISSOURI

SUMMIT HOMES
120 SE 30TH STREET
LEE'S SUMMIT, MO 64082

PROJECT NO.	FILE NAME	DATE	SHEET	OF
1	LOT 125, MANOR AT STONEY CREEK	7/21/21	1	1

THIS DRAWING IS NOT VALID UNLESS THE SIGNATURE, DATE AND SEAL OF THE ENGINEER WHO SUPERVISED THE PREPARATION OF THIS DRAWING HAS BEEN AFFIXED HERETO.