


SECTION 2, TOWNSHIP 47 N, RANGE 32 W  
IN LEE'S SUMMIT, JACKSON COUNTY, MO

ASBUILT  
03-24-2022

☐ NOT FOR CONSTRUCTION

☒ REVIEWED FOR CONSTRUCTION

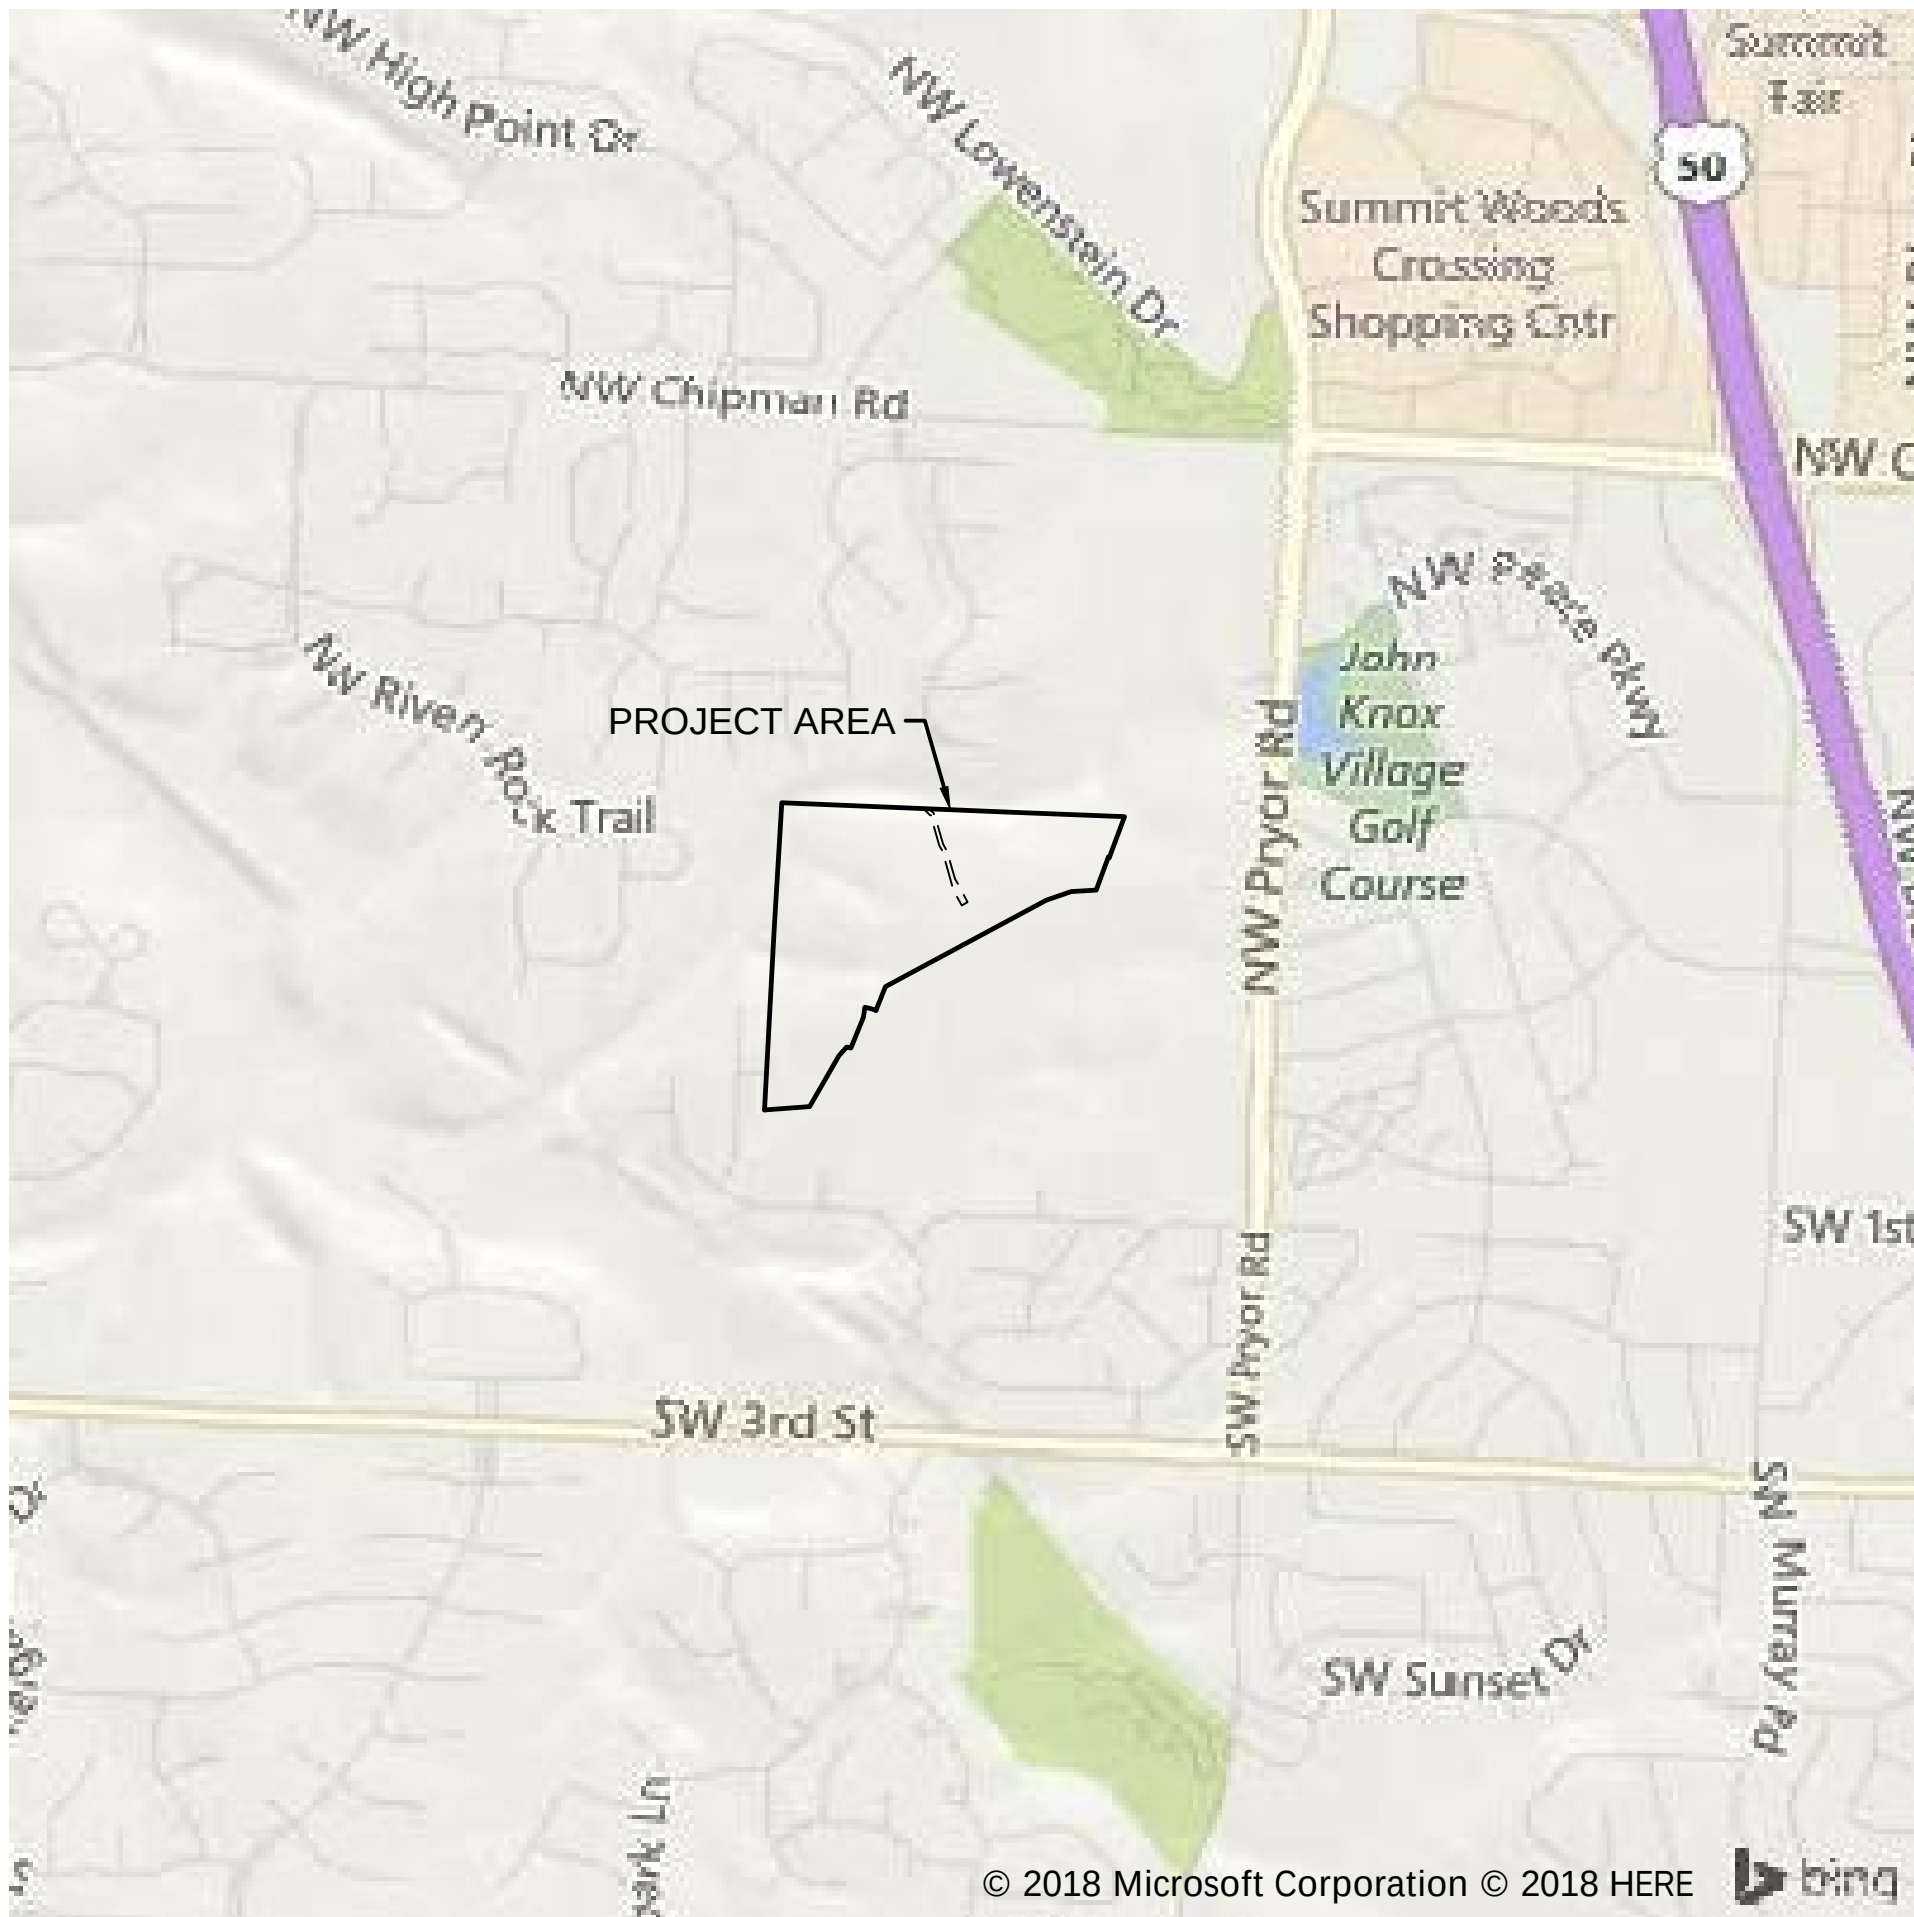

Part of Lot 3B, WEST VILLAGE COMMERCIAL DEVELOPMENT, LOTS 3A AND 3B, a subdivision recorded as Instrument Number 19E0018413 in Book 1182 at Page 62 in Jackson County Recorder of Deeds Office located in the Northeast and Southeast Quarter of Section 2, Township 47 North, Range 32 West of the 5th Principal Meridian in Lee's Summit, Jackson County, Missouri being bounded and described by or under the direct supervision of Jason S Roudsbaugh, P.L.S. 2002014092 as follows: Commencing at the Southeast corner of said Southeast Quarter; thence North 87°05'43" West, on the South line of said Southeast Quarter 2,633.21 feet to the Southwest corner of said Southeast Quarter; thence North 03°40'41" East, on the West line of said Southeast Quarter, 1,326.36 feet to the Southwest corner of said Lot 3B, also being the Southwest corner of the North half said Southeast Quarter, also being a point on the Easterly line of STERLING HILLS 5TH PLAT, a subdivision in said Lee's Summit recorded as Instrument Number 11273788 in Book 154 at Page 88 in said Jackson County Recorder of Deeds Office, also being the Southwest corner of proposed WOODSIDE RIDGE 1st Plat, Lots 1 thru 143 inclusive, and Tracts A, B, C, D, E, F, G and H; thence North 03°05'41" East on said West line and said Easterly line, also being the West line of said Lot 3B, also being the Westerly line of proposed WOODSIDE RIDGE 1ST PLAT, LOTS 1 thru 143 inclusive, and Tracts A, B, C, D, E, F, G and H, 389.26 feet to the Point of Beginning of the tract of land to be herein described; thence leaving said proposed Westerly line, continuing North 03°05'41" East on said West lines and said Easterly lines, 936.61 feet to the Northeast corner of said STERLING HILLS 5TH PLAT, also being a point on the Easterly line of WINTERSET WOODS – 3RD PLAT, a subdivision in said Lee's Summit recorded as Instrument Number 20030002463 in Book 174 at Page 14 in said Jackson County Recorder of Deeds Office, also being the Northwest corner of said Southeast Quarter; thence North 03°26'14" East, on the said West line of said Lot 3B, said Easterly line and West line of said Northeast Quarter, 665.72 feet to the Northwest corner of the South Half of said Northeast Quarter, also being the Northwest corner of said Lot 3B, also being the Northwest corner of the South Half of said Northeast Quarter, also being a point on the Southerly line of the FOREST OF BROOKRIDGE ESTATES – THIRD PLAT, LOTS 117 – 133, a subdivision in said Lee's Summit recorded as Instrument Number 1802804 in Book 144 at Page 57 in said Jackson County Recorder of Deeds Office; thence South 87°37'42" East, along said Southerly line, also along the North line of said Lot 3B, also being the North line of said South Half of said South Half of said Northeast Quarter, also being the South line of the FOREST OF BROOKRIDGE ESTATES – THIRD PLAT, LOTS 117 – 133, a distance of 1,210.45 feet to the Southeast corner of said the FOREST OF BROOKRIDGE ESTATES – THIRD PLAT LOTS 117 – 133 and to a point on said proposed Westerly line; thence South 87°37'42" East on said North line of said South Half of said South Half, said North line of said Lot 3B, and said proposed Westerly line, 574.95 feet; thence leaving said North lines, South 20°32'36" West, along said proposed Westerly line, 229.10 feet; thence Westerly, along said proposed Westerly line, on a curve to the left, having an initial tangent bearing of North 69°27'24" West with a radius of 428.00 feet, a central angle of 00°42'29" and an arc distance of 5.25 feet; thence South 19°50'07" West, along said proposed Westerly line 178.42 feet; thence South 85°52'23" West, along said proposed Westerly line, 130.41 feet; thence South 70°59'24" West, along said proposed Westerly line, 137.47 feet; thence South 61°49'26" West, along said proposed Westerly line, 951.56 feet; thence South 21°24'31" West, along said proposed Westerly line, 135.10 feet; thence Westerly, along said proposed Westerly line, along a curve to the left having an initial tangent bearing of North 68°35'29" West with a radius of 275.00 feet, a central angle of 12°33'32" and an arc distance of 60.28 feet; thence South 08°50'59" West, along said proposed Westerly line, 50.00 feet; thence South 22°12'04" West, along said proposed Westerly line, 173.03 feet; thence North 75°51'31" West, along said proposed Westerly line, 21.43 feet; thence South 41°11'03" West, along said proposed Westerly line, 60.06 feet; thence South 29°55'27" West, along said proposed Westerly line, 306.11 feet; thence South 85°54'26" West, along said proposed Westerly line, 236.75 feet to the Point of Beginning. Containing 1,514,368 square feet or 34.77 acres, more or less.

BMK #5 CHISELED SQUARE ON THE S.E. CORNER OF A CONCRETE PAD FOR A TRAFFIC SIGNAL BOX AT THE S.W. CORNER OF PRYOR ROAD AND O'BRIEN ROAD.

ELEVATION: 979.24

  
JULIE E SELLERS, P.E.  
CIVIL ENGINEER  
MO# 2017000367

10/27/2022  
DATE

STATE OF MISSOURI  
JULIE ELAINE  
SELLERS  
NUMBER  
PE-2017000367  
PROFESSIONAL ENGINEER

[illegible]

COVER SHEET  
STREET & STORM SEWER PLANS

WOODSIDE RIDGE  
SECOND PLAT


LEE'S SUMMIT, MO

drawn by: C.S.M  
checked by: S.M.S  
designed by: C.S.M  
QA/QC by: J.E.S  
project no.: C18-1140  
date: 2020.06.09

SHEET  
C101



11. P.O.S= PROPOSED OPEN SPACE.

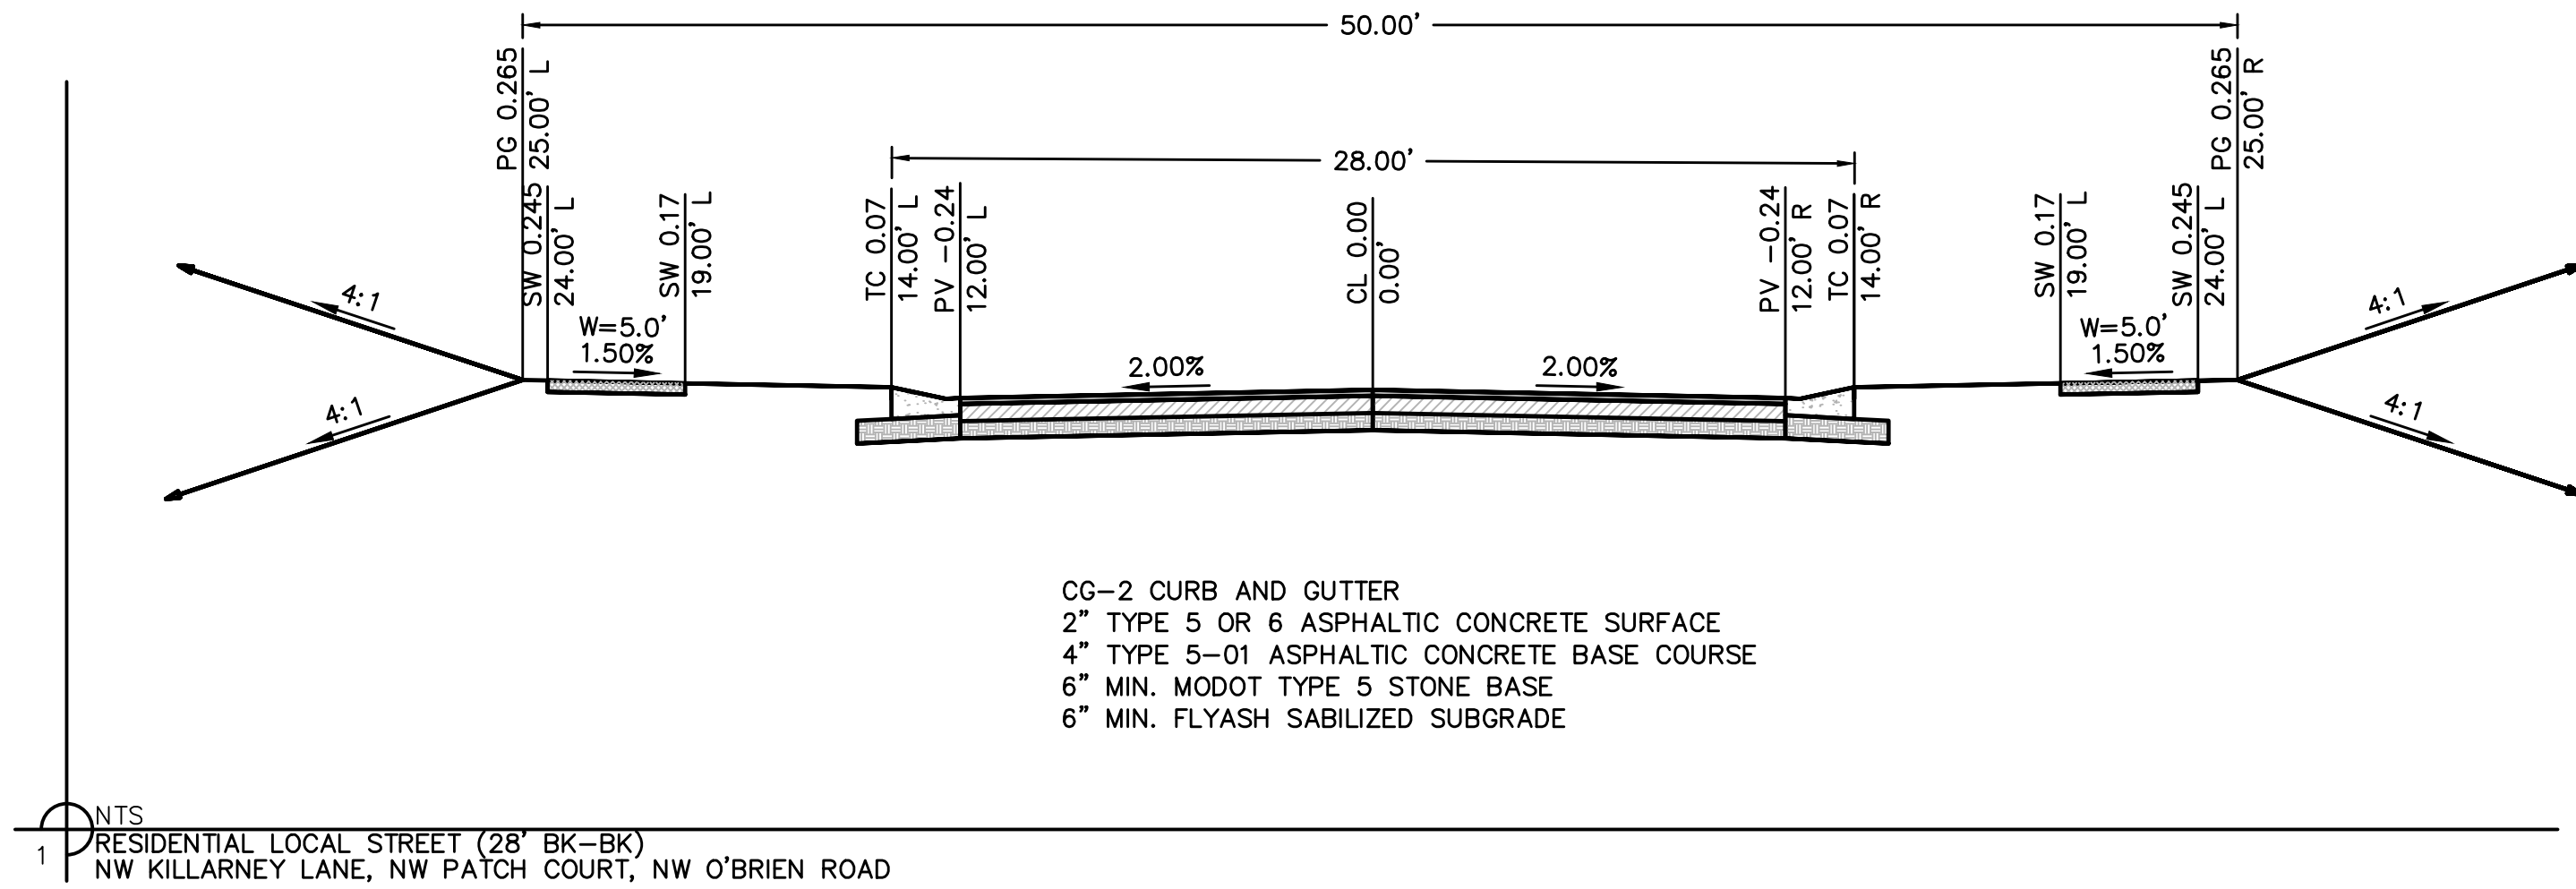

DWG: F:\2018\1001-1500\018-1140-C\40-Design\AutoCAD\Final Plans - Asbuilts\Sheets\GNCV\Street & Storm\C\_GEN01\_C181140.dwg  
DATE: Oct 17, 2022 12:36pm

| ESTIMATE OF QUANTITIES |                                     |      |                    |          |
|------------------------|-------------------------------------|------|--------------------|----------|
| ITEM NO.               | DESCRIPTION                         | UNIT | QUANTITY           | AS-BUILT |
| SITE                   |                                     |      |                    |          |
| 1                      | EXCAVATION                          | C.Y. | 52613              |          |
| 2                      | EMBANKMENT                          | C.Y. | 83489              |          |
| STREET                 |                                     |      |                    |          |
| 3                      | EXCAVATION                          | C.Y. | 8049               |          |
| 4                      | EMBANKMENT                          | C.Y. | 7968               |          |
| 5                      | 8" ASPHALT PAVEMENT                 | S.Y. | 7373               |          |
| 6                      | STABILIZED SUBGRADE                 | S.Y. | 9028               |          |
| 7                      | 8" MoDOT TYPE 5 AGGREGATE           | S.Y. | 9028               |          |
| 8                      | CONCRETE CURB & GUTTER (CG-2)       | L.F. | 4747.02            |          |
| 9                      | ADA HANDICAP RAMP                   | EA.  | 6                  |          |
| 10                     | STOP SIGNS                          | EA.  | 3                  |          |
| 11                     | STREET NAME SIGNS                   | EA.  | 4                  |          |
| 12                     | SIGN POSTS                          | EA.  | 1                  |          |
| 13                     | MILL & OVERLAY                      | S.Y. | 40                 |          |
| 14                     | 5' CONCRETE SIDEWALK                | L.F. | 55.00              |          |
| 15                     | 4" COMPACTED AGGREGATE FOR SIDEWALK | S.Y. | 31.00              |          |
| 16                     | SEEDING, FERTILIZER, OR MULCH       | AC.  | 19.61              |          |
| 17                     | TOPSOIL                             | C.Y. | 13688.61           |          |
| STORM                  |                                     |      |                    |          |
| 18                     | STD. CURB INLET (5'x3' INSIDE)      | EA.  | <del>42</del>      | 12       |
| 19                     | STD. MANHOLE (4' DIA. INSIDE)       | EA.  | <del>7</del>       | 8        |
| 20                     | STD. FIELD INLET (4'x4' INSIDE)     | EA.  | <del>2</del>       | 2        |
| 21                     | 15" HDPE                            | L.F. | <del>1310.46</del> | 1273.78  |
| 22                     | 18" HDPE                            | L.F. | <del>562.72</del>  | 467.81   |
| 23                     | 18" RCP                             | L.F. | <del>181.03</del>  | 188.31   |
| 24                     | 24" HDPE                            | L.F. | <del>283.67</del>  | 267.74   |
| 25                     | 15" HDPE END SECTION                | EA.  | <del>2</del>       | 2        |
| 26                     | 18" HDPE END SECTION                | EA.  | <del>5</del>       | 5        |
| 27                     | 24" HDPE END SECTION                | EA.  | <del>1</del>       | 1        |
| 28                     | RIP-RAP                             | S.Y. | <del>162</del>     | 125.87   |

| LEGEND |                                           |
|--------|-------------------------------------------|
| ECTVGH | EXISTING CABLE TV, OVERHEAD               |
| ECTV   | EXISTING CABLE TV, UNDERGROUND            |
| CTVGH  | PROPOSED CABLE TV, OVERHEAD               |
| CTV    | PROPOSED CABLE TV, UNDERGROUND            |
| FEVGH  | FUTURE CABLE TV, OVERHEAD                 |
| FEV    | FUTURE CABLE TV, UNDERGROUND              |
| FGHGH  | EXISTING FIBER OPTIC, OVERHEAD            |
| FGH    | EXISTING FIBER OPTIC, UNDERGROUND         |
| FOGH   | PROPOSED FIBER OPTIC, OVERHEAD            |
| FO     | PROPOSED FIBER OPTIC, UNDERGROUND         |
| FGHGH  | FUTURE FIBER OPTIC, OVERHEAD              |
| FGH    | FUTURE FIBER OPTIC, UNDERGROUND           |
| EPF    | EXISTING FIRE PROTECTION SYSTEM LINE      |
| FP     | PROPOSED FIRE PROTECTION SYSTEM LINE      |
| FFP    | FUTURE FIRE PROTECTION SYSTEM LINE        |
| EFL    | EXISTING FUEL LINE                        |
| FL     | PROPOSED FUEL LINE                        |
| FFL    | FUTURE FUEL LINE                          |
| EG     | EXISTING NATURAL GAS LINE                 |
| G      | PROPOSED NATURAL GAS LINE                 |
| FG     | FUTURE NATURAL GAS LINE                   |
| ETELGH | EXISTING TELEPHONE LINE, OVERHEAD         |
| ETEL   | EXISTING TELEPHONE LINE, UNDERGROUND      |
| TELGH  | PROPOSED TELEPHONE LINE, OVERHEAD         |
| TEL    | PROPOSED TELEPHONE LINE, UNDERGROUND      |
| FEELGH | FUTURE TELEPHONE LINE, OVERHEAD           |
| FEEL   | FUTURE TELEPHONE LINE, UNDERGROUND        |
| EOGH   | EXISTING POWER/ELECTRIC LINE, OVERHEAD    |
| EE     | PROPOSED POWER/ELECTRIC LINE, UNDERGROUND |
| EOH    | PROPOSED POWER/ELECTRIC LINE, OVERHEAD    |
| E      | PROPOSED POWER/ELECTRIC LINE, UNDERGROUND |
| FEOH   | FUTURE POWER/ELECTRIC LINE, OVERHEAD      |
| FE     | FUTURE POWER/ELECTRIC LINE, UNDERGROUND   |
| ESS    | EXISTING SANITARY SEWER                   |
| SS     | PROPOSED SANITARY SEWER                   |
| FESS   | FUTURE SANITARY SEWER                     |
| ESL    | EXISTING STEAM LINE                       |
| SL     | PROPOSED STEAM LINE                       |
| FSL    | FUTURE STEAM LINE                         |
| EST    | EXISTING STORM SEWER                      |
| SS     | PROPOSED STORM SEWER                      |
| FST    | FUTURE STORM SEWER                        |
| EW     | EXISTING WATER LINE                       |
| W      | PROPOSED WATER LINE                       |
| FW     | FUTURE WATER LINE                         |

ASBUILT  
03-24-2022

SUMMARY OF QUANTITIES AS INDICATED ABOVE AND ANY QUANTITIES AS SHOWN WITHIN THE PLANS HAVE BEEN PROVIDED FOR PERMITTING PURPOSES ONLY AND ARE NOT INTENDED FOR USE IN PREPARATION OF CONTRACT DOCUMENTS. QUANTITIES INTENDED FOR, BUT NOT LIMITED TO, THE PREPARATION OF PROPOSALS AND BID DOCUMENTS SHALL BE INDEPENDENTLY EVALUATED BY THE ESTIMATING PARTY BASED UPON THE CONTENTS OF THESE PLANS.

ALL NOTES REFERENCED ON THIS PLAN SHEET MAY HAVE APPLICATIONS TO EVERY FACET OF THE CONSTRUCTION PLANS. THE NOTE HEADINGS OR TITLES ARE TO BE USED AS A GENERAL GUIDE TO APPLICABLE SITUATIONS.



**olsson**

MO Certificate of Authority # 001592  
 1301 BURLINGTON SUITE 100  
 NORTH KANSAS CITY, MO 64116  
 TEL 816.361.1177  
[www.olsonco.com](http://www.olsonco.com)

| GENERAL NOTES                         | NO. REV. | DATE | REVISIONS DESCRIPTION | BY |
|---------------------------------------|----------|------|-----------------------|----|
| <b>STREET &amp; STORM SEWER PLANS</b> |          |      |                       |    |
|                                       |          |      |                       |    |
|                                       |          |      |                       |    |
|                                       |          |      |                       |    |
| <b>WOODSIDE RIDGE<br/>SECOND PLAT</b> |          |      |                       |    |
|                                       |          |      |                       |    |
|                                       |          |      |                       |    |
|                                       |          |      |                       |    |
| <b>LEE'S SUMMIT, MO</b>               |          |      |                       |    |
|                                       |          |      |                       |    |
| <b>2020</b>                           |          |      | <b>REVISIONS</b>      |    |

drawn by: \_\_\_\_\_ C.S.M.

checked by: \_\_\_\_\_ S.M.S.

designed by: \_\_\_\_\_ C.S.M.

QA/QC by: \_\_\_\_\_ J.E.S.



project no.: \_\_\_\_\_ C18-1140

date: \_\_\_\_\_ 2020.07.10

**SHEET**

**C102**



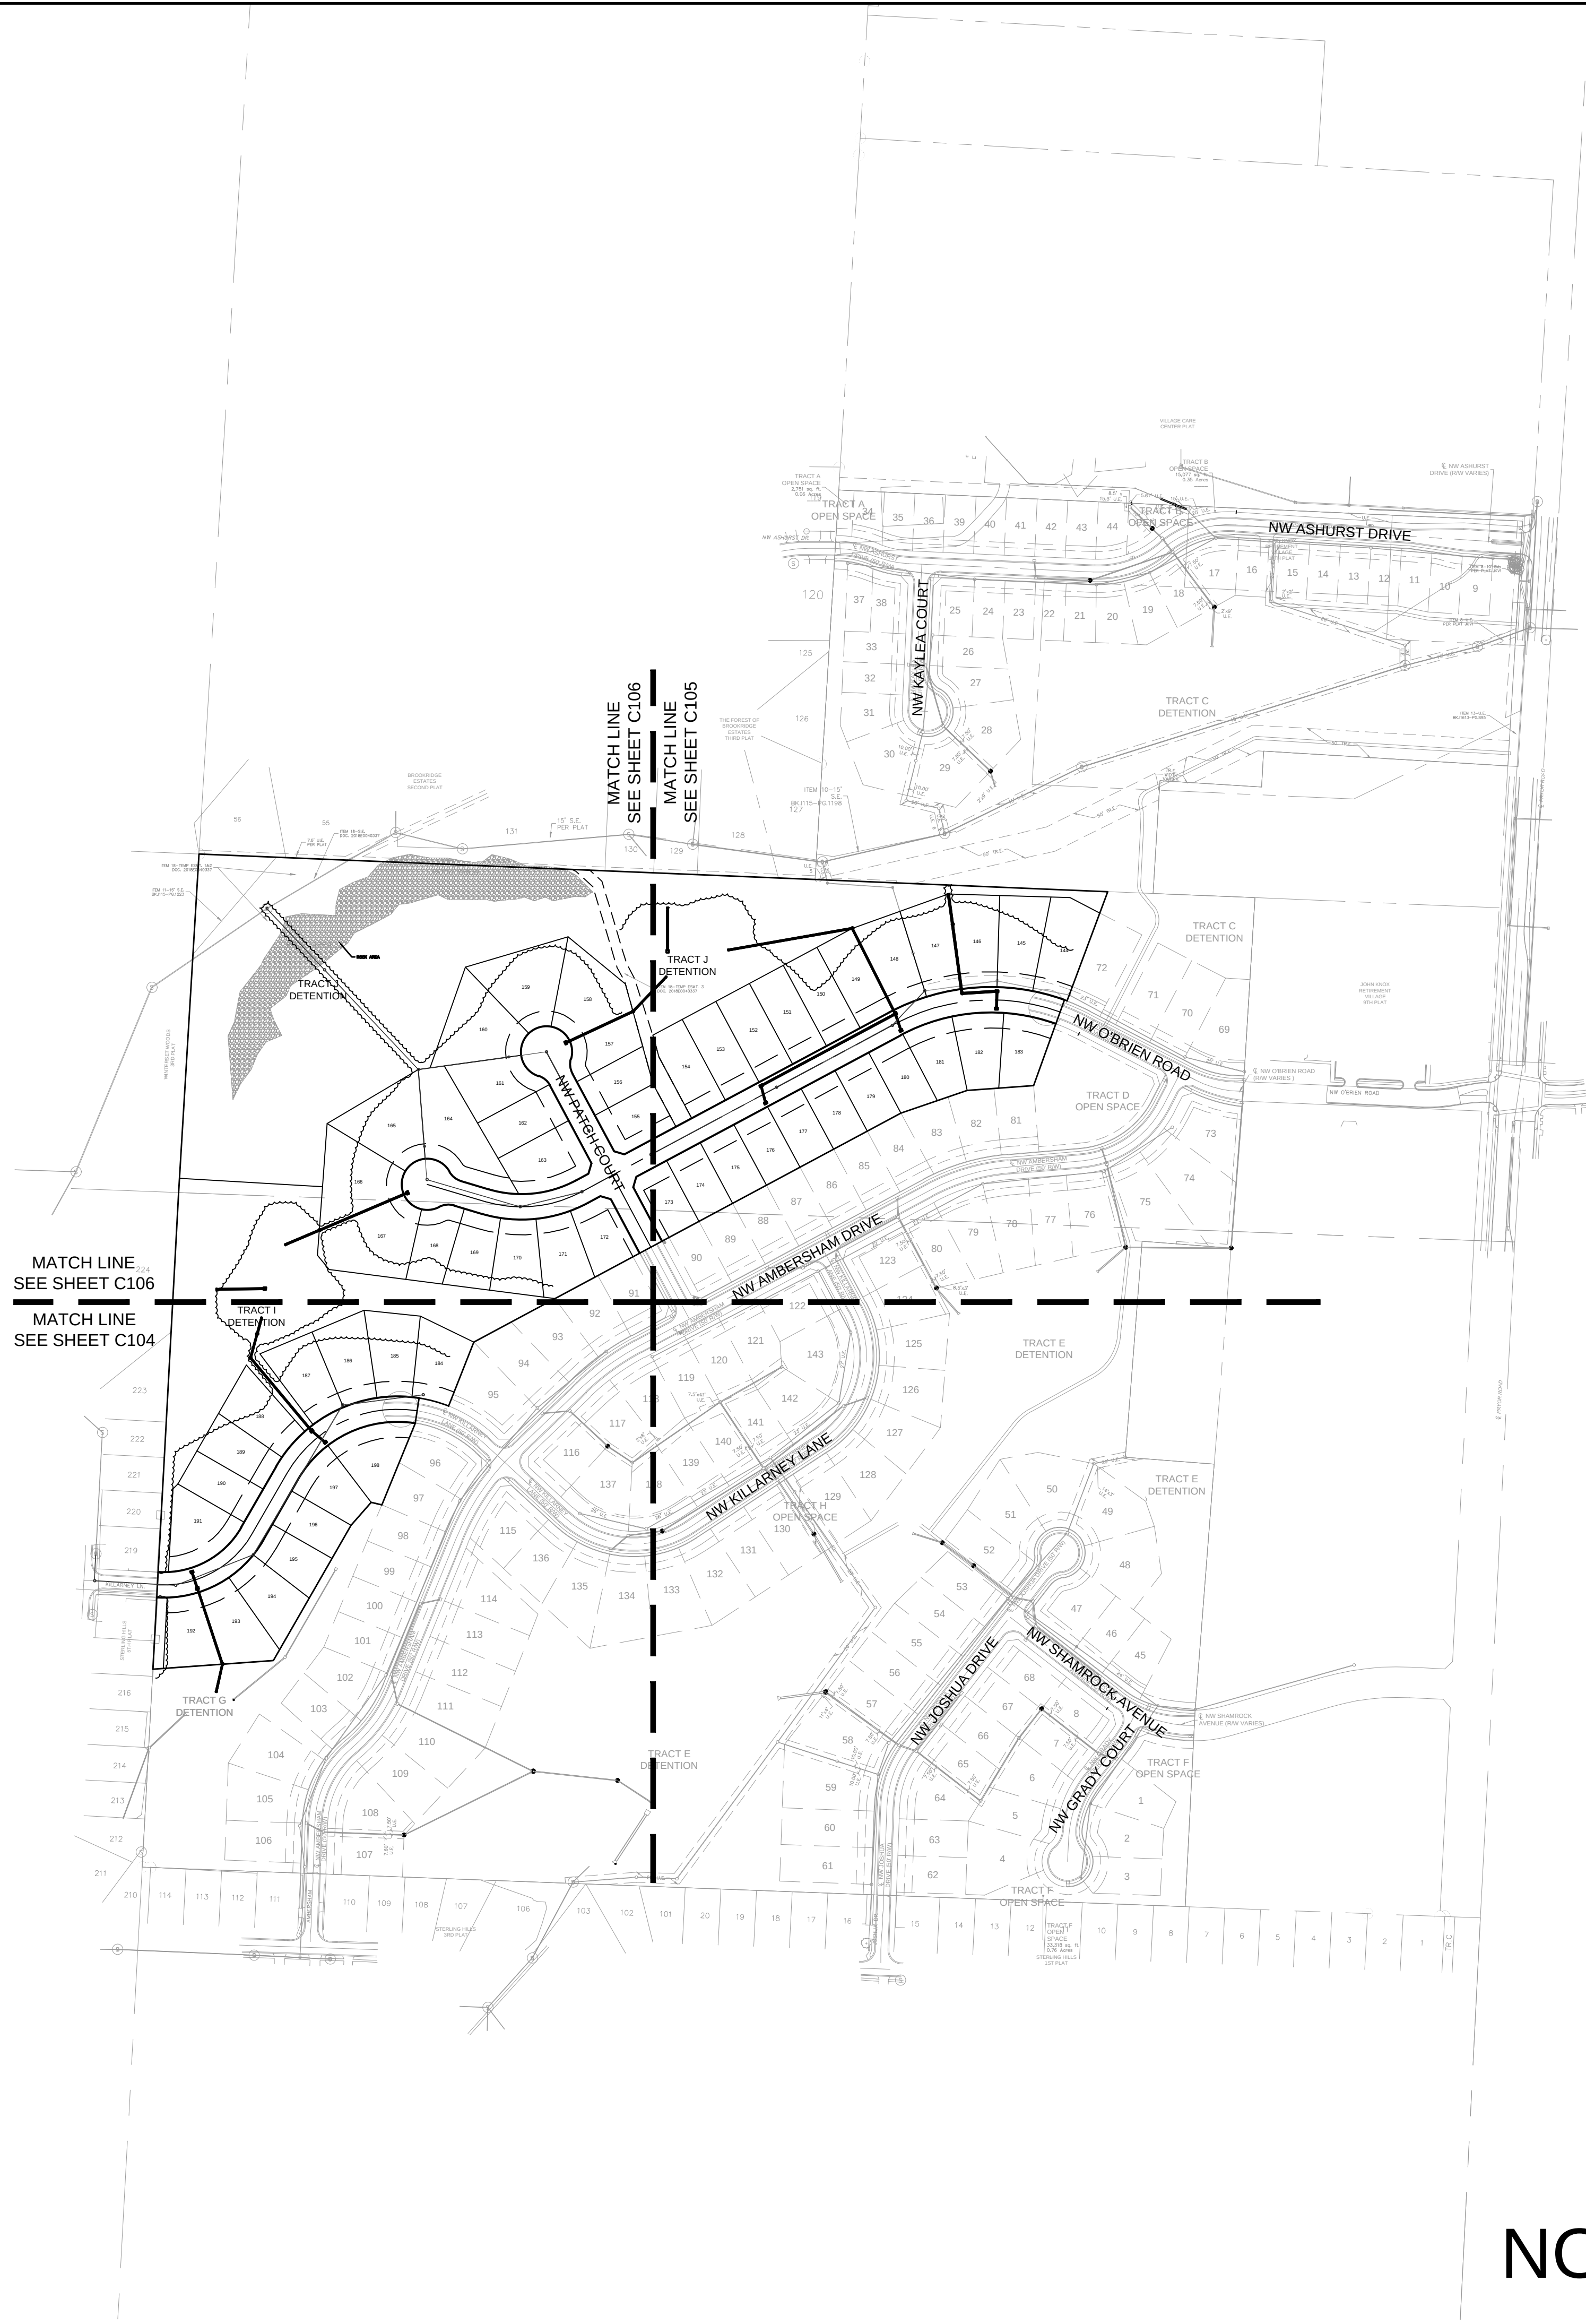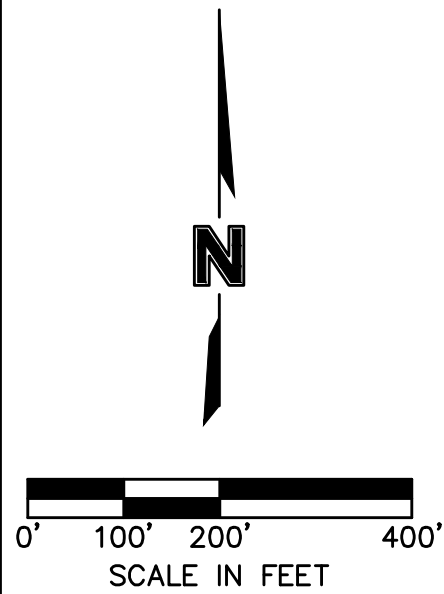

NOT ASBUILT

MASTER GENERAL LAYOUT  
STREET & STORM SEWER PLANS

WOODSIDE RIDGE  
SECOND PLAT

LEE'S SUMMIT, MO

2020

drawn by: C.S.M.  
checked by: S.M.S.  
designed by: C.S.M.  
QA/QC by: J.E.S.  
project no.: C18-1140  
date: 2020.07.10

SHEET  
C103

REVISIONS

BY

NO. REV.

DATE

REVISIONS DESCRIPTION

BY

DATE

NO. REV.

REVISIONS DESCRIPTION

BY

DATE

NO. REV.

REVISIONS DESCRIPTION



BY

DATE

NO. REV.



DWG: F:\2018\1001-1500\018-1140-C\40-Design\AutoCAD\Final Plans - Asbuilt\Sheets\GNC\Street & Storm\C\_GEN02\_C181140.dwg  
DATE: Oct 17, 2022 12:37pm  
USER: ssaylor

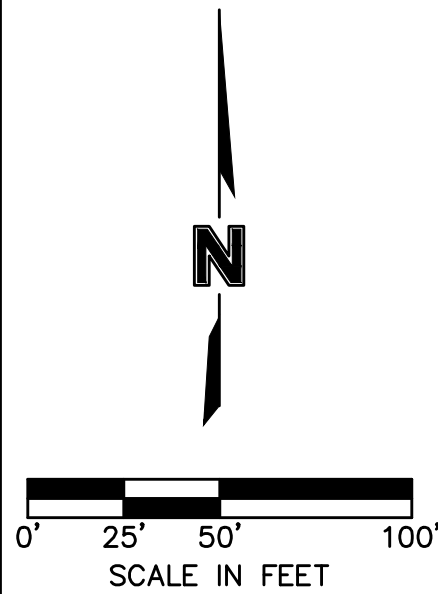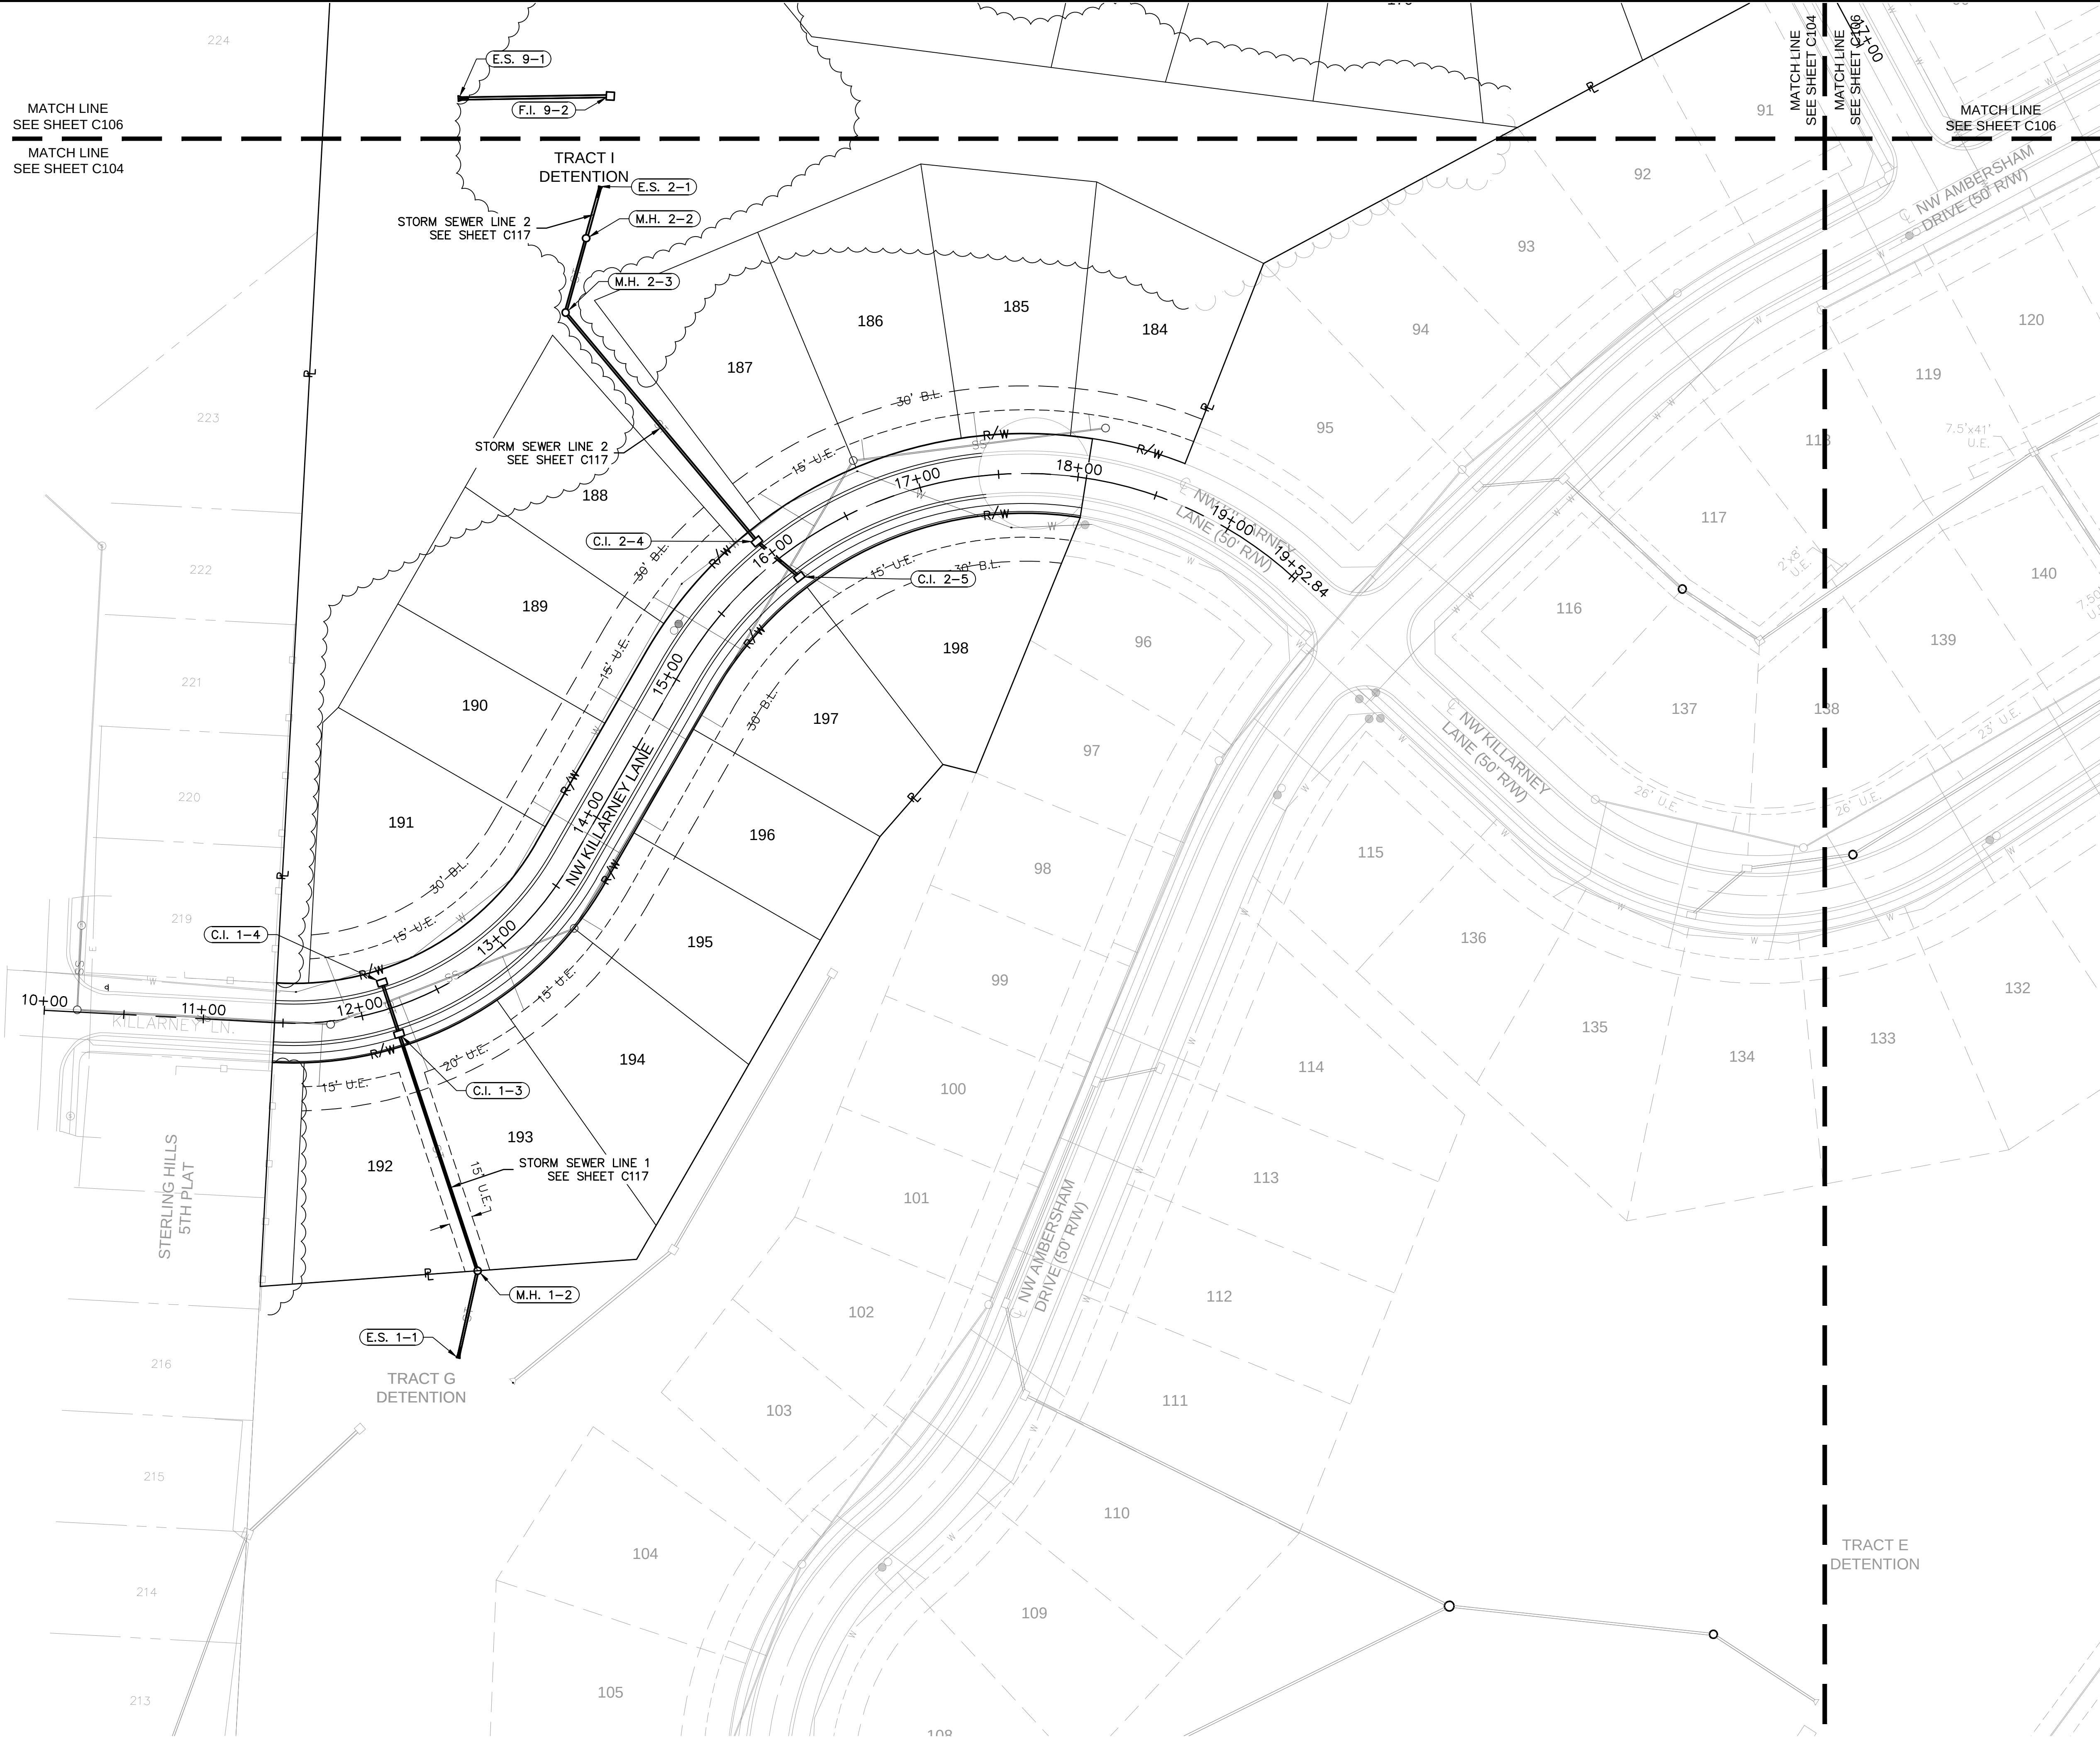

NOT ASBUILT

olsson

NO Conflicts of Interest at 03/09/22  
300 E. BIRCH STREET, SUITE 100  
NORTH KANSAS CITY, MO 64116  
TEL 816.861.1177  
www.olsson.com

STATE OF MISSOURI  
JULIE ELAINE SELLERS  
NUMBER  
PE-2017000367  
10/27/2022  
PROFESSIONAL SEAL

BY: \_\_\_\_\_  
REVISIONS DESCRIPTION  
DATE  
NO. REV. \_\_\_\_\_  
GENERAL LAYOUT  
STREET & STORM SEWER PLANS  
WOODSIDE RIDGE  
SECOND PLAT  
LEE'S SUMMIT, MO  
2020

drawn by: \_\_\_\_\_ C.S.M.  
checked by: \_\_\_\_\_ S.M.S.  
designed by: \_\_\_\_\_ C.S.M.  
QA/QC by: \_\_\_\_\_ J.E.S.  
project no.: C18-1140  
date: 2020.07.10

SHEET  
C104









DWG: F:\2018\1001-1500\018-1140-C\40-Design\AutoCAD\Final Plans - Asbuilt\Sheets\GNCV\Street & Storm\C\_GEN02\_C181140.dwg  
DATE: Oct 17, 2022 12:27pm  
USER: ssaylor



KEY MAP

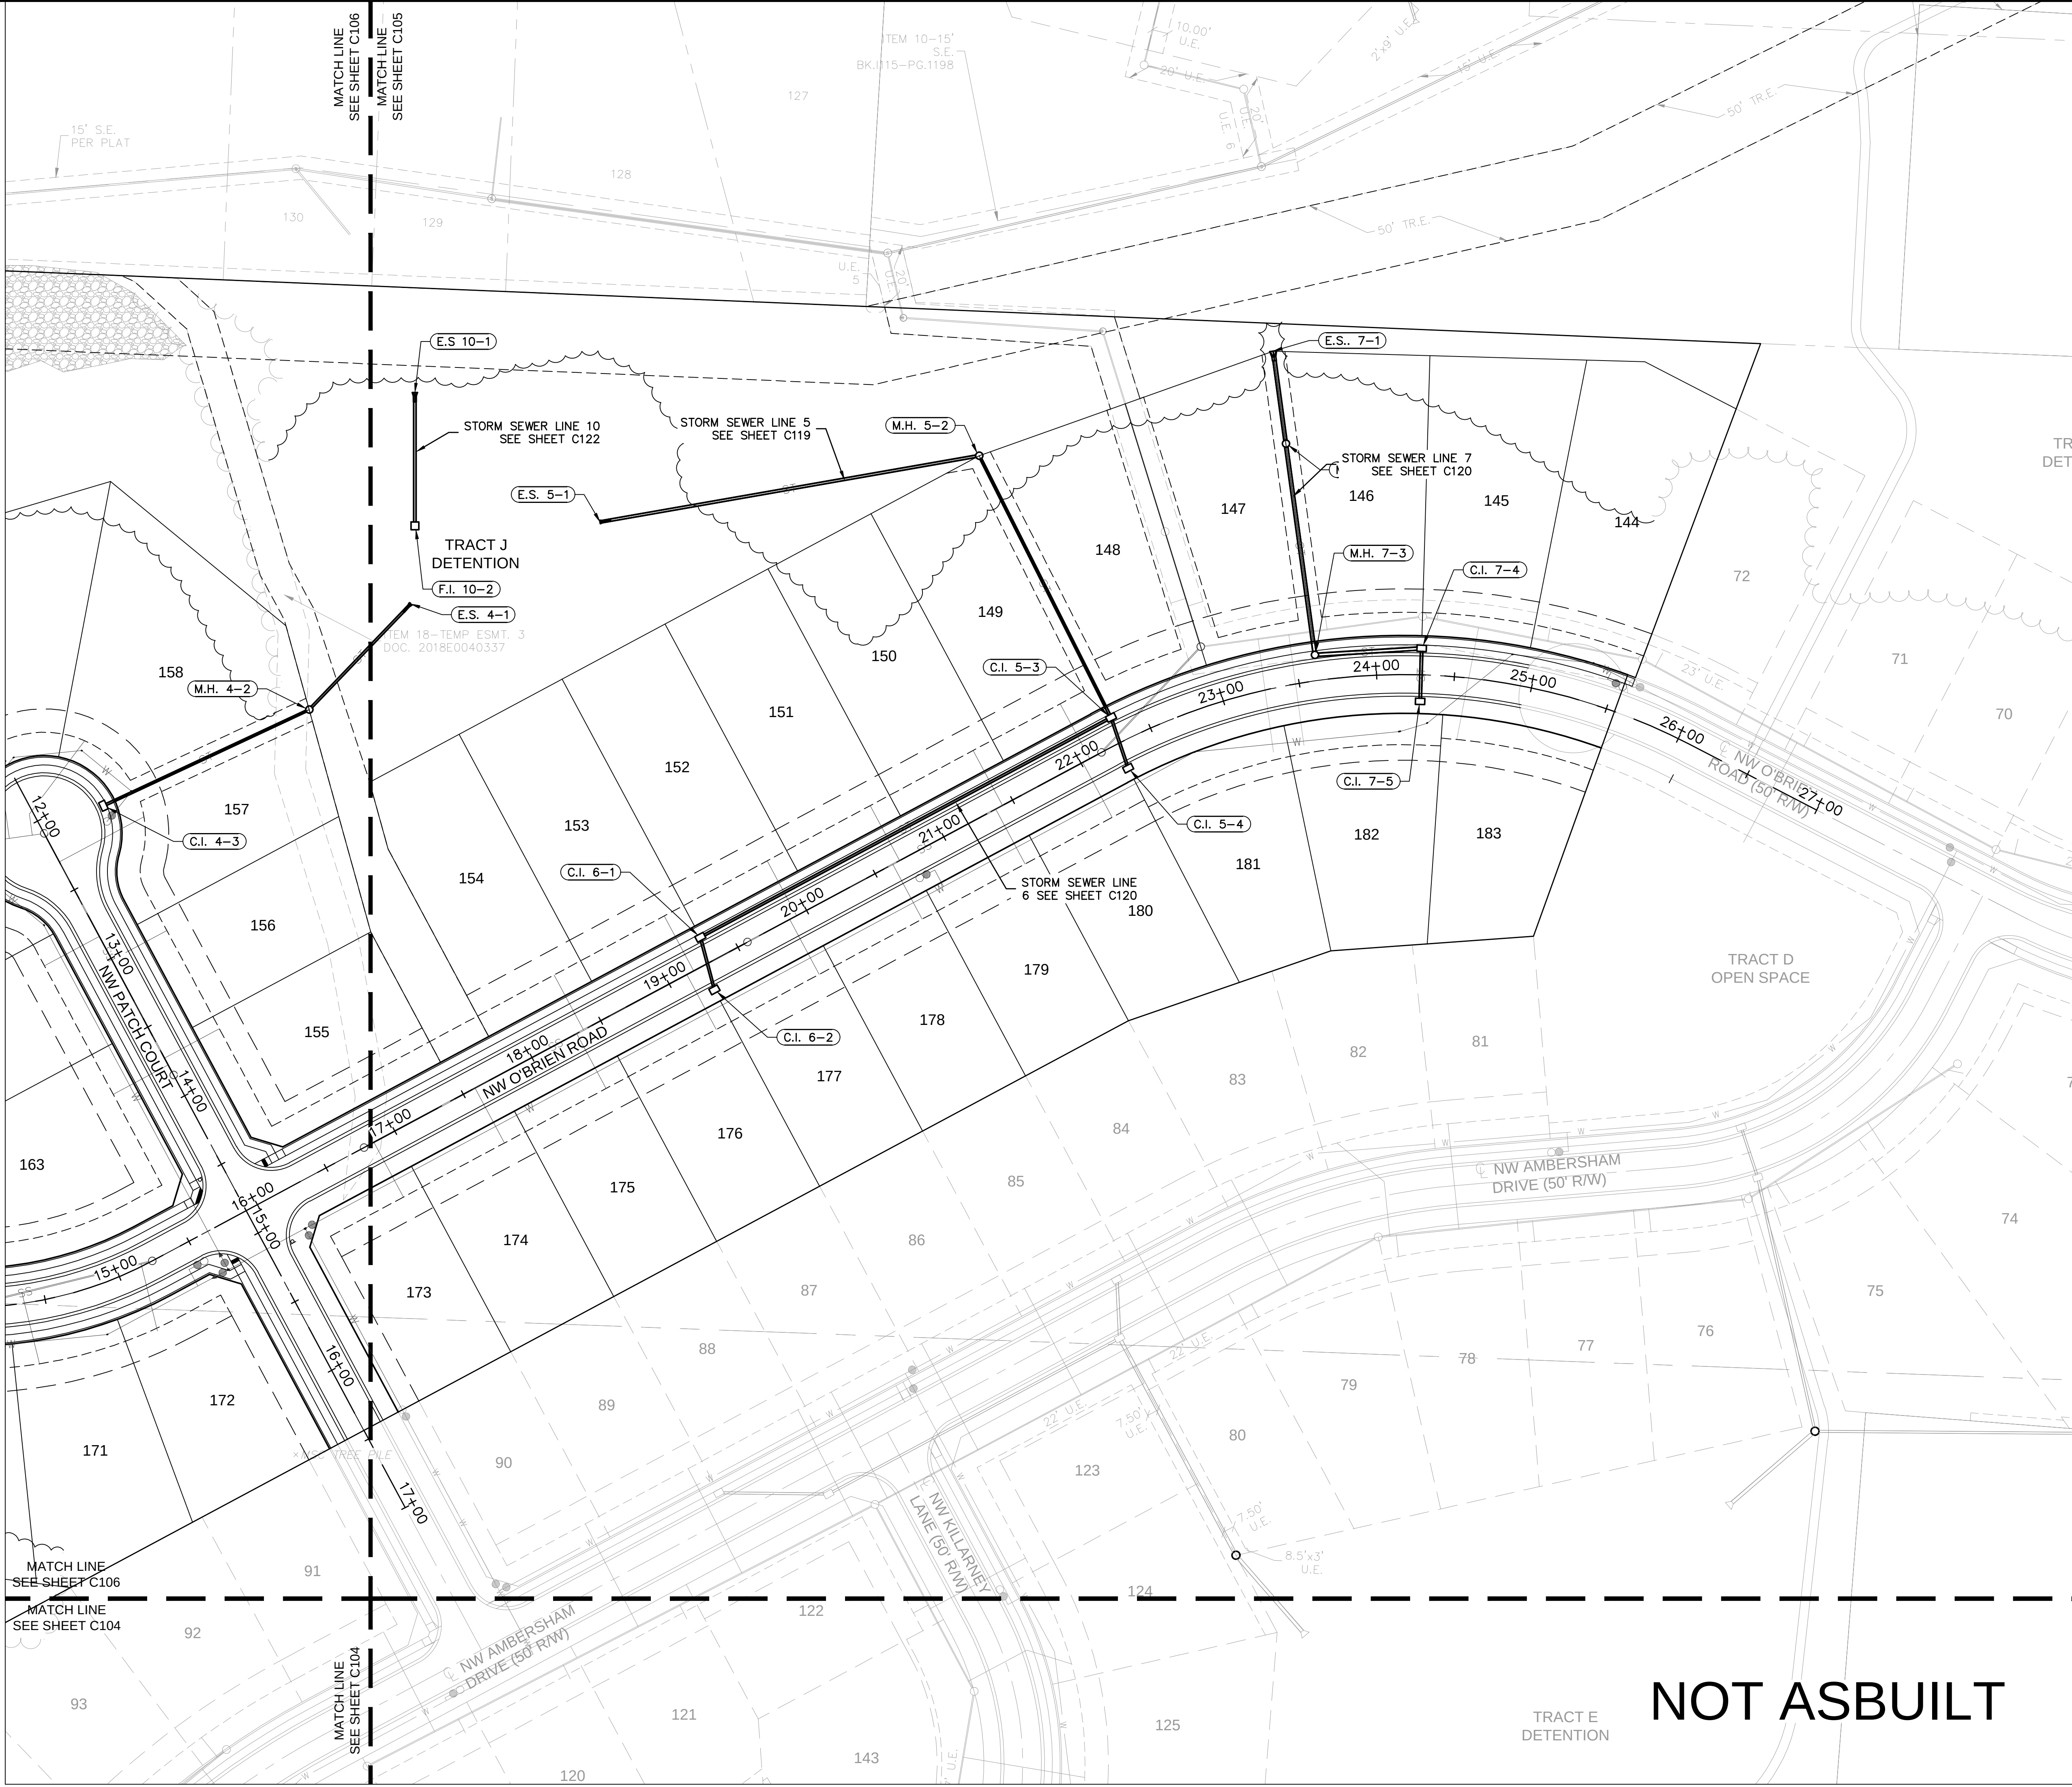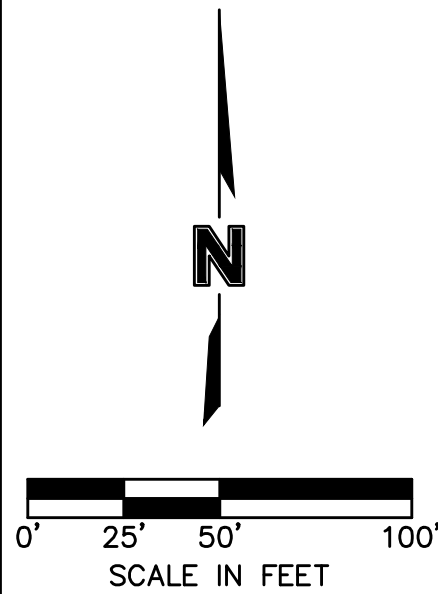

NOT ASBUILT

olsson

NO Conflicts of Interest on file  
300 E. Main Street, Suite 100  
North Kansas City, MO 64116  
TEL 816.861.1177  
www.olsson.com

STATE OF MISSOURI  
JULIE ELAINE SELLERS  
NUMBER PE-2017000367  
10/27/2022  
Professional Seal

BY: [Signature]  
DATE: [Blank]  
NO. REV: [Blank]

REVISIONS DESCRIPTION

NO. REV. DATE

GENERAL LAYOUT  
STREET & STORM SEWER PLANS  
WOODSIDE RIDGE  
SECOND PLAT  
LEE'S SUMMIT, MO

2020

drawn by: [Blank] C.S.M.  
checked by: [Blank] S.M.S.  
designed by: [Blank] C.S.M.  
QA/QC by: [Blank] J.E.S.  
project no.: C18-1140  
date: 2020.07.10

SHEET C106





1. CONTRACTOR SHALL ADHERE TO THE "DESIGN AND CONSTRUCTION MANUAL" SECTION 2100 AS ADOPTED BY THE CITY OF LEE'S SUMMIT (LATEST EDITION), FOR EXCAVATION AND EMBANKMENT WORK WITHIN THE PROPOSED RIGHT-OF-WAY.

2. AREAS OF CONSTRUCTION SHALL BE STRIPPED OF ALL VEGETATION, ORGANIC MATTER AND TOPSOIL TO A DEPTH AS RECOMMENDED BY GEOTECHNICAL ENGINEER AND OR TESTING AGENCY. SOILS REMOVED DURING SITE STRIPPING SHOULD BE EVALUATED TO DETERMINE IF PORTIONS OF THE TOPSOIL STRATUM MAY BE UTILIZED AS STRUCTURAL FILL WITHIN PAVEMENT AREAS. ANY MATERIAL NOT DEEMED AS SUITABLE FILL MATERIAL BY THE GEOTECHNICAL ENGINEER AND OR TESTING AGENCY SHALL BE REMOVED FROM THE JOB SITE BY THE CONTRACTOR AT HIS EXPENSE.

3. ALL EMBANKMENT OUTSIDE OF RIGHT-OF-WAY SHOULD BE PLACED IN CONTROLLED LIFTS HAVING A MAXIMUM LOOSE LIFT THICKNESS OF 8". EMBANKMENT SHOULD BE COMPACTED TO A MINIMUM OF 95% OF THE MATERIALS MAXIMUM DRY DENSITY AS DETERMINED BY ASTM D-698 (STANDARD PROCTOR COMPACTION). MOISTURE CONTENT OF THE FILL AT THE TIME OF COMPACTION SHALL BE WITHIN A RANGE OF -0 TO +4 PERCENT OF OPTIMUM MOISTURE CONTENT.

| LEGEND                                                                            |                                |
|-----------------------------------------------------------------------------------|--------------------------------|
|  | EXISTING INDEX CONTOURS        |
|  | EXISTING INTERMEDIATE CONTOURS |
|  | PROPOSED INDEX CONTOURS        |
|  | PROPOSED INTERMEDIATE CONTOURS |



| EARTHWORK QUANTITIES |            |             |
|----------------------|------------|-------------|
| LOCATION             | CUT (C.Y.) | FILL (C.Y.) |
| STREET               | 8049       | 7968        |
| SITE                 | 52613      | 83489       |
| TOTAL                | 60662      | 91457       |

1. EARTHWORK QUANTITIES BASED ON FINISHED GRADE SURFACE AND DO NOT INCLUDE ADJUSTMENTS FOR TOPSOIL AND SHRINKAGE.

2. EARTHWORK QUANTITIES DO NOT TAKE INTO CONSIDERATION EXCAVATION, REMOVAL AND DISPOSAL OF MATERIAL DEEMED UNSUITABLE BY A GEOTECHNICAL ENGINEER. THE EARTHWORK CONTRACTOR IS RESPONSIBLE FOR EXCAVATION, REMOVAL AND DISPOSAL OF UNSUITABLE MATERIAL AND FOR REPLACING IT WITH SUITABLE MATERIAL.

1. REMOVE TOPSOIL AND ORGANIC DIRT FROM THE AREA
2. PROOF ROLL TO CHECK THE SUBGRADE
  - 2.1. REMOVE OR REPAIR ANY UNSTABLE AREA IN ACCORDANCE WITH THIRD-PARTY TESTER

3. PLACE 9" LOOSE LIFTS OF 9" MATERIAL WITH LL=50 AND PI=25 OR GREATER. EMBANKMENT SHOULD BE COMPACTED TO A MINIMUM OF 95% OF THE MATERIALS MAXIMUM DRY DENSITY AS DETERMINED BY ASTM D-698 (STANDARD PROCTOR COMPACTION). MOISTURE CONTENT OF THE FILL AT THE TIME OF COMPACTION SHALL BE WITHIN A RANGE OF -0 TO +4 PERCENT OF OPTIMUM MOISTURE CONTENT.

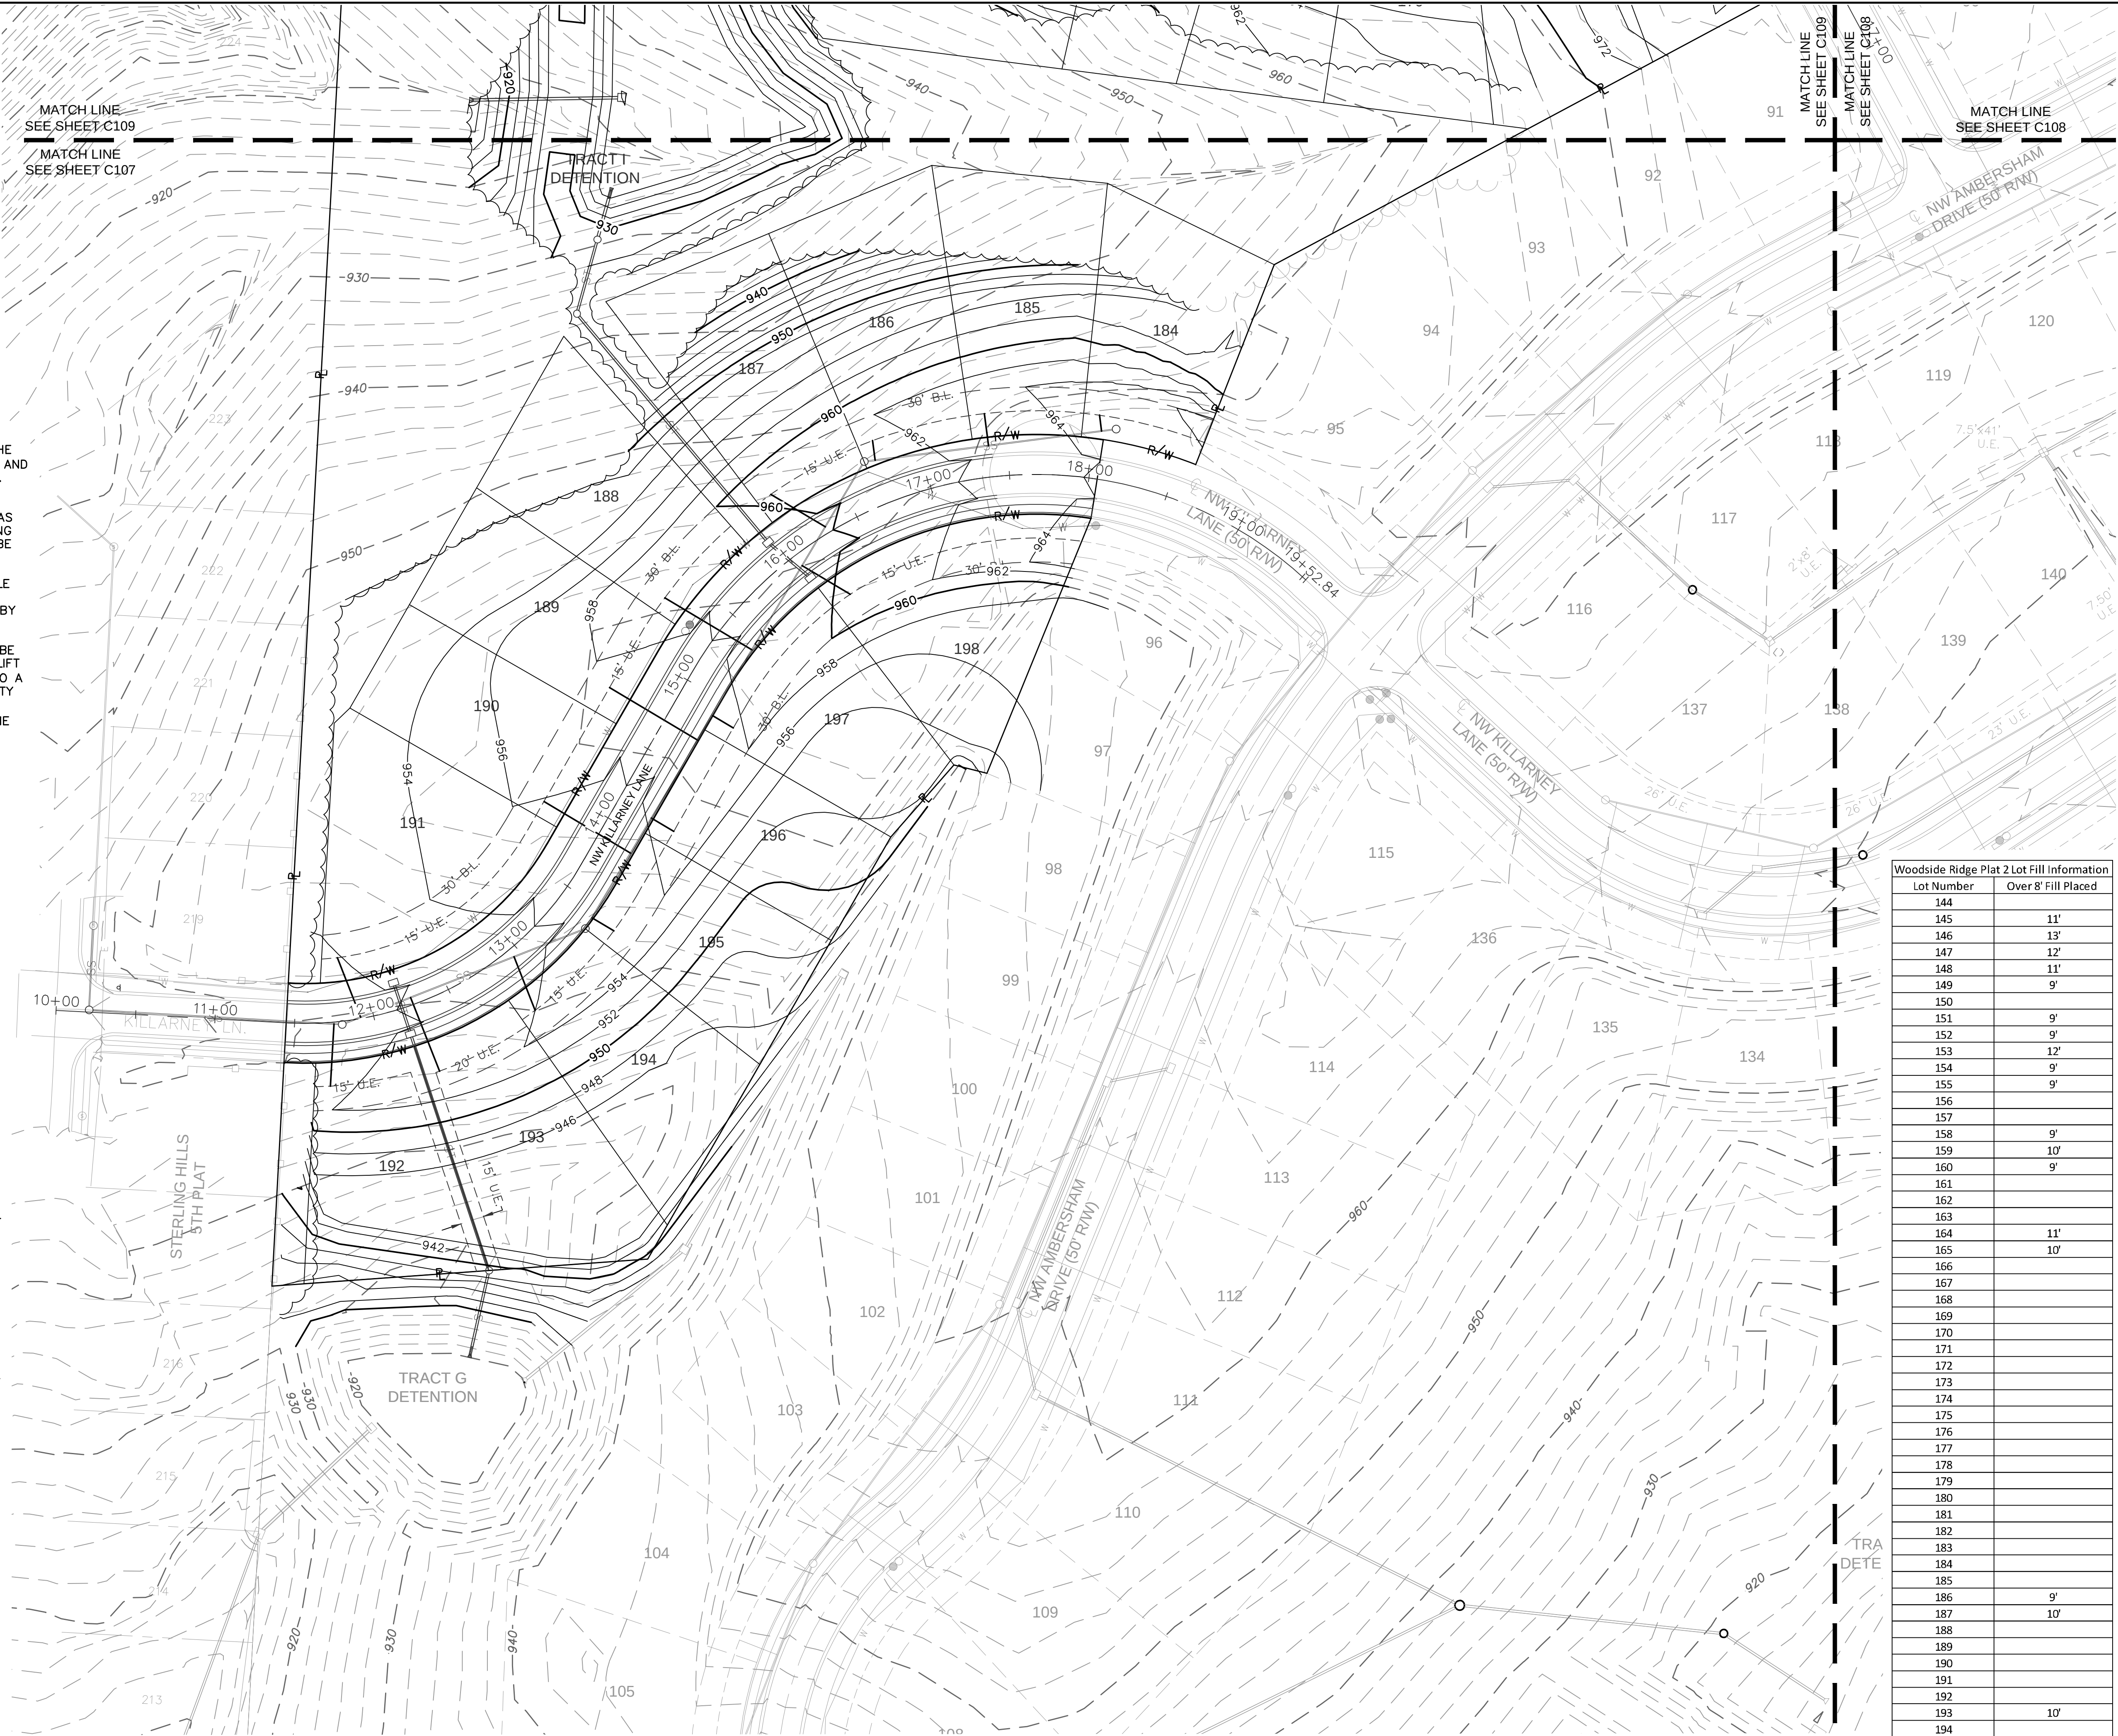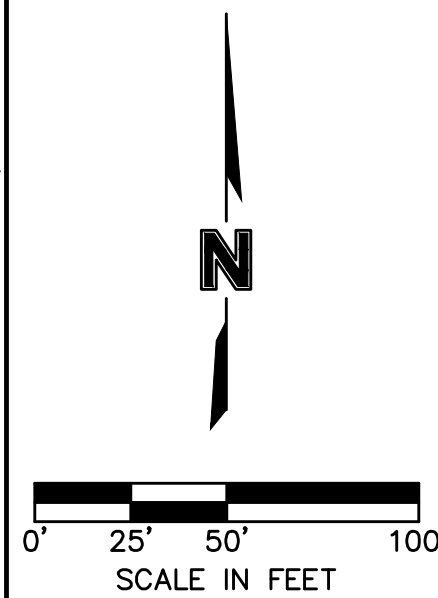

| Woodside Ridge Plat 2 Lot Fill Information |                     |
|--------------------------------------------|---------------------|
| Lot Number                                 | Over 8' Fill Placed |
| 144                                        |                     |
| 145                                        | 11'                 |
| 146                                        | 13'                 |
| 147                                        | 12'                 |
| 148                                        | 11'                 |
| 149                                        | 9'                  |
| 150                                        |                     |
| 151                                        | 9'                  |
| 152                                        | 9'                  |
| 153                                        | 12'                 |
| 154                                        | 9'                  |
| 155                                        | 9'                  |
| 156                                        |                     |
| 157                                        |                     |
| 158                                        | 9'                  |
| 159                                        | 10'                 |
| 160                                        | 9'                  |
| 161                                        |                     |
| 162                                        |                     |
| 163                                        |                     |
| 164                                        | 11'                 |
| 165                                        | 10'                 |
| 166                                        |                     |
| 167                                        |                     |
| 186                                        | 9'                  |
| 187                                        | 10'                 |
| 188                                        |                     |
| 189                                        |                     |
| 190                                        |                     |
| 191                                        |                     |
| 192                                        |                     |
| 193                                        | 10'                 |
| 194                                        |                     |
| 195                                        |                     |
| 196                                        |                     |
| 197                                        |                     |
| 198                                        |                     |

NOT ASBUILT

[illegible]

# GRADING PLAN STREET & STORM SEWER PLANS

WOODSIDE RIDGE  
SECOND PLAT

LEE'S SUMMIT, MO

drawn by: C.S.M  
checked by: S.M.S  
designed by: C.S.M  
QA/QC by: J.E.S  
project no.: C18-1140  
date: 2020.07.10

SHEET  
C107

**olson**

MO Certificate of Authority #:001592  
1301 BURLINGTON, SUITE 100  
NORTH KANSAS CITY, MO 64116

www.olsson.com







KEY MAP

| Woodside Ridge Plat 2 Lot Fill Information |                     |
|--------------------------------------------|---------------------|
| Lot Number                                 | Over 8' Fill Placed |
| 144                                        |                     |
| 145                                        | 11'                 |
| 146                                        | 13'                 |
| 147                                        | 12'                 |
| 148                                        | 11'                 |
| 149                                        | 9'                  |
| 150                                        |                     |
| 151                                        | 9'                  |
| 152                                        | 9'                  |
| 153                                        | 12'                 |
| 154                                        | 9'                  |
| 155                                        | 9'                  |
| 156                                        |                     |
| 157                                        |                     |
| 158                                        | 9'                  |
| 159                                        | 10'                 |
| 160                                        | 9'                  |
| 161                                        |                     |
| 162                                        |                     |
| 163                                        |                     |
| 164                                        | 11'                 |
| 165                                        | 10'                 |
| 166                                        |                     |
| 167                                        |                     |
| 186                                        | 9'                  |
| 187                                        | 10'                 |
| 188                                        |                     |
| 189                                        |                     |
| 190                                        |                     |
| 191                                        |                     |
| 192                                        |                     |
| 193                                        | 10'                 |
| 194                                        |                     |
| 195                                        |                     |
| 196                                        |                     |
| 197                                        |                     |
| 198                                        |                     |

NOT ASBUILT

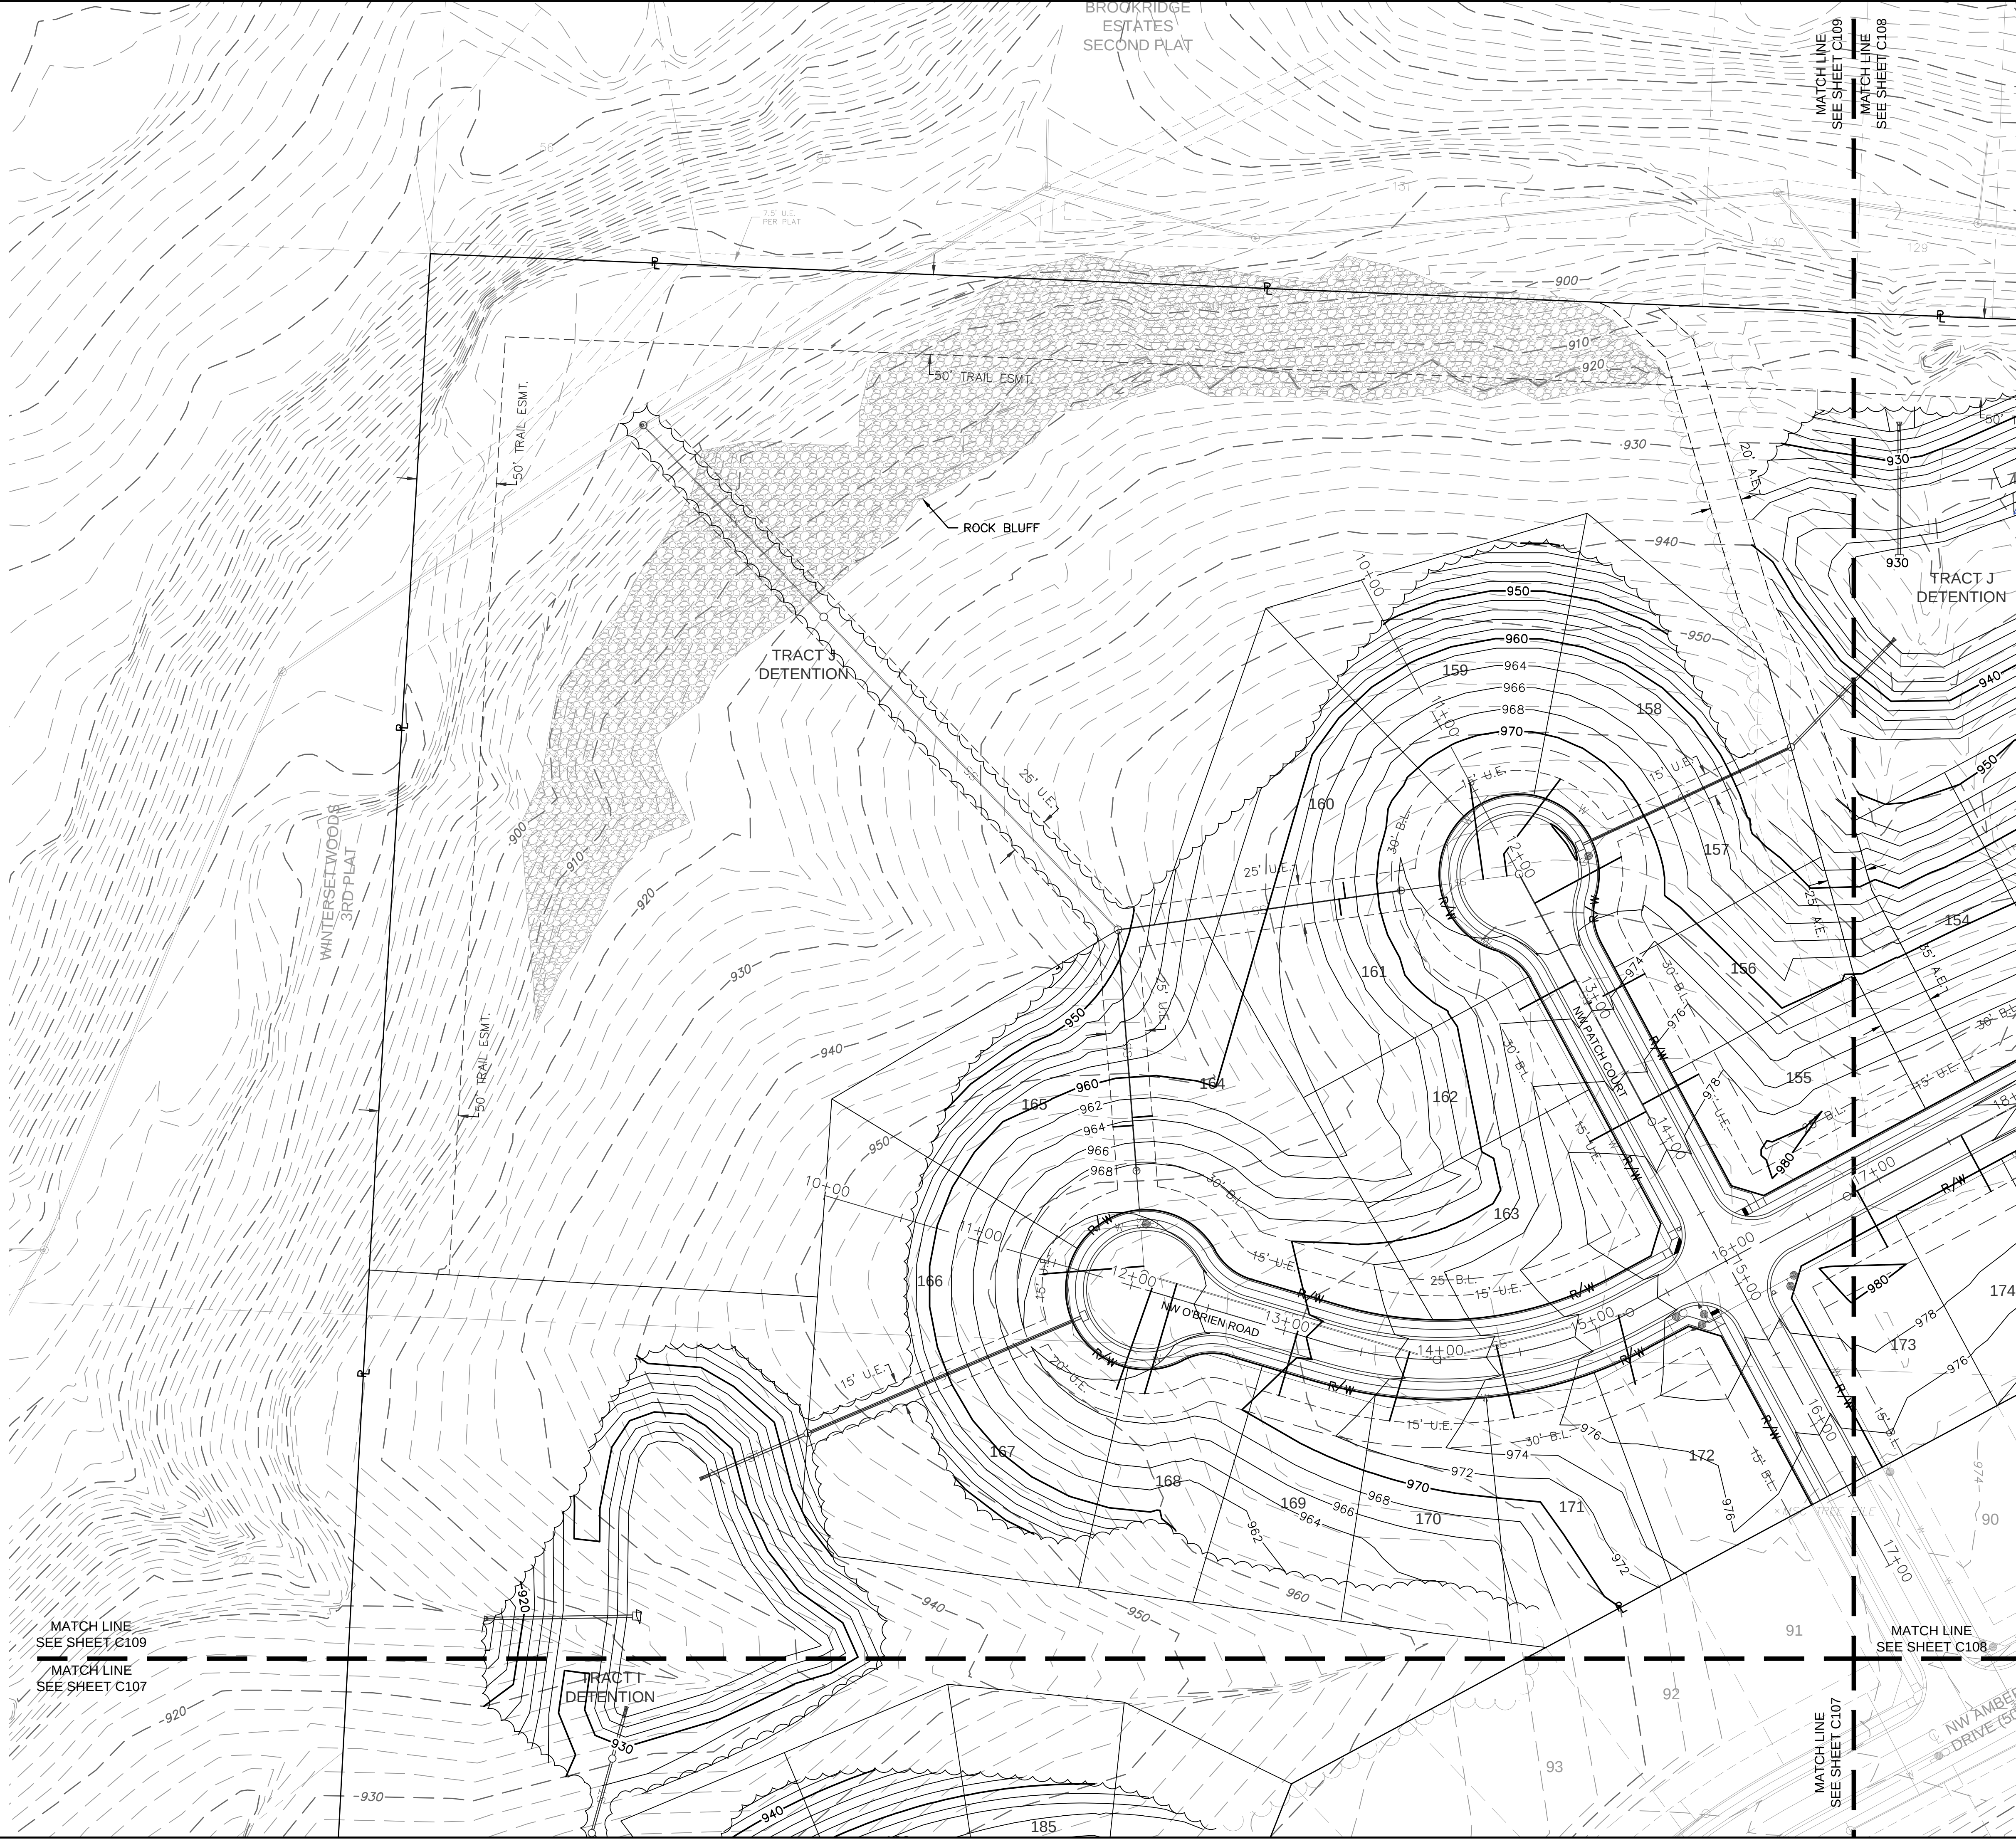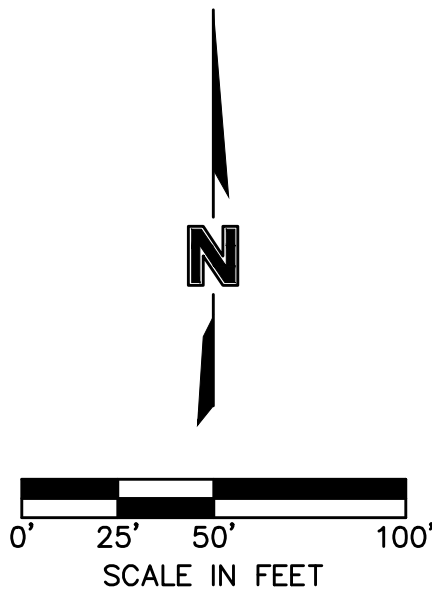

BY

NO. REV.

DATE

REVISIONS DESCRIPTION

STATE OF MISSOURI

JULIE ELAINE SELLERS

NUMBER PE-2017000367

10/27/2022

PROFESSIONAL SEAL

GRADING PLAN

STREET & STORM SEWER PLANS

WOODSIDE RIDGE

SECOND PLAT

LEE'S SUMMIT, MO



2020

SHEET C108











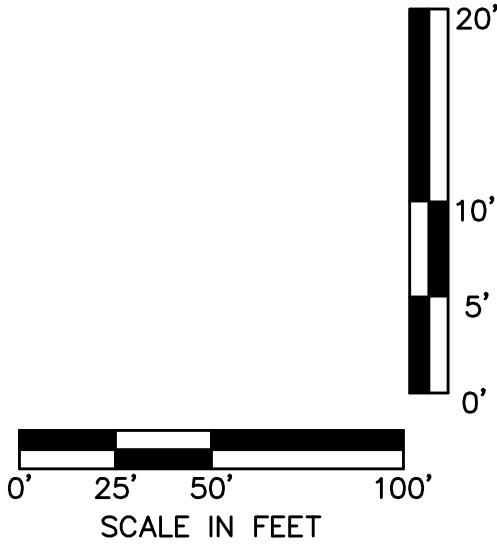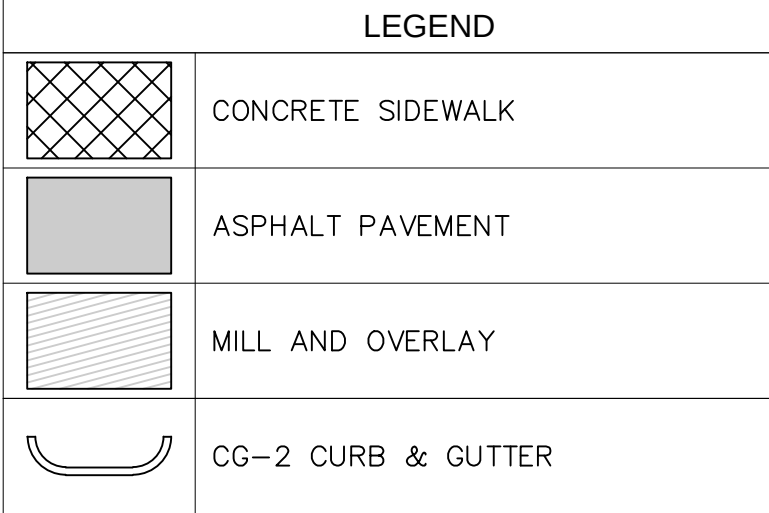

| CURVE TABLE |             |            |             |              |                 |
|-------------|-------------|------------|-------------|--------------|-----------------|
| CURVE ID #  | RADIUS (FT) | DELTA      | LENGTH (FT) | TANGENT (FT) | P.I. STA. (BK.) |
| C1          | 200.00      | 063°10'08" | 220.50      | 122.97       | 12+43.68        |
| C2          | 250.00      | 102°45'33" | 448.37      | 312.94       | 16+39.90        |

ASBUILT  
03-24-2022




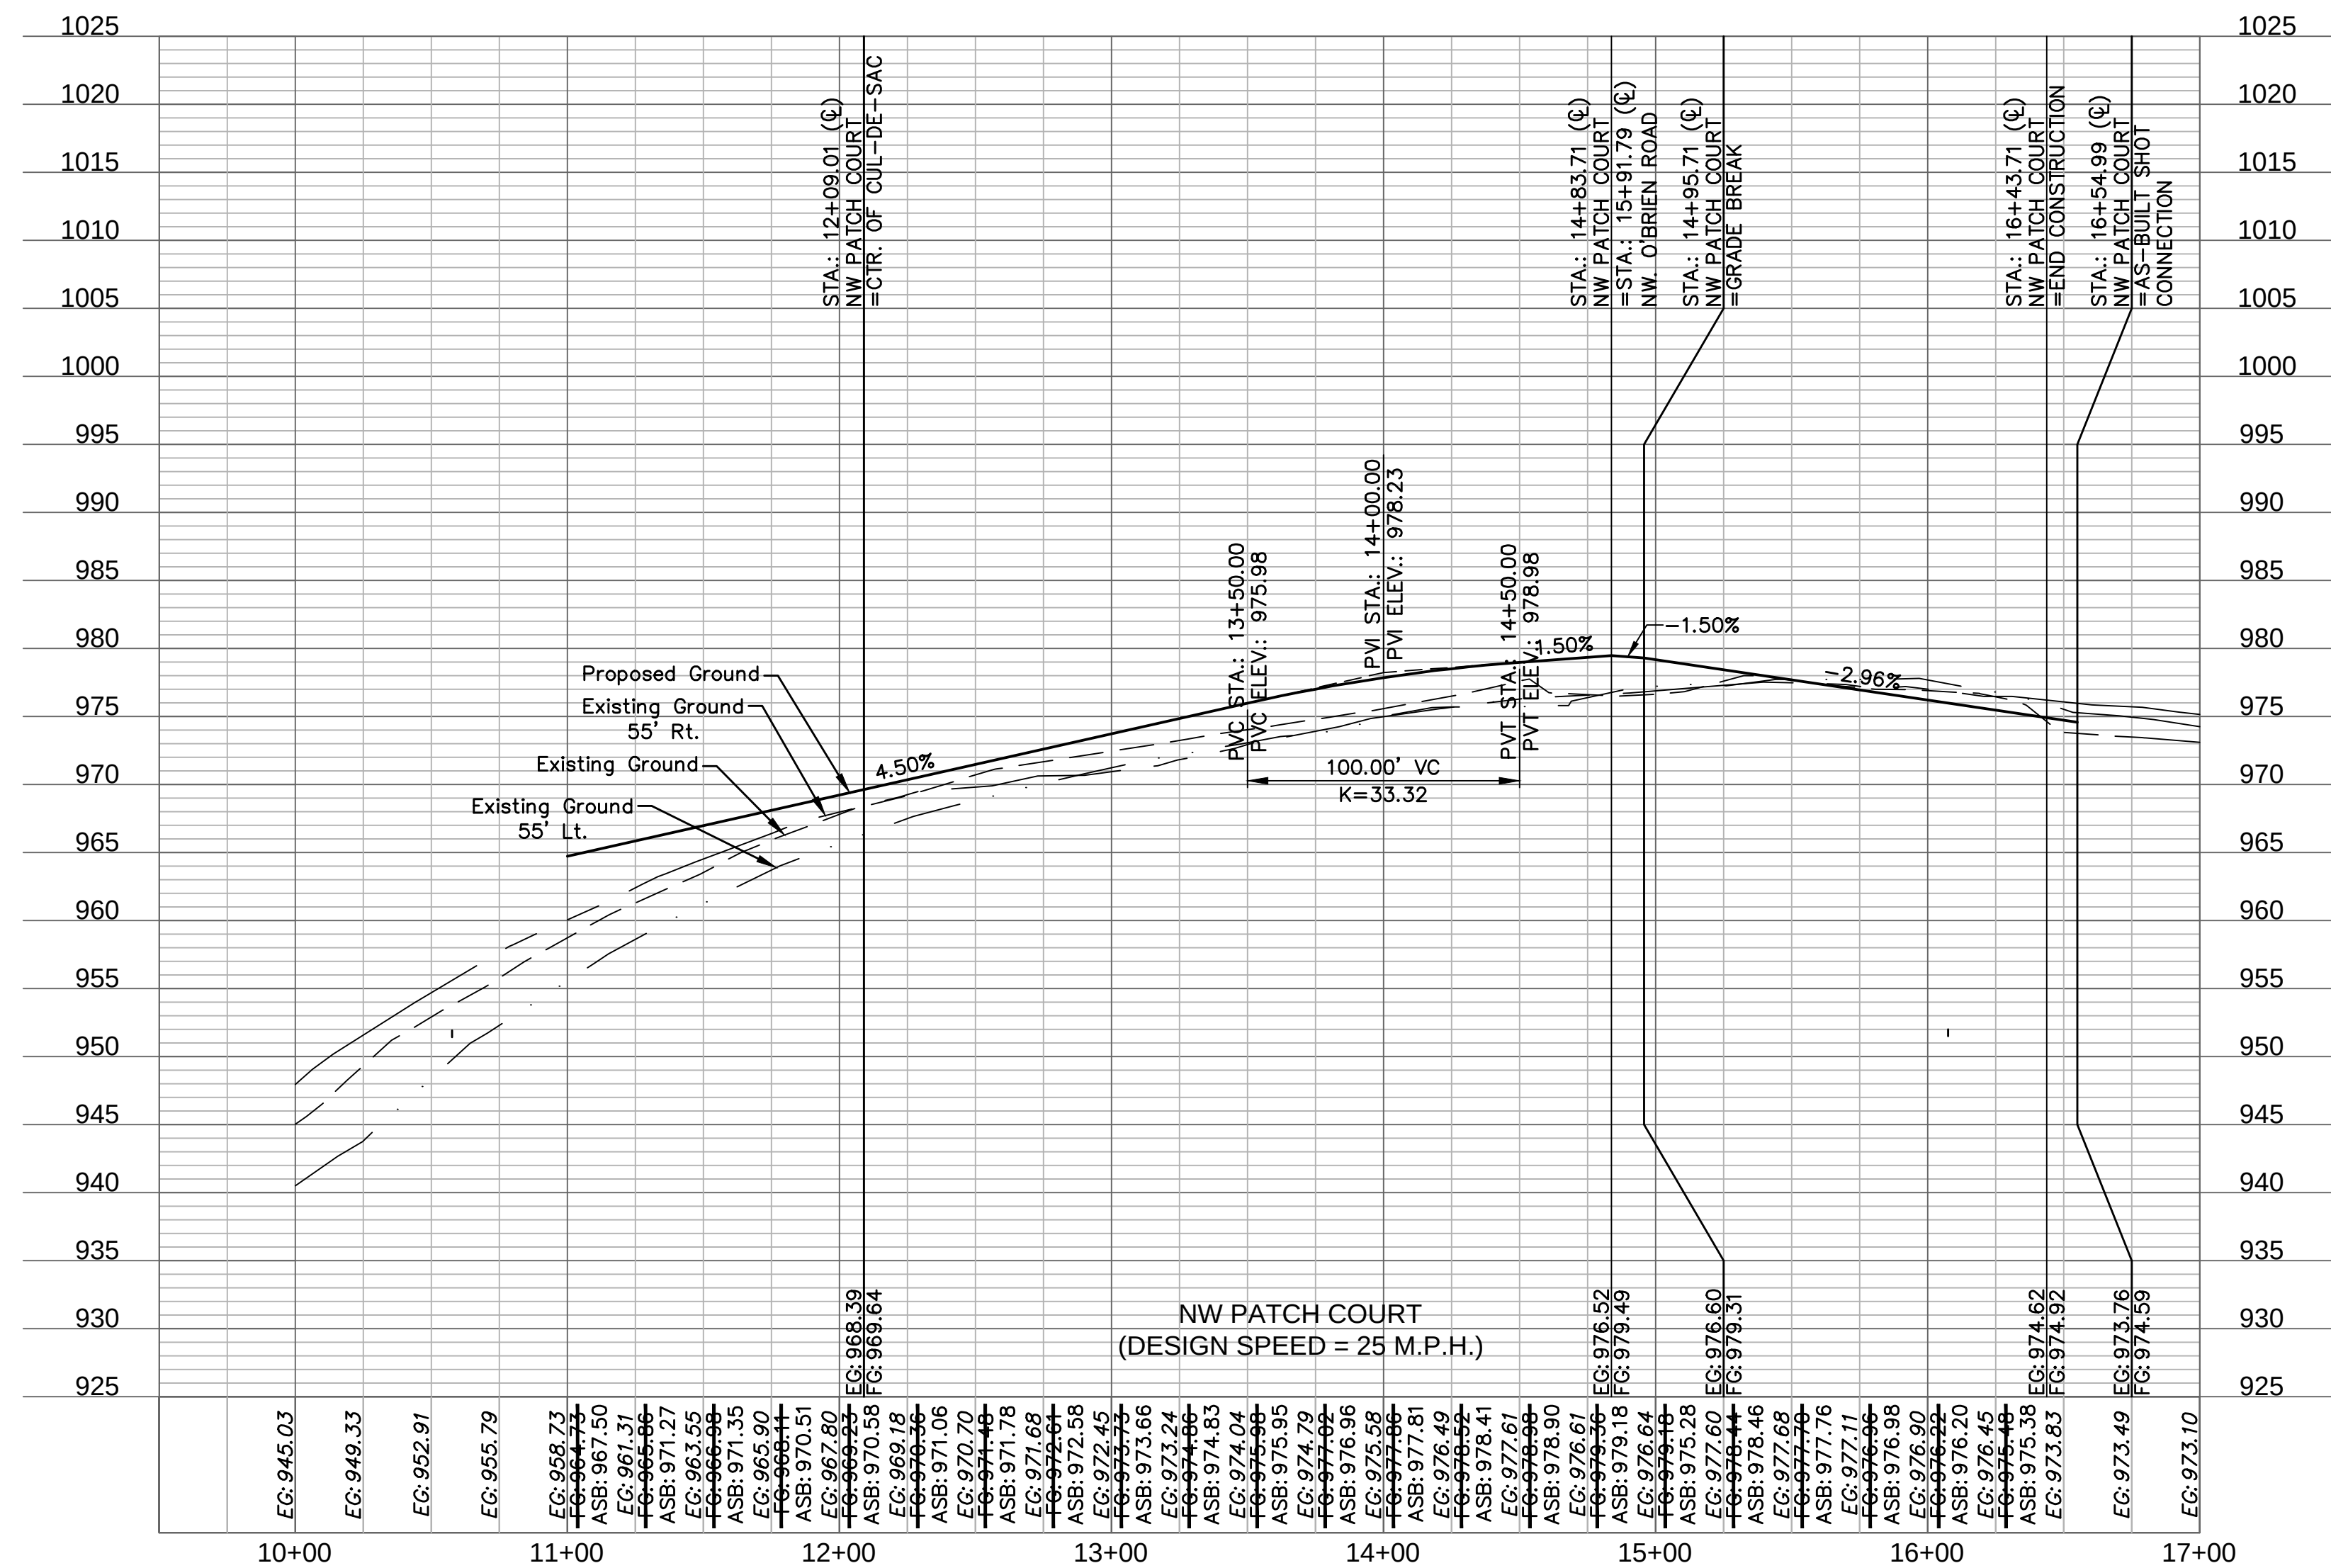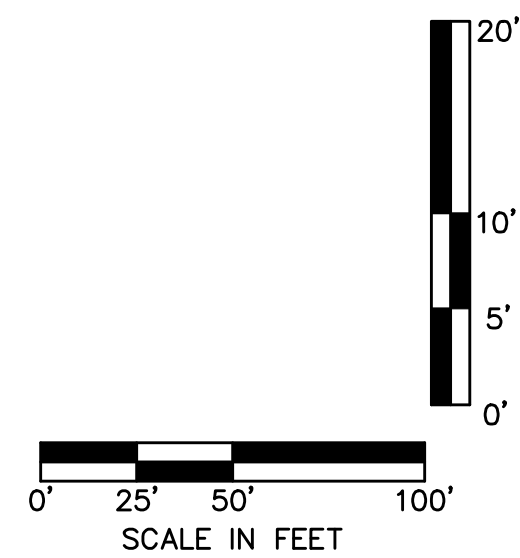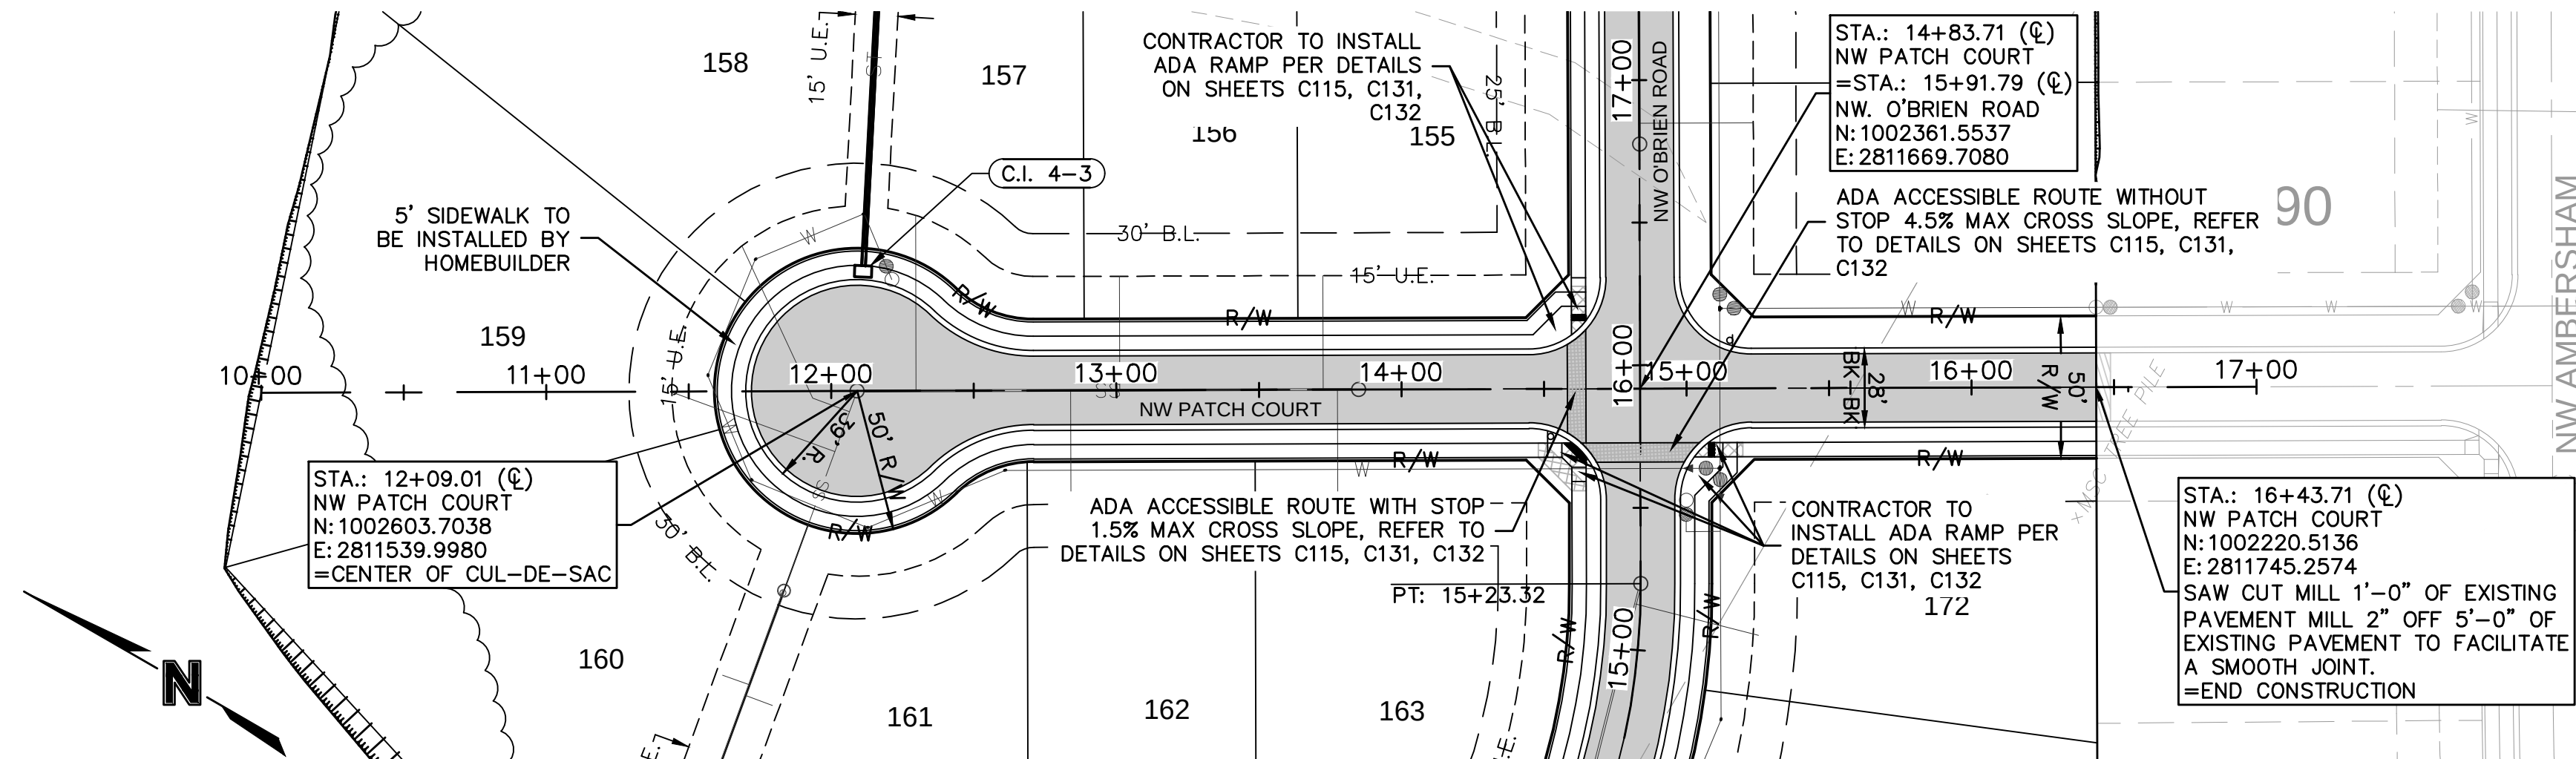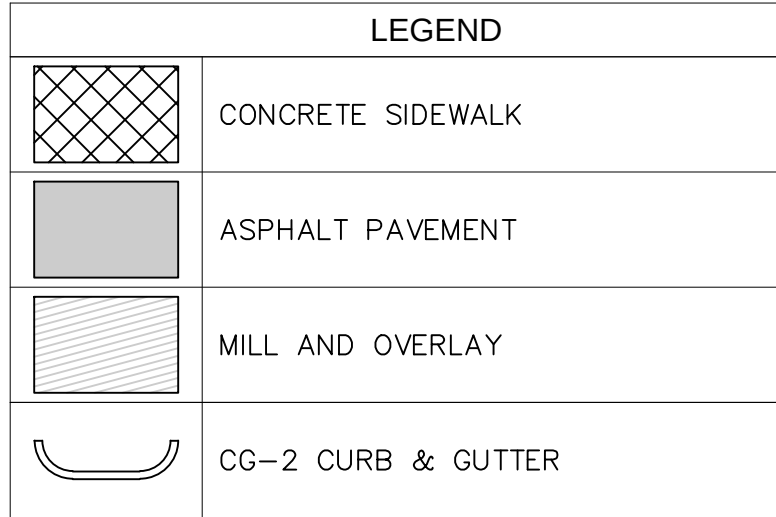

ASBUILT  
03-24-2022

|                                                      |  |            |      |                       |    |
|------------------------------------------------------|--|------------|------|-----------------------|----|
| drawn by: _____ C.S.M                                |  | NO<br>REV. | DATE | REVISIONS DESCRIPTION | BY |
| checked by: _____ S.M.S                              |  |            |      |                       |    |
| designed by: _____ C.S.M                             |  |            |      |                       |    |
| QA/QC by: _____ J.E.S                                |  |            |      |                       |    |
| project no.: _____ C18-1140                          |  |            |      |                       |    |
| date: _____ 2020.07.10                               |  |            |      |                       |    |
| ROADWAY PLAN & PROFILE<br>STREET & STORM SEWER PLANS |  |            |      |                       |    |
| WOODSIDE RIDGE<br>SECOND PLAT                        |  |            |      |                       |    |
| LEE'S SUMMIT, MO                                     |  | 2020       |      | REVISIONS             |    |
| SHEET<br>C111                                        |  |            |      |                       |    |





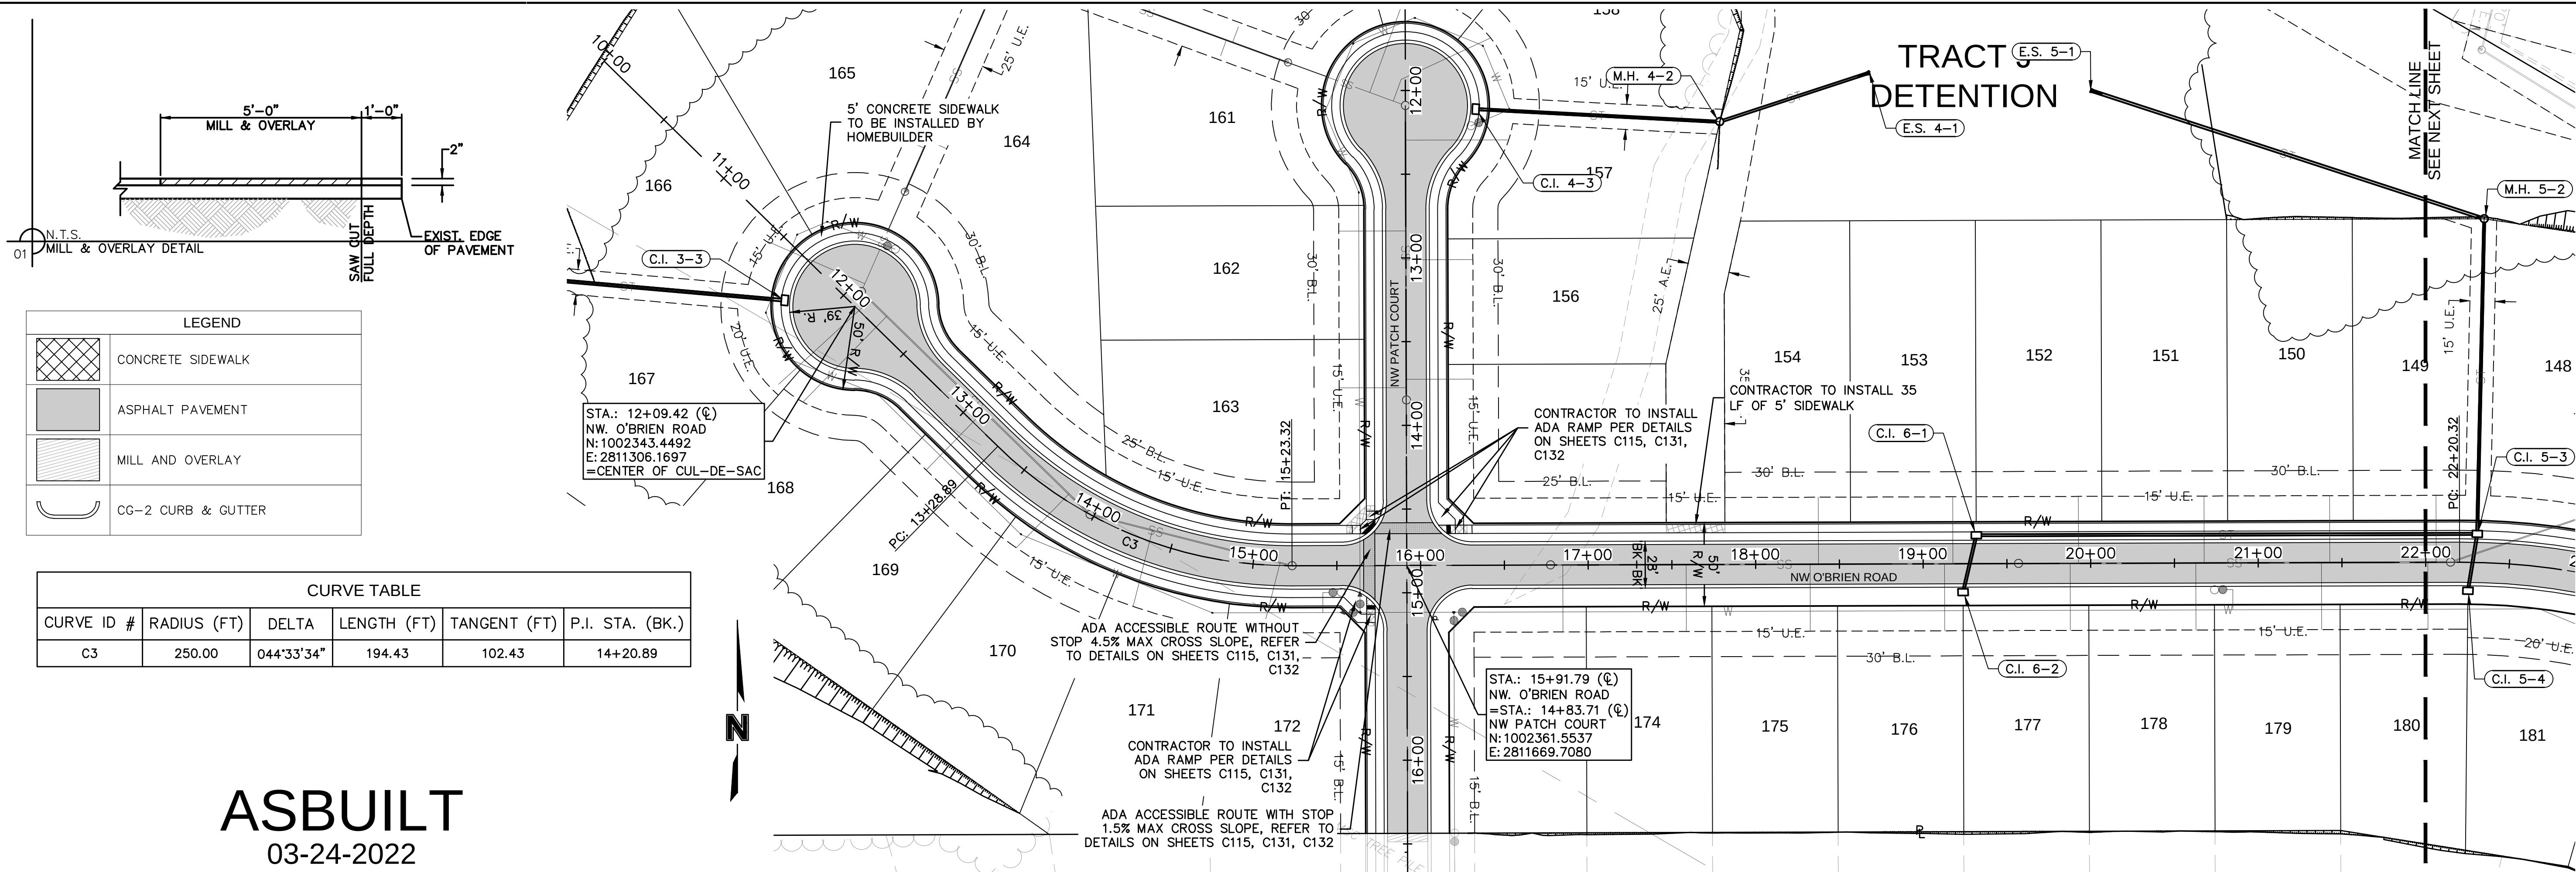

| LEGEND |                    |
|--------|--------------------|
|        | CONCRETE SIDEWALK  |
|        | ASPHALT PAVEMENT   |
|        | MILL AND OVERLAY   |
|        | CG-2 CURB & GUTTER |

| CURVE TABLE |             |            |             |              |                 |
|-------------|-------------|------------|-------------|--------------|-----------------|
| CURVE ID #  | RADIUS (FT) | DELTA      | LENGTH (FT) | TANGENT (FT) | P.I. STA. (BK.) |
| C3          | 250.00      | 044°33'34" | 194.43      | 102.43       | 14+20.89        |

ASBUILT  
03-24-2022

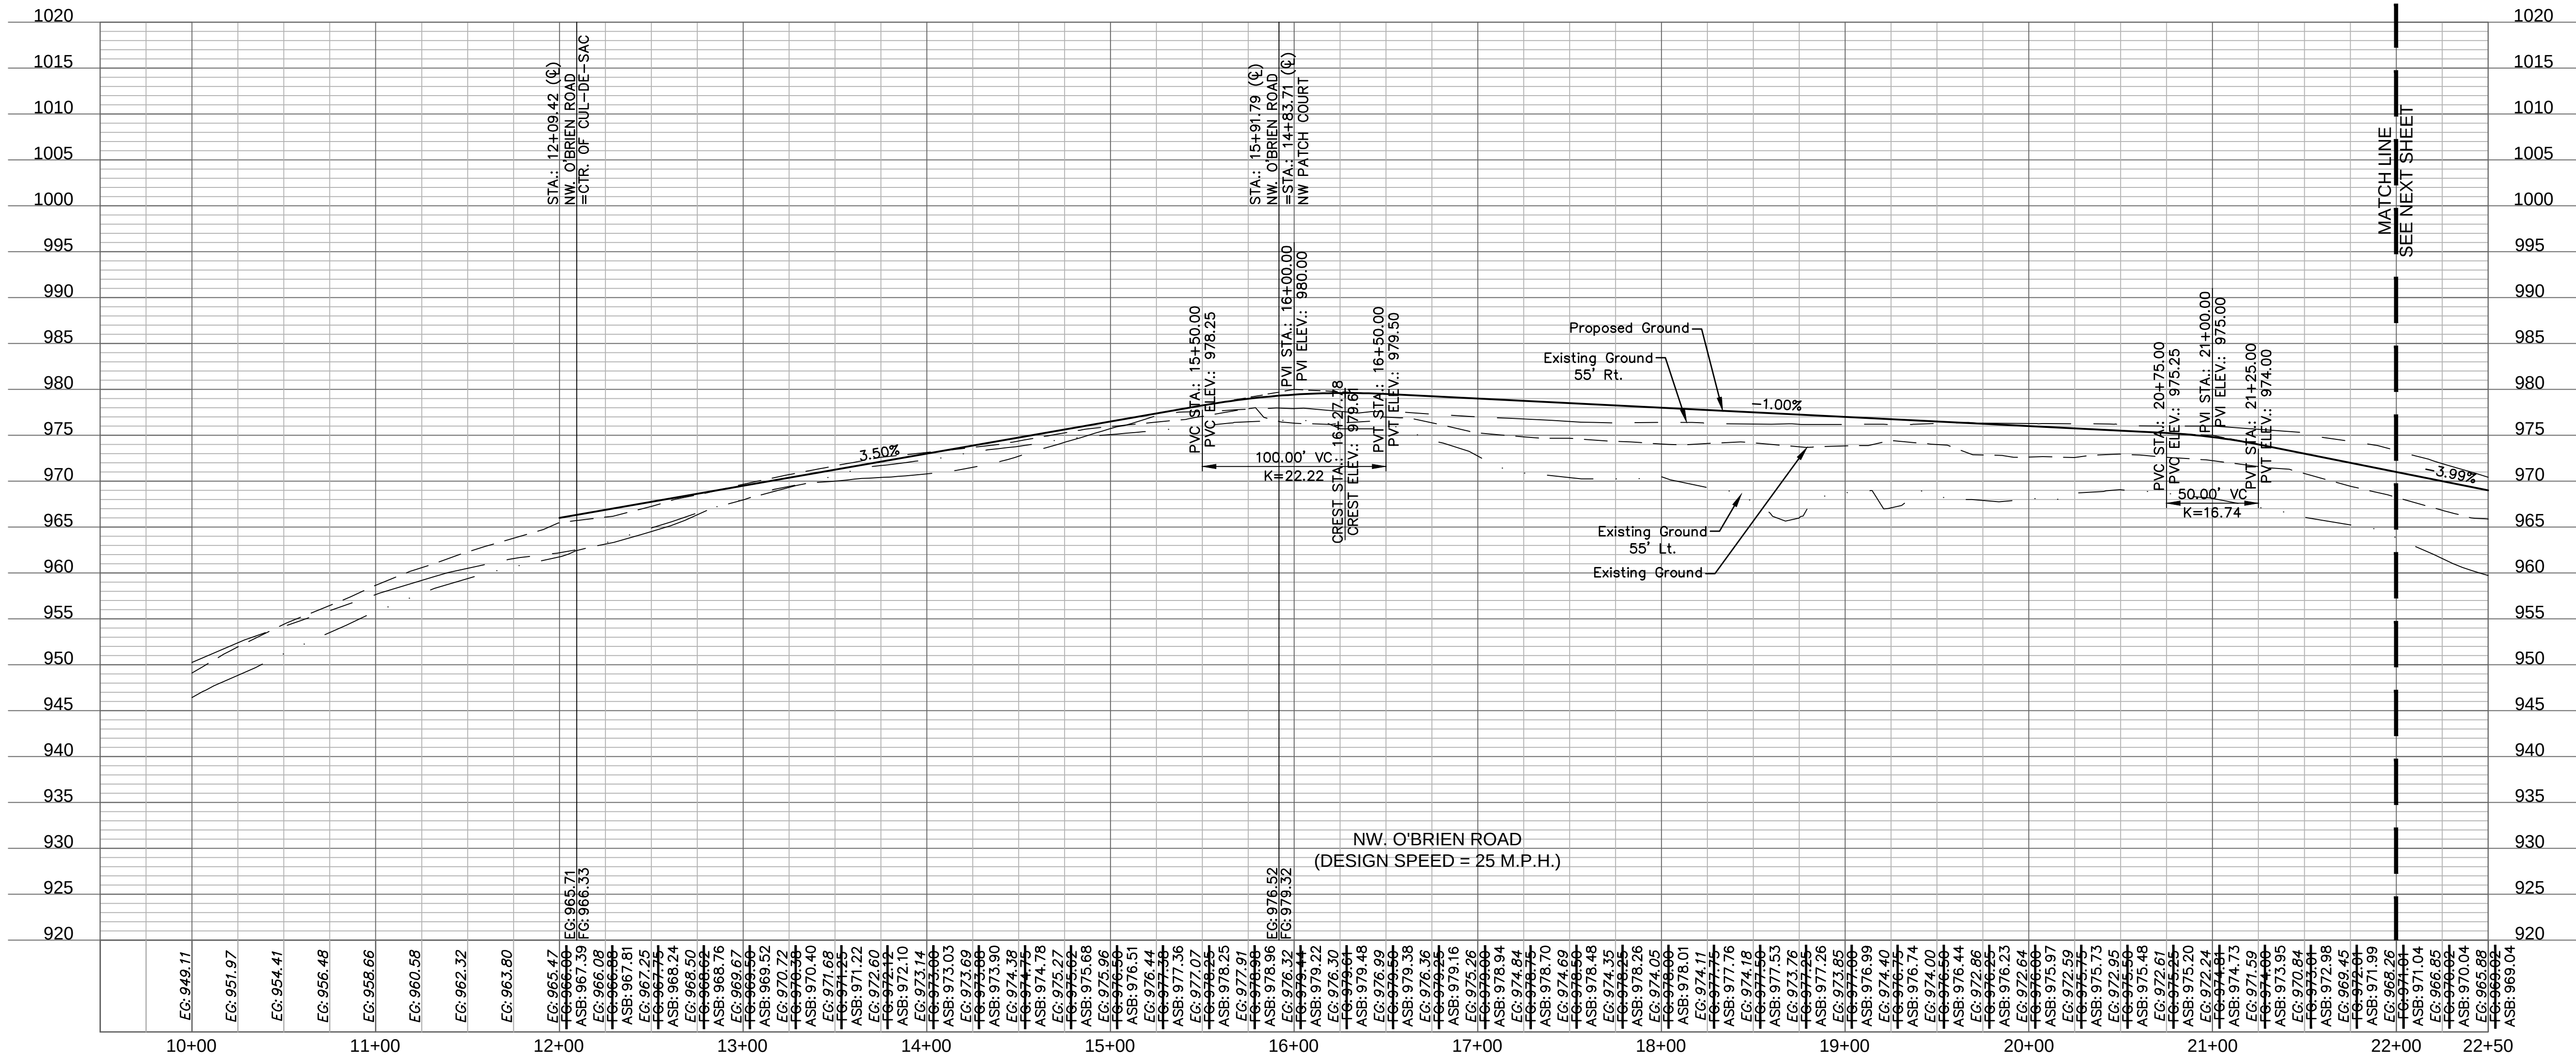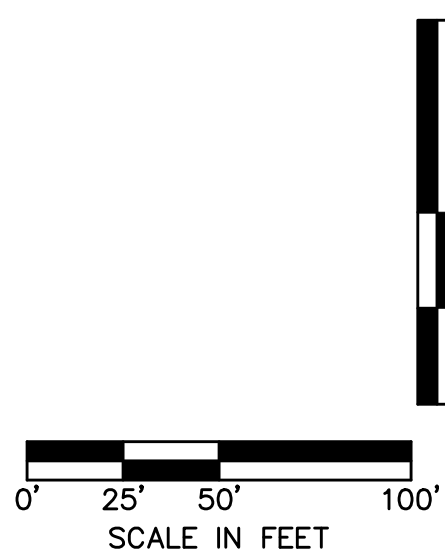

olsson

NO. 1000 of Authority of Missouri  
300 E. BROADWAY, SUITE 100  
NORTH KANSAS CITY, MO 64116  
TEL. 816.861.1177  
www.olsson.com

STATE OF MISSOURI  
JULIE ELAINE SELLERS  
NUMBER  
PE-2017000367  
10/27/2022  
MISSOURI DEPARTMENT OF TRANSPORTATION

BY: \_\_\_\_\_  
NO. REV. \_\_\_\_\_  
DATE \_\_\_\_\_  
REVISIONS DESCRIPTION


ROADWAY PLAN & PROFILE  
STREET & STORM SEWER PLANS  
WOODSIDE RIDGE  
SECOND PLAT  
LEE'S SUMMIT, MO

2020

drawn by: \_\_\_\_\_ C.S.M.  
checked by: \_\_\_\_\_ S.M.S.  
designed by: \_\_\_\_\_ C.S.M.  
QA/QC by: \_\_\_\_\_ J.E.S.  
project no.: \_\_\_\_\_ C18-1140  
date: 2020.07.10




SHEET  
C112



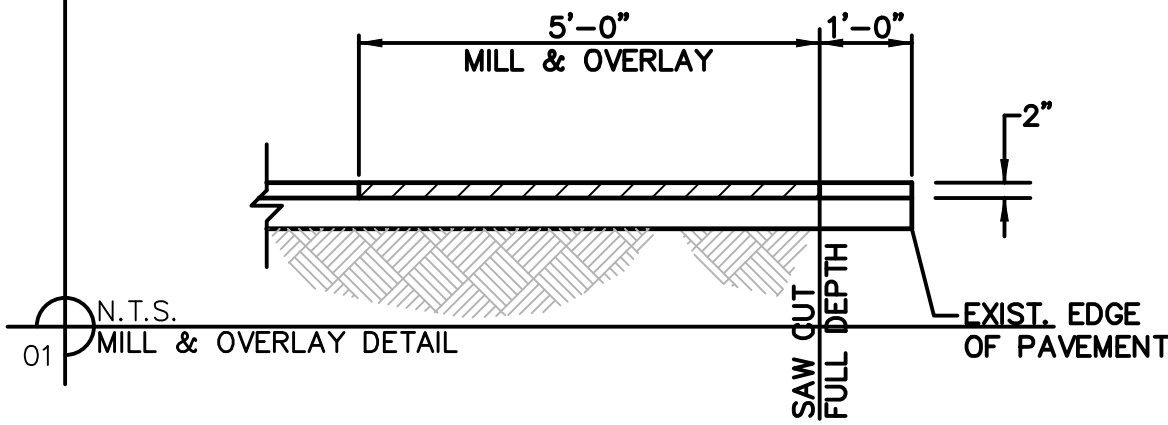

| LEGEND |                    |
|--------|--------------------|
|        | CONCRETE SIDEWALK  |
|        | ASPHALT PAVEMENT   |
|        | MILL AND OVERLAY   |
|        | CG-2 CURB & GUTTER |

| CURVE TABLE |             |            |             |              |                 |
|-------------|-------------|------------|-------------|--------------|-----------------|
| CURVE ID #  | RADIUS (FT) | DELTA      | LENGTH (FT) | TANGENT (FT) | P.I. STA. (BK.) |
| C4          | 400.00      | 055°31'00" | 387.58      | 210.52       | 23+97.37        |

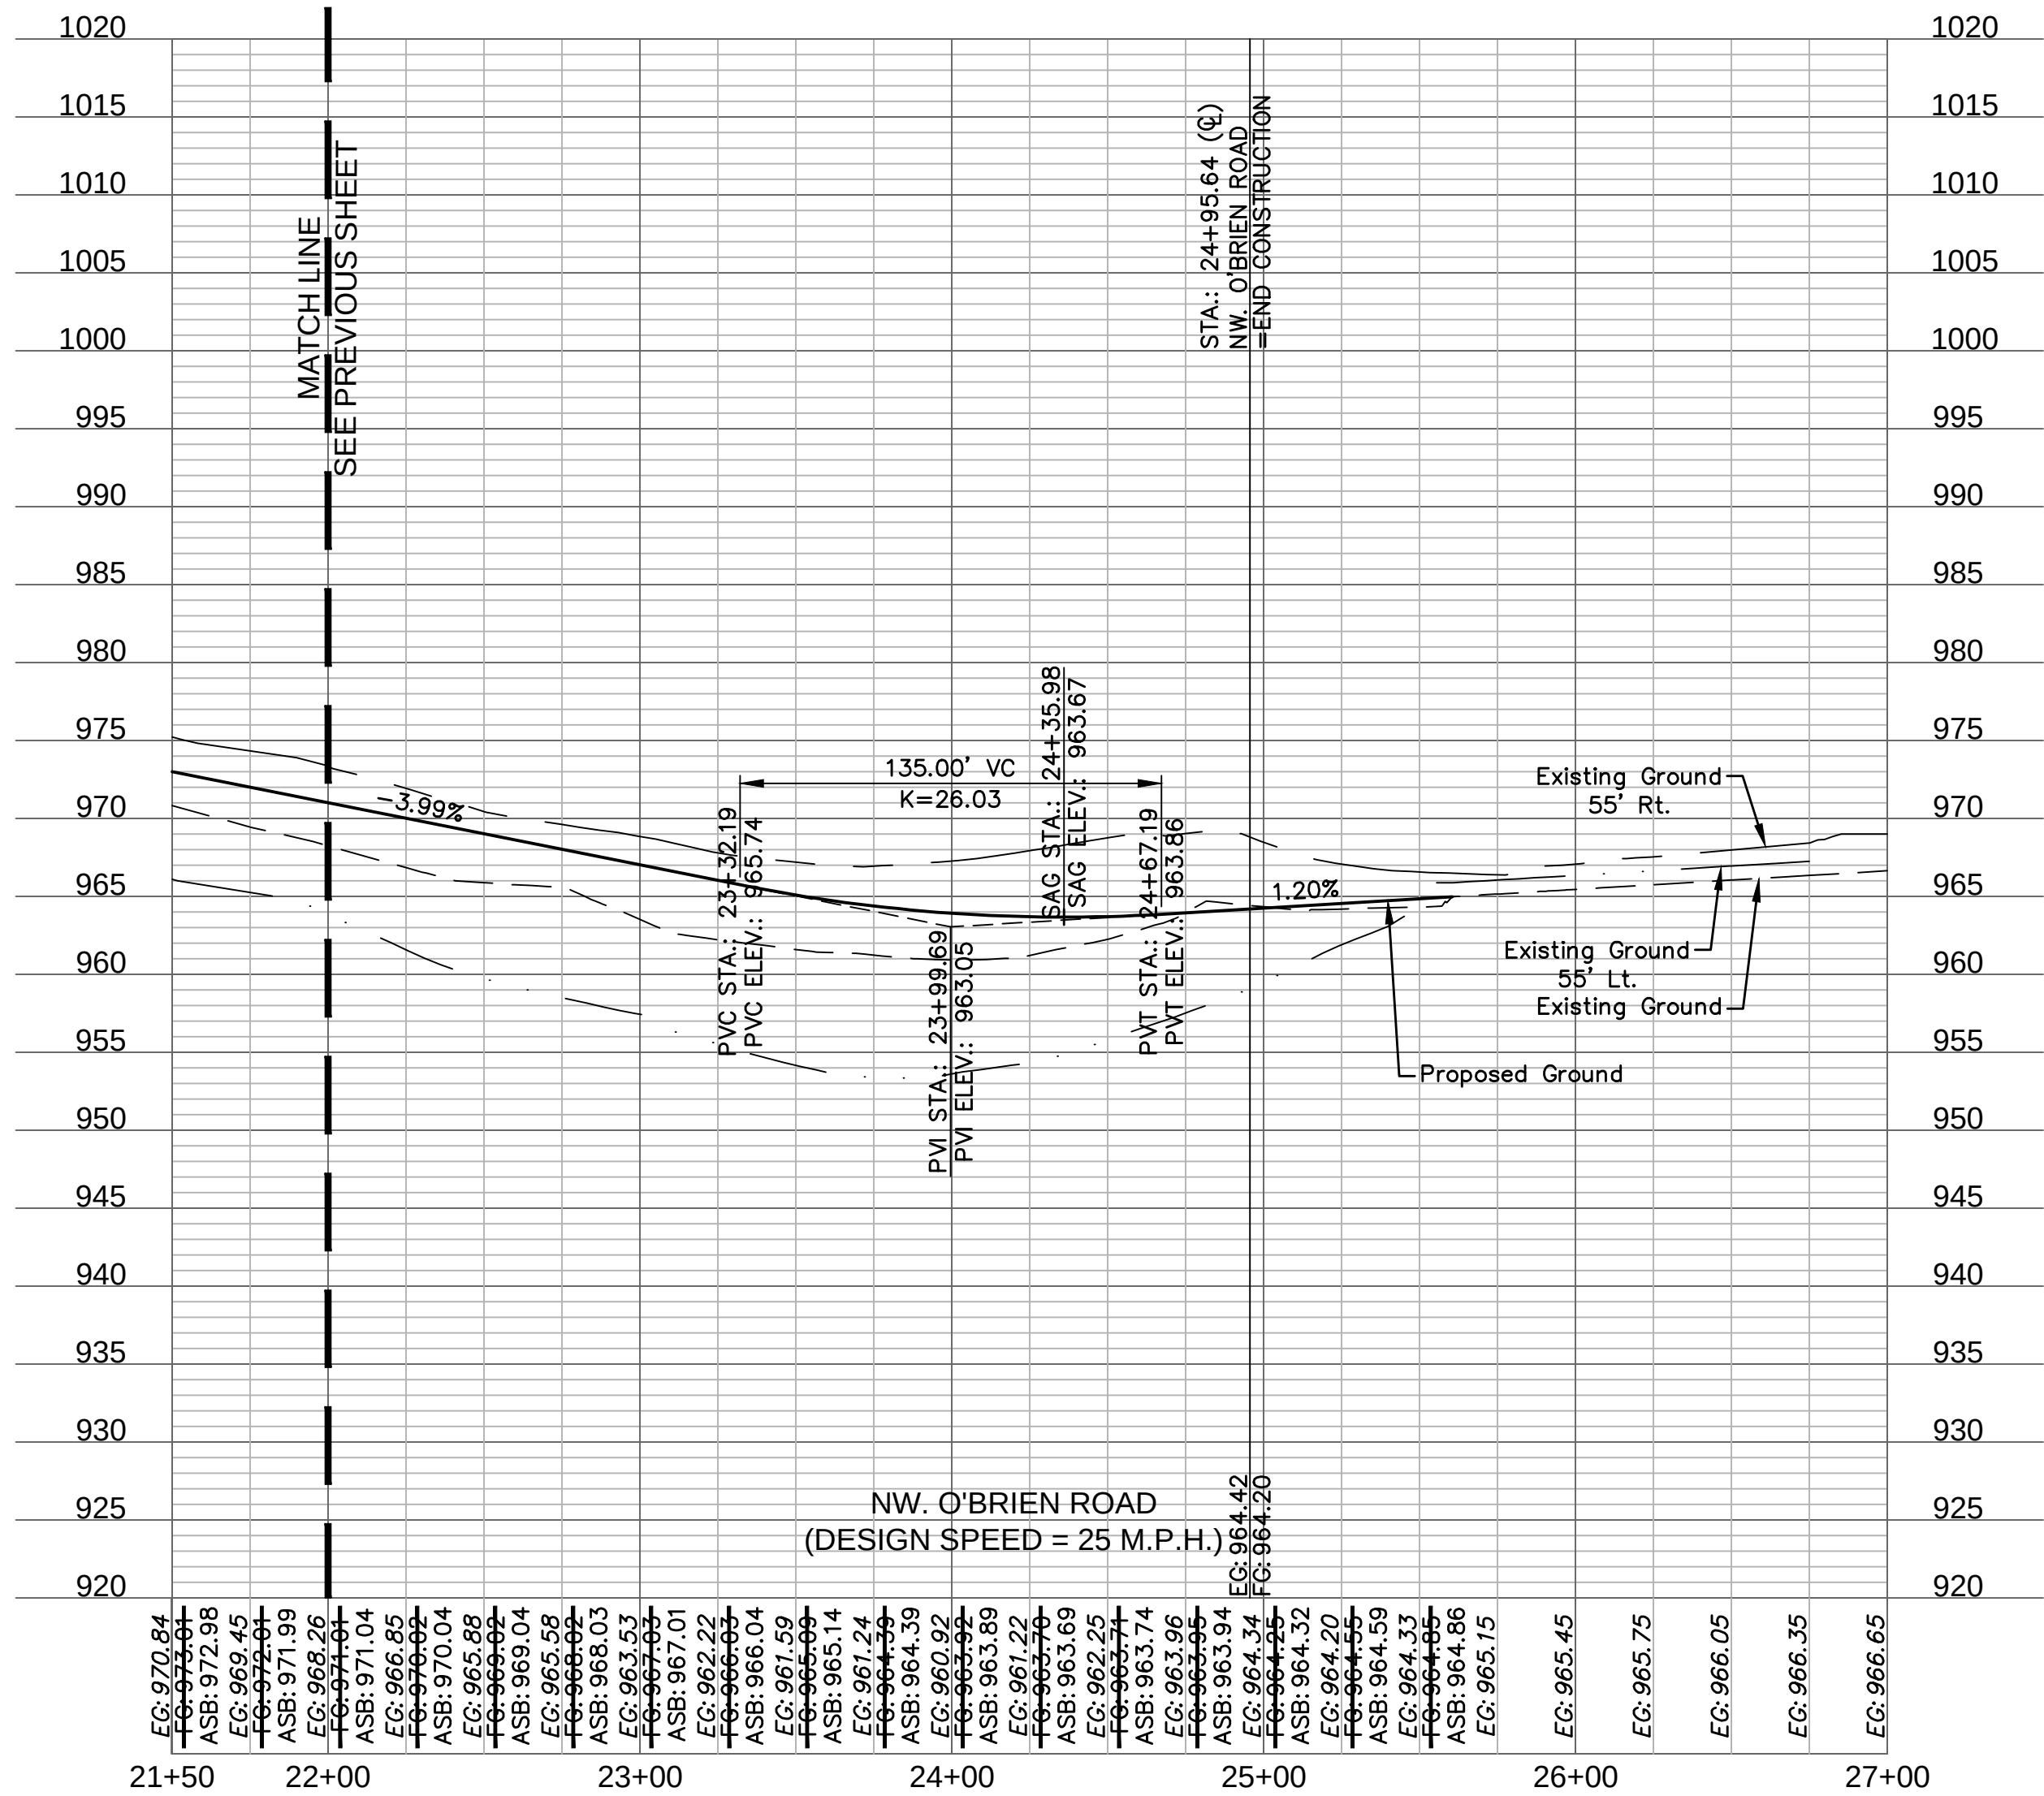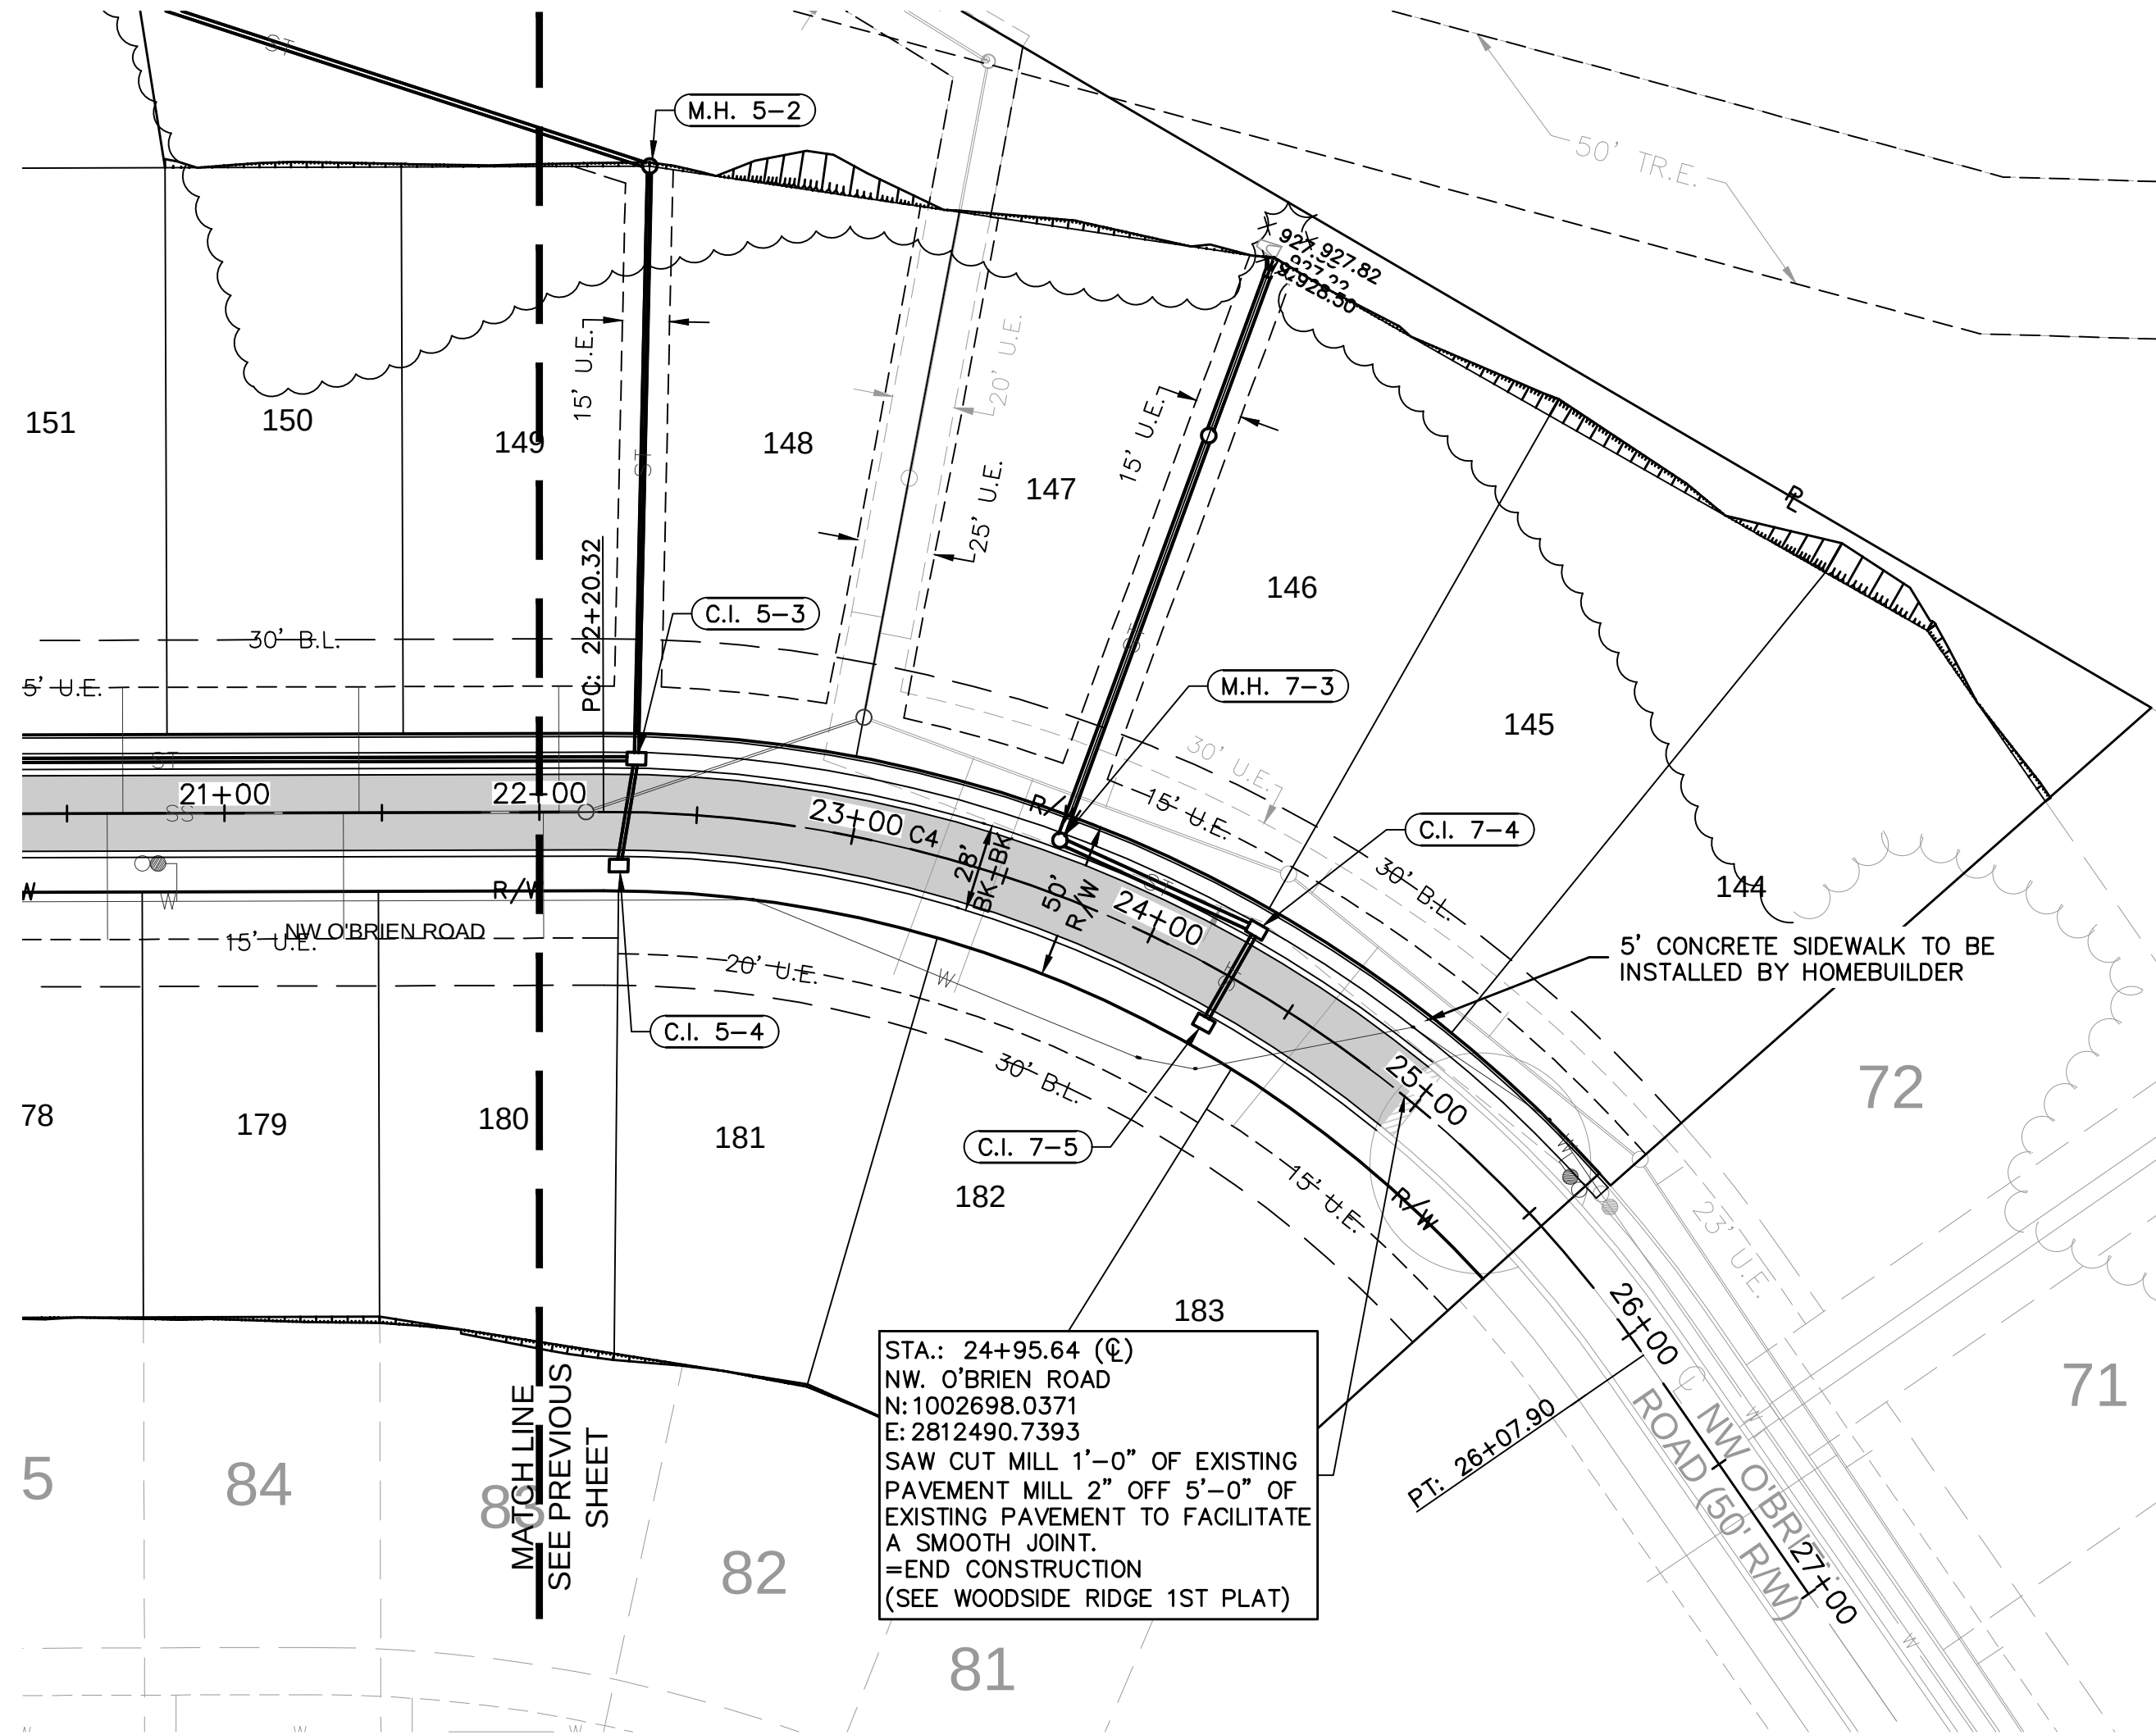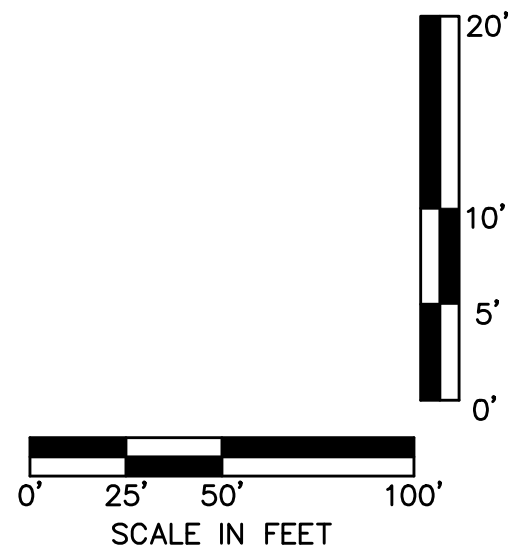

ASBUILT  
03-24-2022

olsson

NO Conflicts of Interest at 03/19/22  
303 E. BIRKING STREET, SUITE 100  
NORTH KANSAS CITY, MO 64116  
TEL: 816.861.1177  
www.olsson.com

STATE OF MISSOURI  
JULIE ELAINE SELLERS  
NUMBER  
PE-2017000367  
10/27/2022  
APPROVAL


BY  
NO. REV.  
DATE  
REVISIONS DESCRIPTION

ROADWAY PLAN & PROFILE  
STREET & STORM SEWER PLANS  
WOODSIDE RIDGE  
SECOND PLAT  
LEE'S SUMMIT, MO  
2020

drawn by: C.S.M.  
checked by: S.M.S.  
designed by: C.S.M.  
QA/QC by: J.E.S.  
project no.: C18-1140  
date: 2020.07.10


SHEET  
C113



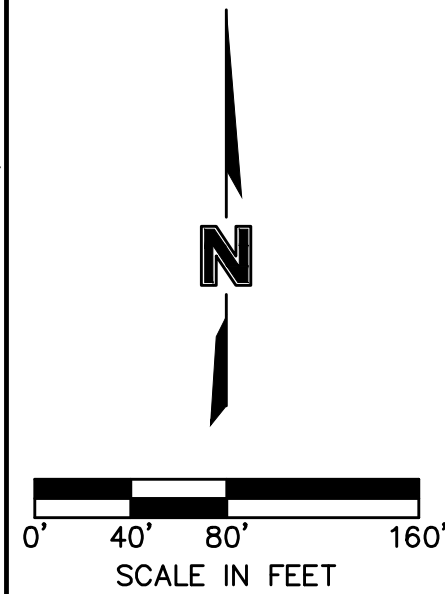

NOT ASBUILT

**olson**

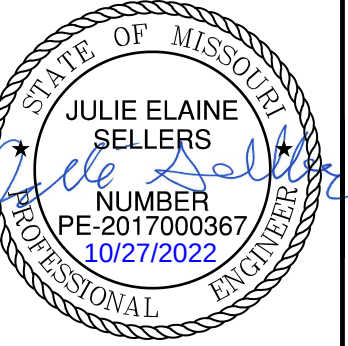

1301 BURLINGTON, SUITE 100  
NORTH KANSAS CITY, MO 64116  
TEL 816.361.1177  
www.olsson.com

[illegible]

WOODSIDE RIDGE  
SECOND PLAT


Drawn by: C.S.M  
 Checked by: S.M.S  
 Designed by: C.S.M  
 A/QC by: J.E.S  
 Project no.: C18-1140  
 Date: 2020.07.10

SHEET  
C114

DWG: F:\2018\1001-1500\018-1140-C\40-Design\AutoCAD\Final Plans - Asbuilts\Sheets\GNCV\Street & Storm\C\_TRF02\_C181140.dwg  
DATE: Oct 17, 2022 12:40pm  
USER: ssaylor

DWG: F:\2018\1001-1500\018-1140-C\40-Design\AutoCAD\Final Plans - Asbuilts\Sheets\GNCV\Street & Storm\C\_TRF02\_C181140.dwg





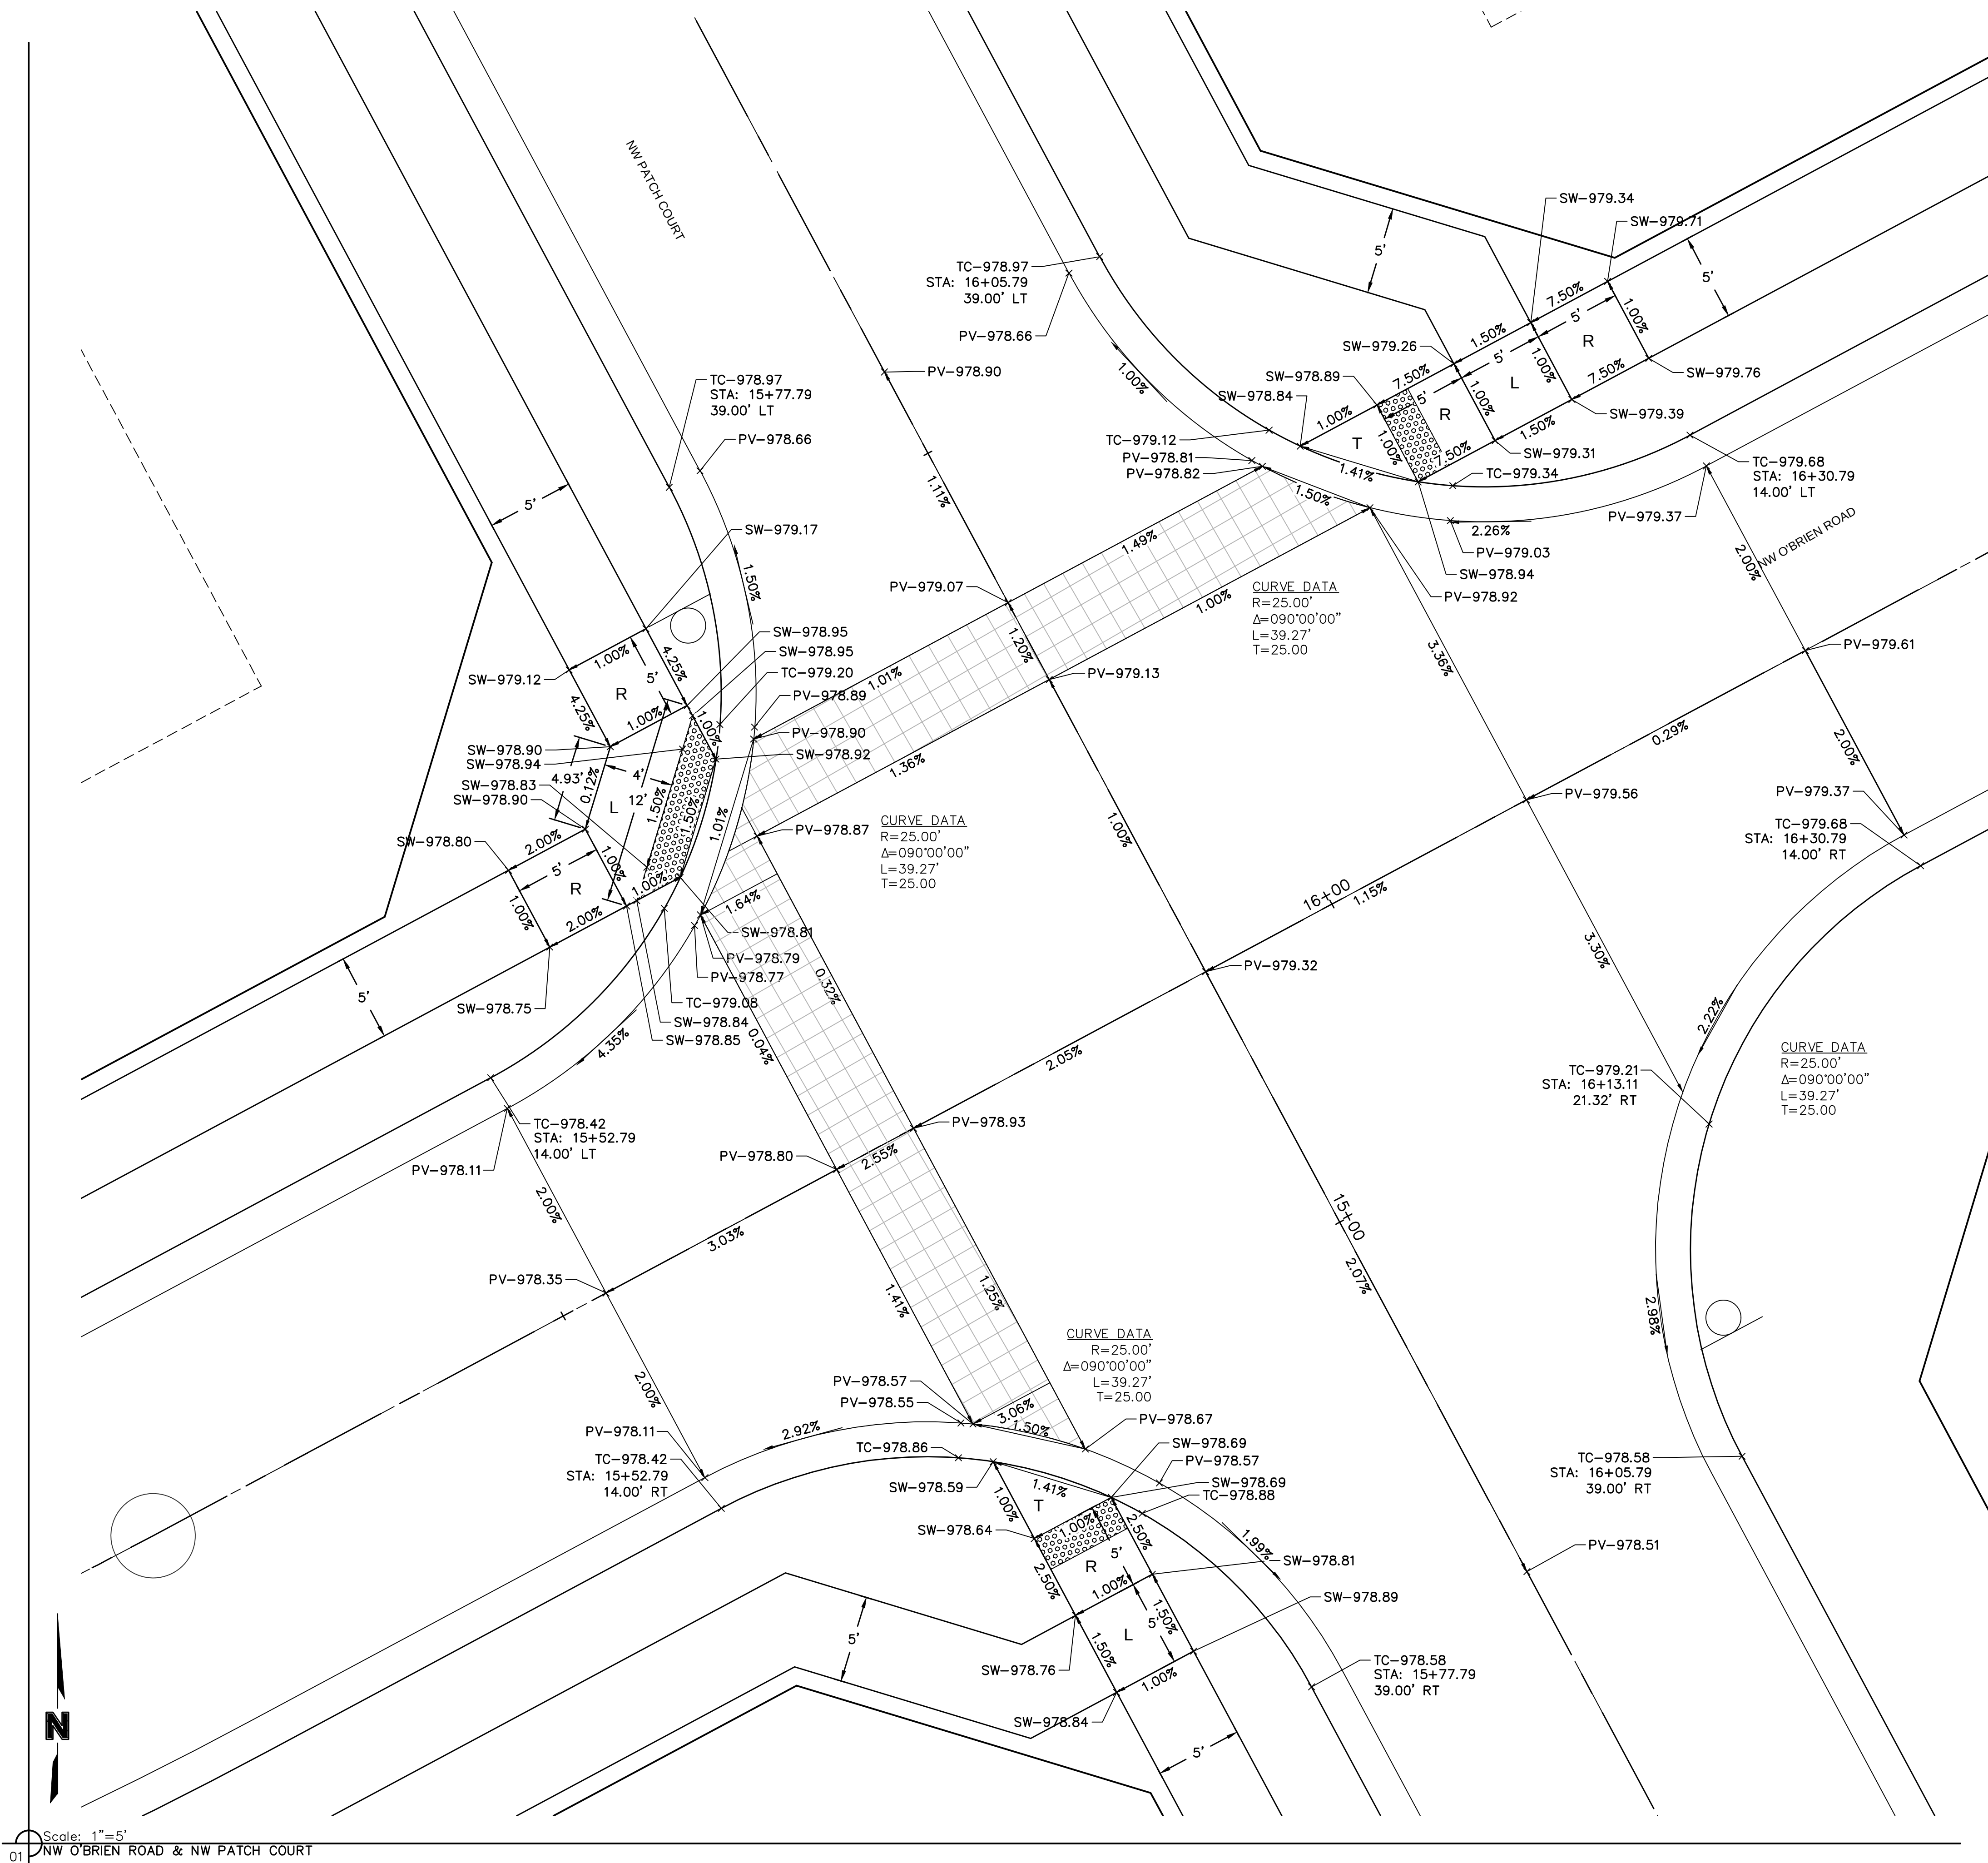

# NOT ASBUILT

[illegible]




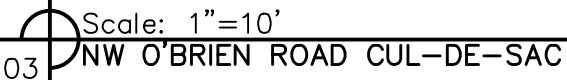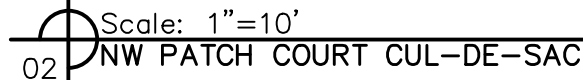



# NOT ASBUILT

[illegible]





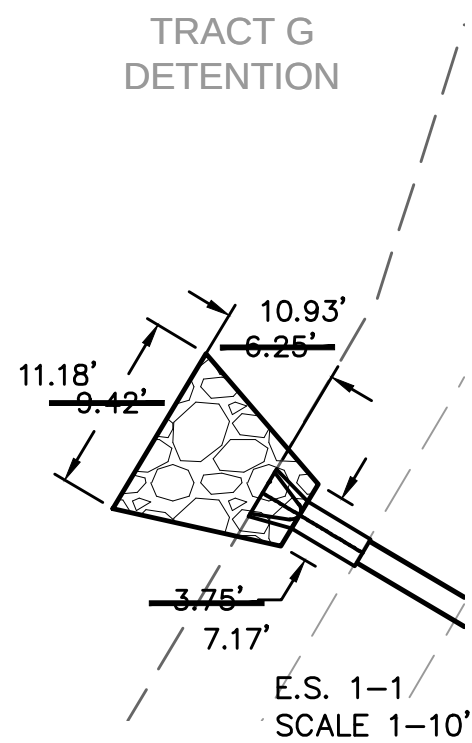



| Riprap Calculations                                      |                           |                          |        |              |                         |                        |
|----------------------------------------------------------|---------------------------|--------------------------|--------|--------------|-------------------------|------------------------|
| End Section                                              | Q <sub>100</sub><br>(cfs) | Pipe<br>Diameter<br>(ft) | Class* | D50*<br>(in) | Apron<br>Length<br>(ft) | Apron<br>Depth<br>(ft) |
| E.S. 1-1                                                 | 7.34                      | 1.25                     | 3      | 10           | 6.25                    | 2.00                   |
| *Per Table 10.1 HEC 14-FHWA-Energy Dissipators Pg. 10-18 |                           |                          |        |              |                         | 19.74                  |

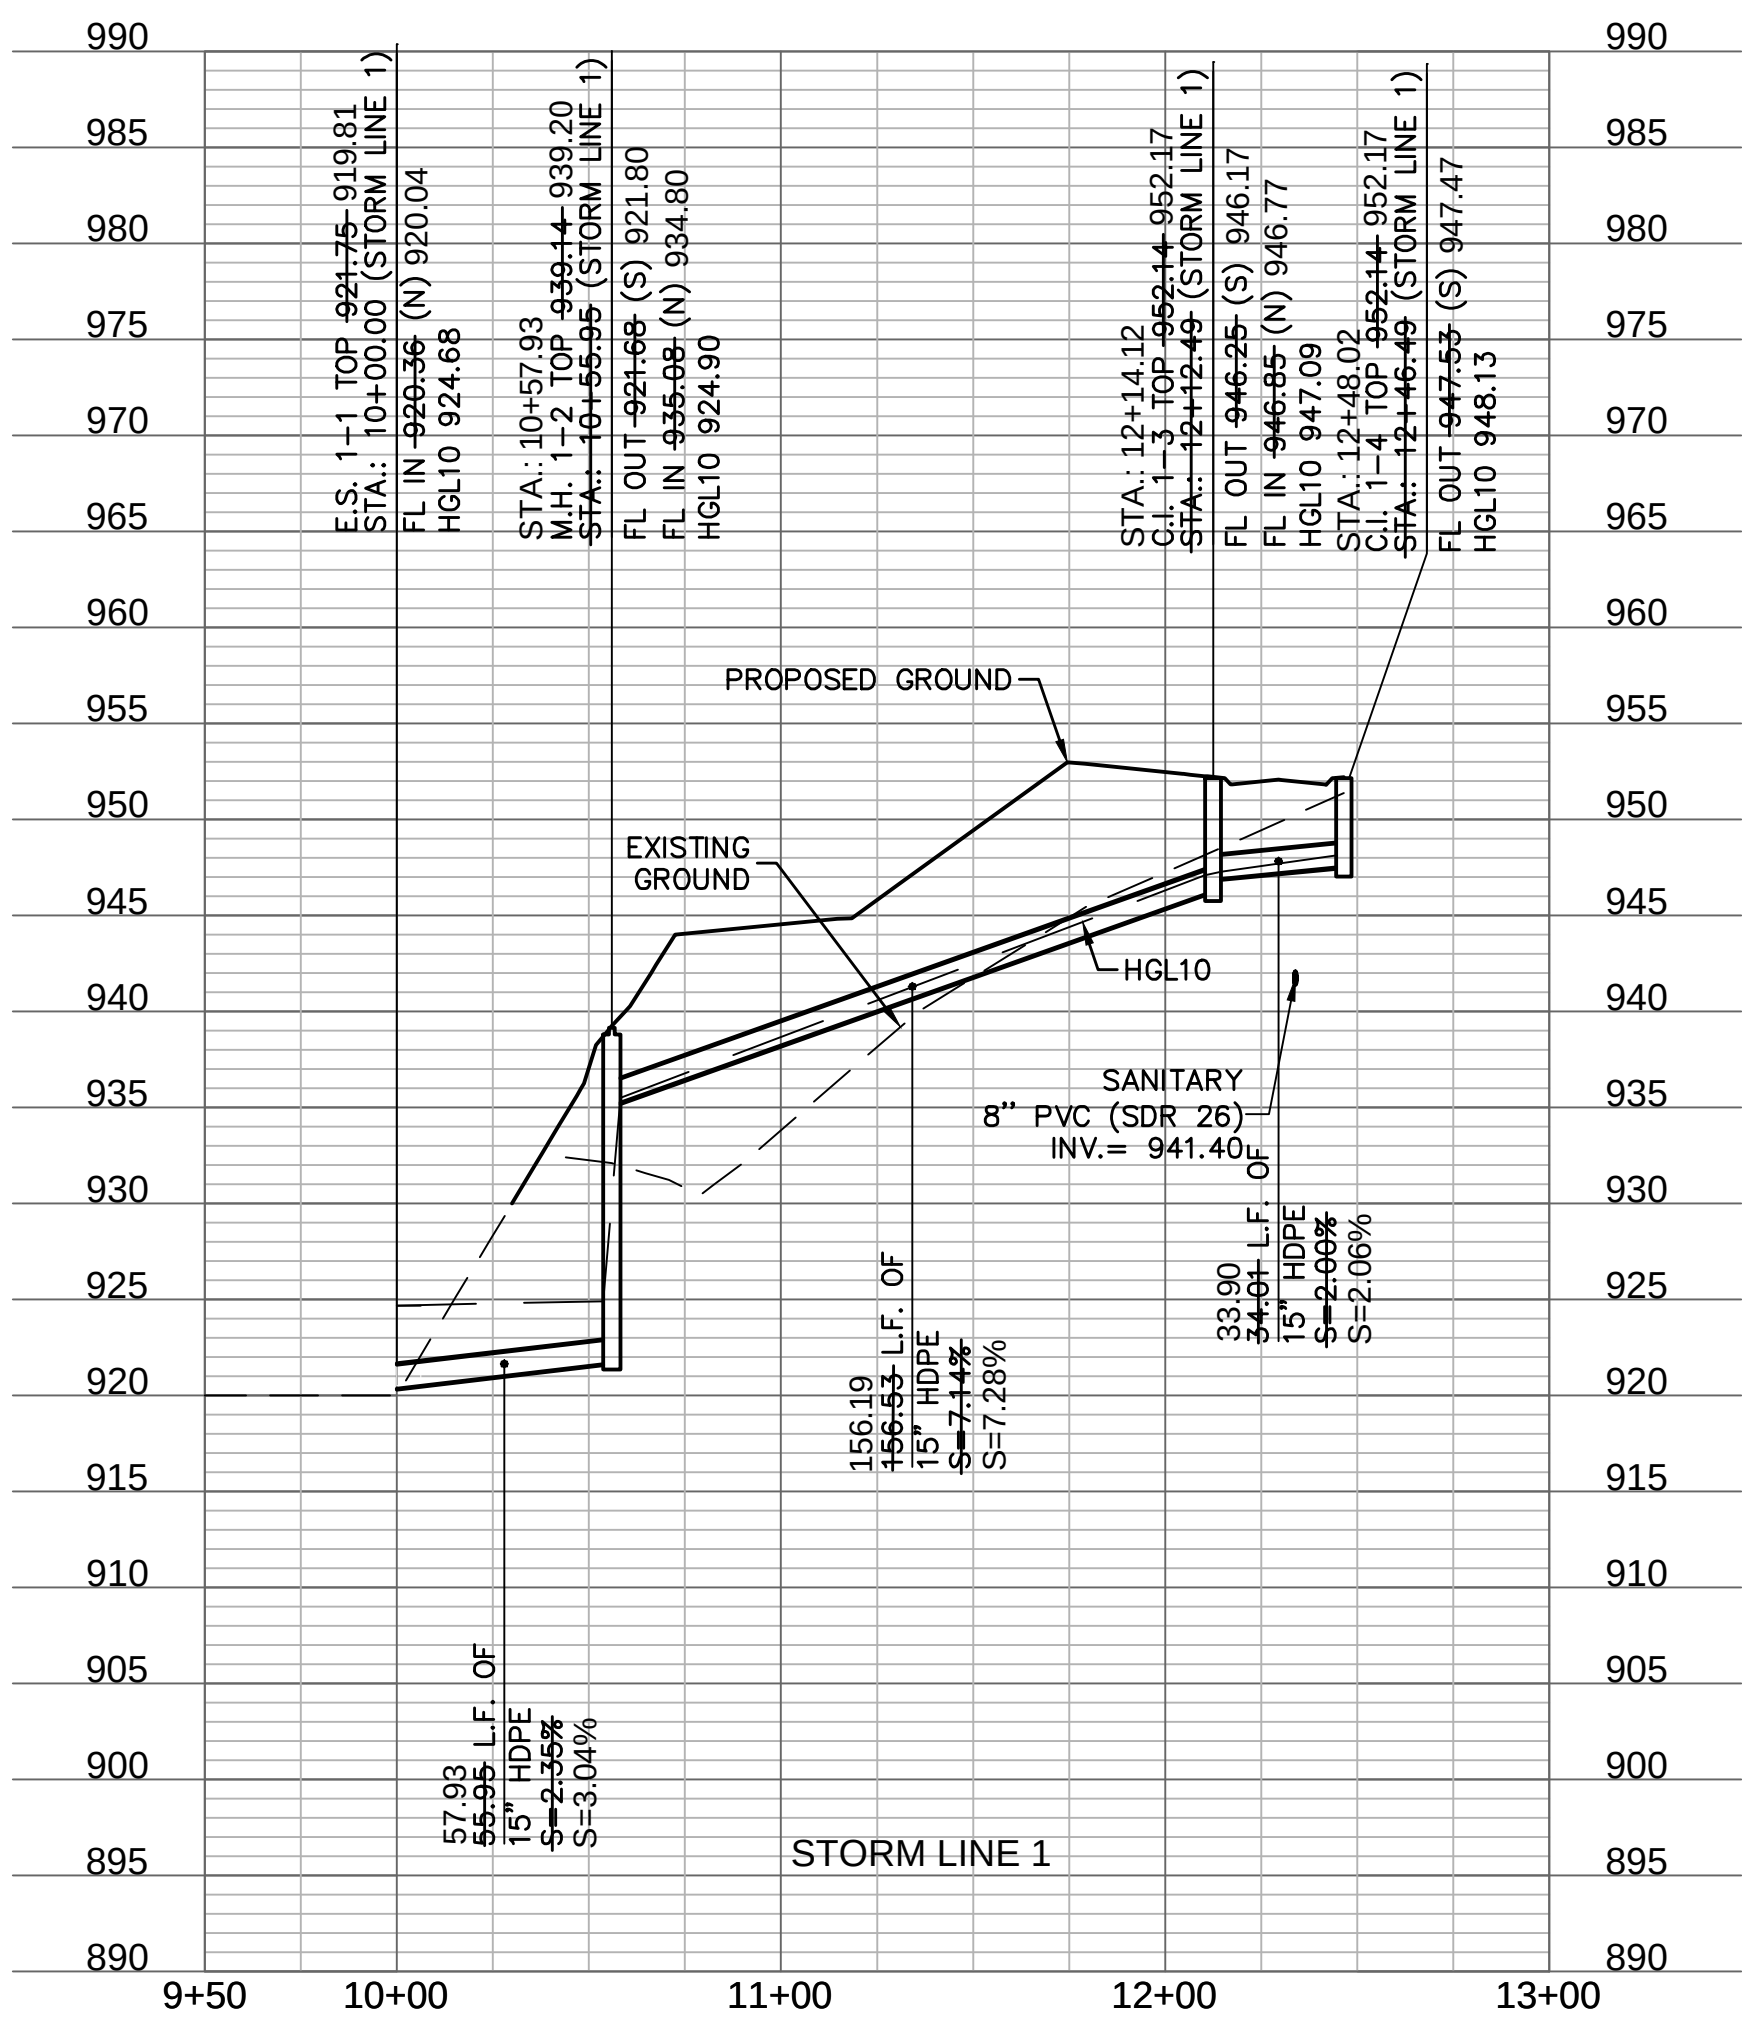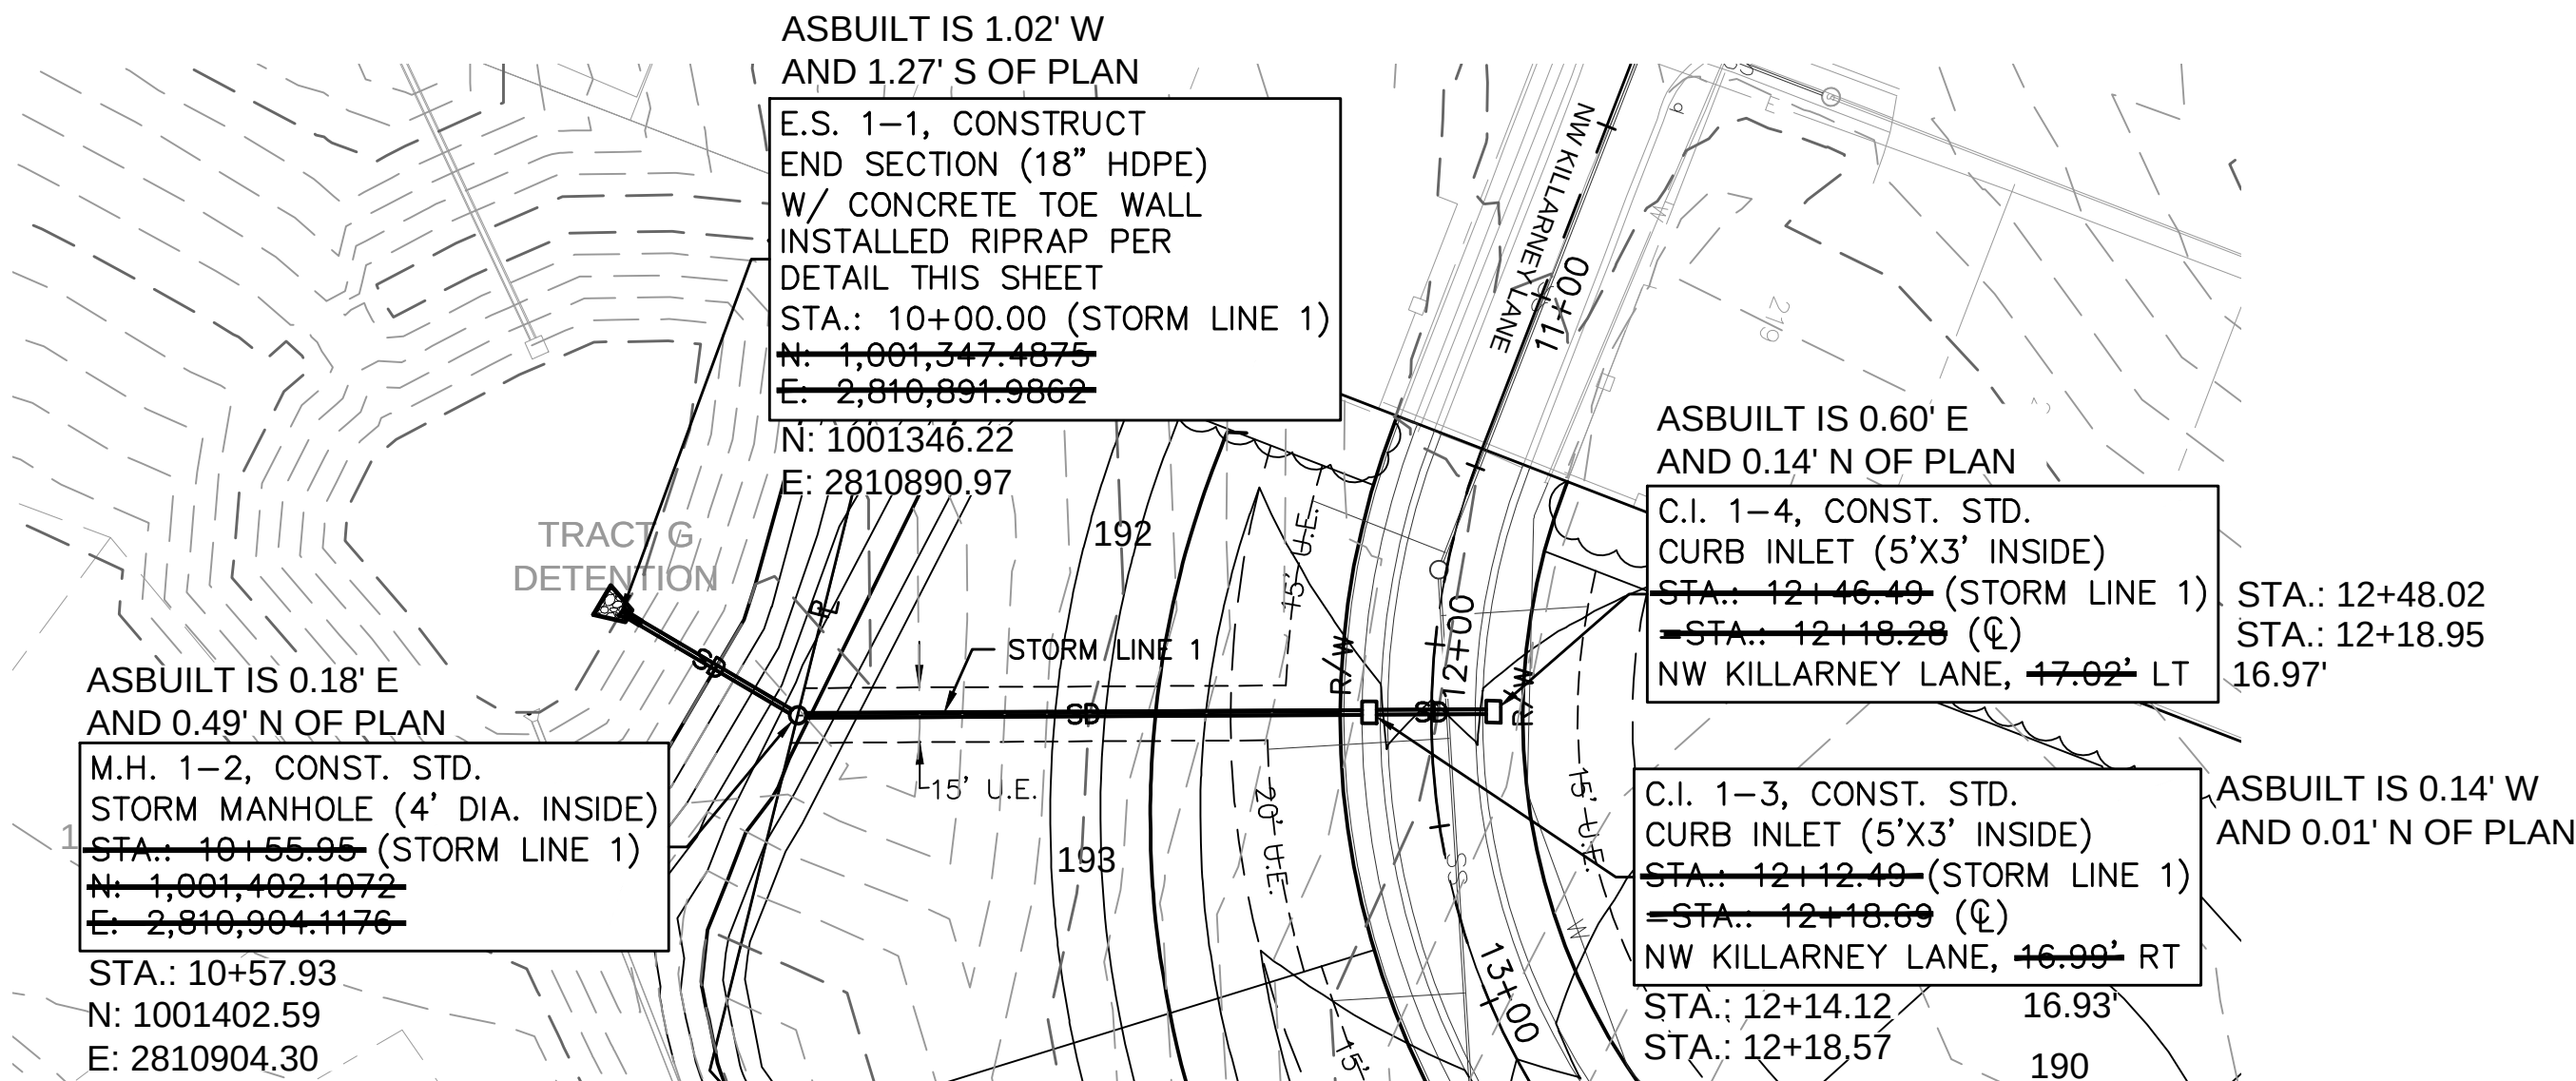

ASBUILT  
03-24-2022

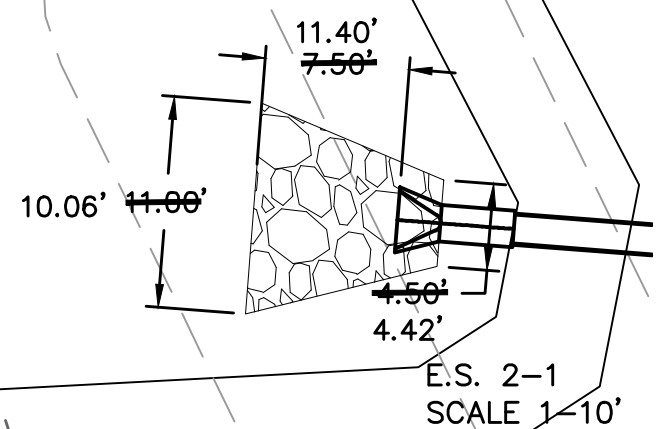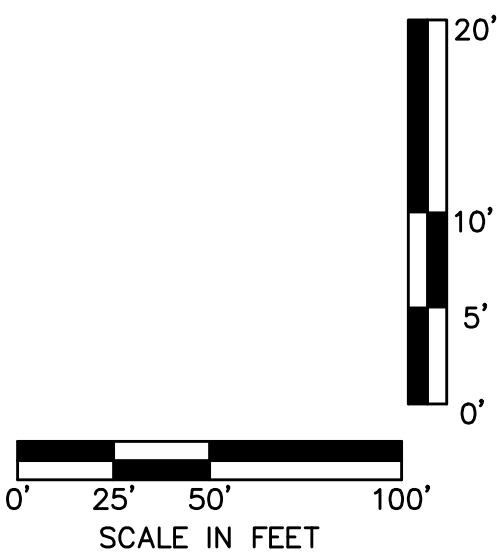

| Riprap Calculations                                      |                           |                          |        |              |                         |                        |
|----------------------------------------------------------|---------------------------|--------------------------|--------|--------------|-------------------------|------------------------|
| End Section                                              | Q <sub>100</sub><br>(cfs) | Pipe<br>Diameter<br>(ft) | Class* | D50*<br>(in) | Apron<br>Length<br>(ft) | Apron<br>Depth<br>(ft) |
| E.S. 2-1                                                 | 9.35                      | 1.5                      | 3      | 10           | 7.5                     | 2.00                   |
| *Per Table 10.1 HEC 14-FHWA-Energy Dissipators Pg. 10-18 |                           |                          |        |              |                         | 8.77                   |

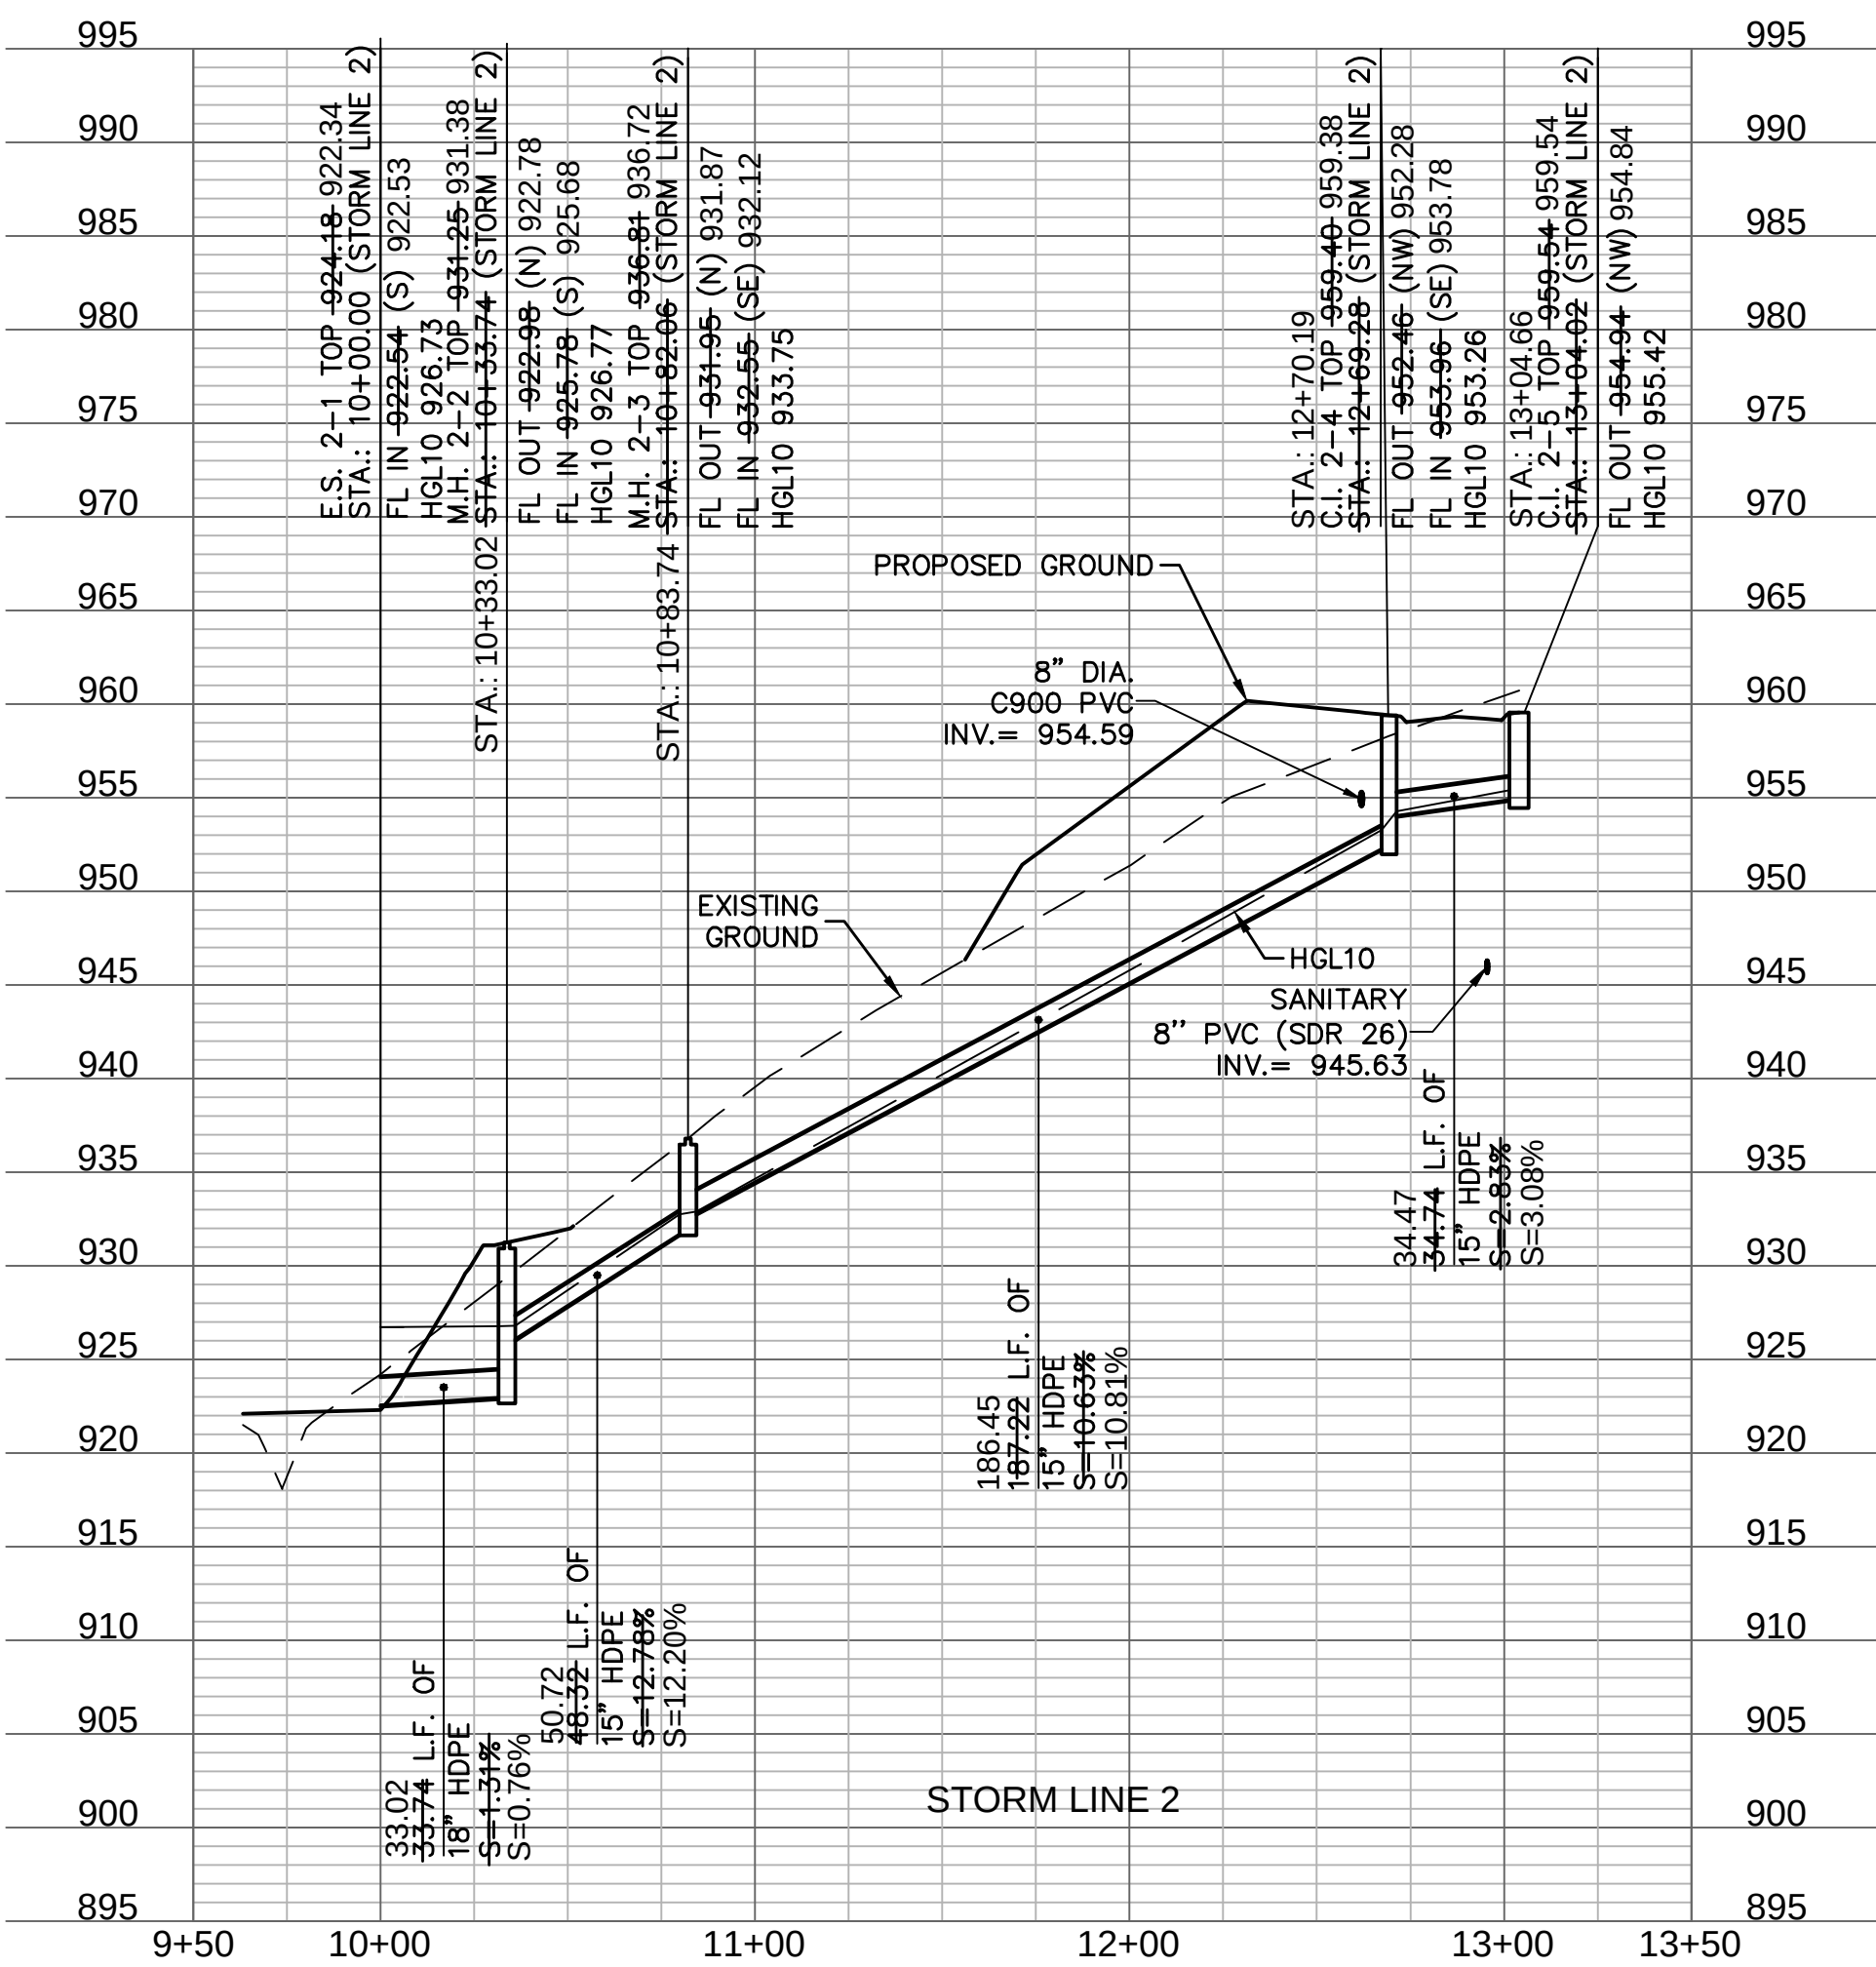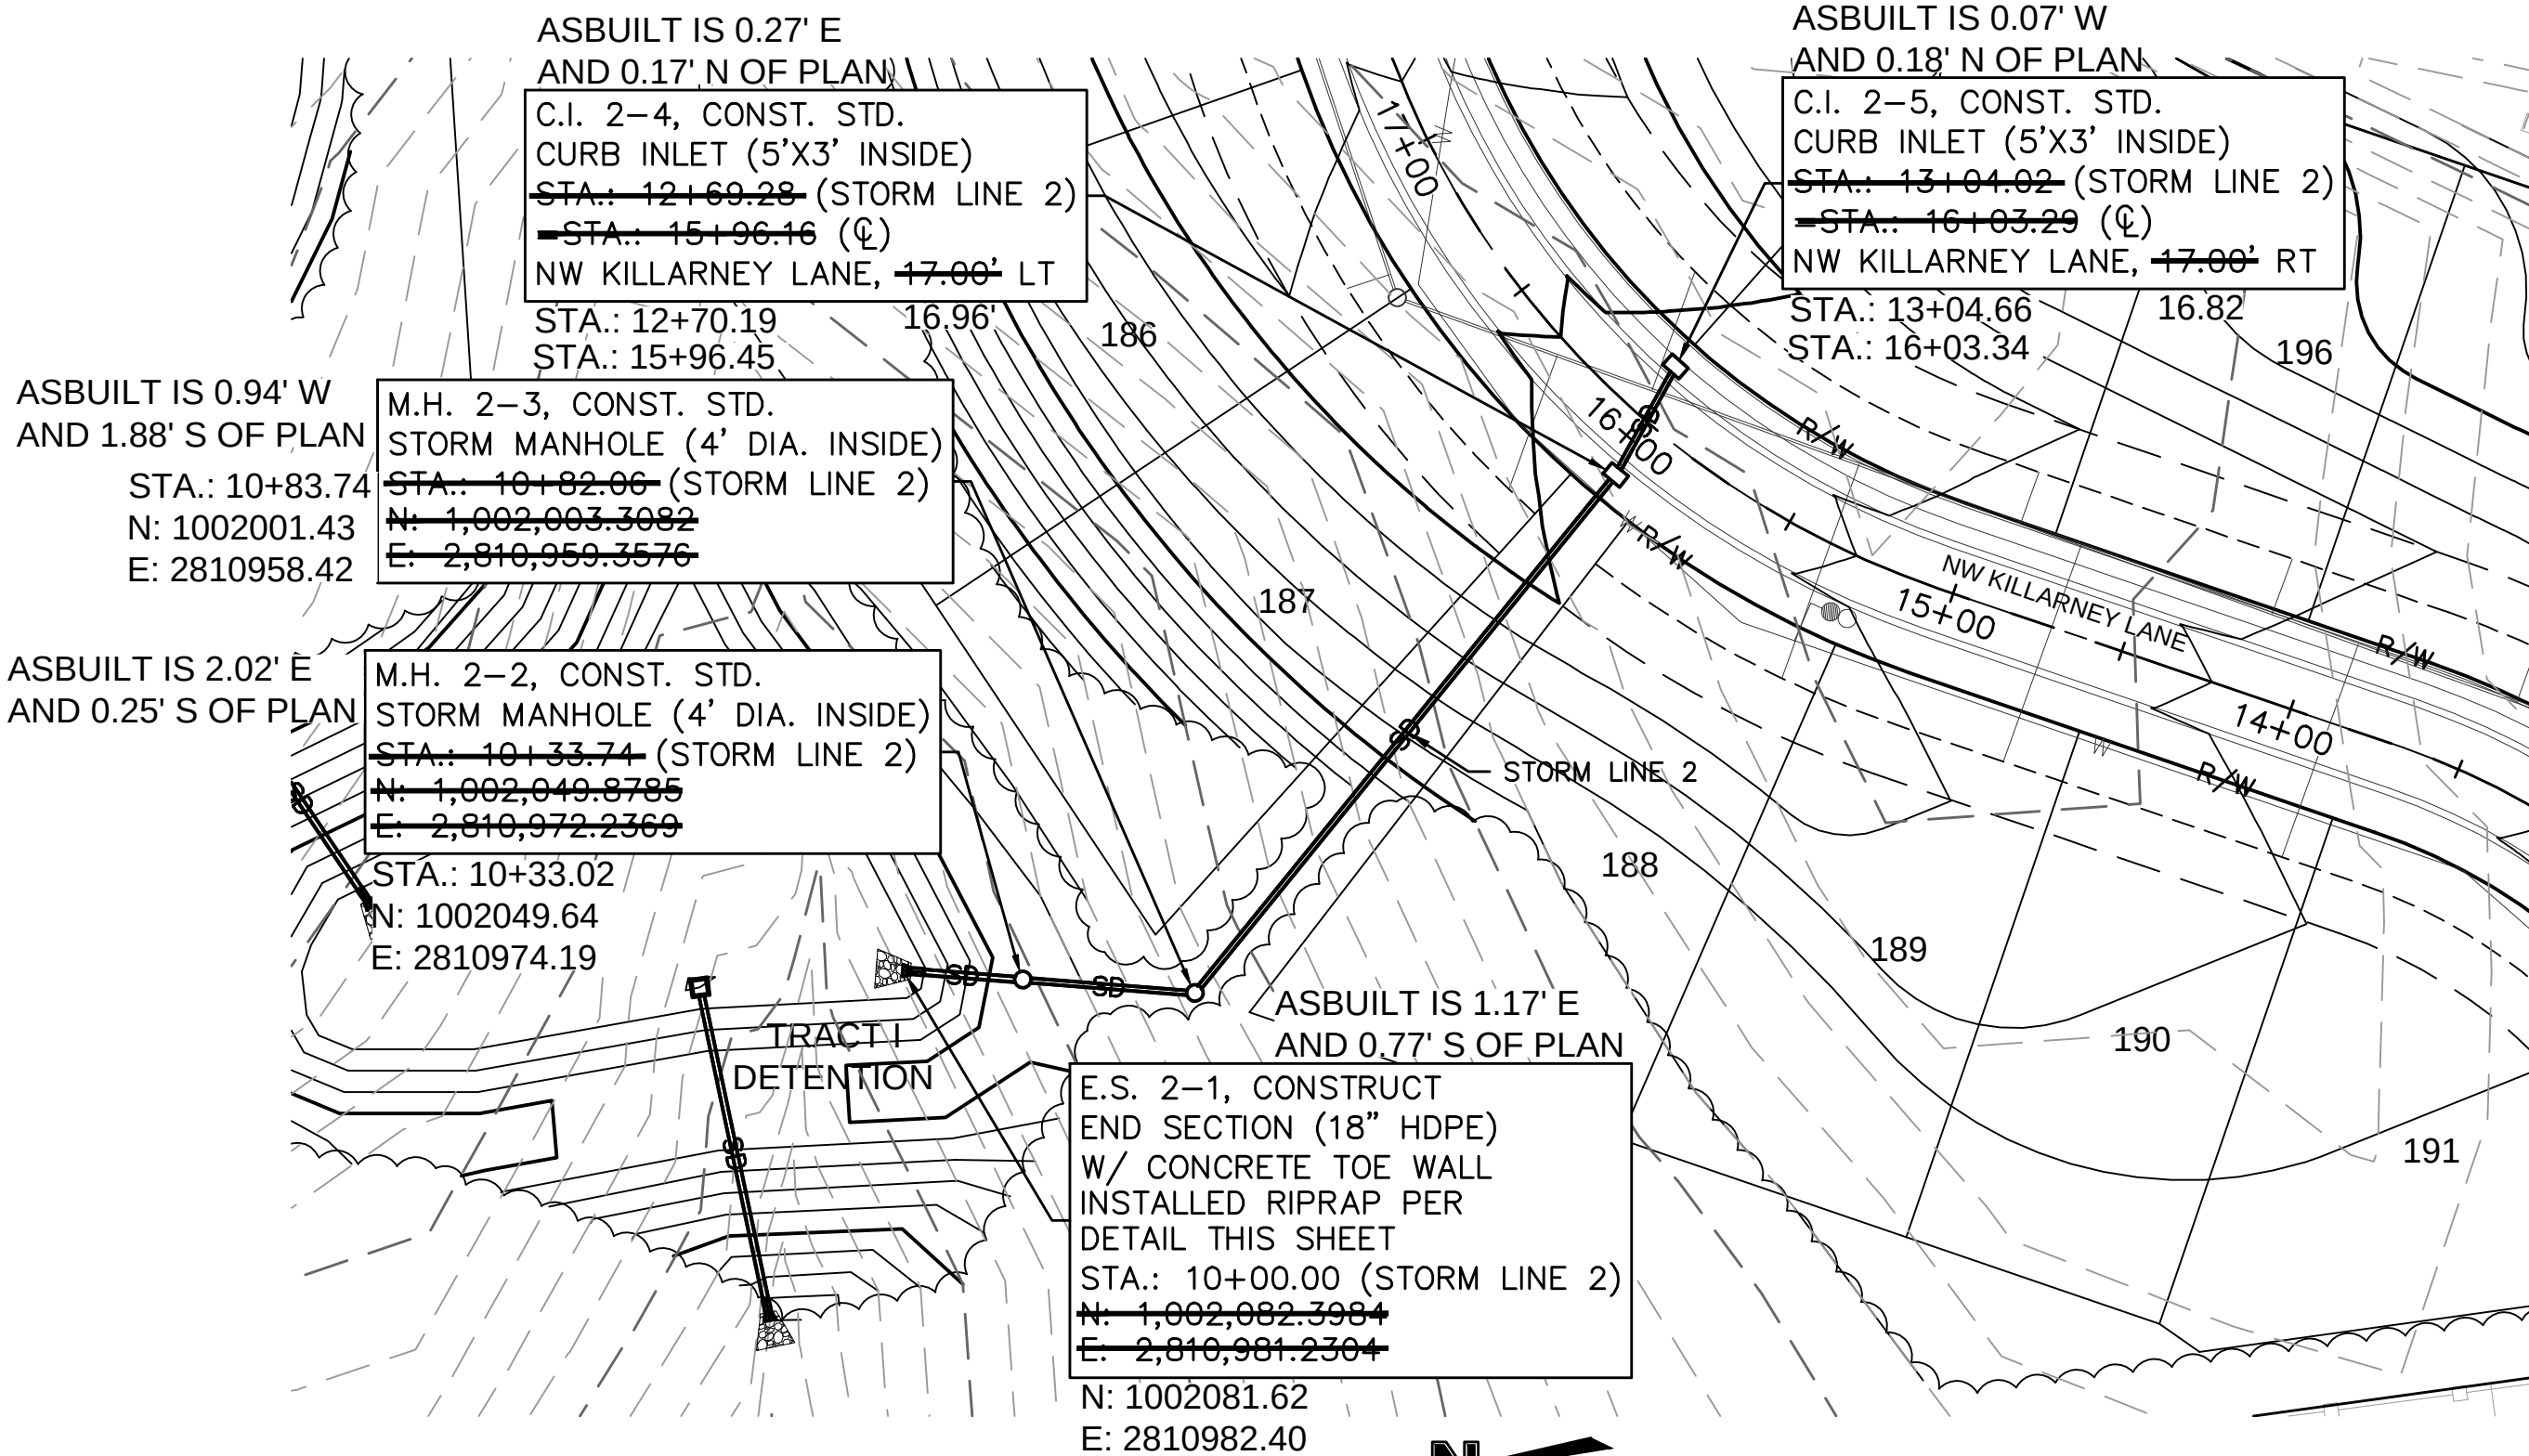

olsson

NO. 001001 of Authority of MISSOURI  
300 E. BROADWAY, SUITE 100  
NORTH KANSAS CITY, MO 64116  
TEL. 816.861.1177  
WWW.OLSSON.COM

STATE OF MISSOURI  
JULIE ELAINE  
SELLERS  
NUMBER  
PE-2017000367  
10/27/2022  
APPROVAL

BY

REVISIONS DESCRIPTION

NO. REV. DATE

2 3/16/2021 REVISED PER CONTRACTOR COMMENT


2020

STORM SEWER PLAN & PROFILE  
STREET & STORM SEWER PLANS  
WOODSIDE RIDGE  
SECOND PLAT  
LEE'S SUMMIT, MO

drawn by: C.S.M.  
checked by: S.M.S.  
designed by: C.S.M.  
QA/QC by: J.E.S.  
project no.: C18-1140  
date: 2020.07.10

SHEET  
C117




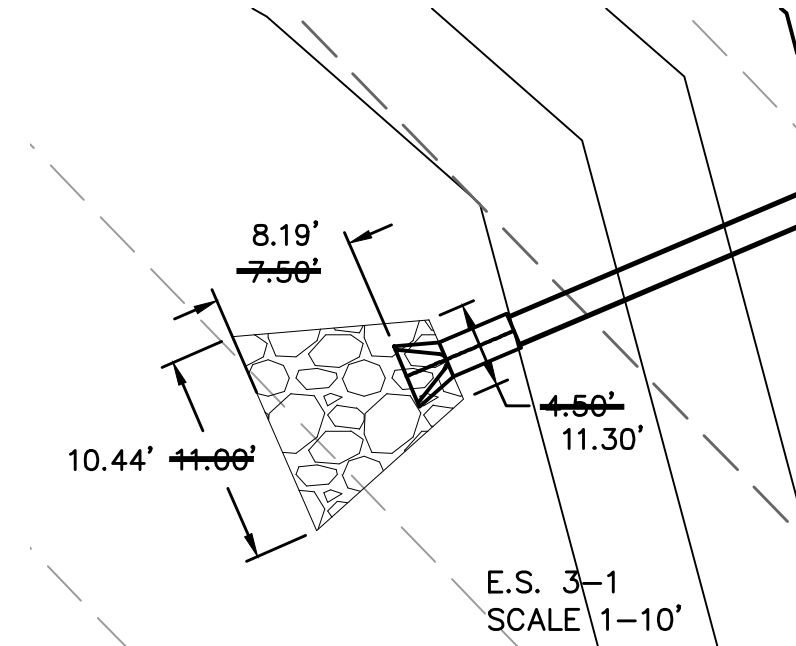

| Riprap Calculations |                           |                          |        |              |                         |                        |
|---------------------|---------------------------|--------------------------|--------|--------------|-------------------------|------------------------|
| End Section         | Q <sub>100</sub><br>(cfs) | Pipe<br>Diameter<br>(ft) | Class* | D50*<br>(in) | Apron<br>Length<br>(ft) | Apron<br>Depth<br>(ft) |
| E.S. 3-1            | 7.83                      | 1.5                      | 3      | 10           | 7.5                     | 2.00                   |

\*Per Table 10.1 HEC 14-FHWA-Energy Dissipators Pg. 10-18



10.41

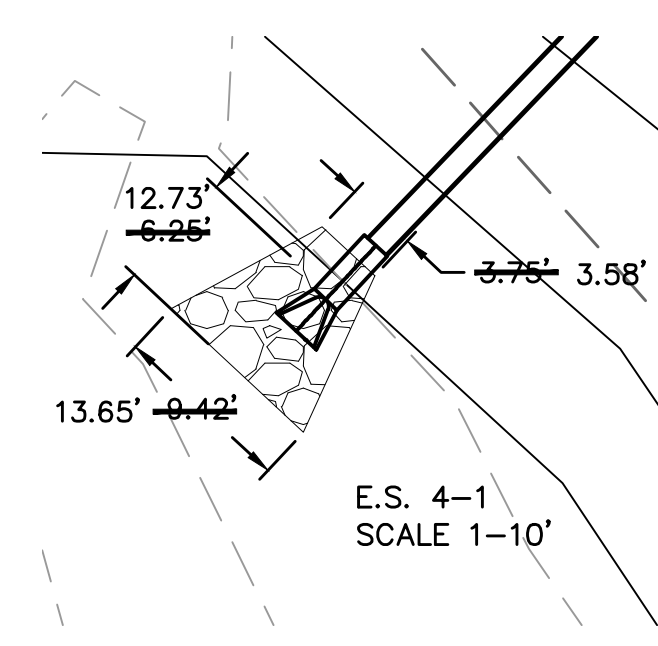




| Riprap Calculations |                           |                          |        |              |                         |                        |
|---------------------|---------------------------|--------------------------|--------|--------------|-------------------------|------------------------|
| End Section         | Q <sub>100</sub><br>(cfs) | Pipe<br>Diameter<br>(ft) | Class* | D50*<br>(in) | Apron<br>Length<br>(ft) | Apron<br>Depth<br>(ft) |
| E.S. 4-1            | 6.05                      | 1.25                     | 3      | 10           | 6.25                    | 2.00                   |

\*Per Table 10.1 HEC 14-FHWA-Energy Dissipators Pg. 10-18

13.71

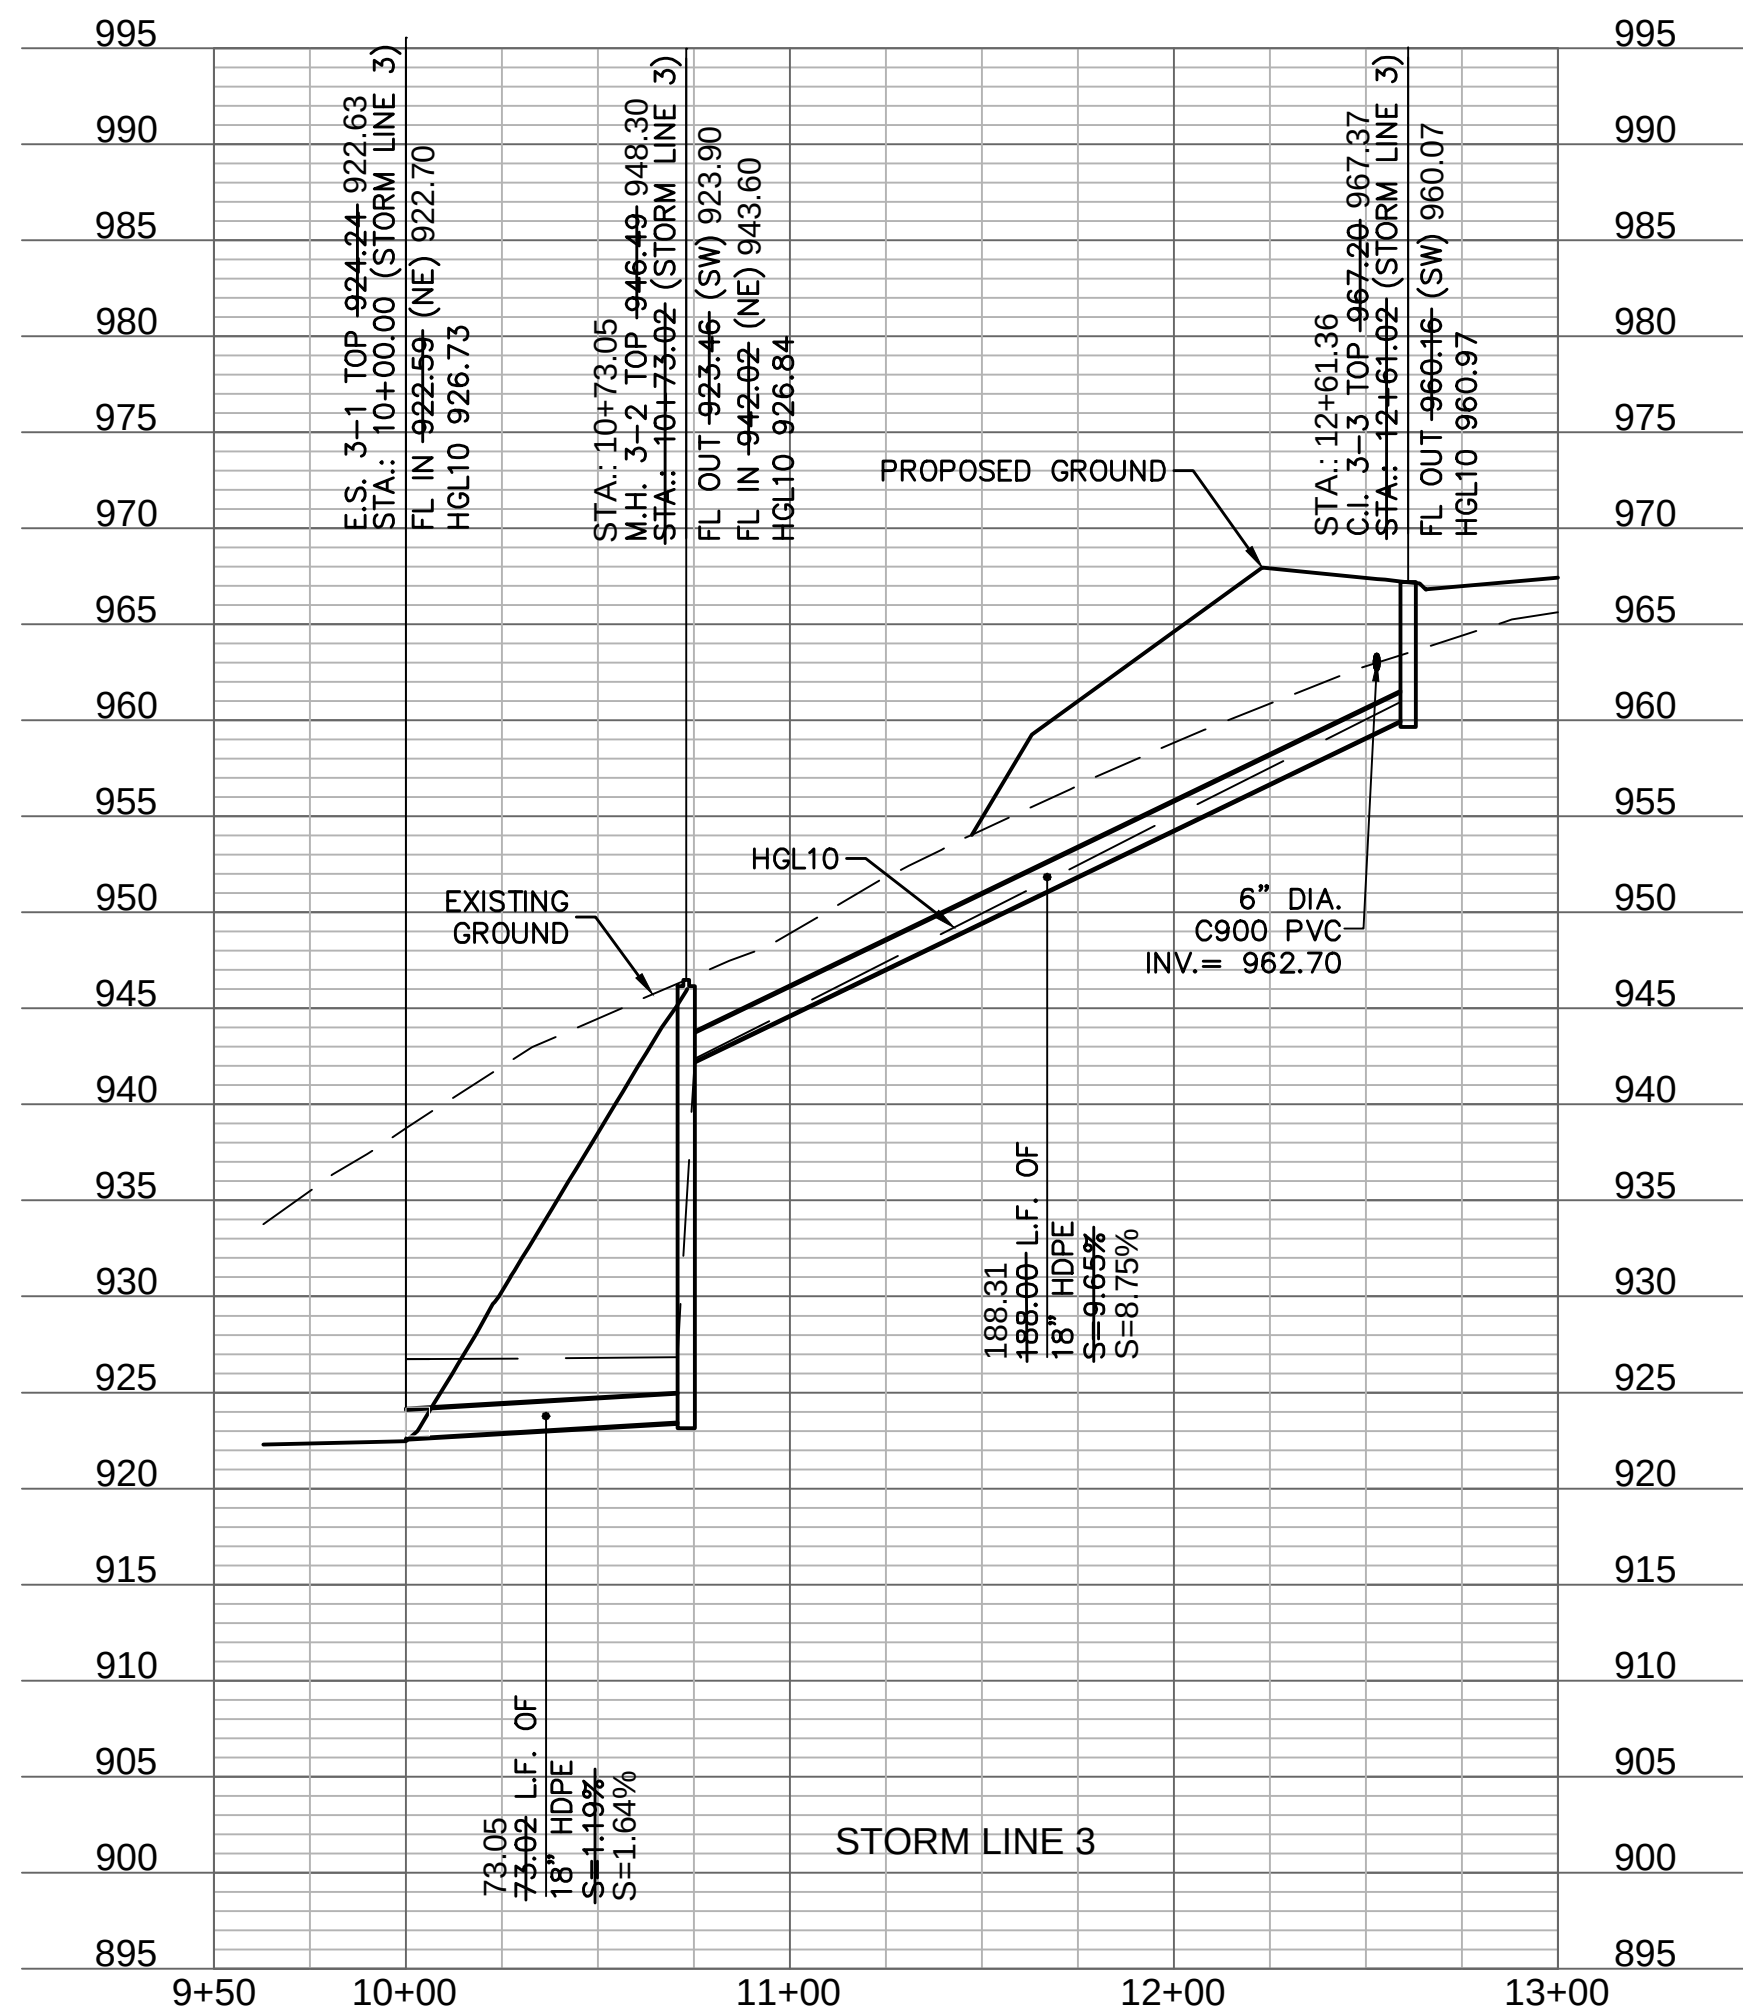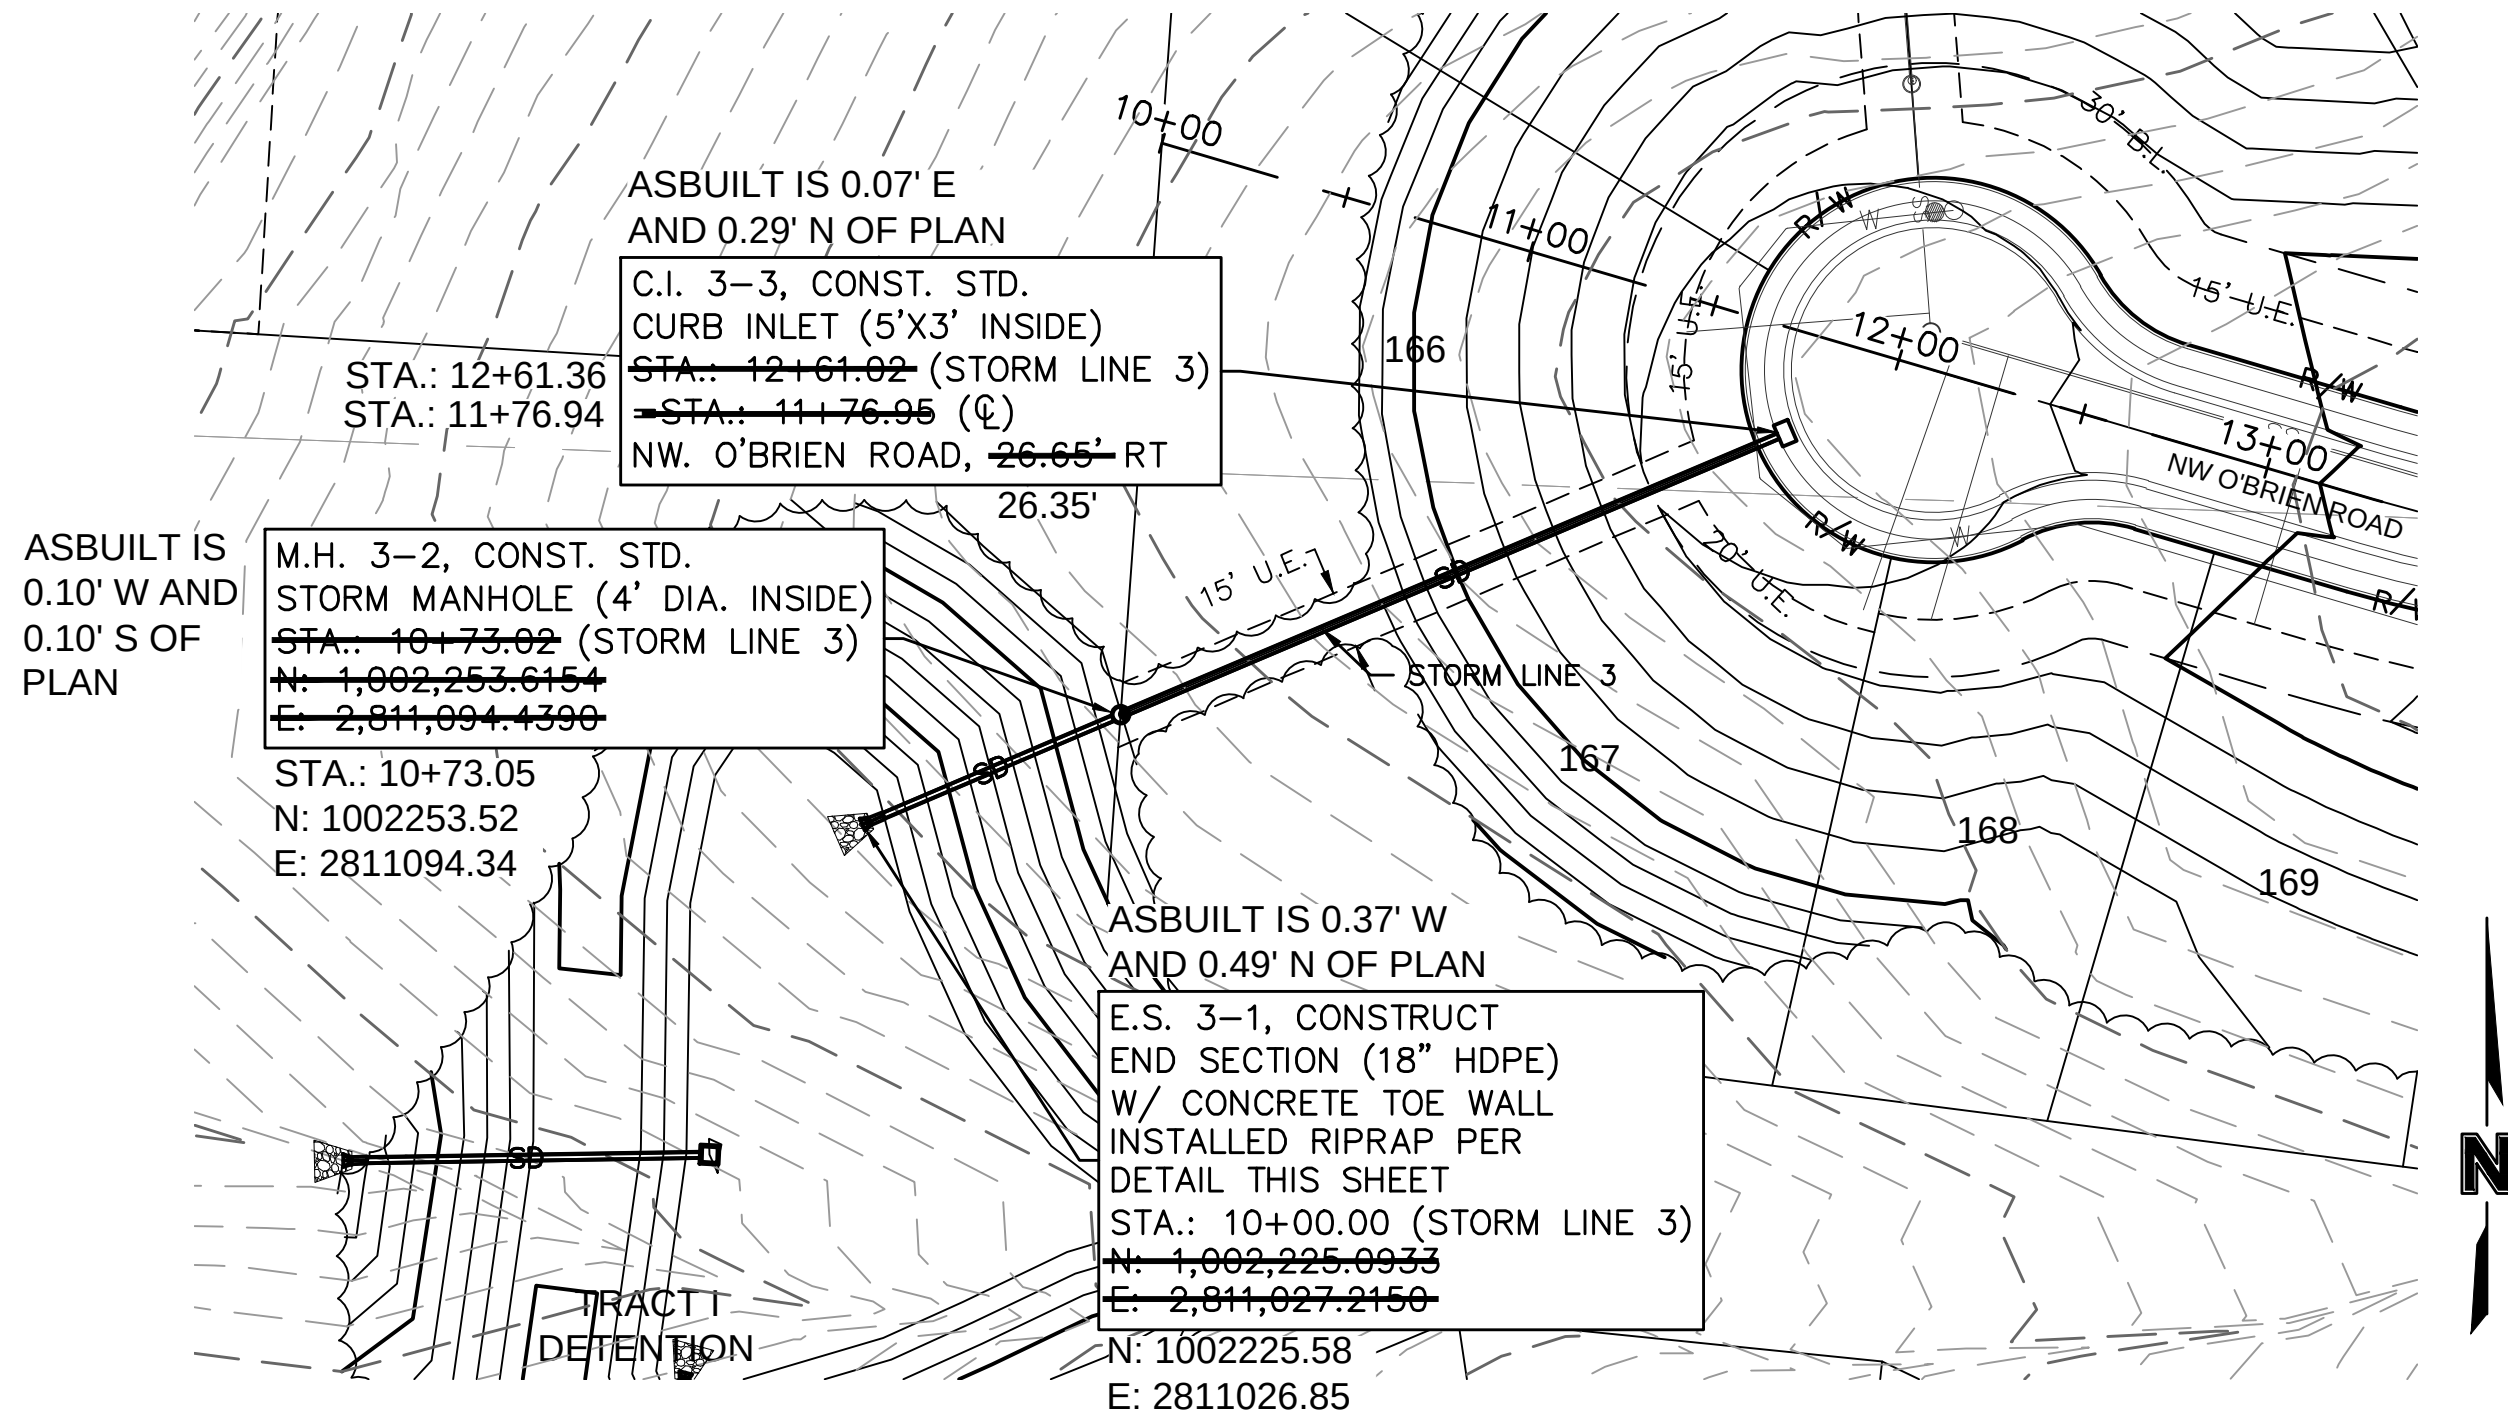

ASBUILT  
03-24-2022

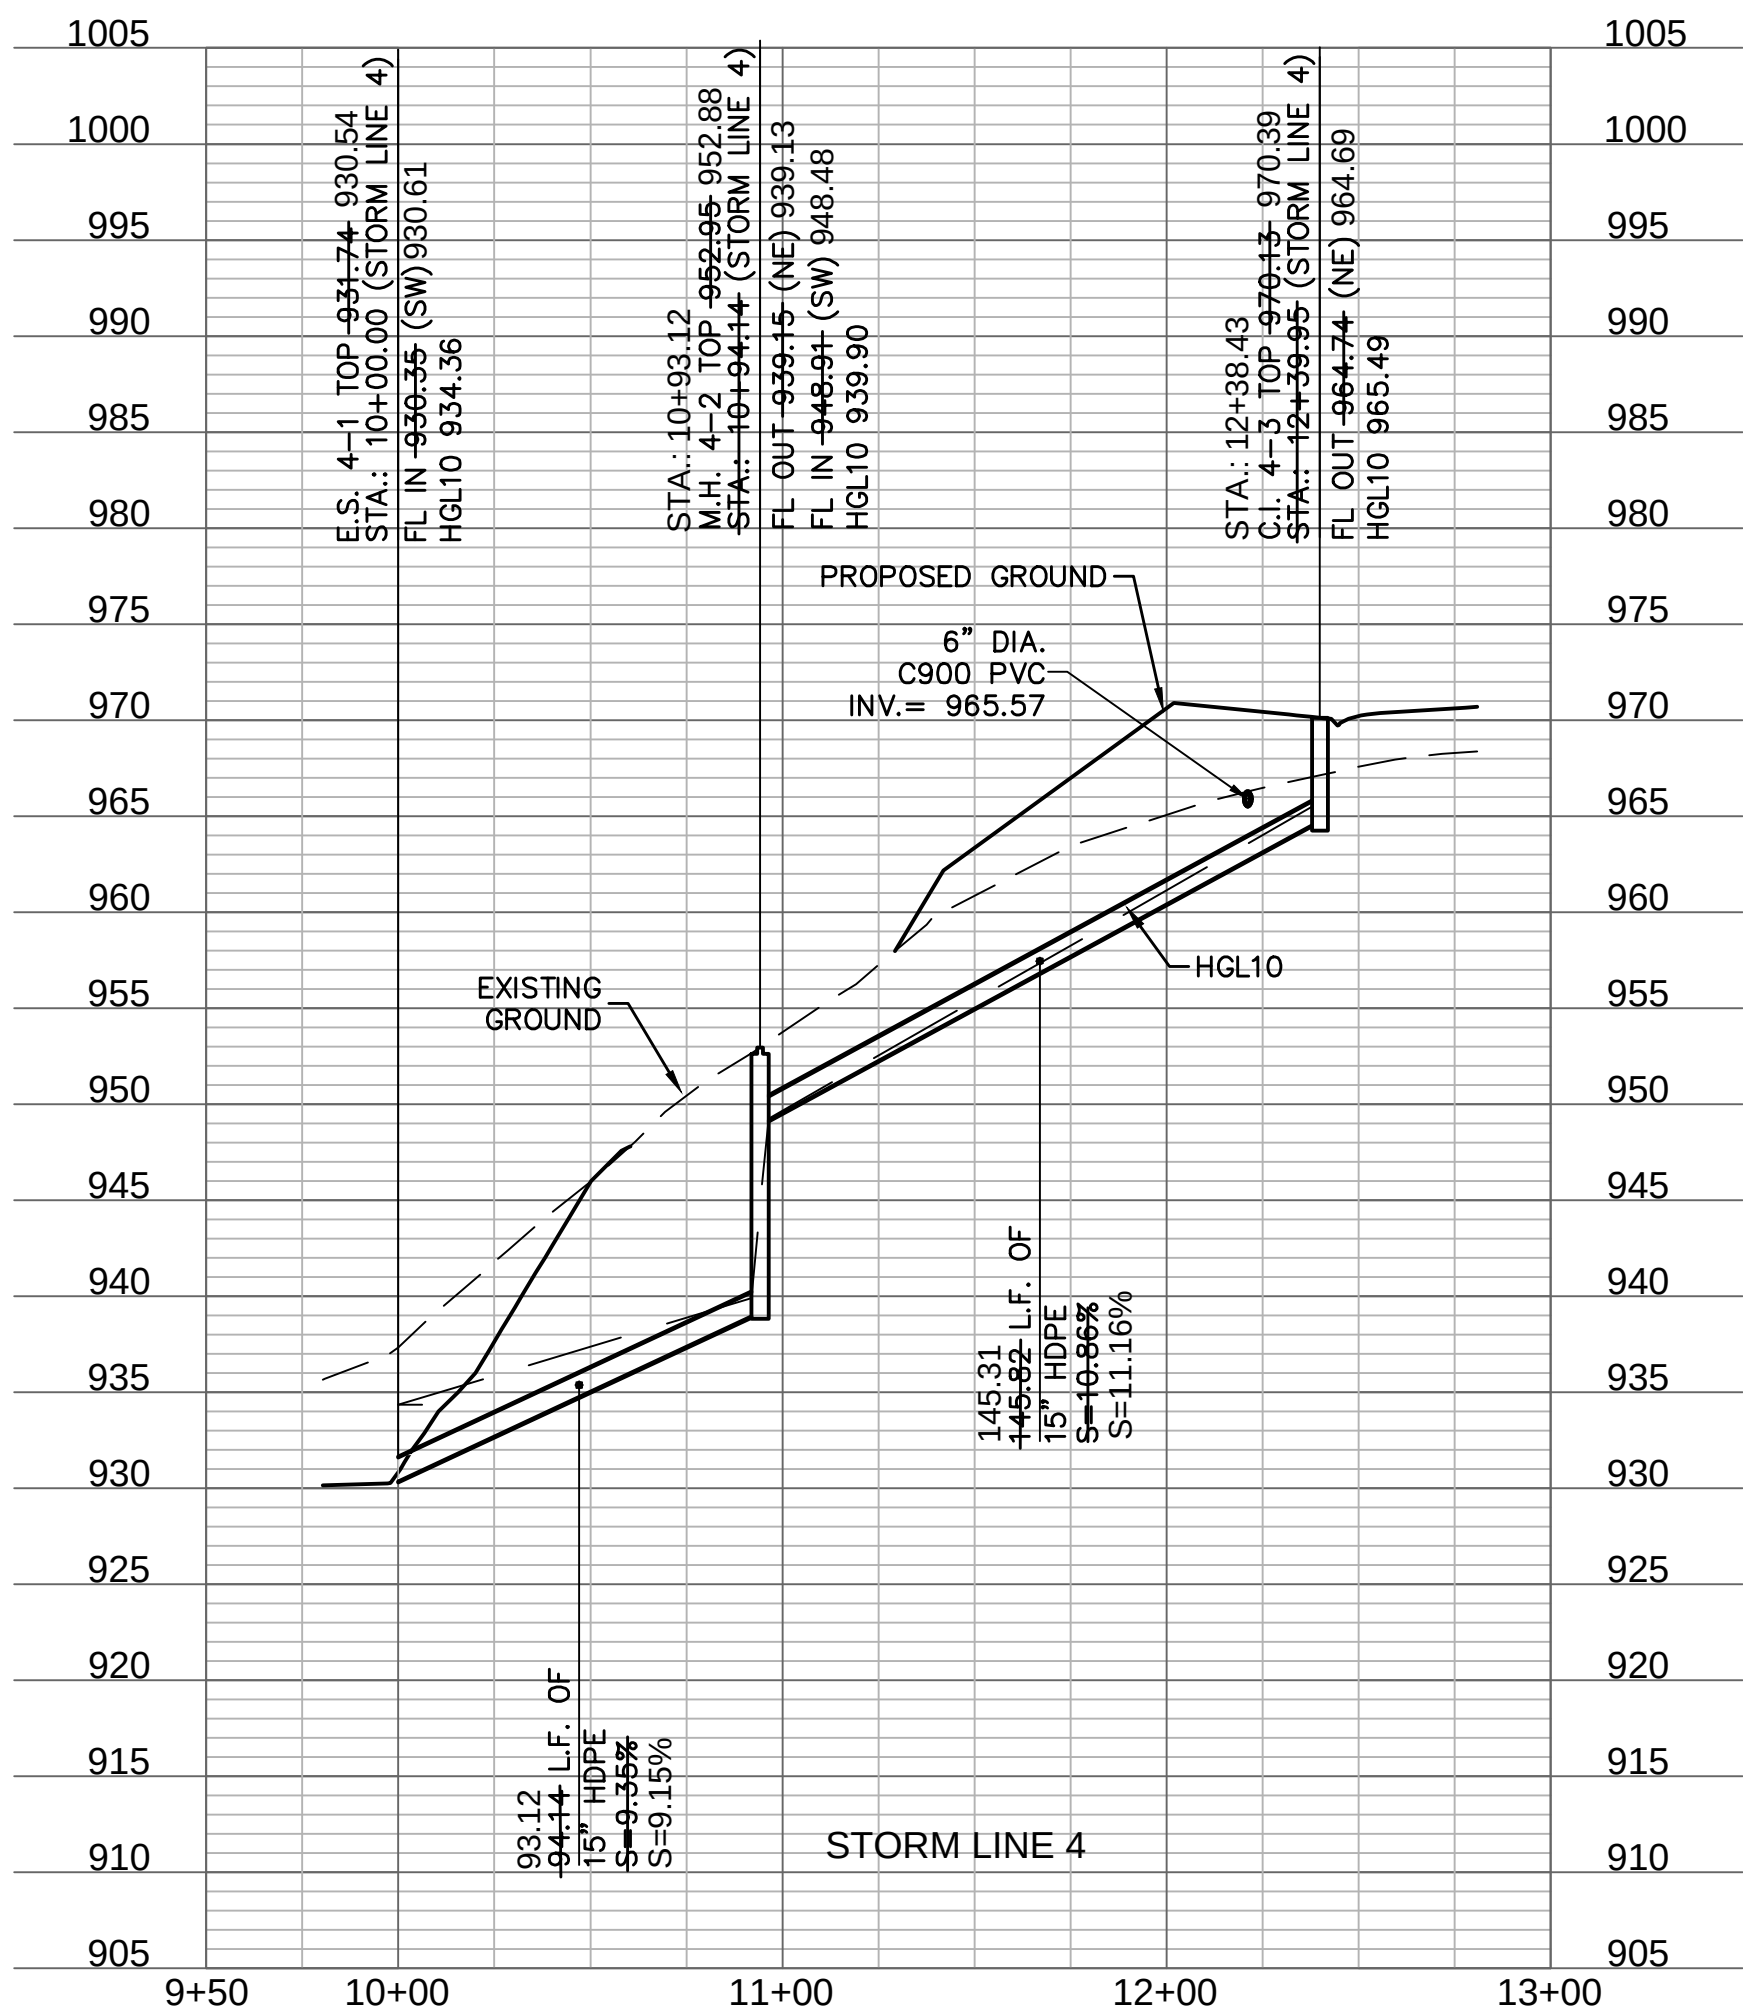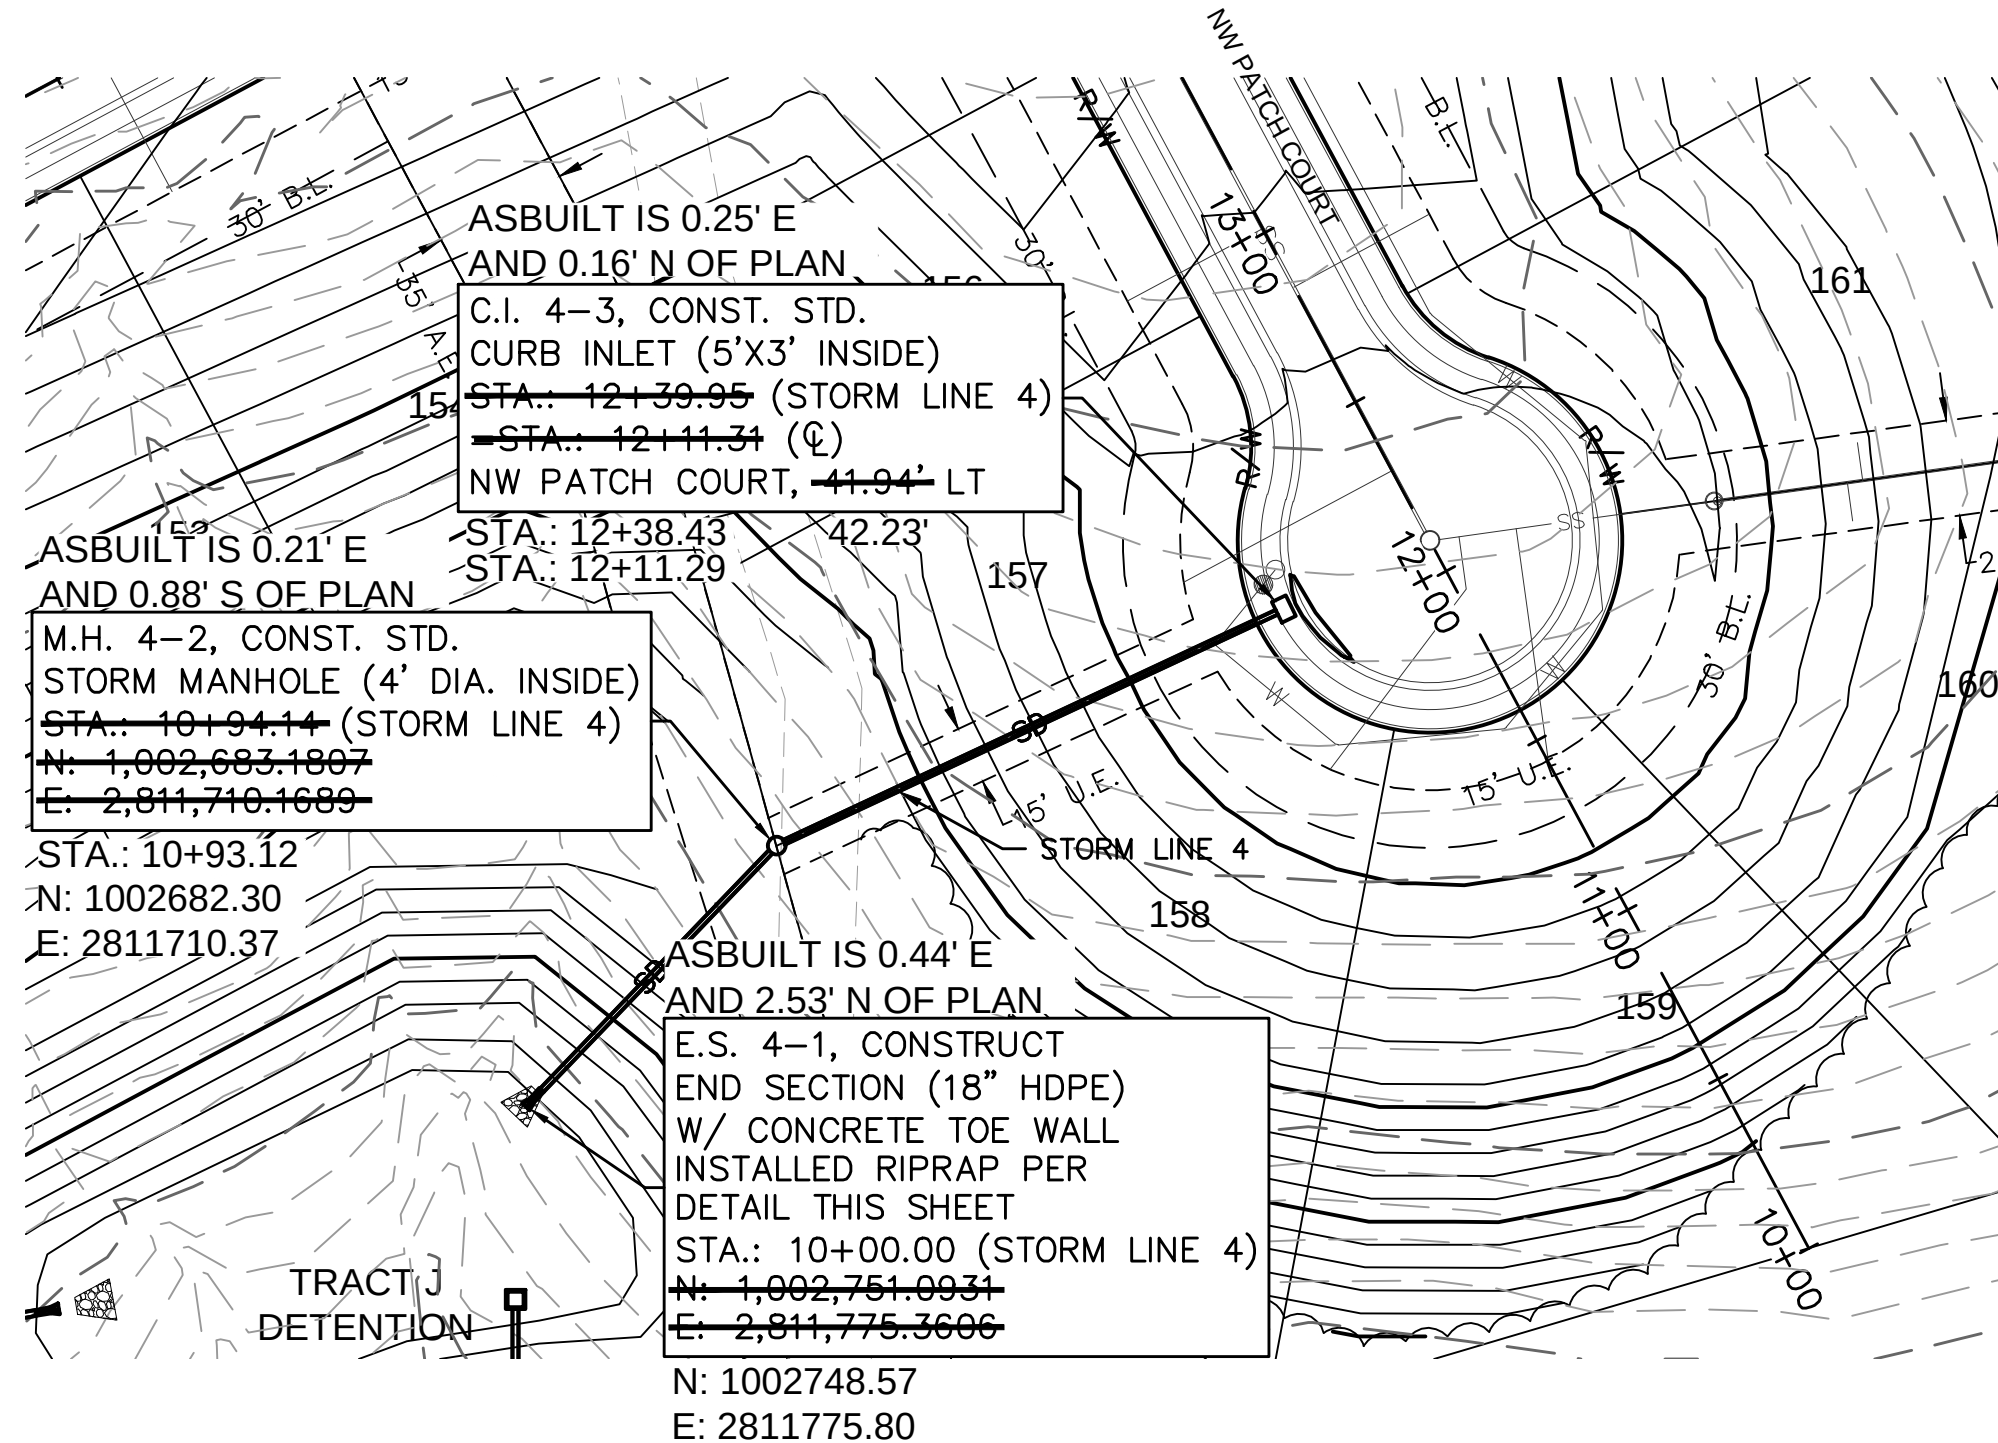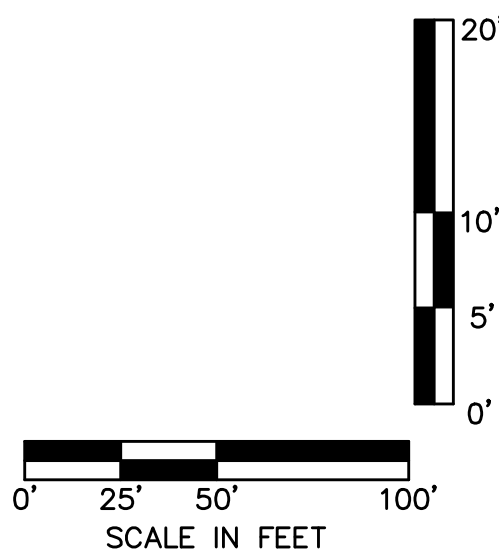

olsson



| BY  |      | REVISIONS DESCRIPTION |                                |
|-----|------|-----------------------|--------------------------------|
| NO. | REV. | DATE                  | REVISIONS DESCRIPTION          |
| 2   |      | 3/16/2021             | REVISED PER CONTRACTOR COMMENT |




|                                                          |  |      |
|----------------------------------------------------------|--|------|
| STORM SEWER PLAN & PROFILE<br>STREET & STORM SEWER PLANS |  | 2020 |
| WOODSIDE RIDGE<br>SECOND PLAT                            |  |      |
| LEE'S SUMMIT, MO                                         |  |      |

|                    |            |
|--------------------|------------|
| drawn by: _____    | C.S.M      |
| checked by: _____  | S.M.S      |
| designed by: _____ | C.S.M      |
| QA/QC by: _____    | J.E.S      |
| project no.: _____ | C18-1140   |
| date: _____        | 2020.07.10 |

drawn by: C.S.M.  
checked by: S.M.S.  
designed by: C.S.M.  
QA/QC by: J.E.S.  
project no.: C18-1140  
date: 2020.07.10

SHEET  
C118



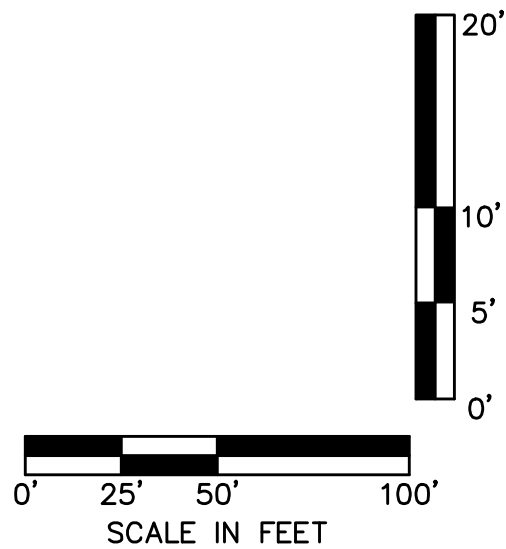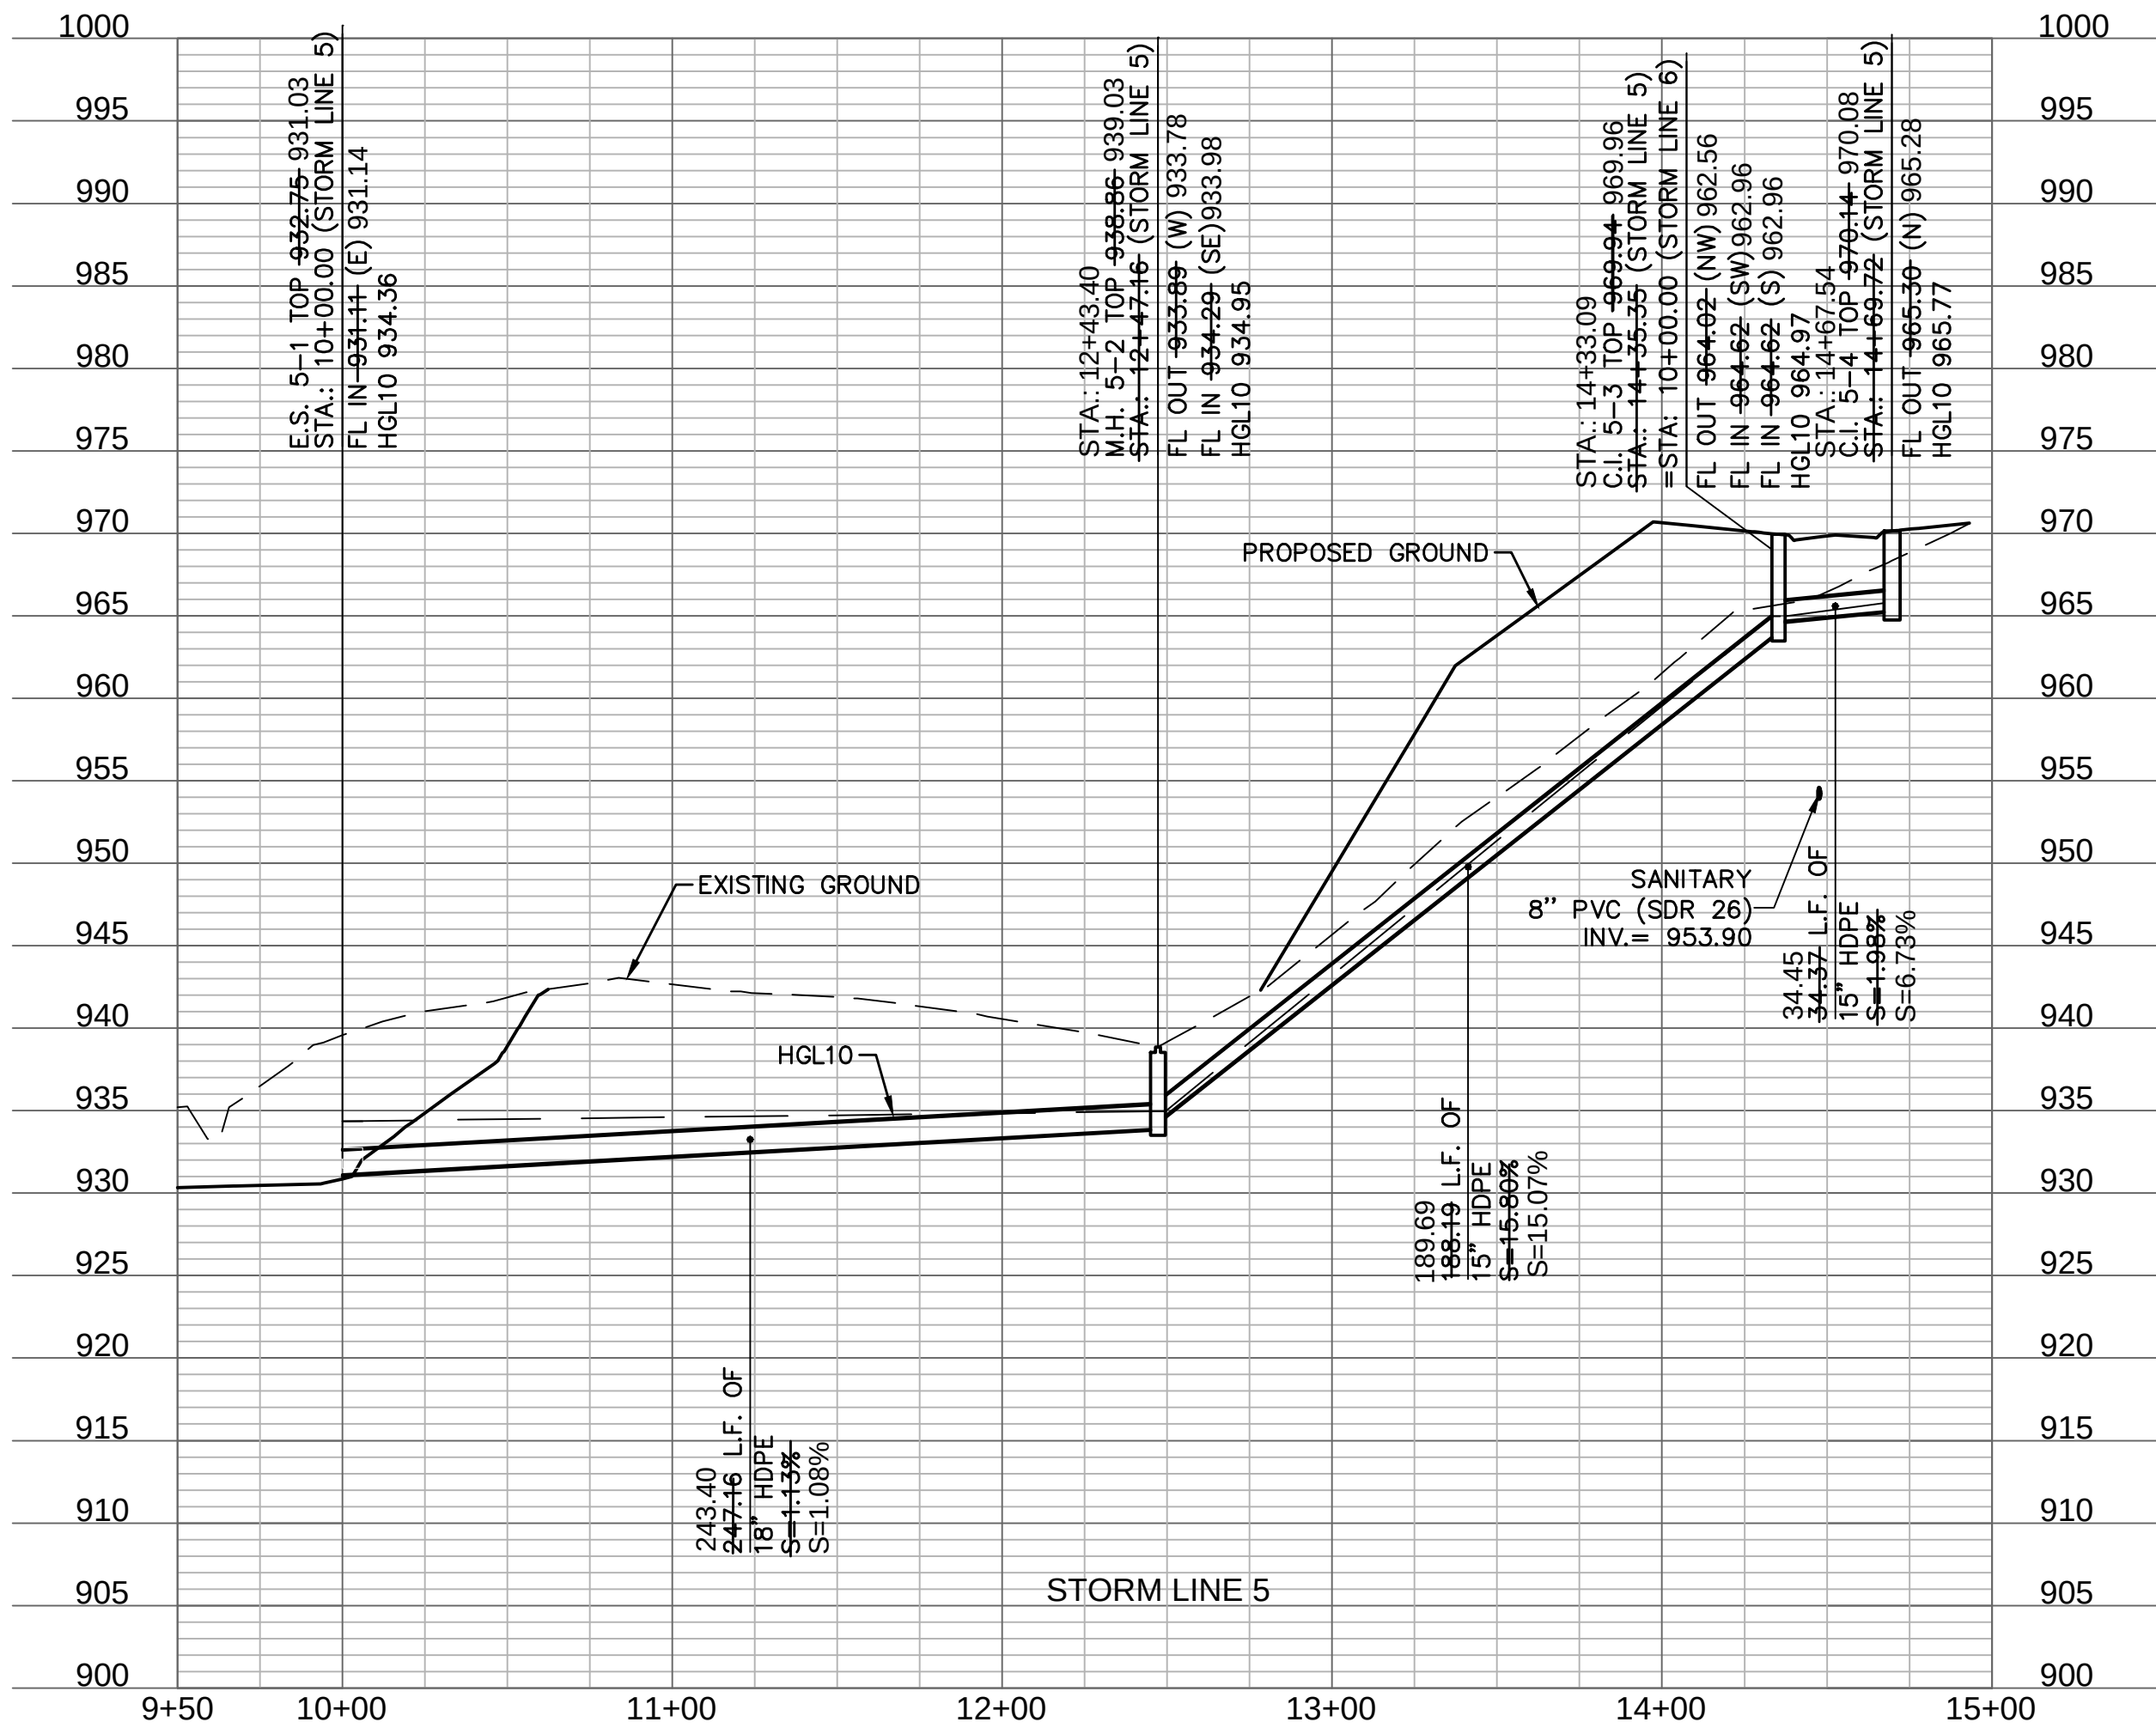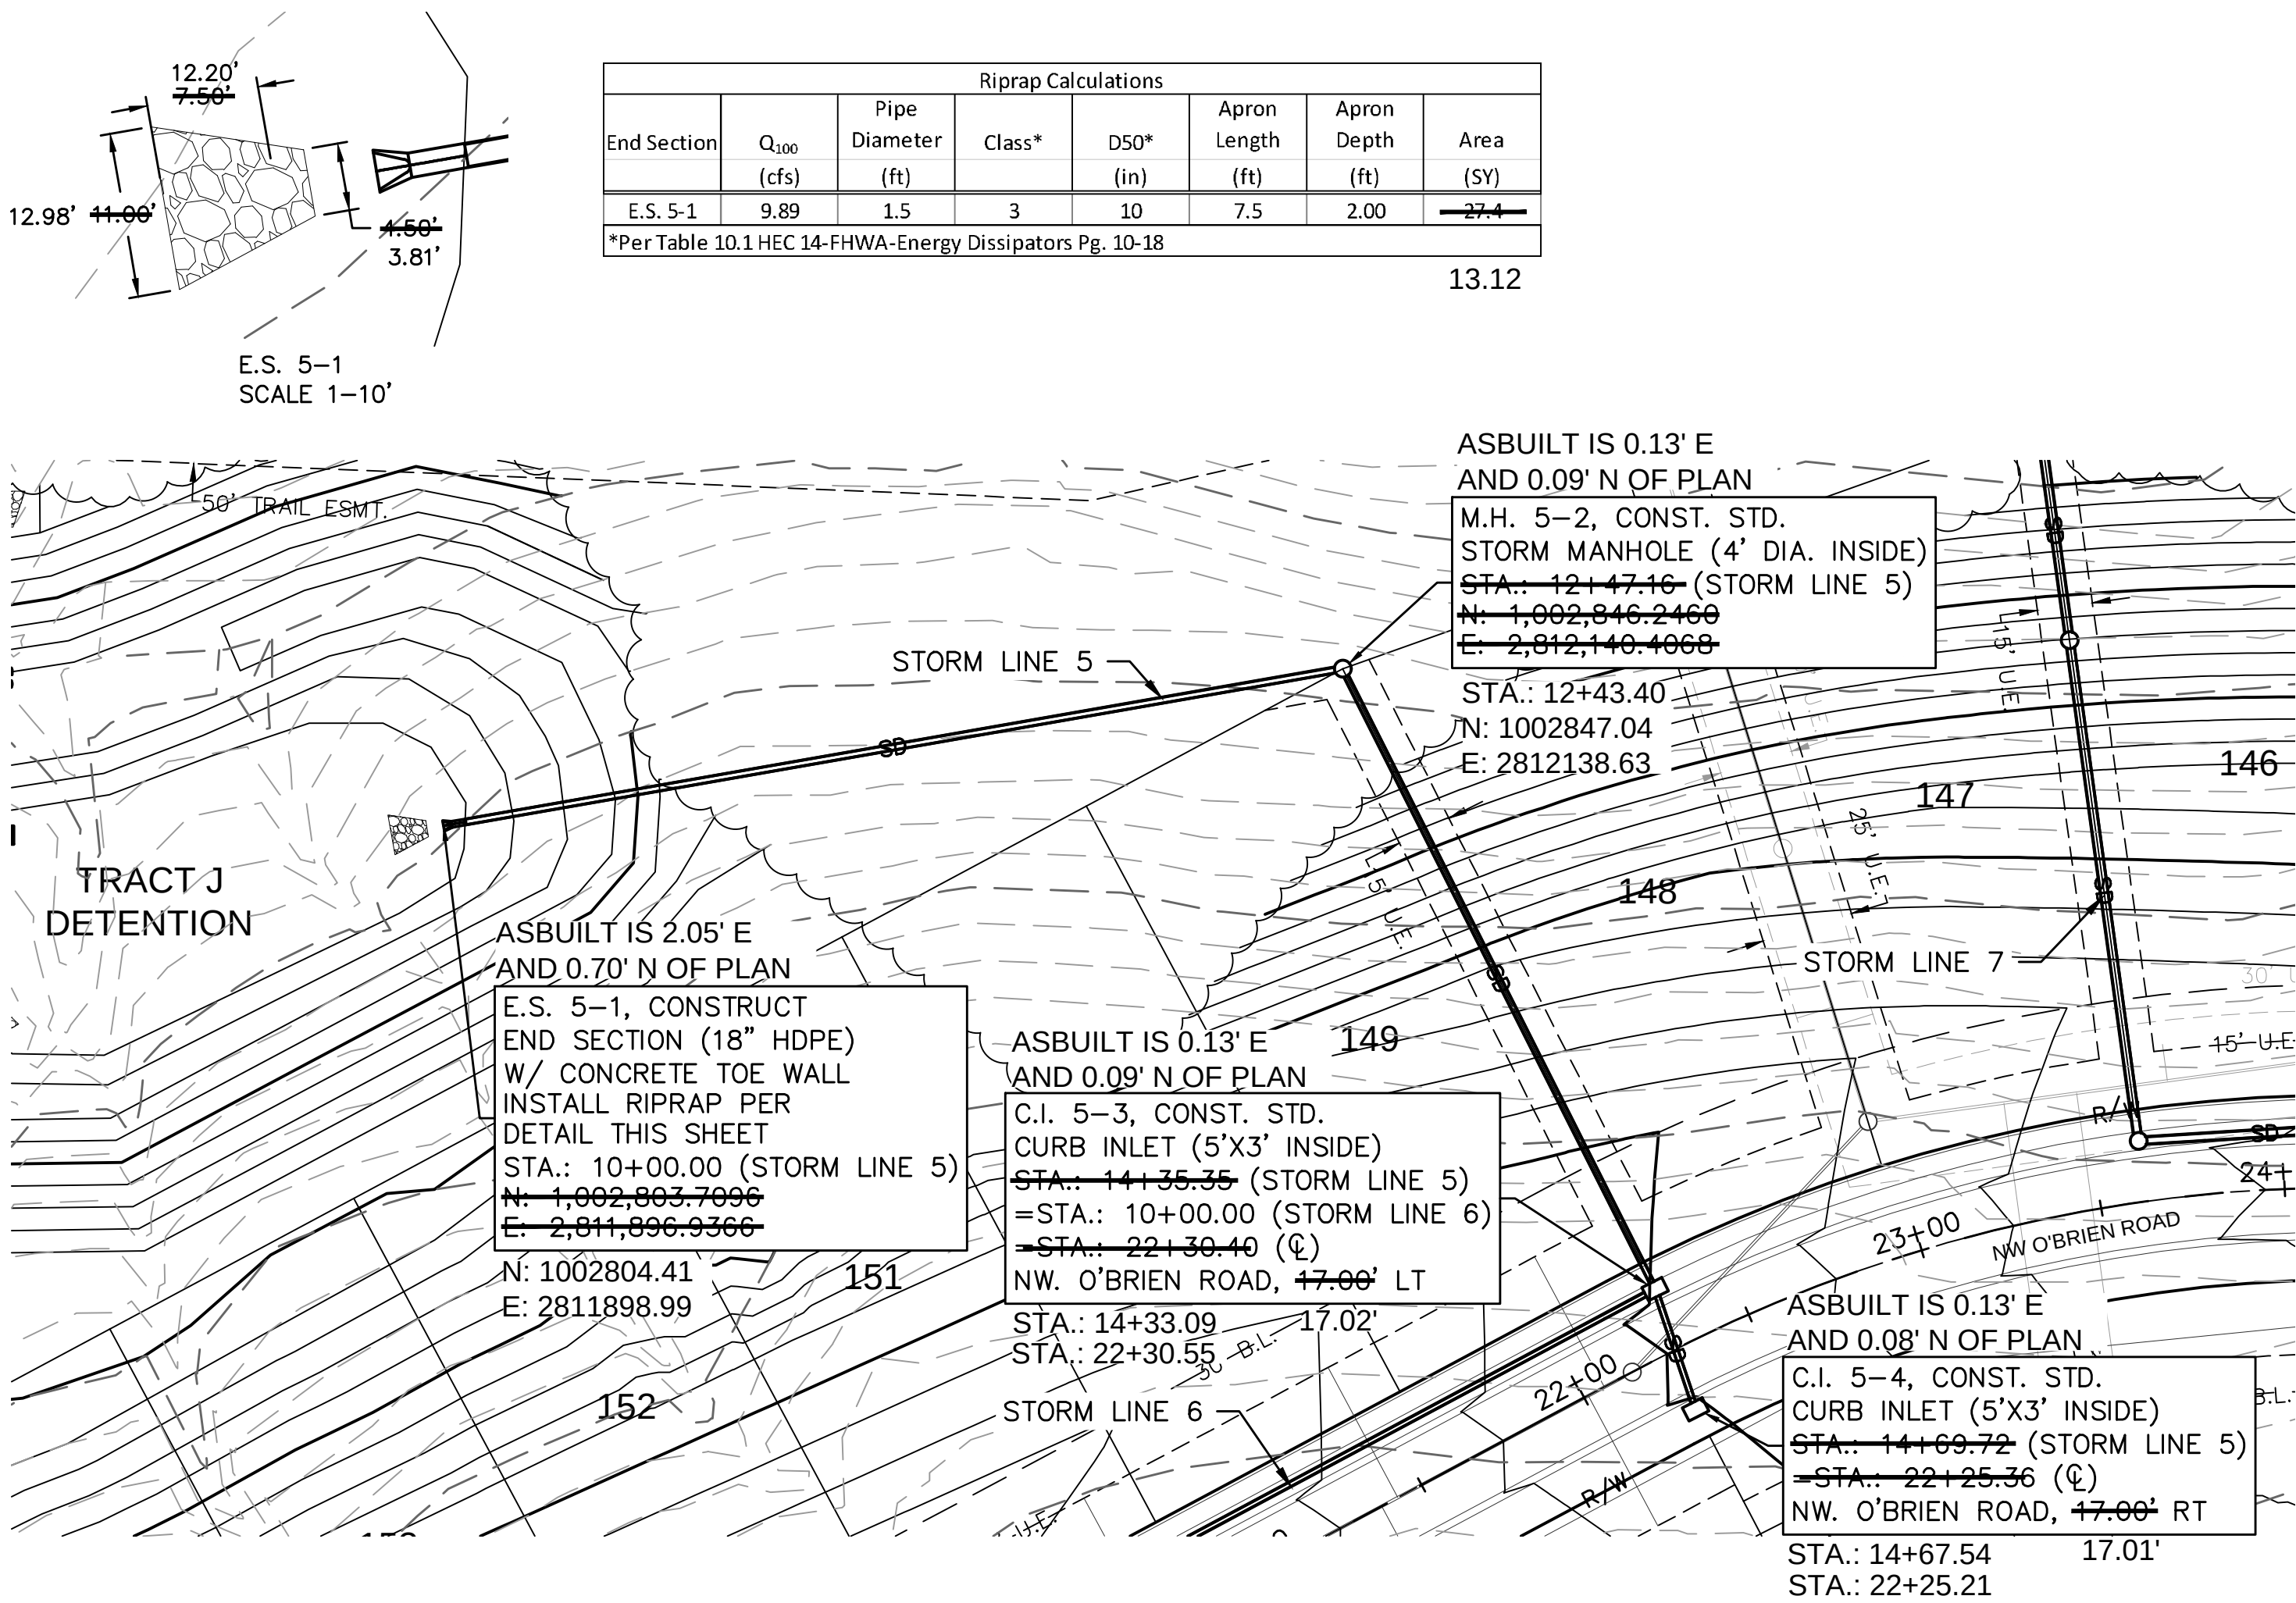

STORM SEWER PLAN & PROFILE  
STREET & STORM SEWER PLANS

WOODSIDE RIDGE  
SECOND PLAT

LEE'S SUMMIT, MO

2020


drawn by: C.S.M.  
checked by: S.M.S.  
designed by: C.S.M.  
QA/QC by: J.E.S.  
project no.: C18-1140  
date: 2020.07.10

SHEET  
C119

NO. REV. DATE REVISIONS DESCRIPTION

2 3/16/2021 REVISED PER CONTRACTOR COMMENT

BY


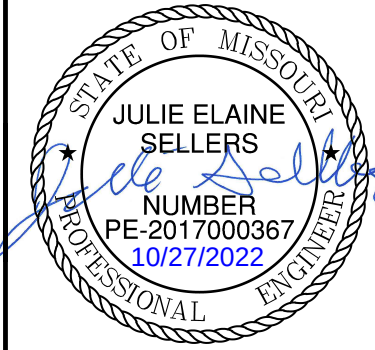


REVISIONS


olsson

NO. 018-1140-001  
301 E. BIRCH STREET, SUITE 100  
NORTH KANSAS CITY, MO 64116  
TEL. 816.381.1177  
WWW.OLSSON.COM

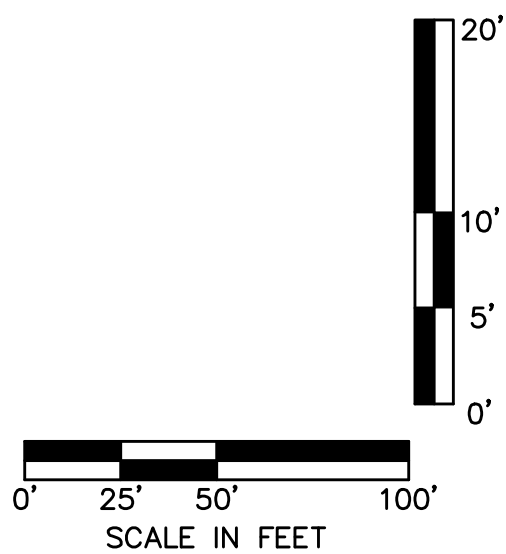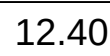


12.40

03-24-2022


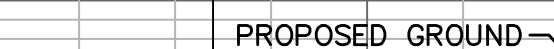




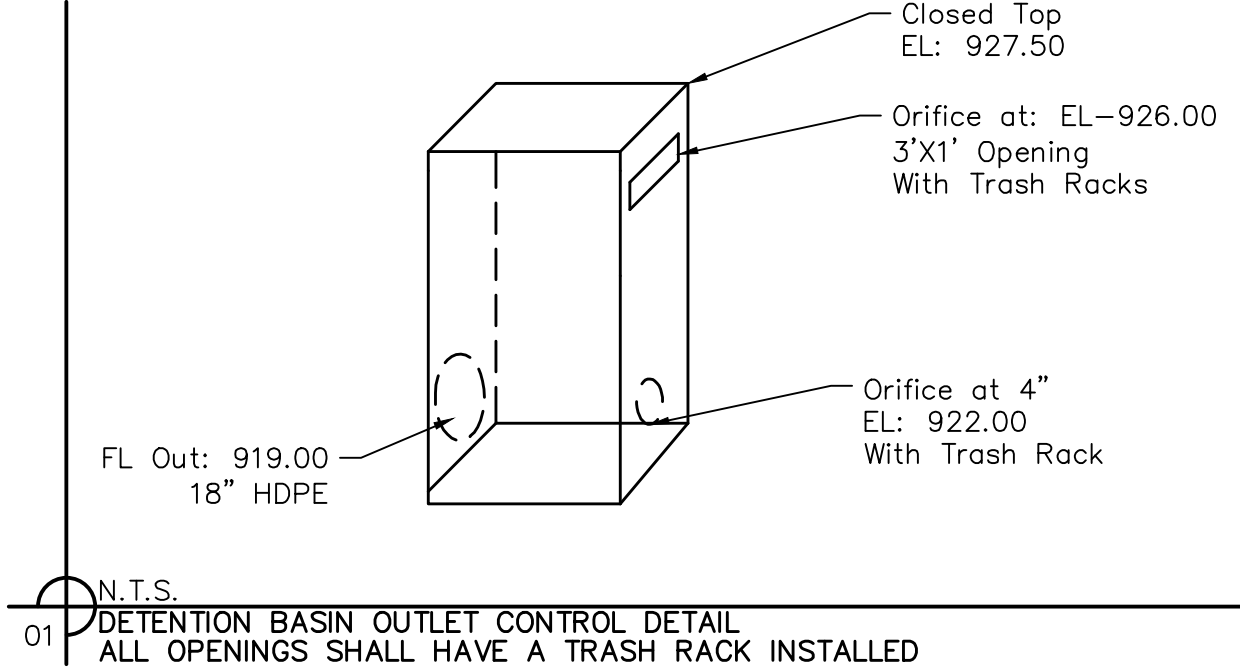

| EARTHWORK QUANTITIES |             |
|----------------------|-------------|
| CUT (C.Y.)           | FILL (C.Y.) |
| 6,485                | 2,184       |
|                      |             |



|              |               |
|--------------|---------------|
| 10yr. W.S.E. | 100yr. W.S.E. |
| 926.73       | 928.54        |
|              |               |

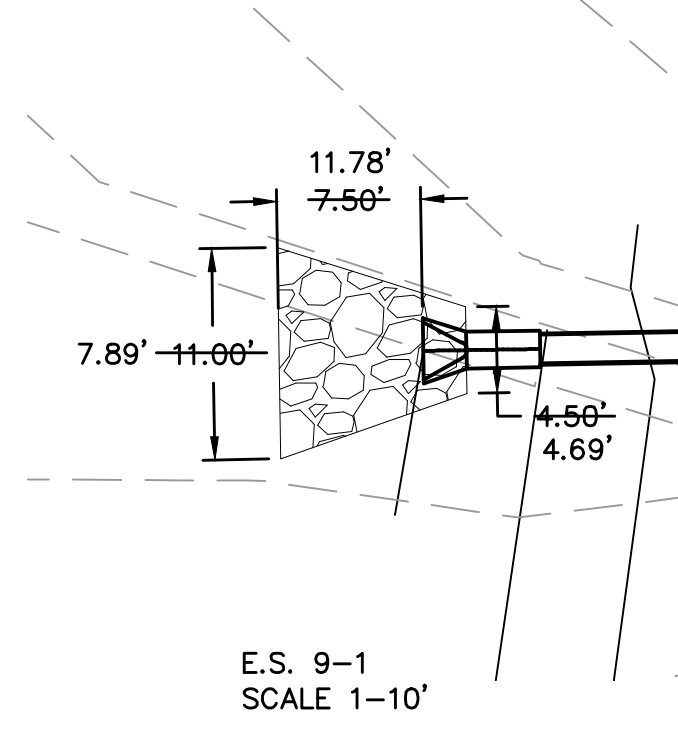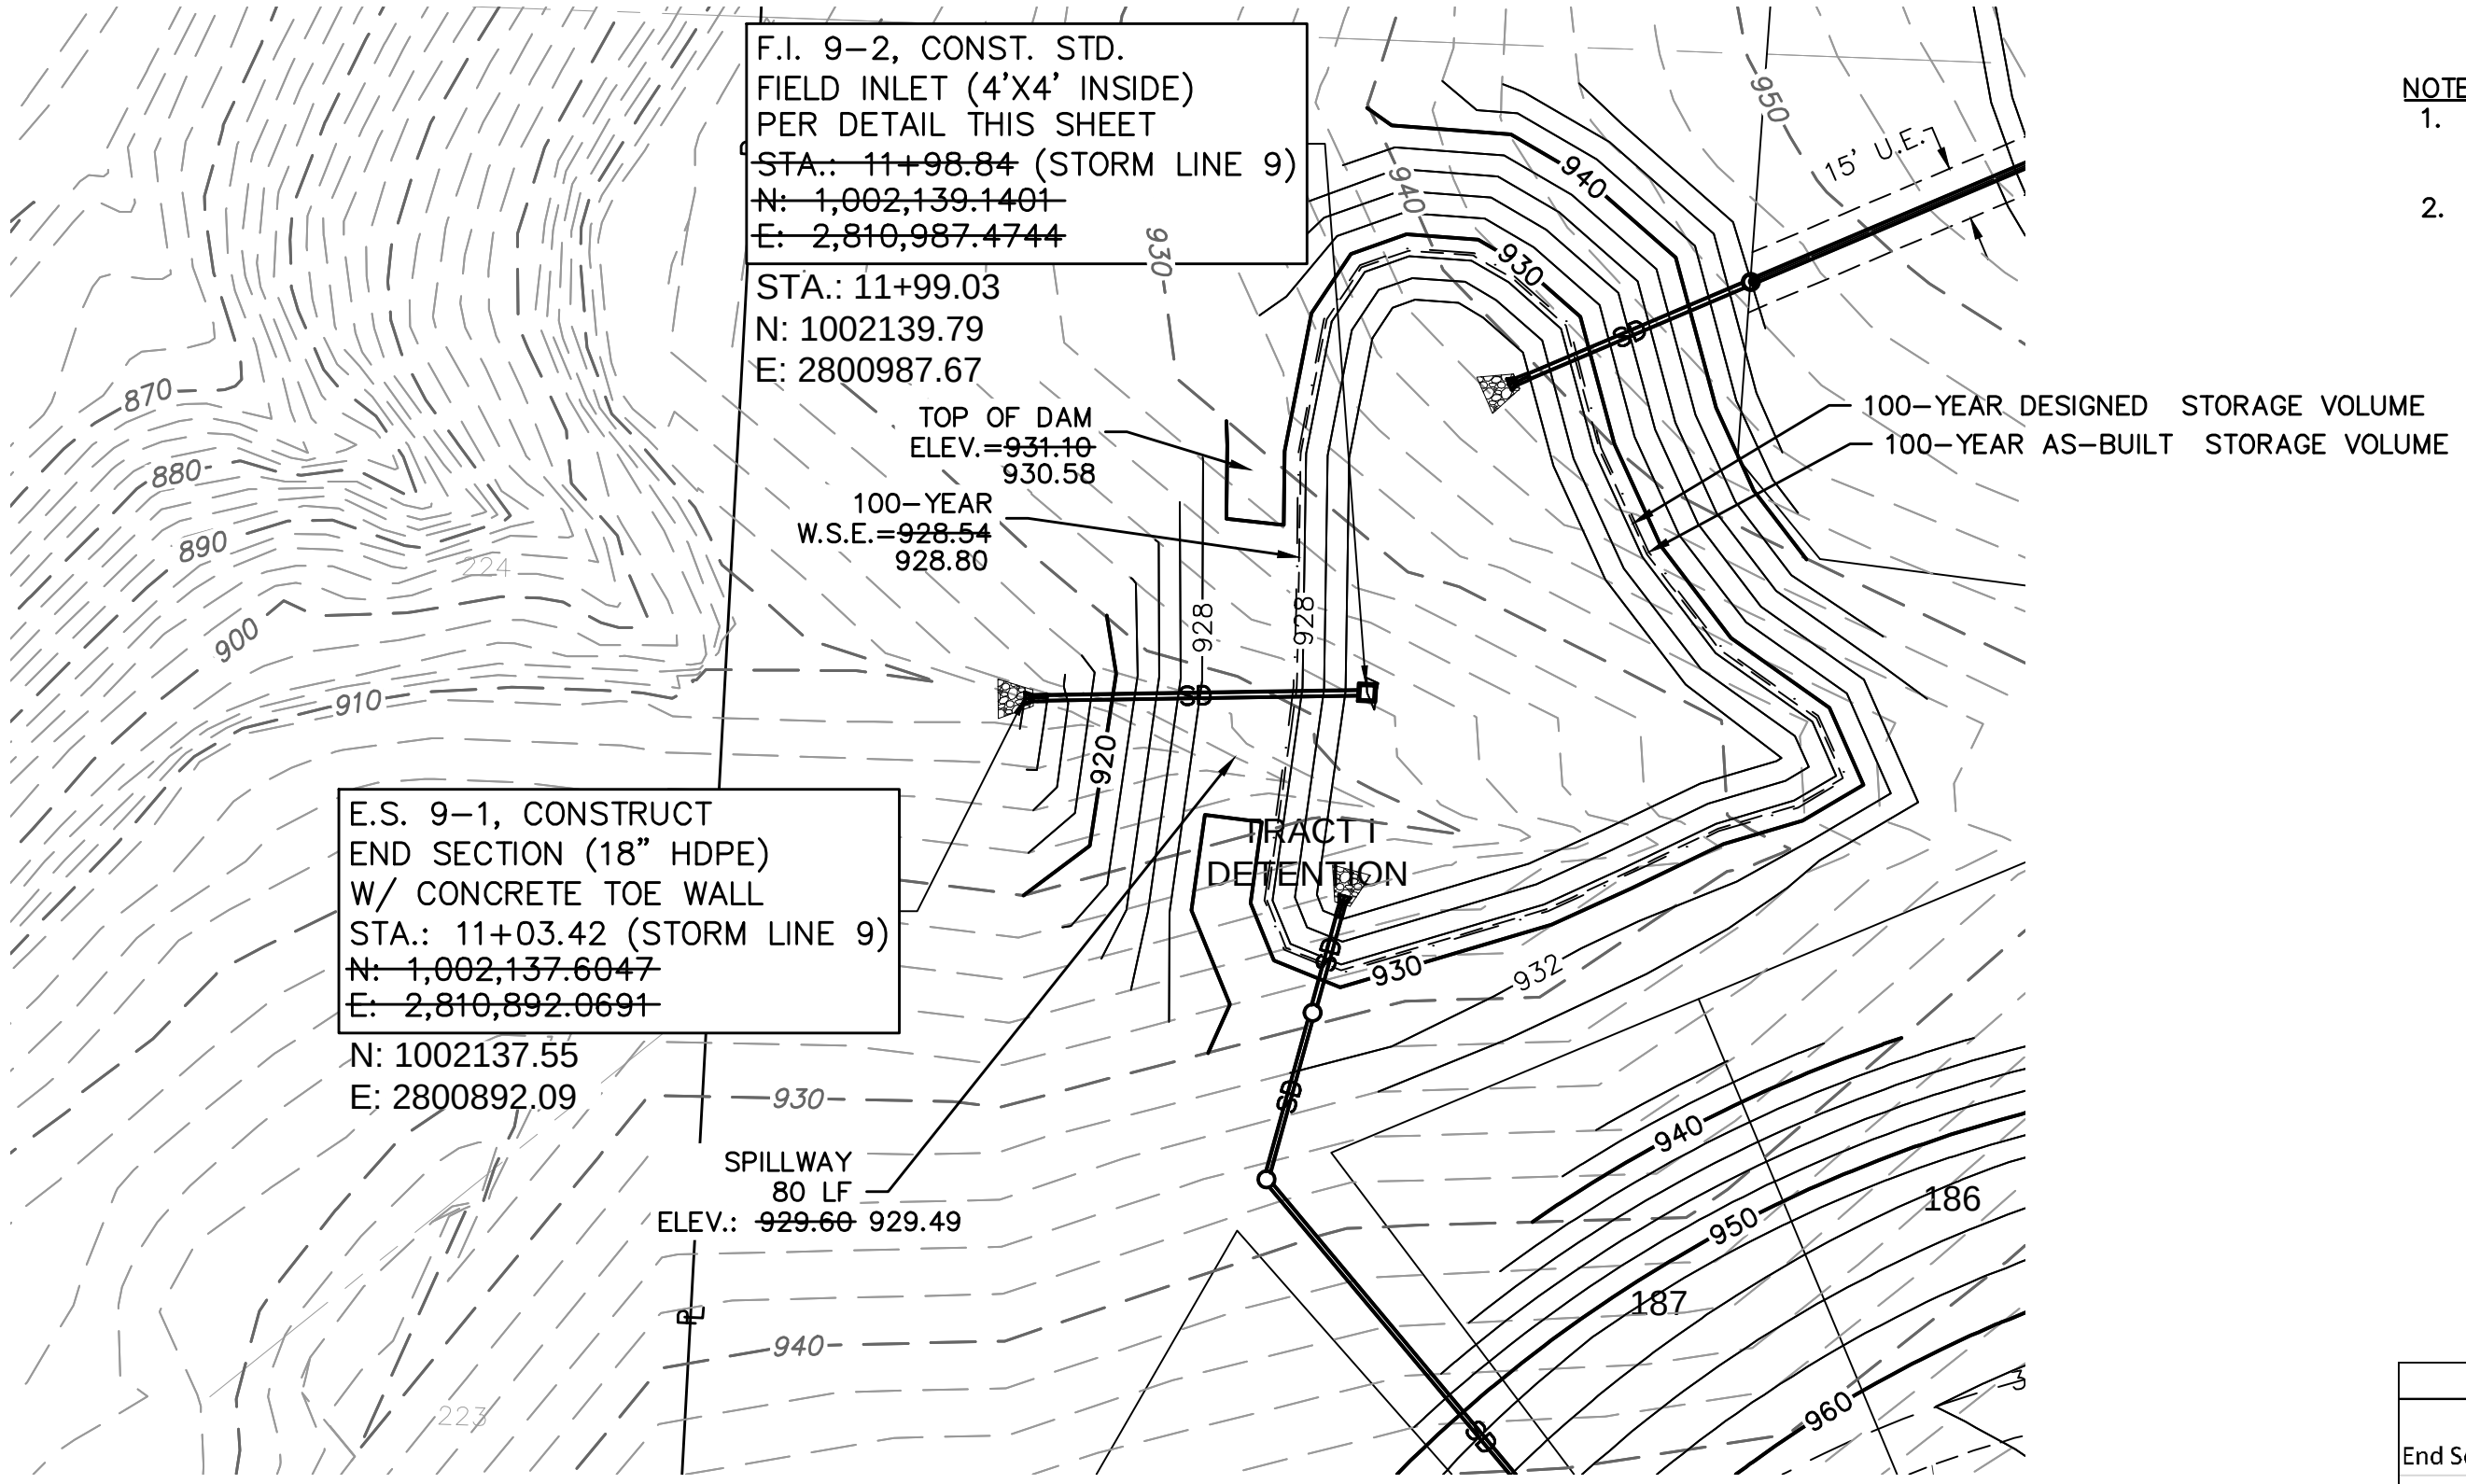

| Riprap Calculations |                           |                          |        |              |                         |                        |                 |
|---------------------|---------------------------|--------------------------|--------|--------------|-------------------------|------------------------|-----------------|
| End Section         | Q <sub>100</sub><br>(cfs) | Pipe<br>Diameter<br>(ft) | Class* | D50*<br>(in) | Apron<br>Length<br>(ft) | Apron<br>Depth<br>(ft) | Area<br>(SY)    |
| E.S. 9-1            | 23.91                     | 1.5                      | 3      | 10           | 7.5                     | 2.00                   | <del>27.4</del> |

\*Per Table 10.1 HEC 14-FHWA-Energy Dissipators Pg. 10-18

23.88

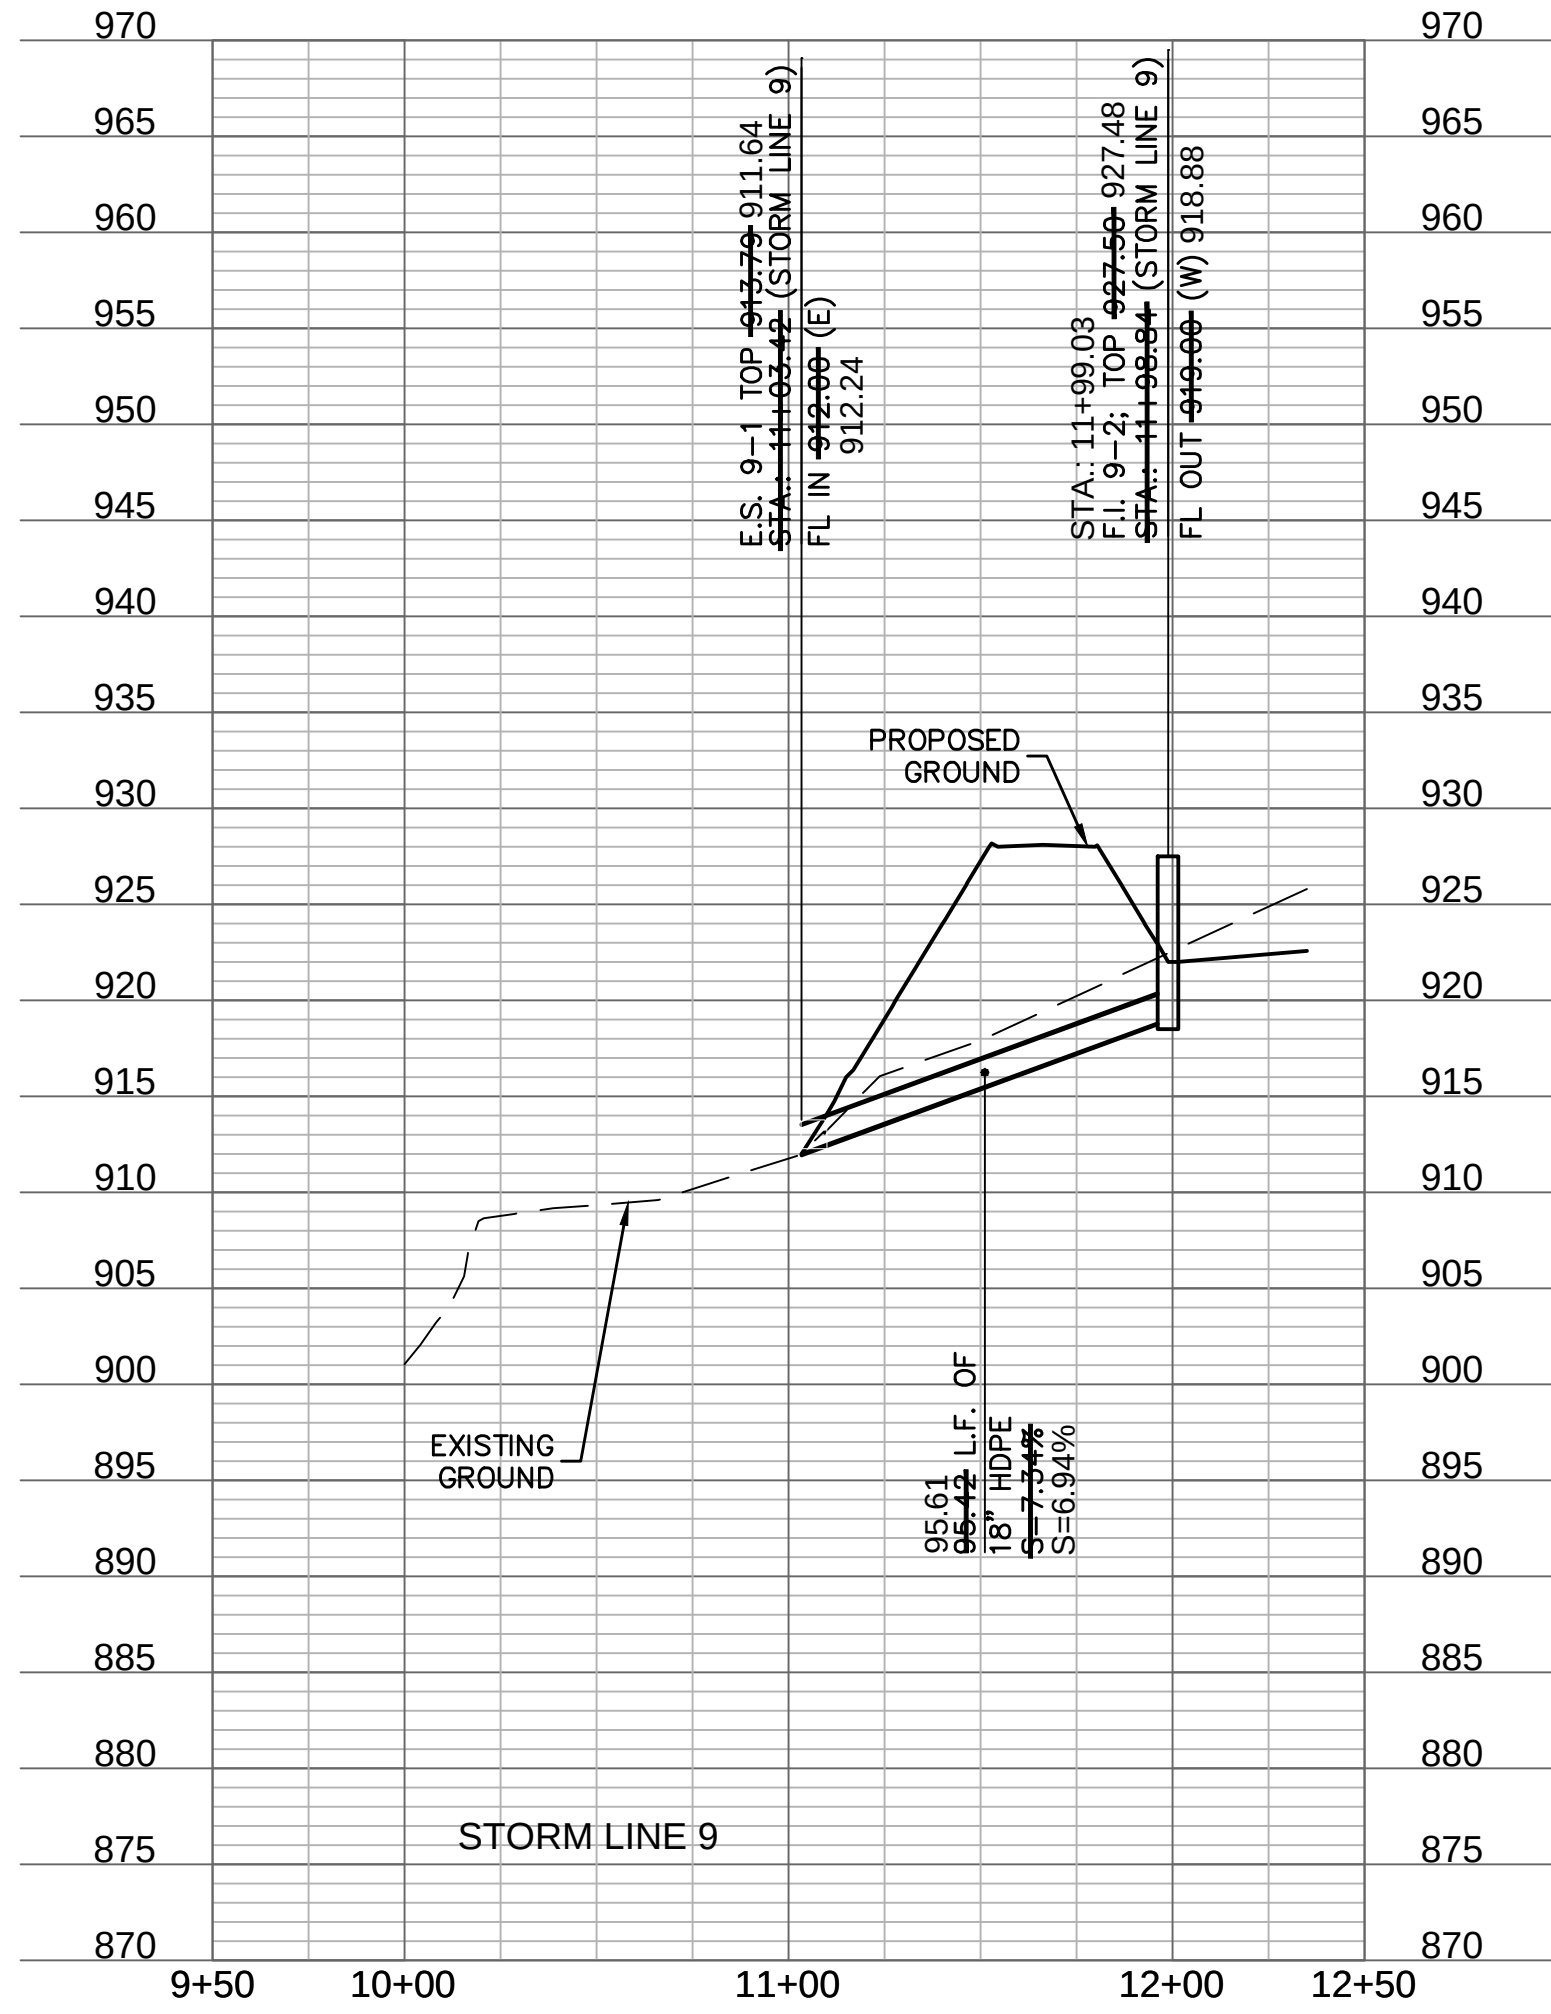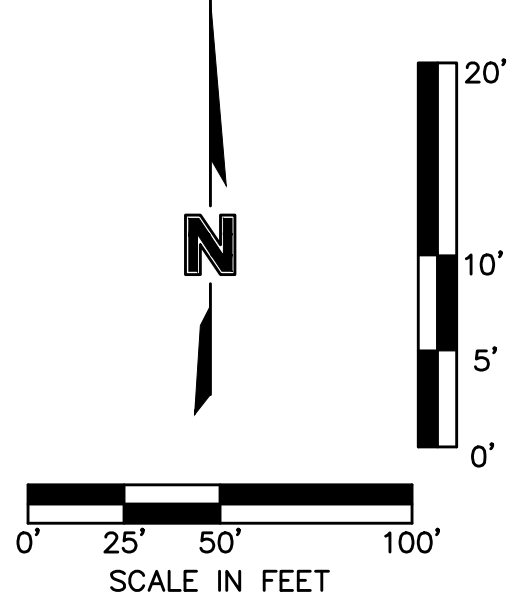


ASBUILT  
03-24-2022

[illegible]

|                                                    |                               |                  |      |
|----------------------------------------------------|-------------------------------|------------------|------|
| DETENTION BASIN PLAN<br>STREET & STORM SEWER PLANS | WOODSIDE RIDGE<br>SECOND PLAT | LEE'S SUMMIT, MO | 2020 |
|----------------------------------------------------|-------------------------------|------------------|------|




drawn by: C.S.M  
checked by: S.M.S  
designed by: C.S.M  
QA/QC by: J.E.S  
project no.: C18-1140  
date: 2020.07.10



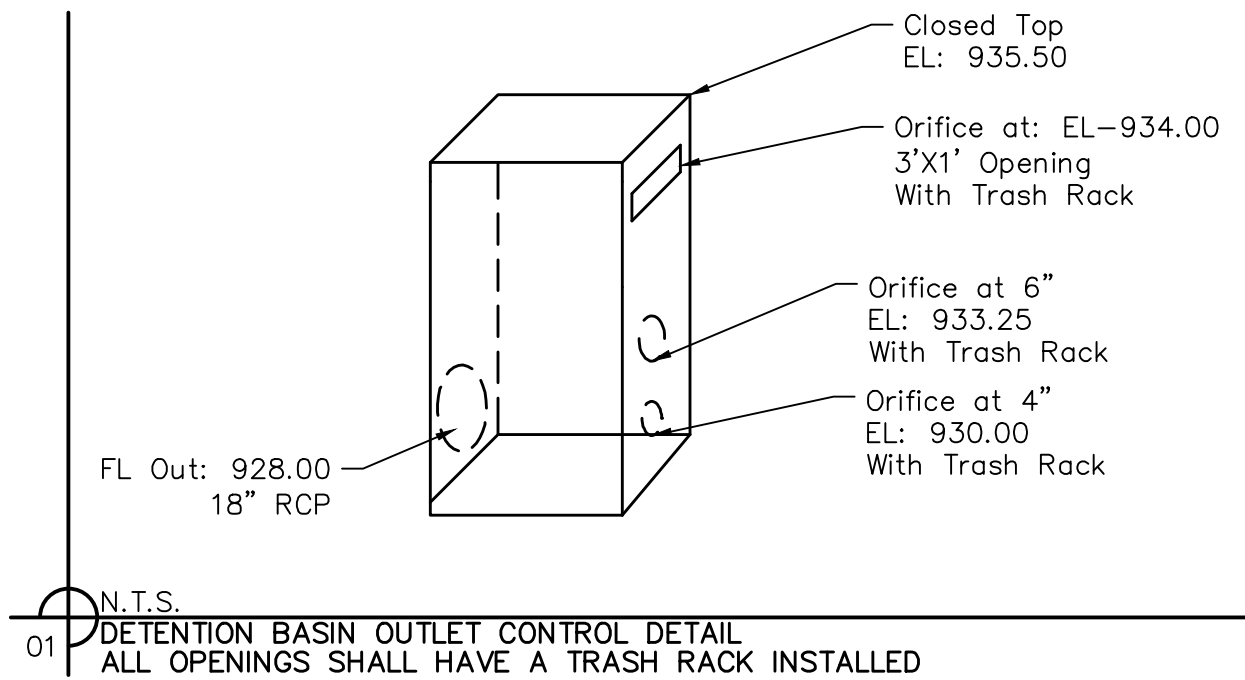


| EARTHWORK QUANTITIES |             |
|----------------------|-------------|
| CUT (C.Y.)           | FILL (C.Y.) |
| 4,012                | 2,535       |

| 10yr. W.S.E. | 100yr. W.S.E. |
|--------------|---------------|
| 934.36       | 935.67        |

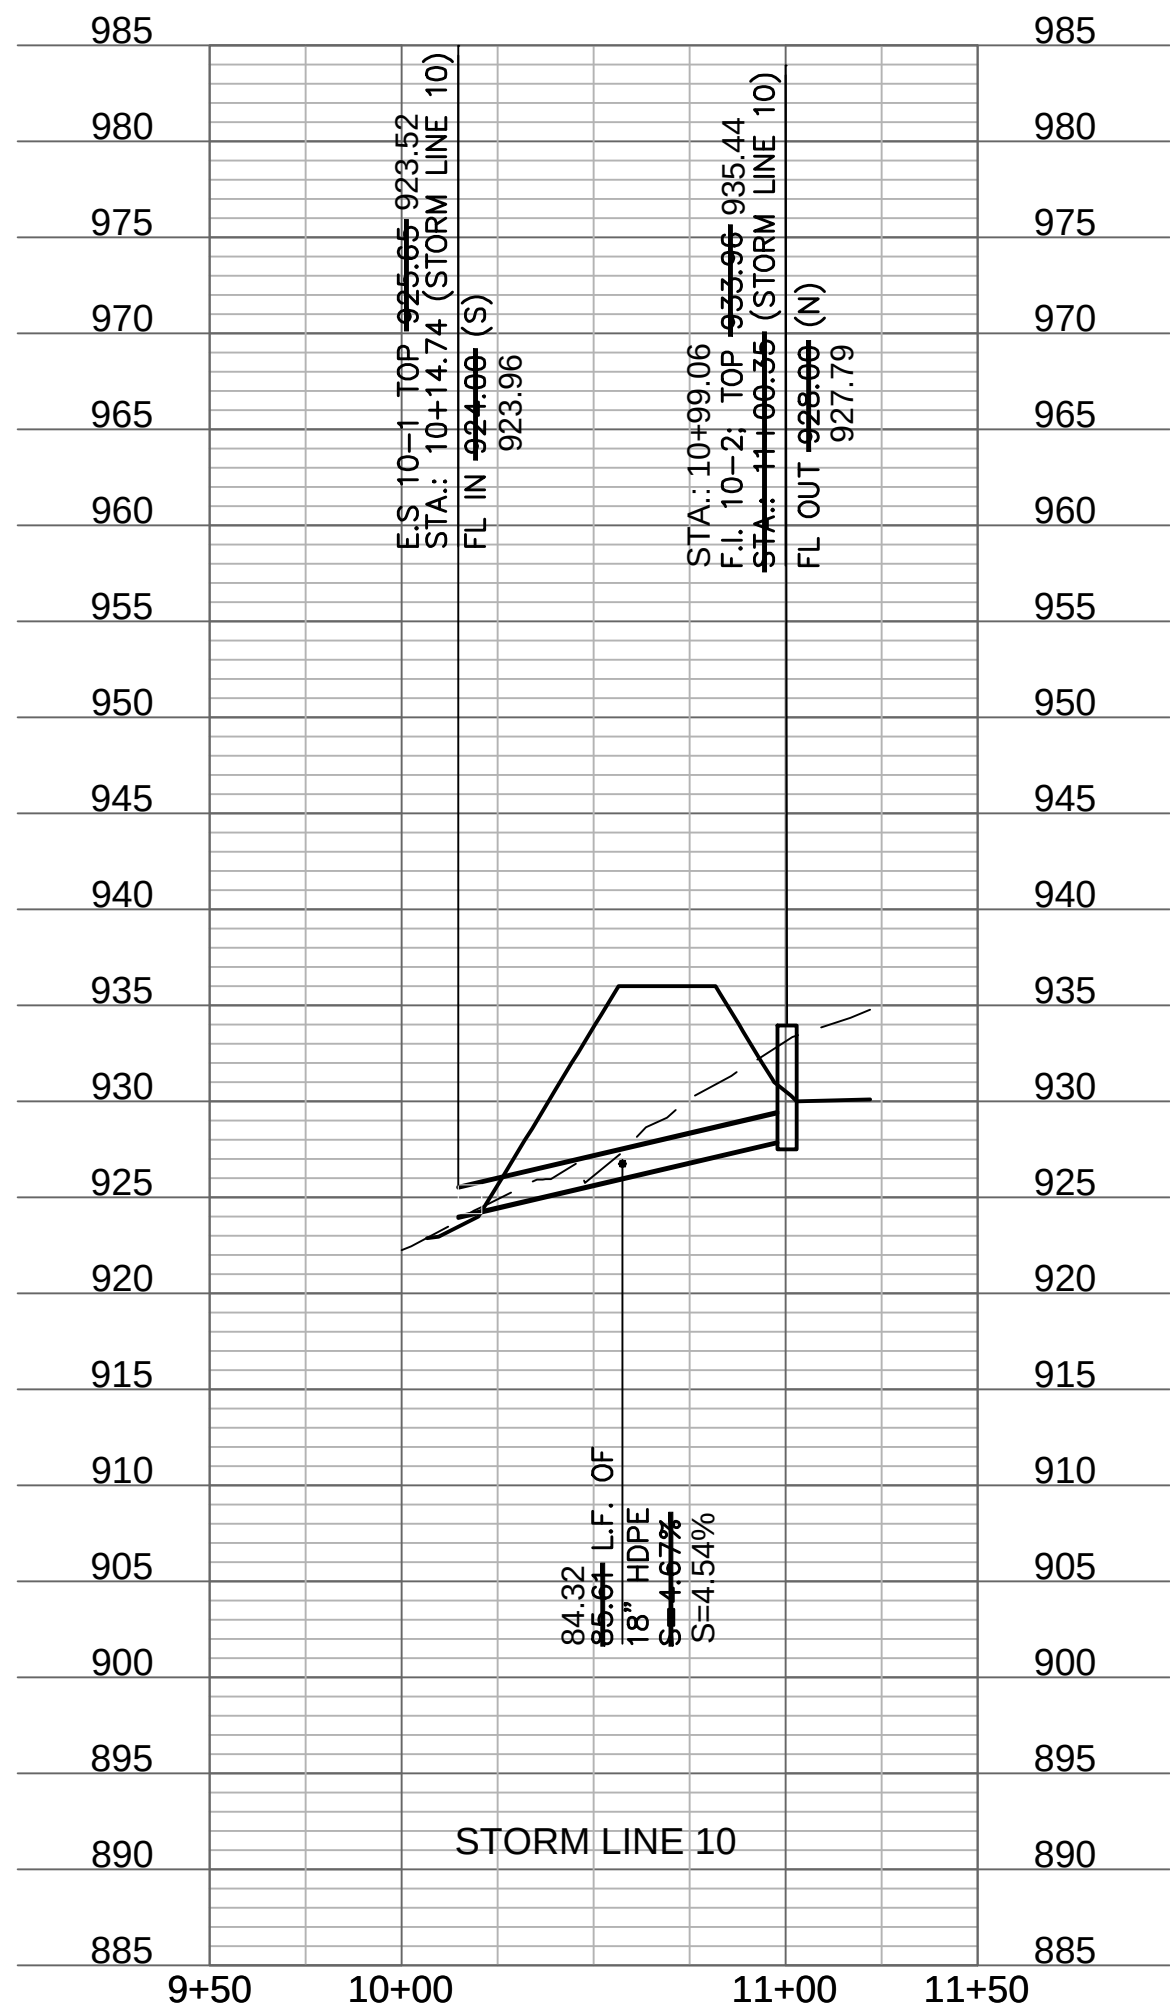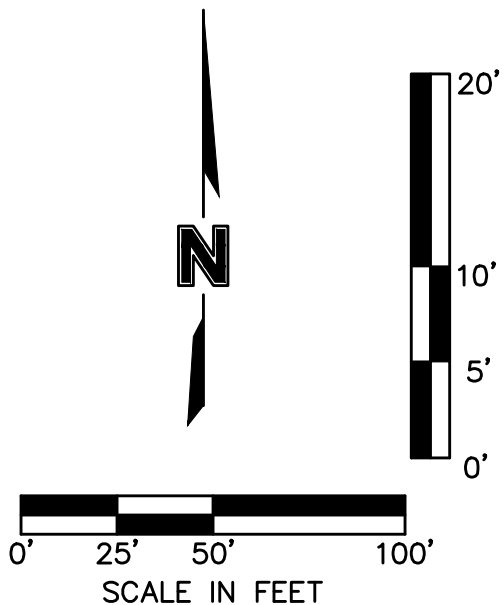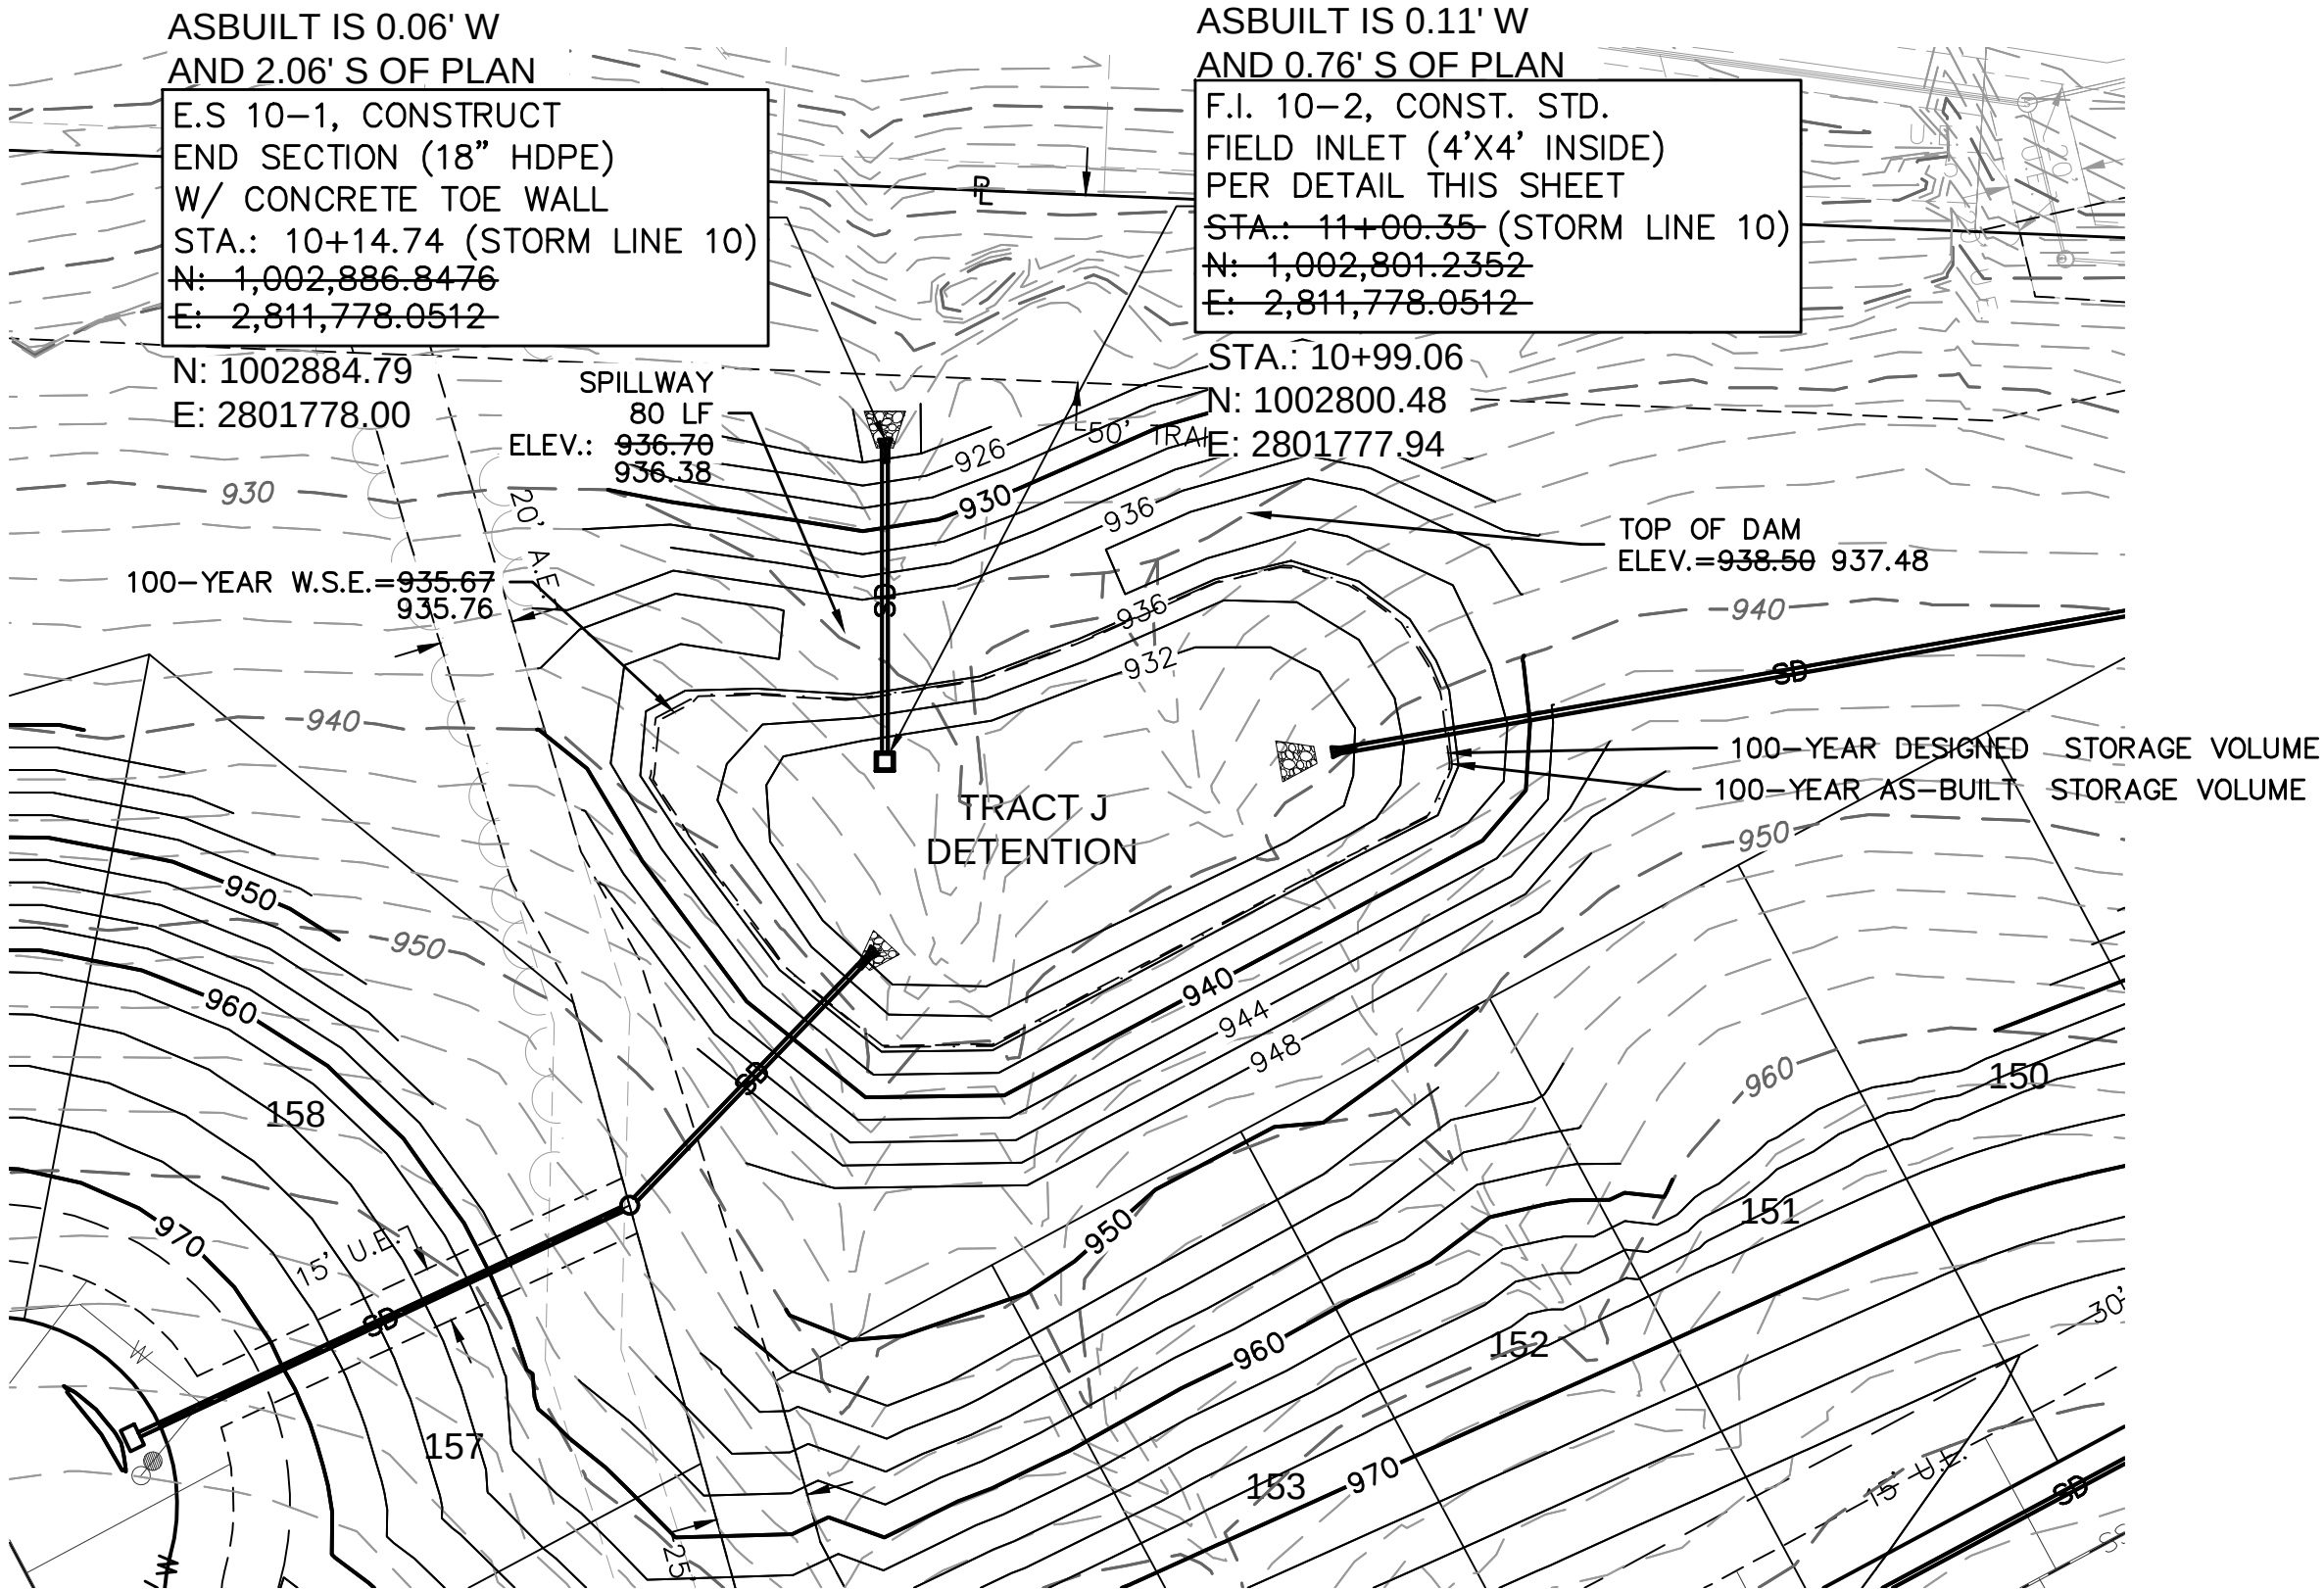

- NOTES:
1. CONTRACTOR SHALL MAINTAIN DRAINAGE DURING CONSTRUCTION AND IS RESPONSIBLE FOR ANY DEWATERING NECESSARY FOR CONSTRUCTION. DEWATERING SHALL BE SUBSIDIARY TO OTHER BID ITEMS.
  2. CONTRACTOR SHALL SUBMIT SHOP DRAWINGS DETAILING THE STRUCTURE DIMENSIONS, INVERTS, AND STRUCTURAL REINFORCEMENT DETAILS ON THE PRINCIPAL SPILLWAY.

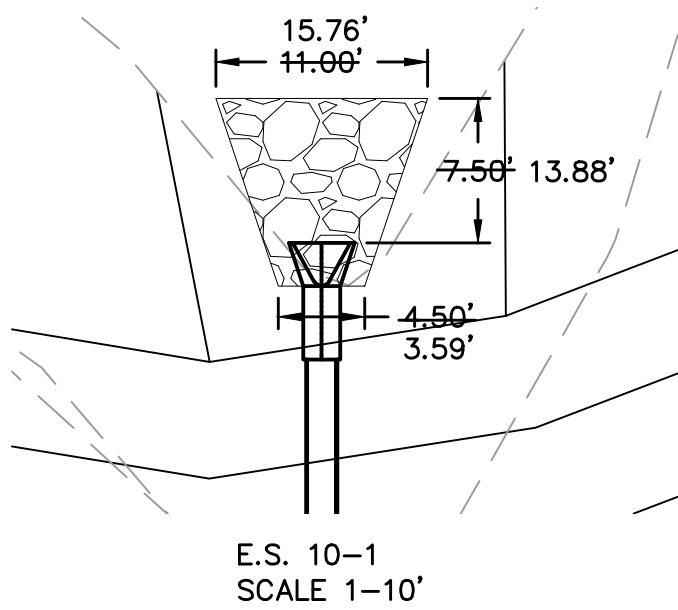

| Riprap Calculations                                      |                           |                          |        |              |                         |                        |
|----------------------------------------------------------|---------------------------|--------------------------|--------|--------------|-------------------------|------------------------|
| End Section                                              | Q <sub>100</sub><br>(cfs) | Pipe<br>Diameter<br>(ft) | Class* | D50*<br>(in) | Apron<br>Length<br>(ft) | Apron<br>Depth<br>(ft) |
| E.S. 10-1                                                | 18.41                     | 1.5                      | 3      | 10           | 7.5                     | 2.00                   |
| *Per Table 10.1 HEC 14-FHWA-Energy Dissipators Pg. 10-18 |                           |                          |        |              |                         | 23.84                  |

ASBUILT  
03-24-2022

DETENTION BASIN PLAN  
STREET & STORM SEWER PLANS

WOODSIDE RIDGE  
SECOND PLAT

LEE'S SUMMIT, MO

drawn by: \_\_\_\_\_ C.S.M.  
checked by: \_\_\_\_\_ S.M.S.  
designed by: \_\_\_\_\_ C.S.M.  
QA/QC by: \_\_\_\_\_ J.E.S.  
project no.: C18-1140  
date: 2020.07.10

SHEET  
C122

REVISIONS DESCRIPTION

NO. REV.

DATE

REVISIONS

2020

olsson



www.olsson.com

NO. 018-1140-001  
300 E. BROADWAY, SUITE 100  
NORTH KANSAS CITY, MO 64116  
TEL. 816.861.1177






KEY MAP

| LEGEND |                                |
|--------|--------------------------------|
|        | FINISHED INDEX CONTOURS        |
|        | FINISHED INTERMEDIATE CONTOURS |
|        | RIDGE LINE                     |
|        | DRAINAGE AREA                  |
|        | RUNOFF COEFFICIENT             |
|        | STORM STRUCTURE NUMBER         |

- NOTES:
1. INDIVIDUAL LOT OWNERS SHALL NOT CHANGE OR OBSTRUCT THE DRAINAGE FLOW LINES OR PATHS ON THE LOTS, AS SHOWN ON THE MASTER DRAINAGE PLAN, UNLESS SPECIFIC APPLICATION IS MADE AND APPROVED BY THE CITY ENGINEER.
  2. PLAT IS LOCATED IN ZONE X, "AREAS OUTSIDE THE 1-PERCENT ANNUAL CHANCE FLOODPLAINS, AREAS OF 1-PERCENT ANNUAL CHANCE SHEET FLOW FLOODING WHERE THE AVERAGE DEPTHS ARE LESS THAN 1 FOOT, AREAS OF 1-PERCENT ANNUAL CHANCE STREAM FLOODING WHERE THE CONTRIBUTING DRAINAGE AREA IS LESS THAN 1 SQUARE MILE, OR AREAS PROTECTED FROM THE 1-PERCENT ANNUAL CHANCE FLOOD BY LEVEES. NO BASE FLOOD ELEVATIONS OR DEPTHS ARE SHOWN WITHIN THIS ZONE"
  3. BUFFER ZONE FOR NATURAL STREAMS IS LOCATED WITHIN PLAT.
  4. MLO ELEVATIONS HAVE BEEN PROVIDED AT EACH LOT CORNER. INTERPOLATION WILL BE ALLOWED BETWEEN CORNER MBOES SHOWN ON THE MASTER DRAINAGE PLAN, DEPENDING ON THE LOCATION OF THE LOWEST OPENING ON THE PROPOSED STRUCTURE.
  5. NO BUILDING PERMITS WILL BE ISSUED UNTIL AN AS-GRADED MASTER DRAINAGE PLAN HAS BEEN SUBMITTED TO THE CITY AND APPROVED BY THE CITY.

NOT ASBUILT

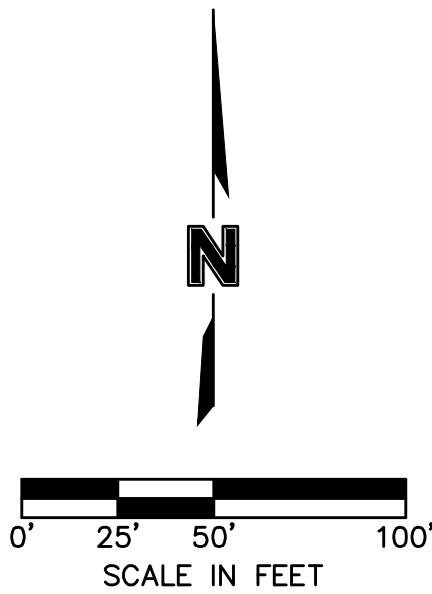

olsson

NO Conflicts of Interest at 03/09/22  
300 E. BURNING TREE BLVD, SUITE 100  
NORTH KANSAS CITY, MO 64116  
TEL 816.861.1177  
www.olson.com

STATE OF MISSOURI  
JULIE ELAINE SELLERS  
NUMBER  
PE-2017000367  
10/27/2022  
APPROVAL

BY  
REVISIONS DESCRIPTION  
NO. REV. DATE  
2020

DRAINAGE PLAN  
STREET & STORM SEWER PLANS  
WOODSIDE RIDGE  
SECOND PLAT  
LEE'S SUMMIT, MO

drawn by: C.S.M.  
checked by: S.M.S.  
designed by: C.S.M.  
QA/QC by: J.E.S.  
project no.: C18-1140  
date: 2020.07.10

SHEET  
C123





| LEGEND                                                                            |                                |
|-----------------------------------------------------------------------------------|--------------------------------|
|  | FINISHED INDEX CONTOURS        |
|  | FINISHED INTERMEDIATE CONTOURS |
|  | RIDGE LINE                     |
| A                                                                                 | DRAINAGE AREA                  |
| C                                                                                 | RUNOFF COEFFICIENT             |
|  | STORM STRUCTURE NUMBER         |

NOTES:  
1. INDIVIDUAL LOT OWNERS SHALL NOT CHANGE OR  
OBSTRUCT THE DRAINAGE FLOW LINES OR PATHS ON  
THE LOTS, AS SHOWN ON THE MASTER DRAINAGE PLAN,  
UNLESS SPECIFIC APPLICATION IS MADE AND APPROVED  
BY THE CITY ENGINEER.



2. PLAT IS LOCATED IN ZONE X, "AREAS OUTSIDE THE 1-PERCENT ANNUAL CHANCE FLOODPLAINS, AREAS OF 1-PERCENT ANNUAL CHANCE SHEET FLOW FLOODING WHERE THE AVERAGE DEPTHS ARE LESS THAN 1 FOOT, AREAS OF 1-PERCENT ANNUAL CHANCE STREAM FLOODING WHERE THE CONTRIBUTING DRAINAGE AREA IS LESS THAN 1 SQUARE MILE, OR AREAS PROTECTED FROM THE 1-PERCENT ANNUAL CHANCE FLOOD BY LEVEES. NO BASE FLOOD ELEVATIONS OR DEPTHS ARE SHOWN WITHIN THIS ZONE"

3. BUFFER ZONE FOR NATURAL STREAMS IS LOCATED WITHIN PLAT.


4. MLO ELEVATIONS HAVE BEEN PROVIDED AT EACH LOT CORNER. INTERPOLATION WILL BE ALLOWED BETWEEN CORNER MBOES SHOWN ON THE MASTER DRAINAGE PLAN, DEPENDING ON THE LOCATION OF THE LOWEST OPENING ON THE PROPOSED STRUCTURE.

5. NO BUILDING PERMITS WILL BE ISSUED UNTIL AN AS-GRADED MASTER DRAINAGE PLAN HAS BEEN SUBMITTED TO THE CITY AND APPROVED BY THE CITY.

NOT ASBUILT

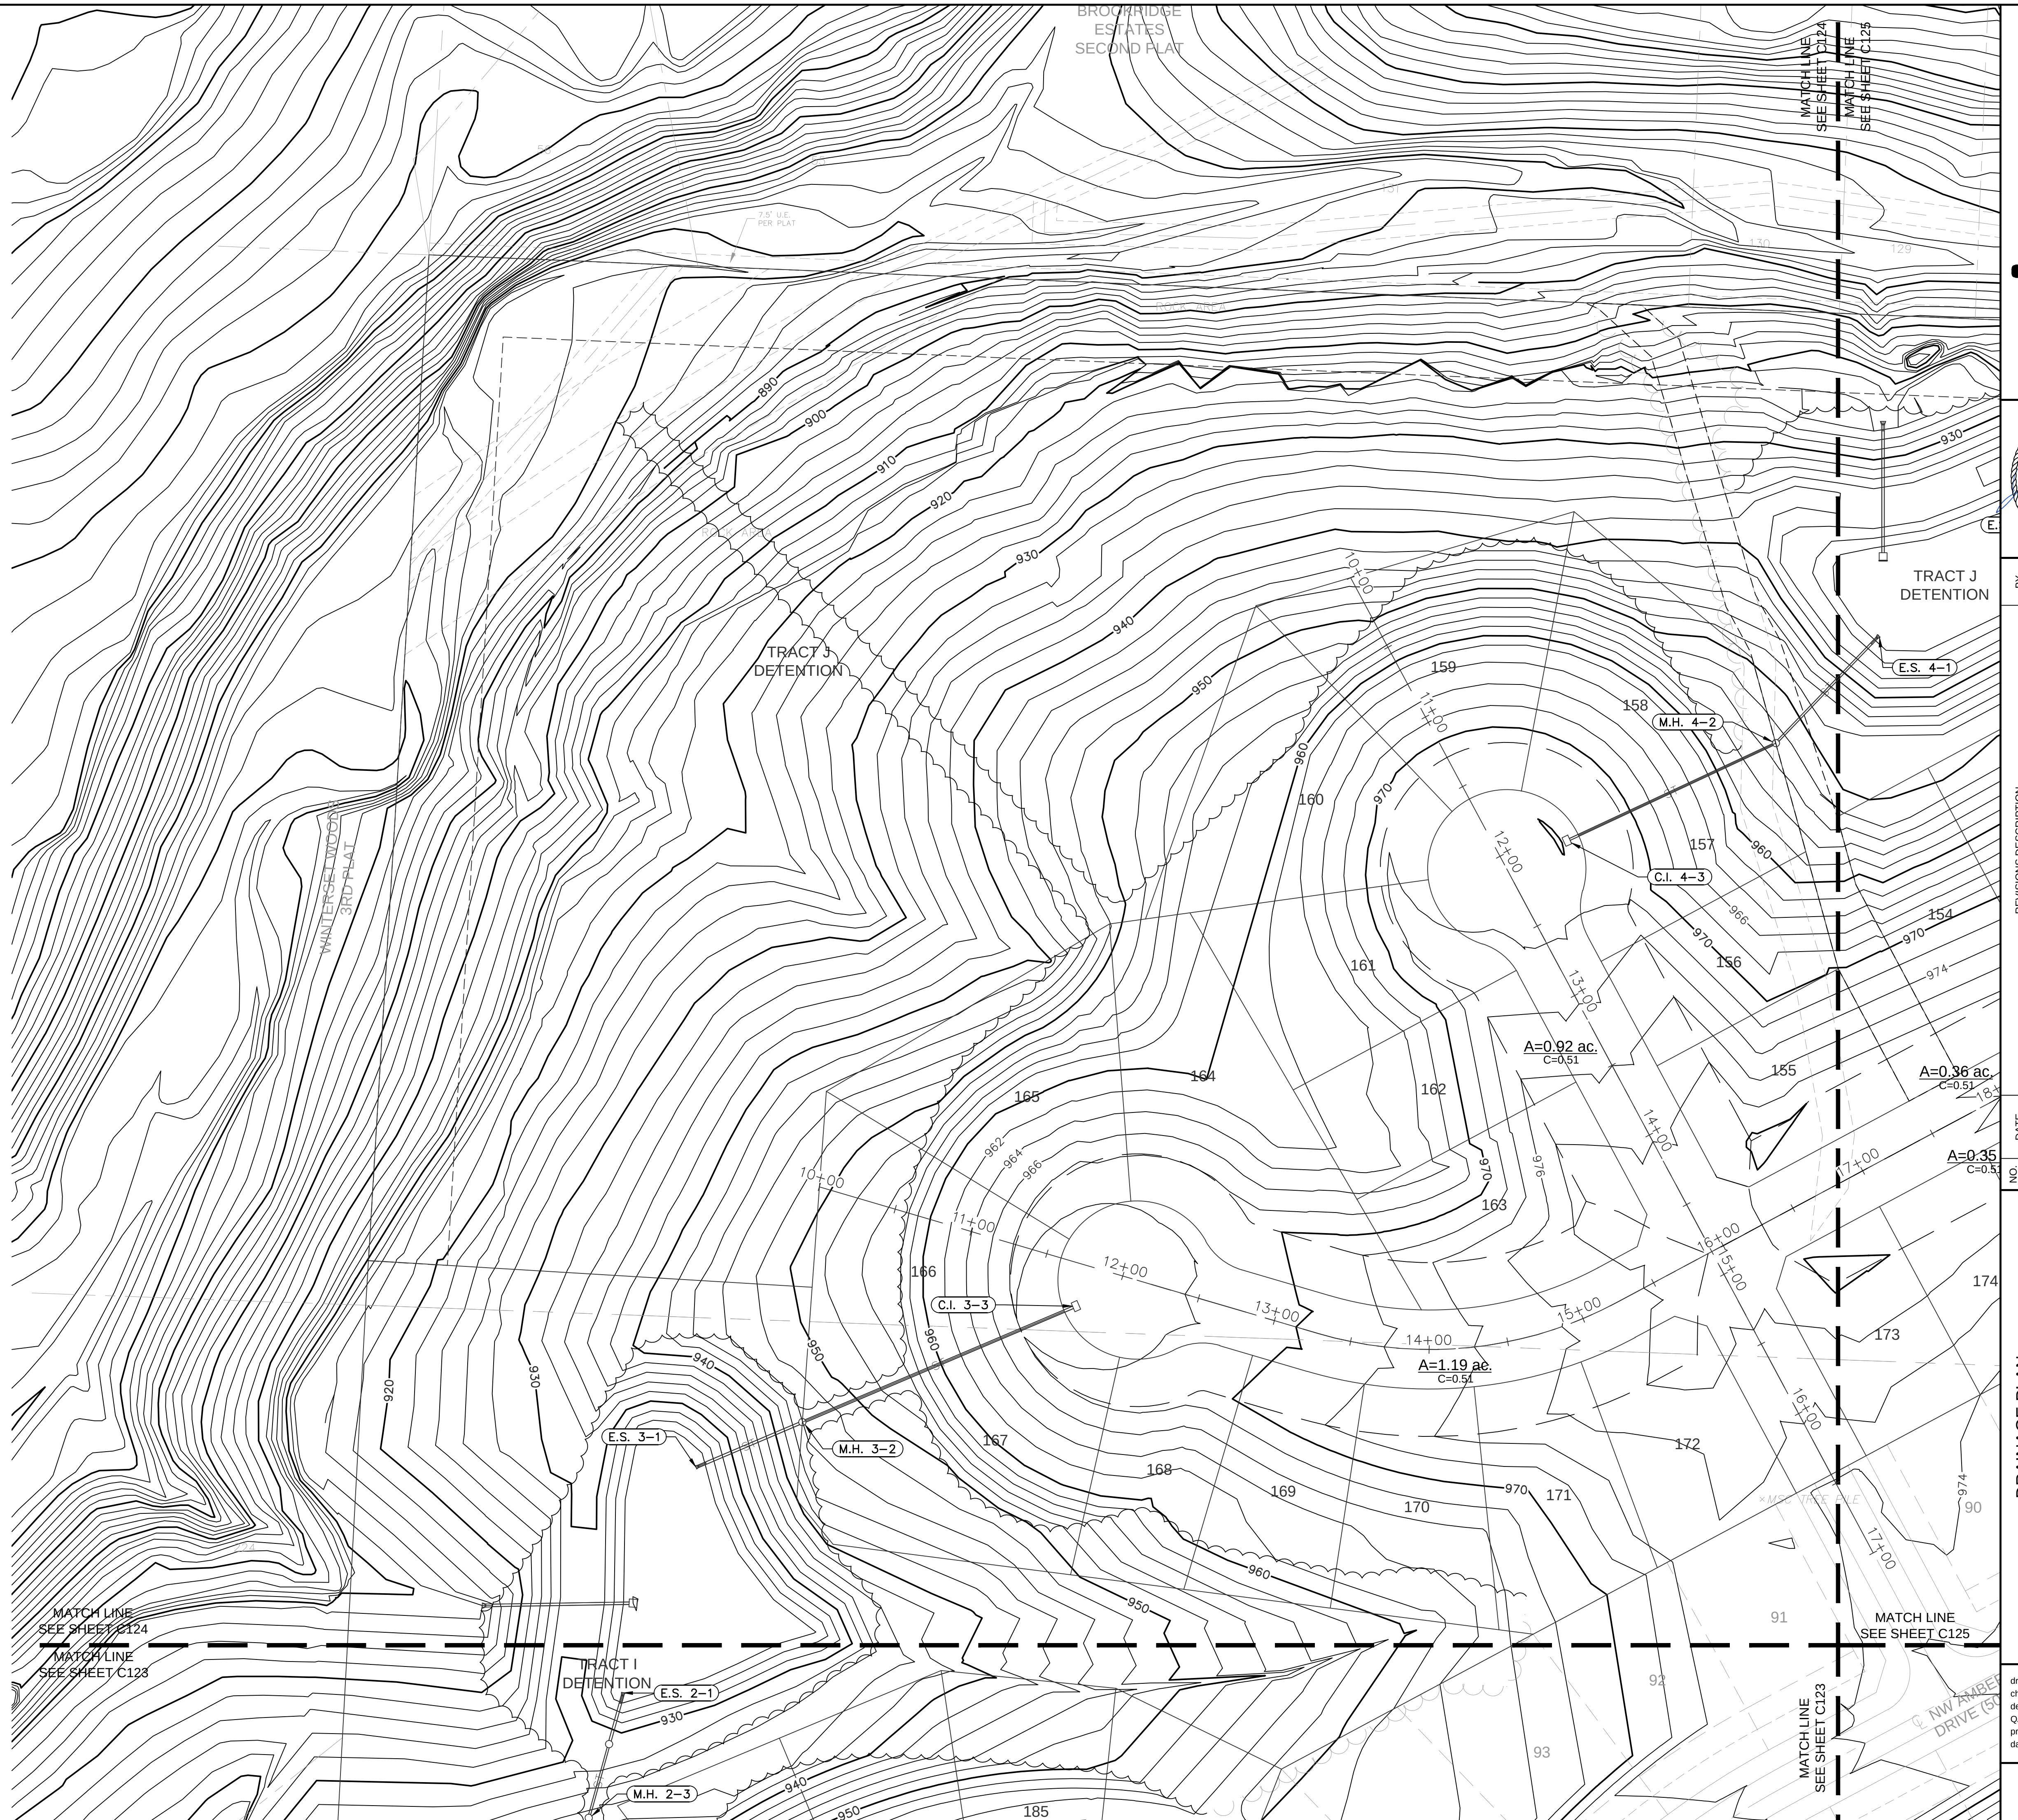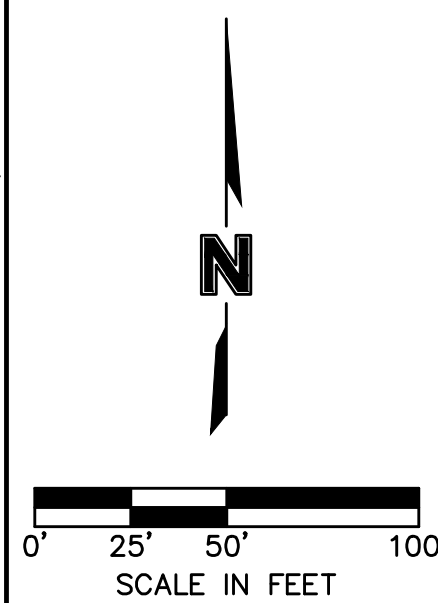

olson

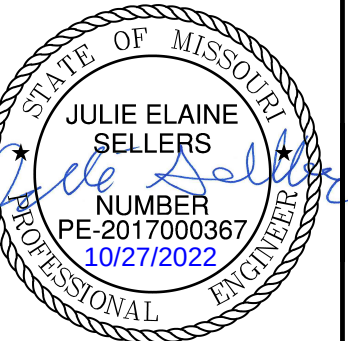[illegible]

WOODSIDE RIDGE  
SECOND PLAT

LEE'S SUMMIT, MO

Drawn by: C.S.M  
 Checked by: S.M.S  
 Designed by: C.S.M  
 A/QC by: J.E.S  
 Project no.: C18-1140  
 Date: 2020.07.10

SHEET  
C124

## REVISIONS

2020

LEE'S SUMMIT, MO

1301 DORLINGTON, SUITE 100  
NORTH KANSAS CITY, MO 64116

TEL 816.361.1177      www.olsson.com





| LEGEND                                                                            |                                |
|-----------------------------------------------------------------------------------|--------------------------------|
|  | FINISHED INDEX CONTOURS        |
|  | FINISHED INTERMEDIATE CONTOURS |
|  | RIDGE LINE                     |
|  | DRAINAGE AREA                  |
|  | RUNOFF COEFFICIENT             |
|  | STORM STRUCTURE NUMBER         |

NOTES:  
1. INDIVIDUAL LOT OWNERS SHALL NOT CHANGE OR OBSTRUCT THE DRAINAGE FLOW LINES OR PATHS ON THE LOTS, AS SHOWN ON THE MASTER DRAINAGE PLAN UNLESS SPECIFIC APPLICATION IS MADE AND APPROVED BY THE CITY ENGINEER.

2. PLAT IS LOCATED IN ZONE X, "AREAS OUTSIDE THE 1-PERCENT ANNUAL CHANCE FLOODPLAINS, AREAS OF 1-PERCENT ANNUAL CHANCE SHEET FLOW FLOODING WHERE THE AVERAGE DEPTHS ARE LESS THAN 1 FOOT, AREAS OF 1-PERCENT ANNUAL CHANCE STREAM FLOODING WHERE THE CONTRIBUTING DRAINAGE AREA IS LESS THAN 1 SQUARE MILE, OR AREAS PROTECTED FROM THE 1-PERCENT ANNUAL CHANCE FLOOD BY LEVEES. NO BASE FLOOD ELEVATIONS OR DEPTHS ARE SHOWN WITHIN THIS ZONE"




3. BUFFER ZONE FOR NATURAL STREAMS IS LOCATED WITHIN PLAT.

4. MLO ELEVATIONS HAVE BEEN PROVIDED AT EACH LOT CORNER. INTERPOLATION WILL BE ALLOWED BETWEEN CORNER MBOES SHOWN ON THE MASTER DRAINAGE PLAN, DEPENDING ON THE LOCATION OF THE LOWEST OPENING ON THE PROPOSED STRUCTURE.

5. NO BUILDING PERMITS WILL BE ISSUED UNTIL AN AS-GRADED MASTER DRAINAGE PLAN HAS BEEN SUBMITTED TO THE CITY AND APPROVED BY THE CITY

DWG: F:\2018\1001-1500\018-1140-C\40-Design\AutoCAD\Final Plans - Asbuilts\Sheets\GNCV\Street & Storm\C\_DRN02\_C181140.dwg

DWG: F:\2018\1001-1500\018-  
DATE: Oct 17, 2022 12:44pm

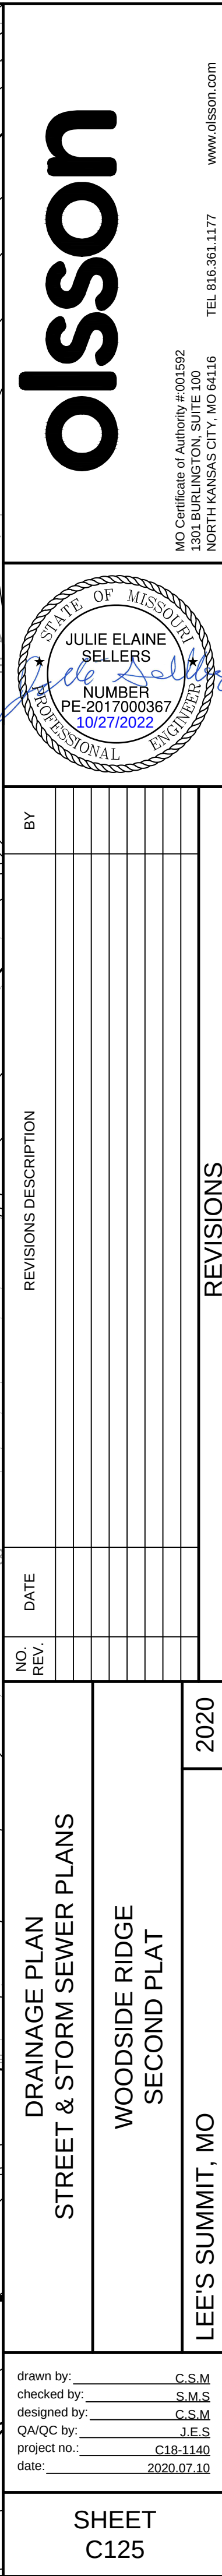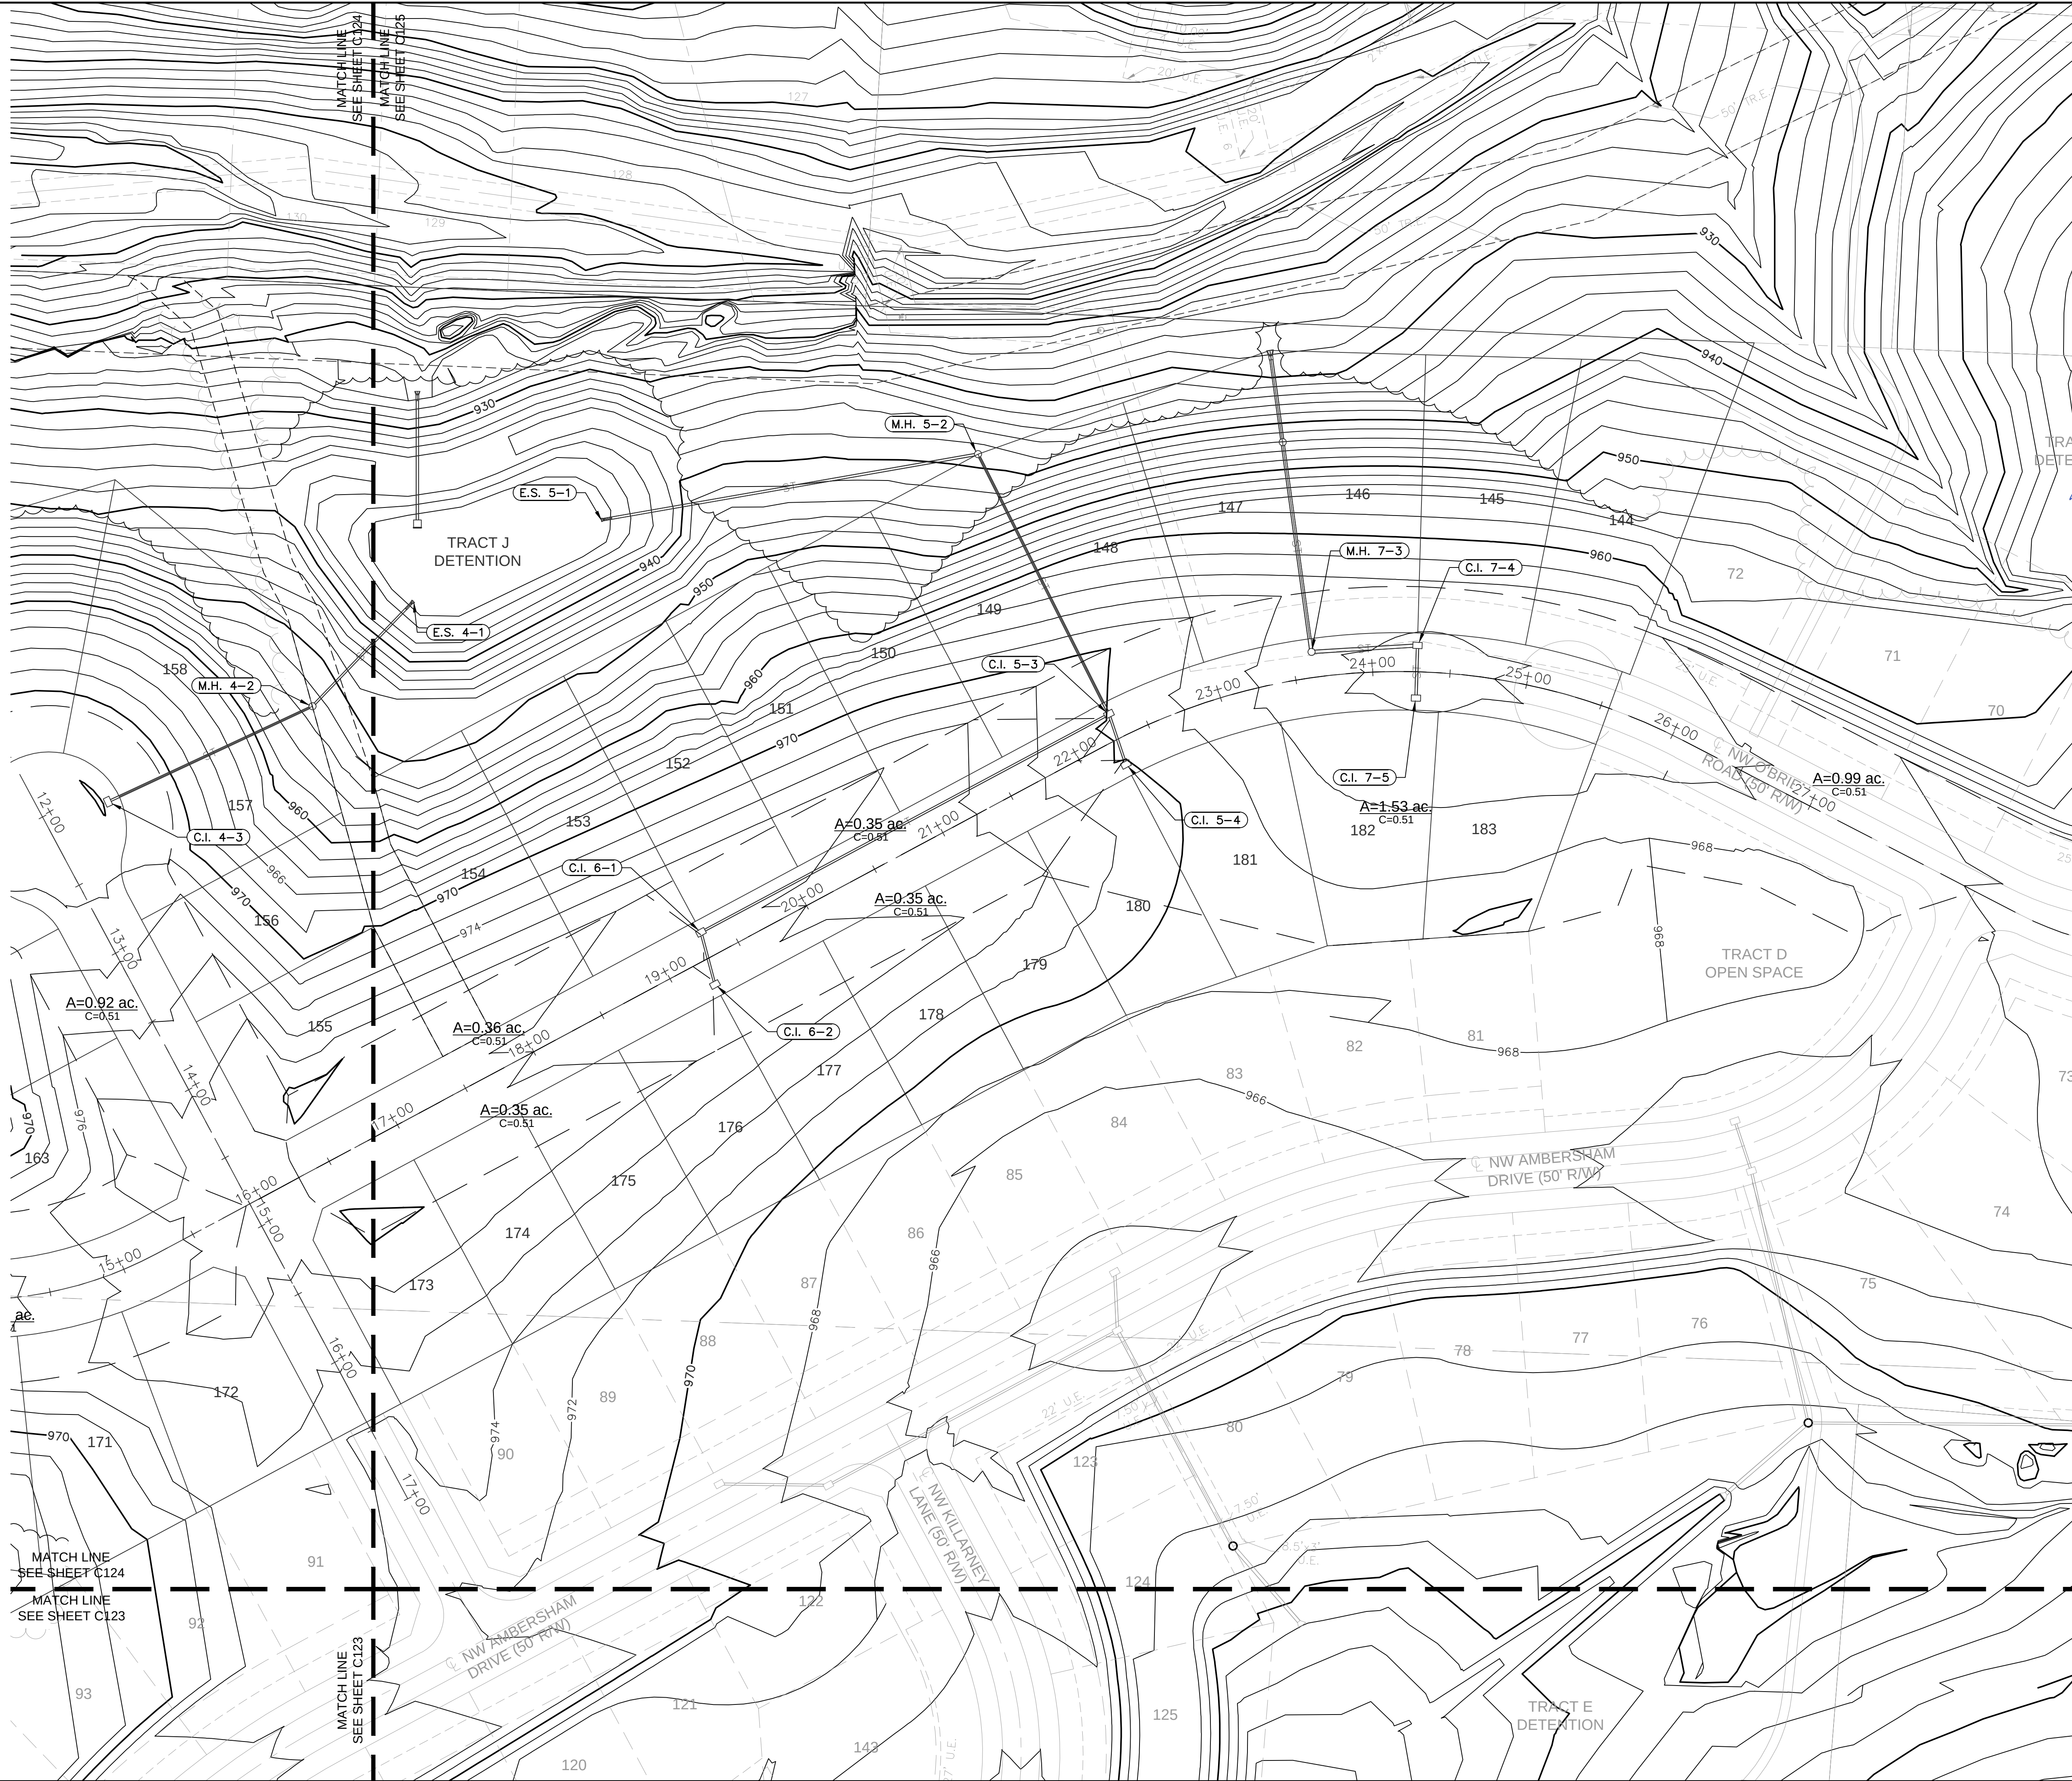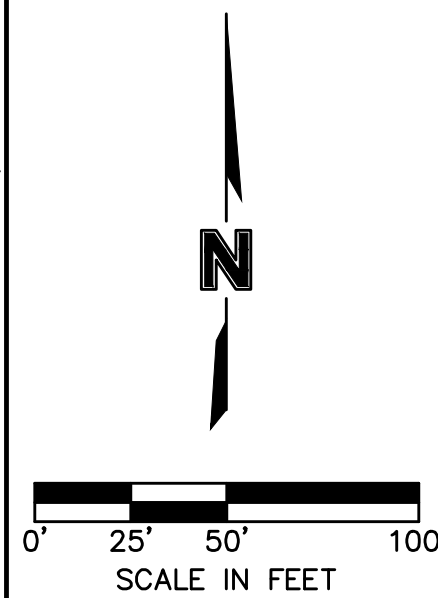[illegible]

|                                             |      |
|---------------------------------------------|------|
| DRAINAGE PLAN<br>STREET & STORM SEWER PLANS |      |
| WOODSIDE RIDGE<br>SECOND PLAT               |      |
| LEE'S SUMMIT, MO                            | 2020 |

drawn by: C.S.M  
checked by: S.M.S  
designed by: C.S.M  
QA/QC by: J.E.S  
project no.: C18-1140  
date: 2020.07.10

SHEET  
C125



| 10 Year Return Frequency |                      |             |                      |                        |           |               |             |                  |                 |                |                 |                           |
|--------------------------|----------------------|-------------|----------------------|------------------------|-----------|---------------|-------------|------------------|-----------------|----------------|-----------------|---------------------------|
| Upstream Structure       | Downstream Structure | Length (ft) | Upstream Invert (ft) | Downstream Invert (ft) | Slope (%) | Diameter (in) | Manning's n | Total Flow (cfs) | Velocity (ft/s) | Capacity (cfs) | Flow Depth (ft) | Upstream Struct. HGL (ft) |
| M.H. 5-2                 | Outfall              | 253.96      | 933.89               | 930.00                 | 1.53      | 18            | 0.012       | 5.48             | 3.60            | 14.08          | 1.50            | 934.95                    |
| C.I. 5-3                 | M.H. 5-2             | 188.19      | 964.02               | 934.29                 | 15.80     | 15            | 0.012       | 5.48             | 6.22            | 27.80          | 0.77            | 964.97                    |
| C.I. 6-1                 | C.I. 5-3             | 299.05      | 971.17               | 964.62                 | 2.19      | 15            | 0.012       | 2.66             | 5.58            | 10.35          | 0.43            | 971.82                    |
| C.I. 6-2                 | C.I. 6-1             | 34.93       | 972.17               | 971.37                 | 2.29      | 15            | 0.012       | 1.31             | 3.27            | 10.59          | 0.45            | 972.62                    |
| C.I. 5-4                 | C.I. 5-3             | 34.40       | 965.30               | 964.62                 | 1.98      | 15            | 0.012       | 1.41             | 4.20            | 9.84           | 0.35            | 965.77                    |
| M.H. 7-2                 | Outfall              | 42.64       | 925.43               | 925.00                 | 1.01      | 24            | 0.012       | 10.22            | 6.48            | 24.61          | 0.90            | 926.57                    |
| M.H. 7-3                 | M.H. 7-2             | 178.96      | 955.95               | 925.75                 | 16.88     | 24            | 0.012       | 10.22            | 6.94            | 100.66         | 0.82            | 957.09                    |
| C.I. 7-4                 | M.H. 7-3             | 68.71       | 957.92               | 956.55                 | 1.99      | 24            | 0.012       | 10.22            | 7.54            | 34.60          | 0.75            | 959.06                    |
| C.I. 7-5                 | C.I. 7-4             | 34.00       | 959.20               | 958.52                 | 2.00      | 18            | 0.012       | 6.12             | 6.82            | 16.09          | 0.64            | 960.15                    |
| M.H. 2-2                 | Outfall              | 33.74       | 922.67               | 922.00                 | 1.99      | 18            | 0.012       | 3.94             | 2.23            | 16.03          | 1.50            | 926.77                    |
| M.H. 2-3                 | M.H. 2-2             | 48.32       | 931.95               | 925.78                 | 12.77     | 15            | 0.012       | 3.94             | 4.20            | 25.00          | 1.02            | 932.75                    |
| C.I. 2-4                 | M.H. 2-3             | 187.22      | 952.46               | 932.55                 | 10.63     | 15            | 0.012       | 3.94             | 9.33            | 22.81          | 0.35            | 953.26                    |
| C.I. 2-5                 | C.I. 2-4             | 34.74       | 954.94               | 953.96                 | 2.82      | 15            | 0.012       | 1.50             | 4.99            | 11.75          | 0.30            | 955.42                    |
| M.H. 4-2                 | Outfall              | 91.51       | 939.15               | 930.00                 | 10.00     | 15            | 0.012       | 3.45             | 3.65            | 22.12          | 1.25            | 939.90                    |
| C.I. 4-3                 | M.H. 4-2             | 145.82      | 964.74               | 948.91                 | 10.86     | 15            | 0.012       | 3.45             | 8.99            | 23.05          | 0.33            | 965.49                    |
| M.H. 1-2                 | Outfall              | 55.95       | 921.68               | 920.00                 | 3.00      | 15            | 0.012       | 4.34             | 3.54            | 12.12          | 1.25            | 924.90                    |
| C.I. 1-3                 | M.H. 1-2             | 156.54      | 946.25               | 935.08                 | 7.14      | 15            | 0.012       | 4.34             | 8.66            | 18.69          | 0.41            | 947.09                    |
| C.I. 1-4                 | C.I. 1-3             | 34.01       | 947.53               | 946.85                 | 2.00      | 15            | 0.012       | 2.27             | 5.21            | 9.89           | 0.41            | 948.13                    |
| M.H. 3-2                 | Outfall              | 73.02       | 923.46               | 922.00                 | 2.00      | 18            | 0.012       | 4.46             | 2.52            | 16.09          | 1.50            | 926.84                    |
| C.I. 3-3                 | M.H. 3-2             | 188.00      | 960.16               | 942.02                 | 9.65      | 18            | 0.012       | 4.46             | 9.13            | 35.34          | 0.36            | 960.87                    |

| 10 Year Return Frequency |                |           |                 |            |                 |                |                             |               |             |                           |              |               |               |
|--------------------------|----------------|-----------|-----------------|------------|-----------------|----------------|-----------------------------|---------------|-------------|---------------------------|--------------|---------------|---------------|
| Inlet ID                 | Inlet Location | Peak Flow | Upstream Bypass | Total Flow | Clogging Factor | Inlet Capacity | Sag Inlet Capacity (Note 1) | Captured Flow | Bypass Flow | Inlet Efficiency (Note 2) | Gutter Depth | Gutter Spread | Ponding Depth |
|                          |                | (cfs)     | (cfs)           | (cfs)      |                 | (cfs)          | (cfs)                       | (cfs)         | (cfs)       | (%)                       | (ft)         | (ft)          | (ft)          |
| C.I. 5-3                 | GRADE          | 1.31      | 0.10            | 1.41       | 1.00            | 1.12           | 1.12                        | 1.12          | 0.29        | 79.64%                    | 0.12         | 5.85          | ...           |
| C.I. 5-4                 | GRADE          | 1.31      | 0.09            | 1.41       | 1.00            | 1.12           | 1.12                        | 1.12          | 0.29        | 79.72%                    | 0.12         | 5.85          | ...           |
| C.I. 6-1                 | GRADE          | 1.35      | 0.00            | 1.35       | 1.00            | 1.25           | 1.25                        | 1.25          | 0.10        | 92.60%                    | 0.15         | 7.46          | ...           |
| C.I. 6-2                 | GRADE          | 1.31      | 0.00            | 1.31       | 1.00            | 1.22           | 1.22                        | 1.22          | 0.09        | 92.83%                    | 0.15         | 7.38          | ...           |
| C.I. 7-4(L)              | SAG            | 0.75      | 0.39            | 1.14       | 0.80            | 19.40          | 15.52                       | 1.14          | 0.00        | 100.00%                   | 0.14         | 6.76          | ...           |
| C.I. 7-4(R)              | SAG            | 2.25      | 0.00            | 2.25       | 0.80            | 19.40          | 15.52                       | 2.25          | 0.00        | 100.00%                   | 0.14         | 6.97          | ...           |
| C.I. 7-4(B)              | SAG            | 0.71      | 0.00            | 0.71       | 0.80            | 19.40          | 15.52                       | 0.71          | 0.00        | 100.00%                   | ...          | ...           | ...           |
| C.I. 7-4                 | SAG            | 3.71      | 0.39            | 4.10       | 0.80            | 19.40          | 15.52                       | 4.10          | 0.00        | 100.00%                   | ...          | ...           | ...           |
| C.I. 7-5(L)              | SAG            | 2.25      | 0.38            | 2.63       | 0.80            | 19.40          | 15.52                       | 2.63          | 0.00        | 100.00%                   | 0.15         | 7.39          | ...           |
| C.I. 7-5(R)              | SAG            | 1.61      | 0.00            | 1.61       | 0.80            | 19.40          | 15.52                       | 1.61          | 0.00        | 100.00%                   | 0.15         | 7.71          | ...           |
| C.I. 7-5(B)              | SAG            | 1.88      | 0.00            | 1.88       | 0.80            | 19.40          | 15.52                       | 1.88          | 0.00        | 100.00%                   | ...          | ...           | ...           |
| C.I. 7-5                 | SAG            | 5.74      | 0.38            | 6.12       | 0.80            | 19.40          | 15.52                       | 6.12          | 0.00        | 100.00%                   | ...          | ...           | ...           |
| C.I. 4-3(L)              | SAG            | 2.29      | 0.00            | 2.29       | 0.80            | 19.40          | 15.52                       | 2.29          | 0.00        | 100.00%                   | 0.14         | 7.13          | ...           |
| C.I. 4-3(R)              | SAG            | 0.53      | 0.00            | 0.53       | 0.80            | 19.40          | 15.52                       | 0.53          | 0.00        | 100.00%                   | 0.10         | 5.03          | ...           |
| C.I. 4-3(B)              | SAG            | 0.64      | 0.00            | 0.64       | 0.80            | 19.40          | 15.52                       | 0.64          | 0.00        | 100.00%                   | ...          | ...           | ...           |
| C.I. 4-3                 | SAG            | 3.45      | 0.00            | 3.45       | 0.80            | 19.40          | 15.52                       | 3.45          | 0.00        | 100.00%                   | ...          | ...           | ...           |
| C.I. 3-3(L)              | SAG            | 1.99      | 0.00            | 1.99       | 0.80            | 19.40          | 15.52                       | 1.99          | 0.00        | 100.00%                   | 0.17         | 8.59          | ...           |
| C.I. 3-3(R)              | SAG            | 1.80      | 0.00            | 1.80       | 0.80            | 19.40          | 15.52                       | 1.80          | 0.00        | 100.00%                   | 0.16         | 7.77          | ...           |
| C.I. 3-3(B)              | SAG            | 0.68      | 0.00            | 0.68       | 0.80            | 19.40          | 15.52                       | 0.68          | 0.00        | 100.00%                   | ...          | ...           | ...           |
| C.I. 3-3                 | SAG            | 4.46      | 0.00            | 4.46       | 0.80            | 19.40          | 15.52                       | 4.46          | 0.00        | 100.00%                   | ...          | ...           | ...           |
| C.I. 2-4                 | GRADE          | 2.44      | 0.00            | 2.44       | 1.00            | 1.93           | 1.93                        | 1.93          | 0.51        | 79.16%                    | 0.17         | 8.26          | ...           |
| C.I. 2-5                 | GRADE          | 1.50      | 0.00            | 1.50       | 1.00            | 1.30           | 1.30                        | 1.30          | 0.20        | 86.81%                    | 0.14         | 6.88          | ...           |
| C.I. 1-3                 | GRADE          | 1.88      | 0.20            | 2.07       | 1.00            | 1.69           | 1.69                        | 1.69          | 0.39        | 81.41%                    | 0.15         | 7.69          | ...           |
| C.I. 1-4                 | GRADE          | 1.76      | 0.51            | 2.27       | 1.00            | 1.81           | 1.81                        | 1.81          | 0.46        | 79.80%                    | 0.16         | 7.96          | ...           |

Notes:

- Inlet capacity at sag location has been reduced by a clogging factor of 0.80, reducing theoretical capacity to 80% capacity, as required per APWA Section 5600. Both theoretical capacity and reduced capacity are shown.
- Inlet efficiency shown in the tables is Captured Flow/Total Flow, denoting the actual percentage of flow captured after the capacity has been reduced to 80% of theoretical capacity.

| Drainage Area Design Table |               |      |       |         |      |           |
|----------------------------|---------------|------|-------|---------|------|-----------|
| 10 Year Return Frequency   |               |      |       |         |      |           |
| Inlet ID                   | Drainage Area | C    | Tc    | i       | K    | Peak Flow |
|                            | (ac)          |      | (min) | (in/hr) |      | (cfs)     |
| C.I. 5-3                   | 0.35          | 0.51 | 5.00  | 7.35    | 1.00 | 1.31      |
| C.I. 5-4                   | 0.35          | 0.51 | 5.00  | 7.35    | 1.00 | 1.31      |
| C.I. 6-1                   | 0.36          | 0.51 | 5.00  | 7.35    | 1.00 | 1.35      |
| C.I. 6-2                   | 0.35          | 0.51 | 5.00  | 7.35    | 1.00 | 1.31      |
| C.I. 7-4(L)                | 0.20          | 0.51 | 5.00  | 7.35    | 1.00 | 0.75      |
| C.I. 7-4(R)                | 0.60          | 0.51 | 5.00  | 7.35    | 1.00 | 2.25      |
| C.I. 7-4(B)                | 0.19          | 0.51 | 5.00  | 7.35    | 1.00 | 0.71      |
| C.I. 7-4                   | 0.99          | 0.51 | 5.00  | 7.35    | 1.00 | 3.71      |
| C.I. 7-5(L)                | 0.60          | 0.51 | 5.00  | 7.35    | 1.00 | 2.25      |
| C.I. 7-5(R)                | 0.43          | 0.51 | 5.00  | 7.35    | 1.00 | 1.61      |
| C.I. 7-5(B)                | 0.50          | 0.51 | 5.00  | 7.35    | 1.00 | 1.88      |
| C.I. 7-5                   | 1.53          | 0.51 | 5.00  | 7.35    | 1.00 | 5.74      |
| C.I. 4-3(L)                | 0.61          | 0.51 | 5.00  | 7.35    | 1.00 | 2.29      |
| C.I. 4-3(R)                | 0.14          | 0.51 | 5.00  | 7.35    | 1.00 | 0.53      |
| C.I. 4-3(B)                | 0.17          | 0.51 | 5.00  | 7.35    | 1.00 | 0.64      |
| C.I. 4-3                   | 0.92          | 0.51 | 5.00  | 7.35    | 1.00 | 3.45      |
| C.I. 3-3(L)                | 0.53          | 0.51 | 5.00  | 7.35    | 1.00 | 1.99      |
| C.I. 3-3(R)                | 0.48          | 0.51 | 5.00  | 7.35    | 1.00 | 1.80      |
| C.I. 3-3(B)                | 0.18          | 0.51 | 5.00  | 7.35    | 1.00 | 0.68      |
| C.I. 3-3                   | 1.19          | 0.51 | 5.00  | 7.35    | 1.00 | 4.46      |
| C.I. 2-4                   | 0.65          | 0.51 | 5.00  | 7.35    | 1.00 | 2.44      |
| C.I. 2-5                   | 0.40          | 0.51 | 5.00  | 7.35    | 1.00 | 1.50      |
| C.I. 1-3                   | 0.50          | 0.51 | 5.00  | 7.35    | 1.00 | 1.88      |
| C.I. 1-4                   | 0.47          | 0.51 | 5.00  | 7.35    | 1.00 | 1.76      |

# NOT ASBUILT

[illegible]



| Storm Sewer Design Calculation Table |                      |             |                      |                        |           |               |             |                  |                 |                |                 |                           |
|--------------------------------------|----------------------|-------------|----------------------|------------------------|-----------|---------------|-------------|------------------|-----------------|----------------|-----------------|---------------------------|
| 100 Year Return Frequency            |                      |             |                      |                        |           |               |             |                  |                 |                |                 |                           |
| Upstream Structure                   | Downstream Structure | Length (ft) | Upstream Invert (ft) | Downstream Invert (ft) | Slope (%) | Diameter (in) | Manning's n | Total Flow (cfs) | Velocity (ft/s) | Capacity (cfs) | Flow Depth (ft) | Upstream Struct. HGL (ft) |
| M.H. 5-2                             | Outfall              | 253.96      | 933.89               | 930.00                 | 1.53      | 18            | 0.012       | 9.89             | 5.60            | 14.08          | 1.50            | 937.59                    |
| C.I. 5-3                             | M.H. 5-2             | 188.19      | 964.02               | 934.29                 | 15.80     | 15            | 0.012       | 9.89             | 8.15            | 27.80          | 1.25            | 965.20 j                  |
| C.I. 6-1                             | C.I. 5-3             | 299.05      | 971.17               | 964.62                 | 2.19      | 15            | 0.012       | 4.67             | 6.65            | 10.35          | 0.59            | 972.05                    |
| C.I. 6-2                             | C.I. 6-1             | 34.93       | 972.17               | 971.37                 | 2.29      | 15            | 0.012       | 2.30             | 3.65            | 10.59          | 0.68            | 972.78 j                  |
| C.I. 5-4                             | C.I. 5-3             | 34.40       | 965.30               | 964.62                 | 1.98      | 15            | 0.012       | 2.60             | 4.36            | 9.84           | 0.58            | 965.95                    |
| M.H. 7-2                             | Outfall              | 42.64       | 925.43               | 925.00                 | 1.01      | 24            | 0.012       | 18.97            | 7.91            | 24.61          | 1.32            | 927.00                    |
| M.H. 7-3                             | M.H. 7-2             | 178.96      | 955.95               | 925.75                 | 16.88     | 24            | 0.012       | 18.97            | 8.21            | 100.66         | 1.25            | 957.52                    |
| C.I. 7-4                             | M.H. 7-3             | 68.71       | 957.92               | 956.55                 | 1.99      | 24            | 0.012       | 18.97            | 9.23            | 34.60          | 1.06            | 959.49                    |
| C.I. 7-5                             | C.I. 7-4             | 34.00       | 959.20               | 958.52                 | 2.00      | 18            | 0.012       | 11.25            | 8.18            | 16.09          | 0.97            | 960.48                    |
| M.H. 2-2                             | Outfall              | 33.74       | 922.67               | 922.00                 | 1.99      | 18            | 0.012       | 6.91             | 3.91            | 16.03          | 1.50            | 928.66                    |
| M.H. 2-3                             | M.H. 2-2             | 48.32       | 931.95               | 925.78                 | 12.77     | 15            | 0.012       | 6.91             | 5.95            | 25.00          | 1.25            | 933.00 j                  |
| C.I. 2-4                             | M.H. 2-3             | 187.22      | 952.46               | 932.55                 | 10.63     | 15            | 0.012       | 6.91             | 11.27           | 22.81          | 0.47            | 953.51                    |
| C.I. 2-5                             | C.I. 2-4             | 34.74       | 954.94               | 953.96                 | 2.82      | 15            | 0.012       | 2.63             | 5.90            | 11.75          | 0.40            | 955.59                    |
| M.H. 4-2                             | Outfall              | 91.51       | 939.15               | 930.00                 | 10.00     | 15            | 0.012       | 6.05             | 5.36            | 22.12          | 1.25            | 940.14 j                  |
| C.I. 4-3                             | M.H. 4-2             | 145.82      | 964.74               | 948.91                 | 10.86     | 15            | 0.012       | 6.05             | 10.80           | 23.05          | 0.44            | 965.73                    |
| M.H. 1-2                             | Outfall              | 55.95       | 921.68               | 920.00                 | 3.00      | 15            | 0.012       | 8.40             | 6.85            | 12.12          | 1.25            | 927.29                    |
| C.I. 1-3                             | M.H. 1-2             | 156.54      | 946.25               | 935.08                 | 7.14      | 15            | 0.012       | 8.40             | 11.00           | 18.69          | 0.59            | 947.38                    |
| C.I. 1-4                             | C.I. 1-3             | 34.01       | 947.53               | 946.85                 | 2.00      | 15            | 0.012       | 4.52             | 6.44            | 9.89           | 0.59            | 948.39                    |
| M.H. 3-2                             | Outfall              | 73.02       | 923.46               | 922.00                 | 2.00      | 18            | 0.012       | 7.83             | 4.43            | 16.09          | 1.50            | 928.89                    |
| C.I. 3-3                             | M.H. 3-2             | 188.00      | 960.16               | 942.02                 | 9.65      | 18            | 0.012       | 7.83             | 10.90           | 35.34          | 0.48            | 961.24                    |

| Inlet Design Table        |                |           |                 |            |                 |                |                             |               |             |                           |              |               |               |
|---------------------------|----------------|-----------|-----------------|------------|-----------------|----------------|-----------------------------|---------------|-------------|---------------------------|--------------|---------------|---------------|
| 100 Year Return Frequency |                |           |                 |            |                 |                |                             |               |             |                           |              |               |               |
| Inlet ID                  | Inlet Location | Peak Flow | Upstream Bypass | Total Flow | Clogging Factor | Inlet Capacity | Sag Inlet Capacity (Note 1) | Captured Flow | Bypass Flow | Inlet Efficiency (Note 2) | Gutter Depth | Gutter Spread | Ponding Depth |
|                           |                | (cfs)     | (cfs)           | (cfs)      |                 | (cfs)          | (cfs)                       | (cfs)         | (cfs)       | (%)                       | (ft)         | (ft)          | (ft)          |
| C.I. 5-3                  | GRADE          | 2.30      | 0.31            | 2.62       | 1.00            | 1.73           | 1.73                        | 1.73          | 0.89        | 65.92%                    | 0.15         | 7.38          | ...           |
| C.I. 5-4                  | GRADE          | 2.30      | 0.30            | 2.60       | 1.00            | 1.72           | 1.72                        | 1.72          | 0.88        | 66.09%                    | 0.15         | 7.36          | ...           |
| C.I. 6-1                  | GRADE          | 2.37      | 0.00            | 2.37       | 1.00            | 2.05           | 2.05                        | 2.05          | 0.31        | 86.71%                    | 0.18         | 9.21          | ...           |
| C.I. 6-2                  | GRADE          | 2.30      | 0.00            | 2.30       | 1.00            | 2.01           | 2.01                        | 2.01          | 0.30        | 87.07%                    | 0.18         | 9.12          | ...           |
| C.I. 7-4(L)               | SAG            | 1.32      | 1.21            | 2.52       | 0.80            | 19.40          | 15.52                       | 2.52          | 0.00        | 100.00%                   | 0.18         | 9.12          | ...           |
| C.I. 7-4(R)               | SAG            | 3.95      | 0.00            | 3.95       | 0.80            | 19.40          | 15.52                       | 3.95          | 0.00        | 100.00%                   | 0.17         | 8.61          | ...           |
| C.I. 7-4(B)               | SAG            | 1.25      | 0.00            | 1.25       | 0.80            | 19.40          | 15.52                       | 1.25          | 0.00        | 100.00%                   | ...          | ...           | ...           |
| C.I. 7-4                  | SAG            | 6.51      | 1.21            | 7.72       | 0.80            | 19.40          | 15.52                       | 7.72          | 0.00        | 100.00%                   | ...          | ...           | ...           |
| C.I. 7-5(L)               | SAG            | 3.95      | 1.18            | 5.13       | 0.80            | 19.40          | 15.52                       | 5.13          | 0.00        | 100.00%                   | 0.19         | 9.49          | ...           |
| C.I. 7-5(R)               | SAG            | 2.83      | 0.00            | 2.83       | 0.80            | 19.40          | 15.52                       | 2.83          | 0.00        | 100.00%                   | 0.19         | 9.52          | ...           |
| C.I. 7-5(B)               | SAG            | 3.29      | 0.00            | 3.29       | 0.80            | 19.40          | 15.52                       | 3.29          | 0.00        | 100.00%                   | ...          | ...           | ...           |
| C.I. 7-5                  | SAG            | 10.07     | 1.18            | 11.25      | 0.80            | 19.40          | 15.52                       | 11.25         | 0.00        | 100.00%                   | ...          | ...           | ...           |
| C.I. 4-3(L)               | SAG            | 4.01      | 0.00            | 4.01       | 0.80            | 19.40          | 15.52                       | 4.01          | 0.00        | 100.00%                   | 0.18         | 8.80          | ...           |
| C.I. 4-3(R)               | SAG            | 0.92      | 0.00            | 0.92       | 0.80            | 19.40          | 15.52                       | 0.92          | 0.00        | 100.00%                   | 0.12         | 6.21          | ...           |
| C.I. 4-3(B)               | SAG            | 1.12      | 0.00            | 1.12       | 0.80            | 19.40          | 15.52                       | 1.12          | 0.00        | 100.00%                   | ...          | ...           | ...           |
| C.I. 4-3                  | SAG            | 6.05      | 0.00            | 6.05       | 0.80            | 19.40          | 15.52                       | 6.05          | 0.00        | 100.00%                   | ...          | ...           | ...           |
| C.I. 3-3(L)               | SAG            | 3.49      | 0.00            | 3.49       | 0.80            | 19.40          | 15.52                       | 3.49          | 0.00        | 100.00%                   | 0.21         | 10.61         | ...           |
| C.I. 3-3(R)               | SAG            | 3.16      | 0.00            | 3.16       | 0.80            | 19.40          | 15.52                       | 3.16          | 0.00        | 100.00%                   | 0.19         | 9.60          | ...           |
| C.I. 3-3(B)               | SAG            | 1.18      | 0.00            | 1.18       | 0.80            | 19.40          | 15.52                       | 1.18          | 0.00        | 100.00%                   | ...          | ...           | ...           |
| C.I. 3-3                  | SAG            | 7.83      | 0.00            | 7.83       | 0.80            | 19.40          | 15.52                       | 7.83          | 0.00        | 100.00%                   | ...          | ...           | ...           |
| C.I. 2-4                  | GRADE          | 4.28      | 0.00            | 4.28       | 1.00            | 2.85           | 2.85                        | 2.85          | 1.43        | 66.66%                    | 0.20         | 10.19         | ...           |
| C.I. 2-5                  | GRADE          | 2.63      | 0.00            | 2.63       | 1.00            | 2.04           | 2.04                        | 2.04          | 0.59        | 77.68%                    | 0.17         | 8.50          | ...           |
| C.I. 1-3                  | GRADE          | 3.29      | 0.59            | 3.88       | 1.00            | 2.65           | 2.65                        | 2.65          | 1.23        | 68.23%                    | 0.19         | 9.73          | ...           |
| C.I. 1-4                  | GRADE          | 3.09      | 1.43            | 4.52       | 1.00            | 2.90           | 2.90                        | 2.90          | 1.61        | 64.28%                    | 0.21         | 10.31         | ...           |

Notes:  
1. Inlet capacity at sag location has been reduced by a clogging factor of 0.80, reducing theoretical capacity to 80% capacity, as required per APWA Section 5600. Both theoretical capacity and reduced capacity are shown.  
2. Inlet efficiency shown in the tables is Captured Flow/Total Flow, denoting the actual percentage of flow captured after the capacity has been reduced to 80% of theoretical capacity.

| Drainage Area Design Table |               |      |       |         |      |           |
|----------------------------|---------------|------|-------|---------|------|-----------|
| 100 Year Return Frequency  |               |      |       |         |      |           |
| Inlet ID                   | Drainage Area | C    | Tc    | i       | K    | Peak Flow |
|                            | (ac)          |      | (min) | (in/hr) |      | (cfs)     |
| C.I. 5-3                   | 0.35          | 0.51 | 5.00  | 10.32   | 1.25 | 2.30      |
| C.I. 5-4                   | 0.35          | 0.51 | 5.00  | 10.32   | 1.25 | 2.30      |
| C.I. 6-1                   | 0.36          | 0.51 | 5.00  | 10.32   | 1.25 | 2.37      |
| C.I. 6-2                   | 0.35          | 0.51 | 5.00  | 10.32   | 1.25 | 2.30      |
| C.I. 7-4(L)                | 0.20          | 0.51 | 5.00  | 10.32   | 1.25 | 1.32      |
| C.I. 7-4(R)                | 0.60          | 0.51 | 5.00  | 10.32   | 1.25 | 3.95      |
| C.I. 7-4(B)                | 0.19          | 0.51 | 5.00  | 10.32   | 1.25 | 1.25      |
| C.I. 7-4                   | 0.99          | 0.51 | 5.00  | 10.32   | 1.25 | 6.51      |
| C.I. 7-5(L)                | 0.60          | 0.51 | 5.00  | 10.32   | 1.25 | 3.95      |
| C.I. 7-5(R)                | 0.43          | 0.51 | 5.00  | 10.32   | 1.25 | 2.83      |
| C.I. 7-5(B)                | 0.50          | 0.51 | 5.00  | 10.32   | 1.25 | 3.29      |
| C.I. 7-5                   | 1.53          | 0.51 | 5.00  | 10.32   | 1.25 | 10.07     |
| C.I. 4-3(L)                | 0.61          | 0.51 | 5.00  | 10.32   | 1.25 | 4.01      |
| C.I. 4-3(R)                | 0.14          | 0.51 | 5.00  | 10.32   | 1.25 | 0.92      |
| C.I. 4-3(B)                | 0.17          | 0.51 | 5.00  | 10.32   | 1.25 | 1.12      |
| C.I. 4-3                   | 0.92          | 0.51 | 5.00  | 10.32   | 1.25 | 6.05      |
| C.I. 3-3(L)                | 0.53          | 0.51 | 5.00  | 10.32   | 1.25 | 3.49      |
| C.I. 3-3(R)                | 0.48          | 0.51 | 5.00  | 10.32   | 1.25 | 3.16      |
| C.I. 3-3(B)                | 0.18          | 0.51 | 5.00  | 10.32   | 1.25 | 1.18      |
| C.I. 3-3                   | 1.19          | 0.51 | 5.00  | 10.32   | 1.25 | 7.83      |
| C.I. 2-4                   | 0.65          | 0.51 | 5.00  | 10.32   | 1.25 | 4.28      |
| C.I. 2-5                   | 0.40          | 0.51 | 5.00  | 10.32   | 1.25 | 2.63      |
| C.I. 1-3                   | 0.50          | 0.51 | 5.00  | 10.32   | 1.25 | 3.29      |
| C.I. 1-4                   | 0.47          | 0.51 | 5.00  | 10.32   | 1.25 | 3.09      |

100 YEAR DRAINAGE TABLES  
STREET & STORM SEWER PLANS

WOODSIDE RIDGE  
SECOND PLAT

LEE'S SUMMIT, MO

2020

BY

NO. REV. 2

DATE 3/16/2021

REVISIONS DESCRIPTION

REVISED PER CONTRACTOR COMMENT

REVISIONS

drawn by: \_\_\_\_\_ C.S.M  
checked by: \_\_\_\_\_ S.M.S  
designed by: \_\_\_\_\_ C.S.M  
QA/QC by: \_\_\_\_\_ J.E.S  
project no.: C18-1140  
date: 2020.07.10

SHEET C127



olsson

NO. 00000001 of Authority # 001692  
303 EUPHROSINE AVENUE, SUITE 100  
NORTH KANSAS CITY, MO 64116  
www.olsson.com  
TEL. 816.861.1177

NOT ASBUILT



USER: ssaylor

DWG: F:\2018\1001-1500\018-1140-C\40-Design\AutoCAD\Final Plans - Asbuilt\Sheets\GNCV\Street & Storm\C\_MDR02-C181140.dwg  
DATE: Oct 17, 2022 12:45pm



#### KEY MAP

| Woodside Ridge Second Plat<br>Minimum Building Opening Elevation |                   |                       |                                   |  |
|------------------------------------------------------------------|-------------------|-----------------------|-----------------------------------|--|
| Lot                                                              | Rear Left<br>MBOE | Rear<br>Right<br>MBOE | As Built<br>Plot Plan<br>Required |  |
| 149                                                              | 945.25            | 938.92                | Y                                 |  |
| 150                                                              | 952.25            | 945.25                | Y                                 |  |
| 151                                                              | 950.78            | 952.25                | Y                                 |  |
| 152                                                              | 950.23            | 950.78                | Y                                 |  |
| 153                                                              | 950.56            | 950.23                | Y                                 |  |
| 154                                                              | 953.80            | 950.56                | Y                                 |  |
| 155                                                              | 970.20            | 979.35                | Y                                 |  |
| 156                                                              | 957.42            | 970.20                | Y                                 |  |
| 157                                                              | 953.53            | 957.42                | Y                                 |  |
| 158                                                              | 937.69            | 953.53                | Y                                 |  |
| 166                                                              | 948.97            | 945.09                | Y                                 |  |
| 167                                                              | 952.18            | 948.97                | Y                                 |  |
| 168                                                              | 959.64            | 952.18                | Y                                 |  |
| 169                                                              | 961.17            | 959.64                | Y                                 |  |
| 170                                                              | 965.96            | 961.17                | Y                                 |  |
| 184                                                              | 947.98            | 959.19                | Y                                 |  |
| 185                                                              | 937.74            | 947.98                | Y                                 |  |
| 186                                                              | 934.36            | 937.74                | Y                                 |  |
| 187                                                              | 936.96            | 934.36                | Y                                 |  |
| 192                                                              | 939.85            | 934.23                | Y                                 |  |
| 193                                                              | 941.51            | 939.85                | Y                                 |  |
| 194                                                              | 945.79            | 941.51                | Y                                 |  |
| 195                                                              | 947.41            | 945.79                | Y                                 |  |
| 196                                                              | 950.30            | 947.41                | Y                                 |  |
| 197                                                              | 951.37            | 950.30                | Y                                 |  |
| 198                                                              | 952.90            | 951.37                | Y                                 |  |


MBOE elevations have been provided per lot lines, facing the lot from the street. Interpolation will be allowed between the right and left side MBOE's provided, depending on the location of the lowest opening on the proposed structure.

#### NOTES:

- INDIVIDUAL LOT OWNERS SHALL NOT CHANGE OR OBSTRUCT THE DRAINAGE FLOW LINES OR PATHS ON THE LOTS, AS SHOWN ON THE MASTER DRAINAGE PLAN, UNLESS SPECIFIC APPLICATION IS MADE AND APPROVED BY THE CITY ENGINEER.
- PLAT IS LOCATED IN ZONE X, "AREAS OUTSIDE THE 1-PERCENT ANNUAL CHANCE FLOODPLAINS, AREAS OF 1-PERCENT ANNUAL CHANCE SHEET FLOW FLOODING WHERE THE AVERAGE DEPTHS ARE LESS THAN 1 FOOT, AREAS OF 1-PERCENT ANNUAL CHANCE STREAM FLOODING WHERE THE CONTRIBUTING DRAINAGE AREA IS LESS THAN 1 SQUARE MILE, OR AREAS PROTECTED FROM THE 1-PERCENT ANNUAL CHANCE FLOOD BY LEVEES. NO BASE FLOOD ELEVATIONS OR DEPTHS ARE SHOWN WITHIN THIS ZONE"
- BUFFER ZONE FOR NATURAL STREAMS IS LOCATED WITHIN PLAT.
- MBOE ELEVATIONS HAVE BEEN PROVIDED AT EACH LOT CORNER. INTERPOLATION WILL BE ALLOWED BETWEEN CORNER MBOES SHOWN ON THE MASTER DRAINAGE PLAN, DEPENDING ON THE LOCATION OF THE LOWEST OPENING ON THE PROPOSED STRUCTURE.
- NO BUILDING PERMITS WILL BE ISSUED UNTIL AN AS-GRADED MASTER DRAINAGE PLAN HAS BEEN SUBMITTED TO THE CITY AND APPROVED BY THE CITY.

RMBOE - REAR MINIMUM BUILDING OPENING ELEVATION  
FMBOE - FRONT MINIMUM BUILDING OPENING ELEVATION


LOT TYPES:  
S - STANDARD  
D - DAYLIGHT  
W - WALKOUT

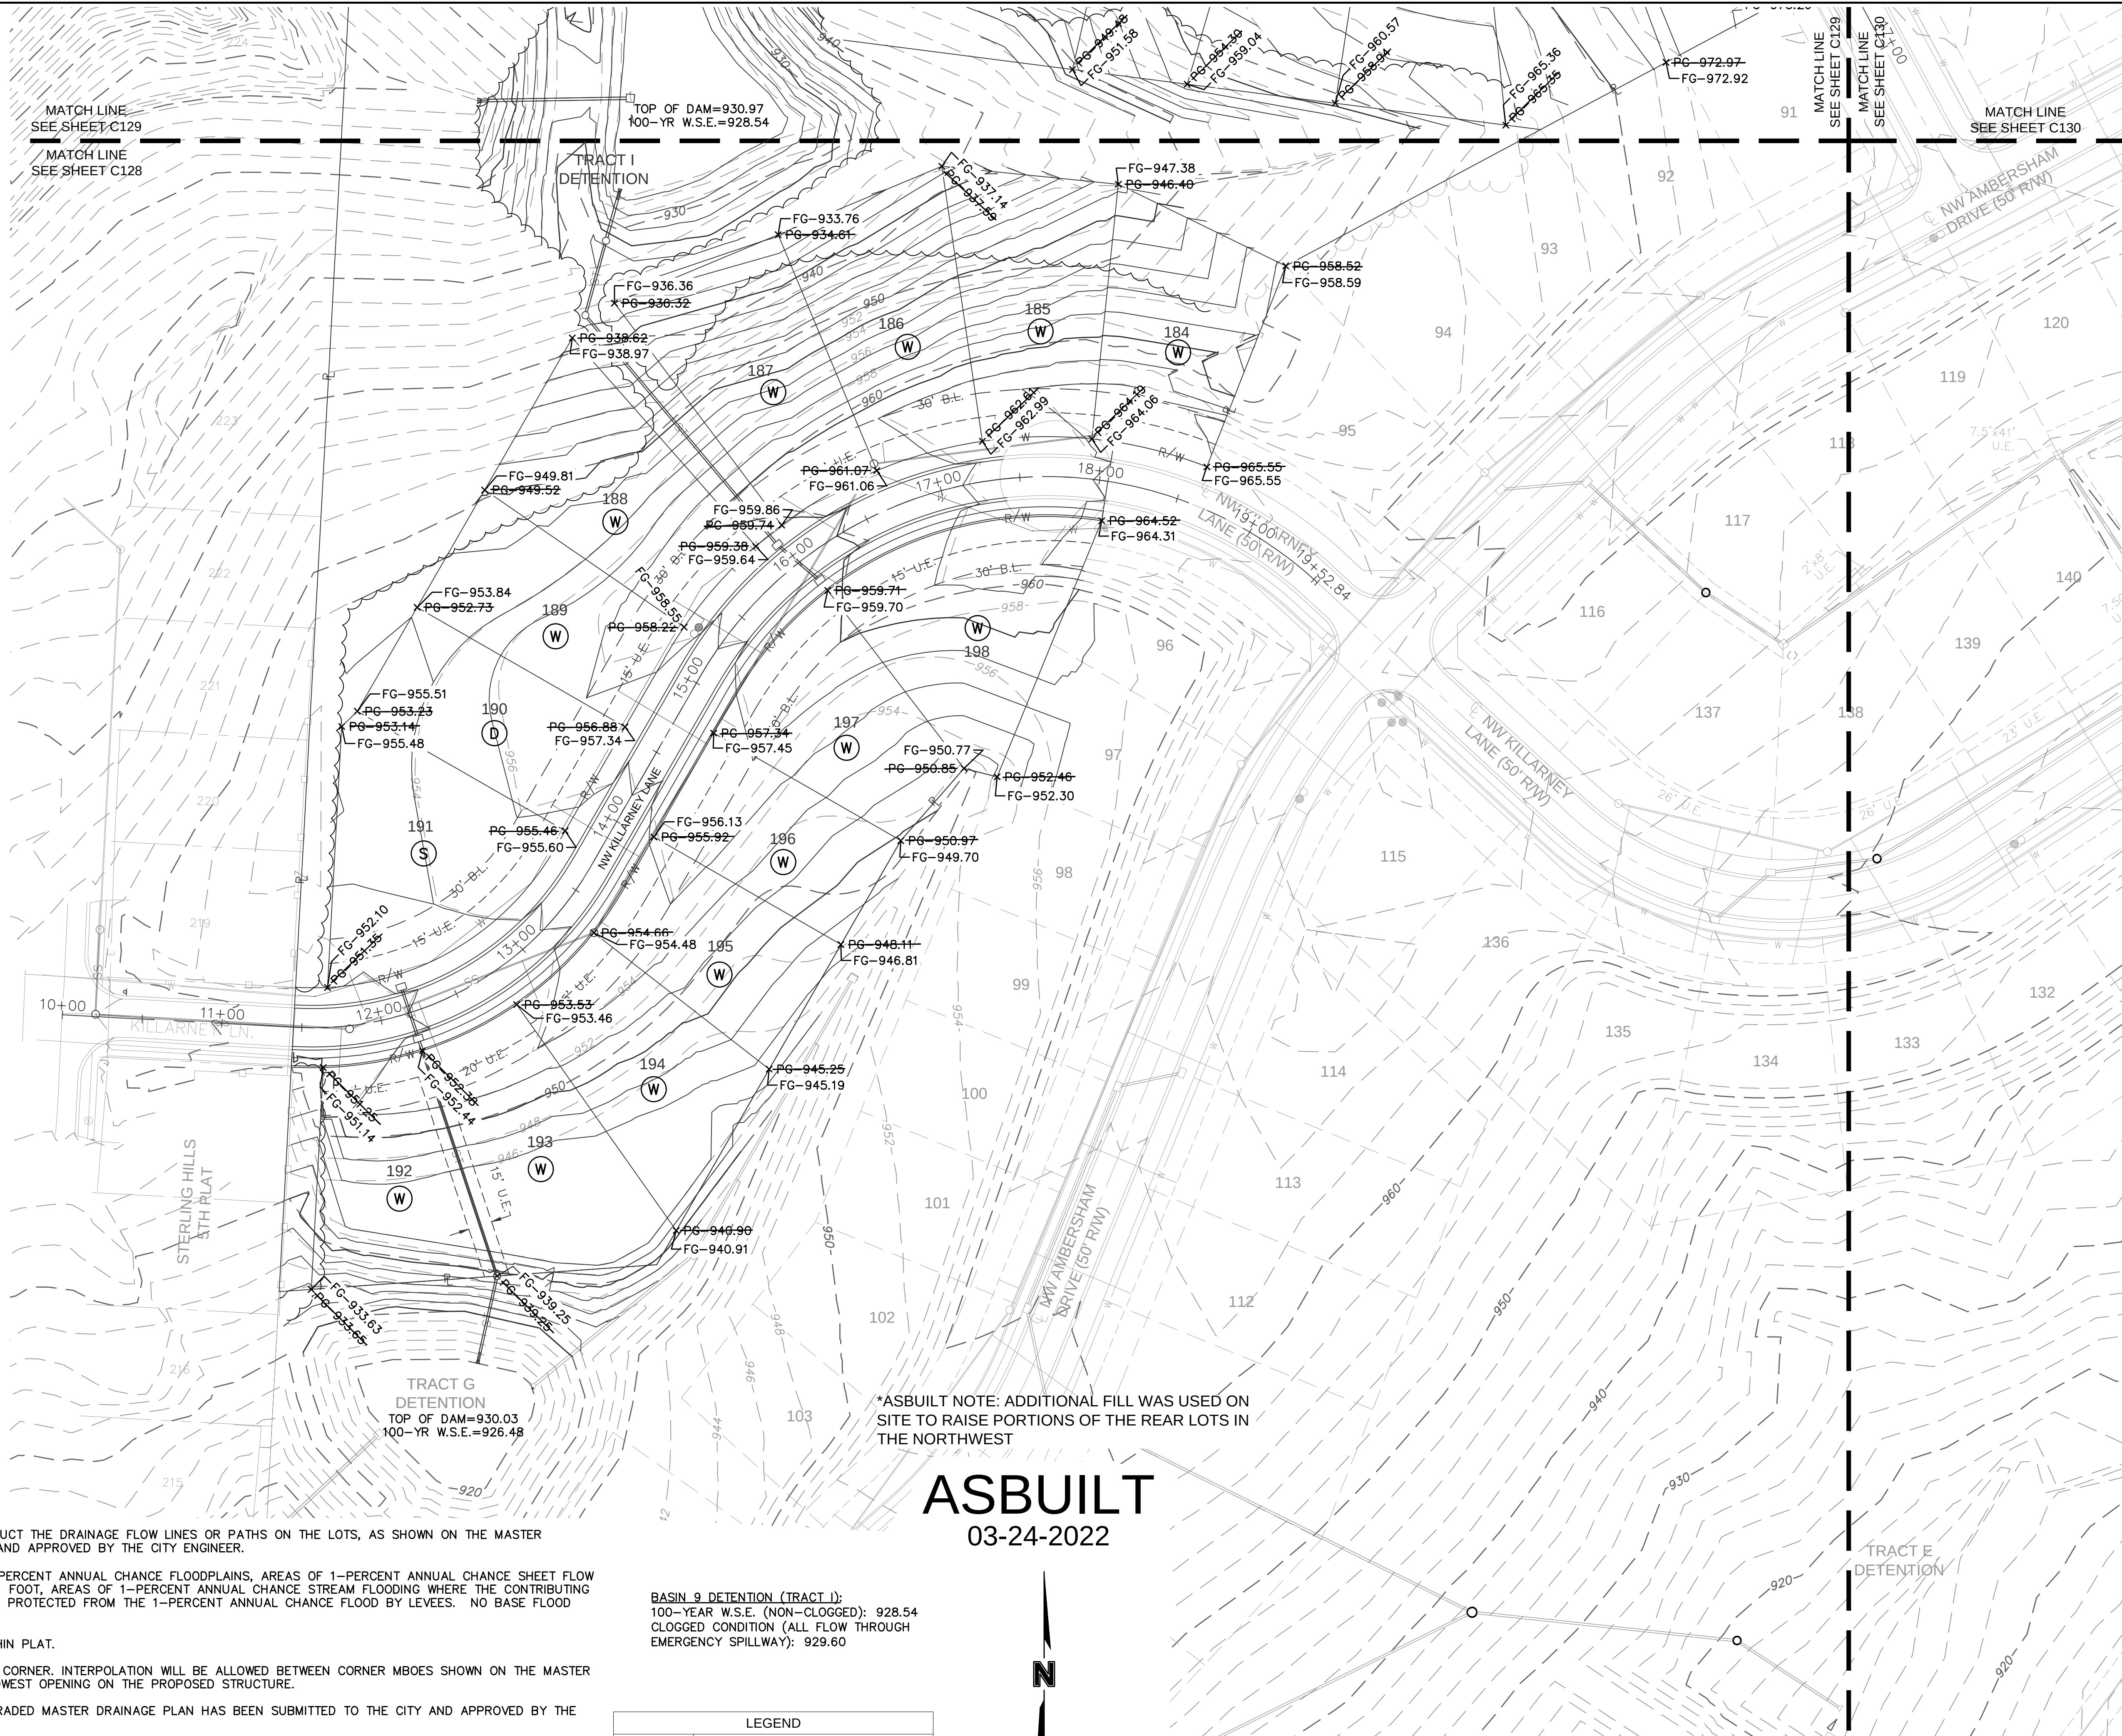

**BASIN 9 DETENTION (TRACT I):**  
100-YEAR W.S.E. (NON-CLOGGED): 928.54  
CLOGGED CONDITION (ALL FLOW THROUGH EMERGENCY SPILLWAY): 929.60

| LEGEND |                                |
|--------|--------------------------------|
| 100    | FINISHED INDEX CONTOURS        |
| 100    | FINISHED INTERMEDIATE CONTOURS |

**ASBUILT**  
03-24-2022

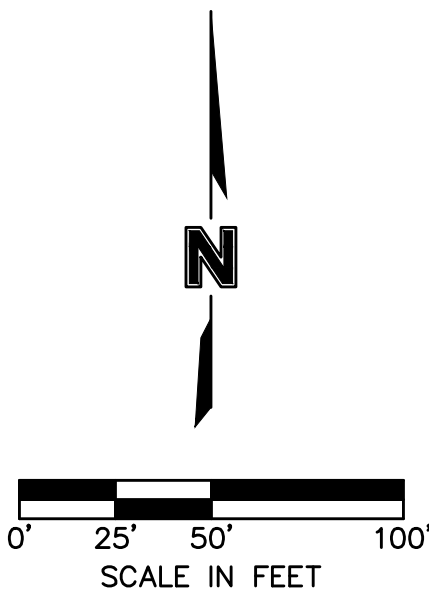

BY

NO. REV.

DATE

REVISIONS DESCRIPTION

1

7/10/2020

REVISED PER CITY COMMENTS

MASTER DRAINAGE PLAN  
STREET & STORM SEWER PLANS

WOODSIDE RIDGE  
SECOND PLAT

LEE'S SUMMIT, MO

2020

2020.07.10

drawn by: C.S.M.  
checked by: S.M.S.  
designed by: C.S.M.  
QA/QC by: J.E.S.  
project no.: C18-1140  
date: 2020.07.10

SHEET  
C128

olsson

NO Conflicts of Interest at 03/24/22  
303 E. MAIN STREET, SUITE 100  
NORTH KANSAS CITY, MO 64116  
TEL 816.861.1177  
www.olson.com

STATE OF MISSOURI  
JULIE ELAINE  
SELLERS  
NUMBER  
PE-2017000367  
10/27/2022  
APPROVAL





KEY MAP

NOTES:  
1. INDIVIDUAL LOT OWNERS SHALL NOT CHANGE OR OBSTRUCT THE DRAINAGE FLOW LINES OR PATHS ON THE LOTS, AS SHOWN ON THE MASTER DRAINAGE PLAN, UNLESS SPECIFIC APPLICATION IS MADE AND APPROVED BY THE CITY ENGINEER.

2. PLAT IS LOCATED IN ZONE X, "AREAS OUTSIDE THE 1-PERCENT ANNUAL CHANCE FLOODPLAINS, AREAS OF 1-PERCENT ANNUAL CHANCE SHEET FLOW FLOODING WHERE THE AVERAGE DEPTHS ARE LESS THAN 1 FOOT, AREAS OF 1-PERCENT ANNUAL CHANCE STREAM FLOODING WHERE THE CONTRIBUTING DRAINAGE AREA IS LESS THAN 1 SQUARE MILE, OR AREAS PROTECTED FROM THE 1-PERCENT ANNUAL CHANCE FLOOD BY LEVEES. NO BASE FLOOD ELEVATIONS OR DEPTHS ARE SHOWN WITHIN THIS ZONE"

3. BUFFER ZONE FOR NATURAL STREAMS IS LOCATED WITHIN PLAT.

4. MBOE ELEVATIONS HAVE BEEN PROVIDED AT EACH LOT CORNER. INTERPOLATION WILL BE ALLOWED BETWEEN CORNER MBOES SHOWN ON THE MASTER DRAINAGE PLAN, DEPENDING ON THE LOCATION OF THE LOWEST OPENING ON THE PROPOSED STRUCTURE.

5. NO BUILDING PERMITS WILL BE ISSUED UNTIL AN AS-GRADED MASTER DRAINAGE PLAN HAS BEEN SUBMITTED TO THE CITY AND APPROVED BY THE CITY.

RMBOE - REAR MINIMUM BUILDING OPENING ELEVATION  
FMBOE - FRONT MINIMUM BUILDING OPENING ELEVATION

LOT TYPES:  
S - STANDARD  
D - DAYLIGHT  
W - WALKOUT


BASIN C1 DETENTION (TRACT I):  
100-YEAR W.S.E. (NON-CLOGGED): 928.54  
CLOGGED CONDITION (ALL FLOW THROUGH EMERGENCY SPILLWAY): 929.60

BASIN C1 DETENTION (TRACT J):  
100-YEAR W.S.E. (NON-CLOGGED): 935.67  
CLOGGED CONDITION (ALL FLOW THROUGH EMERGENCY SPILLWAY): 936.70

| LEGEND |                                |
|--------|--------------------------------|
|        | FINISHED INDEX CONTOURS        |
|        | FINISHED INTERMEDIATE CONTOURS |



ASBUILT  
03-24-2022

\*ASBUILT NOTE: ADDITIONAL FILL WAS USED ON SITE TO RAISE PORTIONS OF THE REAR LOTS IN THE NORTHWEST

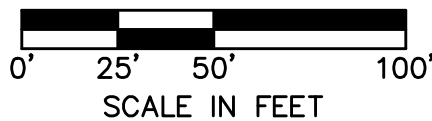

| Woodside Ridge Second Plat<br>Minimum Building Opening Elevation |                |                 |                             |
|------------------------------------------------------------------|----------------|-----------------|-----------------------------|
| Lot                                                              | Rear Left MBOE | Rear Right MBOE | As Built Plot Plan Required |
| 149                                                              | 945.25         | 938.92          | Y                           |
| 150                                                              | 952.25         | 945.25          | Y                           |
| 151                                                              | 950.78         | 952.25          | Y                           |
| 152                                                              | 950.23         | 950.78          | Y                           |
| 153                                                              | 950.56         | 950.23          | Y                           |
| 154                                                              | 953.80         | 950.56          | Y                           |
| 155                                                              | 970.20         | 979.35          | Y                           |
| 156                                                              | 957.42         | 970.20          | Y                           |
| 157                                                              | 953.53         | 957.42          | Y                           |
| 158                                                              | 937.69         | 953.53          | Y                           |
| 166                                                              | 948.97         | 945.09          | Y                           |
| 167                                                              | 952.18         | 948.97          | Y                           |
| 168                                                              | 959.64         | 952.18          | Y                           |
| 169                                                              | 961.17         | 959.64          | Y                           |
| 170                                                              | 965.96         | 961.17          | Y                           |
| 184                                                              | 947.98         | 959.19          | Y                           |
| 185                                                              | 937.74         | 947.98          | Y                           |
| 186                                                              | 934.36         | 937.74          | Y                           |
| 187                                                              | 936.96         | 934.36          | Y                           |
| 192                                                              | 939.85         | 934.23          | Y                           |
| 193                                                              | 941.51         | 939.85          | Y                           |
| 194                                                              | 945.79         | 941.51          | Y                           |
| 195                                                              | 947.41         | 945.79          | Y                           |
| 196                                                              | 950.30         | 947.41          | Y                           |
| 197                                                              | 951.37         | 950.30          | Y                           |
| 198                                                              | 952.90         | 951.37          | Y                           |

MBOE elevations have been provided per lot lines, facing the lot from the street. Interpolation will be allowed between the right and left side MBOE's provided, depending on the location of the lowest opening on the proposed structure.

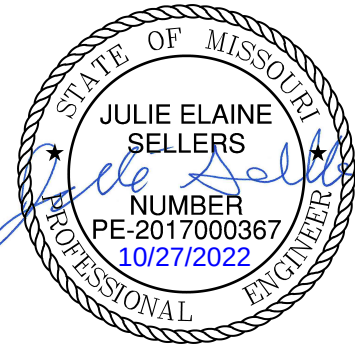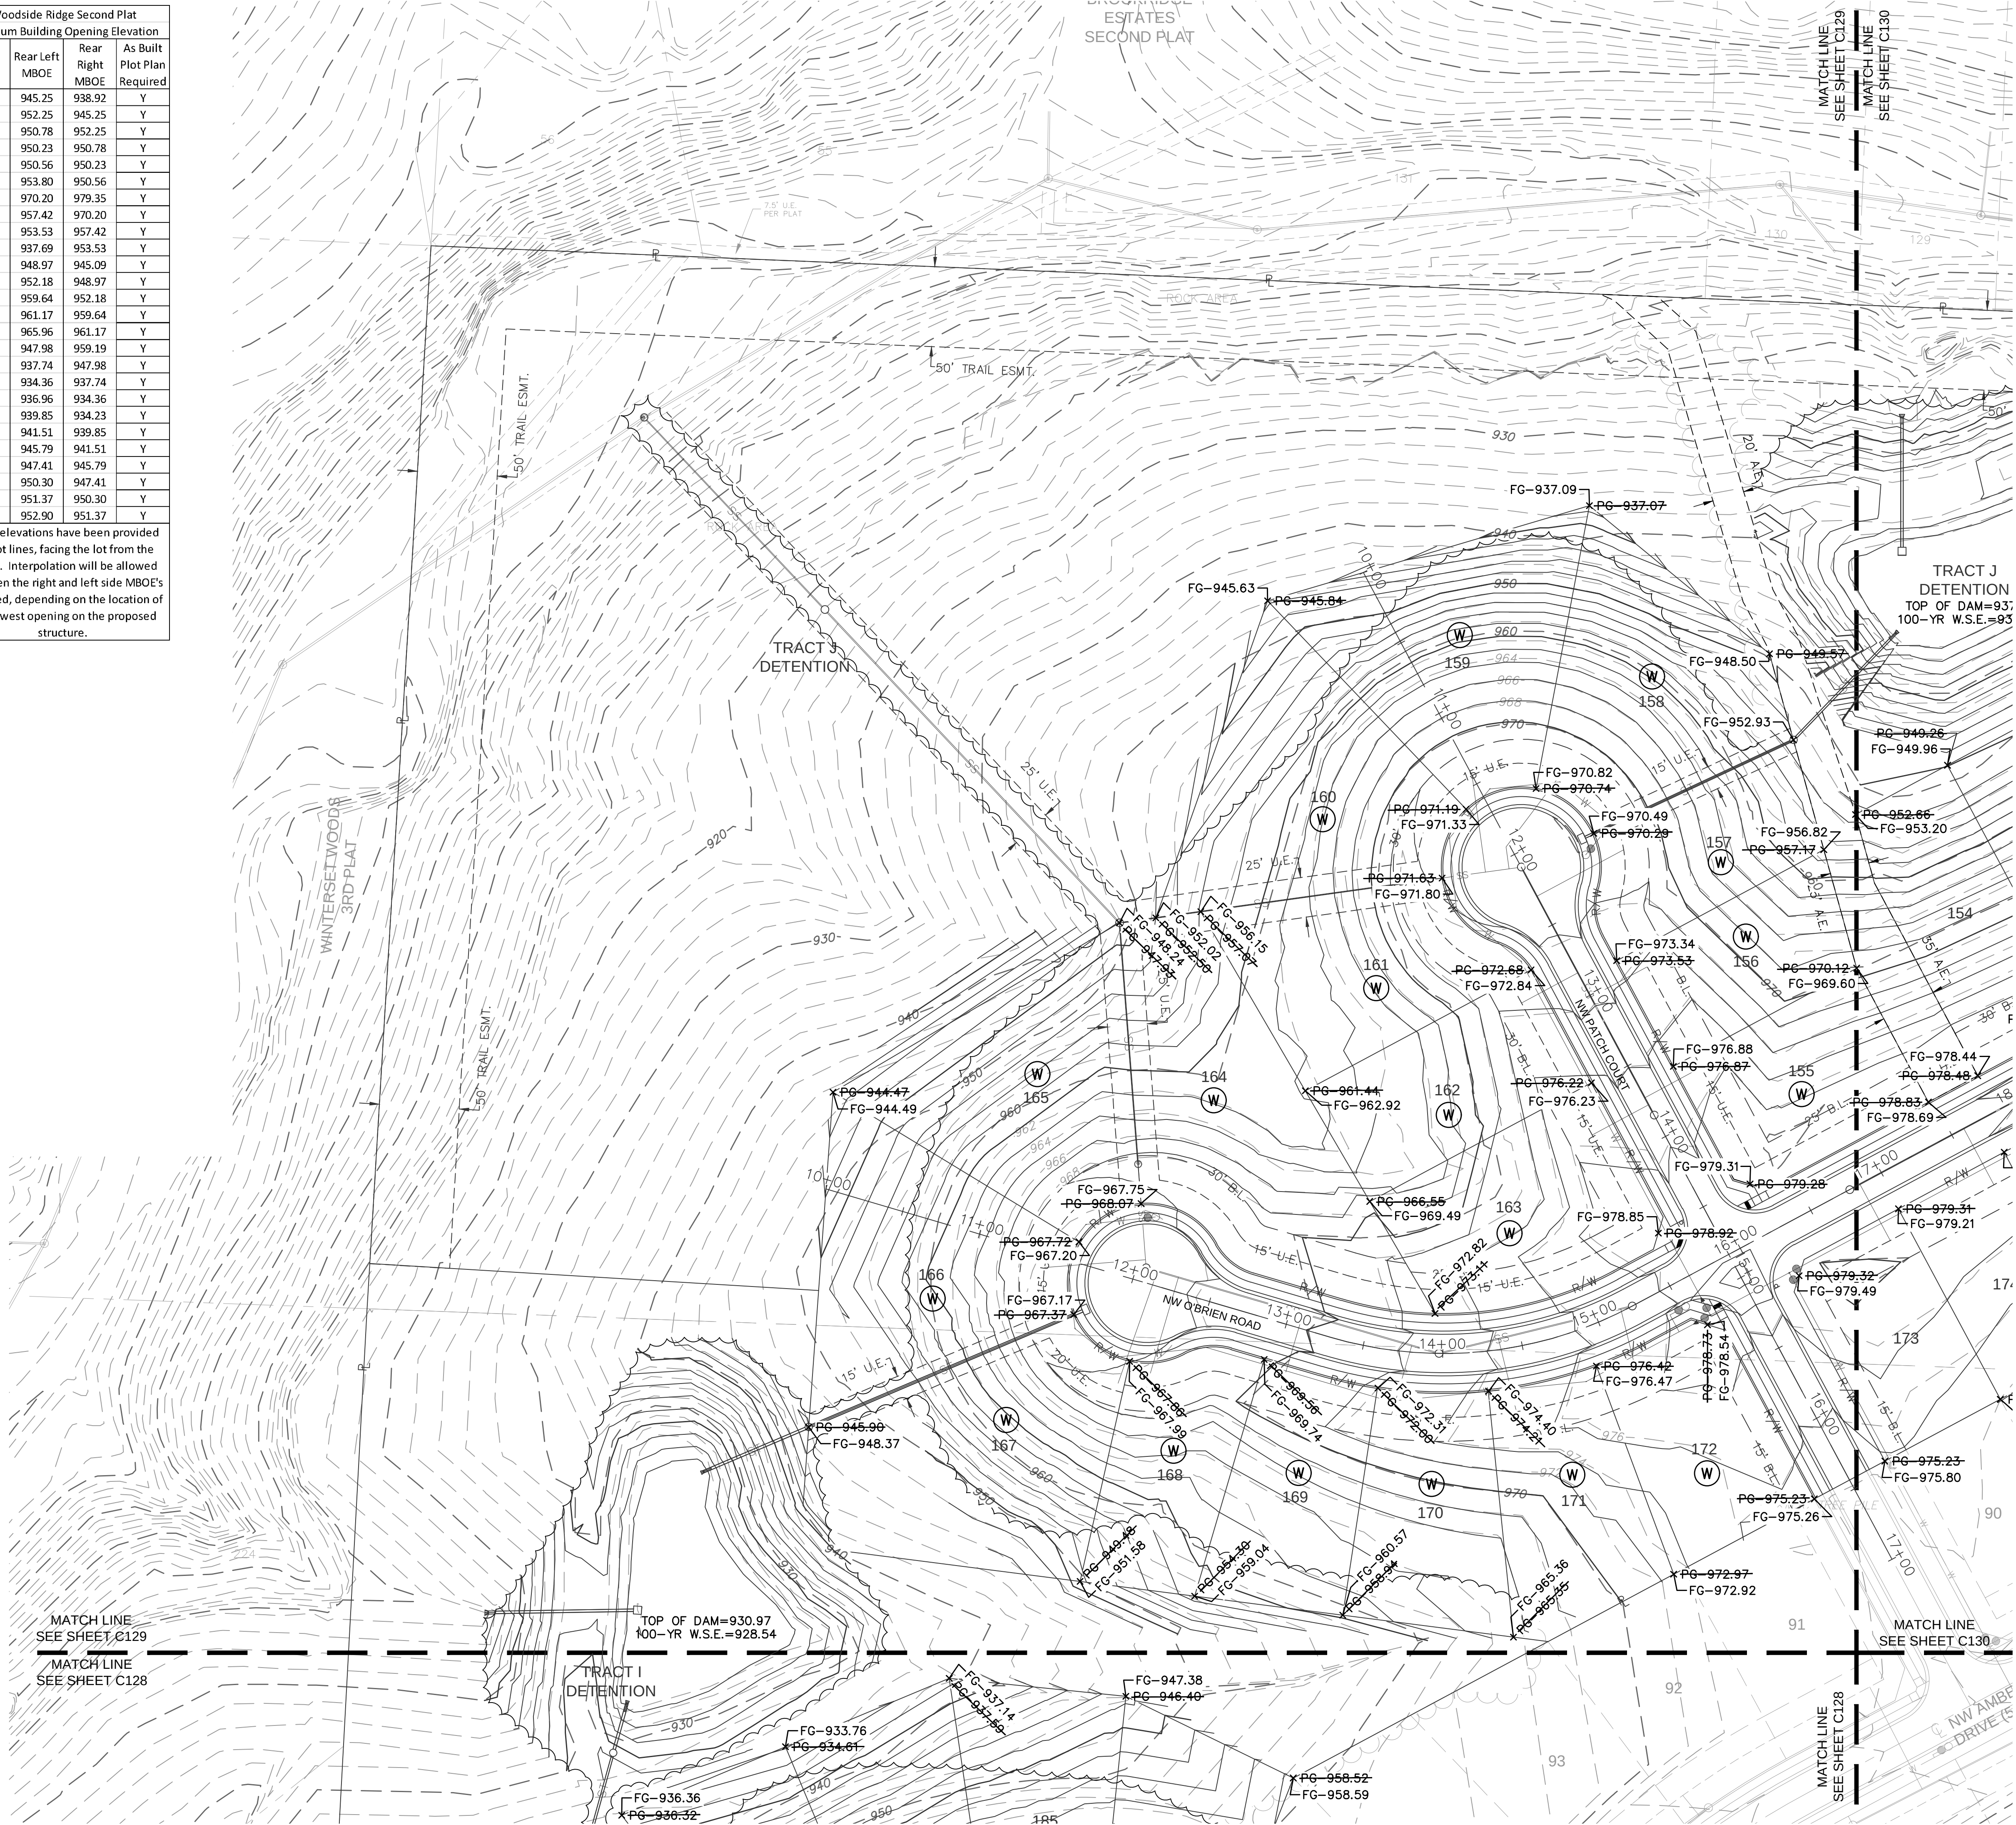

| BY       |           | REVISIONS DESCRIPTION     |  |
|----------|-----------|---------------------------|--|
| NO. REV. | DATE      | REVISED PER CITY COMMENTS |  |
| 1        | 7/10/2020 |                           |  |

|                                                    |  |                               |  |
|----------------------------------------------------|--|-------------------------------|--|
| MASTER DRAINAGE PLAN<br>STREET & STORM SEWER PLANS |  | WOODSIDE RIDGE<br>SECOND PLAT |  |
| LEE'S SUMMIT, MO                                   |  | 2020                          |  |

drawn by: \_\_\_\_\_ C.S.M.  
checked by: \_\_\_\_\_ S.M.S.  
designed by: \_\_\_\_\_ C.S.M.  
QA/QC by: \_\_\_\_\_ J.E.S.  
project no.: C18-1140  
date: 2020.07.10







KEY MAP

| Woodside Ridge Second Plat         |                |                 |                    |          |
|------------------------------------|----------------|-----------------|--------------------|----------|
| Minimum Building Opening Elevation |                |                 |                    |          |
| Lot                                | Rear Left MBOE | Rear Right MBOE | As Built Plot Plan | Required |
| 149                                | 945.25         | 938.92          | Y                  |          |
| 150                                | 952.25         | 945.25          | Y                  |          |
| 151                                | 950.78         | 952.25          | Y                  |          |
| 152                                | 950.23         | 950.78          | Y                  |          |
| 153                                | 950.56         | 950.23          | Y                  |          |
| 154                                | 953.80         | 950.56          | Y                  |          |
| 155                                | 970.20         | 979.35          | Y                  |          |
| 156                                | 957.42         | 970.20          | Y                  |          |
| 157                                | 953.53         | 957.42          | Y                  |          |
| 158                                | 937.69         | 953.53          | Y                  |          |
| 166                                | 948.97         | 945.09          | Y                  |          |
| 167                                | 952.18         | 948.97          | Y                  |          |
| 168                                | 959.64         | 952.18          | Y                  |          |
| 169                                | 961.17         | 959.64          | Y                  |          |
| 170                                | 965.96         | 961.17          | Y                  |          |
| 184                                | 947.98         | 959.19          | Y                  |          |
| 185                                | 937.74         | 947.98          | Y                  |          |
| 186                                | 934.36         | 937.74          | Y                  |          |
| 187                                | 936.96         | 934.36          | Y                  |          |
| 192                                | 939.85         | 934.23          | Y                  |          |
| 193                                | 941.51         | 939.85          | Y                  |          |
| 194                                | 945.79         | 941.51          | Y                  |          |
| 195                                | 947.41         | 945.79          | Y                  |          |
| 196                                | 950.30         | 947.41          | Y                  |          |
| 197                                | 951.37         | 950.30          | Y                  |          |
| 198                                | 952.90         | 951.37          | Y                  |          |

MBOE elevations have been provided per lot lines, facing the lot from the street. Interpolation will be allowed between the right and left side MBOE's provided, depending on the location of the lowest opening on the proposed structure.

| LEGEND |                                |
|--------|--------------------------------|
| 100    | FINISHED INDEX CONTOURS        |
| 100    | FINISHED INTERMEDIATE CONTOURS |

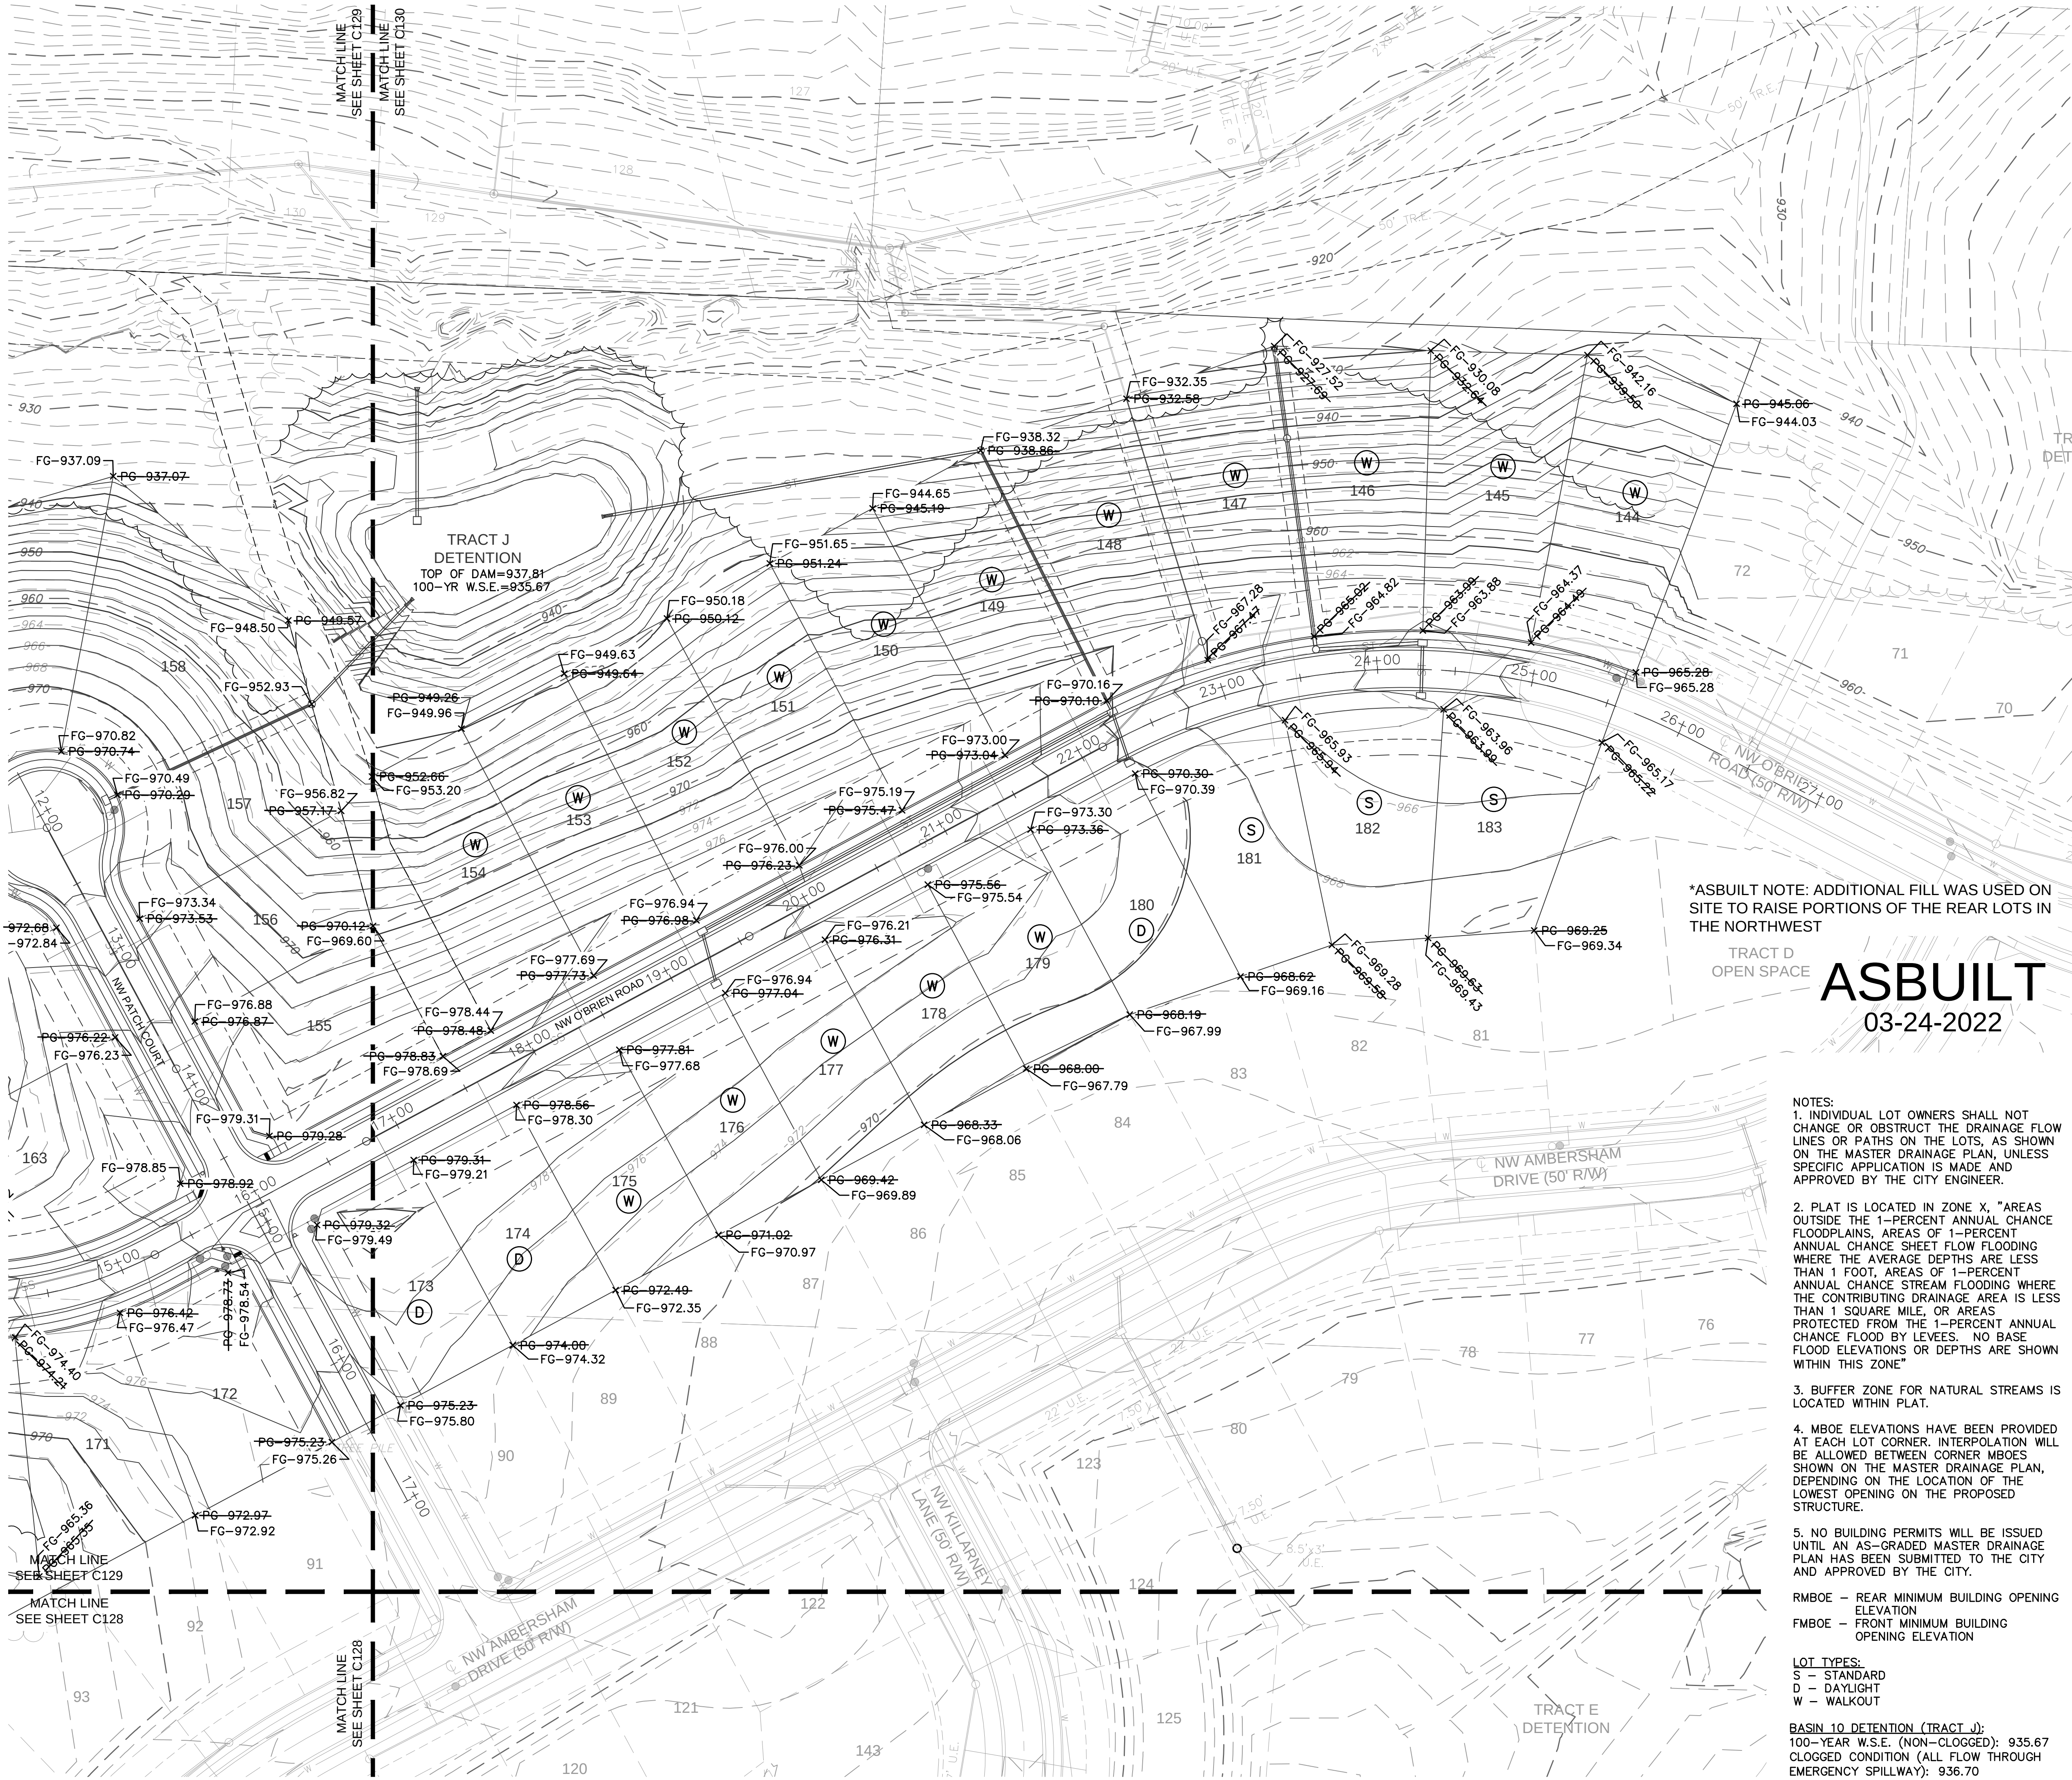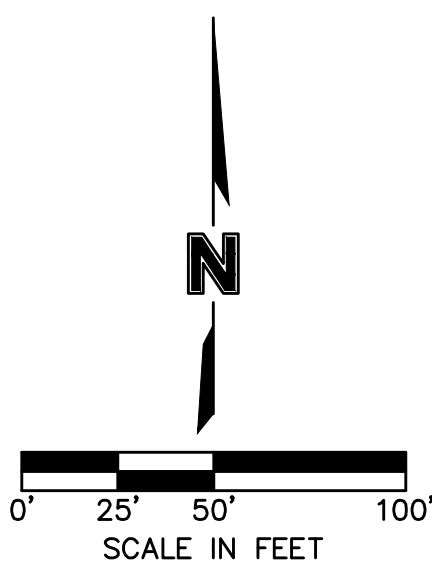

\*ASBUILT NOTE: ADDITIONAL FILL WAS USED ON SITE TO RAISE PORTIONS OF THE REAR LOTS IN THE NORTHWEST

ASBUILT  
03-24-2022

- NOTES:
- INDIVIDUAL LOT OWNERS SHALL NOT CHANGE OR OBSTRUCT THE DRAINAGE FLOW LINES OR PATHS ON THE LOTS, AS SHOWN ON THE MASTER DRAINAGE PLAN, UNLESS SPECIFIC APPLICATION IS MADE AND APPROVED BY THE CITY ENGINEER.
  - PLAT IS LOCATED IN ZONE X, "AREAS OUTSIDE THE 1-PERCENT ANNUAL CHANCE FLOODPLAINS, AREAS OF 1-PERCENT ANNUAL CHANCE SHEET FLOW FLOODING WHERE THE AVERAGE DEPTHS ARE LESS THAN 1 FOOT, AREAS OF 1-PERCENT ANNUAL CHANCE STREAM FLOODING WHERE THE CONTRIBUTING DRAINAGE AREA IS LESS THAN 1 SQUARE MILE, OR AREAS PROTECTED FROM THE 1-PERCENT ANNUAL CHANCE FLOOD BY LEVEES. NO BASE FLOOD ELEVATIONS OR DEPTHS ARE SHOWN WITHIN THIS ZONE"
  - BUFFER ZONE FOR NATURAL STREAMS IS LOCATED WITHIN PLAT.
  - MBOE ELEVATIONS HAVE BEEN PROVIDED AT EACH LOT CORNER. INTERPOLATION WILL BE ALLOWED BETWEEN CORNER MBOE'S SHOWN ON THE MASTER DRAINAGE PLAN, DEPENDING ON THE LOCATION OF THE LOWEST OPENING ON THE PROPOSED STRUCTURE.
  - NO BUILDING PERMITS WILL BE ISSUED UNTIL AN AS-GRADED MASTER DRAINAGE PLAN HAS BEEN SUBMITTED TO THE CITY AND APPROVED BY THE CITY.
- RMBOE - REAR MINIMUM BUILDING OPENING ELEVATION  
FMBOE - FRONT MINIMUM BUILDING OPENING ELEVATION
- LOT TYPES:  
S - STANDARD  
D - DAYLIGHT  
W - WALKOUT
- BASIN 10 DETENTION (TRACT J);  
100-YEAR W.S.E. (NON-CLOGGED): 935.67  
CLOGGED CONDITION (ALL FLOW THROUGH EMERGENCY SPILLWAY): 936.70

olsson

NO. 1001-1500  
303 E. MAIN STREET, SUITE 100  
NORTH KANSAS CITY, MO 64116  
TEL. 816.861.1177  
WWW.OLSSON.COM

STATE OF MISSOURI  
JULIE ELAINE SELLERS  
NUMBER  
PE-2017000367  
10271202  
APPROVAL

BY

REVISIONS DESCRIPTION

NO. REV. DATE

1 7/10/2020 REVISED PER CITY COMMENTS

MASTER DRAINAGE PLAN  
STREET & STORM SEWER PLANS

WOODSIDE RIDGE  
SECOND PLAT




LEE'S SUMMIT, MO

2020

SHEET  
C130




01 N.T.S.  
ADA RAMP RETROFIT DETAIL (A)

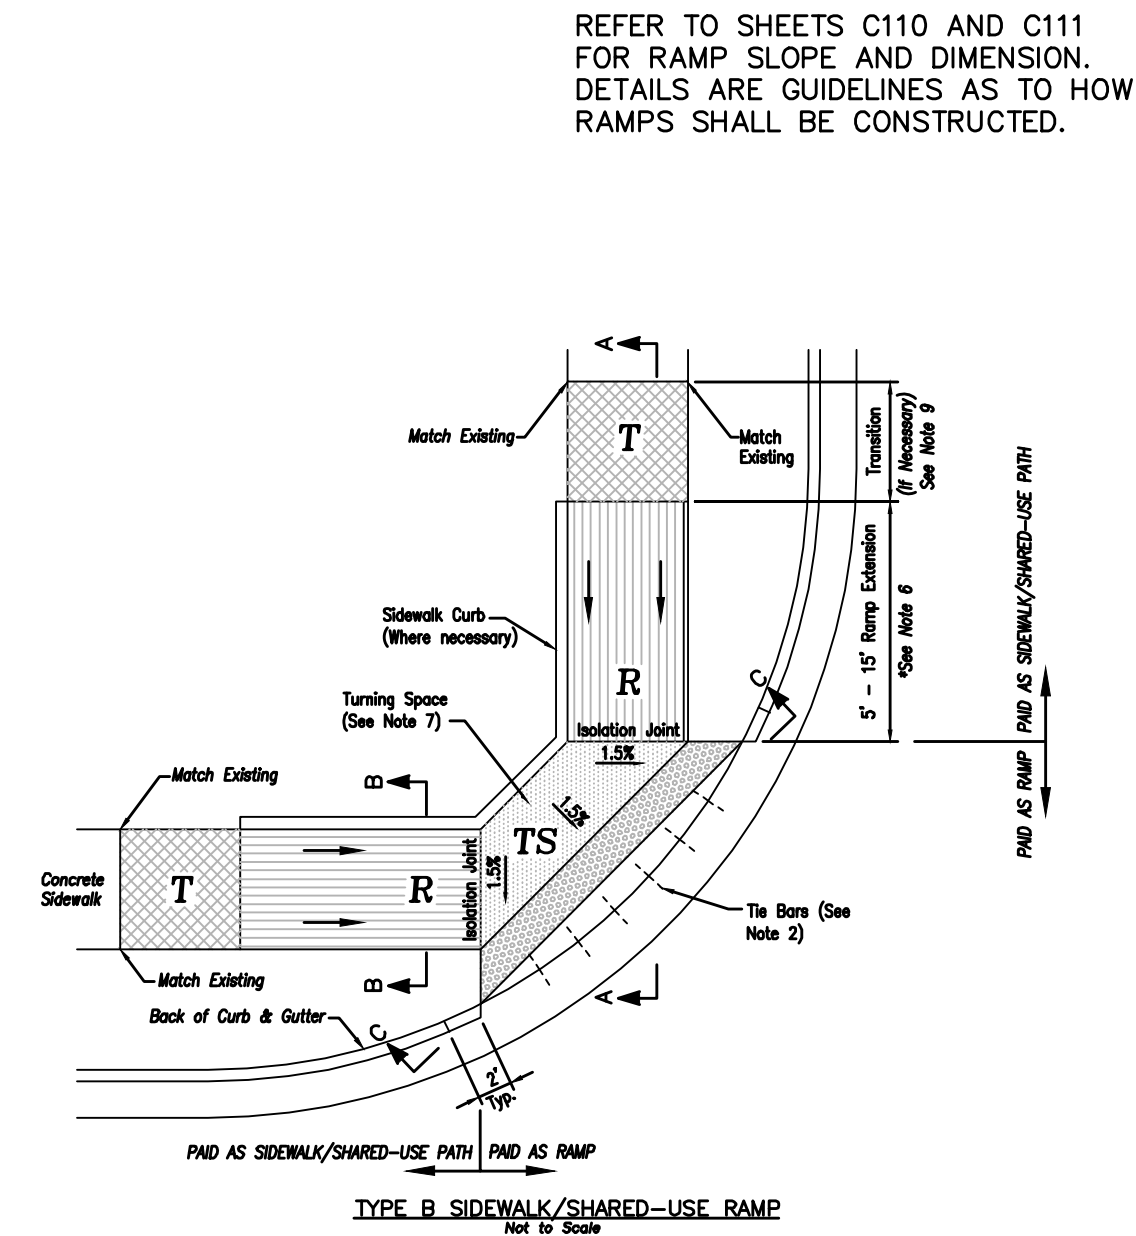
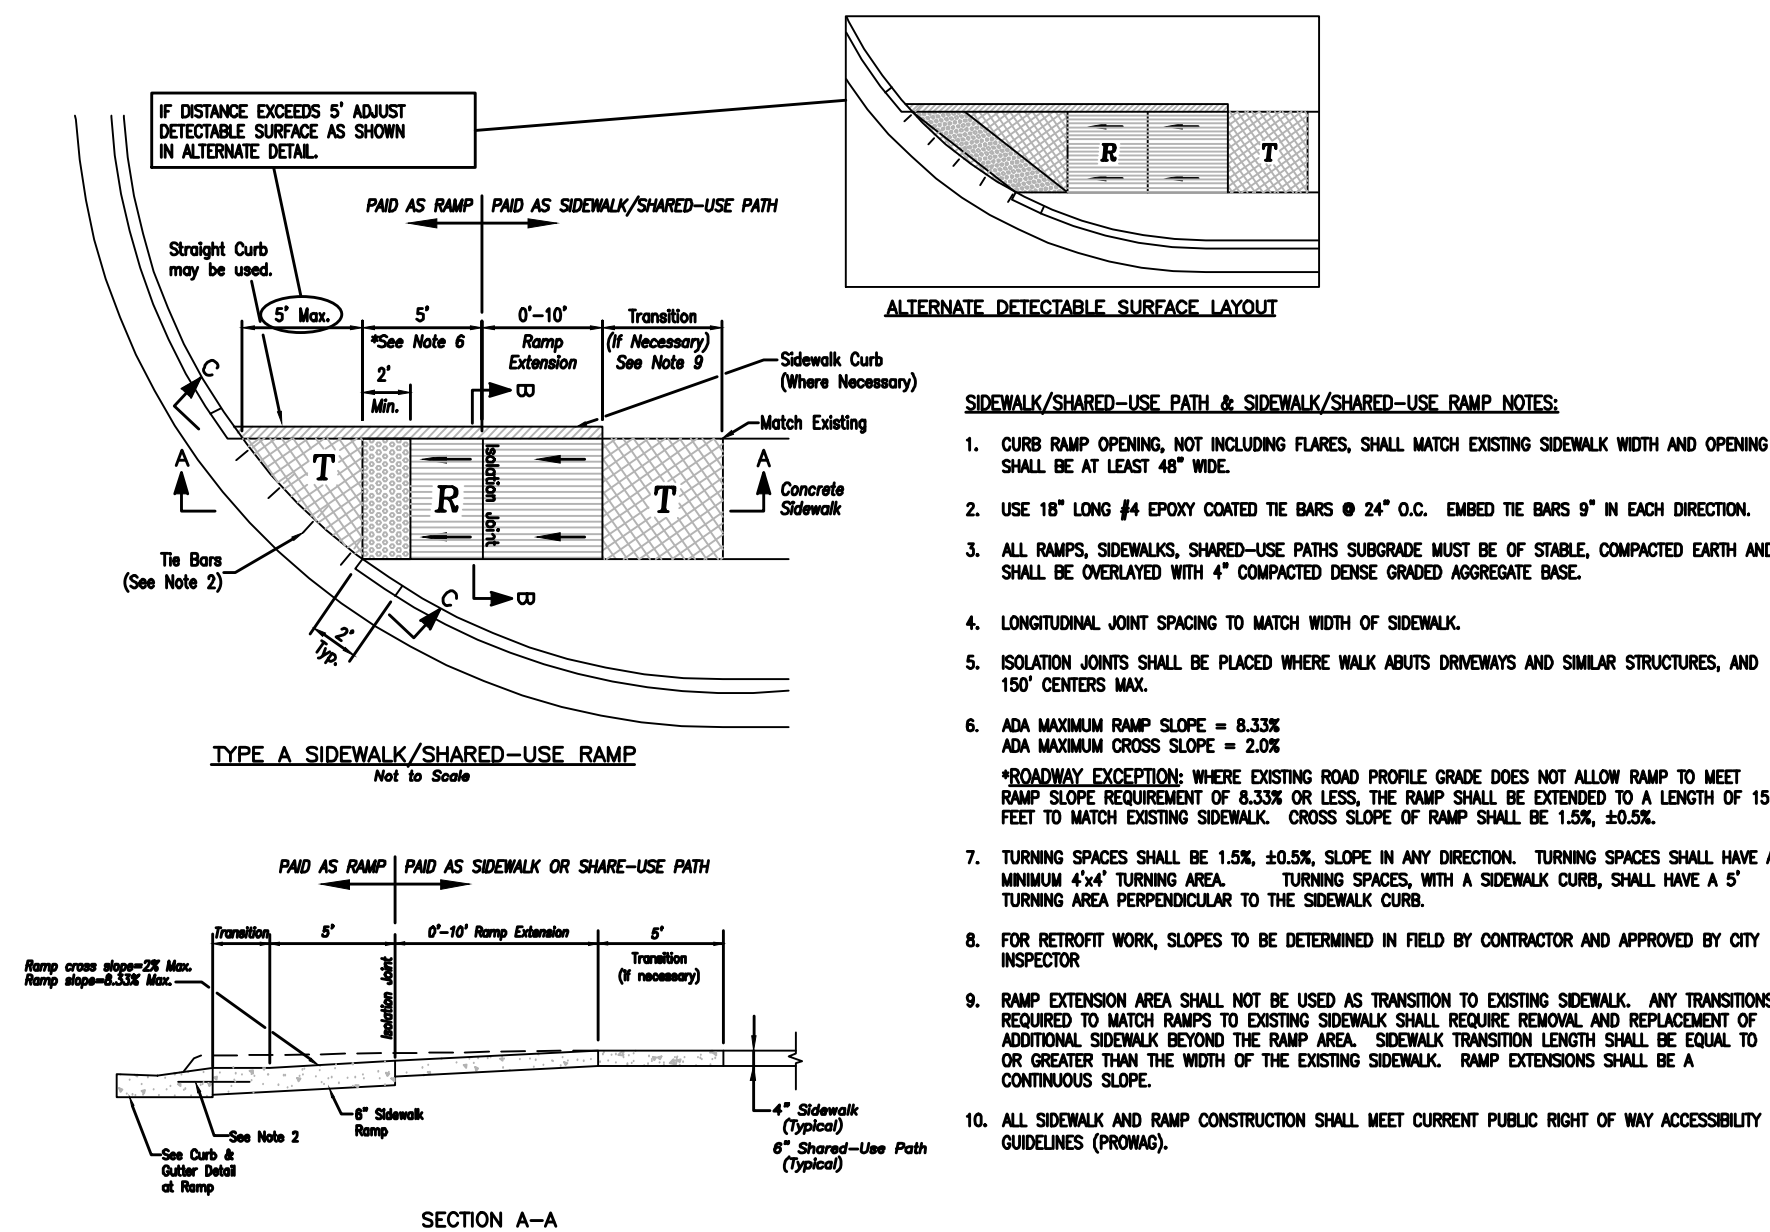
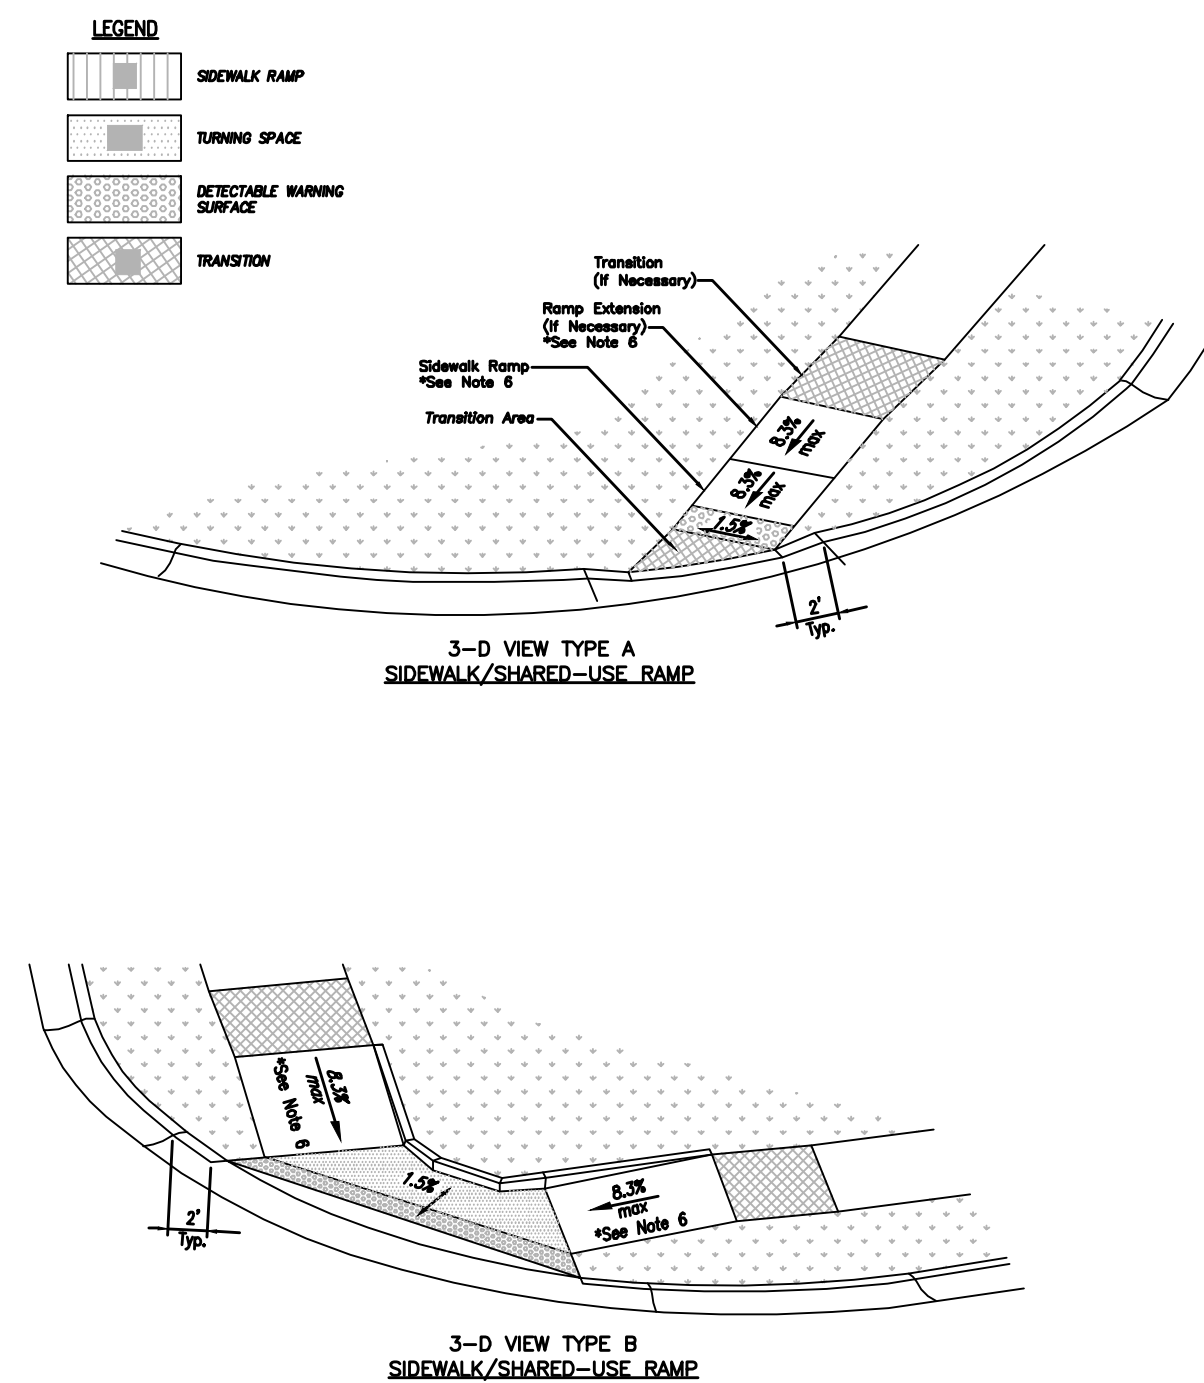


REFER TO SHEETS C110 AND C111 FOR RAMP SLOPE AND DIMENSION. DETAILS ARE GUIDELINES AS TO HOW RAMPS SHALL BE CONSTRUCTED.

NOT ASBUILT

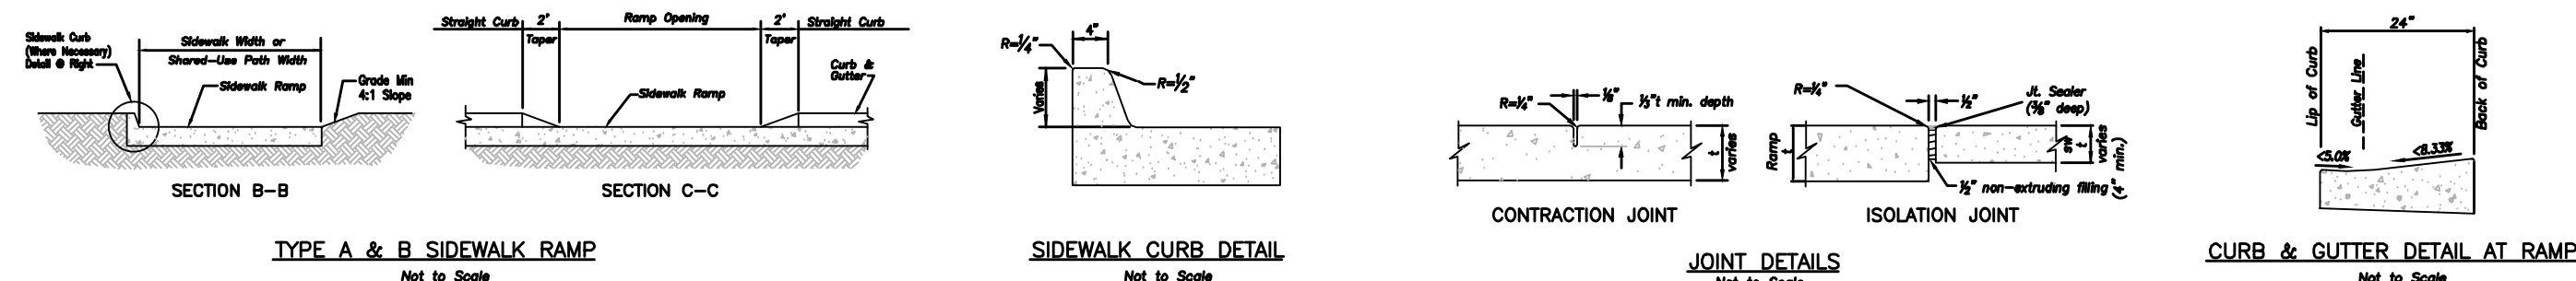

02 N.T.S.  
ADA RAMP RETROFIT DETAIL (B)

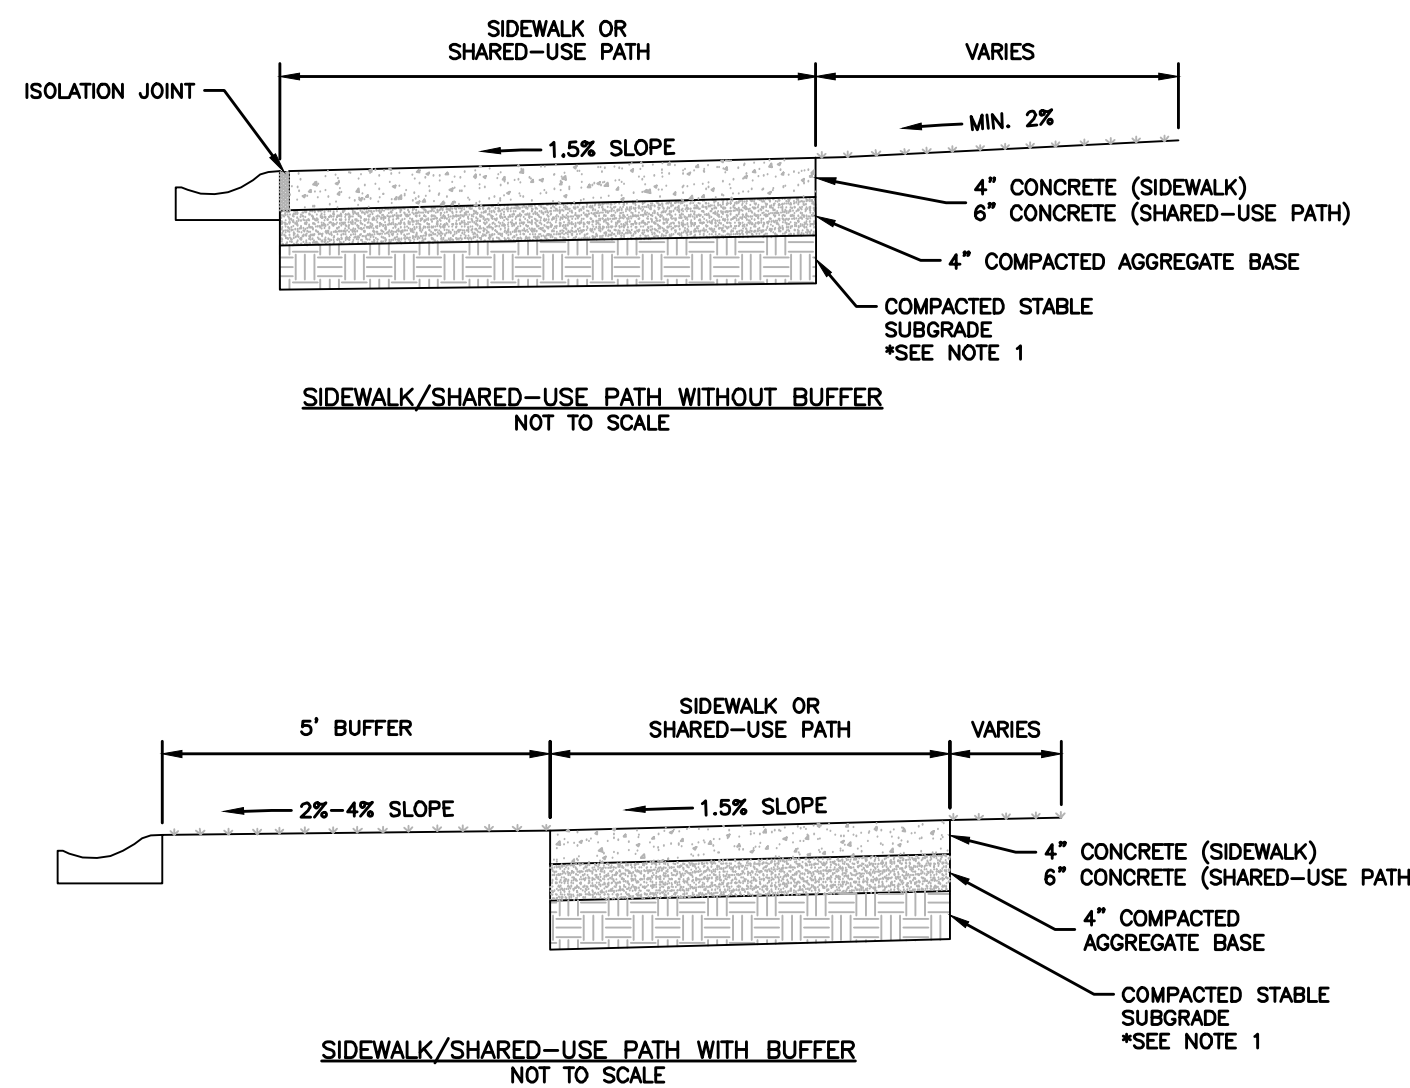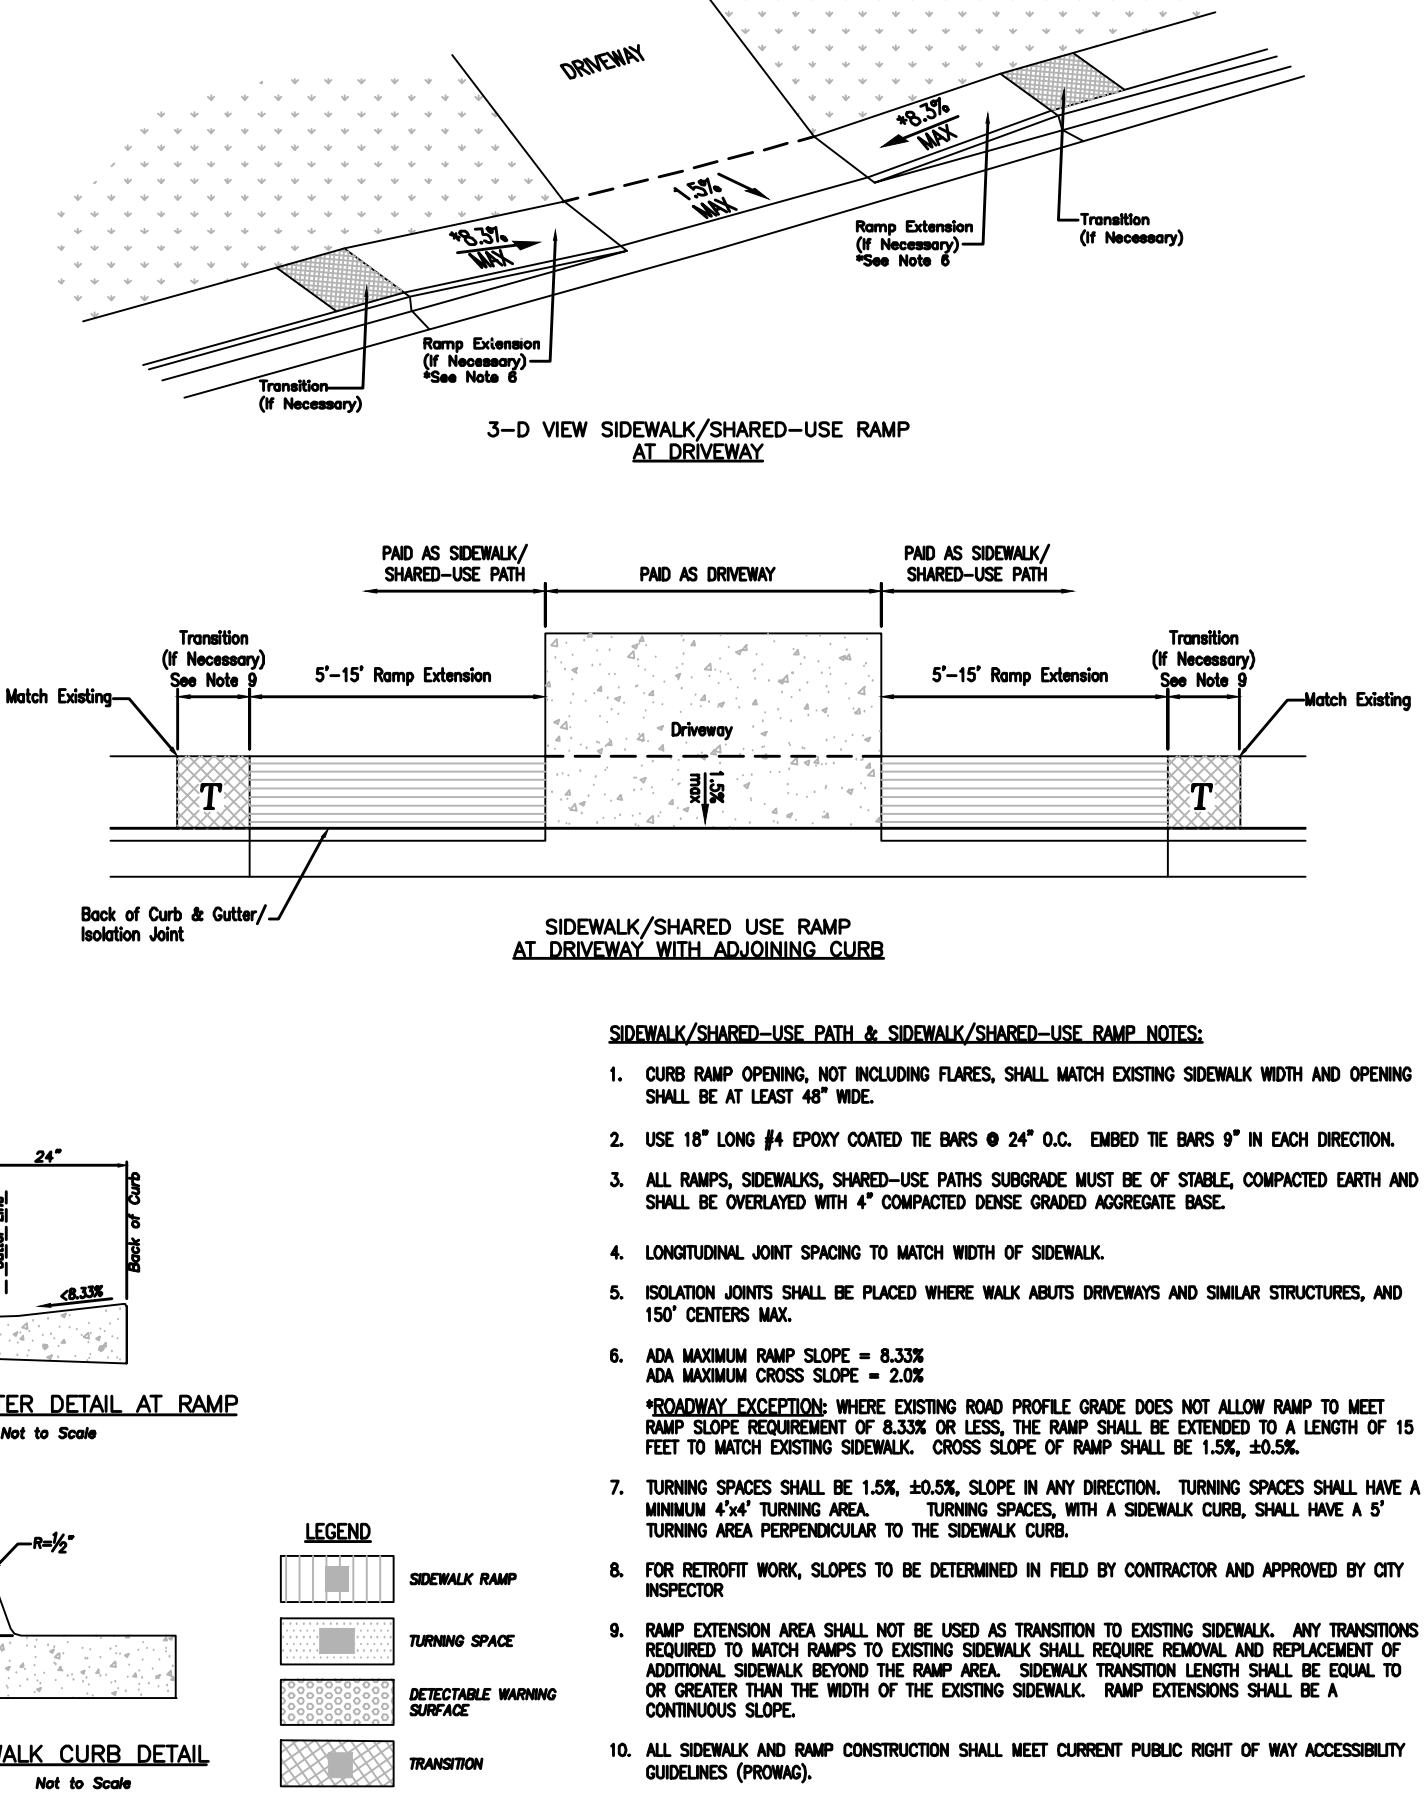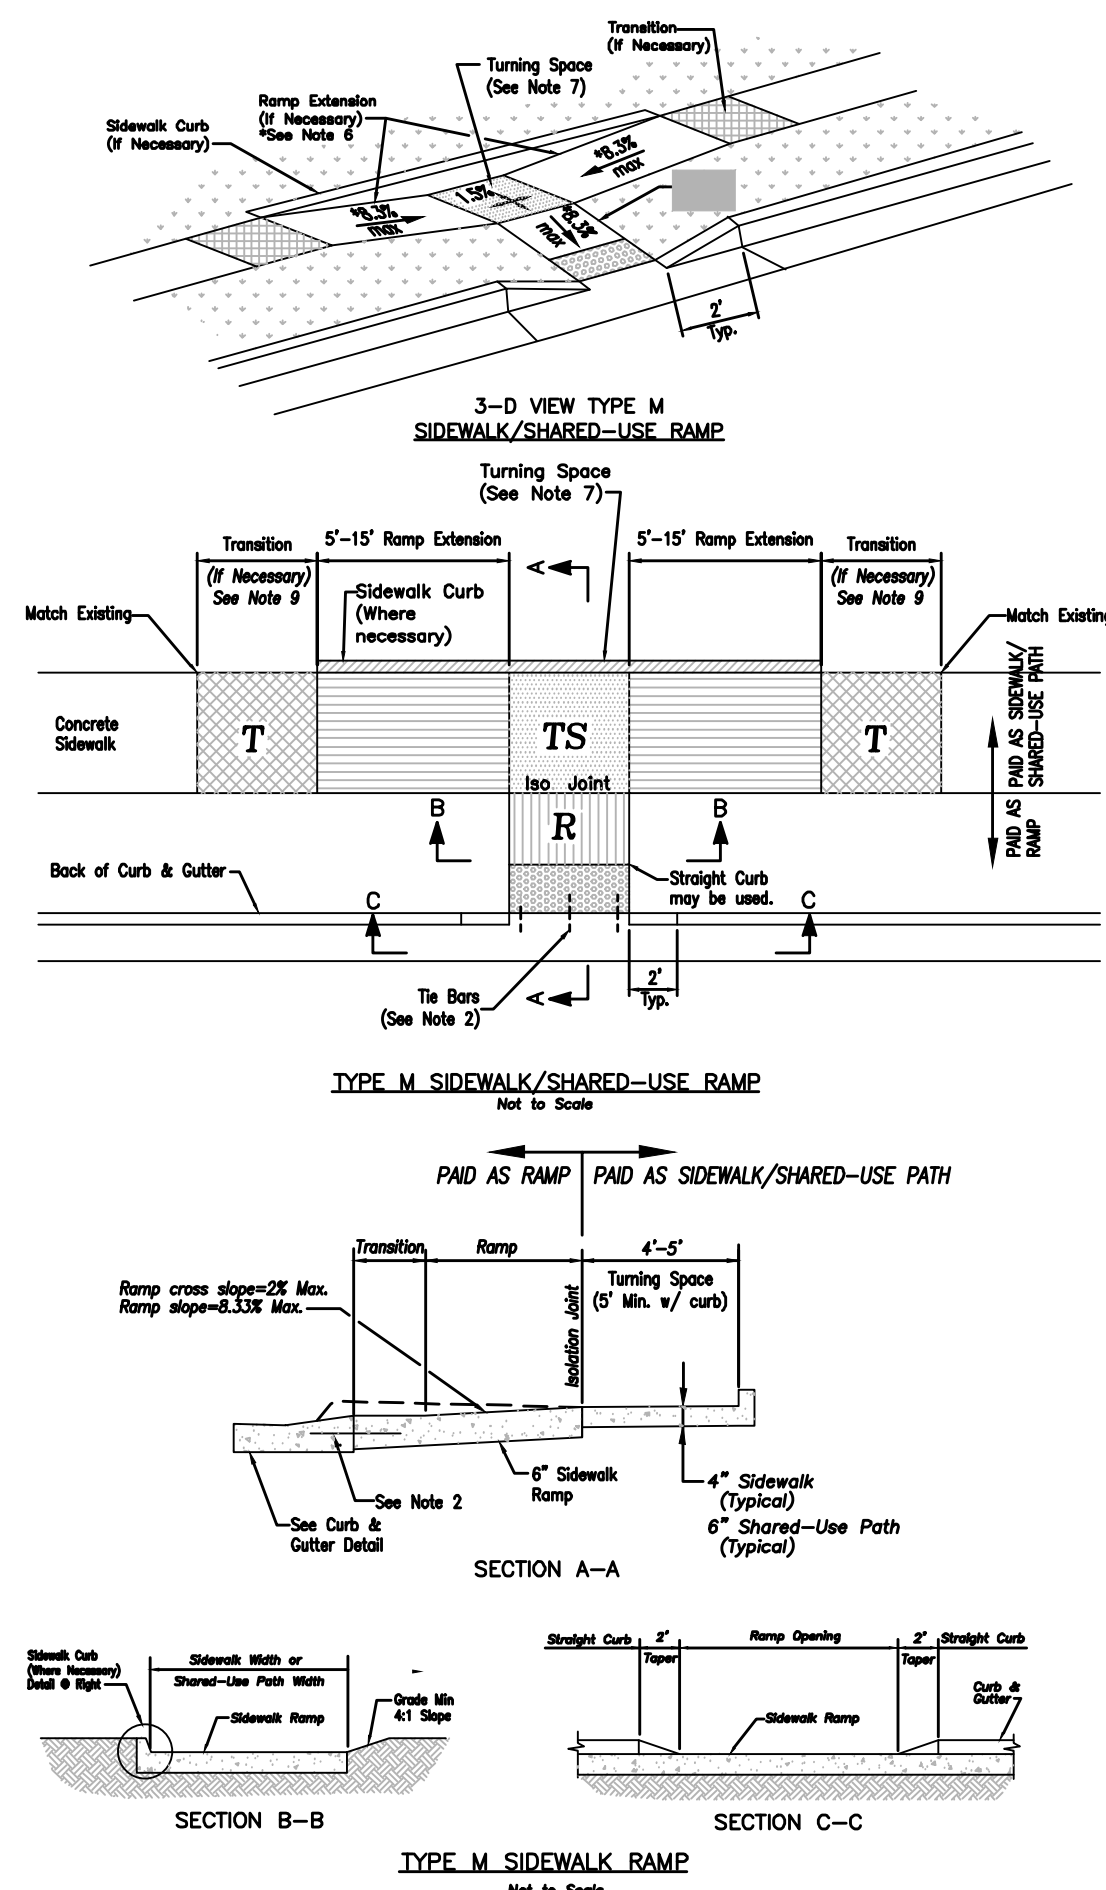


- GENERAL NOTES:
- SUBGRADE MUST BE OF STABLE, COMPACTED EARTH AND SHALL BE OVERLAYED WITH 4" GRADED AGGREGATE BASE.
  - 1.5% CROSS SLOPE MUST BE MAINTAINED THROUGH DRIVEWAYS.
  - KOMBE 4K CONCRETE MIX SHALL BE REQUIRED FOR ALL SIDEWALKS AND SHARED-USE PATHS OR AS APPROVED BY THE CITY INSPECTOR.
  - ALL SIDEWALKS SHALL MEET CURRENT PUBLIC RIGHT OF WAY ACCESSIBILITY GUIDELINES (PROWAG).
  - AN EXPANSION JOINT SHALL BE PLACED AT A MAXIMUM OF 150 FT. CONSTRUCTION JOINTS SHALL BE PLACED THE SAME WIDTH OF SIDEWALK, BUT NO GREATER THAN 10 FT.
  - SHARED-USE PATH WIDTH SHALL BE 10 FT. WIDE.
  - SIDEWALK FINISHING (NO PICTURE FRAMING) AS DIRECTED BY CITY INSPECTOR.
  - WHITE CURING COMPOUND MUST BE APPLIED UNIFORMLY TO THE CONCRETE SURFACE IMMEDIATELY AFTER FINAL FINISHING.

03 N.T.S.  
SIDEWALK/SHARED-USE PATH DETAIL







05

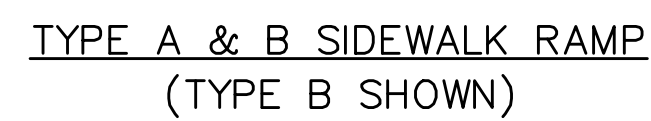

02

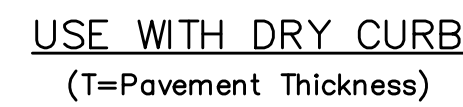

0.5

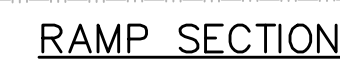

04

NO.

333

drawn by: C.S.M  
checked by: S.M.S  
designed by: C.S.M  
QA/QC by: J.E.S  
project no.: C18-1140  
date: 2020.07.10

SHEET  
C132

MO Certificate of Authority #001592  
1301 BURLINGTON, SUITE 100  
NORTH KANSAS CITY, MO 64116  
TEL 816.361.1177  
www.olsson.com

NOT ASBUILT











1. BACKFILL SHALL BE JOY EXCAVATED MATERIAL FREE FROM DEBRIS AND STONES COMPACTED TO 90% OF MAXIMUM DENSITY AT OPTIMUM MOISTURE CONTENT AS DETERMINED BY ASTM D698 FOR BACKFILL UNDER PAVEMENT (EXISTING OR PROPOSED).
2. TRENCH BANKS MAY BE CUT BACK ON SLOPES IN ACCORDANCE WITH CURRENT OSHA REGULATIONS, BUT ONLY IN AREAS WHERE THE INCREASED TRENCH WIDTH WILL NOT INTERFERE WITH SURFACE FEATURES. SLOPES MUST NOT EXTEND BELOW TOP OF BEDDING.
3. MINIMUM AND MAXIMUM WIDTHS SHALL BE IN ACCORDANCE WITH PIPE MANUFACTURER'S RECOMMENDATION AS APPROVED ON ENGINEERING PLANS.

01 N.T.S. UNDERGROUND PIPE INSTALLATION FROM STORM SEWER LINES

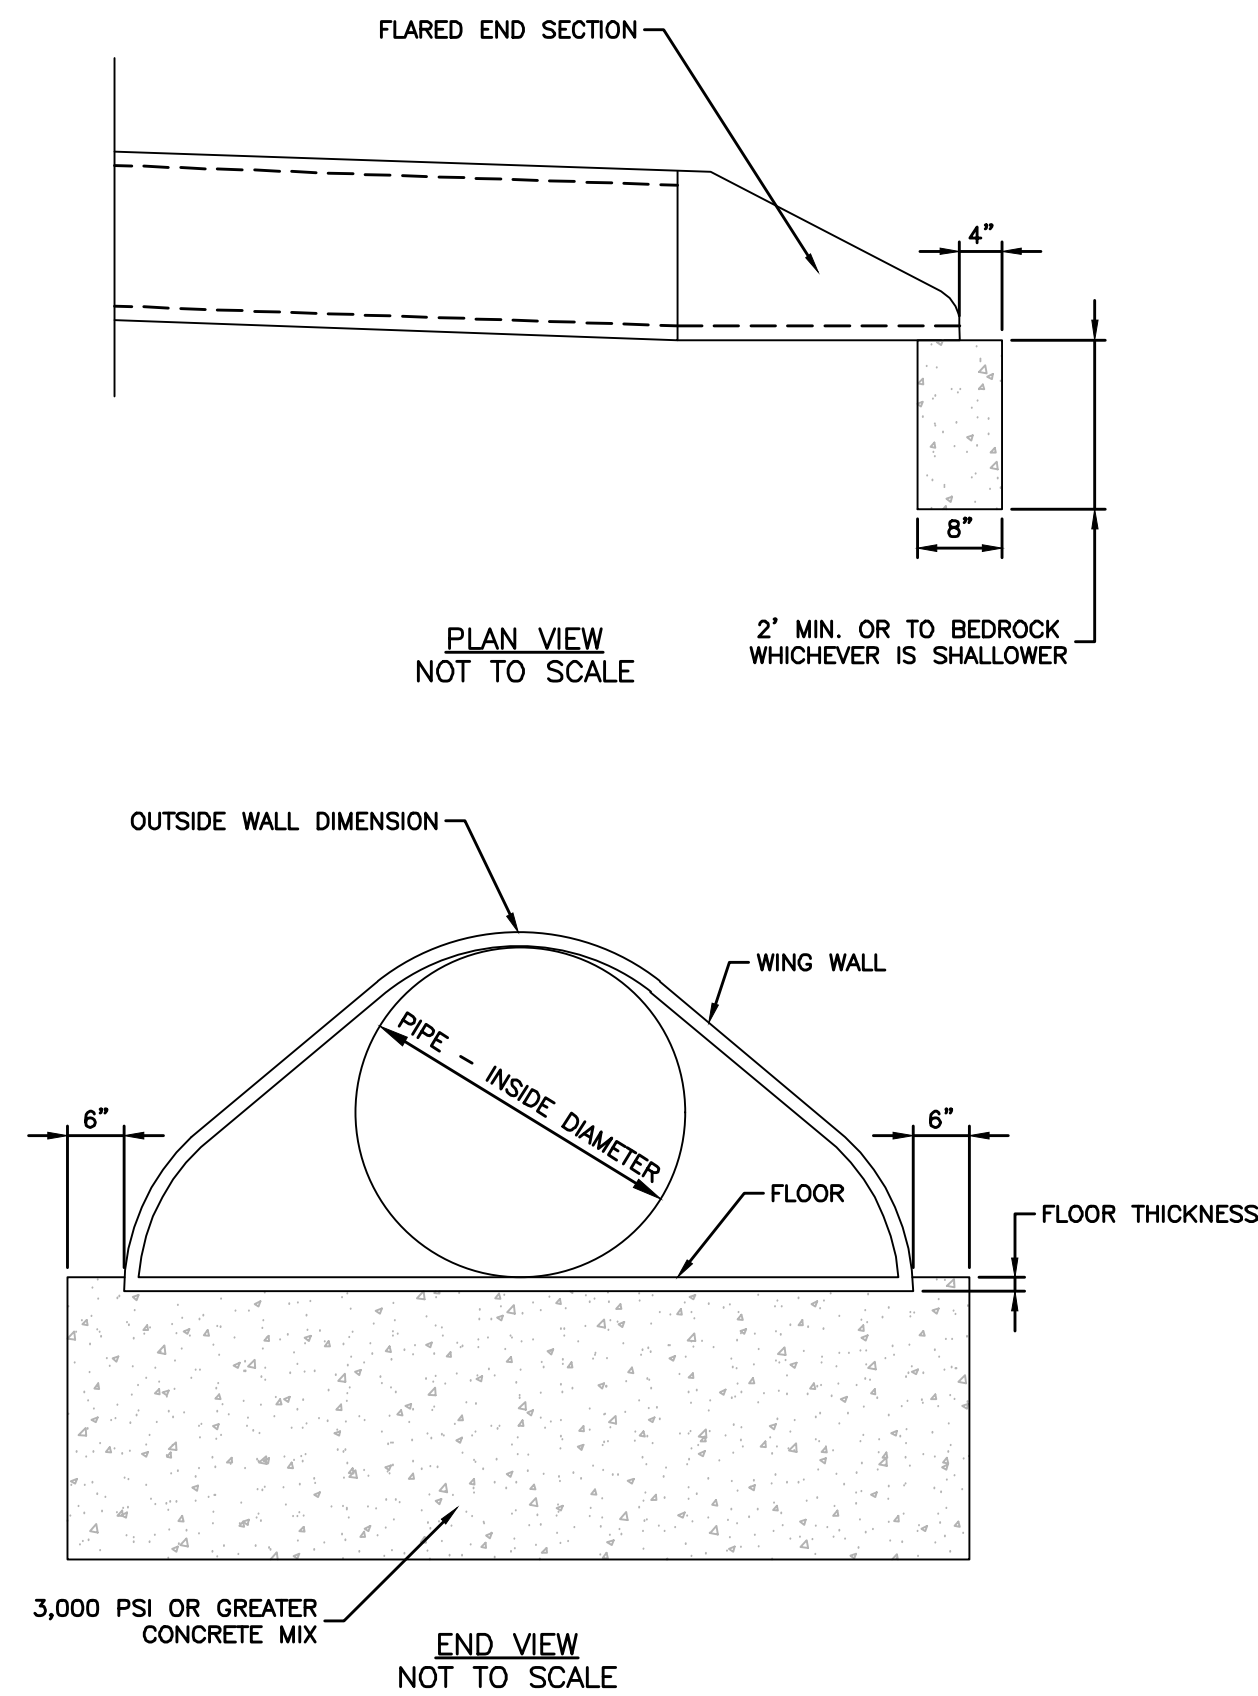

03 N.T.S.  
FLARED END SECTION SUPPORT DETAIL

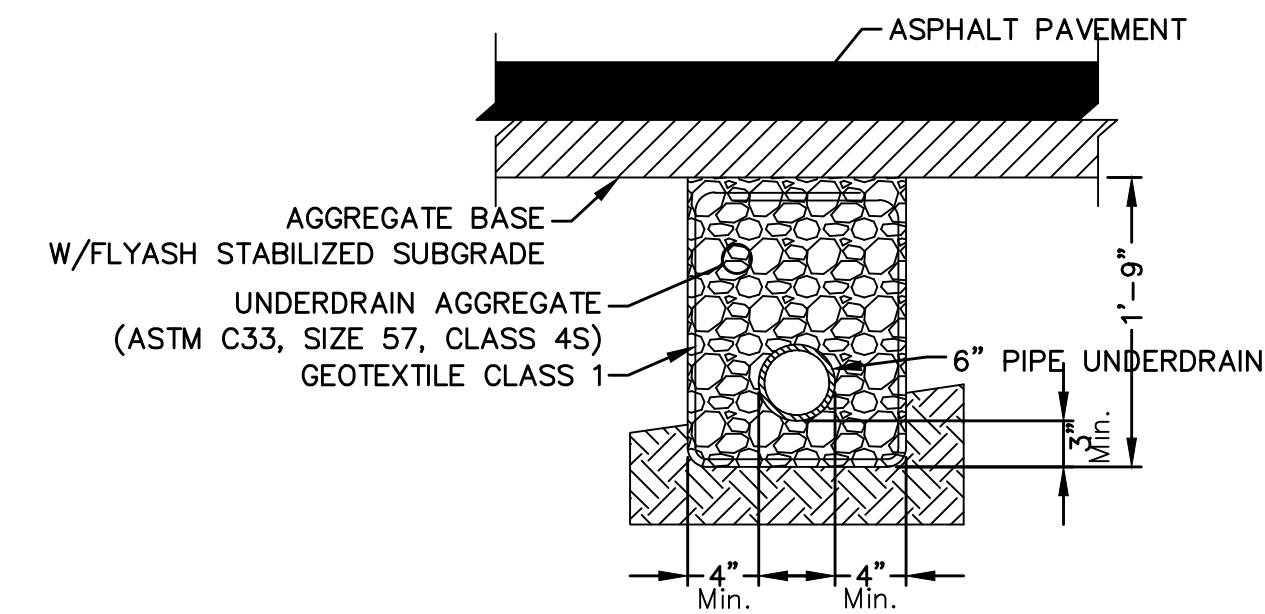

NOTES:


1. Where Pipe Underdrains are used, all Underdrain Outlet Pipes shall be solid wall with watertight joints. All Outlets Pipes shall be tied into the nearest storm sewer inlets at roadway sag locations as indicated in the street profile.
2. All Underdrain Pipes shall be installed at a minimum slope of 1%.
3. Underdrain Pipe shall be installed with the perforations placed down.
4. Blanket Underdrain Aggregate, Pipe Underdrain Aggregate, Pipe Underdrain, Edge Underdrain and Outlet Pipe shall conform to City of Lee's Summit Specifications.
5. Overlap geotextile at top of trench a minimum of 12".

05 N.T.S. PIPE UNDERDRAIN LATERAL

NOT ASBUILT

**olson**

1301 BURLINGTON, SUITE 100  
NORTH KANSAS CITY, MO 64116  
TEL 816.361.1177  
www.olsson.com

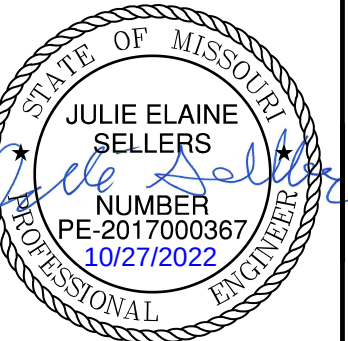[illegible]

|                               |      |
|-------------------------------|------|
| STORM DETAIL SHEET 1          | 2020 |
| STREET & STORM SEWER PLANS    |      |
| WOODSIDE RIDGE<br>SECOND PLAT |      |
| LEE'S SUMMIT, MO              |      |

Drawn by: C.S.M  
 Checked by: S.M.S  
 Designed by: C.S.M  
 A/QC by: J.E.S  
 Project no.: C18-1140  
 Date: 2020.07.10

HEET  
C134



