ELECTRICAL SPECIFICATIONS	ELECTRICAL SPECIFICATIONS (CONTINUED)
1. GENERAL PROVISIONS:	E. BUS BAR BRACING SHALL BE UL LISTED AS INDICATED ON DRAWINGS. ADDITIONAL BRACING SHALL BE PROVIDED AS REQUIRED TO MEET OR EXCEED INDICATED AVAILABLE FAULT
 A. PROVIDE ALL LABOR, MATERIALS, EQUIPMENT, NECESSARY FOR THE COMPLETE INSTALLATION OF THE ELECTRICAL SYSTEMS OUTLINED. B. OBTAIN ALL PERMITS, FEES, LICENSES, INSPECTIONS, AND CERTIFICATES OF COMPLIANCE OR 	CURRENTS. F. DIRECTORY CARDS SHALL BE COMPLETELY FILLED IN BY TYPEWRITER, LISTING CIRCUIT NUMBERS AND LOAD SERVED. INCLUDING EXISTING CIRCUITS. CIRCUIT BREAKERS SHALL BE IDENTIFIED BY CIRCUIT
 C. ALL WORK SHALL BE PERFORMED IN ACCORDANCE WITH THE LATEST APPROVED EDITION OF THE 	NUMBER LABELS AS HEREINBEFORE SPECIFIED.
NATIONAL ELECTRIC CODE (NEC), AND ALL APPLICABLE LAWS, CODES AND REGULATIONS OF THE GOVERNMENTAL BODIES HAVING JURISDICTION OVER THE SITE.	A. DISCONNECTS SHALL BE EXTERNALLY OPERATED, QUICK-MAKE, QUICK-BREAK, SAFETY, WITH PROVISIONS FOR PAD LOCKING. FUSED AND NON-FUSED DISCONNECT SWITCHES SHALL BE PROVIDED AS INDICATED.
D. ALL TESTING REQUIRED BY AUTHORITIES SHALL BE CONSIDERED PART OF THIS WORK. E. DURING CONSTRUCTION, ALL FIXTURES, EQUIPMENT, CONDUIT, ETC. SHALL BE COVERED, PLUGGED, OR CAPPED AS REQUIRED TO KEEP CLEAN AND UNDAMAGED. ALL DAMAGED ITEMS SHALL BE RESTORED TO ORIGINAL CONDITION OR REPLACED. ALL PROTECTIVE COVERING SHALL BE REMOVED BEFORE FINAL ACCEPTANCE.	 B. INDOOR SWITCHES SHALL BE NEMA I AND OUTDOOR SWITCHES SHALL BE NEMA 3R, UNLESS INDICATED OTHERWISE. 12. FUSES:
F. PROVIDE ALL NECESSARY CUTTING AND PATCHING OF WALLS, FLOORS, CEILINGS, AND ROOFS AS NECESSARY. PATCH AROUND ALL OPENINGS SHALL MATCH ADJACENT AREA. COORDINATE ALL	A. FUSES PROTECTING CIRCUIT BREAKER PANELS SHALL BE CURRENT LIMITING U.L. CLASS RK-1 FUSES WITH 200,000 AMPERES RMS SYM INTERRUPTING CAPACITY. FUSING ELEMENTS SHALL BE SILVER FOR RATINGS ABOVE 60 AMPERES.
ROOFING WORK WITH OWNER OR RESPONSIBLE PARTY, SO THAT THE EXISTING ROOFING WARRANTY WILL BE MAINTAINED. G. CONTRACTOR SHALL GUARANTEE ALL WORK AND MATERIALS AGAINST DEFECTS FOR A PERIOD OF ONE YEAR FROM FINAL ACCEPTANCE.	B. ALL OTHER FUSES SHALL BE U.L. CLASS RK-5, DUAL-ELEMENT WITH A MINIMUM TIME-DELAY OF 10 SECONDS AT 500% RATING. FUSES SHALL HAVE CURRENT-LIMITING SHORT-CIRCUIT LINKS AND 200,000 AMPERES RMS SYM INTERRUPTING CAPACITY. FUSING ELEMENTS SHALL BE COPPER.
H. CONTRACTOR SHALL PROVIDE ACCESS PANELS WHERE NECESSARY FOR CONCEALED ELECTRIAL COMPONENTS.	13. LIGHT FIXTURES: A. WHERE LIGHT FIXTURES ARE MOUNTED IN A LAY-IN CEILING, PROVIDE A MINIMUM OF 2 SUPPORT WIRES
 CONTRACTOR SHALL PROMPTLY CALL ENGINEERS ATTENTION TO ANY APPARENT CONTRADICTIONS, AMBIGUITIES, ERRORS, DISCREPANCIES, OR OMISSIONS IN THE PLANS OR SPECIFICATIONS. OPERATION AND MAINTENANCE MANUALS: 	ATTACHED DIRECTLY BETWEEN EACH LIGHT FIXTURE AND THE BUILDING STRUCTURE. SUPPORT WIRES SHALL BE A MINIMUM OF 12 GAUGE GALVANIZED STEEL WIRE, SOFT ANNEALED. B. FIXTURES ARE REQUIRED AT ALL LIGHTING OUTLETS SHOWN ON THE DRAWINGS. APPROVED LIGHTING FIXTURE WIRE IS REQUIRED IN ALL FIXTURES AND FIXTURE RACEWAYS. WEATHERPROOF WIRING IS
 A. DURING THE COURSE OF CONSTRUCTION, COLLECT AND COMPILE OPERATING INSTRUCTIONS, WIRING DIAGRAMS, CATALOG CUTS, LUBRICATION AND PREVENTIVE MAINTENANCE INSTRUCTIONS, PARTS LISTS, ETC. FOR ALL EQUIPMENT FURNISHED UNDER THIS CONTRACT. B. ALL LITERATURE AND INSTRUCTIONS SHIPPED WITH THE EQUIPMENT SHALL BE SAVED FOR INCLUSION 	REQUIRED FOR EXTERIOR FIXTURES. ALL PARTS OF FIXTURES AND WIRING SHALL BE IN ACCORDANCE WITH NEC REQUIREMENTS. C. ALL FIXTURES SHALL CARRY UL AND ETL LABELS. 14. SLEEVES:
IN THE OPERATION AND MAINTENANCE MANUALS.	A. PROVIDE, SET, AND PROPERLY LOCATE PIPE SLEEVES AS REQUIRED FOR THIS WORK.
AND LABELED WITH THE PROJECT NAME, ADDRESS, ARCHITECT, ENGINEER, CONTRACTORS, ETC. CONTRACTORS, ETC. DOCUMENTS SHALL BE COMPILED AND BOUND IN DIGITAL FILE OR 3 RING BINDER.	B. INTERIOR PARTITIONS: 16 GAGE GALVANIZED STEEL, PACK BETWEEN CONDUIT AND SLEEVE WITH FIRE SAFING AND CAULK AT EACH END WITH FIRE RESISTANT SEALANT.
3. MANUFACTURERS: A. MANUFACTURERS, MODEL NUMBERS, ETC. INDICATED OR SCHEDULED ON THE DRAWINGS SHALL BE	C. ROOF: PROSET OR EQUAL, MANUFACTURED PVC SCHEDULE 40 PIPE SLEEVE WITH WEATHERPROOF SEAL. COORDINATE WITH ROOFING CONTRACTOR AND FLASH AS REQUIRED TO MAINTAIN ROOF WARRANTY.
INTERPRETED AS HAVING ESTABLISHED A STANDARD OF QUALITY AND SHALL NOT BE CONSTRUED AS LIMITING COMPETITION. ARTICLES, FIXTURES, ETC. OF EQUAL QUALITY BY MANUFACTURERS SHALL BE ACCEPTABLE, SUBJECT TO STRUCTURAL AND ELECTRICAL CONSTRAINTS OF THE PROJECT DESIGN, UNLESS NOTED OTHERWISE.	 GROUNDING: A. GROUND ALL ELECTRICAL APPARATUS IN ACCORDANCE WITH THE NATIONAL ELECTRIC CODE (NEC) 250, AND ANY LOCAL REQUIREMENTS. INSURE CONTINUOUS BOND WHERE FLEXIBLE CONDUIT IS USED. PROVIDE BONDING JUMPER INSIDE ALL FLEXIBLE CONDUIT.
4. TESTING, AND BALANCING: A. ALL CIRCUITS SHALL BE TESTED FOR CONTINUITY, SHORTS, AND GROUNDS BEFORE CONNECTING TO THE	B. BOND METAL PIPING SYSTEMS IN COMPLIANCE WITH NEC 250.4(A)(4).
PROPER PHASE AS DESIGNED TO BALANCE THE LOADING BETWEEN PHASES. B. POWER AND LIGHTING PANELS SHALL BE PROPERLY PHASED TO DISTRIBUTE THE LOAD AND SHALL BE CONNECTED AND ADJUSTED TO OPERATE AS SPECIFIED.	16. REMODELING WORK: A. DEMOLITION: DISCONNECT, DEMOLISH AND REMOVE ABANDONED ELECTRICAL MATERIALS AND EQUIPMENT
C. ALL MOTORS AND SIMILAR EQUIPMENT SHALL BE CHECKED FOR PROPER PHASE ROTATION AND OPERATION.	INDICATED TO BE REMOVED AND NOT INDICATED TO BE SALVAGED OR REMAIN. B. EQUIPMENT TO BE SALVAGED:
5. RACEWAYS: A. CONDUIT INSIDE THE BUILDING SHALL BE METALLIC TUBING (EMT), BEARING THE UL LABEL, WITH	 DISCONNECT AND REMOVE EXISTING ELECTRICAL EQUIPMENT INDICATED TO BE REMOVED AND SALVAGED. DELIVER EQUIPMENT TO THE LOCATION DESIGNATED BY THE OWNER FOR STORAGE.
COMPRESSION TYPE FITTINGS OR SCREW SET FITTINGS. B. CONDUIT EXPOSED TO THE WEATHER, INSTALLED UNDERGROUND, IN CONCRETE, OR USED FOR SERVICE ENTRANCE SHALL BE STANDARD RIGID CONDUIT (GALVANIZED) WITH THREADED FITTINGS.	2) ALL MATERIALS AND EQUIPMENT DESIGNATED TO BE REUSED OR RELOCATED SHALL BE CAREFULLY REMOVED, AND STORED UNTIL NEEDED FOR REMODELING WORK. ALL ITEMS SHALL BE RESTORED TO "LIKE NEM" CONDITION WITH RUST OR CORROSION REMOVED. SURFACE PAINT TOUCHED UP OR
C. UNDERGROUND CONDUIT MAY BE POLYVINYL CHLORIDE WITH A DEFLECTION TEMPERATURE, UNDER LOAD AT 264 PSI, OF 78 DEGREES C, AND A TENSILE STRENGTH OF 5,200 PSI. JOINTS SHALL BE FLUSH SOLVENT WELDED IN ACCORDANCE WITH THE MANUFACTURER'S INSTRUCTIONS. CONDUIT SHALL BE EQUAL TO CARLON POWER AND COMMUNICATIONS DUCT TYPE DB (DIRECT BURIAL). CONDUIT AND FITTINGS	REPAINTED AS REQUIRED TO MATCH NEW CONSTRUCTION, AND THOROUGHLY CLEANED AND INSPECTED. ANY ITEMS WHICH BECOME DAMAGED BEYOND REPAIR AS A RESULT OF CONSTRUCTION OR DEMOLITION ACTIVITY SHALL BE REPLACED WITH NEW MATERIAL EQUIVALENT IN EVERY RESPECT.
SHALL BE PRODUCED BY THE SAME MANUFACTURER. D. FLEXIBLE METAL CONDUIT SHALL ONLY BE USED FOR CONNECTIONS TO MOTORS,	EQUIPMENT NOT INDICATED TO BE SALVAGED. D. PROTECT ADJACENT MATERIALS INDICATED TO REMAIN. INSTALL AND MAINTAIN DUST AND NOISE
TRANSFORMERS, AND LIGHT FIXTURES. MAXIMUM LENGTH SHALL BE 6'-0". 6. CONDUCTORS:	BARRIERS TO KEEP DIRT, DUST, AND NOISE FROM BEING TRANSMITTED TO ADJACENT AREAS. REMOVE PROTECTION AND BARRIERS AFTER REMODELING OPERATIONS ARE COMPLETE.
 A. WIRES SHALL BE CONTINUOUS WITHOUT SPLICES OR TAPS IN CONDUIT RUNS. ALL SPLICES SHALL BE MADE IN JUNCTION, PULL, OR OUTLET BOXES. ALL WIRE SHALL BE INSTALLED IN CONDUIT, WIREWAYS, OR OTHER PROTECTIVE COVER SANCTIONED BY CODES. B. CONDUCTORS FOR LIGHTING AND POWER SHALL BE COPPER, MINIMUM NO. 12 A.W.G., 600 VOLT. 	E. PROVIDE ALL ALTERATIONS AND REWORK INDICATED AND/OR REQUIRED FOR THE PROPER INSTALLATION AND OPERATION OF ALL EXISTING ELECTRICAL SYSTEMS, INTEGRATING THE NEW AND EXISTING AREAS. LOCATE, IDENTIFY, AND PROTECT ELECTRICAL SERVICES PASSING THROUGH REMODELING AREA AND SERVING OTHER AREAS OUTSIDE THE REMODELING LIMITS. MAINTAIN SERVICES TO AREAS OUTSIDE REMODELING LIMITS. WHEN SERVICES MUST BE INTERRUPTED, INSTALL TEMPORARY SERVICES FOR AFFECTED AREAS.
C. NO. 10 GAUGE AND SMALLER CONDUCTORS SHALL BE TYPE THWN (WET LOCATIONS) OR THHN (DRY LOCATIONS), SOLID CONDUCTOR, UNLESS OTHERWISE INDICATED.	AFFECTED AREAS. 1) ABANDONED CONDUIT SHALL HAVE WIRE REMOVED AND SHALL BE CAPPED. ABANDONED OUTLETS IN WALLS OR PARTITIONS SHALL HAVE DEVICES AND WIRE REMOVED, AND SHALL BE COVERED.
 D. NO. 8 GAUGE AND LARGER CONDUCTORS SHALL BE TYPE THWN (WET LOCATIONS) OR THHN (DRY LOCATIONS), STRANDED, UNLESS OTHERWISE INDICATED. E. SERVICE ENTRANCE AND PANEL FEEDER CONDUCTORS, NO. 3 GAUGE AND LARGER SHALL BE TYPE 	2) WHERE EXISTING CONDUITS TERMINATE AT AN EXISTING OUTLET IN A WALL, CEILING, OR FLOOR TO BE REMOVED, DISCONNECT AND REMOVE DEVICE AND WIRE FROM CONDUIT. CONDUIT SHALL BE
 SLINVIGE LINITANCE AND FARLE FLEDER CONDUCTING, NO. 5 CALCE AND EARCER SHALL DE THE E XHHW-2 (WET LOCATIONS) OR THHN (DRY LOCATIONS), STRANDED COPPER, UNLESS OTHERWISE INDICATED. MC CABLE: 	CUT BACK AND CAPPED (BELOW THE FLOOR OR ABOVE THE CEILING) SO NOT TO CREATE AN OBSTRUCTION. PATCH FLOOR TO MATCH EXISTING. 3) WHERE EXISTING CIRCUITS EXTEND BEYOND THE OUTLET IN THE EXISTING WALL, CEILING, OR
A. MC CABLE SHALL CONSIST OF INTERLOCK ARMORED CABLE MADE OF THREE OR FOUR TYPE THHN SOLID (#8 AWG AND LARGER MAY BE STRANDED) COPPER CONDUCTORS RATED 90°C FOR DRY LOCATIONS, WITH NYLON OR EQUIVALENT UL LISTED JACKET, PER UL STANDARD 83 THE THREE CONDUCTORS SHALL BE TWISTED TOGETHER WITH THE COPPER GROUNDING CONDUCTOR, SUITABLE FILLERS, AND WRAPPED IN BINDER TAPE. THE ASSEMBLY SHALL BE ARMORED WITH SPIRALLY WRAPPED INTERLOCKED ARMOR OF ALUMINUM OR GALVANIZED	FLOOR TO BE REMOVED, FURNISH AND INSTALL NEW CONDUIT AND WIRE TO EITHER REROUTE THE CIRCUIT OR FEED THE REMAINING OUTLET(S) FROM ANOTHER ELECTRICAL SOURCE, BUT IN SUCH A MANNER AS NOT TO REVISE THE CIRCUIT. ALL REROUTED CONDUIT SHALL BE APPROVED BY THE ARCHITECT. 4) WHERE EXISTING OUTLETS IN A WALL, CEILING, OR FLOOR TO BE REMOVED ARE ESSENTIAL TO
STEEL. B. CABLES SHALL BE TESTED IN ACCORDANCE WITH UL STANDARD 1569 FOR TYPE MC CABLE AND RATED	MAINTAIN OPERATION OF OTHER REMAINING OUTLETS, RELOCATE THE OUTLET TO A NEW CONVENIENT LOCATION. EXISTING WIRING DEVICES SHALL NOT BE REUSED, UNLESS OTHERWISE INDICATED.
AT 600 VOLTS, 90 DEG. C FOR DRY LOCATIONS AND 75 DEG. C FOR WET LOCATIONS. C. MC CABLE INSTALLED IN PATIENT CARE AREAS SHALL BE "HCF" TYPE WITH GREEN INSULATED COPPER GROUNDING CONDUCTOR, BARE ALUMINUM GROUNDING/BONDING CONDUCTOR AND INTERLOCKED GREEN	5) WHERE LIGHTING FIXTURES ARE INDICATED TO BE DEMOLISHED, REMOVE ALL WIRE AND MODIFY THE EXISTING CONDUIT (IF APPLICABLE) FOR THE NEW LIGHTING. ALL UNUSED CONDUIT SHALL BE REMOVED.
ALUMINUM ARMOR LISTED FOR USE AS AN EQUIPMENT GROUNDING CONDUCTOR IN CONJUCTION WITH THE BARE ALUMINUM BONDING CONDUCTOR. 1) CABLES SHALL MEET ALL NEC REQUIREMENTS FOR ARTICLE 517 AND SHALL BE UL LISTED FOR USE IN HEALTH CARE FACILITIES.	 6) WHERE A TELEPHONE CIRCUIT EXTENDS BEYOND AN OUTLET IN AN EXISTING WALL, CEILING, OR FLOOR TO BE REMOVED, PROVIDE NECESSARY EMPTY CONDUIT AND NOTIFY THE OWNER WHO WILL REQUEST THE OWNER TO ARRANGE WITH THE TELEPHONE COMPANY FOR NEW WIRING TO OUTLETS THAT REMAIN. 2) INVERE EXISTING CONDUCT AND INVERTIGATED IN OR ATTACHED TO AN EXISTING WALL.
2) HCF CABLE SHALL NOT BE USED IN HAZARDOUS ANESTHETIZING AREAS.8. WIRING DEVICES:	7) WHERE EXISTING CONDUIT AND WIRE RUNS ARE LOCATED IN OR ATTACHED TO AN EXISTING WALL, CEILING OR FLOOR TO BE REMOVED, THEY SHALL BE REROUTED IN EITHER NEW OR EXISTING CONSTRUCTION TO MAINTAIN CONTINUITY OF CIRCUITS UNLESS OTHERWISE INDICATED.
A. WALL SWITCHES SHALL BE SPECIFICATION GRADE, QUIET TYPE, FLUSH TOGGLE SWITCH, RATED FOR 20 AMPS, WITH THERMOPLASTIC COVER PLATES.	8) CONDUIT SHALL BE CONCEALED WITHIN THE EXISTING BUILDING CONSTRUCTION WHEREVER POSSIBLE, EXCEPT WHERE OTHERWISE INDICATED.
1) SINGLE POLE: HUBBELL #CS1221-X, OR EQUAL. 2) THREE WAY: HUBBELL #CS1223-X, OR EQUAL. 3) AS SPECIFIED ON PLANS	 9) EXISTING WIRE SHALL BE DISCONNECTED AND REMOVED WHEREVER EXISTING CIRCUITS ARE ABANDONED. 17. BOXES IN FIRE RATED ASSEMBLIES:
B. RECEPTACLES SHALL BE SPECIFICATION GRADE, DUPLEX, GROUNDING, THREE-WIRE TYPE, RATED FOR 20 AMPS, WITH THERMOPLASTIC COVER PLATES. HUBBELL #CR5352-X, OR EQUAL.	A. OUTLET BOXES THAT DO NOT EXCEED 16 SQUARE INCHES AND INSTALLED IN FIRE RATED WALLS SHALL NOT BE INSTALLED CLOSER THAN 24" HORIZONTAL INCHES TO OTHER OUTLET BOXES.
C. GROUND FAULT INTERRUPTER RECEPTACLES (GFI) SHALL BE HUBBELL #GF20-XL. DEVICE COVER PLATES SHALL BE AS HEREINBEFORE SPECIFIED.	B. IF BOXES MUST BE INSTALLED WITHIN 24" OF EACH OTHER THAN BOTH OUTLET BOXES SHALL BE PROTECTED WITH LISTED PUTTY PADS, 3M FIRE BARRIER MOLDABLE PUTTY + OR EQUAL.
D. ISOLATED GROUND RECEPTACLES (IG) SHALL BE HUBBELL #CR5352IG, ORANGE COLOR. DEVICE COVER PLATES SHALL BE AS HEREINBEFORE SPECIFIED.	18. FIRE ALARM SYSTEM (AEGIS FIRE PROTECTION): ELECTRICAL CONTRACTOR SHALL PROVIDE DESIGN BUILD ENERGINEERED SHOP DRAWINGS OF FIRE
 E. RECEPTACLES OUTSIDE BUILDING AND WHERE NOTED AS WEATHERPROOF, SHALL BE LISTED 'WEATHER- RESISTANT' HUBBEL #GFTR20-X OR EQUAL AND SHALL BE INSTALLED IN A WEATHERPROOF ENCLOSURE WHICH SHALL BE INTERMATIC #WP1010MXD OR #WP1010HMXD DIECAST METAL WEATHERPROOF RECEPTACLE COVER. COVER SHALL BE WEATHER PROOF RATED WHILE IN USE. F. VERIFY DEVICES AND DEVICE COVERPLATES COLOR AND STYLE WITH ARCHITECT. 	ALARM SYSTEM TO BE INSTALLED. PROVIDE DEVICES, CONDUIT, WIRES, CABLE, PROGRAMMING AND TESTING AS DIRECTED BY EQUIPMENT MANUFACTURER AND LOCAL FIRE DEPARTMENT FOR A CODE COMPLIANT FIRE ALARM/DETECTION SYSTEM. MATERIALS, EQUIPMENT, AND WORKMANSHIP SHALL MEET PREVAILING CODES. THE SYSTEM SHALL BE COMPLETE AND OPERABLE. SUBMIT ONE LINE DIAGRAM OF SYSTEM WITH SIZES AND BATTERY CALCULATIONS. EQUIPMENT TO BE NEW AND SHALL BE STAMPED, SIGNED. CALIBRATION AND TESTED BY FACTORY CERTIFIED TECHNICIAN. FIRE ALARM DEVICES ARE
	SIGNED, CALIDRATION AND TESTED BT FACTORT CERTIFIED TECHNICIAN. THE ALARM DEVICES ARE SHOWN FOR INTENT ONLY FOR PERMITTING PROCESS. CONTRACTOR IS RESPONSIBLE FOR INCLUDING IN BID/DESIGN ALL NECESSARY DEVICES (ANNUNCIATOR(S), NOTIFICATION APPLICANCES, INITIATING DEVICES, AND ADDITIONAL COMPONENTS).
A. HOT DIPPED GALVANIZED STEEL BOXES. PROVIDE TYPE TO SUIT CONDITIONS FOR INSTALLATION. B. ALL BOXES SHALL BE FLUSH MOUNTED, UNLESS INDICATED OTHERWISE.	
10. PANELBOARDS: A. FURNISH AND INSTALL CIRCUIT BREAKER PANELBOARDS AS SHOWN ON THE DRAWINGS. PANELBOARDS	
SHALL BE LISTED BY UL AND SO LABELED, AND SHALL BE FULLY RATED FOR THE VOLTAGE AND CURRENT CAPACITY INDICATED ON THE PANEL SCHEDULE. PANELBOARDS SHALL BE EQUAL TO SQUARE D TYPE NQ OR NF WITH BOLT IN TYPE BREAKERS. PANELBOARD LUGS SHALL BE RATED AT 75°C. 1) CIRCUIT BREAKER INTERRUPTING CAPACITIES SHALL MEET OR EXCEED THE AVAILABLE RMS	
SYMMETRICAL FAULT CURRENTS INDICATED AND AS REQUIRED TO MEET OR EXCEED THE AVAILABLE FAULT CURRENT FROM LOCAL UTILITY. B. CIRCUIT BREAKERS SHALL MEET APPLICABLE PORTIONS OF UL STANDARD 489 AND NEMA AB-L. CIRCUIT	
BREAKERS SHALL BE BOLT-ON, GROUP MOUNTED, AMBIENT MAGNETIC, WITH COMMON TRIP, UL RATED TO CARRY 80% OF NAMEPLATE RATING CONTINUOUSLY IN FREE AIR AT 40° C. CIRCUIT BREAKERS SHALL BE TRIP INDICATING AND FULLY INTERCHANGEABLE WITHOUT DISTURBING ADJACENT UNITS. WIRE TERMINALS SHALL BE RATED 75 DEGREES C. THE OPERATING MECHANISM SHALL BE TRIP-FREE SO THAT CONTACTS CANNOT BE HELD CLOSED AGAINST ANY ABNORMAL OVERCURRENT OR SHORT CIRCUIT CONDITION.	
 a) BREAKERS SHALL MEET APPLICABLE NEMA AND/OR UL SPECIFICATIONS. C. PANELBOARD BOXES SHALL BE GALVANIZED SHEET STEEL WITH AMPLE WIRING GUTTER SPACE IN ACCORDANCE WITH NEC. FRONTS SHALL BE OF SHEET STEEL PAINTED LIGHT GREY OVER A SUITABLE RUST INVERTOR REINER. RANEL BOARDS GUALL BE FOURPED WITH ONE RECE DOOR. (MINDER) 	
RUST INHIBITOR PRIMER. PANELBOARDS SHALL BE EQUIPPED WITH ONE PIECE DOOR, CYLINDER TUMBLER TYPE LOCK, DIRECTORY CARD-HOLDER AND QUARTER-TURN ADJUSTABLE TRIM CLAMPS.	

D. PANELBOARD INTERIORS SHALL CONSIST OF REINFORCED GALVANIZED SHEET STEEL FRAMES WITH ALUMINUM

BUS BARS AND CIRCUIT BREAKERS, PROPERLY SUPPORTED TO PREVENT VIBRATIONS AND BREAKAGE IN HANDLING. BUS BARS SHALL BE SEQUENCE PHASED. PANELBOARD SHALL HAVE A FULL SIZED SOLID

ALUMINUM NEUTRAL AND GROUND BUS.

CAL SPECIFICATIONS (CONTINUED)

ISTING ELECTRICAL EQUIPMENT INDICATED TO BE REMOVED AND ENT TO THE LOCATION DESIGNATED BY THE OWNER FOR STORAGE

 \bigcirc

 \bigcirc

CIRCUITING	¢ NOTES
+46"	SPECIAL MOUNTING HEIGHT FOR ASSOCIATED DEVICE (CENTERLINE OF DEVICE)
GFI	GROUND FAULT CIRCUIT INTERRUPTER DEVICE
MP	MEATHERPROOF ENCLOSURE ON DEVICE
E	EXISTING DEVICE TO REMAIN
	ELECTRICAL FLOOR PLAN NOTE WITH DESIGNATION
	CONDUIT CONCEALED WHERE POSSIBLE OR AS NOTED, ARROWS INDICATE HOME RUN TO PANEL. CIRCUIT NUMBERS INDICATED
	#12 WIRE IN CONDUIT, UNLESS NOTED OTHERWISE ON DRAWINGS OR SPECIFICATION
\sim	GROUNDING CONDUCTOR, #12 WIRE UNLESS NOTED OTHERWISE ON DRAWINGS OR SPECIFICATION
~~~	CONDUIT ROUTED UNDER FLOOR/GRADE
LIGHTING	
1 1 1 1	EMERGENCY TWIN HEAD LIGHT FIXTURE
181	EXIT LIGHT WITH DIRECTIONAL ARROWS INDICATED
	STRIP FIXTURE WITH TYPE DESIGNATION
A •	RECESSED OR SURFACE MOUNTED FIXTURE WITH TYPE DESIGNATION
ANL	NIGHT LIGHT, CONNECT TO UNSWITCHED CIRCUIT
۸Q	CEILING OR RECESSED FIXTURE WITH TYPE DESIGNATION
^ Q-	WALL MOUNTED FIXTURE WITH TYPE DESIGNATION
POWER DE	VICES
¢	DUPLEX RECEPTACLE, BOTTOM OF BOX AT 16" AFF, UNLESS NOTED OTHERWISE
ф	FOURPLEX RECEPTACLE, BOTTOM OF BOX AT 16" AFF, UNLESS NOTED OTHERWISE
♦▽	DEVICE MOUNTED ABOVE COUNTER AND/OR SPLASH GUARD
	HEAVY DUTY OUTLET - NEMA CONFIGURATION SIZE PER EQUIPMENT MANUFACTURER'S RECOMMENDATION
	PANEL BOARD, TOP OF BOX 6'-0" AFF
Q	JUNCTION BOX
L D	NON-FUSED DISCONNECT SWITCH
	FUSED DISCONNECT SWITCH
<u>·</u>	MOTOR WITH DESIGNATION
CONTROLS	
5	SINGLE POLE WALL SWITCH, TOP OF BOX AT 48" AFF
52	TWO POLE WALL SWITCH, TOP OF BOX AT 48" AFF
S₃	THREE-WAY WALL SMITCH, TOP OF BOX AT 48" AFF
Sm	MANUAL MOTOR STARTER WITH OVERLOADS
Ś.⊳	DIMMER SWITCH, TOP OF BOX AT 48" AFF. VERIFY DIMMER TYPE AND COMPATIBILITY WITH FIXTURE (0-10V, ELV, LINE VOLTAGE)
<b>\$</b> 3D	THREE WAY DIMMER SWITCH, TOP OF BOX AT 48" AFF. VERIFY DIMMER TYPE AND COMPATIBILITY WITH FIXTURE (0-10V, ELV, LINE VOLTAGE)
COMMUNIC	ATIONS
•	DATA/TELEPHONE OUTLET WITH MINIMUM $\frac{3}{4}$ " CONDUIT STUBBED UP TO ABOVE ACCESSIBLE CEILING, BOTTOM OF BOX AT 16", UNLESS NOTED OTHERWISE. PROVIDE WITH PULL STRING
	FLAT SCREEN TELEVISION - PROVIDE AND INSTALL ONE (1) HUBBELL #RR1510X RECESSED TAMPER-RESISTANT DUPLEX RECEPTACLE WITH COVERPLATE AND ONE(1) HUBBELL #HBL260 TWO GANG LARGE CAPACITY WALL BOX (UP TO 2" KNOCKOUT) W/ MUD RING AND COVERPLATE FOR DATA. PROVIDE 2"C WITH PULL STRING TO ABOVE ACCESSIBLE CEILING FOR DATA CABLES. MOUNT BOX AT 7'-6" AFF UNLESS NOTED OTHERWISE (VERIFY)
	$\underline{M}$ - FIRE ALARM SYSTEM IS EXISTING TO REMAIN. PROVIDE COMPATIBLE DEVICES AND CONNECT TO EXISTING SYSTEM AS
Ø	DUCT MOUNT SMOKE DETECTOR
×	FIRE ALARM HORN/STROBE COMBINATION SIGNAL, CENTERLINE AT 6'-8" AFF
Ø	FIRE ALARM VISUAL STROBE, CENTERLINE AT 6'-8" AFF
R	RELAY TO SHUT DOWN FAN POWERED BOX IN ALARM CONDITION
MISCELLAN	EOUS
	COMBINATION POWER AND DATA FLOORBOX

COMBINATION POWER AND DATA FLOORBOX

LINE VOLTAGE THERMOSTAT

ELECTRICAL SYMBOLS LIST

ELECTRICAL GENERAL NOTES:

- SURFACE AS REQUIRED.
- OF THE SYSTEM REGARDLESS OF CIRCUITING INDICATED.
- ETC. NOT BEING REUSED. DO NOT JUST ABANDON.

- STRUCTURE.

10. EACH BRANCH CIRCUIT SHALL HAVE A DEDICATED NEUTRAL PER NEC 210.4.

- FOR COMPLIANCE WITH CODE.

13. PROVIDE LOW VOLTAGE WIRING BETWEEN ALL 0-10V DIMMING DRIVERS CONTROLLED BY 0-10V DIMMERS PER MANUFACTURER'S INSTRUCTIONS WHETHER INDICATED ON PLANS OR NOT.



1. COORDINATE ALL WORK WITH OTHER TRADES AND EXISTING CONDITIONS AS REQUIRED TO PROPERLY INSTALL ALL SYSTEMS AS INTENDED, WITHIN THE CONFINES OF THE SPACES AVAILABLE, AND WITHOUT INTERFERENCES.

2. WHERE CONDUIT IS SHOWN UNDER FLOOR, SAW CUT EXISTING FLOOR SLAB AS REQUIRED FOR INSTALLATION OF UNDER FLOOR CONDUIT. NO STRUCTURAL ELEMENTS SHALL BE OR SAW CUT. WHEN SAW CUTTING, PATCH FLOOR TO MATCH EXISTING

3. IT IS THE ELECTRICAL CONTRACTORS RESPONSIBILITY TO PROPERLY BALANCE ALL BRANCH CIRCUITS BETWEEN THE PHASES

4. ALL EXPOSED RACEWAYS SHALL BE IN EMT CONDUIT, MC CABLE IS NOT PERMITTED IN EXPOSED AREAS.

5. ELECTRICAL CONTRACTOR SHALL REMOVE ALL EXISTING ELECTRICAL EQUIPMENT, FIXTURES, SYSTEMS, CONDUIT AND WIRE,

6. ELECTRICAL CONTRACTOR TO COORDINATE MANUFACTURER ELECTRICAL REQUIREMENTS FOR HVAC EQUIPMENT BEING FURNISHED WITH MECHANICAL CONTRACTOR PRIOR TO ROUGH-IN. EQUIPMENT DISCONNECTS TO BE PROVIDED BY ELECTRICAL CONTRACTOR UNLESS NOTED OTHERWISE IN MECHANICAL SCHEDULES.

7. REFER TO ARCHITECTURAL DRAWINGS FOR EXACT LOCATION OF LIGHT FIXTURES AND DEVICES.

8. REFER TO ARCHITECTURAL & STRUCTURAL DRAWINGS FOR REQUIREMENTS FOR SUPPORTING TRANSFORMERS, EQUIPMENT, ETC. FROM THE STRUCTURE. PROVIDE ADDITIONAL STEEL AS REQUIRED TO PROPERLY SUPPORT SYSTEMS FROM THE

9. ALL MATERIALS EXPOSED WITHIN PLENUMS SHALL BE NONCOMBUSTIBLE OR SHALL HAVE A FLAME SPREAD INDEX OF NOT MORE THAN 25 AND A SMOKE-DEVELOPED INDEX OF NOT MORE THAN 50 WHEN TESTED IN ACCORDANCE WITH ASTM E 84.

11. FIRE ALARM SYSTEM (AEGIS FIRE PROTECTIONS) IS SHOWN FOR SCHEMATIC PURPOSES. THE FIRE ALARM CONTRACTOR IS RESPONSIBLE FOR PROVIDING DESIGN AND SHOP DRAWINGS SUBMITTAL TO FIRE MARSHAL FOR APPROVAL AS REQUIRED BY THE FIRE MARSHAL. IT IS THE CONTRACTORS RESPONSIBILITY TO PROVIDE ADDITIONAL DEVICES, POWER SUPPLIES, ETC

12. ALL BRANCH CIRCUITS SHALL BE SIZED TO ALLOW FOR A MAXIMUM OF 3% VOLTAGE DROP. ALL FEEDERS SHALL BE SIZED TO ALLOW FOR A MAXIMUM OF 2% VOLTAGE DROP. ELECTRICAL CONTRACTOR SHALL VERIFY WIRING INDICATED IS SUFFICIENT AND INCREASE CONDUCTOR SIZE AS REQUIRED BASED OFF ACTUAL INSTALLED LENGTH OF CONDUCTORS.

14. REFER TO ARCHITECTURAL ELEVATIONS FOR MOUNTING HEIGHT OF POWER/DATA OUTLETS.

HEALTH CARE FACILITY NOTES

1. PATIENT AREAS (DRAW AND ALL EXAM) SHALL COMPLY WITH NEC ARTICLE 517 FOR HEALTH CARE FACILITIES.

2. ALL BRANCH CIRCUITS SUPPLYING PATIENT AREAS (DRAW AND ALL EXAM) SHALL HAVE REDUNDANT GROUNDING PER NEC 517.13(a) & (b). ALL UNDER FLOOR CONDUITS FOR BRANCH CIRCUITS SHALL BE METALLIC.

3. ALL DEVICES IN PATIENT CARE AREAS (DRAW AND ALL EXAM) SHALL BE HOSPITAL GRADE, GROUNDING, THREE WIRE TYPE, RATED FOR 20 AMPS, WITH COVER PLATES. HUBBELL #HBL8300-H, OR EQUAL. VERIFY COLOR WITH ARCHITECT.

BC PROJECT #:	21759
MISSOURI	PE COA #2009003629
an instrument of service by the Designer to the Architectural Works Copyright Pro designs, including the overall form, arrar herein, constitute the original, copyrighte	Engineer, or under his supervision. This drawing is provided as /Engineer and is intended for use on this project only. Pursuant tection Act of 1990, all drawings, specifications, ideas and gement and composition of spaces and elements appearing ed work of the Designer/Engineer. Any reproduction, use, or in without prior written consent of the Engineer is strictly



WWW.HJMARCH.COM 10/28/2022 C OF MISS " BRETT M HERMANN

ARCHITE 10/28/2025

7520 WASHINGTON ST

KANSAS CITY, MO 64114

HJM

**RELEASED FOR** CONSTRUCTION As Noted on Plans Review

ment Services I


NUMBER PE-2018035615


0 ⊢ O Ζ LL R R L Ľ Y S ш C. Ζ Ш

Ζ


AD 08,0 AY R0/ M0 64( ~ ഗ Ш. о́ Ш 4

|>|-| < | < |**BID SET** PROJ. NO. SCALE: 2146 As indicated DRAWING TITLE ELECTRICAL **SPECIFICATIONS** AWING NUMBER **E000** 

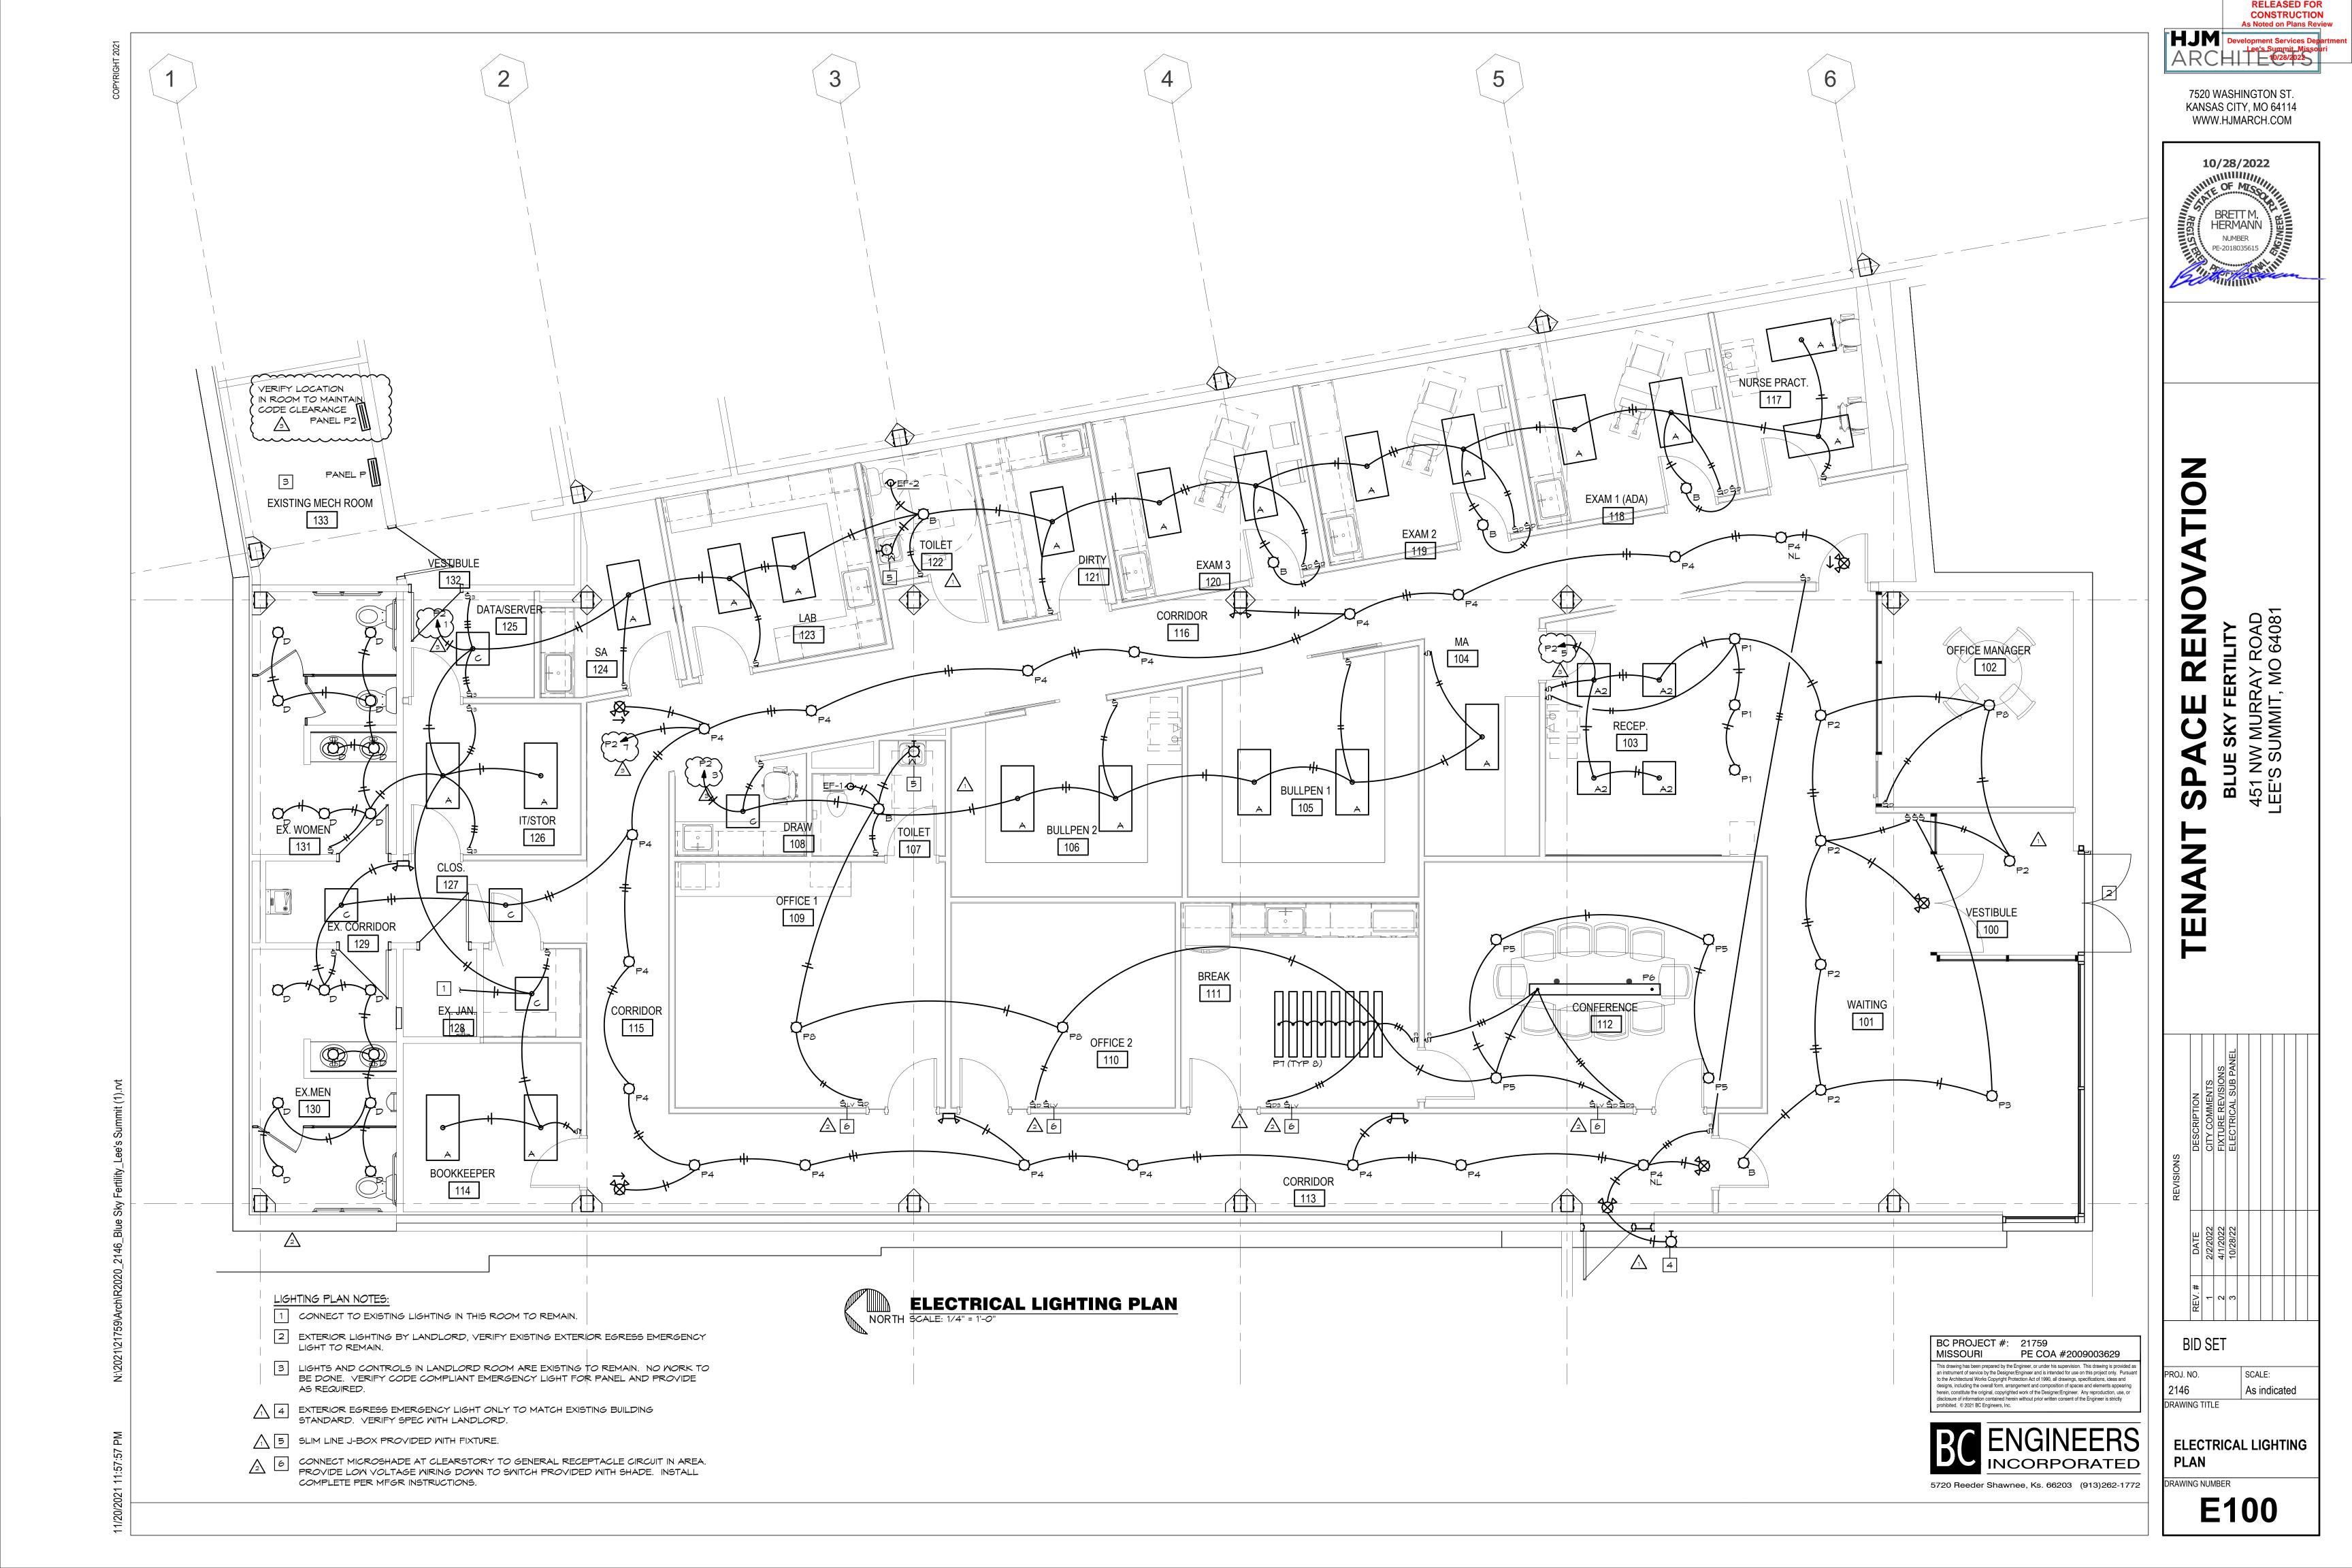


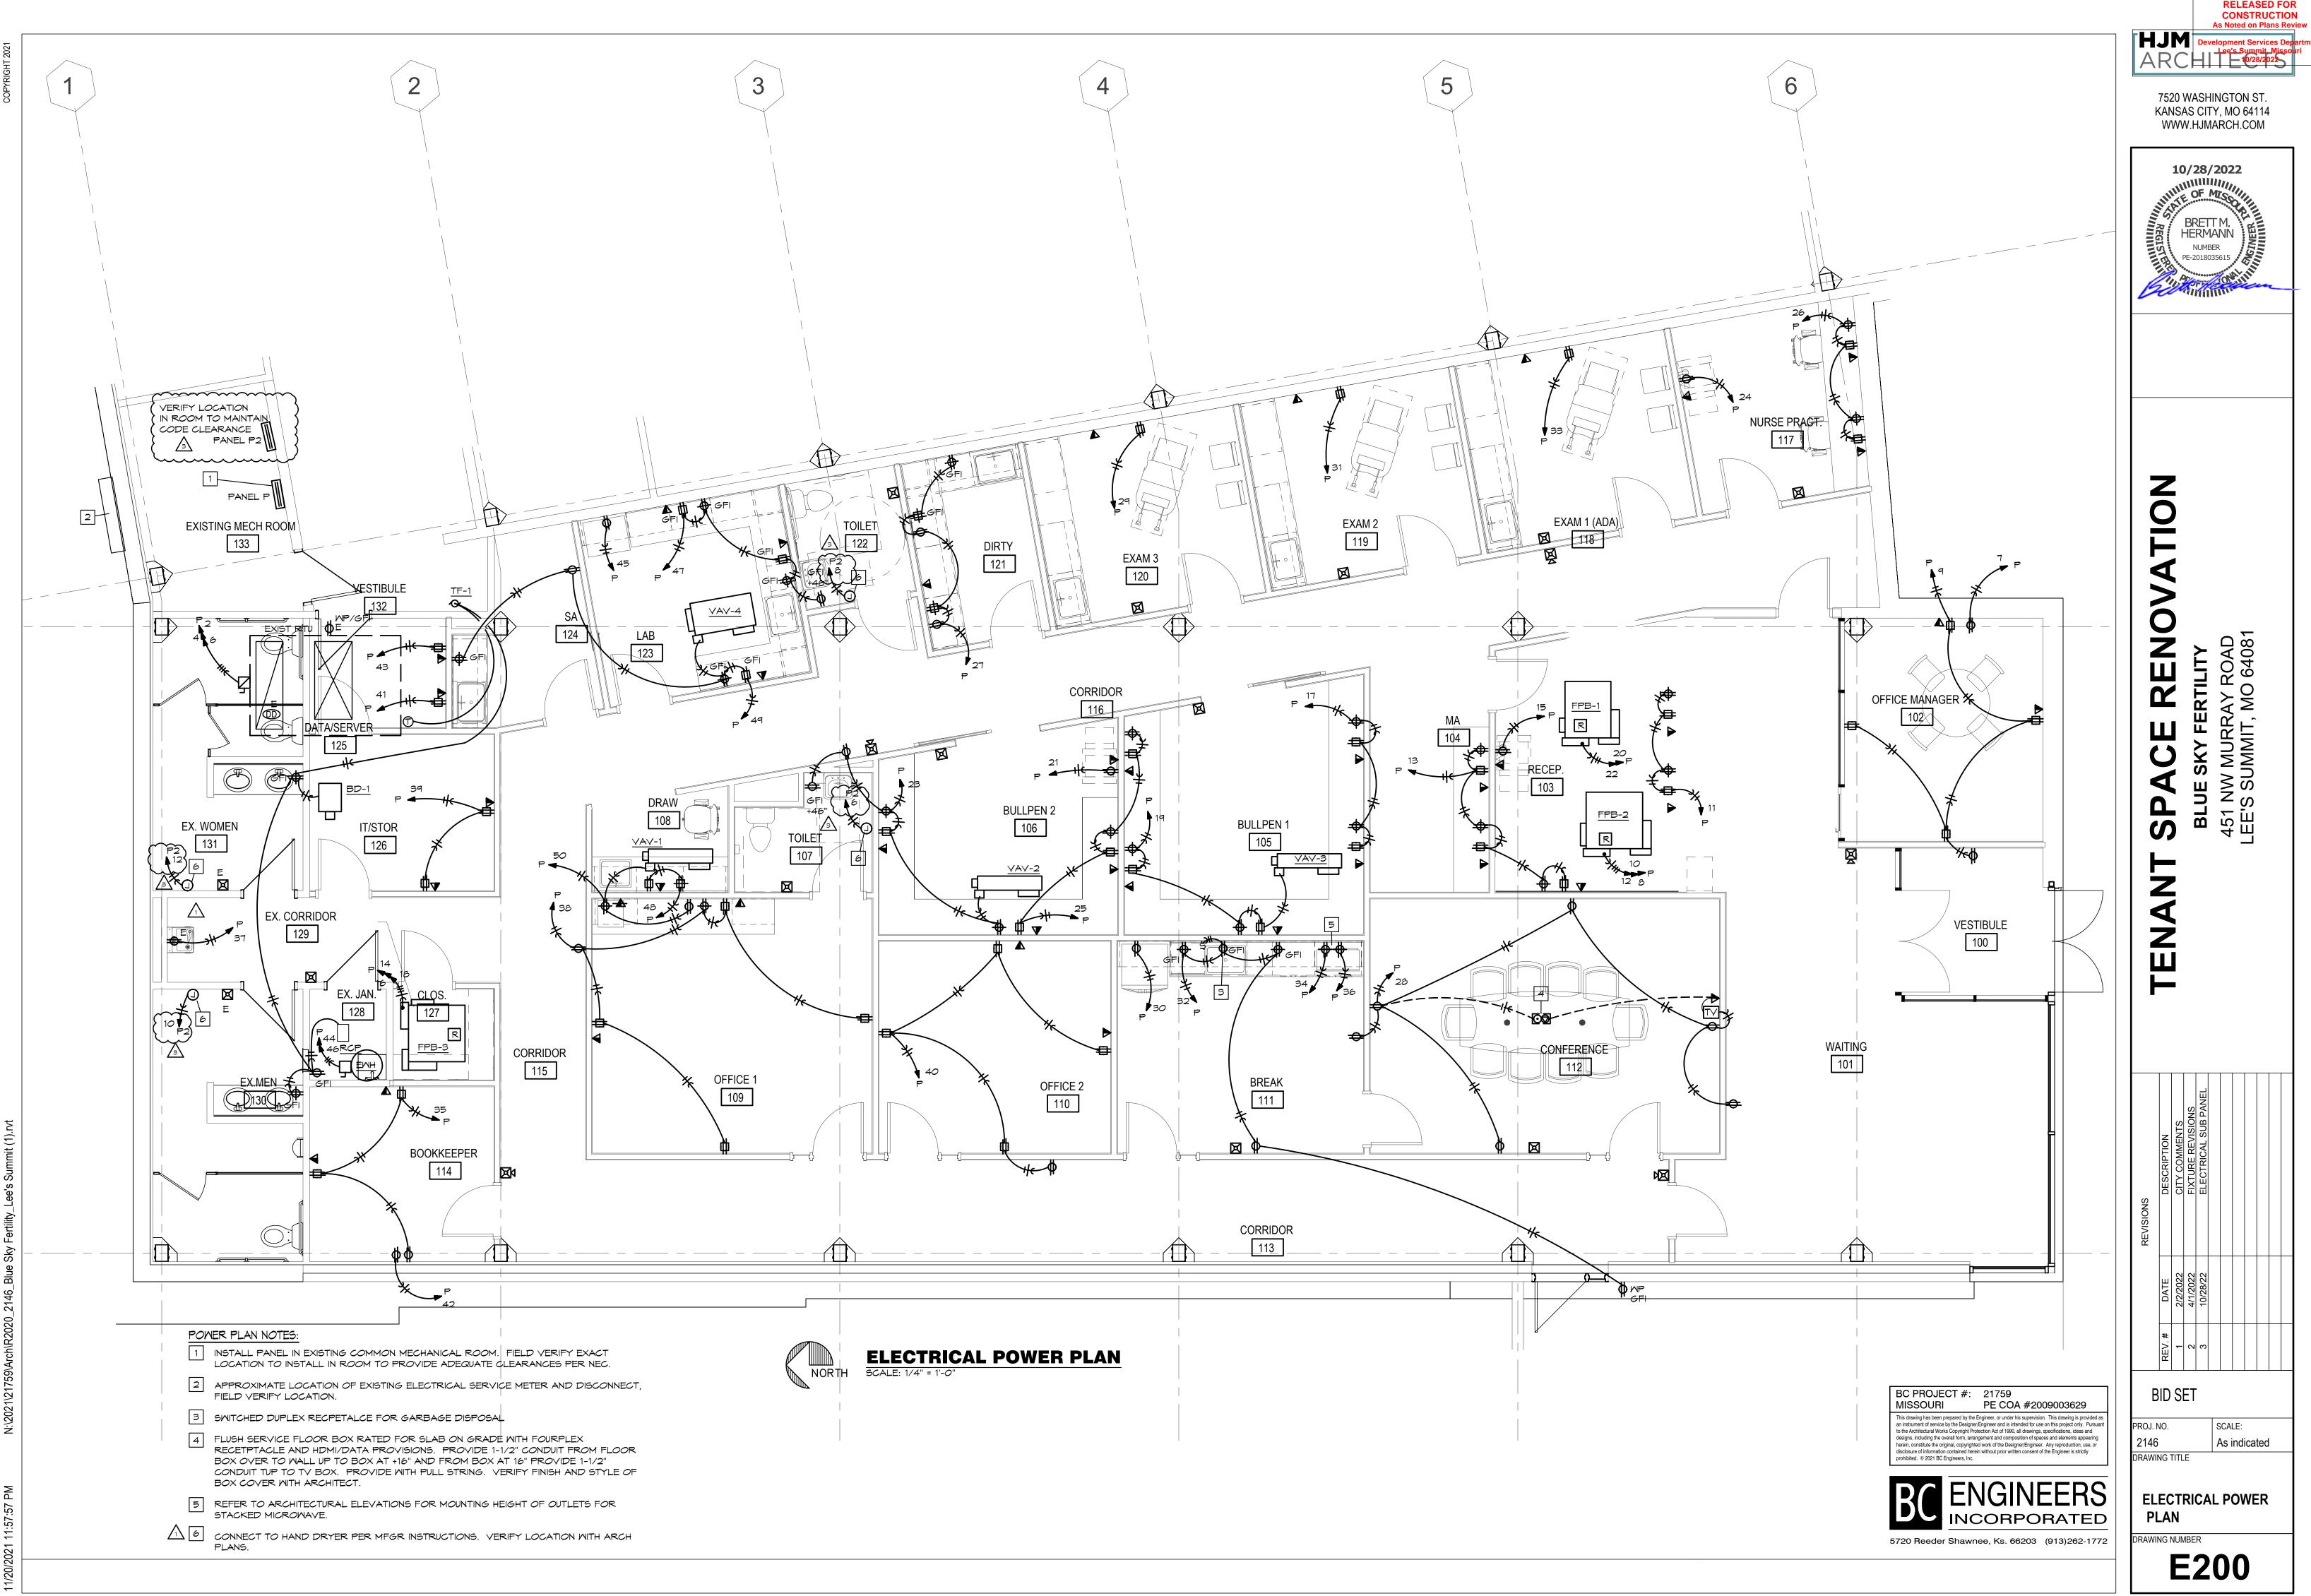

					LIGHT FIXTURE SCHEDULE	
	ARK NO.	MANUFACTURER & CATALOG NUMBER	VOLTS WATTS	LIGHT SOURCE	DESCRIPTION	EQUIVALENT MANUFACTURERS
,	A	H.E. WILLIAMS LP-24-L50/835-DIM- UNV	120 49	LED - 3500K 5000 LUMS	2'X4' GRID LAY-IN LED FLAP PANEL.	COLUMBIA, LITHONIA SIGNIFY, OR EQUAL
I	в	H.E. WILLIAMS 6DR-TL-L15/835-DIM- UNV-0-W-0F-CS-N-F1	120 14	LED - 3500K 1500 LUMS	6" LED DOWN LIGHT WITH WIDE DISTRUBUTION, CLEAR SEMI-SPECULAR REFLECTOR/TRIM, AND 0-10V DIMMING.	PRESCOLITE, LITHONIA, SIGNIFY, C EQUAL
	c	H.E. WILLIAMS LP-22-L50/835-DIM- UNV	120 39	LED - 3500K 5000 LUMS	2'X2' GRID LAY-IN LED FLAP PANEL.	COLUMBIA, LITHONI, SIGNIFY, OR EQUAL
1	D	H.E. WILLIAMS 2DR-L12-835-UNV-O-W-ZF- SG	120 14	LED - 3500K 1200 LUMS	2" RECESSED DOWNLIGHT WITH MUD-IN FLANGE AND OPEN REFLECTOR SATIN-GLOW ANIDIZED FINISH	COLUMBIA, LITHONI, SIGNIFY, OR EQUAL
F	₽1	EUREKA MONK 4175-LED.13-35-120-C-60- ANTE-ANTE-CLR	120 13	LED -3500K 999 LUMENS	CABLE MOUNT DECORATIVE PENDANT, ANTHRACITE FINISH ON CANOPY AND SHADE. VERIFY MOUNTING HEIGHT WITH ARCHITECT	OR EQUAL APPROVED BY ARCHITECT
F	P2	EUREKA STELLA 4272D16-LED-35-80-120-AC -BLKE-BLKE-WH	120 35	LED - 3500K 2620 LUMENS	CABLE MOUNT 16" DIAMETER DIRECT ONLY DECORATIVE PENDANT, BLACK FINISH WITH WHITE DIFFUSER. VERIFY MOUNTING HEIGHT WITH ARCHITECT	OR EQUAL APPROVED BY ARCHITECT
F	P3	LIGHTART ACOUSTIC RING ACC-SHPE-RING-6D-24H-DK -STD-835-STM	120 135	LED - 3500K	6' DIAMETER, 24" HIGH AIRCRAFT CABLE MOUNT, DUSK FINISH, VERIFY MOUNTING HEIGHT WITH ARCHITECT	OR EQUAL APPROVED BY ARCHITECT
F	₽4	EUREKA MILL 4277DI-25-LED.REG.LOW 35-80-120-AC-60-RC1-BLKE -BLKE-NBF-WH	120 28	LED - 3500K 2000 LUMENS	DIRECT/INDIRECT DECORATIVE PENDANT, AIR CRAFT CABLE MOUNT, VERIFY MOUNTING HEIGHT WITH ARCHITECT. VERIFY COLOR FINISH WITH ARCHITECT REGULAR OUTPUT DIRECT, LOW OUTPUT INDIRECT	OR EQUAL APPROVED BY ARCHITECT
	P5	EUREKA STELLA 4272D9-LED-35-80-120-DV- AC-BLKE-BLKE-WH	120 28	LED - 3500K 2050 LUMENS	CABLE MOUNT 9" DIAMETER DIRECT ONLY DECORATIVE PENDANT, BLACK FINISH WITH WHITE DIFFUSER. VERIFY MOUNTING HEIGHT WITH ARCHITECT, 0-10 VOLT DIMMING	OR EQUAL APPROVED BY ARCHITECT
	P6	LIGHTART WING 2.0 ACC-SHPE-WING-96L-DK- DKT-STD-835-BPC-BK	120 74	LED - 3500K	CABLE MOUNT & WING FIXTURE, DUSK AND BLACK FINISH, VERIFY WITH ARCHITECT. VERIFY MOUNTING HEIGHT WITH ARCHITECT. 0-10 VOLT DIMMING	OR EQUAL APPROVED BY ARCHITECT
F	P7	LIGHTART ACC-STAT-BEAM-48L-12H-NI -WME-PM-CUSR-STD-ID835- IHE-DHE-P01-SC-0S-BPC-BK -120	120 72	LED - 3500K	48"Lx12"H LINEAR ACOUSTIC BAFFLE WITH DIRECT/INDIRECT LIGHT. HIGH EFFICIENCY OUTPUT, NICKEL/MAPLE WITH BLACK FINISH, VERIFY WITH ARCHITECT. VERIFY MOUNTING HEIGHT WITH ARCHITECT. 0-10 VOLT DIMMING	OR EQUAL APPROVED BY ARCHITECT
F	≥8	EUREKA CALDERA 4246-46-LED-HO-35-80- 120-DV-AC-60-RC1-BLKE-B LKE-	120 105	LED - 3500K 6900 LUMENS	46" DIAMETER LED, AIRCRAFT CABLE, VERIFY MOUNTING HEIGHT WITH ARCHITECT. BLACK FINISH, 0-10 VOLT DIMMING	OR EQUAL APPROVED BY ARCHITECT
,	Μ	EUREKA EXPO 3545-24-LED-35-80-120-SL -BLKE-WH-3980B-	120 9	LED - 3500K 1214 LUMENS	24" HORIZONTAL MOUNT LED ABOVE MIRROR, VERIFY ROUGH-IN HEIGHT WITH ARCHITECT. BLACK FINISH. PROVIDE WITH SLIM LINE COVER AND SLIM LINE INSTALL J-BOX	OR EQUAL APPROVED BY ARCHITECT
	¢	DUAL-LITE EV2	120 1	INCL	EMERGENCY LIGHT WITH TWIN ADJUSTABLE 1 WATT LED HEADS AND BATTERY, MOUNT AT 7'-6"±, TO CLEAR OBSTACLES. (PROVIDES 1 FC AVG. ON 27' CENTER FIXTURE SPACING)	SURE-LITES LITHONIA OR EQUAL
	8	DUAL-LITE EVC-U-R-M	120 3	INCL	COMBINATION EMERGENCY/EXIT LIGHT WITH LED LAMPS, RED LETTERS ON WHITE BACKGROUND, TWIN LED EMERGENCY LIGHT HEADS, UNIVERSAL MOUNT, BATTERY BACKUP	SURE-LITES LITHONIA OR EQUAL

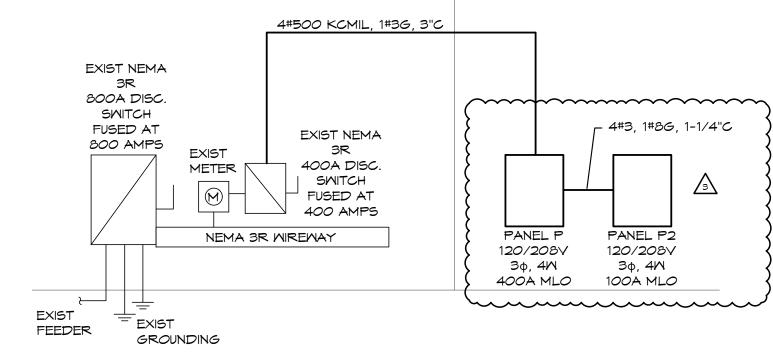

ELECTRICAL RISER DIAGRAM

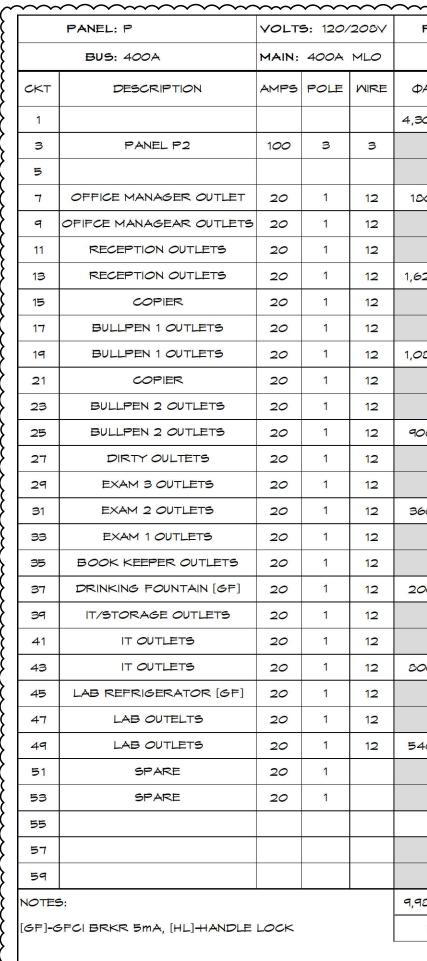

 $\underline{1}$ 

F	PANEL: P2	VOLT	5: 120	⁄208∨	PH:	ЗФ	MIRE:	4 <b>N</b>	LOCAT	ION:	MECH	RM		MOUNTING	BURFACE	
	BUS: 100A	MAIN:	100A	MLO	IC:	22,	000	RMS SY	M AMPS					FEEDER:	SEE RISER DIAGI	RAM
CKT	DESCRIPTION	AMPS	POLE	MIRE	ΦΑ	ΦB	ФС	ΦΑ	ФВ	ΦC	MIRE	POLE	AMPS	DESC	CRIPTION	U N
1	LIGHTS	20	1	12	1,5 <i>00</i>			900			12	1	20	RESTROC	M CKT (EXIST)	
з	LIGHTS	20	1	12		1,500			900		12	1	20	EX	ST CKT	9
5	LIGHTS	20	1	12			1,500			1,500	12	1	20	HANI	DRYER	
Т	LIGHTS	20	1	12	400			1,5 <i>00</i>			12	1	20	HANI	D DRYER	i,
9	SPARE	20	1						1,500		12	1	20	HANI	D DRYER	1
11	SPARE	20	1							1,500	12	1	20	HANI	D DRYER	1
13	SPARE	20	1									1	20	5	PARE	ſ
15	SPARE	20	1									1	20	9	PARE	ſ
17	SPARE	20	1									1	20	9	PARE	ſ
19	SPARE	20	1									1	20	5	PARE	11
21	SPARE	20	1									1	20	9	PARE	11
23	BUSSED SPACE													BUSS	ED SPACE	14
25	BUSSED SPACE													BUSS	ED SPACE	N
27	BUSSED SPACE													BUSS	ED SPACE	N
29	BUSSED SPACE													BUSS	ED SPACE	10
NOTES:					1,900	1,5 <i>00</i>	1,500	2,400	2,400	3,000						
					4,3	00	3,4	100	4,5	00		TOTAL	CONNE	CTED LOAD:	12,700	V
											-	٢	NEC DEM	MAND LOAD:	13,925	V
										DEM	IAND A	MPS @	208	VOLT / 30:	38.6	5

									ON	ST	RU	D F CTI Ins F	ION	1
			A	R	C			lopr	nent 's S 1	t Sei umr 10/2	rvic mit, B/20	es D Mis 122	) Son	artment Iri
$\sim$		<u>~~~</u>		752 KAN				NG [.] Y, N						
	MOUNTING: SURFACE FEEDER: SEE RISER DIAGR.							ARC					_	
S	DESCRIPTION	KT NO 2			10	)/2	8/	202	22					
2		4				O	FN	AIS.	Q.					
	(FIELD VERIFY RTU BRKR RQD)	6 0		REGIS				ANN	J	INEER				
,	FAN POWERED BOX FPB-2	10 12		TERIN	۲ ک			-R 35615			III III			
,	FAN POWERED BOX FPB-3	14 16		Źd				iiii	<u>~</u>		-	<u> </u>	┫	-
		18			_	_				_	_	_		
,	FAN POWERED BOX FPB-1	20 22												
> >	NURSE PRACT COPIER	24 26											_	
>	CONF OUTLETS	28												
> >	REFRIGERATOR [GF] BREAK COUNTER OUTLETS	30 32												
>	MICROWAVE [GF]	34 36		Ζ	<b>)</b>									
, ,	OFFICE 1 OUTLETS	38		C										
>	OFFICE 2 OUTLETS BOOK KEEPER	40 42												
, ,	WATER HEATER	42 44		4										
,	DRAW OUTLETS	46 48		Z										
, ,	OFFICE 1 PRINTER/UC REFRIG							_		<b>—</b>				
> >	EXIST RESTROOM EXHAUST SPARE	52 54		2	/ 	> F				408.				
		56						С Ч С	2 c - (	è С				
		58 60			<b>.</b>			247		Ž				
	100 100			SPACE RENOVATION		L >		I NW MIRRAY ROAD						
	CTED LOAD:         109,120           1AND LOAD:         101,625					21	くつ			N				
8	VOLT / 3Φ: 282.08	A		54			L D	ŠZ		5				
	MOUNTING: SURFACE			っ		٥		451		: Ll Ll				
	FEEDER: SEE RISER DIAGR	۲AM							-					
-5	DESCRIPTION	CKT NO		Z										
2	RESTROOM CKT (EXIST)	2												
2 2	EXIST CKT HAND DRYER	4												
2	HAND DRYER	8												
2	HAND DRYER	10												
2 2	SPARE	12 14												
2	SPARE	16												
2 2	SPARE	18 20											-	
2	SPARE	22					PANEL							
	BUSSED SPACE	24		NO	<b>1ENTS</b>	~	IL SUB							
	BUSSED SPACE BUSSED SPACE	26 28		DESCRIPTION	COMMENT	FIXTURE RE	ELECTRICAL							
	BUSSED SPACE	30	S S	DES	CITY	FIXT								
NE	CTED LOAD: 12,700	VA	REVISIONS											
			R H			_	+							
8	VOLT / 3Φ: 38.65	; A		DATE	2/2/2022	4/1/2022	10/28/22							
				DA	2/2/2	4/1/2	10/28							
				<. #		2	e e	+					1	
				REV	-	()								
ſ	BC PROJECT #: 21759			BID	SI	ΞT								
ŀ	MISSOURI PE COA #2 This drawing has been prepared by the Engineer, or under his superv an instrument of service by the Designer/Engineer and is intended for to the Architectural Works Copyright Protection Act of 1990, all drawing	rvision. This d or use on this p	rsuant PRO.I	NO.				SCA	LE:				-	
	to the Architectural Works Copyright Protection Act of 1990, all drawin designs, including the overall form, arrangement and composition of herein, constitute the original, copyrighted work of the Designer/Engin disclosure of information contained herein without prior written conse prohibited. © 2021 BC Engineers, Inc.	spaces and e ineer. Any rep		6	TITL	F		As		icat	ted			
L						-								
	BC ENGIN			EC	ΓR		٩L	SC	H	ED	)UI	LE	S	
	5720 Reeder Shawnee, Ks. 66203	210		ING 1	NUM	IBEF	2						_	
;		-		ſ				_	_					
					╞─		Z	0	ſ					

~~~~	~~~~		~~~~		~~~~~	~~~~	~~~~	~~~~			~~~~
PH:	зФ	MIRE:	4M	LOCATI	ON:	MECH	RM		MOUNTING:		
IC:	22,0	000	RMS SY	M AMPS					FEEDER:	SEE RISER DIAGR	
ΦΑ	ΦB	ФС	ΦΑ	ΦB	ФС	MIRE	POLE	AMPS	DES	CRIPTION	CKT NO
1,300			10,560								2
	3,900			10,560		З	з	100	ROC	FTOP UNIT	4
		4,500			10,560				(FIELD VERIF	Y RTU BRKR RQD)	6
180			3,600								8
	1,620			3,600		В	з	40	FAN POWE	RED BOX FPB-2	10
		1,080			3,600	-					12
, <mark>620</mark>			4,500								14
	1,200			4,500		6	з	50	FAN PONE	RED BOX FPB-3	16
		1,080			4,500						18
,080			1,400			12	2	20	FAN POME	RED BOX FPB-1	20
	1,200			1,400							22
		1,080			1,200	12	1	20	NURSE P	RACT COPIER	24
900			1,080			12	1	20	NURSE PI	RACT OUTELTS	26
	1,260			1,440		12	1	20	CON	F OUTLETS	28
		360		-	1,000	12	1	20	REFRIG	ERATOR [GF]	30
360			1,200			12	1	20	BREAK CC	NUNTER OUTLETS	32
	360		.,	1,200		12	1	20		OWAVE [GF]	34
		900		.,	1,200	12	1	20		OWAVE [GF]	36
200			1,800		1,200	12	1	20		E 1 OUTLETS	38
200	720		1,000	1,620		12	1	20		E 2 OUTLETS	40
	120	500		1,020	180	12	1	20		K KEEPER	40
200		200	2.250		100					ER HEATER	42
800	1.000		2,250	2.25.0		10	2	30			
	1,000	10(0		2,250	700	10				N OUTLETS	46
		1,260			720	12	1	20			48
540			800			12	1	20		INTER/UC REFRIG	50
				100		12	1	20	jos ar irgado no ata 500 mos, o	IROOM EXHAUST	52
							1	20		BPARE	54
											56
											58
											60
1,980	11,260	11,060	27,190	26,670	22,960	-					
37,	170	37,9	930	34,0	020	ר	OTAL	CONNE	CTED LOAD:	109,120	VA
							Ν	EC DEN	MAND LOAD:	101,625	VA
					DEM	IAND A	MPS @	208	VOLT / ЗФ:	282.08	A
PH:	ЗΦ	MIRE:	4 M	LOCAT	ION:	MECH	RM		MOUNTING	SURFACE	
IC:	22,0	000	RMS SY	M AMPS					FEEDER:	SEE RISER DIAGR	AM
ΦΑ	ФВ	ФС	ΦΑ	ФВ	ФС	MIRE	POLE	AMPS	DES	BCRIPTION	CKT NO
1,500			900			12	1	20	RESTRO	OM CKT (EXIST)	2
	1,5 <i>00</i>			900		12	1	20	E	KIST CKT	4
		1,500			1,500	12	1	20	HAH	ND DRYER	6

BC PROJE MISSOURI	CT #:	21759 PE COA #2009003629
an instrument of service I to the Architectural Work designs, including the ov	by the Designe s Copyright Pro erall form, arra	Engineer, or under his supervision. This drawing is provided as rr/Engineer and is intended for use on this project only. Pursuan otection Act of 1990, all drawings, specifications, ideas and ungement and composition of spaces and elements appearing
	contained here	ted work of the Designer/Engineer. Any reproduction, use, or ein without prior written consent of the Engineer is strictly