


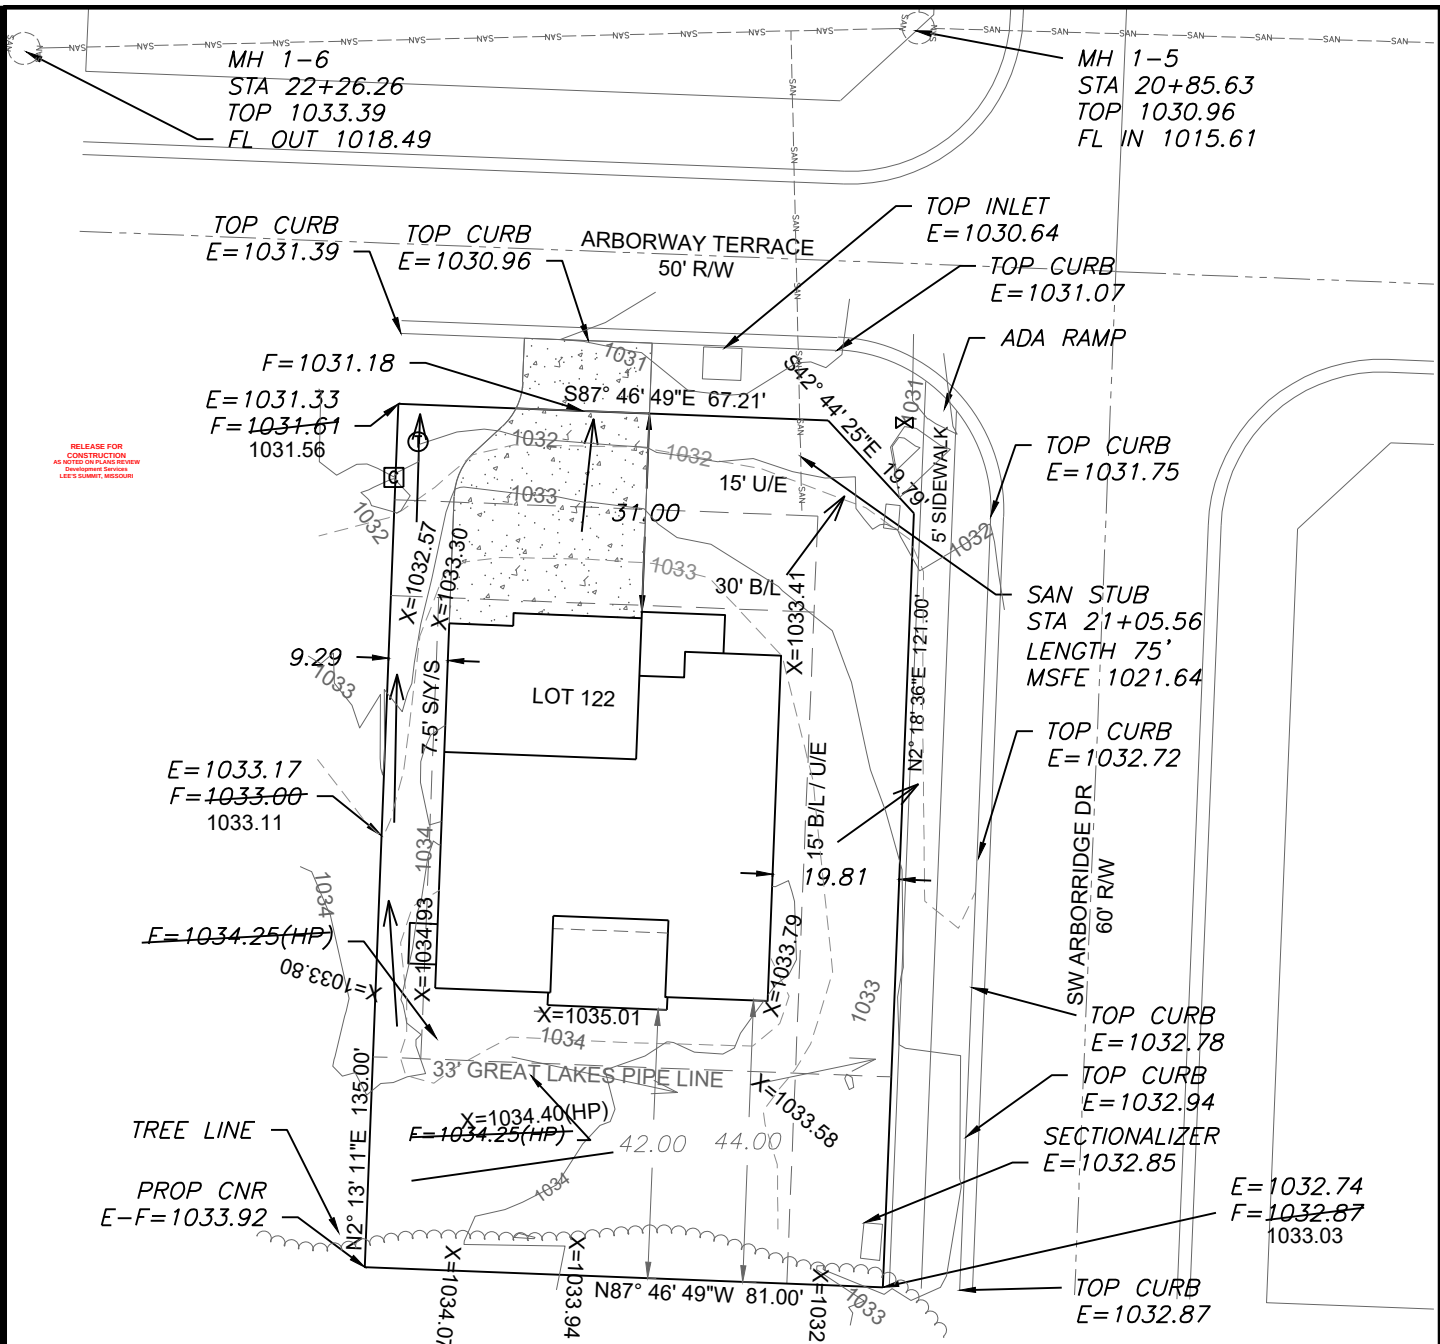

X=###.## = Actual asbuilt ground shots taken on October 21, 2022


Contours shown are asbuilt.

--- PROPOSED CONTOURS
--- AS-GRADED CONTOURS

LEGEND

- Gas Meter
- Telephone or Fiber-Optic Pedestal
- Cable TV Pedestal
- Electric Pedestal
- Light Pole
- Mailbox
- Fire Hydrant
- Water Valve

EXTENDED LOT AREA = 13,460.18 SF
DRIVE AREA = 929 SF
APPROACH AREA = 221.22 SF
SIDEWALK AREA = 698.28 SF

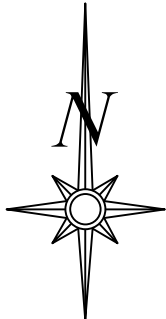

Scale 1"=30'

LOT INFORMATION

10,851 SQ. FT.
MSFE = 1021.64
ADDRESS
1601 SW ARBORWAY TERRACE

LEGAL DESCRIPTION

LOT 122, HAWTHORN RIDGE 2ND PLAT, A SUBDIVISION AS RECORDED IN LEE'S SUMMIT, JACKSON COUNTY, MISSOURI.


PROPOSED HOUSE

TOP FOUNDATION = 1035.50
GARAGE FLOOR = 1033.50
TOP FOOTING = 1026.50
BASEMENT FLOOR = 1026.83
DRIVE SLOPE = 7.5%


E = EXISTING ELEVATION
F = PROPOSED FINAL ELEVATION
G = ADJACENT GRADE AT EGRESS
U/E = UTILITY EASEMENT
B/L = BUILDING LINE
S/Y/S = SIDE YARD SETBACK
R/Y/S = REAR YARD SETBACK

NOTES

- BUILDER TO VERIFY ALL BUILDING ELEVATIONS AND DIMENSIONS.
- THIS PLOT PLAN DOES NOT CONSTITUTE A BOUNDARY SURVEY.
- THE EASEMENTS SHOWN ON THIS PLOT PLAN ARE TAKEN FROM THE FINAL PLAT. OTHER EASEMENTS MAY EXIST.

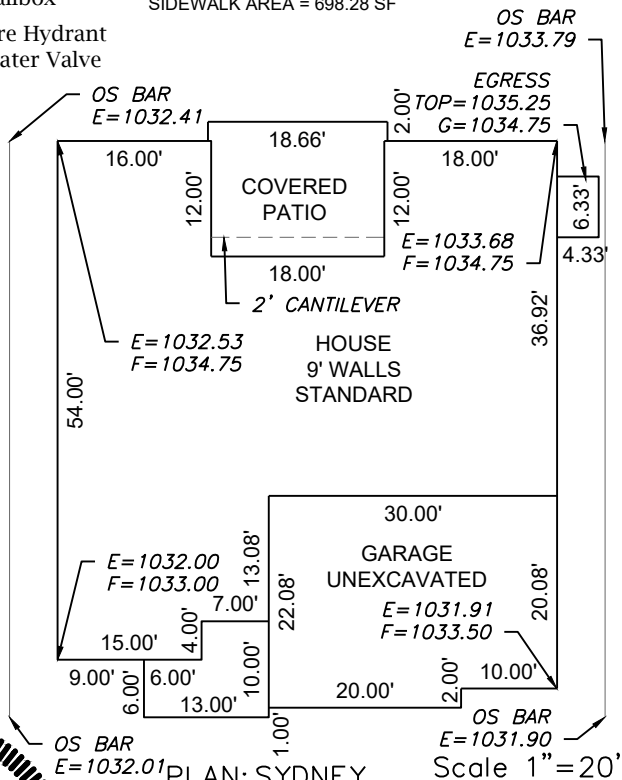

ENGINEERING SOLUTIONS
ENGINEERING & SURVEYING
50 SE 30TH STREET
LEE'S SUMMIT, MO 64082
P:(816) 623-9888 F:(816) 623-9849
WWW.ENGINEERINGSOLUTIONSKC.COM

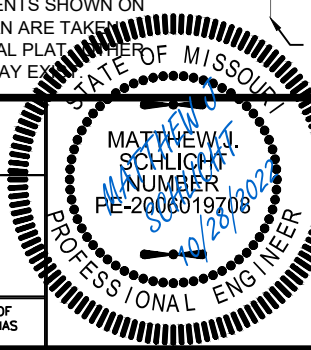

AS-GRADED PLOT PLAN - LOT 122

HAWTHORN RIDGE 2ND PLAT
LEE'S SUMMIT, JACKSON COUNTY, MISSOURI

SUMMIT HOMES
120 SE 30TH STREET
LEE'S SUMMIT, MO 64082

PROJECT NO.	FILE NAME	DATE	SHEET	OF
1	LOT 122, HAWTHORN RIDGE	8/11/21	1	1

THIS DRAWING IS NOT VALID UNLESS THE SIGNATURE, DATE AND SEAL OF THE ENGINEER WHO SUPERVISED THE PREPARATION OF THIS DRAWING HAS BEEN AFFIXED HERETO.