

# Greystone - Hook Farms 26

2027 SW Hook Farm Dr  
Lee's Summit, MO 64082



## General Information



2006 Interior Energy Cons. Code (Table R402.1.1)

Doors & Windows:	U-0.65 MAX
Glazing SHGF:	0.40
Skylights:	U-0.65 MAX
Roof	
Attic Ceilings:	R-30 MIN
Vaults:	R-30 MIN
Vaults < 500sf:	R-30 MIN
Wood Frame Walls:	R-13 MIN
Basement Walls:	R-0
Floor (over unconditioned):	R-19 MIN
Slab on Grade:	R-0
Ductwork:	R-8 MIN
Fuel Fired Furnace:	90% AFUE MIN
Electric Furnace:	No Minimum
Cooling System:	13 SEER MIN
Water Heater	
Gas Fired Storage:	0.67 EF MIN
Gas Fired Instant:	0.62 EF MIN
Electric Storage:	0.97 EF MIN
Electric Instant:	0.93 EF MIN

An energy efficient certificate is required to be posted in or on the electrical panel before the final inspection. The certificate will be provided with all new residential permits. It is the permit holder/contractor's responsibility to ensure the certificate has accurate information and is posted before final inspection - Owner/Contractor is responsible for meeting the prescriptive requirements of IRC chapter 11 unless a HER Index Analysis for Performance Compliance based on the plans is submitted to the AFJ for approval.

IRC 2012


Ground Snow Load:	20PSF
Wind Speed:	90mph
Topography Effects:	No
Seismic Design Category:	A
Damage From Weather:	Severe
Frost Line Depth:	36 inches
Termite:	Moderate to Heavy
Winter Design Temperature:	6 F
Ice Barrier Underlayment:	Yes
Flood Hazard:	
Air Freezing Index:	1,500 or less
Mean Annual Temperature:	55 F

- Whole House Mechanical Ventilation System is required for any dwelling with air infiltration at a rate of less than 5 air changes per hour (at ACH50 standard R303.4).
- Carbon monoxide detectors required (R315)
- Steel columns shall be minimum schedule 40 (R507.2)
- Deck Ledger attachment to house shall be per Tables 507.9.1.3.
- New provisions for attachment of rafters, trusses and roof beams. (R802.3 and R802.11)
- Programmable thermostat required (N1103.1.1)
- Air handlers shall be rated for Maximum 2% air leakage rate (N1103.2.2.1)
- Building cavities used as return air plenums shall be sealed to prevent leakage across the thermal envelope. (N1103.2.3)
- Certain hot water pipes shall be insulated (N1103.4)
- All exhaust fans shall terminate to the building exterior (M1507.2)
- Makeup air system required for kitchen exhaust hoods that exceed 400 CFM M1503.4
- Building cavities in a thermal envelope wall (including the wall between the house and garage) shall not be used as return air plenums (unless the required insulation and air barrier are maintained) (M1601.1.1, 87.5)
- An air handling system shall not serve both the living space and the garage (M1601.6)
- A concrete-encased grounding electrode (UFER Ground) connection complies with the requirements of the 2018 IRC Section E3608.1.2 in providing a connection with no less than the required minimum of steel.
- Compliance with the requirements and show connection as needed for roof beam, trus, rafter, and girder connections for uplift per IRC 802.11
- Garage Door Rating: DASMA 90 MPH Rated

**Greystone - Hook Farms 26**  
 2027 SW Hook Farm Dr  
 Lee's Summit, MO 64082


### Sheet List

- 05 - Architecture
- A0 Foundation Plan
- A1 Floor Plan - Main Level
- A2 RCP/Electrical Plan
- A3.C Elevations
- A4.C Building Sections
- A5 Details
- A6 Details
- A7 Grading Options

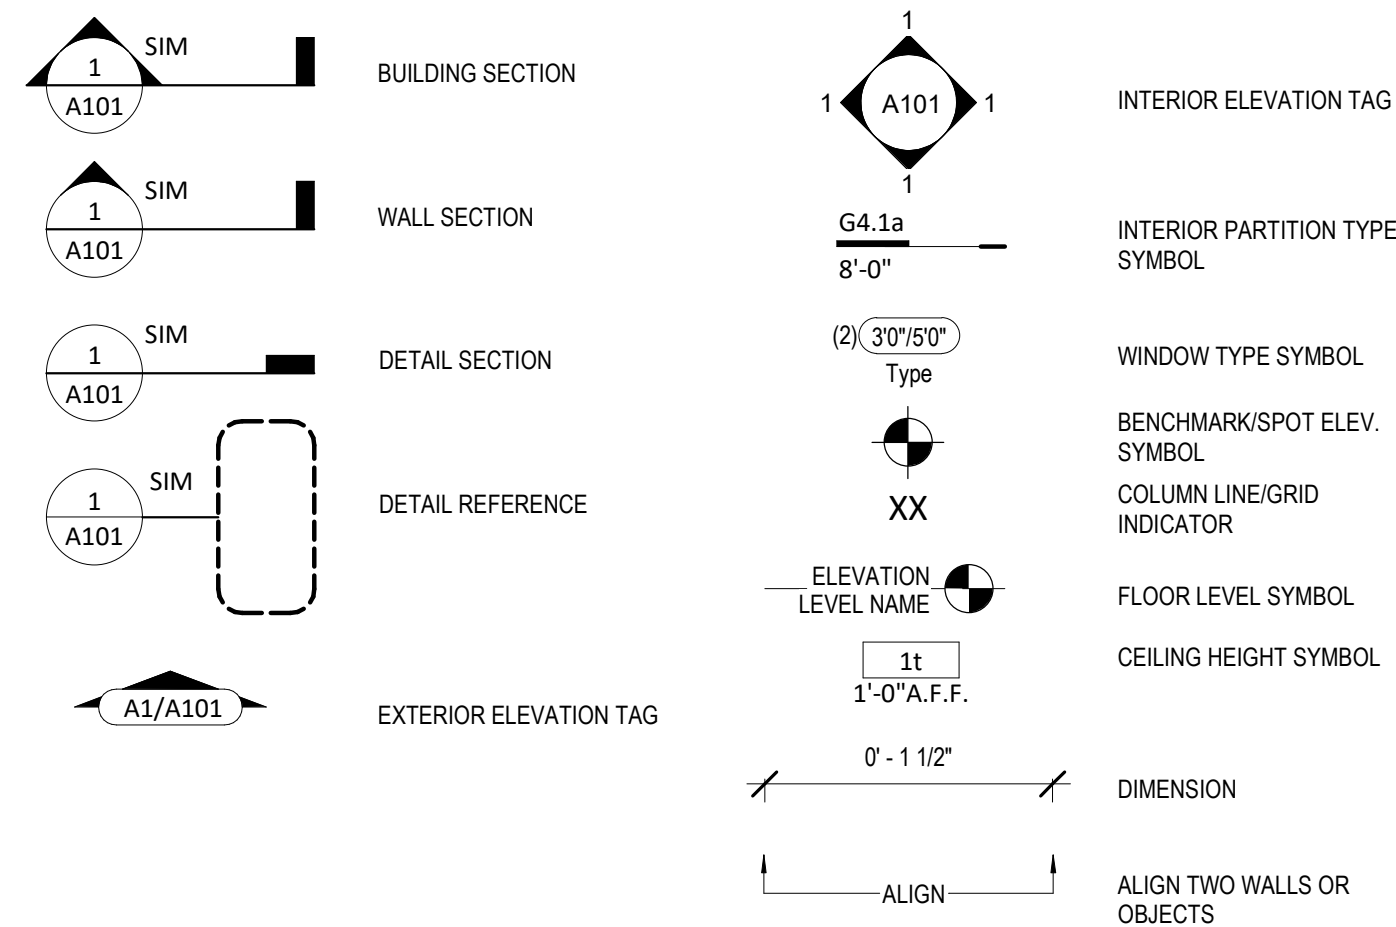

### Interior Partition Types


- NOTES:
- PROVIDE MOISTURE RESISTANT GWB IN WET AREAS
  - EXTEND ALL FIRE RATED WALLS STRUCTURE TO STRUCTURE.
  - USE TYPE "X" GWB FOR ALL FIRE RATED PARTITIONS
  - REFER TO ELEVATIONS FOR LOCATIONS WHERE WALL IS NOT FULL HEIGHT. IN THESE CASES CAP THE TOP OF THE WALL WITH A LAYER OF 1/2" GYPSUM BOARD U.N.O.

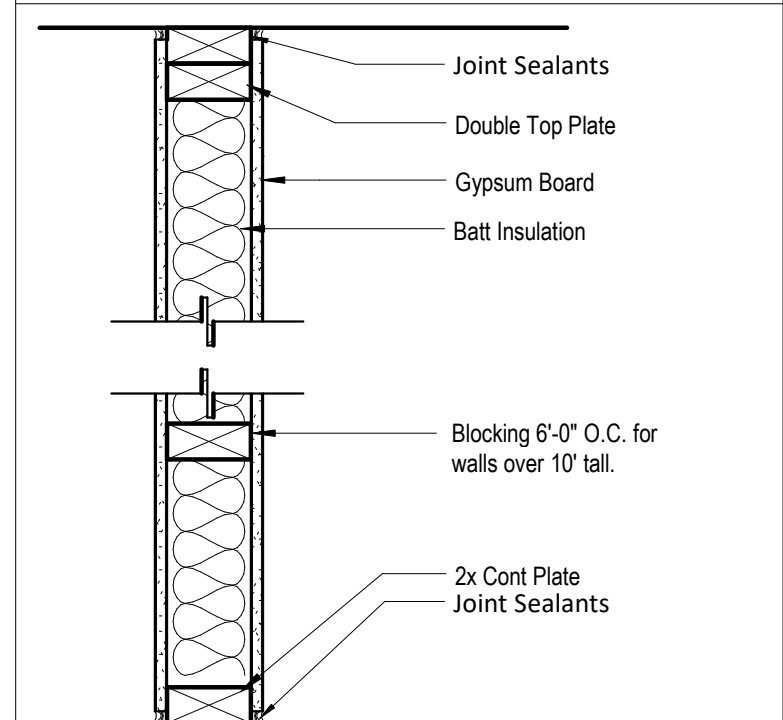

**PARTITION SYSTEM:**  
GYPSUM WALL BOARD PARTITION **G**

PARTITION IDENTIFICATION PLAN SYMBOL	G4	G4.1	G4.L	G6
BASE PARTITION THICKNESS	4.5"	4.5"	4.5"	6.5"
STUD SPACING (O.C.)	16"	16"	16"	16"
STUD SIZE	2x4	2x4	2x4	2x6
GWB THICKNESS	1/2"	5/8"	5/8"	1/2"
JOINT SEALANTS	No	No	No	No
INTERIOR LOAD BEARING WALL	No	No	Yes	No
FIRE RATING (HRS)	-	1	-	-
FIRE TEST NUMBER	-	U314	-	-
FIRE TEST NUMBER (HEAD OF WALL)	-	-	-	-
FIRE RESISTIVE JOINTS	-	-	-	-
ACOUSTIC RATING (STC)	-	-	-	-
ACOUSTICAL TEST NUMBER	-	-	-	-
INSULATION	No	Yes	No	No
ACOUSTICAL JOINTS	-	-	-	-
REMARKS:	* SEE NOTE #4	* SEE NOTE #3	* SEE NOTE #3	* SEE NOTE #4


- NOTES:
- REFER TO ELEVATIONS FOR LOCATIONS WHERE WALL IS NOT FULL HEIGHT. IN THESE CASES CAP THE TOP OF THE WALL WITH A LAYER OF 1/2" GYPSUM BOARD U.N.O.

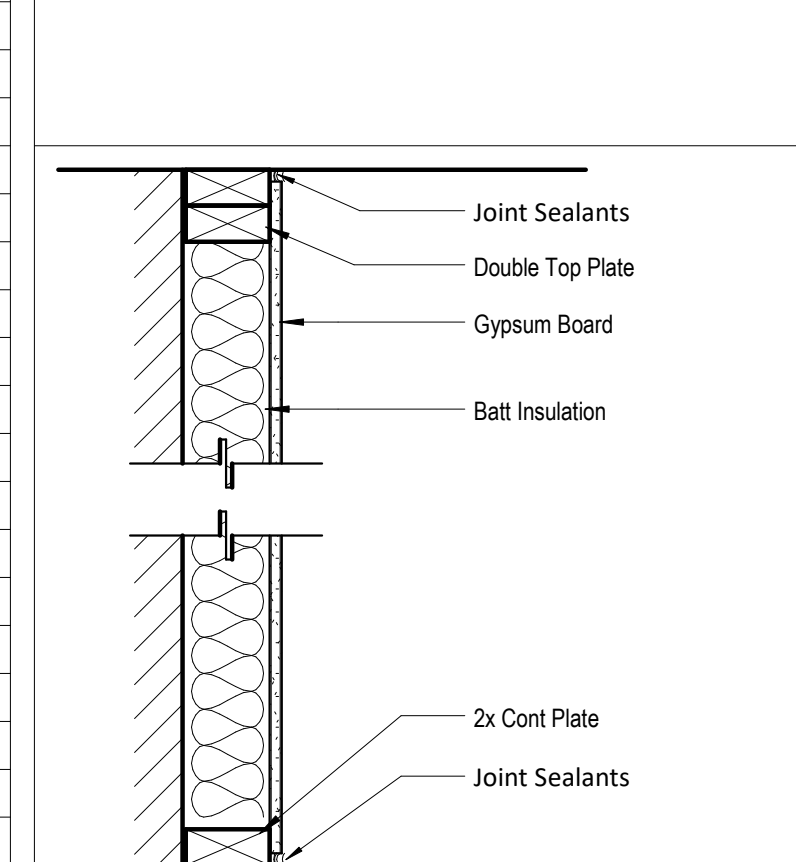

**PARTITION SYSTEM:**  
GYPSUM FURRING PARTITION **F**

PARTITION IDENTIFICATION PLAN SYMBOL	F4
BASE PARTITION THICKNESS	4"
STUD SPACING (O.C.)	16"
STUD SIZE	2x4
GWB THICKNESS	1/2"
JOINT SEALANT	No
FIRE RATING (HRS)	-
FIRE TEST NUMBER	-
FIRE TEST NUMBER (HEAD OF WALL)	-
FIRE RESISTIVE JOINTS	-
ACOUSTIC RATING (STC)	-
ACOUSTICAL TEST NUMBER	-
INSULATION	No
ACOUSTICAL JOINTS	-
REMARKS:	* SEE NOTE #1

- NOTES:
- REFER TO ELEVATIONS FOR LOCATIONS WHERE WALL IS NOT FULL HEIGHT. IN THESE CASES CAP THE TOP OF THE WALL WITH A LAYER OF 1/2" GYPSUM BOARD U.N.O.

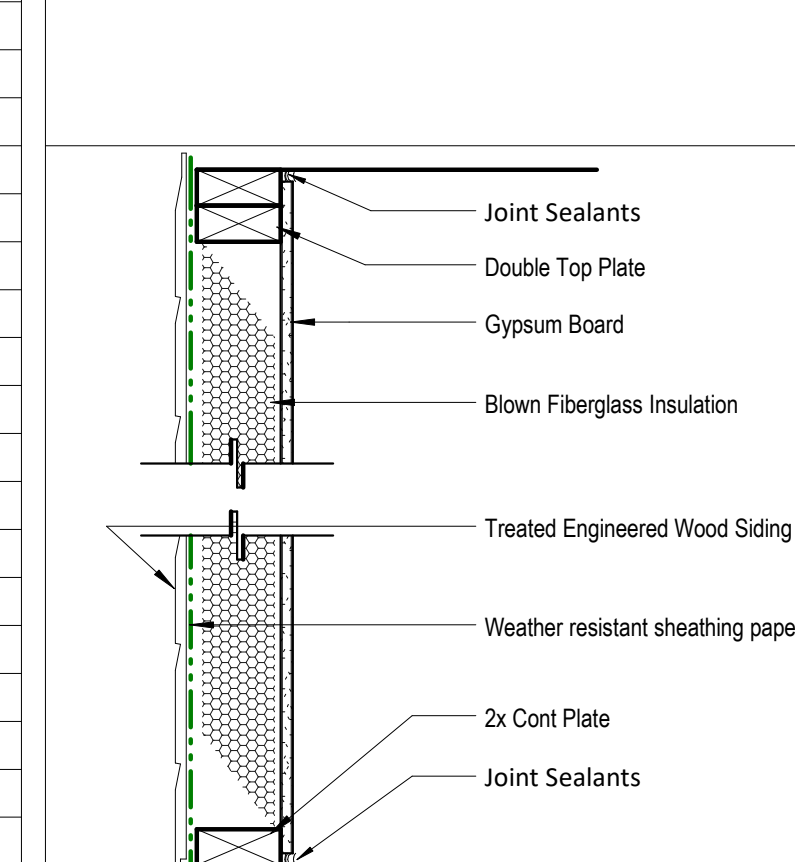

**PARTITION SYSTEM:**  
Exterior Partition **E**


PARTITION IDENTIFICATION PLAN SYMBOL	E4
BASE PARTITION THICKNESS	4"
STUD SPACING (O.C.)	16"
STUD SIZE	2x4
GWB THICKNESS	1/2"
JOINT SEALANT	Yes
FIRE RATING (HRS)	-
FIRE TEST NUMBER	-
FIRE TEST NUMBER (HEAD OF WALL)	-
FIRE RESISTIVE JOINTS	-
ACOUSTIC RATING (STC)	-
ACOUSTICAL TEST NUMBER	-
INSULATION	Yes
ACOUSTICAL JOINTS	-
REMARKS:	* SEE NOTE #1

RELEASE FOR CONSTRUCTION  
AS NOTED FOR PLAN REVIEW  
DEVELOPMENT SERVICES  
LEE'S SUMMIT MISSOURI  
11/02/2022

PERMIT SET

Original Issue Date: 2022-06-21

REVISIONS		
Number	Description	Date

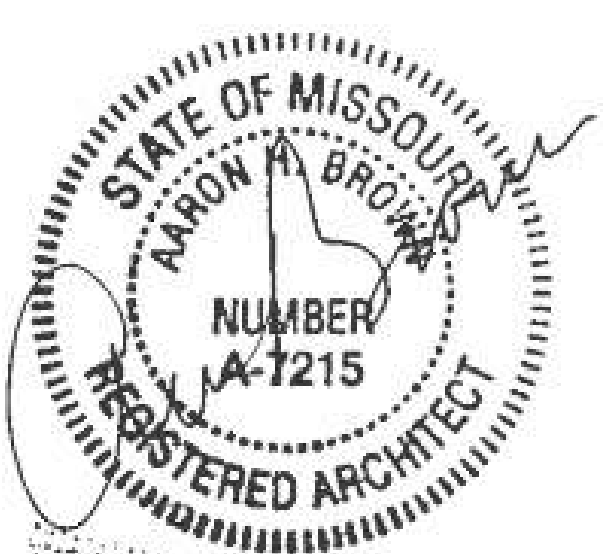

**PERMIT SET**

PLAN DESCRIPTION: Greystone

**00**

Architect:  
**Elevate Design + Build**  
350 SW Longview Blvd  
Lee's Summit, MO 64081  
816.622.8826 voice  
www.elevatedesignbuild.com  
2027 SW Hook Farm Dr  
Lee's Summit, MO 64082

UNLESS A PROFESSIONAL SEAL WITH SIGNATURE AND DATE IS AFFIXED, THIS DOCUMENT IS PRELIMINARY AND IS NOT INTENDED FOR CONSTRUCTION, RECORDING PURPOSES OR IMPLEMENTATION.



PERMIT SET  
Original Issue Date: 2022-06-21

REVISIONS		
Number	DESCRIPTION	DATE

Foundation Plan

**A0**

Project No.

RELEASE FOR HR ACTION  
AS NOTED FOR PLAN REVIEW  
DEVELOPMENT SERVICES  
LEE'S SUMMIT, MISSOURI  
11/02/2022

Structural Foundation Schedule					
Type	Width	Length	Depth	Reinforcing	Comments
<b>Footings</b>					
F1	3'-0"	3'-0"	1'-0"	Reinf w/ (6) #4's, rebar count is each way, equal centers	GARAGE PEDISTAL
F2	4'-0"	4'-0"	1'-4"	Reinf w/ (8) #4's, rebar count is each way, equal centers. (8) #4's, vertical rebar count in pad column. Hold ped down 12" Min below gar. door block-down and/or bottom of slab.	
<b>Wall Foundation</b>					
FTG-1	1'-4"	<varies>	0'-8"	Reinf w/ (2) #4 bot. eq. spaced. Dowel into wall w/ (1) #4 turned up @ 12" o.c.	<varies>
FTG-2	1'-0"	<varies>	3'-0"	Reinf. w/ (2) #4 vert. T1B wrapped in #4 stirrup @ 48" o.c.	FROST FOOTING


Foundation Wall Schedule			
Type	Width	Reinforcing	Comments
C8	0'-8"	Reinf. w/ #4 vert. @ 12" oc / (3) #4 hor. equally spaced.	<varies>

Areas	
Basement Finished	1229 SF
Living Area	1328 SF
Garage	609 SF
Patio	152 SF
Front Porch	23 SF
Unexcavated	784 SF



Slab Schedule	
S4.1	4" MIN CONG. SLAB REINF. W/ #4'S E.W. @ 12" O.C. OVER COMPACTED FILL AND GRAVEL
S8.1	8" MIN CONG. SLAB REINF. W/ #4'S E.W. @ 12" O.C. OVER COMPACTED FILL AND GRAVEL

Foundation Notes:				
FOOTINGS FOUNDATION & CONCRETE NOTES				
1. TO ADDRESS DIFFERENTIAL SETTLEMENT, ALL INTERIOR BEARING AND EXTERIOR FOOTINGS & PADS TO BE LOCATED & PLACED MIN. 18 INCHES INTO UNDISTURBED NATURAL SOIL.				
2. EXIST. FOOTING TO BE PLACED MIN. 36 INCHES BELOW FIN. GRADE				
3. DESIGN IS BASED ON MIN. OF 2,500 PSI. CONCRETE STRENGTHS TO ACHIEVE THE FOLLOWING BASED UPON:				
A. 3,000 PSI FOR FOOTINGS, FOUND. WALLS & VERT. SUPPORTS				
B. 3,500 PSI FOR GARAGE FLOOR				
C. CONG. EXPOSED TO WEATHER TO HAVE 6% (+/-1%) AIR ENTRAINMENT				
D. PROVIDE 4" (MIN) CONG. SLAB REINF. W/ #4 @ 12" O.C. E.W. TOP REINF. OVER FROSTFALLS AS INDICATED (4" X 7" FT @ 8" O.C. E.W. PLACE OVER 6 MIL VAPOR BARRIER)				
E. REINFORCE EXTERIOR FOOTINGS W/ #4 @ 24" E.W. REINFORCE W/ (2) #4 CONT. AT BOTTOM				
F. PROVIDE #4 X 48" (L) @ 45 DEGREES @ REINFRANT CORNERS				
G. (2" X 12") ASTM A575 ANCHOR BOLTS @ 48" O.C. @ EXIST. WALLS				
H. ANCHOR PRESSURE TREATED PLATE @ INT. BEARING WALLS W/ 1/2" X 4-1/2" H/LTI WEDGE BOLTS @ 12" O.C. MAX. 12" FROM ENDS				
I. PROVIDE 24" L/48" MIN. INCLUDING CORNERS				
J. INSTALL HOLD-DOWN BOLT ANCHORAGE AS INDICATED ON PLAN				
K. PROVIDE BITUMINOUS DAMP-PROOFING AT FOUNDATION WALLS				
L. SOIL BEARING CAPACITY IS NOT ASSUMED TO BE GREATER THAN 2,000 PSF IN THE CURRENT FOUNDATION DESIGN. ALL COMPACTED FILL AREAS REQUIRE A SPECIAL INSPECTION				
STEEL COLUMNS & OTHER BASEMENT FOUNDATION NOTES				
1. ALL STEEL PIPE COLUMNS TO BE 3" (OR 3 1/2" SCHEDULE 40) GRADE				
2. INTER BEARING WALLS & COLUMNS SHALL BE ISOLATED FROM THE BASEMENT FLOOR SLAB				
3. INTER. NON-BEARING WALLS, OTHER THAN THOSE RESTING DIRECTLY ON THE FOOTING, SHALL BE ISOLATED FROM THE FLOOR FRAMING ABOVE				
4. AT WALKOUT FOUNDATION AREAS, REINFORCE THE SLAB FROM THE FOUNDATION WALL TO 2 FEET BEYOND THE OVERLAP AREA WITH #4'S @ 24 INCHES O.C. PERPENDICULAR AND HORIZONTAL TO THE WALL. MAXIMUM 4-FOOT OVERLAP				
5. AT FIN. JOISTS THE FOUNDATION WALL SHALL BE INSULATED WITH A MINIMUM R-6 INSULATION FOR A MIN OF 3 FEET BELOW THE BOTTOM OF THE SLAB.				
6. WHERE FLOOR JOISTS ARE PARALLEL TO THE FOUNDATION WALL, THE WALL SHALL BE SUPPORTED LATERALLY AT THE TOP BY SOLID BLOCKING FOR MINIMUM OF TWO JOIST SPACES, SPACED NOT MORE THAN 4 FEET O.C.				

Interior Partition Naming Convention		
Partition Material Type	Nominal Stud/Partition Thickness	Fire Rating or other modifier
Partition Height. Omitted at walls spanning full height.		

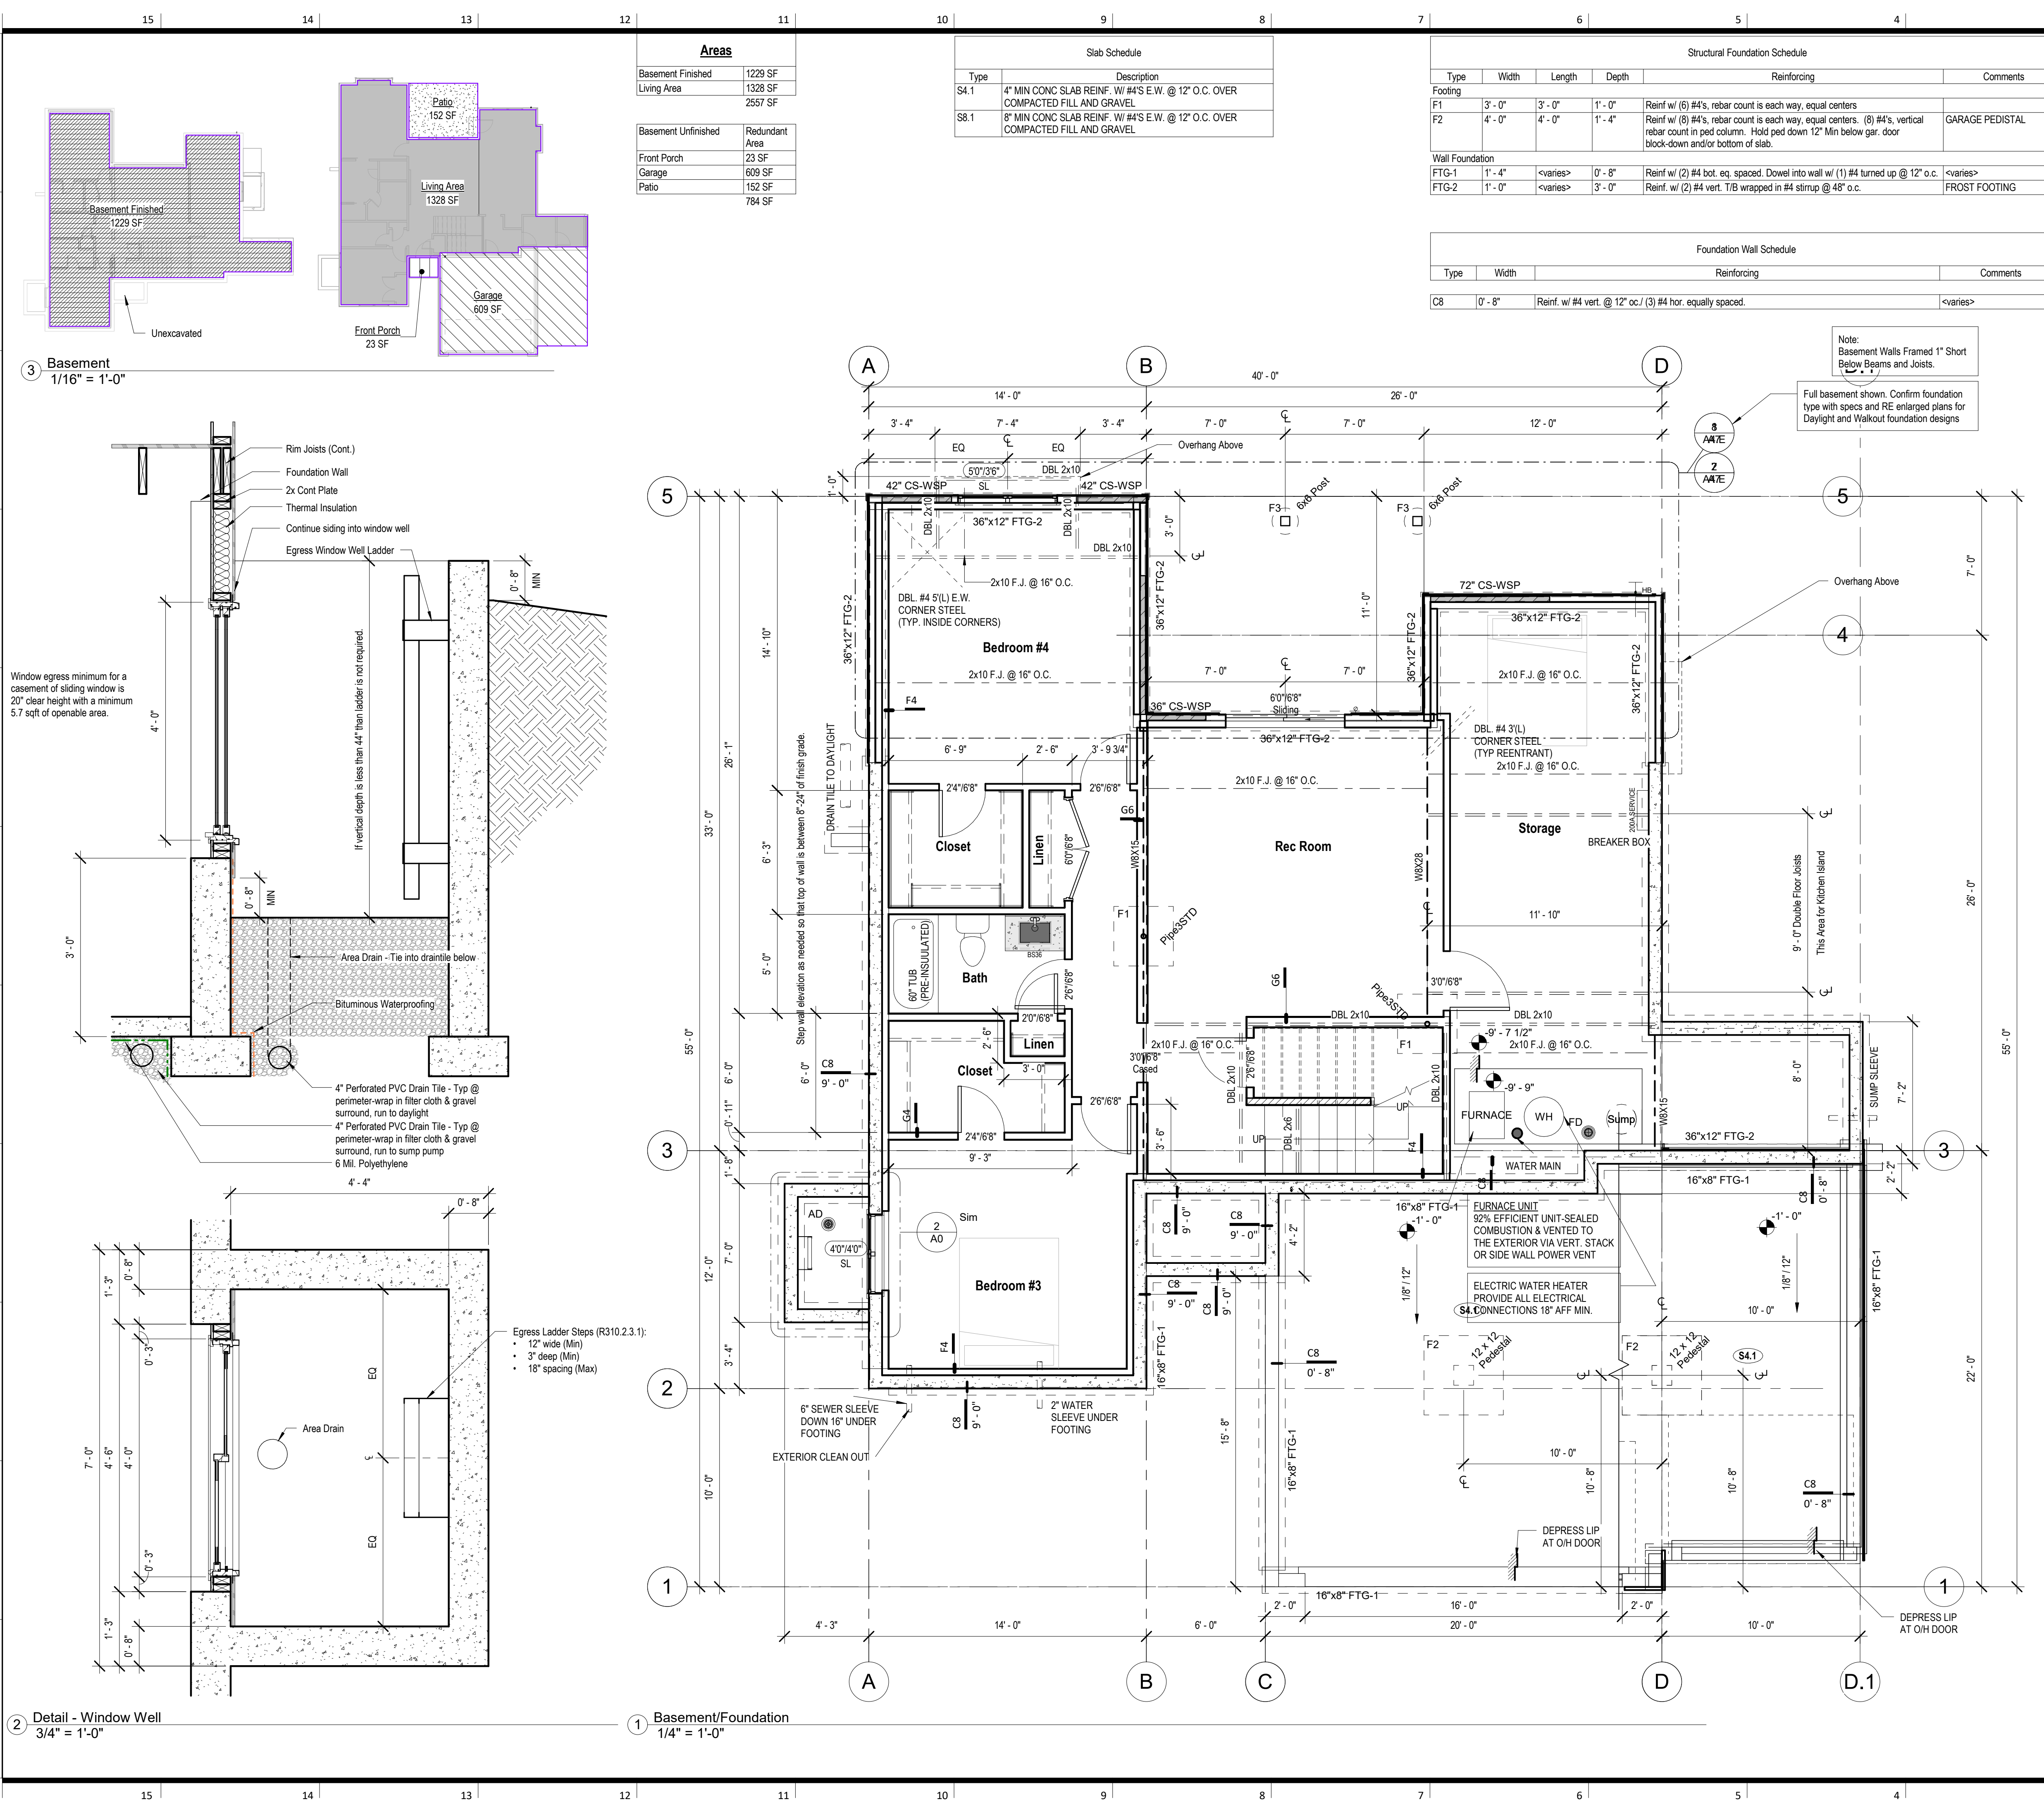

3 Basement  
1/16" = 1'-0"

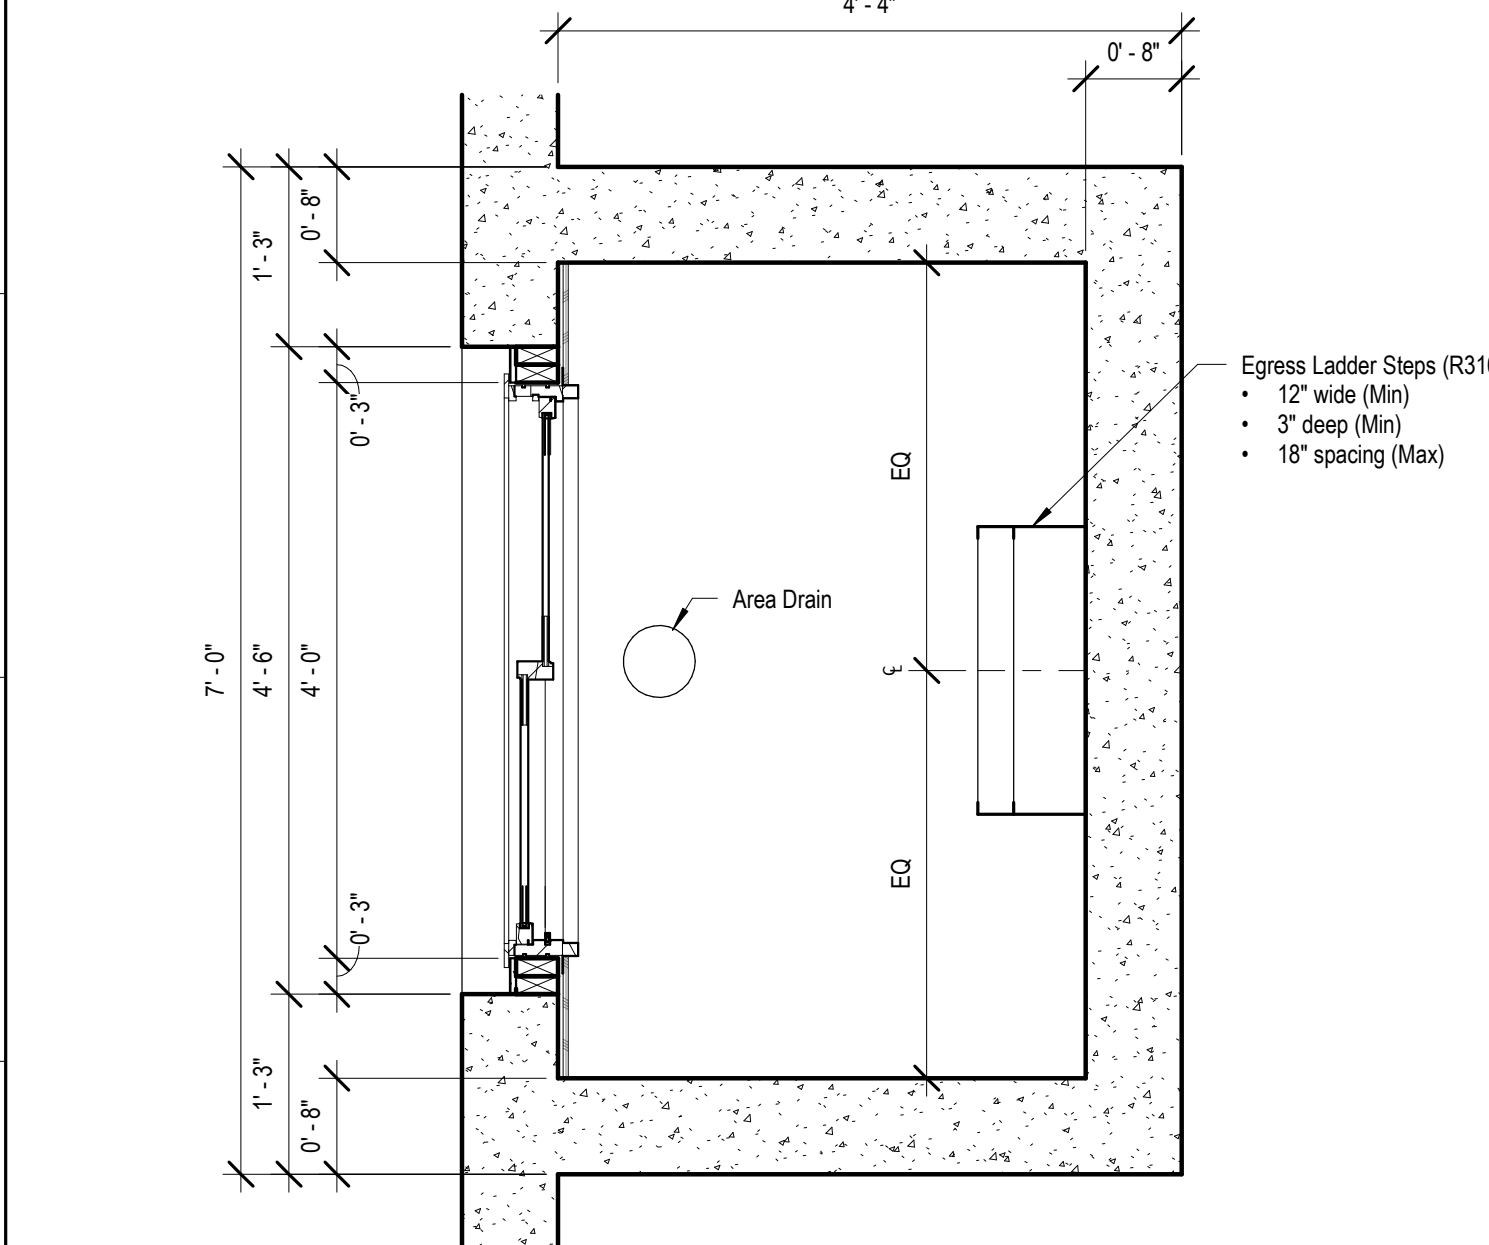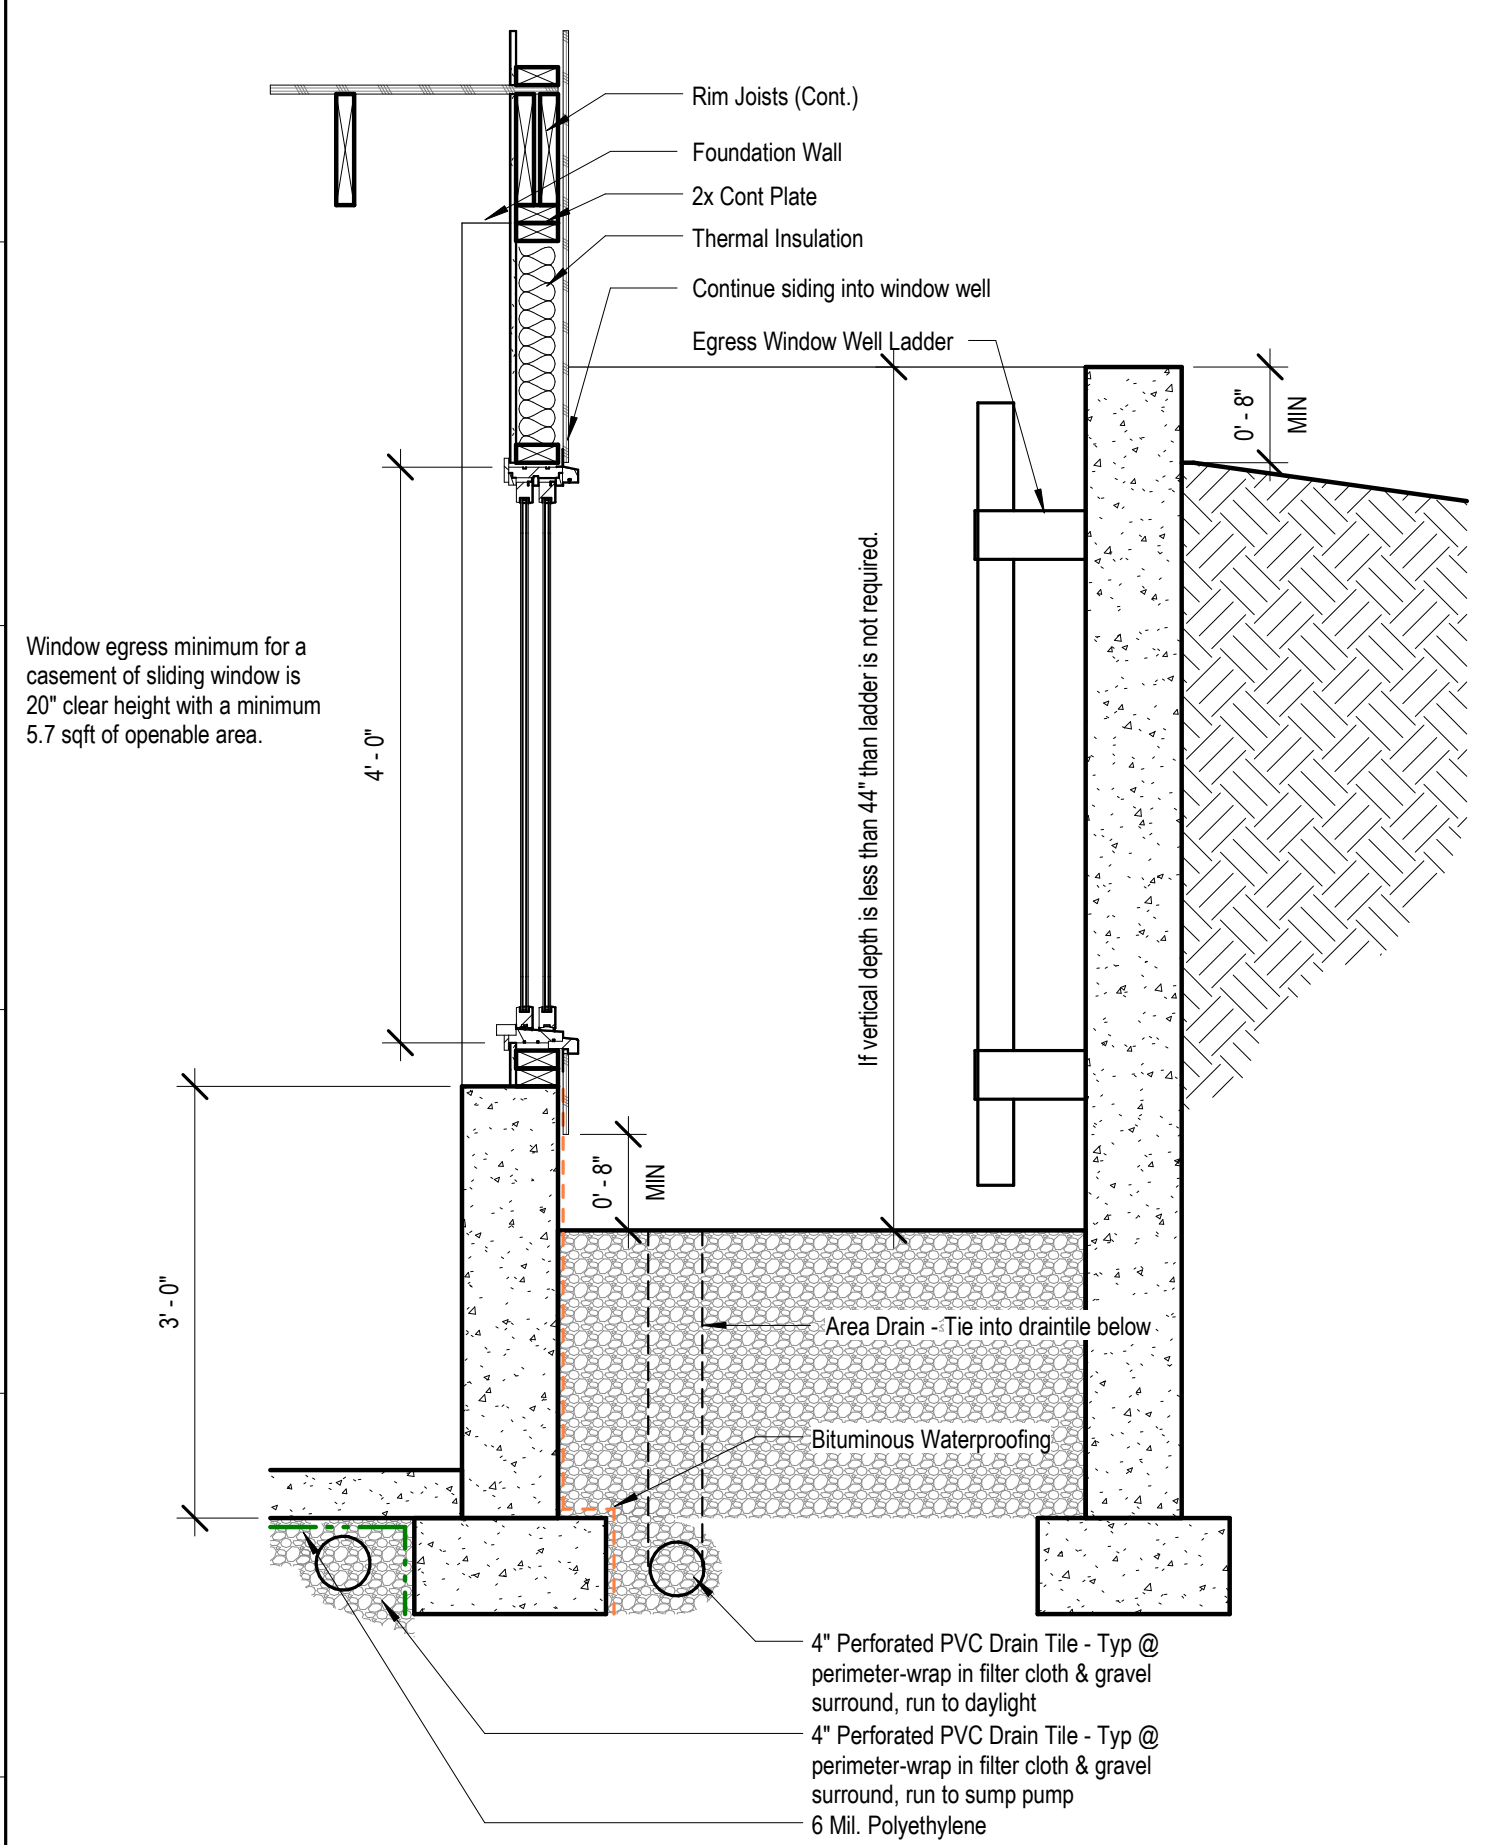

2 Detail - Window Well  
3/4" = 1'-0"

1 Basement/Foundation  
1/4" = 1'-0"

BRACED WALL LINE SCHEDULE (2 CAR GARAGE OPTION)						
WALL LINE	TOTAL LENGTH	AVG SPACING	BASE	TABLE R602.10.3 ADJ FACTOR	REQ'D LENGTH	PROVIDED LENGTH
MAIN FLOOR						
A	45'	45'	9'	0.95	8.55'	9.00'
B	45'	15'	10.5'	1.38	14.46'	15.00'
C	22'	22'	5.5'	0.95	5.23'	10.00'
D	50'	25'	11'	1.24	13.55'	14.00'
ATTIC						
1	20'	20'	3.5'	0.95	3.33'	6.00*
2	14'	14'	3.5'	0.95	3.33'	4.00*
3	26'	13'	7'	1.24	8.65'	9.00*
4	26'	26'	5.5'	0.95	5.23'	12.00**
5	14'	14'	3.5'	0.95	3.33'	6.00*

BRACED WALL LINE SCHEDULE (3 CAR GARAGE OPTION)						
WALL LINE	TOTAL LENGTH	AVG SPACING	BASE	TABLE R602.10.3 ADJ FACTOR	REQ'D LENGTH	PROVIDED LENGTH
MAIN FLOOR						
A	45'	45'	9'	0.95	8.55'	9.00'
B	45'	15'	10.5'	1.38	14.46'	15.00'
C	22'	22'	5.5'	0.95	5.23'	10.00'
D	28'	28'	5.5'	0.95	5.23'	9.00'
ATTIC						
D.1	22'	22'	5.5'	0.95	5.23'	6.00*
1	30'	30'	5.5'	0.95	5.23'	6.00*
2	14'	14'	3.5'	0.95	3.33'	4.00*
3	36'	12'	10.5'	1.38	14.46'	15.00'
4	26'	26'	5.5'	0.95	5.23'	12.00**
5	14'	14'	3.5'	0.95	3.33'	6.00*

- \* CS-PF PANELS CONTRIBUTING LENGTH ARE CALCULATED AT 1.5x ACTUAL LENGTH PER TABLE R602.10.5
- CS-WSP PANELS: DISTANCE FROM END OF BRACED WALL LINE TO FIRST BRACED WALL PANEL CANNOT EXCEED A COMBINED TOTAL OF 10' PER R602.10.2.2
  - WOOD STRUCTURAL PANELS: BLOCKING OF HORIZONTAL JOINTS IS REQUIRED UNLESS EXCEPTION R602.10.4.4.1 IS NOTED AS BEING APPLIED IN SCHEDULE ABOVE.
  - CS-WSP PANELS: MIN. 2 PANELS AT BOTH CORNERS WITHOUT USING HOLD DOWNS PER R602.10.4.4 AND MAX. 12'-6" FROM CORNER
  - CS-WSP PANELS: MIN PANELS LENGTH ADJACENT TO AN OPENING FOR 9' PLATE = 27", FOR 8' PLATE = 24" PER TABLE R602.10.5.

- ③ **Brace System**  
1 1/2" = 1'-0"

ASPHALT SINGLES OVER 15# FELT PAPER ON MIN. 9/16" PLYWD. OR OSB BOARD W/ SPACER CLIPS EDGES NAILED @ 6" O.C. W/ 8d COMMON

INSULATION BATTLE @ RAFTERS

REDWOOD OR VINYL FASCIA W/ GALV. FLASHING

GUTTER


2 x 4 LOOKOUTS @ 24" O.C. W/ VINYL SLOTTED EAVES

PER IRC 703.2 WEATHER RESISTANT SHEATHING PAPER, ASPHALT SATURATED FELT NO. 15-COMPLYING WITH ASTM D 226 APPLIED OVER THE SUDS OR SHEATHING OF ALL EXT. WALLS

**FLOATING WINDOW SEAT DETAILS:**  
-INSTALLED 20" FROM FLOOR  
-7 1/4" TALL, 9 1/4" DEEP, 60" LENGTH

**Door and Window Headers**  
All Headers are (2) 2x10 boards at 6" 10" to bottom of header, U.N.O. Full protection meeting IRC R312.2 shall be provided for windows w/ sills < 24" AFF & EXT. Grade > 72" below window.


**Interior Partition Naming Convention**

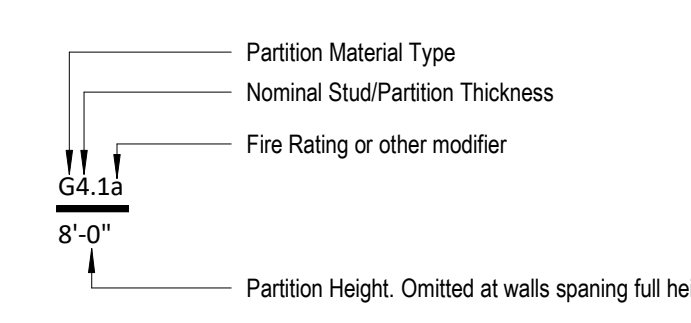


**General Notes:**

- DOORS AND WINDOWS**
- ALL GLAZING WITHIN 12" OF THE FINISHED FLOOR, ADJACENT TO DOORS > 24" AND WITHIN DOORS, ABOVE PARTITIONS TO BE SAFETY TYPE GLASS AND LABELED SUCH AS COMPLIANCE WITH SECTION 308 OF THE IRC.
  - SHOWER DOORS SHALL HAVE SAFETY GLAZING. HINGED SHOWER DOORS SHALL SWING OUTWARD.
- GARAGES**
- GARAGE SEPARATION WALL TO BE 1"R CONST. W/ MIN. 5/8" TYPE X GWB, EXTEND TO BOTTOM OF ROOF. DOOR TO BE 24" MIN. RATED, 1 3/8" C.I. EQUIPPED W/ GLOBE & LATCH.
  - 1 1/2" x 5/8" RECEPTACLES SHALL HAVE GFCI PROTECTION.
  - TYPE X 5/8" GB REQUIRED ON GARAGE CEILING BELOW LIVING AREAS.
- LIGHT AND VENTILATION**
- PROVIDE STARWAY ILLUMINATION PER R302.9.3
  - CABLE VENT & MECHANICAL VENTS TO PROVIDE A MIN. OF 10 S.F. NET-FREE OF ATTIC VENTILATION.
  - FURNACES ENCLOSED IN A ROOM LESS THAN 100 S.F. SHALL BE PROVIDED BY A MEANS OF COMBUSTION MAKE-UP AIR AS DETERMINED BY A QUALIFIED AND LICENSED MECHANICAL CONTRACTOR.
  - VENTILATE KITCHENS AND LAUNDRY ROOMS PER R303.3
  - PROVIDE MIN. 16" x 10" SOFFIT VENTS ALONG GABLE SPACED EVENLY W/ NO MORE THAN 9'-0" O.C.
- CYPRESS BOARD**
- GWB APPLIED TO CEILING SHALL BE 16" WHEN FRAMING MEMBERS ARE 16" O.C. OR 5/8" WHEN MEMBERS ARE 24" O.C. OR USE 1/2" SAG-RESISTANT GYP. CEILING BOARD.
- MECHANICAL SYSTEMS**
- FURNACE & WATER HEATER SHALL BE ON 18" PLATFORM IN PLACE IN A GARAGE OR ROOM W/ DIRECT ACCESS TO GARAGE.
  - PROVIDE MIN. 75% AFUE FOR WEATHERIZED GAS HEATING EQUIP. 80% FOR NON-WEATHERIZED.
  - PROVIDE MIN. 13 SEER FOR AIR CONDITIONING EQUIPMENT
  - SUPPLY AND RETURN DUCTS SHALL BE INSULATED TO MIN. R-8
- ELECTRICAL SYSTEMS**
- PROVIDE GROUND ENCASED IN CONCRETE FOOTING
  - ALL ELECTRICAL CONDUCTORS SHALL BE COPPER
  - RECEPT. IN THE FOLLOWING LOCATIONS SHALL BE GFCI PROTECTED:
    - BEDROOM KITCHEN (WITHIN FEET OF SINK), GARAGE, SHED, EXTERIOR, UNFINISHED BASEMENT & HEATED FLOOR.
    - ALL BRANCH CIRCUITS THAT SUPPLY 120V, SINGLE PHASE, 15 & 20 AMP OUTLETS INSTALLED IN:
      - BEDROOMS, BATHROOMS, REC ROOMS, CLOSETS, HALLWAYS, & SM. ROOMS SHALL BE PROTECTED BY A COMBINATION TYPE ARC-FULT CIRCUIT INTERRUPTER
      - INSTALLED TO PROVIDE PROTECTION OF THE BRANCH CIRCUIT
  - ALL 15 & 20A RECEPT. SHALL BE LISTED TAMPER-RESISTANT.
    - EXCEPTION: RECEPTACLES IN THE FOLLOWING LOCATIONS SHALL NOT BE REQUIRED TAMPER RESISTANT:
      - RECEPTACLES LOCATED MORE THAN 5.5 FEET AFF.
      - WHERE SUCH RECEPTACLES ARE LOCATED IN SPACES DEDICATED FOR THE APPLIANCE SERVED & UNDER CONDITIONS OF NORMAL USE, THE APPLIANCE ARE NOT EASILY MOVED, APPLIANCE TO BE CORO-N-PLUG CONNECTED TO RECEPT.
- EXTERIOR WALL FRAMING**
- BOTTOM SILL PLATES SHALL BE PRESSURE TREATED OR EQUAL
  - SILL PLATES SHALL BEARERED MIN. 6 INCHES ABOVE GRADE
  - ALL EXTS. STUDS TO BE SECURED TO THEIR DOUBLE TOP PLATES W/ (2) 16d NAILS (MIN)
  - ALL EXTERIOR CORNERS TO BE BRACED WITH 7/16" OSB NAILED SCHEDULE SHALL BE 8d COMMON @ 6" O.C. ALONG EDGES & 8d COMMON @ 12" O.C. @ INTERMEDIATE STUDS
- ROOF FRAMING**
- ALL ROOF RAFTERS/CHANGES TO BE 16" UNO
  - ALL JOISTS & RAFTERS TO BE ALIGNED OVER STUDS
  - ROOF SHEATHING SHALL BE 7/16" OSB LAP W/ LONG DIMENSION PERPENDICULAR TO GABLE LINE & STAGGERED 48" O.C. W/ LONG DIMENSION PERPENDICULAR TO GABLE LINE & STAGGERED 48" O.C. W/ GALV. SPACER CLIPS ALONG ALL EDGES. SECURE SHEATHING W/ 8d COMMON NAILS TO RAFTERS AT 6" O.C. ALL EDGES
- UNFINISHED BASEMENT REQUIREMENTS**
- FIRE PROTECTION OF FLOORS: FLOOR ASSEMBLIES CONSTRUCTED W/ JOISTS LESS THAN 2X10 DIMENSIONAL LUMBER
  - JOISTS OR OPEN WEB JOISTS OVER UNFINISHED BASEMENTS SHALL BE PROVIDED WITH 5/8" OSB
  - UNFINISHED BASEMENTS SHALL BE MIN. R-13 INSULATED WALL OR INSULATED OR FLOORCEILING (MIN R-19)
  - ALL EXPOSED HVAC DUCTING IN UNFINISHED BASEMENTS TO BE MIN R-4 INSULATED OR ENCLOSED INSIDE A FLOORCEILING
  - UNFINISHED BASEMENTS SHALL HAVE NO CONDITIONED AIR OUTLETS
- EROSION CONTROL**
- EROSION CONTROL MEASURES SHALL BE IN PLACE & IN GOOD WORKING ORDER AT ALL TIMES DURING INSPECTIONS. IN THE EVENT THAT THEY ARE NOT, THE RESPECTOR MAY CANCEL THE INSPECTION UNTIL SUCH TIME THE EROSION CONTROL MEASURES ARE IN PLACE. A FINE, RE-INSPECTION FEE & STOP WORK ORDER MAY BE ISSUED IF EROSION CONTROL IS NOT ADDRESSED. MINIMUMS INCLUDE:
- SILT FENCE OR STRAW BATTLE AROUND ALL DISTURBED SOIL. SHALL BE IN PLACE BEFORE ANY EXCAVATION BEGINS
  - TEMPORARY GRAVEL CONSTRUCTION ENTRANCE. THIS ENTRANCE SHOULD BE THE ONLY ENTRANCE & EXIT USED FOR VEHICLES INTO & OUT OF THE SITE
  - STREETS SHALL BE MAINTAINED FREE OF ALL SOIL & GRAVEL IN A BROOM CLEAN CONDITION AT ALL TIMES
- WOOD FRAMING, FLOORS AND ROOF NOTES**
- EXT. WALL FRAMING TO BE 2 x 4 @ 16" O.C. OR DFL STUD GRADE 2 OR BETTER @ 16" O.C.
  - ROOF SHEATHING TO BE 7/16" OSB NAILED W/ 8d @ 6" O.C. PANEL INDEX 240; PROVIDE CLIPS AT UNSUPPORTED PANEL EDGES
  - CEILING EXT. WALLS W/ 7/16" OSB NAILED W/ 8d @ 6" O.C.
  - HEADERS: PROVIDE 2x4 @ 16" O.C. OR DFL #2 OR BETTER UNO. CONSTRUCT HEADERS W/ 2 x 8 @ 16" O.C. BETWEEN OR OVER JOISTS OF 16" O.C.
  - BLOCKING MIN. 1.5 INCHES UTILITY GRADE LUMBER JOISTS TO BE SUPPORTED AT ENDS
  - ALL LEFTS/ SOIL BLOCKING: 10" x 10" MIN.
  - 2x10 C.I. & RAFTERS TO BE SYP OR DFL GRADE #2 OR BETTER
  - EXT. WALL STUDS & GABLE END WALLS TO BE CONTINUOUS FROM FLOOR TO ROOF/CEILING DIAPHRAGM PER R603.3
  - STUDS, RAFTERS, JOISTS, MIS. LUMBER MIN. GRADE #2 D.F. OR S.Y.P.
- PHYSICAL SECURITY ORDINANCE**
- OWNER/BUILDER IS RESPONSIBLE FOR COMPLIANCE OF PHYSICAL SECURITY ORDINANCE FOR THEIR LOCAL JURISDICTION

- SHOWER HEADS:**  
-INSTALLED 62" FROM FLOOR TO TOP OF HEAD  
-1 HEAD INSTALLED 38" FROM NICHE WALL  
-2 HEAD INSTALLED 53" FROM NICHE WALL

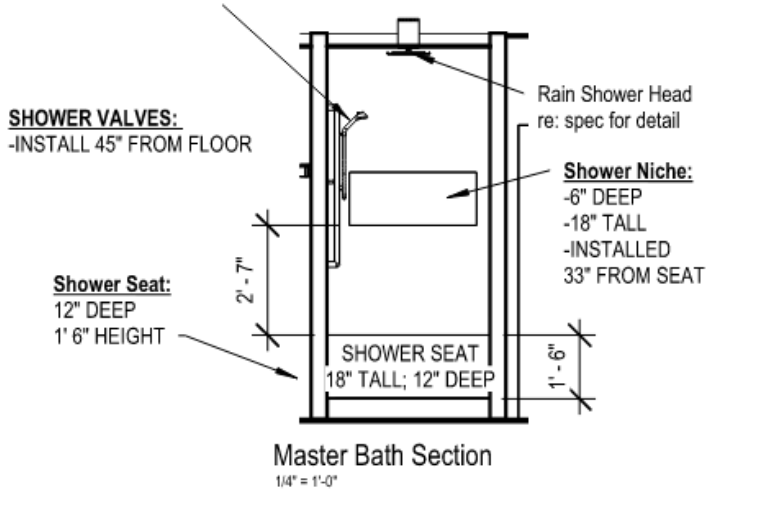

- SHOWER VALVES:**  
-INSTALL 45" FROM FLOOR

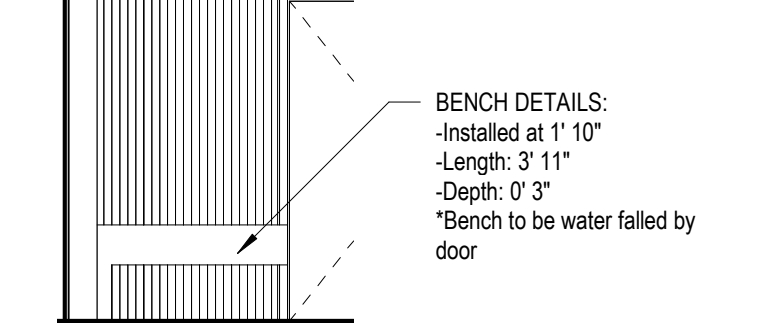

- BENCH NOOK ACCENT**  
1/4" = 1'-0"

② Section 3  
1/2" = 1'-0"

① Floor Plan - Living Space  
1/4" = 1'-0"



architect:  
Elevate Design + Build  
350 SW Longview Blvd  
Lee's Summit, MO 64081  
816.622.8826 voice  
www.elevatedesignbuild.com  
2027 SW Hook Farm Dr  
Lee's Summit, MO 64082

PERMIT SET  
Original Issue Date: 2022-06-21

REVISIONS	DATE
Number	DESCRIPTION

Floor Plan - Main Level

**A1**


15 | 14 | 13 | 12 | 11 | 10 | 9 | 8 | 7 | 6 | 5 | 4 | 3 | 2 | 1

Lighting Fixture Schedule		
Type Mark	Description	Type Comments
B1	Ceiling Mounted Exposed Bulb	
C1	Recessed Can Light - Interior	
C2	Recessed Can Light - Exterior	
C3	LED Disk Light	
CF1	Ceiling Fan w/ Light - Surface Mounted	
CF2	Ceiling Fan w/ Light - Down Rod	Mount with 2'-0" Down Rod
S1	Wall Sconce - Exterior	
V1	Vanity Wall Mounted	
V2	Vanity Wall Mounted	


Note:  
 1. Lighting fixtures penetrating the thermal envelope (Ex: can lights in attic) shall be IC-Rated, Leakage-Rated and sealed to teh gypsum wallboard (N1103.1.1)



# Greystone - Hook Farms 26

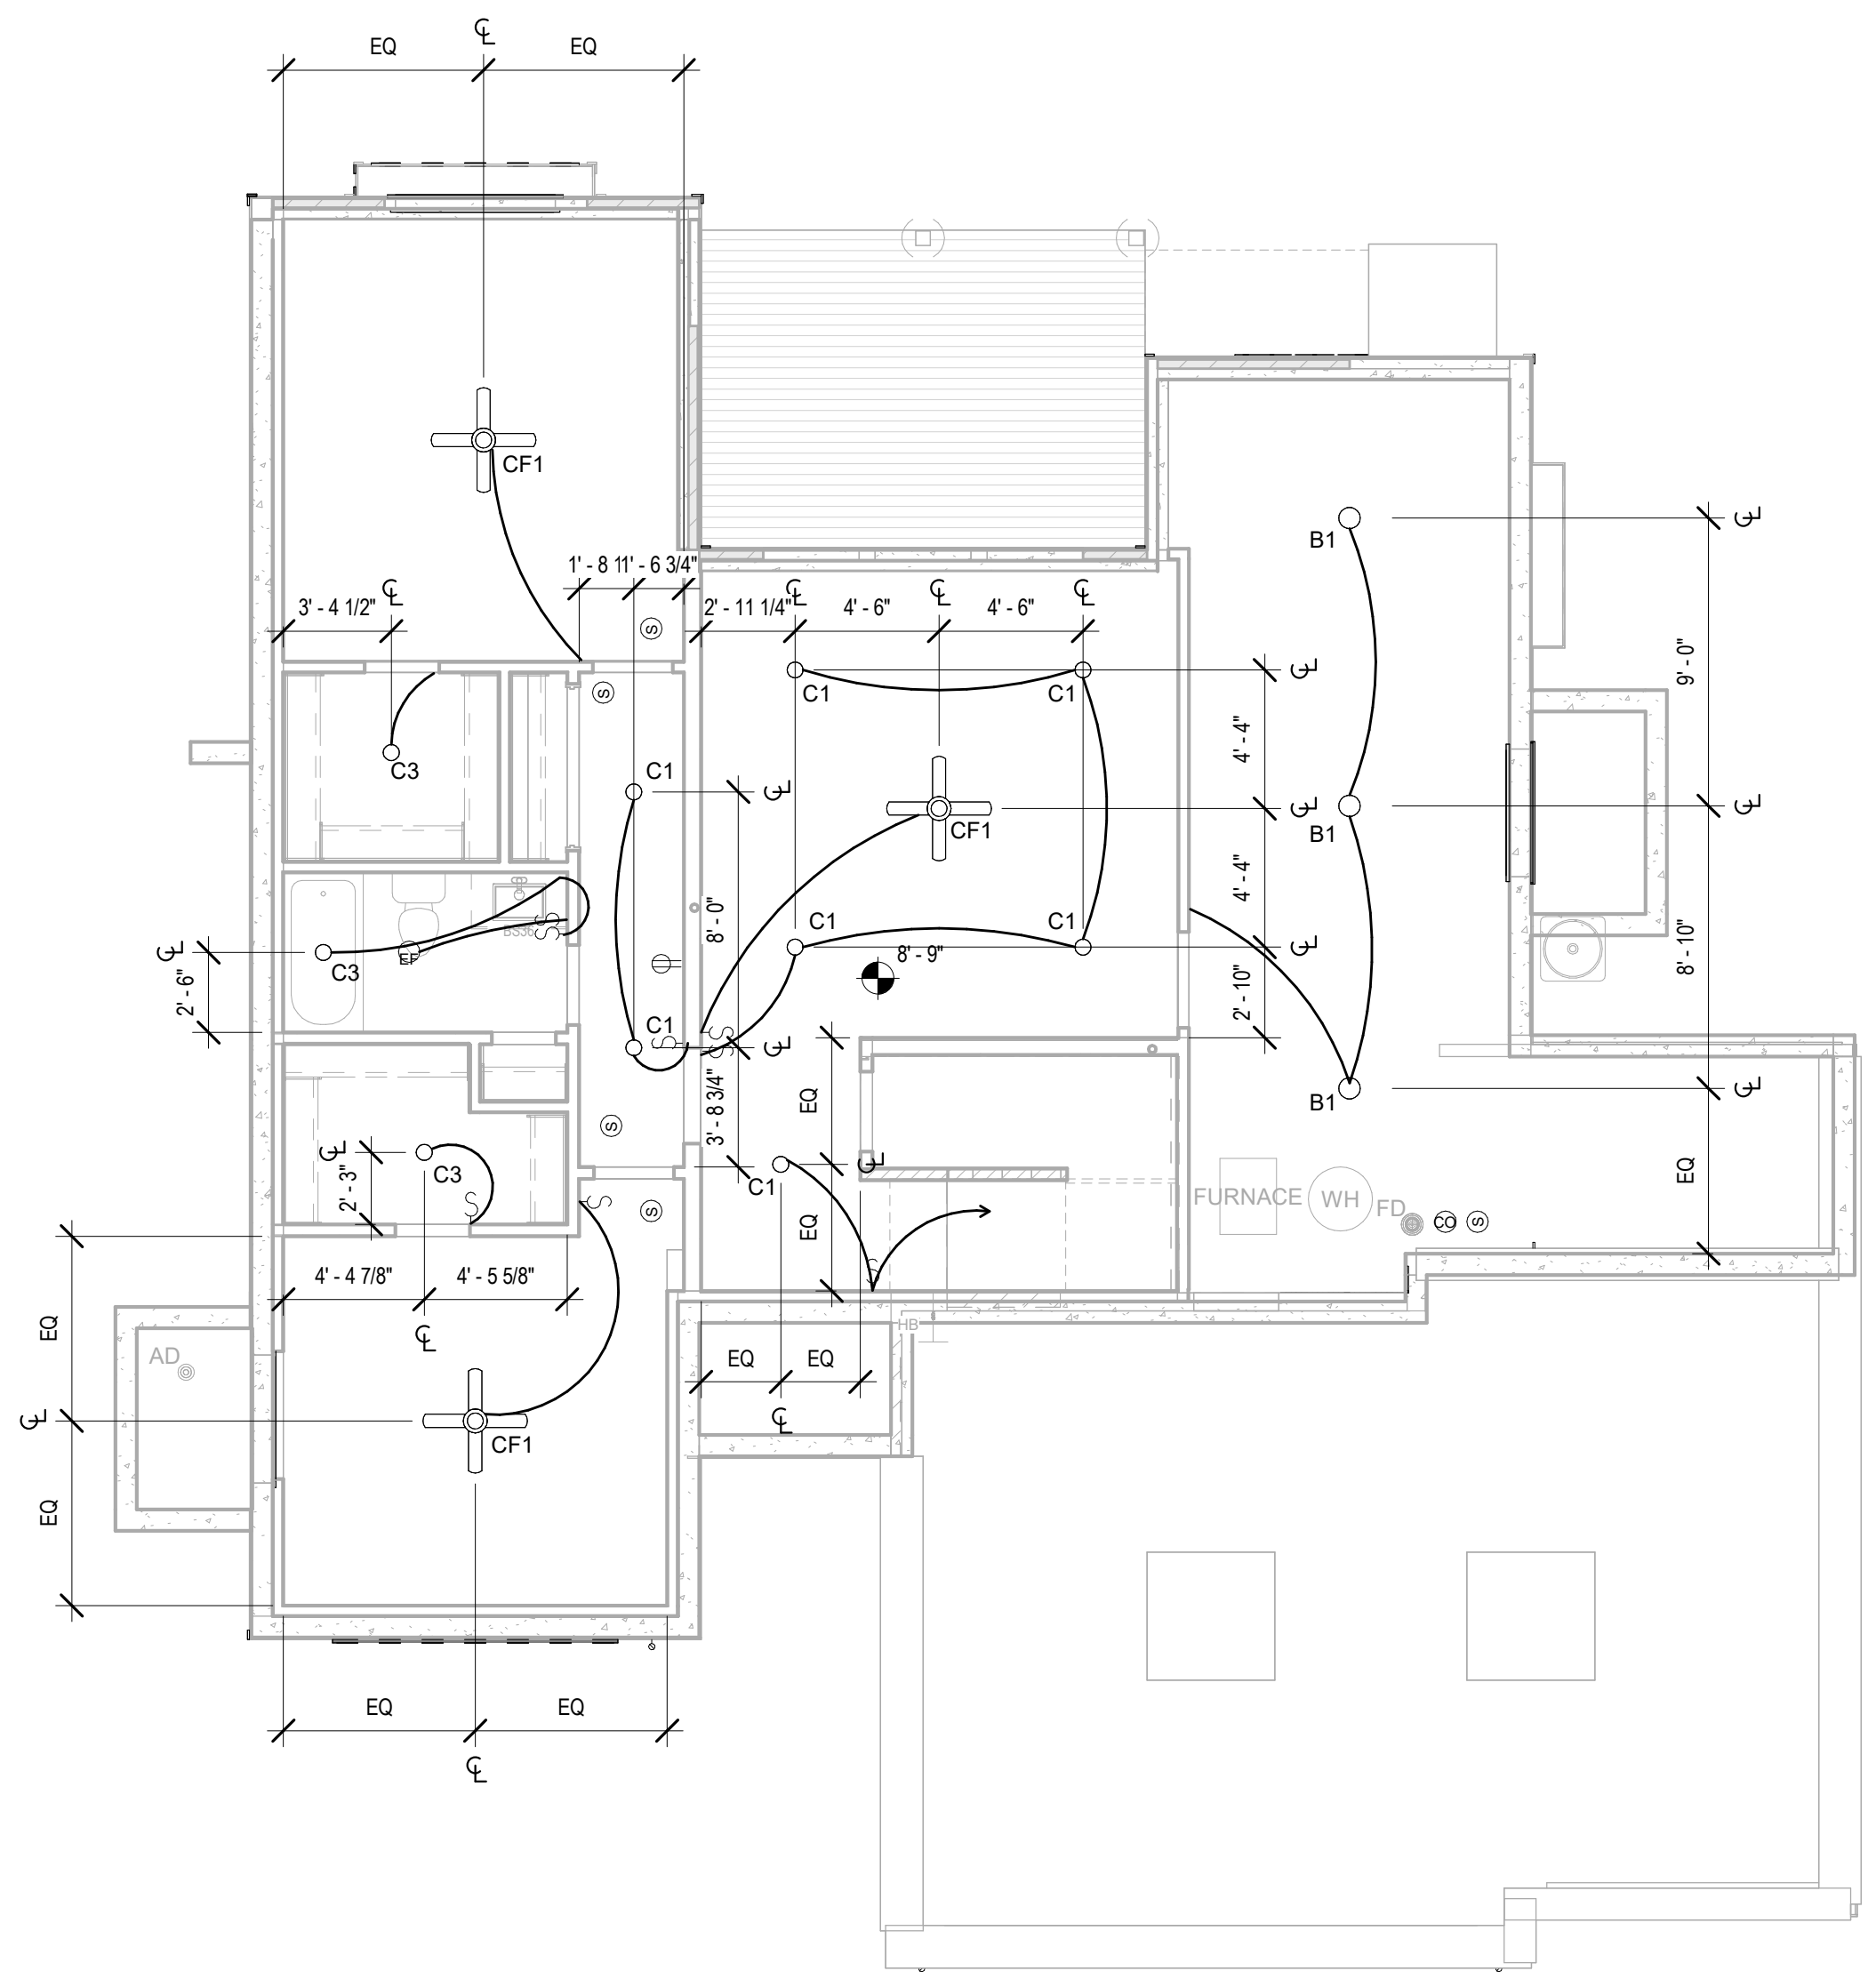

② RCP/Electrical - Basement  
 3/16" = 1'-0"

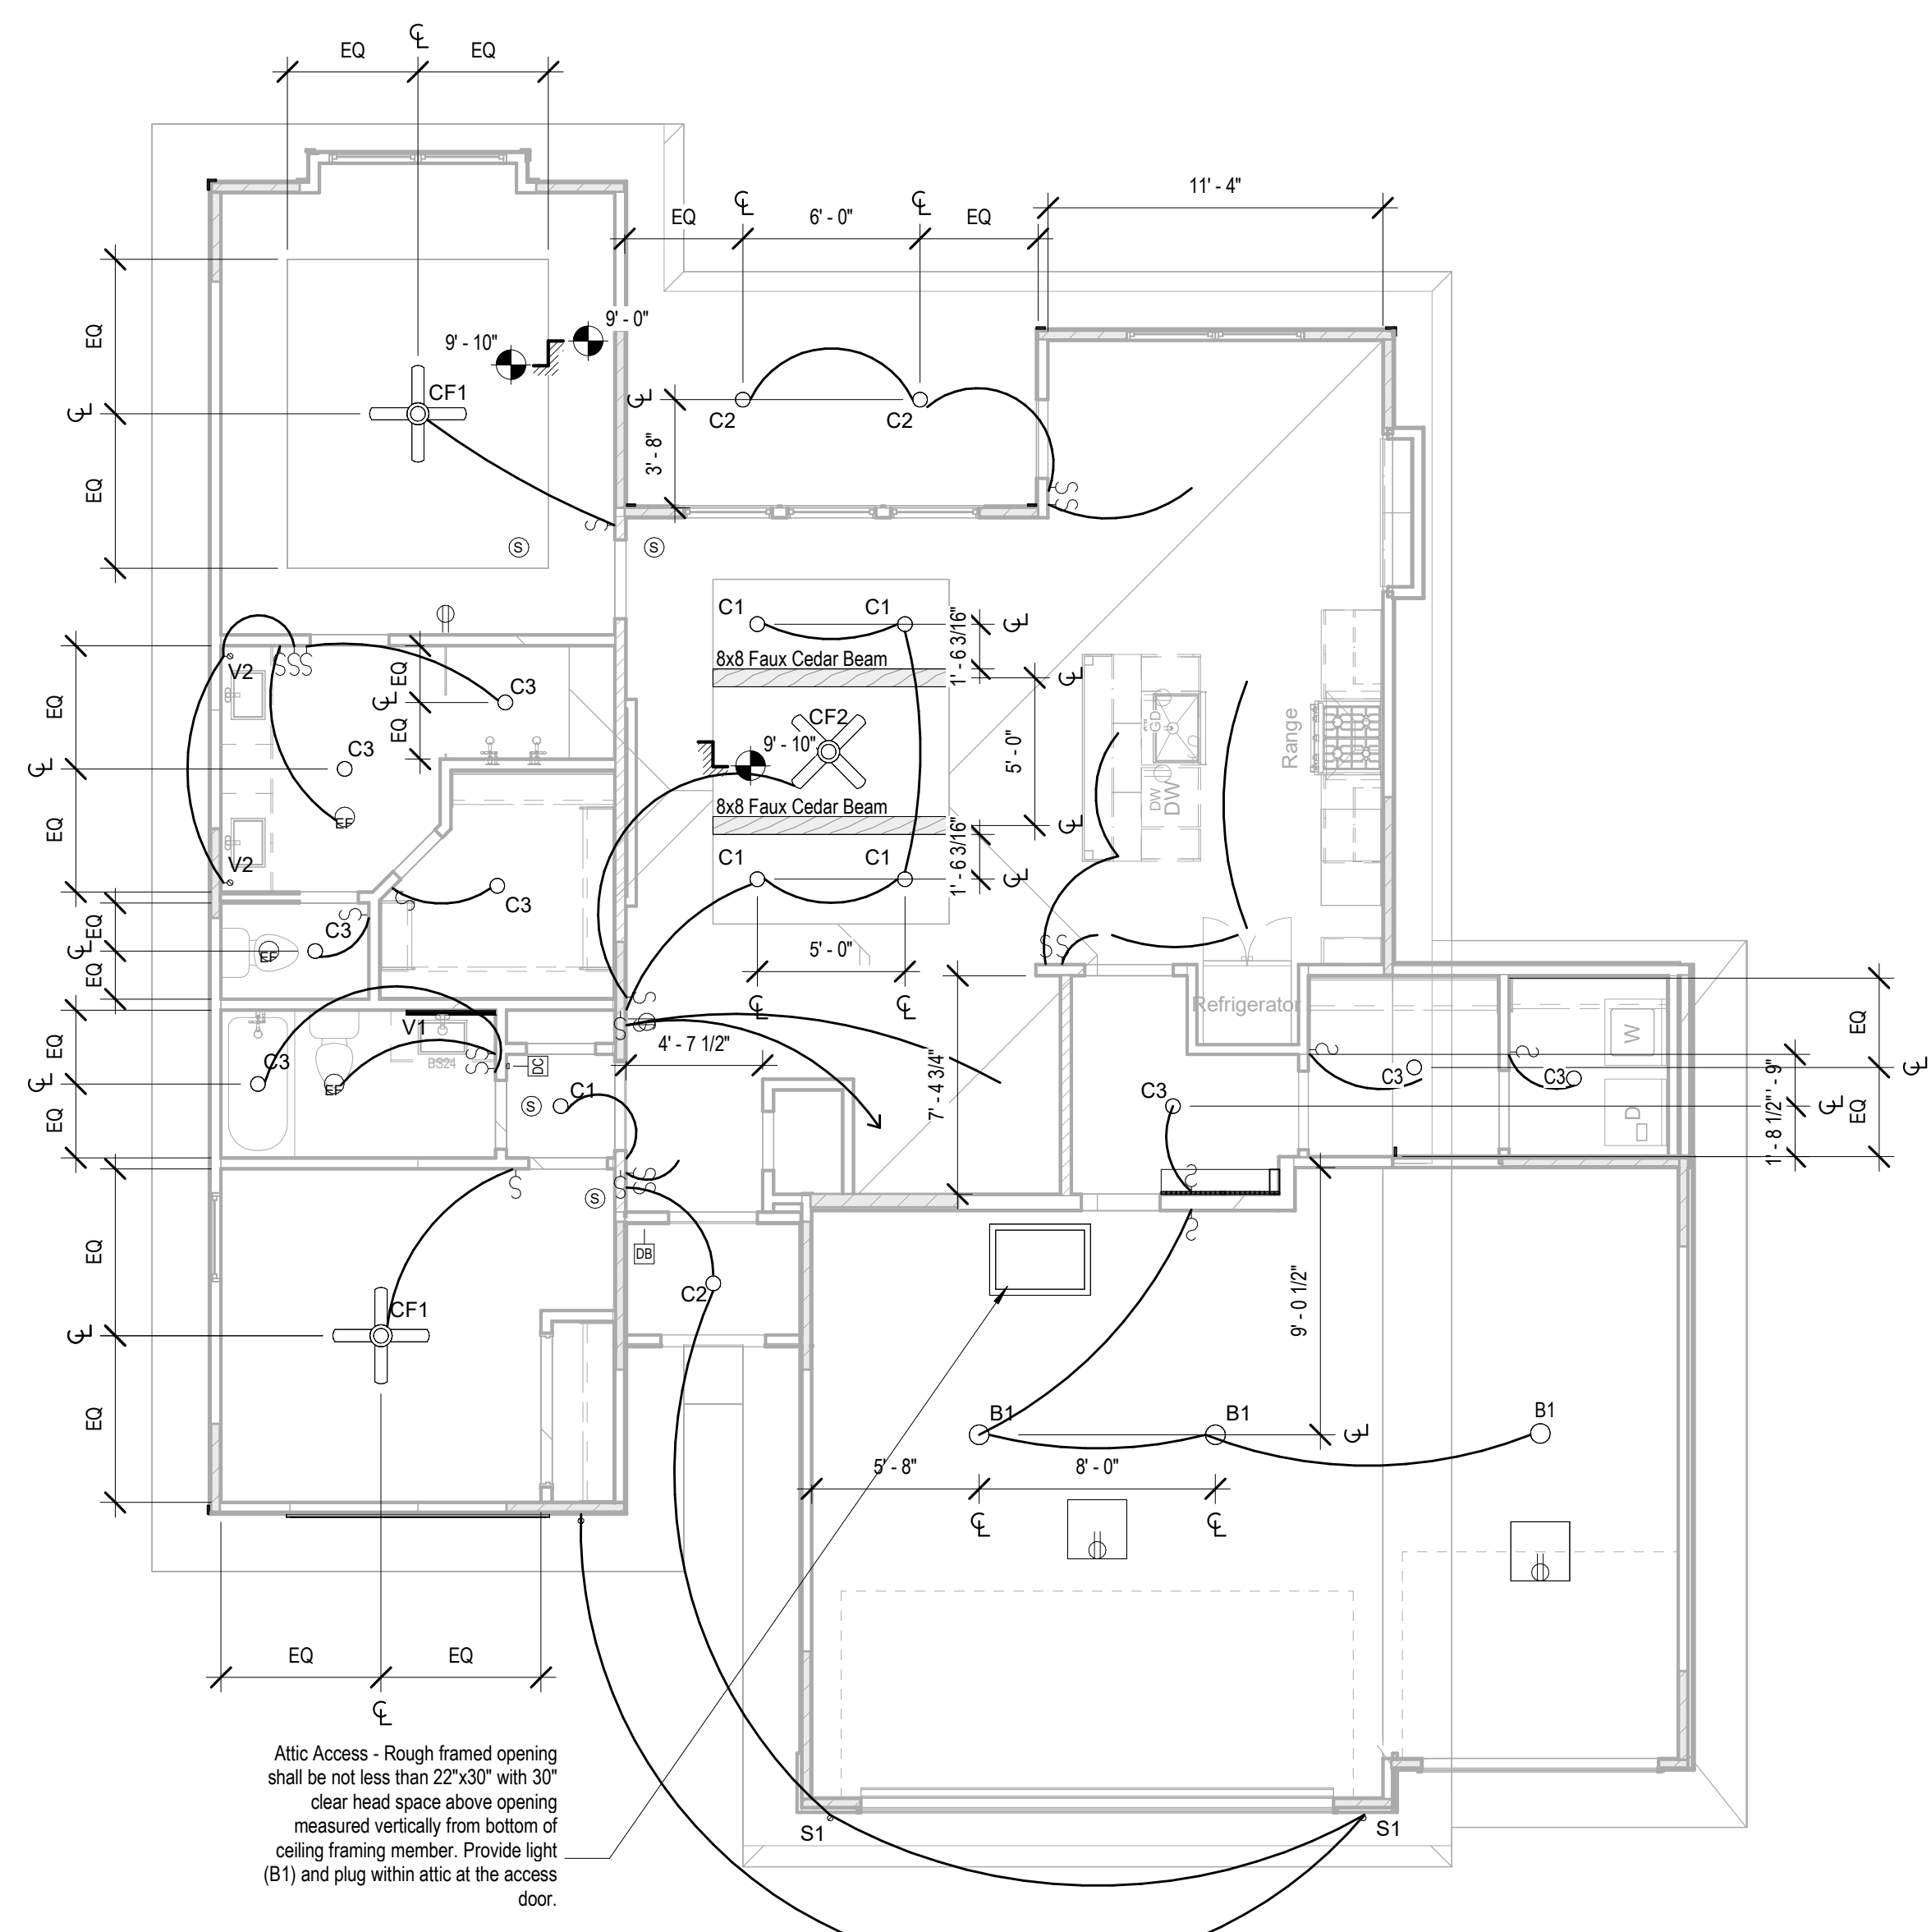

① RCP/Electrical Plan - Main Level  
 3/16" = 1'-0"

architect:  
 Elevate Design + Build  
 350 SW Longview Blvd  
 Lee's Summit, MO 64081  
 816.622.8826 voice  
 www.elevatedesignbuild.com  
 2027 SW Hook Farm Dr  
 Lee's Summit, MO 64082

UNLESS A PROFESSIONAL SEAL WITH SIGNATURE AND DATE IS AFFIXED, THIS DOCUMENT IS PRELIMINARY AND IS NOT INTENDED FOR CONSTRUCTION, RECORDING PURPOSES OR IMPLEMENTATION



PERMIT SET  
 Original Issue Date: 2022-06-21

REVISIONS		
Number	DESCRIPTION	DATE

RCP/Electrical Plan

# A2

Project No. RELEASE FOR **HR350** ACTION AS NOTED FOR PLAN REVIEW DEVELOPMENT SERVICES LEE'S SUMMIT, MISSOURI 11/02/2022

# Greystone - Hook Farms 26

architect:  
**Elevate Design + Build**  
350 SW Longview Blvd  
Lee's Summit, MO 64081  
816.622.8826 voice  
www.elevatedesignbuild.com  
2027 SW Hook Farm Dr  
Lee's Summit, MO 64082

UNLESS A PROFESSIONAL SEAL WITH SIGNATURE AND DATE IS AFFIXED, THIS DOCUMENT IS PRELIMINARY AND IS NOT INTENDED FOR CONSTRUCTION, RECORDING PURPOSES OR IMPLEMENTATION




PERMIT SET  
Original Issue Date: 2022-06-21

REVISIONS		
Number	DESCRIPTION	DATE

Elevations

## A3.C


Project No. **RELEASE FOR PERMITS**  
AS NOTED FOR PLAN REVIEW  
DEVELOPMENT SERVICES  
LEE'S SUMMIT, MISSOURI  
**11/02/2022**

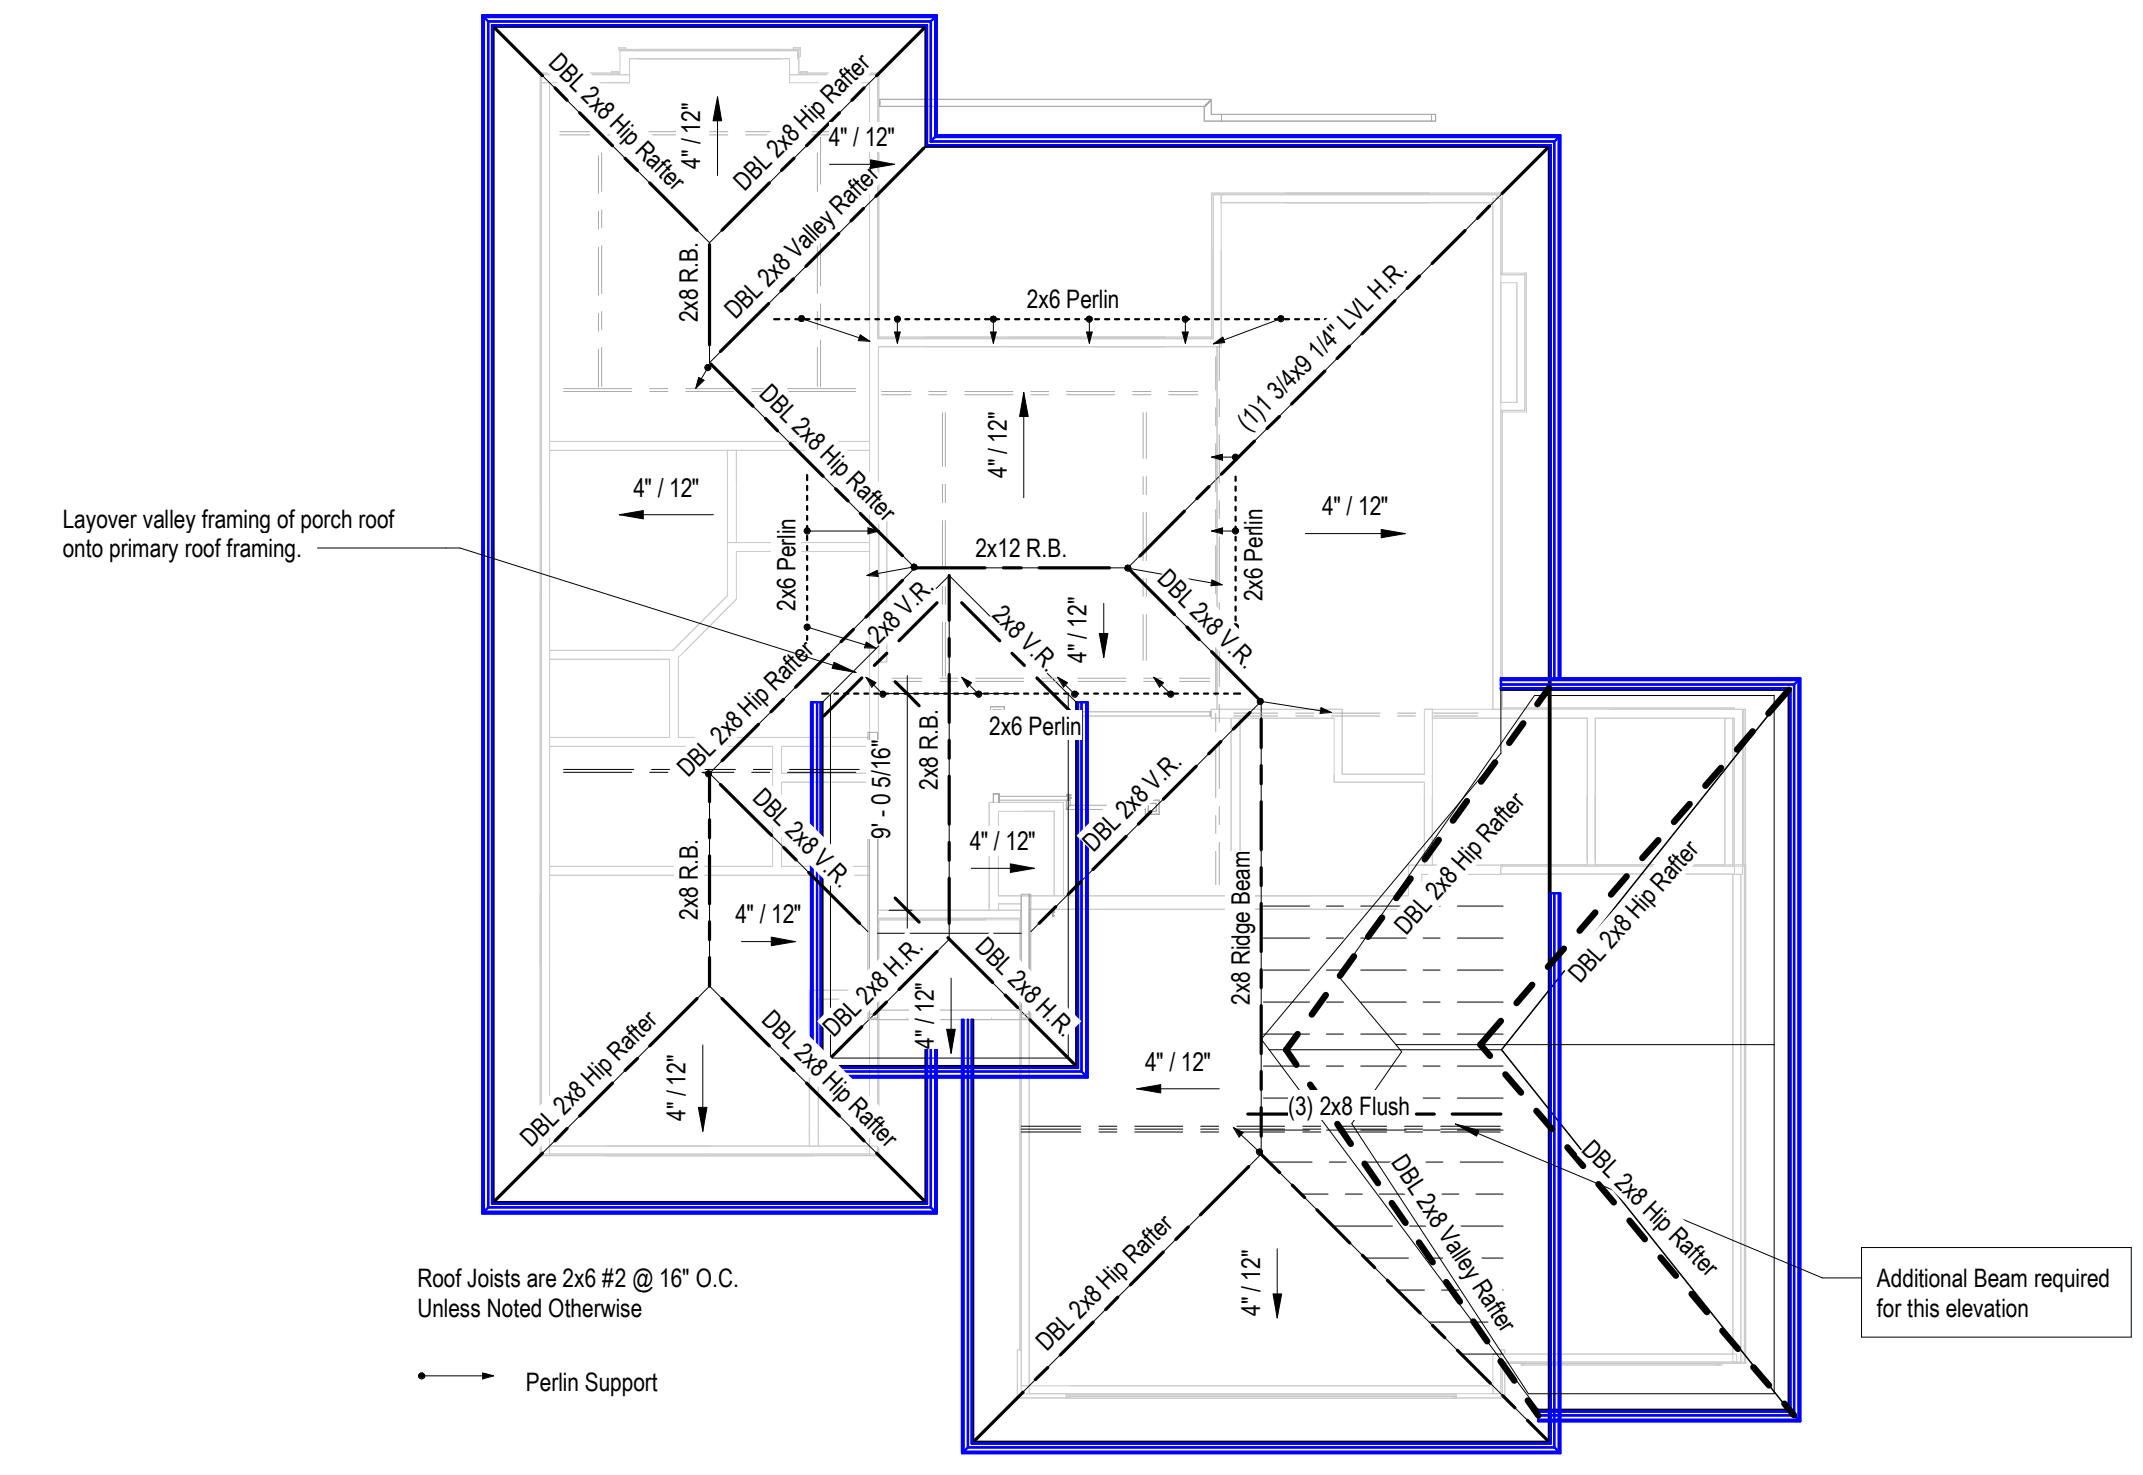


5 Roof Framing  
1/8" = 1'-0"




4 Back Elevation  
1/8" = 1'-0"

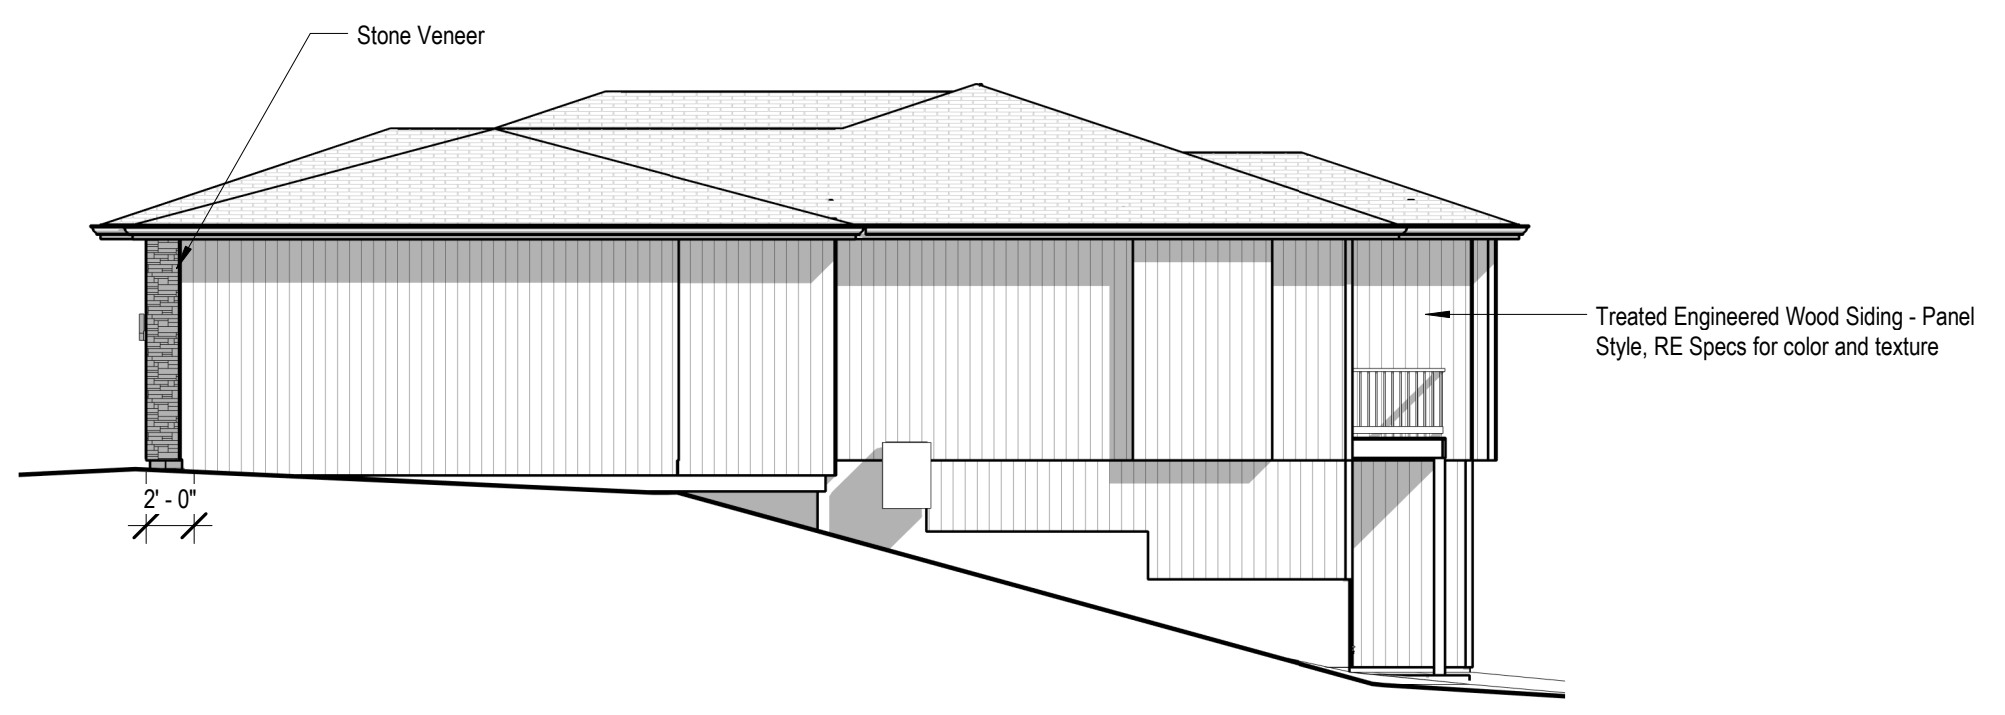

3 Right Elevation  
1/8" = 1'-0"

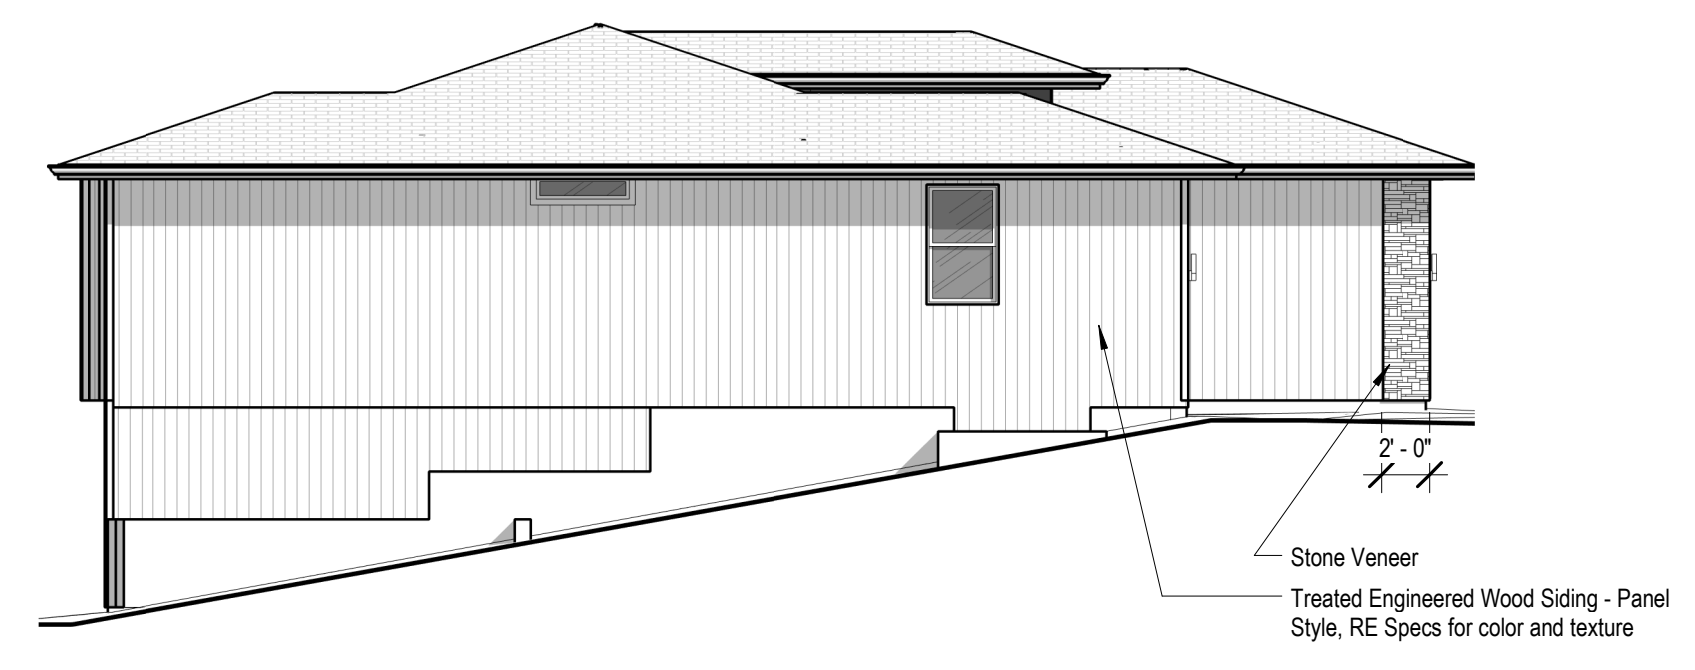


2 Left Elevation  
1/8" = 1'-0"

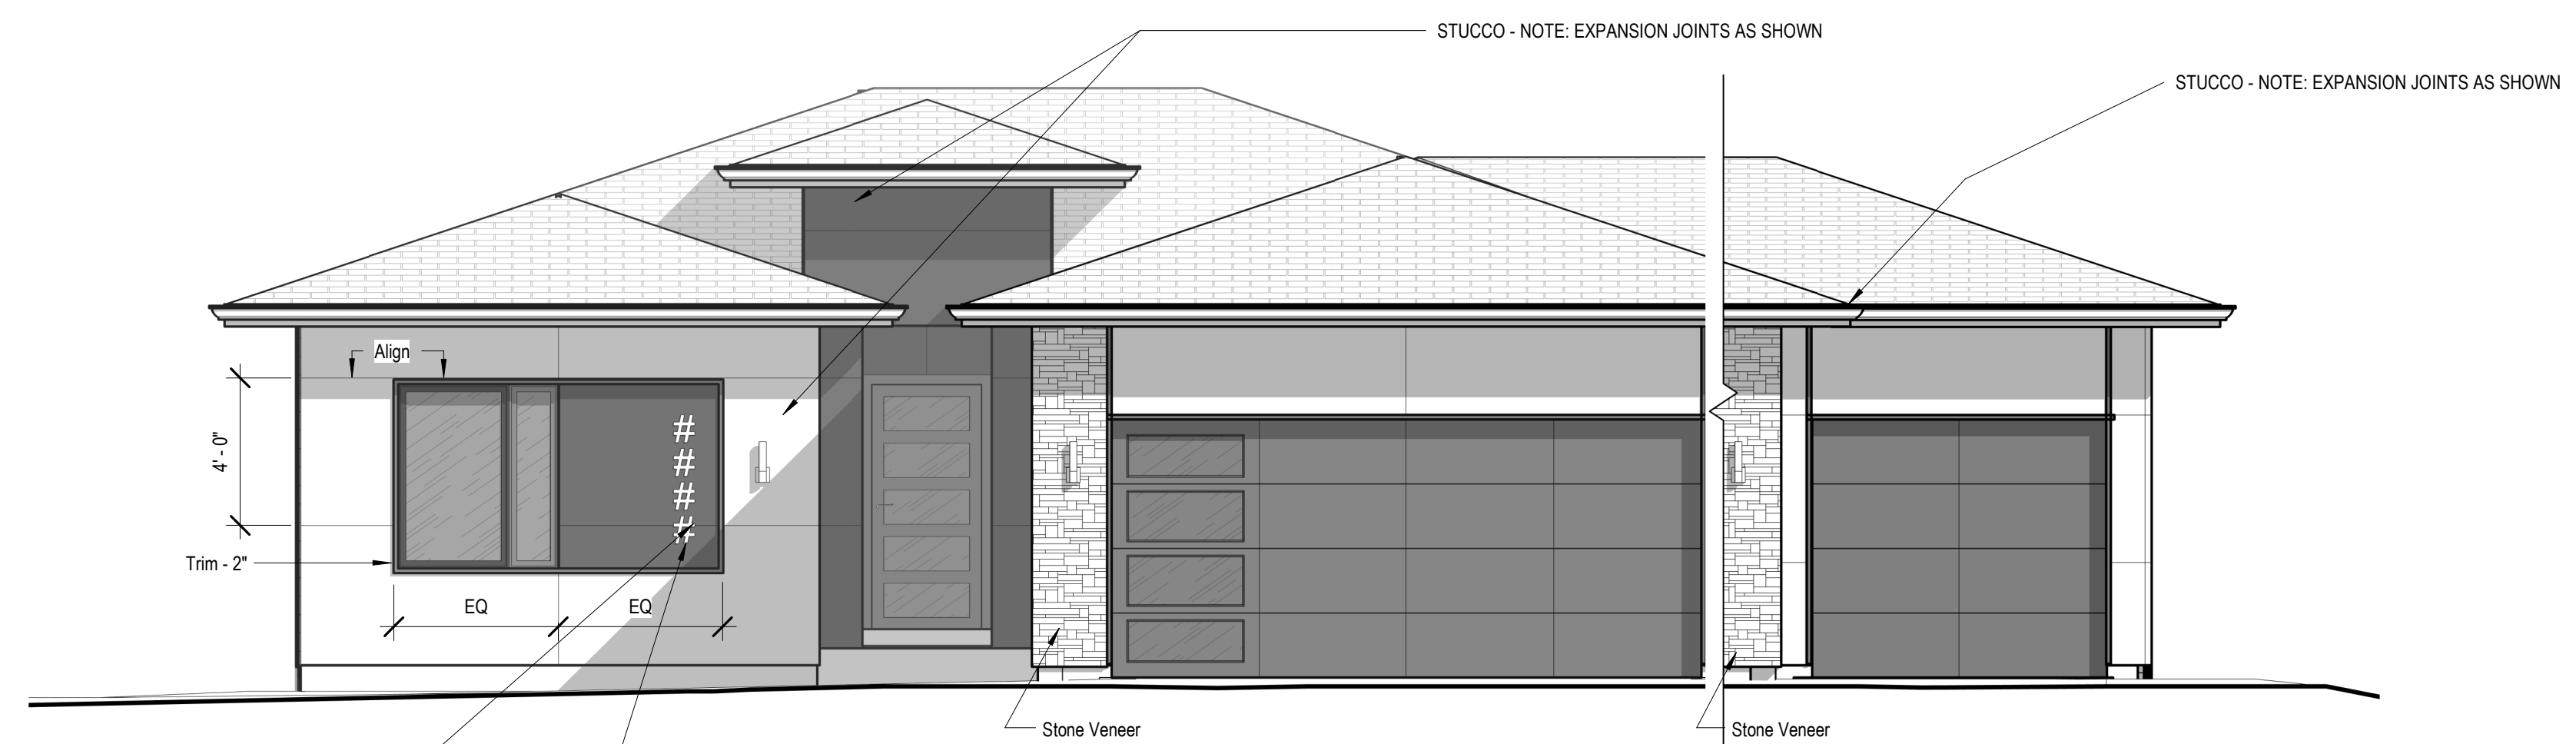


1 Front Elevation - Modern  
1/4" = 1'-0"

# Greystone - Hook Farms 26

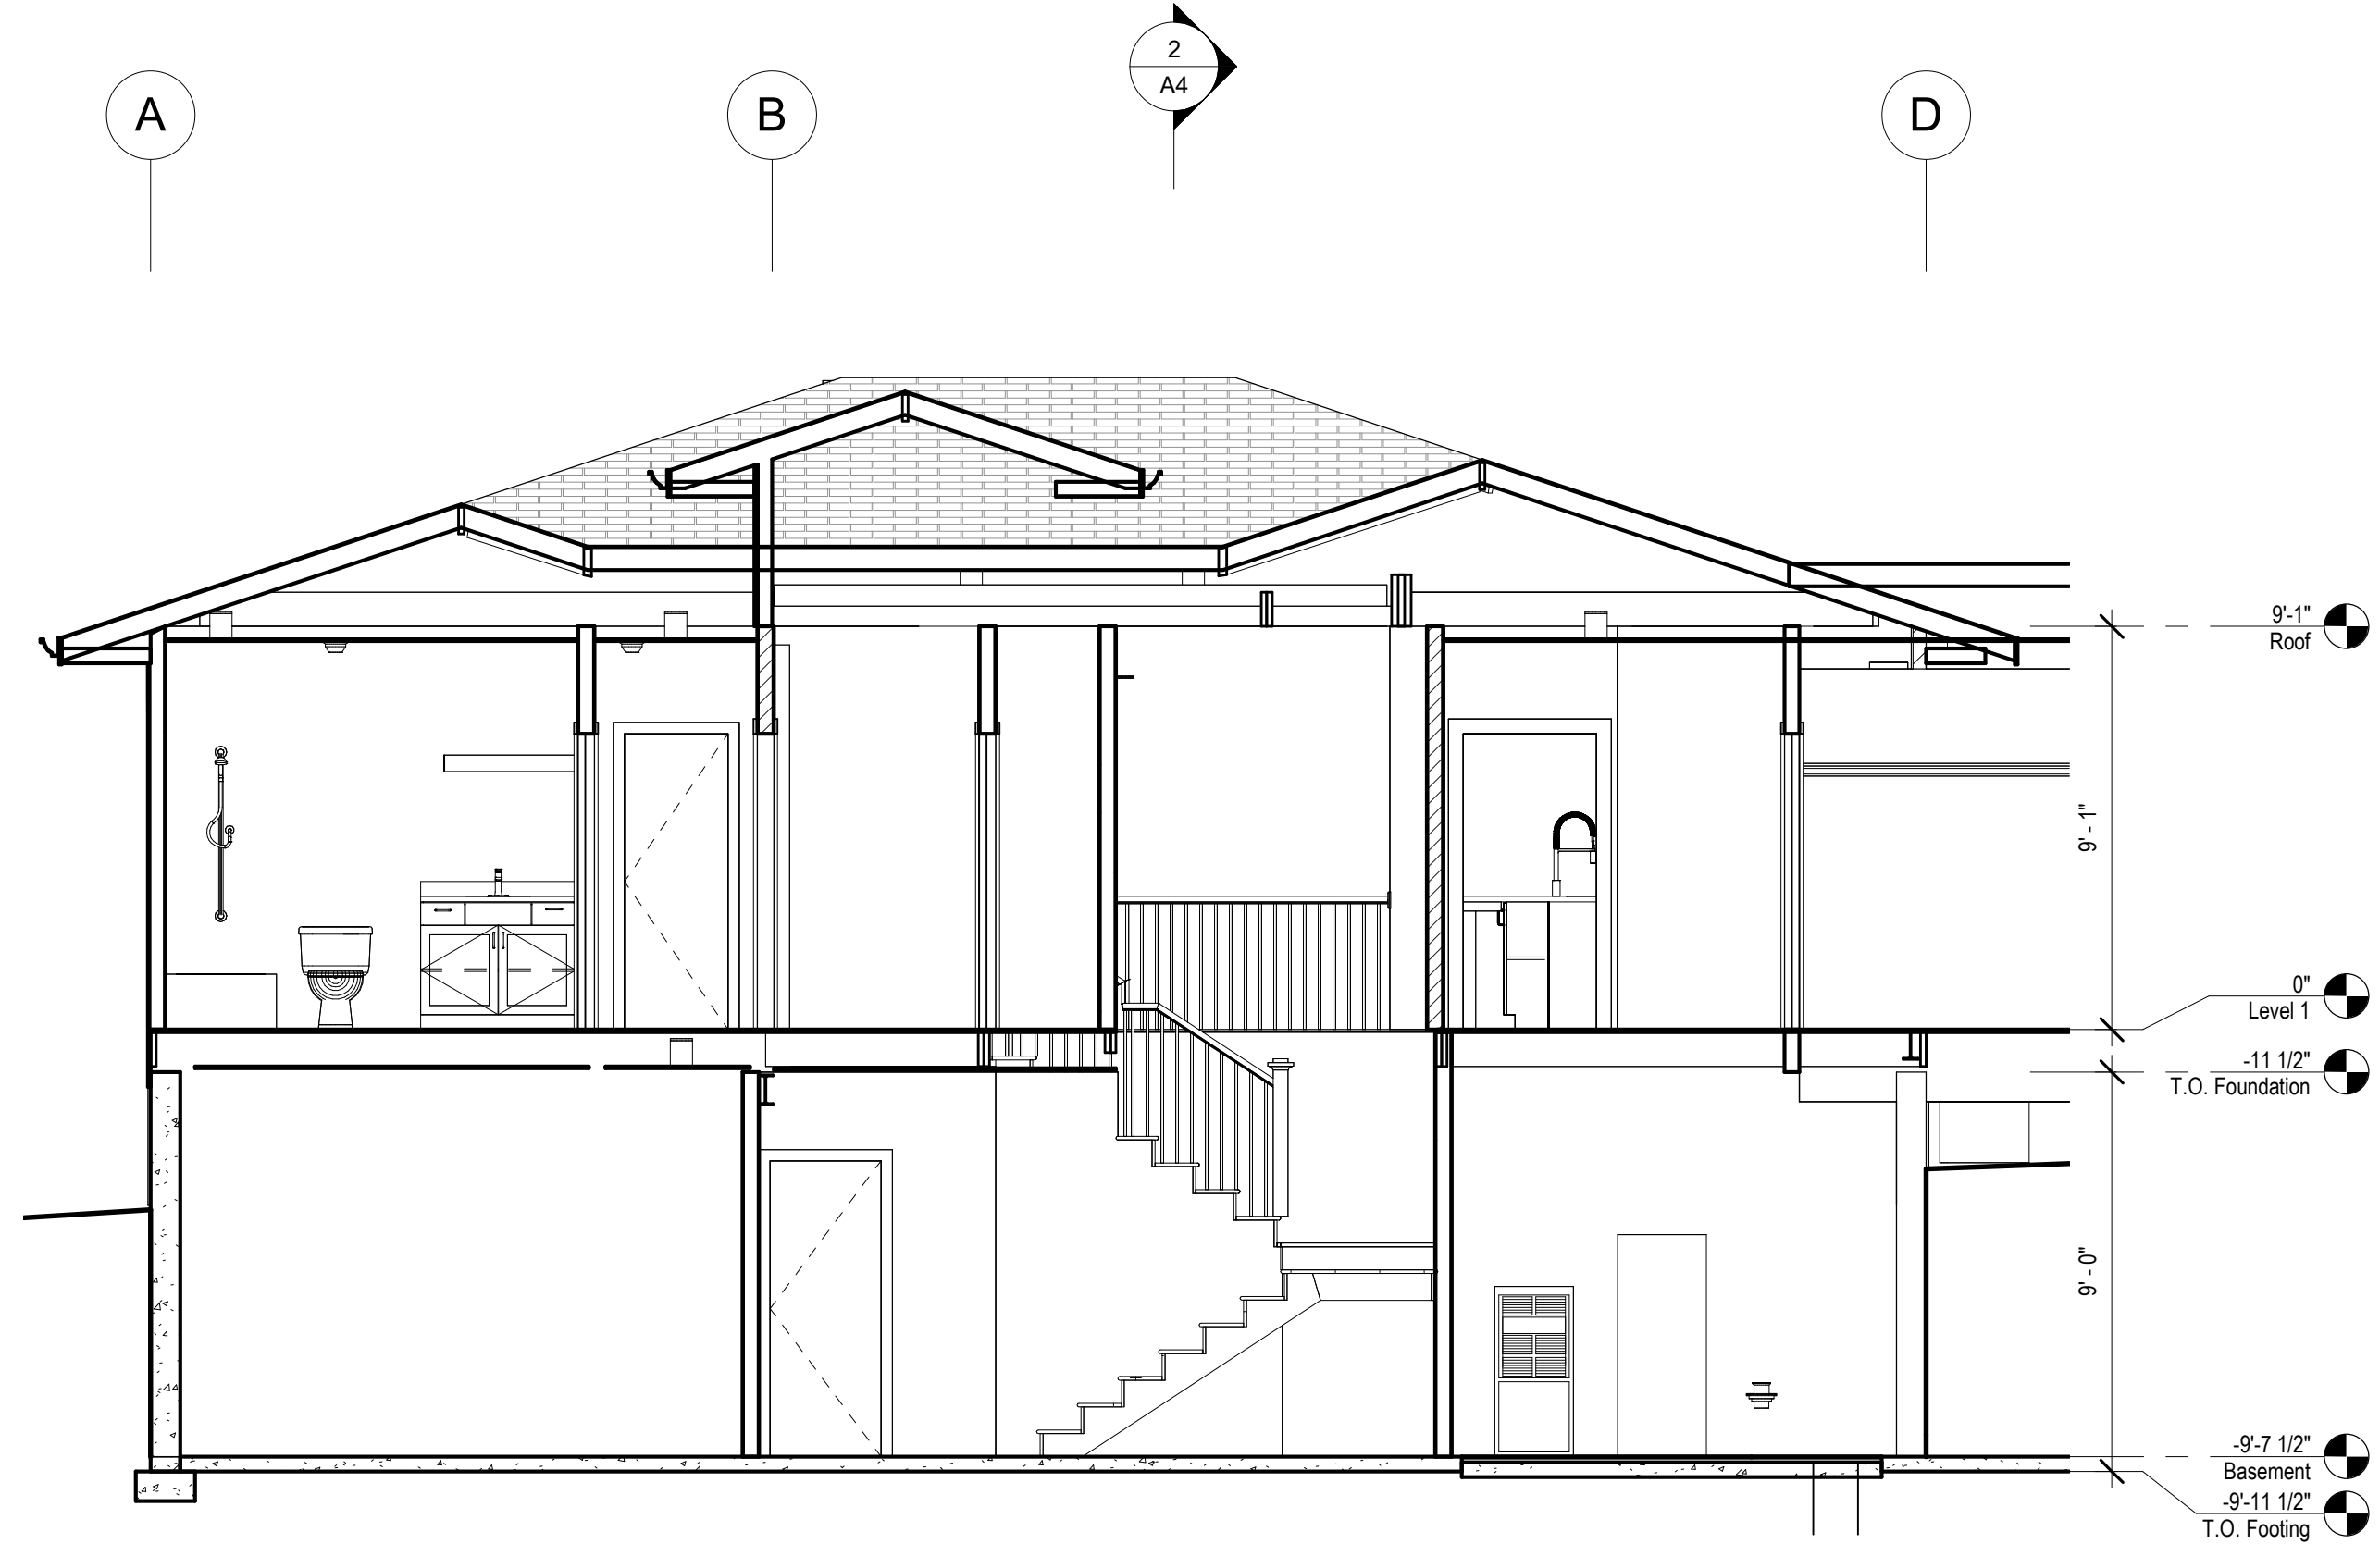

② Building Section  
1/4" = 1'-0"

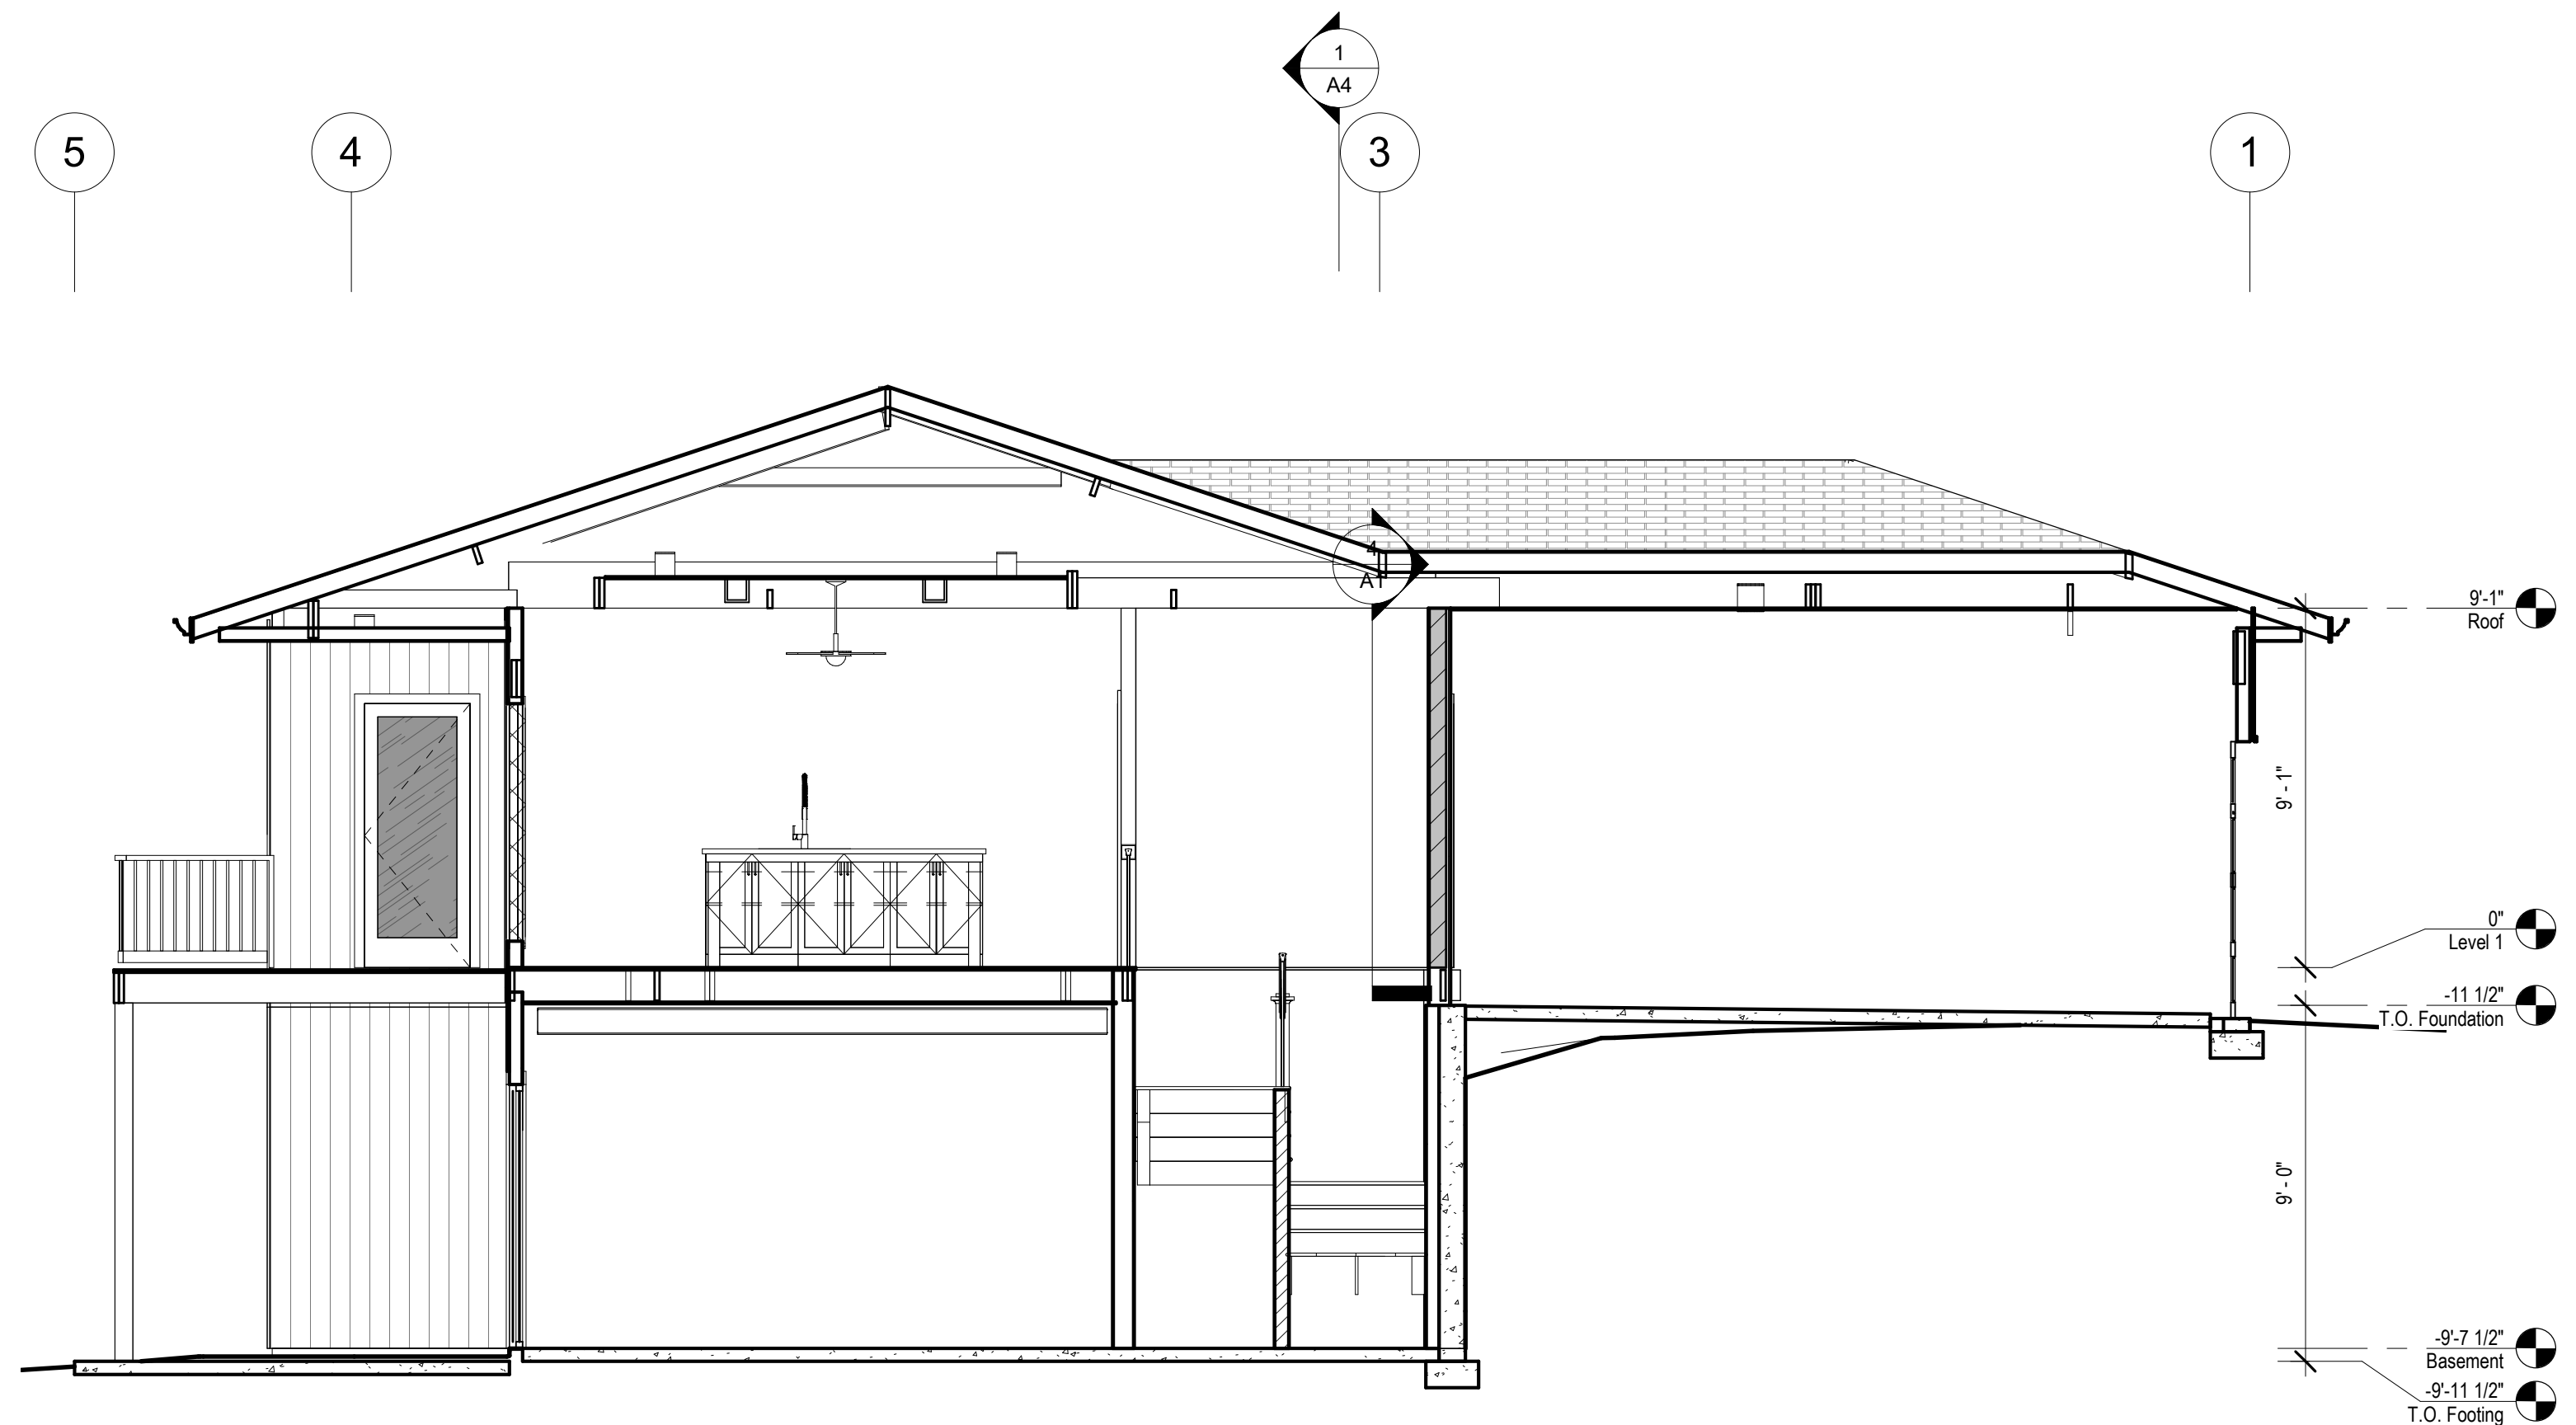

① Building Section  
1/4" = 1'-0"

architect:  
**Elevate Design + Build**  
350 SW Longview Blvd  
Lee's Summit, MO 64081  
816.622.8826 voice  
www.elevatedesignbuild.com  
2027 SW Hook Farm Dr  
Lee's Summit, MO 64082

UNLESS A PROFESSIONAL SEAL WITH SIGNATURE AND DATE IS AFFIXED, THIS DOCUMENT IS PRELIMINARY AND IS NOT INTENDED FOR CONSTRUCTION, RECORDING PURPOSES OR IMPLEMENTATION.



Original Issue Date: 2022-06-21

REVISIONS

Number	DESCRIPTION	DATE

Building Sections

# A4.C

Project No.

RELEASE FOR PERMIT  
AS NOTED FOR PLAN REVIEW  
DEVELOPMENT SERVICES  
LEE'S SUMMIT, MISSOURI  
11/02/2022

architect:  
**Elevate Design + Build**  
350 SW Longview Blvd  
Lee's Summit, MO 64081  
816.622.8826 voice  
www.elevatedesignbuild.com  
2027 SW Hook Farm Dr  
Lee's Summit, MO 64082

UNLESS A PROFESSIONAL SEAL WITH SIGNATURE AND DATE IS AFFIXED, THIS DOCUMENT IS PRELIMINARY AND IS NOT INTENDED FOR CONSTRUCTION, RECORDING PURPOSES OR IMPLEMENTATION.



PERMIT SET  
Original Issue Date: 2022-06-21

















Number	DESCRIPTION	DATE
REVISIONS		

Details

**A5**

Project No.

RELEASE FOR PERMITS  
AS NOTED FOR PLAN REVIEW  
DEVELOPMENT SERVICES  
LEE'S SUMMIT, MISSOURI  
**11/02/2022**

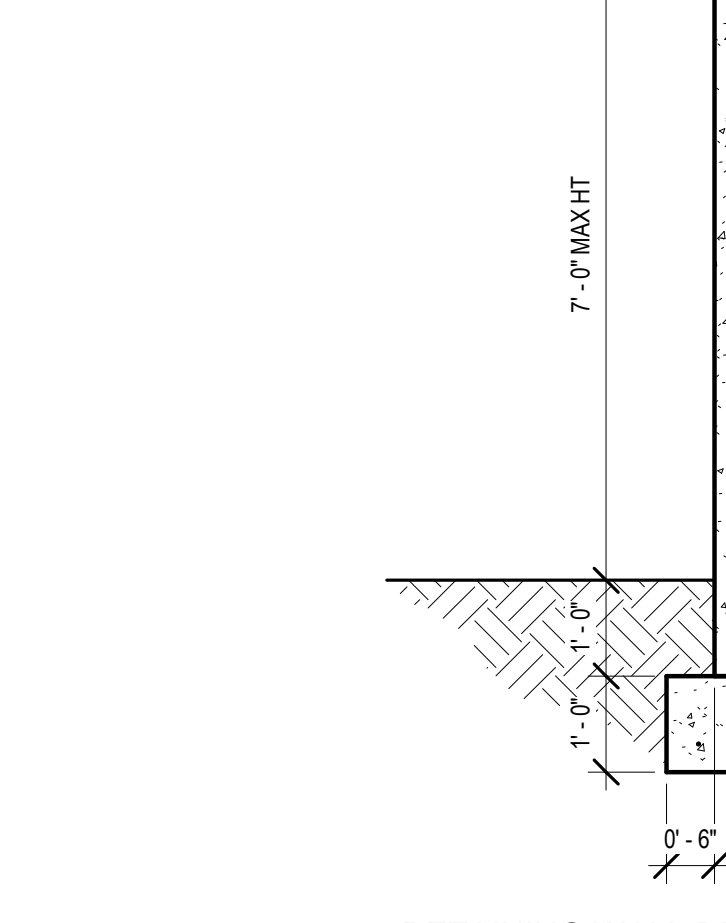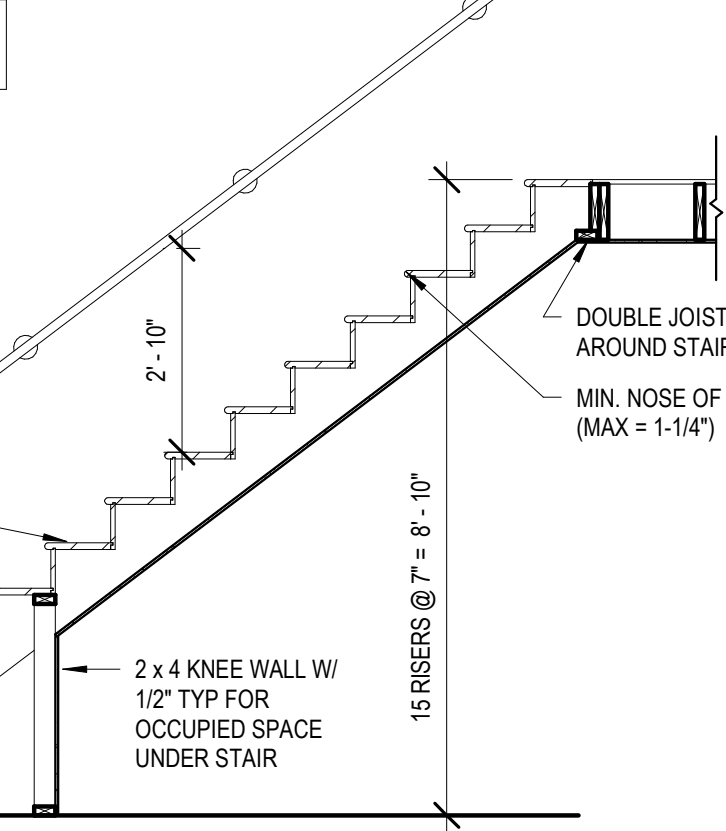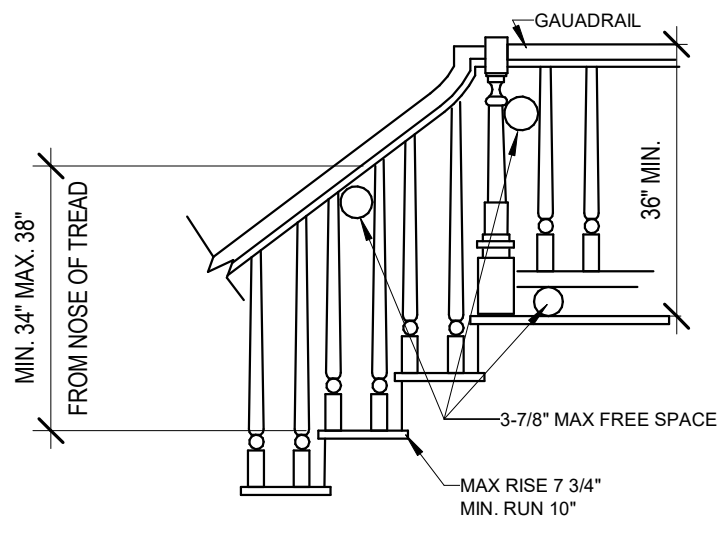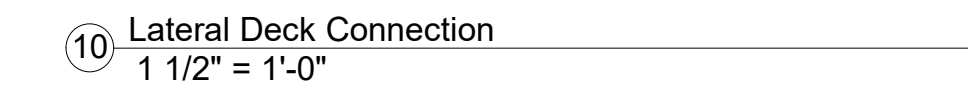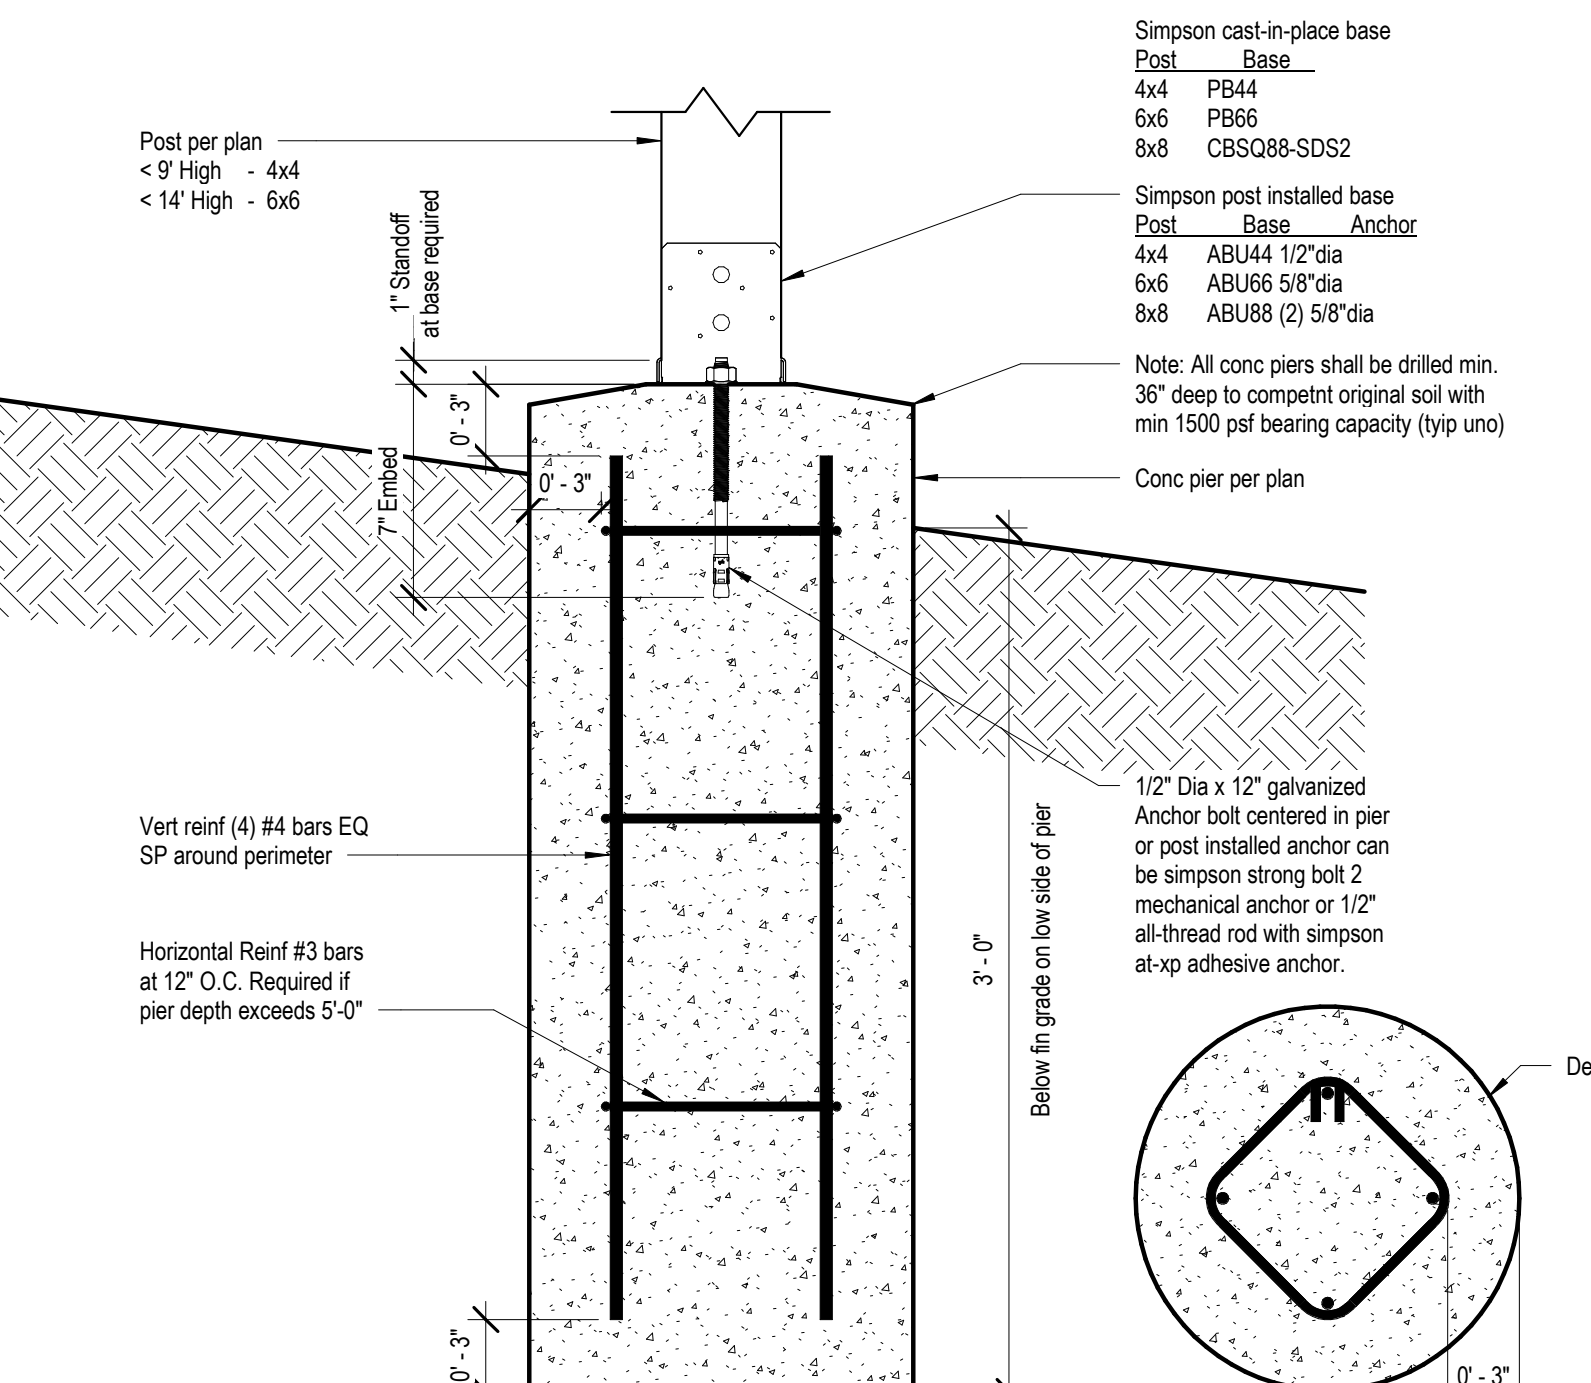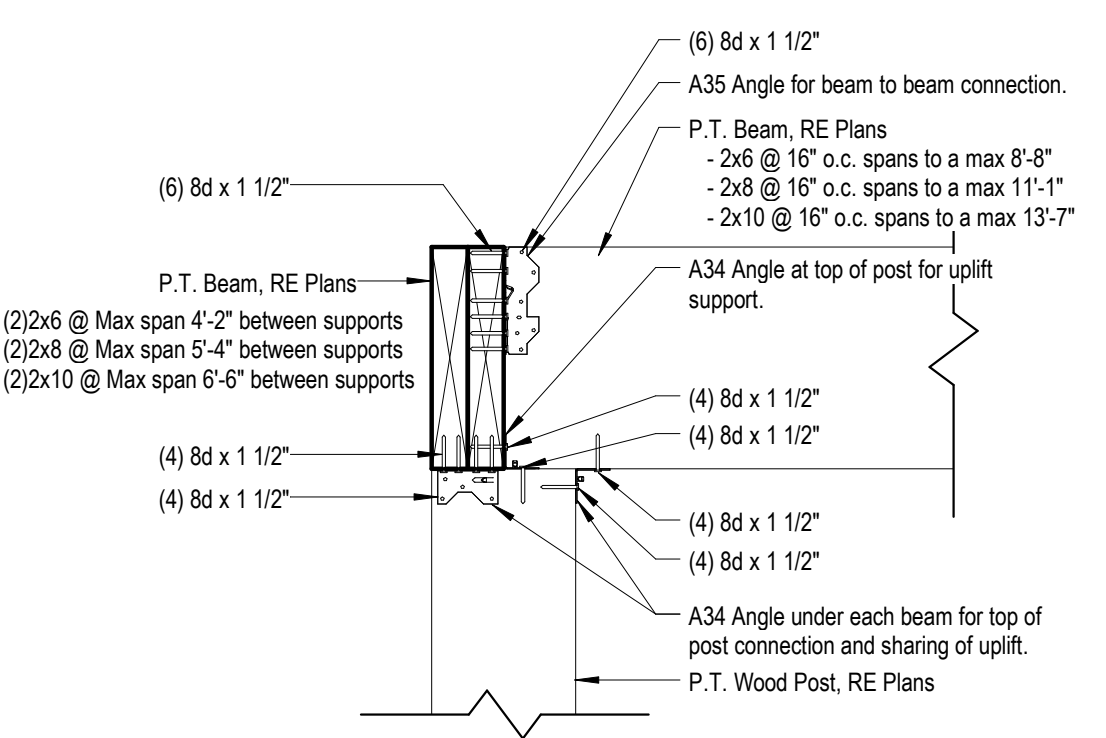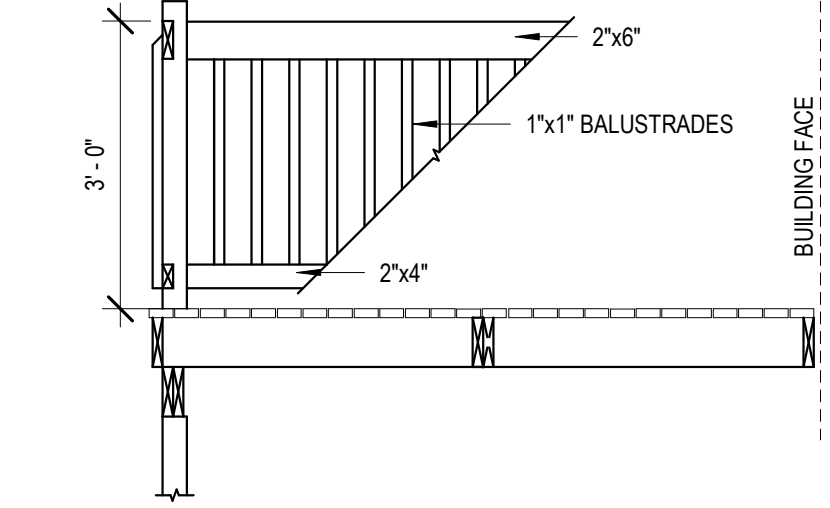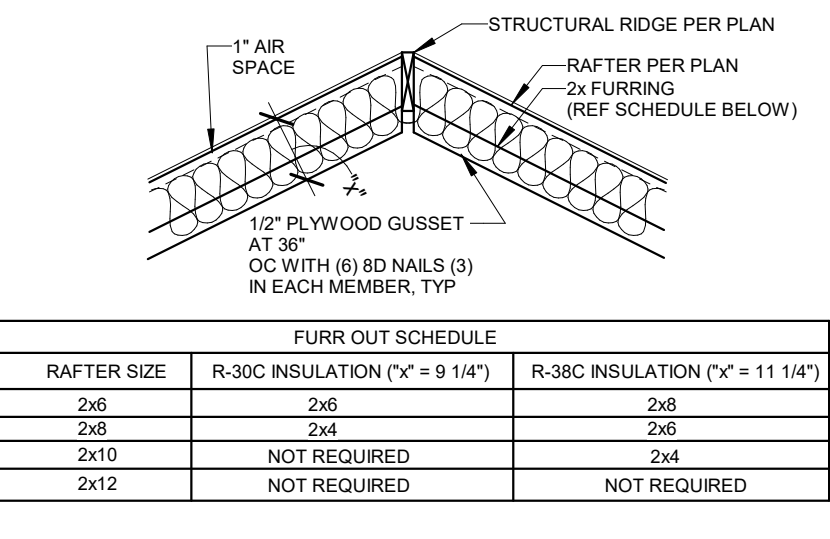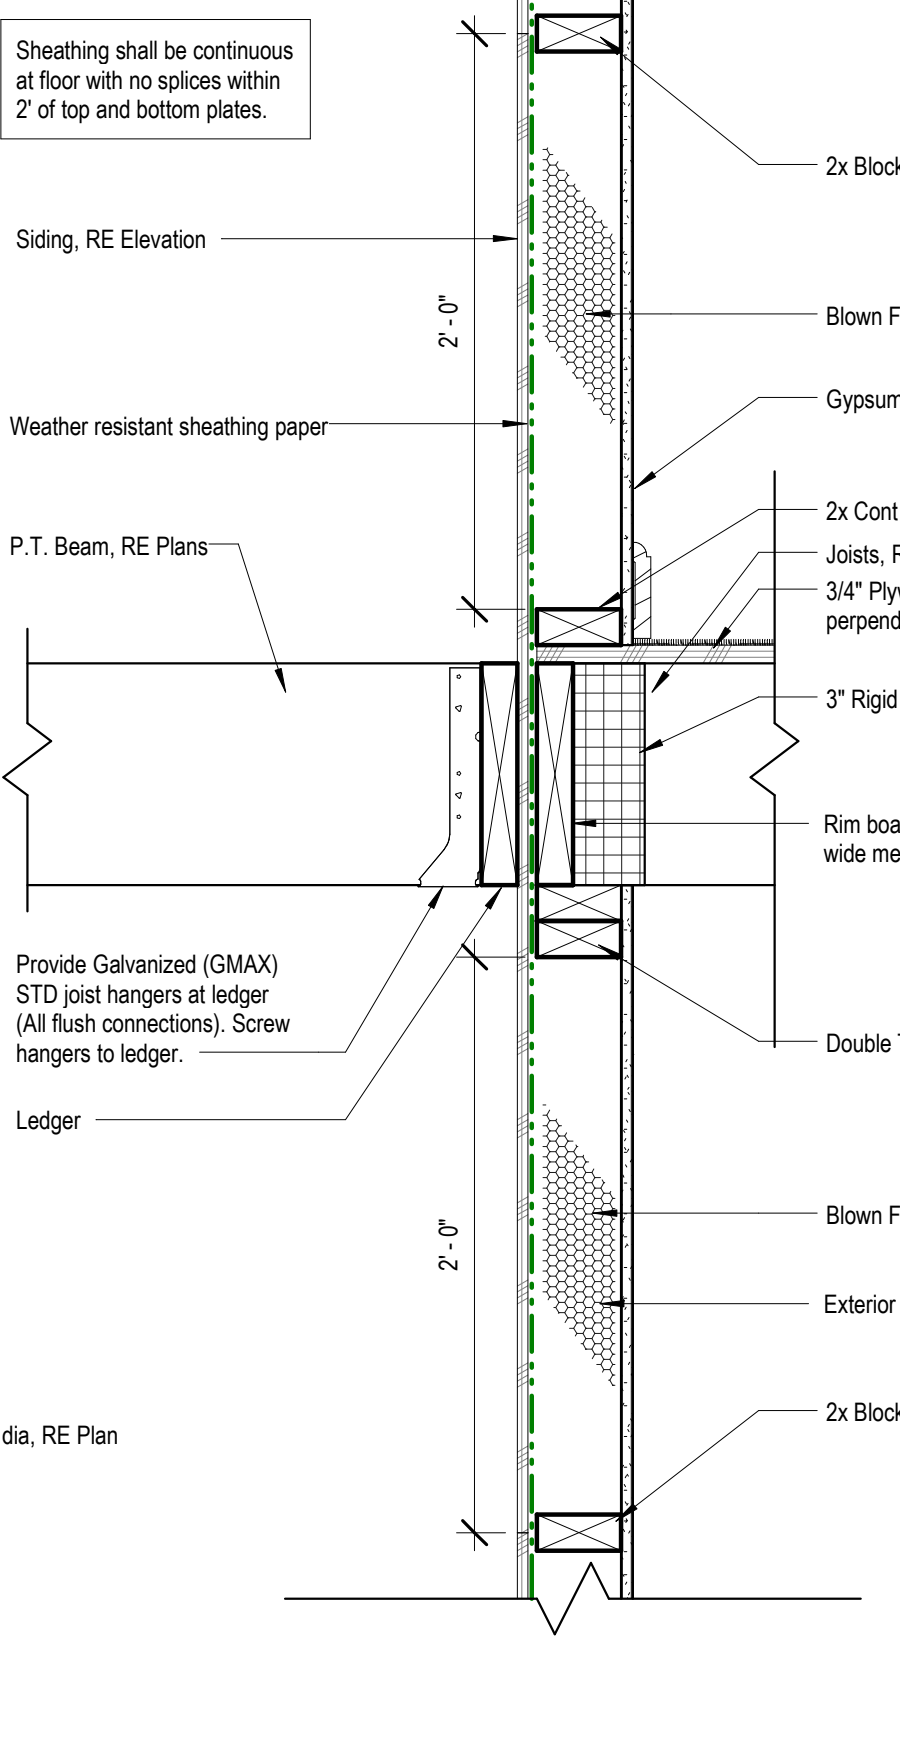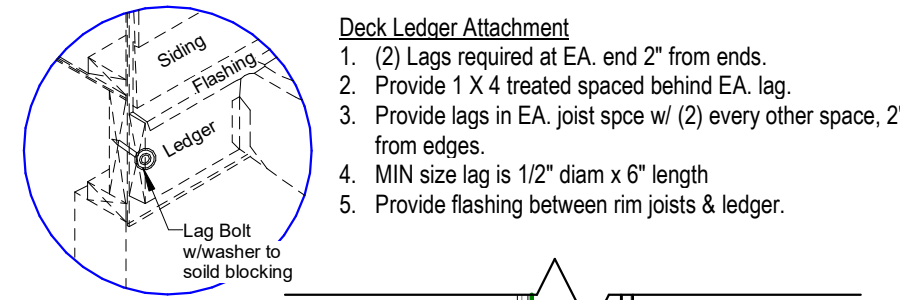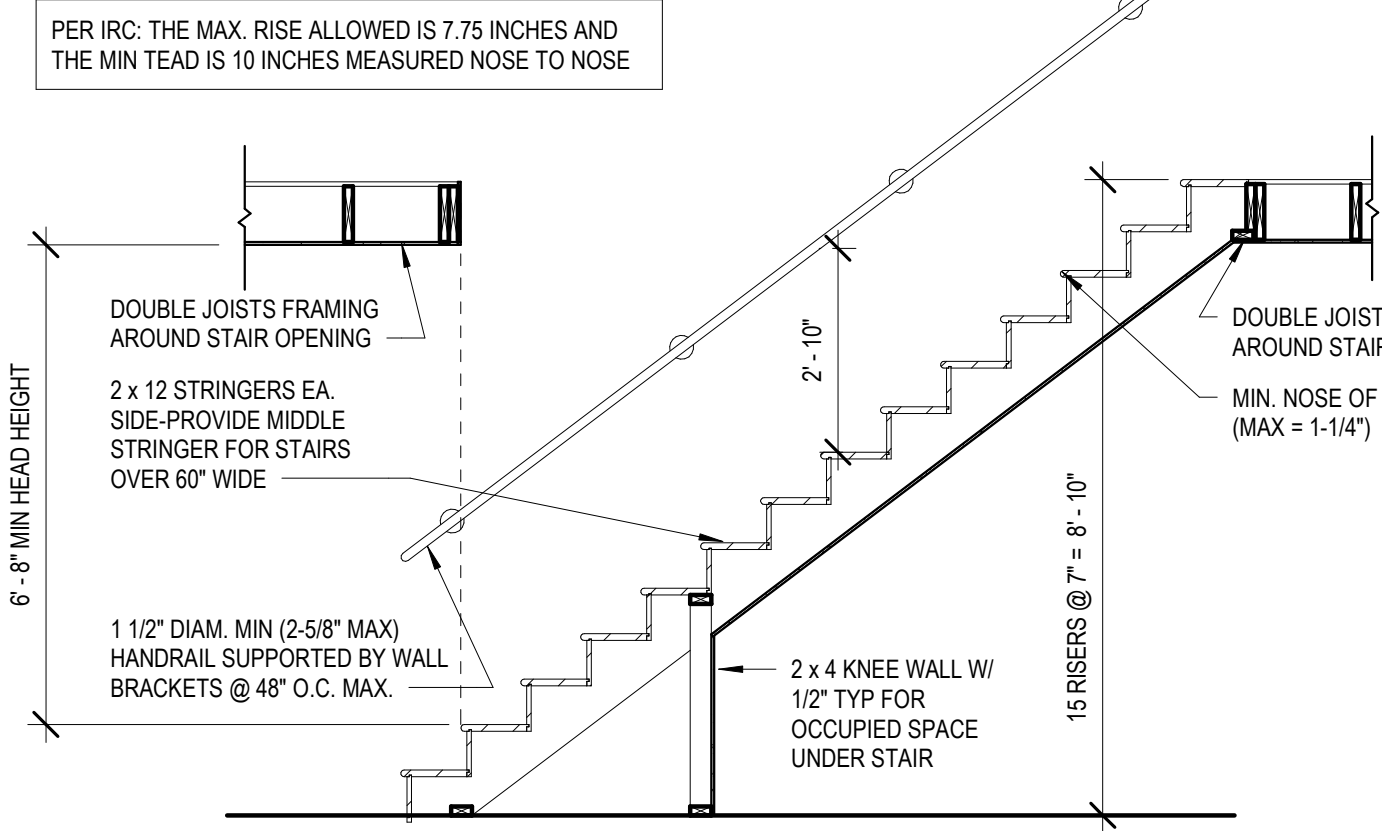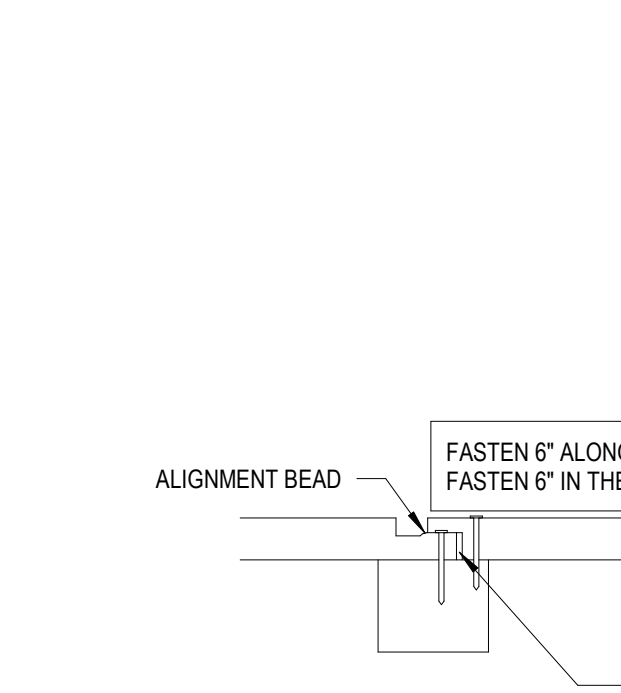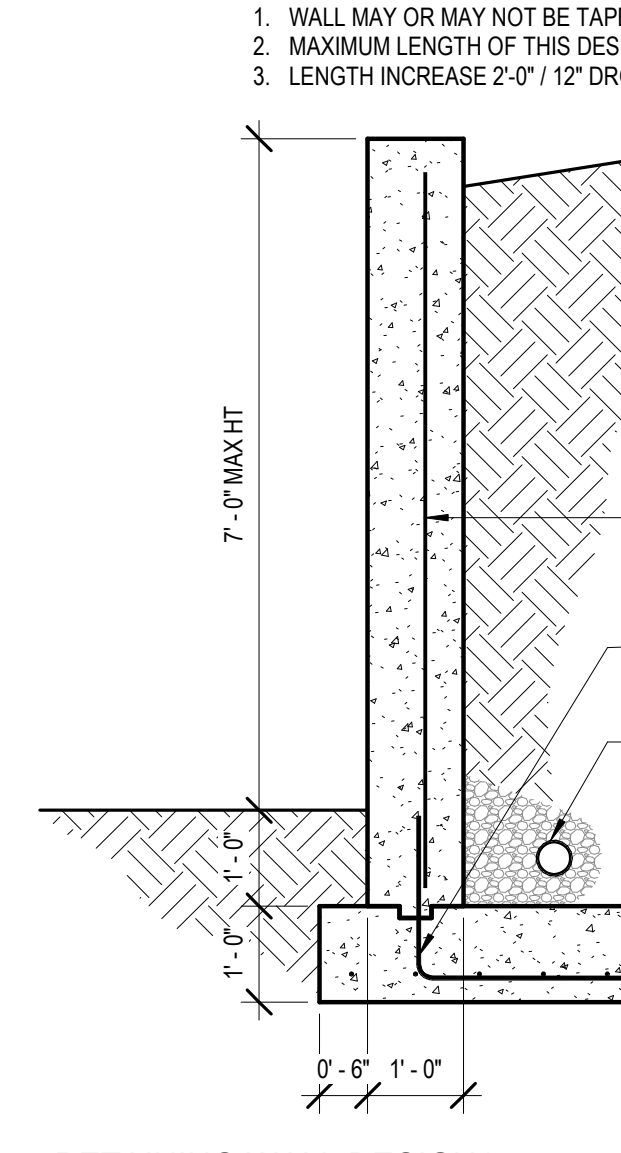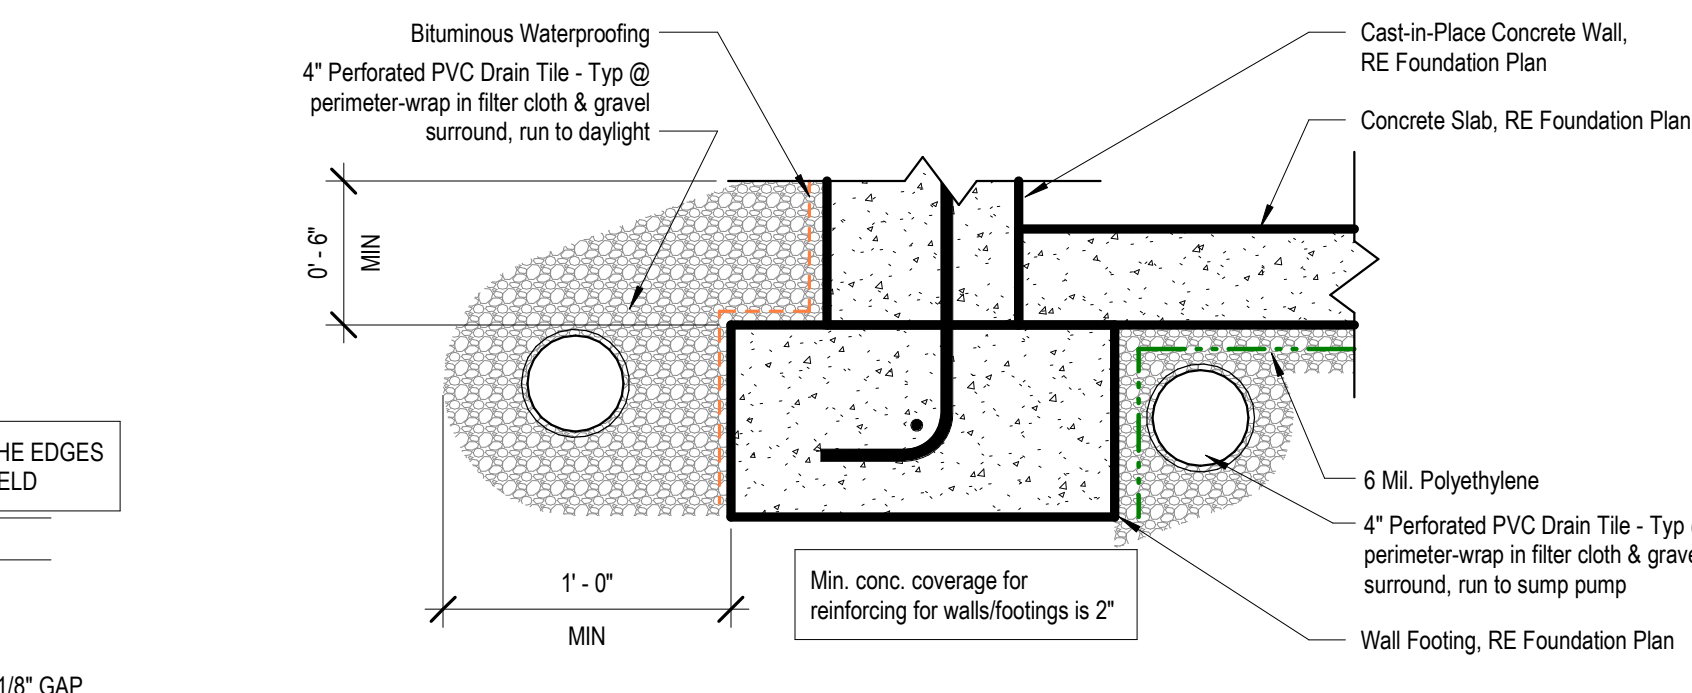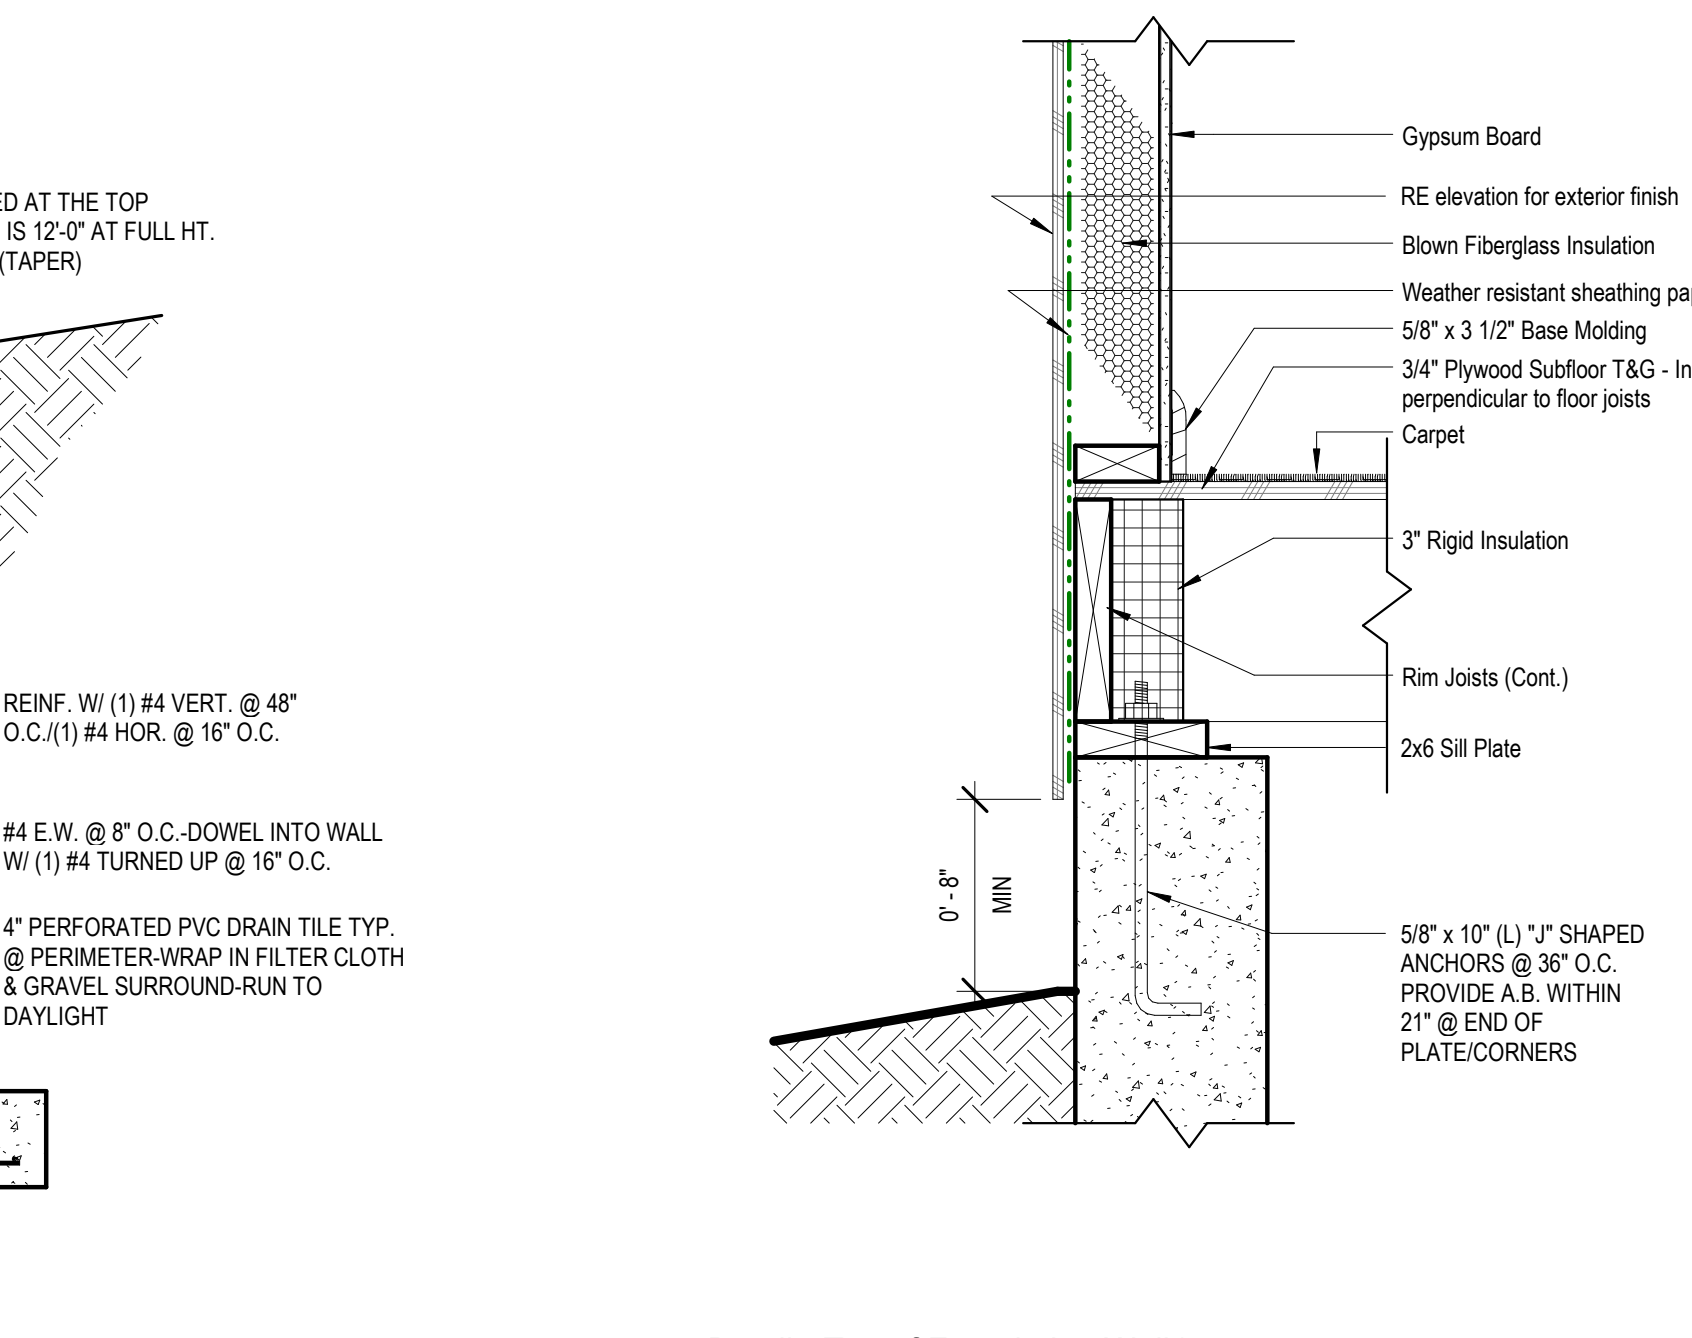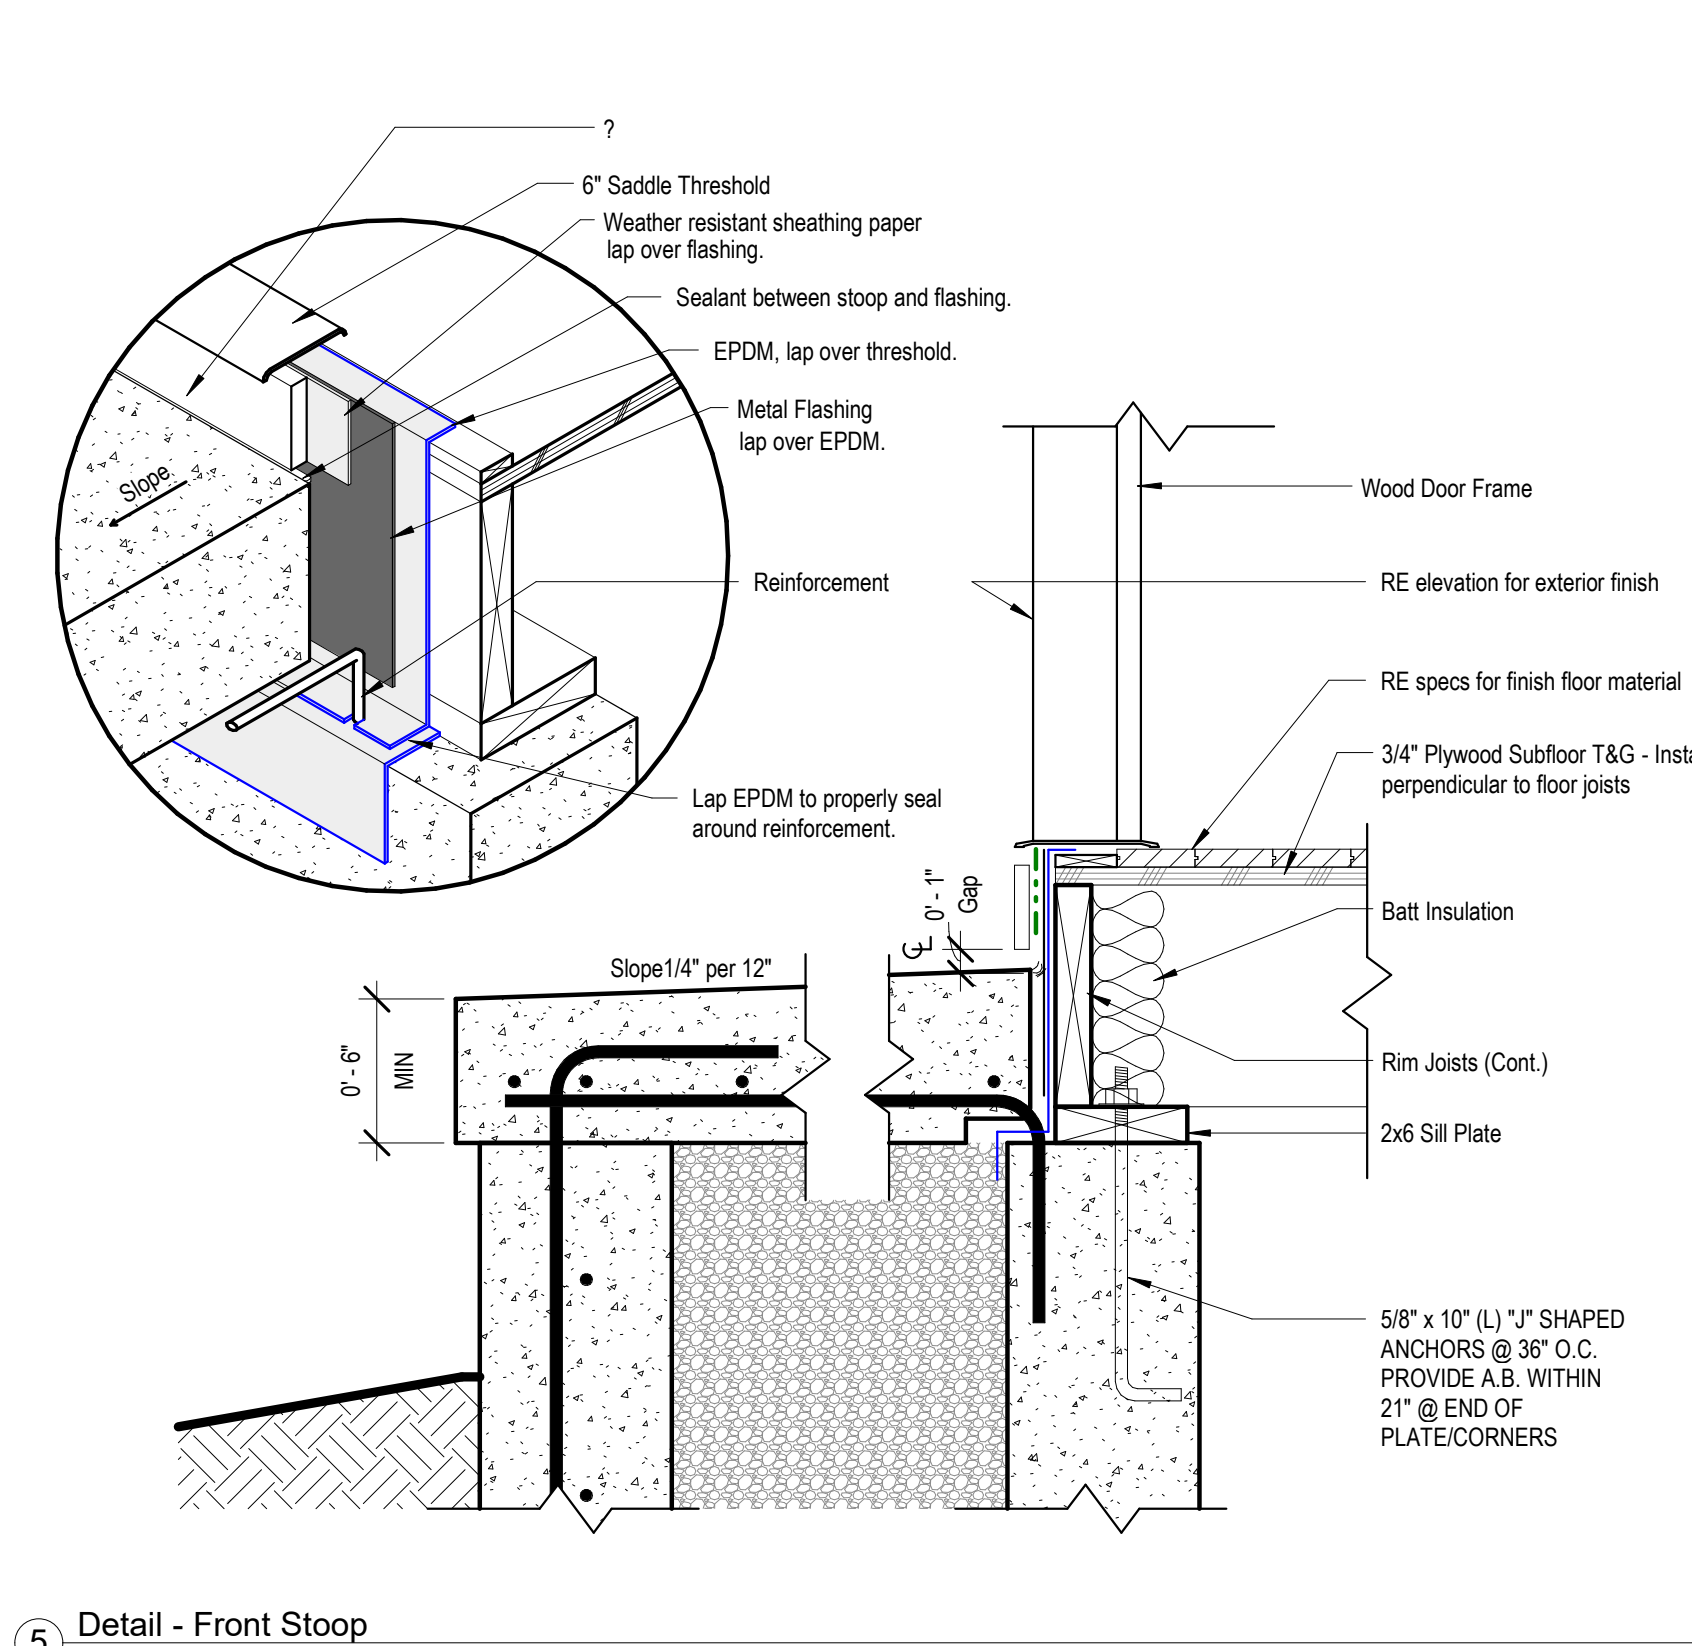

Project No.

RELEASE FOR PERMITS  
AS NOTED FOR PLAN REVIEW  
DEVELOPMENT SERVICES  
LEE'S SUMMIT, MISSOURI  
**11/02/2022**


architect:  
Elevate Design + Build  
350 SW Longview Blvd  
Lee's Summit, MO 64081  
816.622.8826 voice  
www.elevatedesignbuild.com  
2027 SW Hook Farm Dr  
Lee's Summit, MO 64082

UNLESS A PROFESSIONAL SEAL WITH SIGNATURE AND DATE IS AFFIXED, THIS DOCUMENT IS PRELIMINARY AND IS NOT INTENDED FOR CONSTRUCTION, RECORDING PURPOSES OR IMPLEMENTATION



PERMIT SET  
Original Issue Date: 2022-06-21  
REVISIONS  
Number DESCRIPTION DATE

Details  
A6  
Project No.

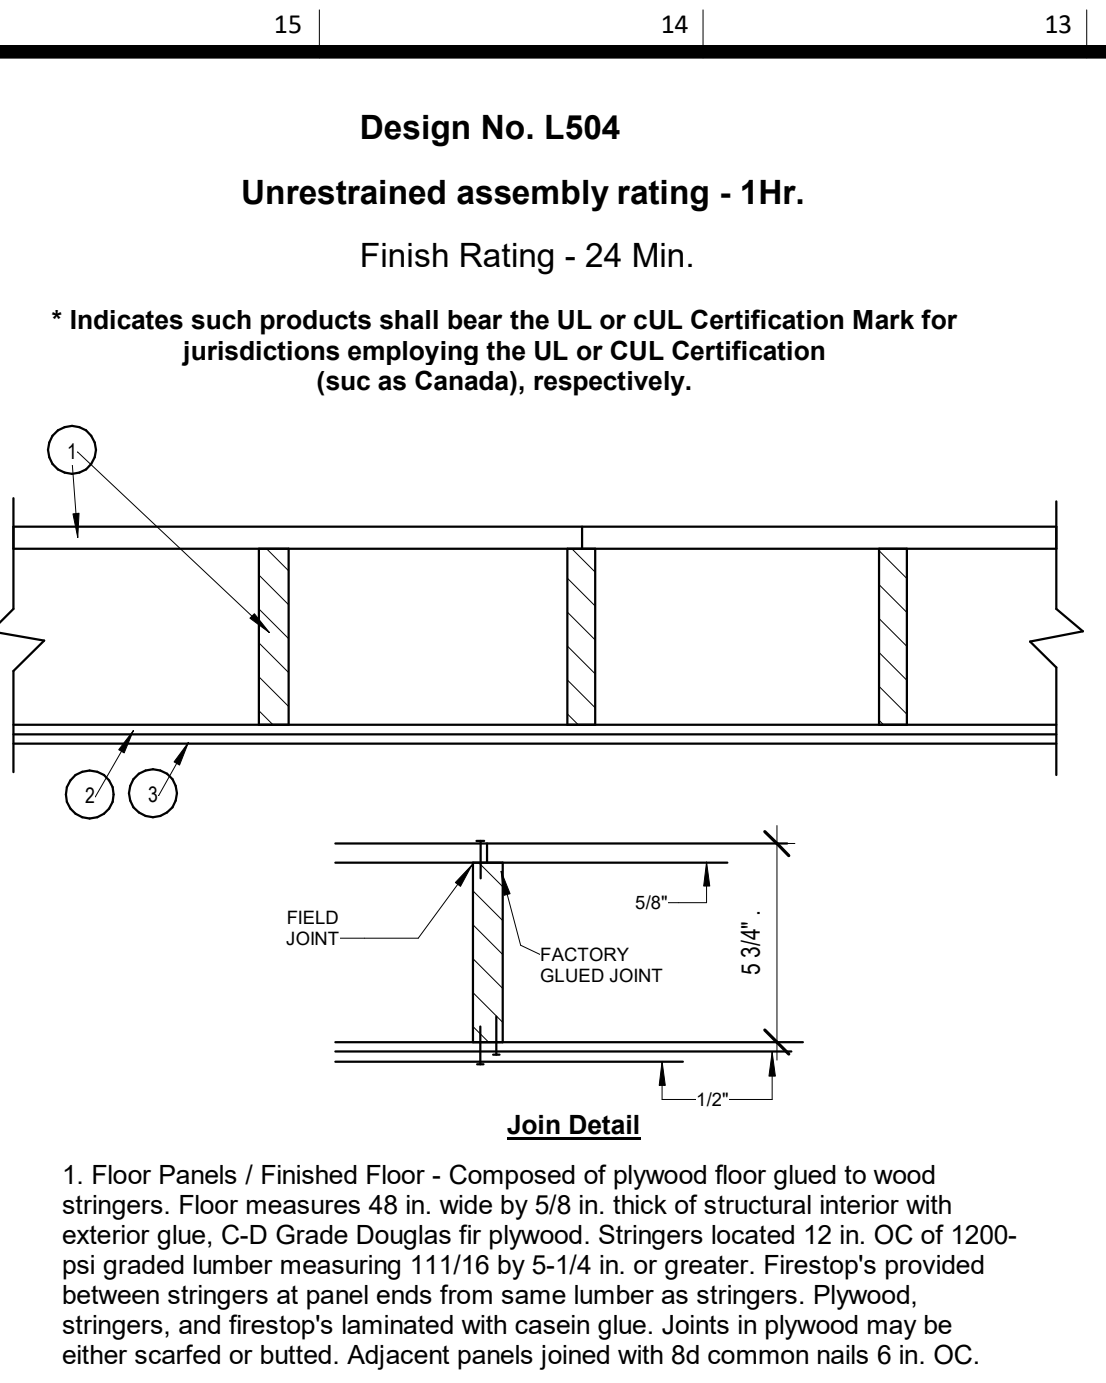

**Design No. L504**  
Unrestrained assembly rating - 1Hr.  
Finish Rating - 24 Min.

\* Indicates such products shall bear the UL or cUL Certification Mark for jurisdictions employing the UL or cUL Certification (such as Canada), respectively.

1. Floor Panels / Finished Floor - Composed of plywood floor glued to wood stringers. Floor measures 48 in. wide by 5/8 in. thick of structural interior with exterior glue, C-D Grade Douglas fir plywood. Stringers located 12 in. OC of 1200-psi graded lumber measuring 1 1/16 by 5-1/4 in. or greater. Firestop's provided between stringers at panel ends from same lumber as stringers. Plywood, stringers, and firestop's laminated with casein glue. Joints in plywood may be either scarfed or butted. Adjacent panels joined with 8d common nails 6 in. OC.

Finish Floor - (Optional Not Shown) - The optional finish flooring may consist of one of the following systems to be applied over Item 1:


**System No. 3**  
**Finish Flooring - Floor Topping Mixture** - Min 3/4 in. thickness of floor topping mixture having a minimum compressive strength of 1500 psi. Refer to manufacturer's instructions accompanying the material for specific mix design.  
**MAXXON CORP** - Types Maxxon Standard and Maxxon High Strength

**2. Sound-Deadening Board** - Nom 4 by 8 ft by 1/2 in. thick plain wood fiber board weighing 15 to 18 lb per cu ft. Installed with long dimension parallel with stringers and attached to each stringer with 5d cement coated cooler nails, 1-5/8 in. long, 0.086 in. shank diameter with 1/4 in. diameter flat head spaced nails 12 in. OC. Nails spaced 1/2 in. from side and end joints.

**3. Gypsum Board\*** - Nom 1/2 in. thick, installed with long dimension perpendicular to stringers and secured to each stringer with 8d cement coated cooler nails, 2-3/8 in. long, 0.113 in. shank diameter with 9/32 in. diameter flat head spaced 6 in. OC at end joints and 8 in. OC elsewhere. Nails spaced 3/4 and 1/2 in. from side and end joints, respectively. Joints in gypsum board shall be staggered with joints in sound-deadening board.  
**AMERICAN GYPSUM CO** - Type AG-C


**4. Finishing System** - (Not Shown) - Vinyl, dry or premixed joint compound, applied in two coats to joints and screw-heads. Nom 2 in wide paper tape embedded in first layer of compound over all joints. As an alternate, nom 3/32 in, thick veneer plaster may be applied to the entire surface of gypsum board.

\* Indicates such products shall bear the UL or cUL Certification Mark for jurisdictions employing the UL or cUL Certification (such as Canada), respectively.

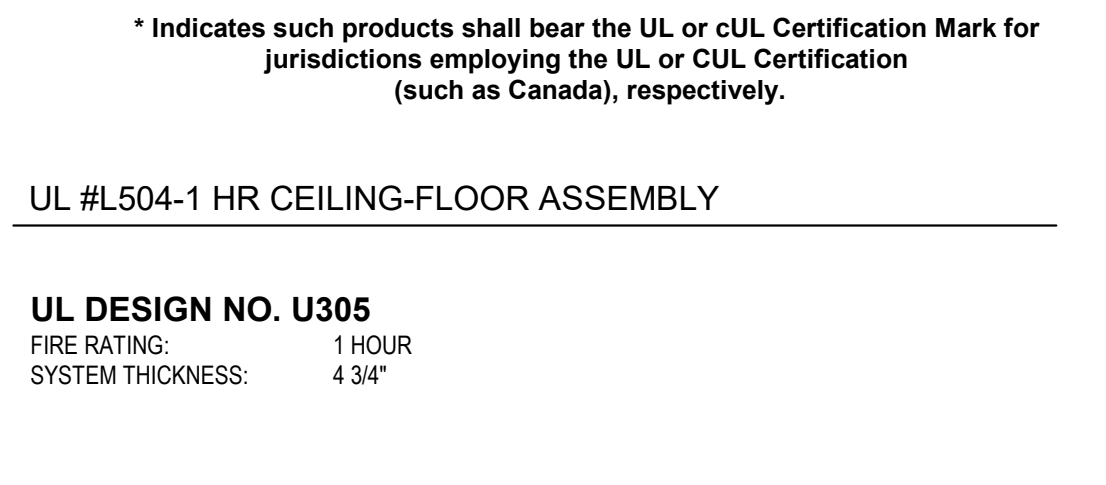


**UL DESIGN NO. U305**  
FIRE RATINGS: 1 HOUR  
SYSTEM THICKNESS: 4 3/4"

**ASSEMBLY OPTIONS:**  
**GYPSUM BOARD:** ONE LAYER 5/8" THICK GYPSUM BOARD (UL TYPE ULIX\*)  
**WOOD STUDS:** 2X4 WOOD STUDS, 16" O.C.  
**GYPSUM BOARD:** ONE LAYER 5/8" THICK GYPSUM BOARD (UL TYPE ULIX\*)

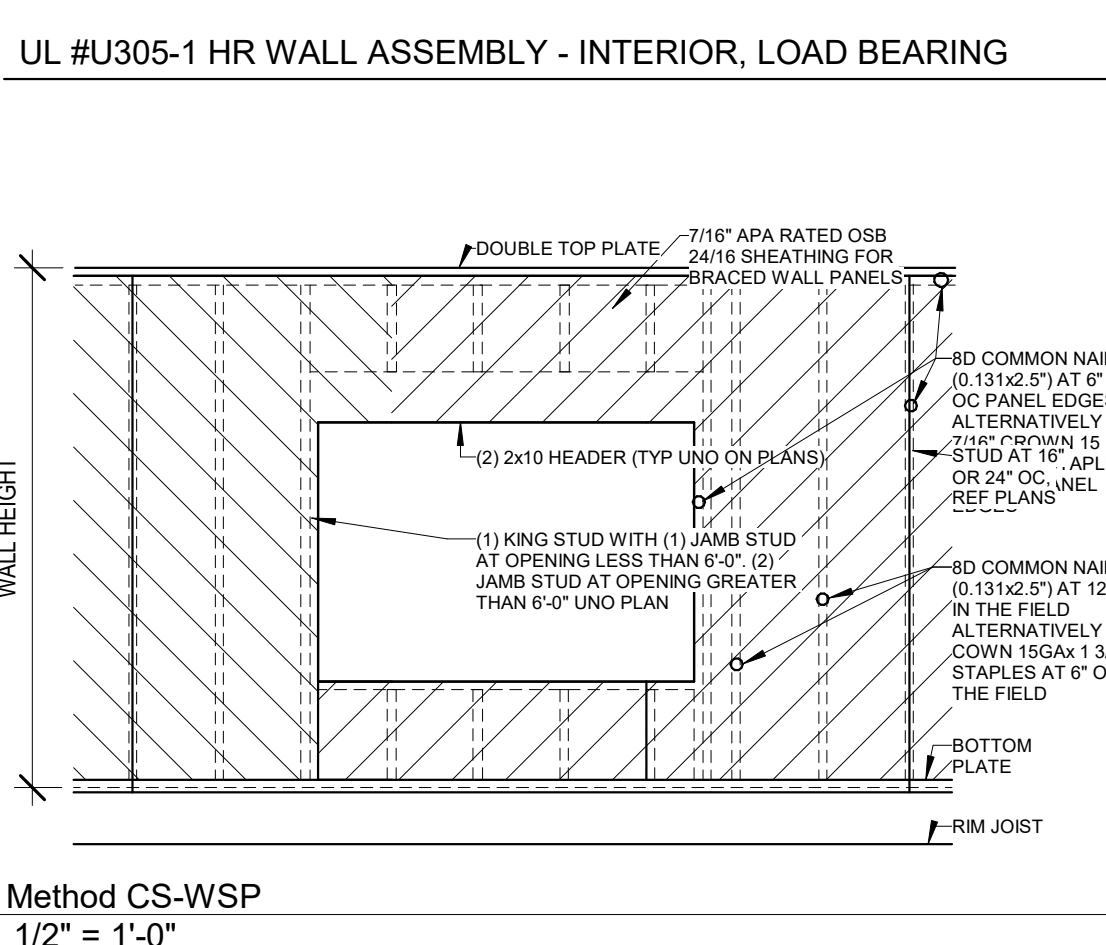

**Method CS-WSP**  
1/2" = 1'-0"

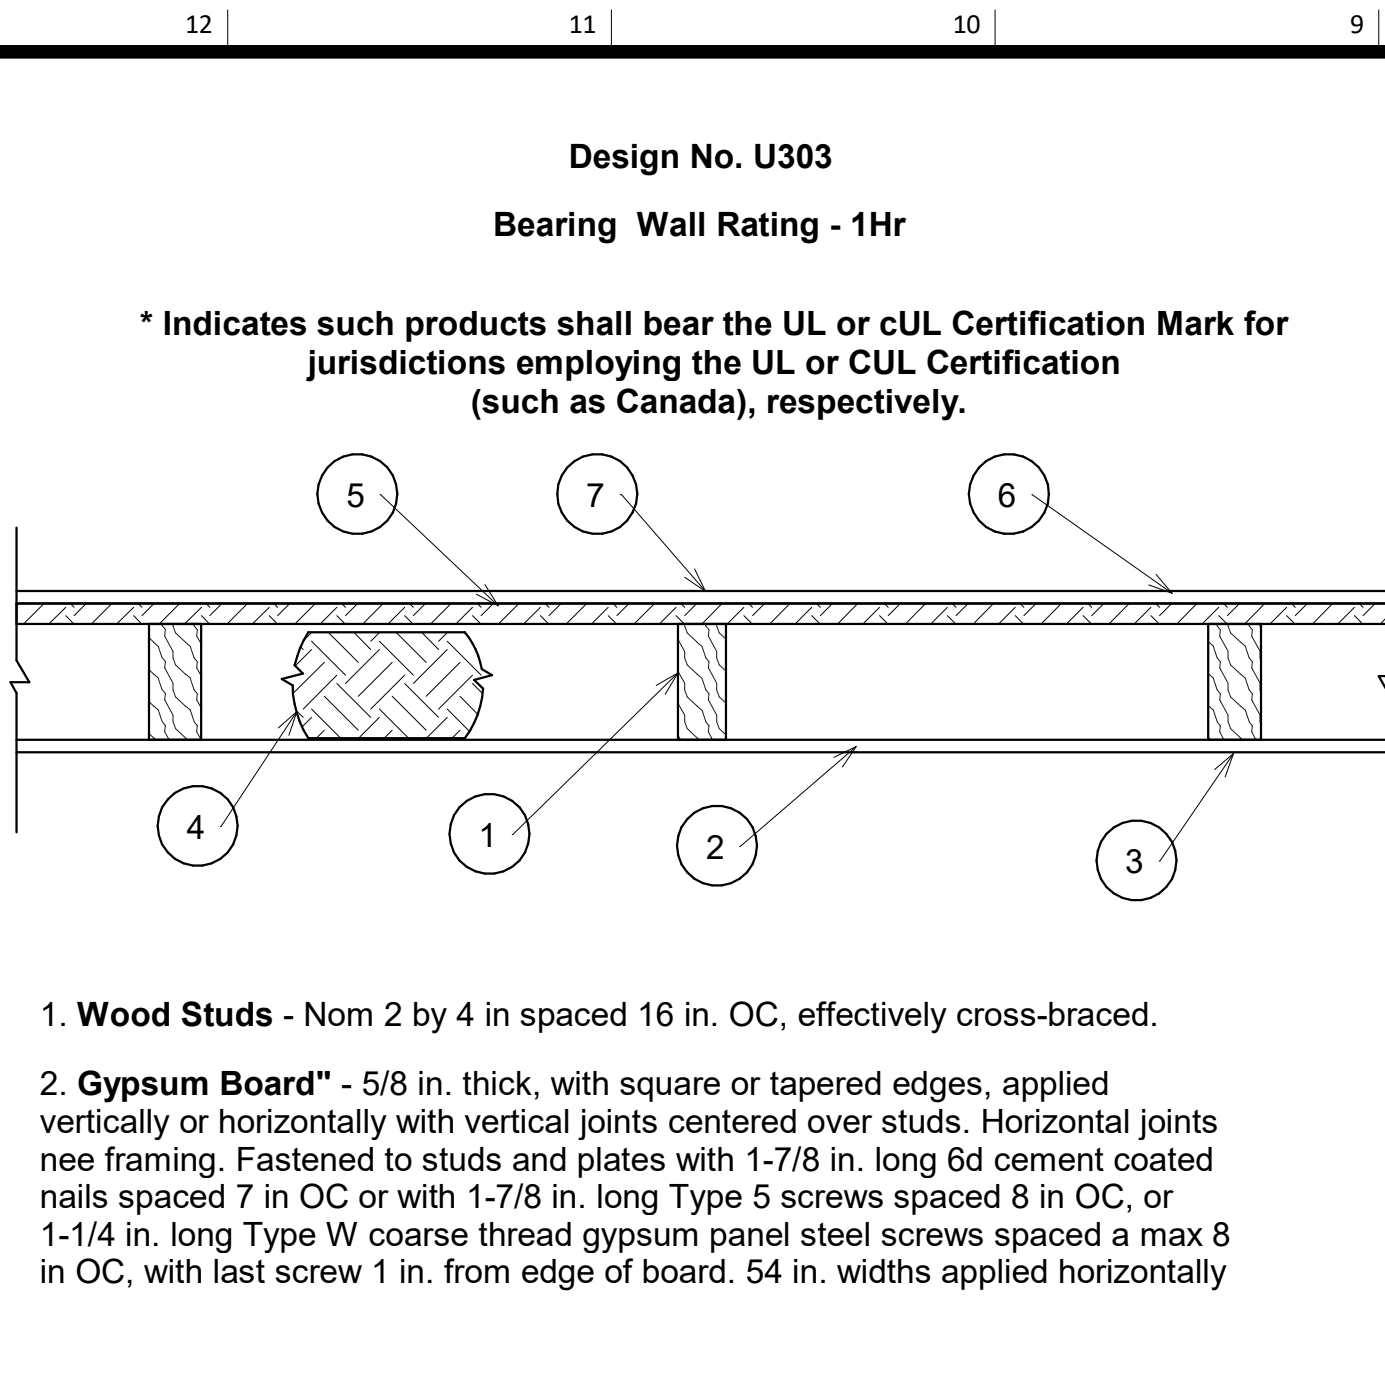

**Design No. U303**  
Bearing Wall Rating - 1Hr

\* Indicates such products shall bear the UL or cUL Certification Mark for jurisdictions employing the UL or cUL Certification (such as Canada), respectively.

1. **Wood Studs** - Nom 2 by 4 in spaced 16 in. OC, effectively cross-braced.

2. **Gypsum Board\*** - 5/8 in. thick, with square or tapered edges, applied vertically or horizontally with vertical joints centered over studs. Horizontal joints nee framing. Fastened to studs and plates with 1-7/8 in. long 6d cement coated nails spaced 7 in OC or with 1-7/8 in. long Type 5 screws spaced 8 in OC, or 1-1/4 in. long Type W coarse thread gypsum panel steel screws spaced a max 8 in OC, with last screw 1 in. from edge of board. 54 in. widths applied horizontally

**UNITED STATES GYPSUM CO**-Types AR, FRX-G, IP-ARIP-X1, IP-X2, IPC-AR, SCX, ULIX, ULK WRC or WR

3. **Joints** - When tapered edge gypsum board is used, joints covered with joint compound and paper tape. As an alternate, gypsum veneer plaster may be applied to the entire surface of Classified veneer baseboard with joints reinforced with paper tape. When square-edge gypsum board is used, treatment of joints is optional

4. **Batts and Blankets** - Min 3 in. thick mineral wool batts, friction fit between studs. THERMAFIBER INC-Type SAFB, SAFB FF

5. **Sheathing** - Min 1/52 in, thick, 4 ft wide, wood structural panels, min grade "sheathing" applied vertically, with vertical joints centered over studs. Attached to studs with 10d galy nails 6 in. OC at the perimeter and 12 in. OC in the field. Sheathing fully covered with a weather resistive barrier



6. **Cementitious Backer Units** - 1/2 or 5/8 in, thick, installed vertically or horizontally over the sheathing with vertical joints centered over studs. All joints offset min 12 in from underlying sheathing joints. Fastened to studs and plates with corrosion resistant 2-1/4 in. long chamfered, ribbed wafer head screws with a minimum head diameter of 400 inches or 2-1/4 in hot-dipped galvanized roofing nails spaced 8 in. OC.

**UNITED STATES GYPSUM CO**-Type DCB.




7. **Joints** - Cement board joints need not be treated.

8. **Vapor Retarder, Water Barrier or Weather Resistive Barrier** - (Optional, not shown) -As required

\* Indicates such products shall bear the UL or cUL Certification Mark for jurisdictions employing the UL or cUL Certification (such as Canada), respectively.

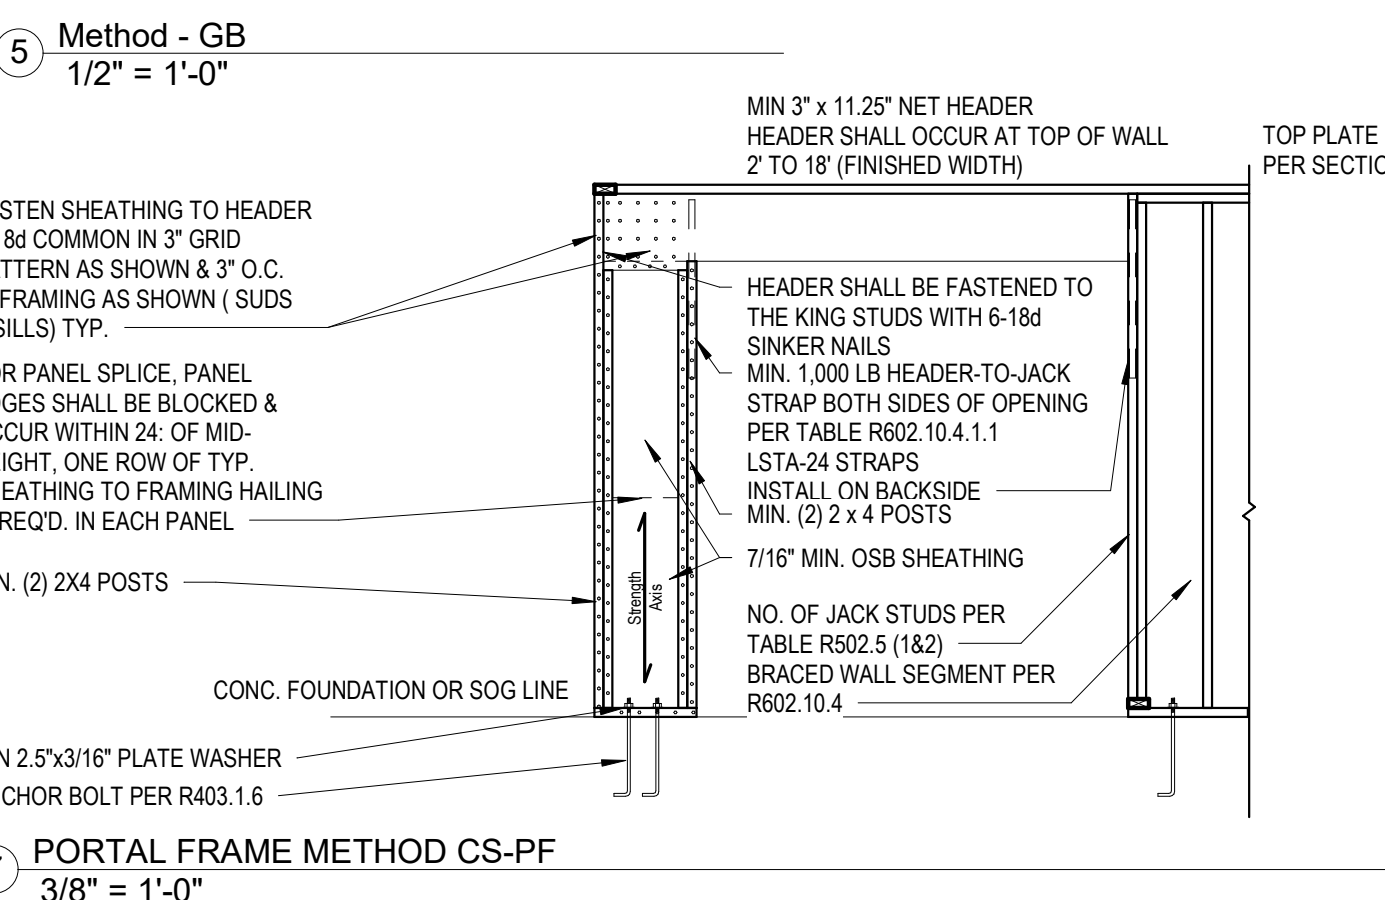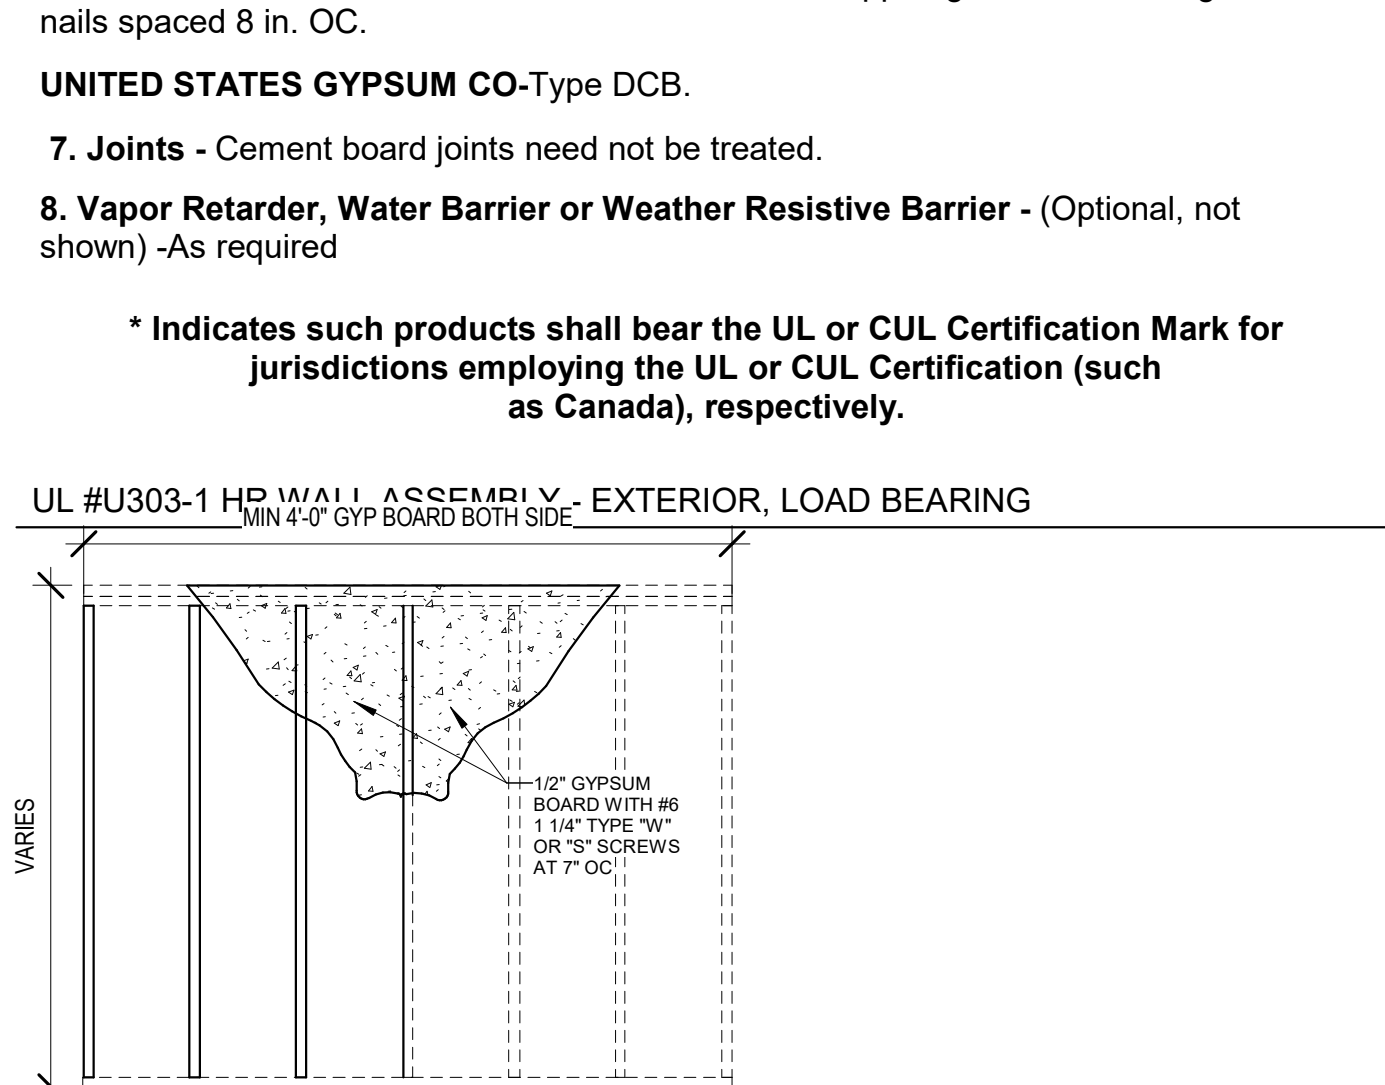


**Method GB**  
1/2" = 1'-0"


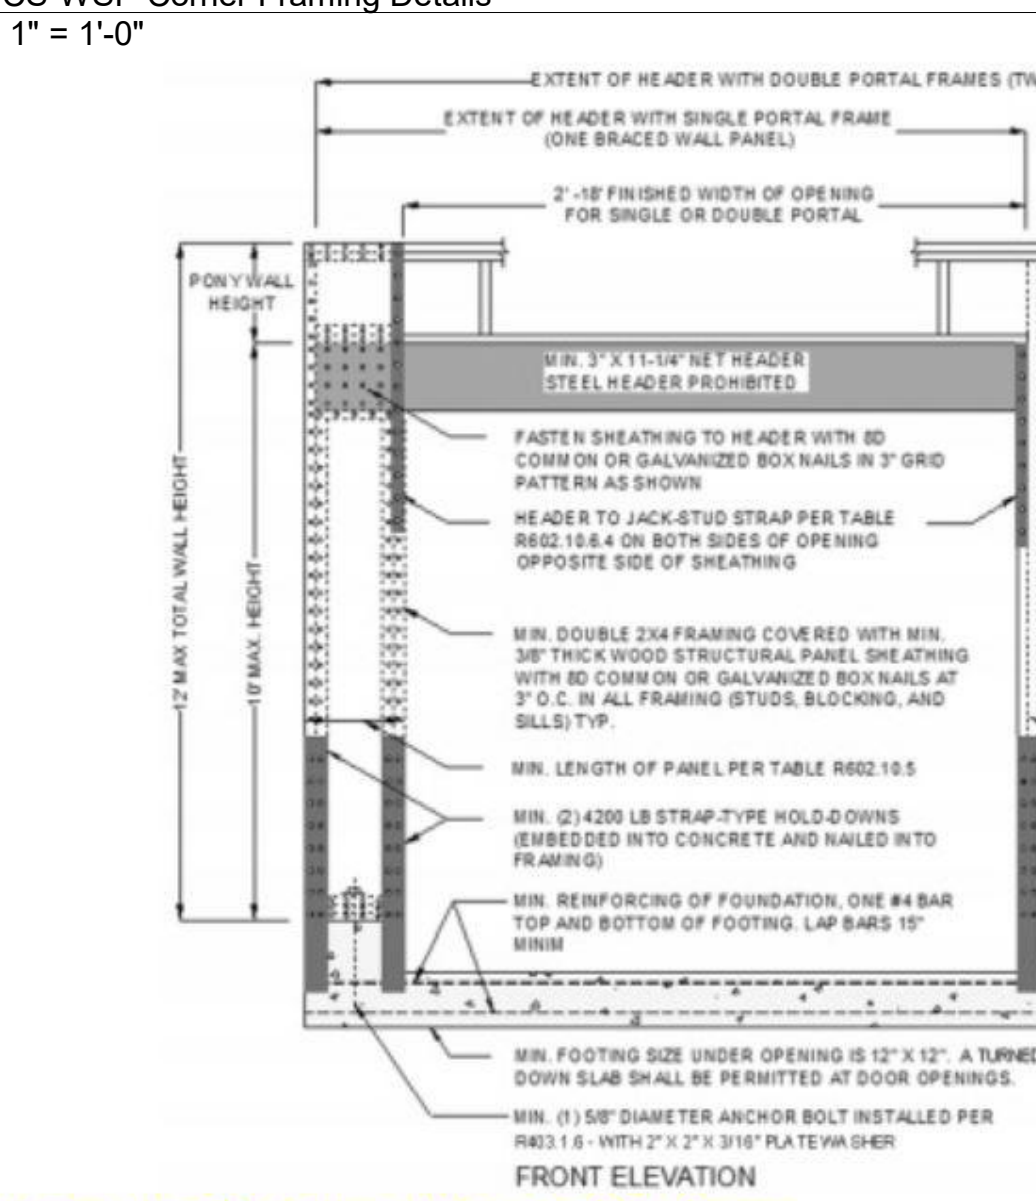
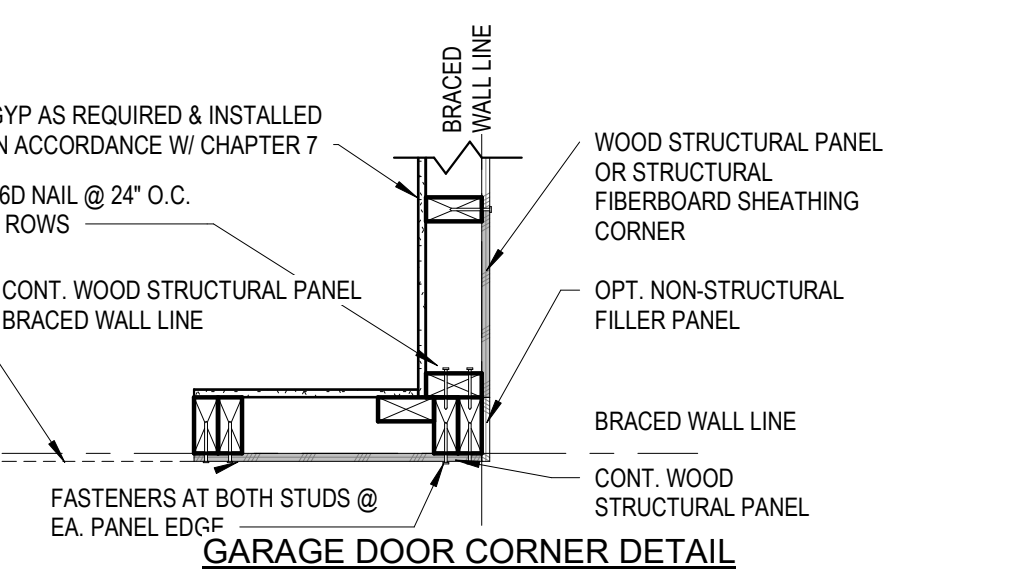
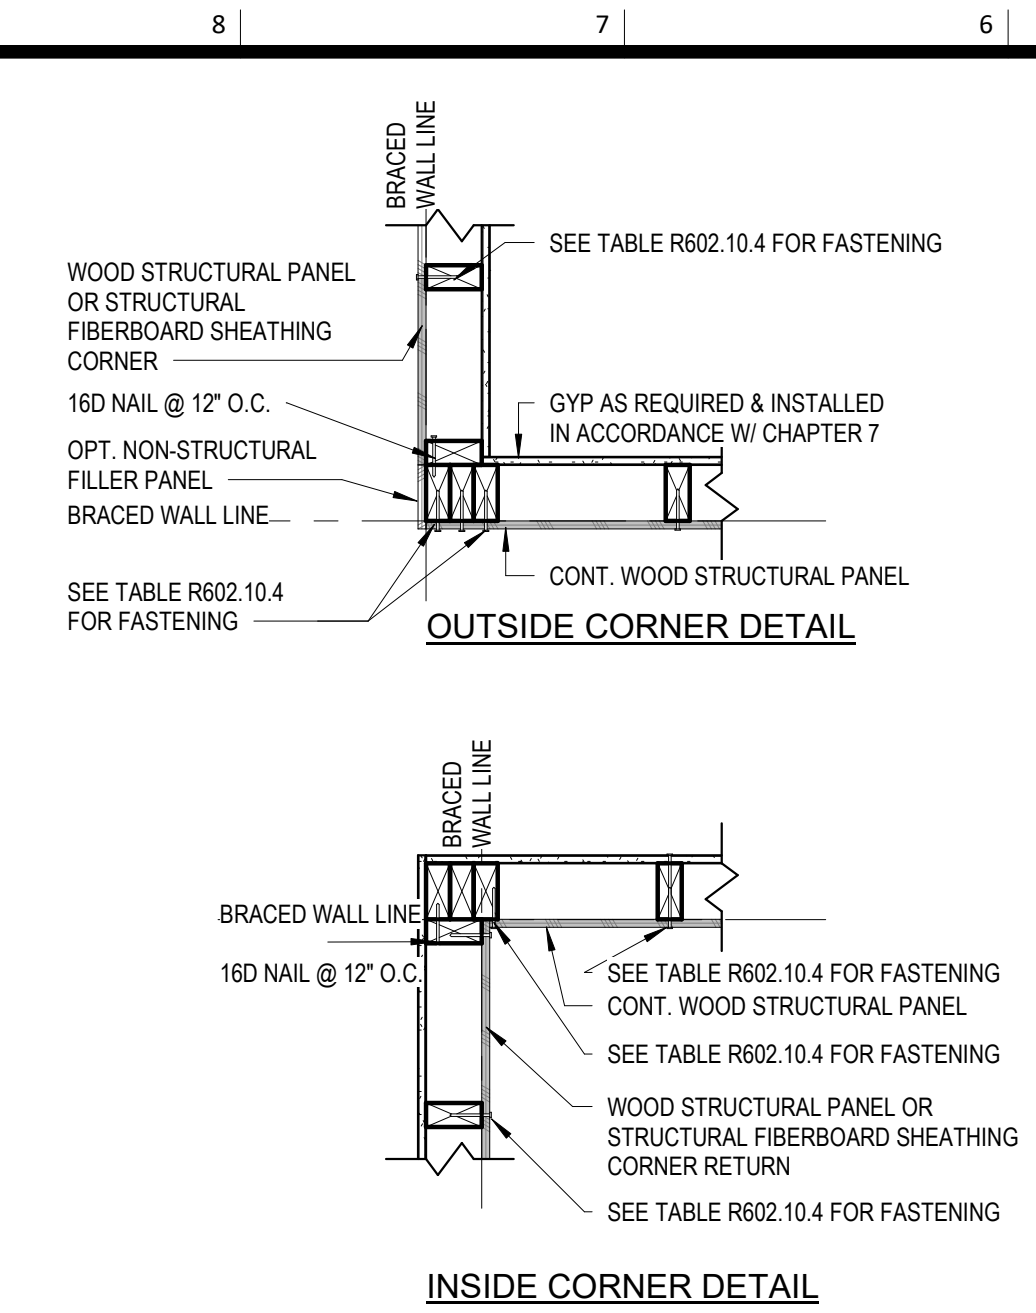


For SI: 1 inch = 25.4 mm, 1 foot = 304.8 mm.

FIGURE R602.10.6.2 METHOD PFH—PORTAL FRAME WITH HOLD-DOWNS

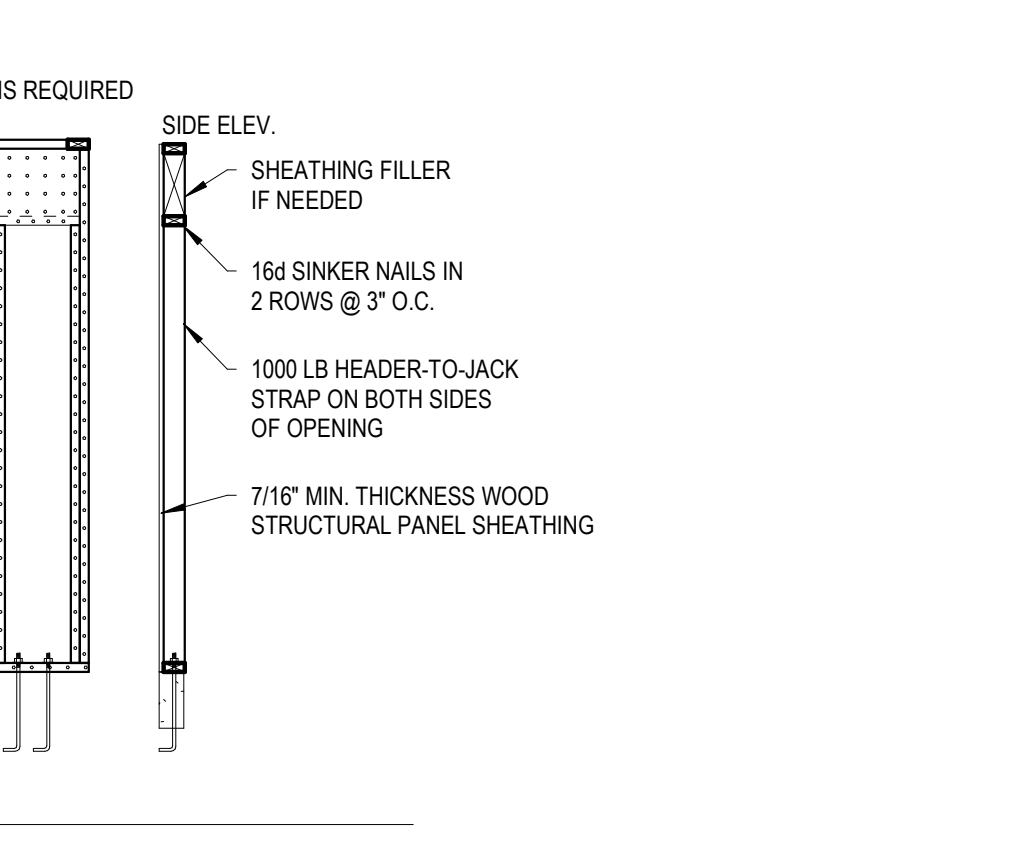

**Method CS-PF**  
3/8" = 1'-0"

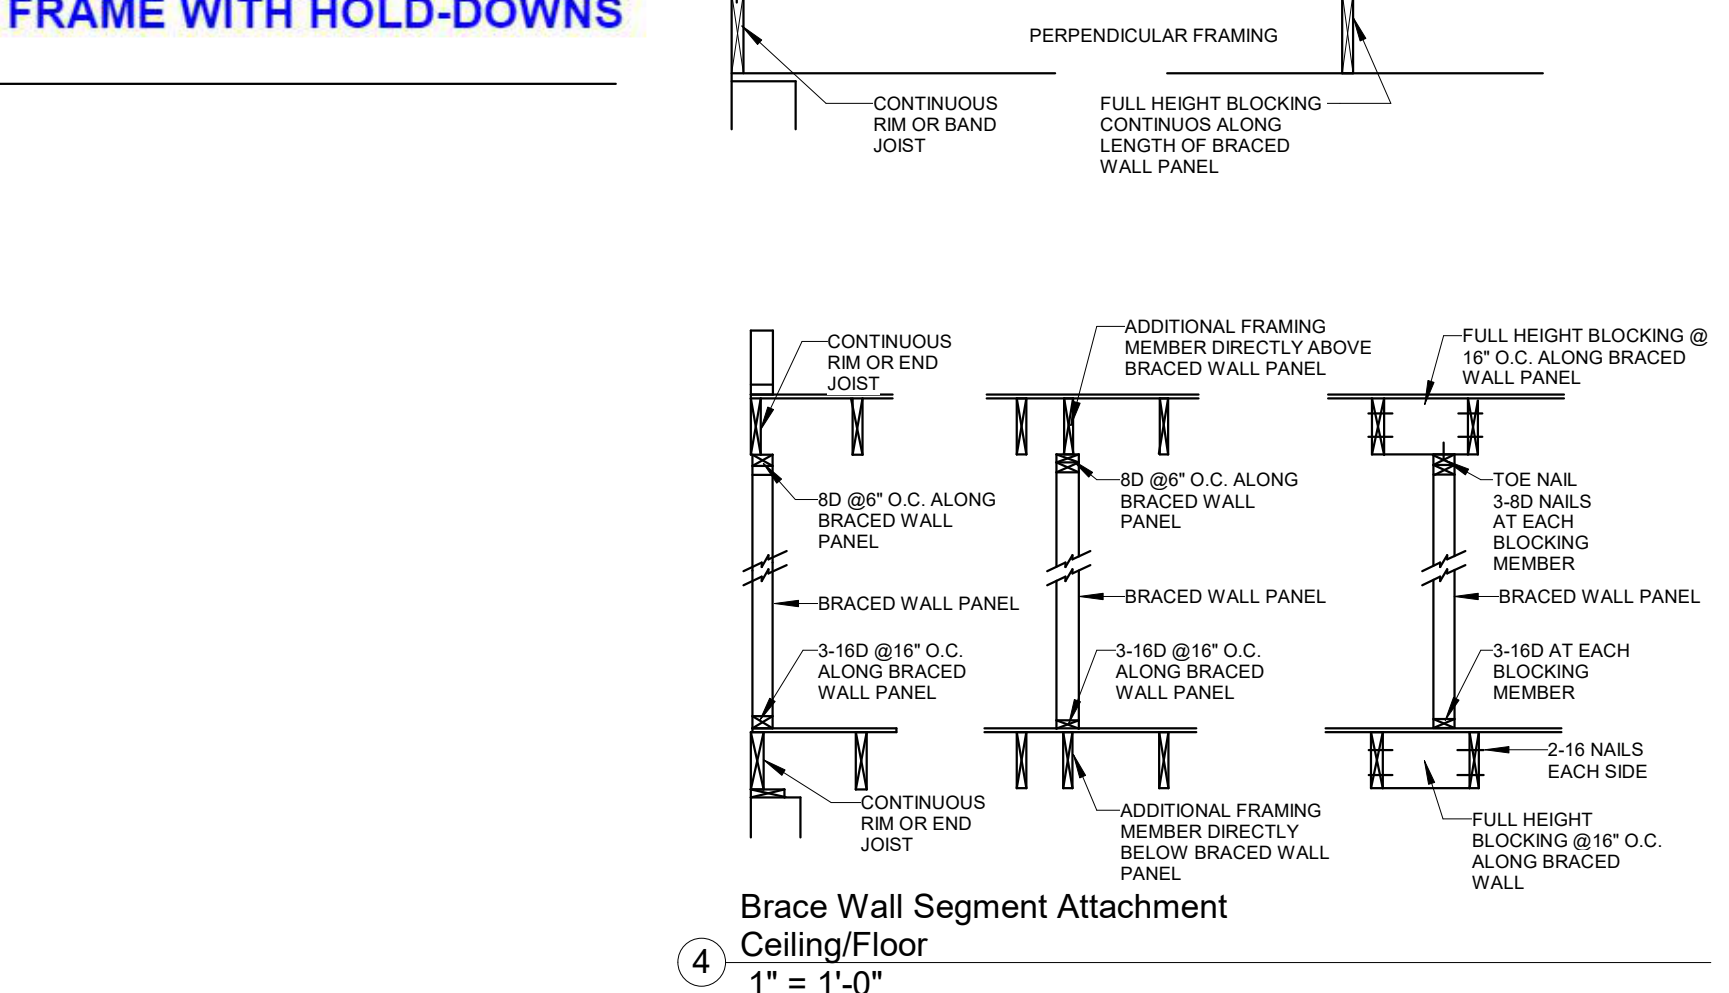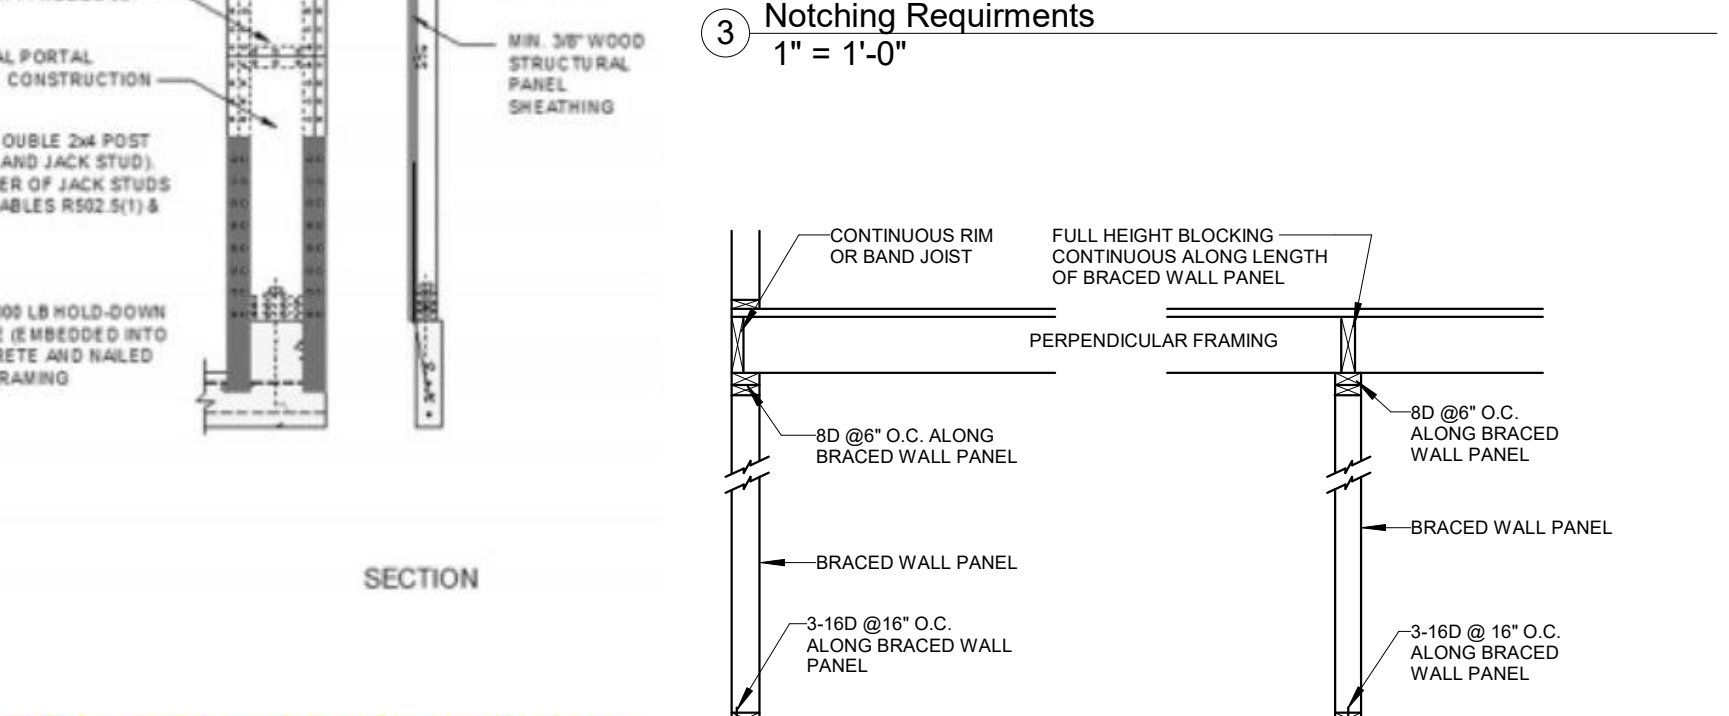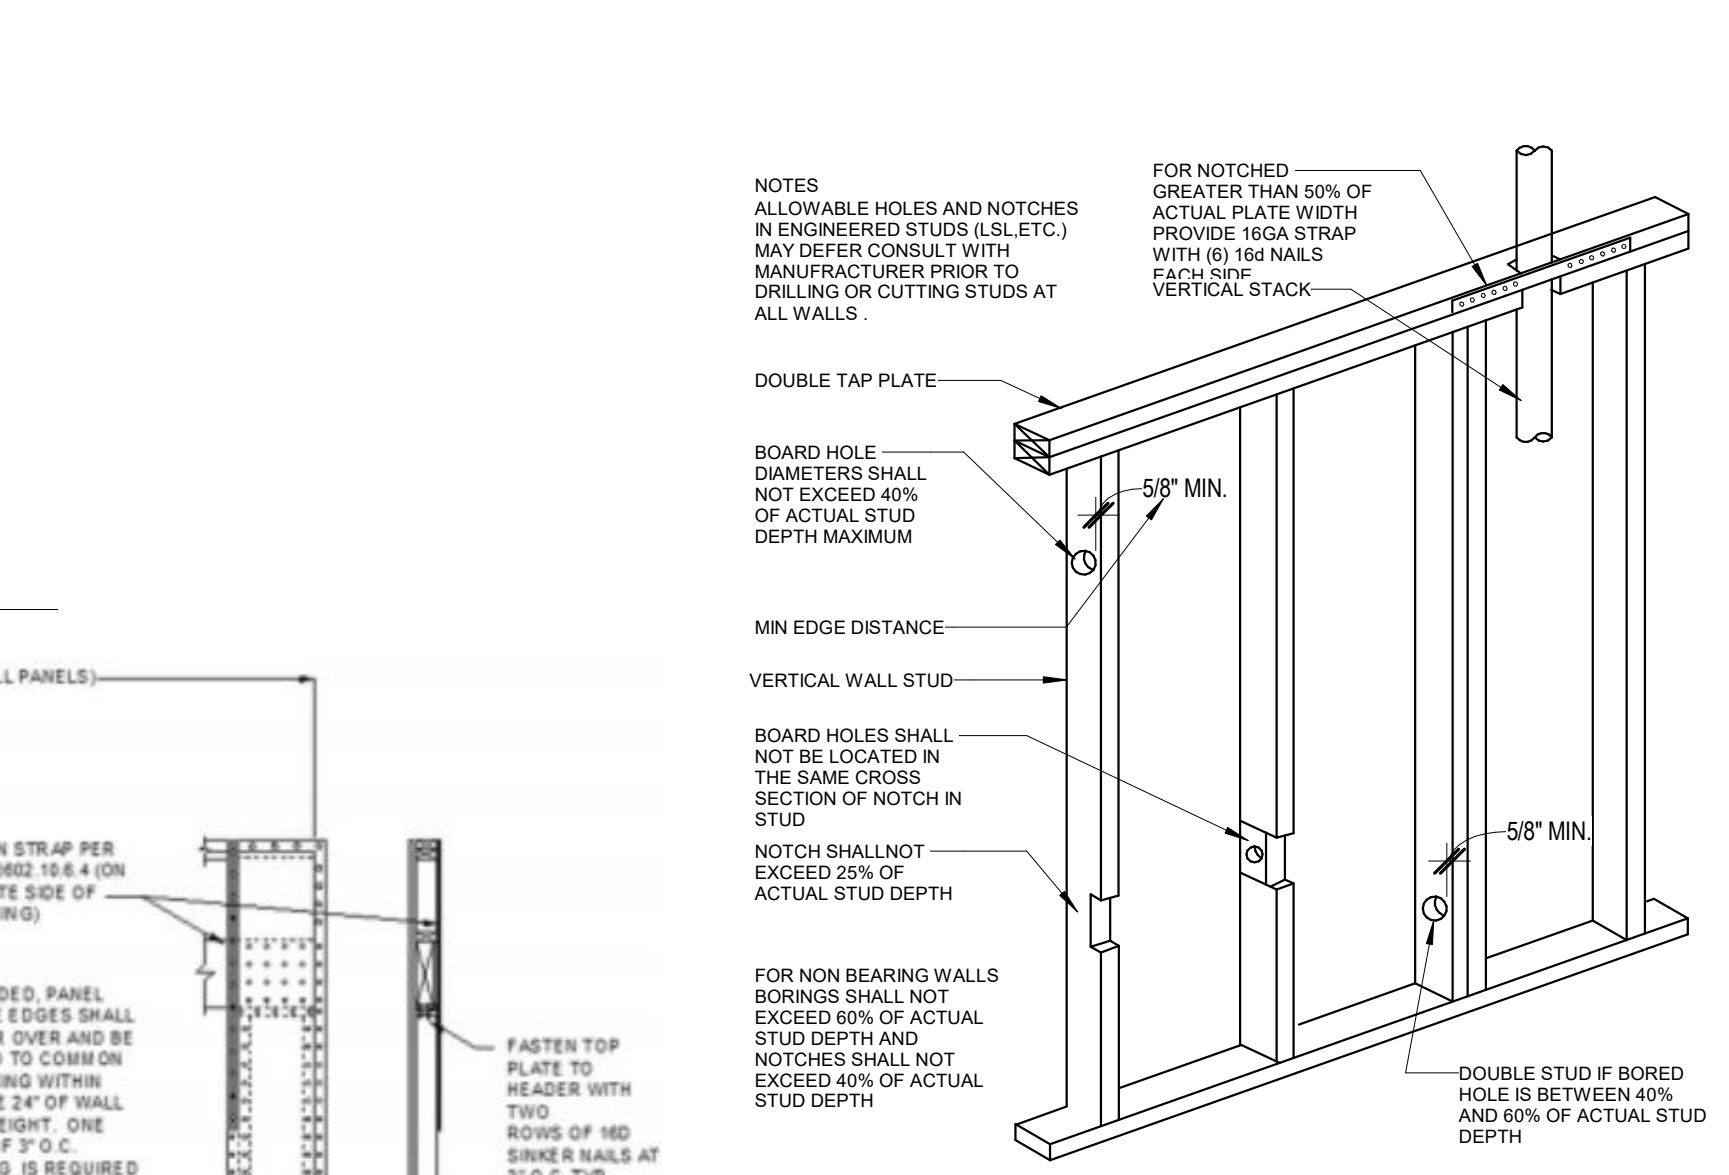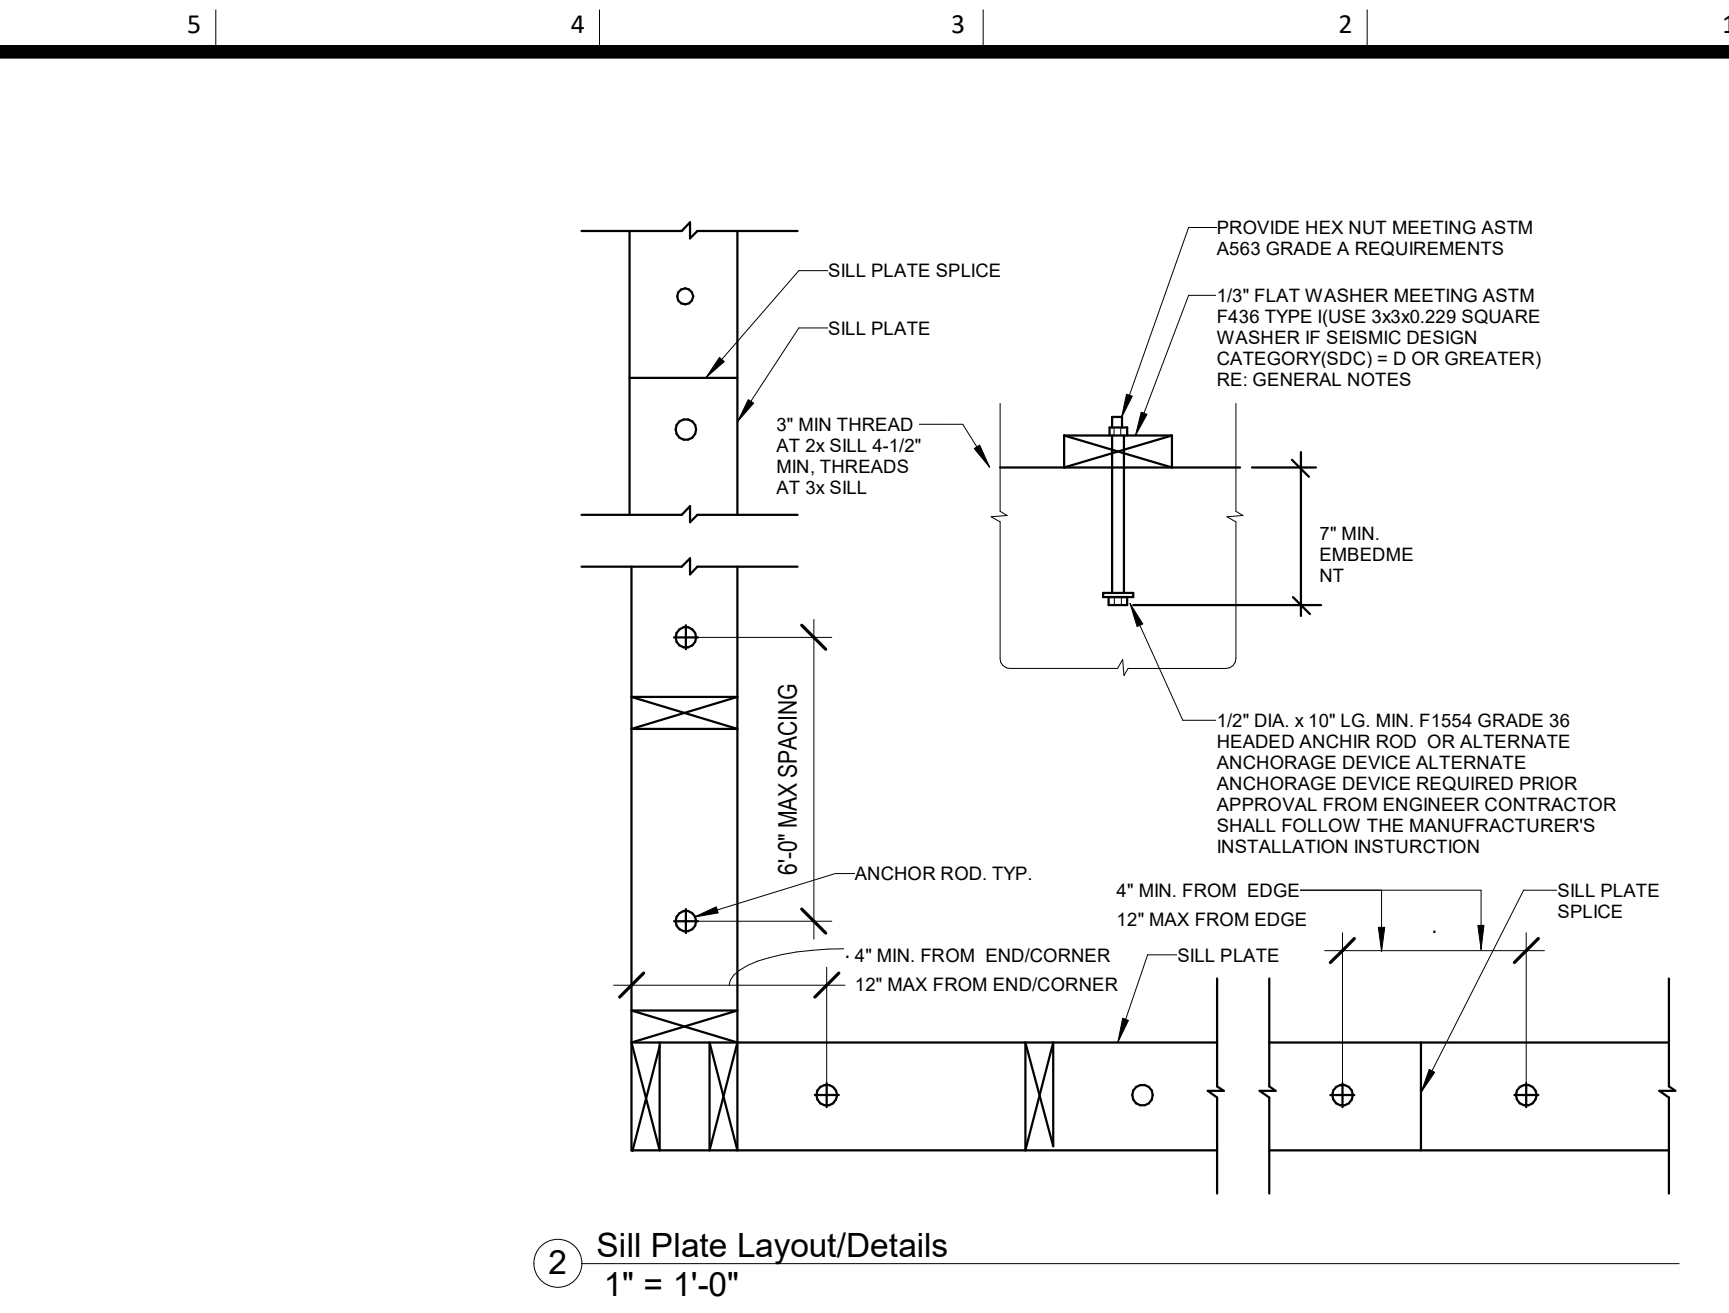

**Method CS-PF**  
3/8" = 1'-0"