


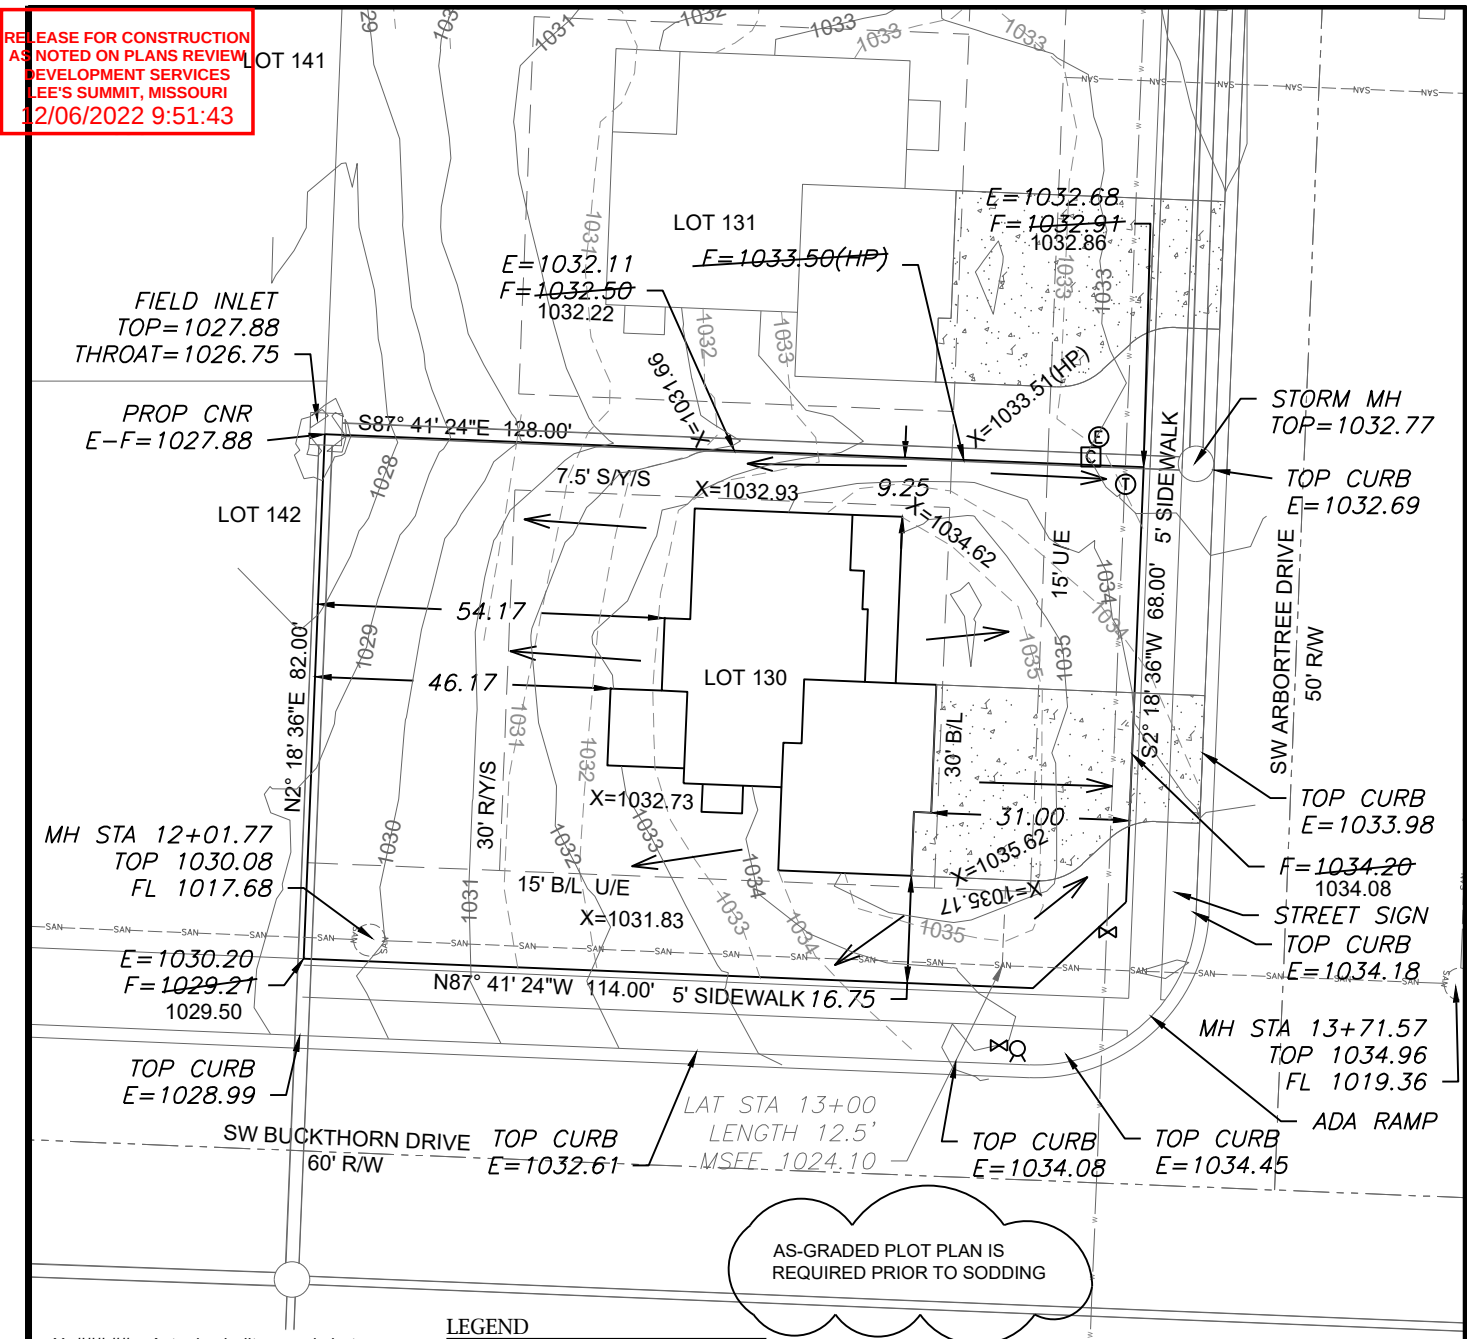


AS-GRADED PLOT PLAN IS
REQUIRED PRIOR TO SODDING

X=###.## = Actual asbuilt ground shots
taken on September 19, 2022

Contours shown are asbuilt.

--- PROPOSED
CONTOURS
--- AS-GRADED
CONTOURS

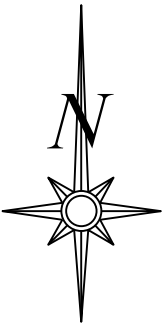

Scale 1"=30'

LOT INFORMATION

10,398 SQ. FT.
MBOE (REAR LEFT) = 1031.40
MBOE (REAR RIGHT) = 1027.91
MSFE = 1024.10
ADDRESS
3124 SW ARBORTREE DR

LEGAL DESCRIPTION

LOT 130, HAWTHORN RIDGE
2ND PLAT, A SUBDIVISION AS
RECORDED IN LEE'S SUMMIT,
JACKSON COUNTY, MISSOURI.

LEGEND

- Gas Meter
- Telephone or Fiber-Optic Pedestal
- Cable TV Pedestal
- Electric Pedestal
- Light Pole
- Mailbox
- Fire Hydrant
- Water Valve

PROPOSED HOUSE


TOP FOUNDATION = 1037.00
GARAGE FLOOR = 1036.00
TOP FOOTING = 1028.00
BASEMENT FLOOR = 1028.33
DRIVE SLOPE = 5.8%

E = EXISTING ELEVATION
F = PROPOSED FINAL ELEVATION
G = ADJACENT GRADE AT EGRESS
U/E = UTILITY EASEMENT
B/L = BUILDING LINE
S/Y/S = SIDE YARD SETBACK
R/Y/S = REAR YARD SETBACK

NOTES

- BUILDER TO VERIFY ALL
BUILDING ELEVATIONS AND
DIMENSIONS.
- THIS PLOT PLAN DOES NOT
CONSTITUTE A BOUNDARY
SURVEY.
- THE EASEMENTS SHOWN ON
THIS PLOT PLAN ARE TAKEN
FROM THE FINAL PLAT. OTHER
EASEMENTS MAY EXIST.

EXTENDED LOT AREA = 12,932 SF
DRIVE AREA = 906 SF
APPROACH AREA = 221 SF
SIDEWALK AREA = 960 SF

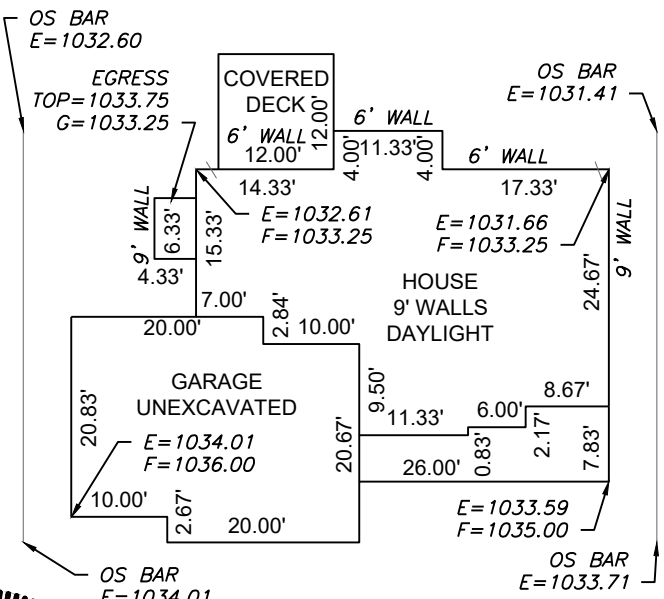

PLAN: PRESTON RIDGE

Scale 1"=20'

AS-BUILT PLOT PLAN - LOT 130

HAWTHORN RIDGE 2ND PLAT
LEE'S SUMMIT, JACKSON COUNTY, MISSOURI

SUMMIT HOMES
120 SE 30TH STREET
LEE'S SUMMIT, MO 64082

PROJECT NO.	FILE NAME	DATE	SHEET	OF
1	LOT 130, 131, HAWTHORN RIDGE	10/25/21	1	1

ENGINEERING SOLUTIONS
ENGINEERING & SURVEYING

50 SE 30TH STREET
LEE'S SUMMIT, MO 64082
P(816) 623-9888 F(816) 623-9849
WWW.ENGINEERINGSOLUTIONKCC.COM

THIS DRAWING IS NOT VALID UNLESS THE SIGNATURE, DATE AND SEAL OF
THE ENGINEER WHO SUPERVISED THE PREPARATION OF THIS DRAWING HAS
BEEN AFFIXED HERETO.

