


Notes

1. Contractor is responsible for verifying all existing utility locations prior to excavation.
2. There are no known natural or artificial water storage detention areas, or wetlands in the area designated for construction.
3. No part of the project lies within the 100 year flood plain.
4. All erosion and sediment control measures need to be implemented prior to construction.
5. Additional erosion control may be required by the City Engineer, Design Engineer or Owner at any time problematic areas are noted in the field or existing measures are found to be ineffective.
6. Soil Stabilization of disturbed areas shall be completed within 14 days of construction inactivity.
7. Contractor responsible for all density testing of roadway subgrade and granular base.



NOTE: Swale sections extend the entire length between upstream and downstream structures with the exception of a transition at each structure. The minimum swale depth shall be 6" over the 100-year water surface elevation.

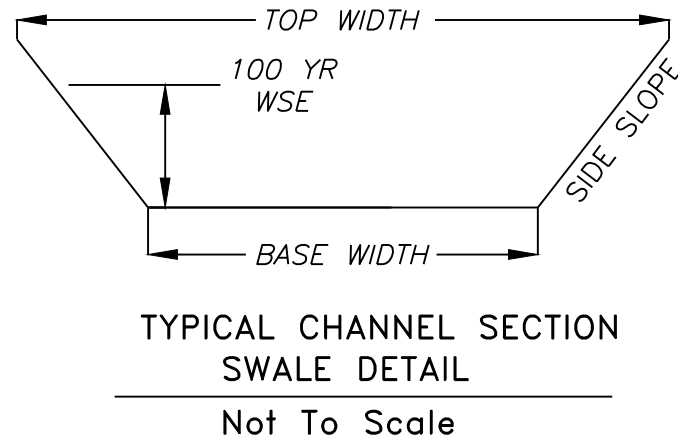

100 YEAR OVERFLOW SWALE SECTIONS									
Section	100 Yr. Runoff (c.f.s.)	Bed Slope (%)	Base Width (ft)	Side Slope (1:V)	100 Yr WSE (ft)	Sectional Area (f.p.s.)	Velocity 100Yr (f.p.s.)	Hydraulic Radius (ft)	Shear Stress (p.s.f.)
1-1	0.82	2.00	5	6	0.11	0.62	1.32	0.10	0.12
2-2	1.30	2.00	5	6	0.14	0.82	1.59	0.12	0.15

Note: See Table 8.10 of the APWA / MARC BMP Manual for design Summary for Native Vegetation Swales.

NOTE: Swale should be lined with "Straw with Net" turf reinforcement (Curlex Blanket or Eqv.). Per Table 5607-1 in APWA Manual

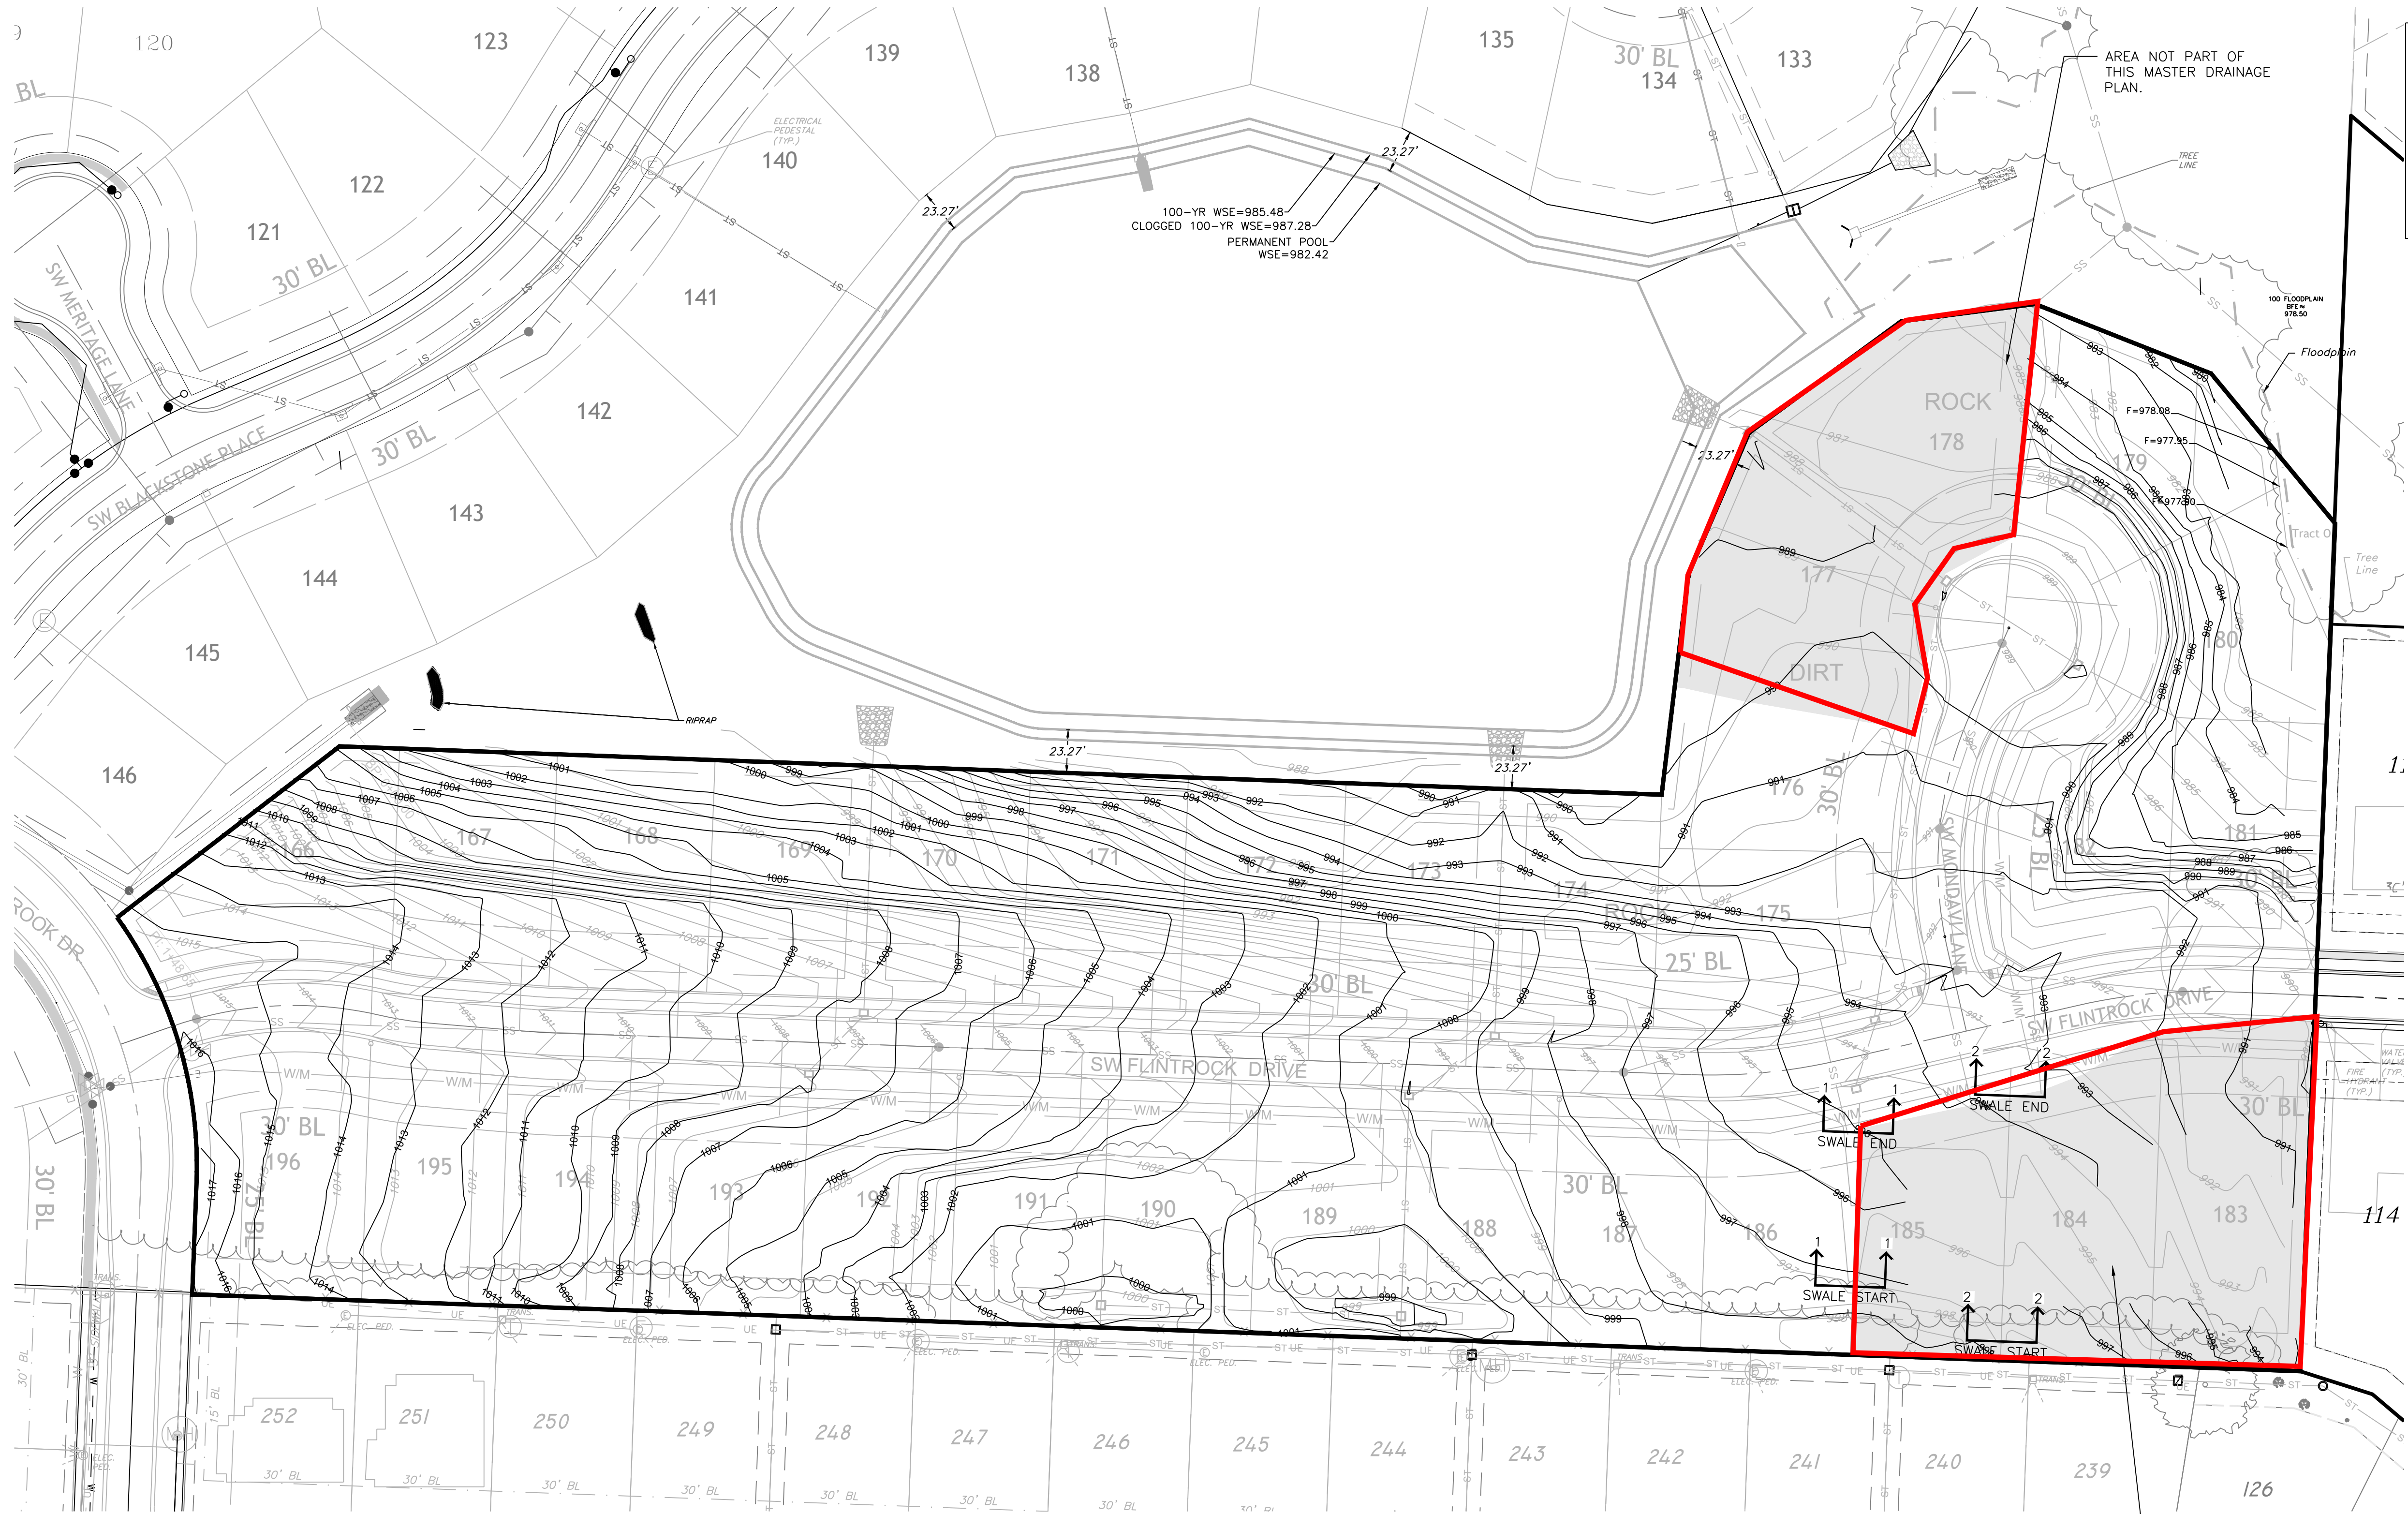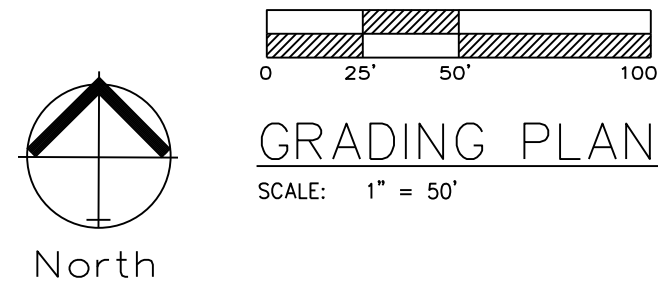

Estimated Cut / Fill Quantities

Site Area	9.65 Acres
Cut Volume (Unadjusted)	17,287 c.y.
Fill Volume (Unadjusted)	20,068 c.y.
Street & Sidewalk Cut Volume	1,680 c.y.

Net Fill 1,101 c.y. (Unadjusted)

Accepted Master Drainage Plan

This as-graded Master Drainage Plan (MDP) has been reviewed for accuracy. It is accepted for basic conformance to the approved MDP and may be used for the review of individual lot grading (plot) plans.



RECORD DRAWING
The information provided on this drawing conforms to construction records; it is not intended for construction, implementation or recording purposes; and it is solely based on information obtained by my firm.

Date: 11/18/2022
Certified by: Matthew J. Schlicht
Title: Engineer
Firm: Engineering Solutions

Master Drainage Plan 1 of 3:


Grading Plan
Street, Stormwater, Master Drainage Plans for:
Napa Valley 5th Plat
Lee's Summit, Jackson County, Missouri

Project:
NAPA VALLEY LSWO

Issue Date:
October 31, 2022

Napa Valley 5th Plat
Lee's Summit, Jackson County, Missouri


Professional Registration
Missouri
Engineering 2005002186-D
Surveying 2005008319-D
Kansas
Engineering E-1685
Surveying LS-218
Oklahoma
Engineering 6254
Nebraska
Engineering CA2821

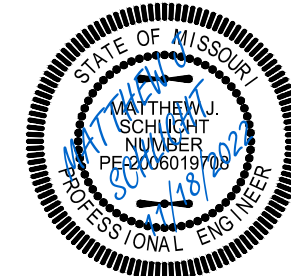

Matthew J. Schlicht
MO PE 2006019708
KS PE 19071
OK PE 25226
NE PE E-14335

REVISIONS
11/18/2022 As-Built

Lot Number	Basement Type	MBOE
166	Walkout	N/A
167	Walkout	N/A
168	Walkout	N/A
169	Walkout	N/A
170	Walkout	N/A
171	Walkout	N/A
172	Walkout	N/A
173	Walkout	N/A
174	Walkout	N/A
175	Full	N/A
176	Full	N/A
177	Full	N/A
178	Daylight	N/A
179	Walkout	N/A
180	Walkout	N/A
181	Walkout	N/A
182	Daylight	N/A
183	Full	N/A
184	Full	N/A
185	Full	N/A
186	Full	N/A
187	Daylight	N/A
188	Daylight	N/A
189	Walkout	N/A
190	Walkout	N/A
191	Walkout	N/A
192	Walkout	N/A
193	Walkout	N/A
194	Daylight	N/A
195	Full	N/A
196	Full	N/A

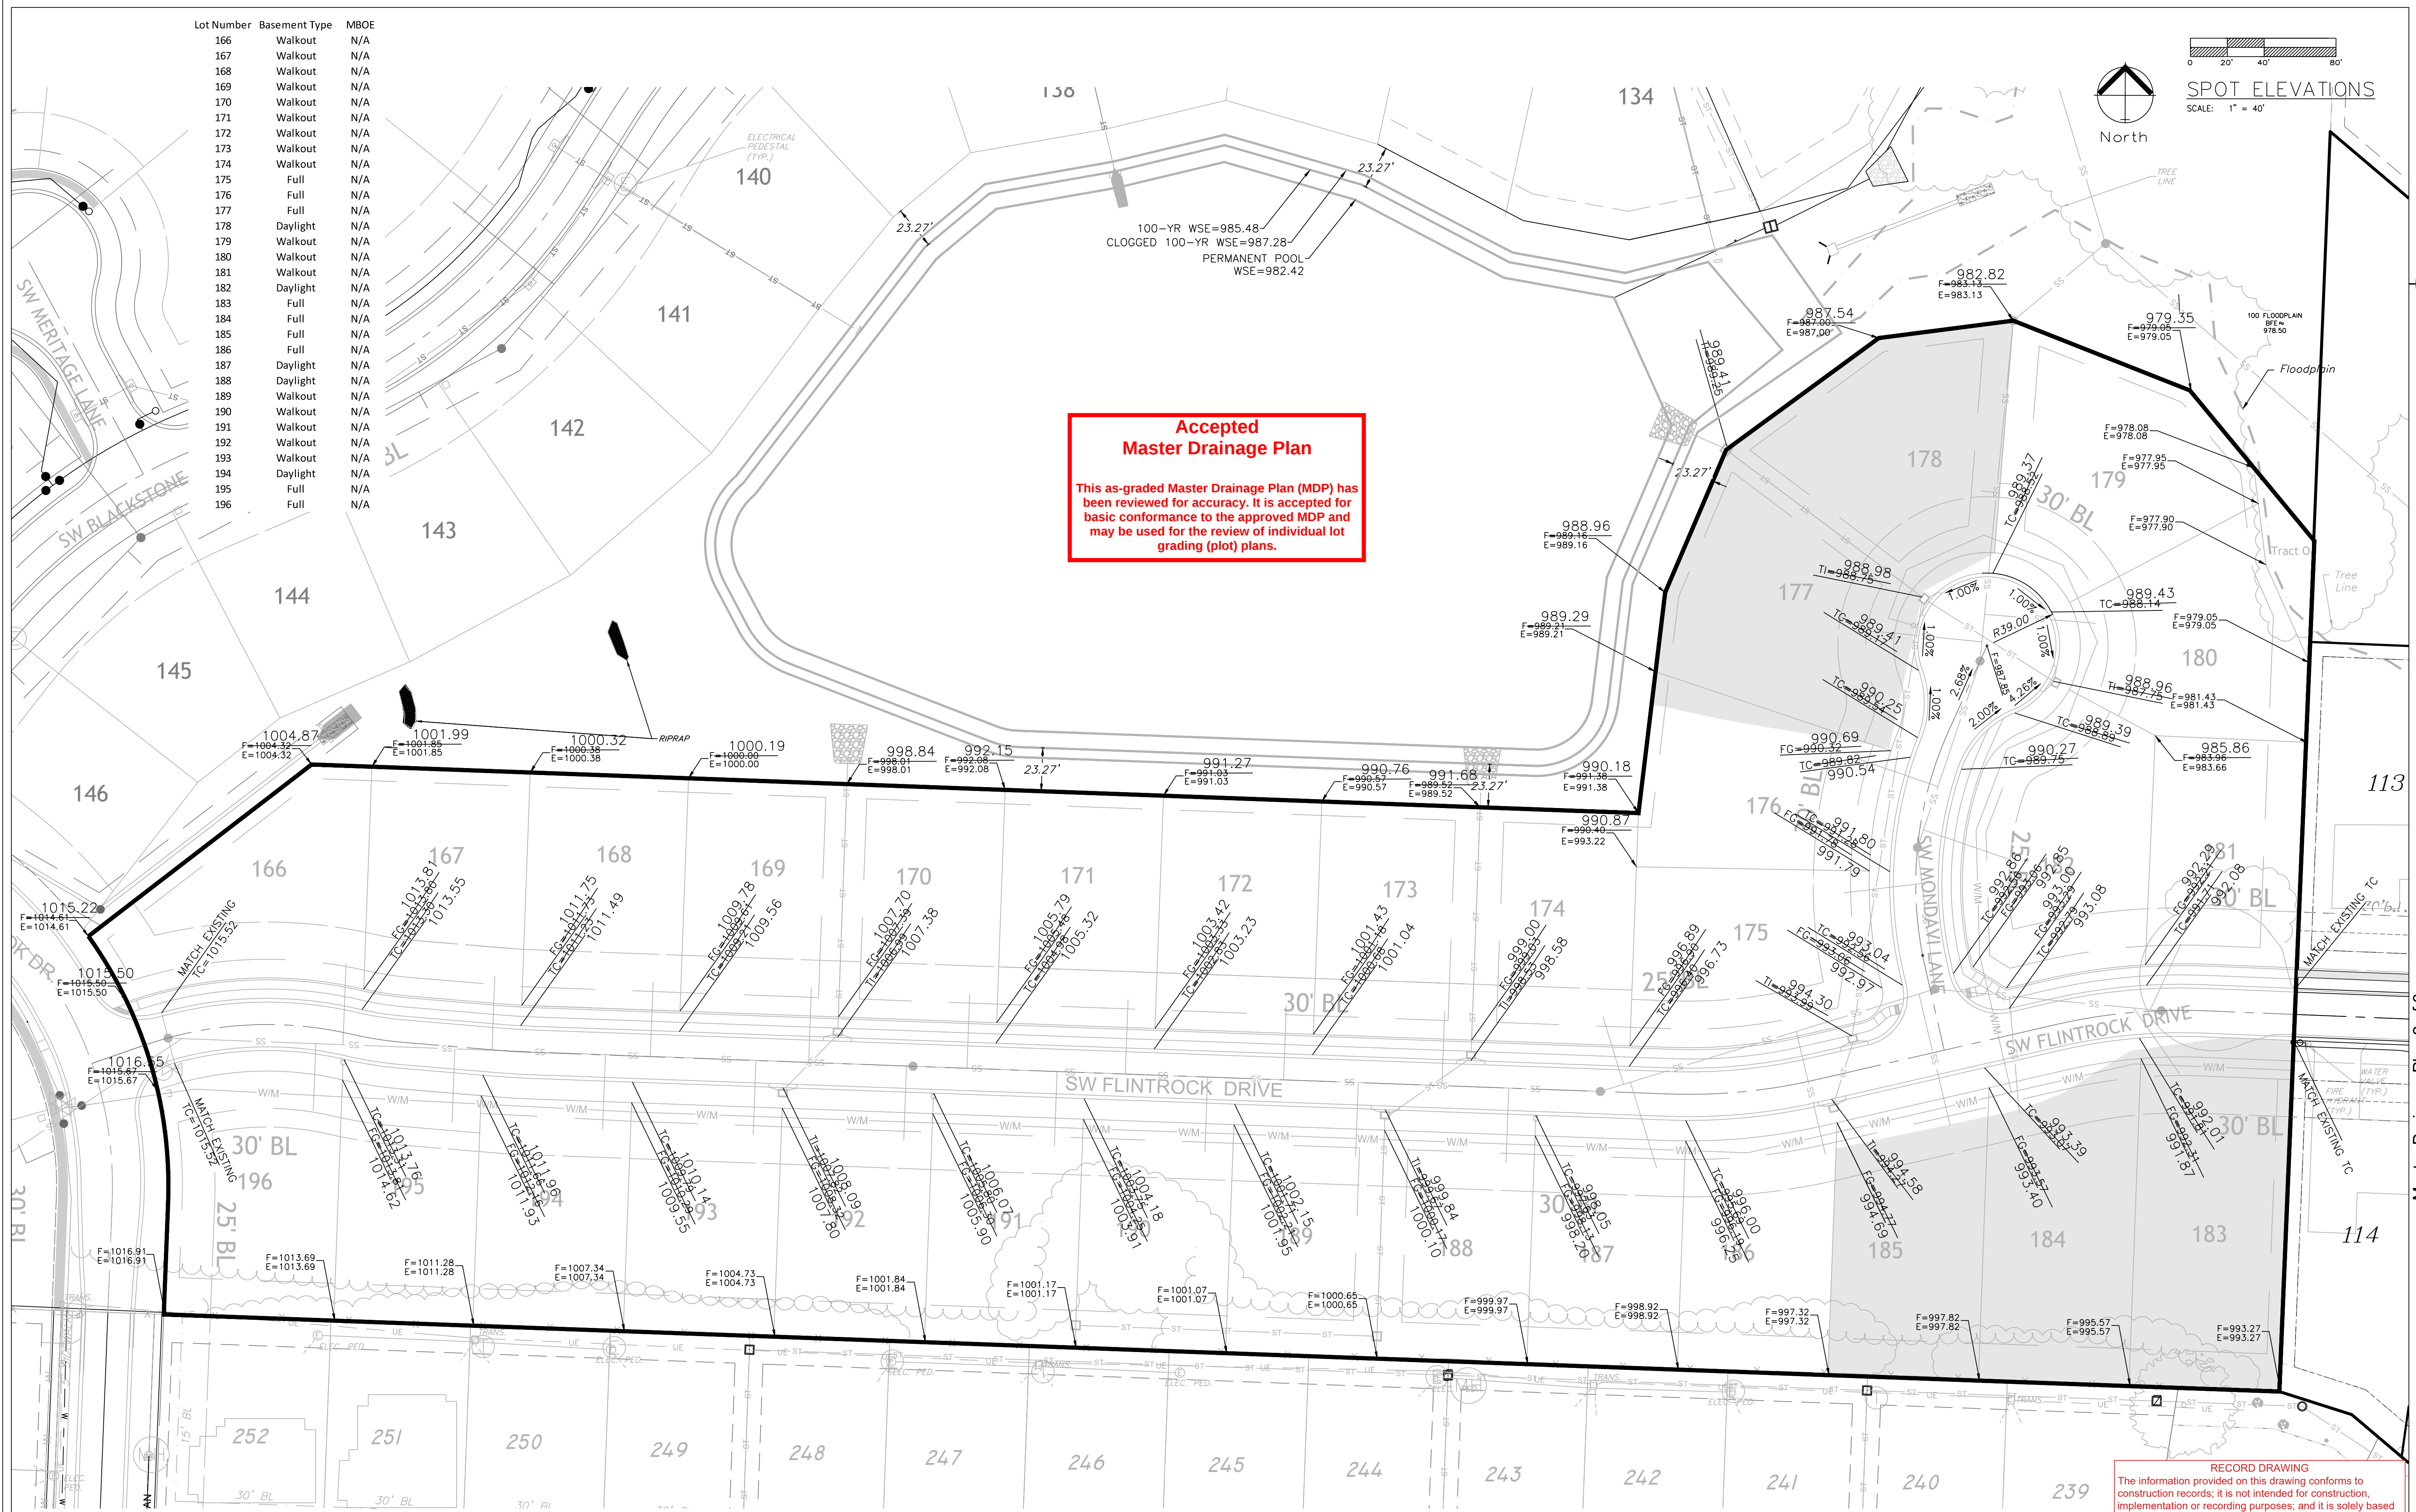


ENGINEERING SOLUTIONS
ENGINEERING & SURVEYING
50 SE 30TH STREET
LEE'S SUMMIT, MO 64082
P: (816) 623-9888 F: (816) 623-9849

Professional Registration
Missouri
Engineering 2005002186-D
Surveying 2005008319-D
Kansas
Engineering E-1695
Surveying LS-218
Oklahoma
Engineering 6254
Nebraska
Engineering CA2821

Project: NAPA VALLEY L5MO
Issue Date: October 31, 2022


Napa Valley 5th Plat
Lee's Summit, Jackson County, Missouri

Master Drainage Plan 2 of 3:
Spot Elevations
Street, Stormwater Master Drainage Plans for:
Napa Valley 5th Plat
Lee's Summit, Jackson County, Missouri

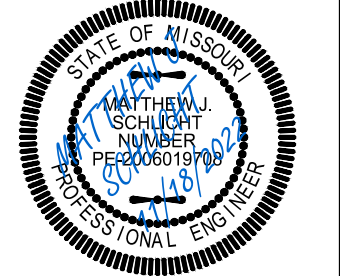

Matthew J. Schlicht
MO PE 2006019708
KS PE 19071
OK PE 25226
NE PE E-14335

REVISIONS
11/18/2022 As-Built

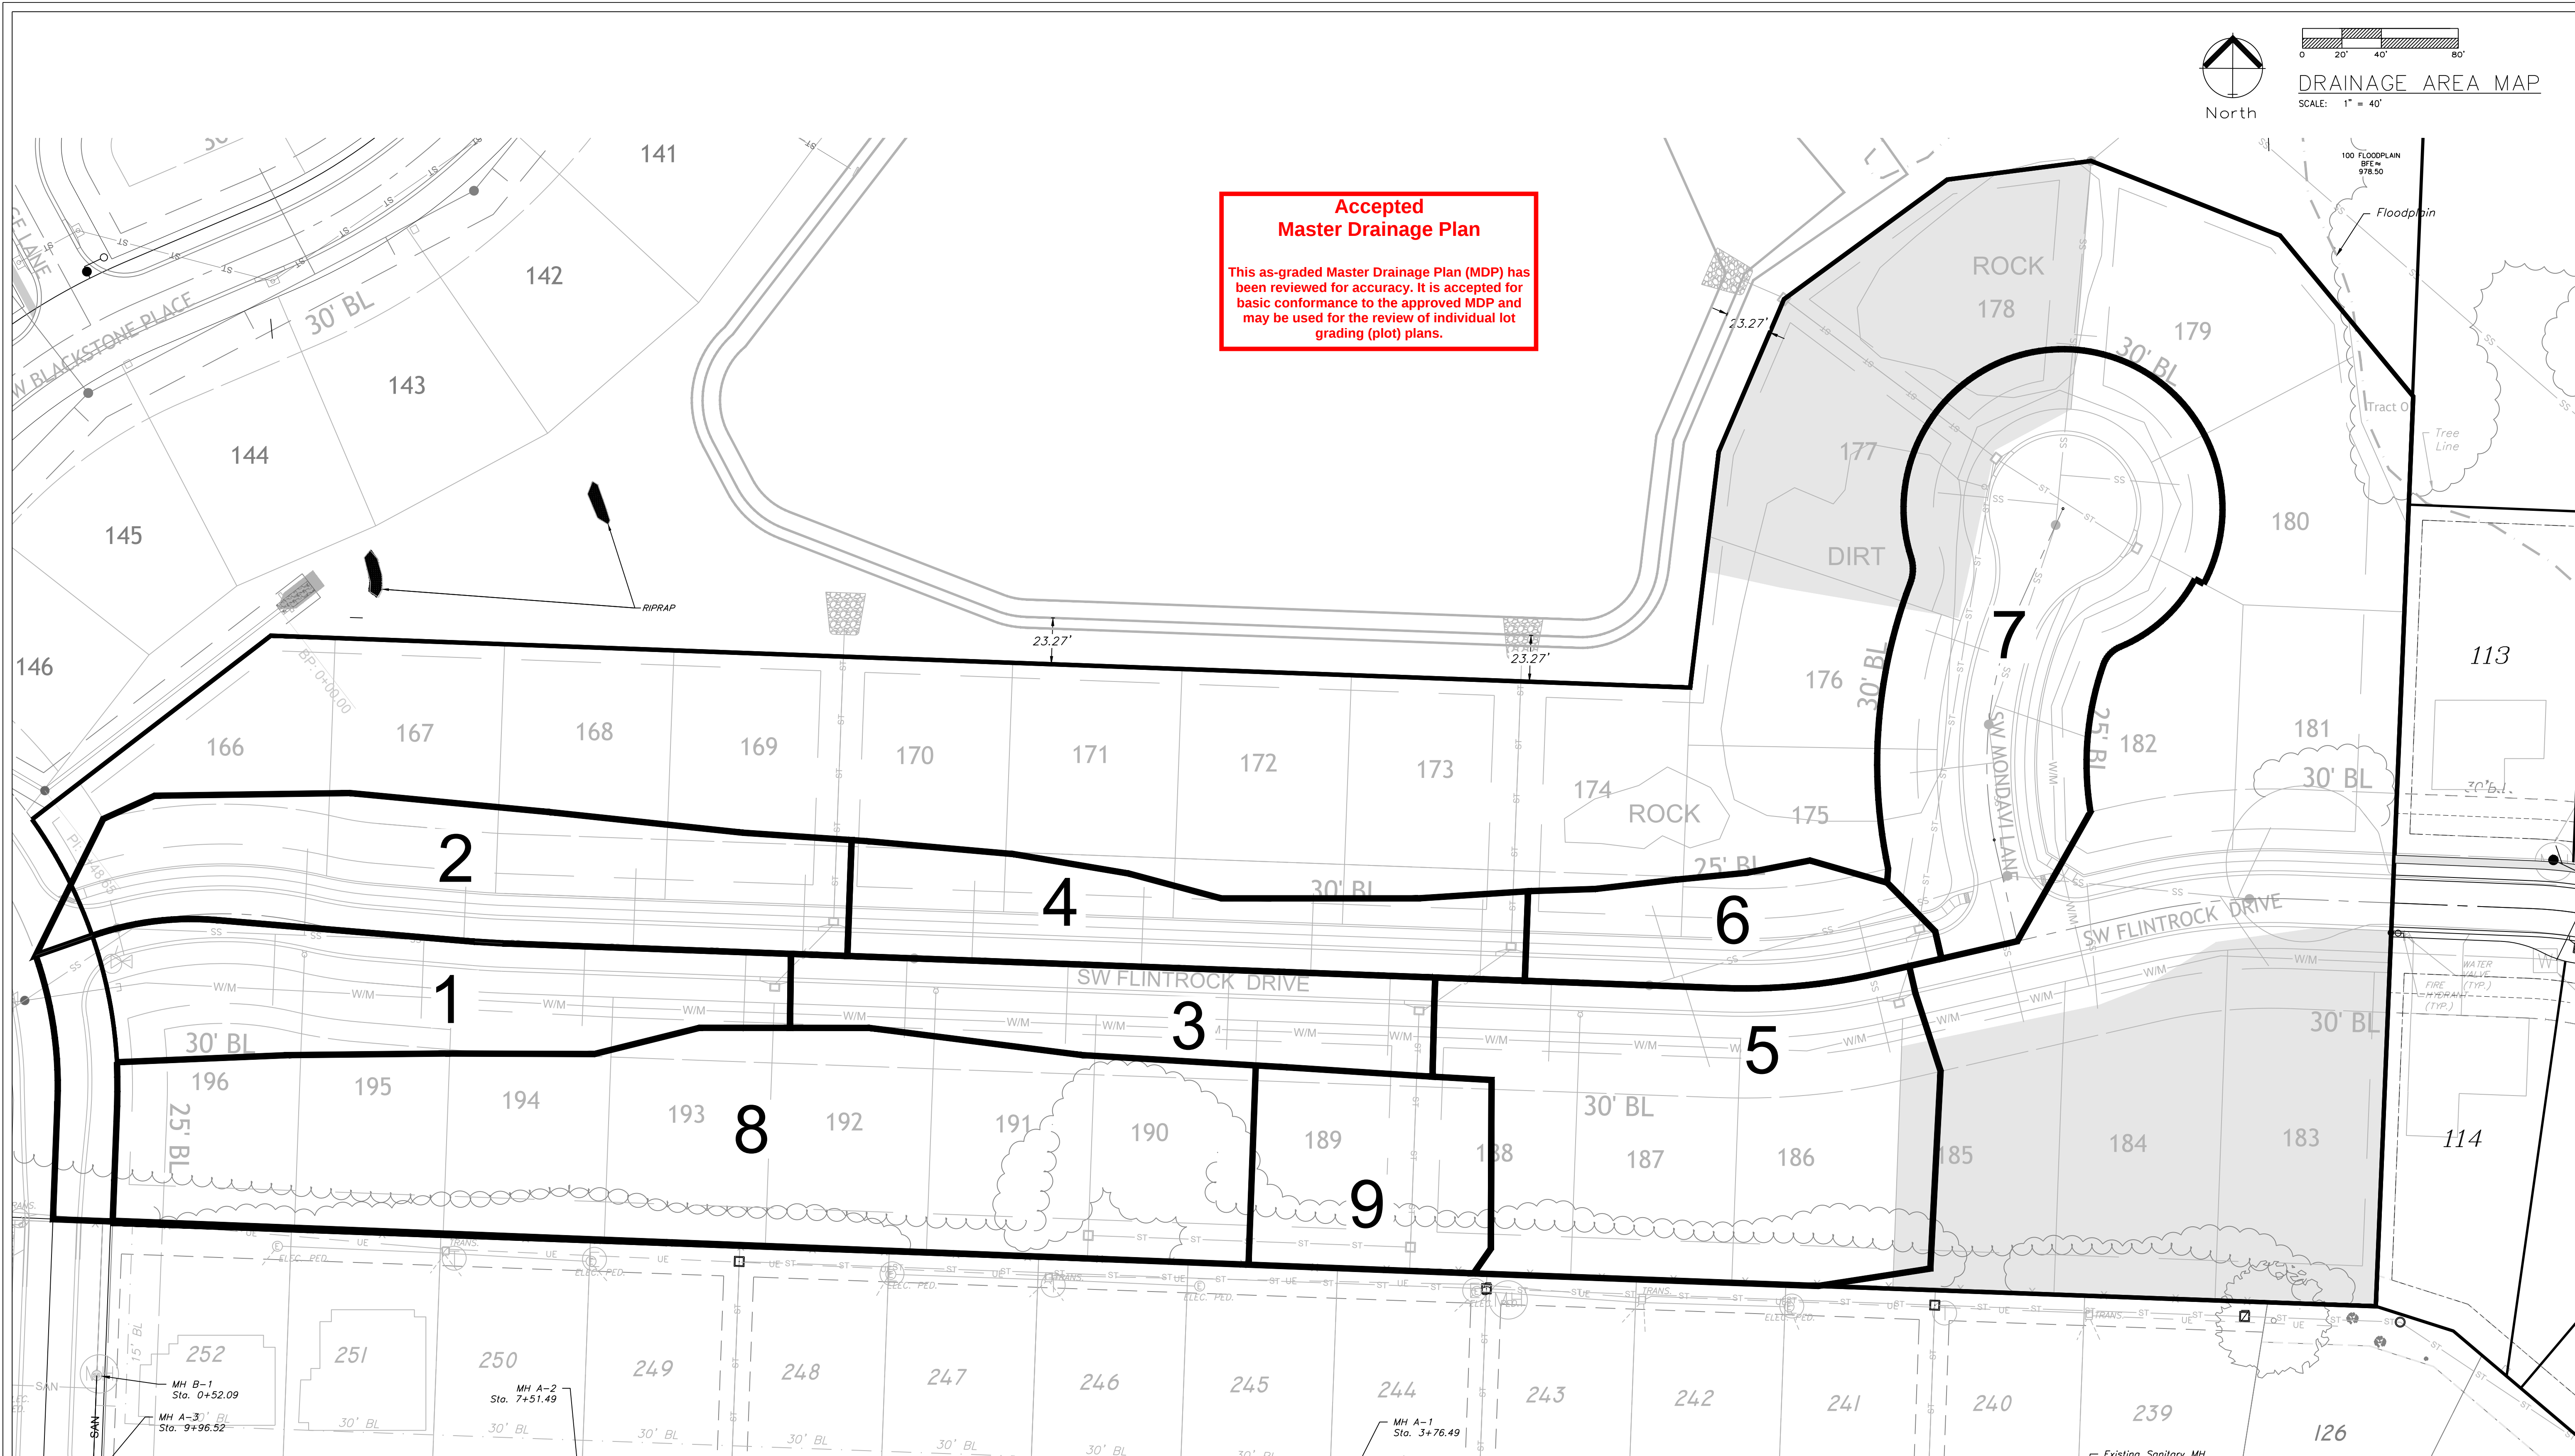

**Accepted
Master Drainage Plan**

This as-graded Master Drainage Plan (MDP) has been reviewed for accuracy. It is accepted for basic conformance to the approved MDP and may be used for the review of individual lot grading (plot) plans.

APWA STORM DRAINAGE "TC" COMPUTATIONS FOR : NAPA VALLEY 5TH PLAT

yellow areas are self computing overwrite if necessary					Surface types:																																																											
					SURFACE CODES					Asph/ConcBus/Com					Dirt					Grass/Park					Lake					MultFam					SnglFam					Undev					Other																			
					"C" Values					A					B					D					G					L					M					S					U					Z														
										0.90					0.87					0.60					0.30					0.90					0.66					0.51					0.3																			
TOTAL WATERSHED					Overwrite Length - DN Elev or Slope if necessary										SURFACE CODE					P=Paved U=Unpaved					Overwrite Slope or Elevations if necessary										Cal Overland Flow T(I)					Used Min 5 Max 15 T(I)					Cal Channel One T(T)					Cal Channel Two T(T)					Total T(10)					AREA ID				
					OVERLAND FLOW - 100' MAX										P					CHANNEL FLOW - FIRST REACH																																												
AREA ID	TOTAL ACRES	WTRSHD LENGTH	UP ELEV	DN ELEV	SURFACE CODE	"C" VALUE	OVRLND LENGTH	UP ELEV	DN ELEV	SLOPE %	or U	CHANNEL LENGTH	ELEV	DN ELEV	SLOPE %	VELOCITY F/S																																																
1	0.54	359.00	1015.00	1010.50	S	0.51	59.0	1015.0	1013.70	2.2	P	300.0	1013.7	1010.5	1.07	2.1	6.3	6.3	2.4	0.0	8.7	1																																										
2	0.57	384.00	1016.00	1010.20	S	0.51	49.0	1016.0	1015.00	2.0	P	335.0	1015.0	1010.2	1.43	2.4	5.9	5.9	2.3	0.0	8.2	2																																										
3	0.32	333.00	1010.50	1005.00	S	0.51	26.0	1010.5	1009.80	2.7	P	307.0	1009.8	1005.0	1.56	2.5	3.9	5.0	2.0	0.0	7.0	3																																										
4	0.35	369.00	1012.20	1003.00	S	0.51	47.0	1012.2	1011.00	2.6	P	322.0	1011.0	1003.0	2.48	3.2	5.3	5.3	1.7	0.0	7.0	4																																										
5	0.32	258.00	1007.20	994.50	S	0.51	41.0	1007.2	1004.00	7.8	P	217.0	1004.0	994.5	4.38	4.3	3.4	5.0	0.9	0.0	5.9	5																																										
6	0.24	221.00	1005.00	994.00	S	0.51	36.0	1005.0	1003.00	5.6	P	185.0	1003.0	994.0	4.86	4.5	3.6	5.0	0.7	0.0	5.7	6																																										
7	0.78	236.00	995.00	991.00	S	0.51	49.0	995.0	992.50	5.1	P	187.0	992.5	991.0	0.80	1.8	4.3	5.0	1.7	0.0	6.7	7																																										
8	2.26	508.00	1016.00	999.00	S	0.51	100.0	1016.0	1014.00	2.0	U	408.0	1014.0	999.0	3.68	3.1	8.4	8.4	2.2	0.0	10.6	8																																										
9	0.46	133.00	1008.50	999.00	S	0.51	100.0	1008.5	1000.00	8.5	U	33.0	1000.0	999.0	3.03	2.8	5.2	5.2	0.2	0.0	5.4	9																																										

RECORD DRAWING

The information provided on this drawing conforms to construction records; it is not intended for construction, implementation or recording purposes; and it is solely based on information obtained by my firm.

"100-00 100.10", "4-00% 1.15% slope", or "8-inch HDPE-PVC pipe" are all typical examples of revisions that indicate that design data has been replaced with "as-built" information. All other data is as designed and has not been field verified.

Date: 11/18/2022
Certified by: Matthew J. Schlicht
Title: Engineer
Firm: Engineering Solutions

ENGINEERING SOLUTIONS
ENGINEERING & SURVEYING
50 SE 30TH STREET
LEE'S SUMMIT, MO 64082
P: (816) 623-9888 F: (816) 623-9849

Professional Registration
Missouri
Engineering 2005002186-D
Surveying 2005008319-D
Kansas
Engineering E-1695
Surveying LS-218
Oklahoma
Engineering 6254
Nebraska
Engineering CA2821

Project: NAPA VALLEY 5TH PLAT
Issue Date: October 31, 2022

Master Drainage Map 3 of 3:
Drainage Area Map
Street, Stormwater, Master Drainage Plans for:
Napa Valley 5th Plat
Lee's Summit, Jackson County, Missouri

STATE OF MISSOURI
MATTHEW J. SCHLICHT
REGISTERED PROFESSIONAL ENGINEER
NO. 000000000
EXPIRATION DATE 12/31/2025

Matthew J. Schlicht
MO PE 2006019708
KS PE 19071
OK PE 25226
NE PE E-14335

REVISIONS
11/18/2022 As-Built

C.202