


# CONSTRUCTION STAKE PLOT PLAN

ORDERED BY: NEW MARK HOMES

DESCRIPTION: LOT 91 WOODSIDE RIDGE 1ST PLAT  
LOTS 1-143 & TRACTS A,B,C,D,E,F,G, and H  
LEE'S SUMMIT, JACKSON COUNTY, MISSOURI  
218 NW AMBERSHAM  
NO DECK CONSTRUCTION WITHOUT A PERMIT

AS BUILTS PERFORMED ON  
10/27/2022

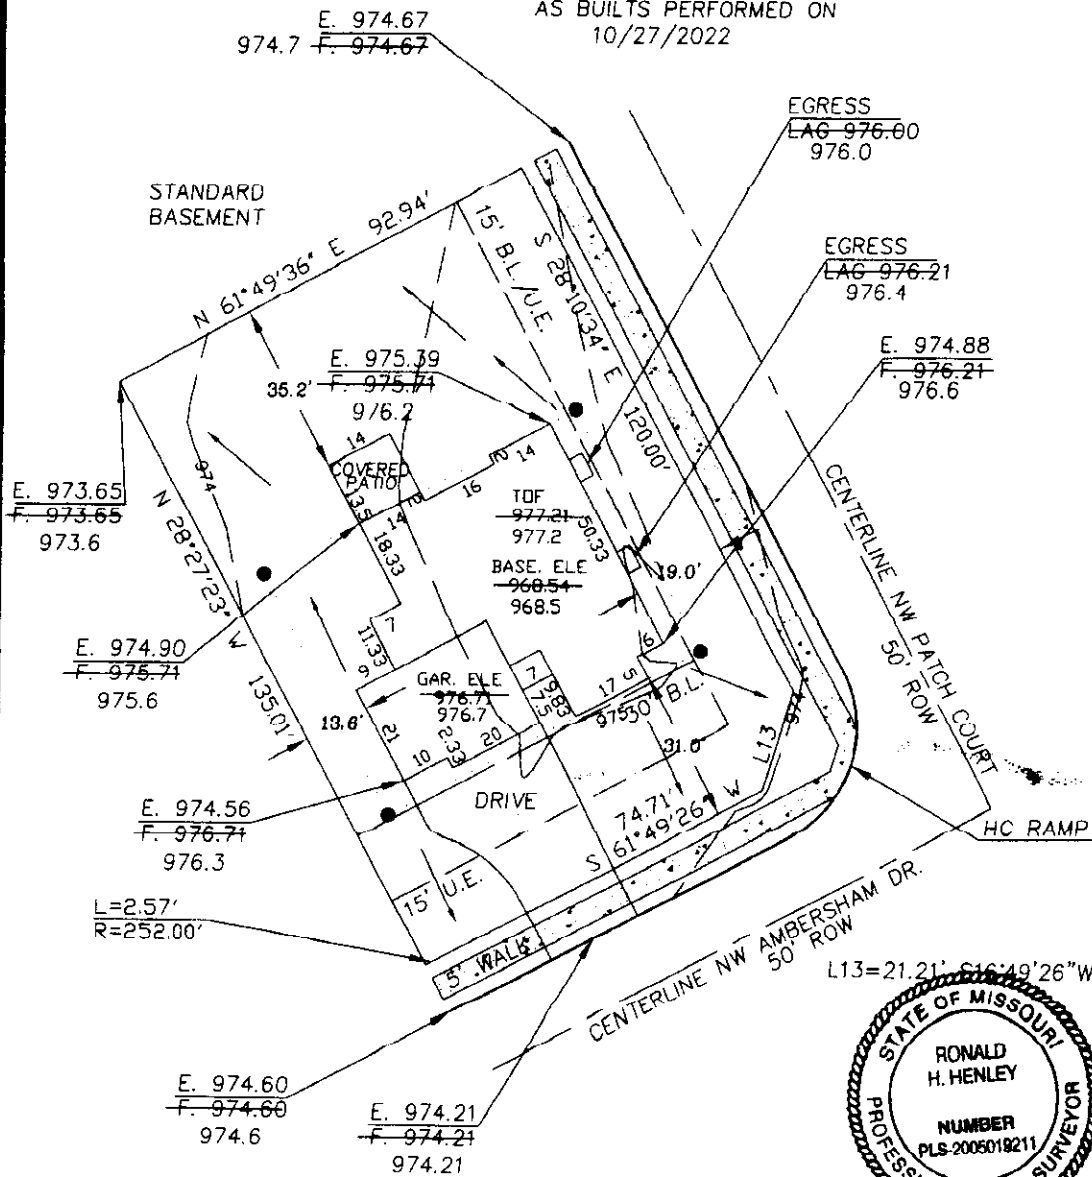

• = 6' O/S BAR (TYP)


**HENLEY  
SURVEY CO.**

PHONE: (816) 716-3254

This plot plan was prepared for use before and during foundation construction only. House staked as shown on plot plan. Contractor to check and verify house dimensions and elevations at job site. We are not responsible for unknown or platted easements of any kind unless we are furnished the description of said easements before the field work is performed. NOTE: Cuts shown hereon for excavation are a guide only. Final decision as to cuts and foundation height are to be made by builder on job site.



1" = 30' DATE: 12/28/20

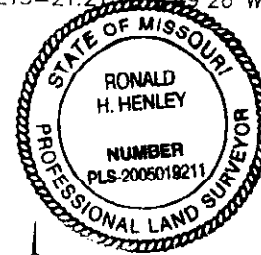

DIRECTION OF DRAINAGE →