


RELEASE FOR CONSTRUCTION  
AS NOTED FOR PLAN REVIEW  
DEVELOPMENT SERVICES  
LEE'S SUMMIT, MISSOURI  
12/08/2022

CONCRETE WALLS OVER 9-0 SHALL BE 9.5" WIDE

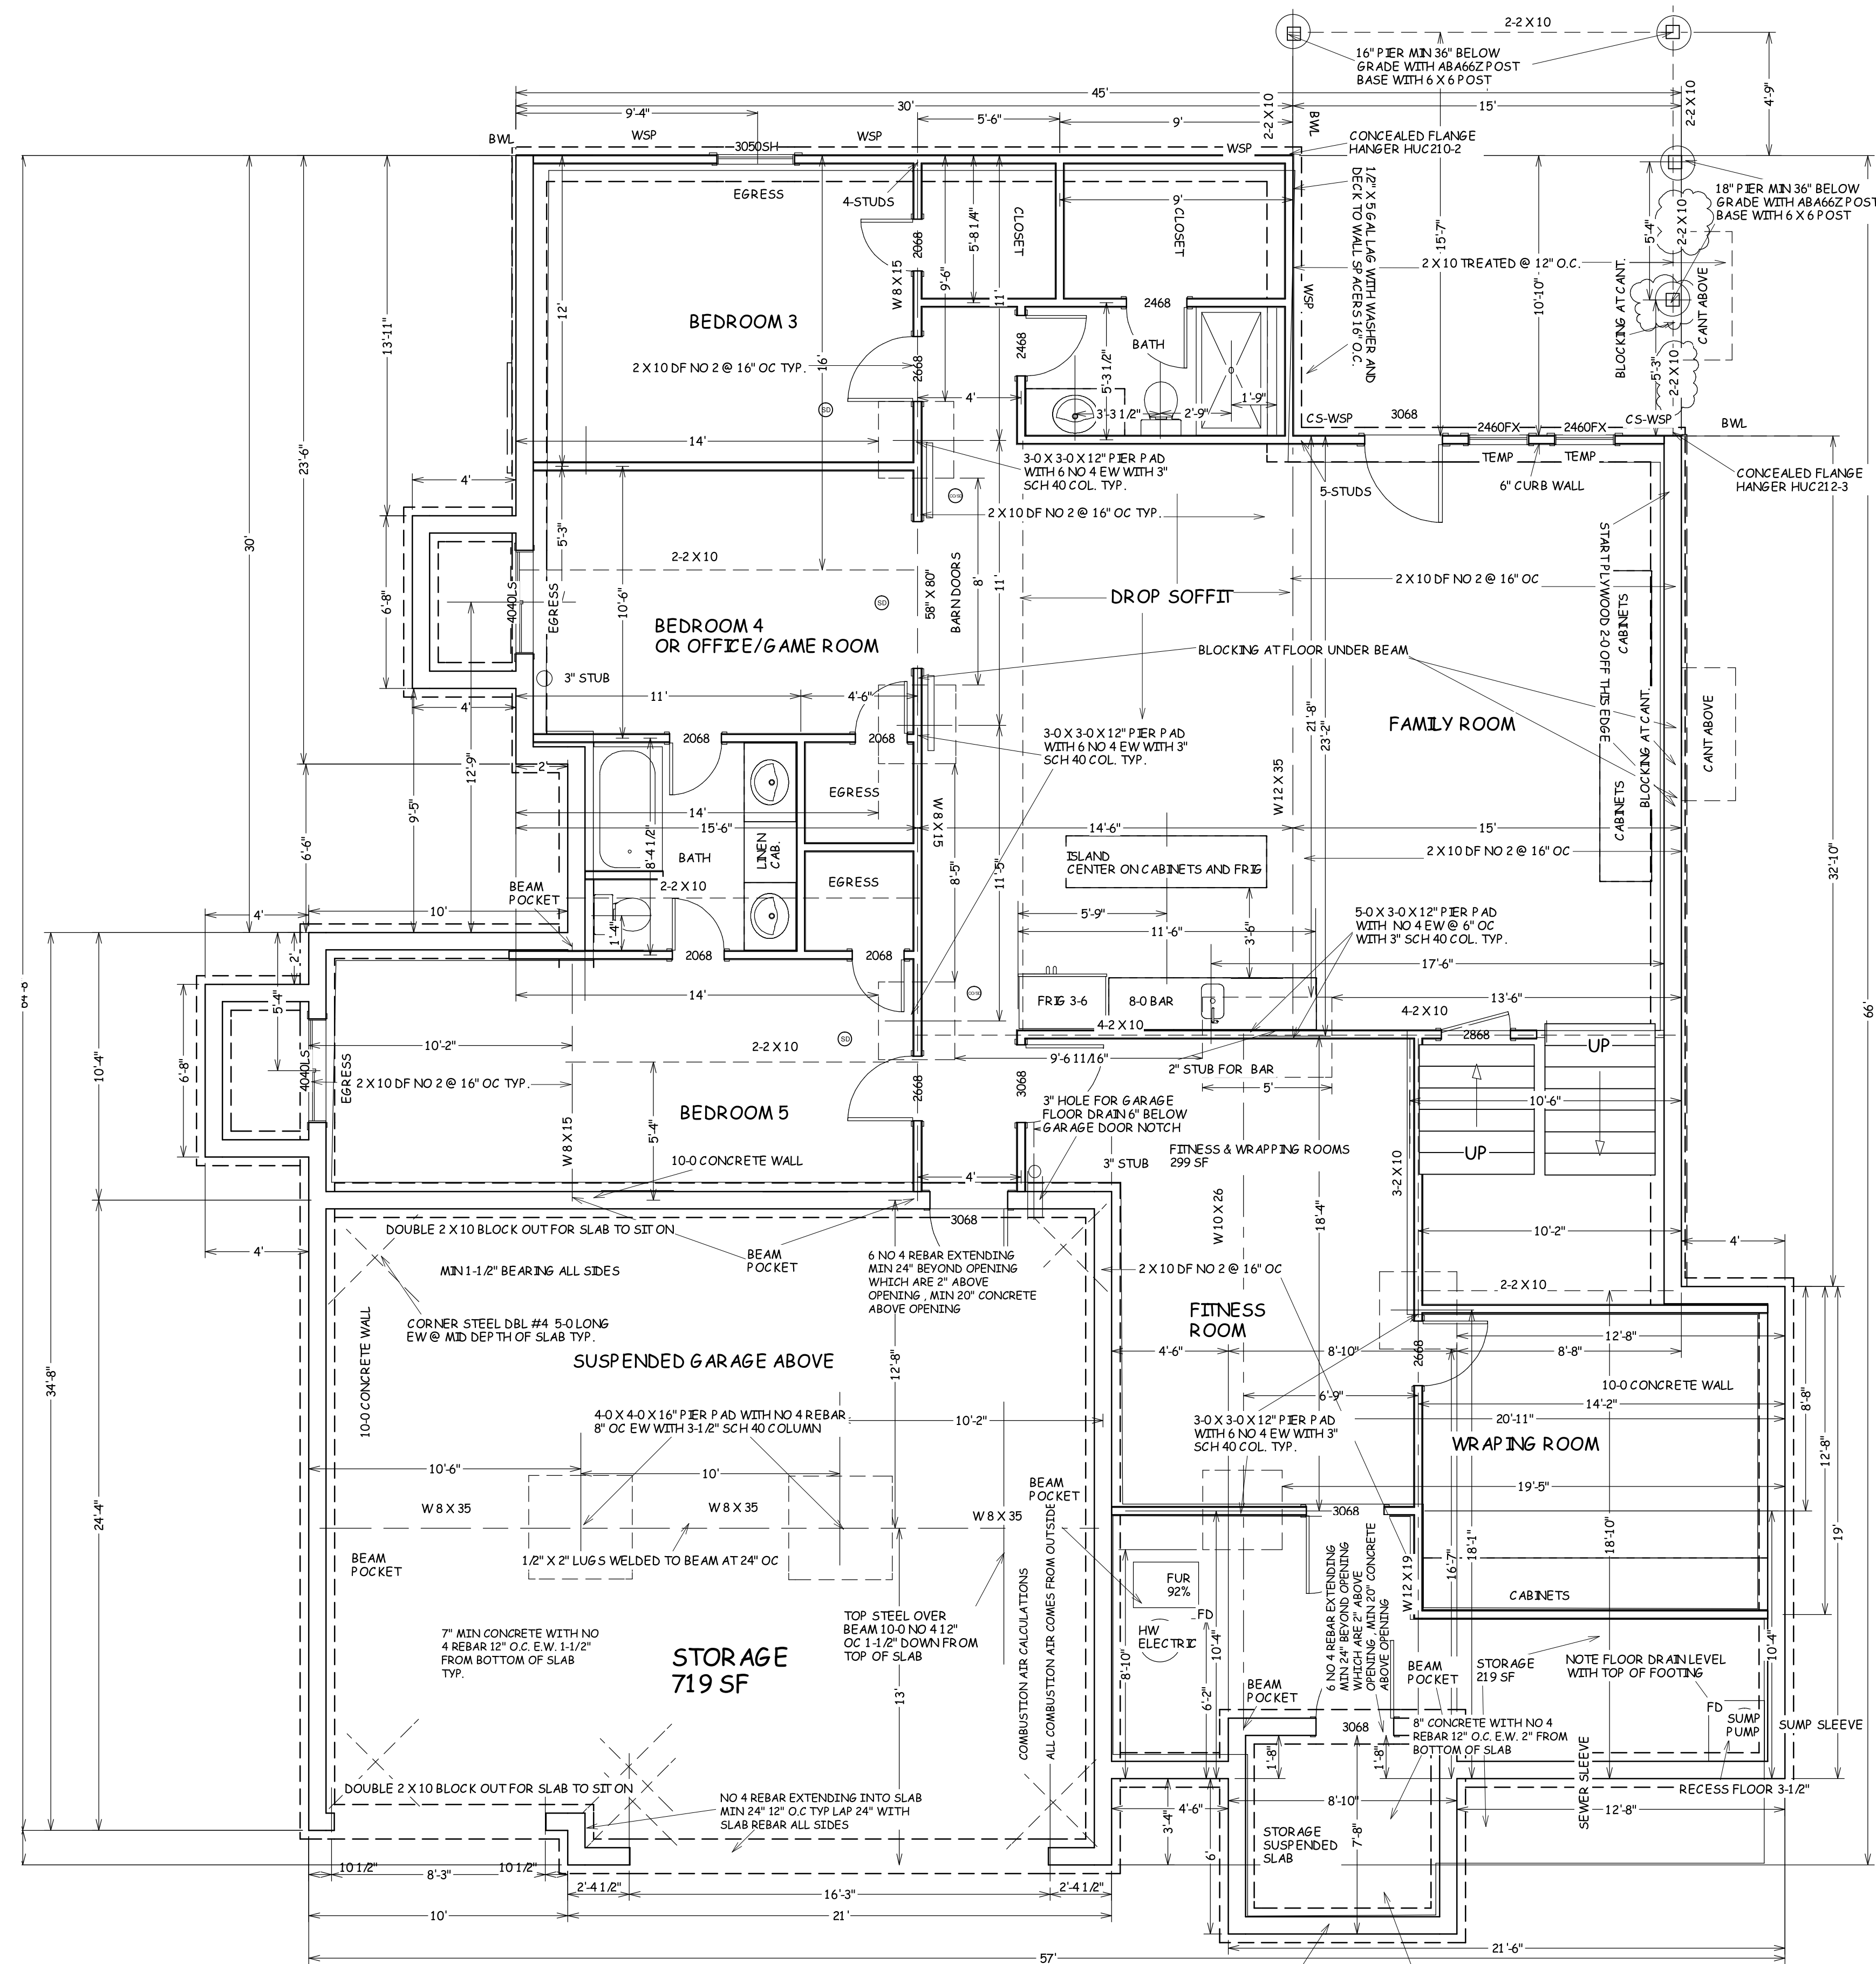

NOTE: BUILDER WILL  
CUT DOWN CONCRETE  
SIDE WALLS TO GRADE

SUSPENDED SLAB  
CONCRETE MIN 4,000 PSI  
GRADE 40 REBAR

FOUNDATION PLAN  
1804 SF FINISHED  
1058 SF UNFINISHED



BUILD IN ACCORDANCE WITH  
2018 INTERNATIONAL  
RESIDENTIAL CODE AND  
LOCAL CODES.

TRUMARK HOMES  
KYLE VI  
ELEVATION B  
LOT 167 WOODSIDE RESERVE  
2125 NW O BRIEN RD  
LEE SUMMIT MO

SCALE  
1/4" = 1'-0

DATE  
11-16-22

PLAN NO.  
3842

SHEET NO.

2 OF 5