

LEE'S SUMMIT LOGISTICS

43 I K SPEC BUILDING




NE TUDOR RD & MAIN ST
LEE'S SUMMIT, MO
64086
11.02.22

BUILD OUT CONSTRUCTION SET


OWNER
SCANNELL PROPERTIES
8801 RIVER CROSSING BLVD, SUITE 300
INDIANAPOLIS, IN 46240
O : 317 . 218 . 1648

CIVIL ENGINEER
OLLSON
7301 W. 133RD ST. SUITE 200
OVERLAND PARK, KS 66213
O : 913 . 381 . 1170

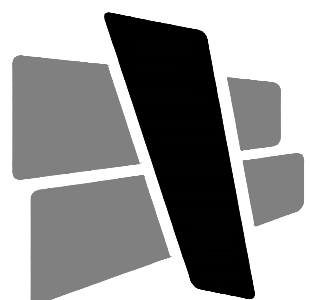ARCHITECT

CURRAN
ARCHITECTURE
5719 LAWTON LOOP E. DR. #212
INDIANAPOLIS, IN 46216
O : 317 . 288 . 0681
CONTACT : SHAWN CURRAN

STRUCTURAL ENGINEER
WALLACE DESIGN
COLLECTIVE
1741 MCGEE STREET
KANSAS CITY, MO 64108
O : 816 . 421 . 8282

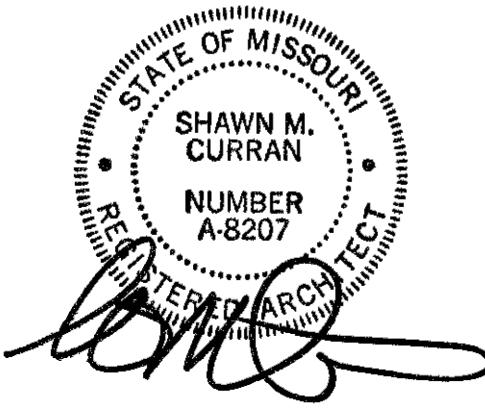CONTRACTOR
KADEAN CONSTRUCTION
1821 MCGEE STREET
KANSAS CITY, MO 64108
O : 816 . 708 . 1199



LEE'S SUMMIT LOGISTICS 43 I K SPEC
210300

DRAWINGS INDEX SHELL CONT

TILT-UP PANEL

T1.1	TILT-UP PANEL PLAN
T1.2	TILT-UP PANEL PLAN
T1.3	TILT-UP PANEL PLAN
T1.4	TILT-UP PANEL PLAN
T1.5	TILT-UP PANEL PLAN
T1.6	TILT-UP PANEL PLAN
T1.7	TILT-UP PANEL PLAN
T1.8	TILT-UP PANEL PLAN
T1.9	TILT-UP PANEL PLAN
T1.10	TILT-UP PANEL PLAN
T1.11	TILT-UP PANEL PLAN
T2.1	TILT-UP PANEL ELEVATIONS
T2.2	TILT-UP PANEL ELEVATIONS
T3.1	TILT-UP PANEL DETAILS
T4.1	TILT-UP PANEL REINFORCING LAYOUT
T4.2	TILT-UP PANEL REINFORCING LAYOUT
T4.3	TILT-UP PANEL REINFORCING LAYOUT
T4.4	TILT-UP PANEL REINFORCING LAYOUT
T4.5	TILT-UP PANEL REINFORCING LAYOUT
T4.6	TILT-UP PANEL REINFORCING LAYOUT

DRAWINGS INDEX SHELL

COVER

CIVIL ENGINEERING

C200 SITE PLAN

ARCHITECTURAL

A001	SCOPE NOTES & CODE SUMMARY
A002	TYPICAL ACCESSIBILITY DETAILS
A100	LIFE SAFETY PLAN
A101	OVERALL FLOOR PLAN
A102	FLOOR PLAN - AREA A
A103	FLOOR PLAN - AREA B
A104	FLOOR PLAN - AREA C
A105	FLOOR PLAN - AREA D
A106	FLOOR PLAN - AREA E
A107	FLOOR PLAN - AREA F
A120	ROOF PLAN
A200	OVERALL EXTERIOR ELEVATIONS
A201	EXTERIOR ELEVATIONS
A202	EXTERIOR ELEVATIONS
A203	EXTERIOR ELEVATIONS
A204	EXTERIOR ELEVATIONS
A205	EXTERIOR ELEVATIONS
A206	EXTERIOR ELEVATIONS
A207	EXTERIOR ELEVATIONS
A301	WALL SECTIONS
A302	WALL SECTIONS
A303	WALL SECTIONS
A304	WALL SECTIONS
A305	RATED WALL INFORMATION
A501	TYPICAL TILT WALL BUILDING DETAILS
A502	TYPICAL TILT WALL BUILDING DETAILS
A503	TYPICAL TILT WALL BUILDING DETAILS
A601	DOOR SCHEDULE & STOREFRONT ELEVATIONS

STRUCTURAL

S0.0	GENERAL NOTES
S0.1	GENERAL NOTES
S1.0	OVERALL FOUNDATION PLAN
S1.1	ENLARGED PARTIAL FOUNDATION PLAN
S1.2	ENLARGED PARTIAL FOUNDATION PLAN
S1.3	ENLARGED PARTIAL FOUNDATION PLAN
S1.4	ENLARGED PARTIAL FOUNDATION PLAN
S2.0	OVERALL ROOF FRAMING PLAN
S2.1	ENLARGED PARTIAL FRAMING PLAN
S2.2	ENLARGED PARTIAL FRAMING PLAN
S2.3	ENLARGED PARTIAL FRAMING PLAN
S2.4	ENLARGED PARTIAL FRAMING PLAN
S2.5	ROOF DECK ATTACHMENT PLAN
S2.6	LATERAL LOAD PLAN
S3.0	FOUNDATION DETAILS
S3.1	FOUNDATION DETAILS
S3.2	FOUNDATION DETAILS
S3.3	FOUNDATION DETAILS
S4.0	FRAMING DETAILS
S4.1	FRAMING DETAILS
S4.2	FRAMING DETAILS
S4.3	FRAMING DETAILS

MECHANICAL

M1.1	OVERALL MECHANICAL PLAN
M2.1	MECHANICAL DETAILS & SPECIFICATIONS
M3.1	MECHANICAL SCHEDULES

PLUMBING


P0.0	PLUMBING SPECIFICATIONS
P100	PARTIAL PLUMBING FLOOR PLAN UNIT A
P101	PARTIAL PLUMBING FLOOR PLAN UNIT B
P102	PARTIAL PLUMBING FLOOR PLAN UNIT C
P103	PARTIAL PLUMBING FLOOR PLAN UNIT D
P104	PARTIAL PLUMBING FLOOR PLAN UNIT E
P105	PARTIAL PLUMBING FLOOR PLAN UNIT F
P106	PLUMBING SPECIFICATIONS

ELECTRICAL

E1.00	LIGHTING PLAN
E2.00	POWER PLAN
E4.00	PHOTOMETRIC PLAN
E5.00	SITE LIGHTING PLAN
E6.00	ONE LINE DIAGRAM
E7.00	PANEL SCHEDULES

FIRE PROTECTION

FP0.0	SYSTEM NOTES
FP1.0	HYDRAULIC SITE PLAN
FP2.0	OVERHEAD PIPING LAYOUT
FP2.1.1	AREA 1 SYSTEMS 01-02
FP2.1.2	AREA 1 SYSTEMS CONT. 01-02
FP2.1.3	AREA 2 SYSTEMS 02-03
FP2.1.4	AREA 2 SYSTEMS CONT. 02-03
FP2.1.5	AREA 3 SYSTEMS 03-04
FP2.1.6	AREA 3 SYSTEMS CONT. 03-04
FP2.1.7	AREA 4 SYSTEMS 05
FP2.1.8	AREA 5 SYSTEMS 06
FP2.1.9	AREA 6 SYSTEMS 07
FP2.1.10	AREA 7 SYSTEMS 08-09
FP2.1.11	AREA 7 SYSTEMS CONT. 08-09
FP2.1.12	AREA 8 SYSTEMS 09-10
FP2.1.13	AREA 8 SYSTEMS CONT. 09-10
FP2.1.14	AREA 9 SYSTEMS 10-11
FP2.1.15	AREA 9 SYSTEMS CONT. 10-11
FP2.1.16	AREA 10 SYSTEMS 11-12
FP2.1.17	AREA 10 SYSTEMS CONT. 11-12
FP2.1.18	AREA 11 SYSTEMS 12-13
FP2.1.19	AREA 11 SYSTEMS CONT. 12-13
FP2.1.20	AREA 12 SYSTEMS 13-14
FP2.1.21	AREA 12 SYSTEMS CONT. 13-14
FP2.1.22	AREA 13 SYSTEMS 14-15
FP2.1.23	AREA 13 SYSTEMS CONT. 14-15
FP2.1.24	AREA 14 SYSTEMS 15-16
FP2.1.25	AREA 14 SYSTEMS CONT. 15-16
FP2.1.26	AREA 15 SYSTEMS 16-17
FP2.1.27	AREA 15 SYSTEMS CONT. 16-17
FP2.1.28	AREA 16 SYSTEMS 17-18
FP2.1.29	AREA 16 SYSTEMS CONT. 17-18
FP2.1.30	AREA 17 SYSTEMS 18-19
FP2.1.31	AREA 17 SYSTEMS CONT. 18-19
FP2.1.32	AREA 18 SYSTEMS 19-20
FP2.1.33	AREA 18 SYSTEMS CONT. 19-20
FP2.1.34	AREA 19 SYSTEMS 20-21
FP2.1.35	AREA 19 SYSTEMS CONT. 20-21
FP2.1.36	AREA 20 SYSTEMS 21-22
FP2.1.37	AREA 20 SYSTEMS CONT. 21-22
FP2.1.38	AREA 21 SYSTEMS 22-23
FP2.1.39	AREA 21 SYSTEMS CONT. 22-23
FP2.1.40	AREA 22 SYSTEMS 23-24
FP2.1.41	AREA 22 SYSTEMS CONT. 23-24
FP2.1.42	AREA 23 SYSTEMS 24-25
FP2.1.43	AREA 23 SYSTEMS CONT. 24-25
FP2.1.44	AREA 24 SYSTEMS 25-26
FP2.1.45	AREA 24 SYSTEMS CONT. 25-26
FP2.1.46	AREA 25 SYSTEMS 26-27
FP2.1.47	AREA 25 SYSTEMS CONT. 26-27
FP2.1.48	AREA 26 SYSTEMS 27-28
FP2.1.49	AREA 26 SYSTEMS CONT. 27-28
FP2.1.50	AREA 27 SYSTEMS 28-29
FP2.1.51	AREA 27 SYSTEMS CONT. 28-29
FP2.1.52	AREA 28 SYSTEMS 29-30
FP2.1.53	AREA 28 SYSTEMS CONT. 29-30
FP2.1.54	AREA 29 SYSTEMS 30-31
FP2.1.55	AREA 29 SYSTEMS CONT. 30-31
FP2.1.56	AREA 30 SYSTEMS 31-32
FP2.1.57	AREA 30 SYSTEMS CONT. 31-32
FP2.1.58	AREA 31 SYSTEMS 32-33
FP2.1.59	AREA 31 SYSTEMS CONT. 32-33
FP2.1.60	AREA 32 SYSTEMS 33-34
FP2.1.61	AREA 32 SYSTEMS CONT. 33-34
FP2.1.62	AREA 33 SYSTEMS 34-35
FP2.1.63	AREA 33 SYSTEMS CONT. 34-35
FP2.1.64	AREA 34 SYSTEMS 35-36
FP2.1.65	AREA 34 SYSTEMS CONT. 35-36
FP2.1.66	AREA 35 SYSTEMS 36-37
FP2.1.67	AREA 35 SYSTEMS CONT. 36-37
FP2.1.68	AREA 36 SYSTEMS 37-38
FP2.1.69	AREA 36 SYSTEMS CONT. 37-38
FP2.1.70	AREA 37 SYSTEMS 38-39
FP2.1.71	AREA 37 SYSTEMS CONT. 38-39
FP2.1.72	AREA 38 SYSTEMS 39-40
FP2.1.73	AREA 38 SYSTEMS CONT. 39-40
FP2.1.74	AREA 39 SYSTEMS 40-41
FP2.1.75	AREA 39 SYSTEMS CONT. 40-41
FP2.1.76	AREA 40 SYSTEMS 41-42
FP2.1.77	AREA 40 SYSTEMS CONT. 41-42
FP2.1.78	AREA 41 SYSTEMS 42-43
FP2.1.79	AREA 41 SYSTEMS CONT. 42-43
FP2.1.80	AREA 42 SYSTEMS 43-44
FP2.1.81	AREA 42 SYSTEMS CONT. 43-44
FP2.1.82	AREA 43 SYSTEMS 44-45
FP2.1.83	AREA 43 SYSTEMS CONT. 44-45
FP2.1.84	AREA 44 SYSTEMS 45-46
FP2.1.85	AREA 44 SYSTEMS CONT. 45-46
FP2.1.86	AREA 45 SYSTEMS 46-47
FP2.1.87	AREA 45 SYSTEMS CONT. 46-47
FP2.1.88	AREA 46 SYSTEMS 47-48
FP2.1.89	AREA 46 SYSTEMS CONT. 47-48
FP2.1.90	AREA 47 SYSTEMS 48-49
FP2.1.91	AREA 47 SYSTEMS CONT. 48-49
FP2.1.92	AREA 48 SYSTEMS 49-50
FP2.1.93	AREA 48 SYSTEMS CONT. 49-50
FP2.1.94	AREA 49 SYSTEMS 50-51
FP2.1.95	AREA 49 SYSTEMS CONT. 50-51
FP2.1.96	AREA 50 SYSTEMS 51-52
FP2.1.97	AREA 50 SYSTEMS CONT. 51-52
FP2.1.98	AREA 51 SYSTEMS 52-53
FP2.1.99	AREA 51 SYSTEMS CONT. 52-53
FP2.2.0	FIRE PUMP AND RISER DETAIL

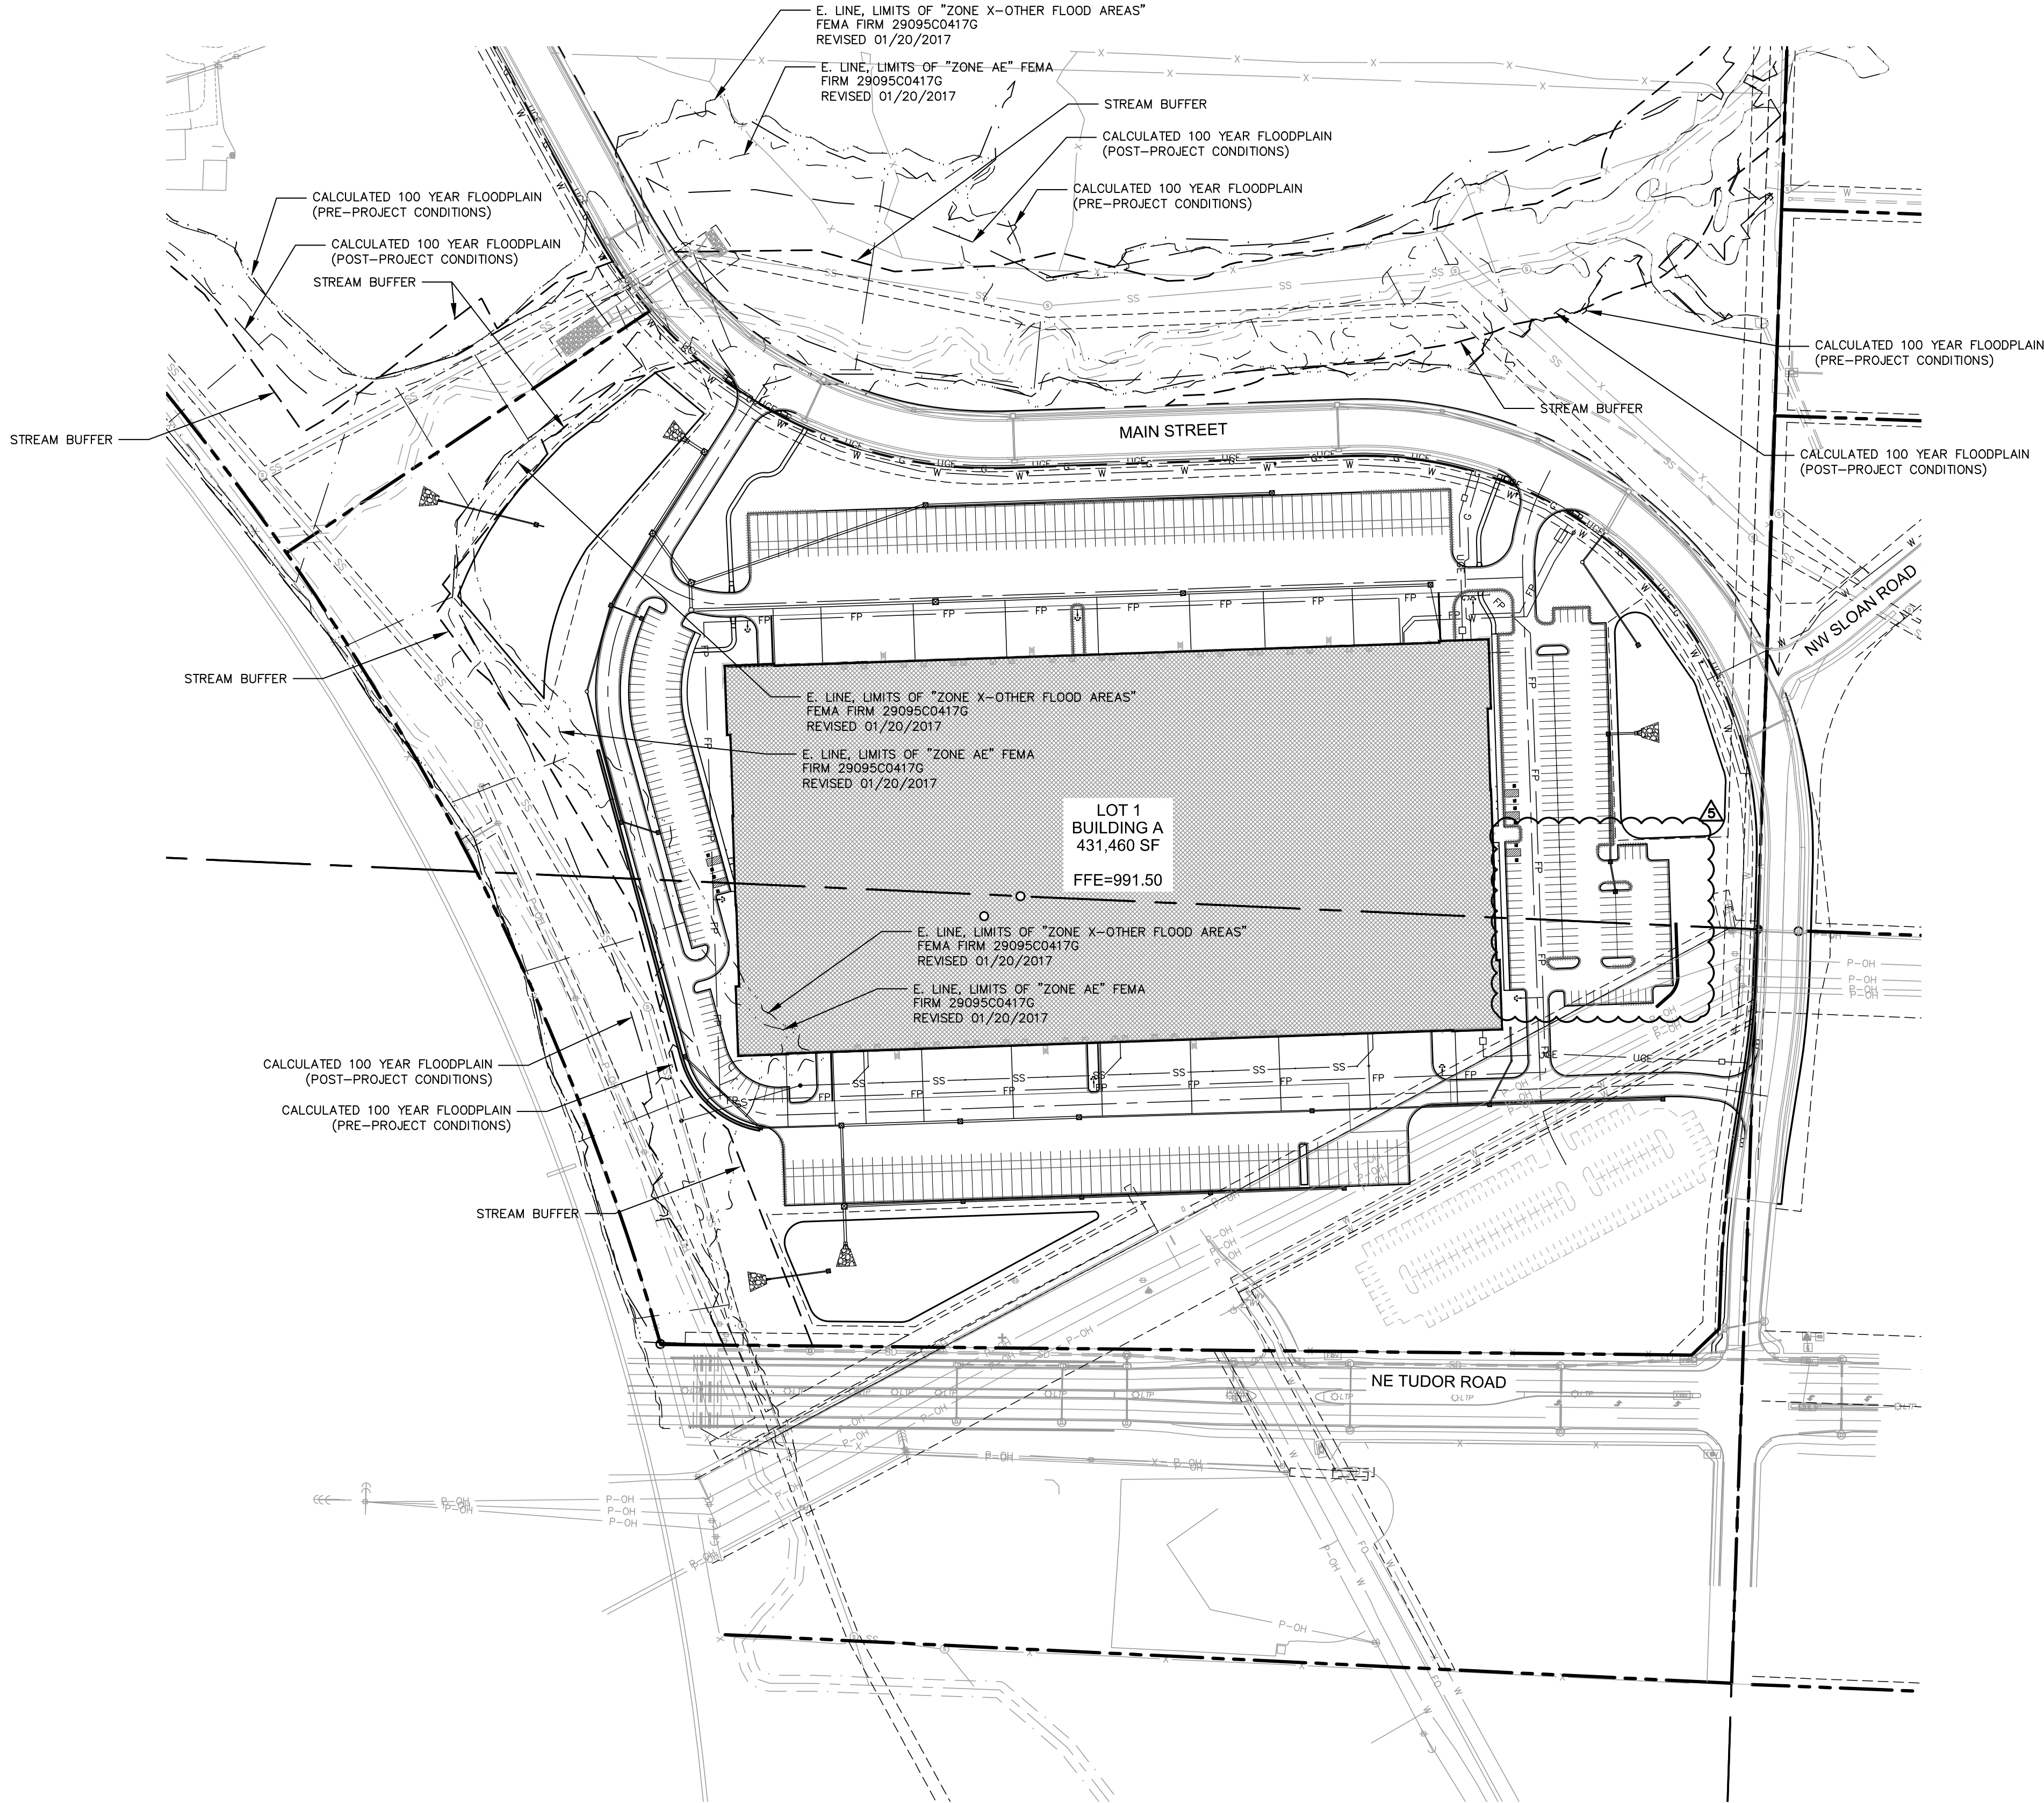

BUILDING & SITE DATA							
ZONING							
NO. OF STORIES	BLDG HEIGHT	USE	BUILDING SQ. FT.	PARKING REQUIRED	PARKING PROVIDED	FLOOR AREA RATIO	LOT AREA
1	48 FT	BUILDING A WAREHOUSE	431,460 S.F.	1 STALL PER 1000 SF (432 STALLS)	320 STALLS (159 FUTURE STALLS)	0.26	37.90 ACRES
LOT 1 PROPOSED OPEN SPACE= 788,745 S.F. (18.107 ACRES) 47.86%							
REQUIRED OPEN SPACE= REFERENCE LANDSCAPE PLAN							
LOT 1 PROPOSED IMPERVIOUS AREA= 858,965 S.F. (19.719 ACRES)							

PROPERTY OWNER/ DEVELOPER

SCANNELL PROPERTIES #603, LLC
5801 RIVER CROSSING BLVD, SUITE 300
INDIANAPOLIS, IN 46240
PH: 317-218-1648

ENGINEER/ LANDSCAPE ARCHITECT

OLSSON
7301 W. 133RD STREET, SUITE 200
OVERLAND PARK, KS 66213
PH: 913-381-1170
F: 913-381-1174



PROPOSED SITE USE

INDUSTRIAL

EXISTING & PROPOSED ZONING

SITE AREA

NET SITE AREA= 3,439,837 SQ. FT., (78.9678 AC±)

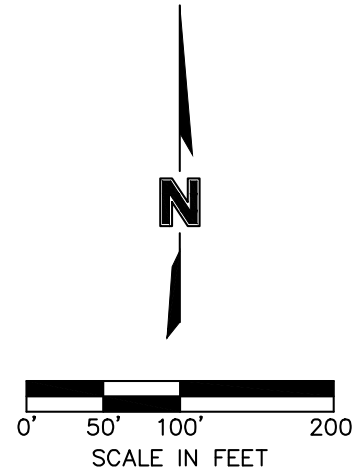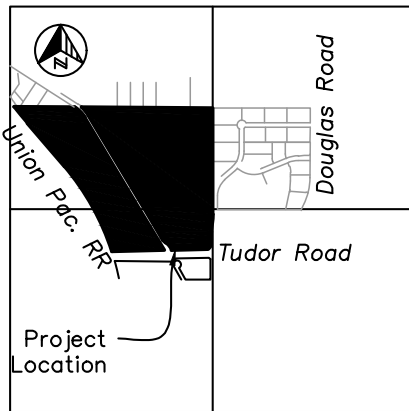

LEGEND	
	PROPERTY LINE
	SECTION LINE
	FEMA FLOOD PLAIN LIMITS
	LOT LINE
	FENCE

PROPERTY DESCRIPTION


All that part of an unplatted tract of land, together with all that part of North Main Street right of way, all lying in the West Half of Section 31, Township 48 North, Range 31 West, lying in the City of Lee's Summit, Jackson County, Missouri, described by Patrick Ethan Ward, MO PLS-20050071, of Olsson MOLC-366, on October 14, 2021, as follows:

BEGINNING at the Northeast corner of the Southwest Quarter of Section 31, Township 48 North, Range 31 West; thence South 01 degree 59 minutes 47 seconds West, on the East line of said Southwest Quarter, a distance of 65.98 feet to a point on the West line of NW Sloan Street right of way, as established in Document 2013E0075031, said point also lying on a non-tangent curve; thence in a Southerly direction, departing said East line, on said West line and on a curve to the right whose initial tangent bears South 02 degrees 47 minutes 37 seconds West, having a radius of 970.00 feet, through a central angle of 6 degrees 27 minutes 07 seconds, an arc distance of 109.23 feet to a point of tangency; thence South 09 degrees 14 minutes 44 seconds West, continuing on said West line, a distance of 111.80 feet to a point of curvature; thence in a Southerly direction, continuing on said West line and on a curve to the left, having a radius of 1030.00 feet, through a central angle of 7 degrees 14 minutes 57 seconds, an arc distance of 130.32 feet to a point of tangency; thence South 01 degree 59 minutes 47 seconds West, continuing on said West line, a distance of 69.49 feet to a point on the North line of NE Tudor Road right of way, as established in said Document 2013E0075031; thence South 46 degrees 15 minutes 48 seconds West, departing said West line, on said North line, a distance of 46.09 feet to a point; thence North 89 degrees 24 minutes 16 seconds West, continuing on said North line, and on the North line of NW Tudor Road right of way, as established in Document 2013E0075030, a distance of 1249.23 feet to a point on the East line of Union Pacific Railroad right of way, as now established, said point also lying on a non-tangent curve; thence in a Northerly and Northwesterly direction, departing said North line, on said East line and on a curve to the left whose initial tangent bears North 15 degrees 40 minutes 27 seconds West, having a radius of 3203.90 feet, through a central angle of 22 degrees 48 minutes 11 seconds, an arc distance of 1275.12 feet to a point of tangency; thence North 38 degrees 34 minutes 39 seconds West, continuing on said East line, a distance of 738.40 feet to a point of curvature; thence in a Northwesterly direction, continuing on said East line and on a curve to the right, having a radius of 5981.13 feet, through a central angle of 2 degrees 39 minutes 22 seconds, an arc distance of 277.27 feet to a point on the North line of the South Half of the Northwest Quarter of said Section 31, said point also lying on a non-tangent line; thence South 87 degrees 40 minutes 30 seconds East, departing said East line, on said North line, a distance of 884.17 feet to a point on a non-tangent curve; thence in a Southeasterly direction, departing said North line, on a curve to the right whose initial tangent bears South 45 degrees 29 minutes 38 seconds East, having a radius of 544.00 feet, through a central angle of 16 degrees 50 minutes 44 seconds, an arc distance of 159.94 feet to a point of tangency; thence South 28 degrees 38 minutes 55 seconds East a distance of 437.58 feet to a point of curvature; thence in a Southeasterly and Easterly direction, on a curve to the left, having a radius of 476.00 feet, through a central angle of 63 degrees 19 minutes 59 seconds, an arc distance of 526.16 feet to a point of tangency; thence North 88 degrees 01 minute 06 seconds East a distance of 416.85 feet to a point of curvature; thence in an Easterly and Southeasterly direction, on a curve to the right, having a radius of 544.00 feet, through a central angle of 65 degrees 51 minutes 08 seconds, an arc distance of 625.24 feet to a point on a non-tangent line, said point also lying on the East line of said Northwest Quarter; thence South 01 degree 53 minutes 30 seconds West, on said East line, a distance of 338.00 feet to the POINT OF BEGINNING, containing 2,375,437 Square Feet or 54.5325 Acres, more or less.


GENERAL LAYOUT PLAN		REVISIONS	
REV. NO.	DATE	REVISION DESCRIPTION	BY
1	12/04/2021	CITY COMMENTS	
2	02/03/2022	OWNER CHANGES	
3	02/03/2022	CITY & ENERGY COMMENTS	
4	02/24/2022	CITY COMMENTS	
5	06/15/2022	COMMENTS & SHIPS	
6	06/15/2022	WARRANTY REPORT	
			2021

SCANNELL DEVELOPMENT LEE'S SUMMIT LOGISTICS	
NORTHWEST CORNER OF TUDOR ROAD AND MAIN STREET	
LEE'S SUMMIT, MISSOURI	

drawn by:	OLSSON
checked by:	ENG
approved by:	ENG
QA/QC by:	ENG
project no.:	021-04157
drawing #:	GLP01_02104157.dwg
date:	

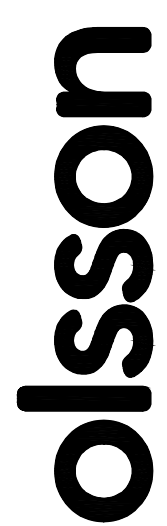

7301 West 133rd Street, Suite 200
Overland Park, KS 66215-4750
TEL 913.381.1170
www.olsson.com

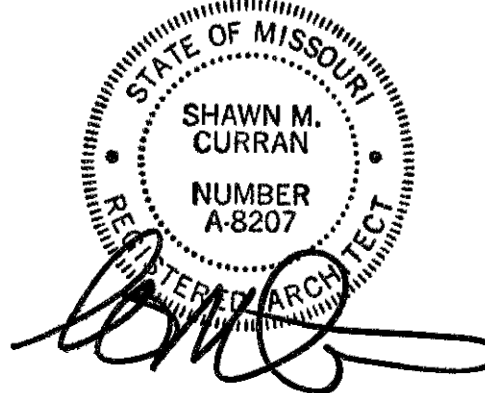

THIS DRAWING AND THE IDEAS, DESIGNS AND CONCEPTS CONTAINED HEREIN ARE THE EXCLUSIVE INTELLECTUAL PROPERTY OF CURRAN ARCHITECTURE, AND ARE NOT TO BE USED OR REPRODUCED, WHOLE OR IN PART, WITHOUT THE WRITTEN CONSENT OF CURRAN ARCHITECTURE.
© COPYRIGHT 2021, CURRAN ARCHITECTURE

PROJECT INFORMATION

LEE'S SUMMIT LOGISTICS
BUILDING A LOT I

NW CORNER OF
NE TUDOR RD & MAIN ST
LEE'S SUMMIT, MO 64086

ISSUE DATES

PERMIT SET	02.18.22
PERMIT REVIEW COMMENTS	05.16.22
VE REVISIONS	12.20.22

210300

SCOPE NOTES

A001

SYMBOLS

(NOT ALL MAY APPLY)

	KEYED NOTE
	WINDOW OR GLAZED OPENING TAG IF WINDOW - WH IF STOREFRONT - SF# IF CURTAINWALL - CWH
	ACCESSORY TAG
	EQUIPMENT TAG
	FINISH TAG
	ROOM TAG
	ELEVATION TAG - INTERIOR OR EXTERIOR
	SECTION CUT AT AREAS SHOWN SMALL SCALE
	ENLARGED PLAN
	ELEVATION TARGET. FINISHED FLOOR = 0'-0" UNO
	REVISION
	PLAN OR TRUE NORTH
	BATT INSULATION - WIDTH OF FRAMING UNO
	FIRE EXTINGUISHER IN SEMI-RECESSED CABINET PROVIDED / INSTALLED BY GC
	SURFACE MOUNTED FIRE EXTINGUISHER PROVIDED / INSTALLED BY GC
	DOOR WITH DOOR NUMBER
	WINDOW OR GLAZED OPENING
	STUD FRAMED WALL - REFER TO INDEX SHEET FOR INFORMATION
	CMU WALL - REFER TO SECTIONS AND DETAILS
	BRICK WALL - REFER TO SECTIONS AND DETAILS
	CONCRETE WALL - REFER TO SECTIONS AND DETAILS
	EIFS OVER SUBSTRATE - REFER TO SECTIONS FOR WIDTH AND PROFILE
	EXISTING DOOR - REFER TO DOOR SCHEDULE
	EXISTING FRAMED WALL
	EXISTING WINDOW WITH SILL AND / OR STOOL
	DEMO'D DOOR
	DEMO'D WALL
	WALL TYPE WALL HEIGHT IF DESIGNATED ON PLANS. IF NOT, SEE WALL TYPES THIS SHEET

ABBREVIATIONS

PS	PROJECTION SCREEN	FLR	FLOOR	PS	PROJECTION SCREEN
QT	QUARRY TILE	FR	FIRE RETARDANT	QT	QUARRY TILE
R	RISER	FT	FEET	R	RISER
RA	RETURN AIR	GA	GAUGE	RA	RETURN AIR
RB	RESILIENT BASE	GB	GRAB BAR	RB	RESILIENT BASE
RD	ROOF DRAIN	GC	GENERAL CONTRACTOR	RD	ROOF DRAIN
REF	REFERENCE	GYP BD	GYPSUM BOARD	REF	REFERENCE
REFR	REFRIGERATOR	HDWR	HARDWARE	REFR	REFRIGERATOR
REQD	REQUIRED	HGT	HEIGHT	REQD	REQUIRED
RO	ROUGH OPENING	HM	HOLLOW METAL	RO	ROUGH OPENING
SA	SUPPLY AIR	HORIZ	HORIZONTAL	SA	SUPPLY AIR
SCHED	SCHEDULE	HP	HIGH POINT	SCHED	SCHEDULE
SCMD	SOLID CORE METAL DOOR	HVAC	HEATING, VENTILATING, AIR CONDITIONING	SCMD	SOLID CORE METAL DOOR
SCVD	SOLID CORE WOOD DOOR	HW	HOT WATER	SCVD	SOLID CORE WOOD DOOR
SEC	SECTION	INSUL	INSULATION	SEC	SECTION
SF	SQUARE FOOT	JAN	JANITOR	SF	SQUARE FOOT
SM	SIMILAR	JST	JOIST	SM	SIMILAR
SPECS	SPECIFICATIONS	JT	JOINT	SPECS	SPECIFICATIONS
SQ	SQUARE	KD	KNOCKDOWN	SQ	SQUARE
SS	STAINLESS STEEL	KIT	KITCHEN	SS	STAINLESS STEEL
STD	STANDARD	LAM	LAMINATE	STD	STANDARD
STL	STEEL	LAV	LAVATORY	STL	STEEL
STOR	STORAGE	LLH	LONG LEG HORIZONTAL	STOR	STORAGE
STRUCT	STRUCTURAL	LLV	LONG LEG VERTICAL	STRUCT	STRUCTURAL
SUSP	SUSPENDED	MAS	MASONRY	SUSP	SUSPENDED
TB	TACK BOARD	MAT	MATERIAL	TB	TACK BOARD
TEL	TELEPHONE	MAX	MAXIMUM	TEL	TELEPHONE
TLT	TOILET	MB	MARKER BOARD	TLT	TOILET
T.O.	TOP OF	MECH	MECHANICAL	T.O.	TOP OF
TRTD	TREATED	MEZZ	MEZZANINE	TRTD	TREATED
TV	TELEVISION	MFR	MANUFACTURER	TV	TELEVISION
TYT	TYPICAL	MIN	MINIMUM	TYT	TYPICAL
UNO	UNLESS NOTED OTHERWISE	MO	MASONRY OPENING	UNO	UNLESS NOTED OTHERWISE
UR	URNAL	MTL	METAL	UR	URNAL
YCT	VINYL COMPOSITION TILE	NIC	NOT IN CONTRACT	YCT	VINYL COMPOSITION TILE
VERT	VERTICAL	NR	NOT RATED	VERT	VERTICAL
VIF	VERIFY IN FIELD	OC	ON CENTER	VIF	VERIFY IN FIELD
VT	VINYL TILE	OD	OUTSIDE DIAMETER	VT	VINYL TILE
W/	WITH	OFD	OVERFLOW DRAIN	W/	WITH
W/O	WITHOUT	OH	OPPOSITE HAND	W/O	WITHOUT
WB	WOOD BASE	OPNG	OPENING	WB	WOOD BASE
WC	WATER CLOSET	OPP	OPPOSITE	WC	WATER CLOSET
WD	WOOD	OTO	OUT TO OUT	WD	WOOD
WH	WATER HEATER	PLAS LAM	PLASTIC LAMINATE	WH	WATER HEATER
WP	WORKING POINT	PLWD	PLYWOOD	WP	WORKING POINT

SCOPE NOTES

IN THE EVENT OF QUESTIONS REGARDING THE CONTRACT DOCUMENTS, SPECIFICATIONS, EXISTING CONDITIONS OR DESIGN INTENT, THE CONTRACTOR SHALL BE RESPONSIBLE FOR OBTAINING CLARIFICATION FROM THE ARCHITECT PRIOR TO BID SUBMITTAL AND PROCEEDING WITH ANY WORK IN QUESTION.

THESE CONTRACT DOCUMENTS ARE INTENDED TO DESCRIBE ONLY THE SCOPE AND APPEARANCE OF THE REAL PROPERTY IMPROVEMENTS, INCLUDING THE PERFORMANCE AND LEVEL OF QUALITY EXPECTED OF ITS COMPONENTS. IT IS THE CONTRACTOR'S RESPONSIBILITY TO INSURE THAT ALL WORK COMPLETED AND MATERIALS INSTALLED BE IN FULL COMPLIANCE AT A MINIMUM, WITH ALL APPLICABLE CODES, REGULATIONS, AND ORDINANCES HAVING JURISDICTIONAL AUTHORITY OVER THE PROJECT.

THESE CONTRACT DOCUMENTS DO NOT ATTEMPT TO INSTRUCT THE CONTRACTOR IN THE DETAILS OF HIS TRADE. THEY ARE PERFORMANCE SPECIFICATIONS IN THAT THEY DO REQUIRE THAT ALL MANUFACTURED ITEMS, MATERIALS AND EQUIPMENT BE INSTALLED IN STRICT CONFORMANCE TO THE MANUFACTURER'S RECOMMENDED SPECIFICATIONS, EXCEPT IN THE CASE WHERE THE CONTRACT DOCUMENTS ARE MORE STRINGENT. ANY MISCELLANEOUS ITEMS OR MATERIALS NOT SPECIFICALLY NOTED, BUT REQUIRED FOR PROPER INSTALLATION SHALL BE FURNISHED AND INSTALLED BY THE CONTRACTOR.

ALL WORK SHALL BE WARRANTED SATISFACTORY, IN MATERIALS AND WORKMANSHIP FOR A PERIOD OF ONE (1) YEAR, OR FOR THE PERIOD OF WARRANTY CUSTOMARY, OR STIPULATED FOR THE TRADE, CRAFT, OR PRODUCT, WHICHEVER IS LONGER. ONLY COMPETENT MECHANICS CAPABLE OF PRODUCING GOOD WORKMANSHIP CUSTOMARY TO THE TRADE SHOULD BE USED. COMMENCING WORK BY A CONTRACTOR OR SUBCONTRACTOR CONSTITUTES ACCEPTANCE OF THE CONDITIONS AND SURFACES CONCERNED. IF ANY SUCH CONDITIONS ARE UNACCEPTABLE, THE GENERAL CONTRACTOR SHALL BE NOTIFIED IMMEDIATELY, AND NO WORK SHALL BE PERFORMED UNTIL THE CONDITIONS ARE CORRECTED.

THE CONTRACTOR SHALL BE RESPONSIBLE FOR FAMILIARIZING HIMSELF WITH THE PROJECT SCOPE OF WORK, BUILDING STANDARDS, SCHEDULE AND DEADLINES. THE CONTRACTOR SHALL FURTHER BE RESPONSIBLE FOR ADVISING THE OWNER OF ALL LONG LEAD ITEMS AFFECTING THE PROJECT SCHEDULE AND SHALL, UPON REQUEST FROM THE OWNER, SUBMIT ORDER CONFIRMATIONS AND DELIVERY DATES FOR SUCH LONG LEAD ITEMS TO THE OWNER.

ALL CONTRACTOR OR SUPPLIER REQUESTS FOR SUBSTITUTIONS OF SPECIFIED ITEMS SHALL BE SUBMITTED, IN WRITING, ACCOMPANIED BY THE ALTERNATIVE PRODUCT INFORMATION, TO THE ARCHITECT, NO LATER THAN TEN (10) BUSINESS DAYS, PRIOR TO BID OPENING DATE. SUBSTITUTIONS SHALL ONLY BE CONSIDERED IF THEY DO NOT SACRIFICE QUALITY, FUNCTIONALITY, APPEARANCE OR WARRANTY. UNDER NO CIRCUMSTANCES WILL THE OWNER BE REQUIRED TO PROVE THAT A PRODUCT PROPOSED FOR SUBSTITUTION IS OR IS NOT OF EQUAL QUALITY TO THE PRODUCT SPECIFIED. UNDER NO CIRCUMSTANCES SHALL THE CONTRACTOR SCALE THE DRAWINGS TO DETERMINE DIMENSIONS. REFER TO PLANS, SECTIONS AND DETAILS FOR ALL DIMENSIONAL INFORMATION.

THE CONTRACTOR SHALL BE RESPONSIBLE FOR THE INSTALLATION OF ALL SELECTED MATERIALS WHICH SHALL BE COMPLETE IN ALL RESPECTS PRIOR TO THE FINAL ACCEPTANCE, UNLESS OTHERWISE NOTED.

THE CONTRACTOR SHALL PRESERVE ALL PRINTED INSTRUCTIONS AND WARRANTY INFORMATION THAT IS PROVIDED WITH EQUIPMENT OR MATERIALS USED, AND DELIVER SAID PRINTED MATTER TO THE OWNER AT THE TIME OF SUBSTANTIAL COMPLETION. THE CONTRACTOR SHALL INSTRUCT THE OWNER IN THE PROPER USE OF THE EQUIPMENT FURNISHED BY THEIR TRADE.

GENERAL CONTRACTOR SHALL PROVIDE A THOROUGH CONSTRUCTION CLEANING AT PROJECT CLOSE OUT, PRIOR TO PUNCH LIST WALK THROUGH.

THE CONTRACTOR SHALL SUBMIT SHOP DRAWINGS OF ALL FABRICATED ITEMS, AND PHYSICAL SAMPLES OF ALL FINISH MATERIALS SPECIFIED TO THE ARCHITECT FOR REVIEW.

REVIEWED SHOP DRAWINGS AND SUBMITTALS BY OTHERS SHALL NOT BE CONSIDERED AS PART OF THE CONTRACT DOCUMENTS. THE ARCHITECT ASSUMES NO RESPONSIBILITY FOR DRAWINGS, SCHEDULES, AND/OR SPECIFICATIONS FOR WORK ON THE PROJECT PREPARED BY OTHERS.

THE ARCHITECT WILL REVIEW ALL SHOP DRAWINGS, SUBMITTALS AND SAMPLES FOR CONFORMITY WITH THE CONTRACT DOCUMENTS AND RETURN THEM TO THE CONTRACTOR WITHIN SEVEN (7) WORKING DAYS EXCEPT AS MAY OTHERWISE BE PROVIDED FOR BY THE OWNER.

THE CONTRACTOR SHALL NOT REPRODUCE AND MARK UP ANY PART OF THE CONTRACT DOCUMENTS FOR SUBMITTAL AS A SHOP DRAWING. ANY SUCH SUBMITTAL WILL BE REJECTED.

ANY SUBMITTAL REQUIRED TO BE REVIEWED MORE THAN THE INITIAL REVIEW AND ONE (1) ADDITIONAL REVIEW, WILL BE CONSIDERED TO BE IN EXCESS OF THE SCOPE OF THE PROJECT. THE TIME REQUIRED FOR THIRD AND SUBSEQUENT REVIEWS OF A SUBMITTAL WILL BE PAID FOR BY THE CONTRACTOR TO THE ARCHITECT AT THE ARCHITECT'S STANDARD BILLING RATES, PLUS REIMBURSABLE EXPENSES.

THE CONTRACTOR SHALL BE RESPONSIBLE FOR VERIFICATION OF ANY EXISTING CONDITIONS AND ALL CRITICAL DIMENSIONS ASSOCIATED WITH THE PROPOSED WORK. THE CONTRACTOR SHALL CONFIRM THAT ALL WORK OUTLINED WITHIN THE CONTRACT DOCUMENTS CAN BE ACCOMPLISHED AS SHOWN, PRIOR TO BID OPENING. THE CONTRACTOR SHALL NOTIFY THE ARCHITECT OF ANY CONDITIONS ENCOUNTERED WHICH MAY AFFECT BUILDING CODE COMPLIANCE, LIFE SAFETY, ISSUANCE OF CERTIFICATE OF OCCUPANCY, OR COMPLETION OF THE PROJECT AS DIRECTED IN THE CONTRACT DOCUMENTS.

NO ADDITIONAL FUNDS WILL BE APPROVED FOR WORK OMITTED FROM THE CONTRACTOR'S BID DUE TO LACK OF VERIFICATION BY THE CONTRACTOR, EXCEPT AS OTHERWISE APPROVED BY THE OWNER FOR WORK ASSOCIATED WITH HIDDEN CONDITIONS WHICH ARE NOT ACCESSIBLE PRIOR TO CONSTRUCTION.

REFER TO PROJECT MANUAL (WHEN APPLICABLE) FOR ADDITIONAL REQUIREMENTS AND DIRECTIONS. ALL INTERIOR FINISHES SHALL COMPLY WITH CHAPTER EIGHT (8) OF THE INTERNATIONAL BUILDING CODE.

LIGHT GAGE METAL STUDS, STUDS, THEIR COMPONENTS AND THEIR CONNECTIONS SHALL BE ENGINEERED BY A PROFESSIONAL ENGINEER LICENSED IN THE STATE WHERE THE PROJECT IS LOCATED. THE ENGINEER SHALL AFFIX THEIR SEAL AND SIGNATURE TO SHOP DRAWINGS AND CALCULATIONS SUBMITTED FOR REVIEW.

STEEL REQUIRED TO TRANSMIT GRAVITY AND/OR LATERAL LOADS TO THE STRUCTURE NOT DETAILED ON THE STRUCTURAL DRAWINGS IS THE RESPONSIBILITY OF THE METAL STUD SUPPLIER TO DESIGN, DETAIL, PROVIDE AND INSTALL.


METAL STUDS SHALL BE DESIGNED TO SUPPORT THE LOADS SHOWN IN THE DESIGN DATA IN ADDITION TO THE WEIGHT OF THE MATERIALS ATTACHED TO THE METAL STUDS. METAL STUDS SHALL BE DESIGNED USING THE LOAD COMBINATIONS IN SECTION 1605.3.1 OF THE INTERNATIONAL BUILDING CODE, 2012 EDITION. NO INCREASE IN ALLOWABLE STRESS IS ALLOWED.

DEFLECTION DUE TO LATERAL LOAD SHALL BE LIMITED TO $\frac{1}{160}$ OF THE STUD SPAN, FOR CANTILEVERS, THE DEFLECTION DUE TO LATERAL LOAD AT THE END OF THE CANTILEVER SHALL BE LIMITED TO $\frac{1}{160}$ OF THE CANTILEVER DIMENSION.

METAL STUD MANUFACTURER SHALL DETERMINE FINAL LAYOUT AND GAUGE OF STUDS TO MEET THE ARCHITECTURAL AND STRUCTURAL REQUIREMENTS.

WHERE ROUGH CARPENTRY IS IN CONTACT WITH THE GROUND, EXPOSED TO WEATHER OR IN AREAS OF HIGH RELATIVE HUMIDITY PROVIDE FASTENERS AND ANCHORAGES WITH A HOT DIP ZINC COATING OF G90 COMPLYING WITH ASTM A153 OR PROVIDE FASTENERS AND ANCHORAGES OF TYPE 304 STAINLESS STEEL.

ALL WOOD SHEATHING TO BE FIRE TREATED UNLESS NOTED OTHERWISE.

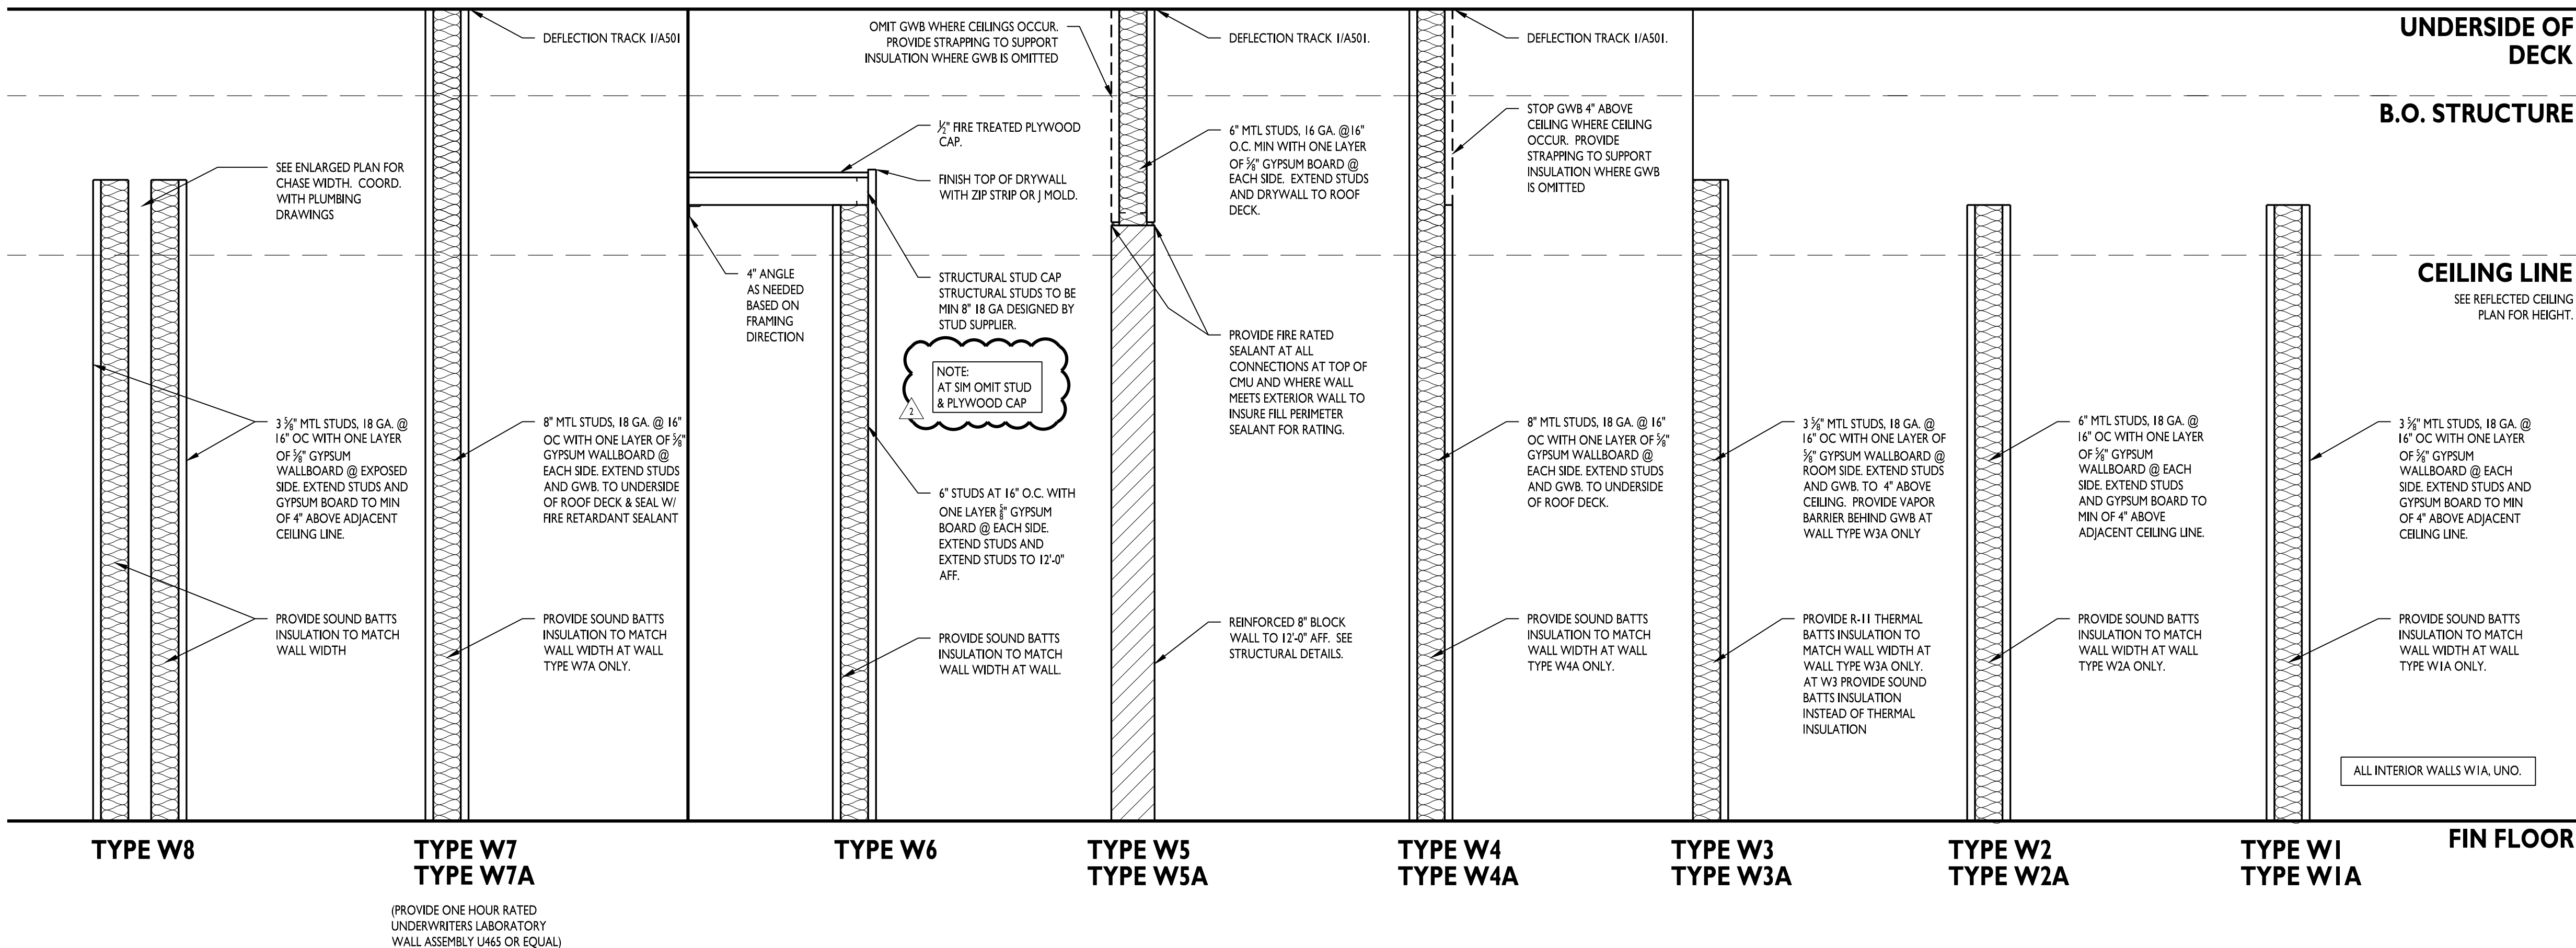

WALL TYPE GENERAL NOTES

- A. NOTE: WALL HEIGHT AS MARKED ON PLANS IN CONJUNCTION WITH WALL TYPE SYMBOL WILL SUPERCEDE WALL HEIGHTS AS SHOWN ABOVE. SEE SYMBOLS LEGEND THIS SHEET.

B. PROVIDE DEEP LEG DEFLECTION TRACK AT TOP OF ALL METAL STUD WALLS WHERE STUDS EXTEND TO UNDERSIDE OF ROOF DECK OR STRUCTURE ABOVE.

C. USE MOLD AND MILDEW RESISTANT GYPSUM WALLBOARD ON ALL PLUMBING WALLS. USE 5/8" CEMENT BOARD INSTEAD OF GYP BOARD BEHIND ALL TILE FINISHES.
- D. BRACE METAL STUD WALLS TO TOP OF STRUCTURAL STEEL ELEMENTS ABOVE CEILING PLANE. COORDINATE REQUIRED BRACE SPACING WITH STRUCTURAL ENGINEER PRIOR TO BEGINNING CONSTRUCTION.

E. REFER TO ROOM FINISH SCHEDULE FOR ALL FINISH SELECTIONS: CEILING TYPES AND HEIGHTS; AND TYPES, SIZES AND LOCATIONS ETC.


F. ALL STUD WALLS CREATING A CONCEALED WALL SPACE TO HAVE FIREBLOCKING AT INTERVALS NOT EXCEEDING 10'-0" PER 718.2.2 IBC 2012
- G. DESIGN ALL PARTITIONS TO U240 AT 5 PSF.

H. U.N.O. ALL WALLS TO HAVE ONE LAYER DRYWALL EACH SIDE, LEVEL 4 FINISH.

WALL TYPES

NOT TO SCALE

CERTIFICATION

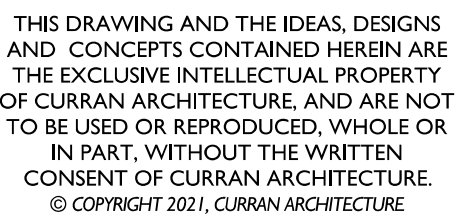

PROJECT INFORMATION

NW CORNER OF
NE TUDOR RD & MAIN ST
LEE'S SUMMIT, MO 64086



ISSUE DATES

PERMIT SET 02.18.22

210300


TYPICAL ACCESSIBILITY DETAILS

A002

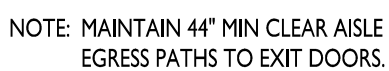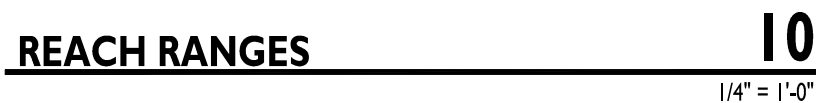


ACCESSIBLE ROUTES



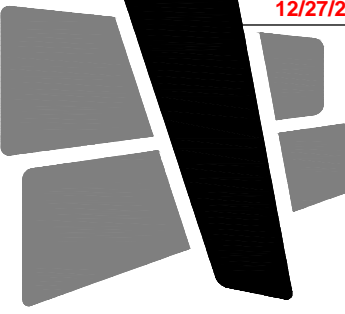

CURRAN
ARCHITECTURE

5719 LAWTON LOOP E. DR. #212
INDIANAPOLIS, IN 46216
O :: 317 . 288 . 0681
F :: 317 . 288 . 0753

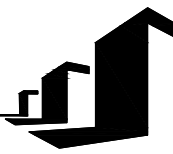

SCANNELL
PROPERTIES

CERTIFICATION

THIS DRAWING AND THE IDEAS, DESIGNS
AND CONCEPTS CONTAINED HEREIN ARE
THE EXCLUSIVE INTELLECTUAL PROPERTY
OF CURRAN ARCHITECTURE, AND ARE NOT
TO BE USED OR REPRODUCED, WHOLE OR
IN PART, WITHOUT THE WRITTEN
CONSENT OF CURRAN ARCHITECTURE.
© COPYRIGHT 2021, CURRAN ARCHITECTURE

PROJECT INFORMATION

LEE'S SUMMIT LOGISTICS
BUILDING A LOT I

NW CORNER OF
NE TUDOR RD & MAIN ST
LEE'S SUMMIT, MO 64086

ISSUE DATES

PERMIT SET 02/18/22


210300

LIFE SAFETY PLAN


A100

KEYED NOTES


1. EXIT, EXIT SIGN, AND EMERGENCY LIGHTING ABOVE DOOR
INTERIOR WITH BATTERY BACKUP. EXTERIOR EGRESS
LIGHTING ABOVE DOOR TIED TO BATTERY BACK UP.
2. PROPOSED FIRE EXTINGUISHER LOCATION. VERIFY WITH FIRE
MARSHAL. FINAL QUANTITY AND LOCATIONS TO BE
DETERMINED WITH FINAL RACKING PLAN AND FIRE
DEPARTMENT REVIEW.
3. SEE CIVIL PLANS AND FIRE PROTECTION PLANS FOR FIRE
DEPARTMENT CONNECTION POINTS AND FIRE LINE LEAD INS
THIS LOCATION.
4. PROVIDE BUILDING ADDRESS SIGNAGE THIS LOCATION.
SIGNAGE TO BE 12" BELOW TOP OF PARAPET. SEE DOOR ID
NOTES THIS SHEET. STREET NAME AND NUMBER TO BE
PROVIDED.
5. THIS DOOR LABELED "PUMP ROOM". SEE DOOR ID NOTES.
6. ONE-HOUR RATED PUMP ROOM. SEE FLOOR PLAN AND WALL
TYPES.

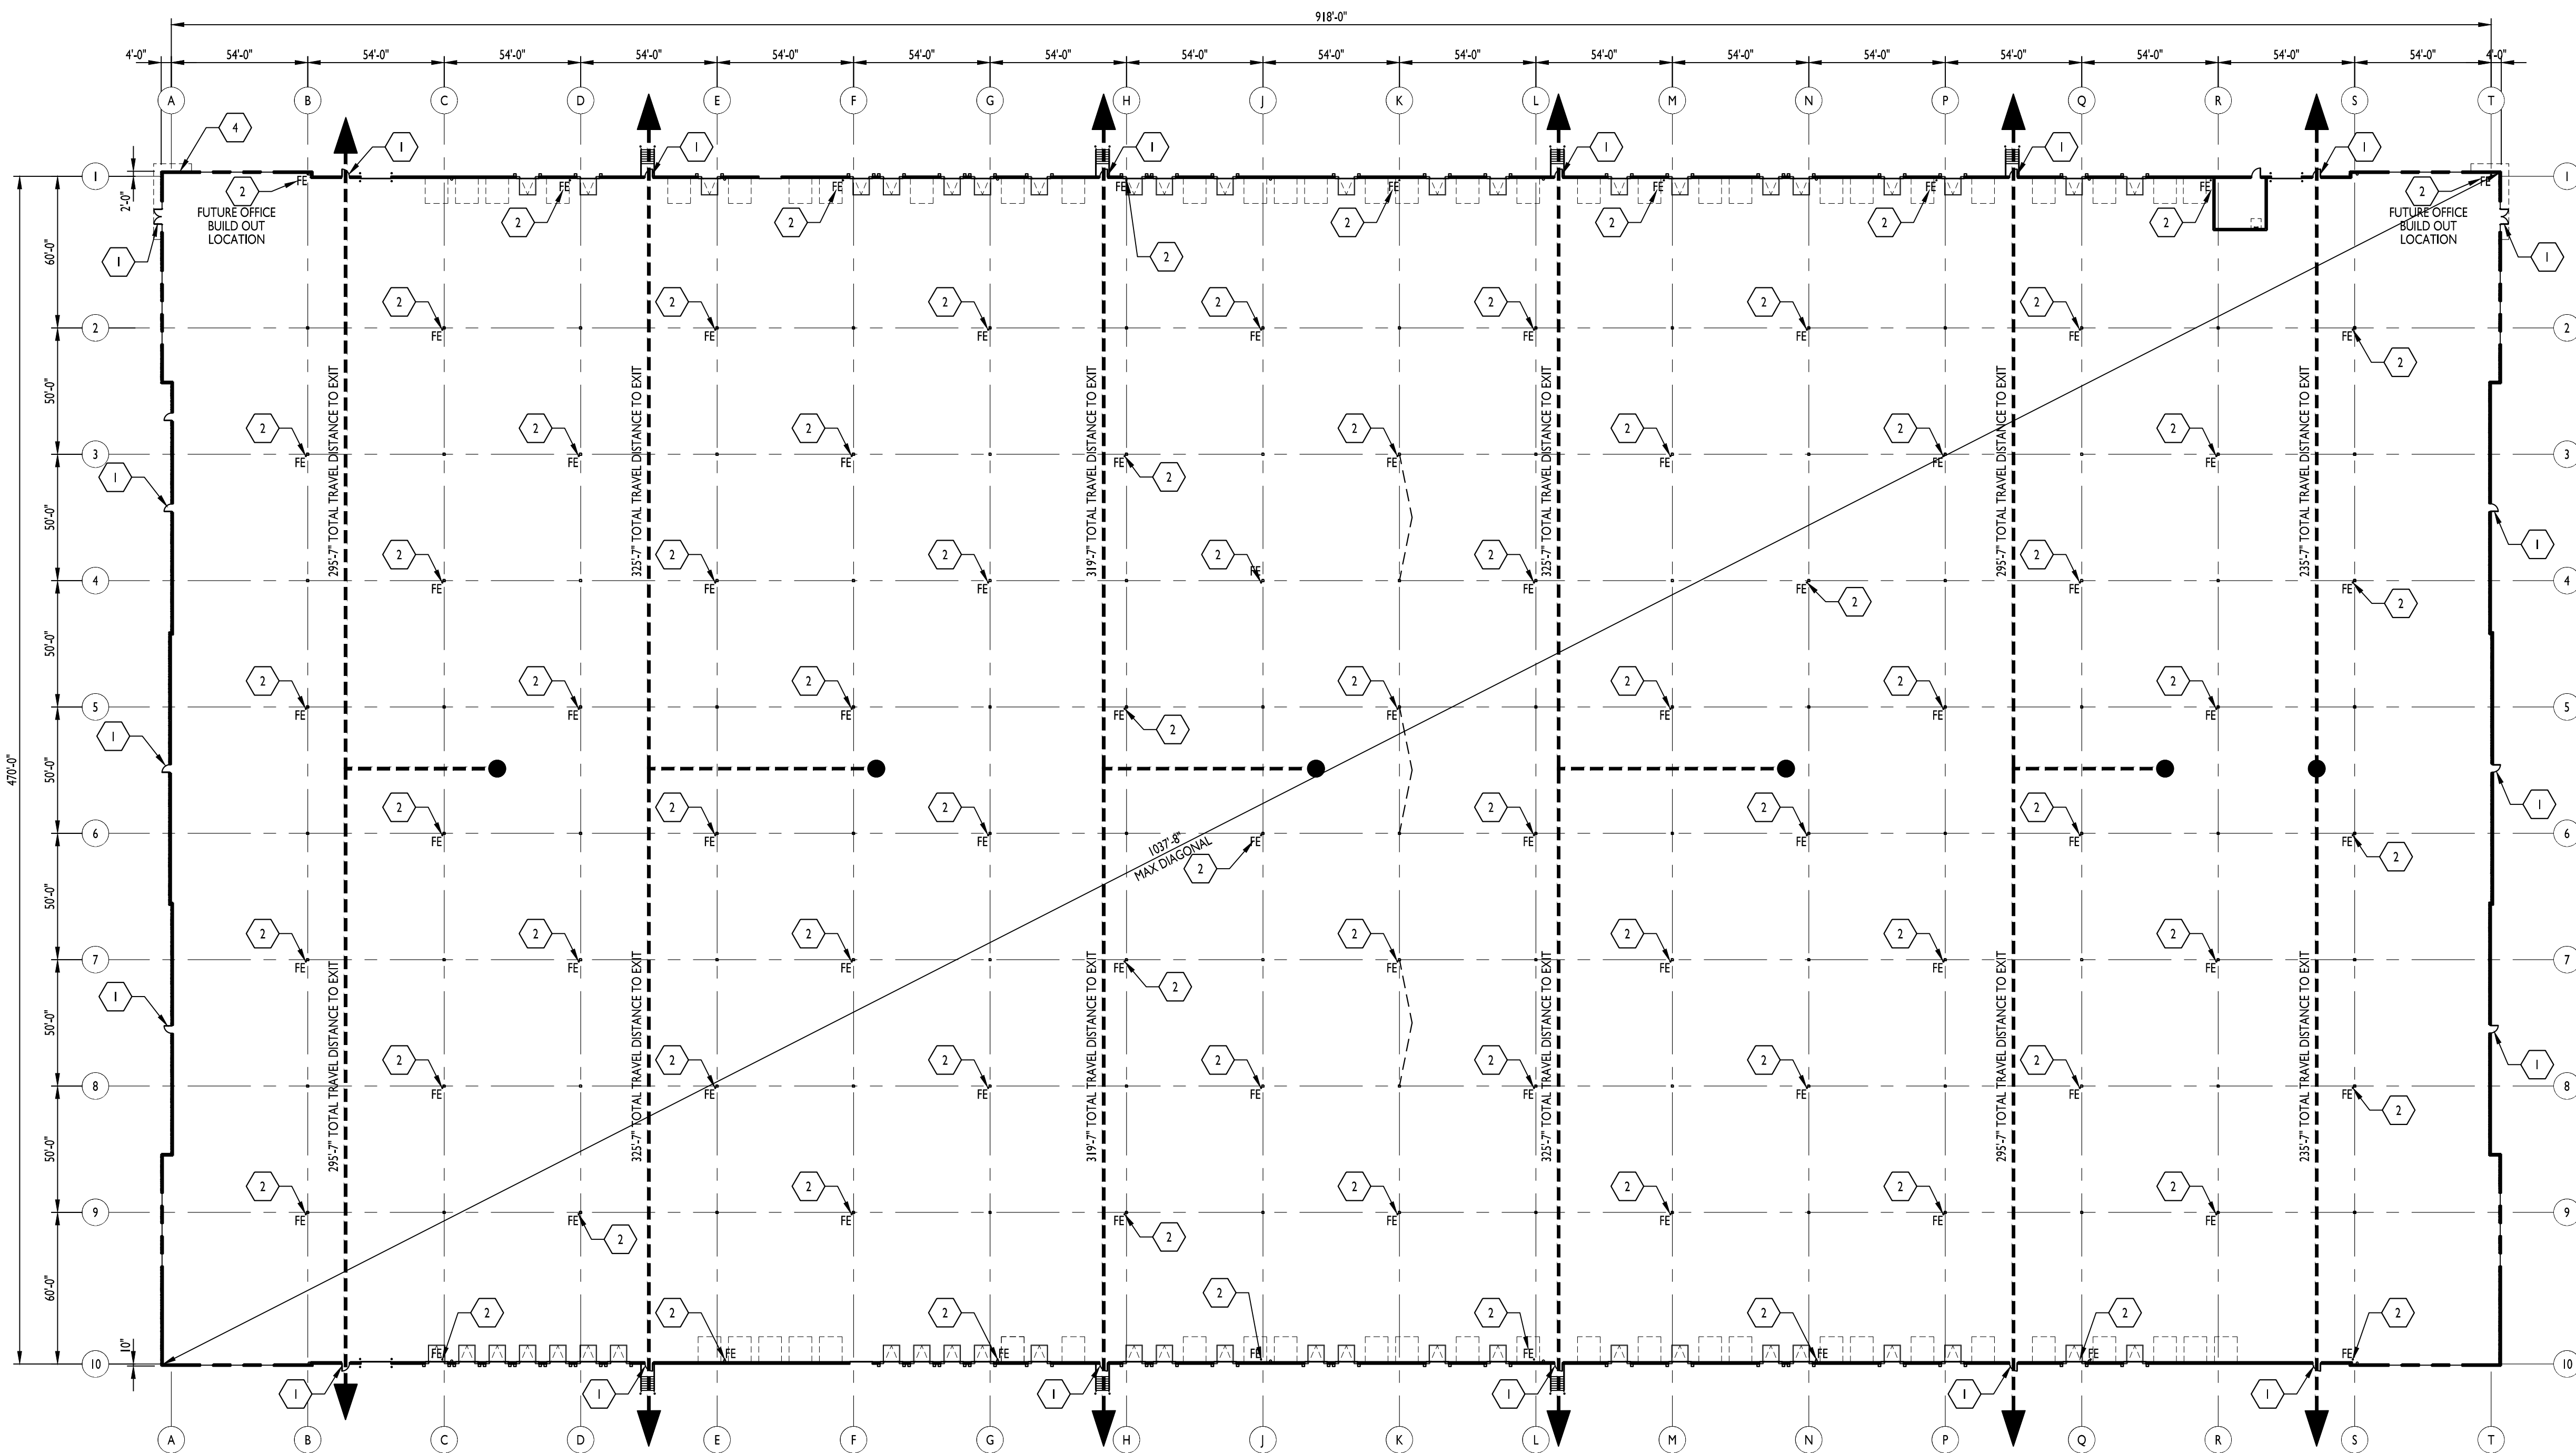

LIFE SAFETY PLAN

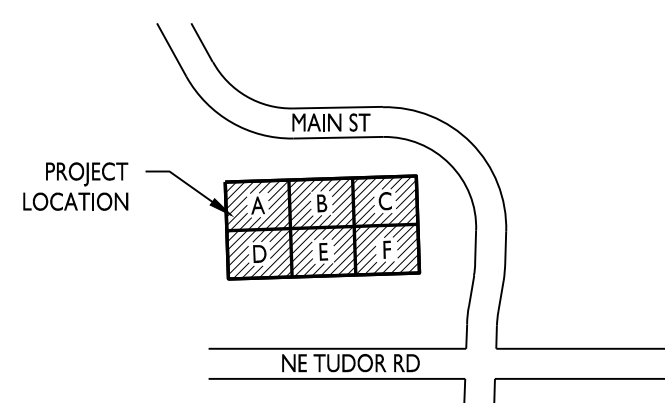


KEY PLAN

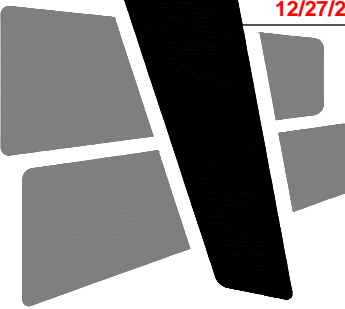

CURRAN
ARCHITECTURE

5719 LAWTON LOOP E. DR. #212
INDIANAPOLIS, IN 46216
O :: 317 . 288 . 0681
F :: 317 . 288 . 0753

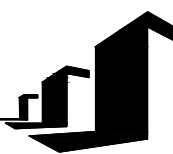

SCANNELL
PROPERTIES

CERTIFICATION

THIS DRAWING AND THE IDEAS, DESIGNS
AND CONCEPTS CONTAINED HEREIN ARE
THE EXCLUSIVE INTELLECTUAL PROPERTY
OF CURRAN ARCHITECTURE, AND ARE NOT
TO BE USED OR REPRODUCED, WHOLE OR
IN PART, WITHOUT THE WRITTEN
CONSENT OF CURRAN ARCHITECTURE.
© COPYRIGHT 2021, CURRAN ARCHITECTURE

PROJECT INFORMATION

LEE'S SUMMIT LOGISTICS
BUILDING A LOT I

NW CORNER OF
NE TUDOR RD & MAIN ST
LEE'S SUMMIT, MO 64086

ISSUE DATES

PERMIT SET 02.18.22


210300

OVERALL FLOOR PLAN


A101

GENERAL NOTES


- CONTRACTOR SHALL BE RESPONSIBLE FOR VERIFICATION OF ALL DIMENSIONS AND JOB CONDITIONS. ANY DEVIATION FROM WHAT IS NOTED IN DRAWINGS SHALL BE BROUGHT TO THE ATTENTION OF THE ARCHITECT IMMEDIATELY.
- ALL DIMENSIONS SHOWN ARE FACE OF BRICK, MASONRY OR METAL STUD FRAMING, UNLESS OTHERWISE NOTED.
- PROVIDE DEEP LEG DEFLECTION TRACK AT ALL METAL STUD CONNECTIONS WITH STRUCTURE ABOVE, TYPICAL.
- PROVIDE FIRE RATED WOOD BLOCKING IN METAL STUD WALLS FOR ANY WALL SUPPORTED ITEMS.
- PROVIDE APPROVED FIRE RATED STOPPING MATERIALS IN ANY OPENINGS IN FIRE RATED ASSEMBLIES.
- REFER TO DOOR AND WINDOW SCHEDULES FOR ALL MATERIALS, FINISHES, AND HARDWARE INFORMATION.
- REFER TO EXTERIOR ELEVATIONS FOR ALL BRICK, MASONRY, AND OTHER EXPANSION JOINT LOCATIONS.
- ALL MATERIALS LOCATED IN CEILING PLENUM SHALL BE RATED FOR SUCH INSTALLATION OR PROTECTED TO PROVIDE COMPLIANCE. THIS INCLUDES BUT IS NOT LIMITED TO INSULATION (FHC 25/50) POWER AND LOW VOLTAGE WIRING, TELECOMMUNICATIONS CABLING, PLUMBING SUPPLY AND DRAIN LINES AND SUPPORTING BRACKETS AND/OR BLOCKING FOR CEILING HUNG ITEMS.
- PRIOR TO ORDERING ANY PRODUCTS, CONTRACTOR SHALL SUBMIT SAMPLES TO THE ARCHITECT OF ALL FINISH MATERIALS TO BE USED ON THE PROJECT. THE CONTRACTOR SHALL BEAR SOLE RESPONSIBILITY FOR ANY MATERIALS ORDERED INCORRECTLY WHEN THAT MATERIAL WAS NOT REVIEWED BY THE ARCHITECT.
- PROVIDE CONCRETE FILLED STEEL PIPE BOLLARDS AT ALL REQUIRED UTILITY EQUIPMENT LOCATIONS SUCH AS GAS METERS, ELECTRICAL TRANSFORMER PANELS, ETC. COORDINATE WITH UTILITY COMPANY AND CONTRACTORS, WHEN APPLICABLE, FOR NECESSARY LOCATIONS. REFER TO CIVIL DRAWINGS FOR BOLLARD SPECIFICATIONS AND ADDITIONAL INFORMATION.
- ALL DOORS, UNLESS OTHERWISE NOTED, TO HAVE HINGE SIDE SET 4" FROM CORNER SHOWN TO OUTSIDE OF FRAME.
- UNLESS SPECIFIED ELSEWHERE, ALL INTERIOR SLABS AND SLAB INFILLS TO BE FF-50/FL-25 OVERALL AND FF-35/FL-25 LOCAL.
- ALL EXIT DOORS TO HAVE TACTILE EXIT SIGNAGE PER 703.4 OF THE ANSI 117.1 2009.

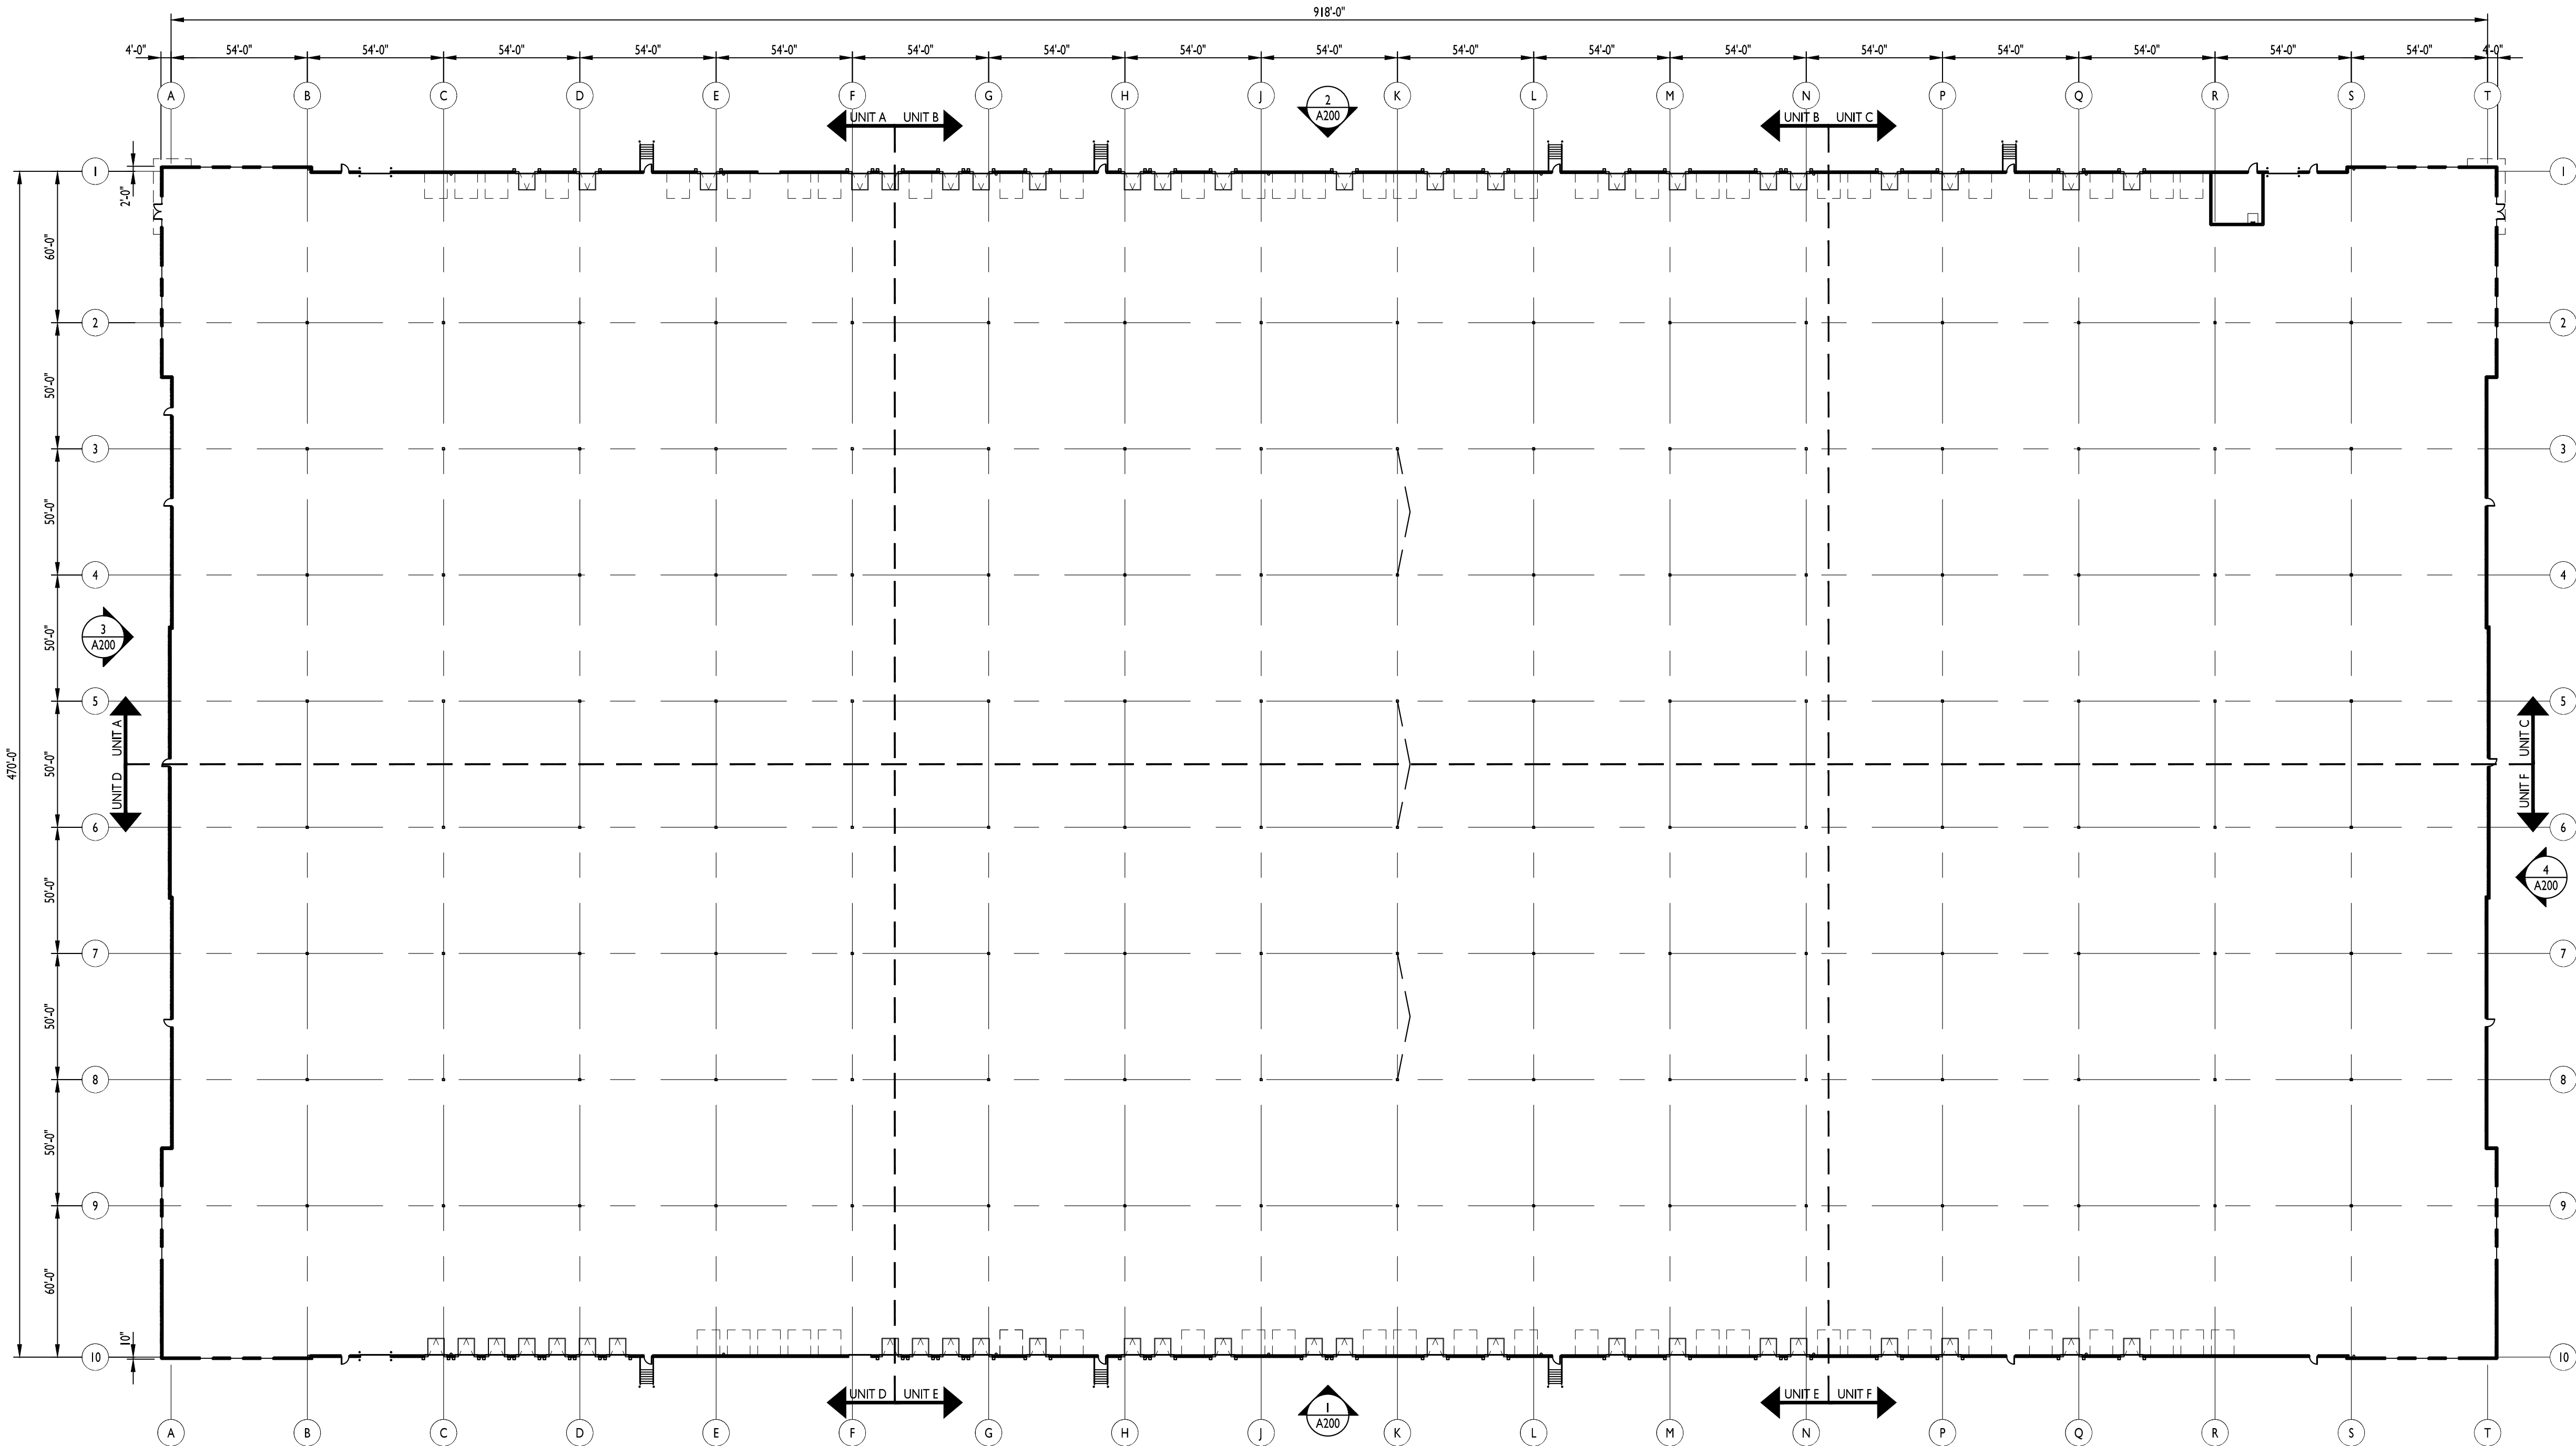

OVERALL FLOOR PLAN

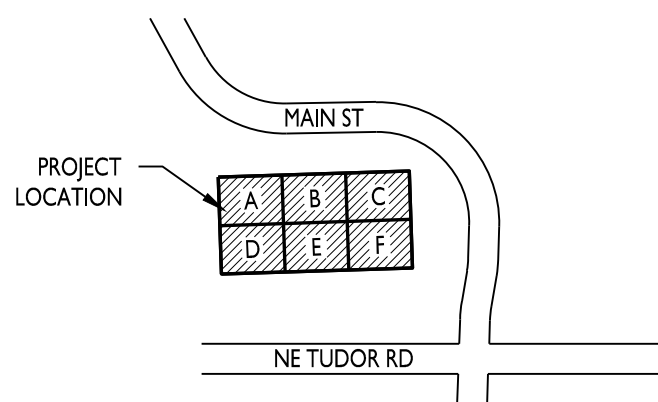

KEY PLAN

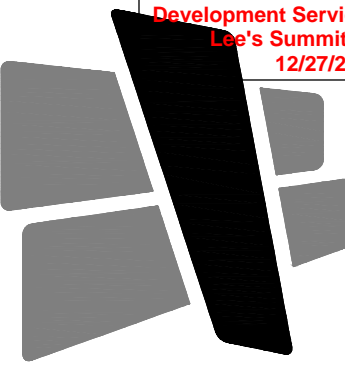

CURRAN
ARCHITECTURE

5719 LAWTON LOOP E. DR. #212
INDIANAPOLIS, IN 46216
O :: 317 . 288 . 0681
F :: 317 . 288 . 0753



SCANNELL
PROPERTIES

GENERAL NOTES

- CONTRACTOR SHALL BE RESPONSIBLE FOR VERIFICATION OF ALL DIMENSIONS AND JOB CONDITIONS. ANY DEVIATION FROM WHAT IS NOTED IN DRAWINGS SHALL BE BROUGHT TO THE ATTENTION OF THE ARCHITECT IMMEDIATELY.
- ALL DIMENSIONS SHOWN ARE FACE OF BRICK, MASONRY OR METAL STUD FRAMING, UNLESS OTHERWISE NOTED.
- PROVIDE DEEP LEG DEFLECTION TRACK AT ALL METAL STUD CONNECTIONS WITH STRUCTURE ABOVE, TYPICAL.
- PROVIDE FIRE RATED WOOD BLOCKING IN METAL STUD WALLS FOR ANY WALL SUPPORTED ITEMS.
- PROVIDE APPROVED FIRE RATED STOPPING MATERIALS IN ANY OPENINGS IN FIRE RATED ASSEMBLIES.
- REFER TO DOOR AND WINDOW SCHEDULES FOR ALL MATERIALS, FINISHES, AND HARDWARE INFORMATION.
- REFER TO EXTERIOR ELEVATIONS FOR ALL BRICK, MASONRY, AND OTHER EXPANSION JOINT LOCATIONS.
- ALL MATERIALS LOCATED IN CEILING PLENUM SHALL BE RATED FOR SUCH INSTALLATION OR PROTECTED TO PROVIDE COMPLIANCE. THIS INCLUDES BUT IS NOT LIMITED TO INSULATION (FHC 25/50) POWER AND LOW VOLTAGE WIRING, TELECOMMUNICATIONS CABLING, PLUMBING SUPPLY AND DRAIN LINES AND SUPPORTING BRACKETS AND/OR BLOCKING FOR CEILING HUNG ITEMS.
- PRIOR TO ORDERING ANY PRODUCTS, CONTRACTOR SHALL SUBMIT SAMPLES TO THE ARCHITECT OF ALL FINISH MATERIALS TO BE USED ON THE PROJECT. THE CONTRACTOR SHALL BEAR SOLE RESPONSIBILITY FOR ANY MATERIALS ORDERED INCORRECTLY WHEN THAT MATERIAL WAS NOT REVIEWED BY THE ARCHITECT.
- PROVIDE CONCRETE FILLED STEEL PIPE BOLLARDS AT ALL REQUIRED UTILITY EQUIPMENT LOCATIONS SUCH AS GAS METERS, ELECTRICAL TRANSFORMER PANELS, ETC. COORDINATE WITH UTILITY COMPANY AND CONTRACTORS, WHEN APPLICABLE, FOR NECESSARY LOCATIONS. REFER TO CIVIL DRAWINGS FOR BOLLARD SPECIFICATIONS AND ADDITIONAL INFORMATION.
- ALL DOORS, UNLESS OTHERWISE NOTED, TO HAVE HINGE SIDE SET 4" FROM CORNER SHOWN TO OUTSIDE OF FRAME.
- UNLESS SPECIFIED ELSEWHERE, ALL INTERIOR SLABS AND SLAB INFILLS TO BE FF-50/FL-25 OVERALL AND FF-35/FL-25 LOCAL.
- ALL EXIT DOORS TO HAVE TACTILE EXIT SIGNAGE PER 703.4 OF THE ANSI 117.1 2009.

KEYED NOTES

- DOCK SEALS.
- DOCK LEVELER. COORDINATE W/ MANUFACTURER FOR SIZING AND SLAB PREP.
- CONCRETE FILLED PIPE BOLLARDS.
- GALVANIZED STEEL STAIRS. REFER TO 11/A502 & 12/A502.
- METAL CANOPY ABOVE. REFER TO WALL SECTIONS & ELEVATIONS.
- LOCATION OF FUTURE DOCK DOORS. PRECAST PANELS TO BE FABRICATED TO ALLOW FOR FUTURE REMOVAL OF CONCRETE IN THESE LOCATIONS. REFER TO ELEVATIONS FOR ADDITIONAL INFORMATION.
- STEEL COLUMNS PROVIDE PANTED FINISH.
- COORDINATE ROOF DRAIN LEADERS SO THAT IT IS CENTERED BETWEEN DOORS
- KNOX BOX LOCATION. COORDINATE WITH FIRE DEPARTMENT.
- 30' X 30' CONCRETE PATIO. REFER TO CIVIL DRAWINGS FOR TYPICAL SIDEWALK CONCRETE SPEC, JOINT SPACING, AND CONTINUATION OF ANY WALKS FROM PATIO TO PARKING LOT. PROVIDE SHADE STRUCTURE AT NORTH EAST CORNER OF PATIO. SHADE STRUCTURE TO BE ENGINEERED BY SUPPLIER.

THIS DRAWING AND THE IDEAS, DESIGNS AND CONCEPTS CONTAINED HEREIN ARE THE EXCLUSIVE INTELLECTUAL PROPERTY OF CURRAN ARCHITECTURE, AND ARE NOT TO BE USED OR REPRODUCED, WHOLE OR IN PART, WITHOUT THE WRITTEN CONSENT OF CURRAN ARCHITECTURE.
© COPYRIGHT 2021, CURRAN ARCHITECTURE

PROJECT INFORMATION

LEE'S SUMMIT LOGISTICS
BUILDING A LOT I

NW CORNER OF
NE TUDOR RD & MAIN ST
LEE'S SUMMIT, MO 64086


ISSUE DATES

PERMIT SET	02.18.22
PERMIT REVIEW COMMENTS	05.16.22
TENANT COORDINATION	06.06.22

210300

FLOOR PLAN
AREA A

A102

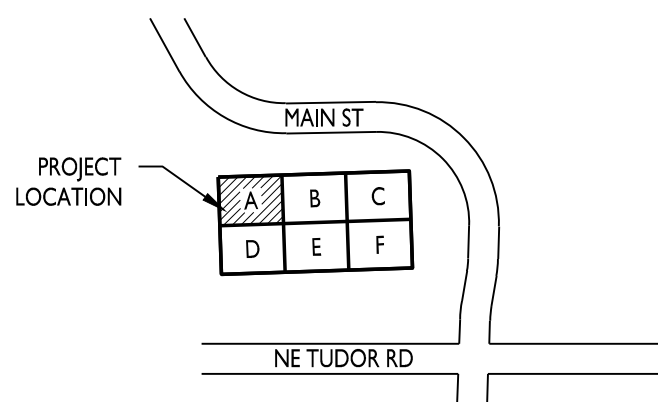

KEY PLAN



5719 LAWTON LOOP E. DR. #212
INDIANAPOLIS, IN 46216
O :: 317 . 288 . 0681
F :: 317 . 288 . 0753

CERTIFICATION

THIS DRAWING AND THE IDEAS, DESIGNS
AND CONCEPTS CONTAINED HEREIN ARE
THE EXCLUSIVE INTELLECTUAL PROPERTY
OF CURRAN ARCHITECTURE, AND ARE NOT
TO BE USED OR REPRODUCED, WHOLE OR
IN PART, WITHOUT THE WRITTEN
CONSENT OF CURRAN ARCHITECTURE.
© COPYRIGHT 2021, CURRAN ARCHITECTURE

PROJECT INFORMATION

LEE'S SUMMIT LOGISTICS
BUILDING A LOT I

NW CORNER OF
NE TUDOR RD & MAIN ST
LEE'S SUMMIT, MO 64086

ISSUE DATES

PERMIT SET 02.18.22
TENANT COORDINATION 06.06.22

210300

FLOOR PLAN
AREA B


A103

GENERAL NOTES

- CONTRACTOR SHALL BE RESPONSIBLE FOR VERIFICATION OF ALL DIMENSIONS AND JOB CONDITIONS. ANY DEVIATION FROM WHAT IS NOTED IN DRAWINGS SHALL BE BROUGHT TO THE ATTENTION OF THE ARCHITECT IMMEDIATELY.
- ALL DIMENSIONS SHOWN ARE FACE OF BRICK, MASONRY OR METAL STUD FRAMING, UNLESS OTHERWISE NOTED.
- PROVIDE DEEP LEG DEFLECTION TRACK AT ALL METAL STUD CONNECTIONS WITH STRUCTURE ABOVE, TYPICAL.
- PROVIDE FIRE RATED WOOD BLOCKING IN METAL STUD WALLS FOR ANY WALL SUPPORTED ITEMS.
- PROVIDE APPROVED FIRE RATED STOPPING MATERIALS IN ANY OPENINGS IN FIRE RATED ASSEMBLIES.
- REFER TO DOOR AND WINDOW SCHEDULES FOR ALL MATERIALS, FINISHES, AND HARDWARE INFORMATION.
- REFER TO EXTERIOR ELEVATIONS FOR ALL BRICK, MASONRY, AND OTHER EXPANSION JOINT LOCATIONS.
- ALL MATERIALS LOCATED IN CEILING PLENUM SHALL BE RATED FOR SUCH INSTALLATION OR PROTECTED TO PROVIDE COMPLIANCE. THIS INCLUDES BUT IS NOT LIMITED TO INSULATION (FHC 25/50) POWER AND LOW VOLTAGE WIRING, TELECOMMUNICATIONS CABLING, PLUMBING SUPPLY AND DRAIN LINES AND SUPPORTING BRACKETS AND/OR BLOCKING FOR CEILING HUNG ITEMS.
- PRIOR TO ORDERING ANY PRODUCTS, CONTRACTOR SHALL SUBMIT SAMPLES TO THE ARCHITECT OF ALL FINISH MATERIALS TO BE USED ON THE PROJECT. THE CONTRACTOR SHALL BEAR SOLE RESPONSIBILITY FOR ANY MATERIALS ORDERED INCORRECTLY WHEN THAT MATERIAL WAS NOT REVIEWED BY THE ARCHITECT.
- PROVIDE CONCRETE FILLED STEEL PIPE BOLLARDS AT ALL REQUIRED UTILITY EQUIPMENT LOCATIONS SUCH AS GAS METERS, ELECTRICAL TRANSFORMER PANELS, ETC. COORDINATE WITH UTILITY COMPANY AND CONTRACTORS, WHEN APPLICABLE, FOR NECESSARY LOCATIONS. REFER TO CIVIL DRAWINGS FOR BOLLARD SPECIFICATIONS AND ADDITIONAL INFORMATION.
- ALL DOORS, UNLESS OTHERWISE NOTED, TO HAVE HINGE SIDE SET 4" FROM CORNER SHOWN TO OUTSIDE OF FRAME.
- UNLESS SPECIFIED ELSEWHERE, ALL INTERIOR SLABS AND SLAB INFILLS TO BE FF-50/FL-25 OVERALL AND FF-35/FL-25 LOCAL.
- ALL EXIT DOORS TO HAVE TACTILE EXIT SIGNAGE PER 703.4 OF THE ANSI 117.1 2009.


KEYED NOTES

- DOCK SEALS.
- DOCK LEVELER, COORDINATE W/ MANUFACTURER FOR SIZING AND SLAB PREP.
- CONCRETE FILLED PIPE BOLLARDS.
- GALVANIZED STEEL STAIRS. REFER TO 11/A502 & 12/A502.
- METAL CANOPY ABOVE. REFER TO WALL SECTIONS & ELEVATIONS.
- LOCATION OF FUTURE DOCK DOORS. PRECAST PANELS TO BE FABRICATED TO ALLOW FOR FUTURE REMOVAL OF CONCRETE IN THESE LOCATIONS. REFER TO ELEVATIONS FOR ADDITIONAL INFORMATION.
- STEEL COLUMNS PROVIDE PANTED FINISH.
- COORDINATE ROOF DRAIN LEADERS SO THAT IT IS CENTERED BETWEEN DOORS
- KNOX BOX LOCATION. COORDINATE WITH FIRE DEPARTMENT.

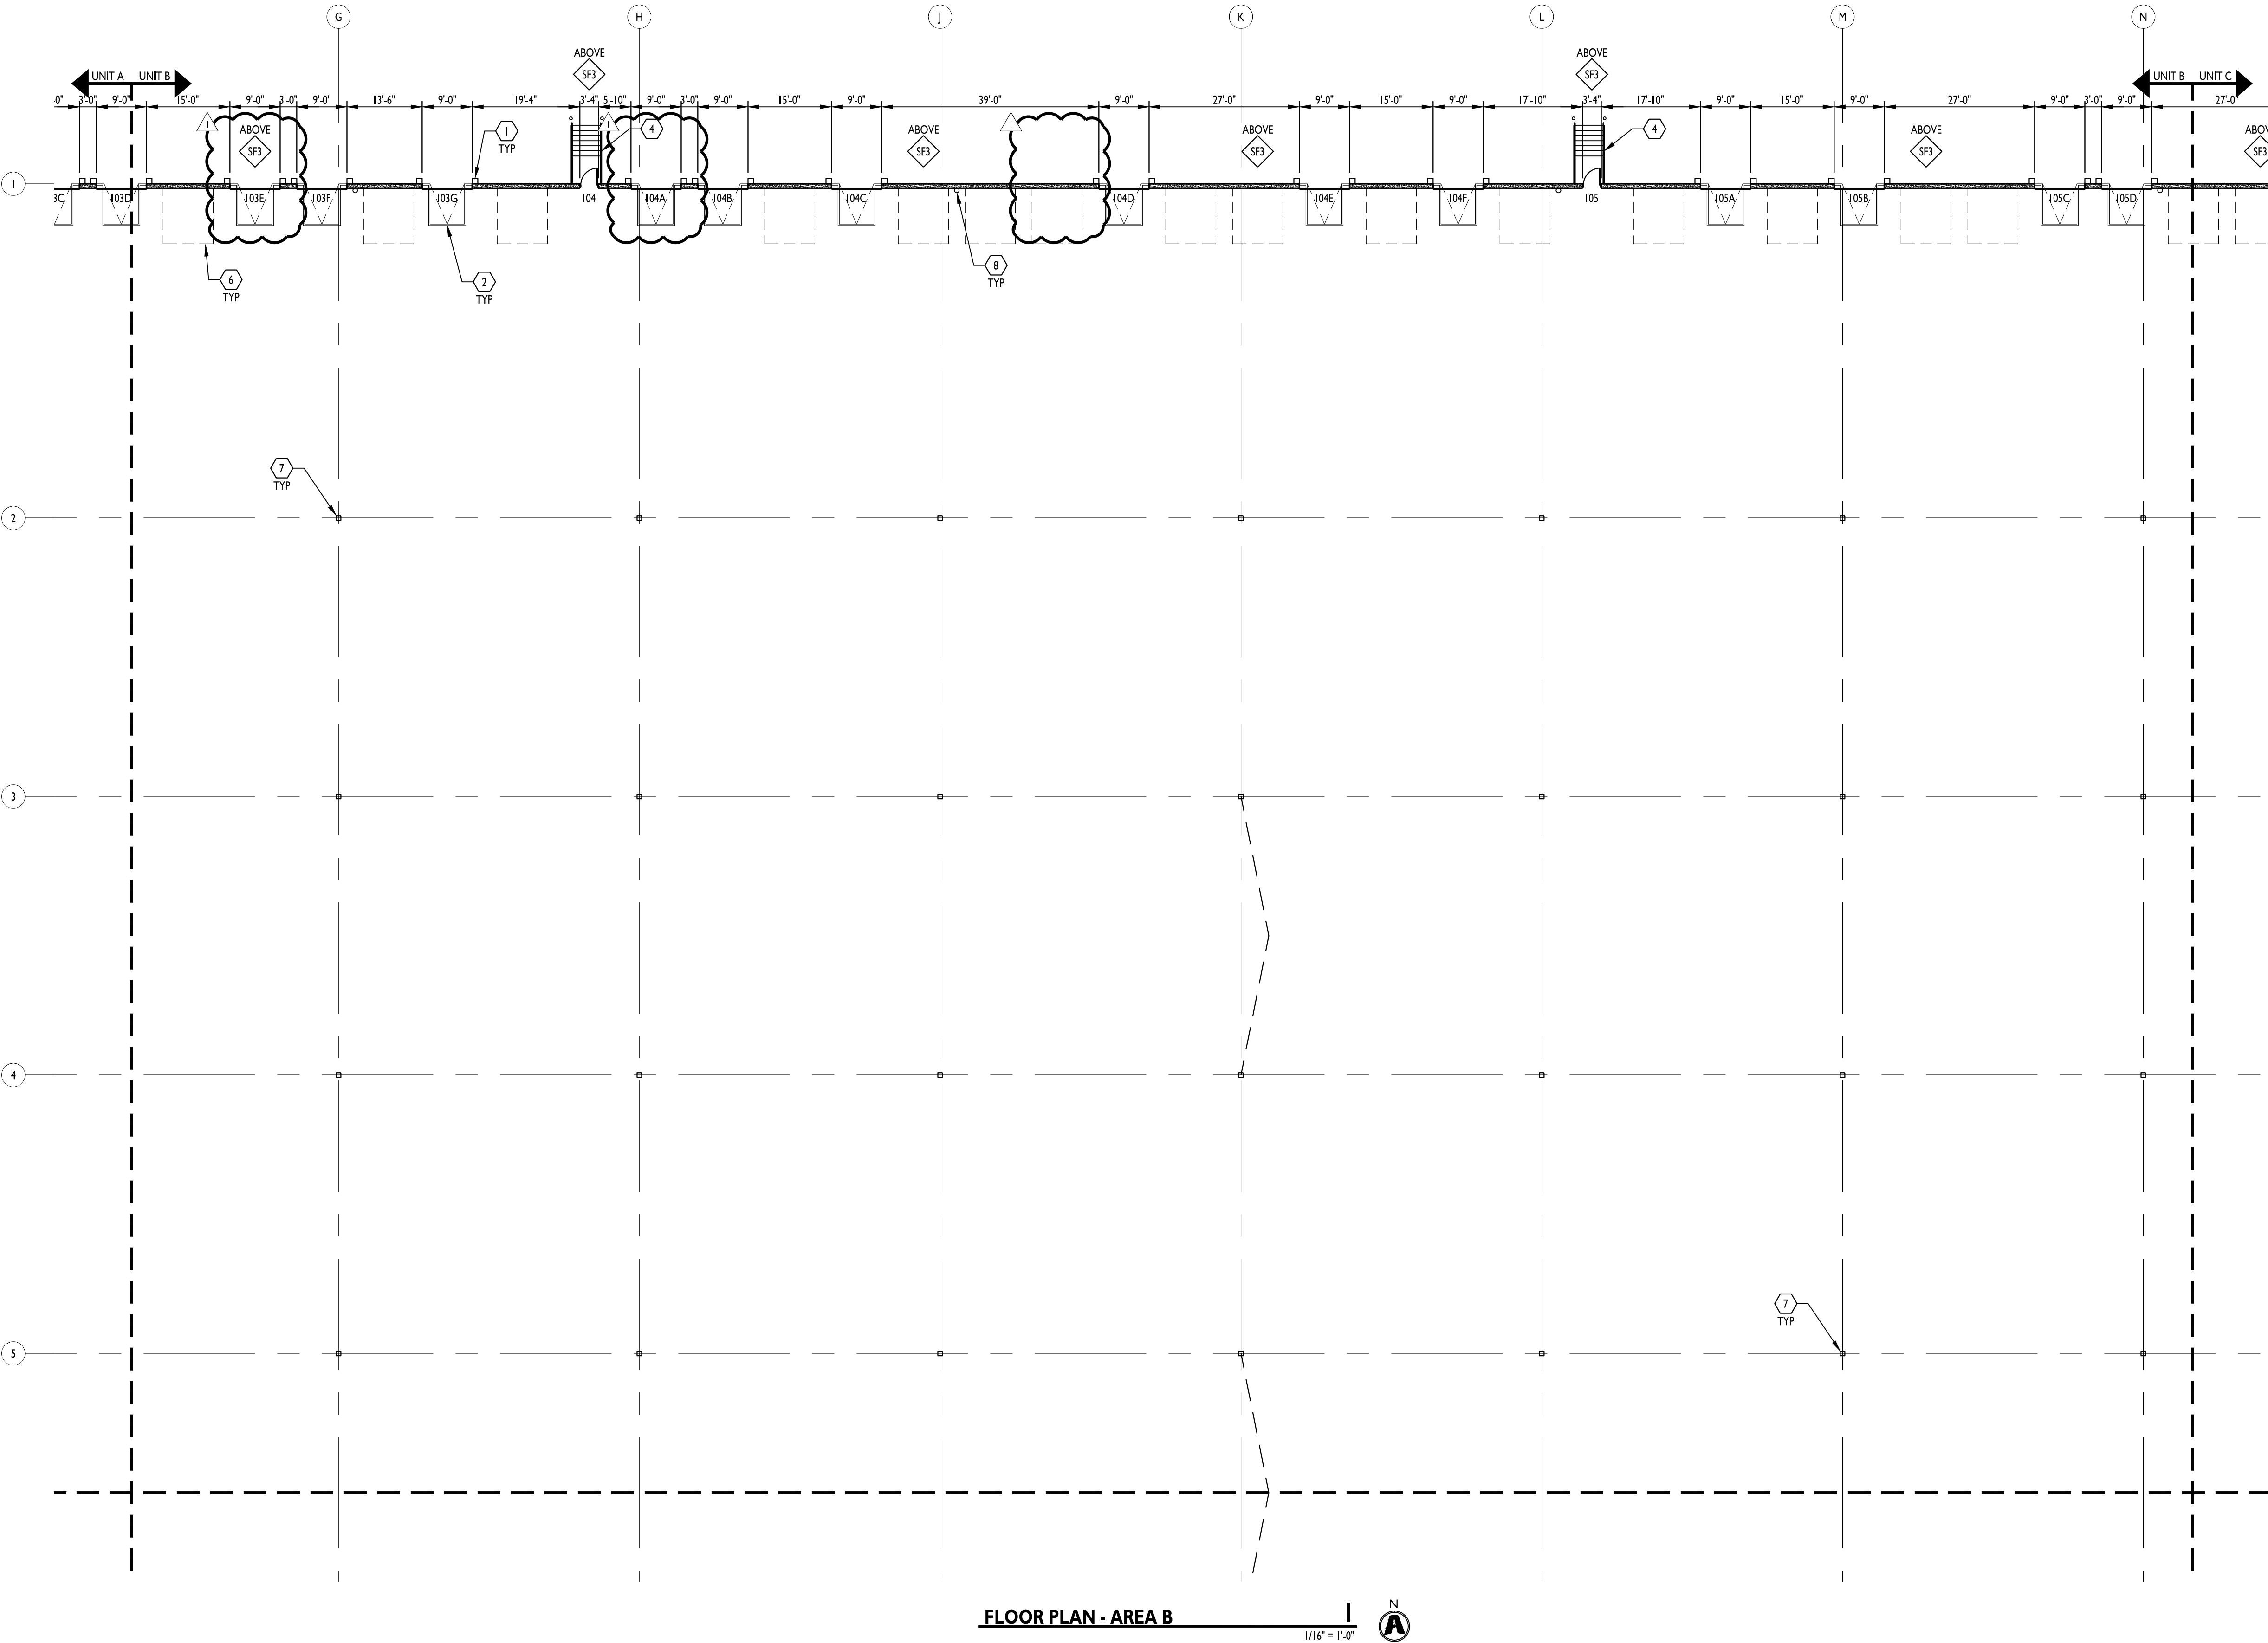


FLOOR PLAN - AREA B

1/16" = 1'-0"
N

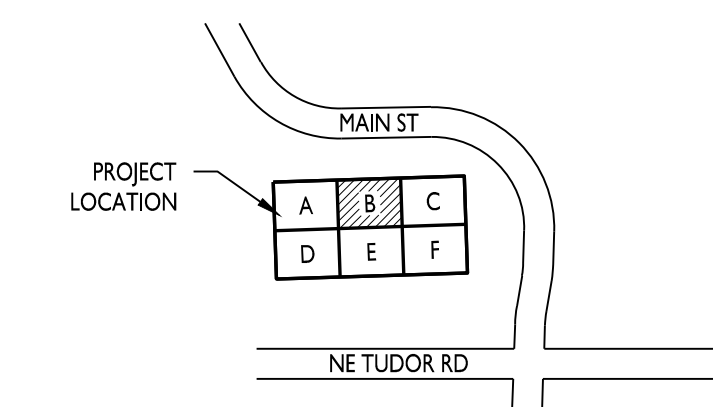


KEY PLAN

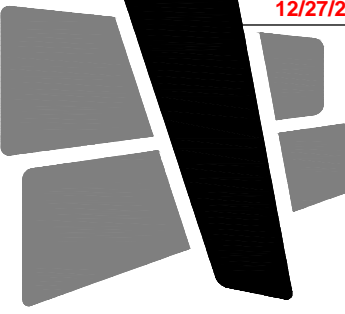

CURRAN
ARCHITECTURE

5719 LAWTON LOOP E. DR. #212
INDIANAPOLIS, IN 46216
O :: 317 . 288 . 0681
F :: 317 . 288 . 0753

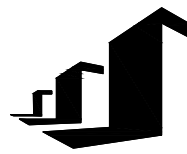

SCANNELL
PROPERTIES

GENERAL NOTES

- CONTRACTOR SHALL BE RESPONSIBLE FOR VERIFICATION OF ALL DIMENSIONS AND JOB CONDITIONS. ANY DEVIATION FROM WHAT IS NOTED IN DRAWINGS SHALL BE BROUGHT TO THE ATTENTION OF THE ARCHITECT IMMEDIATELY.
- ALL DIMENSIONS SHOWN ARE FACE OF BRICK, MASONRY OR METAL STUD FRAMING, UNLESS OTHERWISE NOTED.
- PROVIDE DEEP LEG DEFLECTION TRACK AT ALL METAL STUD CONNECTIONS WITH STRUCTURE ABOVE, TYPICAL.
- PROVIDE FIRE RATED WOOD BLOCKING IN METAL STUD WALLS FOR ANY WALL SUPPORTED ITEMS.
- PROVIDE APPROVED FIRE RATED STOPPING MATERIALS IN ANY OPENINGS IN FIRE RATED ASSEMBLIES.
- REFER TO DOOR AND WINDOW SCHEDULES FOR ALL MATERIALS, FINISHES, AND HARDWARE INFORMATION.
- REFER TO EXTERIOR ELEVATIONS FOR ALL BRICK, MASONRY, AND OTHER EXPANSION JOINT LOCATIONS.
- ALL MATERIALS LOCATED IN CEILING PLENUM SHALL BE RATED FOR SUCH INSTALLATION OR PROTECTED TO PROVIDE COMPLIANCE. THIS INCLUDES BUT IS NOT LIMITED TO INSULATION (FHC 25/50) POWER AND LOW VOLTAGE WIRING, TELECOMMUNICATIONS CABLING, PLUMBING SUPPLY AND DRAIN LINES AND SUPPORTING BRACKETS AND/OR BLOCKING FOR CEILING HUNG ITEMS.
- PRIOR TO ORDERING ANY PRODUCTS, CONTRACTOR SHALL SUBMIT SAMPLES TO THE ARCHITECT OF ALL FINISH MATERIALS TO BE USED ON THE PROJECT. THE CONTRACTOR SHALL BEAR SOLE RESPONSIBILITY FOR ANY MATERIALS ORDERED INCORRECTLY WHEN THAT MATERIAL WAS NOT REVIEWED BY THE ARCHITECT.
- PROVIDE CONCRETE FILLED STEEL PIPE BOLLARDS AT ALL REQUIRED UTILITY EQUIPMENT LOCATIONS SUCH AS GAS METERS, ELECTRICAL TRANSFORMER PANELS, ETC. COORDINATE WITH UTILITY COMPANY AND CONTRACTORS, WHEN APPLICABLE, FOR NECESSARY LOCATIONS. REFER TO CIVIL DRAWINGS FOR BOLLARD SPECIFICATIONS AND ADDITIONAL INFORMATION.
- ALL DOORS, UNLESS OTHERWISE NOTED, TO HAVE HINGE SIDE SET 4" FROM CORNER SHOWN TO OUTSIDE OF FRAME.
- UNLESS SPECIFIED ELSEWHERE, ALL INTERIOR SLABS AND SLAB INFILLS TO BE FF-50/FL-25 OVERALL AND FF-35/FL-25 LOCAL.
- ALL EXIT DOORS TO HAVE TACTILE EXIT SIGNAGE PER 703.4 OF THE ANSI 117.1 2009.

KEYED NOTES

- DOCK SEALS.
- DOCK LEVELER. COORDINATE W/ MANUFACTURER FOR SIZING AND SLAB PREP.
- CONCRETE FILLED PIPE BOLLARDS.
- GALVANIZED STEEL STAIRS. REFER TO 11/A502 & 12/A502.
- METAL CANOPY ABOVE. REFER TO WALL SECTIONS & ELEVATIONS.
- LOCATION OF FUTURE DOCK DOORS. PRECAST PANELS TO BE FABRICATED TO ALLOW FOR FUTURE REMOVAL OF CONCRETE IN THESE LOCATIONS. REFER TO ELEVATIONS FOR ADDITIONAL INFORMATION.
- STEEL COLUMNS PROVIDE PANTED FINISH.
- COORDINATE ROOF DRAIN LEADERS SO THAT IT IS CENTERED BETWEEN DOORS.
- KNOX BOX LOCATION. COORDINATE WITH FIRE DEPARTMENT.

THIS DRAWING AND THE IDEAS, DESIGNS AND CONCEPTS CONTAINED HEREIN ARE THE EXCLUSIVE INTELLECTUAL PROPERTY OF CURRAN ARCHITECTURE, AND ARE NOT TO BE USED OR REPRODUCED, WHOLE OR IN PART, WITHOUT THE WRITTEN CONSENT OF CURRAN ARCHITECTURE.
© COPYRIGHT 2021, CURRAN ARCHITECTURE

PROJECT INFORMATION

LEE'S SUMMIT LOGISTICS
BUILDING A LOT I

NW CORNER OF
NE TUDOR RD & MAIN ST
LEE'S SUMMIT, MO 64086



ISSUE DATES

PERMIT SET	02.18.22
PERMIT REVIEW COMMENTS	05.16.22


210300

FLOOR PLAN
AREA C

A104

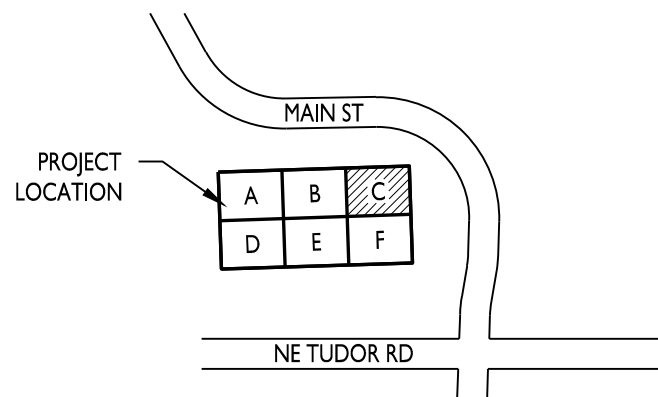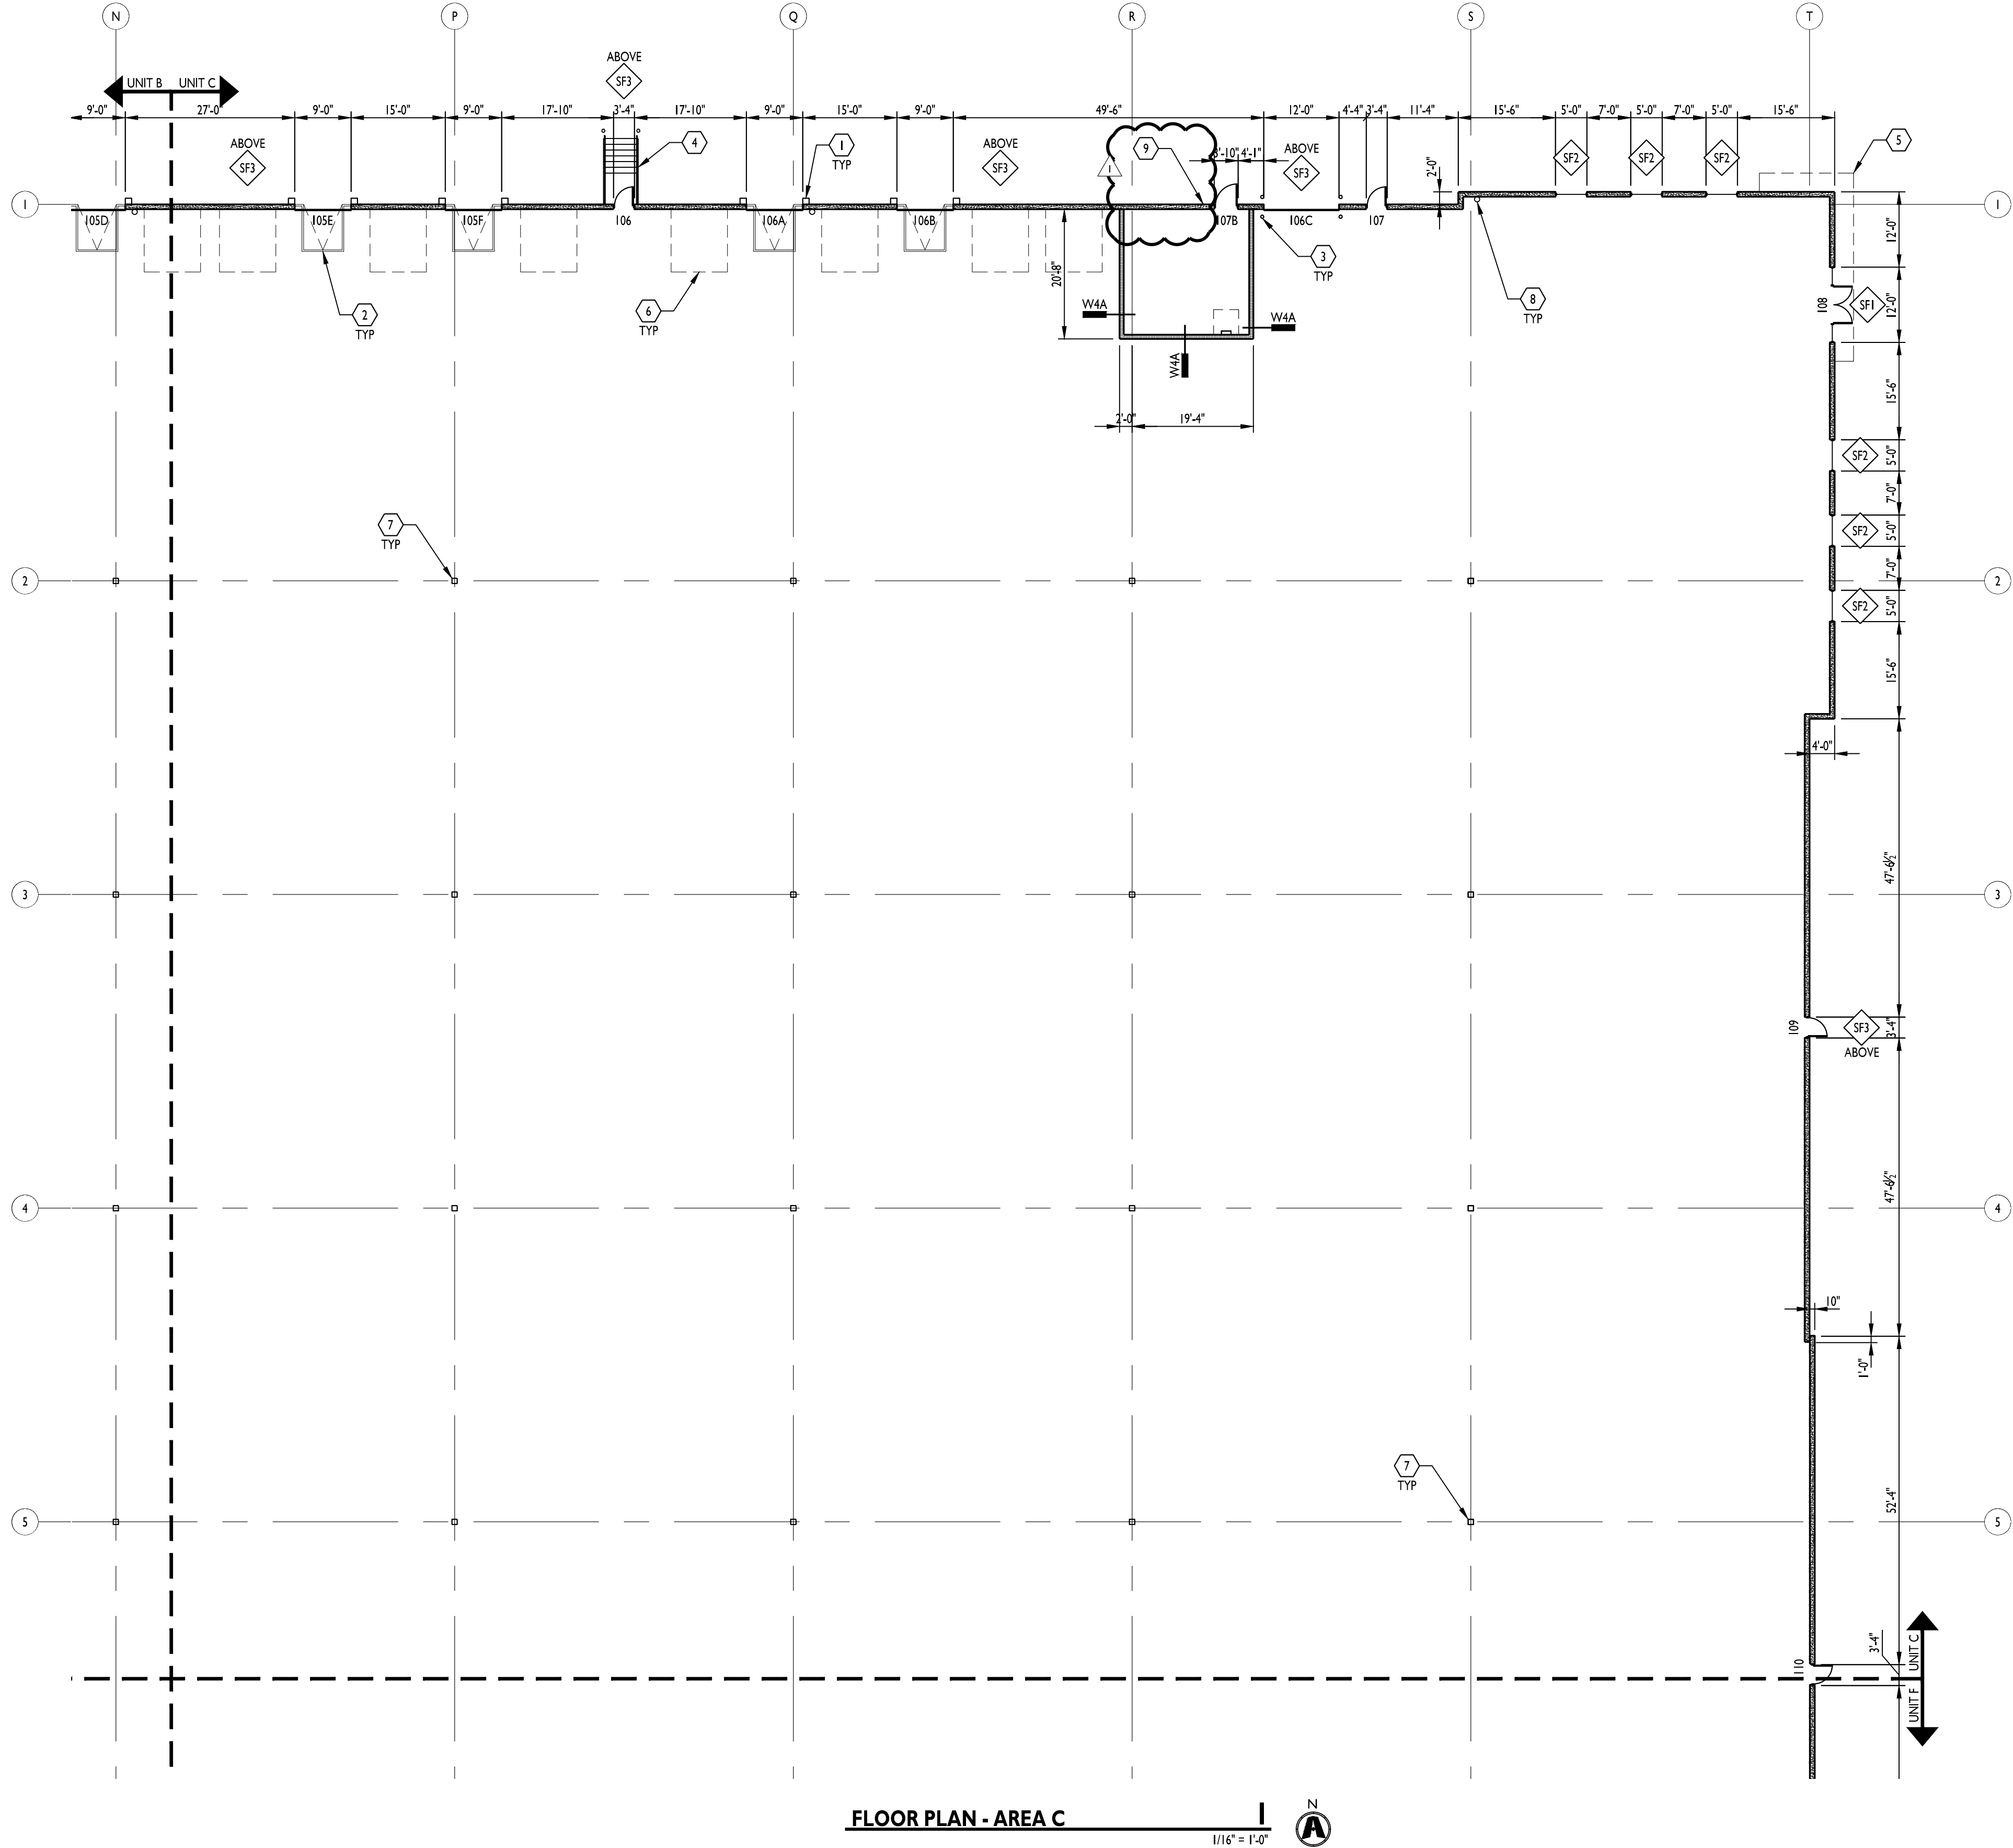


KEY PLAN

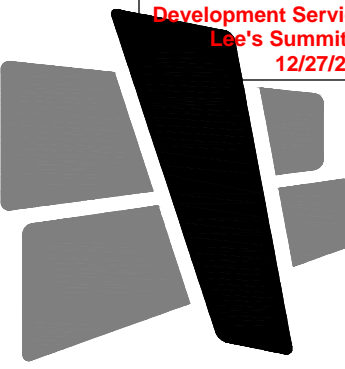

CURRAN
ARCHITECTURE

5719 LAWTON LOOP E. DR. #212
INDIANAPOLIS, IN 46216
O :: 317 . 288 . 0681
F :: 317 . 288 . 0753

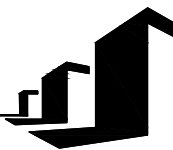

SCANNELL
PROPERTIES

GENERAL NOTES

- CONTRACTOR SHALL BE RESPONSIBLE FOR VERIFICATION OF ALL DIMENSIONS AND JOB CONDITIONS. ANY DEVIATION FROM WHAT IS NOTED IN DRAWINGS SHALL BE BROUGHT TO THE ATTENTION OF THE ARCHITECT IMMEDIATELY.
- ALL DIMENSIONS SHOWN ARE FACE OF BRICK, MASONRY OR METAL STUD FRAMING, UNLESS OTHERWISE NOTED.
- PROVIDE DEEP LEG DEFLECTION TRACK AT ALL METAL STUD CONNECTIONS WITH STRUCTURE ABOVE, TYPICAL.
- PROVIDE FIRE RATED WOOD BLOCKING IN METAL STUD WALLS FOR ANY WALL SUPPORTED ITEMS.
- PROVIDE APPROVED FIRE RATED STOPPING MATERIALS IN ANY OPENINGS IN FIRE RATED ASSEMBLIES.
- REFER TO DOOR AND WINDOW SCHEDULES FOR ALL MATERIALS, FINISHES, AND HARDWARE INFORMATION.
- REFER TO EXTERIOR ELEVATIONS FOR ALL BRICK, MASONRY, AND OTHER EXPANSION JOINT LOCATIONS.
- ALL MATERIALS LOCATED IN CEILING PLENUM SHALL BE RATED FOR SUCH INSTALLATION OR PROTECTED TO PROVIDE COMPLIANCE. THIS INCLUDES BUT IS NOT LIMITED TO INSULATION (FHC 25/50) POWER AND LOW VOLTAGE WIRING, TELECOMMUNICATIONS CABLING, PLUMBING SUPPLY AND DRAIN LINES AND SUPPORTING BRACKETS AND/OR BLOCKING FOR CEILING HUNG ITEMS.
- PRIOR TO ORDERING ANY PRODUCTS, CONTRACTOR SHALL SUBMIT SAMPLES TO THE ARCHITECT OF ALL FINISH MATERIALS TO BE USED ON THE PROJECT. THE CONTRACTOR SHALL BEAR SOLE RESPONSIBILITY FOR ANY MATERIALS ORDERED INCORRECTLY WHEN THAT MATERIAL WAS NOT REVIEWED BY THE ARCHITECT.
- PROVIDE CONCRETE FILLED STEEL PIPE BOLLARDS AT ALL REQUIRED UTILITY EQUIPMENT LOCATIONS SUCH AS GAS METERS, ELECTRICAL TRANSFORMER PANELS, ETC. COORDINATE WITH UTILITY COMPANY AND CONTRACTORS, WHEN APPLICABLE, FOR NECESSARY LOCATIONS. REFER TO CIVIL DRAWINGS FOR BOLLARD SPECIFICATIONS AND ADDITIONAL INFORMATION.
- ALL DOORS, UNLESS OTHERWISE NOTED, TO HAVE HINGE SIDE SET 4" FROM CORNER SHOWN TO OUTSIDE OF FRAME.
- UNLESS SPECIFIED ELSEWHERE, ALL INTERIOR SLABS AND SLAB INFILLS TO BE FF-50/FL-25 OVERALL AND FF-35/FL-25 LOCAL.
- ALL EXIT DOORS TO HAVE TACTILE EXIT SIGNAGE PER 703.4 OF THE ANSI 117.1 2009.

KEYED NOTES

- DOCK SEALS.
- DOCK LEVELER. COORDINATE W/ MANUFACTURER FOR SIZING AND SLAB PREP.
- CONCRETE FILLED PIPE BOLLARDS.
- GALVANIZED STEEL STAIRS. REFER TO 11/A502 & 12/A502.
- METAL CANOPY ABOVE. REFER TO WALL SECTIONS & ELEVATIONS.
- LOCATION OF FUTURE DOCK DOORS. PRECAST PANELS TO BE FABRICATED TO ALLOW FOR FUTURE REMOVAL OF CONCRETE IN THESE LOCATIONS. REFER TO ELEVATIONS FOR ADDITIONAL INFORMATION.
- STEEL COLUMNS PROVIDE PANTED FINISH.
- COORDINATE ROOF DRAIN LEADERS SO THAT IT IS CENTERED BETWEEN DOORS
- KNOX BOX LOCATION. COORDINATE WITH FIRE DEPARTMENT.

THIS DRAWING AND THE IDEAS, DESIGNS AND CONCEPTS CONTAINED HEREIN ARE THE EXCLUSIVE INTELLECTUAL PROPERTY OF CURRAN ARCHITECTURE, AND ARE NOT TO BE USED OR REPRODUCED, WHOLE OR IN PART, WITHOUT THE WRITTEN CONSENT OF CURRAN ARCHITECTURE.
© COPYRIGHT 2021, CURRAN ARCHITECTURE

PROJECT INFORMATION

LEE'S SUMMIT LOGISTICS
BUILDING A LOT I

NW CORNER OF
NE TUDOR RD & MAIN ST
LEE'S SUMMIT, MO 64086


ISSUE DATES

PERMIT SET	02.18.22
TENANT COORDINATION	06.06.22


210300

FLOOR PLAN
AREA D


A105

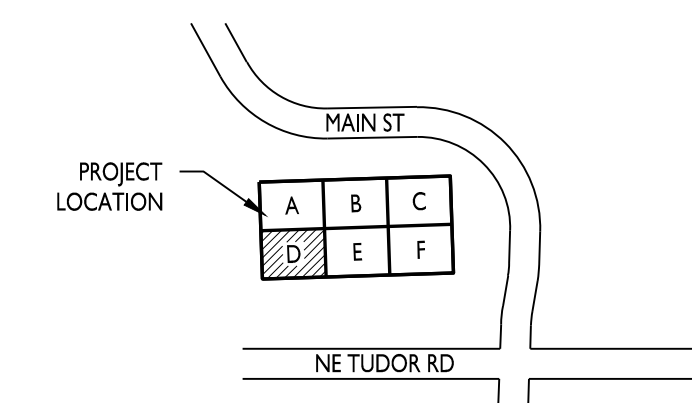

KEY PLAN

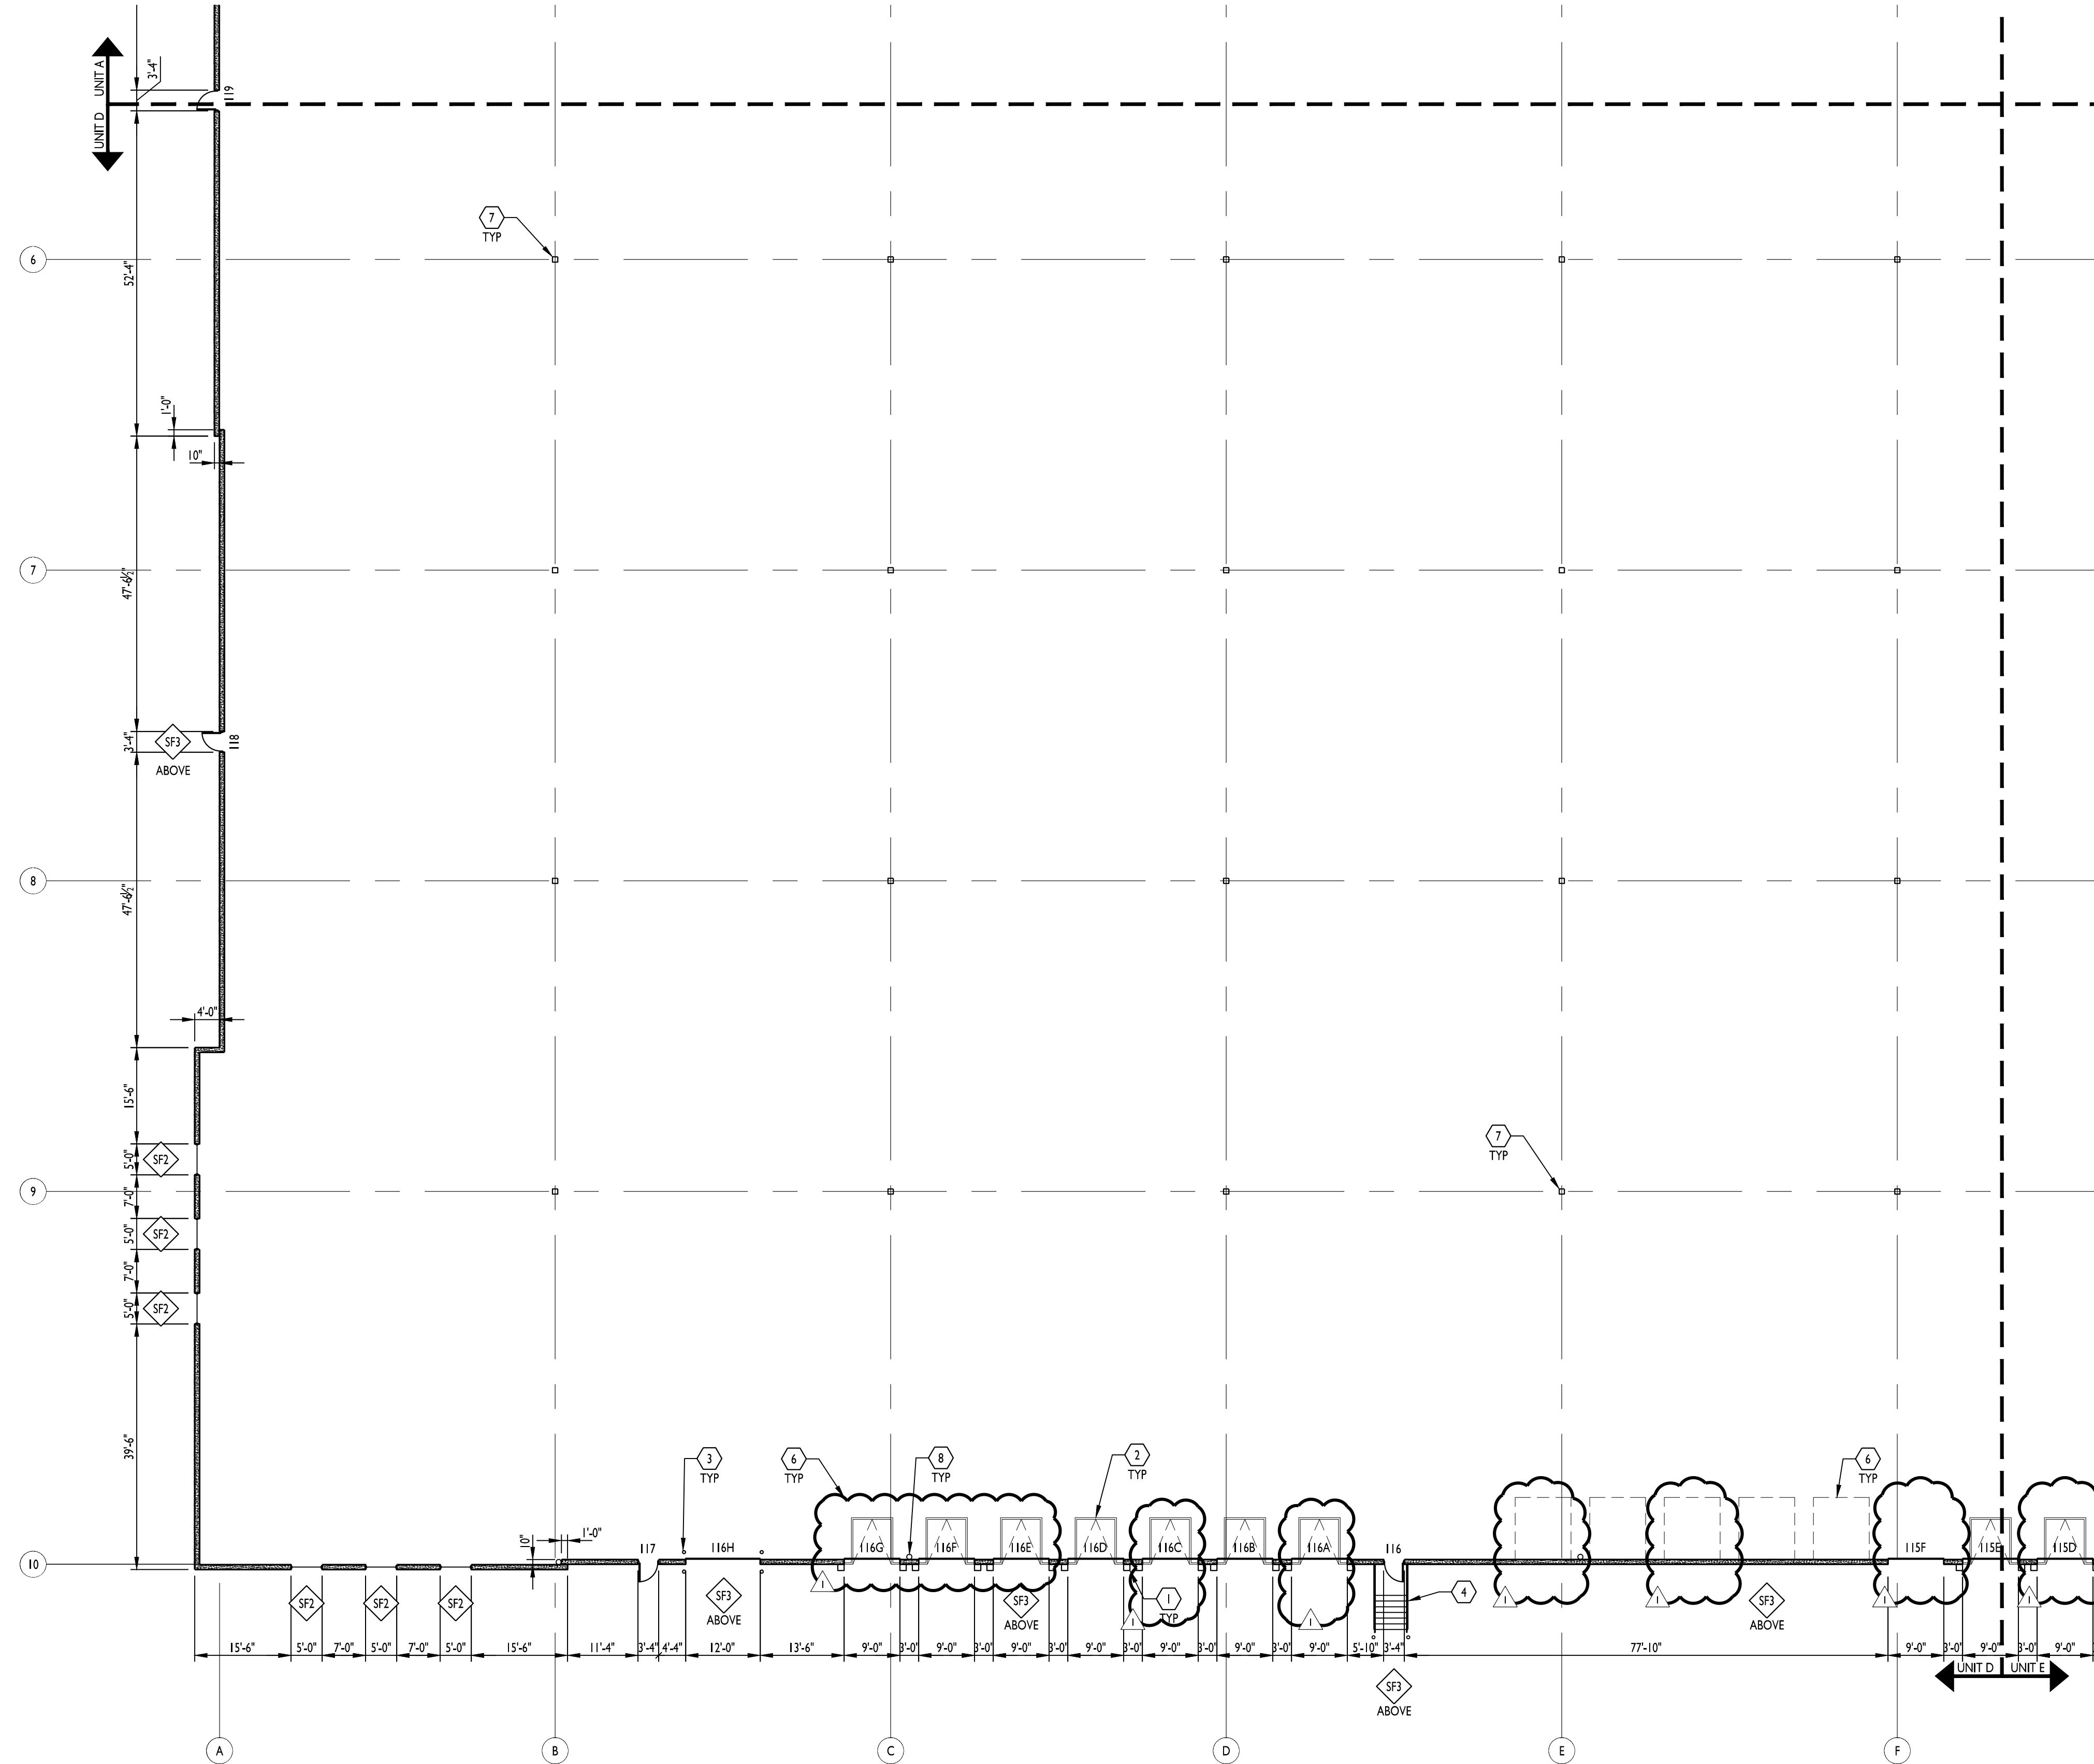


FLOOR PLAN - AREA D
1/16" = 1'-0"
N

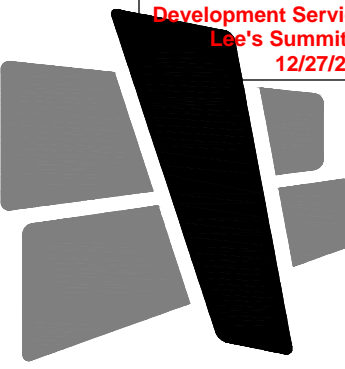

CURRAN
ARCHITECTURE

5719 LAWTON LOOP E. DR. #212
INDIANAPOLIS, IN 46216
O :: 317 . 288 . 0681
F :: 317 . 288 . 0753

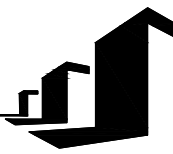

SCANNELL
PROPERTIES

GENERAL NOTES

- CONTRACTOR SHALL BE RESPONSIBLE FOR VERIFICATION OF ALL DIMENSIONS AND JOB CONDITIONS. ANY DEVIATION FROM WHAT IS NOTED IN DRAWINGS SHALL BE BROUGHT TO THE ATTENTION OF THE ARCHITECT IMMEDIATELY.
- ALL DIMENSIONS SHOWN ARE FACE OF BRICK, MASONRY OR METAL STUD FRAMING, UNLESS OTHERWISE NOTED.
- PROVIDE DEEP LEG DEFLECTION TRACK AT ALL METAL STUD CONNECTIONS WITH STRUCTURE ABOVE, TYPICAL.
- PROVIDE FIRE RATED WOOD BLOCKING IN METAL STUD WALLS FOR ANY WALL SUPPORTED ITEMS.
- PROVIDE APPROVED FIRE RATED STOPPING MATERIALS IN ANY OPENINGS IN FIRE RATED ASSEMBLIES.
- REFER TO DOOR AND WINDOW SCHEDULES FOR ALL MATERIALS, FINISHES, AND HARDWARE INFORMATION.
- REFER TO EXTERIOR ELEVATIONS FOR ALL BRICK, MASONRY, AND OTHER EXPANSION JOINT LOCATIONS.
- ALL MATERIALS LOCATED IN CEILING PLENUM SHALL BE RATED FOR SUCH INSTALLATION OR PROTECTED TO PROVIDE COMPLIANCE. THIS INCLUDES BUT IS NOT LIMITED TO INSULATION (FHC 25/50) POWER AND LOW VOLTAGE WIRING, TELECOMMUNICATIONS CABLING, PLUMBING SUPPLY AND DRAIN LINES AND SUPPORTING BRACKETS AND/OR BLOCKING FOR CEILING HUNG ITEMS.
- PRIOR TO ORDERING ANY PRODUCTS, CONTRACTOR SHALL SUBMIT SAMPLES TO THE ARCHITECT OF ALL FINISH MATERIALS TO BE USED ON THE PROJECT. THE CONTRACTOR SHALL BEAR SOLE RESPONSIBILITY FOR ANY MATERIALS ORDERED INCORRECTLY WHEN THAT MATERIAL WAS NOT REVIEWED BY THE ARCHITECT.
- PROVIDE CONCRETE FILLED STEEL PIPE BOLLARDS AT ALL REQUIRED UTILITY EQUIPMENT LOCATIONS SUCH AS GAS METERS, ELECTRICAL TRANSFORMER PANELS, ETC. COORDINATE WITH UTILITY COMPANY AND CONTRACTORS, WHEN APPLICABLE, FOR NECESSARY LOCATIONS. REFER TO CIVIL DRAWINGS FOR BOLLARD SPECIFICATIONS AND ADDITIONAL INFORMATION.
- ALL DOORS, UNLESS OTHERWISE NOTED, TO HAVE HINGE SIDE SET 4" FROM CORNER SHOWN TO OUTSIDE OF FRAME.
- UNLESS SPECIFIED ELSEWHERE, ALL INTERIOR SLABS AND SLAB INFILLS TO BE FF-50/FL-25 OVERALL AND FF-35/FL-25 LOCAL.
- ALL EXIT DOORS TO HAVE TACTILE EXIT SIGNAGE PER 703.4 OF THE ANSI 117.1 2009.

KEYED NOTES

- DOCK SEALS.
- DOCK LEVELER. COORDINATE W/ MANUFACTURER FOR SIZING AND SLAB PREP.
- CONCRETE FILLED PIPE BOLLARDS.
- GALVANIZED STEEL STAIRS. REFER TO 11/A502 & 12/A502.
- METAL CANOPY ABOVE. REFER TO WALL SECTIONS & ELEVATIONS.
- LOCATION OF FUTURE DOCK DOORS. PRECAST PANELS TO BE FABRICATED TO ALLOW FOR FUTURE REMOVAL OF CONCRETE IN THESE LOCATIONS. REFER TO ELEVATIONS FOR ADDITIONAL INFORMATION.
- STEEL COLUMNS PROVIDE PANTED FINISH.
- COORDINATE ROOF DRAIN LEADERS SO THAT IT IS CENTERED BETWEEN DOORS.
- KNOX BOX LOCATION. COORDINATE WITH FIRE DEPARTMENT.

THIS DRAWING AND THE IDEAS, DESIGNS AND CONCEPTS CONTAINED HEREIN ARE THE EXCLUSIVE INTELLECTUAL PROPERTY OF CURRAN ARCHITECTURE, AND ARE NOT TO BE USED OR REPRODUCED, WHOLE OR IN PART, WITHOUT THE WRITTEN CONSENT OF CURRAN ARCHITECTURE.
© COPYRIGHT 2021, CURRAN ARCHITECTURE


PROJECT INFORMATION

LEE'S SUMMIT LOGISTICS
BUILDING A LOT I


NW CORNER OF
NE TUDOR RD & MAIN ST
LEE'S SUMMIT, MO 64086

ISSUE DATES

PERMIT SET	02.18.22
TENANT COORDINATION	06.06.22

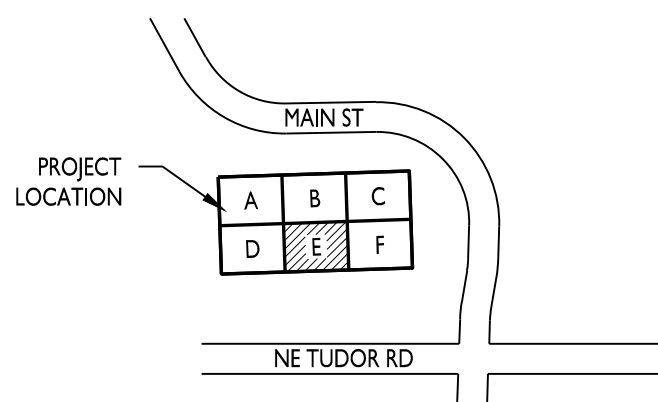

KEY PLAN

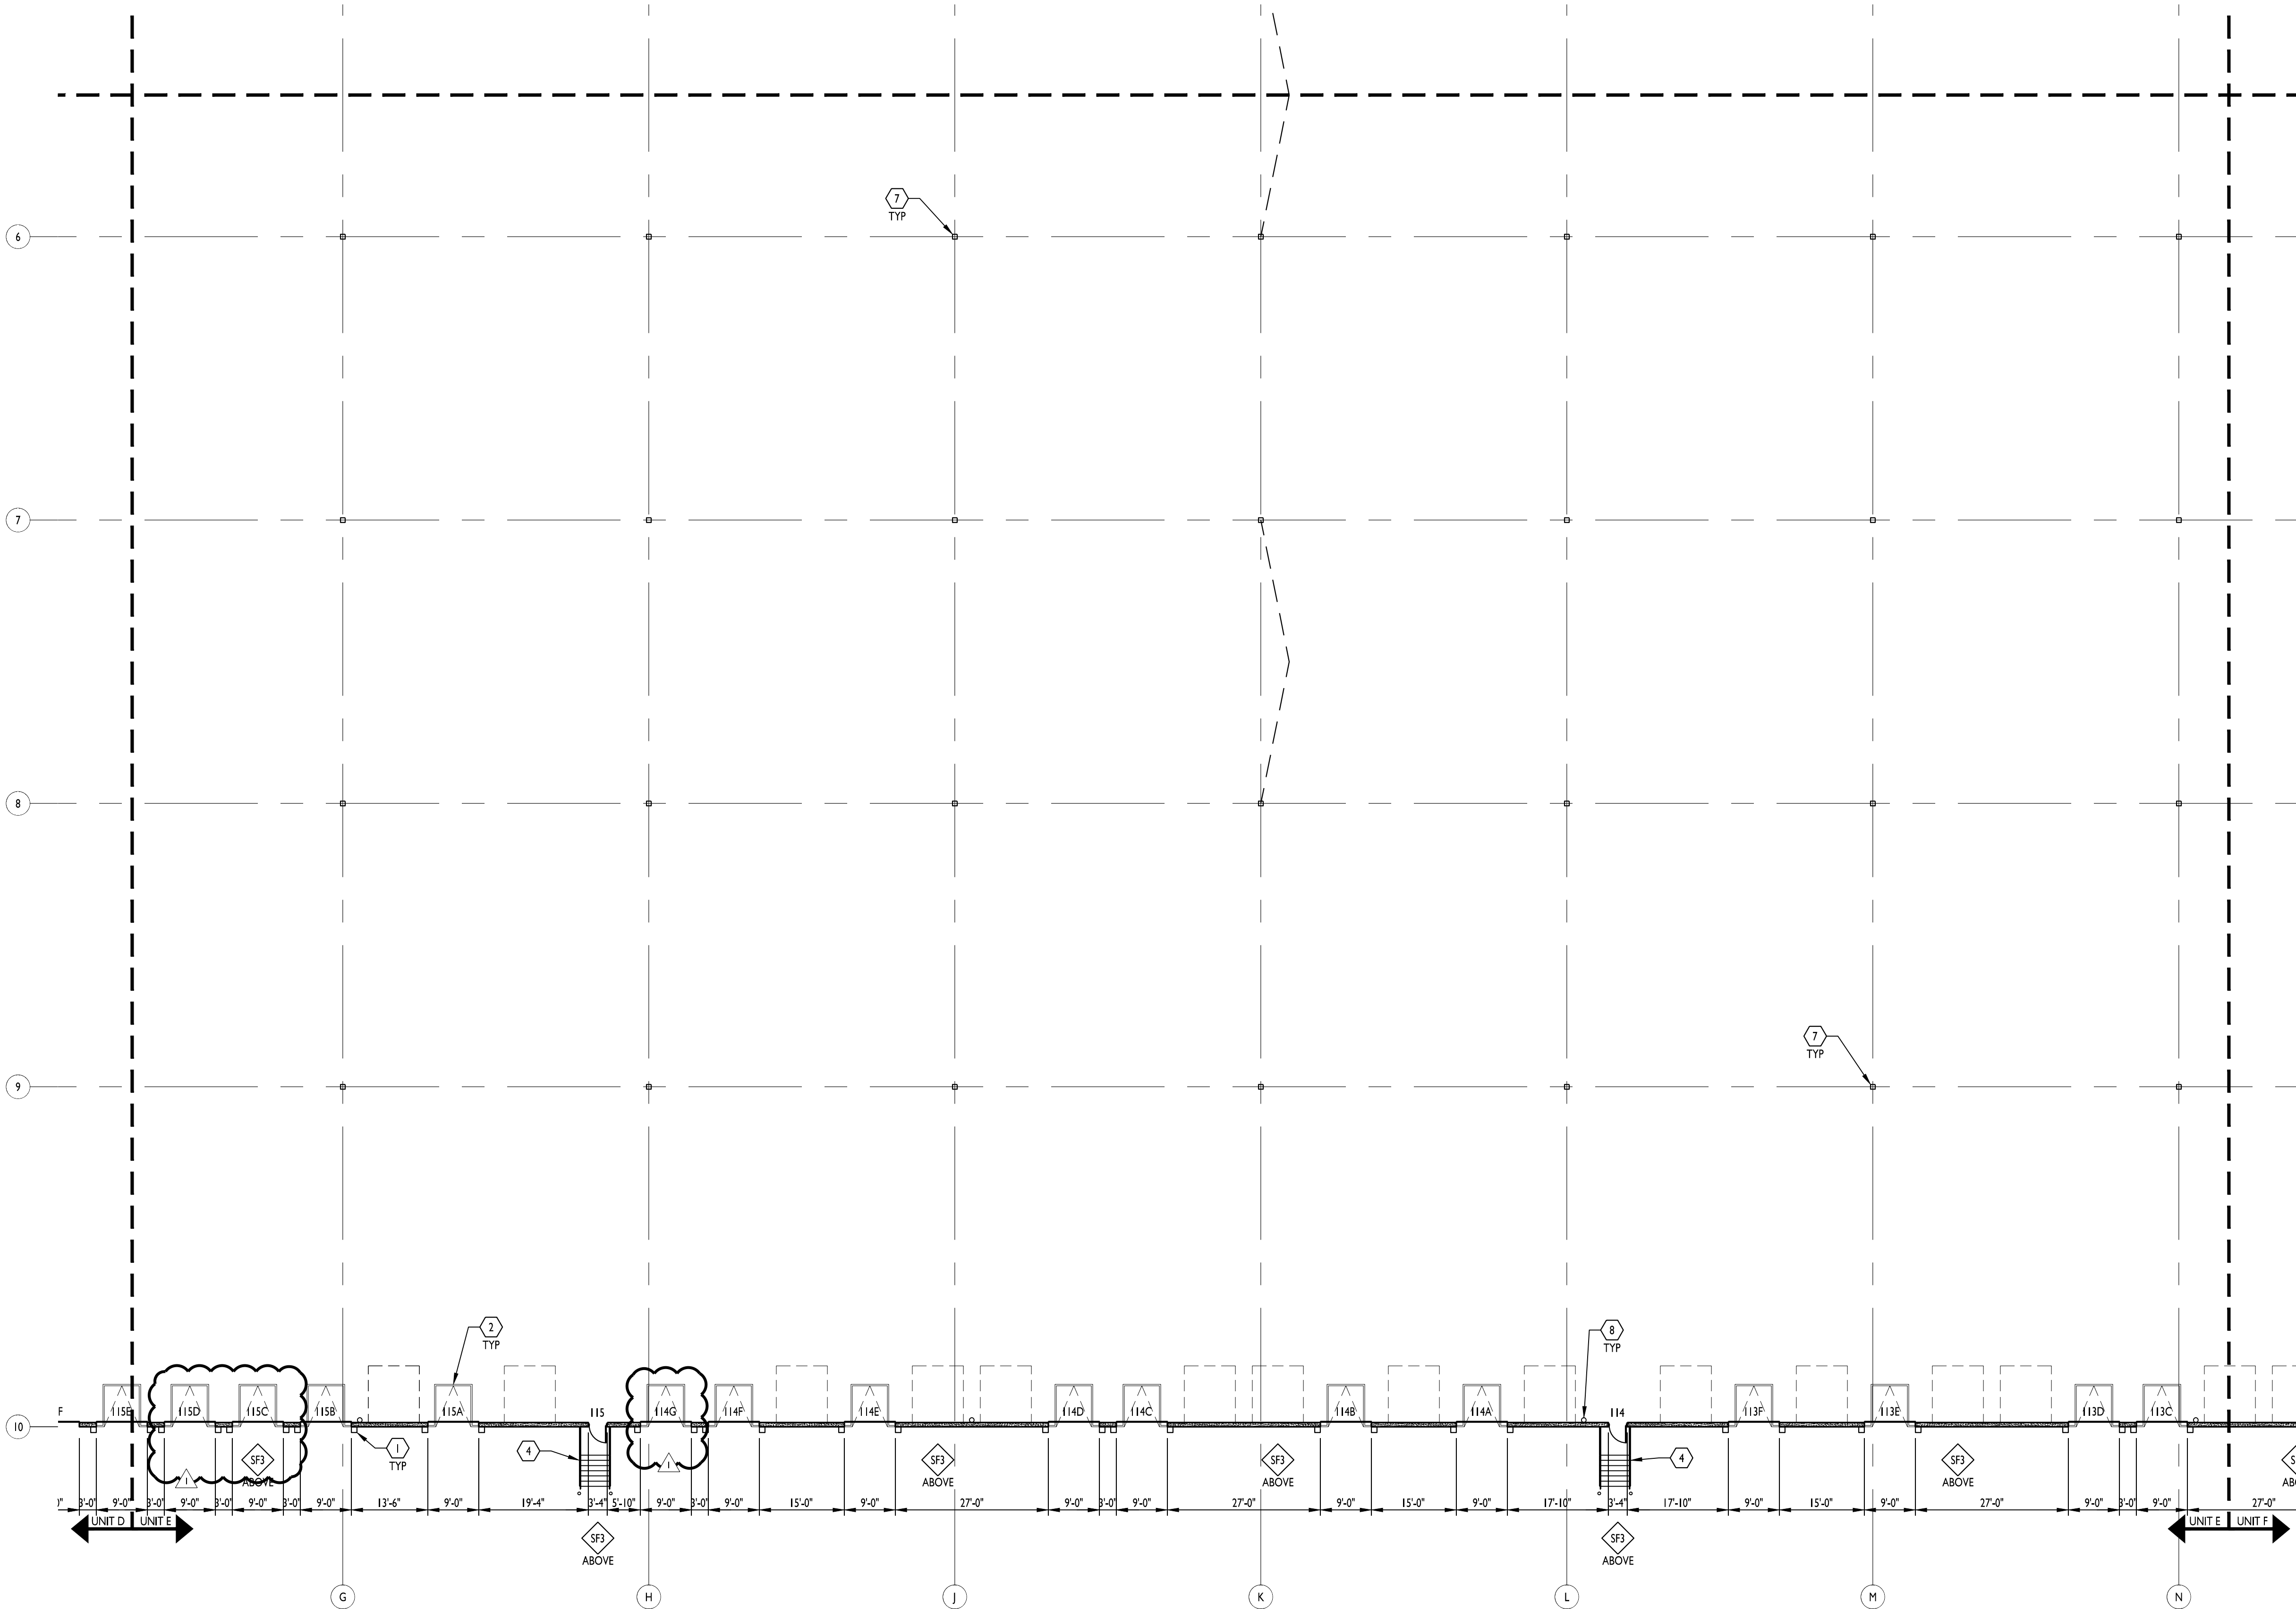

FLOOR PLAN - AREA E

1
1/16" = 1'-0"

210300


FLOOR PLAN
AREA E

A106



CURRAN
ARCHITECTURE

5719 LAWTON LOOP E. DR. #212
INDIANAPOLIS, IN 46216
O :: 317 . 288 . 0681
F :: 317 . 288 . 0753

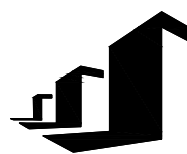

SCANNELL
PROPERTIES

GENERAL NOTES

- CONTRACTOR SHALL BE RESPONSIBLE FOR VERIFICATION OF ALL DIMENSIONS AND JOB CONDITIONS. ANY DEVIATION FROM WHAT IS NOTED IN DRAWINGS SHALL BE BROUGHT TO THE ATTENTION OF THE ARCHITECT IMMEDIATELY.
- ALL DIMENSIONS SHOWN ARE FACE OF BRICK, MASONRY OR METAL STUD FRAMING, UNLESS OTHERWISE NOTED.
- PROVIDE DEEP LEG DEFLECTION TRACK AT ALL METAL STUD CONNECTIONS WITH STRUCTURE ABOVE, TYPICAL.
- PROVIDE FIRE RATED WOOD BLOCKING IN METAL STUD WALLS FOR ANY WALL SUPPORTED ITEMS.
- PROVIDE APPROVED FIRE RATED STOPPING MATERIALS IN ANY OPENINGS IN FIRE RATED ASSEMBLIES.
- REFER TO DOOR AND WINDOW SCHEDULES FOR ALL MATERIALS, FINISHES, AND HARDWARE INFORMATION.
- REFER TO EXTERIOR ELEVATIONS FOR ALL BRICK, MASONRY, AND OTHER EXPANSION JOINT LOCATIONS.
- ALL MATERIALS LOCATED IN CEILING PLENUM SHALL BE RATED FOR SUCH INSTALLATION OR PROTECTED TO PROVIDE COMPLIANCE. THIS INCLUDES BUT IS NOT LIMITED TO INSULATION (FHC 25/50) POWER AND LOW VOLTAGE WIRING, TELECOMMUNICATIONS CABLING, PLUMBING SUPPLY AND DRAIN LINES AND SUPPORTING BRACKETS AND/OR BLOCKING FOR CEILING HUNG ITEMS.
- PRIOR TO ORDERING ANY PRODUCTS, CONTRACTOR SHALL SUBMIT SAMPLES TO THE ARCHITECT OF ALL FINISH MATERIALS TO BE USED ON THE PROJECT. THE CONTRACTOR SHALL BEAR SOLE RESPONSIBILITY FOR ANY MATERIALS ORDERED INCORRECTLY WHEN THAT MATERIAL WAS NOT REVIEWED BY THE ARCHITECT.
- PROVIDE CONCRETE FILLED STEEL PIPE BOLLARDS AT ALL REQUIRED UTILITY EQUIPMENT LOCATIONS SUCH AS GAS METERS, ELECTRICAL TRANSFORMER PANELS, ETC. COORDINATE WITH UTILITY COMPANY AND CONTRACTORS, WHEN APPLICABLE, FOR NECESSARY LOCATIONS. REFER TO CIVIL DRAWINGS FOR BOLLARD SPECIFICATIONS AND ADDITIONAL INFORMATION.
- ALL DOORS, UNLESS OTHERWISE NOTED, TO HAVE HINGE SIDE SET 4" FROM CORNER SHOWN TO OUTSIDE OF FRAME.
- UNLESS SPECIFIED ELSEWHERE, ALL INTERIOR SLABS AND SLAB INFILLS TO BE FF-50/FL-25 OVERALL AND FF-35/FL-25 LOCAL.
- ALL EXIT DOORS TO HAVE TACTILE EXIT SIGNAGE PER 703.4 OF THE ANSI 117.1 2009.

KEYED NOTES

- DOCK SEALS.
- DOCK LEVELER. COORDINATE W/ MANUFACTURER FOR SIZING AND SLAB PREP.
- CONCRETE FILLED PIPE BOLLARDS.
- GALVANIZED STEEL STAIRS. REFER TO 11/A502 & 12/A502.
- METAL CANOPY ABOVE. REFER TO WALL SECTIONS & ELEVATIONS.
- LOCATION OF FUTURE DOCK DOORS. PRECAST PANELS TO BE FABRICATED TO ALLOW FOR FUTURE REMOVAL OF CONCRETE IN THESE LOCATIONS. REFER TO ELEVATIONS FOR ADDITIONAL INFORMATION.
- STEEL COLUMNS PROVIDE PANTED FINISH.
- COORDINATE ROOF DRAIN LEADERS SO THAT IT IS CENTERED BETWEEN DOORS
- KNOX BOX LOCATION. COORDINATE WITH FIRE DEPARTMENT.

THIS DRAWING AND THE IDEAS, DESIGNS AND CONCEPTS CONTAINED HEREIN ARE THE EXCLUSIVE INTELLECTUAL PROPERTY OF CURRAN ARCHITECTURE, AND ARE NOT TO BE USED OR REPRODUCED, WHOLE OR IN PART, WITHOUT THE WRITTEN CONSENT OF CURRAN ARCHITECTURE.
© COPYRIGHT 2021, CURRAN ARCHITECTURE

PROJECT INFORMATION

LEE'S SUMMIT LOGISTICS
BUILDING A LOT I

NW CORNER OF
NE TUDOR RD & MAIN ST
LEE'S SUMMIT, MO 64086


ISSUE DATES

PERMIT SET 02.18.22

210300


FLOOR PLAN
AREA F

A107

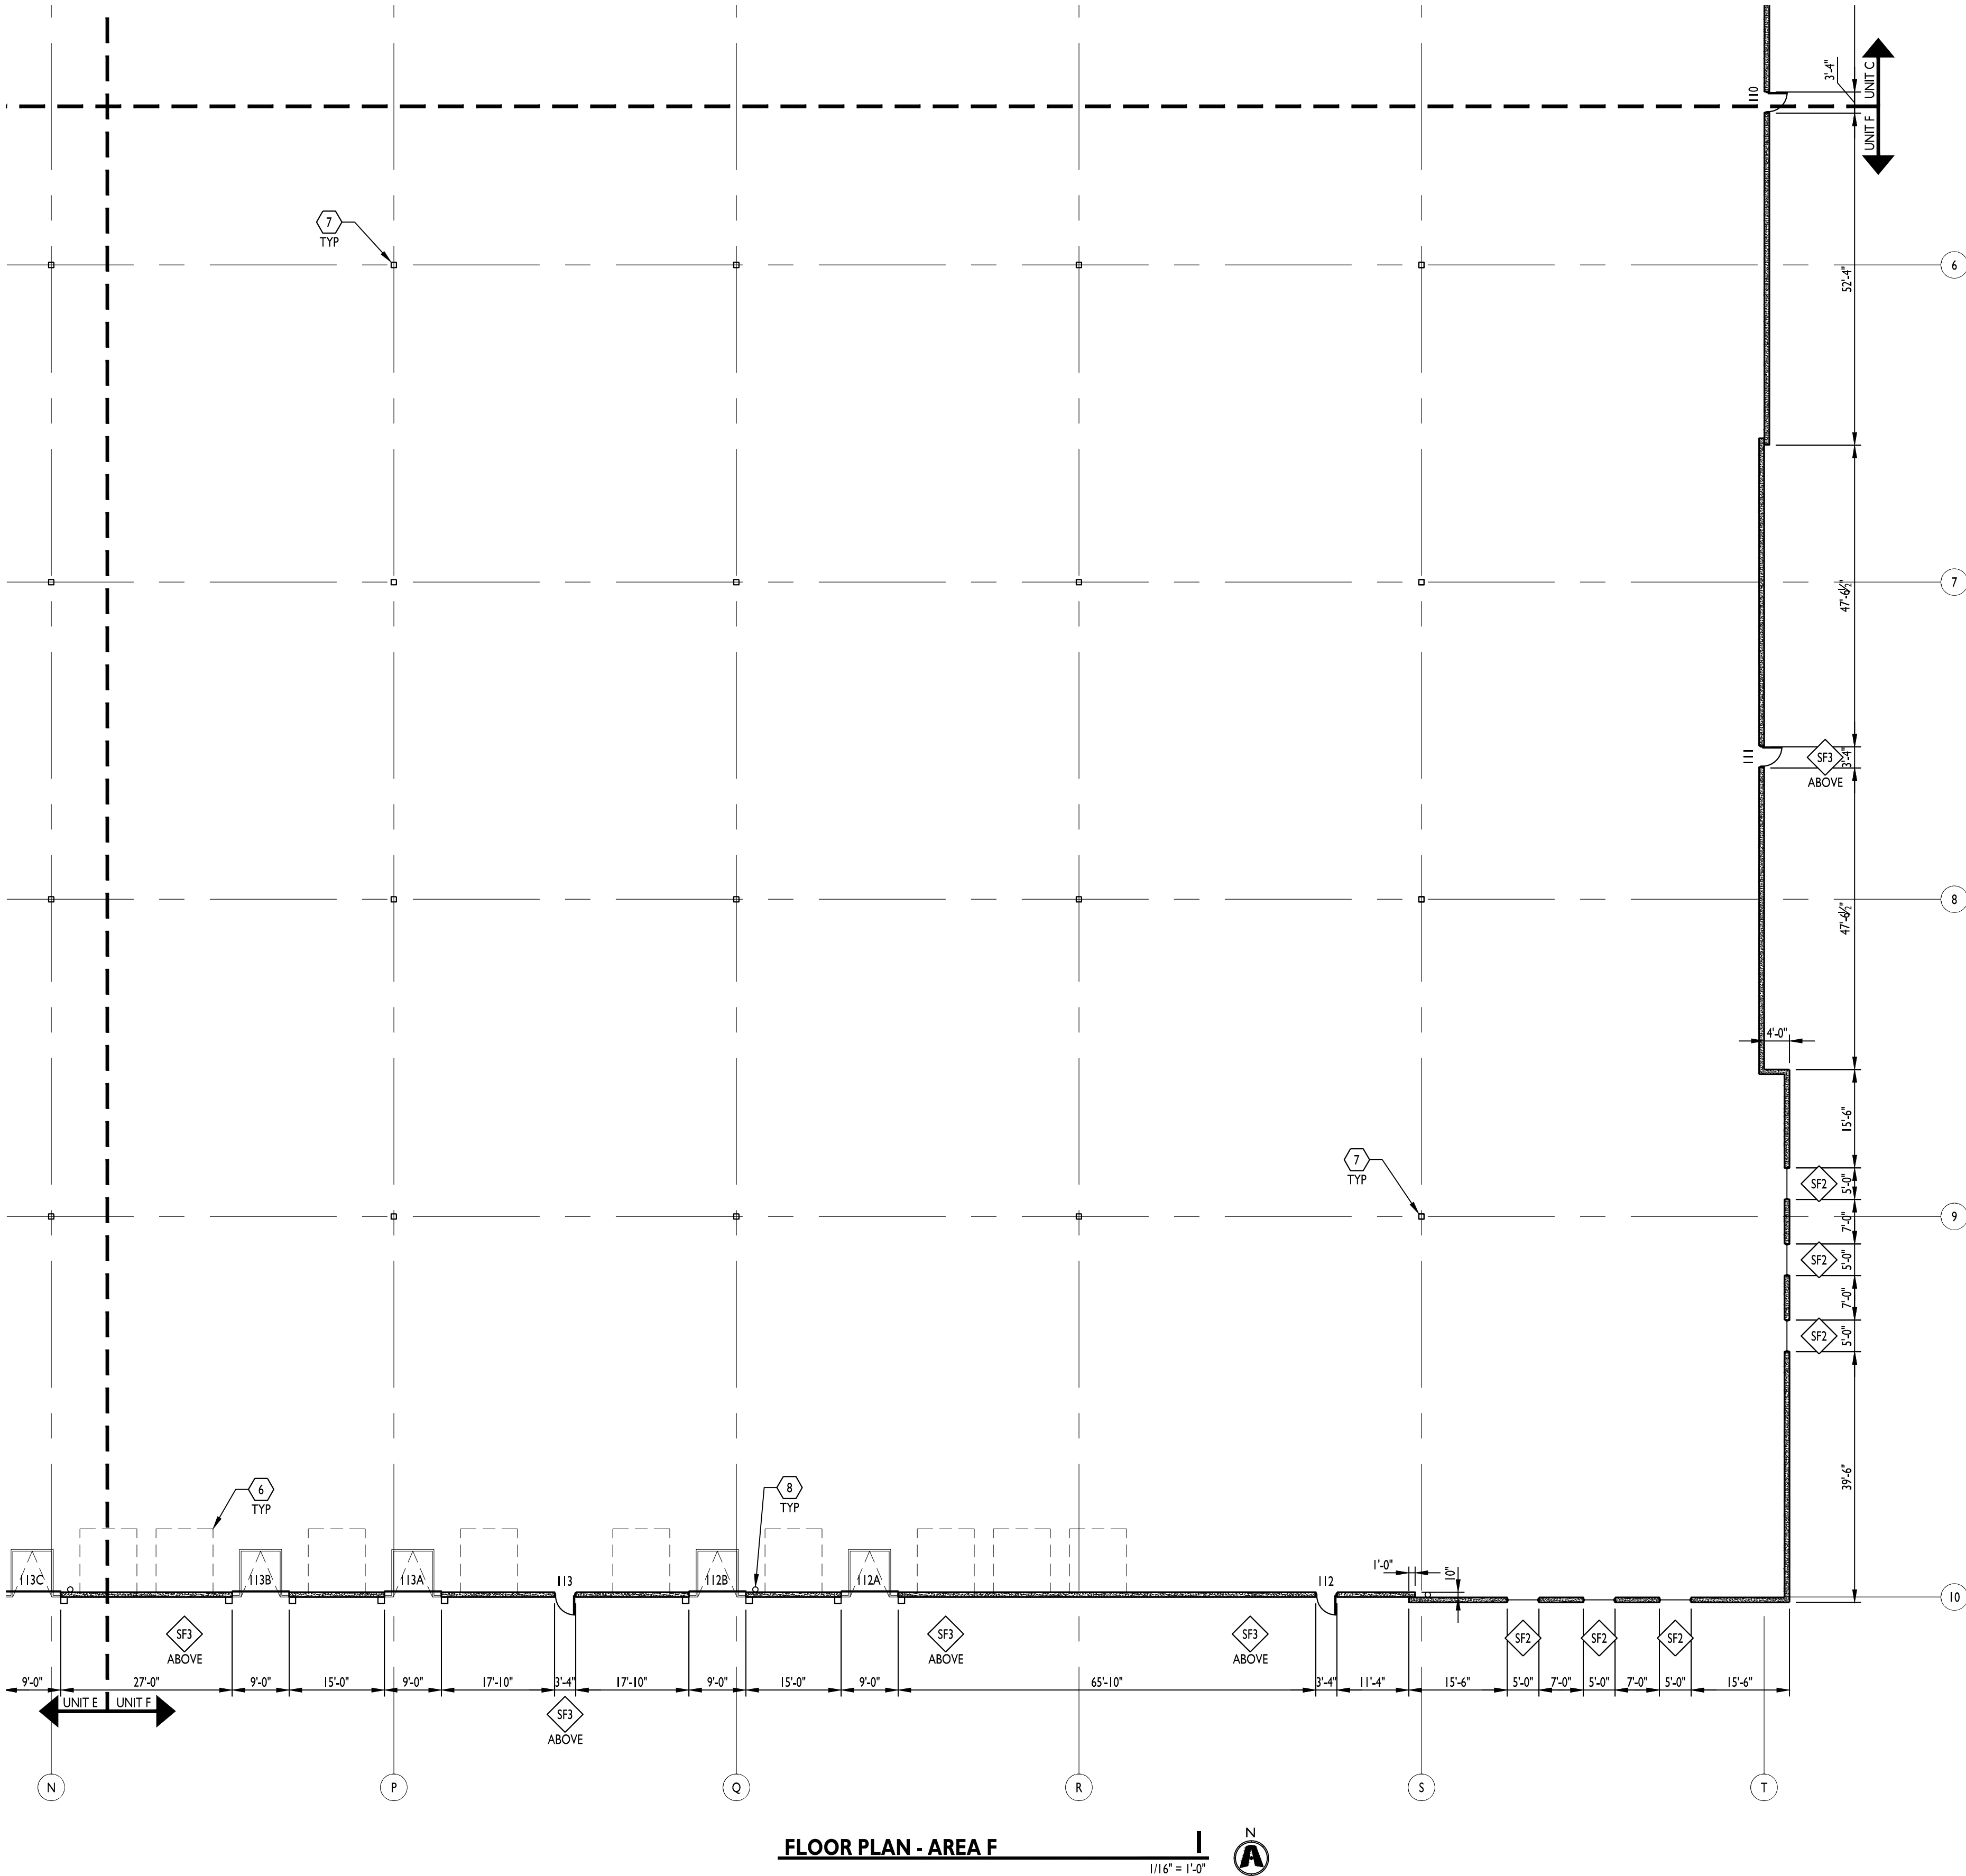


FLOOR PLAN - AREA F

1/16" = 1'-0"

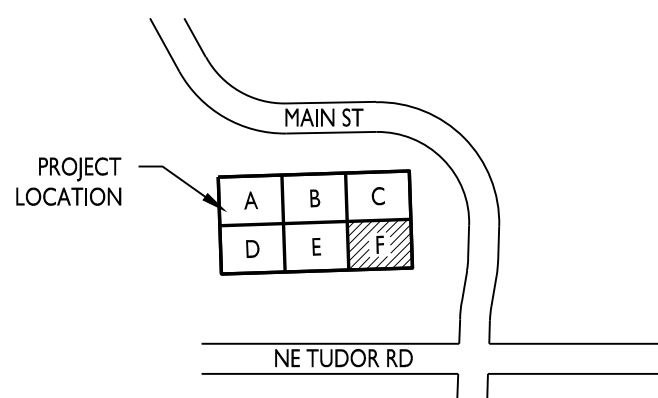


KEY PLAN

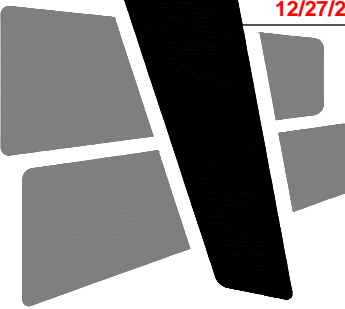

CURRAN
ARCHITECTURE

5719 LAWTON LOOP E. DR. #212
INDIANAPOLIS, IN 46216
O :: 317 . 288 . 0681
F :: 317 . 288 . 0753

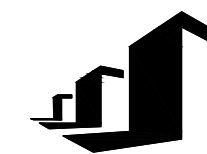

SCANNELL
PROPERTIES

CERTIFICATION

THIS DRAWING AND THE IDEAS, DESIGNS
AND CONCEPTS CONTAINED HEREIN ARE
THE EXCLUSIVE INTELLECTUAL PROPERTY
OF CURRAN ARCHITECTURE, AND ARE NOT
TO BE USED OR REPRODUCED, WHOLE OR
IN PART, WITHOUT THE WRITTEN
CONSENT OF CURRAN ARCHITECTURE.
© COPYRIGHT 2021, CURRAN ARCHITECTURE

PROJECT INFORMATION

LEE'S SUMMIT LOGISTICS
BUILDING A LOT I

NW CORNER OF
NE TUDOR RD & MAIN ST
LEE'S SUMMIT, MO 64086

ISSUE DATES


PERMIT SET	02.18.22
TENANT COORDINATION	06.06.22

210300


ROOF PLAN

A120

ROOF PLAN LEGEND

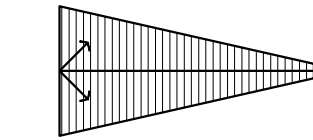

DENOTES TAPERED INSULATION OR ROOF
CRICKETS TO ROOF DRAIN LOCATIONS. SLOPE
MIN OF 1/4"FOOT AS INDICATED BY ARROWS OR
TWICE THE AMOUNT OF THE UNDERLYING
DECK WHICHEVER IS GREATER.

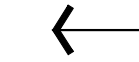


DENOTES ROOF SLOPE AT 1/2" / FOOT MINIMUM.

ROOF TYPE #1


MECHANICALLY FASTENED 45 MIL TPO
MEMBRANE WITH RIGID POLYISOCYANURATE
INSULATION AT MINIMUM OF R-20. INSULATION
TO BE TWO LAYERS WITH STAGGERED JOINTS.
MEMBRANE SHEETS RUN PERPENDICULAR TO
THE DECK FLUTES. FOAM PERIMETER OF
INSULATION. SEE DETAIL.

KEYED NOTES


- 4' x 4' INSULATED ROOF HATCH. COORDINATE LOCATION WITH
ROOF FRAMING BELOW. REFER TO A304 FOR DETAIL.
- MANUFACTURED PAN & GUTTER AWING W/ SCUPPER DIRECTED
TO LANDSCAPE BELOW. MAPES ILLUMIDECK OR EQUAL.
- PREFINISHED METAL COPING WITH CONTINUOUS HOLD DOWN
CLIP AT EDGE OF PANEL.
- ROOF DRAINS, REFER TO ENGINEERING DRAWINGS.
- OVERFLOW SCUPPER OPENING IN WALL. WRAP WITH ROOF
MEMBRANE. BOTTOM OF OPENING TO BE AT 2" ABOVE ROOF
MEMBRANE. COORDINATE FINAL LOCATION.
- ROOF MANUFACTURER'S TYPICAL EXPANSION JOINT DETAIL.
COORDINATE PLACEMENT WITH ROOF FRAMING.
- TAPERED INSULATION TO DIRECT WATER TO ROOF DRAINS.
- LINE INDICATES APPROXIMATE LOCATION OF ROOF FRAMING.
SLOPE TO DRAIN. SEE ROOF FRAMING PLANS.
- ROOF ACCESS PENTHOUSE CONSTRUCTED WITH GFS FRAMING
AND CLAD IN EXTERIOR SHEATHING AND INSULATED METAL
PANELS. COORDINATE FINAL LOCATION WITH ROOF FRAMING
AND STAIRS BELOW.
- DIMENSIONS SHOWN ARE TO INTERIOR OF DECK ANGLE (CLEAR
OPENING DIMENSION). ADJUST OPENING TO COORDINATE WITH
JOISTS AS REQUIRED.

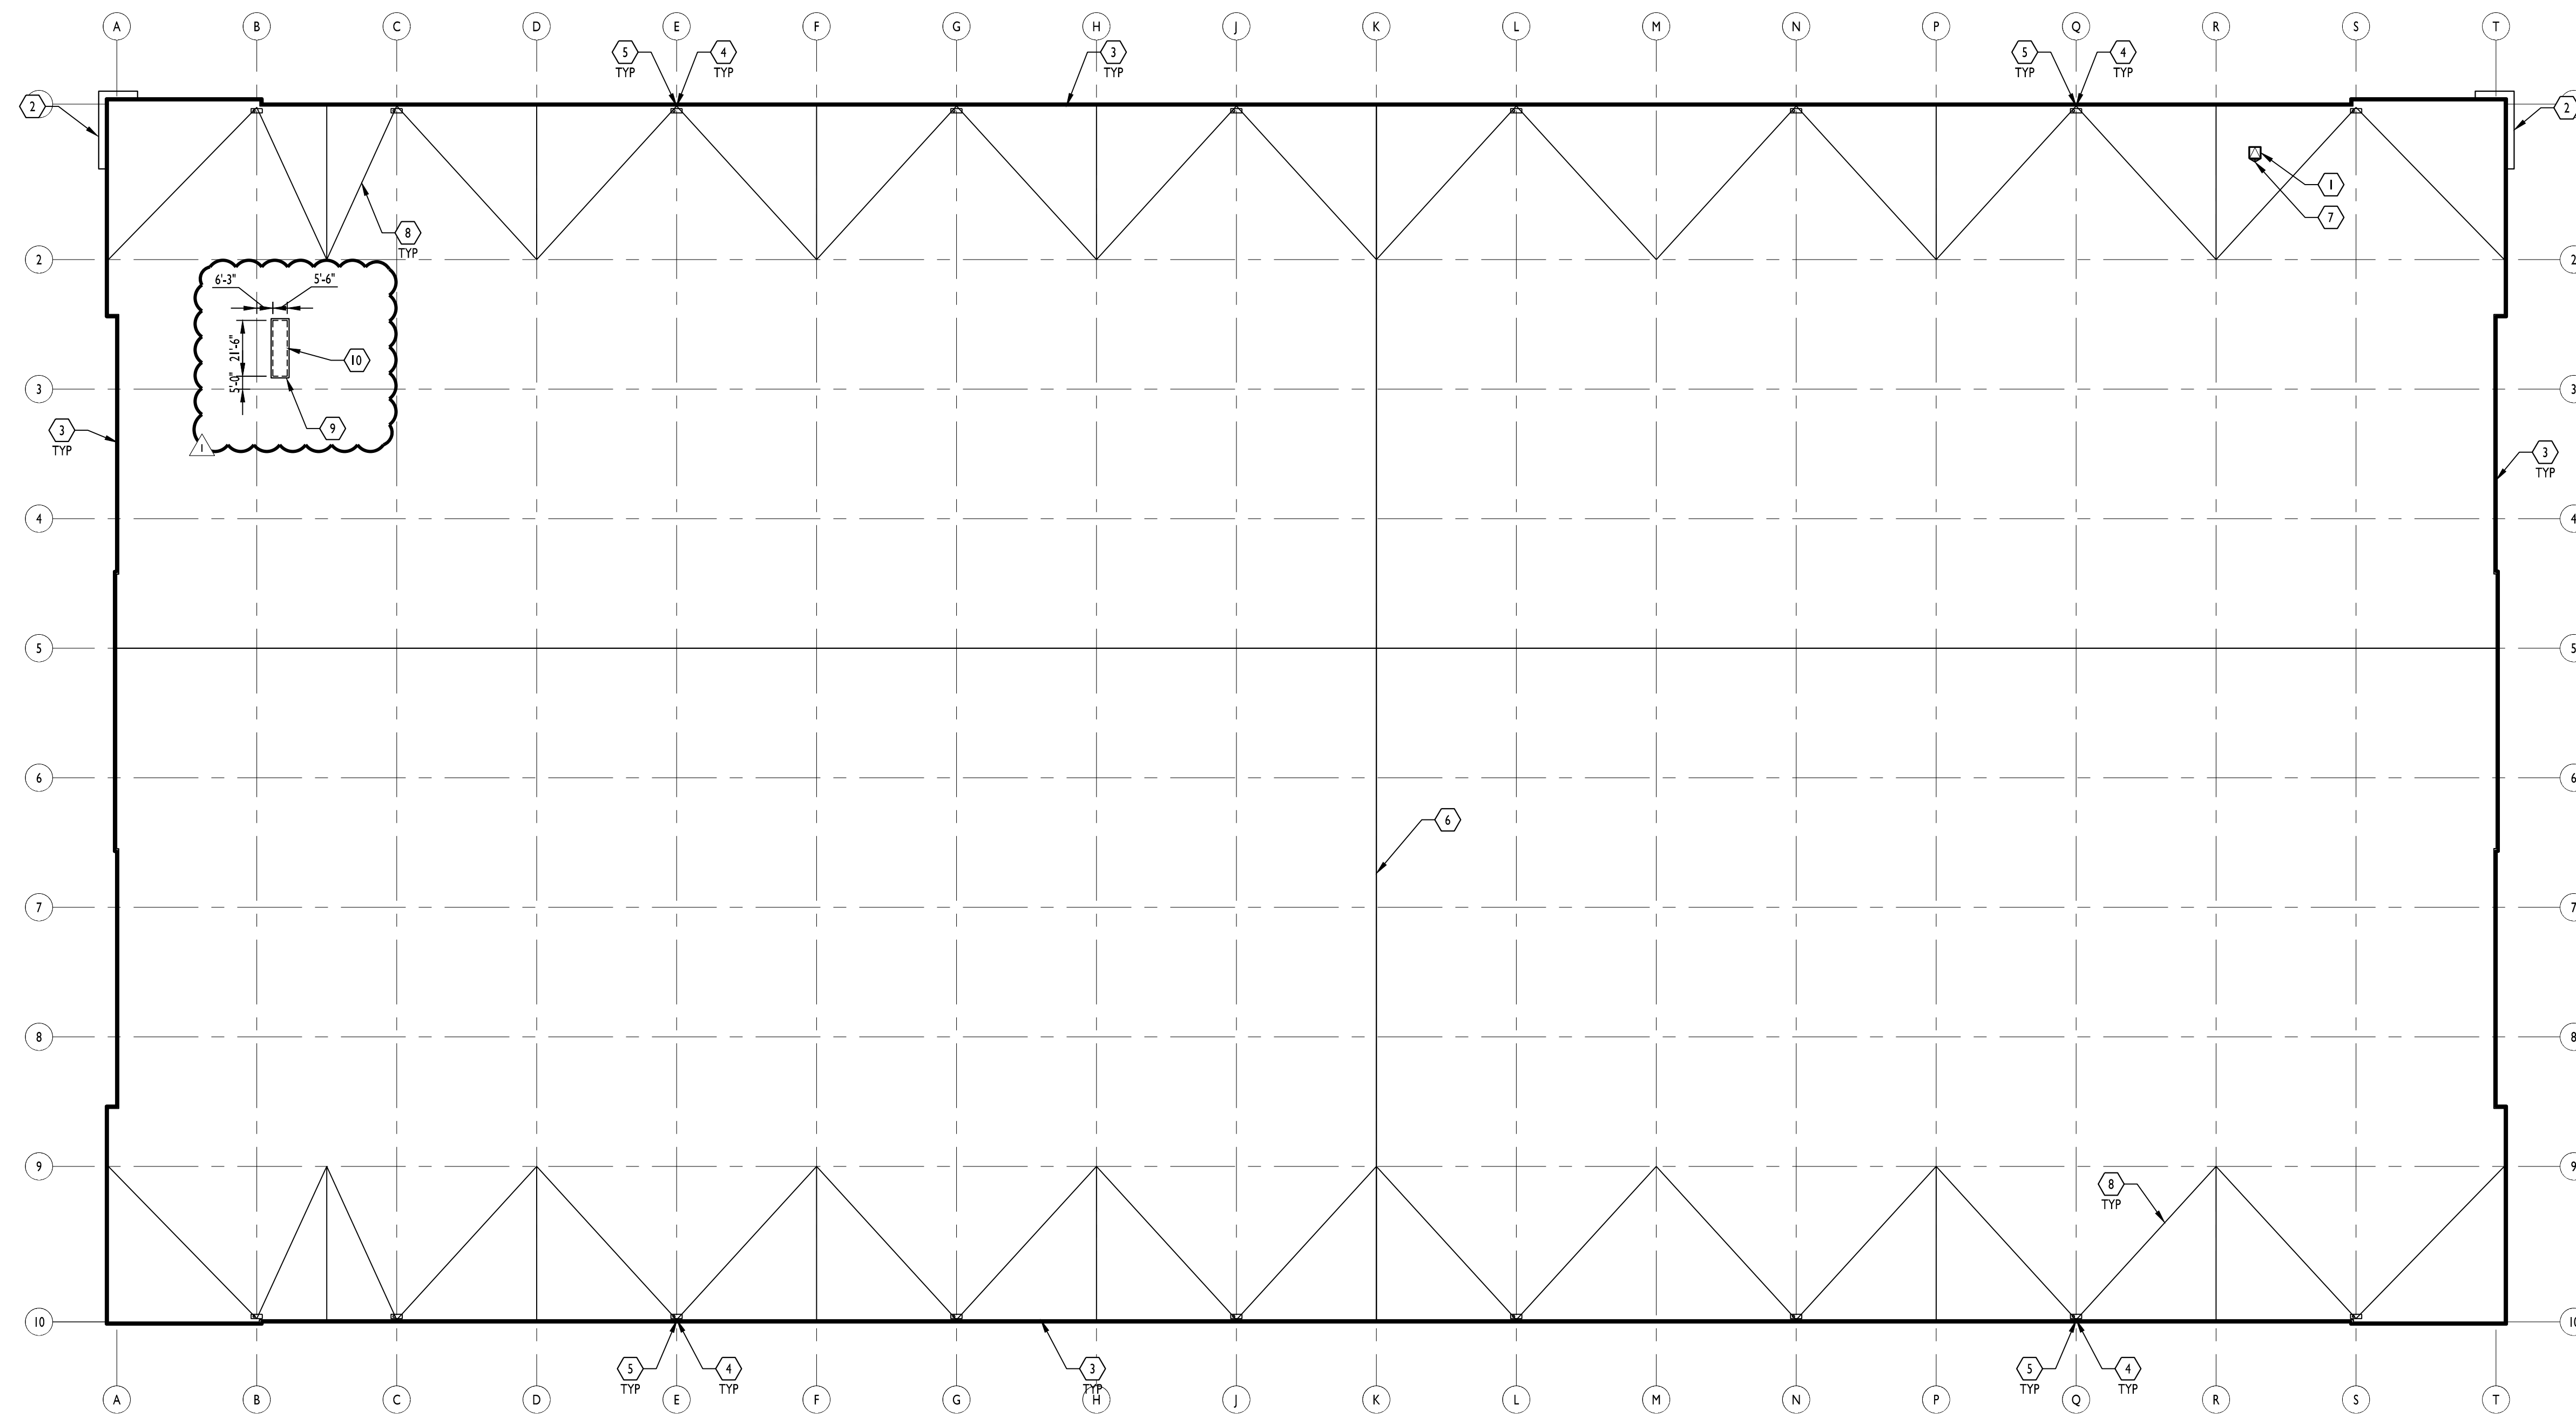

ROOF PLAN
1
1" = 40'
N
A

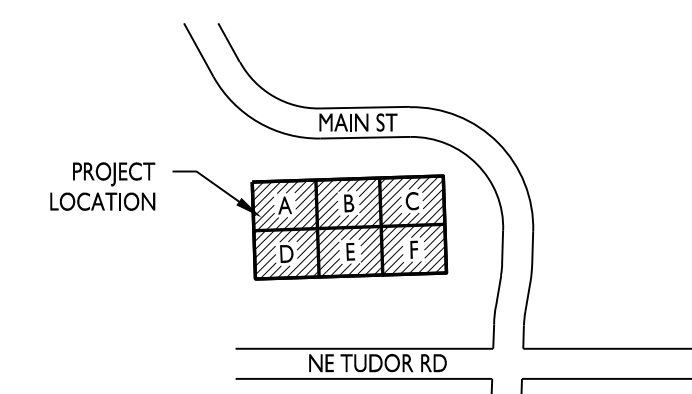

KEY PLAN

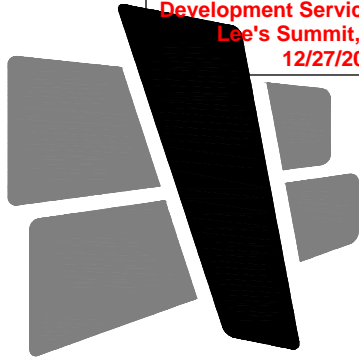

CURRAN
ARCHITECTURE

5719 LAWTON LOOP E. DR. #212
INDIANAPOLIS, IN 46216
O :: 317 . 288 . 0681
F :: 317 . 288 . 0753



SCANNELL
PROPERTIES

CERTIFICATION

THIS DRAWING AND THE IDEAS, DESIGNS
AND CONCEPTS CONTAINED HEREIN ARE
THE EXCLUSIVE INTELLECTUAL PROPERTY
OF CURRAN ARCHITECTURE, AND ARE NOT
TO BE USED OR REPRODUCED, WHOLE OR
IN PART, WITHOUT THE WRITTEN
CONSENT OF CURRAN ARCHITECTURE.
© COPYRIGHT 2021, CURRAN ARCHITECTURE

PROJECT INFORMATION

LEE'S SUMMIT LOGISTICS
BUILDING A LOT I

NW CORNER OF
NE TUDOR RD & MAIN ST
LEE'S SUMMIT, MO 64086


ISSUE DATES

PERMIT SET 02.18.22


210300

OVERALL EXTERIOR
ELEVATIONS


A200

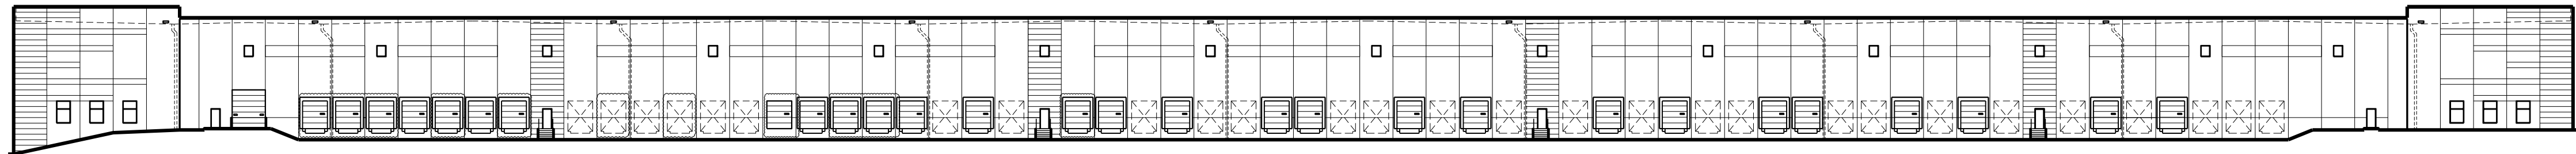


OVERALL SOUTH ELEVATION 1
1" = 40'

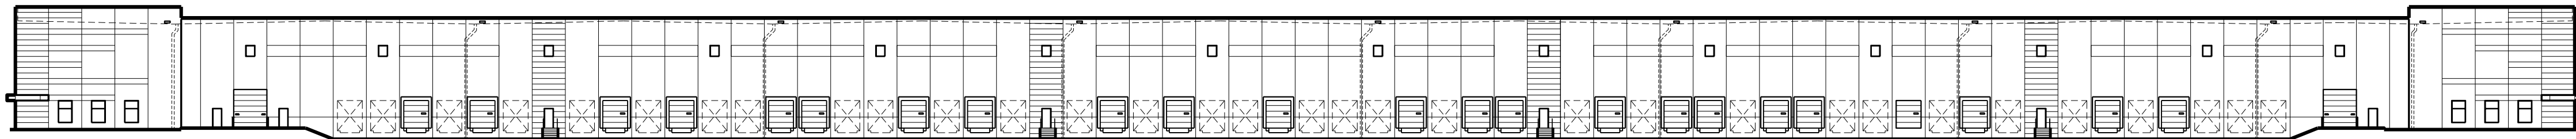


OVERALL NORTH ELEVATION 2
1" = 40'

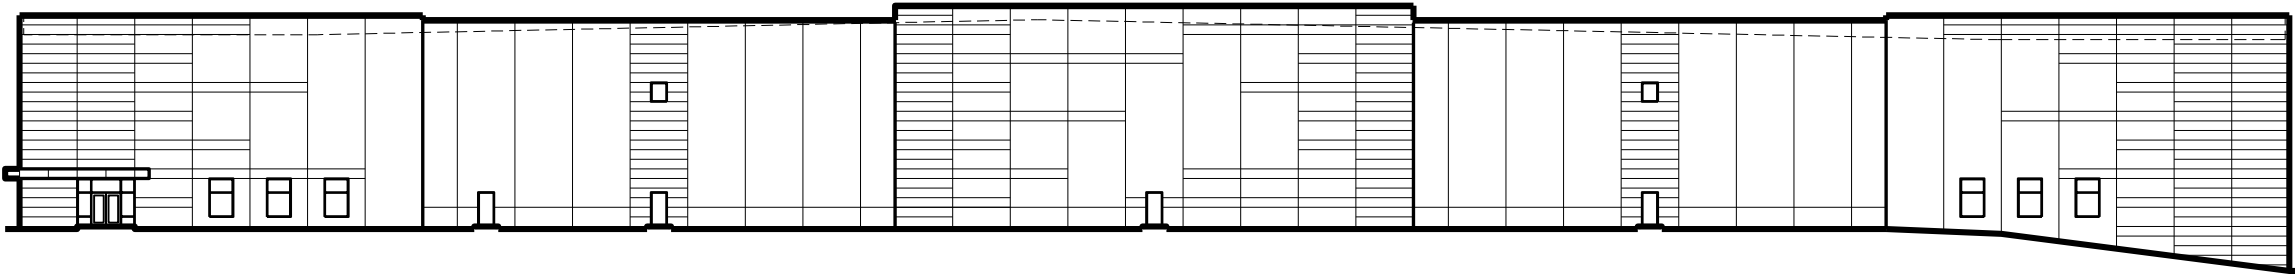

OVERALL WEST ELEVATION 3
1" = 40'

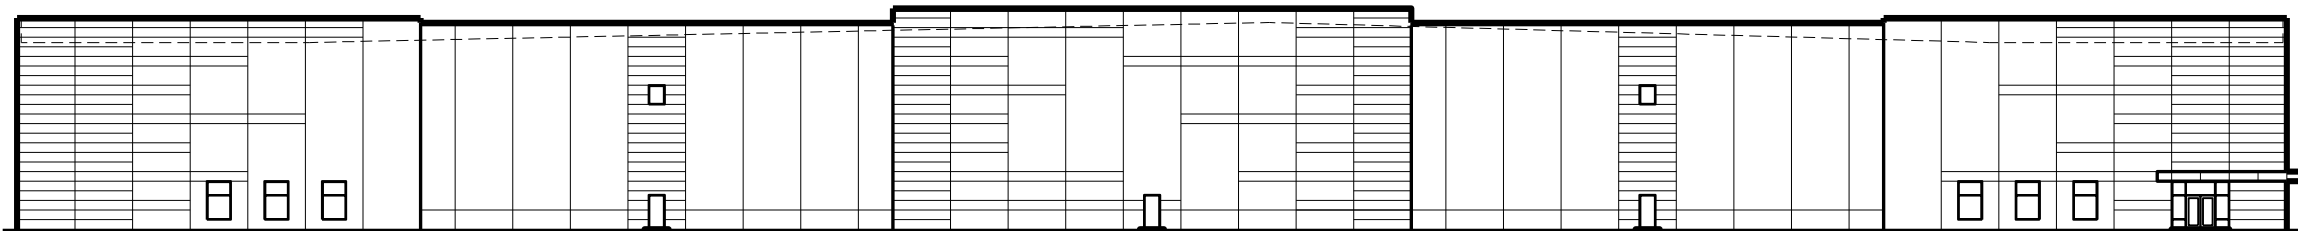


OVERALL EAST ELEVATION 4
1" = 40'

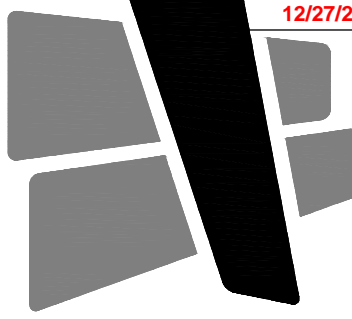

CURRAN
ARCHITECTURE

5719 LAWTON LOOP E. DR. #212
INDIANAPOLIS, IN 46216
O :: 317 . 288 . 0681
F :: 317 . 288 . 0753

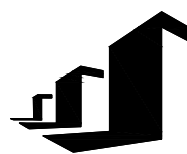

SCANNELL
PROPERTIES

CERTIFICATION

THIS DRAWING AND THE IDEAS, DESIGNS
AND CONCEPTS CONTAINED HEREIN ARE
THE EXCLUSIVE INTELLECTUAL PROPERTY
OF CURRAN ARCHITECTURE, AND ARE NOT
TO BE USED OR REPRODUCED, WHOLE OR
IN PART, WITHOUT THE WRITTEN
CONSENT OF CURRAN ARCHITECTURE.
© COPYRIGHT 2021, CURRAN ARCHITECTURE

PROJECT INFORMATION

LEE'S SUMMIT LOGISTICS
BUILDING A LOT I

NW CORNER OF
NE TUDOR RD & MAIN ST
LEE'S SUMMIT, MO 64086

ISSUE DATES

PERMIT SET 02.18.22
TENANT COORDINATION 06.06.22

210300

EXTERIOR ELEVATIONS




A201

GENERAL TILT WALL PAINT NOTES

- CONCRETE TO CURE 30 DAYS PRIOR TO PAINT OR VERIFY PH LEVEL IS BETWEEN 6-8. IF PH IS HIGHER THAN 8 A PRIMER THAT IS TOLERANT OF A HIGH ALKALINE SUBSTRATE IS REQUIRED. VERIFY PRODUCT WITH PAINT MANUFACTURER DATA SHEETS FOR ACCEPTABLE MATERIALS TO MEET THE PH OF THE PANELS. TYPICAL LOXON PRIMERS. PROVIDE REPORT STATING PH LEVEL OF PANEL PRIOR TO PAINT APPLICATION.
- TILT WALL CONTRACTOR TO VERIFY AND CONFIRM TO GENERAL CONTRACTOR THAT ALL BOND BREAKERS HAVE BEEN REMOVED FROM THE FACE OF THE CONCRETE VIA PRESSURE WASHING OR SAND BLASTING. PROCESS IS DEPENDENT ON THE TYPE OF BOND BREAKER USED. TILT WALL CONTRACTOR TO SUPPLY A LETTER CONFIRMING THAT BOND BREAKER IS REMOVED.
- PRIOR TO PAINTING, VERIFY THAT PRECAST CONCRETE MOISTURE LEVEL IS 15% OR LOWER.
- ALL ACRYLIC PAINTS TO BE 100% ACRYLIC SHERWIN WILLIAMS A-100, SUPER PAINT OR EQUAL.
- ELASTOMERIC PAINTS WILL BE ACCEPTABLE. CONPLEX OR SHERLASTIC OR EQUAL. MUST BE APPLIED AT 10 MILS RO 30+ MILS WET. MUST APPLY TWO COATS. VERIFY PH REQUIREMENTS WITH DATA SHEETS.
- BASE LINE SPECIFICATION FOR THIS PROJECT:
PRIMER COAT: LOXON SEALER AZ44V6300
SECOND COAT: A-100 EXTERIOR LATEX FLAT A6 SERIES

KEYED NOTES

- INSULATED STEEL DOOR. SEE DOOR SCHEDULE. VERIFY PAINT COLOR WITH OWNER.
- TYPICAL DOCK DOOR AND EQUIPMENT. SEE DOOR SCHEDULE
- INSULATED TILT WALL CONCRETE PANEL W/ PAINTED FINISH. REVEALS CAST IN AS SHOWN. REFER TO WALL SECTIONS FOR ADDITIONAL DETAIL.
- TYPICAL OVERHEAD DRIVE IN DOOR. SEE DOOR SCHEDULE.
- DOCK STAIR AND BOLLARDS.
- ANODIZED ALUMINUM STOREFRONT. LOW-E GLASS.
- TYPICAL ANODIZED ALUMINUM STOREFRONT DOOR. GLASS AND ALUMINUM COLOR TO MATCH STOREFRONT. SEE DOOR SCHEDULE.
- PRE-FINISHED COPING/ROOF EDGE. SEE ROOF PLAN.
- ANODIZED ALUMINUM STOREFRONT CLERESTORY. LOW-E GLASS. SEE DOOR SCHEDULE. CENTERED IN PANEL.
- GRADE LEVEL. SEE CIVIL PLANS FOR MORE INFORMATION.
- MANUFACTURED PAN & GUTTER AWNING EQUAL TO MAPES LUMIDECK OR EQUAL. COORDINATE SCUPPER/DRAIN LOCATIONS IN THE FIELD WITH FINAL LANDSCAPE PLAN.
- KNOCK OUT PANEL IN TILT WALL. CENTERED IN PANEL. SIZED FOR 9'-0" x 10'-0" W/ REVEALS. PROVIDE REVEAL ALONG KNOCKOUT. 6" SOLID SECTION OF PANEL. CENTERED ON REVEAL.
- REVEALS @ CAST IN PANEL. SEE WALL SECTIONS FOR DETAIL & HEIGHTS.
- WALL MOUNTED WALL PACK LIGHT FIXTURE MOUNTED AT 29'-8" AFF TO CENTER OF FIXTURE. SEE ELECTRICAL PLANS AND SITE LIGHTING PHOTOMETRIC PLANS FOR FURTHER INFORMATION. CENTER ON PANEL.
- TYPICAL PAINTED STEEL BOLLARDS.
- DASHED LINE INDICATES SLOPE OF ROOF LINE BEYOND. SEE ROOF PLAN FOR MORE INFORMATION.
- 24" WIDE x 8" TALL OVERFLOW SCUPPER OPENING IN WALL. BOTTOM TO BE AT 34'-0" AFF WITH CENTER OF OPENING 48" AWAY FROM COLUMN LINE AS SHOWN. COORDINATE WITH FINAL ROOF FRAMING ELEVATIONS.
- ROOF DRAIN ON INTERIOR SIDE OF PANEL. COORDINATE LOCATION TO BE CENTERED BETWEEN DOORS / KNOCKOUTS. AND TO AVOID CLERESTORY WINDOWS.

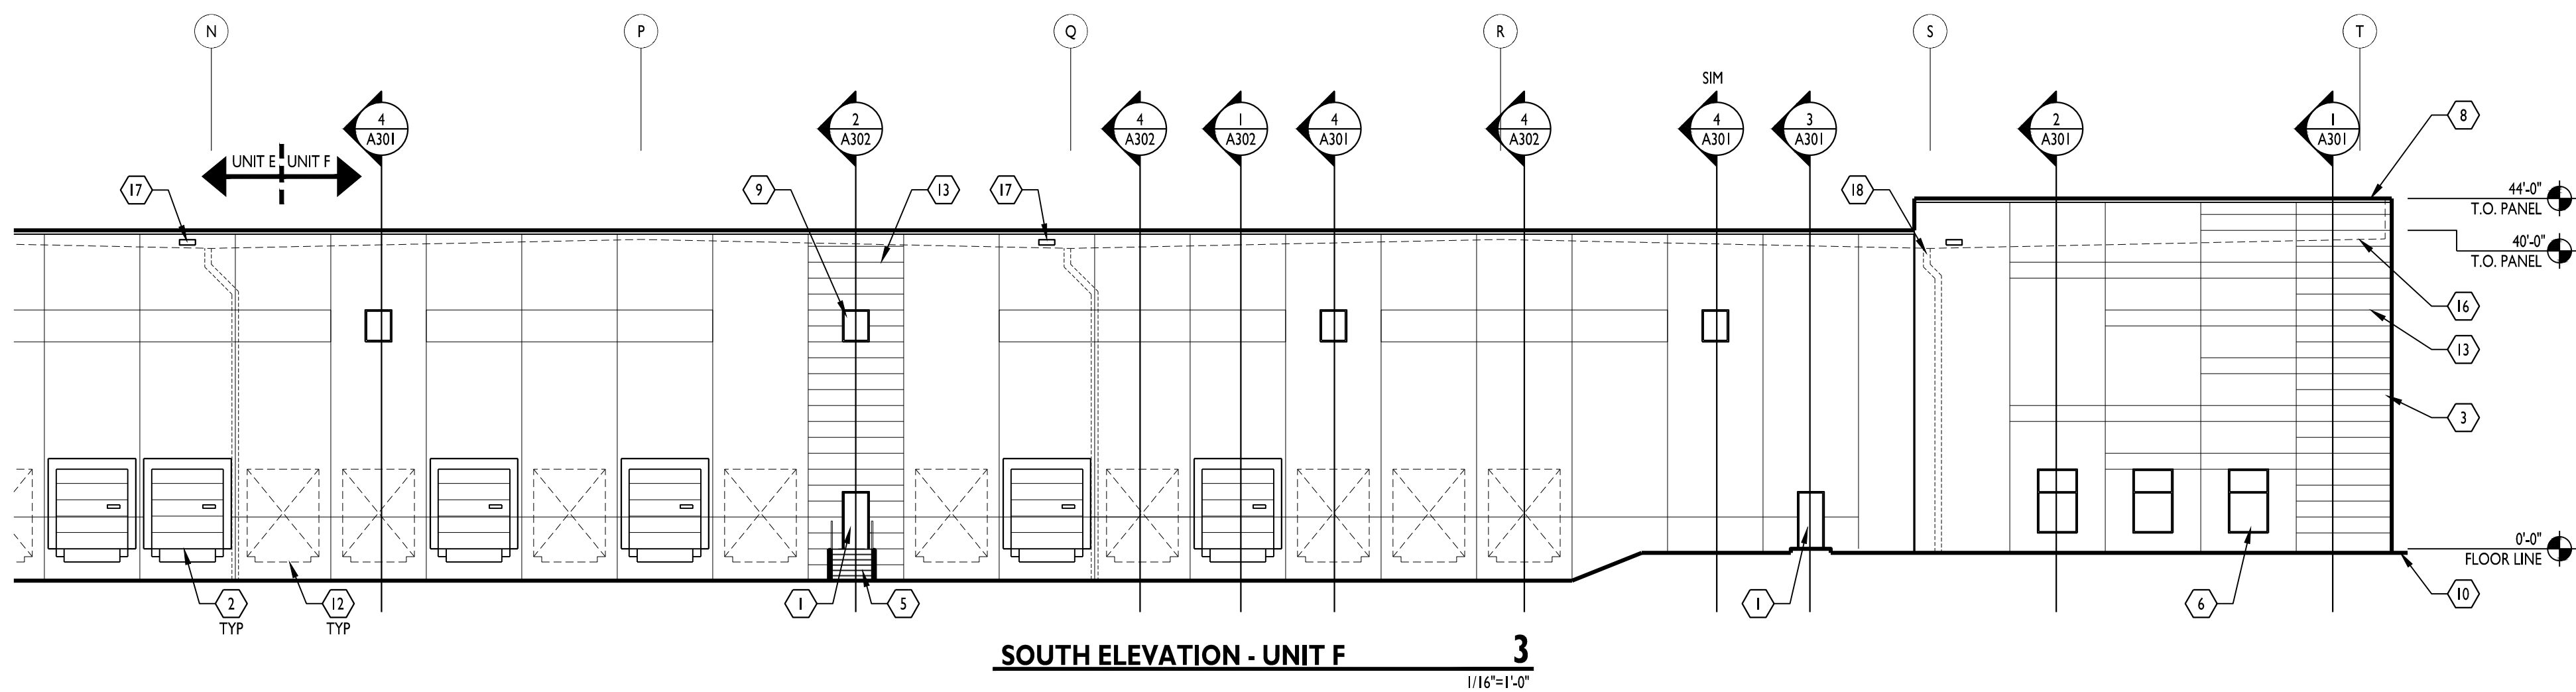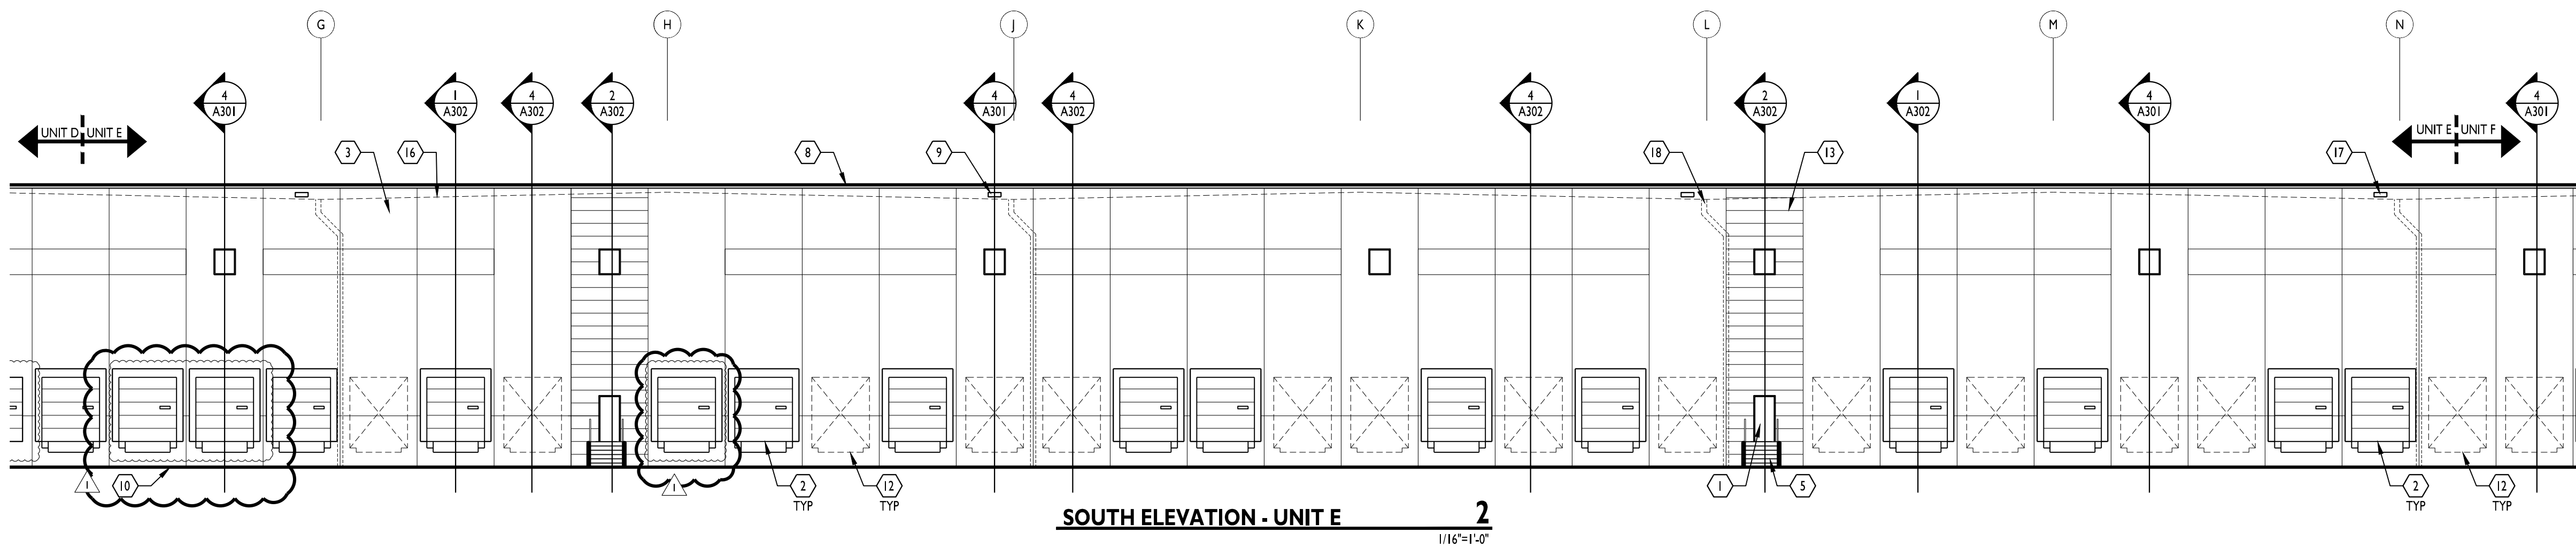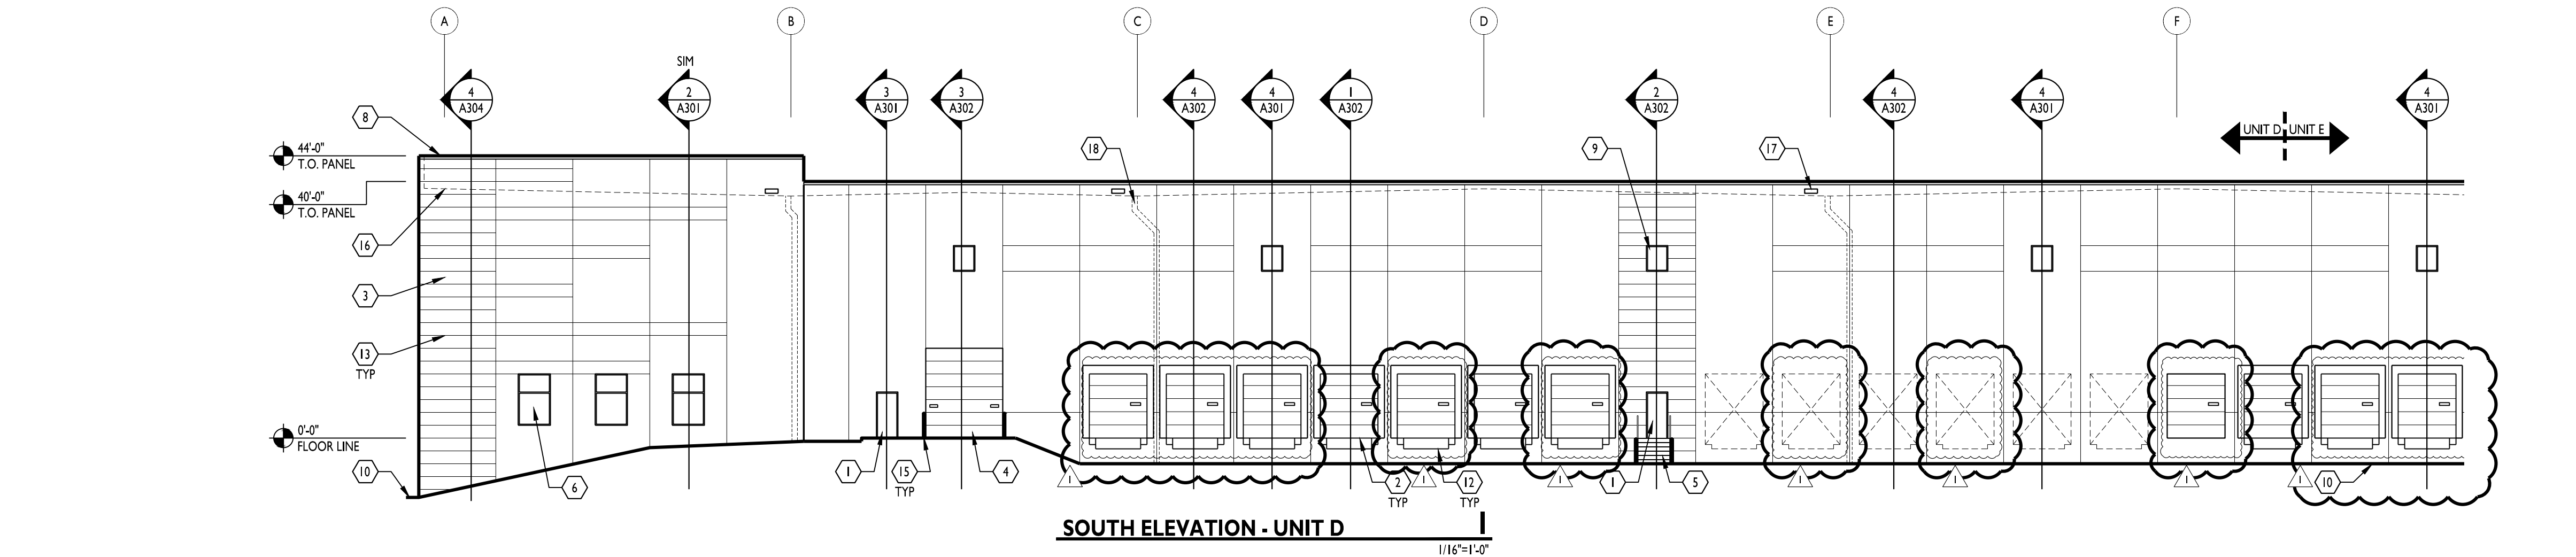



THIS DRAWING AND THE IDEAS, DESIGNS
AND CONCEPTS CONTAINED HEREIN ARE
THE EXCLUSIVE INTELLECTUAL PROPERTY
OF CURRAN ARCHITECTURE, AND ARE NOT
TO BE USED OR REPRODUCED, WHOLE OR
IN PART, WITHOUT THE WRITTEN
CONSENT OF CURRAN ARCHITECTURE.
© COPYRIGHT 2021, CURRAN ARCHITECTURE

PROJECT INFORMATION

LEE'S SUMMIT LOGISTICS
BUILDING A LOT I

NW CORNER OF
NE TUDOR RD & MAIN ST
LEE'S SUMMIT, MO 64086

ISSUE DATES

PERMIT SET	02.18.22
TENANT COORDINATION	06.06.22

210300

EXTERIOR ELEVATIONS


A202

GENERAL TILT WALL
PAINT NOTES


- CONCRETE TO CURE 30 DAYS PRIOR TO PAINT OR VERIFY PH LEVEL IS BETWEEN 6-8. IF PH IS HIGHER THAN 8, A PRIMER THAT IS TOLERANT OF A HIGH ALKALINE SUBSTRATE IS REQUIRED. VERIFY PRODUCT WITH PAINT MANUFACTURER DATA SHEETS FOR ACCEPTABLE MATERIALS TO MEET THE PH OF THE PANELS. TYPICAL LOXON PRIMERS. PROVIDE REPORT STATING PH LEVEL OF PANEL PRIOR TO PAINT APPLICATION.
- TILT WALL CONTRACTOR TO VERIFY AND CONFIRM TO GENERAL CONTRACTOR THAT ALL BOND BREAKERS HAVE BEEN REMOVED FROM THE FACE OF THE CONCRETE VIA PRESSURE WASHING OR SAND BLASTING. PROCESS IS DEPENDENT ON THE TYPE OF BOND BREAKER USED. TILE WALL CONTRACTOR TO SUPPLY A LETTER CONFIRMING THAT BOND BREAKER IS REMOVED.
- PRIOR TO PAINTING, VERIFY THAT PRECAST CONCRETE MOISTURE LEVEL IS 15% OR LOWER.
- ALL ACRYLIC PAINTS TO BE 100% ACRYLIC SHERWIN WILLIAMS A-100, SUPER PAINT OR EQUAL.
- ELASTOMERIC PAINTS WILL BE ACCEPTABLE. CONPLEX OR SHERLASTIC OR EQUAL. MUST BE APPLIED AT 10 MILS RO 30+ MILS WET. MUST APPLY TWO COATS. VERIFY PH REQUIREMENTS WITH DATA SHEETS.
- BASE LINE SPECIFICATION FOR THIS PROJECT:
PRIMER COAT: LOXON SEALER AZ4V6300
SECOND COAT: A-100 EXTERIOR LATEX FLAT A6 SERIES

KEYED NOTES


- INSULATED STEEL DOOR. SEE DOOR SCHEDULE. VERIFY PAINT COLOR WITH OWNER.
- TYPICAL DOCK DOOR AND EQUIPMENT. SEE DOOR SCHEDULE.
- INSULATED TILT WALL CONCRETE PANEL W/ PAINTED FINISH. REVEALS CAST IN AS SHOWN. REFER TO WALL SECTIONS FOR ADDITIONAL DETAIL.
- TYPICAL OVERHEAD DRIVE IN DOOR. SEE DOOR SCHEDULE.
- DOCK STAIR AND BOLLARDS.
- ANODIZED ALUMINUM STOREFRONT. LOW-E GLASS.
- TYPICAL ANODIZED ALUMINUM STOREFRONT DOOR. GLASS AND ALUMINUM COLOR TO MATCH STOREFRONT. SEE DOOR SCHEDULE.
- PRE-FINISHED COPING/ROOF EDGE. SEE ROOF PLAN.
- ANODIZED ALUMINUM STOREFRONT CLERESTORY. LOW-E GLASS. SEE DOOR SCHEDULE. CENTERED IN PANEL.
- GRADE LEVEL. SEE CIVIL PLANS FOR MORE INFORMATION.
- MANUFACTURED PAN & GUTTER AWNING EQUAL TO MAPES LUMIDECK OR EQUAL. COORDINATE SCUPPER/DRAIN LOCATIONS IN THE FIELD WITH FINAL LANDSCAPE PLAN.
- KNOCK OUT PANEL IN TILT WALL. CENTERED IN PANEL. SIZED FOR 9'-0" x 10'-0" W/ REVEALS. PROVIDE REVEAL ALONG KNOCKOUT. 6" SOLID SECTION OF PANEL. CENTERED ON REVEAL.
- REVEALS @ CAST IN PANEL. SEE WALL SECTIONS FOR DETAIL & HEIGHTS.
- WALL MOUNTED WALL PACK LIGHT FIXTURE MOUNTED AT 29'-8" AFF TO CENTER OF FIXTURE. SEE ELECTRICAL PLANS AND SITE LIGHTING PHOTOMETRIC PLANS FOR FURTHER INFORMATION. CENTER ON PANEL.
- TYPICAL PAINTED STEEL BOLLARDS.
- DASHED LINE INDICATES SLOPE OF ROOF LINE BEYOND. SEE ROOF PLAN FOR MORE INFORMATION.
- 24" WIDE x 8" TALL OVERFLOW SCUPPER OPENING IN WALL. BOTTOM TO BE AT 34'-0" AFF WITH CENTER OF OPENING 48" AWAY FROM COLUMN LINE AS SHOWN. COORDINATE WITH FINAL ROOF FRAMING ELEVATIONS.
- ROOF DRAIN ON INTERIOR SIDE OF PANEL. COORDINATE LOCATION TO BE CENTERED BETWEEN DOORS / KNOCKOUTS. AND TO AVOID CLERESTORY WINDOWS.

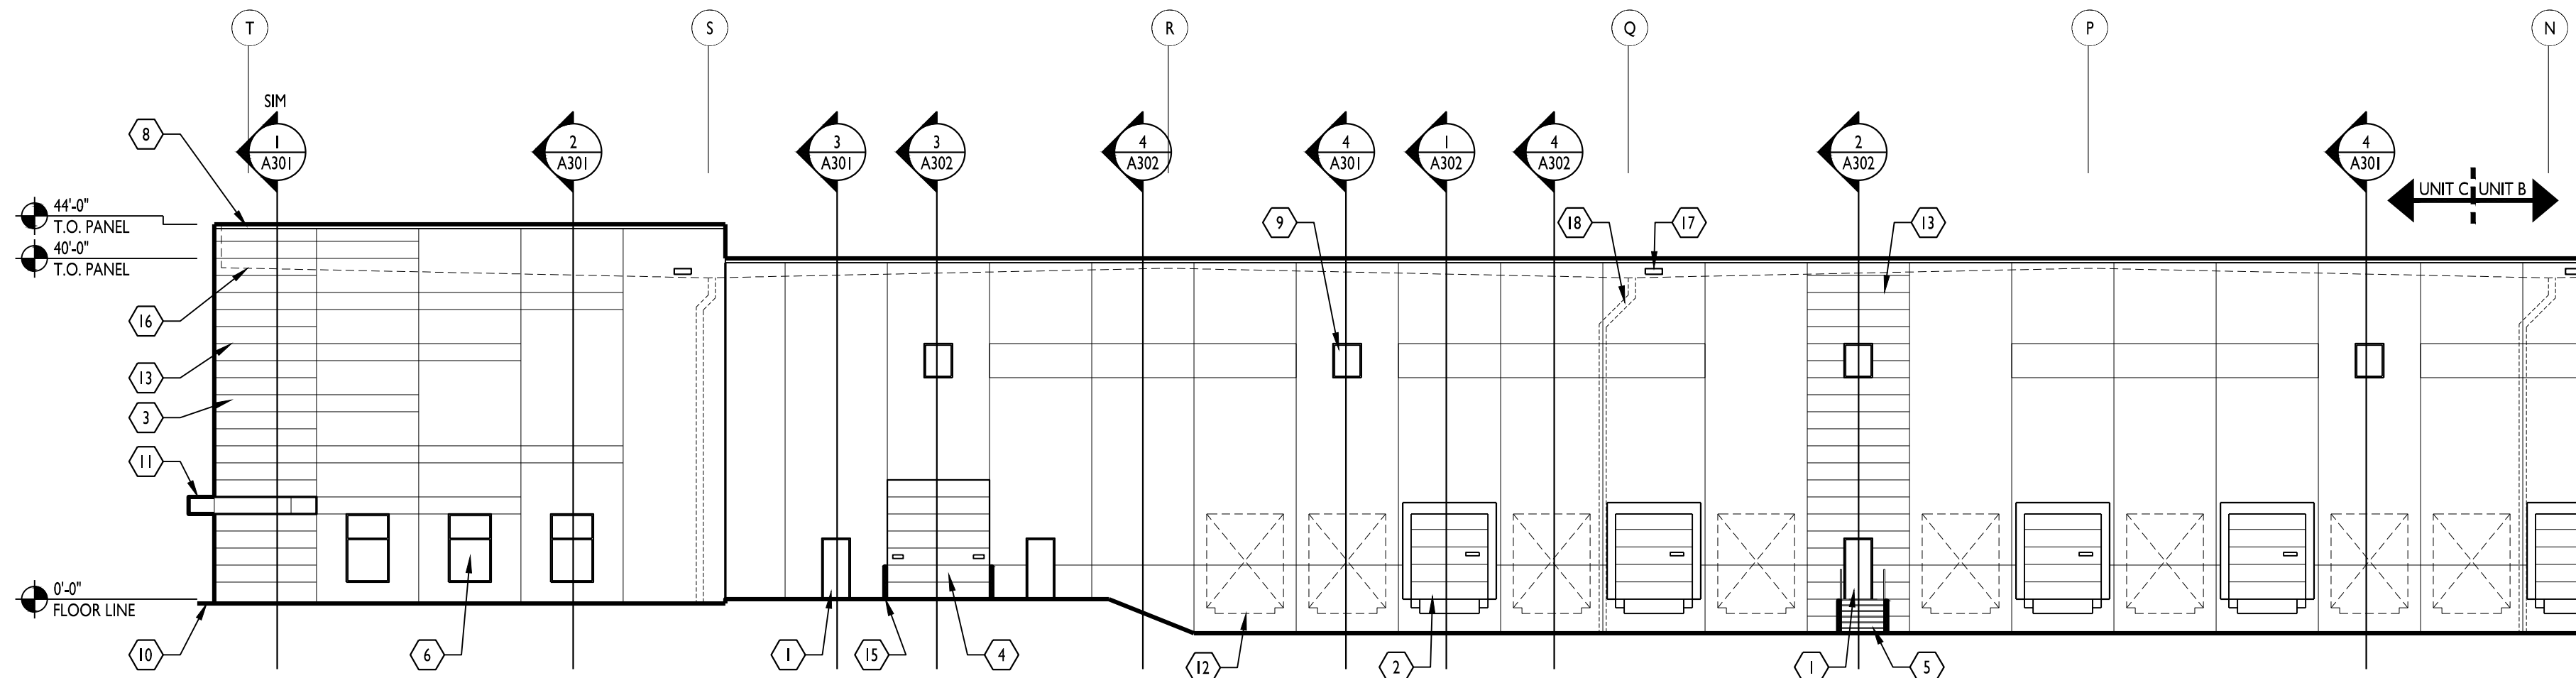


NORTH ELEVATION - UNIT C
1
1/16"=1'-0"

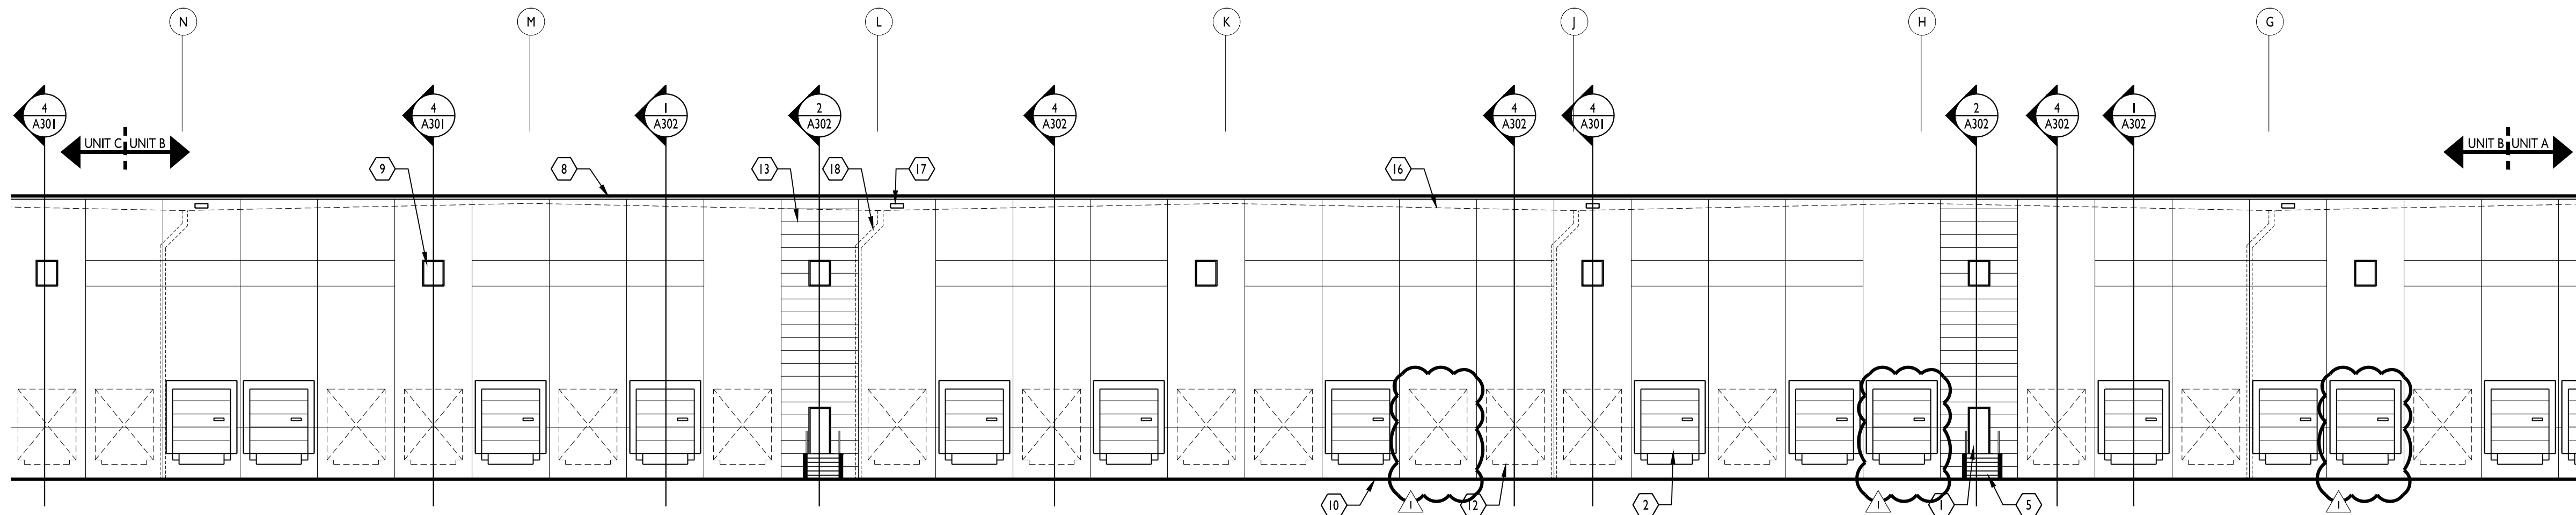

NORTH ELEVATION - UNIT B
2
1/16"=1'-0"

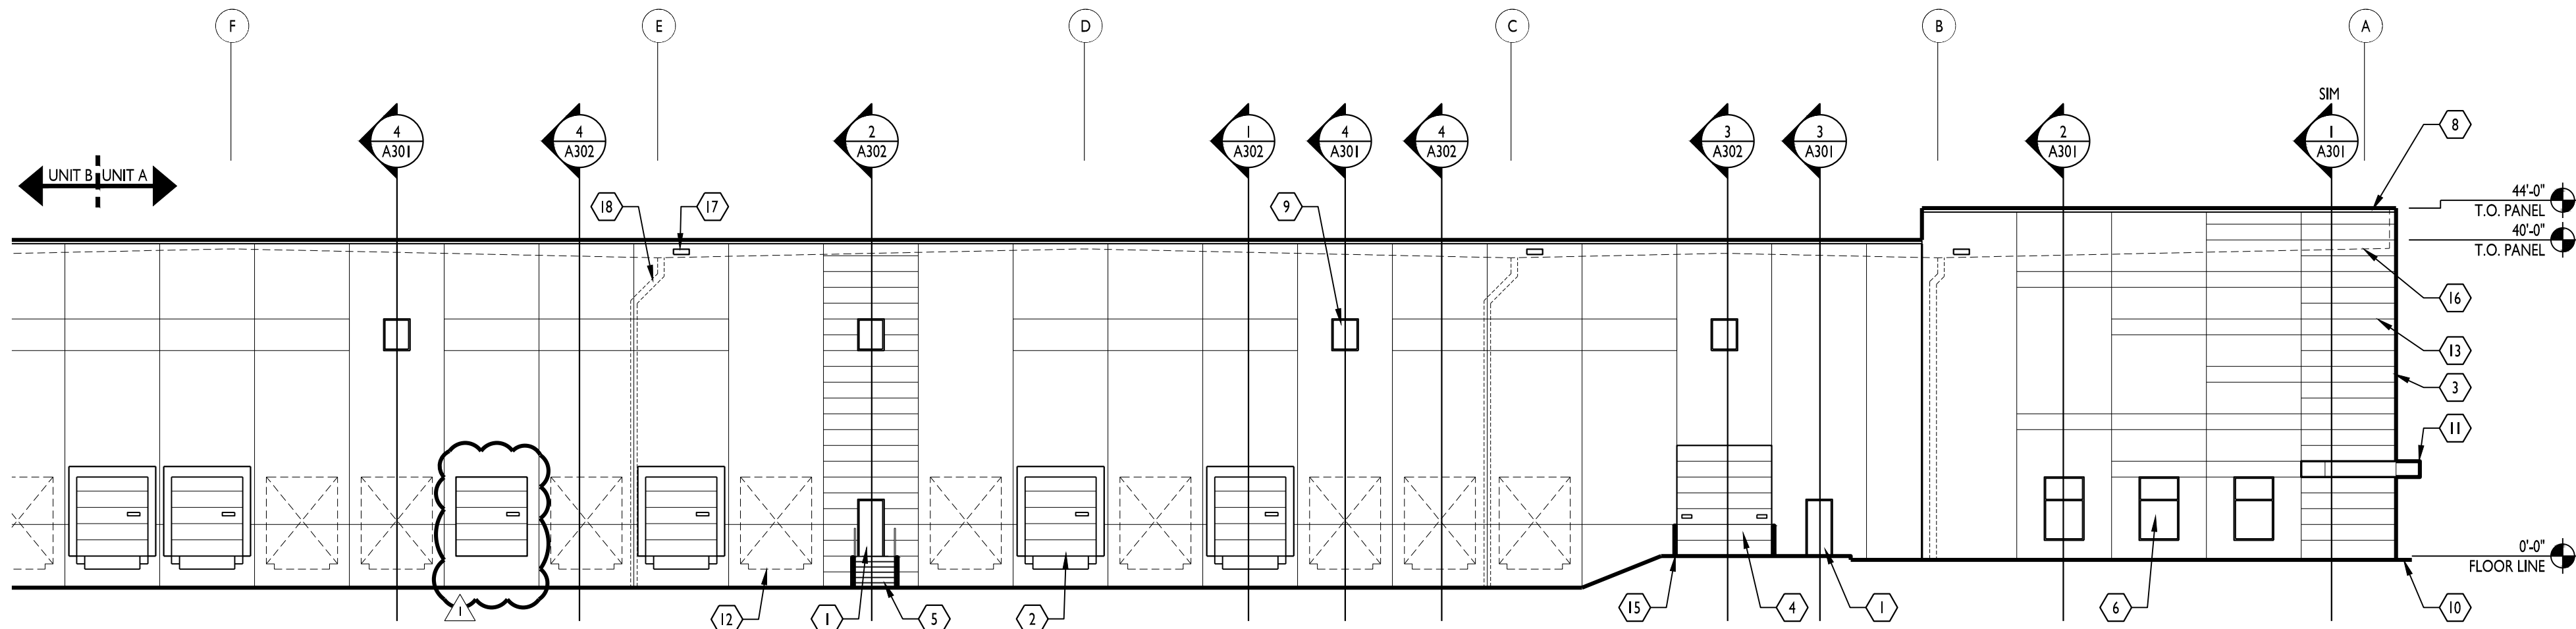


NORTH ELEVATION - UNIT A
3
1/16"=1'-0"

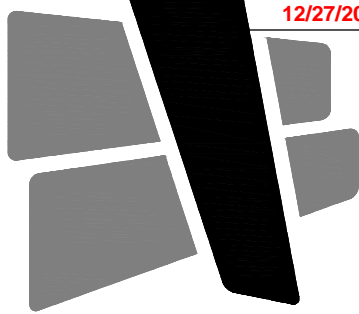

CURRAN
ARCHITECTURE

5719 LAWTON LOOP E. DR. #212
INDIANAPOLIS, IN 46216
O :: 317 . 288 . 0681
F :: 317 . 288 . 0753

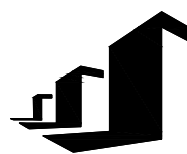

SCANNELL
PROPERTIES

CERTIFICATION

THIS DRAWING AND THE IDEAS, DESIGNS
AND CONCEPTS CONTAINED HEREIN ARE
THE EXCLUSIVE INTELLECTUAL PROPERTY
OF CURRAN ARCHITECTURE, AND ARE NOT
TO BE USED OR REPRODUCED, WHOLE OR
IN PART, WITHOUT THE WRITTEN
CONSENT OF CURRAN ARCHITECTURE.
© COPYRIGHT 2021, CURRAN ARCHITECTURE

PROJECT INFORMATION

LEE'S SUMMIT LOGISTICS
BUILDING A LOT I

NW CORNER OF
NE TUDOR RD & MAIN ST
LEE'S SUMMIT, MO 64086

ISSUE DATES

PERMIT SET 02.18.22
TENANT COORDINATION 06.06.22

210300

EXTERIOR ELEVATIONS


A203

GENERAL TILT WALL PAINT NOTES

- CONCRETE TO CURE 30 DAYS PRIOR TO PAINT OR VERIFY PH LEVEL IS BETWEEN 6-8. IF PH IS HIGHER THAN 8, A PRIMER THAT IS TOLERANT OF A HIGH ALKALINE SUBSTRATE IS REQUIRED. VERIFY PRODUCT WITH PAINT MANUFACTURER DATA SHEETS FOR ACCEPTABLE MATERIALS TO MEET THE PH OF THE PANELS. TYPICAL LOXON PRIMERS. PROVIDE REPORT STATING PH LEVEL OF PANEL PRIOR TO PAINT APPLICATION.
- TILT WALL CONTRACTOR TO VERIFY AND CONFIRM TO GENERAL CONTRACTOR THAT ALL BOND BREAKERS HAVE BEEN REMOVED FROM THE FACE OF THE CONCRETE VIA PRESSURE WASHING OR SAND BLASTING. PROCESS IS DEPENDENT ON THE TYPE OF BOND BREAKER USED. TILT WALL CONTRACTOR TO SUPPLY A LETTER CONFIRMING THAT BOND BREAKER IS REMOVED.
- PRIOR TO PAINTING, VERIFY THAT PRECAST CONCRETE MOISTURE LEVEL IS 15% OR LOWER.
- ALL ACRYLIC PAINTS TO BE 100% ACRYLIC SHERWIN WILLIAMS A-100, SUPER PAINT OR EQUAL.
- ELASTOMERIC PAINTS WILL BE ACCEPTABLE. CONFLEX OR SHERLASTIC OR EQUAL. MUST BE APPLIED AT 10 MILS RO 30+ MILS WET. MUST APPLY TWO COATS. VERIFY PH REQUIREMENTS WITH DATA SHEETS.
- BASE LINE SPECIFICATION FOR THIS PROJECT:
PRIMER COAT: LOXON SEALER A34W6300
SECOND COAT: A-100 EXTERIOR LATEX FLAT A6 SERIES


KEYED NOTES

- INSULATED STEEL DOOR. SEE DOOR SCHEDULE. VERIFY PAINT COLOR WITH OWNER.
- TYPICAL DOCK DOOR AND EQUIPMENT. SEE DOOR SCHEDULE
- INSULATED TILT WALL CONCRETE PANEL W/ PAINTED FINISH. REVEALS CAST IN AS SHOWN. REFER TO WALL SECTIONS FOR ADDITIONAL DETAIL.
- TYPICAL OVERHEAD DRIVE IN DOOR. SEE DOOR SCHEDULE.
- DOCK STAIR AND BOLLARDS.
- ANODIZED ALUMINUM STOREFRONT. LOW-E GLASS.
- TYPICAL ANODIZED ALUMINUM STOREFRONT DOOR. GLASS AND ALUMINUM COLOR TO MATCH STOREFRONT. SEE DOOR SCHEDULE.
- PRE-FINISHED COPING/ROOF EDGE. SEE ROOF PLAN.
- ANODIZED ALUMINUM STOREFRONT CLERESTORY. LOW-E GLASS. SEE DOOR SCHEDULE. CENTERED IN PANEL.
- GRADE LEVEL. SEE CIVIL PLANS FOR MORE INFORMATION.
- MANUFACTURED PAN & GUTTER AWNING EQUAL TO MAPES LUMIDECK OR EQUAL. COORDINATE SCUPPER/DRAIN LOCATIONS IN THE FIELD WITH FINAL LANDSCAPE PLAN.
- KNOCK OUT PANEL IN TILT WALL. CENTERED IN PANEL. SIZED FOR 9'-0" x 10'-0" W/ REVEALS. PROVIDE REVEAL ALONG KNOCKOUT. 6" SOLID SECTION OF PANEL. CENTERED ON REVEAL.
- REVEALS @ CAST IN PANEL. SEE WALL SECTIONS FOR DETAIL & HEIGHTS.
- WALL MOUNTED WALL PACK LIGHT FIXTURE MOUNTED AT 29'-8" AFF TO CENTER OF FIXTURE. SEE ELECTRICAL PLANS AND SITE LIGHTING PHOTOMETRIC PLANS FOR FURTHER INFORMATION. CENTER ON PANEL.
- TYPICAL PAINTED STEEL BOLLARDS.
- DASHED LINE INDICATES SLOPE OF ROOF LINE BEYOND. SEE ROOF PLAN FOR MORE INFORMATION.
- 24" WIDE x 8" TALL OVERFLOW SCUPPER OPENING IN WALL. BOTTOM TO BE AT 34'-0" AFF WITH CENTER OF OPENING 48" AWAY FROM COLUMN LINE AS SHOWN. COORDINATE WITH FINAL ROOF FRAMING ELEVATIONS.
- ROOF DRAIN ON INTERIOR SIDE OF PANEL. COORDINATE LOCATION TO BE CENTERED BETWEEN DOORS / KNOCKOUTS. AND TO AVOID CLERESTORY WINDOWS.

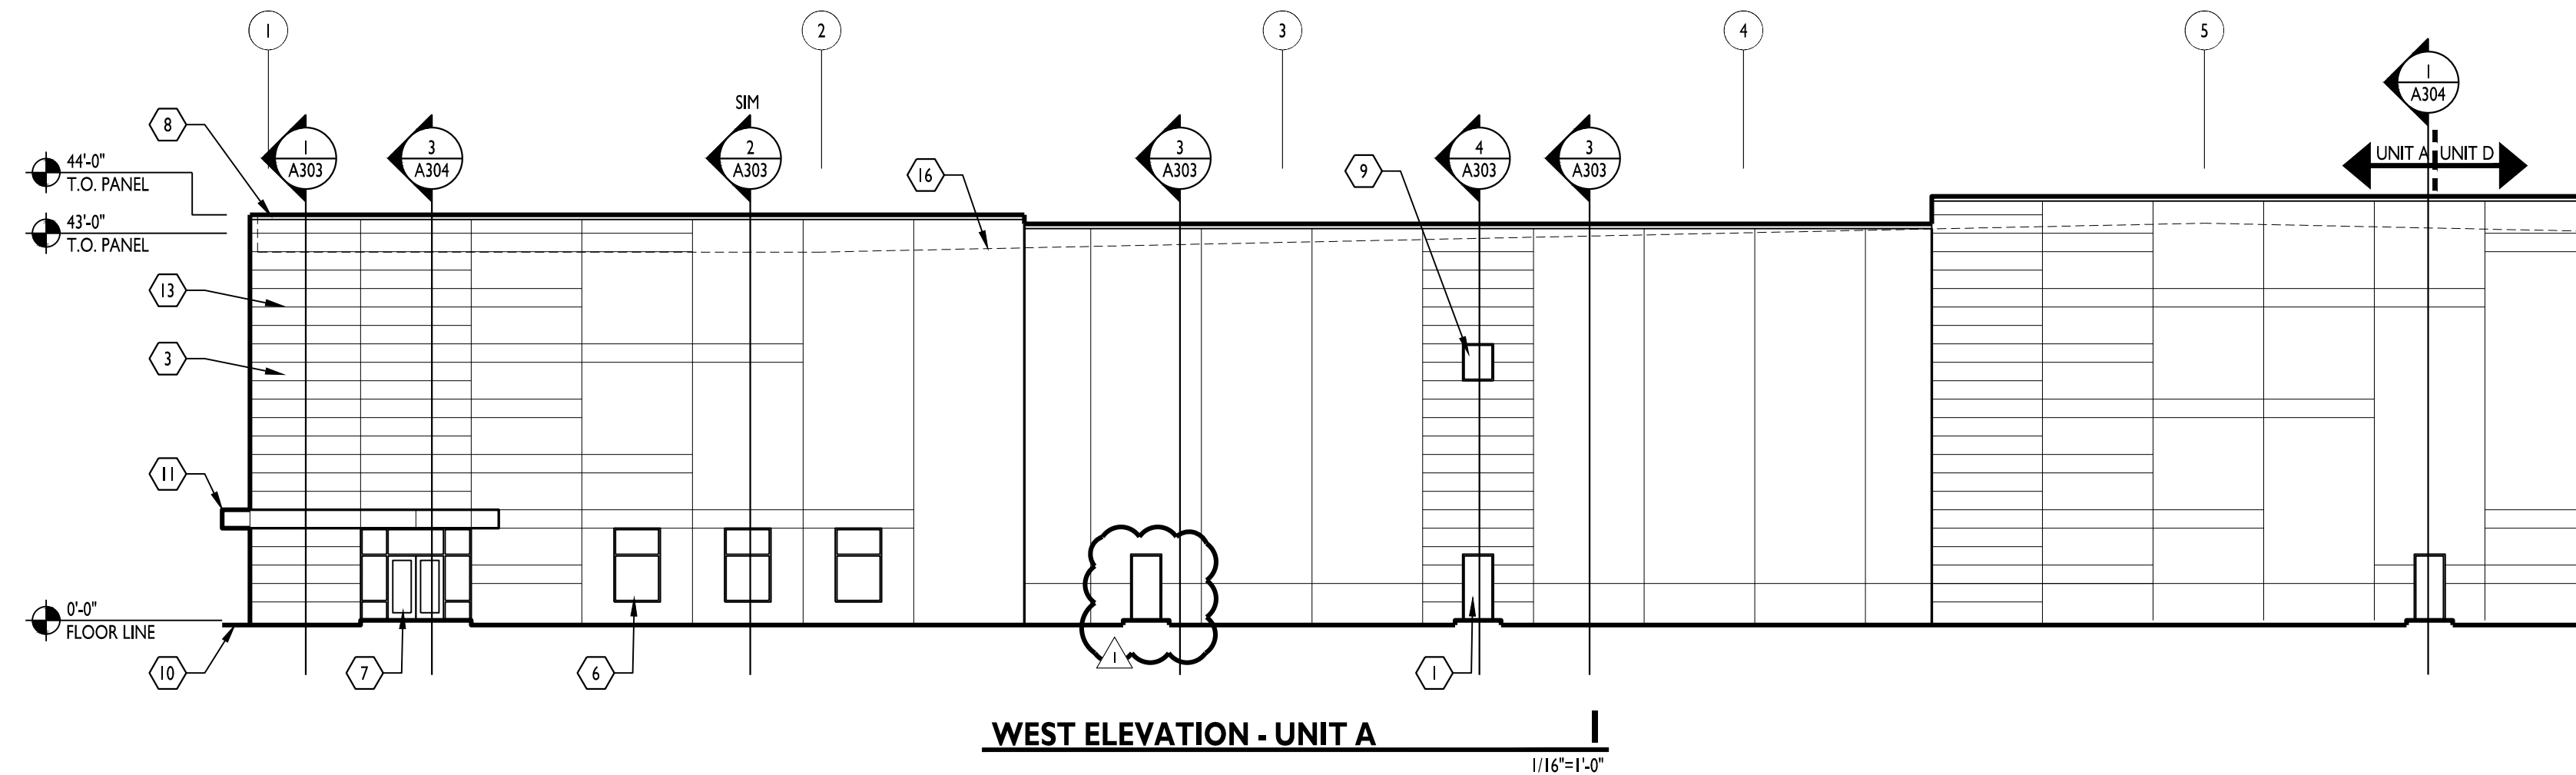


WEST ELEVATION - UNIT A

1
1/16"=1'-0"

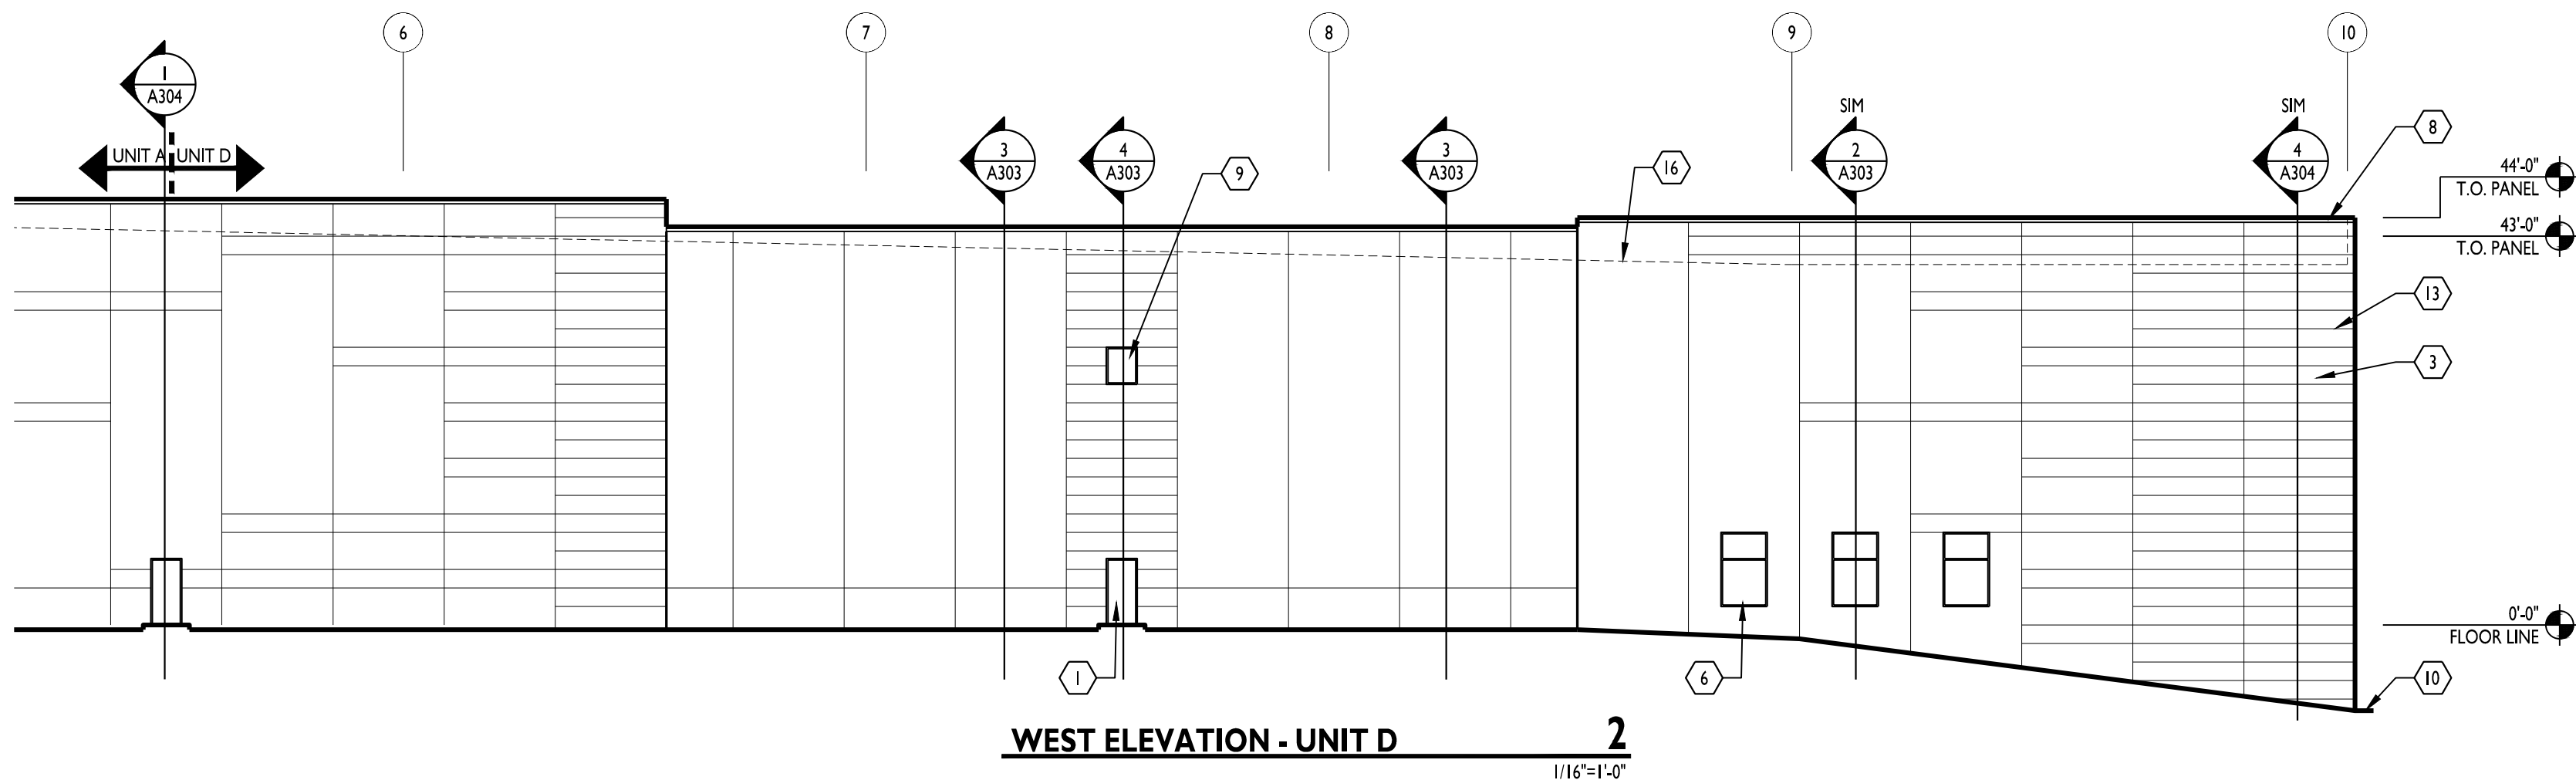


WEST ELEVATION - UNIT D

2
1/16"=1'-0"

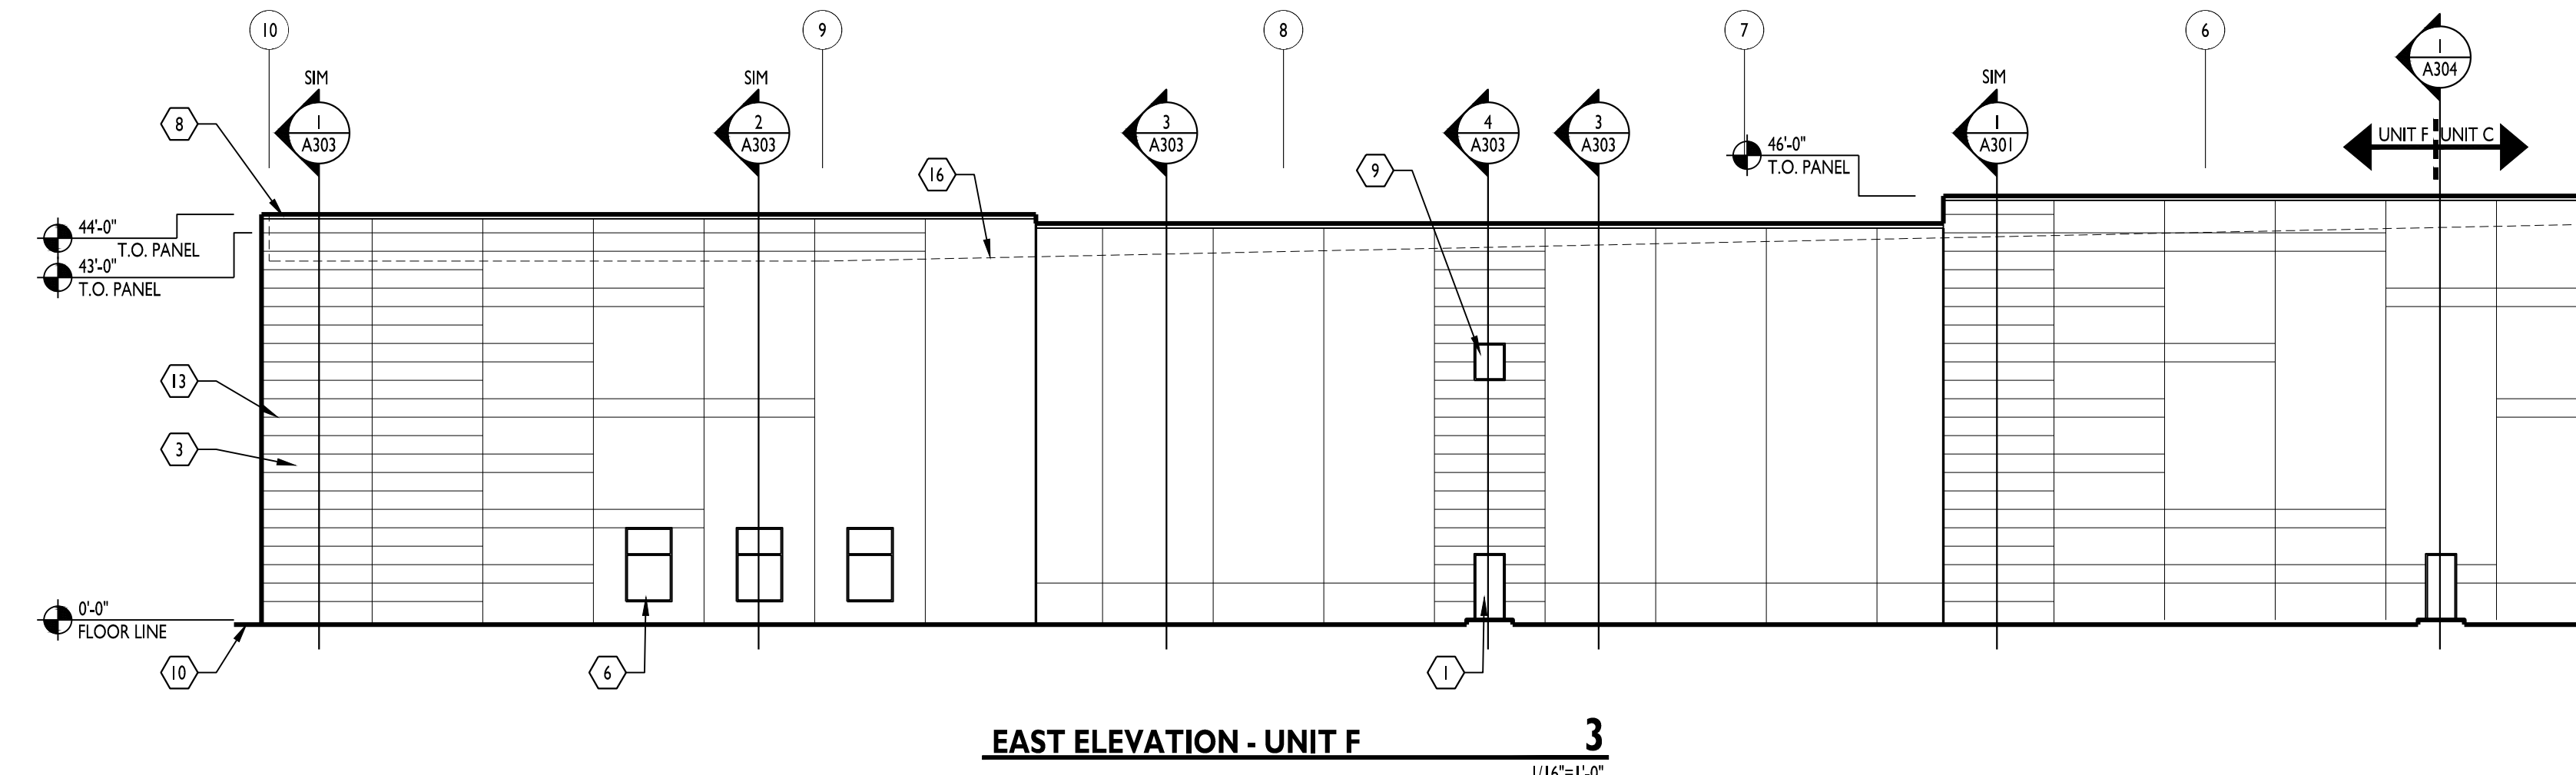


EAST ELEVATION - UNIT F

3
1/16"=1'-0"

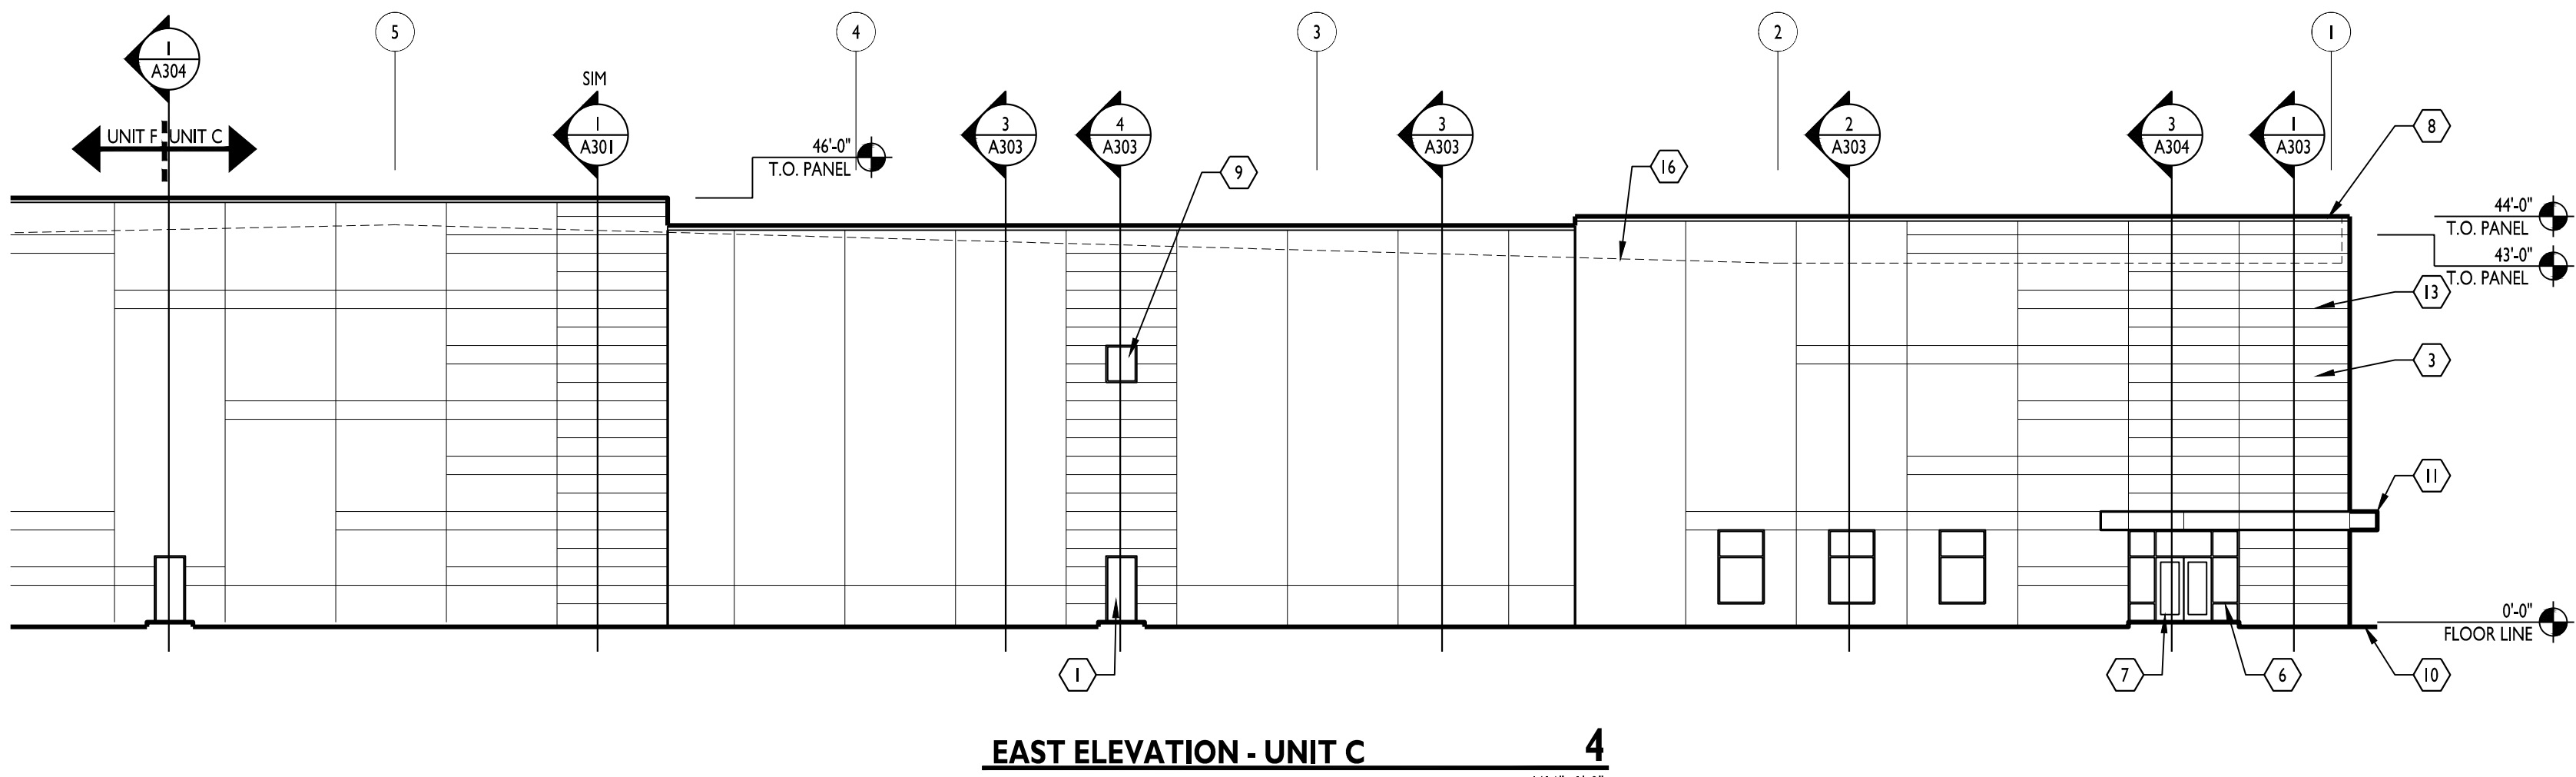


EAST ELEVATION - UNIT C

4
1/16"=1'-0"

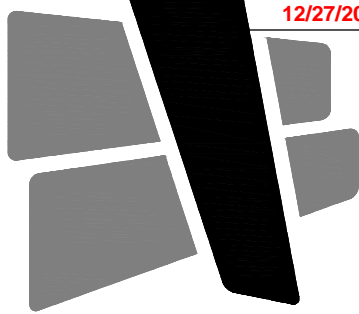

CURRAN
ARCHITECTURE

5719 LAWTON LOOP E. DR. #212
INDIANAPOLIS, IN 46216
O :: 317 . 288 . 0681
F :: 317 . 288 . 0753

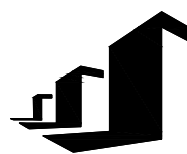

SCANNELL
PROPERTIES

CERTIFICATION

THIS DRAWING AND THE IDEAS, DESIGNS
AND CONCEPTS CONTAINED HEREIN ARE
THE EXCLUSIVE INTELLECTUAL PROPERTY
OF CURRAN ARCHITECTURE, AND ARE NOT
TO BE USED OR REPRODUCED, WHOLE OR
IN PART, WITHOUT THE WRITTEN
CONSENT OF CURRAN ARCHITECTURE.
© COPYRIGHT 2021, CURRAN ARCHITECTURE

PROJECT INFORMATION

LEE'S SUMMIT LOGISTICS
BUILDING A LOT I

NW CORNER OF
NE TUDOR RD & MAIN ST
LEE'S SUMMIT, MO 64086



ISSUE DATES

PERMIT SET 02.18.22
△ PERMIT REVIEW COMMENTS 05.16.22

210300

EXTERIOR ELEVATIONS

A204

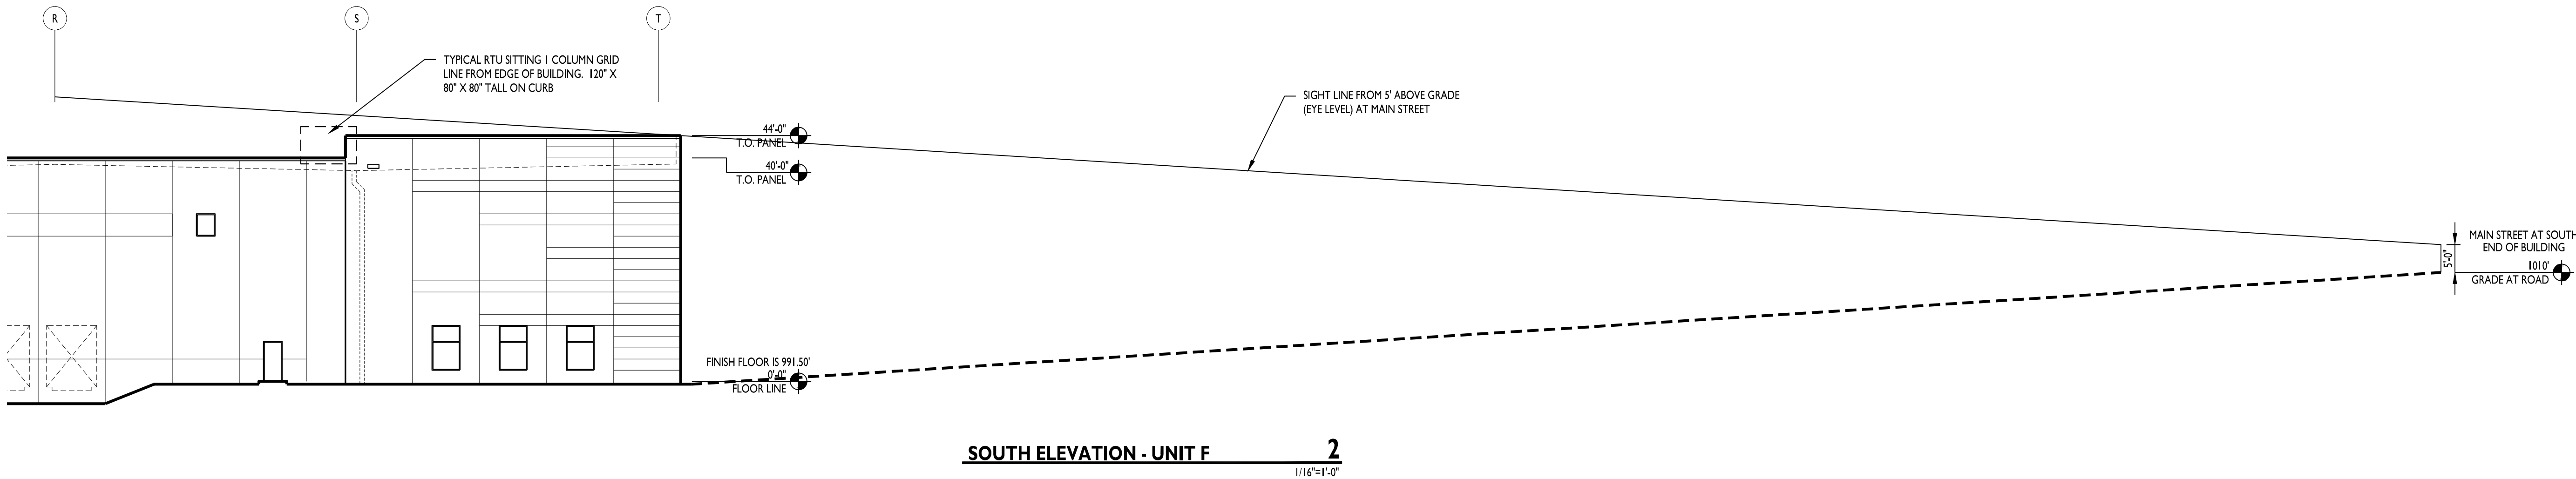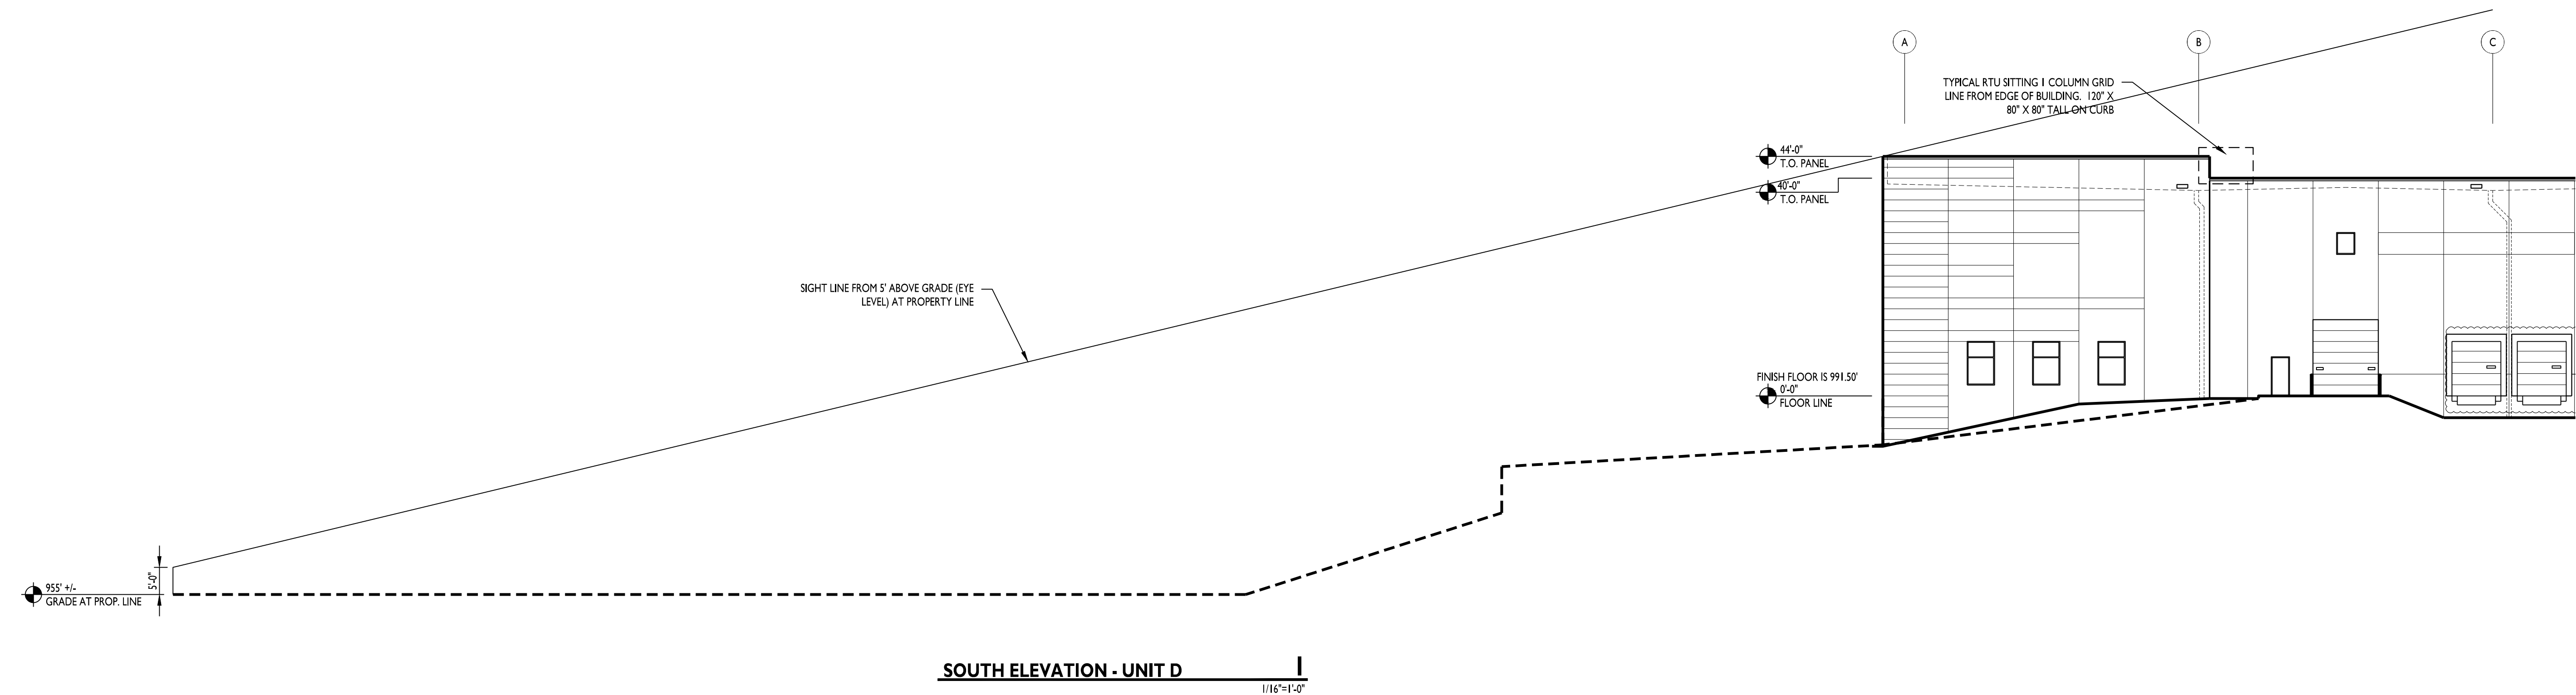

THIS DRAWING AND THE IDEAS, DESIGNS AND CONCEPTS CONTAINED HEREIN ARE THE EXCLUSIVE INTELLECTUAL PROPERTY OF CURRAN ARCHITECTURE, AND ARE NOT TO BE USED OR REPRODUCED, WHOLE OR IN PART, WITHOUT THE WRITTEN CONSENT OF CURRAN ARCHITECTURE.
© COPYRIGHT 2021, CURRAN ARCHITECTURE

PROJECT INFORMATION

LEE'S SUMMIT LOGISTICS
BUILDING A LOT I



NW CORNER OF
NE TUDOR RD & MAIN ST
LEE'S SUMMIT, MO 64086

ISSUE DATES

PERMIT SET	02.18.22
PERMIT REVIEW COMMENTS	05.16.22

210300

EXTERIOR ELEVATIONS

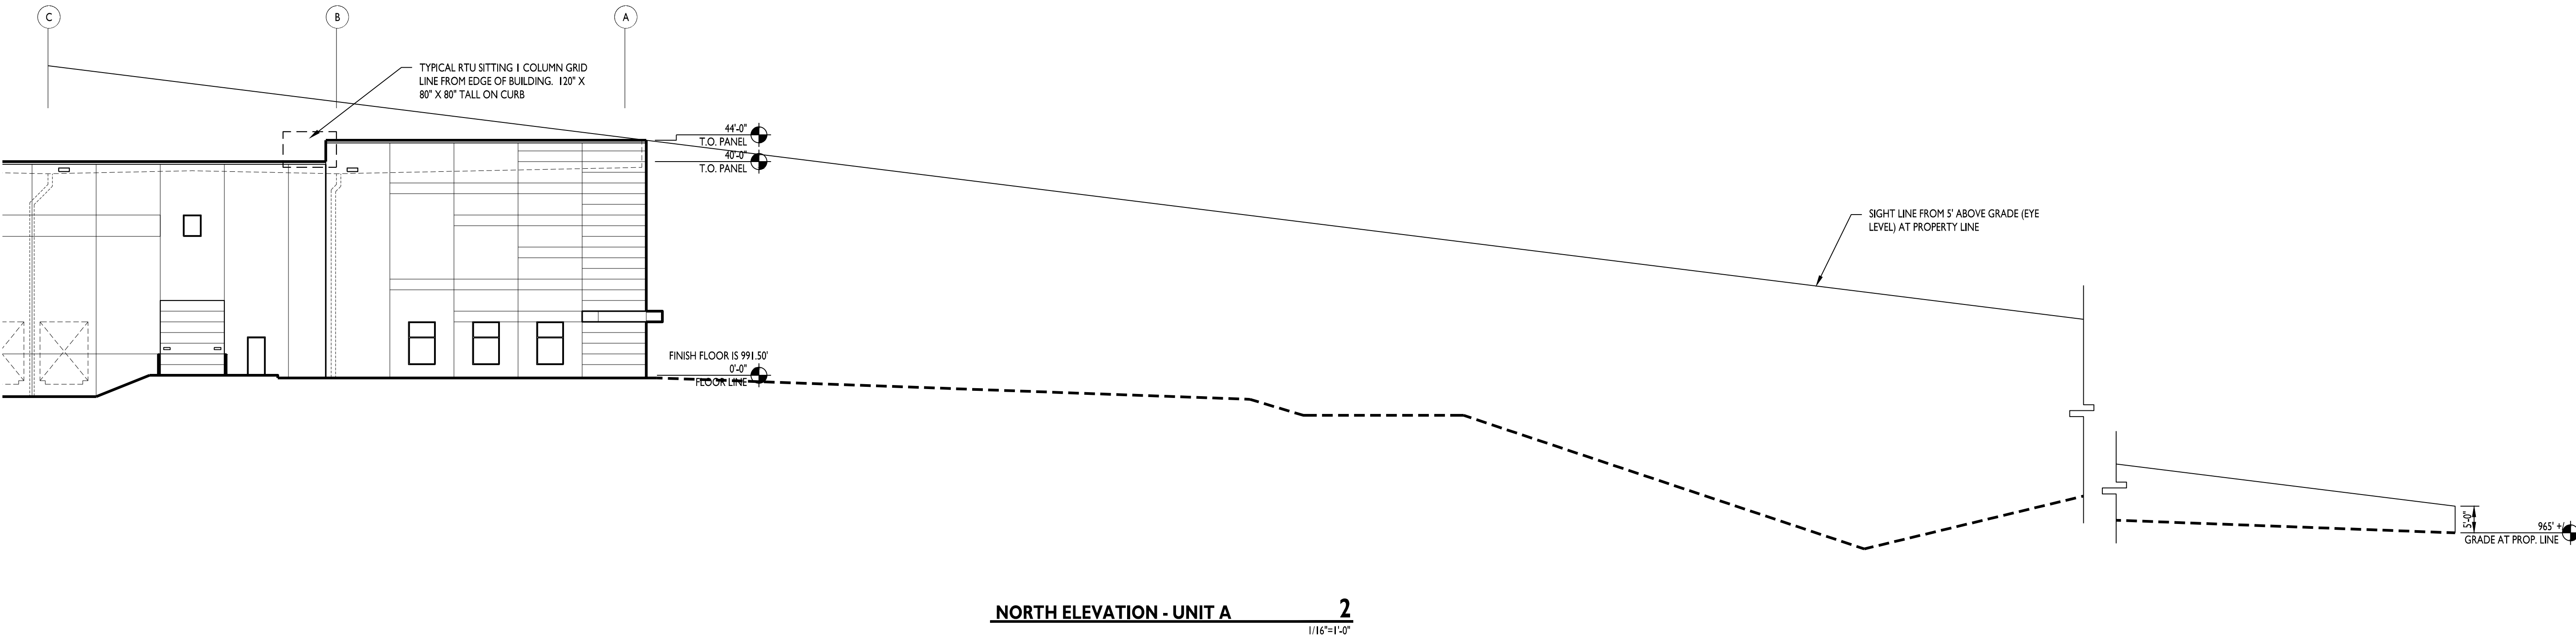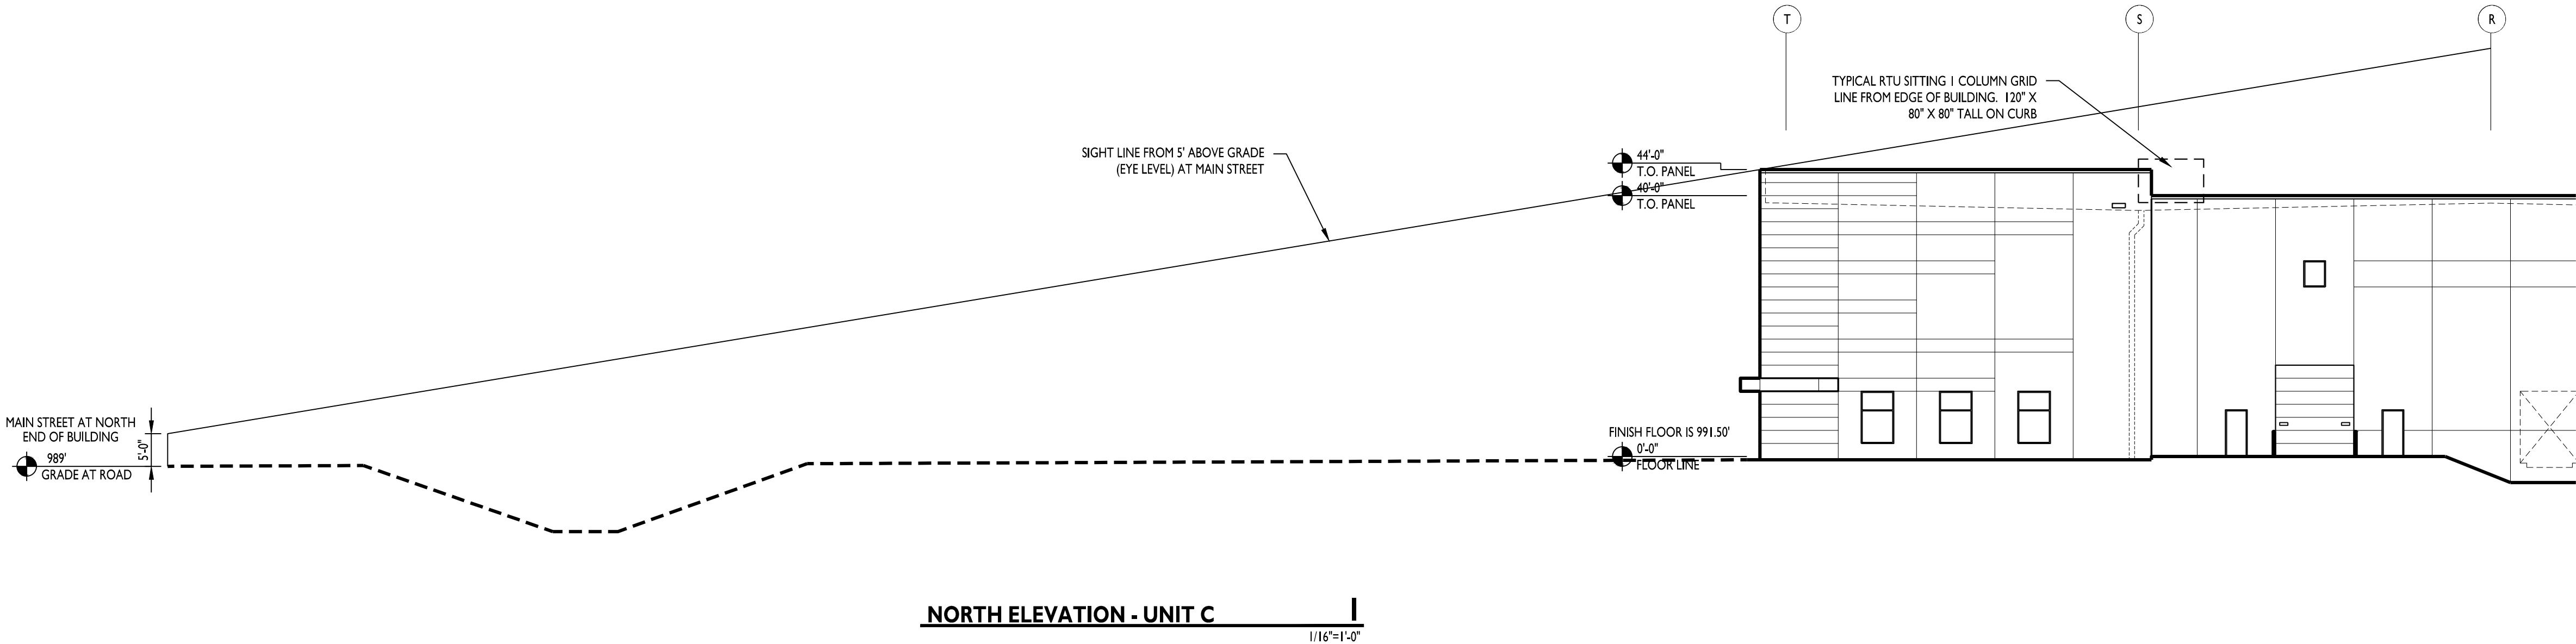

CURRAN

ARCHITECTURE

5719 LAWTON LOOP E. DR. #212
INDIANAPOLIS, IN 46216
O :: 317 . 288 . 0681
F :: 317 . 288 . 0753



CERTIFICATION

THIS DRAWING AND THE IDEAS, DESIGNS
AND CONCEPTS CONTAINED HEREIN ARE
THE EXCLUSIVE INTELLECTUAL PROPERTY
OF CURRAN ARCHITECTURE, AND ARE NOT
TO BE USED OR REPRODUCED, WHOLE OR
IN PART, WITHOUT THE WRITTEN
CONSENT OF CURRAN ARCHITECTURE.
© COPYRIGHT 2021, CURRAN ARCHITECTURE

PROJECT INFORMATION

LEE'S SUMMIT LOGISTICS
BUILDING A LOT I

NW CORNER OF
NE TUDOR RD & MAIN ST
LEE'S SUMMIT, MO 64086



ISSUE DATES

PERMIT SET	02.18.22
△ PERMIT REVIEW COMMENTS	05.16.22

210300

EXTERIOR ELEVATIONS

A206

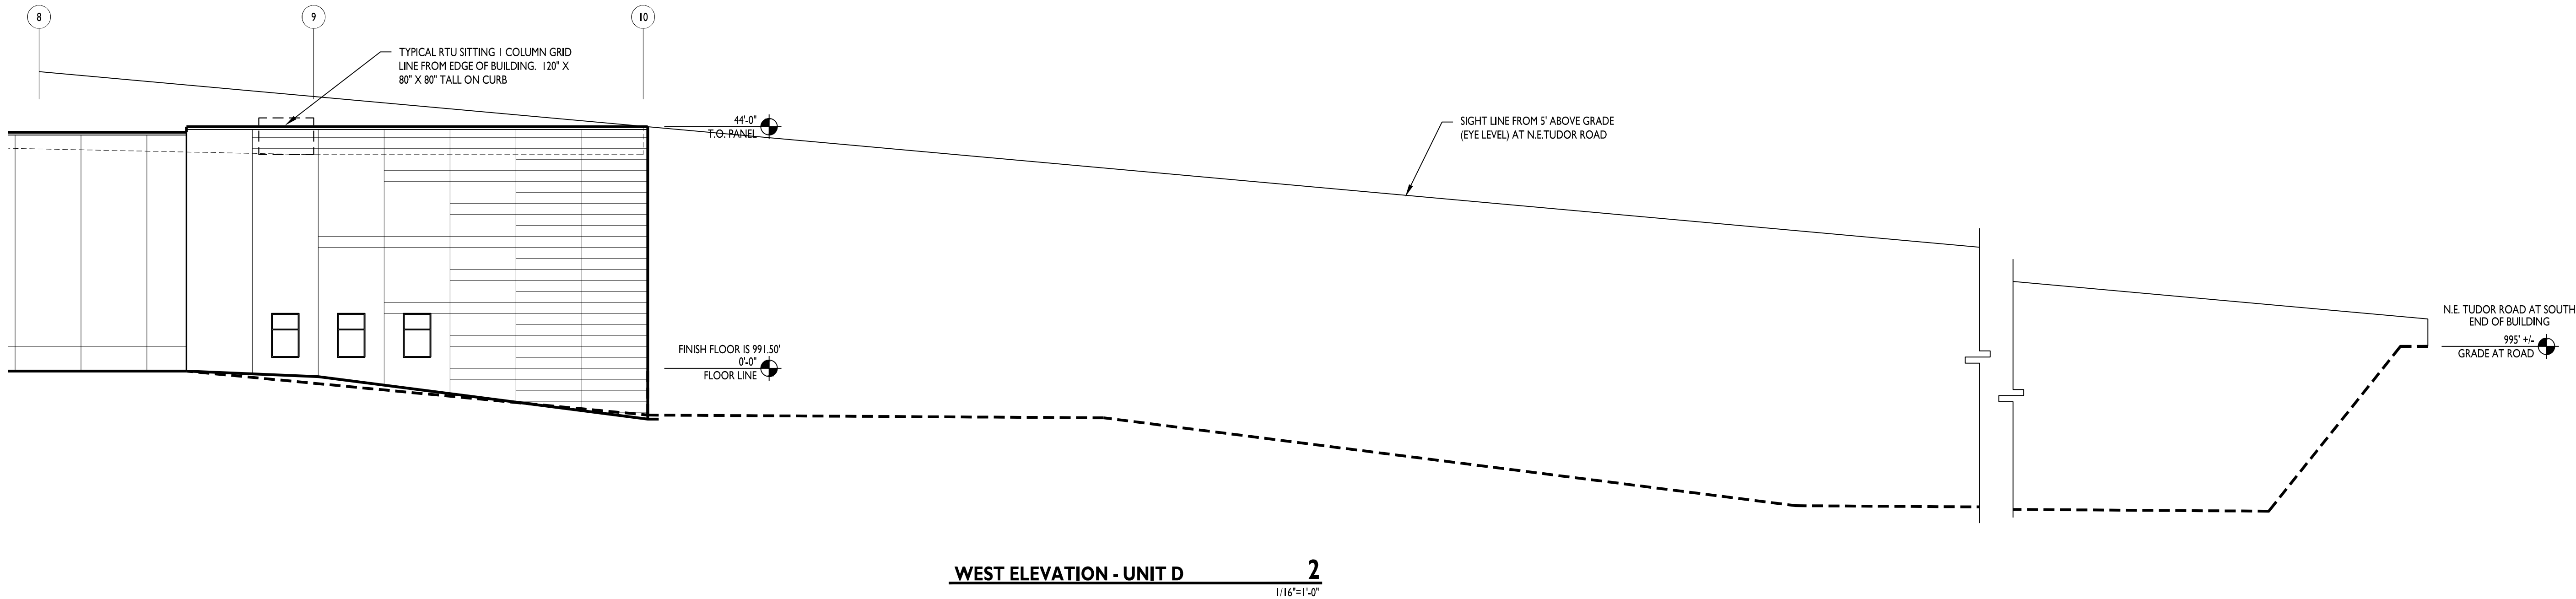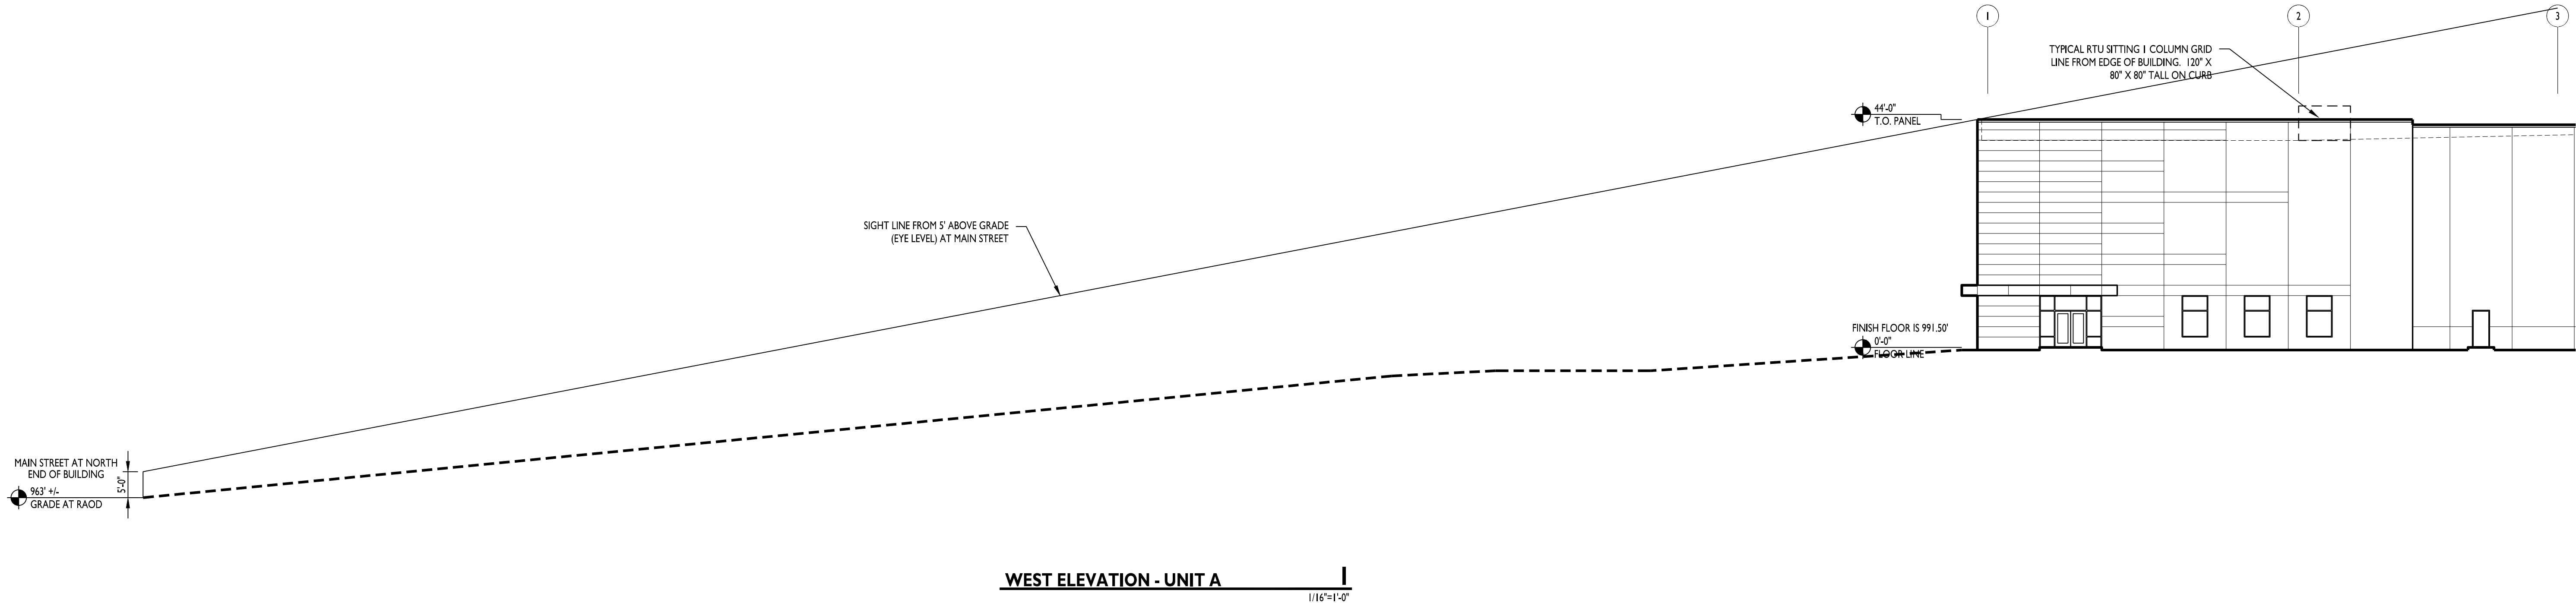

CURRAN
ARCHITECTURE

5719 LAWTON LOOP E. DR. #212
INDIANAPOLIS, IN 46216
O :: 317 . 288 . 0681
F :: 317 . 288 . 0753



CERTIFICATION

THIS DRAWING AND THE IDEAS, DESIGNS
AND CONCEPTS CONTAINED HEREIN ARE
THE EXCLUSIVE INTELLECTUAL PROPERTY
OF CURRAN ARCHITECTURE, AND ARE NOT
TO BE USED OR REPRODUCED, WHOLE OR
IN PART, WITHOUT THE WRITTEN
CONSENT OF CURRAN ARCHITECTURE.
© COPYRIGHT 2021, CURRAN ARCHITECTURE

PROJECT INFORMATION

LEE'S SUMMIT LOGISTICS
BUILDING A LOT I

NW CORNER OF
NE TUDOR RD & MAIN ST
LEE'S SUMMIT, MO 64086



ISSUE DATES


PERMIT SET	02.18.22
△ PERMIT REVIEW COMMENTS	05.16.22

210300

EXTERIOR ELEVATIONS

A207

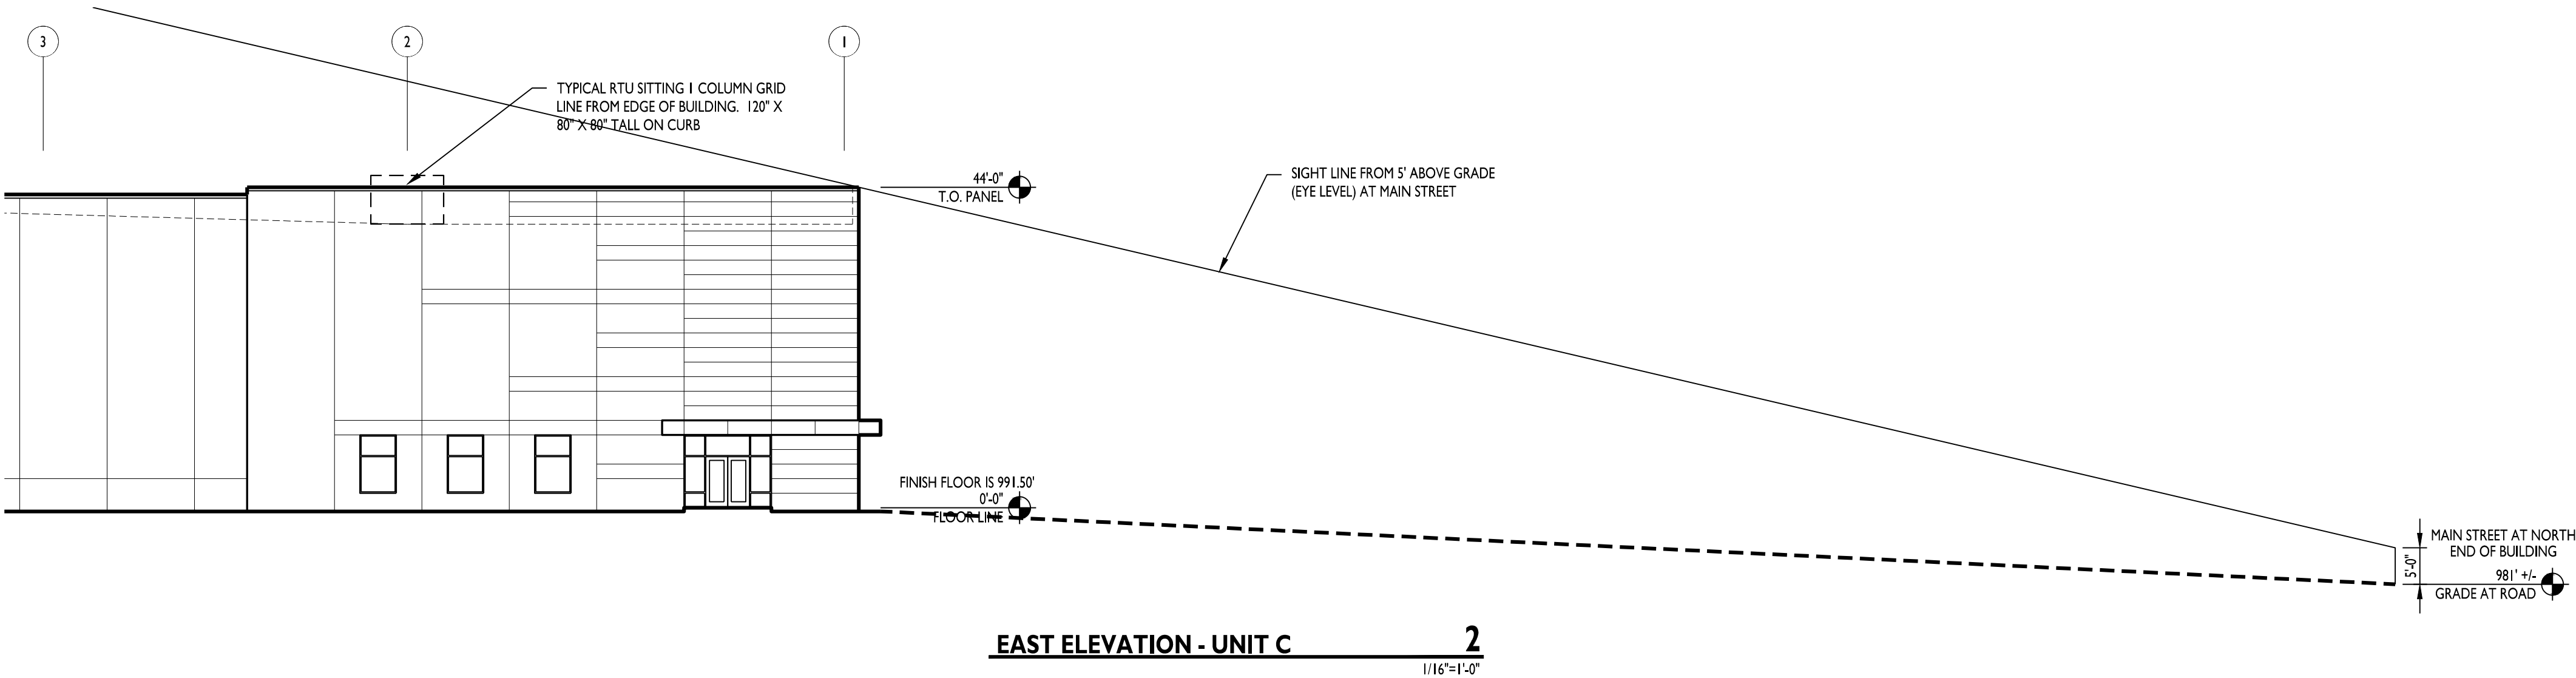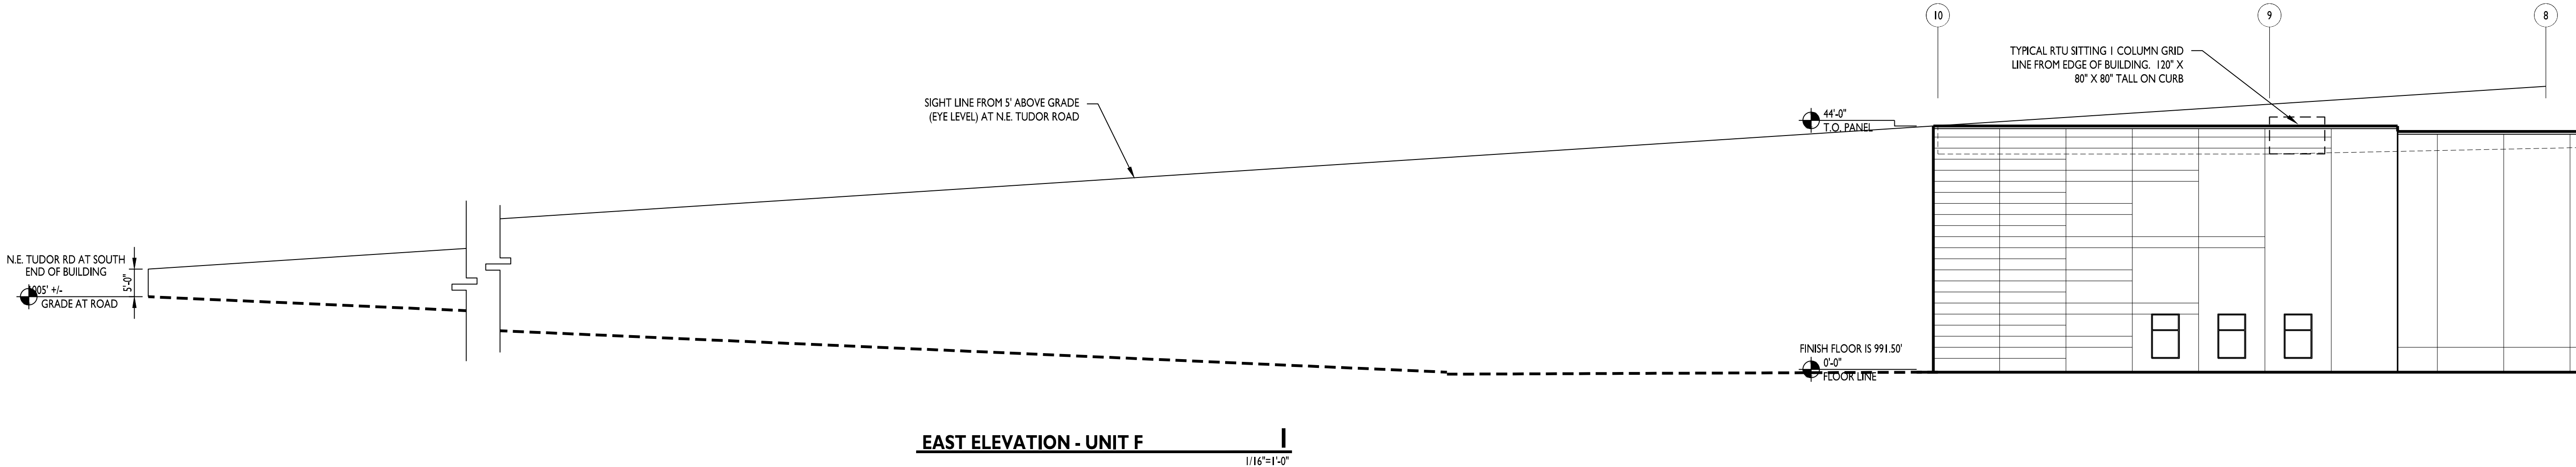

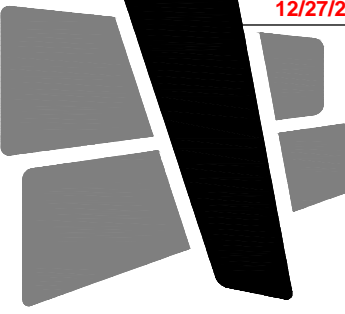

CURRAN
ARCHITECTURE

5719 LAWTON LOOP E. DR. #212
INDIANAPOLIS, IN 46216
O :: 317 . 288 . 0681
F :: 317 . 288 . 0753



SCANNELL
PROPERTIES

CERTIFICATION

THIS DRAWING AND THE IDEAS, DESIGNS
AND CONCEPTS CONTAINED HEREIN ARE
THE EXCLUSIVE INTELLECTUAL PROPERTY
OF CURRAN ARCHITECTURE, AND ARE NOT
TO BE USED OR REPRODUCED, WHOLE OR
IN PART, WITHOUT THE WRITTEN
CONSENT OF CURRAN ARCHITECTURE.
© COPYRIGHT 2021, CURRAN ARCHITECTURE

PROJECT INFORMATION

LEE'S SUMMIT LOGISTICS
BUILDING A LOT I

NW CORNER OF
NE TUDOR RD & MAIN ST
LEE'S SUMMIT, MO 64086

ISSUE DATES

PERMIT SET 02.18.22


210300

WALL SECTIONS

A301


KEYED NOTES

1. ROOF MEMBRANE AND INSULATION BOARD. SEE ROOF PLAN FOR INFORMATION. UNDERSIDE OF DECKING FACTORY FINISHED. COLOR WHITE. MINIMUM SLOPE 1/4 INCH PER FOOT. TYPICAL BUILDING ROOFING UNLESS NOTED OTHERWISE.
2. WRAP ROOF MEMBRANE UP BACK SIDE OF TILTWALL PANEL. OVER TREATED 2x BLOCKING ATTACHED TO TILTWALL PANEL. PROVIDE PRE-FINISHED METAL COPING WITH CONTINUOUS HOLD DOWN CLIP. FOR ALL ROOF EDGES UNLESS NOTED OTHERWISE.
3. DOCK SEAL AND DOCK BUMPER.
4. PRE-FINISHED INSULATED STEEL OVERHEAD DOOR. REFER TO DOOR SCHEDULE.
5. TYPICAL WALL PANELS: TILTWALL CONCRETE PANELS WITH STEEL FORM PAINT READY EXTERIOR FINISH. REFER TO I/A301 FOR TYPICAL VERTICAL SPACING OF REVEALS. REFER TO ELEVATIONS FOR SPECIFIC REVEAL LAYOUT PER PANEL.
6. STRUCTURAL STEEL FRAMING. REFER TO ENGINEERING DRAWINGS. COORDINATE STRUCTURAL WITH TILTWALL MANUFACTURER. ORIENTATION OF FRAMING MAY VARY PER SECTION. REFER TO STRUCTURAL DRAWINGS FOR MORE INFORMATION.
7. THERMALLY BROKEN ALUMINUM STOREFRONT FRAMING WITH 1" INSULATED TINTED GLASS. REFER TO STOREFRONT ELEVATIONS FOR MORE INFORMATION.
8. CONCRETE SLAB ON GRADE. SEE STRUCTURAL.
9. REINFORCED CONCRETE FOUNDATION. SEE STRUCTURAL.
10. SEE CIVIL FOR EXTERIOR GRADING, SIDEWALKS, ETC..
11. PROVIDE HINGED LOCKING GATE ON LADDER.
12. 1/2" EXPANSION JOINT.
13. 2" RIGID INSULATION BOARD, TYPICAL. UNDERSIDE OF SLAB TO TOP OF FOOTING. AT DOORS AND LOCATIONS WHERE DOORS OR STOREFRONT EXTENDS TO FLOOR SLAB, EXTEND THE INSULATION HORIZONTALLY UNDER THE SLAB A MINIMUM OF 4'.
14. DOCK LEVELER PIT. VERIFY DIMENSIONS WITH SUBMITTAL PACKAGE OF LEVELER UNIT. SEE STRUCTURAL FOR REINFORCEMENT INFORMATION.
15. MANUFACTURED PAN AND GUTTER AWNING SYSTEM WITH SCUPPER DIRECTED TO LANDSCAPE BELOW, MAPS LUMIDECK OR EQUAL. FINISH AND SCUPPER LOCATION TO BE SELECTED BY ARCHITECT.
16. REVEALS CAST IN TILTWALL WALL. REFER TO I/A301. SEE ELEVATIONS FOR LOCATIONS OF REVEALS ON EACH PANEL.
17. TYPICAL SEALANT JOINT.
18. INSULATED STEEL DOOR AND HOLLOW METAL FRAME. REFER TO FLOOR PLAN FOR NUMBER AND DOOR SCHEDULE FOR SIZE, HARDWARE AND FINISH.
19. FOAM ENCLOSURE, TYPICAL. ENTIRE PERIMETER OF DECK. VERIFY MATERIAL AND DETAILS. COORDINATE WITH DECK MANUFACTURER/SUPPLIER. FOAM BETWEEN BLOCKING AND TOP LAYER OF ROOF INSULATION. EXTEND DOWN TO DECK AND JOIST ANGLES.
20. PRE-FINISHED METAL COPING WITH CONT. HOLD DOWN CLIP. COLOR SELECTED BY ARCHITECT FROM FULL RANGE OF MANUFACTURER'S COLORS.
21. INSULATION IS TO EXTEND TO BACK OF DOCK LEVELER PIT, AND EXTEND VERTICALLY UP SIDES AND BACK OF PIT TO COMPLETELY INSULATE PIT PERIMETER.
22. GALVANIZED STEEL DOCK STAIR ASSEMBLY. REFER TO I1 AND I2/A501 FOR INFORMATION.
23. 4' X 4' INSULATED ROOF HATCH. COORDINATE PLACEMENT WITH ROOF FRAMING. LADDER TO BE CENTERED BELOW HATCH.
24. "LADDER UP" SUPPORT POST.
25. PROVIDE BRACING AS REQUIRED BY LADDER SUPPLIER.
26. OSHA COMPLIANT ROOF ACCESS LADDER CAGE.
27. LADDER BRACKETS. ANCHOR TO SLAB, ROOF FRAMING AND PLATFORM.
28. 18 INCH WIDE STEEL LADDER WITH 1 INCH DIAMETER STEEL RUNGS AT 12 INCHES O.C. SECURE STRINGERS TO FLOOR - TYPICAL BOTH SIDES PER LADDER SUPPLIER REQUIREMENTS.
29. 1 1/2" DIA STEEL 2 LINE GUARD RAIL WITH 4" TALL TOE BOARD AT PLATFORM LEVEL.
30. PROVIDE ADD ALTERNATE PRICING TO PROVIDE CONDUIT FOR FUTURE TRAILER RESTRAINT.
31. CONCRETE FILLED PIPE BOLLARDS, PAINTED SAFETY YELLOW. REFER TO CIVIL DRAWINGS FOR MORE INFORMATION.
32. FLASHING TO EXTEND OVER EDGE OF CONCRETE. PROVIDE HEMMED EDGE.
33. STICK PIN INSULATION W/ MINIMUM R-13 VALUE. USE ADHESIVES & FASTENERS TO SECURE INSULATION.
34. 8" REINFORCED CMU WALL. REFER TO STRUCTURAL DWGS.
35. HONEYWELL GUIDELOC VERTICAL RAIL AND FALL ARRESTER SYSTEM MOUNTED TO CENTER OF RUNGS, OR EQUAL.
36. CONSTRUCT 1 HR RATED WALL ON TOP OF CMU TO ROOF DECK. REFER TO WALL TYPE W4A ON A301.
37. TYPICAL DEFLECTION TRACK. REFER TO A501 FOR DETAIL.

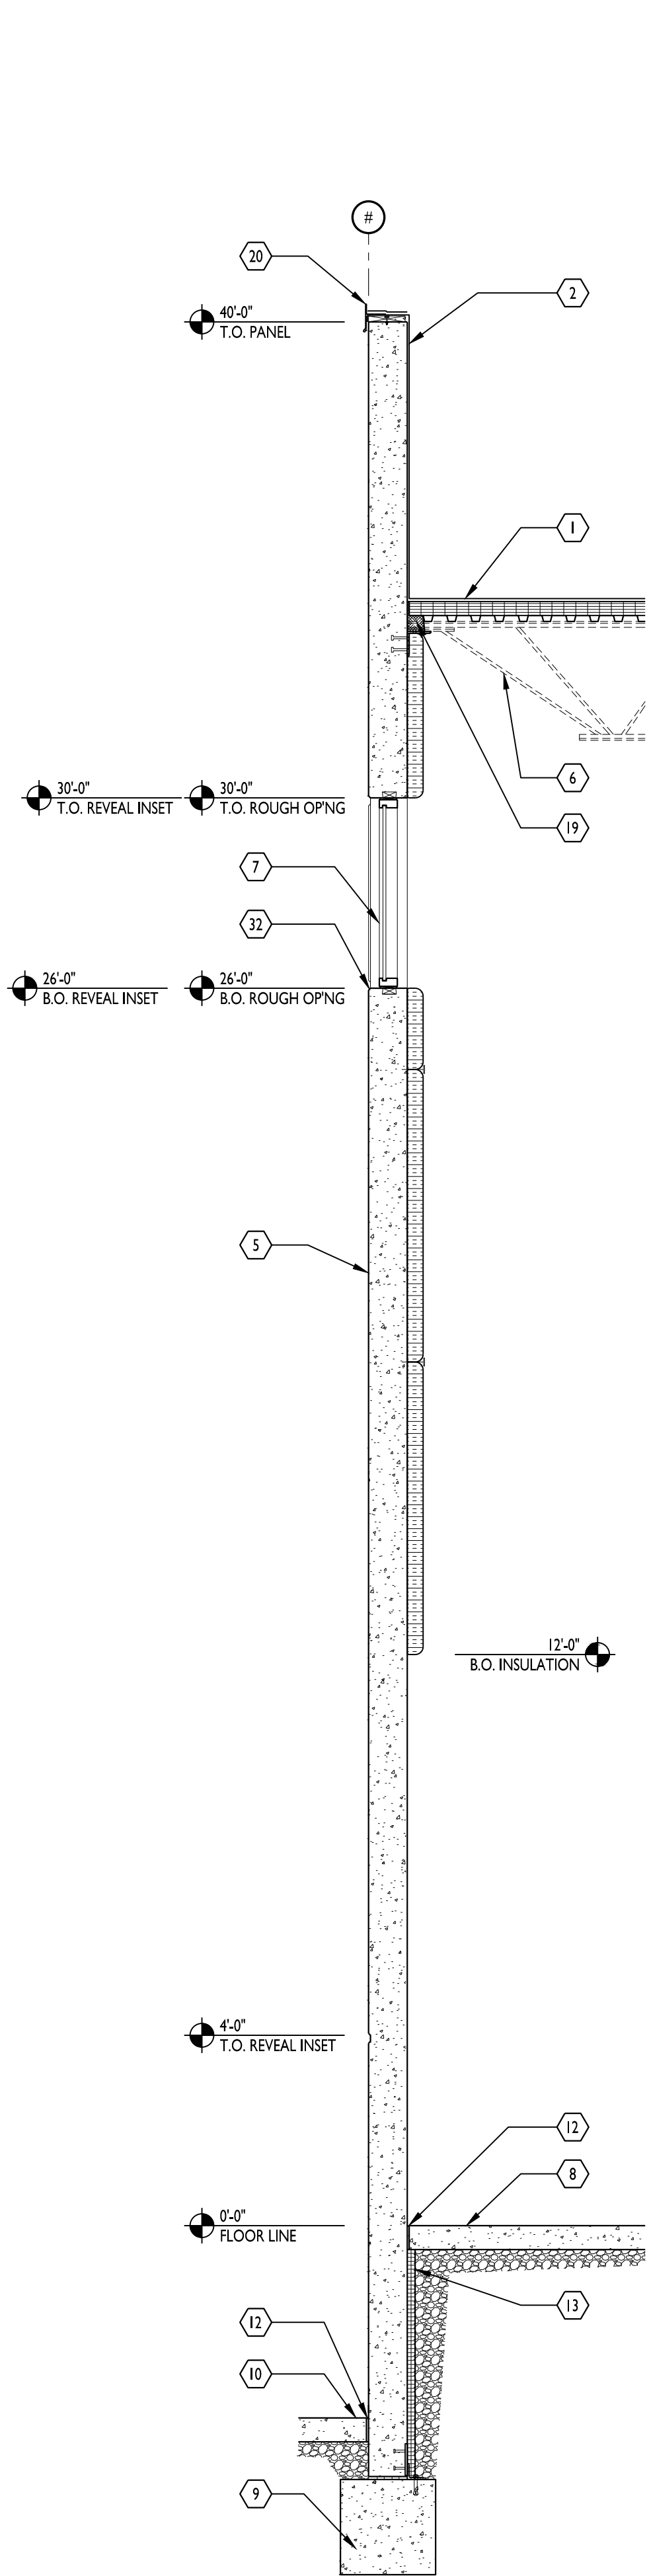


SECTION

4
3/8" = 1'-0"

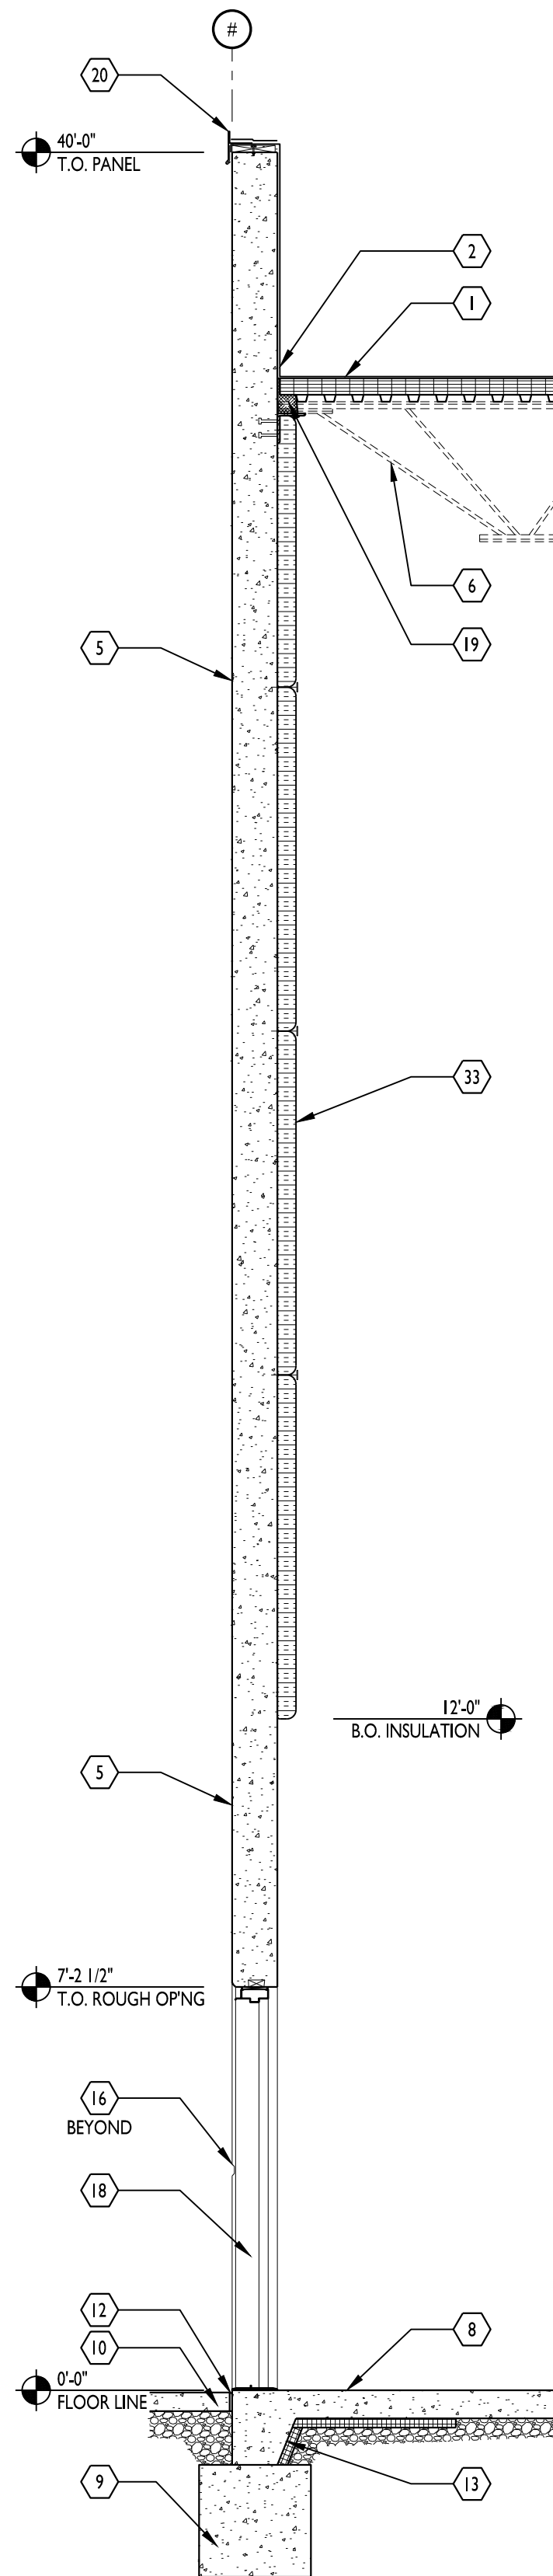


SECTION

3
3/8" = 1'-0"

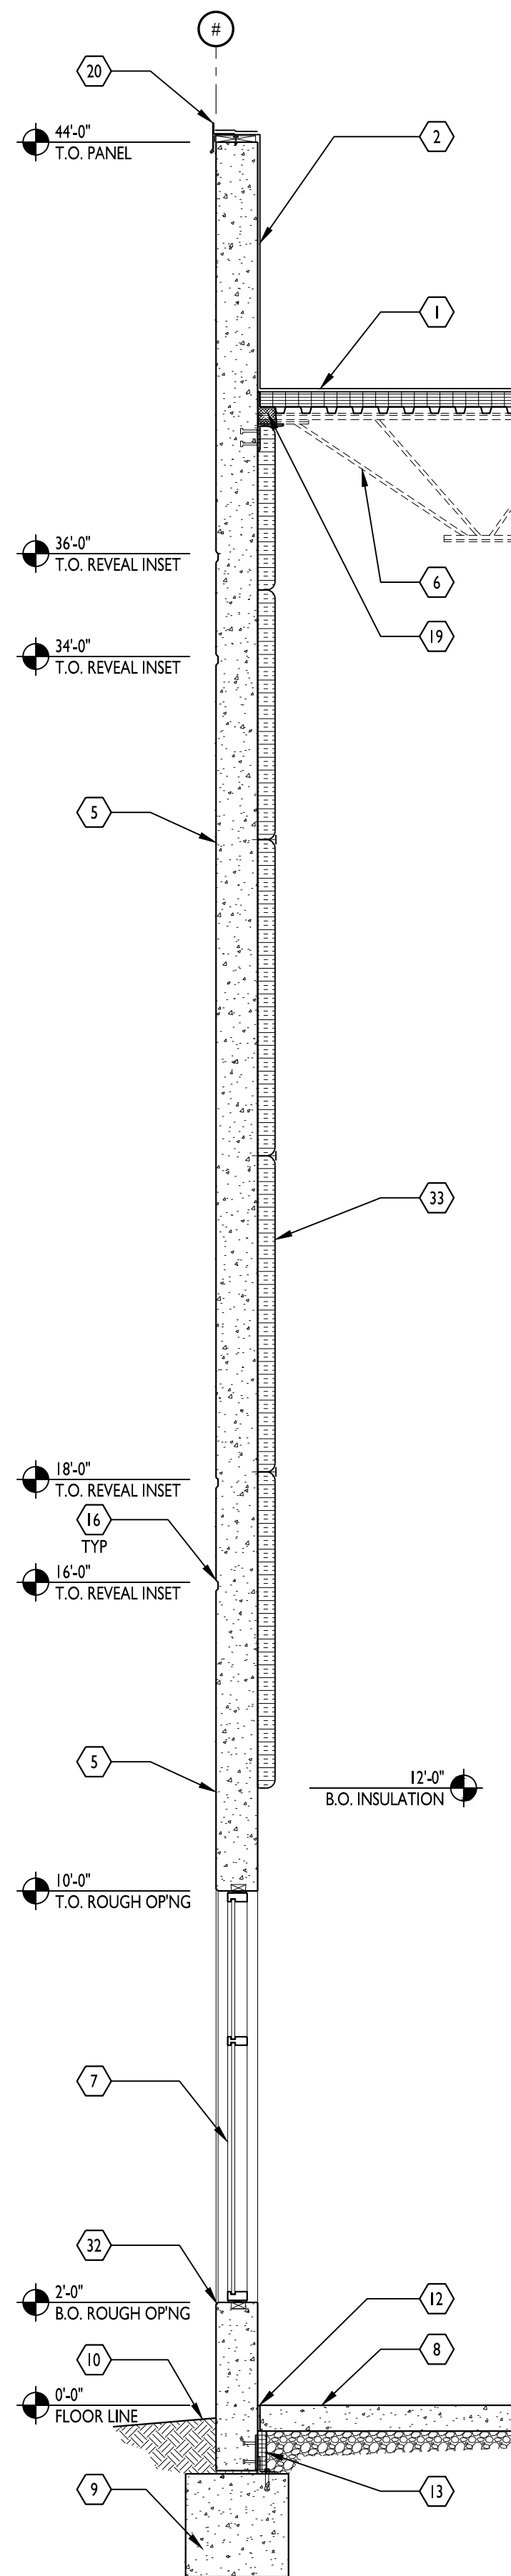


SECTION

2
3/8" = 1'-0"

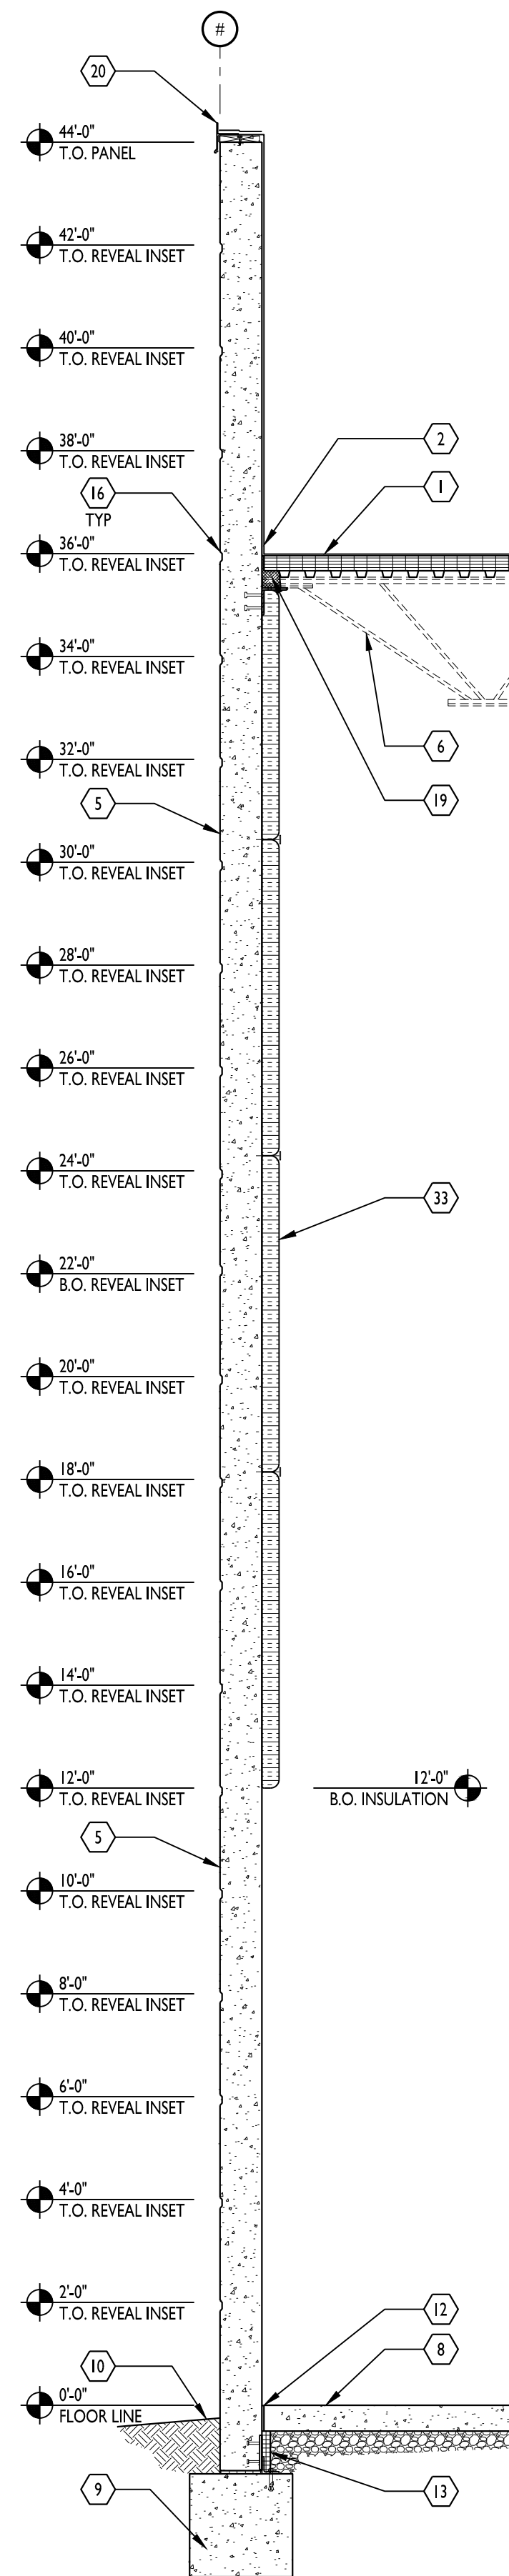


SECTION

1
3/8" = 1'-0"

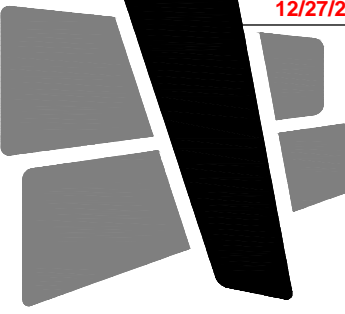

CURRAN
ARCHITECTURE

5719 LAWTON LOOP E. DR. #212
INDIANAPOLIS, IN 46216
O :: 317 . 288 . 0681
F :: 317 . 288 . 0753

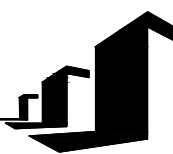

SCANNELL
PROPERTIES

CERTIFICATION

THIS DRAWING AND THE IDEAS, DESIGNS
AND CONCEPTS CONTAINED HEREIN ARE
THE EXCLUSIVE INTELLECTUAL PROPERTY
OF CURRAN ARCHITECTURE, AND ARE NOT
TO BE USED OR REPRODUCED, WHOLE OR
IN PART, WITHOUT THE WRITTEN
CONSENT OF CURRAN ARCHITECTURE.
© COPYRIGHT 2021, CURRAN ARCHITECTURE

PROJECT INFORMATION

LEE'S SUMMIT LOGISTICS
BUILDING A LOT I

NW CORNER OF
NE TUDOR RD & MAIN ST
LEE'S SUMMIT, MO 64086

ISSUE DATES

PERMIT SET 02.18.22


210300


WALL SECTIONS

A302

KEYED NOTES

- ROOF MEMBRANE AND INSULATION BOARD. SEE ROOF PLAN FOR INFORMATION. UNDERSIDE OF DECKING FACTORY FINISHED, COLOR WHITE. MINIMUM SLOPE 1/4 INCH PER FOOT. TYPICAL BUILDING ROOFING UNLESS NOTED OTHERWISE.
- WRAP ROOF MEMBRANE UP BACK SIDE OF TILTWALL PANEL. OVER TREATED 2x BLOCKING ATTACHED TO TILTWALL PANEL. PROVIDE PRE-FINISHED METAL COPING WITH CONTINUOUS HOLD-DOWN CLIP. FOR ALL ROOF EDGES UNLESS NOTED OTHERWISE.
- DOCK SEAL AND DOCK BUMPER.
- PRE-FINISHED INSULATED STEEL OVERHEAD DOOR. REFER TO DOOR SCHEDULE.
- TYPICAL WALL PANELS: TILTWALL CONCRETE PANELS WITH STEEL FORM PAINT READY EXTERIOR FINISH. REFER TO I/A301 FOR TYPICAL VERTICAL SPACING OF REVEALS. REFER TO ELEVATIONS FOR SPECIFIC REVEAL LAYOUT PER PANEL.
- STRUCTURAL STEEL FRAMING. REFER TO ENGINEERING DRAWINGS. COORDINATE STRUCTURAL WITH TILTWALL MANUFACTURER. ORIENTATION OF FRAMING MAY VARY PER SECTION. REFER TO STRUCTURAL DRAWINGS FOR MORE INFORMATION.
- THERMALLY BROKEN ALUMINUM STOREFRONT FRAMING WITH 1" INSULATED TINTED GLASS. REFER TO STOREFRONT ELEVATIONS FOR MORE INFORMATION.
- CONCRETE SLAB ON GRADE. SEE STRUCTURAL.
- REINFORCED CONCRETE FOUNDATION. SEE STRUCTURAL.
- SEE CIVIL FOR EXTERIOR GRADING, SIDEWALKS, ETC..
- PROVIDE HINGED LOCKING GATE ON LADDER.
- 1/2" EXPANSION JOINT.
- 2" RIGID INSULATION BOARD, TYPICAL UNDERSIDE OF SLAB TO TOP OF FOOTING. AT DOORS AND LOCATIONS WHERE DOORS OR STOREFRONT EXTENDS TO FLOOR SLAB, EXTEND THE INSULATION HORIZONTALLY UNDER THE SLAB A MINIMUM OF 4'.
- DOCK LEVELER PIT. VERIFY DIMENSIONS WITH SUBMITTAL PACKAGE OF LEVELER UNIT. SEE STRUCTURAL FOR REINFORCEMENT INFORMATION.
- MANUFACTURED PAN AND GUTTER AWNING SYSTEM WITH SCUPPER DIRECTED TO LANDSCAPE BELOW, MAPS LUMIDOCK OR EQUAL. FINISH AND SCUPPER LOCATION TO BE SELECTED BY ARCHITECT.
- REVEALS CAST IN TILTWALL WALL. REFER TO I/A501. SEE ELEVATIONS FOR LOCATIONS OF REVEALS ON EACH PANEL.
- TYPICAL SEALANT JOINT.
- INSULATED STEEL DOOR AND HOLLOW METAL FRAME. REFER TO FLOOR PLAN FOR NUMBER AND DOOR SCHEDULE FOR SIZE, HARDWARE, AND FINISH.
- FOAM ENCLOSURE, TYPICAL ENTIRE PERIMETER OF DECK. VERIFY MATERIAL AND DETAILS. COORDINATE WITH DECK MANUFACTURER/SUPPLIER. FOAM BETWEEN BLOCKING AND TOP LAYER OF ROOF INSULATION. EXTEND DOWN TO DECK AND JOIST ANGLES.
- PRE-FINISHED METAL COPING WITH CONT. HOLD-DOWN CLIP. COLOR SELECTED BY ARCHITECT FROM FULL RANGE OF MANUFACTURER'S COLORS.
- INSULATION IS TO EXTEND TO BACK OF DOCK LEVELER PIT, AND EXTEND VERTICALLY UP SIDES AND BACK OF PIT TO COMPLETELY INSULATE PIT PERIMETER.
- GALVANIZED STEEL DOCK STAIR ASSEMBLY. REFER TO I1 AND I2/A501 FOR INFORMATION.
- 4' X 4' INSULATED ROOF HATCH. COORDINATE PLACEMENT WITH ROOF FRAMING. LADDER TO BE CENTERED BELOW HATCH.
- "LADDER UP" SUPPORT POST.
- PROVIDE BRACING AS REQUIRED BY LADDER SUPPLIER.
- OSHA COMPLIANT ROOF ACCESS LADDER CAGE.
- LADDER BRACKETS. ANCHOR TO SLAB, ROOF FRAMING AND PLATFORM.
- 18 INCH WIDE STEEL LADDER WITH 1 INCH DIAMETER STEEL RUNGS AT 12 INCHES O.C. SECURE STRINGERS TO FLOOR - TYPICAL BOTH SIDES PER LADDER SUPPLIER REQUIREMENTS.
- 1 1/2" DIA STEEL 2 LINE GUARD RAIL WITH 4" TALL TOE BOARD AT PLATFORM LEVEL.
- PROVIDE ADD ALTERNATE PRICING TO PROVIDE CONDUIT FOR FUTURE TRAILER RESTRAINT.
- CONCRETE FILLED PIPE BOLLARDS, PAINTED SAFETY YELLOW. REFER TO CIVIL DRAWINGS FOR MORE INFORMATION.
- FLASHING TO EXTEND OVER EDGE OF CONCRETE. PROVIDE HEMMED EDGE.
- STICK PIN INSULATION W/ MINIMUM R-13 VALUE. USE ADHESIVES & FASTENERS TO SECURE INSULATION.
- 8" REINFORCED CMU WALL. REFER TO STRUCTURAL DWGS.
- HONEYWELL GUIDELOC VERTICAL RAIL AND FALL ARRESTER SYSTEM MOUNTED TO CENTER OF RUNGS, OR EQUAL.
- CONSTRUCT 1 HR RATED WALL ON TOP OF CMU TO ROOF DECK. REFER TO WALL TYPE W4A ON A501.
- TYPICAL DEFLECTION TRACK. REFER TO A501 FOR DETAIL.

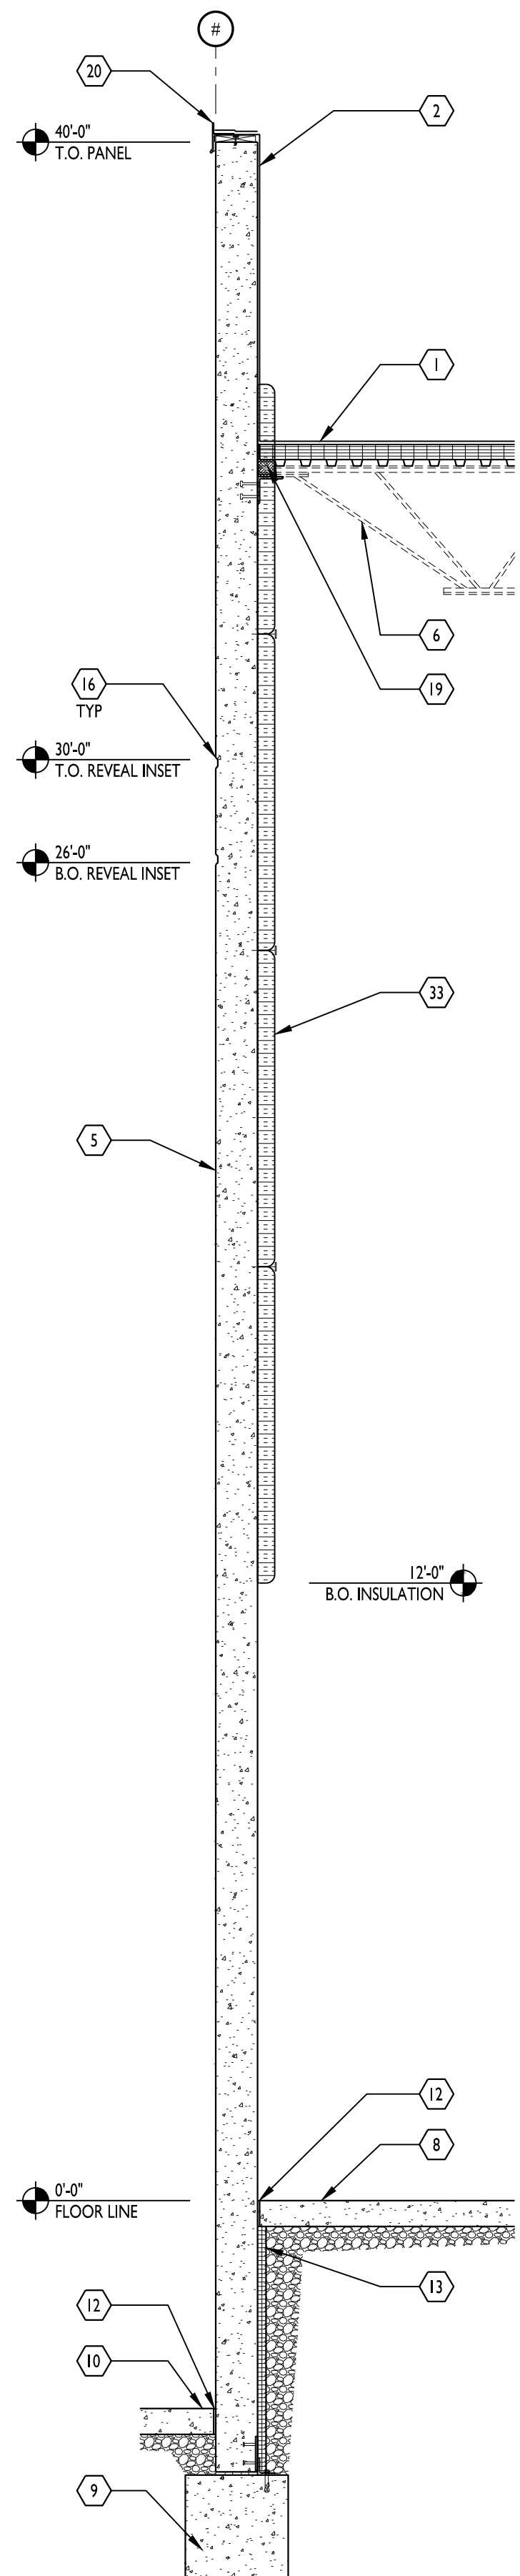

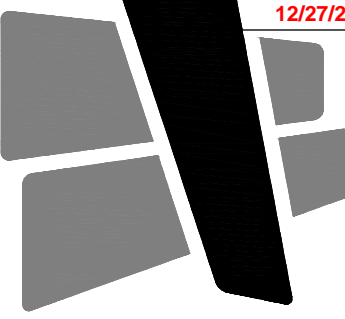

CURRAN
ARCHITECTURE

5719 LAWTON LOOP E. DR. #212
INDIANAPOLIS, IN 46216
O :: 317 . 288 . 0681
F :: 317 . 288 . 0753



SCANNELL
PROPERTIES

CERTIFICATION

THIS DRAWING AND THE IDEAS, DESIGNS
AND CONCEPTS CONTAINED HEREIN ARE
THE EXCLUSIVE INTELLECTUAL PROPERTY
OF CURRAN ARCHITECTURE, AND ARE NOT
TO BE USED OR REPRODUCED, WHOLE OR
IN PART, WITHOUT THE WRITTEN
CONSENT OF CURRAN ARCHITECTURE.
© COPYRIGHT 2021, CURRAN ARCHITECTURE

PROJECT INFORMATION

LEE'S SUMMIT LOGISTICS
BUILDING A LOT I

NW CORNER OF
NE TUDOR RD & MAIN ST
LEE'S SUMMIT, MO 64086

ISSUE DATES

PERMIT SET 02.18.22


210300

WALL SECTIONS

A303

KEYED NOTES


1. ROOF MEMBRANE AND INSULATION BOARD. SEE ROOF PLAN FOR INFORMATION. UNDERSIDE OF DECKING FACTORY FINISHED, COLOR WHITE. MINIMUM SLOPE 1/4 INCH PER FOOT. TYPICAL BUILDING ROOFING UNLESS NOTED OTHERWISE.
2. WRAP ROOF MEMBRANE UP BACK SIDE OF TILTWALL PANEL. OVER TREATED 2x BLOCKING ATTACHED TO TILTWALL PANEL. PROVIDE PRE-FINISHED METAL COPING WITH CONTINUOUS HOLD-DOWN CLIP. FOR ALL ROOF EDGES UNLESS NOTED OTHERWISE.
3. DOCK SEAL AND DOCK BUMPER.
4. PRE-FINISHED INSULATED STEEL OVERHEAD DOOR. REFER TO DOOR SCHEDULE.
5. TYPICAL WALL PANELS: TILTWALL CONCRETE PANELS WITH STEEL FORM PAINT READY EXTERIOR FINISH. REFER TO I/A301 FOR TYPICAL VERTICAL SPACING OF REVEALS. REFER TO ELEVATIONS FOR SPECIFIC REVEAL LAYOUT PER PANEL.
6. STRUCTURAL STEEL FRAMING. REFER TO ENGINEERING DRAWINGS. COORDINATE STRUCTURAL WITH TILTWALL MANUFACTURER. ORIENTATION OF FRAMING MAY VARY PER SECTION. REFER TO STRUCTURAL DRAWINGS FOR MORE INFORMATION.
7. THERMALLY BROKEN ALUMINUM STOREFRONT FRAMING WITH 1" INSULATED TINTED GLASS. REFER TO STOREFRONT ELEVATIONS FOR MORE INFORMATION.
8. CONCRETE SLAB ON GRADE. SEE STRUCTURAL.
9. REINFORCED CONCRETE FOUNDATION. SEE STRUCTURAL.
10. SEE CIVIL FOR EXTERIOR GRADING, SIDEWALKS, ETC..
11. PROVIDE HINGED LOCKING GATE ON LADDER.
12. 1/2" EXPANSION JOINT.
13. 2" RIGID INSULATION BOARD, TYPICAL. UNDERSIDE OF SLAB TO TOP OF FOOTING. AT DOORS AND LOCATIONS WHERE DOORS OR STOREFRONT EXTENDS TO FLOOR SLAB, EXTEND THE INSULATION HORIZONTALLY UNDER THE SLAB A MINIMUM OF 4'.
14. DOCK LEVELER PIT. VERIFY DIMENSIONS WITH SUBMITTAL PACKAGE OF LEVELER UNIT. SEE STRUCTURAL FOR REINFORCEMENT INFORMATION.
15. MANUFACTURED PAN AND GUTTER AWNING SYSTEM WITH SCUPPER DIRECTED TO LANDSCAPE BELOW, MAPS LUMIDECK OR EQUAL. FINISH AND SCUPPER LOCATION TO BE SELECTED BY ARCHITECT.
16. REVEALS CAST IN TILTWALL WALL. REFER TO I/A501. SEE ELEVATIONS FOR LOCATIONS OF REVEALS ON EACH PANEL.
17. TYPICAL SEALANT JOINT.
18. INSULATED STEEL DOOR AND HOLLOW METAL FRAME. REFER TO FLOOR PLAN FOR NUMBER AND DOOR SCHEDULE FOR SIZE, HARDWARE AND FINISH.
19. FOAM ENCLOSURE, TYPICAL ENTIRE PERIMETER OF DECK. VERIFY MATERIAL AND DETAILS. COORDINATE WITH DECK MANUFACTURER/SUPPLIER. FOAM BETWEEN BLOCKING AND TOP LAYER OF ROOF INSULATION. EXTEND DOWN TO DECK AND JOIST ANGLES.
20. PRE-FINISHED METAL COPING WITH CONT. HOLD-DOWN CLIP. COLOR SELECTED BY ARCHITECT FROM FULL RANGE OF MANUFACTURER'S COLORS.
21. INSULATION IS TO EXTEND TO BACK OF DOCK LEVELER PIT, AND EXTEND VERTICALLY UP SIDES AND BACK OF PIT TO COMPLETELY INSULATE PIT PERIMETER.
22. GALVANIZED STEEL DOCK STAIR ASSEMBLY. REFER TO I1 AND I2/A501 FOR INFORMATION.
23. 4' X 4' INSULATED ROOF HATCH. COORDINATE PLACEMENT WITH ROOF FRAMING. LADDER TO BE CENTERED BELOW HATCH.
24. "LADDER UP" SUPPORT POST.
25. PROVIDE BRACING AS REQUIRED BY LADDER SUPPLIER.
26. OSHA COMPLIANT ROOF ACCESS LADDER CAGE.
27. LADDER BRACKETS. ANCHOR TO SLAB, ROOF FRAMING AND PLATFORM.
28. 18 INCH WIDE STEEL LADDER WITH 1 INCH DIAMETER STEEL RUNGS AT 12 INCHES O.C. SECURE STRINGERS TO FLOOR - TYPICAL BOTH SIDES PER LADDER SUPPLIER REQUIREMENTS.
29. 1 1/2" DIA STEEL 2 LINE GUARD RAIL WITH 4" TALL TOE BOARD AT PLATFORM LEVEL.
30. PROVIDE ADD ALTERNATE PRICING TO PROVIDE CONDUIT FOR FUTURE TRAILER RESTRAINT.
31. CONCRETE FILLED PIPE BOLLARDS, PAINTED SAFETY YELLOW. REFER TO CIVIL DRAWINGS FOR MORE INFORMATION.
32. FLASHING TO EXTEND OVER EDGE OF CONCRETE. PROVIDE HEMMED EDGE.
33. STICK PIN INSULATION W/ MINIMUM R-13 VALUE. USE ADHESIVES & FASTENERS TO SECURE INSULATION.
34. 8" REINFORCED CMU WALL. REFER TO STRUCTURAL DWGS.
35. HONEYWELL GUIDELOC VERTICAL RAIL AND FALL ARRESTER SYSTEM MOUNTED TO CENTER OF RUNGS, OR EQUAL.
36. CONSTRUCT 1 HR RATED WALL ON TOP OF CMU TO ROOF DECK. REFER TO WALL TYPE W4A ON A001.
37. TYPICAL DEFLECTION TRACK. REFER TO A501 FOR DETAIL.

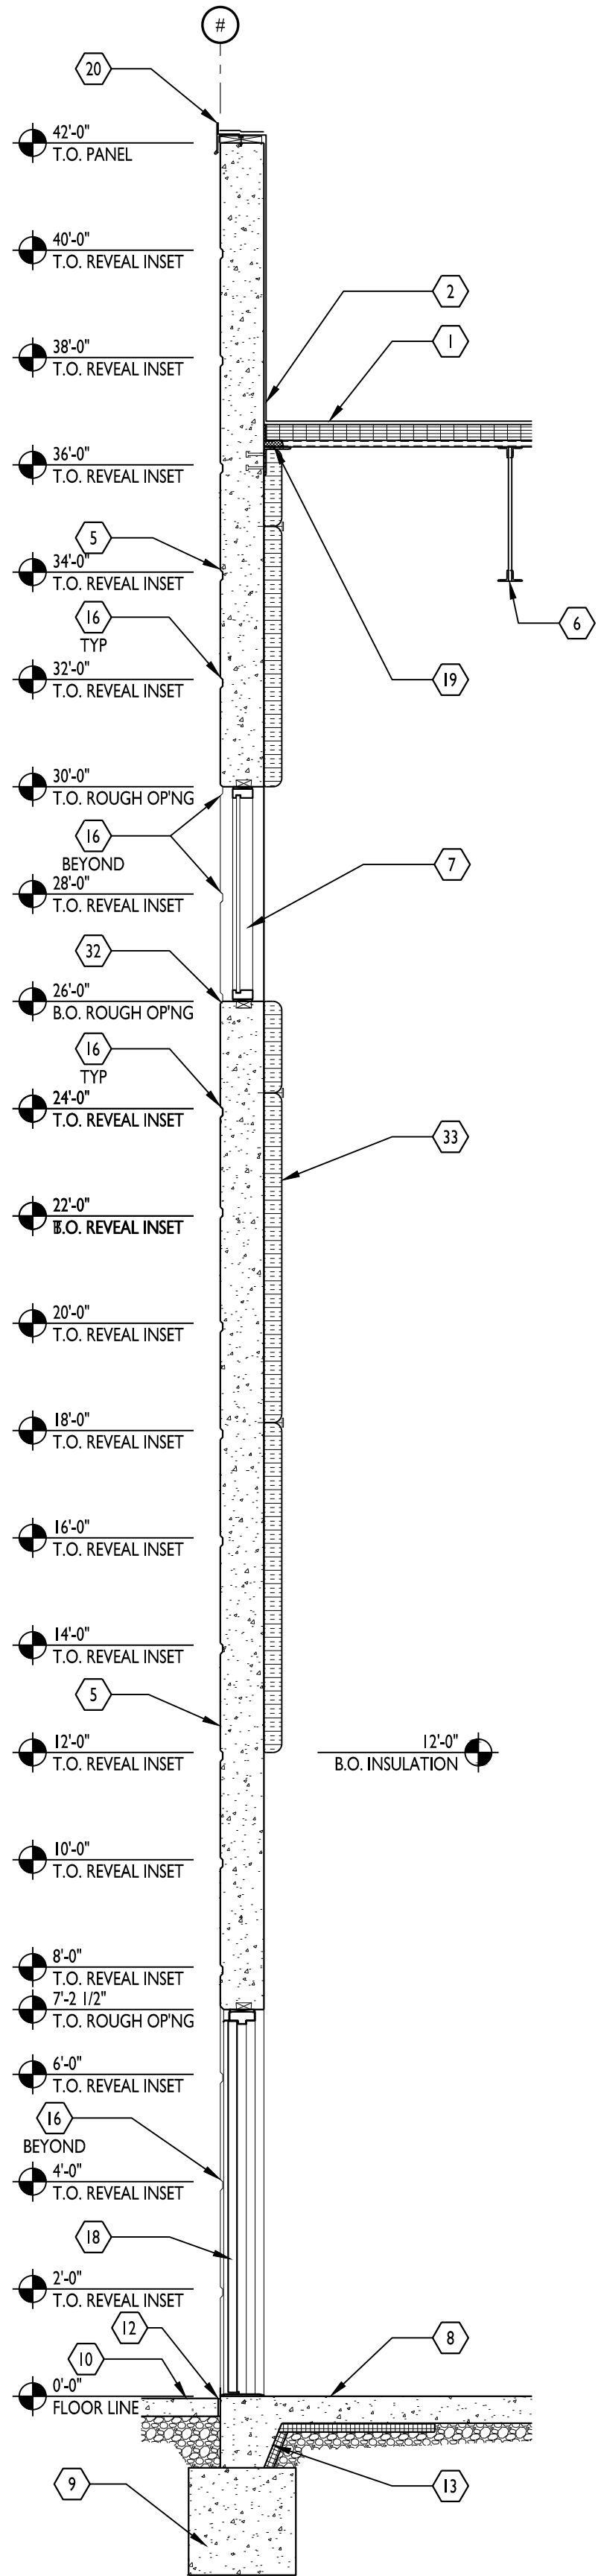

SECTION

4


3/8" = 1'-0"

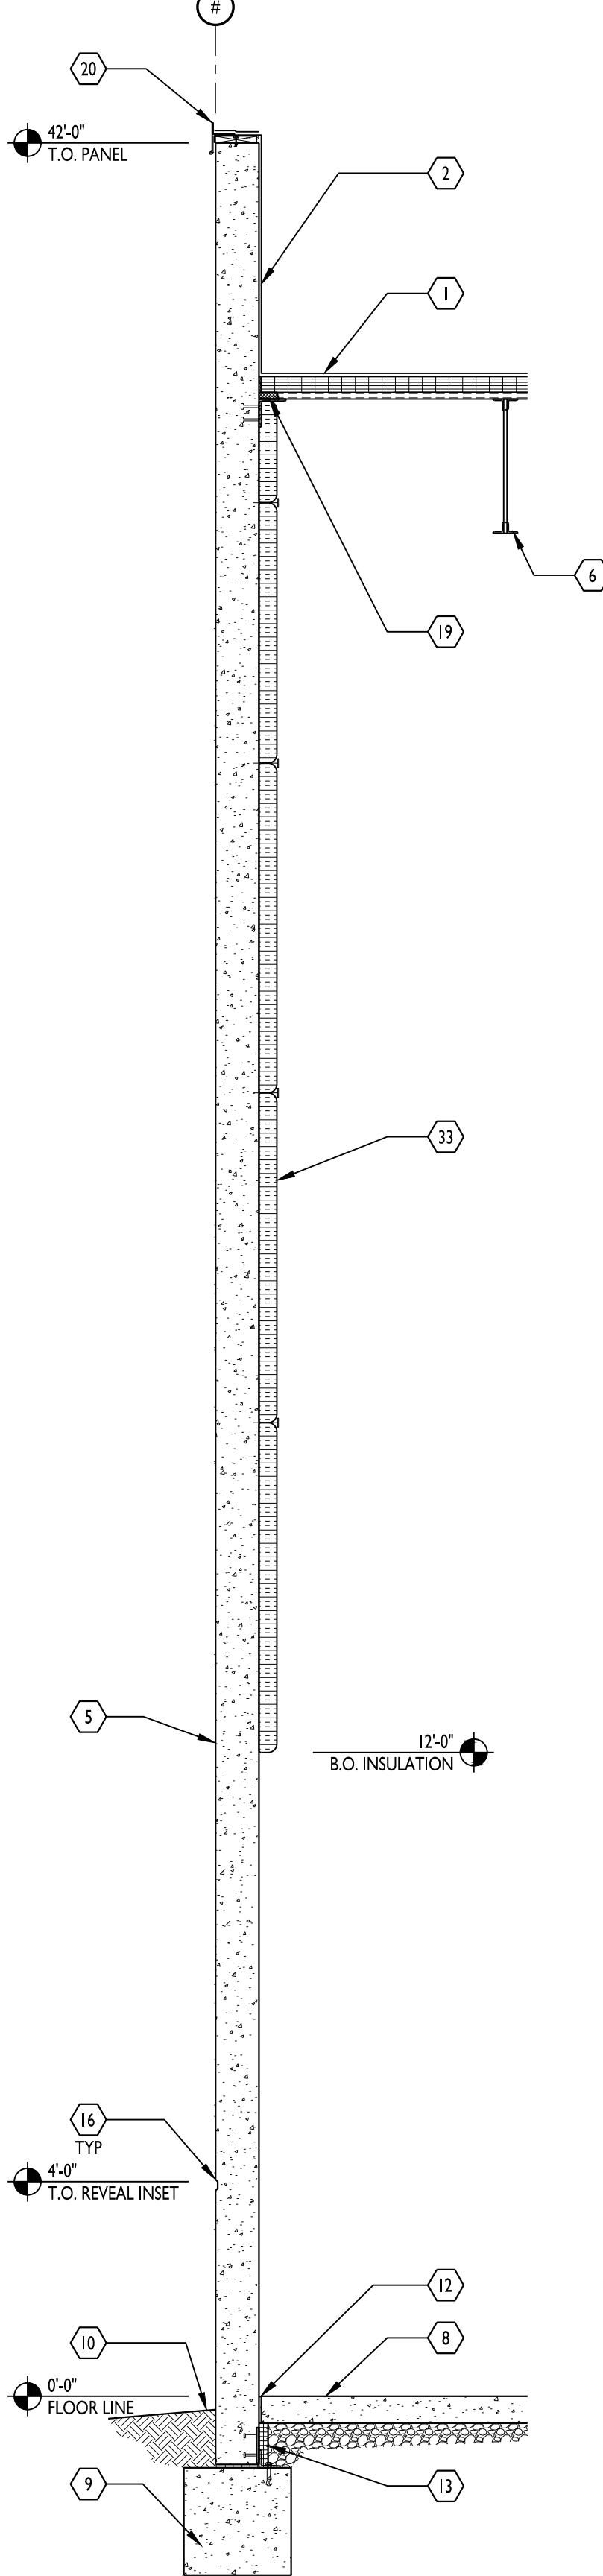

SECTION

3


3/8" = 1'-0"

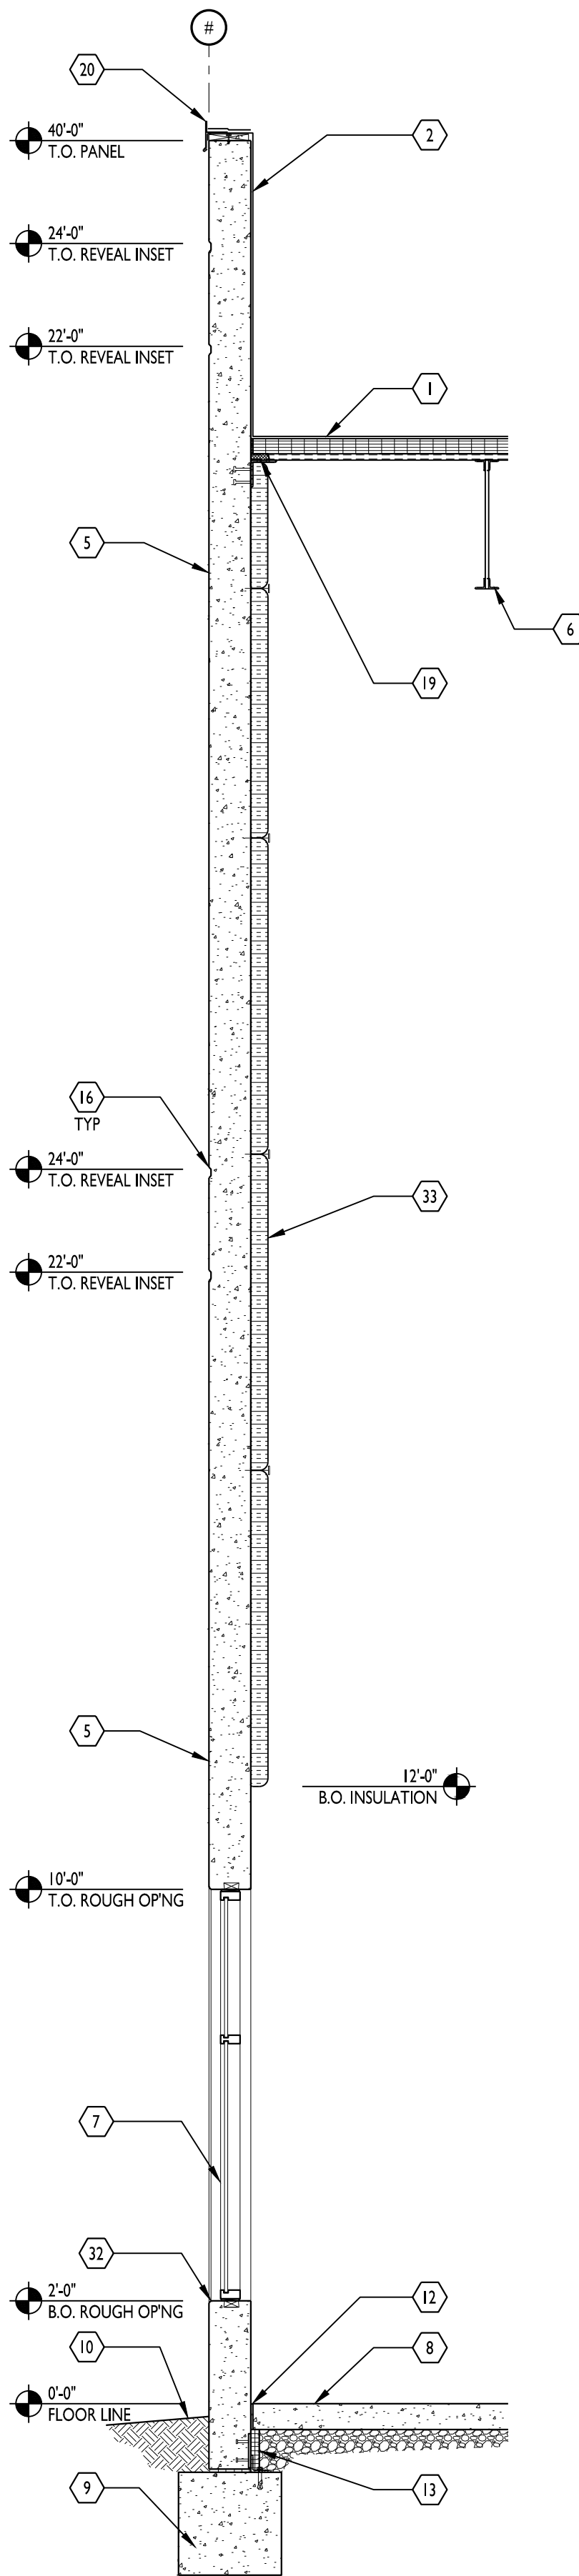

SECTION

2


3/8" = 1'-0"

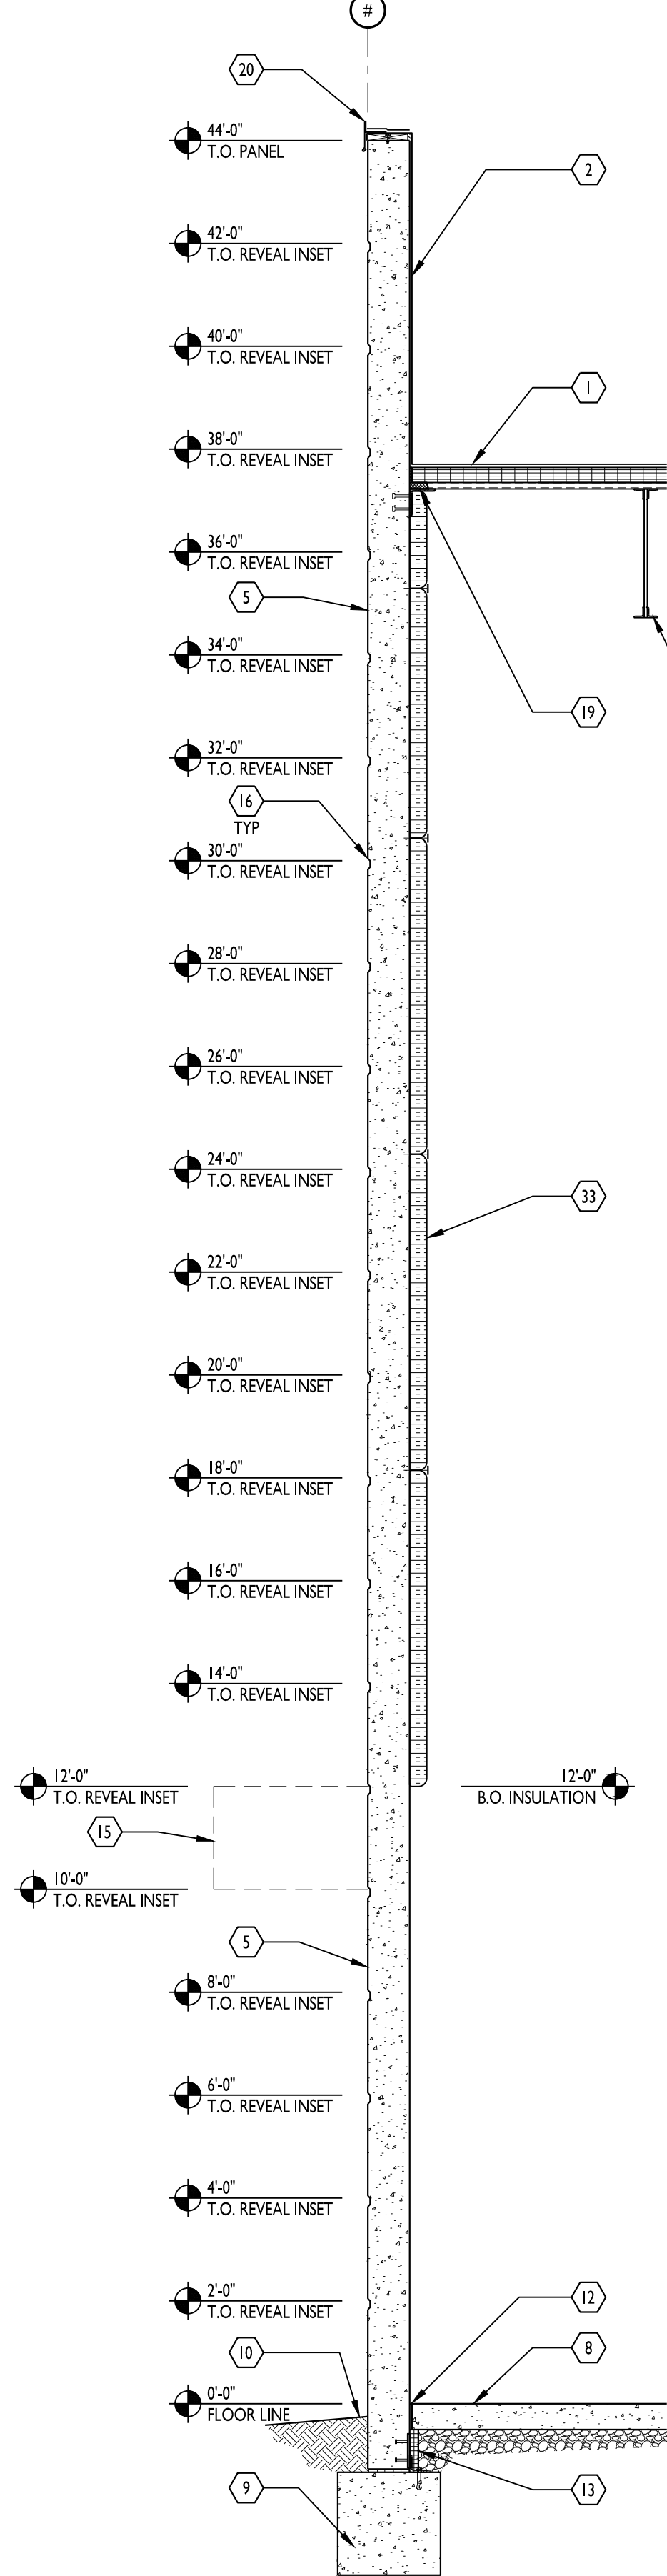

SECTION


1

3/8" = 1'-0"

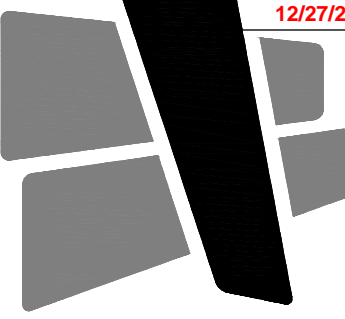

CURRAN
ARCHITECTURE

5719 LAWTON LOOP E. DR. #212
INDIANAPOLIS, IN 46216
O :: 317 . 288 . 0681
F :: 317 . 288 . 0753

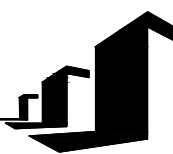

SCANNELL
PROPERTIES

CERTIFICATION

THIS DRAWING AND THE IDEAS, DESIGNS
AND CONCEPTS CONTAINED HEREIN ARE
THE EXCLUSIVE INTELLECTUAL PROPERTY
OF CURRAN ARCHITECTURE, AND ARE NOT
TO BE USED OR REPRODUCED, WHOLE OR
IN PART, WITHOUT THE WRITTEN
CONSENT OF CURRAN ARCHITECTURE.
© COPYRIGHT 2021, CURRAN ARCHITECTURE

PROJECT INFORMATION

LEE'S SUMMIT LOGISTICS
BUILDING A LOT I

NW CORNER OF
NE TUDOR RD & MAIN ST
LEE'S SUMMIT, MO 64086

ISSUE DATES

PERMIT SET 02.18.22


210300

WALL SECTIONS

A304


KEYED NOTES

1. ROOF MEMBRANE AND INSULATION BOARD. SEE ROOF PLAN FOR INFORMATION. UNDERSIDE OF DECKING FACTORY FINISHED, COLOR WHITE. MINIMUM SLOPE 1/4 INCH PER FOOT. TYPICAL BUILDING ROOFING UNLESS NOTED OTHERWISE.
2. WRAP ROOF MEMBRANE UP BACK SIDE OF TILTWALL PANEL OVER TREATED 2x BLOCKING ATTACHED TO TILTWALL PANEL. PROVIDE PRE-FINISHED METAL COPING WITH CONTINUOUS HOLD-DOWN CLIP. FOR ALL ROOF EDGES UNLESS NOTED OTHERWISE.
3. DOCK SEAL AND DOCK BUMPER.
4. PRE-FINISHED INSULATED STEEL OVERHEAD DOOR. REFER TO DOOR SCHEDULE.
5. TYPICAL WALL PANELS: TILTWALL CONCRETE PANELS WITH STEEL FORM PAINT READY EXTERIOR FINISH. REFER TO I/A301 FOR TYPICAL VERTICAL SPACING OF REVEALS. REFER TO ELEVATIONS FOR SPECIFIC REVEAL LAYOUT PER PANEL.
6. STRUCTURAL STEEL FRAMING. REFER TO ENGINEERING DRAWINGS. COORDINATE STRUCTURAL WITH TILTWALL MANUFACTURER. ORIENTATION OF FRAMING MAY VARY PER SECTION. REFER TO STRUCTURAL DRAWINGS FOR MORE INFORMATION.
7. THERMALLY BROKEN ALUMINUM STOREFRONT FRAMING WITH 1" INSULATED TINTED GLASS. REFER TO STOREFRONT ELEVATIONS FOR MORE INFORMATION.
8. CONCRETE SLAB ON GRADE. SEE STRUCTURAL.
9. REINFORCED CONCRETE FOUNDATION. SEE STRUCTURAL.
10. SEE CIVIL FOR EXTERIOR GRADING, SIDEWALKS, ETC..
11. PROVIDE HINGED LOCKING GATE ON LADDER.
12. 1/2" EXPANSION JOINT.
13. 2" RIGID INSULATION BOARD, TYPICAL UNDERSIDE OF SLAB TO TOP OF FOOTING. AT DOORS AND LOCATIONS WHERE DOORS OR STOREFRONT EXTENDS TO FLOOR SLAB, EXTEND THE INSULATION HORIZONTALLY UNDER THE SLAB A MINIMUM OF 4'.
14. DOCK LEVELER PIT. VERIFY DIMENSIONS WITH SUBMITTAL PACKAGE OF LEVELER UNIT. SEE STRUCTURAL FOR REINFORCEMENT INFORMATION.
15. MANUFACTURED PAN AND GUTTER AWNING SYSTEM WITH SCUPPER DIRECTED TO LANDSCAPE BELOW, MAPS LUMIDECK OR EQUAL. FINISH AND SCUPPER LOCATION TO BE SELECTED BY ARCHITECT.
16. REVEALS CAST IN TILTWALL WALL. REFER TO I/A501. SEE ELEVATIONS FOR LOCATIONS OF REVEALS ON EACH PANEL.
17. TYPICAL SEALANT JOINT.
18. INSULATED STEEL DOOR AND HOLLOW METAL FRAME. REFER TO FLOOR PLAN FOR NUMBER AND DOOR SCHEDULE FOR SIZE, HARDWARE, AND FINISH.
19. FOAM ENCLOSURE, TYPICAL ENTIRE PERIMETER OF DECK. VERIFY MATERIAL AND DETAILS. COORDINATE WITH DECK MANUFACTURER/SUPPLIER. FOAM BETWEEN BLOCKING AND TOP LAYER OF ROOF INSULATION. EXTEND DOWN TO DECK AND JOIST ANGLES.
20. PRE-FINISHED METAL COPING WITH CONT. HOLD-DOWN CLIP. COLOR SELECTED BY ARCHITECT FROM FULL RANGE OF MANUFACTURER'S COLORS.
21. INSULATION IS TO EXTEND TO BACK OF DOCK LEVELER PIT, AND EXTEND VERTICALLY UP SIDES AND BACK OF PIT TO COMPLETELY INSULATE PIT PERIMETER.
22. GALVANIZED STEEL DOCK STAIR ASSEMBLY. REFER TO I1 AND I2/A501 FOR INFORMATION.
23. 4' X 4' INSULATED ROOF HATCH. COORDINATE PLACEMENT WITH ROOF FRAMING. LADDER TO BE CENTERED BELOW HATCH.
24. "LADDER UP" SUPPORT POST.
25. PROVIDE BRACING AS REQUIRED BY LADDER SUPPLIER.
26. OSHA COMPLIANT ROOF ACCESS LADDER CAGE.
27. LADDER BRACKETS. ANCHOR TO SLAB, ROOF FRAMING AND PLATFORM.
28. 18 INCH WIDE STEEL LADDER WITH 1 INCH DIAMETER STEEL RUNGS AT 12 INCHES O.C. SECURE STRINGERS TO FLOOR - TYPICAL BOTH SIDES PER LADDER SUPPLIER REQUIREMENTS.
29. 1 1/2" DIA STEEL 2 LINE GUARD RAIL WITH 4" TALL TOE BOARD AT PLATFORM LEVEL.
30. PROVIDE ADD ALTERNATE PRICING TO PROVIDE CONDUIT FOR FUTURE TRAILER RESTRAINT.
31. CONCRETE FILLED PIPE BOLLARDS, PAINTED SAFETY YELLOW. REFER TO CIVIL DRAWINGS FOR MORE INFORMATION.
32. FLASHING TO EXTEND OVER EDGE OF CONCRETE. PROVIDE HEMMED EDGE.
33. STICK PIN INSULATION W/ MINIMUM R-13 VALUE. USE ADHESIVES & FASTENERS TO SECURE INSULATION.
34. 8" REINFORCED CMU WALL. REFER TO STRUCTURAL DWGS.
35. HONEYWELL GUIDELOC VERTICAL RAIL AND FALL ARRESTER SYSTEM MOUNTED TO CENTER OF RUNGS, OR EQUAL.
36. CONSTRUCT 1 HR RATED WALL ON TOP OF CMU TO ROOF DECK. REFER TO WALL TYPE W4A ON A001.
37. TYPICAL DEFLECTION TRACK. REFER TO A501 FOR DETAIL.

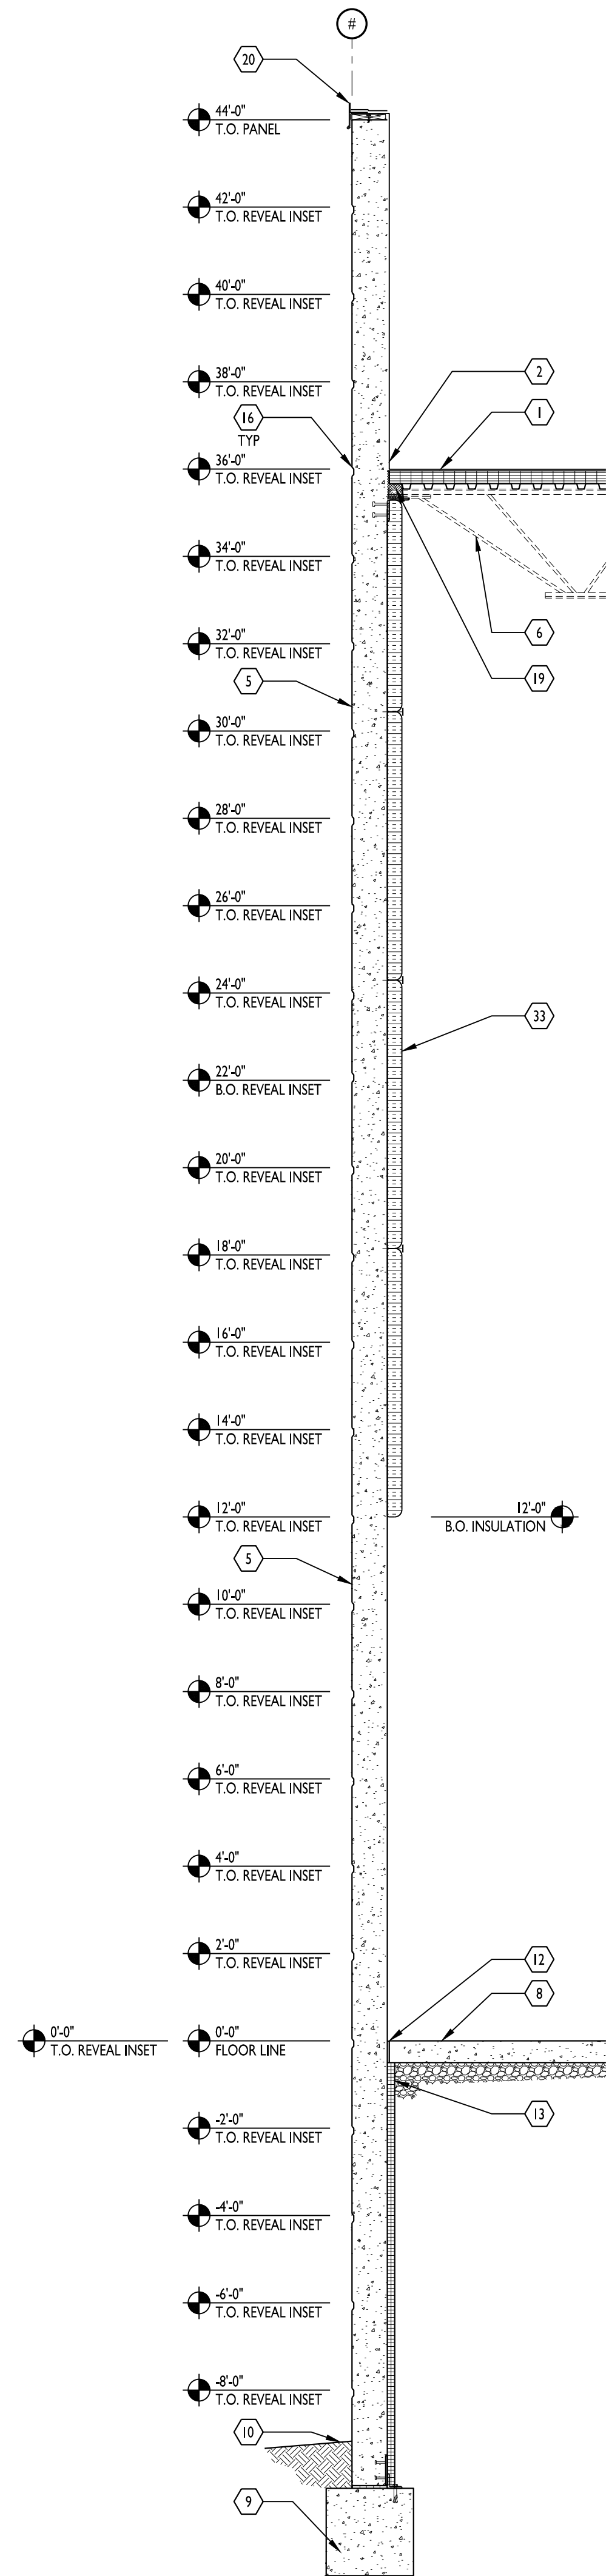


SECTION

4
3/8" = 1'-0"

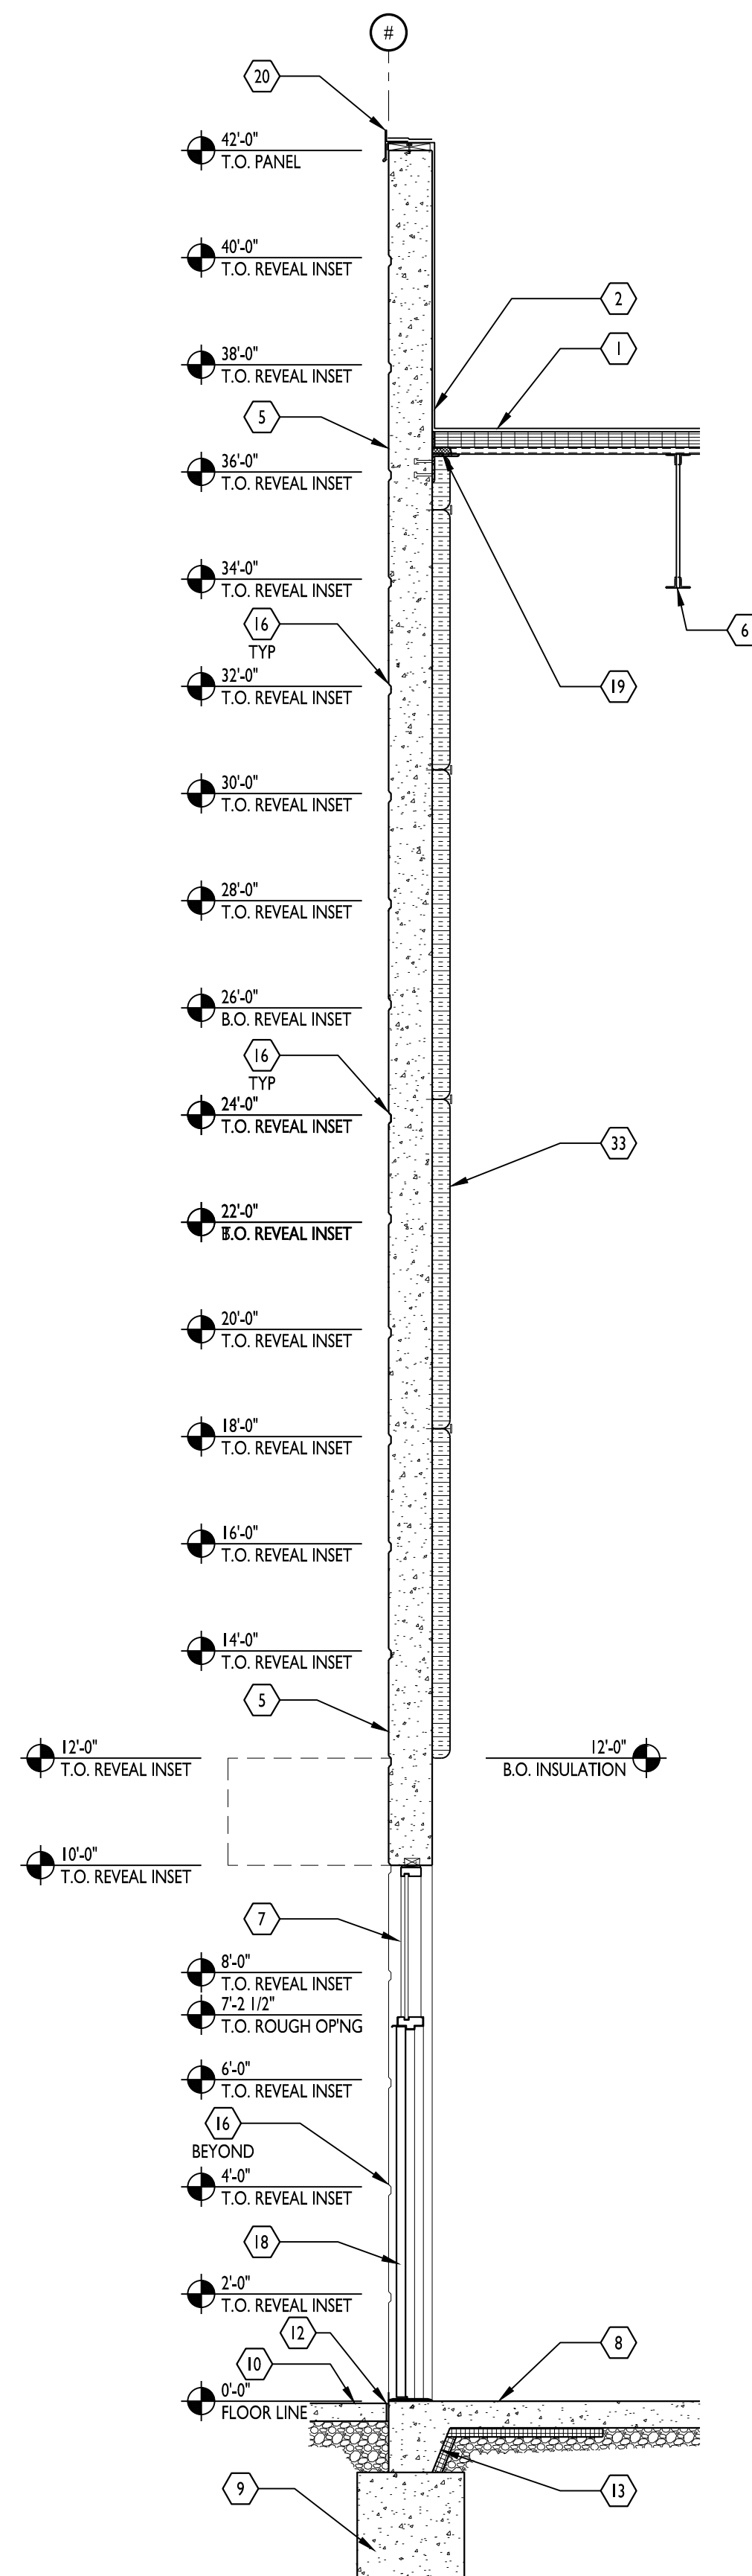


SECTION

3
3/8" = 1'-0"

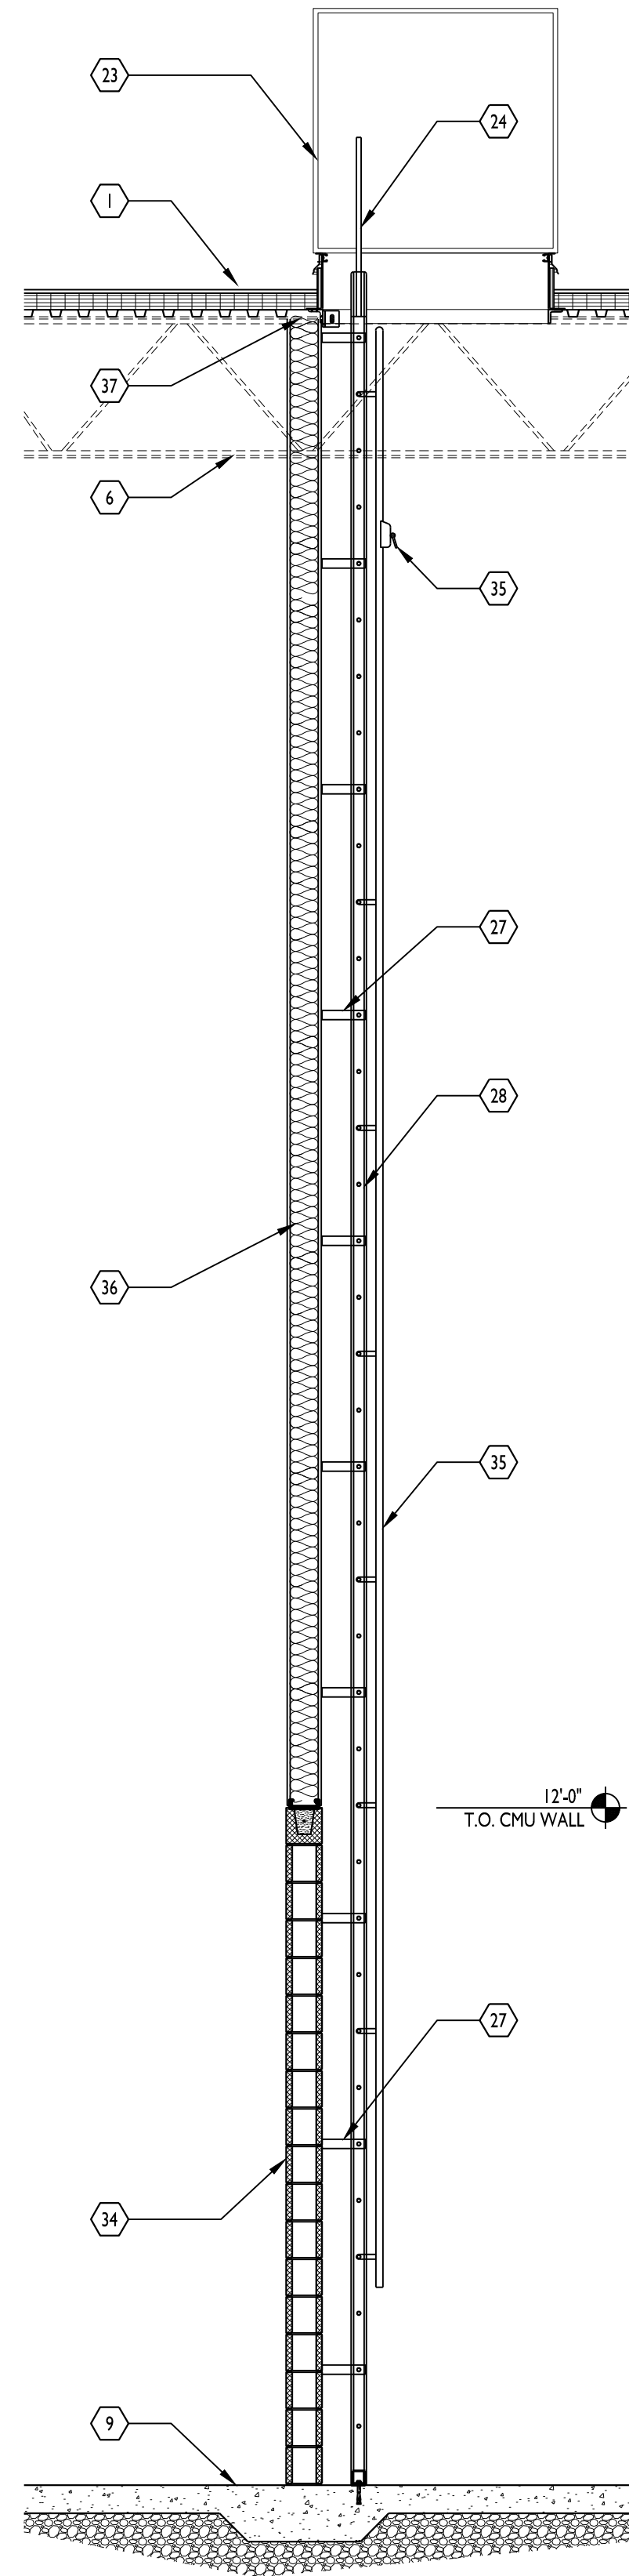

SECTION

2
3/8" = 1'-0"

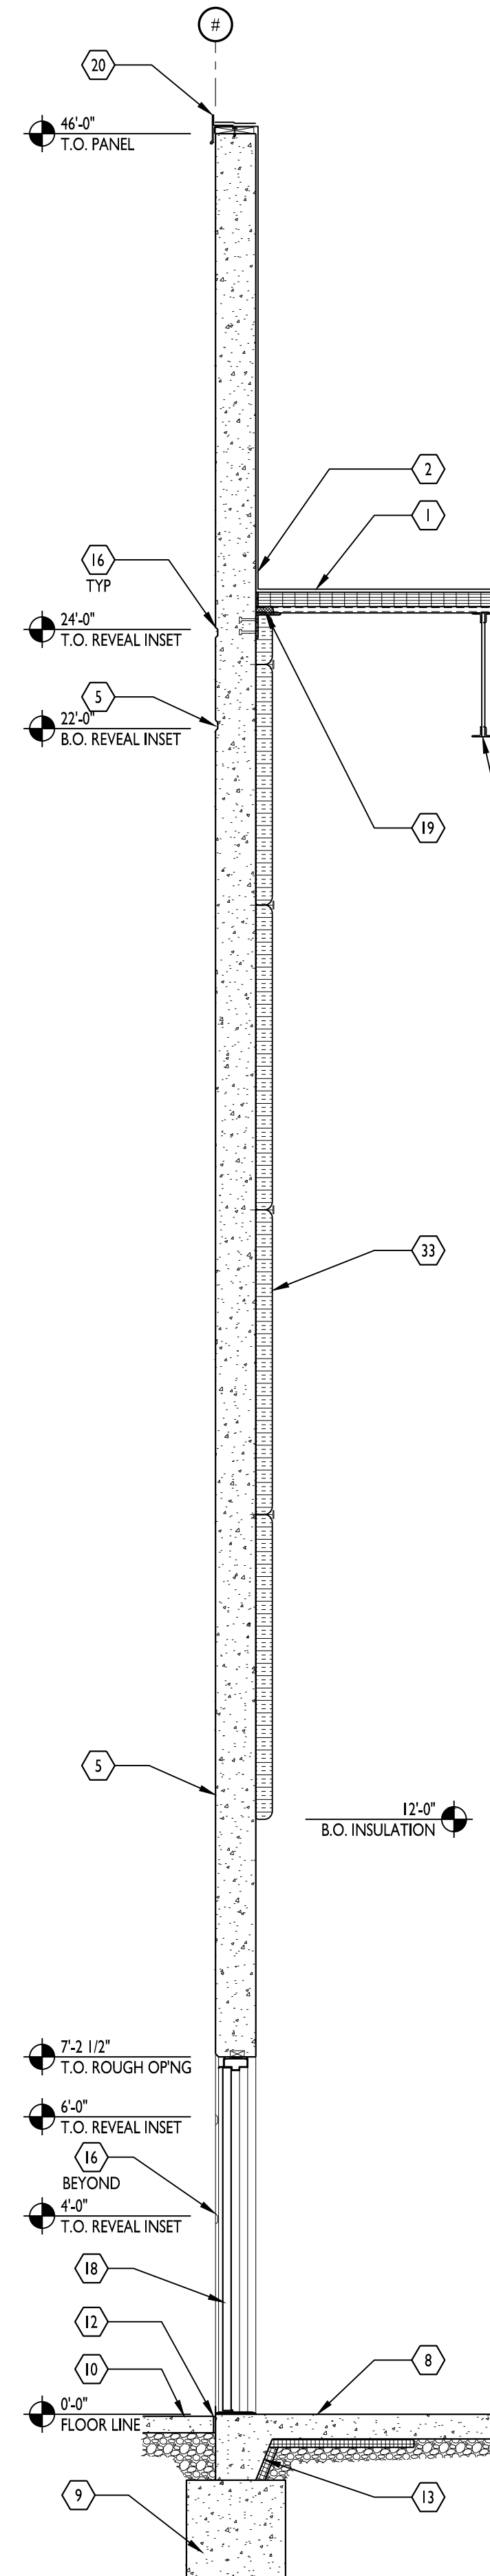


SECTION

1
3/8" = 1'-0"



CURRAN ARCHITECTURE

5719 LAWTON LOOP E. DR. #212
INDIANAPOLIS, IN 46216
O :: 317.288.0681
F :: 317.288.0753

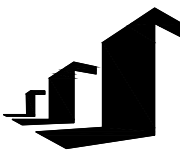

SCANNELL PROPERTIES

CERTIFICATION



THIS DRAWING AND THE IDEAS, DESIGNS AND CONCEPTS CONTAINED HEREIN ARE THE EXCLUSIVE INTELLECTUAL PROPERTY OF CURRAN ARCHITECTURE, AND ARE NOT TO BE USED OR REPRODUCED, WHOLE OR IN PART, WITHOUT THE WRITTEN CONSENT OF CURRAN ARCHITECTURE.
© COPYRIGHT 2021, CURRAN ARCHITECTURE

PROJECT INFORMATION

LEE'S SUMMIT LOGISTICS
BUILDING A LOT I

NW CORNER OF
NE TUDOR RD & MAIN ST
LEE'S SUMMIT, MO 64086

ISSUE DATES

PERMIT SET	02/18/22
PERMIT COMMENTS	10/24/22

210300

RATED WALL
INFORMATION

A305

BOXUV-U465 - Fire Resistance Ratings - ANSUL U.263

Insulation material. The fiber is applied with water to interior surfaces in accordance with the application instructions included with the product. Applied to completely fill the enclosed cavity. Minimum dry density of 4.3 pounds per cubic ft.

NU-WOOL CO INC – Cellulose Insulation

3C, Fiber, Sprayed* – As an alternate to Batts and Blankets (Item 3) – Spray applied cellulose fiber. The fiber is applied with water to completely fill the enclosed cavity in accordance with the application instructions included with the product. The minimum dry density shall be 4.30 lbs/ft³.

INTERNATIONAL CELLULOSE CORP – Celbar-RL

3D, Batts and Blankets* – For use with Item 8, Nom 3 in. thick, minimum 3.4 pcf mineral wool batts, friction fit between the studs and floor and ceiling runners.

See Batts and Blankets (B212) category for names of manufacturers.

4, Gypsum Board* – 5/8 in. thick, 4 ft wide, attached to steel studs and floor and ceiling track with 1 in. long, Type 5 steel screws spaced 8 in. OC along edges of board and 12 in. OC in the field of the board. Joints oriented vertically and staggered on opposite sides of the assembly. When attached to Item 6 (resilient channels) or 6A or 6C (furring channels), gypsum board is screw attached to furring channels with 1 in. long, Type 5 steel screws spaced 12 in. OC.

ACADIA DRYWALL SUPPLIES LTD – Type X

AMERICAN GYPSUM CO – Types AG-C, AGX-1, M-Class

BEIJING NEW BUILDING MATERIALS PUBLIC LTD CO – Type DBX-1.

COC INC – Types AR, C, IP-AR, IP-X1, IP-X2, IPC-AR, SCX, SHX, WRC or WRX.

CERTAINTED GYPSUM INC – Types I, EGRS, GlasRoc, Type X, Type C, SilentFlex, 5/8" East-Life Type X.

CERTAINTED GYPSUM CANADA INC – Type C, Type X, Type Abuse-Resistant, 5/8" East-Life Type X.

GEORGIA-PACIFIC GYPSUM L L C – Types 5, 6, 9, C, DAP, DD, DA, DAPC, DGC, DGS, GFFS6, LS.

LAFARGE NORTH AMERICA INC – Types LGFC-2, LGFC2A, LGFC6, LGFC6A, LGFC-C, LGFC-C/A, LGFC-WD, LGLX.

NATIONAL GYPSUM CO – Types FSK-C, FSK-C/G, FSW-C, FSW-G, FSW-3, FSW-5, FSW-6, FSL.

PARCO BUILDING PRODUCTS L L C, DBA PARCO GYPSUM – Types PG-C, PG-9, PG-11, PG5-WRS.

PANEL REY S A – Types GREX, PRX, RHX, MDX, ETX.

SIAM GYPSUM INDUSTRY (SARABURI) CO LTD – Type EX-1

TEMPLE-INLAND – Type X, Vener Plaster Base - Type X, Water Rated - Type X, Sheathing - Type X, Soffit - Type X, TG-C, GreenGlass Type X, Type X ComfortGuard Sound Densifying Gypsum Board

http://database.ul.com/.../ANSUL-U.263&objid=1074330743&objid=107741824&version=vesion&parent_id=107398481&sequence=1[8/9/2013 8:57:01 AM]

BOXUV-U465 - Fire Resistance Ratings - ANSUL U.263

Insulation material. The fiber is applied with water to interior surfaces in accordance with the application instructions included with the product. Applied to completely fill the enclosed cavity. Minimum dry density of 4.3 pounds per cubic ft.

NU-WOOL CO INC – Cellulose Insulation

3C, Fiber, Sprayed* – As an alternate to Batts and Blankets (Item 3) – Spray applied cellulose fiber. The fiber is applied with water to completely fill the enclosed cavity in accordance with the application instructions included with the product. The minimum dry density shall be 4.30 lbs/ft³.

INTERNATIONAL CELLULOSE CORP – Celbar-RL

3D, Batts and Blankets* – For use with Item 8, Nom 3 in. thick, minimum 3.4 pcf mineral wool batts, friction fit between the studs and floor and ceiling runners.

See Batts and Blankets (B212) category for names of manufacturers.

4, Gypsum Board* – 5/8 in. thick, 4 ft wide, attached to steel studs and floor and ceiling track with 1 in. long, Type 5 steel screws spaced 8 in. OC along edges of board and 12 in. OC in the field of the board. Joints oriented vertically and staggered on opposite sides of the assembly. When attached to Item 6 (resilient channels) or 6A or 6C (furring channels), gypsum board is screw attached to furring channels with 1 in. long, Type 5 steel screws spaced 12 in. OC.

ACADIA DRYWALL SUPPLIES LTD – Type X

AMERICAN GYPSUM CO – Types AG-C, AGX-1, M-Class

BEIJING NEW BUILDING MATERIALS PUBLIC LTD CO – Type DBX-1.

COC INC – Types AR, C, IP-AR, IP-X1, IP-X2, IPC-AR, SCX, SHX, WRC or WRX.

CERTAINTED GYPSUM INC – Types I, EGRS, GlasRoc, Type X, Type C, SilentFlex, 5/8" East-Life Type X.

CERTAINTED GYPSUM CANADA INC – Type C, Type X, Type Abuse-Resistant, 5/8" East-Life Type X.

GEORGIA-PACIFIC GYPSUM L L C – Types 5, 6, 9, C, DAP, DD, DA, DAPC, DGC, DGS, GFFS6, LS.

LAFARGE NORTH AMERICA INC – Types LGFC-2, LGFC2A, LGFC6, LGFC6A, LGFC-C, LGFC-C/A, LGFC-WD, LGLX.

NATIONAL GYPSUM CO – Types FSK-C, FSK-C/G, FSW-C, FSW-G, FSW-3, FSW-5, FSW-6, FSL.

PARCO BUILDING PRODUCTS L L C, DBA PARCO GYPSUM – Types PG-C, PG-9, PG-11, PG5-WRS.

PANEL REY S A – Types GREX, PRX, RHX, MDX, ETX.

SIAM GYPSUM INDUSTRY (SARABURI) CO LTD – Type EX-1

TEMPLE-INLAND – Type X, Vener Plaster Base - Type X, Water Rated - Type X, Sheathing - Type X, Soffit - Type X, TG-C, GreenGlass Type X, Type X ComfortGuard Sound Densifying Gypsum Board

http://database.ul.com/.../ANSUL-U.263&objid=1074330743&objid=107741824&version=vesion&parent_id=107398481&sequence=1[8/9/2013 8:57:01 AM]

http://database.ul.com/.../ANSUL-U.263&objid=1074330743&objid=107741824&version=vesion&parent_id=107398481&sequence=1[8/9/2013 8:57:01 AM]

BOXUV-U465 - Fire Resistance Ratings - ANSUL U.263

Insulation material. The fiber is applied with water to interior surfaces in accordance with the application instructions included with the product. Applied to completely fill the enclosed cavity. Minimum dry density of 4.3 pounds per cubic ft.

NU-WOOL CO INC – Cellulose Insulation

3C, Fiber, Sprayed* – As an alternate to Batts and Blankets (Item 3) – Spray applied cellulose fiber. The fiber is applied with water to completely fill the enclosed cavity in accordance with the application instructions included with the product. The minimum dry density shall be 4.30 lbs/ft³.

INTERNATIONAL CELLULOSE CORP – Celbar-RL

3D, Batts and Blankets* – For use with Item 8, Nom 3 in. thick, minimum 3.4 pcf mineral wool batts, friction fit between the studs and floor and ceiling runners.

4, Gypsum Board* – 5/8 in. thick, 4 ft wide, attached to steel studs and floor and ceiling track with 1 in. long, Type 5 steel screws spaced 8 in. OC along edges of board and 12 in. OC in the field of the board. Joints oriented vertically and staggered on opposite sides of the assembly. When attached to Item 6 (resilient channels) or 6A or 6C (furring channels), gypsum board is screw attached to furring channels with 1 in. long, Type 5 steel screws spaced 12 in. OC.

ACADIA DRYWALL SUPPLIES LTD – Type X

AMERICAN GYPSUM CO – Types AG-C, AGX-1, M-Class

BEIJING NEW BUILDING MATERIALS PUBLIC LTD CO – Type DBX-1.

COC INC – Types AR, C, IP-AR, IP-X1, IP-X2, IPC-AR, SCX, SHX, WRC or WRX.

CERTAINTED GYPSUM INC – Types I, EGRS, GlasRoc, Type X, Type C, SilentFlex, 5/8" East-Life Type X.

CERTAINTED GYPSUM CANADA INC – Type C, Type X, Type Abuse-Resistant, 5/8" East-Life Type X.

GEORGIA-PACIFIC GYPSUM L L C – Types 5, 6, 9, C, DAP, DD, DA, DAPC, DGC, DGS, GFFS6, LS.

LAFARGE NORTH AMERICA INC – Types LGFC-2, LGFC2A, LGFC6, LGFC6A, LGFC-C, LGFC-C/A, LGFC-WD, LGLX.

NATIONAL GYPSUM CO – Types FSK-C, FSK-C/G, FSW-C, FSW-G, FSW-3, FSW-5, FSW-6, FSL.

PARCO BUILDING PRODUCTS L L C, DBA PARCO GYPSUM – Types PG-C, PG-9, PG-11, PG5-WRS.

PANEL REY S A – Types GREX, PRX, RHX, MDX, ETX.

SIAM GYPSUM INDUSTRY (SARABURI) CO LTD – Type EX-1

TEMPLE-INLAND – Type X, Vener Plaster Base - Type X, Water Rated - Type X, Sheathing - Type X, Soffit - Type X, TG-C, GreenGlass Type X, Type X ComfortGuard Sound Densifying Gypsum Board

http://database.ul.com/.../ANSUL-U.263&objid=1074330743&objid=107741824&version=vesion&parent_id=107398481&sequence=1[8/9/2013 8:57:01 AM]

http://database.ul.com/.../ANSUL-U.263&objid=1074330743&objid=107741824&version=vesion&parent_id=107398481&sequence=1[8/9/2013 8:57:01 AM]


http://database.ul.com/.../ANSUL-U.263&objid=1074330743&objid=107741824&version=vesion&parent_id=107398481&sequence=1[8/9/2013 8:57:01 AM]

http://database.ul.com/.../ANSUL-U.263&objid=1074330743&objid=107741824&version=vesion&parent_id=107398481&sequence=1[8/9/2013 8:57:01 AM]

http://database.ul.com/.../ANSUL-U.263&objid=1074330743&objid=107741824&version=vesion&parent_id=107398481&sequence=1[8/9/2013 8:57:01 AM]


http://database.ul.com/.../ANSUL-U.263&objid=1074330743&objid=107741824&version=vesion&parent_id=107398481&sequence=1[8/9/2013 8:57:01 AM]

http://database.ul.com/.../ANSUL-U.263&objid=1074330743&objid=107741824&version=vesion&parent_id=107398481&sequence=1[8/

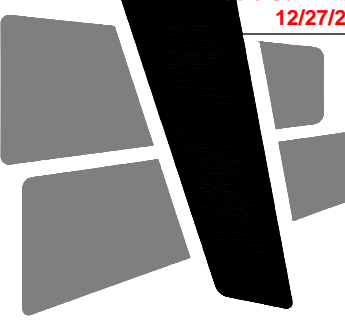


CURRAN ARCHITECTURE

5719 LAWTON LOOP E. DR. #212
INDIANAPOLIS, IN 46216
O :: 317 . 288 . 0681
F :: 317 . 288 . 0753

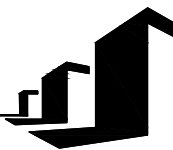

SCANNELL PROPERTIES

CERTIFICATION

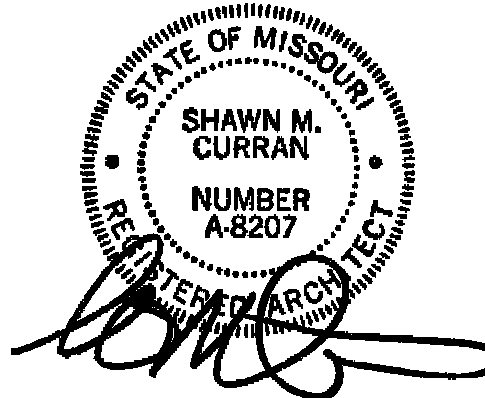

THIS DRAWING AND THE IDEAS, DESIGNS AND CONCEPTS CONTAINED HEREIN ARE THE EXCLUSIVE INTELLECTUAL PROPERTY OF CURRAN ARCHITECTURE, AND ARE NOT TO BE USED OR REPRODUCED, WHOLE OR IN PART, WITHOUT THE WRITTEN CONSENT OF CURRAN ARCHITECTURE.
© COPYRIGHT 2021, CURRAN ARCHITECTURE

PROJECT INFORMATION

LEE'S SUMMIT LOGISTICS
BUILDING A LOT I

NW CORNER OF
NE TUDOR RD & MAIN ST
LEE'S SUMMIT, MO 64086


ISSUE DATES

PERMIT SET 02.18.22


210300

TYPICAL TILT WALL
BUILDING DETAILS


A501

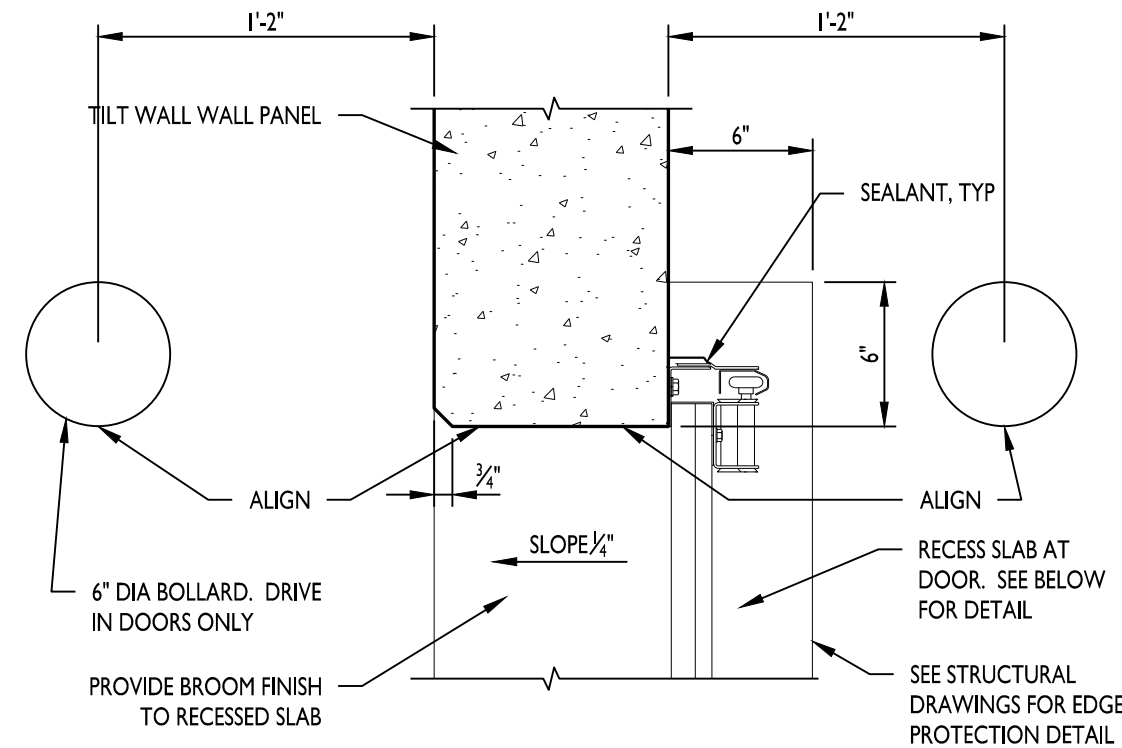


DRIVE IN DOOR JAMB DETAIL **13**
1 1/2" = 1'-0"

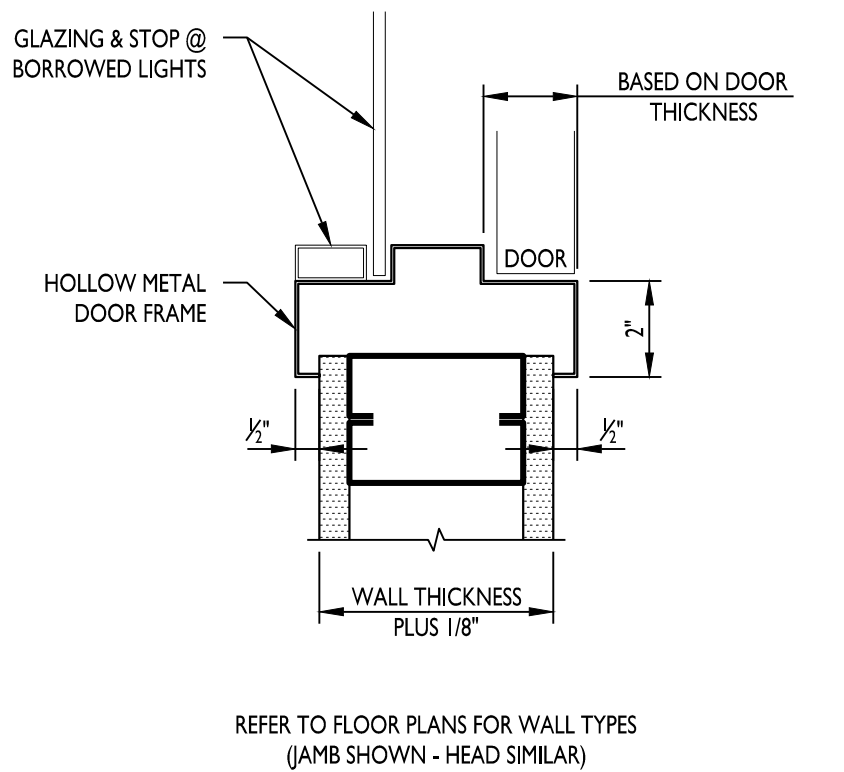


DOOR JAMB SECTION **10**
3" = 1'-0"

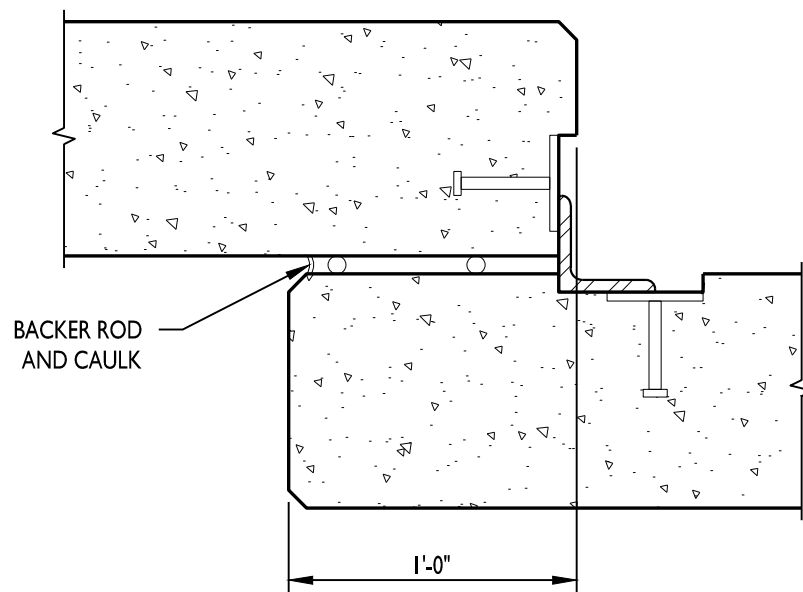


TILT WALL OVERLAP WALL DETAIL **7**
1 1/2" = 1'-0"

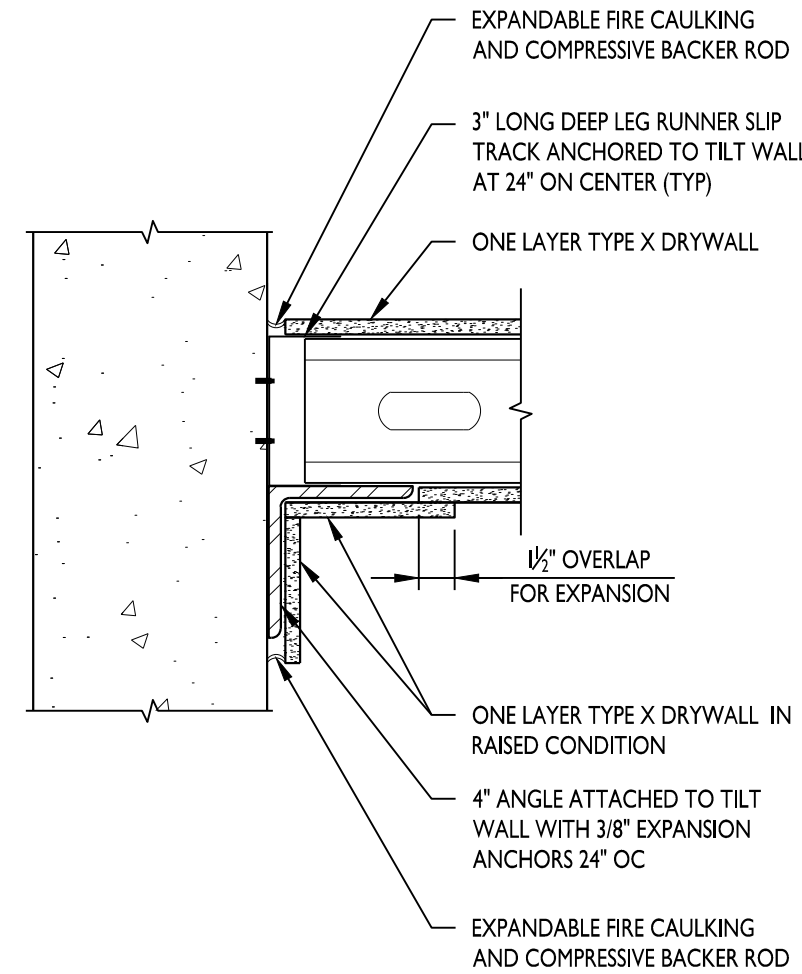


**TILT WALL TO WALL SECTION DETAIL
DRYWALL "LID" CONDITION** **4**
1 1/2" = 1'-0"

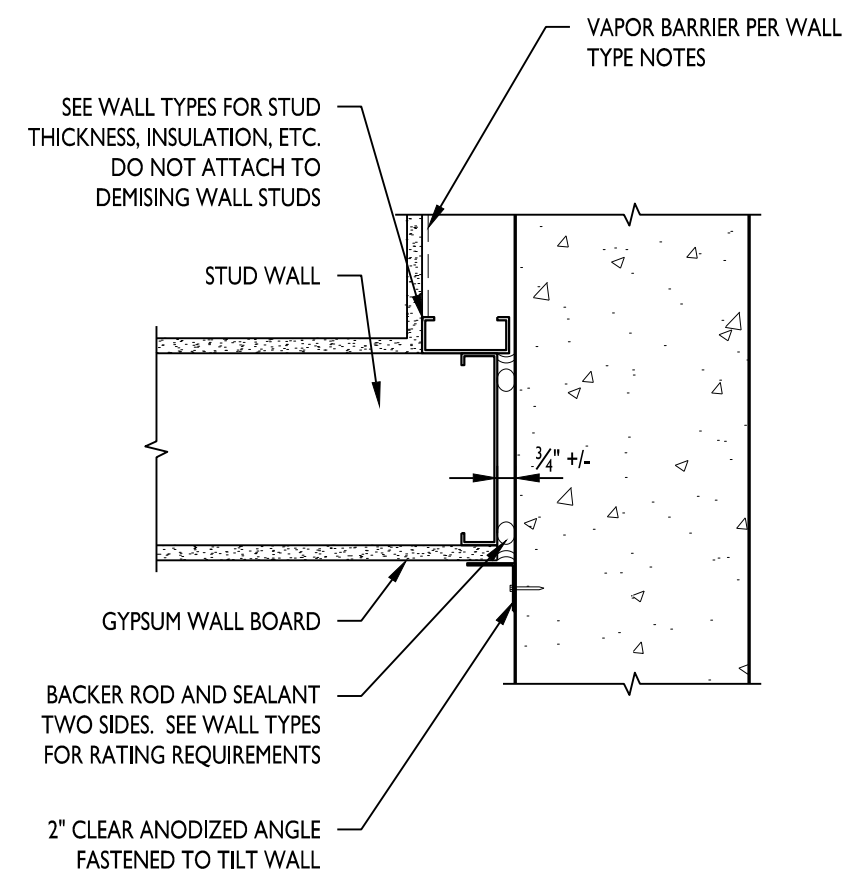


TILT WALL TO WALL PLAN DETAIL **1**
1 1/2" = 1'-0"

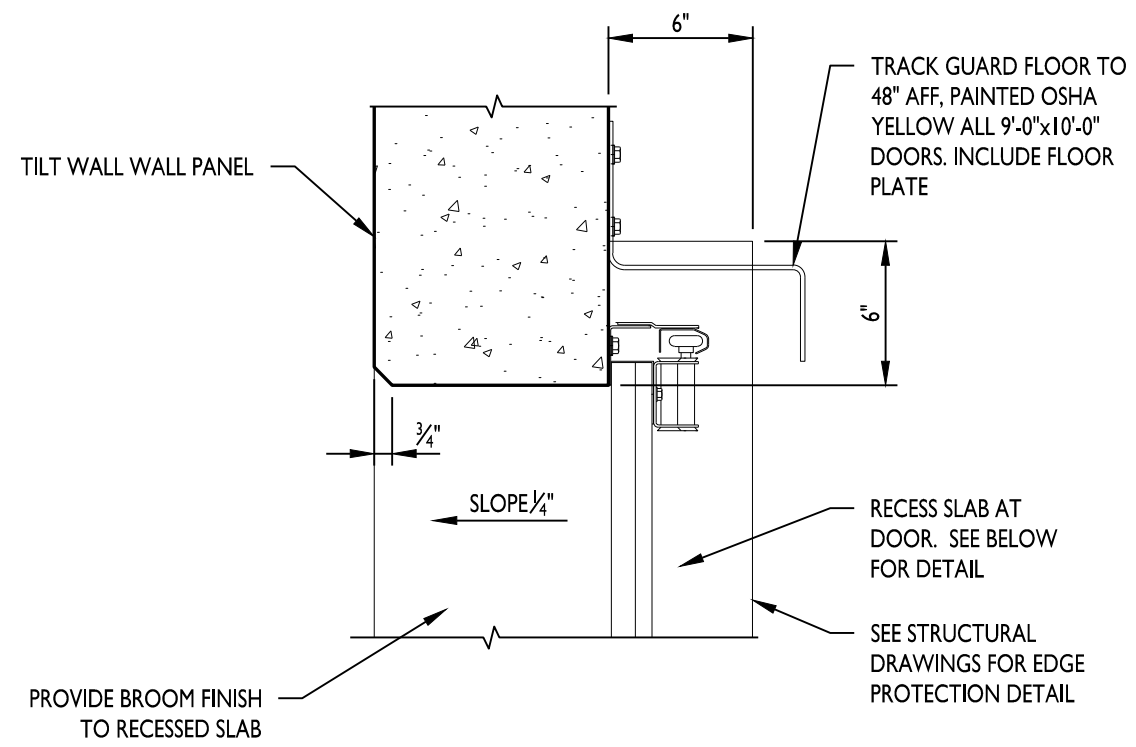


DRIVE IN DOOR JAMB DETAIL **14**
1 1/2" = 1'-0"

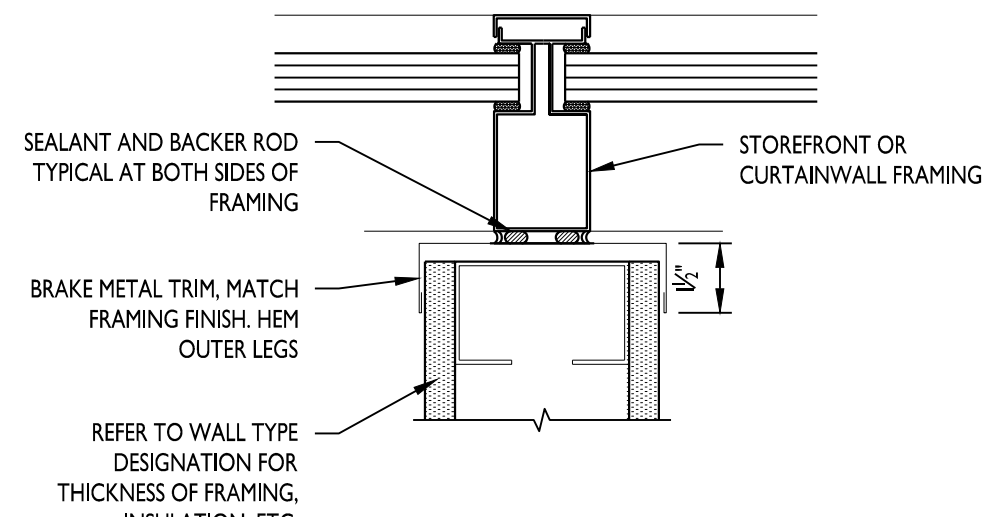


WALL AT MULLION DETAIL **11**
3" = 1'-0"

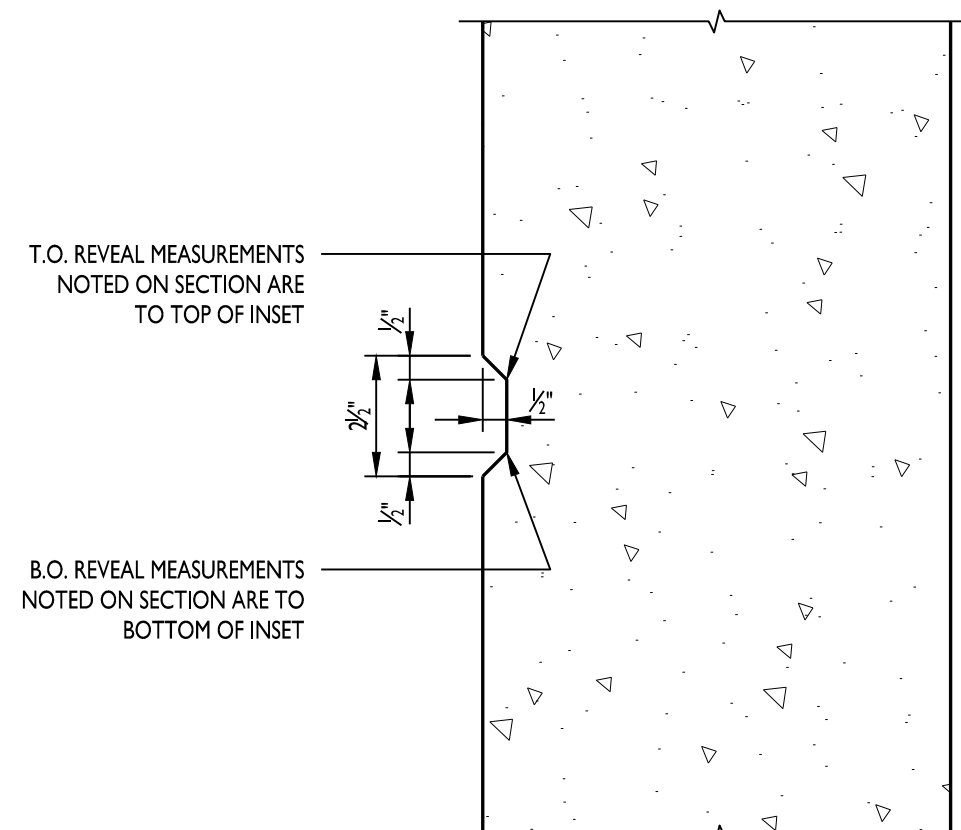


TYPICAL REVEAL DETAIL **8**
3" = 1'-0"

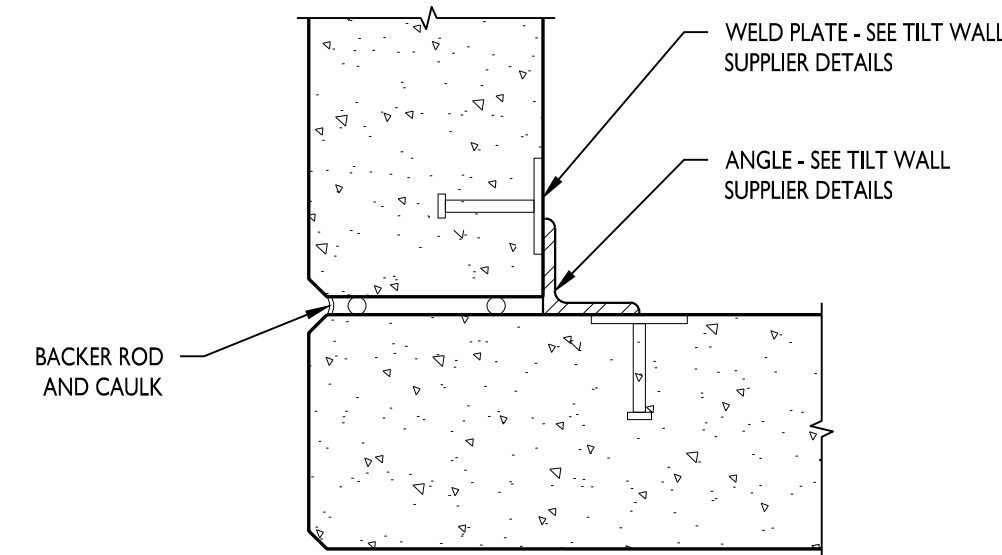


TILT WALL BOX CORNER DETAIL **5**
1 1/2" = 1'-0"

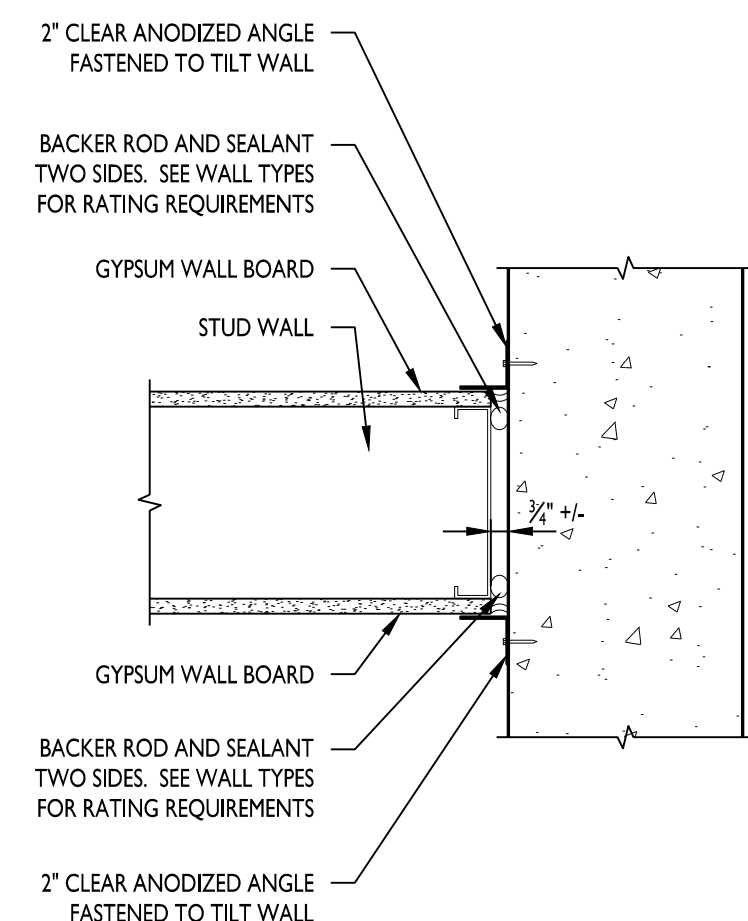


TILT WALL TO WALL PLAN DETAIL **2**
1 1/2" = 1'-0"

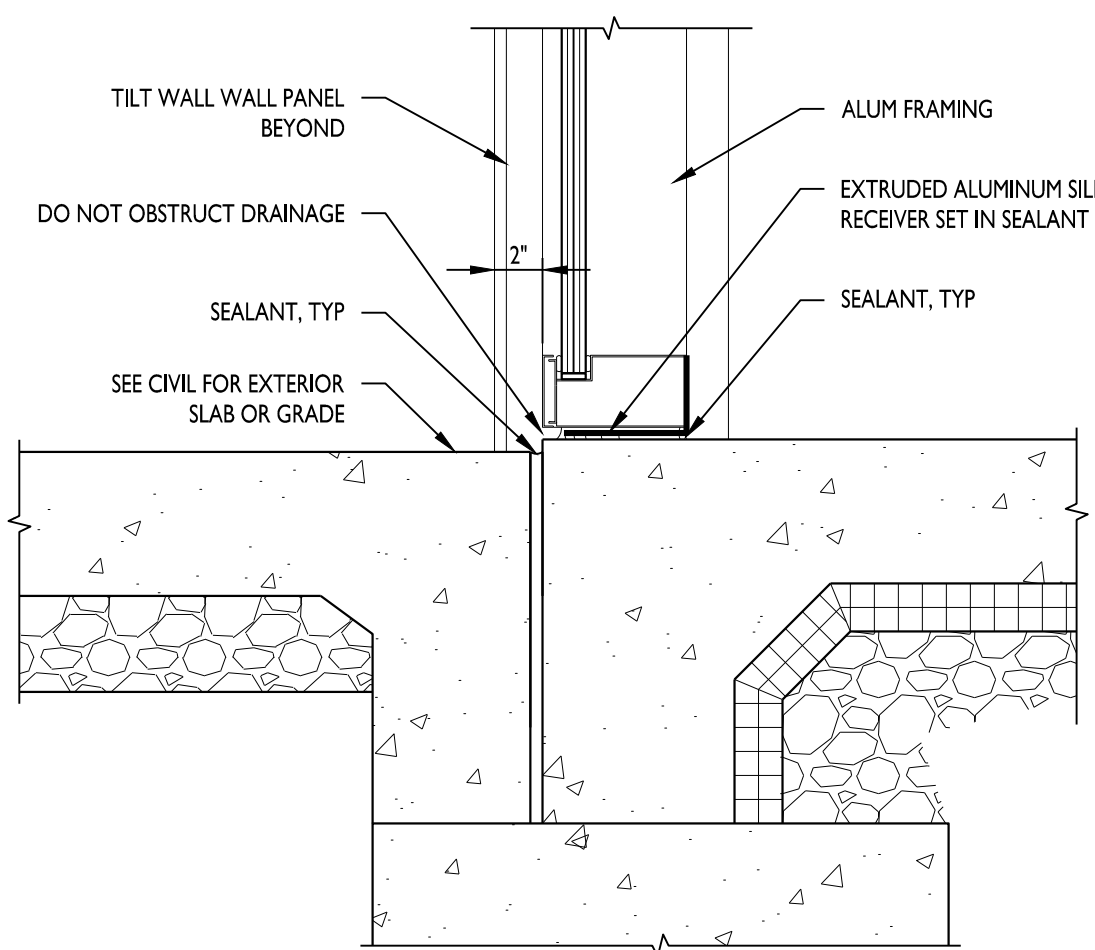


STOREFRONT/CURTAINWALL **15**
1 1/2" = 1'-0"

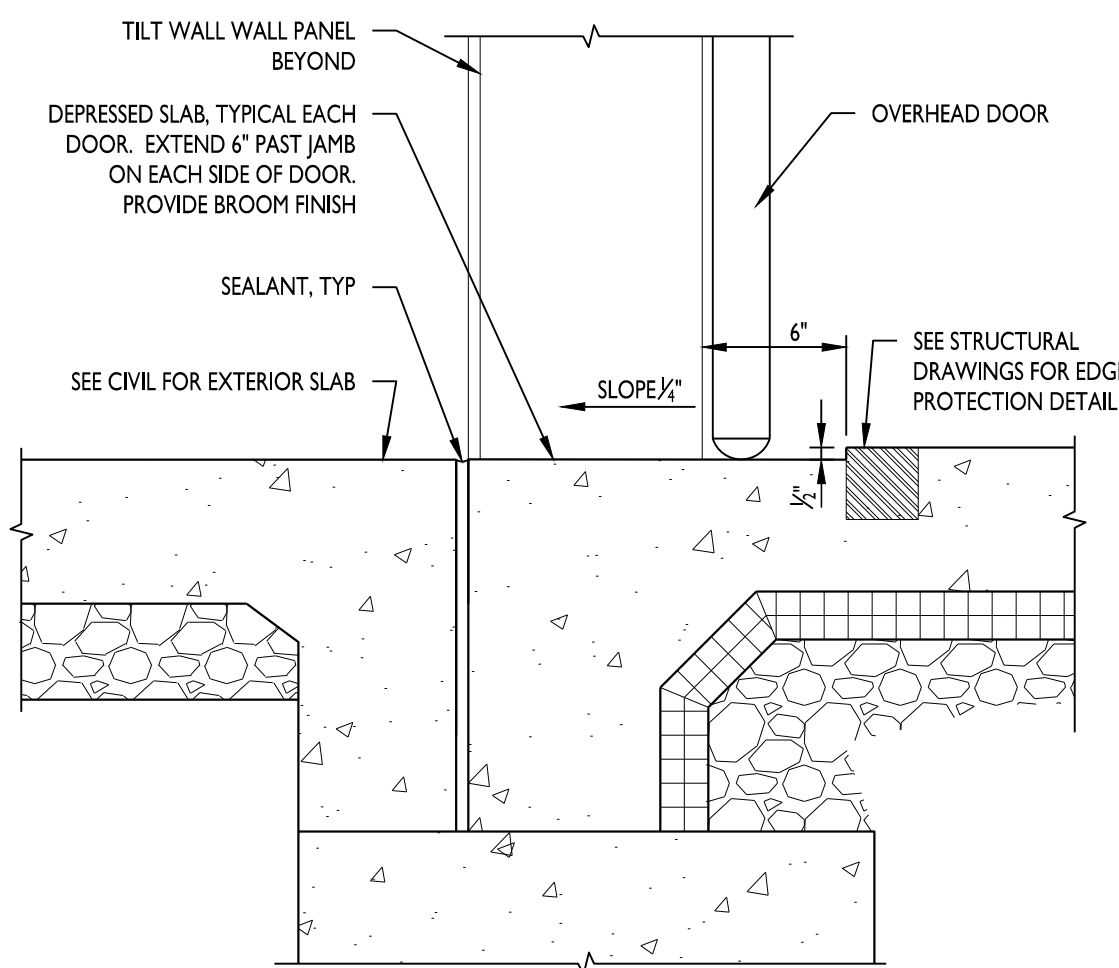


DRIVE IN DOOR DETAIL **12**
1 1/2" = 1'-0"

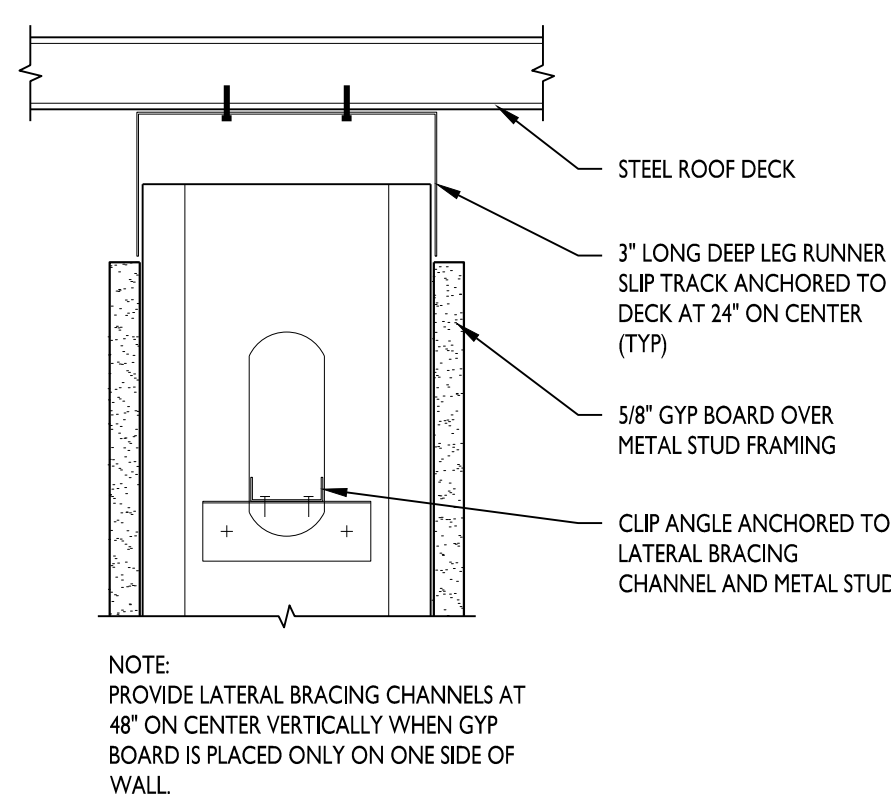

DEFLECTION TRACK DETAIL **9**
3" = 1'-0"

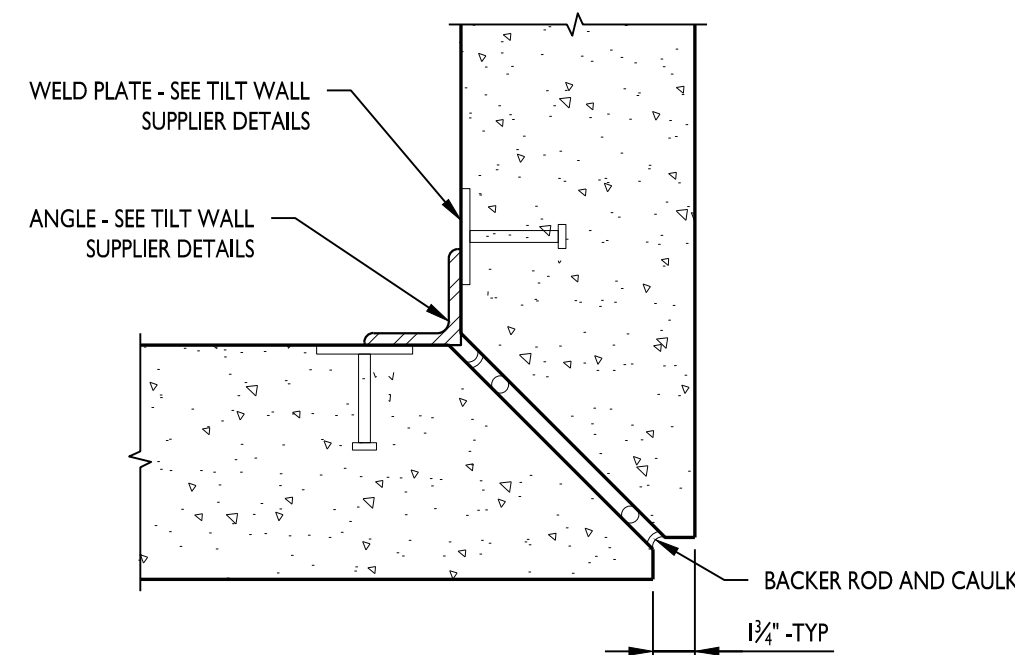

TILT WALL MITER CORNER DETAIL **6**
1 1/2" = 1'-0"

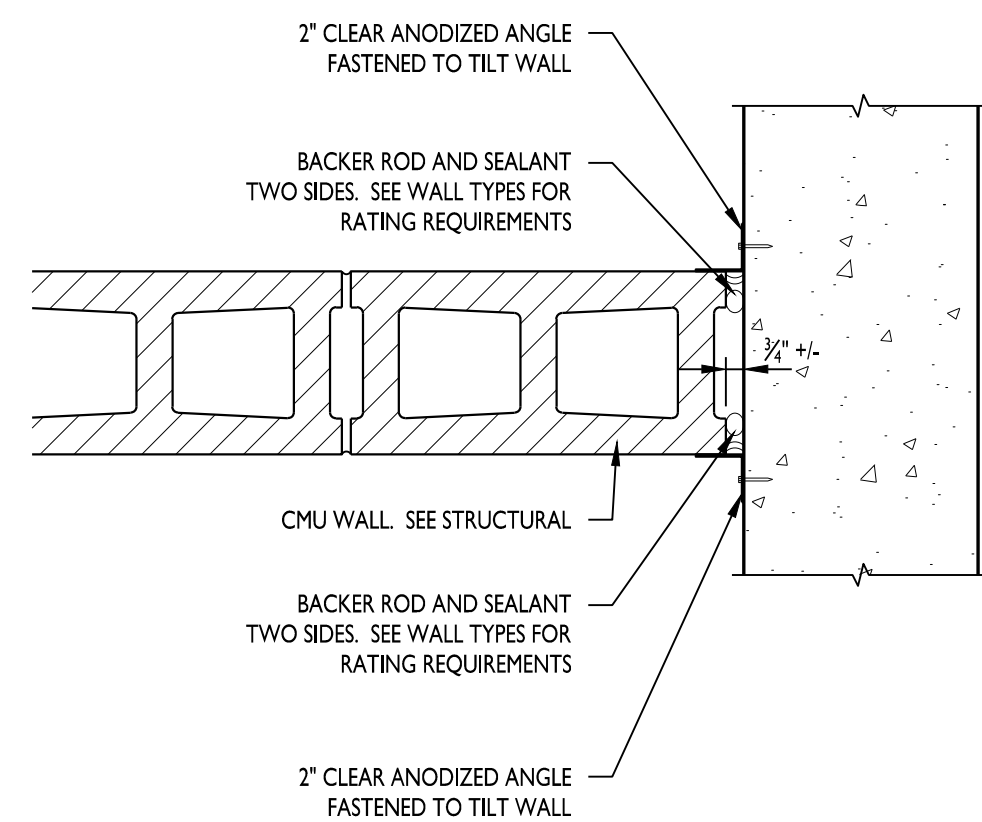

TILT WALL TO WALL PLAN DETAIL **3**
1 1/2" = 1'-0"

CURRAN

ARCHITECTURE

5719 LAWTON LOOP E. DR. #212
INDIANAPOLIS, IN 46216
O :: 317 . 288 . 0681
F :: 317 . 288 . 0753



CERTIFICATION

THIS DRAWING AND THE IDEAS, DESIGNS AND CONCEPTS CONTAINED HEREIN ARE THE EXCLUSIVE INTELLECTUAL PROPERTY OF CURRAN ARCHITECTURE, AND ARE NOT TO BE USED OR REPRODUCED, WHOLE OR IN PART, WITHOUT THE WRITTEN CONSENT OF CURRAN ARCHITECTURE.
© COPYRIGHT 2021, CURRAN ARCHITECTURE

PROJECT INFORMATION

LEE'S SUMMIT LOGISTICS
BUILDING A LOT I

NW CORNER OF
NE TUDOR RD & MAIN ST
LEE'S SUMMIT, MO 64086


ISSUE DATES

PERMIT SET	02.18.22


210300

TYPICAL TILT WALL
BUILDING DETAILS


A502

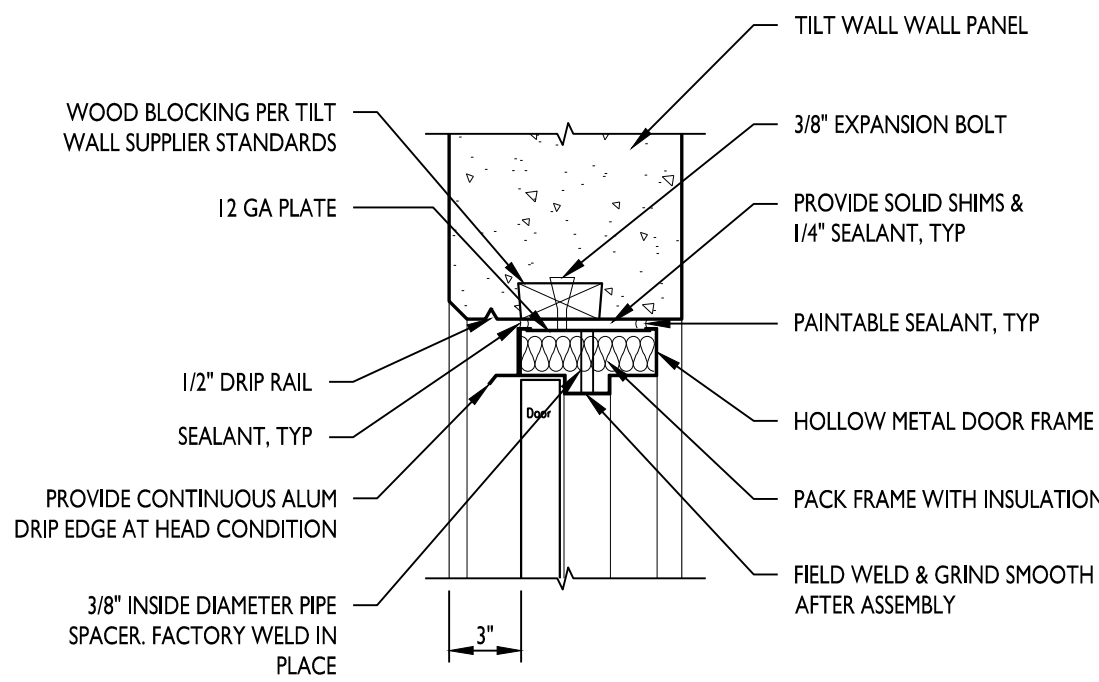


HM DOOR HEAD (IAMB SIM)
1 1/2" = 1'-0"

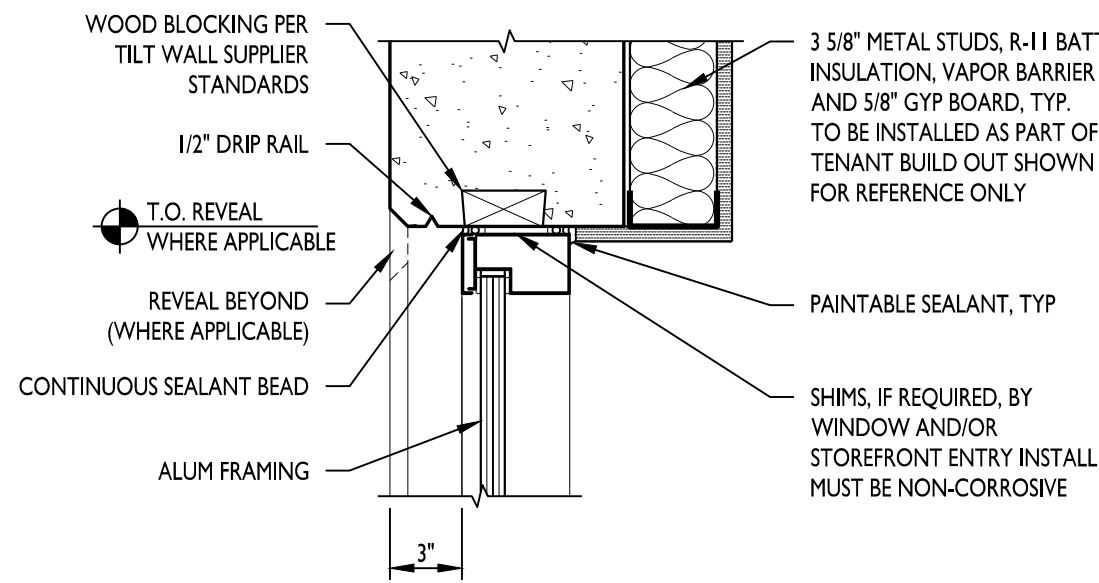


STOREFRONT HEAD (IAMB SIM)
1 1/2" = 1'-0"

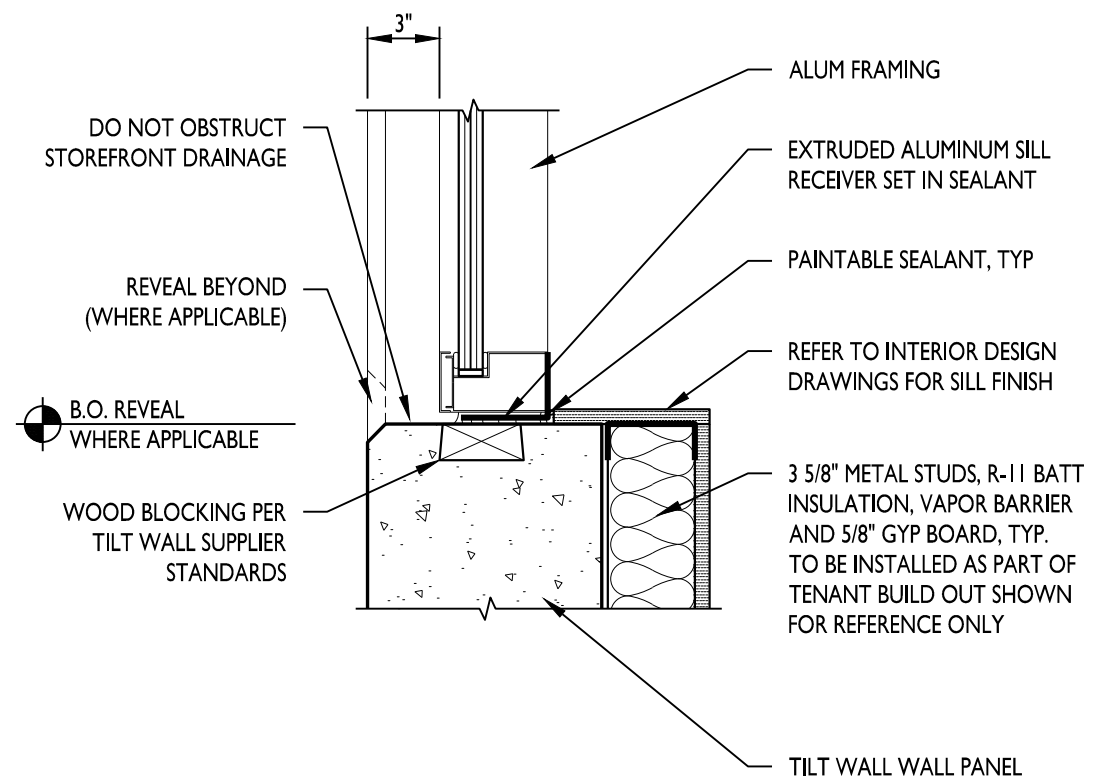


STOREFRONT SILL
1 1/2" = 1'-0"

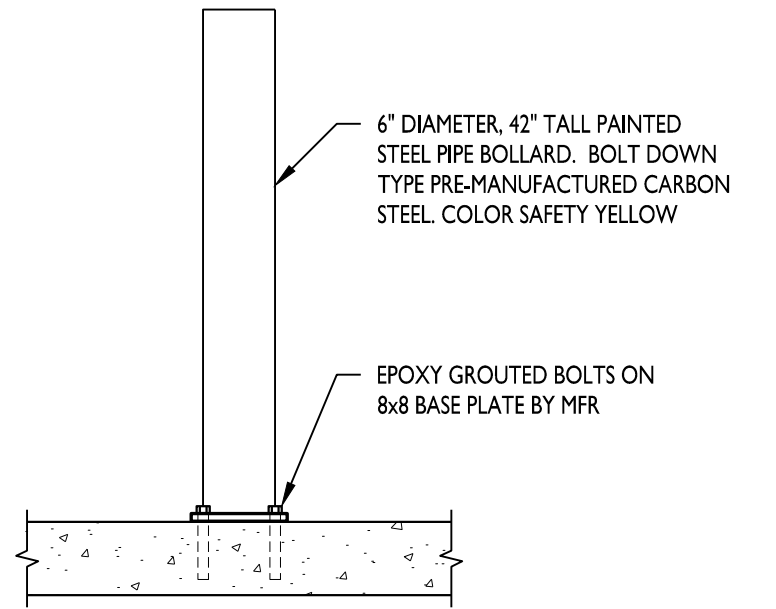


BOLT-DOWN BOLLARD DETAIL
3/4" = 1'-0"

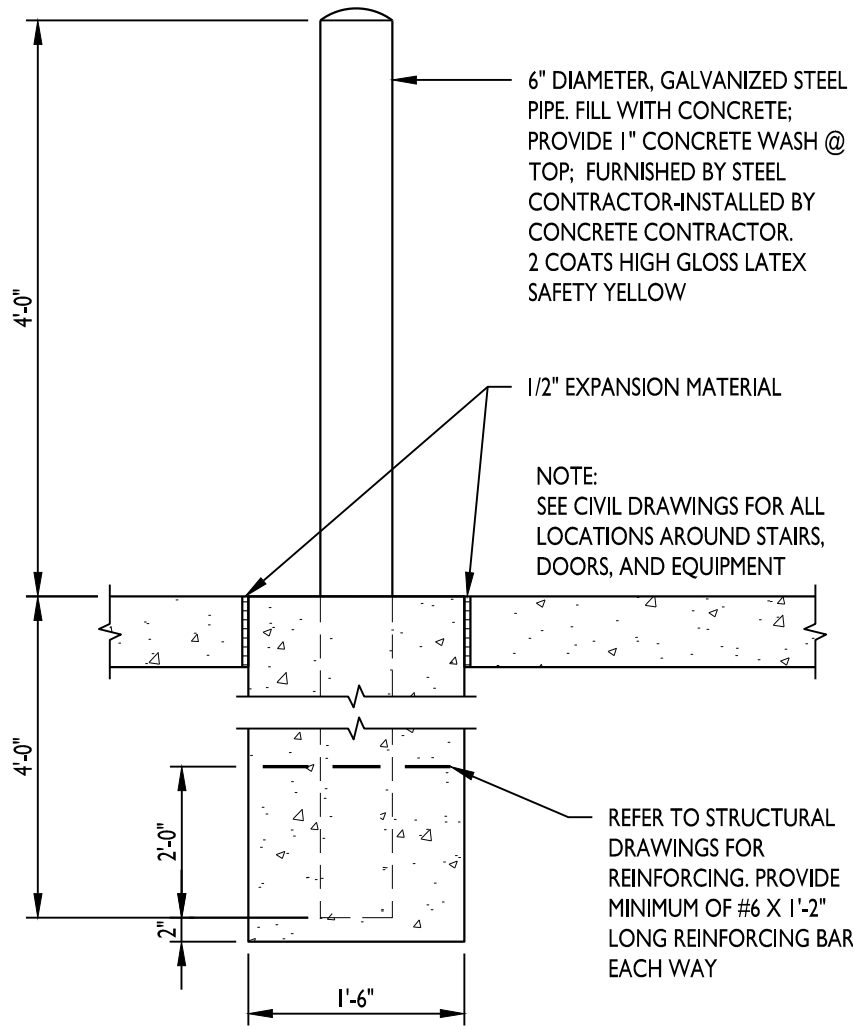


EXTERIOR BOLLARD DETAIL
3/4" = 1'-0"

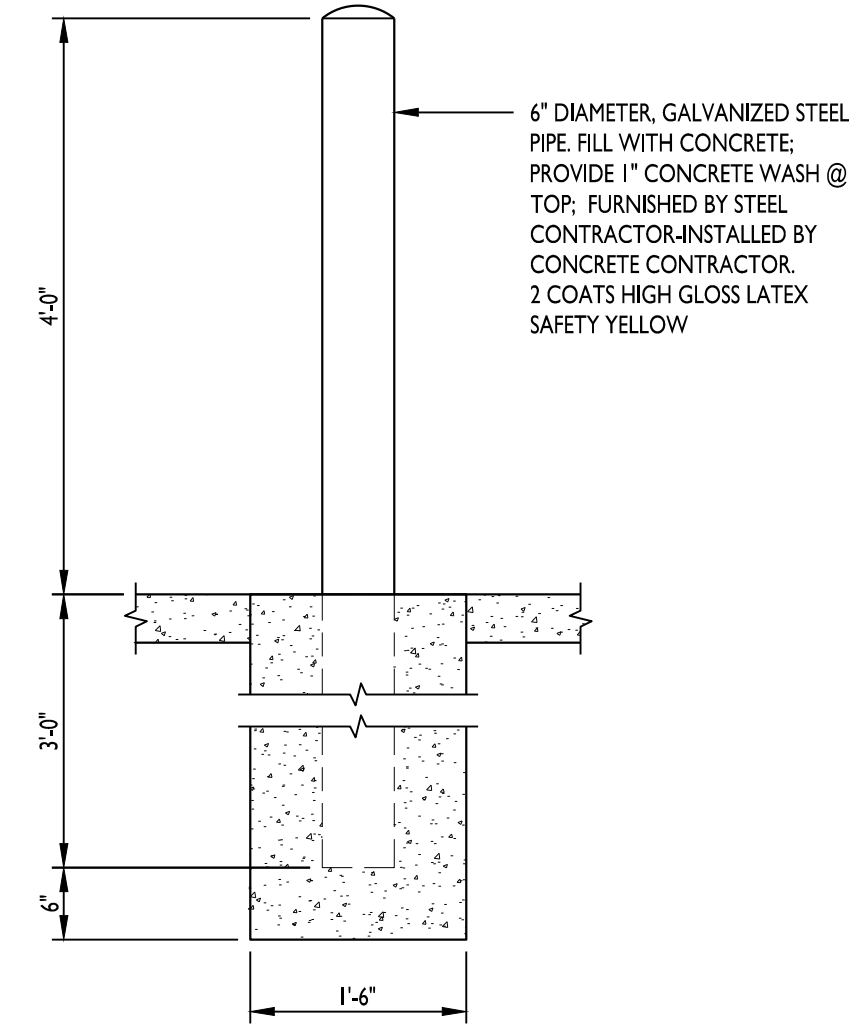


INTERIOR BOLLARD DETAIL
3/4" = 1'-0"

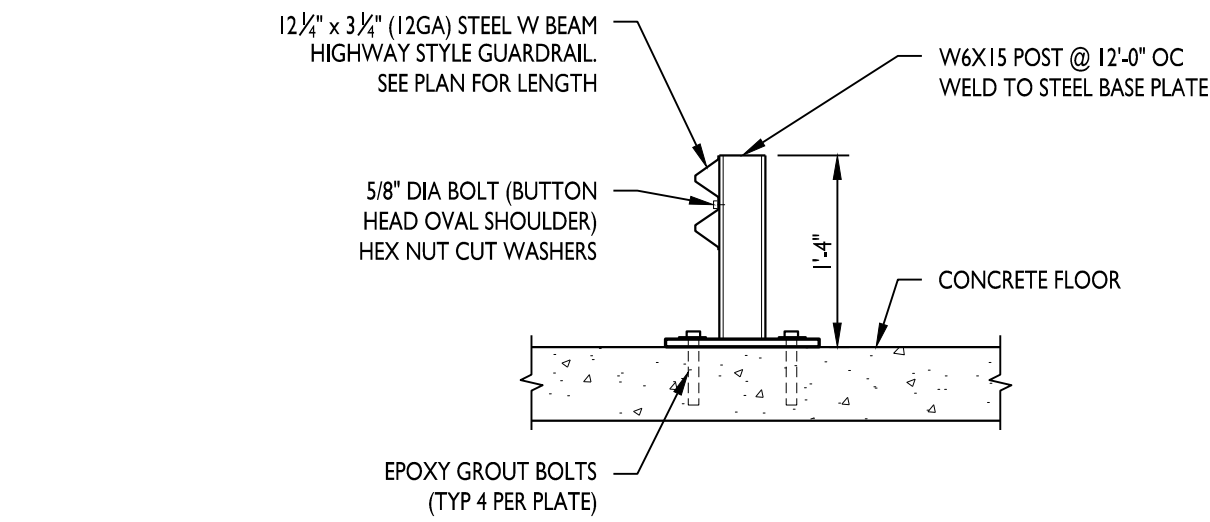


BOLT-DOWN GUARDRAIL DETAIL
3/4" = 1'-0"

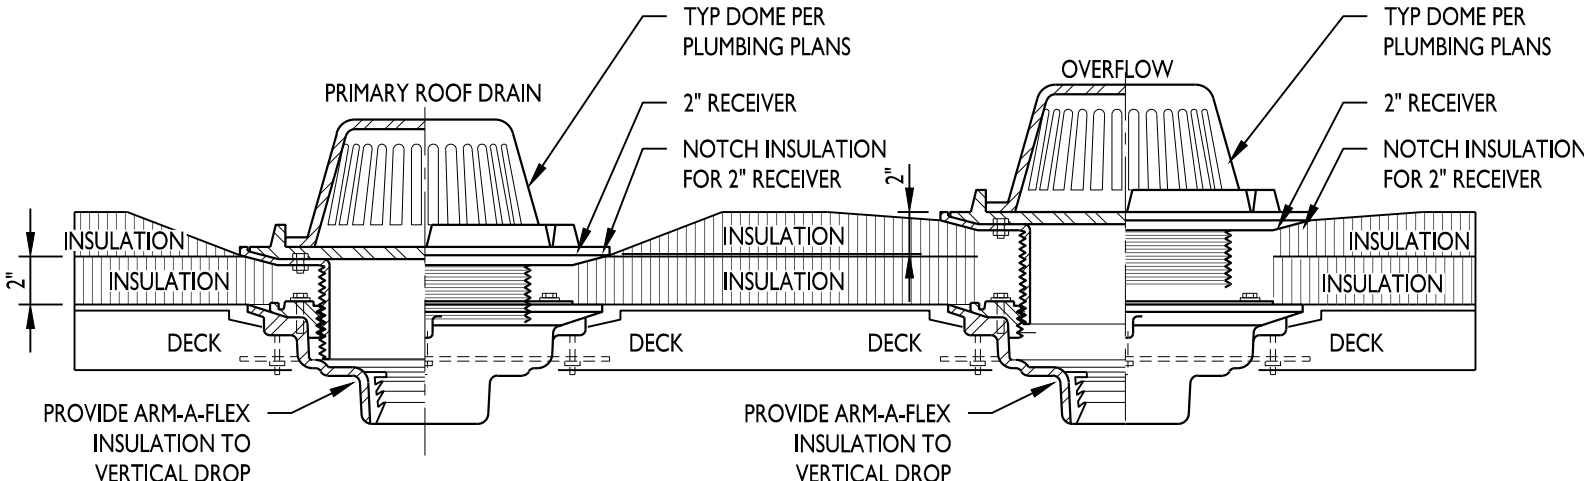


ROOF DRAIN DETAIL
1 1/2" = 1'-0"

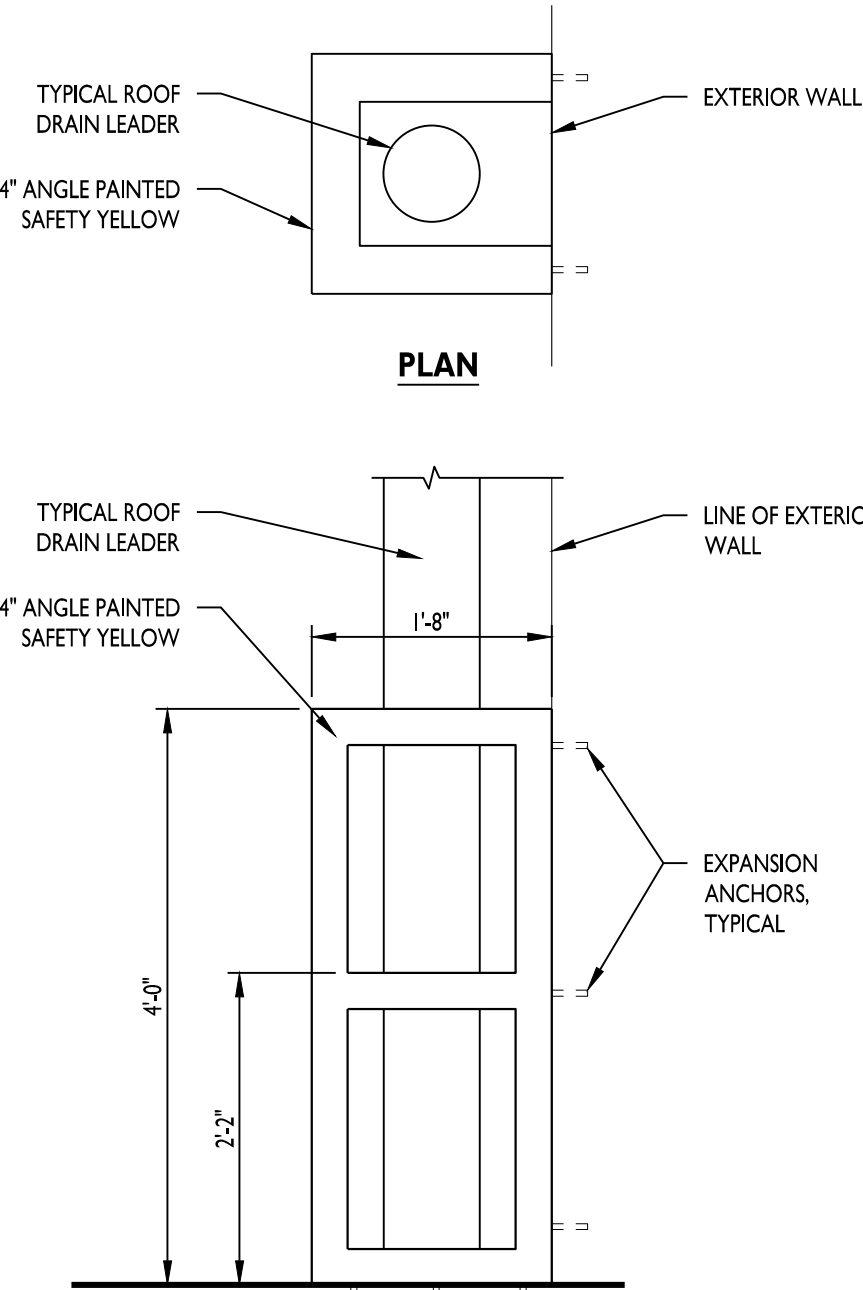

ROOF DRAIN PROTECTION DETAIL
3/4" = 1'-0"

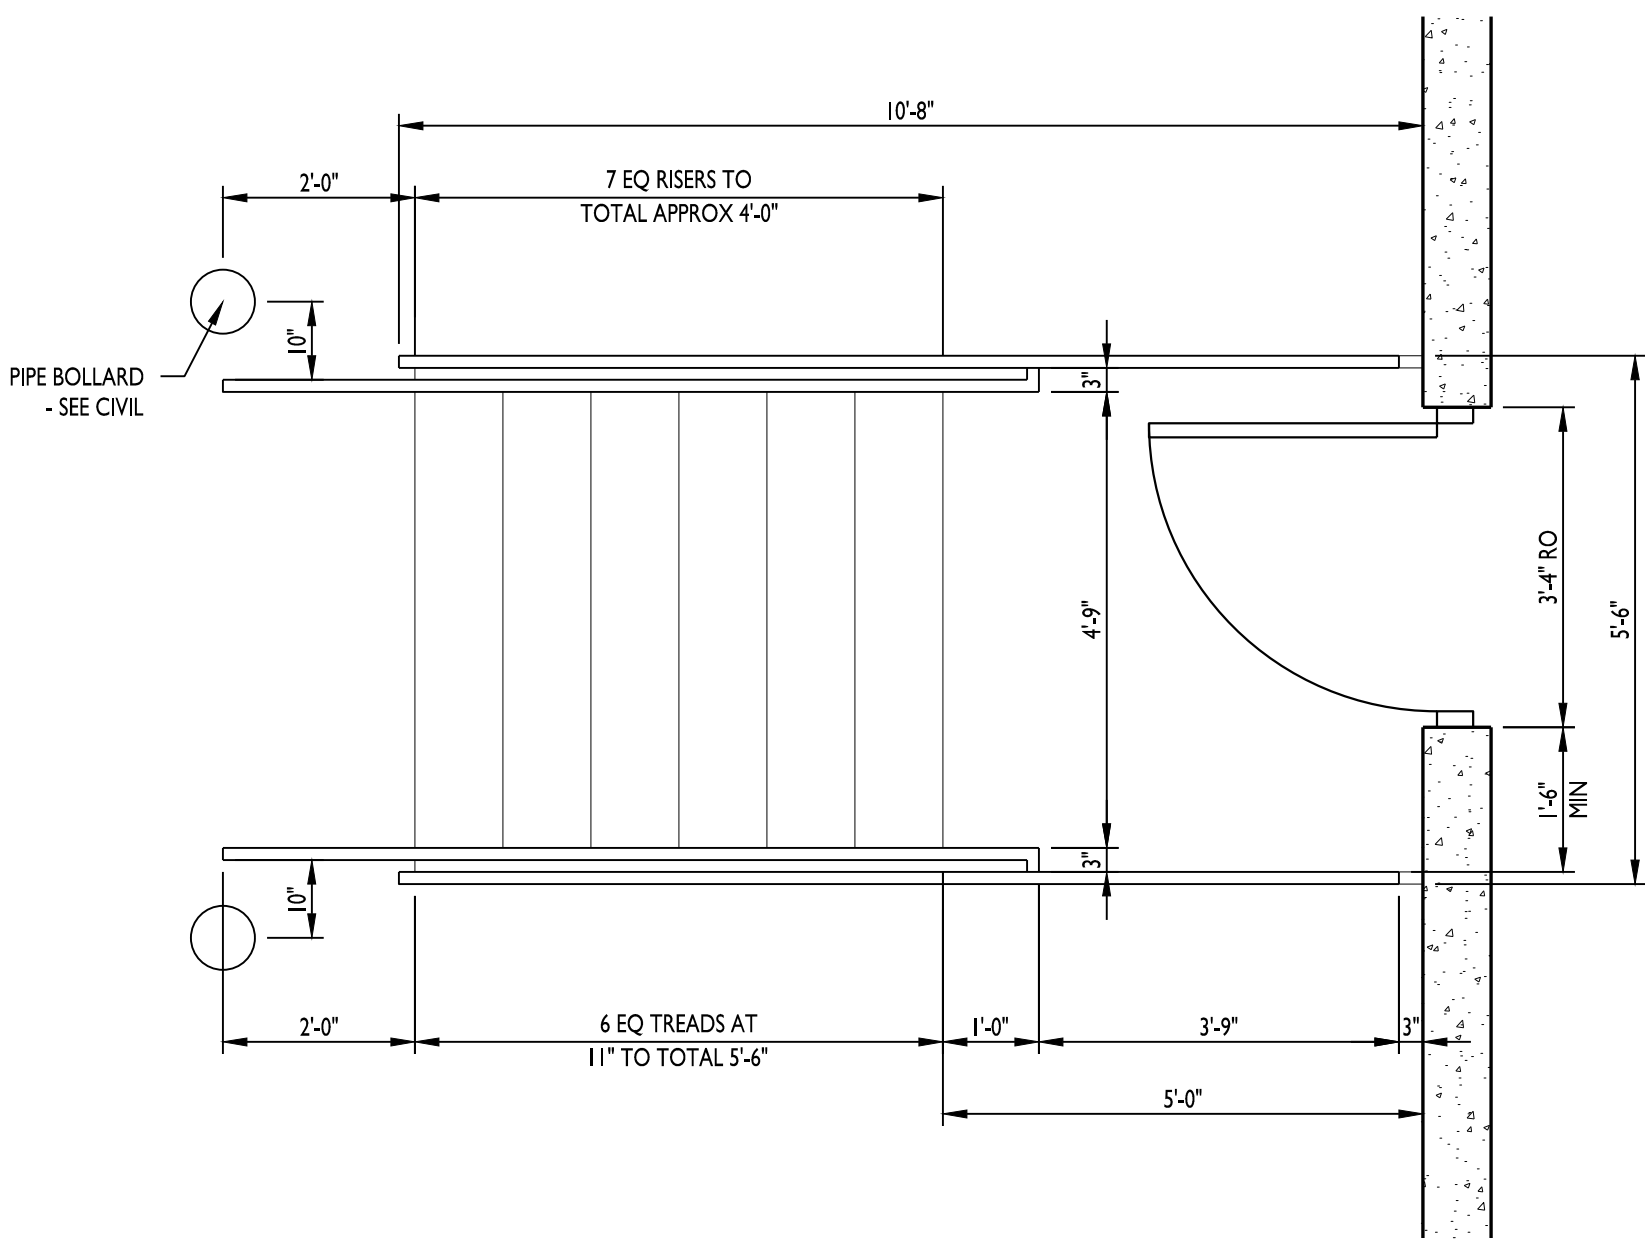

DOCK STAIR PLAN
1/2" = 1'-0"

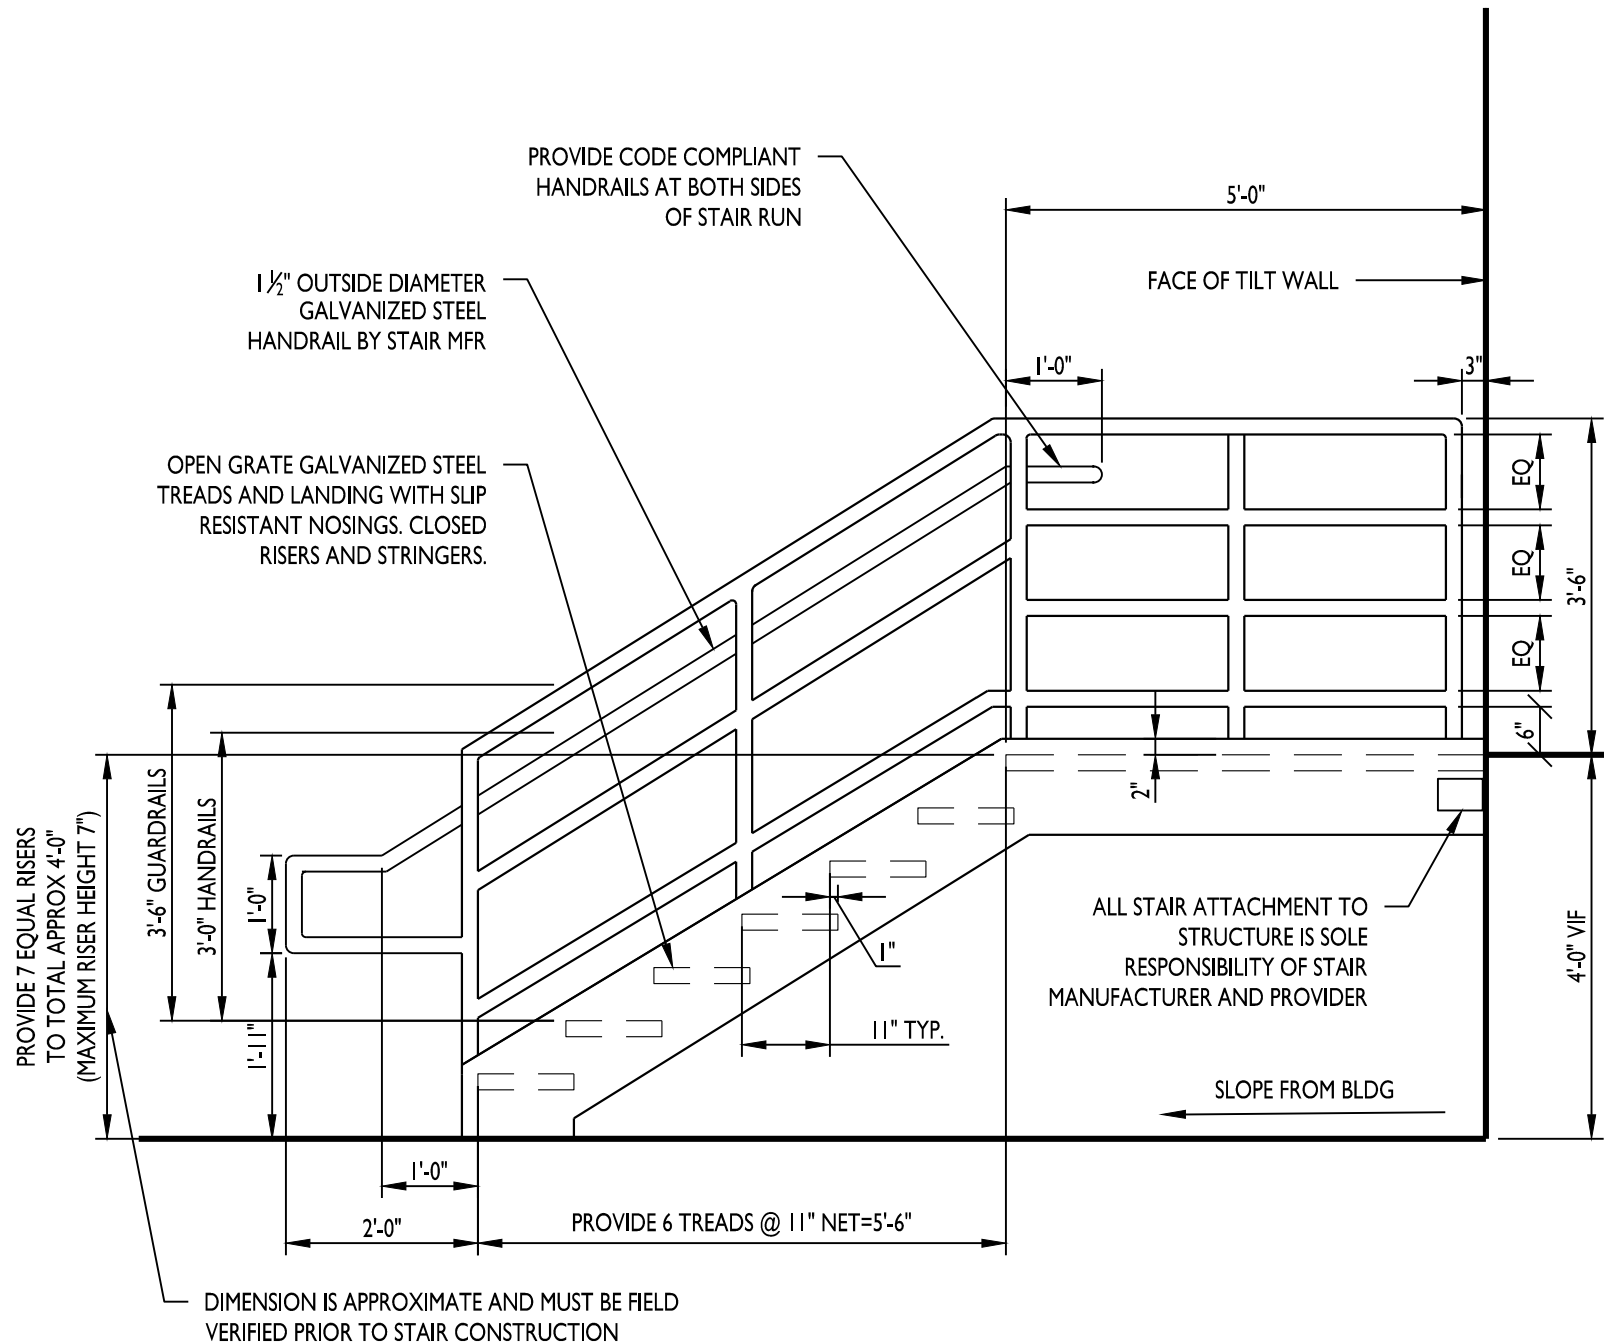

DOCK STAIR ELEVATION
1/2" = 1'-0"



719 LAWTON LOOP E. DR. #212
INDIANAPOLIS, IN 46216
O :: 317.288.0681
F :: 317.288.0753



CERTIFICATION

THIS DRAWING AND THE IDEAS, DESIGNS
AND CONCEPTS CONTAINED HEREIN ARE
THE EXCLUSIVE INTELLECTUAL PROPERTY
OF CURRAN ARCHITECTURE, AND ARE NOT
TO BE USED OR REPRODUCED, WHOLE OR
IN PART, WITHOUT THE WRITTEN
CONSENT OF CURRAN ARCHITECTURE.
© COPYRIGHT 2021, CURRAN ARCHITECTURE

PROJECT INFORMATION

LEE'S SUMMIT LOGISTICS
BUILDING A LOT 1

NW CORNER OF
NE TUDOR RD & MAIN ST
LEE'S SUMMIT, MO 64086


ISSUE DATES

PERMIT SET 02.18.22


210300

TYPICAL TILT WALL BUILDING DETAILS

A503

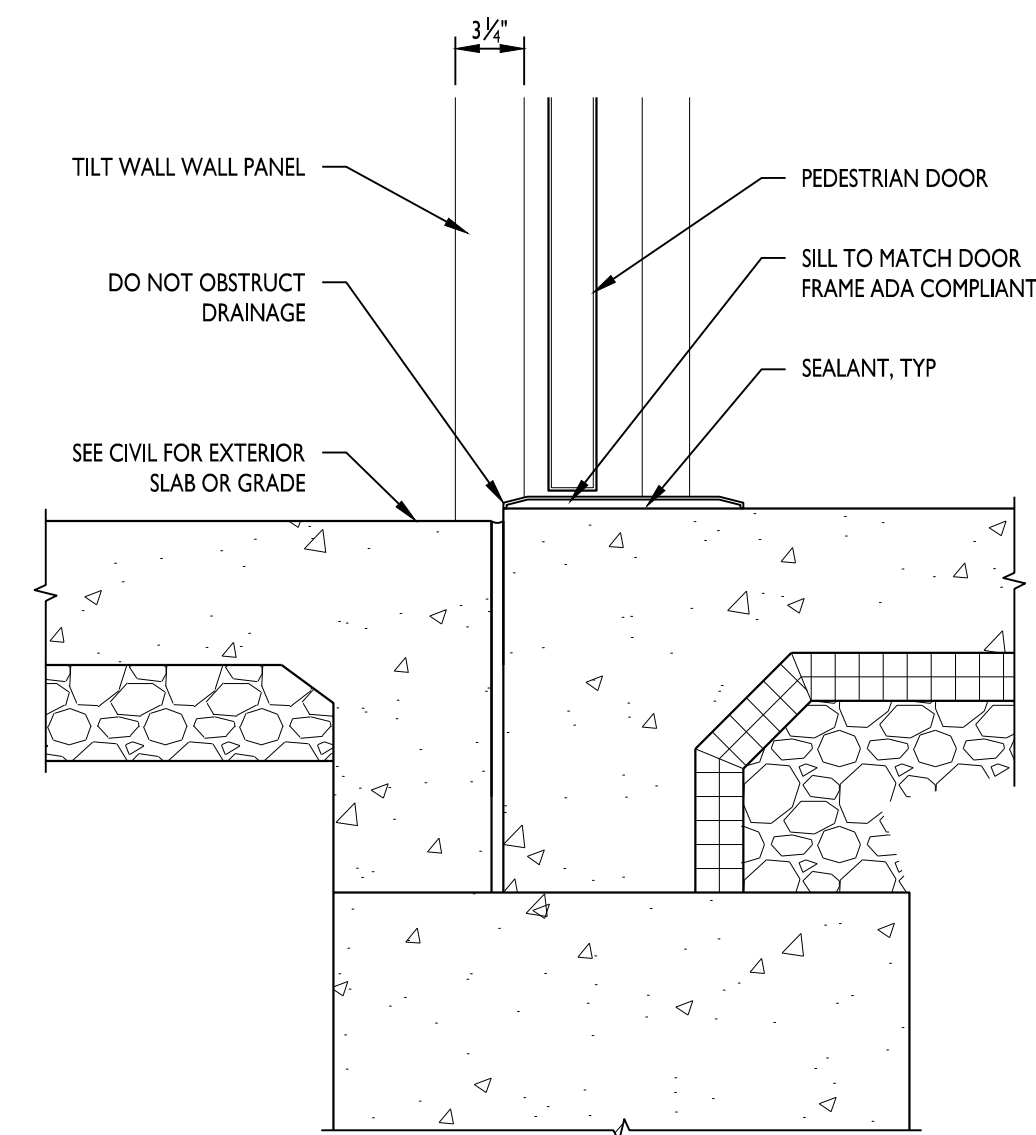


DOOR THRESHOLD **4**
 1 1/2" = 1'-0"

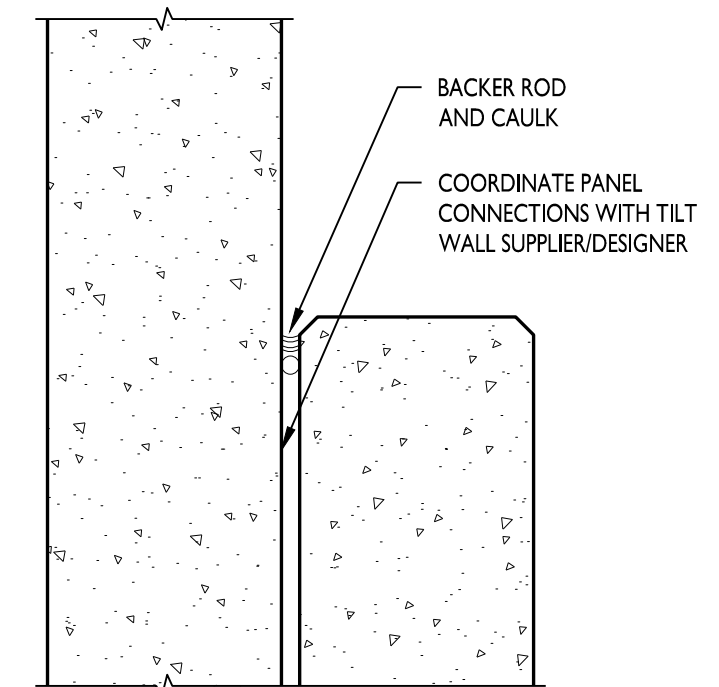


TILT WALL PLAN DETAIL


1 1/2" = 1'-0"

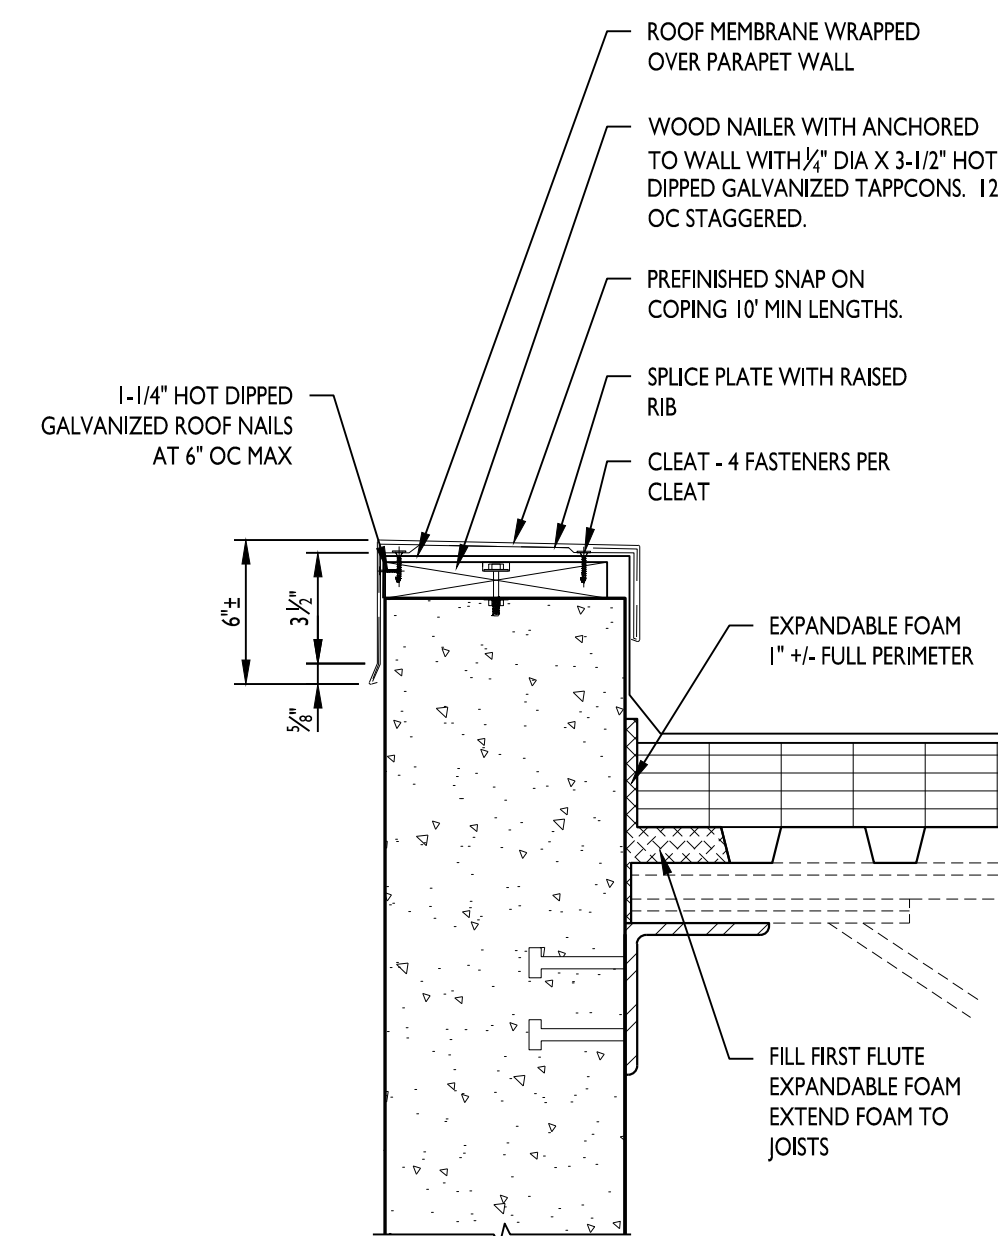


TYPICAL PARAPET DETAIL **5**

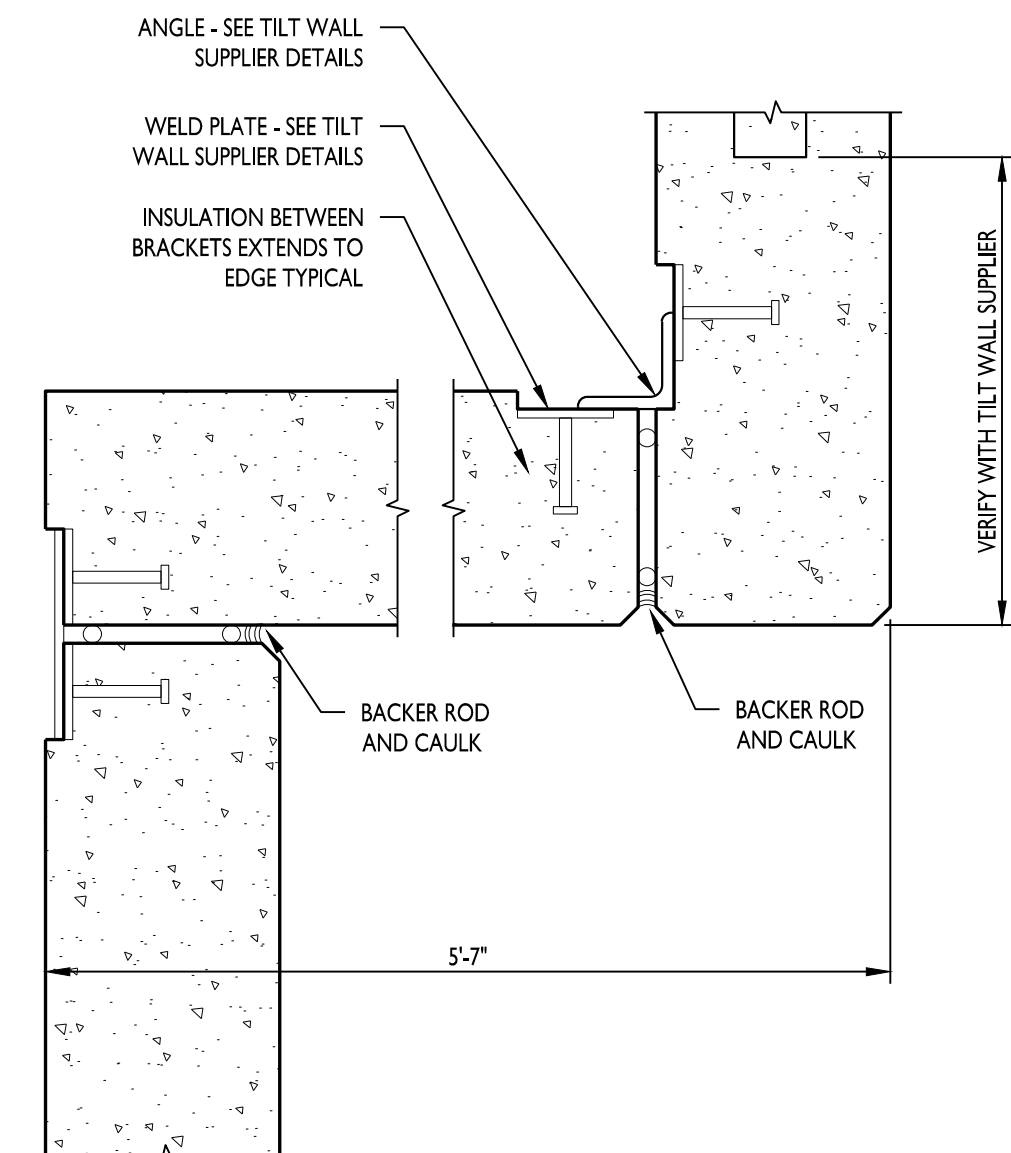

TILT WALL PLAN DETAIL **2**
1 1/2" = 1'-0"

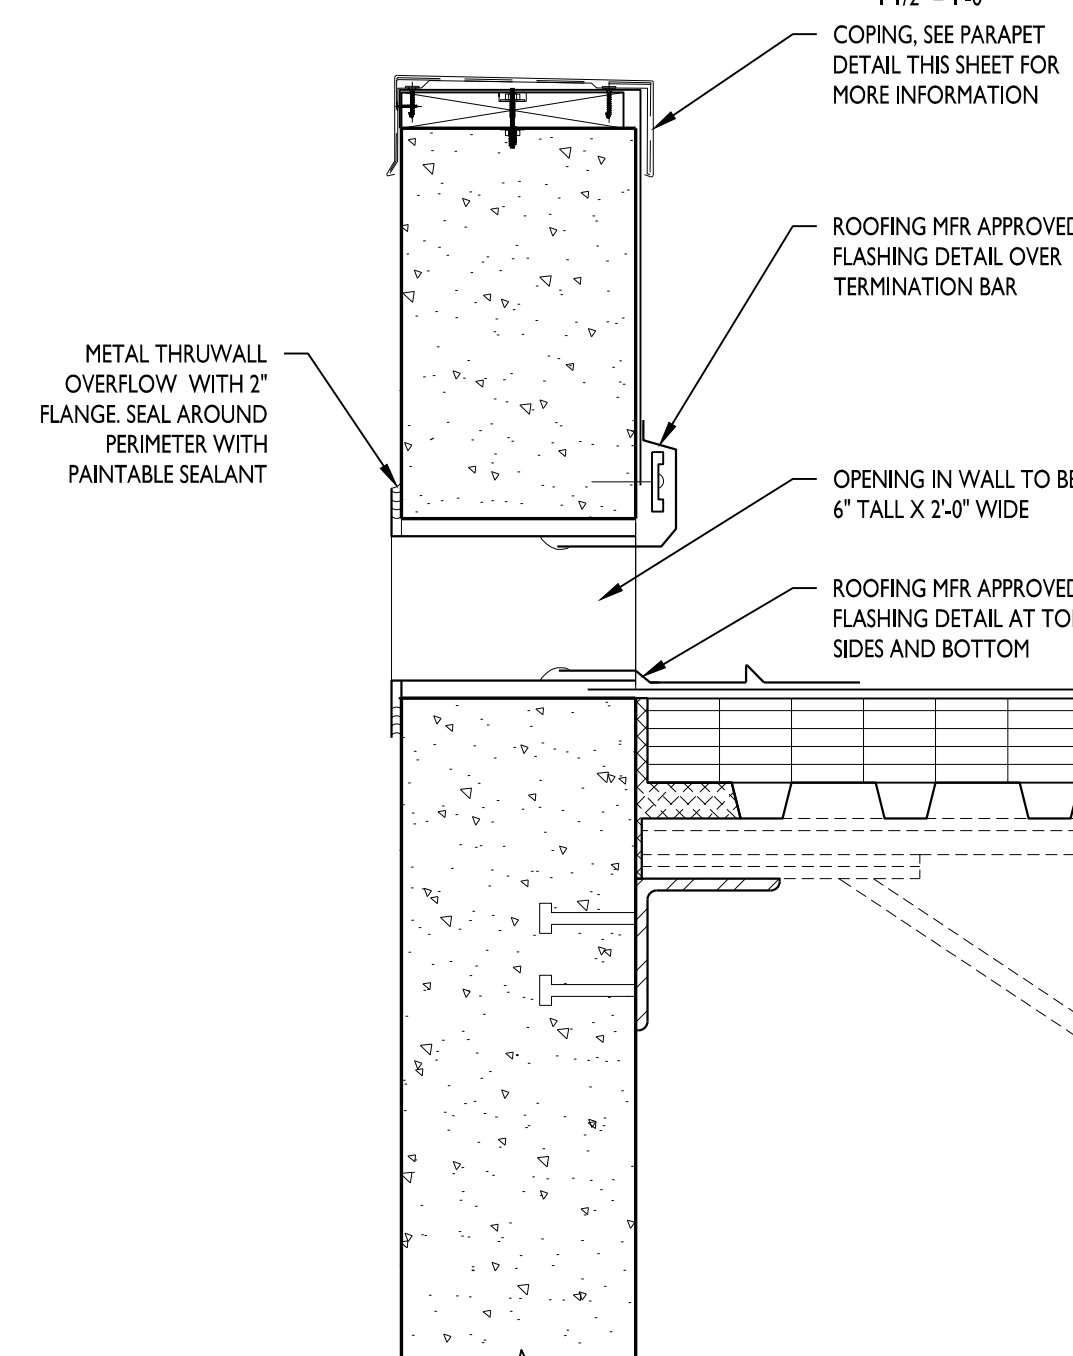


OVERFLOW SCUPPER DETAIL **6**

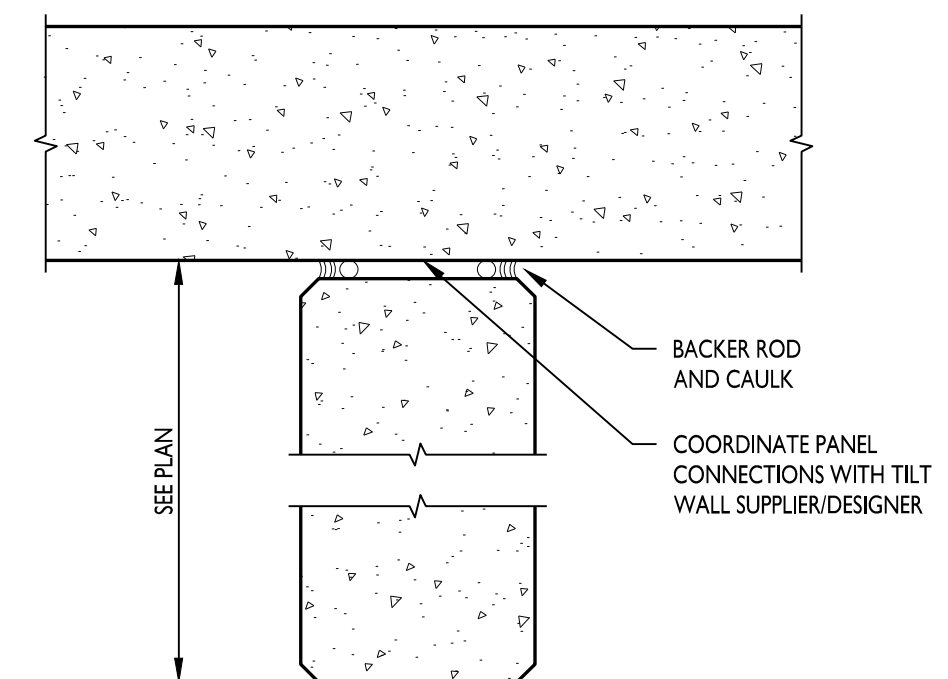

TILT WALL PLAN DETAIL **3**
1 1/2" = 1'-0"

TYPICAL TILT WALL BUILDING DETAILS

A503

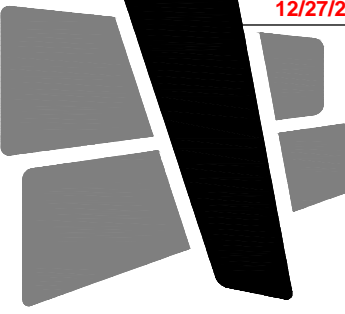

CURRAN
ARCHITECTURE

5719 LAWTON LOOP E. DR. #212
INDIANAPOLIS, IN 46216
O :: 317 . 288 . 0681
F :: 317 . 288 . 0753



SCANNELL
PROPERTIES

CERTIFICATION

THIS DRAWING AND THE IDEAS, DESIGNS
AND CONCEPTS CONTAINED HEREIN ARE
THE EXCLUSIVE INTELLECTUAL PROPERTY
OF CURRAN ARCHITECTURE, AND ARE NOT
TO BE USED OR REPRODUCED, WHOLE OR
IN PART, WITHOUT THE WRITTEN
CONSENT OF CURRAN ARCHITECTURE.
© COPYRIGHT 2021, CURRAN ARCHITECTURE

PROJECT INFORMATION

LEE'S SUMMIT LOGISTICS
BUILDING A LOT I

NW CORNER OF
NE TUDOR RD & MAIN ST
LEE'S SUMMIT, MO 64086

ISSUE DATES

PERMIT SET 02.18.22
TENANT COORDINATION 06.06.22

210300

DOOR & STOREFRONT
ELEVATIONS


A601

DOOR SCHEDULE CONTINUED

MARK	DOOR	SIZE	MATERIAL	GLAZING	FINISH	RATING	FRAME	MATERIAL	FINISH	RATING	HARDWARE	REMARKS
I14	F	3-0 x 7-0	INSUL STL	-	PAINT	-	FI	HM	PAINT	-	2	
I14A	OV2	9-0 x 10-0	INSUL STL	B	PREFINISHED	-	BY MFR	BY MFR	BY MFR	-	BY MFR	
I14B	OV2	9-0 x 10-0	INSUL STL	B	PREFINISHED	-	BY MFR	BY MFR	BY MFR	-	BY MFR	
I14C	OV2	9-0 x 10-0	INSUL STL	B	PREFINISHED	-	BY MFR	BY MFR	BY MFR	-	BY MFR	
I14D	OV2	9-0 x 10-0	INSUL STL	B	PREFINISHED	-	BY MFR	BY MFR	BY MFR	-	BY MFR	
I14E	OV2	9-0 x 10-0	INSUL STL	B	PREFINISHED	-	BY MFR	BY MFR	BY MFR	-	BY MFR	
I14F	OV2	9-0 x 10-0	INSUL STL	B	PREFINISHED	-	BY MFR	BY MFR	BY MFR	-	BY MFR	
I14G	OV2	9-0 x 10-0	INSUL STL	B	PREFINISHED	-	BY MFR	BY MFR	BY MFR	-	BY MFR	
I15	F	3-0 x 7-0	INSUL STL	-	PAINT	-	FI	HM	PAINT	-	2	
I15A	OV2	9-0 x 10-0	INSUL STL	B	PREFINISHED	-	BY MFR	BY MFR	BY MFR	-	BY MFR	
I15B	OV2	9-0 x 10-0	INSUL STL	B	PREFINISHED	-	BY MFR	BY MFR	BY MFR	-	BY MFR	
I15C	OV2	9-0 x 10-0	INSUL STL	B	PREFINISHED	-	BY MFR	BY MFR	BY MFR	-	BY MFR	
I16H	OV1	12-0 x 14-0	INSUL STL	B	PREFINISHED	-	BY MFR	BY MFR	BY MFR	-	BY MFR	
I17	F	3-0 x 7-0	INSUL STL	-	PAINT	-	FI	HM	PAINT	-	2	
I18	F	3-0 x 7-0	INSUL STL	-	PAINT	-	FI	HM	PAINT	-	2	
I19	F	3-0 x 7-0	INSUL STL	-	PAINT	-	FI	HM	PAINT	-	2	
I20	F	3-0 x 7-0	INSUL STL	-	PAINT	-	FI	HM	PAINT	-	2	
I21	F	3-0 x 7-0	INSUL STL	-	PAINT	-	FI	HM	PAINT	-	2	


DOOR SCHEDULE

MARK	DOOR	SIZE	MATERIAL	GLAZING	FINISH	RATING	FRAME	MATERIAL	FINISH	RATING	HARDWARE	REMARKS
I01	FG	(2) 3-0 x 7-0	ALUM	B	CLEAR ANOD	-	SF1	ALUM	CLEAR ANOD	-	1	
I02	F	3-0 x 7-0	INSUL STL	-	PAINT	-	FI	HM	PAINT	-	2	
I02A	OV1	12-0 x 14-0	INSUL STL	B	PREFINISHED	-	BY MFR	BY MFR	BY MFR	-	BY MFR	
I02B	OV2	9-0 x 10-0	INSUL STL	B	PREFINISHED	-	BY MFR	BY MFR	BY MFR	-	BY MFR	
I02C	OV2	9-0 x 10-0	INSUL STL	B	PREFINISHED	-	BY MFR	BY MFR	BY MFR	-	BY MFR	
I03	F	3-0 x 7-0	INSUL STL	-	PAINT	-	FI	HM	PAINT	-	2	
I03A	OV2	9-0 x 10-0	INSUL STL	B	PREFINISHED	-	BY MFR	BY MFR	BY MFR	-	BY MFR	
I03B	OV2	9-0 x 10-0	INSUL STL	B	PREFINISHED	-	BY MFR	BY MFR	BY MFR	-	BY MFR	NO LEVELER, SEALS OR BUMPER AT DOOR
I03C	OV2	9-0 x 10-0	INSUL STL	B	PREFINISHED	-	BY MFR	BY MFR	BY MFR	-	BY MFR	
I03D	OV2	9-0 x 10-0	INSUL STL	B	PREFINISHED	-	BY MFR	BY MFR	BY MFR	-	BY MFR	
I03E	OV2	9-0 x 10-0	INSUL STL	B	PREFINISHED	-	BY MFR	BY MFR	BY MFR	-	BY MFR	
I03F	OV2	9-0 x 10-0	INSUL STL	B	PREFINISHED	-	BY MFR	BY MFR	BY MFR	-	BY MFR	
I03G	OV2	9-0 x 10-0	INSUL STL	B	PREFINISHED	-	BY MFR	BY MFR	BY MFR	-	BY MFR	
I04	F	3-0 x 7-0	INSUL STL	-	PAINT	-	FI	HM	PAINT	-	2	
I04A	OV2	9-0 x 10-0	INSUL STL	B	PREFINISHED	-	BY MFR	BY MFR	BY MFR	-	BY MFR	
I04B	OV2	9-0 x 10-0	INSUL STL	B	PREFINISHED	-	BY MFR	BY MFR	BY MFR	-	BY MFR	
I06	F	3-0 x 7-0	INSUL STL	-	PAINT	-	FI	HM	PAINT	-	2	
I06A	OV2	9-0 x 10-0	INSUL STL	B	PREFINISHED	-	BY MFR	BY MFR	BY MFR	-	BY MFR	
I06B	OV2	9-0 x 10-0	INSUL STL	B	PREFINISHED	-	BY MFR	BY MFR	BY MFR	-	BY MFR	
I06C	OV1	12-0 x 14-0	INSUL STL	B	PREFINISHED	-	BY MFR	BY MFR	BY MFR	-	BY MFR	
I07	F	3-0 x 7-0	INSUL STL	-	PAINT	-	FI	HM	PAINT	-	2	
I07B	F	3-6 x 7-0	INSUL STL	-	PAINT	-	FI	HM	PAINT	-	3	
I08	FG	(2) 3-0 x 7-0	ALUM	B	CLEAR ANOD	-	SF1	ALUM	CLEAR ANOD	-	1	
I09	F	3-0 x 7-0	INSUL STL	-	PAINT	-	FI	HM	PAINT	-	2	
I10	F	3-0 x 7-0	INSUL STL	-	PAINT	-	FI	HM	PAINT	-	2	
I11	F	3-0 x 7-0	INSUL STL	-	PAINT	-	FI	HM	PAINT	-	2	
I12	F	3-0 x 7-0	INSUL STL	-	PAINT	-	FI	HM	PAINT	-	2	
I12A	OV2	9-0 x 10-0	INSUL STL	B	PREFINISHED	-	BY MFR	BY MFR	BY MFR	-	BY MFR	
I12B	OV2	9-0 x 10-0	INSUL STL	B	PREFINISHED	-	BY MFR	BY MFR	BY MFR	-	BY MFR	
I13	F	3-0 x 7-0	INSUL STL	-	PAINT	-	FI	HM	PAINT	-	2	
I13A	OV2	9-0 x 10-0	INSUL STL	B	PREFINISHED	-	BY MFR	BY MFR	BY MFR	-	BY MFR	
I13B	OV2	9-0 x 10-0	INSUL STL	B	PREFINISHED	-	BY MFR	BY MFR	BY MFR	-	BY MFR	
I13C	OV2	9-0 x 10-0	INSUL STL	B	PREFINISHED	-	BY MFR	BY MFR	BY MFR	-	BY MFR	
I13D	OV2	9-0 x 10-0	INSUL STL	B	PREFINISHED	-	BY MFR	BY MFR	BY MFR	-	BY MFR	
I13E	OV2	9-0 x 10-0	INSUL STL	B	PREFINISHED	-	BY MFR	BY MFR	BY MFR	-	BY MFR	
I13F	OV2	9-0 x 10-0	INSUL STL	B	PREFINISHED	-	BY MFR	BY MFR	BY MFR	-	BY MFR	

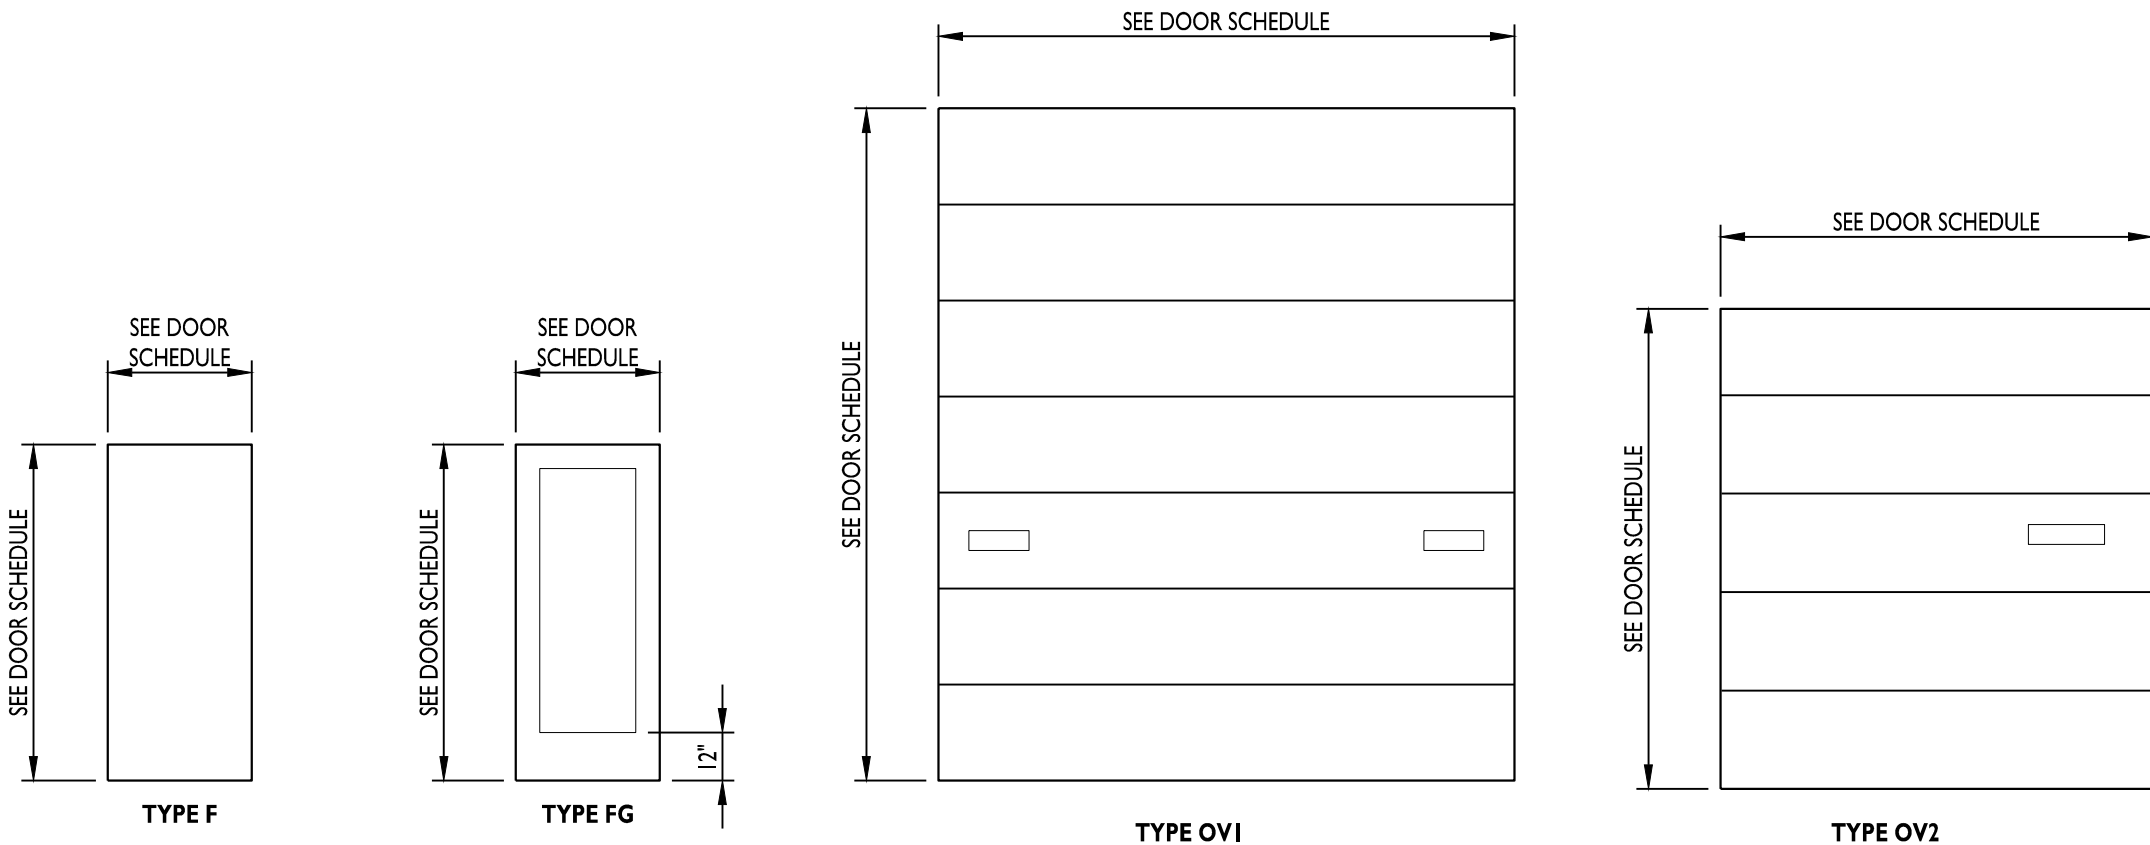


DOOR TYPES

NOT TO SCALE

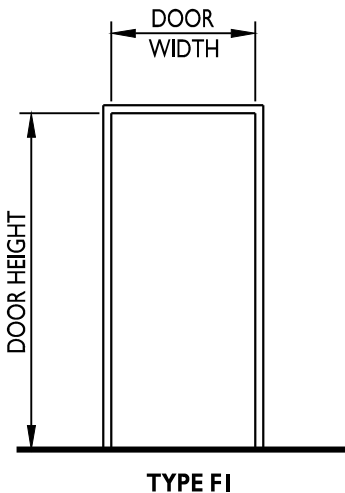

DOOR FRAME TYPES

NOT TO SCALE

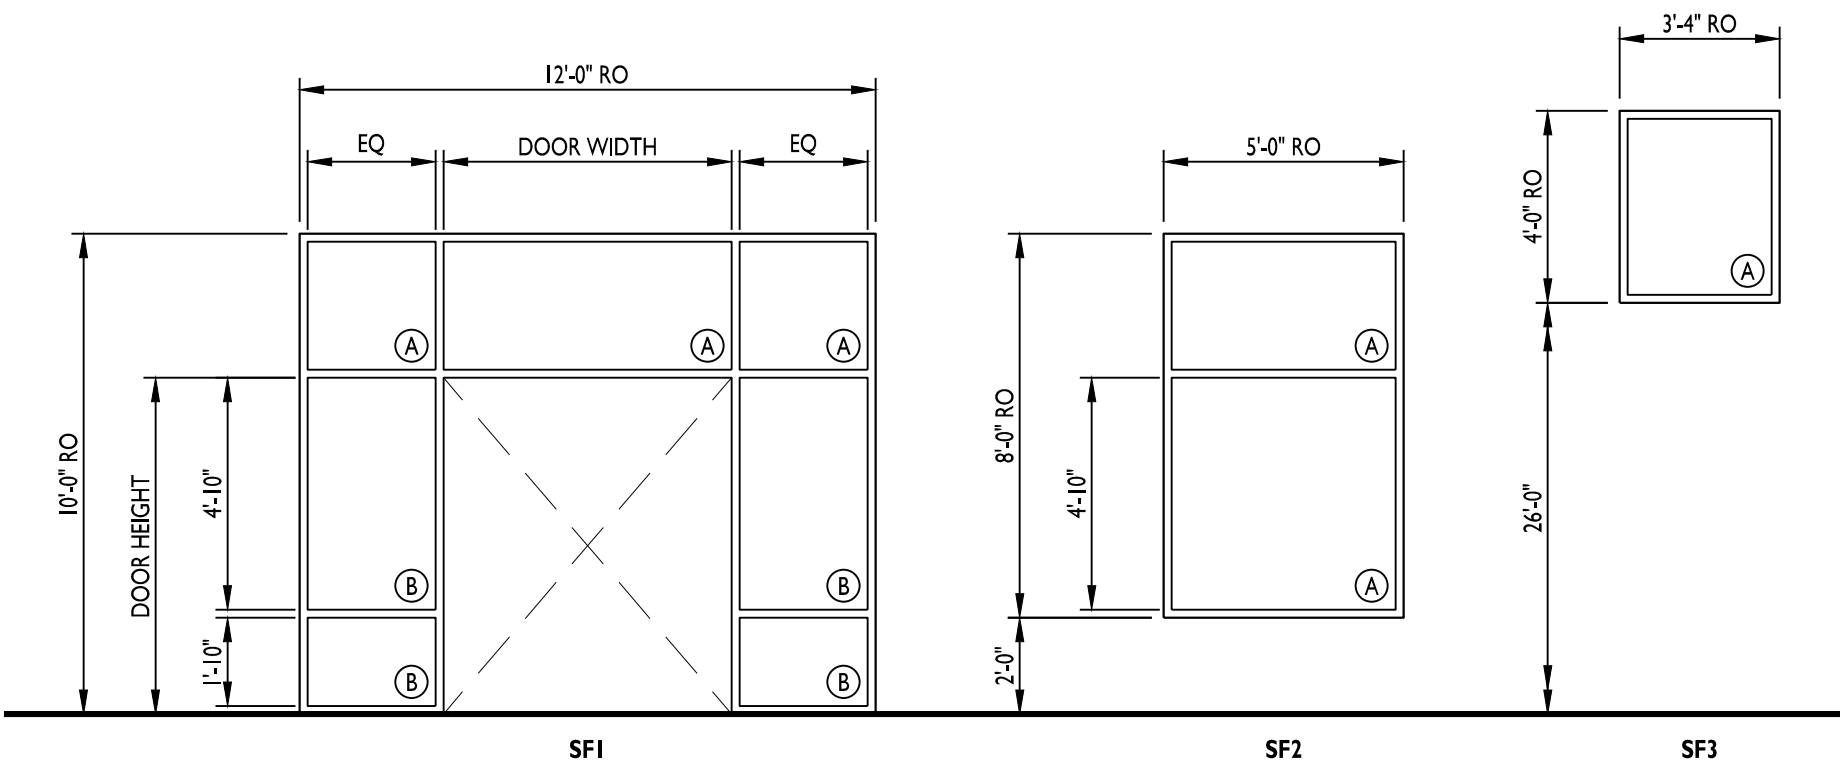

SF1

SF2

SF3

STOREFRONT ELEVATIONS

NOT TO SCALE

GENERAL DOOR AND GLAZING NOTES

- ALL PRE-FINISHED WOOD DOORS SHALL BE SOLID CORE WITH WOOD VENEER, MARSHFIELD OR EQUIVALENT. PROVIDE FINISH SAMPLE AND DOOR CONSTRUCTION DIAGRAM FOR APPROVAL AND HARDWARE BLOCKING COORDINATION. VENEER TO BE WHITE BIRCH OR MAPLE, FREE OF DARK GRAINS UNLESS OTHERWISE NOTED.
- WOOD DOORS SHALL ONLY BE INSTALLED IN CONDITIONED SPACE.
- ALL HARDWARE TO BE MINIMUM 6 PIN BEST COMPATIBLE SYSTEM. COORDINATE KEYING WITH OWNER.
- TEMPERED AND ANNEALED GLASS TO BE CLEANED PER MANUFACTURER REQUIREMENTS. NYLON CLOTH METHODS PREFERRED. DO NOT USE RAZOR BLADES ON GLASS.
- GLASS AROUND DOORS AND IN DOORS SHALL BE TEMPERED UNLESS OTHERWISE NOTED IN ELEVATIONS.
- ANY RATED DOORS TO HAVE LABEL INSTALLED IN JAMB.
- ALL EXITS DOORS TO HAVE TACTILE EXIT SIGNAGE PER 703.4 OF THE ANSI 117.1 2009.
- INSTALL OWNER PROVIDED ADA COMPLIANT RESTROOM SIGNAGE. VERIFY WITH ARCHITECT.
- STOREFRONT TO BE MANKO 2450 CENTER SET, OR EQUAL

GLAZING TYPES

- SECTION OF GLAZING REQUIRED TO BE 1" INSULATED TINTED GLASS.
- SECTION OF GLAZING REQUIRED TO BE 1" INSULATED TEMPERED GLASS.
- SECTION OF GLAZING REQUIRED TO BE 1/4" GLASS.
- SECTION OF GLAZING REQUIRED TO BE 1/4" TEMPERED GLASS.
- SECTION OF GLAZING REQUIRED TO BE 1" INSULATED TEMPERED GREY TINTED SPANDREL GLASS.

EXTERIOR GLAZING MUST MEET THE FOLLOWING SPECIFICATIONS FOR ENERGY CODE COMPLIANCE:

LOW "E" COATING
"U" VALUE - MINIMUM OF 0.28
"SHGC" VALUE - MAXIMUM OF 0.47

DOOR HARDWARE

HARDWARE SET 1

- CONTINUOUS HINGES
- PANIC DEVICES
- PERIMETER SEAL
- THRESHOLD
- SWEEPS
- HD CLOSERS
- PULLS

FINISH: MATCH STOREFRONT

HARDWARE SET 2


- BALL BEARING HINGES
- PANIC DEVICE W/ LEVER
- PERIMETER SEAL
- THRESHOLD W/ DRAINAGE SUBSILL
- SWEEP
- HD CLOSER
- DRIP TRIM

FINISH: US26D

HARDWARE SET 3

- BALL BEARING HINGES
- STOREROOM LOCKSET
- PERIMETER SEAL
- THRESHOLD W/ DRAINAGE SUBSILL
- SWEEP
- HD CLOSER
- DRIP TRIM

FINISH: US26D

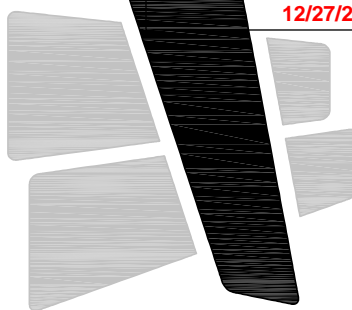

CURRAN
ARCHITECTURE

5719 LAWTON LOOP E. DR. #212
INDIANAPOLIS, IN 46216
O :: 317 . 288 . 0681
F :: 317 . 288 . 0753



SCANNELL
PROPERTIES

wallace



Wallace Engineering
Structural Consultants, Inc.
Structural and Civil Consultants
1741 McGee Street
Kansas City, Missouri 64108
816.421.8282, Fax 816.421.8338

CERTIFICATION



12/13/2022
Missouri COA #001268

THIS DRAWING AND THE IDEAS, DESIGNS AND CONCEPTS CONTAINED HEREIN ARE THE EXCLUSIVE INTELLECTUAL PROPERTY OF CURRAN ARCHITECTURE, AND ARE NOT TO BE USED OR REPRODUCED, WHOLE OR IN PART, WITHOUT THE WRITTEN CONSENT OF CURRAN ARCHITECTURE.
© COPYRIGHT 2021, CURRAN ARCHITECTURE

PROJECT INFORMATION

LEE'S SUMMIT LOGISTICS
BUILDING A LOT I

NW CORNER TUDOR RD & MAINST
LEE'S SUMMIT, MO

ISSUE DATES

ISSUE	DATE
ISSUE FOR PERMIT	02.18.2022
ISSUE FOR PERMIT	04.15.2022

210300

S0.0

GENERAL NOTES

DESIGN PARAMETERS

1.	BUILDING CODE	2018 INTERNATIONAL BUILDING CODE (IBC)
	OCCUPANCY CATEGORY	II
2.	LIVE LOADS	
	A. ROOF – NON–REDUCIBLE	20 PSF
	B. SLAB–ON–GRADE	350 PSF
3.	ROOF SNOW LOAD	
	A. GROUND SNOW LOAD, Pg	20 PSF
	B. FLAT ROOF SNOW LOAD, Pf	20 PSF
	C. SNOW EXPOSURE FACTOR, Ce	1.0
	D. SNOW LOAD IMPORTANCE FACTOR, I	1.0
	E. THERMAL FACTOR, Ct (BUILDING)	1.0
	F. SNOW DRIFT	PER REFERENCED CODE
4.	WIND DESIGN DATA	
	A. ULTIMATE WIND SPEED (3 SECOND GUST), V	109 MPH
	B. WIND IMPORTANCE FACTOR, I	1.00
	C. WIND EXPOSURE CATEGORY	C
	D. INTERNAL PRESSURE COEFFICIENT, Gcpi	+/- 0.18
	E. DESIGN WIND PRESSURE ON COMPONENTS AND CLADDING (1.0W)	
	1) WALLS (500 SQUARE FEET EFFECTIVE WIND AREA)	
	END ZONES	23.7 PSF
	INTERIOR ZONES	23.7 PSF
	2) ROOF (10 SQUARE FEET EFFECTIVE WIND AREA FOR DECK ATTACHMENT)	
	CORNER ZONES	89.1 PSF
	END ZONES	65.4 PSF
	INTERIOR ZONE 1	49.6 PSF
	INTERIOR ZONE 2	28.5 PSF
	F. WIDTH OF END ZONES, α	18.9 FT
5.	EARTHQUAKE DESIGN DATA	
	A. SEISMIC IMPORTANCE FACTOR, I	1.0
	B. MAPPED SPECTRAL RESPONSE ACCELERATION, Ss	9.9 %
	C. MAPPED SPECTRAL RESPONSE ACCELERATION, S1	6.8 %
	D. SITE CLASS	C
	E. SPECTRAL RESPONSE COEFFICIENT, Sds	0.086
	F. SPECTRAL RESPONSE COEFFICIENT, Sd1	0.068
	G. SEISMIC DESIGN CATEGORY	B
	H. STRUCTURAL SYSTEM (DUAL SYSTEM)	
	1) BASIC SEISMIC FORCE–RESISTING SYSTEM TYPE	H. STEEL SYSTEM
	2) VERTICAL ELEMENT TYPE	1) STEEL SYSTEM NOT SPECIFICALLY DETAILED FOR SEISMIC RESISTANCE
	3) BASIC SEISMIC FORCE–RESISTING SYSTEM TYPE	A. BEARING WALL SYSTEMS
	4) VERTICAL ELEMENT TYPE	2) ORDINARY PRECAST SHEAR WALLS
	5) DESIGN BASE SHEAR, LRFD	0.029 W
	6) SEISMIC RESPONSE COEFFICIENT, Cs	0.029
	7) CONTROLLING RESPONSE MODIFICATION FACTOR, R	3
J.	ANALYSIS PROCEDURE	EQUIVALENT LATERAL FORCE
6.	DEAD LOAD	
	A. EPDM MEMBRANE	0.3 PSF
	B. RIGID INSULATION	0.7 PSF
	C. ROOF DECK	2.0 PSF
	D. LIGHTS, PLUMBING, & HVAC	3.0 PSF
	E. SPRINKLERS	2.0 PSF
	F. STEEL JOISTS	2.0 PSF
	G. STEEL GIRDERS	2.0 PSF
	H. TOTAL DEAD LOAD ON JOISTS	10.0 PSF
	J. TOTAL DEAD LOAD ON COLUMNS	12.0 PSF

GENERAL NOTES

GENERAL

- STRUCTURAL ELEMENTS ARE NON–SELF SUPPORTING AND REQUIRE INTERACTION WITH OTHER ELEMENTS FOR STABILITY AND RESISTANCE TO LATERAL FORCES. FRAMING AND WALLS SHALL BE TEMPORARILY BRACED BY THE CONTRACTOR UNTIL PERMANENT BRACING, ROOF DECKS, AND WALLS HAVE BEEN INSTALLED AND CONNECTIONS BETWEEN THESE ELEMENTS HAVE BEEN MADE.
- THE STRUCTURAL DRAWINGS REPRESENT THE FINISHED STRUCTURE AND DO NOT INDICATE THE METHOD OF CONSTRUCTION, UNLESS NOTED OTHERWISE. THE CONTRACTOR IS SOLELY RESPONSIBLE FOR THE MEANS, METHODS, TECHNIQUES, SEQUENCES, AND OPERATION OF CONSTRUCTION AND SAFETY PRECAUTIONS AND PROGRAMS INCIDENTAL THERETO.
- THE SIZE AND LOCATION OF EQUIPMENT PADS AND PENETRATIONS THROUGH THE STRUCTURE FOR MECHANICAL, ELECTRICAL, AND PLUMBING WORK SHALL BE VERIFIED BY THE CONTRACTOR. PENETRATIONS SHALL BE SUBJECT TO APPROVAL BY THE STRUCTURAL ENGINEER. REFER TO MECHANICAL, ELECTRICAL, AND PLUMBING DRAWINGS FOR OPENING LOCATIONS NOT SHOWN ON THE STRUCTURAL DRAWINGS.
- USE ONLY DIMENSIONS INDICATED ON THE DRAWINGS. DO NOT SCALE DRAWINGS OR USE ANY DIMENSIONS TAKEN FROM ELECTRONIC DRAWING FILES. CONTRACTOR SHALL COORDINATE IN–PLACE DIMENSIONS BASED ON TOLERANCES OF THE RESPECTIVE TRADES.
- ASSUME EQUAL SPACING IF NOT INDICATED ON DRAWINGS.
- THE GENERAL NOTES ARE AN INTEGRAL PART OF THE CONTRACT DOCUMENTS AND SHALL BE USED IN CONJUNCTION WITH THE STRUCTURAL DRAWINGS. WHERE REQUIREMENTS INDICATED ON THE STRUCTURAL DRAWINGS DIFFER FROM THE GENERAL NOTES, NOTIFY THE ARCHITECT AND THE STRUCTURAL ENGINEER.
- THE STRUCTURAL DRAWINGS ARE NOT INTENDED TO BE AN INDEPENDENT SET OF THE CONSTRUCTION DOCUMENTS. SEE ARCHITECTURAL, MEP, CIVIL AND OTHER DRAWINGS FOR INFORMATION RELATED TO THE STRUCTURAL WORK. THE CONTRACTOR SHALL VERIFY COORDINATION OF THE DESIRED DETAILS PRIOR TO CONSTRUCTION AND NOTIFY THE ARCHITECT AND THE STRUCTURAL ENGINEER IF ADDITIONAL COORDINATION IS REQUIRED.
- ARCHITECTURAL, MECHANICAL AND ELECTRICAL COMPONENTS AND SYSTEMS SHALL BE DESIGNED AND CONSTRUCTED TO RESIST SEISMIC FORCES AS DETERMINED IN CHAPTER 13 OF ASCE 7.

FOUNDATIONS

- FOUNDATION DESIGNS, SUBGRADE PREPARATION NOTES, AND STRUCTURAL EARTH MOVING SPECIFICATION ARE BASED ON THE RECOMMENDATIONS PROVIDED IN THE GEOTECHNICAL REPORT, BY: OLSSON, INC. OF 1700 E 123RD ST., OLATHE, KANSAS 64080 (PHONE NO. 913–829–0078) DATED: FEBRUARY 2022.
- FOOTING DESIGNS ARE BASED ON AN ASSUMED STABLE, NON–EXPANSIVE SOIL WITH AN ALLOWABLE FOUNDATION PRESSURE OF 2500 PSF WITH A MAXIMUM DIFFERENTIAL SETTLEMENT OF 3/4 INCH. CONTRACTOR SHALL HIRE A GEOTECHNICAL ENGINEER TO DETERMINE WHETHER OR NOT SOIL MEETS THIS MINIMUM CRITERIA AND IF IT DOES NOT, SHALL NOTIFY ENGINEER SO THAT THE FOUNDATION MAY BE REDESIGNED ACCORDINGLY.
- CONTRACTOR AND TESTING LABORATORY REPRESENTATIVE SHALL READ THE GEOTECHNICAL REPORT AND BECOME THOROUGHLY FAMILIAR WITH SITE AND SUBGRADE INFORMATION GIVEN THEREIN. THE CONTRACTOR SHALL BE RESPONSIBLE FOR DETERMINING EXACT QUANTITIES OF CUT AND FILL FOR ESTIMATING AND CONSTRUCTION. SUBGRADE SHALL BE PREPARED AS NOTED IN THE GEOTECHNICAL REPORT.
- A QUALIFIED AND REGISTERED GEOTECHNICAL ENGINEER, LICENSED IN THE STATE WHERE THE PROJECT IS LOCATED, AND WORKING FOR THE TESTING LABORATORY, SHALL DETERMINE CONFORMANCE OF THE FOUNDATION BEARING STRATA WITH THE FOUNDATION DESIGN CRITERIA ABOVE, AND ALL OTHER CONTRACT DOCUMENTS. TESTING LABORATORY SHALL NOTIFY CONTRACTOR, ARCHITECT AND CONSULTING ENGINEER OF ANY CONDITIONS NOT IN ACCORDANCE WITH FOUNDATION DESIGN CRITERIA OR CONTRACT DOCUMENTS.

- USE ONLY STRUCTURAL FILL MATERIAL AS NOTED IN THE GEOTECHNICAL REPORT FOR FILL BELOW BUILDING AND FIVE FEET BEYOND THE EDGES OF THE BUILDING.
- FOUNDATION WALLS SHALL HAVE ADEQUATE TEMPORARY BRACING INSTALLED BY THE CONTRACTOR BEFORE BACKFILL IS PLACED AGAINST THEM. TEMPORARY BRACING SHALL NOT BE REMOVED UNTIL WALL IS PERMANENTLY BRACED.
- FOOTINGS SHALL BE POURED AGAINST UNDISTURBED SOIL, UNLESS NOTED OTHERWISE.
- AVOID DAMAGE TO UNDERGROUND UTILITIES SUCH AS WATER MAINS, SANITARY SEWERS, BURIED CABLES, ETC., WHICH MIGHT EXTEND ACROSS OR ADJOIN SITE.

CONCRETE

- MINIMUM COMPRESSIVE STRENGTH (f'c) AT THE END OF 28 DAYS SHALL BE AS FOLLOWS:
A. FOOTINGS (GRADE BEAMS) 3000 PSI U.N.O. ON PLAN
B. FOUNDATION WALLS 3000 PSI
C. SLABS–ON–GRADE 4000 PSI
D. CONCRETE WALL PANELS (MINIMUM STRENGTH) 4000 PSI
MAXIMUM WATER/CEMENT RATIO = 0.48 TO 0.50 FOR FOOTINGS AND 0.52 FOR SLABS–ON–GRADE AND PRECAST WALLS PANELS
SLUMP LIMITS = 4" + 1"
CONCRETE SHALL BE NORMAL WEIGHT (145 PCF), UNLESS NOTED OTHERWISE.
CEMENTITIOUS MATERIALS CONTENT SHALL NOT BE LESS THAN 520 POUNDS PER CUBIC YARD. USE OF ANY FLY ASH IN FLOOR SLAB MIXES SHALL BE NO MORE THAN 20%.
AIR–ENTRAINED IS NOT REQUIRED FOR STRUCTURAL CONCRETE.
- AGGREGATES SHALL COMPLY WITH ASTM C 33 AND SHALL BE FREE OF DELETERIOUS MATTER AND SHALL BE MADE OF COARSE LIMESTONE OR GRANITE AGGREGATES.
- MATERIALS OR ADMIXTURES SHALL NOT CONTAIN ANY CALCIUM CHLORIDE. IF ADMIXTURES ARE UTILIZED, THEY SHALL BE COMPATIBLE WITH OTHER ADMIXTURES AND MUST NOT CONTRIBUTE WATER–SOLUBLE CHLORIDE IONS EXCEEDING THOSE PERMITTED IN HARDENED CONCRETE.
- REINFORCING STEEL SHALL MEET THE FOLLOWING:
A. DEFORMED BARS ASTM A615, GRADE 60
B. WELDABLE DEFORMED BARS ASTM A706, GRADE 60
C. WELDED WIRE FABRIC ASTM A185
- WHERE DOWELS ARE INDICATED BUT NOT SIZED, PROVIDE DOWELS THAT MATCH SIZE AND LOCATION OF MAIN REINFORCING STEEL AND LAP SPLICE WITH THE MAIN REINFORCING STEEL. REINFORCING BARS SHALL BE SPLICED AS NOTED IN THE REINFORCING LAP SCHEDULE.
- REFER TO ACI 318 LATEST EDITION FOR CONCRETE COVER, ACI 315 LATEST EDITION FOR DETAILING, FABRICATION, PLACEMENT AND SUPPORT PRACTICES, ACI 347 FOR FORMWORK, ACI 305 FOR HOT WEATHER CONCRETING, ACI 306 FOR COLD WEATHER CONCRETING, AND ACI 301 LATEST EDITION FOR STANDARD PRACTICE FOR MIXING AND PLACING CONCRETE. PROVIDE CONCRETE COVER DIMENSIONS IN SHOP DRAWINGS FOR STRUCTURAL ENGINEER REVIEW.
- "C.J." INDICATES SAW CUT CONTRACTION JOINT OR DOWELED CONSTRUCTION JOINT IN SLAB–ON–GRADE. SLAB POURS SHALL BE SEPARATED BY A DOWELED CONSTRUCTION JOINT. CONTRACTION/CONSTRUCTION JOINTS SHALL BE LOCATED AS SHOWN ON PLANS OR AS DIRECTED BY THE STRUCTURAL ENGINEER.
- PROVIDE CORNER BARS THAT MATCH CONTINUOUS REINFORCEMENT SIZE AND QUANTITY AT INTERSECTIONS AND CORNERS OF FOUNDATIONS.
- REINFORCING BAR SUPPORTS SHALL BE BOLSTERS, CHAIRS, SPACERS AND OTHER DEVICES TO HOLD REINFORCING BARS AND WELDED WIRE REINFORCEMENT IN PLACE. MANUFACTURE BAR SUPPORTS FROM STEEL, PLASTIC OR PRECAST CONCRETE ACCORDING TO CRSI'S "MANUAL OF STANDARD PRACTICE" OF GREATER COMPRESSIVE STRENGTH THAN THE CONCRETE PLACED IN.
- FORM–FACING PANELS THAT WILL BE EXPOSED TO VIEW SHALL BE CONSTRUCTED TO MINIMIZE THE NUMBER OF JOINTS AND SHALL BE MADE OF PLYWOOD, METAL OR OTHER APPROVED PANEL MATERIAL. PLYWOOD MUST COMPLY WITH DOC PS 1 AND BE CLASS 1 OR BETTER.
- CHAMFER EXTERIOR CORNERS AND EDGES OF PERMANENTLY EXPOSED CONCRETE.
- THE CONCRETE SLABS SHOWN ON THE STRUCTURAL DRAWINGS HAVE BEEN DESIGNED FOR THE FINISHED STRUCTURE AND HAVE NOT BEEN DESIGNED FOR MEANS AND METHODS OF CONSTRUCTION, INCLUDING BUT NOT LIMITED TO, FORK LIFTS, MAN LIFTS, AND OTHER VEHICULAR TRAFFIC.
- A VAPOR RETARDER NOT LESS THAN 10 MILS THICK SHALL BE INSTALLED ONLY AT AREAS NOTATED ON THE CONSTRUCTION DOCUMENTS. THE RETARDER SHALL BE INSTALLED PER THE MANUFACTURER'S RECOMMENDATION WITH JOINTS USING THE MANUFACTURER'S RECOMMENDED ADHESIVE OR PRESSURE SENSITIVE JOINT TAPE AND INCLUDING THE MANUFACTURER'S PROPRIETARY PENETRATION FLASHING FOR ALL THROUGH–SLAB PENETRATIONS. LAP VAPOR RETARDER JOINTS 6 INCHES MINIMUM.
- CONCRETE SLABS–ON–GRADE SHALL BE CONSTRUCTED WITH A HARD TROWEL FINISH AND BE FINISHED ACCORDING TO ASTM E 1155 TO ACHIEVE THE MINIMUM TOLERANCES BELOW:
OVERALL VALUES: FF = 50 FL = 35
LOCAL VALUES: FF = 25 FL = 20
- THE CONCRETE SLAB–ON–GRADE SHALL BE CURED WITH AN APPROVED CURING MATERIAL THAT HAS BEEN SUBMITTED AND APPROVED BY THE ARCHITECT AND ENGINEER OF RECORD. THE FLOOR SHALL BE CURED WITH ONE COAT OF HARDENER/DENSIFIER (ASHFORD FORMULA SEALER OR APPROVED ALTERNATE).
- CONTRACTOR SHALL VERIFY ALL DIMENSIONS, OPENINGS, BLOCKOUTS, RECESSES, ELEVATIONS, ANCHOR RODS AND EMBED LOCATIONS PRIOR TO CONCRETE PLACEMENT. THE CONTRACTOR SHALL VERIFY WITH ARCHITECTURAL, STRUCTURAL AND MEP DRAWINGS FOR LOCATIONS OF REQUIRED COORDINATION ITEMS. CONTRACTOR SHALL CONTACT THE ARCHITECT OR ENGINEER IF AN ERROR OR OMISSION OCCURS AFTER CONCRETE PLACEMENT.
- ANCHOR BOLTS AND EMBED PLATES SHALL BE TIED INTO THE REBAR CAGE AND HELD IN PLACE WITH A RIGID TEMPLATE TO PREVENT MOVEMENT DURING CONCRETE PLACEMENT.
- NON–SHRINK GROUT SHALL BE PRE–MIXED, NON–SHRINKING WITH A MINIMUM COMPRESSIBE STRENGTH OF 5000 PSI IN 28 DAYS CONFORMING TO USACE SPECIFICATIONS NO. CRD–C621.

CONCRETE WALL PANELS

- THE STRUCTURAL DRAWINGS REPRESENT THE REQUIRED FINAL IN PLACE LOADINGS FOR THE CONCRETE WALL PANELS. THE PANELS SHALL BE DESIGNED BY THE TILT–UP SUPPLIER FOR THE FINAL IN PLACE LOADINGS ALONG WITH BEING DESIGNED FOR ERECTION STRESSES, TEMPORARY BRACING OR LIFTING OF THE WALL PANELS. WALL PANELS SHALL BE DESIGNED AND DETAILED TO ADHERE TO ALL LOCAL CODES.
- THE CONTRACTOR SHALL PROVIDE SHOP DRAWINGS FOR THE TILT–UP WALL PANELS. SHOP DRAWINGS SHALL INCLUDE CALCULATIONS FOR FINAL IN PLACE LOADINGS, ERECTION, LIFTING AND TEMPORARY BRACING OF THE WALL PANELS ALONG WITH ANY OTHER ADDITIONAL CONSTRUCTION CONSIDERATIONS. SHOP DRAWINGS AND CALCULATIONS FOR THE CONSTRUCTION CONSIDERATIONS SHALL BE DESIGNED, SEALED AND SIGNED BY A PROFESSIONAL ENGINEER LICENSED IN THE STATE WHERE THE PROJECT IS LOCATED. DESIGN CALCULATIONS SHALL SHOW STRESSES IN THE PANELS FOR THE LOADS PRESCRIBED IN THE CONSTRUCTION DOCUMENTS ALONG WITH THERMAL DIFFERENTIAL AND ERECTION AND LIFTING FORCES. THE DEFERRED SUBMITTAL DOCUMENTS SHALL BE SUBMITTED TO THE ARCHITECT OR ENGINEER OF RECORD WHO SHALL REVIEW THEM AND FORWARD THEM TO THE BUILDING OFFICIAL AS REQUESTED WITH A NOTATION INDICATING THAT THE DEFERRED SUBMITTAL DOCUMENTS HAVE BEEN REVIEWED AND BEEN FOUND TO BE IN GENERAL CONFORMANCE TO THE DESIGN OF THE BUILDING. THE DEFERRED SUBMITTAL ITEMS SHALL NOT BE INSTALLED UNTIL THE DESIGN AND SUBMITTAL DOCUMENTS HAVE BEEN APPROVED BY THE BUILDING OFFICIAL.
- THE CONTRACTOR SHALL VERIFY THAT THE PROPOSED TILT–UP WALL PANELS ARE CAPABLE OF MEETING THE FINAL IN PLACE AND ERECTION REQUIREMENTS PRIOR TO BEGINNING THE WORK. ANY DEVIATIONS FROM THE WALL PANELS SHOWN ON THE STRUCTURAL DRAWINGS SHALL BE QUALIFIED IN THE CONTRACTOR'S BID.
- THE CONTRACTOR SHALL PROVIDE ADEQUATE VERTICAL AND LATERAL SYSTEM COMPONENTS TO SUPPORT THE LOADINGS STIPULATED IN THE CONSTRUCTION DOCUMENTS. THE FOUNDATIONS HAVE BEEN DESIGNED BASED ON THESE LOADING REQUIREMENTS. ANY DEVIATIONS IN THE LOADINGS SHALL BE APPROVED BY THE ENGINEER OF RECORD PRIOR TO PROCEEDING.
- THE CONCRETE WALL PANELS SHALL CONFORM TO ACI 301, ACI 318, ACI 551, CONCRETE REINFORCING STEEL INSTITUTE (CRSI) "MANUAL OF STANDARD PRACTICE", AND AWS D1.4 STRUCTURAL WELDING CODE FOR REINFORCING STEEL. SEE THE CONCRETE GENERAL NOTES FOR ADDITIONAL CONFORMANCE SPECIFICATIONS.
- SEE THE CONCRETE GENERAL NOTES AND SPECIFICATIONS FOR MIX DESIGN DATA AND REQUIREMENTS.
- THE TILT–UP WALL PANEL SHALL ADHERE TO THE MECHANISMS SET FORTH IN THE STRUCTURAL CONSTRUCTION DOCUMENTS. ADDITIONALLY, THE DESIGN SHALL INCLUDE ALL BOLTS, EMBEDMENT PLATES, BLOCKOUTS, FUTURE KNOCKOUT PANEL LOCATIONS, BRACING AND SUPPORTING STRUCTURE.
- SEE THE STEEL GENERAL NOTES AND SPECIFICATIONS FOR SECTION PROPERTY REQUIREMENTS. ALL STEEL SHAPES, PLATES, ANCHORS, BOLTS, NUTS AND WASHERS SHALL BE HOT DIP GALVANIZED AFTER FABRICATION.
- CAST–IN–PLACE ANCHORS SHALL BE HEADED STUDS OR DEFORMED BAR ANCHORS. ASTM 615 REINFORCING BARS SHALL NOT BE USED AS ANCHORS.
- ALL WELDS SHALL BE PERFORMED BY A AWS CERTIFIED WELDER AND IN ACCORDANCE WITH AWS D1.1 "STRUCTURAL WELDING CODE" AND AWS D1.4 "STRUCTURAL WELDING CODE FOR REINFORCING STEEL". ALL WELDS SHALL BE PAINTED WITH ZINC RICH REPAIR PAINT AFTER WELDING.
- ALL WELDS FOR DEFORMED BAR ANCHORS SHALL USE E90XX ELECTRODES.
- PROVIDE BEARING PADS AND GROUT MATERIALS AS REQUIRED PER CODE AND INDUSTRY STANDARDS.
- COORDINATE WITH THE ARCHITECTURAL DRAWINGS AND SPECIFICATIONS ANY ADDITIONAL REQUIREMENTS FOR DIMENSIONS, FINISH, REVEALS AND ANY OTHER REQUIREMENTS OF THE CONCRETE WALL PANELS.

- CONTRACTOR SHALL ERECT THE CONCRETE WALL PANELS SUCH THAT IT IS SAFE FOR PERSONNEL AND PROPERTY AND PROVIDE BRACING TO PROTECT THE PANELS AGAINST WIND, SEISMIC AND FORCES THAT MAY OCCUR THROUGHOUT THE CONSTRUCTION PROCESS. TEMPORARY BRACING SHALL REMAIN IN PLACE UNTIL ALL PERMANENT BRACING, DECKING, CONNECTIONS AND WALL PANELS HAVE BEEN FULLY INSTALLED.
- CONCRETE WALL PANELS SHALL BE ERECTED TO ADHERE TO THE TOLERANCES OF THE LATEST AMERICAN CONCRETE INSTITUTE SPECIFICATIONS. ERECTION TOLERANCES SHALL BE COORDINATED WITH THE STEEL SUPPLIER TO PROVIDE PROPER FIT–UP. DEFLECTIONS OF THE STRUCTURAL STEEL SYSTEM MAY OCCUR DURING CONCRETE WALL PANEL ERECTION. THESE DEFLECTIONS MAY REQUIRE ADJUSTMENT AND RESETTING OF CONCRETE WALL PANELS IN ORDER TO MEET THE TOLERANCES. THE CONTRACTOR SHALL BE AWARE OF THIS ITERATION PROCESS IN HIS BID AND IS RESPONSIBLE FOR THE TOLERANCES BEING MET.
- THE CONCRETE SLABS SHOWN ON THE STRUCTURAL DRAWINGS HAVE BEEN DESIGNED FOR THE FINISHED STRUCTURE AND HAVE NOT BEEN DESIGNED FOR CRANE USE AND CONCRETE WALL PANEL BRACING. THE CONTRACTOR SHALL VERIFY THE SLAB ADEQUACY AND SUBMIT PROPOSED DESIGNED, IF REQUIRED, TO THE STRUCTURAL ENGINEER FOR REVIEW.
- ALL CONCRETE WALL PANELS COMPONENTS SHALL ADHERE TO THE DETAILING, FABRICATION AND ERECTION REQUIREMENTS OF THE LATEST EDITIONS OF ACI 301 (SPECIFICATIONS FOR CONCRETE), ACI 318 (STRUCTURAL CONCRETE BUILDING CODE), AWS D1.4 (WELDING CODE FOR REINFORCING STEEL), CRSI (MANUAL OF STANDARD PRACTICE), PCI MNL 116 (MANUAL FOR QUALITY CONTROL FOR PLANS AND PRODUCTION OF PRECAST CONCRETE PRODUCTS), PCI MNL 120 (PCI DESIGN HANDBOOK) AND PCI MNL 135 (TOLERANCE MANUAL FOR PRECAST PRESTRESSED CONCRETE CONSTRUCTION).
- CONCRETE WALL PANELS SHALL PROVIDE EXPANSIONS JOINTS AT THE ROOF EXPANSION JOINT TO ALLOW FOR THERMAL EXPANSION AND CONTRACTION. ADDITIONALLY, THE PRECAST SUPPLIER SHALL ALLOW FOR DIFFERENTIAL MOVEMENT BETWEEN WALL PANELS BY ALLOWING EXPANSION EVERY FIFTH WALL PANEL.
- CONCRETE WALL PANELS SHALL BE SOLID CORE BELOW FINISH FLOOR ELEVATION.

STRUCTURAL STEEL

- STRUCTURAL STEEL SHALL MEET THE FOLLOWING MINIMUM YIELD STRESS (Fy), UNLESS NOTED OTHERWISE:
YIELD ASTM SPECIFICATION
A. W, WT SHAPES: 50 KSI A992
B. BARS, PLATES, CHANNELS, ANGLES: 36 KSI A36
C. SQUARE, RECTANGULAR HSS: 50 KSI A500, GRADE C
D. ANCHOR RODS: 36 KSI OR 55 KSI F1554
E. ALL–THREAD RODS: 36 KSI A36
F. HEADED STUD ANCHORS: 65 KSI TENSILE STRESS A108, GRADES 1010–1020
- ALL STRUCTURAL STEEL SHALL ADHERE TO THE DETAILING, FABRICATION AND ERECTION REQUIREMENTS OF THE LATEST EDITIONS OF THE AISC SPECIFICATION FOR STRUCTURAL STEEL BUILDINGS AND THE AISC CODE OF PRACTICE.
- BOLTS FOR STEEL BEAM AND COLUMN CONNECTIONS SHALL BE 3/4-INCH DIAMETER ASTM A325–N HIGH–STRENGTH BOLTS UNLESS NOTED OTHERWISE. ALL BOLTED CONNECTIONS ARE BEARING TYPE AND SHALL BE SNUG TIGHTENED UNLESS NOTED OTHERWISE. FOR PRETENSIONED OR SLIP–CRITICAL JOINTS, THE METHOD OF INSTALLATION SHALL BE TURN–OF–NUT WITH MATCH MARKING, TWIST–OFF–TYPE TENSION CONTROL BOLT ASSEMBLIES (ASTM F1852), OR DIRECT TENSION INDICATORS (ASTM F959).
- WELDING SHALL MEET ANSI / AWS D1.1, STRUCTURAL WELDING CODE LATEST REVISION. ELECTRODES SHALL BE E70XX, LOW HYDROGEN. ALL STRUCTURAL STEEL WELDS SHALL BE PERFORMED BY A AWS CERTIFIED WELDER.
- WELDS NOT SPECIFICALLY SIZED ON THE STRUCTURAL DRAWINGS SHALL BE THE MINIMUM SIZE PER THE LATEST AWS D1.1.
- PROVIDE DOUBLE NUTS AND DOUBLE WASHERS FOR STEEL COLUMN ANCHOR BOLTS TO ALLOW FOR ADJUSTMENT IN BASE PLATE ELEVATION. PROVIDE 1 1/2 INCH NON–SHRINK GROUT UNDER BASE PLATE AFTER ERECTION. USE 2 1/2 INCHES NON–SHRINK GROUT WHEN COLUMN ANCHOR BOLTS ARE 1 1/4 INCH DIAMETER OR LARGER. NON–SHRINK GROUT SHALL BE NON–METALLIC WITH A MINIMUM COMPRESSIVE STRENGTH OF 5,000 PSI AT 28 DAYS.
- SHEAR CONNECTORS SHALL BE A CARBON STEEL HEADED STUD TYPE ASTM A108 GRADES 1010 THRU 1020, AWS D1.1, TYPE B WITH ARC SHIELDS.
- ALL CONNECTIONS ON THE STRUCTURAL DRAWINGS, UNLESS NOTED OTHERWISE, SHALL BE DESIGNED AND DETAILED BY A PROFESSIONAL ENGINEER LICENSED IN THE STATE WHERE THE PROJECT IS LOCATED, EMPLOYED OR RETAINED BY THE STEEL FABRICATOR. THE DESIGN AND DETAILING SHALL COMPLY WITH ALL APPLICABLE CODES AND SPECIFICATION SECTIONS.
- THE GENERAL CONTRACTOR SHALL BE RESPONSIBLE FOR INCLUDING THE COSTS FOR ALL MISCELLANEOUS STEEL IN THEIR BID REGARDLESS OF WHETHER THOSE ITEMS ARE INDICATED ON THE STRUCTURAL DRAWINGS. THESE COSTS SHALL INCLUDE BUT ARE NOT LIMITED TO MISCELLANEOUS STEEL ITEMS SHOWN ON ARCHITECTURAL, CIVIL, MECHANICAL, PLUMBING AND ELECTRICAL DRAWINGS SUCH AS SHELF ANGLES, GLAZING SUPPORTS AND LINTELS.
- LEDGER ANGLES AND LINTELS IN EXTERIOR WALL SYSTEMS SHALL BE HOT DIPPED GALVANIZED PER ASTM A123.
- ALL STRUCTURAL STEEL SHALL HAVE A COAT OF LIGHT GRAY PAINT TO PROVIDE PROTECTION AND GOOD APPEARANCE.

STEEL JOISTS

- STEEL JOISTS SHALL BE AS INDICATED ON THE PLANS AND SHALL BE IN ACCORDANCE WITH THE LATEST SPECIFICATIONS OF THE STEEL JOIST INSTITUTE (SJI) AND MEET THE FOLLOWING:
A. JOISTS SHALL BE DESIGNED FOR THE UNIFORM LOAD CAPACITY (AS SPECIFIED IN THE SJI STANDARD LOAD TABLES) IN ADDITION TO THE CONCENTRATED LOADS SHOWN ON PLANS AND DETAILS.
B. JOISTS THAT SUPPORT CONCENTRATED LOADS SHALL HAVE THEIR CHORDS DESIGNED TO WITHSTAND ALL BENDING STRESSES, OR THE LOADS SHALL OCCUR WITHIN 3 INCHES OF JOIST PANEL POINTS, OR THE JOIST SHALL BE REINFORCED PER THE "JOIST REINFORCING DETAIL" SHOWN HEREIN. CONCENTRATED LOADS SHALL BE CENTERED ON JOISTS AND NOT ATTACHED TO THE EDGE OF CHORD ANGLES.
C. JOISTS SHALL RESIST THE NET UPLIFT PRESSURE AS INDICATED ON THE DETAILS 7 & 8/S4.1. THIS PRESSURE SHALL ACT ALONE. AN ALLOWABLE STRESS INCREASE IS NOT PERMITTED.
D. FOR ALL MEMBERS THAT REQUIRE SPECIFIC ORIENTATION, PROVIDE TAG AT ONE END AND DEFINE LOCATION OF TAGGED END ON ERECTION DRAWINGS.
E. JOIST MANUFACTURER SHALL DETERMINE THE SEAT DEPTH AND WIDTH OF BEARING AND COORDINATE THE SAME WITH THE STEEL FABRICATOR. THE FOLLOWING SEAT DEPTHS ARE ASSUMED ON THE DRAWINGS: 2 1/2 INCHES FOR K–SERIES JOISTS, 5 INCHES FOR LH SERIES JOISTS).
F. JOISTS SHALL BE FABRICATED TO PROVIDE OPENINGS FOR DUCTS AS SHOWN IN THE REQUIRED OPENING IN JOIST DETAIL.
- K–SERIES AND LH–SERIES JOISTS SHALL BE WELDED TO SUPPORTING STEEL WITH MINIMUM 1/8 INCH FILLET WELDS 2 INCHES LONG EACH SIDE OR WITH TWO 1/2 INCH DIAMETER ASTM A307 BOLTS OR THE EQUIVALENT, UNLESS NOTED OTHERWISE. WHEN NEAR OR AT A COLUMN, BOLT JOIST TO SUPPORTING STEEL IN CONFORMANCE WITH OSHA.
- JOIST BRIDGING AND ERECTION STABILITY SHALL BE PROVIDED IN ACCORDANCE WITH THE OCCUPATIONAL SAFETY AND HAZARD ADMINISTRATION (OSHA) AND THE SPECIFICATIONS OF THE STEEL JOIST INSTITUTE (SJI).
- JOIST RTU LOADS ARE PROVIDED ON THE ROOF FRAMING PLAN, REFERENCE PLANS AND DETAILS FOR LOAD LOCATIONS, VALUES AND SUPPORT FRAMING.
- JOIST MANUFACTURER SHALL DESIGN THE COMPRESSION CHORD OF ALL JOISTS SUPPORTING ROOF TOP UNITS, SKY LIGHTS, AND OTHER STRUCTURES FOR AN UNBRACED LENGTH APPLICABLE TO THE CONDITIONS AT THE PROJECT WHERE THE UNBRACED LENGTH IS GREATER THAN THE SJI MAXIMUM. (REFERENCE ARCHITECTURAL AND MECHANICAL DRAWINGS)
- DESIGN JOISTS FOR INTERNAL ROOF DRAINLINE AND FIRE SPRINKLER LINE LOCATIONS, IF REQUIRED, ADD 50 PLF FOR 8 INCH DIAMETER AND SMALLER, ADD 75 PLF FOR 10 INCH DIAMETER, ADD 102 PLF FOR 12 INCH DIAMETER, ADD 122 PLF FOR 14 INCH DIAMETER, ADD 200 PLF FOR 18 INCH DIAMETER. REFERENCE MECHANICAL DRAWINGS FOR EXACT LOCATION. CONTRACTOR SHALL OBTAIN FIRE LINE LOCATIONS AND SIZES PRIOR TO SUBMITTAL OF JOIST SHOP DRAWINGS.
- JOIST DESIGNS SHALL BE PERFORMED BY A PROFESSIONAL ENGINEER LICENSED IN THE STATE WHERE THE PROJECT IS LOCATED, EMPLOYED OR RETAINED BY THE JOIST MANUFACTURER.
- SHOP DRAWING SHALL BE REVIEWED BY THE ARCHITECT AND STUCTURAL ENGINEER OF RECORD PRIOR TO JOIST FABRICATION.
- PROVIDE JOISTS CAPABLE OF WITH STANDING DESIGN LOADS INDICATED WITH LIVE LOAD DEFLECTIONS NO GREATER THAN L/240 OF THE SPAN.
- JOISTS SHALL BE CAMBERED ACCORDING TO SJI'S "SPECIFICATIONS". JOIST AND JOIST GIRDERS SHALL BE SHOP PRIMED WITH MANUFACTURER'S STANDARD SHOP PRIMER.

STEEL DECK

- ROOF DECK
A. ROOF DECK SHALL BE GALVANIZED TYPE "B". DEPTH SHALL BE AS SHOWN ON DRAWINGS. ROOF DECK SHALL BE BOTTOM PRIMED WHITE
B. ROOF DECK IS REQUIRED TO ACT AS A DIAPHRAGM. CONNECTIONS SHALL BE IN ACCORDANCE WITH STEEL DECK INSTITUTE SPECIFICATIONS. REFER TO THE ROOF DIAPHRAGM CONNECTION DIAGRAM FOR ATTACHMENT.
C. DECKING SHALL BE CONTINUOUS OVER A MINIMUM OF (3) SPANS UNLESS NOTED OTHERWISE.
D. NO HANGING LOADS SHALL BE ATTACHED TO ROOF DECK.



CURRAN

ARCHITECTURE

5719 LAWTON LOOP E. DR. #212
INDIANAPOLIS, IN 46216
O :: 317 . 288 . 0681
F :: 317 . 288 . 0753



SCANNELL
PROPERTIES

wallace



Wallace Engineering
Structural Consultants, Inc.

Structural and Civil Consultants
1741 McGee Street
Kansas City, Missouri 64108
816.421.8282, Fax 816.421.8338

CERTIFICATION



12/13/2022
Missouri COA #001268

THIS DRAWING AND THE IDEAS, DESIGNS
AND CONCEPTS CONTAINED HEREIN ARE
THE EXCLUSIVE INTELLECTUAL PROPERTY
OF CURRAN ARCHITECTURE, AND ARE NOT
TO BE USED OR REPRODUCED, WHOLE OR
IN PART, WITHOUT THE WRITTEN
CONSENT OF CURRAN ARCHITECTURE.
© COPYRIGHT 2021, CURRAN ARCHITECTURE

PROJECT INFORMATION

LEE'S SUMMIT LOGISTICS
BUILDING A LOT I

NW CORNER TUDOR RD & MAINST
LEE'S SUMMIT, MO

ISSUE DATES

ISSUE	DATE
ISSUE FOR PERMIT	02.18.2022
ISSUE FOR PERMIT	04.15.2022

210300

S0.1

GENERAL NOTES

POST INSTALLED ANCHORS:

- ANCHORS SHALL ONLY BE INSTALLED WHERE SPECIFIED ON THE CONTRACT DRAWINGS. THE CONTRACTOR SHALL OBTAIN APPROVAL FROM THE STRUCTURAL ENGINEER PRIOR TO INSTALLING POST INSTALLED ANCHORS IN PLACE OF MISSING OR MIS-PLACED CAST-IN-PLACE ANCHORS. CARE SHALL BE TAKEN IN PLACING POST-INSTALLED ANCHORS TO AVOID CONFLICTS WITH EXISTING REINFORCING.
- THE CONTRACTOR SHALL SUBMIT PRODUCT DATA WITH DESIGN VALUES AND PHYSICAL PROPERTIES FOR ALL POST INSTALLED ANCHORS. ADDITIONALLY, THE CONTRACTOR SHALL SUBMIT CERTIFIED ICC ES OR ESR REPORTS WHICH VERIFY COMPLIANCE WITH THE SPECIFIED CRITERIA.
- SUBSTITUTION REQUESTS FOR PRODUCTS OTHER THAN THOSE SPECIFIED ON THE CONTRACT DRAWINGS SHALL BE SUBMITTED BY THE CONTRACTOR TO THE STRUCTURAL ENGINEER ALONG WITH CALCULATIONS THAT ARE SIGNED AND SEALED BY A QUALIFIED PROFESSIONAL ENGINEER RESPONSIBLE FOR THEIR PREPARATION AND LICENSED IN THE STATE WHERE THE PROJECT IS LOCATED. THE CALCULATIONS SHALL DEMONSTRATE THAT THE SUBSTITUTED PRODUCT IS CAPABLE OF ACHIEVING THE PERTINENT EQUIVALENT PERFORMANCE VALUES OF THE SPECIFIED PRODUCT USING THE APPROPRIATE DESIGN PROCEDURE AND/OR STANDARDS AS REQUIRED BY THE BUILDING CODE.
- ALL HOLES SHALL BE DRILLED, DRY AND CLEANED AND ANCHORS SHALL BE INSTALLED IN ACCORDANCE PER ANCHOR MANUFACTURER'S WRITTEN SPECIFICATIONS. THE LATEST VERSION OF THE WRITTEN SPECIFICATION SHALL BE ON-SITE AND FOLLOWED DURING THE INSTALLATION OF THE ANCHORS.
- THE ANCHOR EMBEDMENT DEPTH SHALL BE DEFINED AS THE DEPTH FROM THE SURFACE FACE OF THE LOAD BEARING BASE MATERIAL TO THE DEEPEST PART OF THE ANCHOR AFTER THE ANCHOR HAS BEEN DRIVEN INTO THE HOLE, BUT NOT YET EXPANDED, IF APPLICABLE.
- ANCHORS AT ALL WEATHER EXPOSED LOCATIONS SHALL BE STAINLESS STEEL.
- NON-EPOXY BASED ADHESIVES SHALL BE USED WHEN BASE MATERIAL TEMPERATURE IS BELOW 40 DEGREES FAHRENHEIT.
- THE FOLLOWING CONCRETE MECHANICAL ANCHORS ARE ALLOWED FOR USE IN CRACKED AND UNCRACKED CONCRETE AND HAVE BEEN TESTED AND QUALIFIED FOR USE IN ACCORDANCE WITH ACI 355.2 AND ICC-ES AC193.
 - SIMPSON STRONG-TIE "STRONG BOLT 2" (ICC-ES ESR-3037)
 - SIMPSON STRONG-TIE "TITEN HD" (ICC-ES ESR-2713)
 - HILTI "KWIK BOLT TZ" EXPANSION ANCHOR (ICC-ES ESR 1917)
 - HILTI "HSL-3" HEAVY DUTY EXPANSION ANCHOR (ICC-ES ESR 1545)
 - HILTI "HDA" UNDERCUT ANCHOR (ICC-ES ESR 1546)
 - HILTI "KWIK HUS EZ" EXPANSION ANCHOR (ICC-ES ESR 3027)
- THE FOLLOWING CONCRETE ADHESIVE ANCHORS ARE ALLOWED FOR USE IN CRACKED AND UNCRACKED CONCRETE AND HAVE BEEN TESTED AND QUALIFIED FOR USE IN ACCORDANCE WITH ACI 355.4 AND ICC-ES AC308.
 - SIMPSON STRONG-TIE "SET-XP" (ICC-ES ESR-2508)
 - HILTI "HIT-HY200" (ICC-ES ESR-1385)
 - HILTI "HIT-RE 500 V3" (ICC-ES ESR-3814)

MASONRY

- CONCRETE MASONRY UNITS SHALL MEET ASTM SPECIFICATION C90, WITH A MINIMUM UNIT COMPRESSIVE STRENGTH = 1900 PSI. THE SPECIFIED DESIGN COMPRESSIVE STRENGTH OF THE CONCRETE MASONRY ASSEMBLY (f'm) SHALL BE 1900 PSI.
- MORTAR SHALL BE A PREBLENDED DRY MIX CONFORMING TO ASTM C1714 AND MEETING THE PROPERTY SPECIFICATIONS OF ASTM C270 TYPE "S" MORTAR FOR BELOW GRADE. TYPE "N" MORTAR FOR ABOVE GRADE. MASONRY CEMENT SHALL NOT BE USED FOR MORTAR.
- GROUT SHALL MEET ASTM SPECIFICATION C476 AND HAVE A MINIMUM 28 DAY COMPRESSIVE STRENGTH OF 2000 PSI.
 - LIMIT THE HEIGHT OF VERTICAL GROUT POURS TO 4'-0" OR THE DISTANCE BETWEEN BOND BEAMS, WHICHEVER IS LESS.
 - GROUTING SHALL BE A CONTINUOUS PROCEDURE FOR EACH LIFT. DO NOT ALLOW HORIZONTAL CONSTRUCTION JOINT TO FORM BY DISCONTINUING GROUTING.
 - VERTICAL GROUT POUR EXCEEDING 12 INCHES SHALL BE MECHANICALLY CONSOLIDATED USING A VIBRATOR WITH A MAXIMUM 3/4 INCH DIAMETER HEAD.
- CONTRACTOR SHALL CLEAN THE GROUT SPACES SUCH THAT THEY ARE FREE OF MORTAR DROPPINGS, DEBRIS, LOOSE AGGREGATES AND ANY MATERIAL THAT WOULD PREVENT CONTINUITY OF THE GROUT.
- HORIZONTAL JOINT REINFORCEMENT SHALL BE LADDER TYPE. JOINT REINFORCEMENT SHALL BE SPACED AT 8 INCHES ON CENTER BELOW FINISHED FLOOR AND IN PARAPETS, AND 16 INCHES ON CENTER ABOVE FINISHED FLOOR.
- CONCRETE MASONRY SHALL BE LAID IN RUNNING BOND.
- CONCRETE MASONRY BELOW FINISHED FLOOR SHALL BE NORMAL WEIGHT UNITS AND SHALL HAVE ALL THE CELLS FULLY GROUTED. CONCRETE MASONRY ABOVE FINISHED FLOOR SHALL BE MEDIUM WEIGHT AND IS TO BE GROUTED ONLY AT REINFORCED CELLS AND BOND BEAMS, UNLESS NOTED OTHERWISE. ALL CELLS WITH REINFORCING OR EMBEDDED ITEMS SHALL BE GROUTED SOLID.
- REFERENCE WALL SECTIONS AND DETAILS FOR MISCELLANEOUS BOND BEAM LOCATIONS AND EMBEDDED ITEMS. USE OPEN KNOCK OUT BOND BEAM BLOCK. DO NOT USE TROUGH TYPE BLOCKS FOR BOND BEAMS. DO NOT CONTINUE BOND BEAM REINFORCING THROUGH CONTROL JOINTS, UNLESS NOTED OTHERWISE.
- REINFORCING STEEL SHALL MEET ASTM SPECIFICATION A615, GRADE 60. REINFORCING STEEL SHALL BE SPLICED AS NOTED IN THE REINFORCING LAP SCHEDULE.
- PROVIDE TEMPORARY BRACING FOR WALLS, LINTELS, AND OTHER MASONRY DURING ERECTION. BRACING SHALL BE DESIGNED IN ACCORDANCE WITH THE MASON CONTRACTORS ASSOCIATION OF AMERICA STANDARD PRACTICE FOR BRACING MASONRY WALLS UNDER CONSTRUCTION. DESIGN SHALL BE PERFORMED BY AN ENGINEER LICENSED IN THE STATE WHERE THE PROJECT IS LOCATED. BRACING SHALL REMAIN UNTIL ROOFING AND OTHER STRUCTURAL ELEMENTS ARE COMPLETE AND PROVIDE PERMANENT STABILITY.

DEFERRED STRUCTURAL SUBMITTALS

- THE FOLLOWING STRUCTURAL COMPONENTS SHALL BE DESIGNED AND SUBMITTED BY OTHERS FOR APPROVAL IN ACCORDANCE WITH DRAWINGS AND SPECIFICATIONS.
 - STRUCTURAL STEEL CONNECTIONS OF FRAMING AND BRACING ELEMENTS
 - STEEL JOISTS AND JOIST GIRDERS (CONTRACTOR SHALL OBTAIN FIRE LINE LOCATIONS AND SIZES PRIOR TO SUBMITTAL OF JOIST SHOP DRAWINGS.)
 - STEEL, SELF-SUPPORTING STAIRS AND HANDRAIL FRAMING
 - STOREFRONT AND CURTAINWALL FRAMING, ACCESSORIES AND ATTACHMENTS TO STRUCTURE
 - EXCAVATION SUPPORT
 - TEMPORARY BRACING AND SUPPORT
 - CONCRETE WALL PANEL REINFORCING
 - ROOF ACCESS LADDERS AND SAFETY CAGES
 - SEISMIC ANCHORAGE AND BRACING OF MEP COMPONENTS
- DOCUMENTS FOR DEFERRED STRUCTURAL SUBMITTAL ITEMS SHALL BE DESIGNED, SEALED AND SIGNED BY A PROFESSIONAL ENGINEER LICENSED IN THE STATE WHERE THE PROJECT IS LOCATED. THE DEFERRED SUBMITTAL DOCUMENTS SHALL BE SUBMITTED TO THE ARCHITECT OR ENGINEER OF RECORD WHO SHALL REVIEW THEM AND FORWARD THEM TO THE BUILDING OFFICIAL AS REQUESTED WITH A NOTATION INDICATING THAT THE DEFERRED SUBMITTAL DOCUMENTS HAVE BEEN REVIEWED AND BEEN FOUND TO BE IN GENERAL CONFORMANCE TO THE DESIGN OF THE BUILDING. THE DEFERRED SUBMITTAL ITEMS SHALL NOT BE INSTALLED UNTIL THE DESIGN AND SUBMITTAL DOCUMENTS HAVE BEEN APPROVED BY THE BUILDING OFFICIAL.

SHOP DRAWINGS

- SHOP DRAWINGS AND SUBMITTALS SHALL BE REVIEWED AND APPROVED BY THE CONTRACTOR PRIOR TO SUBMITTAL FOR THE ENGINEER'S REVIEW. THE STRUCTURAL ENGINEER'S REVIEW IS TO CHECK THE GENERAL CONFORMANCE OF THE SHOP DRAWINGS WITH THE CONTRACT DOCUMENTS. THE CONTRACTOR IS RESPONSIBLE FOR ANY ALTERATIONS FROM THE CONTRACT DOCUMENTS WHICH MAY INCLUDE QUANTITIES, DIMENSIONAL ERRORS OR OTHER ERRORS AND OMISIONS IN THE SHOP DRAWINGS.
- SHOP DRAWINGS SHALL NOT BE REPRODUCTIONS OF THE CONTRACT DOCUMENTS.
- THE FOLLOWING STRUCTURAL COMPONENTS SHALL BE SUBMITTED AS A SHOP DRAWING FOR REVIEW:
 - CONCRETE MIX DESIGN AND MATERIALS
 - CONCRETE REINFORCING STEEL
 - CONCRETE FORMWORK
 - STRUCTURAL STEEL
 - STEEL JOISTS
 - STEEL ROOF DECK AND THEIR ATTACHMENTS.
 - ALL DEFERRED SUBMITTAL ITEMS

SPECIAL INSPECTIONS

- THE OWNER SHALL EMPLOY ONE OR MORE SPECIAL INSPECTORS TO PROVIDE INSPECTIONS DURING CONSTRUCTION ON THE TYPES OF WORK LISTED IN THE STATEMENT OF SPECIAL INSPECTIONS PER SECTION 1704 OF THE IBC. THE SPECIAL INSPECTOR SHALL BE A QUALIFIED PERSON WHO SHALL DEMONSTRATE COMPETENCE, TO THE SATISFACTION OF THE BUILDING OFFICIAL, FOR INSPECTION OF THE PARTICULAR TYPE OF CONSTRUCTION OR OPERATION REQUIRING SPECIAL INSPECTION. THESE INSPECTIONS ARE IN ADDITION TO THE INSPECTIONS SPECIFIED IN THE PROJECT SPECIFICATIONS.
- SPECIAL INSPECTORS SHALL KEEP RECORDS OF INSPECTIONS. THE SPECIAL INSPECTOR SHALL FURNISH INSPECTION REPORTS TO THE BUILDING OFFICIAL, AND TO THE REGISTERED DESIGN PROFESSIONAL IN RESPONSIBLE CHARGE. REPORTS SHALL INDICATE THAT WORK INSPECTED WAS DONE IN CONFORMANCE TO APPROVED CONSTRUCTION DOCUMENTS. DISCREPANCIES SHALL BE BROUGHT TO THE IMMEDIATE ATTENTION OF THE CONTRACTOR FOR CORRECTION. IF THE DISCREPANCIES ARE NOT CORRECTED, THE DISCREPANCIES SHALL BE BROUGHT TO THE ATTENTION OF THE BUILDING OFFICIAL AND TO THE REGISTERED DESIGN PROFESSIONAL IN RESPONSIBLE CHARGE PRIOR TO COMPLETION OF THAT PHASE OF WORK. A FINAL REPORT DOCUMENTING REQUIRED SPECIAL INSPECTIONS AND CORRECTION OF ANY DISCREPANCIES NOTED IN THE INSPECTIONS SHALL BE SUBMITTED AT A POINT IN TIME AGREED UPON BY THE PERMIT APPLICANT AND THE BUILDING OFFICIAL PRIOR TO THE START OF WORK.
- THE CONTRACTOR IS RESPONSIBLE FOR NOTIFYING THE SPECIAL INSPECTOR REGARDING INDIVIDUAL INSPECTION FOR ITEMS LISTED ON THE STATEMENT OF SPECIAL INSPECTIONS AND AS NOTED ON THE BUILDING DEPARTMENT APPROVED PLANS. ADEQUATE NOTICE AND ACCESS TO APPROVED PLANS SHALL BE PROVIDED SO THAT THE SPECIAL INSPECTOR HAS TIME TO BECOME FAMILIAR WITH THE PROJECT.
- FABRICATORS OF STRUCTURAL LOAD-BEARING MEMBERS AND ASSEMBLIES SHALL CONFORM TO THE REQUIREMENTS OF SECTION 1704.2 OF THE IBC.
- THE FOLLOWING ITEMS REQUIRE SPECIAL INSPECTION PER SECTION 1700 OF THE REFERENCED BUILDING CODE.

- BOLTS & ANCHORS EMBEDDED IN CONCRETE
- PLACEMENT OF REINFORCING STEEL IN CONCRETE
- CONCRETE MIX DESIGN
- CONCRETE FORMWORK
- STRUCTURAL STEEL FABRICATIONS
- STRUCTURAL STEEL BOLTING AND WELDING
- ON SITE STRUCTURAL FRAMING
- INSPECTION OF ROOF DECK ATTACHMENTS
- SHEAR WALL ATTACHMENTS AND ANCHORS
- POST INSTALLED ANCHORS
- ON SITE SOILS, EXCAVATIONS, FILLING AND COMPACTION
- ERECTION OF PRECAST CONCRETE MEMBERS

ABBREVIATIONS

A.B.	ANCHOR BOLTS
ACI	AMERICAN CONCRETE INSTITUTE
AESS	ARCHITECTURALLY EXPOSED STRUCTURAL STEEL
A.F.F.	ABOVE FINISHED FLOOR
ARCH.	ARCHITECTURAL
BAL.	BALANCE
B.L.	BLOCK LINTEL
BLDG.	BUILDING
B.O.	BOTTOM OF
B.O.D.	BOTTOM OF DECK
BRG.	BEARING
C.J.	CONTRACTION JOINT
C.L.	CENTER LINE
CLR.	CLEAR
CMU	CONCRETE MASONRY UNIT
COL.	COLUMN
CONC.	CONCRETE
CONST.	CONSTRUCTION
CONT.	CONTINUOUS
D.B.A.	DEFORMED BAR ANCHOR
DIA.	DIAMETER
DWG.	DRAWING
E.F.	EACH FACE
E.J.	EXPANSION JOINT
ELEV.	ELEVATION
E.O.D.	EDGE OF DECK
E.O.S.	EDGE OF SLAB
EQ.	EQUH FACE
E.W.	EACH WAY
EXIST.	EXISTING
FDN.	FOUNDATION
F.F.E.	FINISHED FLOOR ELEV.
F.S.	FAR SIDE
FTG.	FOOTING
GA.	GAGE
GALV.	GALVANIZED
G.B.	GRADE BEAM
HORIZ.	HORIZONTAL
H.S.A.	HEADED STUD ANCHOR
IBC	INTERNATIONAL BUILDING CODE
INFO.	INFORMATION
J.B.E.	JOIST BEARING ELEVATION
JT.	JOINT
K	UNIT OF 1,000 POUNDS (KIP)

KSI	KIPS PER SQUARE INCH
LBS.	POUNDS
L.H.	LONG LEG HORIZONTAL
LV.	LONG LEG VERTICAL
LONG.	LONGITUDINAL
MAX.	MAXIMUM
MECH.	MECHANICAL
MFR.	MANUFACTURER
MIN.	MINIMUM
MISC.	MISCELLANEOUS
N.I.C.	NOT IN CONTRACT
NO.	NUMBER
N.T.S.	NOT TO SCALE
N.S.	NEAR SIDE
O.C.	ON CENTER
O.D.	OUTSIDE DIAMETER
O.H.	OPPOSITE HAND
P.A.F.	POWER ACTUATED FASTENER
PCF	POUNDS PER CUBIC FOOT
PLF	POUNDS PER LINEAR FOOT
P.M.E.J.	PREMOLDED EXPANSION JOINT
PSF	POUNDS PER SQUARE FOOT
PSI	POUNDS PER SQUARE INCH
QTY.	QUANTITY
RE.	REFER
REINF.	REINFORCING
REQD.	REQUIRED
R.O.	ROUGH OPENING
RTU	ROOF TOP UNIT
SCHED.	SCHEDULE
S.D.S.	SELF-DRILLING SCREWS
SIM.	SIMILAR
SPECS.	SPECIFICATIONS
STD.	STANDARD
STL.	STEEL
T&B	TOP AND BOTTOM
T.O.	TOP OF
T.O.P.	TOP OF PIER
T.O.W.	TOP OF WALL
TRANS.	TRANSVERSE
TYP.	TYPICAL
U.N.O.	UNLESS NOTED OTHERWISE
VERT.	VERTICAL
W.P.	WORK POINT
WT.	WEIGHT
W.W.R.	WELDED WIRE REINFORCEMENT

NOTE: THE CONTRACTOR SHALL PROVIDE A BASE BID PRICING BASED ON THE PANEL THICKNESS SHOWN ON THE DRAWINGS. ADDITIONALLY, THE BASE BID SHALL REFLECT 3.5 LBS PER SQUARE FEET OF REINFORCING STEEL WITH UNIT PRICING OF ANY ADD OR DEDUCT FROM AFOREMENTIONED TONNAGE. ANY VALUE ENGINEERING DEVIATIONS FOR THE WALLS PANELS FOR PANEL THICKNESS SHALL BE QUALIFIED AS A SEPARATE LINE ITEM IN THE CONTRACTOR'S BID.

CURRAN
ARCHITECTURE


5719 LAWTON LOOP E. DR. #212
INDIANAPOLIS, IN 46216
O :: 317 . 288 . 0681
F :: 317 . 288 . 0753


SCANNELL
PROPERTIES

wallace


Wallace Engineering
Structural Consultants, Inc.
Structural and Civil Consultants
1741 McGee Street
Kansas City, Missouri 64108
816.421.8282, Fax 816.421.8338

CERTIFICATION



12/13/2022
Missouri COA #001268

THIS DRAWING AND THE IDEAS, DESIGNS AND CONCEPTS CONTAINED HEREIN ARE THE EXCLUSIVE INTELLECTUAL PROPERTY OF CURRAN ARCHITECTURE, AND ARE NOT TO BE USED OR REPRODUCED, WHOLE OR IN PART, WITHOUT THE WRITTEN CONSENT OF CURRAN ARCHITECTURE.
© COPYRIGHT 2021, CURRAN ARCHITECTURE

PROJECT INFORMATION


LEE'S SUMMIT LOGISTICS
BUILDING A LOT I

NW CORNER TUDOR RD & MAINST
LEE'S SUMMIT, MO


ISSUE DATES	
ISSUE	DATE
ISSUE FOR PERMIT	02.18.2022
ISSUE FOR PERMIT	04.15.2022

210300

S1.0
OVERALL FOUNDATION PLAN

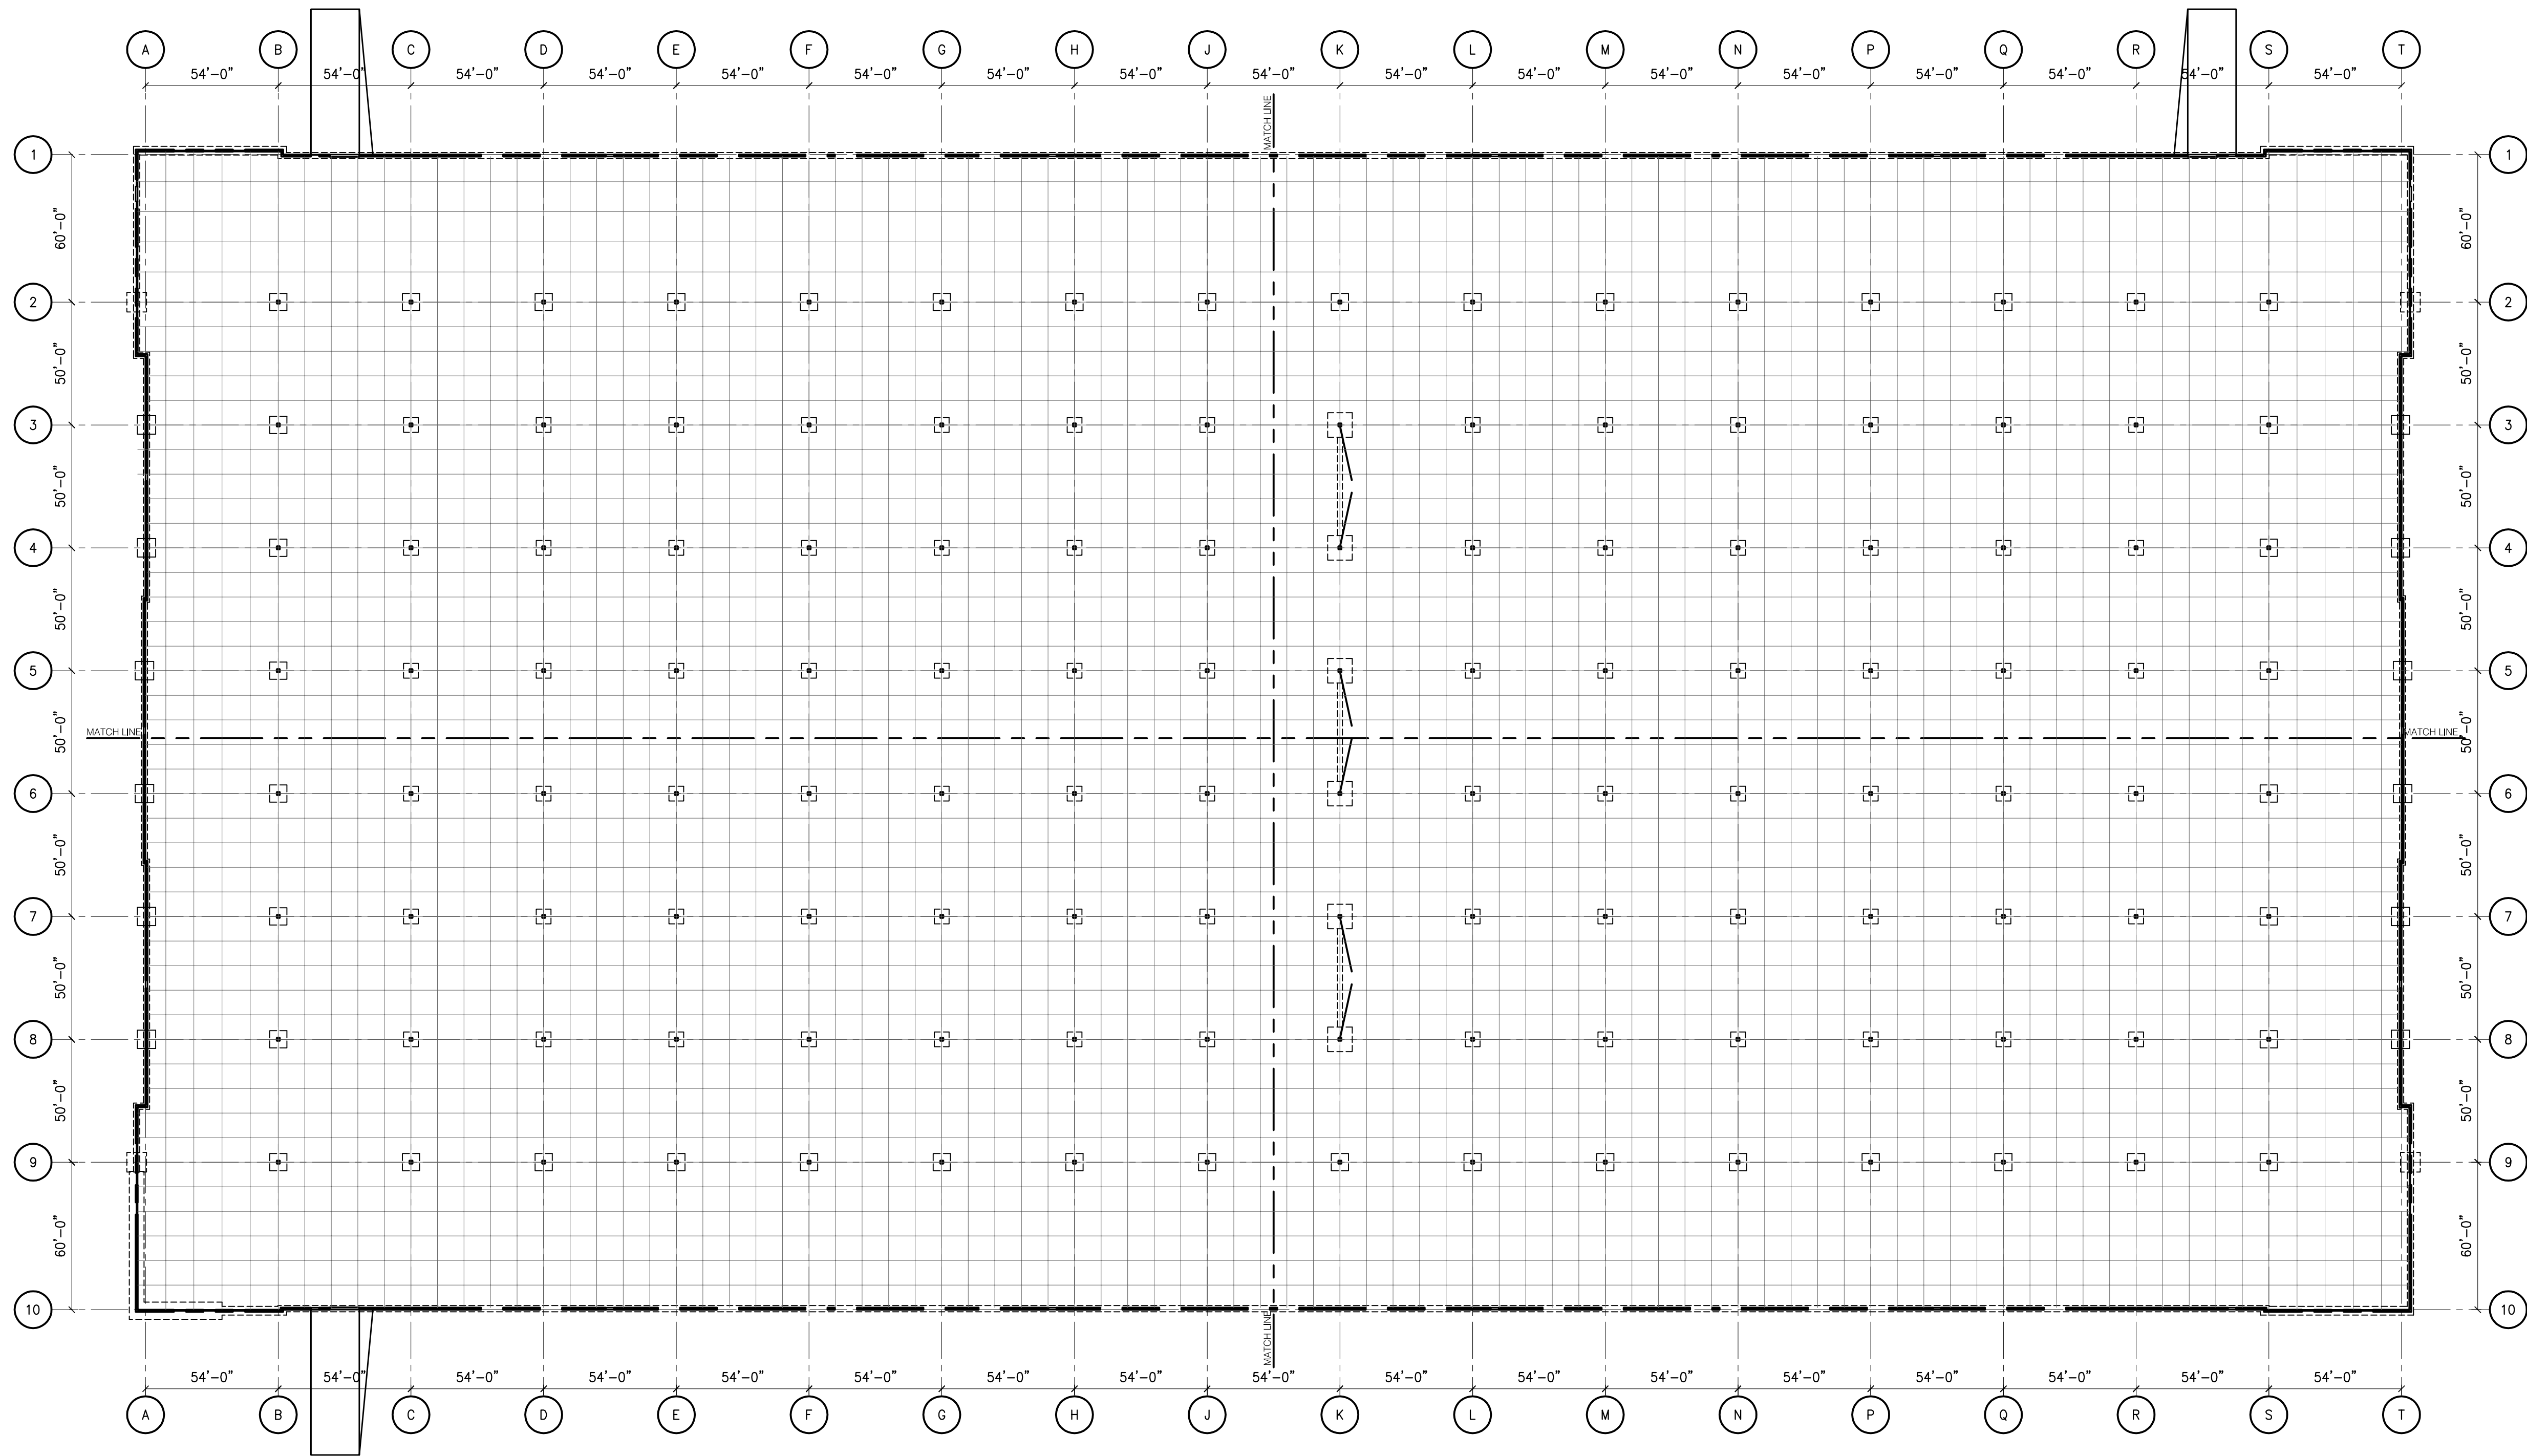

1 OVERALL FOUNDATION PLAN
SCALE: 1"=40'-0"

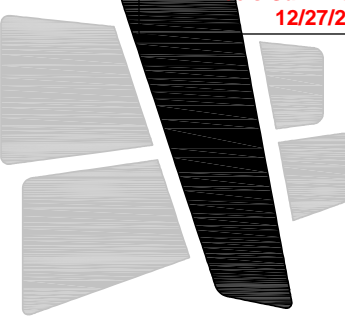

CURRAN
ARCHITECTURE

5719 LAWTON LOOP E. DR. #212
INDIANAPOLIS, IN 46216
O :: 317 . 288 . 0681
F :: 317 . 288 . 0753



SCANNELL
PROPERTIES


wallace



Wallace Engineering
Structural Consultants, Inc.

Structural and Civil Consultants
1741 McGee Street
Kansas City, Missouri 64108
816.421.8282, Fax 816.421.8388

CERTIFICATION

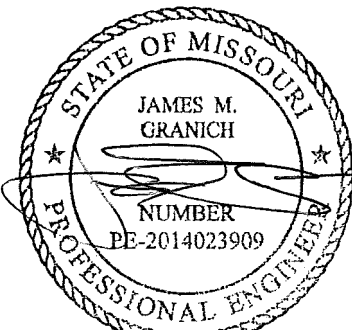

12/13/2022
Missouri COA #001268

THIS DRAWING AND THE IDEAS, DESIGNS
AND CONCEPTS CONTAINED HEREIN ARE
THE EXCLUSIVE INTELLECTUAL PROPERTY
OF CURRAN ARCHITECTURE, AND ARE NOT
TO BE USED OR REPRODUCED, WHOLE OR
IN PART, WITHOUT THE WRITTEN
CONSENT OF CURRAN ARCHITECTURE.
© COPYRIGHT 2021, CURRAN ARCHITECTURE

PROJECT INFORMATION

LEE'S SUMMIT LOGISTICS
BUILDING A LOT I

NW CORNER TUDOR RD & MAINST
LEE'S SUMMIT, MO

ISSUE DATES

ISSUE	DATE
ISSUE FOR PERMIT	02.18.2022
ISSUE FOR PERMIT	04.15.2022

210300

S1.1

ENLARGED PARTIAL
FOUNDATION PLAN

PLAN NOTES:

1. CONCRETE SLAB-ON-GRADE, U.N.O., SHALL BE A 7" THICK UNREINFORCED SLAB (U.N.O.) OVER 4" ROCK, RE: THE GEOTECHNICAL REPORT. T.O. SLAB ELEV = 100'-0". SLAB TO BE SEALED WITH SINGLE COAT OF ASHFORD (OR EQUAL) FLOOR SEALANT.
2. THE CONCRETE SLABS SHOWN ON THE STRUCTURAL DRAWINGS HAVE BEEN DESIGNED FOR THE FINISHED STRUCTURE AND HAVE NOT BEEN DESIGNED FOR MEANS AND METHODS OF CONSTRUCTION, INCLUDING BUT NOT LIMITED TO, FORK LIFTS, MAN LIFTS, AND OTHER VEHICULAR TRAFFIC. THE CONTRACTOR SHALL VERIFY THE SLAB DESIGN MEETS THE CONSTRUCTION NEEDS AND SHALL SUBMIT TO THE ENGINEER OF RECORD FOR REVIEW.
3. TOP OF FOOTING ELEV. = 99'-0, UNLESS NOTED OTHERWISE.
4. ALL PIPING OR CONDUITS THAT OCCUR THROUGH OR UNDER A GRADE BEAM OR FOOTING SHALL BE APPROVED BY THE ENGINEER OF RECORD PRIOR TO PLACEMENT. (RE: 4 & 5/S3.0)
5. RE: 1/S3.0 FOR REINFORCING LAP SCHEDULE.
6. RE: SHEET S3.0 FOR ADDITIONAL CONCRETE FOUNDATION DETAILS
7. ALL PRECAST PANELS SHALL BE 9 1/4" THICK, U.N.O.

PLAN REFERENCE NOTES:

- ④ DRAIN BLOCKOUT IN FOOTING, RE: 10&11/S3.0
- ⑤ DOCK PIT, RE: 5/S3.2. RE: ARCH. FOR LOCATIONS.
- ⑥ DOCK STAIRS RE: 1/S3.1. REFER TO ARCH DWGS FOR LOCATIONS AND TYPE OF STAIR
- ⑦ FOOTING STEP, RE: 6/S3.0
- ⑧ RAMP, RE: CIVIL DWGS.


LEGEND

1. F# = FOOTING MARK; RE: FOOTING SCHEDULE
2. C.J. = SAW CUT CONTROL JOINT; RE: DETAIL 2/S3.0
3. B.P. = BASE PLATE; RE: DETAIL 9/S3.0


SPOT FOOTING SCHEDULE

MARK	SIZE	REINFORCEMENT
M7.5	7'-6"x7'-6"x2'-6"	NO REINF. REQUIRED
M8.0	8'-0"x8'-0"x2'-6"	NO REINF. REQUIRED
F6.0	6'-0"x6'-0"x1'-3"	(6)-#6 EA. WAY
F7.0	7'-0"x7'-0"x1'-3"	(7)-#6 EA. WAY
F10.0	10'-0"x10'-0"x3'-0"	(10)-#7 EA. WAY, TOP & BOT.

NOTE: PROVIDE f'c=4,000 PSI AT FOOTING TYPE F10.0

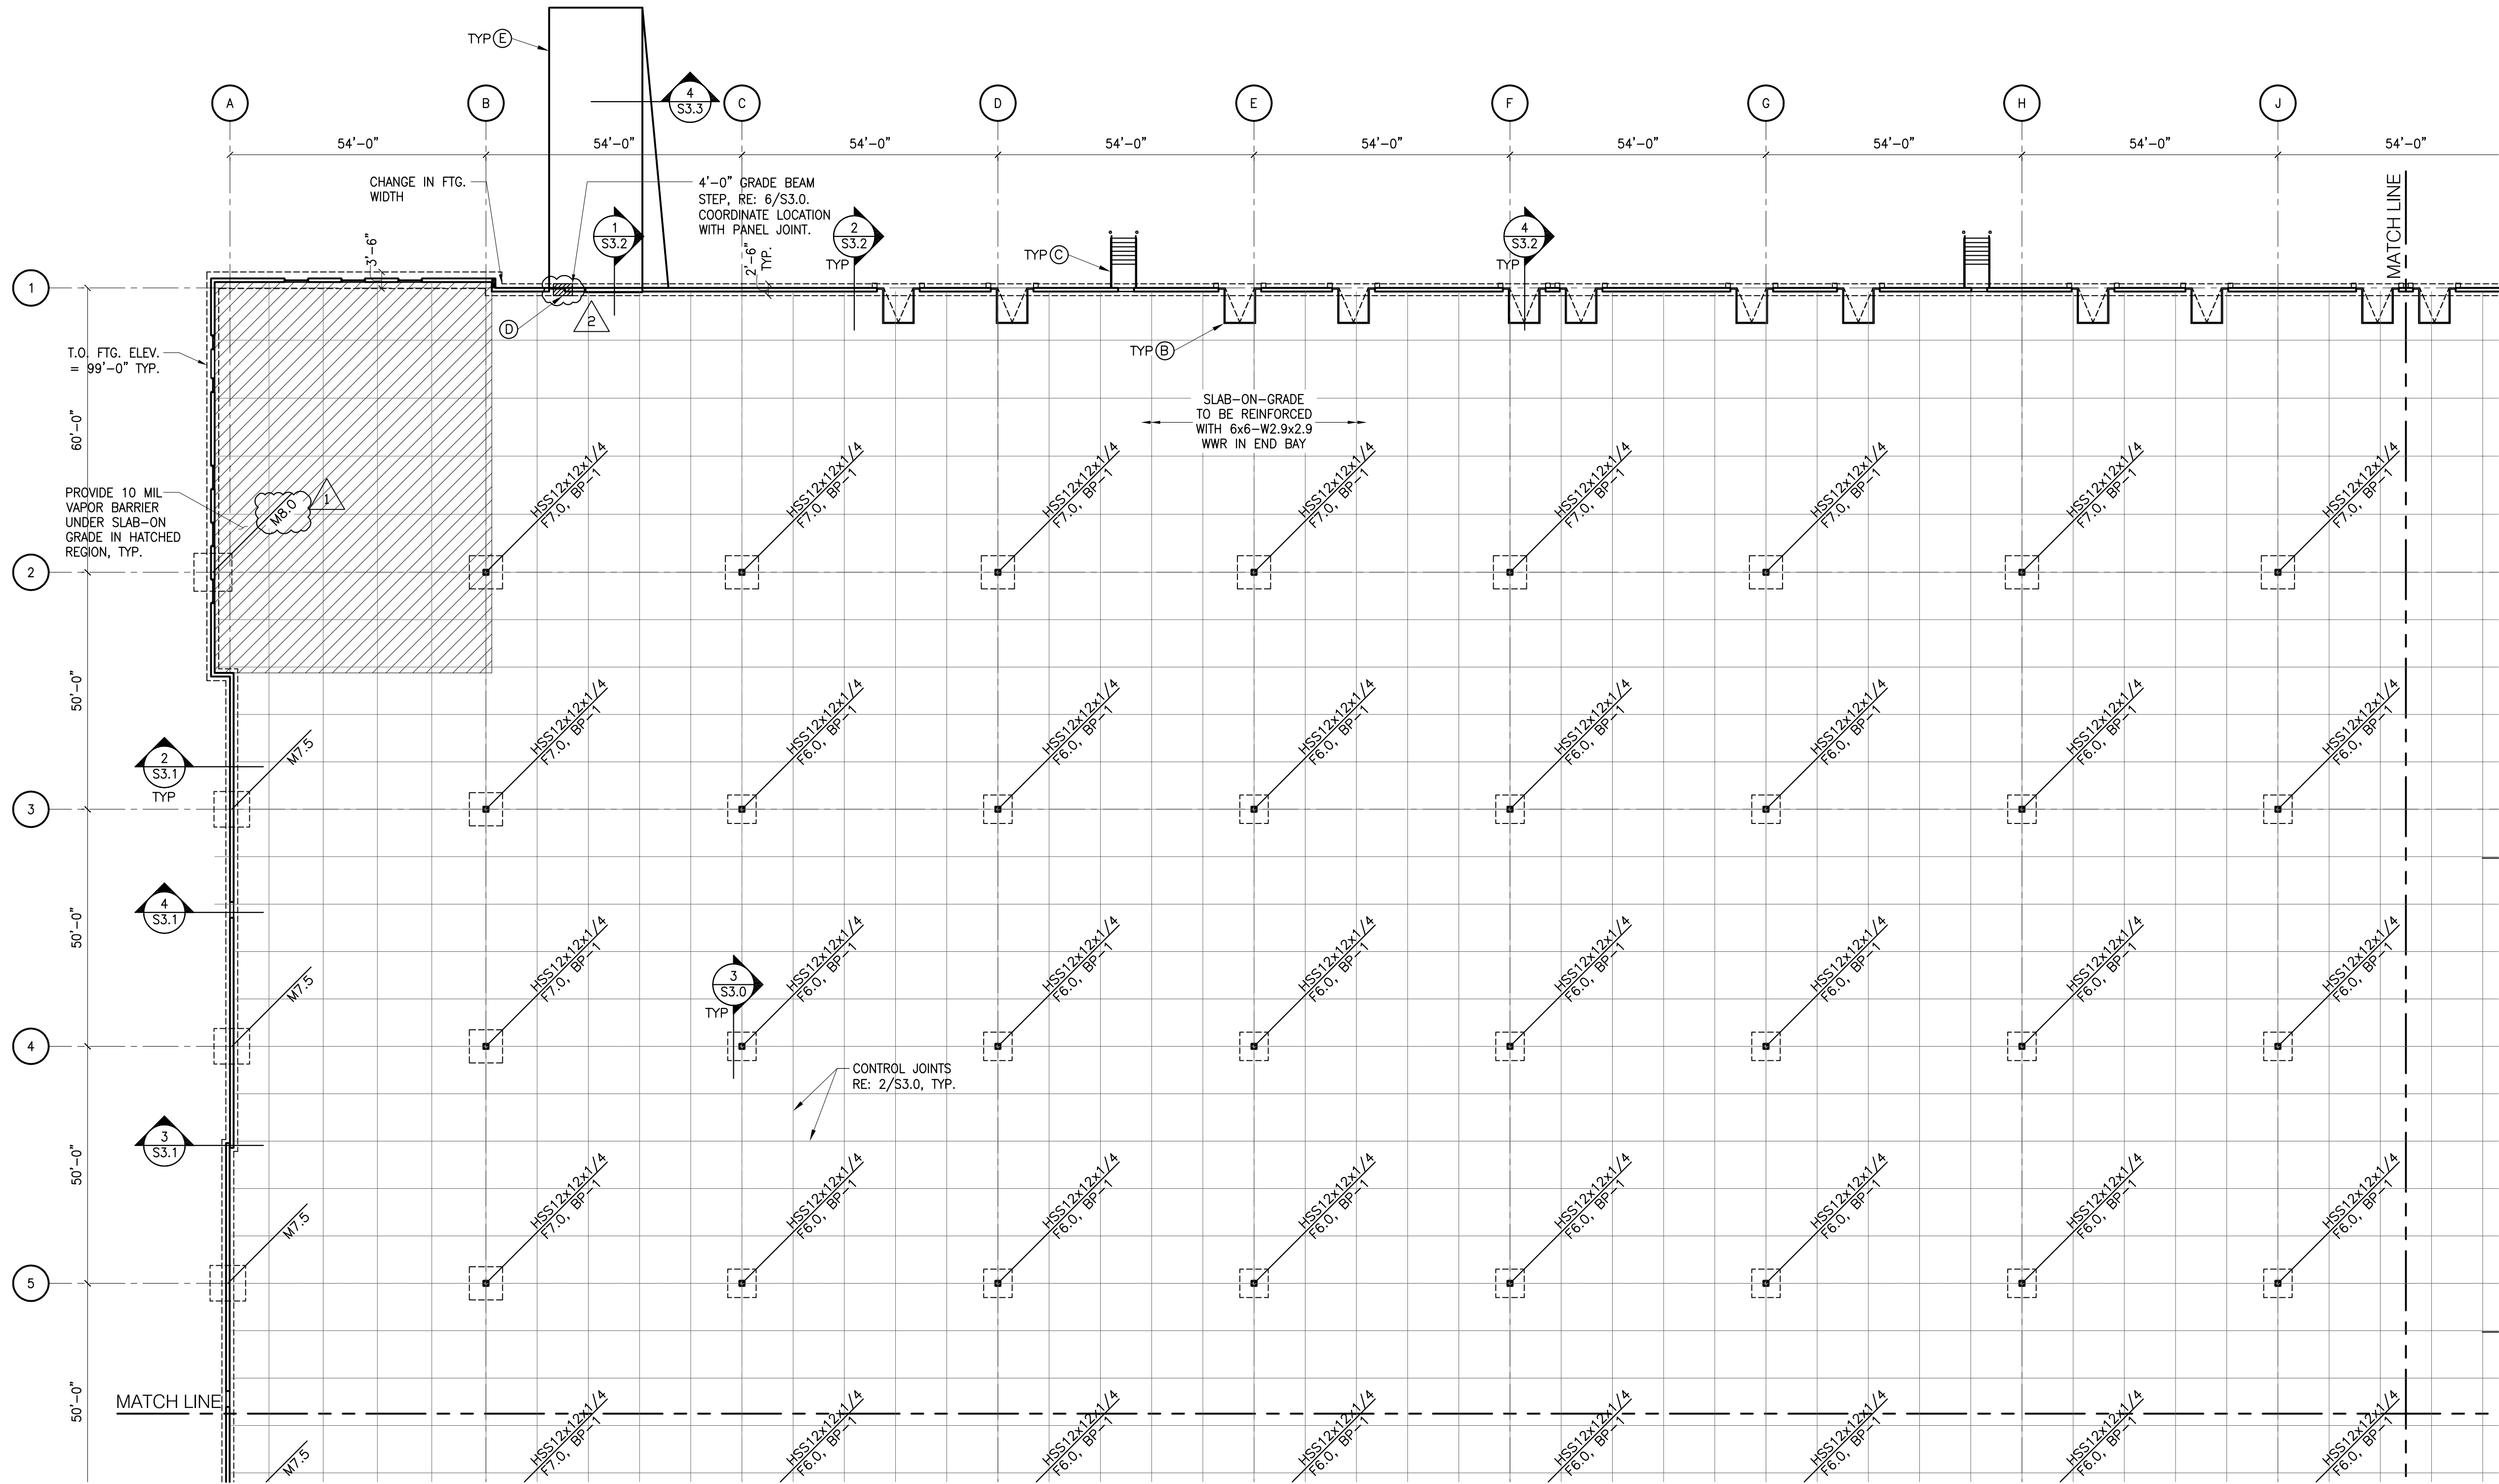

1 ENLARGED PARTIAL FOUNDATION PLAN
SCALE: 1"=20'-0"

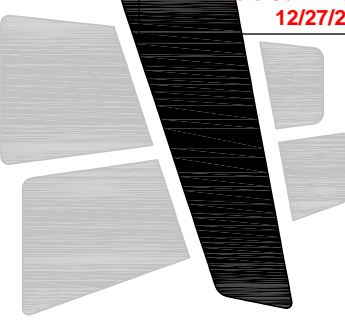

CURRAN
ARCHITECTURE

5719 LAWTON LOOP E. DR. #212
INDIANAPOLIS, IN 46216
O :: 317 . 288 . 0681
F :: 317 . 288 . 0753




SCANNELL
PROPERTIES

wallace

Wallace Engineering
Structural Consultants, Inc.

Structural and Civil Consultants
1741 McGee Street
Kansas City, Missouri 64108
816.421.8282, Fax 816.421.8338

CERTIFICATION

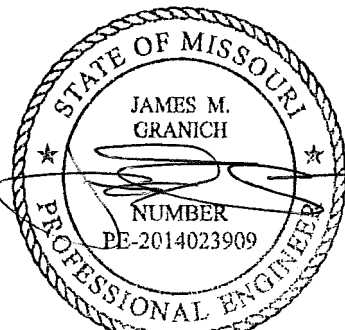

12/13/2022
Missouri COA #001268

THIS DRAWING AND THE IDEAS, DESIGNS
AND CONCEPTS CONTAINED HEREIN ARE
THE EXCLUSIVE INTELLECTUAL PROPERTY
OF CURRAN ARCHITECTURE, AND ARE NOT
TO BE USED OR REPRODUCED, WHOLE OR
IN PART, WITHOUT THE WRITTEN
CONSENT OF CURRAN ARCHITECTURE.
© COPYRIGHT 2021, CURRAN ARCHITECTURE

PROJECT INFORMATION

LEE'S SUMMIT LOGISTICS
BUILDING A LOT I

NW CORNER TUDOR RD & MAINST
LEE'S SUMMIT, MO

ISSUE DATES

ISSUE	DATE
ISSUE FOR PERMIT	02.18.2022
ISSUE FOR PERMIT	04.15.2022

210300

S1.2

ENLARGED PARTIAL
FOUNDATION PLAN

PLAN NOTES:

- CONCRETE SLAB-ON-GRADE, U.N.O., SHALL BE A 7" THICK UNREINFORCED SLAB (U.N.O.) OVER 4" ROCK, RE: THE GEOTECHNICAL REPORT, T.O. SLAB ELEV = 100'-0". SLAB TO BE SEALED WITH SINGLE COAT OF ASHFORD (OR EQUAL) FLOOR SEALANT. THE CONCRETE SLABS SHOWN ON THE STRUCTURAL DRAWINGS HAVE BEEN DESIGNED FOR THE FINISHED STRUCTURE AND HAVE NOT BEEN DESIGNED FOR MEANS AND METHODS OF CONSTRUCTION, INCLUDING BUT NOT LIMITED TO, FORK LIFTS, MAN LIFTS, AND OTHER VEHICULAR TRAFFIC. THE CONTRACTOR SHALL VERIFY THE SLAB DESIGN MEETS THE CONSTRUCTION NEEDS AND SHALL SUBMIT TO THE ENGINEER OF RECORD FOR REVIEW.
- TOP OF FOOTING ELEV. = 99'-0", UNLESS NOTED OTHERWISE.
- ALL PIPING OR CONDUITS THAT OCCUR THROUGH OR UNDER A GRADE BEAM OR FOOTING SHALL BE APPROVED BY THE ENGINEER OF RECORD PRIOR TO PLACEMENT. (RE: 4 & 5/S3.0)
- RE: 1/S3.0 FOR REINFORCING LAP SCHEDULE.
- RE: SHEET S3.0 FOR ADDITIONAL CONCRETE FOUNDATION DETAILS
- ALL PRECAST PANELS SHALL BE 9 1/4" THICK, U.N.O.

PLAN REFERENCE NOTES:

- (A) DRAIN BLOCKOUT IN FOOTING, RE: 10&11/S3.0
(B) DOCK PIT, RE: 5/S3.2. RE: ARCH. FOR LOCATIONS.
(C) DOCK STAIRS RE: 1/S3.1. REFER TO ARCH DWGS FOR LOCATIONS AND TYPE OF STAIR
(D) FOOTING STEP, RE: 6/S3.0
(E) RAMP, RE: CIVIL DWGS.


LEGEND

1. F# = FOOTING MARK; RE: FOOTING SCHEDULE.
2. C.J. = SAW CUT CONTROL JOINT; RE: DETAIL 2/S3.0
3. B.P. = BASE PLATE; RE: DETAIL 9/S3.0

SPOT FOOTING SCHEDULE

MARK	SIZE	REINFORCEMENT
M7.5	7'-6"x7'-6"x2'-6"	NO REINF. REQUIRED
M8.0	8'-0"x8'-0"x2'-6"	NO REINF. REQUIRED
F6.0	6'-0"x6'-0"x1'-3"	(6)-#6 EA. WAY
F7.0	7'-0"x7'-0"x1'-3"	(7)-#6 EA. WAY
F10.0	10'-0"x10'-0"x3'-0"	(10)-#7 EA. WAY, TOP & BOT.


NOTE: PROVIDE f'c=4,000 PSI AT FOOTING TYPE F10.0

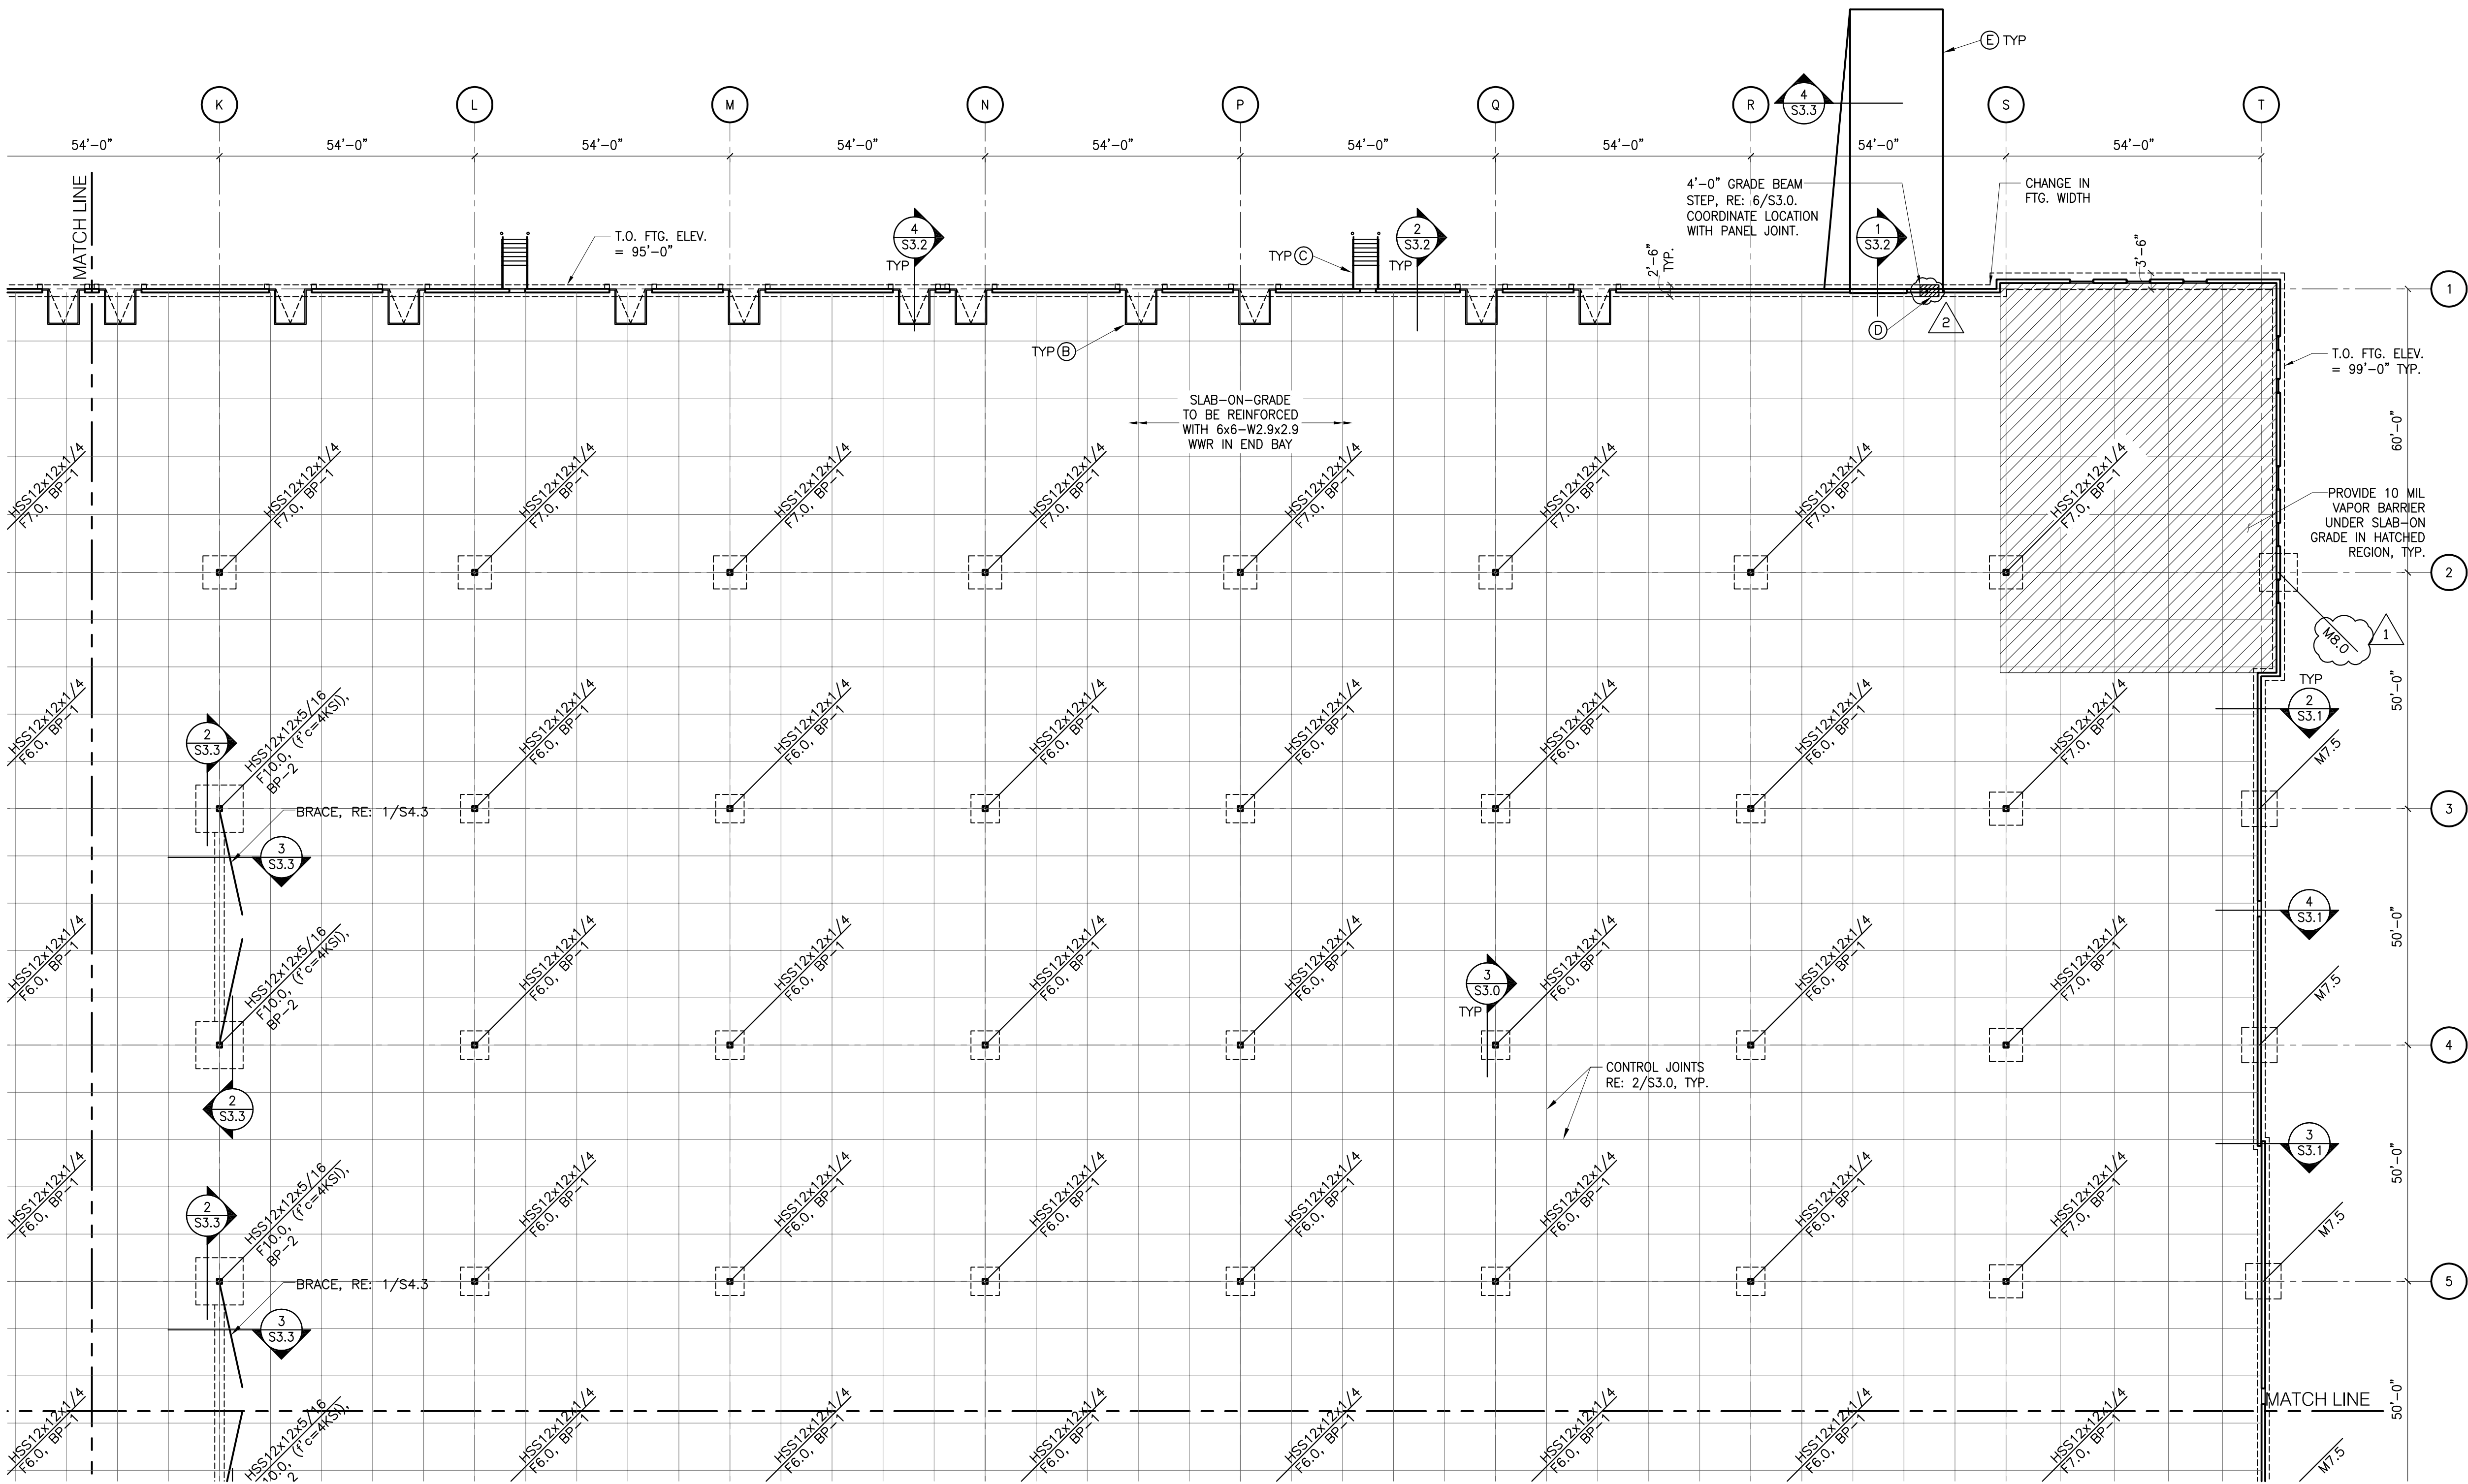

1 ENLARGED PARTIAL FOUNDATION PLAN

SCALE: 1"=20'-0"



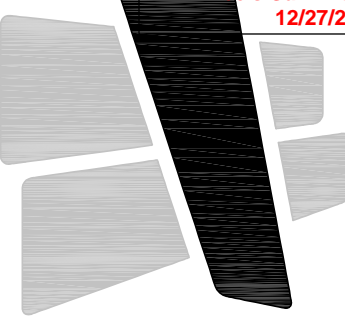

CURRAN
ARCHITECTURE

5719 LAWTON LOOP E. DR. #212
INDIANAPOLIS, IN 46216
O :: 317 . 288 . 0681
F :: 317 . 288 . 0753


SCANNELL
PROPERTIES

wallace



Wallace Engineering
Structural Consultants, Inc.
Structural and Civil Consultants
1741 McGee Street
Kansas City, Missouri 64108
816.421.8282, Fax 816.421.8338

CERTIFICATION

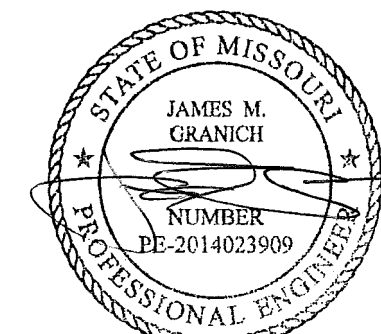

12/13/2022
Missouri COA #001268

THIS DRAWING AND THE IDEAS, DESIGNS
AND CONCEPTS CONTAINED HEREIN ARE
THE EXCLUSIVE INTELLECTUAL PROPERTY
OF CURRAN ARCHITECTURE, AND ARE NOT
TO BE USED OR REPRODUCED, WHOLE OR
IN PART, WITHOUT THE WRITTEN
CONSENT OF CURRAN ARCHITECTURE.
© COPYRIGHT 2021, CURRAN ARCHITECTURE

PROJECT INFORMATION

LEE'S SUMMIT LOGISTICS
BUILDING A LOT I

NW CORNER TUDOR RD & MAINST
LEE'S SUMMIT, MO

ISSUE DATES

ISSUE	DATE
ISSUE FOR PERMIT	02.18.2022
ISSUE FOR PERMIT	04.15.2022

210300

S1.3

ENLARGED PARTIAL
FOUNDATION PLAN

PLAN NOTES:

1. CONCRETE SLAB-ON-GRADE, U.N.O., SHALL BE A 7" THICK UNREINFORCED SLAB (U.N.O.) OVER 4" ROCK, RE: THE GEOTECHNICAL REPORT. T.O. SLAB ELEV = 100'-0".
2. SLAB TO BE SEALED WITH SINGLE COAT OF ASHFORD (OR EQUAL) FLOOR SEALANT. THE CONCRETE SLABS SHOWN ON THE STRUCTURAL DRAWINGS HAVE BEEN DESIGNED FOR THE FINISHED STRUCTURE AND HAVE NOT BEEN DESIGNED FOR MEANS AND METHODS OF CONSTRUCTION, INCLUDING BUT NOT LIMITED TO, FORK LIFTS, MAN LIFTS, AND OTHER VEHICULAR TRAFFIC. THE CONTRACTOR SHALL VERIFY THE SLAB DESIGN MEETS THE CONSTRUCTION NEEDS AND SHALL SUBMIT TO THE ENGINEER OF RECORD FOR REVIEW.
3. TOP OF FOOTING ELEV. = 99'-0, UNLESS NOTED OTHERWISE.
4. ALL PIPING OR CONDUITS THAT OCCUR THROUGH OR UNDER A GRADE BEAM OR FOOTING SHALL BE APPROVED BY THE ENGINEER OF RECORD PRIOR TO PLACEMENT. (RE: 4 & 5/S3.0)
5. RE: 1/S3.0 FOR REINFORCING LAP SCHEDULE.
6. RE: SHEET S3.0 FOR ADDITIONAL CONCRETE FOUNDATION DETAILS
7. ALL PRECAST PANELS SHALL BE 9 1/4" THICK, U.N.O.

PLAN REFERENCE NOTES:

- (A) DRAIN BLOCKOUT IN FOOTING, RE: 10&11/S3.0
(B) DOCK PIT, RE: 5/S3.2. RE: ARCH. FOR LOCATIONS.
(C) DOCK STAIRS, RE: 1/S3.1. REFER TO ARCH DWGS FOR LOCATIONS AND TYPE OF STAIR
(D) FOOTING STEP, RE: 6/S3.0
(E) RAMP, RE: CIVIL DWGS.


LEGEND

1. F# = FOOTING MARK; RE: FOOTING SCHEDULE
2. C.J. = SAW CUT CONTROL JOINT; RE: DETAIL 2/S3.0
3. B.P. = BASE PLATE; RE: DETAIL 9/S3.0

SPOT FOOTING SCHEDULE


MARK	SIZE	REINFORCEMENT
M7.5	7'-6"x7'-6"x2'-6"	NO REINF. REQUIRED
M8.0	8'-0"x8'-0"x2'-6"	NO REINF. REQUIRED
F6.0	6'-0"x6'-0"x1'-3"	(6)-#6 EA. WAY
F7.0	7'-0"x7'-0"x1'-3"	(7)-#6 EA. WAY
F10.0	10'-0"x10'-0"x3'-0"	(10)-#7 EA. WAY, TOP & BOT.

NOTE: PROVIDE $f'_c=4,000$ PSI AT FOOTING TYPE F10.0

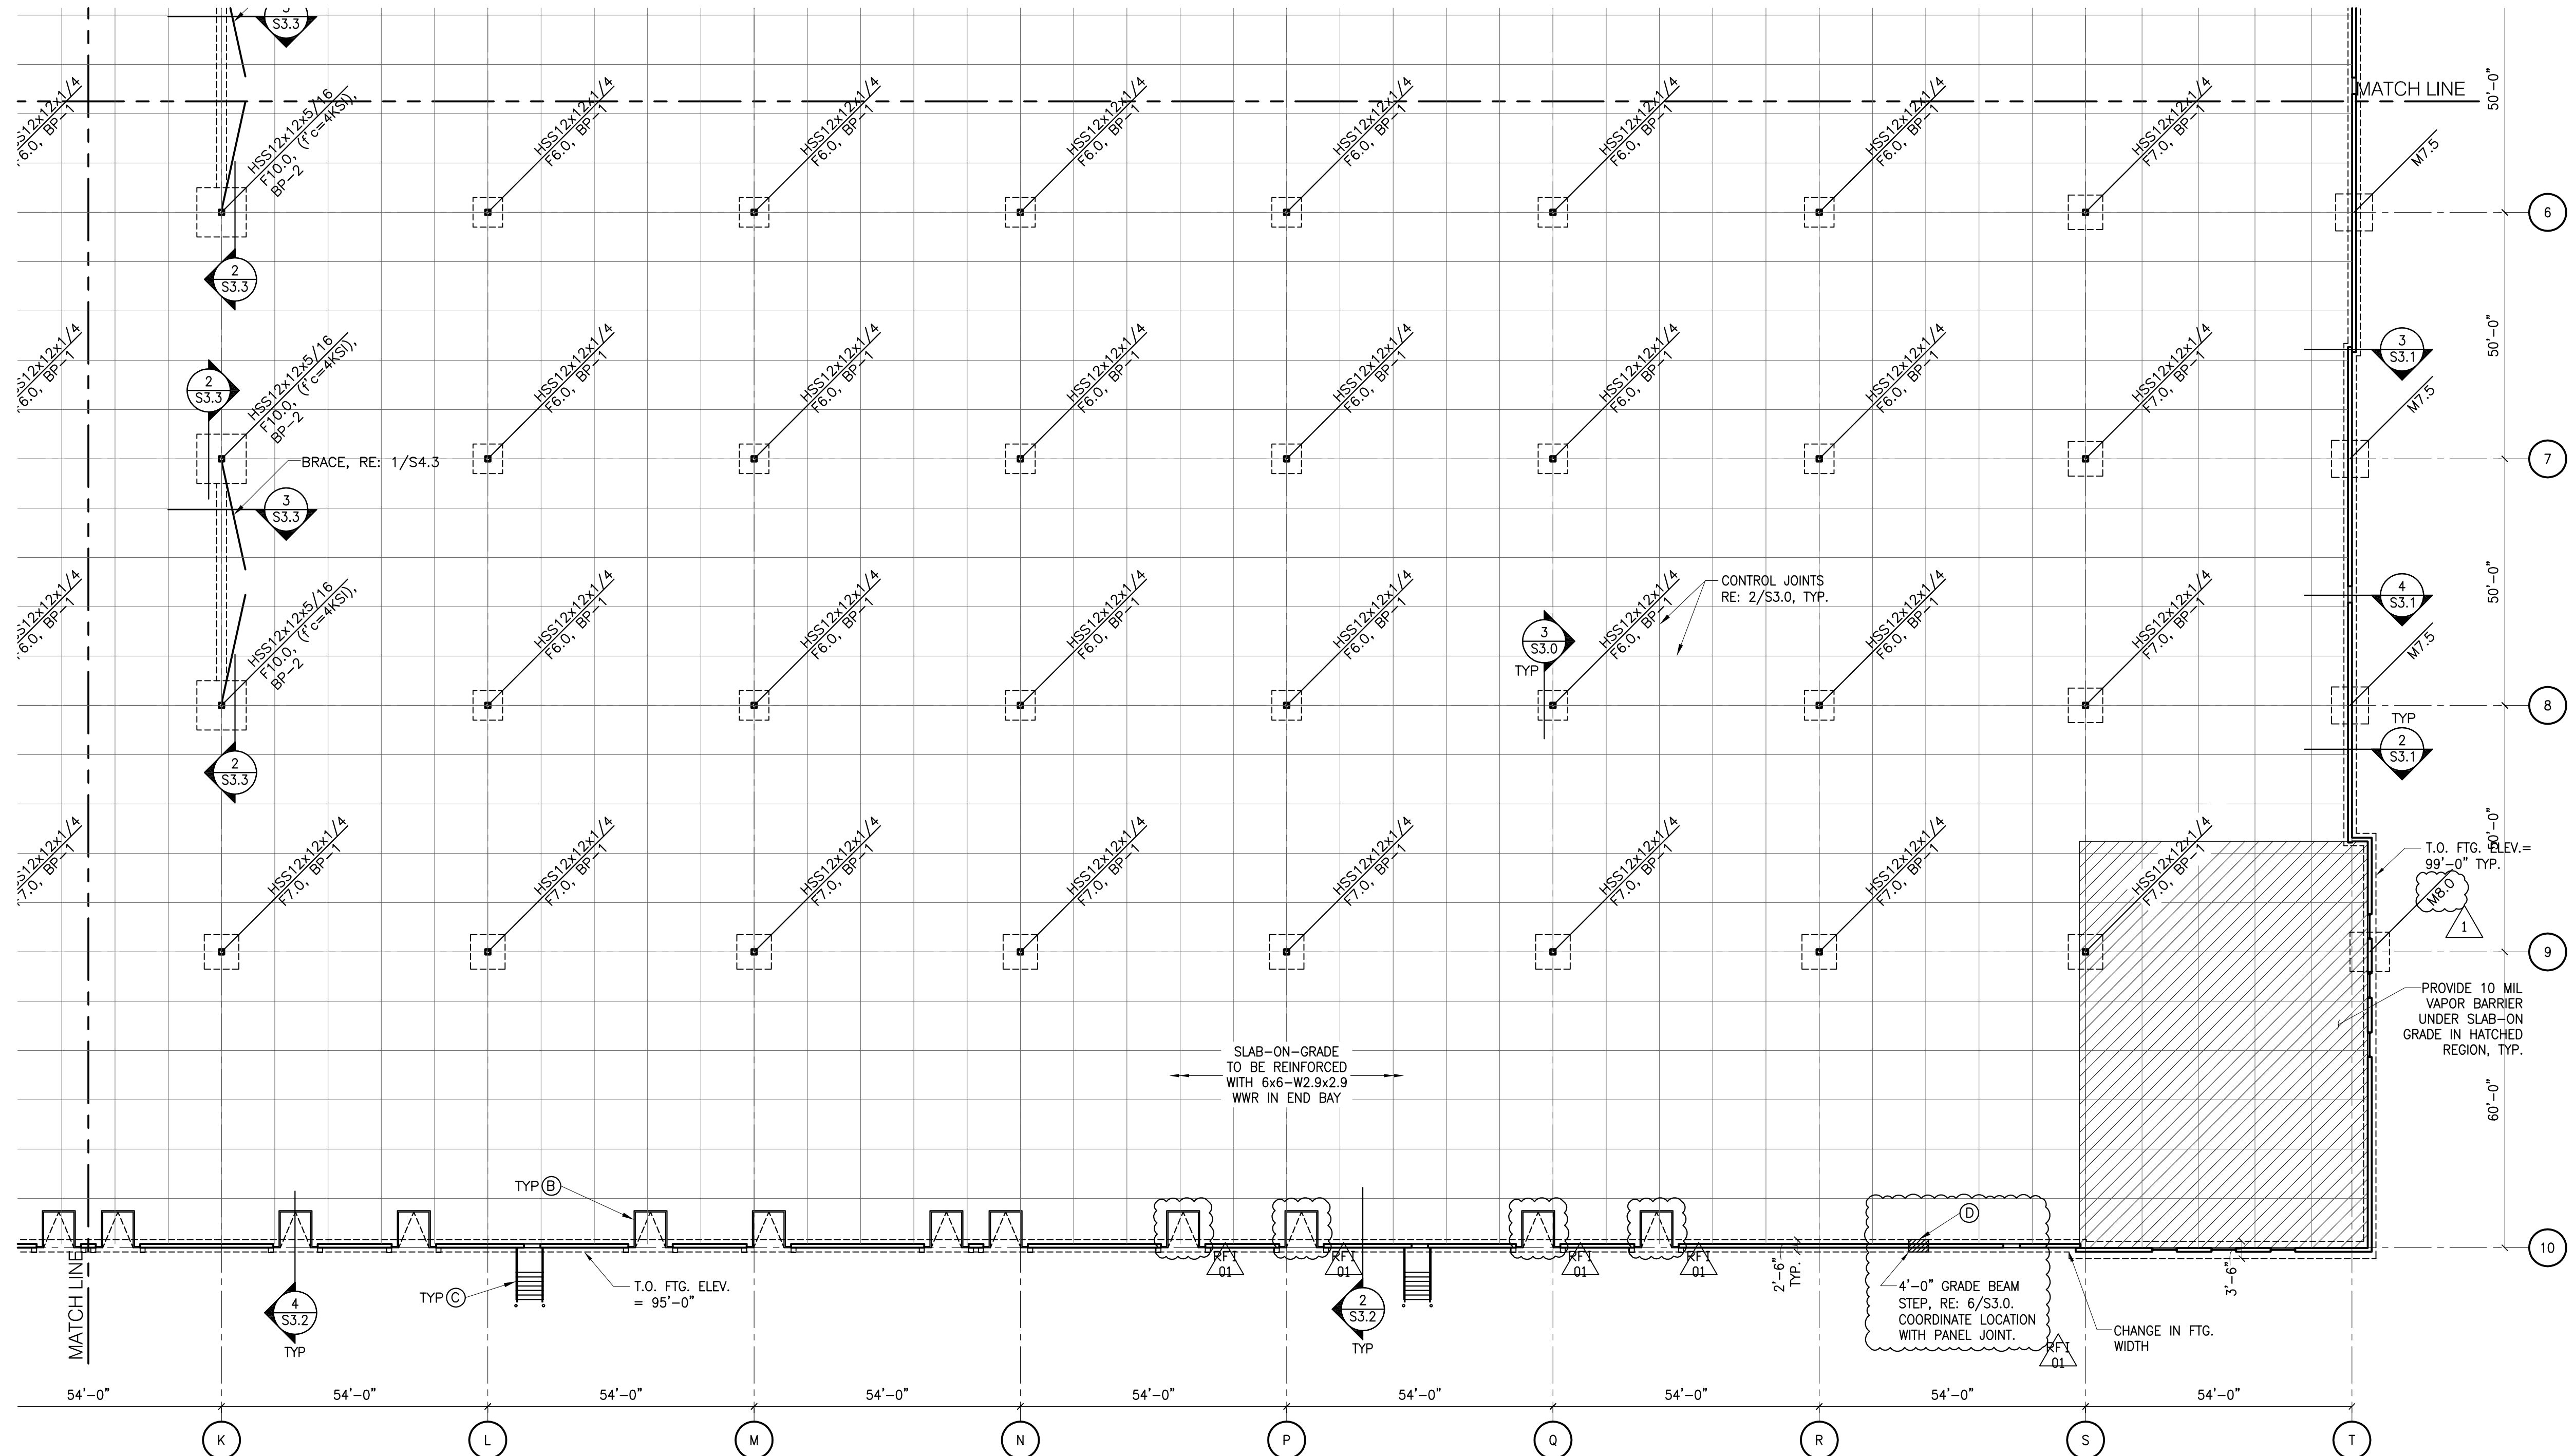

1 ENLARGED PARTIAL FOUNDATION PLAN
SCALE: 1"=20'-0"



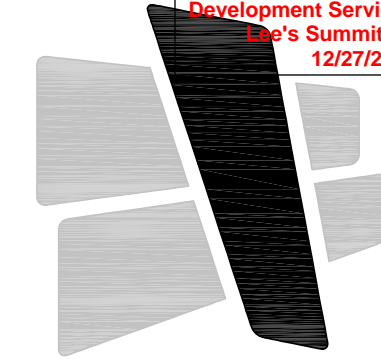

CURRAN
ARCHITECTURE
5719 LAWTON LOOP E. DR. #212
INDIANAPOLIS, IN 46216
O :: 317 . 288 . 0681
F :: 317 . 288 . 0753



Wallace Engineering
Structural Consultants, Inc.
Structural and Civil Consultants
1741 McGee Street
Kansas City, Missouri 64108
816.421.8282, Fax 816.421.8338

CERTIFICATION



12/13/2022
Missouri COA #001268

THIS DRAWING AND THE IDEAS, DESIGNS AND CONCEPTS CONTAINED HEREIN ARE THE EXCLUSIVE INTELLECTUAL PROPERTY OF CURRAN ARCHITECTURE, AND ARE NOT TO BE USED OR REPRODUCED, WHOLE OR IN PART, WITHOUT THE WRITTEN CONSENT OF CURRAN ARCHITECTURE.
© COPYRIGHT 2021, CURRAN ARCHITECTURE

PROJECT INFORMATION

LEE'S SUMMIT LOGISTICS
BUILDING A LOT I
NW CORNER TUDOR RD & MAINST
LEE'S SUMMIT, MO

ISSUE DATES

ISSUE	DATE
ISSUE FOR PERMIT	02.18.2022
ISSUE FOR PERMIT	04.15.2022

210300

S1.4
ENLARGED PARTIAL
FOUNDATION PLAN

PLAN NOTES:

1. CONCRETE SLAB-ON-GRADE, U.N.O., SHALL BE A 7" THICK UNREINFORCED SLAB (U.N.O.) OVER 4" ROCK, RE: THE GEOTECHNICAL REPORT, T.O. SLAB ELEV = 100'-0". SLAB TO BE SEALED WITH SINGLE COAT OF ASHFORD (OR EQUAL) FLOOR SEALANT.
2. THE CONCRETE SLABS SHOWN ON THE STRUCTURAL DRAWINGS HAVE BEEN DESIGNED FOR THE FINISHED STRUCTURE AND HAVE NOT BEEN DESIGNED FOR MEANS AND METHODS OF CONSTRUCTION, INCLUDING BUT NOT LIMITED TO, FORK LIFTS, MAN LIFTS, AND OTHER VEHICULAR TRAFFIC. THE CONTRACTOR SHALL VERIFY THE SLAB DESIGN MEETS THE CONSTRUCTION NEEDS AND SHALL SUBMIT TO THE ENGINEER OF RECORD FOR REVIEW.
3. TOP OF FOOTING ELEV. = 99'-0, UNLESS NOTED OTHERWISE.
4. ALL PIPING OR CONDUITS THAT OCCUR THROUGH OR UNDER A GRADE BEAM OR FOOTING SHALL BE APPROVED BY THE ENGINEER OF RECORD PRIOR TO PLACEMENT. (RE: 4 & 5/S3.0)
5. RE: 1/S3.0 FOR REINFORCING LAP SCHEDULE.
6. RE: SHEET S3.0 FOR ADDITIONAL CONCRETE FOUNDATION DETAILS
7. ALL PRECAST PANELS SHALL BE 9 1/4" THICK, U.N.O.

PLAN REFERENCE NOTES:

1. (A) DRAIN BLOCKOUT IN FOOTING, RE: 10&11/S3.0
2. (B) DOCK PIT, RE: 5/S3.2. RE: ARCH. FOR LOCATIONS.
3. (C) DOCK STAIRS RE: 1/S3.1. REFER TO ARCH DWGS FOR LOCATIONS AND TYPE OF STAIR
4. (D) FOOTING STEP, RE: 6/S3.0
5. (E) RAMP, RE: CIVIL DWGS.


LEGEND

1. F# = FOOTING MARK; RE: FOOTING SCHEDULE
2. C.J. = SAW CUT CONTROL JOINT; RE: DETAIL 2/S3.0
3. B.P. = BASE PLATE; RE: DETAIL 9/S3.0

SPOT FOOTING SCHEDULE

MARK	SIZE	REINFORCEMENT
M7.5	7'-6"x7'-6"x2'-6"	NO REINF. REQUIRED
M8.0	8'-0"x8'-0"x2'-6"	NO REINF. REQUIRED
F6.0	6'-0"x6'-0"x1'-3"	(6)-#6 EA. WAY
F7.0	7'-0"x7'-0"x1'-3"	(7)-#6 EA. WAY
F10.0	10'-0"x10'-0"x3'-0"	(10)-#7 EA. WAY, TOP & BOT.

NOTE: PROVIDE f'c=4,000 PSI AT FOOTING TYPE F10.0

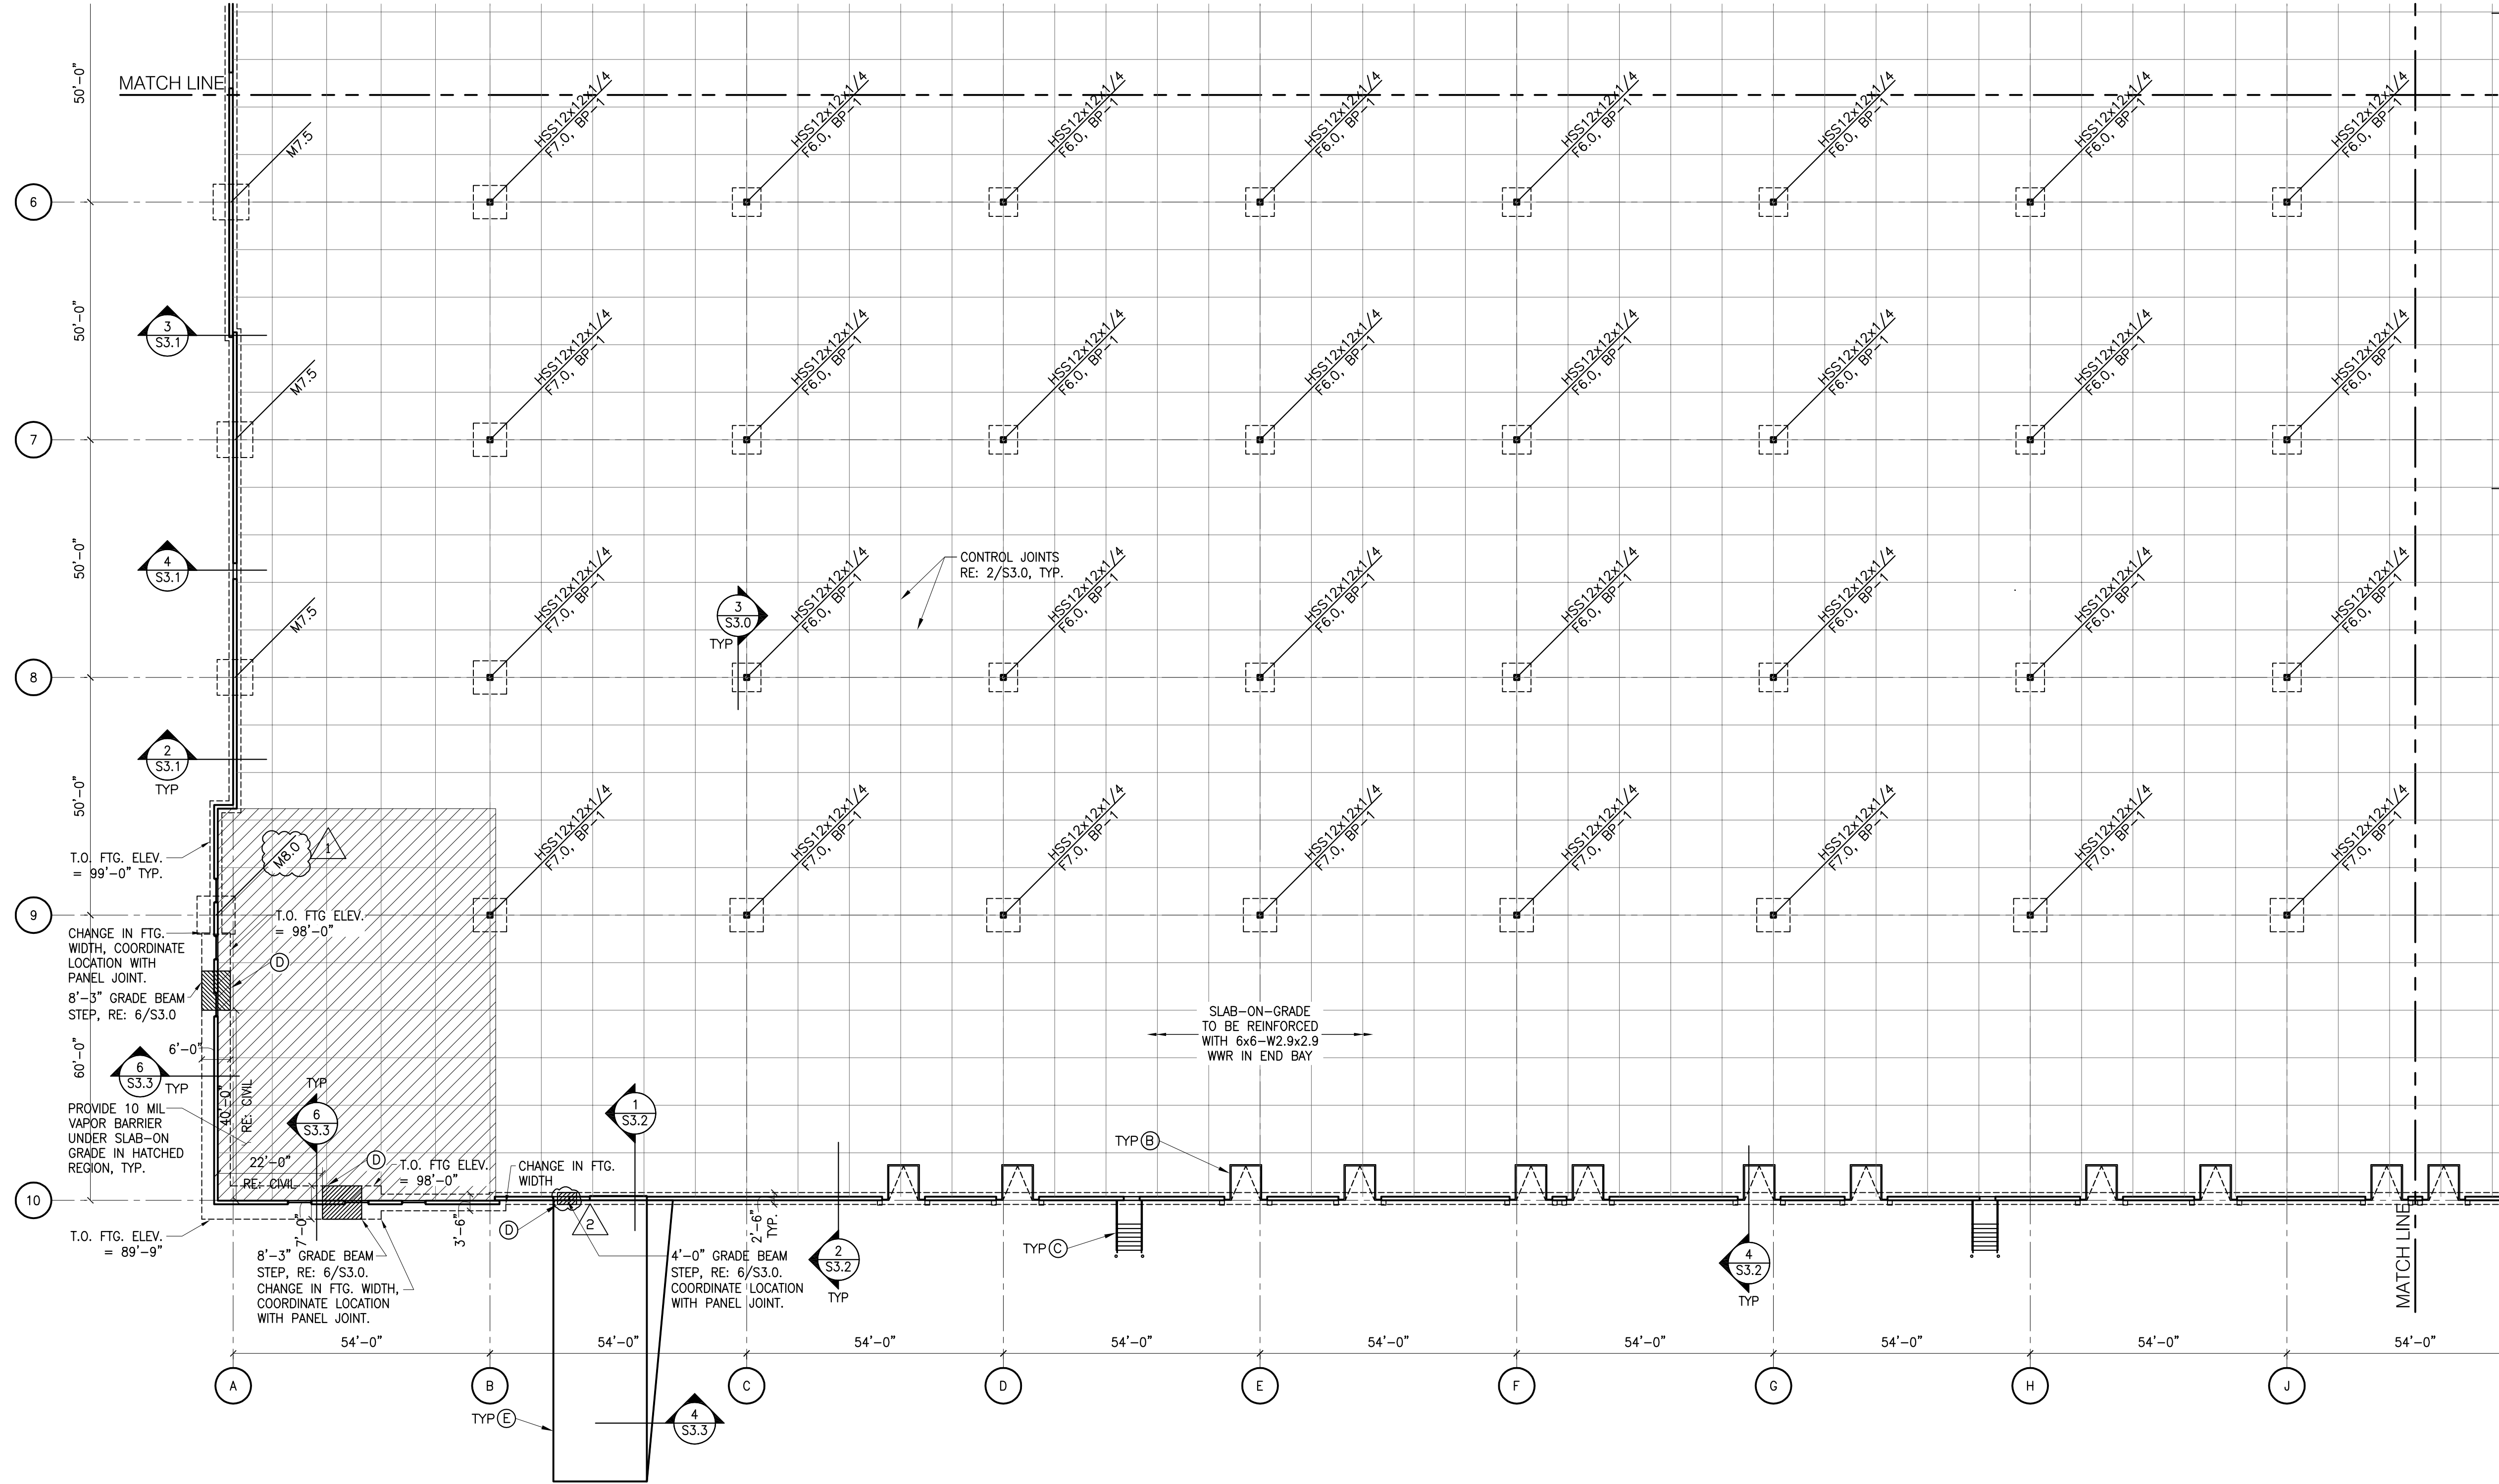

1 ENLARGED PARTIAL FOUNDATION PLAN
SCALE: 1"=20'-0"



CURRAN
ARCHITECTURE


5719 LAWTON LOOP E. DR. #212
INDIANAPOLIS, IN 46216
O :: 317 . 288 . 0681
F :: 317 . 288 . 0753


SCANNELL
PROPERTIES

wallace


Wallace Engineering
Structural Consultants, Inc.
Structural and Civil Consultants
1741 McGee Street
Kansas City, Missouri 64108
816.421.8282, Fax 816.421.8338

CERTIFICATION

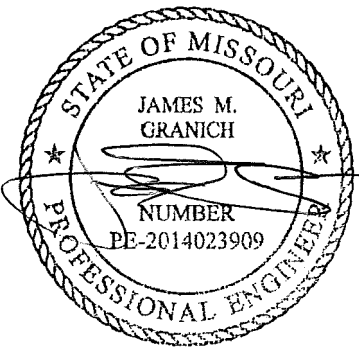
JAMES M. GRANICH
NUMBER DE-2014023909
PROFESSIONAL ENGINEER
12/13/2022
Missouri COA #001268
THIS DRAWING AND THE IDEAS, DESIGNS AND CONCEPTS CONTAINED HEREIN ARE THE EXCLUSIVE INTELLECTUAL PROPERTY OF CURRAN ARCHITECTURE, AND ARE NOT TO BE USED OR REPRODUCED, WHOLE OR IN PART, WITHOUT THE WRITTEN CONSENT OF CURRAN ARCHITECTURE.
© COPYRIGHT 2021, CURRAN ARCHITECTURE

PROJECT INFORMATION


LEE'S SUMMIT LOGISTICS
BUILDING A LOT I

NW CORNER TUDOR RD & MAINST
LEE'S SUMMIT, MO

ISSUE DATES	
ISSUE	DATE
ISSUE FOR PERMIT	02.18.2022
ISSUE FOR PERMIT	04.15.2022

210300

S2.0
OVERALL FRAMING PLAN

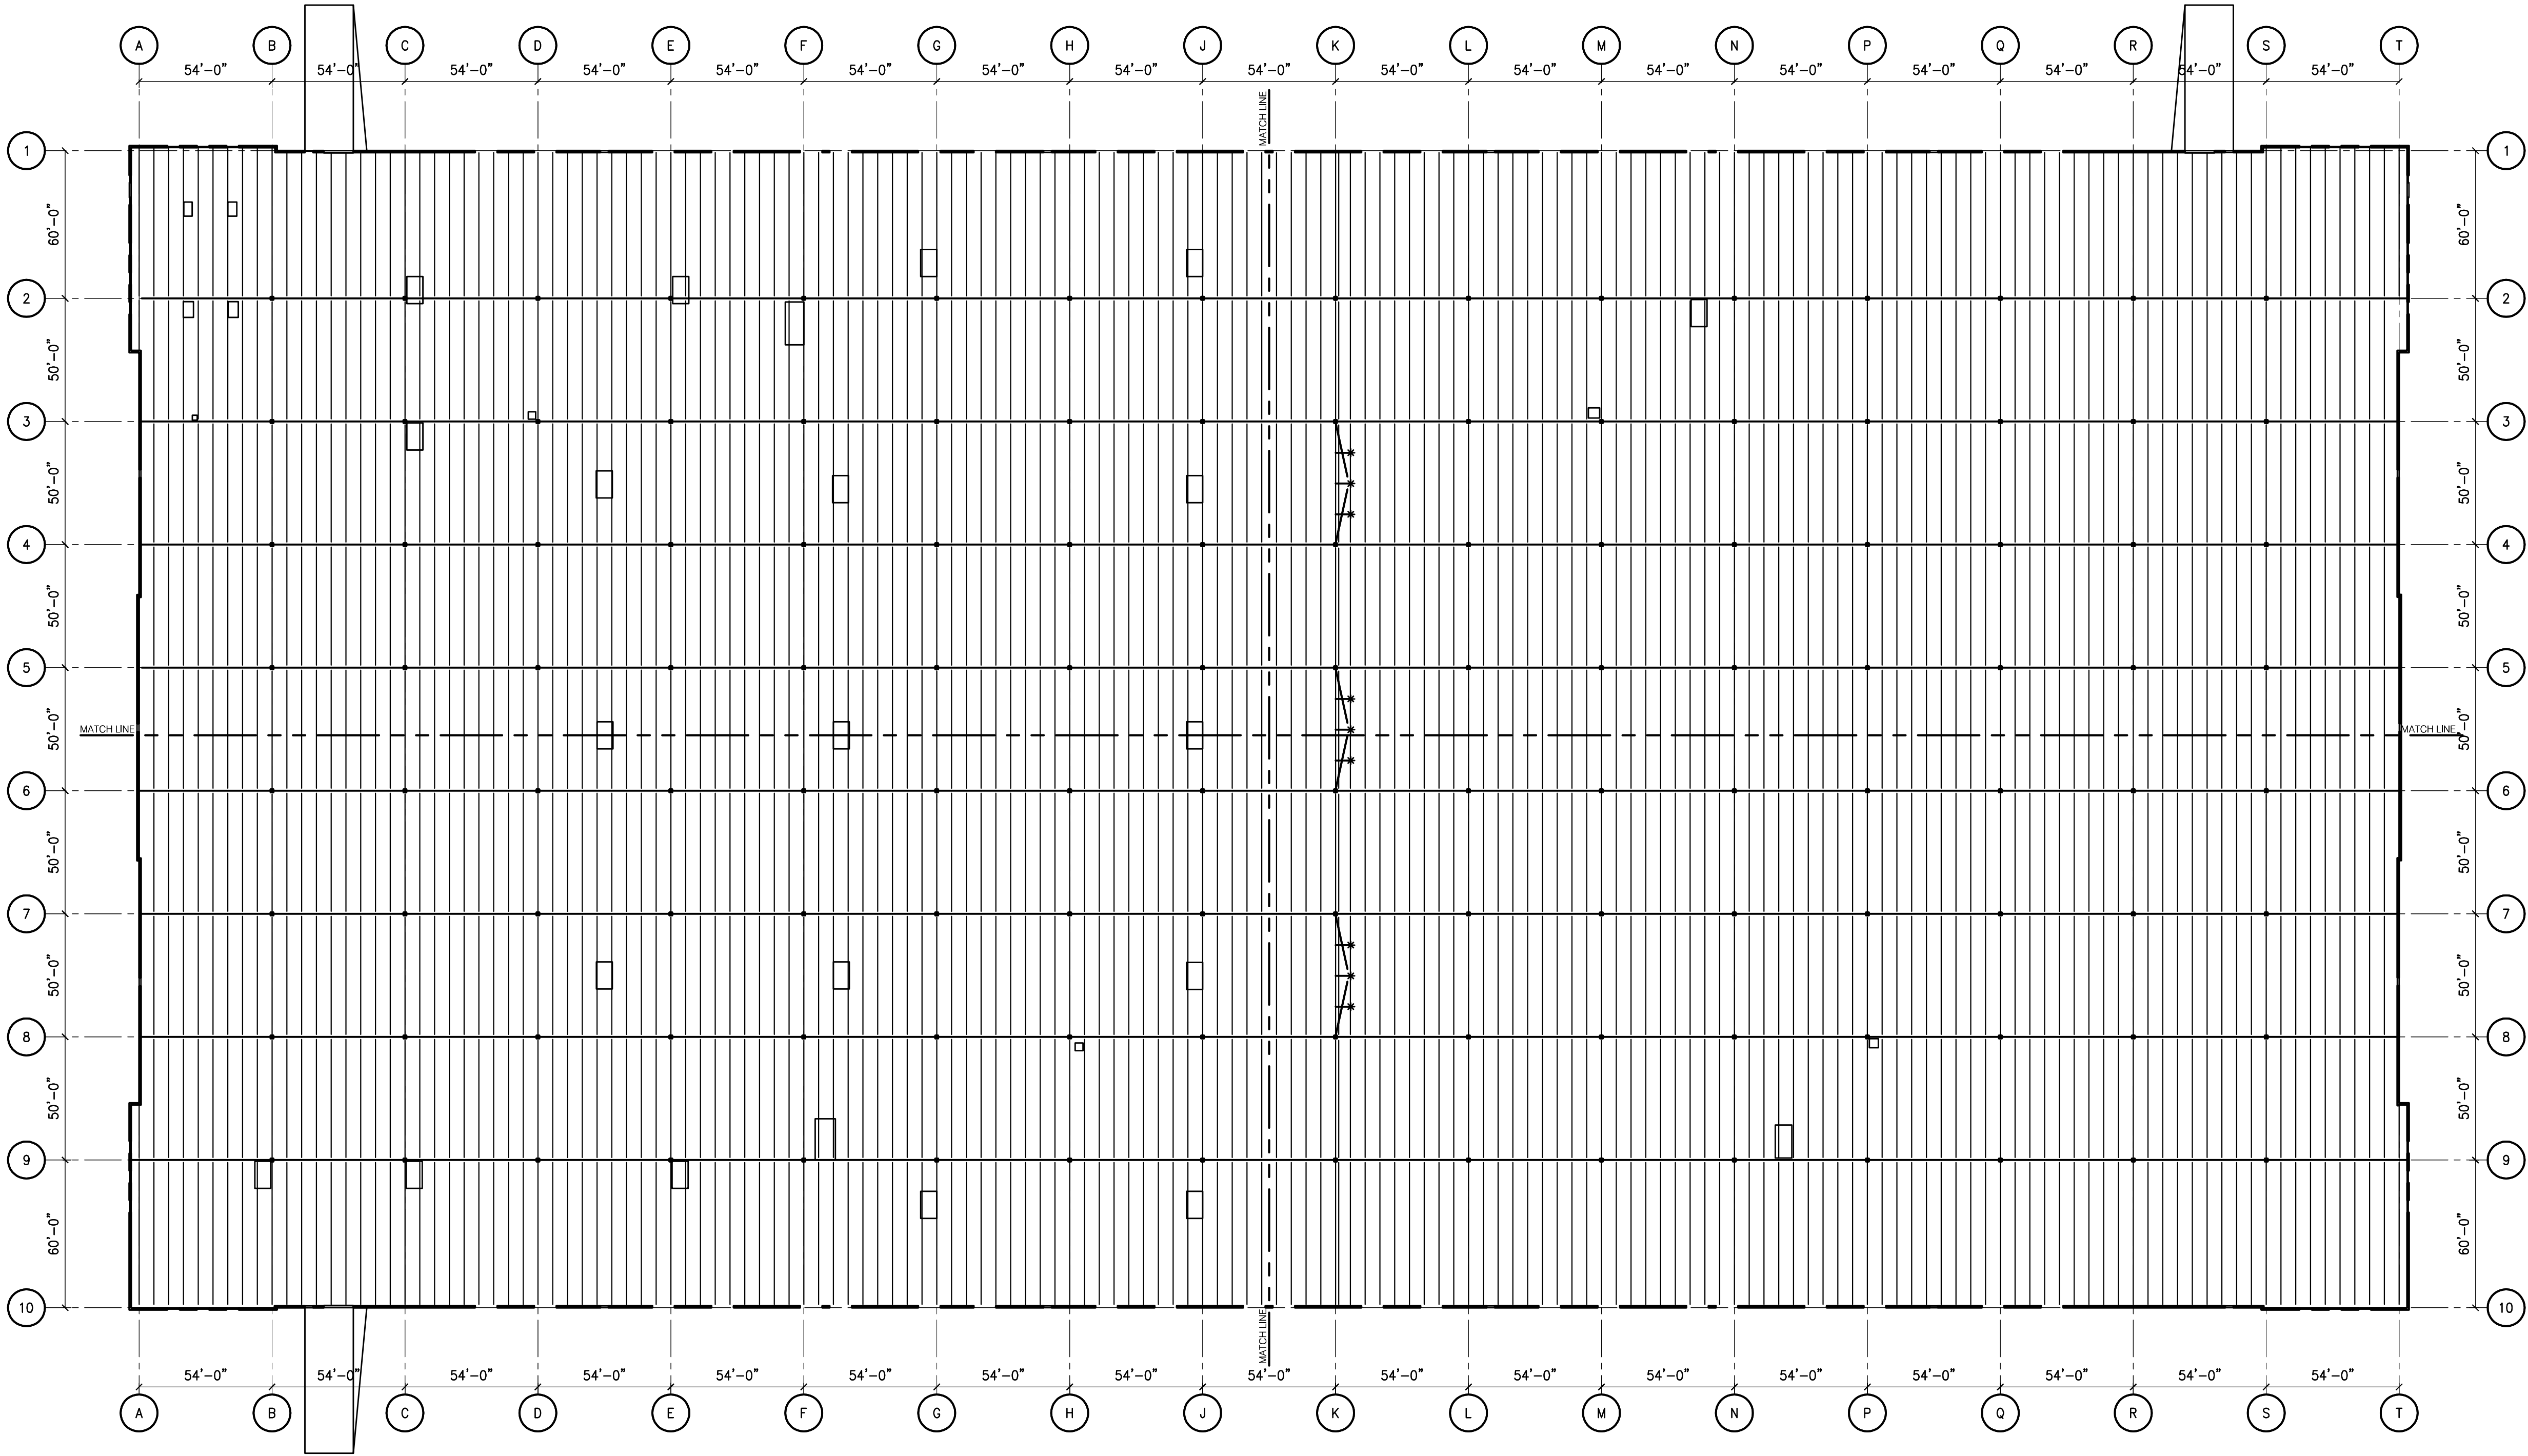


1 OVERALL FRAMING PLAN
SCALE: 1"=40'-0"

5719 LAWTON LOOP E. DR. #2
INDIANAPOLIS, IN 46216
O :: 317.288.0681
F :: 317.288.0753



CERTIFICATION

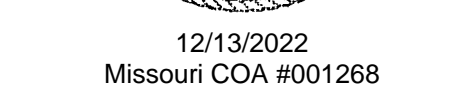

PROJECT INFORMATION

NW CORNER TUDOR RD & MAIN
LEE'S SUMMIT, MO

ISSUE	DATE
ISSUE FOR PERMIT	02.18.2022
ISSUE FOR PERMIT	04.15.2022

S2.1
ENLARGED PART
FRAMING PLAN

- (A) ROOF HATCH, RE: ARCH. PROVIDE ANGLE FRAME AT OPENING, RE: 8/54.0
- (B) JOIST SUPPLIER SHALL DESIGN JOISTS FOR AXIAL LOAD SHOWN.
- (C) DRAG STRUT SPLICE, RE: 9/54.0.
- (D) ROOF TOP EQUIPMENT, RE: ARCH./MEP. PROVIDE ANGLE FRAME AND CURB RE: 5/54.0 JOIST SUPPLIER SHALL ACCOUNT FOR LOAD SHOWN ON PLAN IN JOIST DESIGN.
- (E) CAMBER BEAM TO MATCH ADJACENT JOIST.

1. ALL EDGE ANGLES SHALL BE CONTINUOUS AND SPLICED PER 6/S4.0.
2. VERIFY ALL WALL OPENING, DIMENSIONS, JOINTS, BLOCKOUTS, REVEALS AND FUTURE KNOCK OUT PANELS WITH ARCHITECTURAL DRAWINGS.
3. NOTE TO JOIST MANUFACTURER: PROVIDE STANDARD BRIDGING COMPLYING WITH THE APPLICABLE STEEL JOIST INSTITUTE SPECIFICATIONS TYPICAL FOR GRAVITY AND UPLIFT LOADS SUPERIMPOSED ON ALL JOISTS. DIAGONAL BRIDGING SHALL BE PROVIDED BETWEEN ADJACENT JOISTS WHENEVER BOTTOM CHORD HORIZONTAL BRIDGING IS DISCONTINUOUS. (RE: 1 & 2/S4.0)
4. ROOF DECK AND ROOF DECK ATTACHMENT SHALL BE PER SECT S2.5.
5. RE: 3 AND 4/S4.1 FOR ADDITIONAL PRECAST PANEL CONNECTION DETAILS
6. JOIST SHALL BE DESIGNED FOR ROOF TOP EQUIPMENT, RE: ARCH./MEP. PROVIDE ANGLE FRAME AND CURB RE: S4.0. JOIST SUPPLIER SHALL ACCOUNT FOR LOAD SHOWN ON PLAN IN JOIST DESIGN.
7. JOIST AND JOIST GIRDER DEPTHS SHALL BE LIMITED SO THAT 36"-0" CLEAR HEIGHT TO BOTTOM OF STRUCTURE IS MAINTAINED.

Diagram illustrating the components of a joist cross-section and associated loads:

- JOIST DEPTH**: Indicated by a dimension line across the top of the joist.
- JOIST SERIES**: Indicated by a dimension line across the bottom of the joist.
- TOTAL ASD UNIFORM LOAD (DL + LL) IN PLF**: Indicated by a dimension line across the top of the joist, labeled **30K (208/130)**.
- ASD UNIFORM SNOW LOAD IN PLF**: Indicated by a dimension line across the bottom of the joist, labeled **XXK**.
- LRFD FACTORED REACTION FOR PRECAST SUPPLIER DESIGN**: Indicated by a dimension line across the bottom of the joist, labeled **XXK**.

A diagram of a precast concrete girder with various design parameters labeled. The girder is represented by a horizontal line with a dashed centerline. Labels with arrows pointing to specific parts of the girder include:



- GIRDER DEPTH (MAXIMUM, JOIST SUPPLIER MAY REDUCE)**: Points to the top of the girder.
- NUMBER OF EQUAL SPACED LOADING LOCATIONS**: Points to the top of the girder.
- ADDITIONAL ASD LOAD IN KIPS**: Points to the top of the girder.
- LRFD FACTORED REACTION FOR PRECAST SUPPLIER DESIGN**: Points to the bottom of the girder.
- ASD LOAD IN KIPS AT EACH LOADING LOCATION**: Points to the bottom of the girder.
- GIRDER WEB CONFIGURATION**: Points to the bottom of the girder.

Specific design values are indicated on the girder:

- 54C8N9.4K**: Located on the top of the girder.
- 1K**: Located on the top of the girder.
- XXK**: Located on the bottom of the girder.


STEEL FABRICATOR SHALL DESIGN THE BEAM CONNECTIONS FOR THE STRENGTH
LEVEL LOADS (ASD) SHOWN ON THIS PLAN, TYP. (RE: 1/S4.0)

USE MINIMUM TWO BOLT CONNECTION

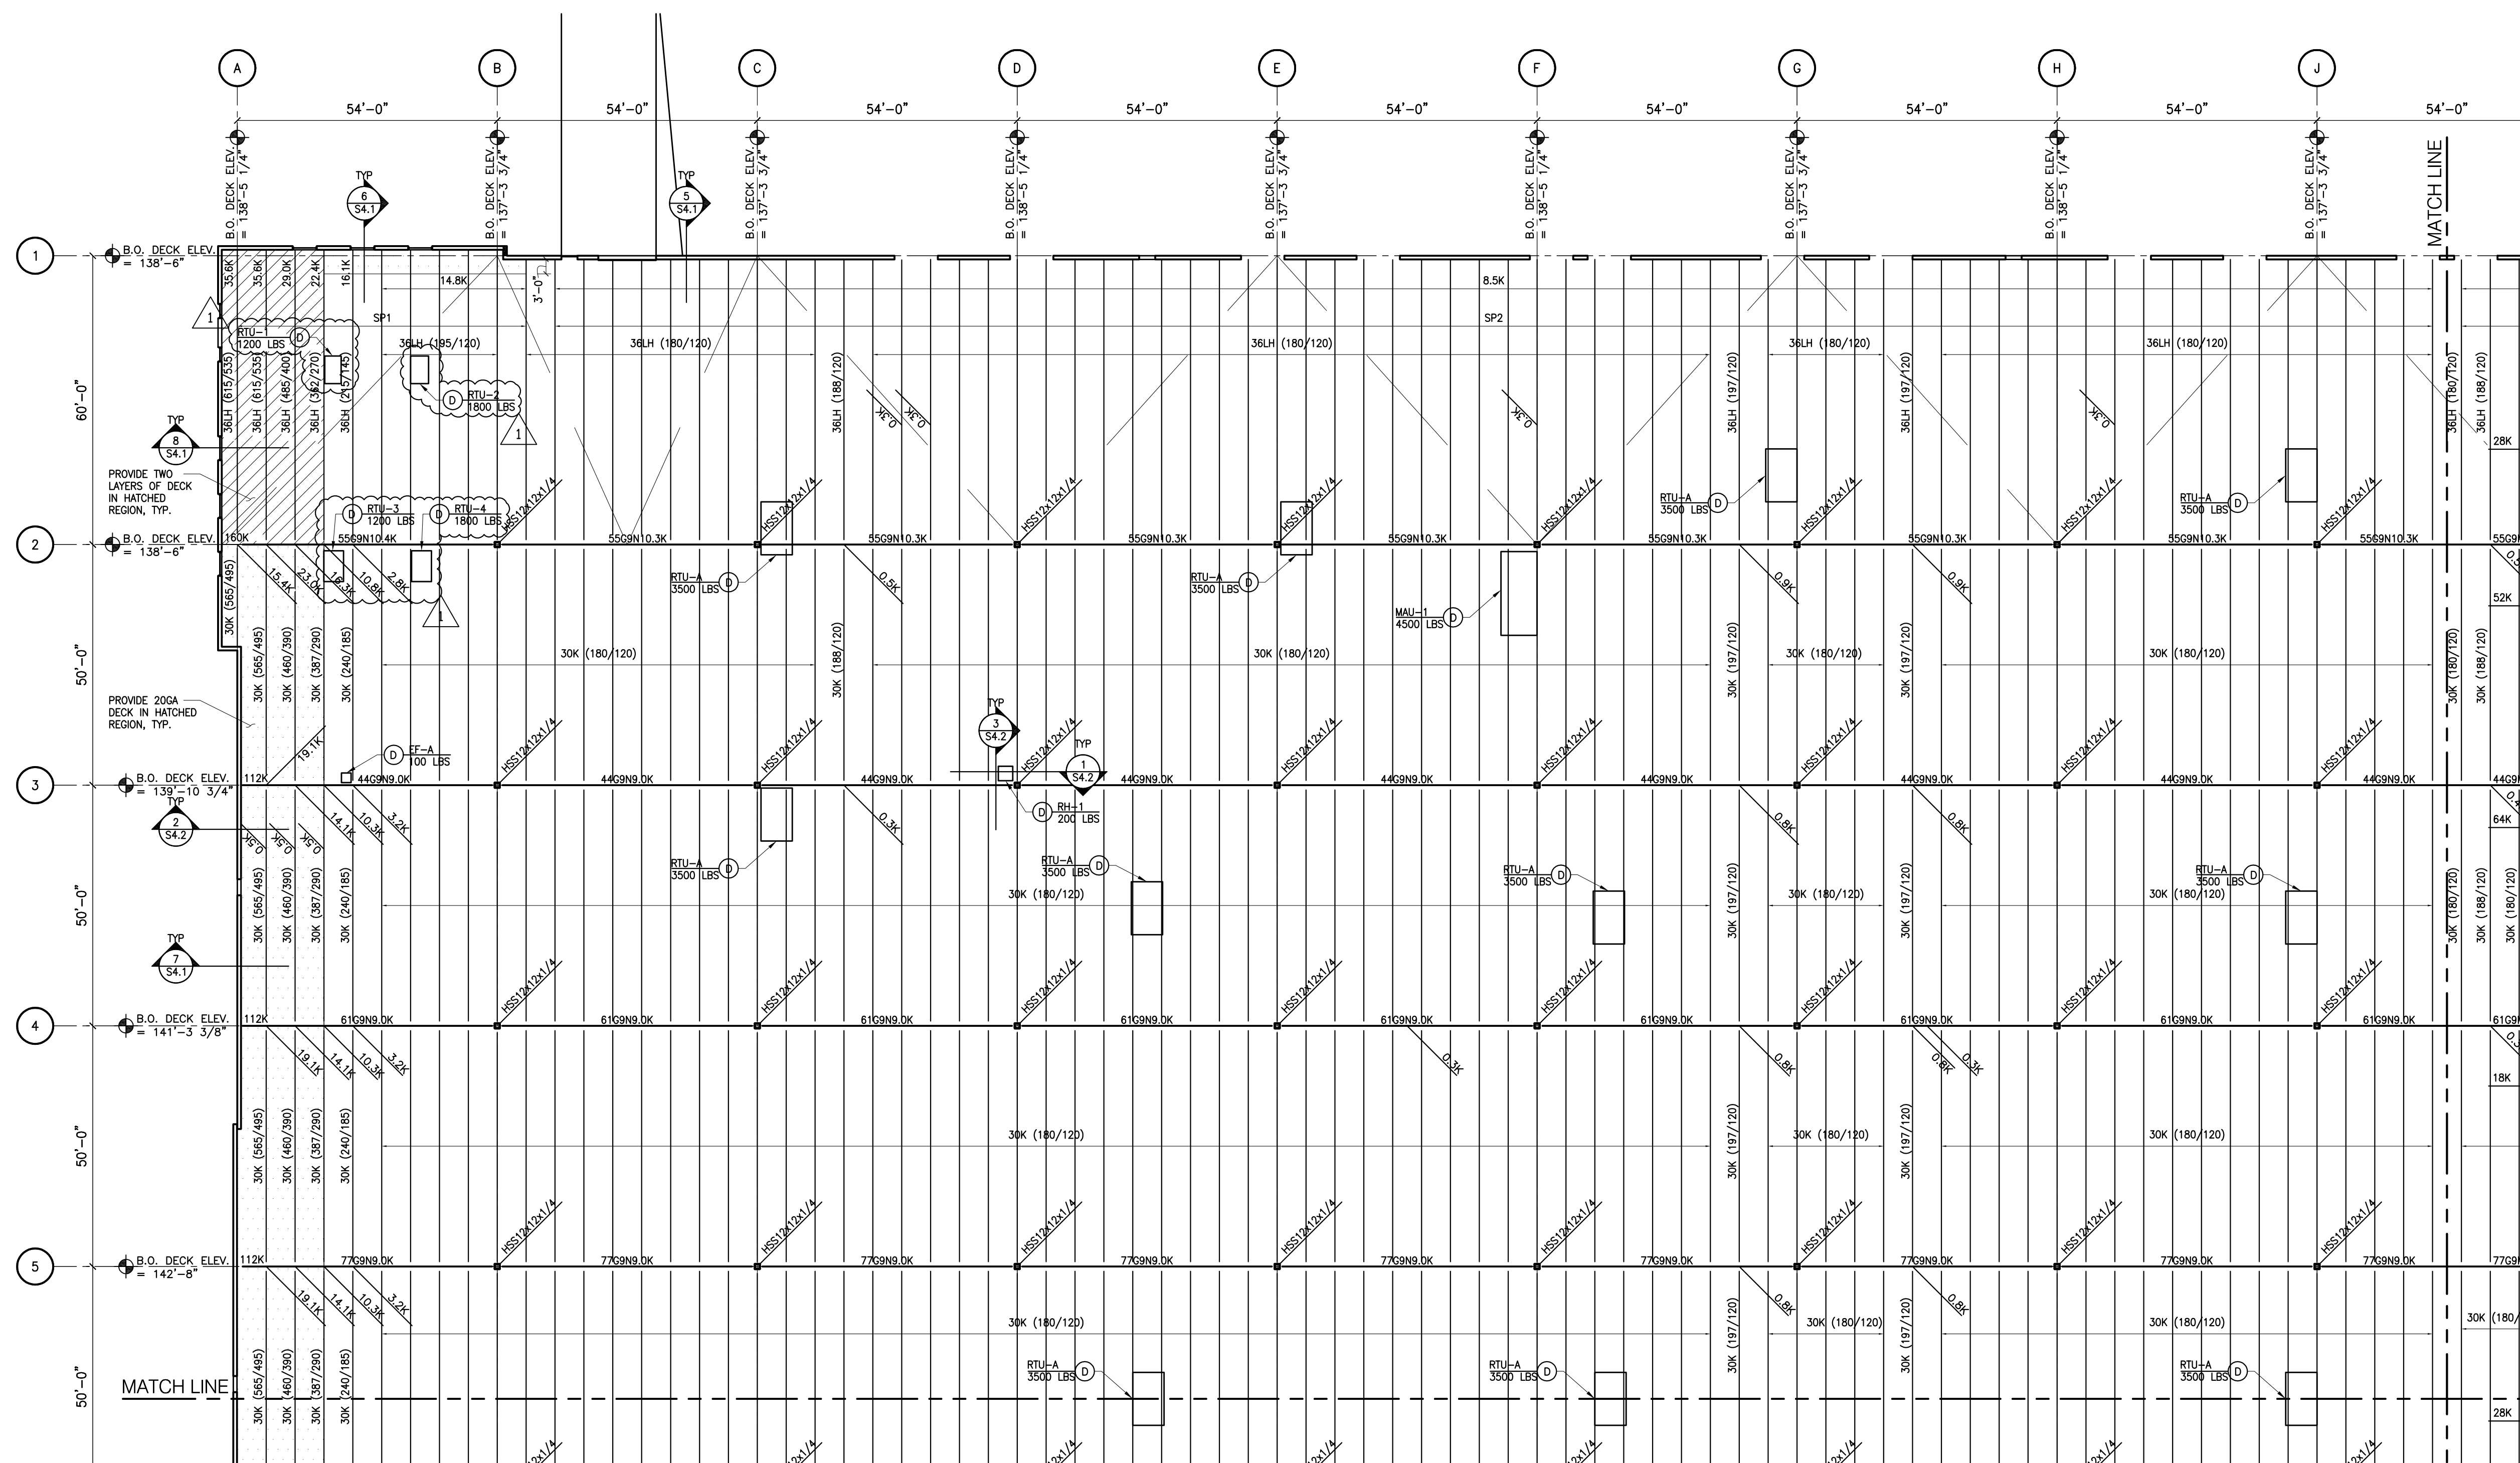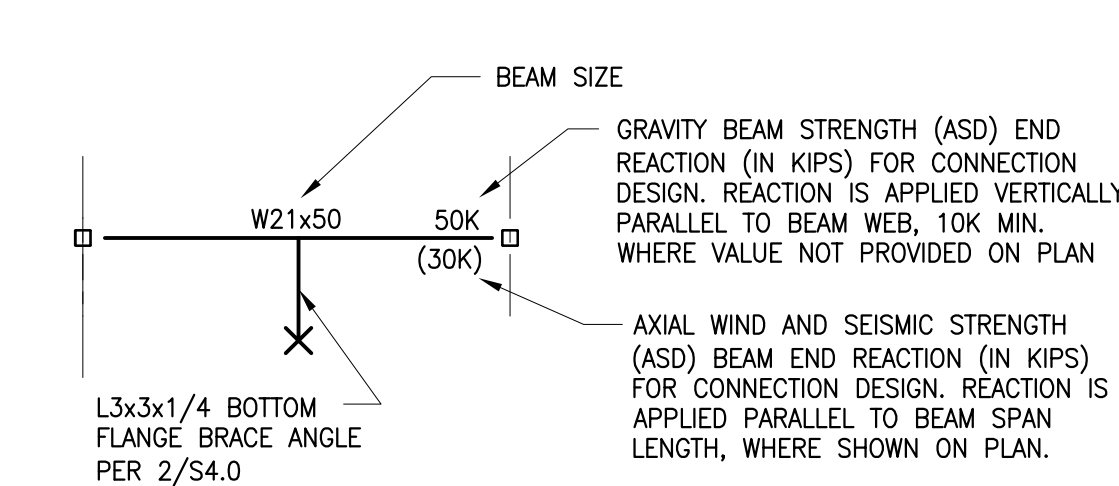

1 ENLARGED PARTIAL FRAMING PLAN
SCALE: 1"=20'-0"



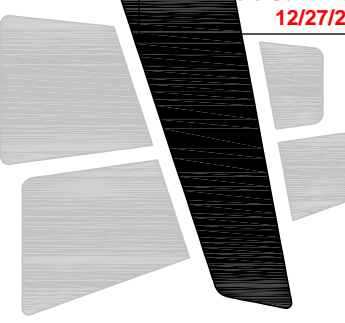

CURRAN
ARCHITECTURE

5719 LAWTON LOOP E. DR. #212
INDIANAPOLIS, IN 46216
O :: 317 . 288 . 0681
F :: 317 . 288 . 0753




SCANNELL
PROPERTIES

wallace

Wallace Engineering
Structural Consultants, Inc.

Structural and Civil Consultants
1741 McGee Street
Kansas City, Missouri 64108
816.421.8282, Fax 816.421.8338

CERTIFICATION

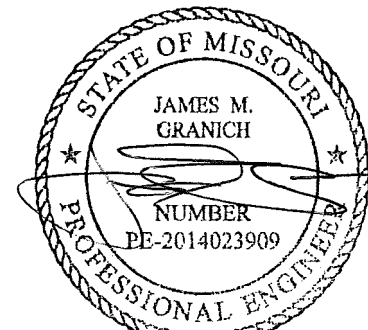

12/13/2022
Missouri COA #001268

THIS DRAWING AND THE IDEAS, DESIGNS AND CONCEPTS CONTAINED HEREIN ARE THE EXCLUSIVE INTELLECTUAL PROPERTY OF CURRAN ARCHITECTURE, AND ARE NOT TO BE USED OR REPRODUCED, WHOLE OR IN PART, WITHOUT THE WRITTEN CONSENT OF CURRAN ARCHITECTURE.
© COPYRIGHT 2021, CURRAN ARCHITECTURE

PROJECT INFORMATION

LEE'S SUMMIT LOGISTICS
BUILDING A LOT I

NW CORNER TUDOR RD & MAINST
LEE'S SUMMIT, MO

ISSUE DATES

ISSUE	DATE
ISSUE FOR PERMIT	02.18.2022
ISSUE FOR PERMIT	04.15.2022

210300

S2.2

ENLARGED PARTIAL
FRAMING PLAN


PLAN REFERENCE NOTES:

- ROOF HATCH, RE: ARCH. PROVIDE ANGLE FRAME AT OPENING, RE: 8/54.0.
- JOIST SUPPLIER SHALL DESIGN JOISTS FOR AXIAL LOAD SHOWN.
- DRAG STRUT SPLICE, RE: 9/54.0.
- ROOF TOP EQUIPMENT, RE: ARCH./MEP. PROVIDE ANGLE FRAME AND CURB RE: 5/54.0. JOIST SUPPLIER SHALL ACCOUNT FOR LOAD SHOWN ON PLAN IN JOIST DESIGN.
- CAMBER BEAM TO MATCH ADJACENT JOIST.


PLAN NOTES

- ALL EDGE ANGLES SHALL BE CONTINUOUS AND SPLICED PER 6/54.0.
- VERIFY ALL WALL OPENING, DIMENSIONS, JOINTS, BLOCKOUTS, REVEALS AND FUTURE KNOCK OUT PANELS WITH ARCHITECTURAL DRAWINGS.
- NOTE TO JOIST MANUFACTURER: PROVIDE STANDARD BRIDGING COMPLYING WITH THE APPLICABLE STEEL JOIST INSTITUTE SPECIFICATIONS TYPICAL FOR GRAVITY AND UPLIFT LOADS SUPERIMPOSED ON ALL JOISTS. DIAGONAL BRIDGING SHALL BE PROVIDED BETWEEN ADJACENT JOISTS WHENEVER BOTTOM CHORD HORIZONTAL BRIDGING IS DISCONTINUOUS. (RE: 1 & 2/54.0)
- ROOF DECK AND ROOF DECK ATTACHMENT SHALL BE PER SHEET S2.5.
- RE: 3 AND 4/54.1 FOR ADDITIONAL PRECAST PANEL CONNECTION DETAILS
- JOIST SHALL BE DESIGNED FOR ROOF TOP EQUIPMENT, RE: ARCH./MEP. PROVIDE ANGLE FRAME AND CURB, RE: 5/54.0. JOIST SUPPLIER SHALL ACCOUNT FOR LOAD SHOWN ON PLAN IN JOIST DESIGN.
- JOIST AND JOIST GIRDER DEPTHS SHALL BE LIMITED SO THAT 36"-0" CLEAR HEIGHT TO BOTTOM OF STRUCTURE IS MAINTAINED

JOIST LEGEND

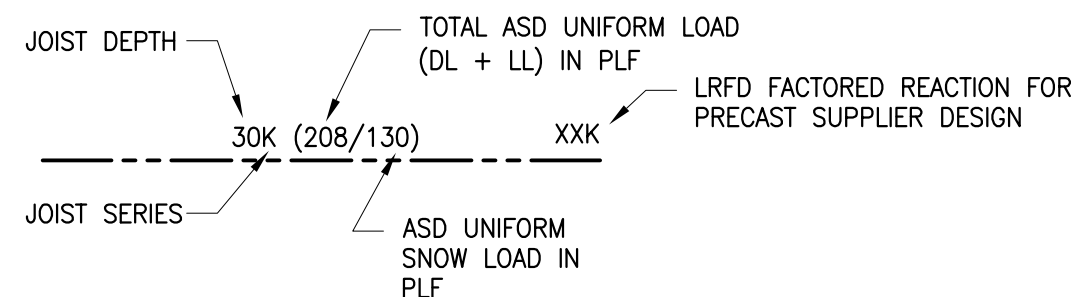



JOIST GIRDER LEGEND

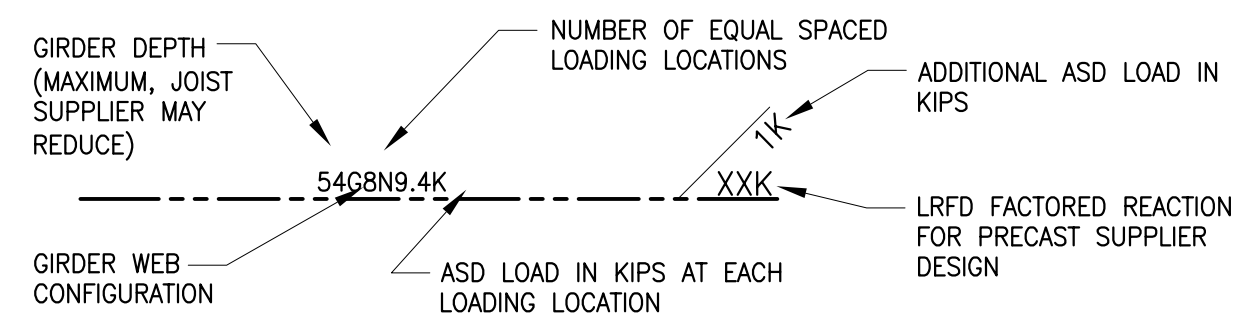


BEAM REACTION LEGEND

STEEL FABRICATOR SHALL DESIGN THE BEAM CONNECTIONS FOR THE STRENGTH LEVEL LOADS (ASD) SHOWN ON THIS PLAN, TYP. (RE: 1/54.0)

USE MINIMUM TWO BOLT CONNECTION

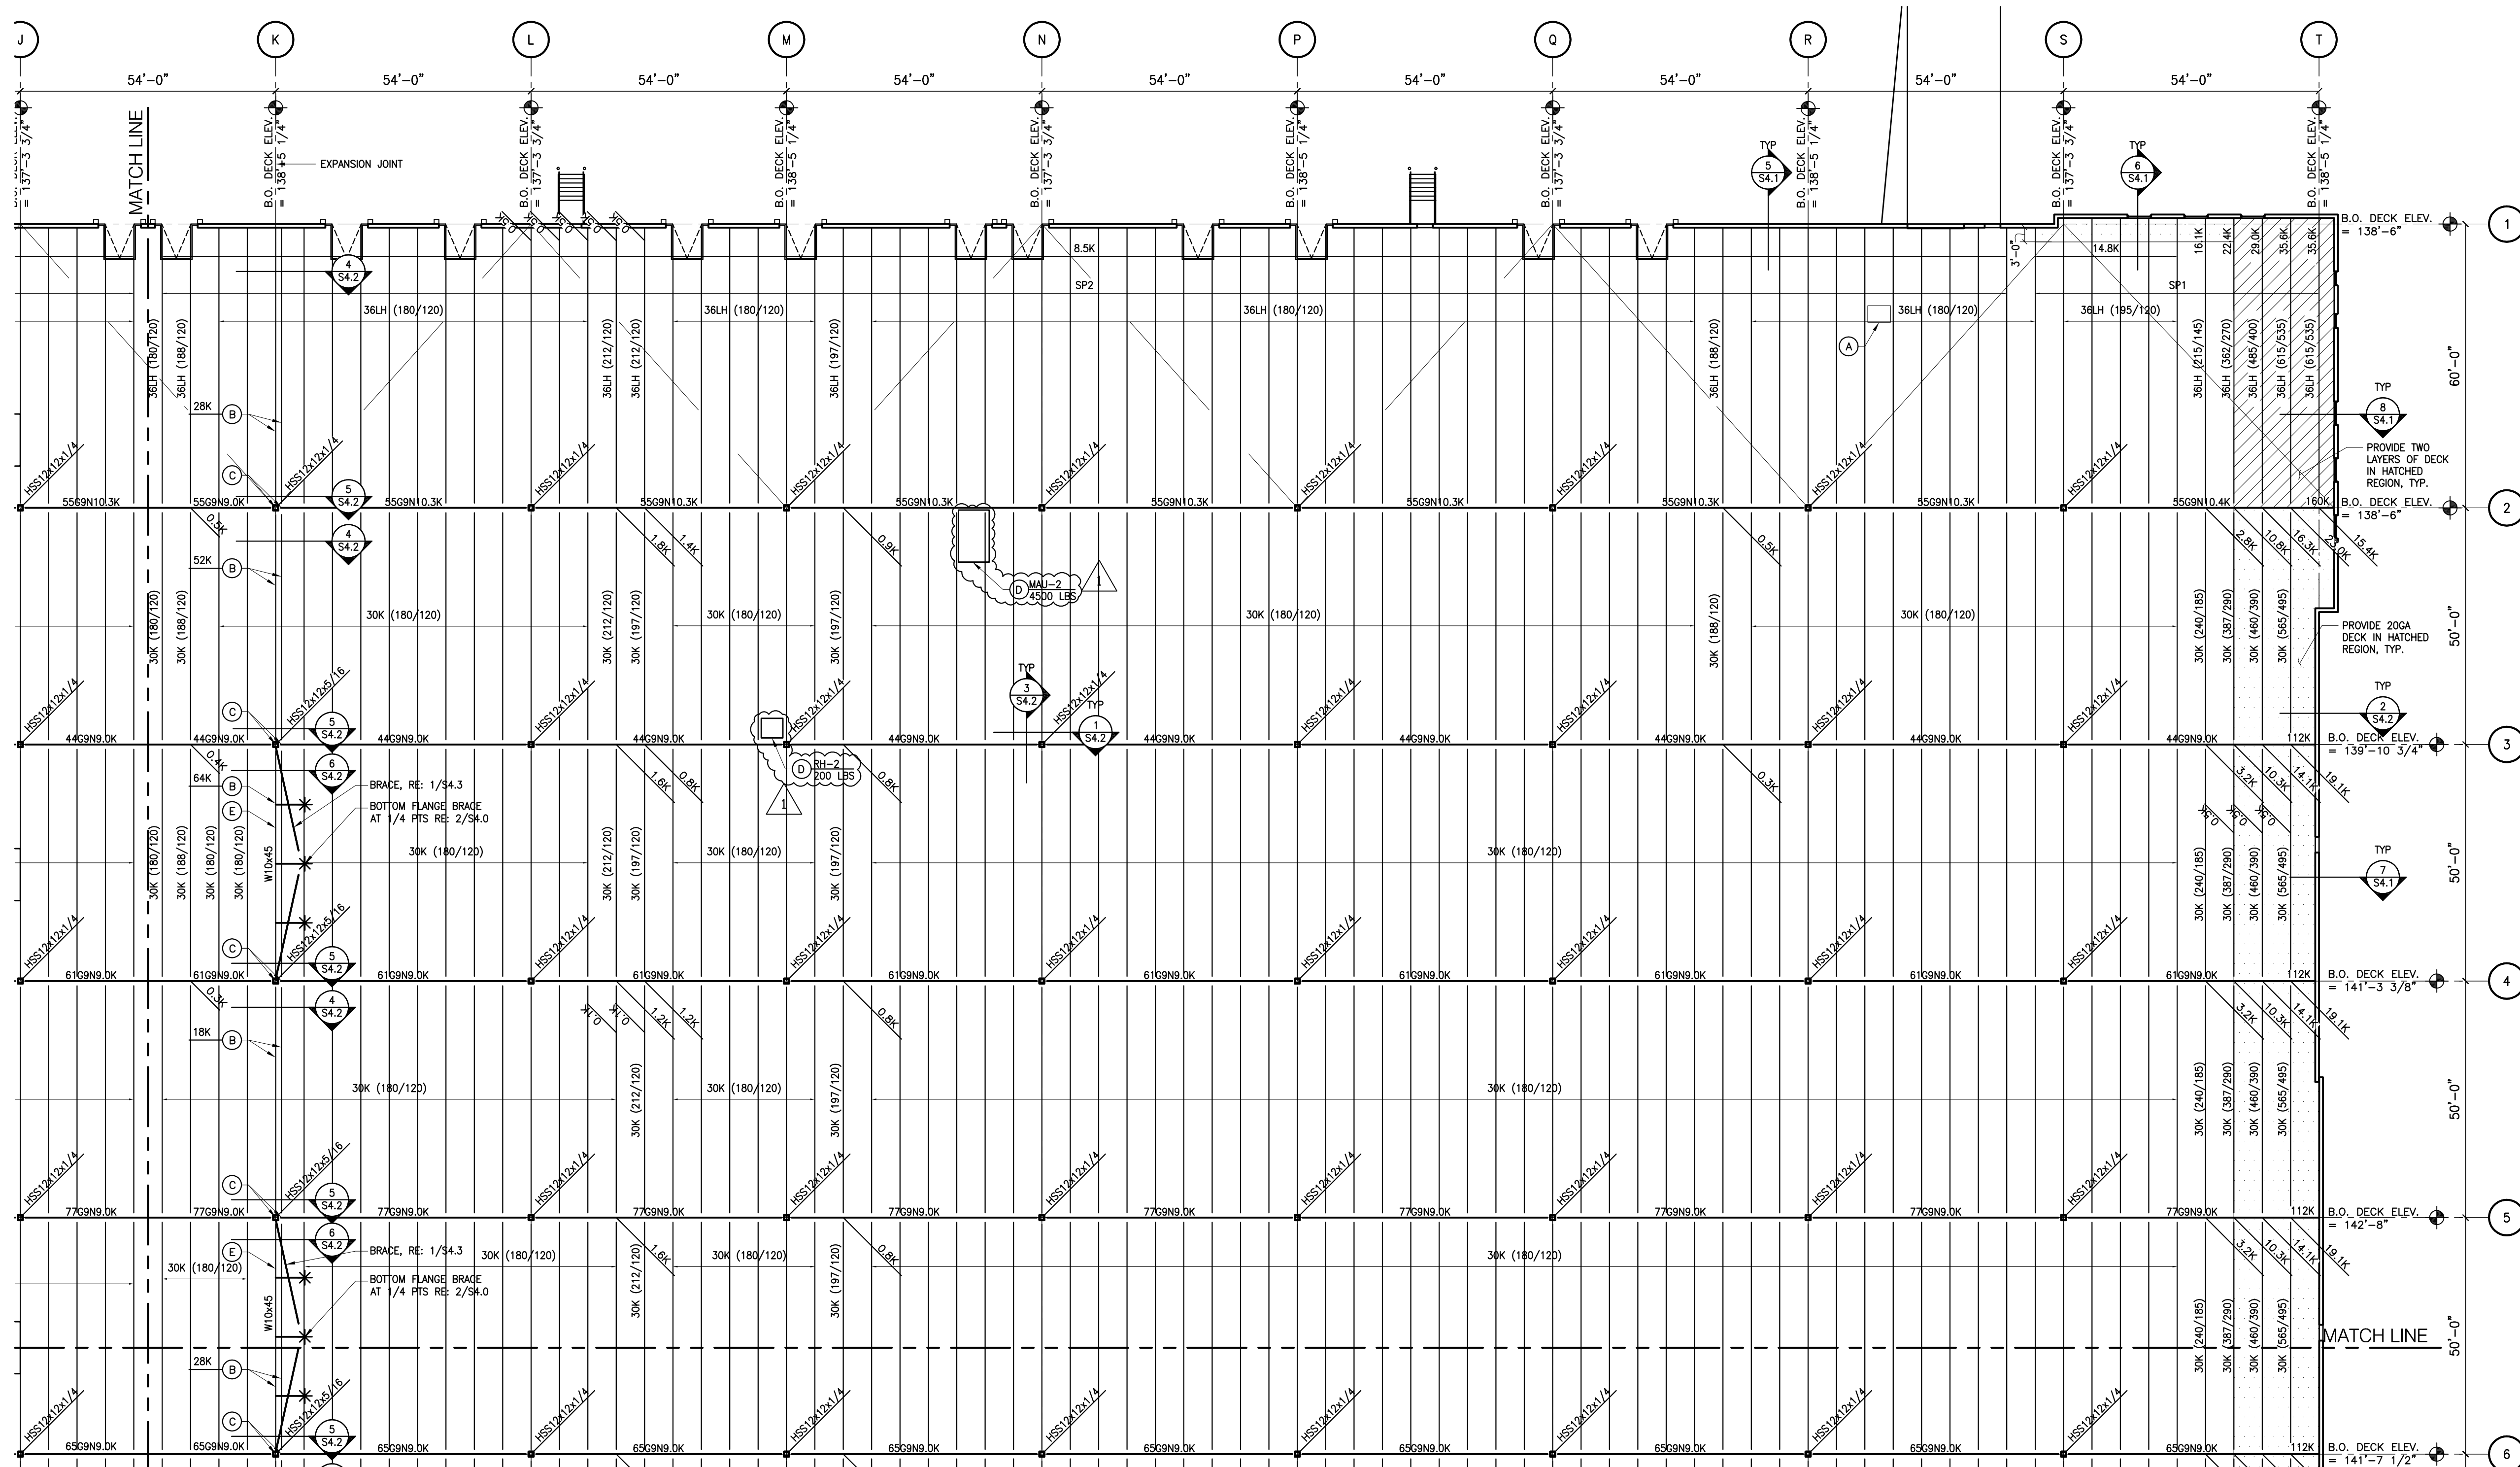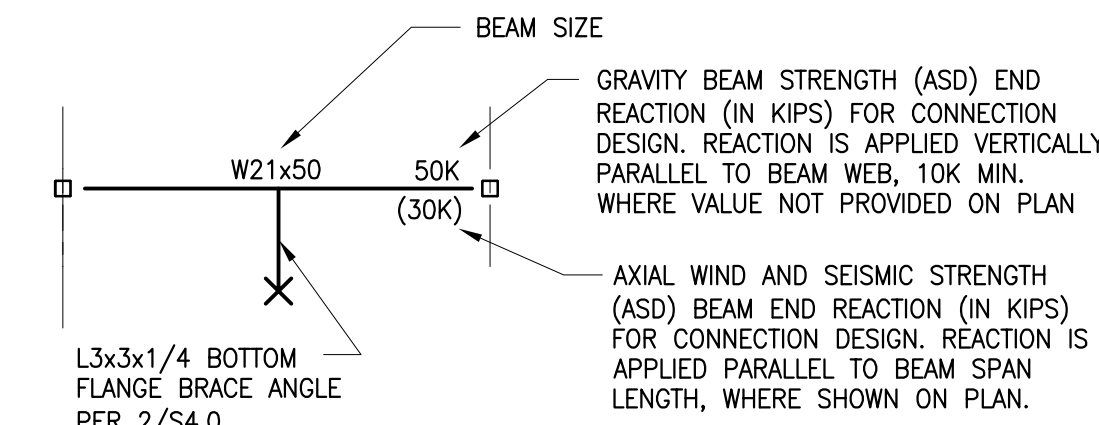

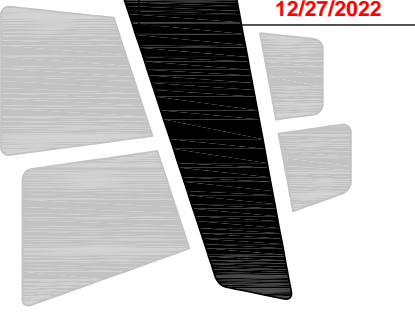

CURRAN
ARCHITECTURE

5719 LAWTON LOOP E. DR. #212
INDIANAPOLIS, IN 46216
O :: 317 . 288 . 0681
F :: 317 . 288 . 0753

SCANNELL
PROPERTIES



Wallace Engineering
Structural Consultants, Inc.
Structural and Civil Consultants
1741 McGee Street
Kansas City, Missouri 64108
816.421.8282, Fax 816.421.8338

CERTIFICATION



12/13/2022
Missouri COA #001268

THIS DRAWING AND THE IDEAS, DESIGNS AND CONCEPTS CONTAINED HEREIN ARE THE EXCLUSIVE INTELLECTUAL PROPERTY OF CURRAN ARCHITECTURE, AND ARE NOT TO BE USED OR REPRODUCED, WHOLE OR IN PART, WITHOUT THE WRITTEN CONSENT OF CURRAN ARCHITECTURE.
© COPYRIGHT 2021, CURRAN ARCHITECTURE

PROJECT INFORMATION

LEE'S SUMMIT LOGISTICS
BUILDING A LOT I

NW CORNER TUDOR RD & MAINST
LEE'S SUMMIT, MO

ISSUE DATES

ISSUE	DATE
ISSUE FOR PERMIT	02.18.2022
ISSUE FOR PERMIT	04.15.2022

210300

S2.3
ENLARGED PARTIAL
FRAMING PLAN


PLAN REFERENCE NOTES:

- (A) ROOF HATCH, RE: ARCH. PROVIDE ANGLE FRAME AT OPENING, RE: 8/54.0
- (B) JOIST SUPPLIER SHALL DESIGN JOISTS FOR AXIAL LOAD SHOWN.
- (C) DRAG STRUT SPLICE, RE: 9/54.0.
- (D) ROOF TOP EQUIPMENT, RE: ARCH./MEP. PROVIDE ANGLE FRAME AND CURB RE: 5/54.0 JOIST SUPPLIER SHALL ACCOUNT FOR LOAD SHOWN ON PLAN IN JOIST DESIGN.
- (E) CAMBER BEAM TO MATCH ADJACENT JOIST.


PLAN NOTES

- 1. ALL EDGE ANGLES SHALL BE CONTINUOUS AND SPLICED PER 6/54.0.
- 2. VERIFY ALL WALL OPENING, DIMENSIONS, JOINTS, BLOCKOUTS, REVEALS AND FUTURE KNOCK OUT PANELS WITH ARCHITECTURAL DRAWINGS.
- 3. NOTE TO JOIST MANUFACTURER: PROVIDE STANDARD BRIDGING COMPLYING WITH THE APPLICABLE STEEL JOIST INSTITUTE SPECIFICATIONS TYPICAL FOR GRAVITY AND UPLIFT LOADS SUPERIMPOSED ON ALL JOISTS. DIAGONAL BRIDGING SHALL BE PROVIDED BETWEEN ADJACENT JOISTS WHENEVER BOTTOM CHORD HORIZONTAL BRIDGING IS DISCONTINUOUS. (RE: 1 & 2/54.0)
- 4. ROOF DECK AND ROOF DECK ATTACHMENT SHALL BE PER SHEET S2.5.
- 5. RE: 3 AND 4/54.1 FOR ADDITIONAL PRECAST PANEL CONNECTION DETAILS.
- 6. JOIST SHALL BE DESIGNED FOR ROOF TOP EQUIPMENT, RE: ARCH./MEP. PROVIDE ANGLE FRAME AND CURB, RE: 5/54.0. JOIST SUPPLIER SHALL ACCOUNT FOR LOAD SHOWN ON PLAN IN JOIST DESIGN.
- 7. JOIST AND JOIST GIRDER DEPTHS SHALL BE LIMITED SO THAT 36"-0" CLEAR HEIGHT TO BOTTOM OF STRUCTURE IS MAINTAINED



JOIST LEGEND

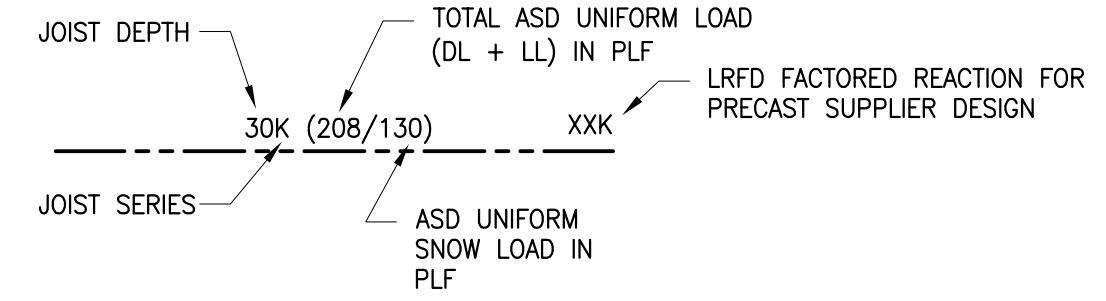

JOIST GIRDER LEGEND

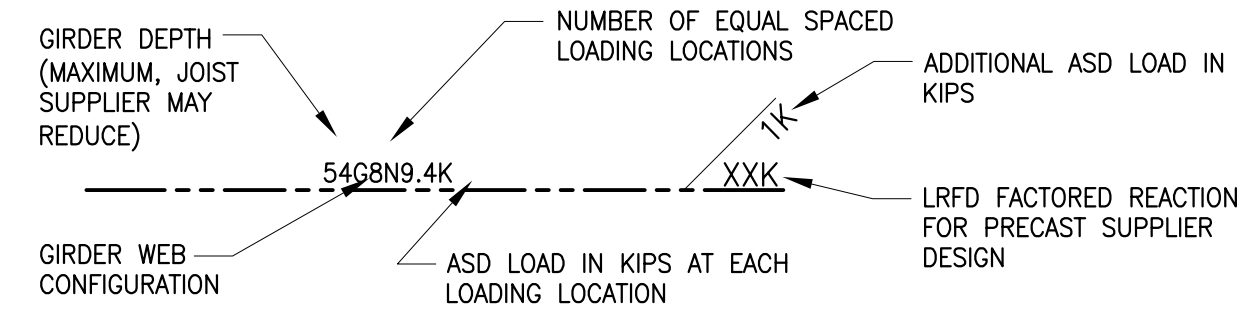

BEAM REACTION LEGEND

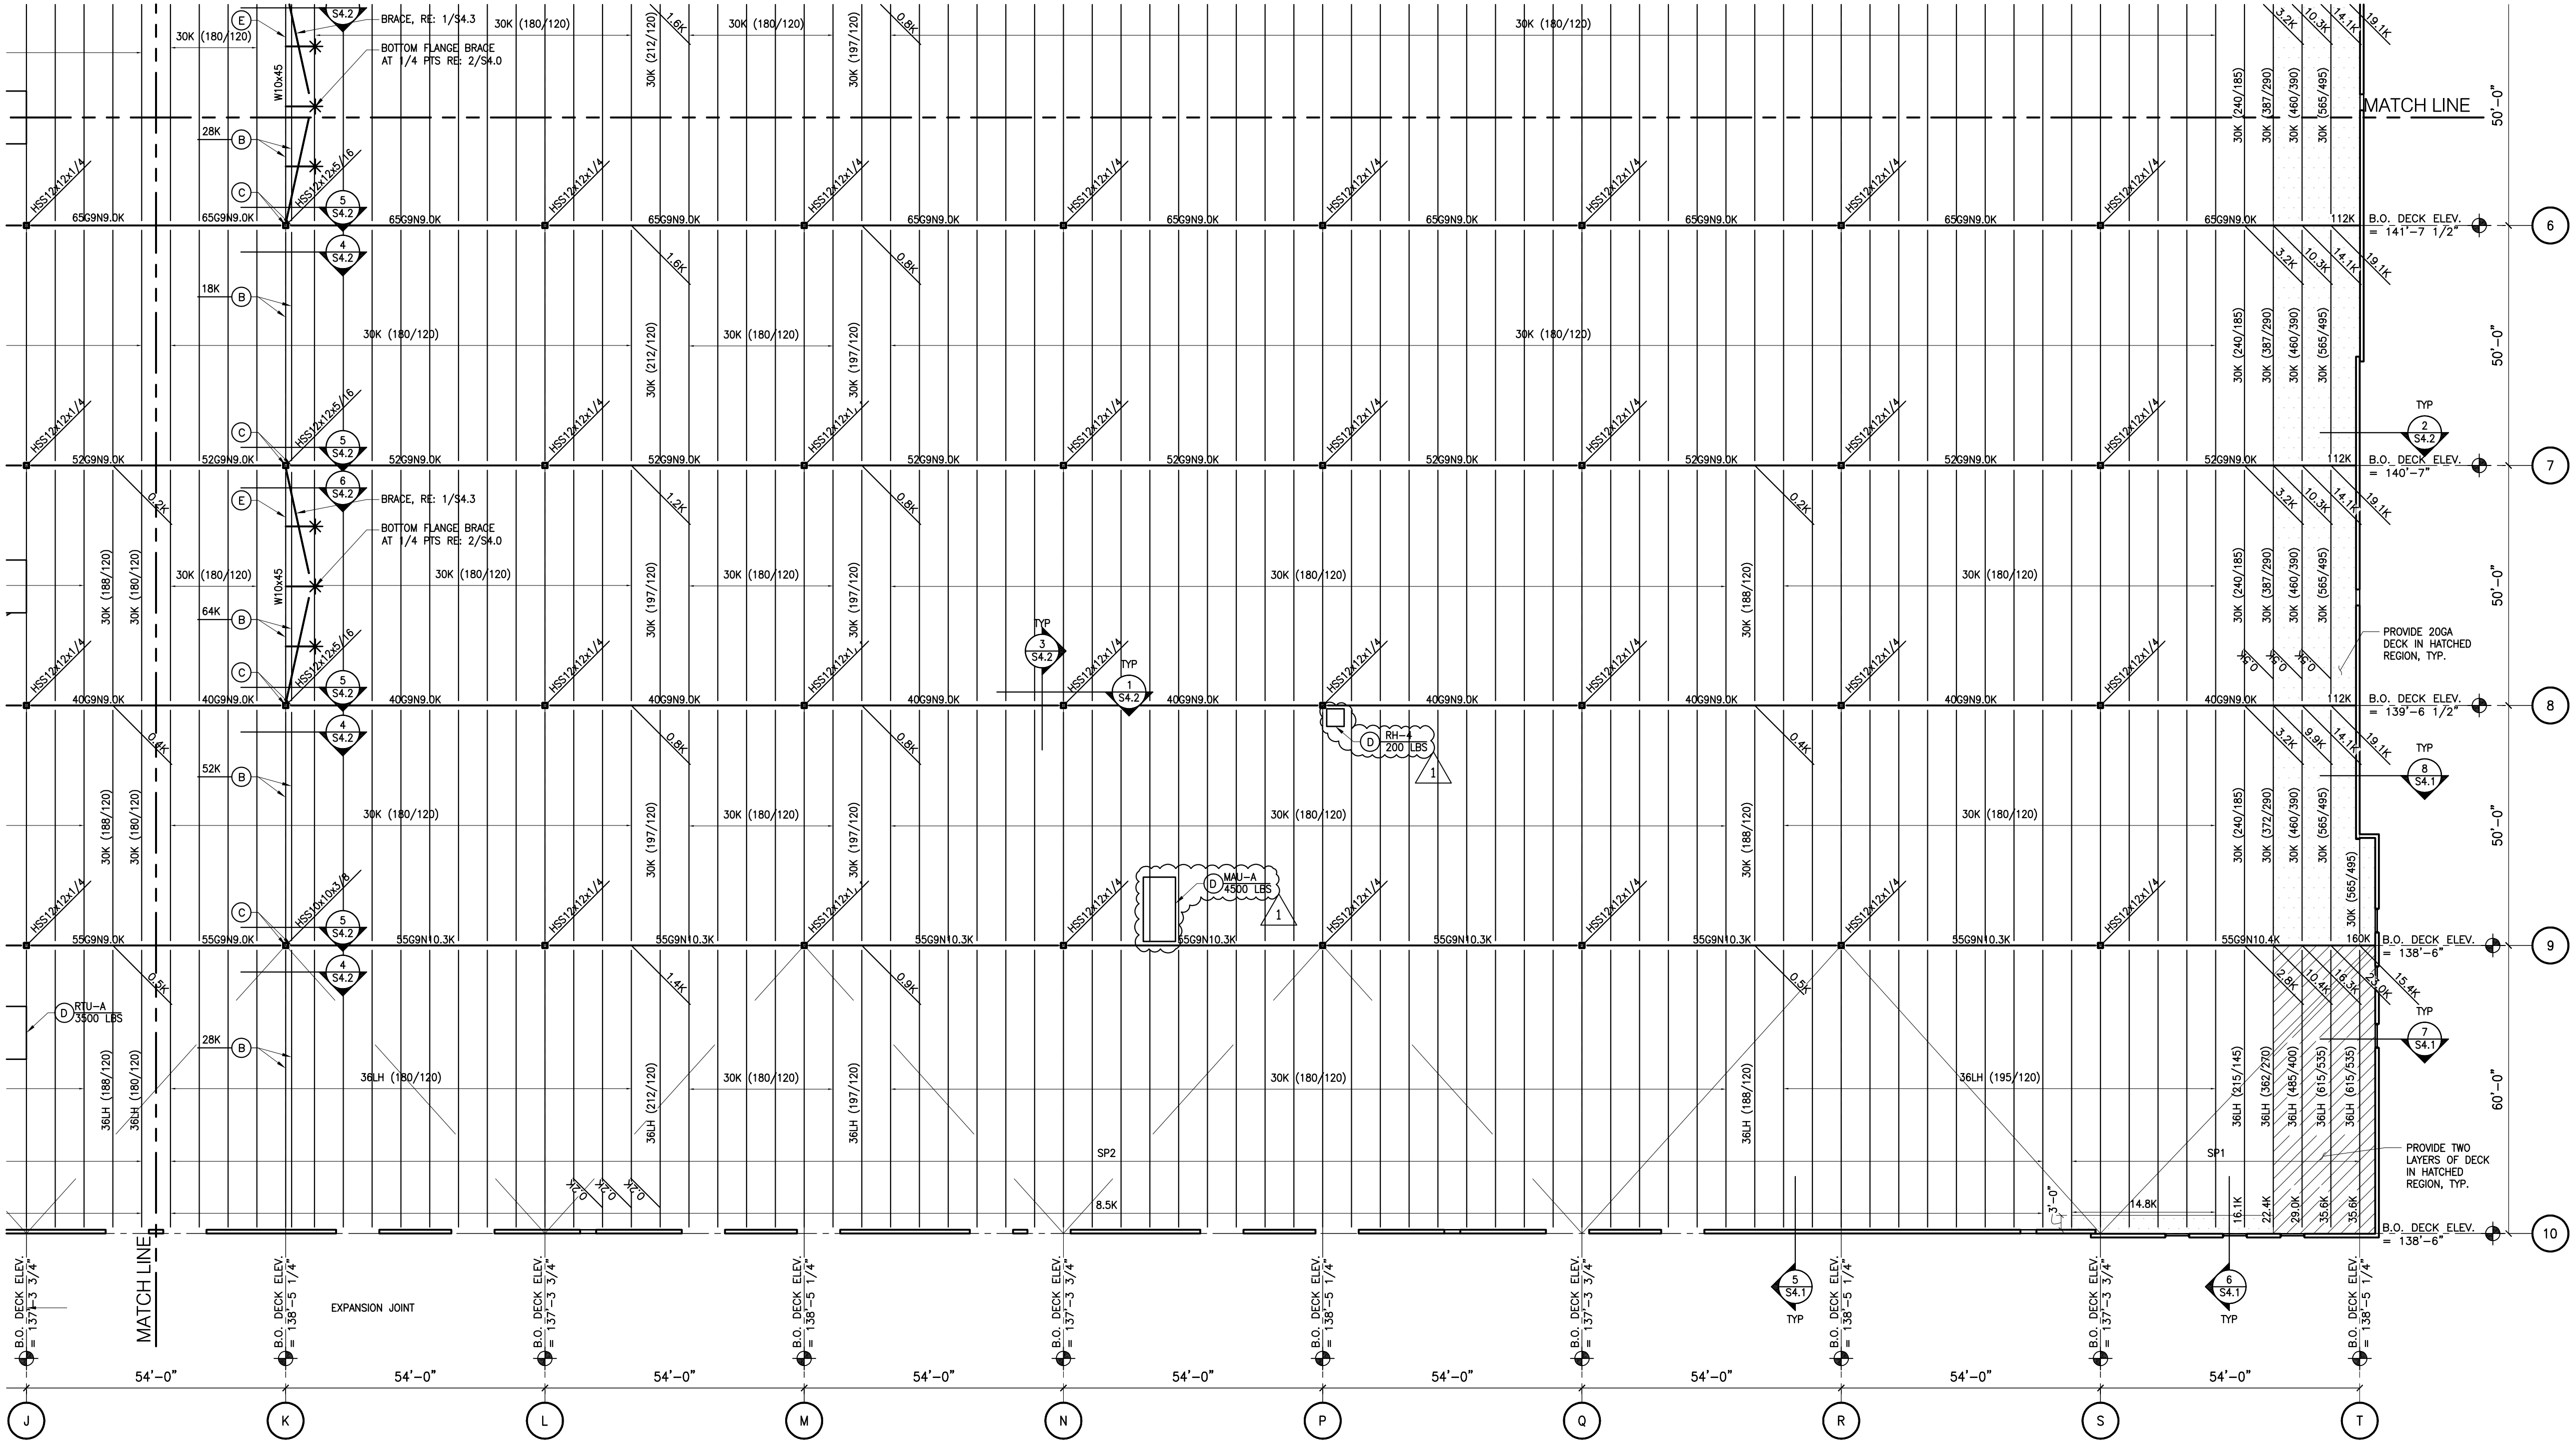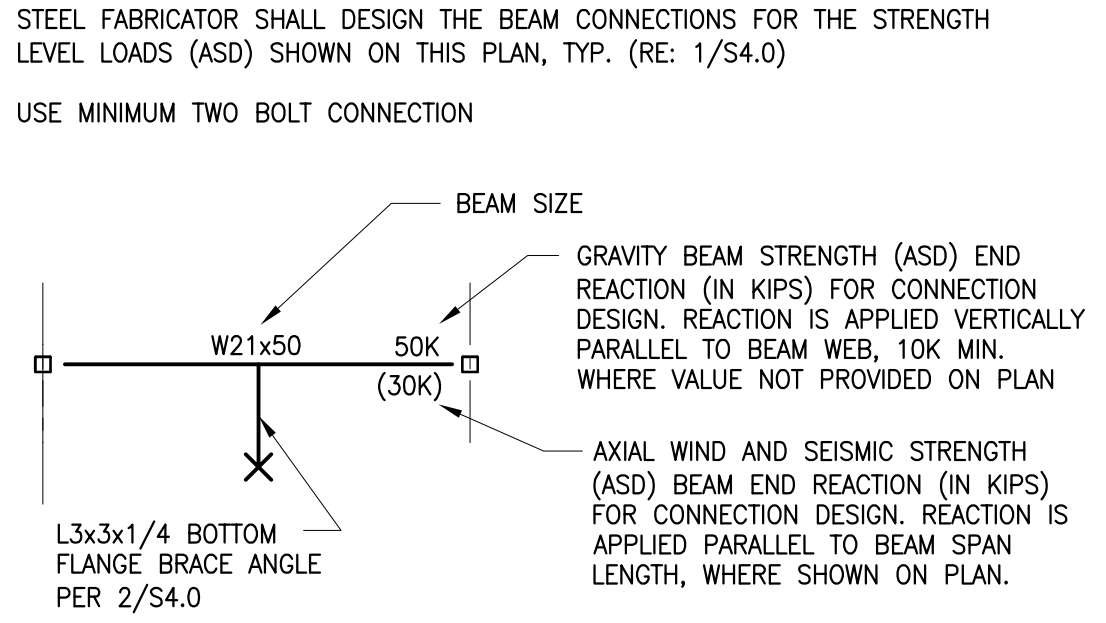

1 ENLARGED PARTIAL FRAMING PLAN
SCALE: 1"=20'-0"

5719 LAWTON LOOP E. DR. #2
INDIANAPOLIS, IN 46216
O :: 317.288.0681
F :: 317.288.0753



THIS DRAWING AND THE IDEAS, DESIGNS AND CONCEPTS CONTAINED HEREIN ARE THE EXCLUSIVE INTELLECTUAL PROPERTY OF CURRAN ARCHITECTURE, AND ARE NOT TO BE USED OR REPRODUCED, WHOLE OR IN PART, WITHOUT THE WRITTEN CONSENT OF CURRAN ARCHITECTURE.
© COPYRIGHT 2021, CURRAN ARCHITECTURE

E'S SUMMIT LOGISTICS BUILDING A LOT 1

DATE	DESCRIPTION
02.18.2023	PAID FOR PERMIT
04.15.2023	PAID FOR PERMIT

32.4

- Ⓐ ROOF HATCH, RE: ARCH. PROVIDE ANGLE FRAME AT OPENING, RE: 8/54.0
- Ⓑ JOIST SUPPLIER SHALL DESIGN JOISTS FOR AXIAL LOAD SHOWN.
- Ⓒ DRAG STRUT SPICE, RE: 9/54.0.
- Ⓓ ROOF TOP EQUIPMENT, RE: ARCH./MEP. PROVIDE ANGLE FRAME AND CURB RE: 5/54.0 JOIST SUPPLIER SHALL ACCOUNT FOR LOAD SHOWN ON PLAN IN JOIST DESIGN.
- Ⓔ CAMBER BEAM TO MATCH ADJACENT JOIST.

1. ALL EDGE ANGLES SHALL BE CONTINUOUS AND SPLICED PER 6/S4.0.
2. VERIFY ALL WALL OPENING, DIMENSIONS, JOINTS, BLOCKOUTS, REVEALS AND FUTURE KNOCK OUT PANELS WITH ARCHITECTURAL DRAWINGS.
3. NOTE TO JOIST MANUFACTURER: PROVIDE STANDARD BRIDGING COMPLYING WITH THE APPLICABLE STEEL JOIST INSTITUTE SPECIFICATIONS TYPICAL FOR GRAVITY AND UPLIFT LOADS SUPERIMPOSED ON ALL JOISTS. DIAGONAL BRIDGING SHALL BE PROVIDED BETWEEN ADJACENT JOISTS WHENEVER BOTTOM CHORD HORIZONTAL BRIDGING IS DISCONTINUOUS. (RE: 1 & 2/S4.0)
4. ROOF DECK AND ROOF DECK ATTACHMENT SHALL BE PER SHEET S2.5.
5. RE: 3 AND 4/S4.1 FOR ADDITIONAL PRECAST PANEL CONNECTION DETAILS
6. JOIST SHALL BE DESIGNED FOR ROOF TOP EQUIPMENT, RE: ARCH./MEP. PROVIDE ANGLE FRAME AND CURB RE: 5/S4.0. JOIST SUPPLIER SHALL ACCOUNT FOR LOAD SHOWN ON PLAN IN JOIST DESIGN.
7. JOIST AND JOIST GIRDER DEPTHS SHALL BE LIMITED SO THAT 36"-0" CLEAR HEIGHT TO BOTTOM OF STRUCTURE IS MAINTAINED

JOIST DEPTH

30K (208/130)

TOTAL ASD UNIFORM LOAD (DL + LL) IN PLF

XXK

LRFD FACTORED REACTION FOR PRECAST SUPPLIER DESIGN



JOIST SERIES

ASD UNIFORM SNOW LOAD IN PLF

Diagram illustrating the components and dimensions of a girder section:

- GIRDER DEPTH (MAXIMUM, JOIST SUPPLIER MAY REDUCE)**: Indicated by a vertical dimension line on the left.
- NUMBER OF EQUAL SPACED LOADING LOCATIONS**: Indicated by a horizontal dimension line above the girder.
- ADDITIONAL ASD LOAD IN KIPS**: Indicated by a vertical dimension line on the right.
- 54G8N9.4K**: Label for the girder section.
- 1K**: Label for the additional ASD load.
- XXK**: Label for the LRFD factored reaction.
- LRFD FACTORED REACTION FOR PRECAST SUPPLIER DESIGN**: Indicated by a vertical dimension line on the right.
- GIRDER WEB CONFIGURATION**: Indicated by a vertical dimension line on the left.
- ASD LOAD IN KIPS AT EACH LOADING LOCATION**: Indicated by a horizontal dimension line below the girder.

USE MINIMUM TWO BOLT CONNECTION

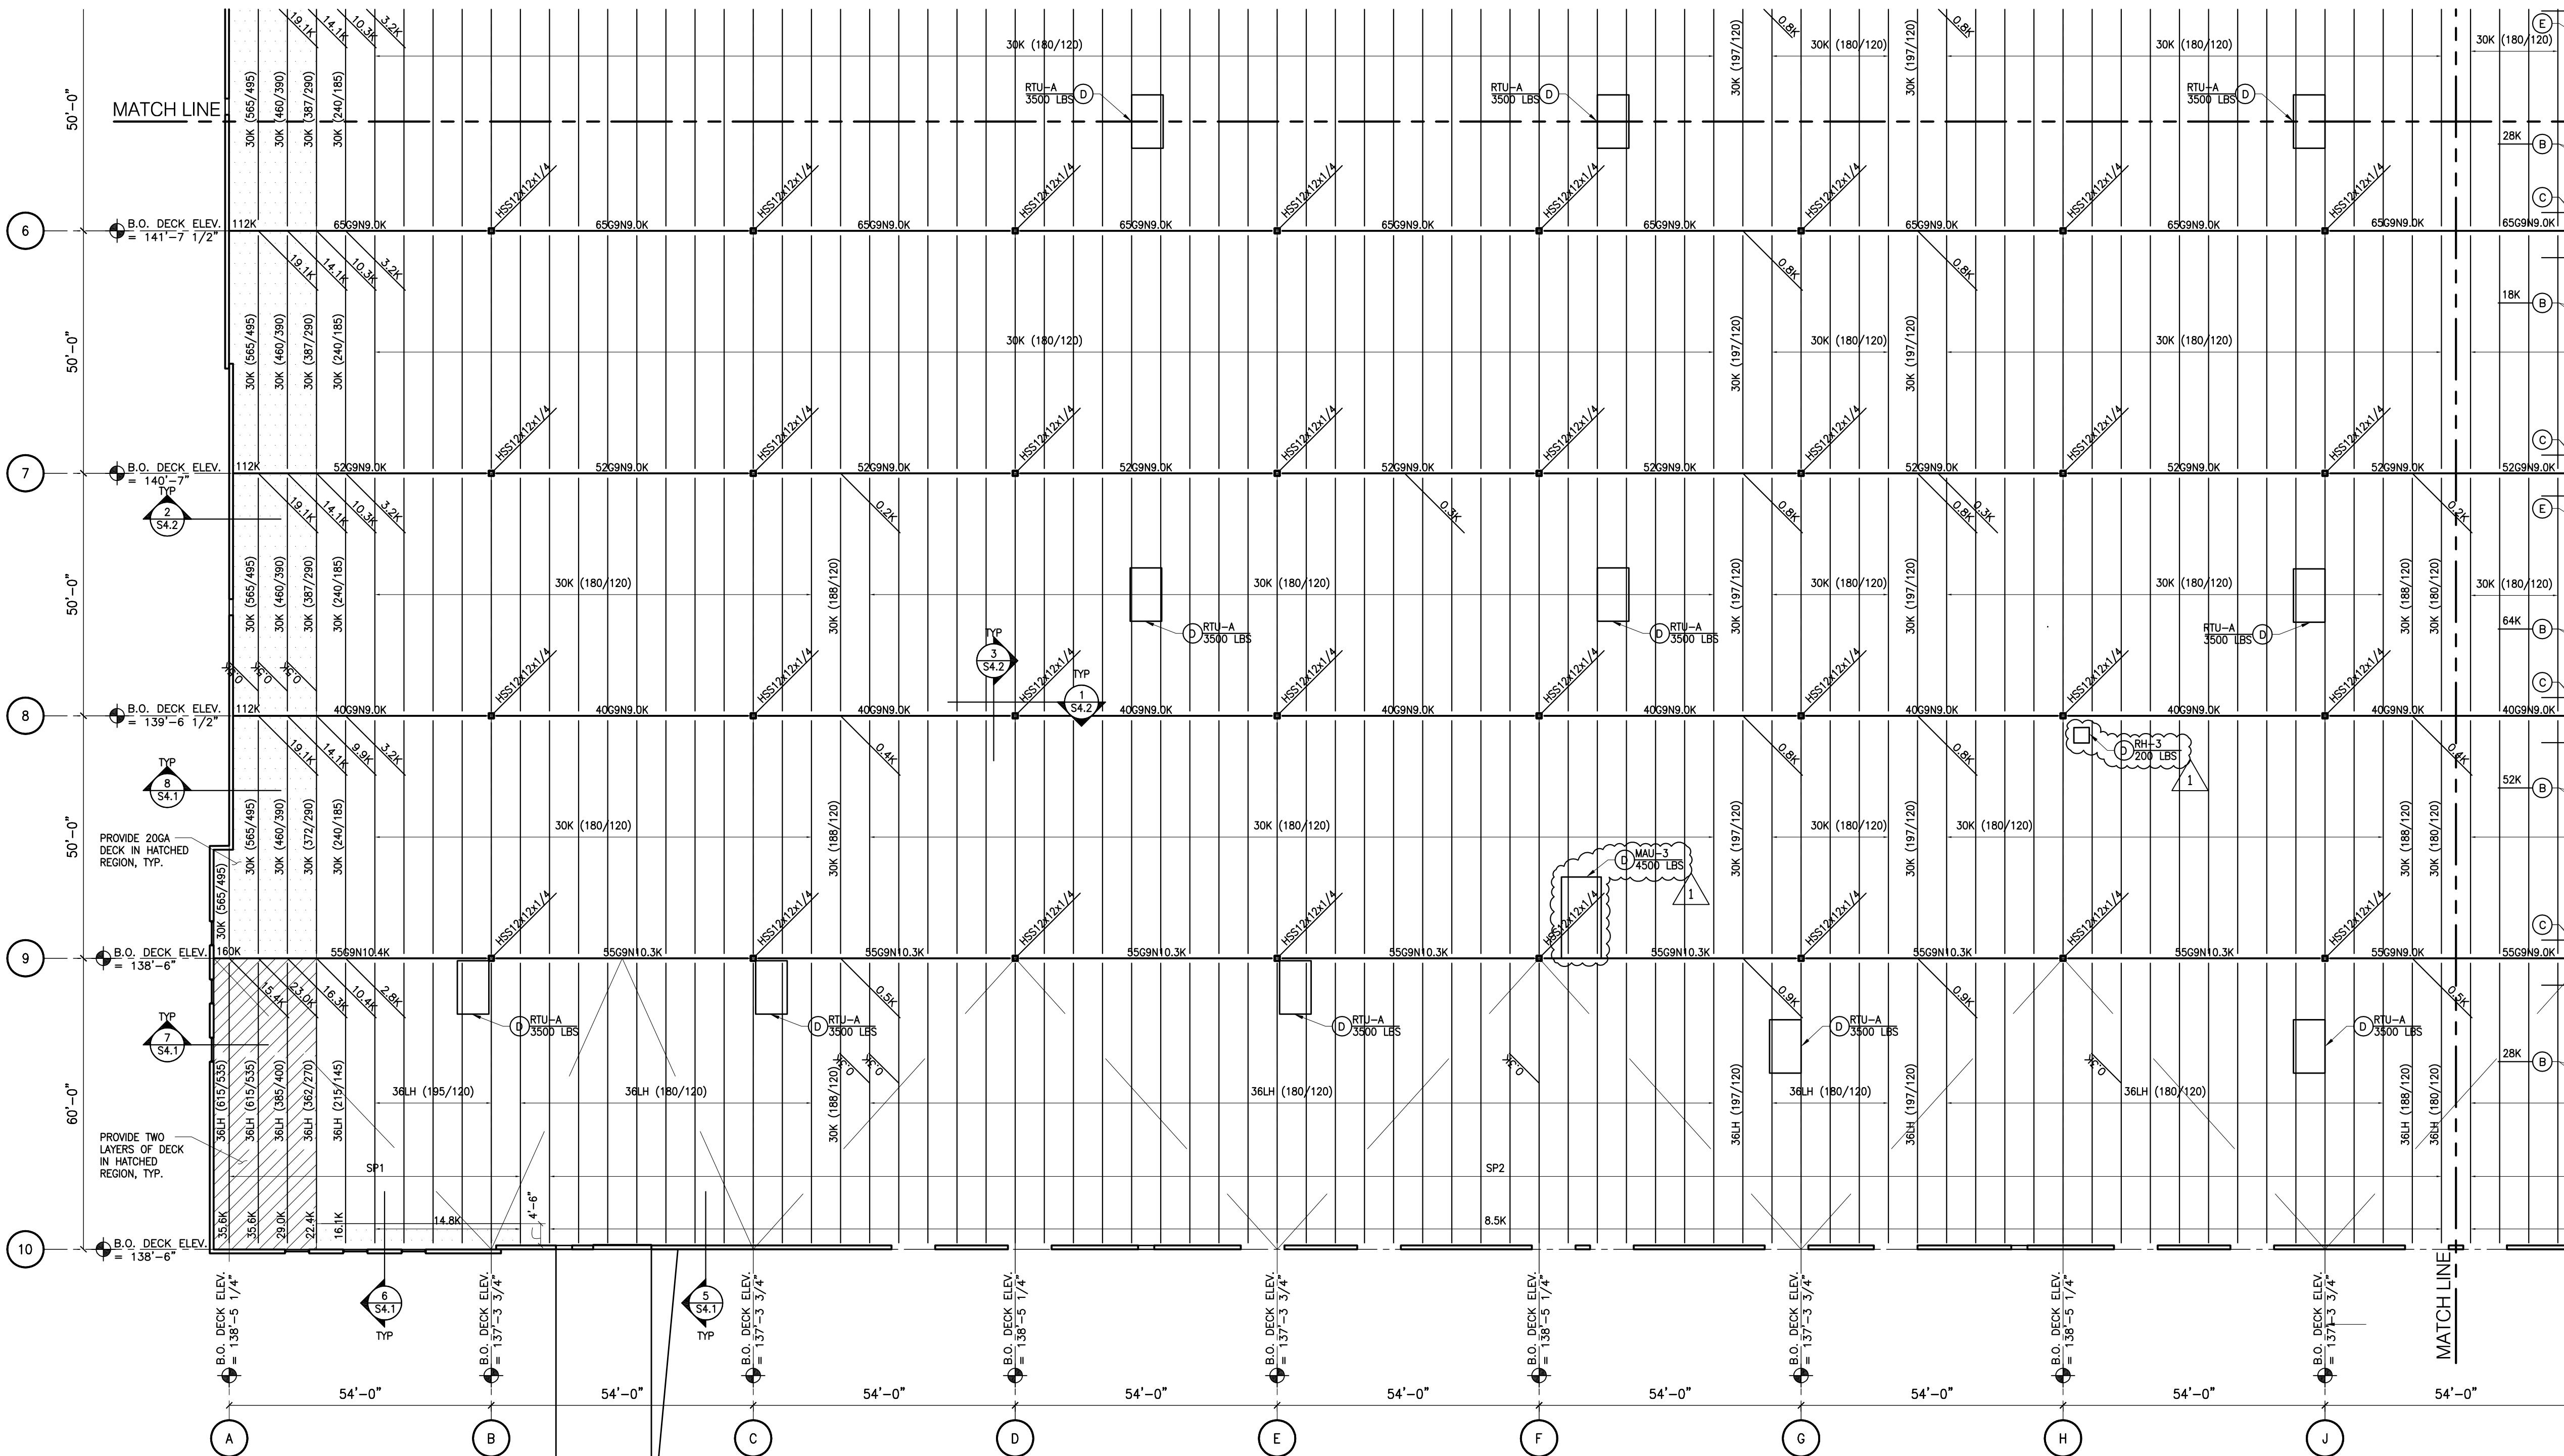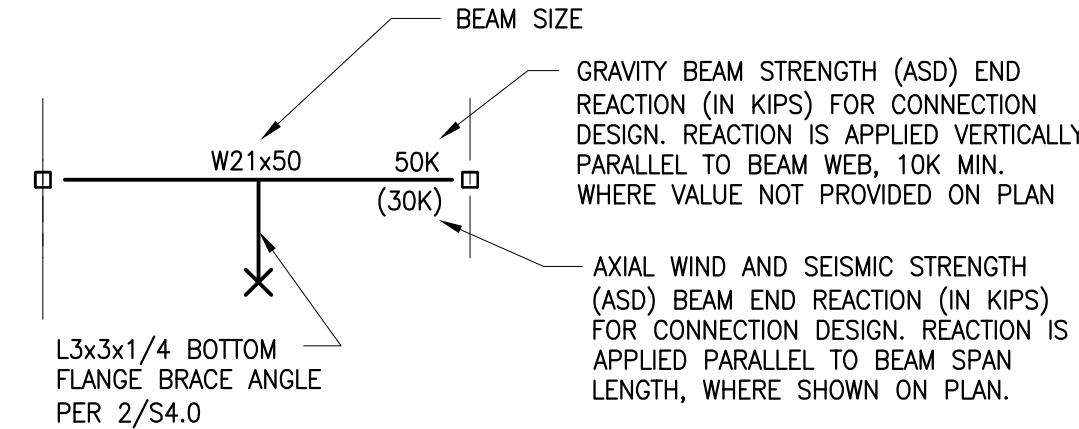


1 ENLARGED PARTIAL FRAMING PLAN
SCALE: 1"=20'-0"



5719 LAWTON LOOP E. DR. #212
INDIANAPOLIS, IN 46216
O :: 317 . 288 . 0681
F :: 317 . 288 . 0753



CERTIFICATION

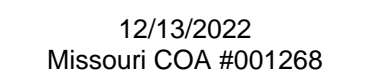

PROJECT INFORMATION

NW CORNER TUDOR RD & MAINST
LEE'S SUMMIT, MO

ISSUE	DATE
ISSUE FOR PERMIT	02.18.2022
ISSUE FOR PERMIT	04.15.2022


S2.5



719 LAWTON LOOP E. DR. #212
INDIANAPOLIS, IN 46216
O :: 317.288.0681
F :: 317.288.0753



CERTIFICATION

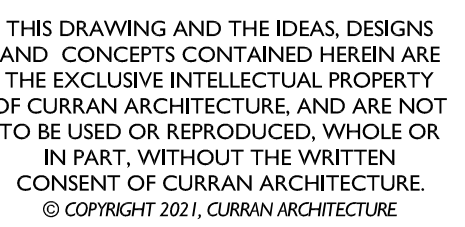


LEE'S SUMMIT LOGISTICS BUILDING A LOT 1

ISSUE	DATE
ISSUE FOR PERMIT	02.18.2022
ISSUE FOR PERMIT	04.15.2022


S2.6

THE LATERAL SYSTEM OF THE BUILDING IS A COMBINATION OF SHEAR WALLS AND BRACED FRAMES. THE LOADS SHOWN ON THIS PLAN ARE THE ASD SEISMIC AND ASD WIND LOADS THAT ARE IMPARTED ON THE CONCRETE WALL PANELS, WHICH SHALL BE DESIGN AND DETAILED AS SHEAR WALLS. THE CONCRETE WALL SUPPLIER SHALL DESIGN THE WALLS TO RESIST THE LATERAL LOADS APPLIED AT THE ROOF DIAPHRAGM ELEVATION. SEE OTHER DETAILS. THE ADDITIONAL SEISMIC LOAD INDUCED BY THE WEIGHT OF THE IN-PLANE PANELS AND OUT-OF-PLANE PANELS HAVE BEEN ACCOUNTED FOR IN THE FORCES SHOWN ON THE PLAN. THE CONCRETE WALL SUPPLIER SHALL DESIGN AND DETAIL THE CONNECTION OF THE CONCRETE PANELS TO THE FOUNDATION IN ORDER TO RESIST THE SHEAR AND UPLIFT FORCES FROM THE WALLS INTO THE FOUNDATION. THE FOUNDATION AND THE FOUNDATION SYSTEM HAS BEEN DESIGNED FOR THE CONCRETE PANELS SHOWN TO ACT AS A COMPLETE SYSTEM ANY DEVIATIONS FROM THIS SHALL BE APPROVED BY THE ENGINEER OF RECORD.







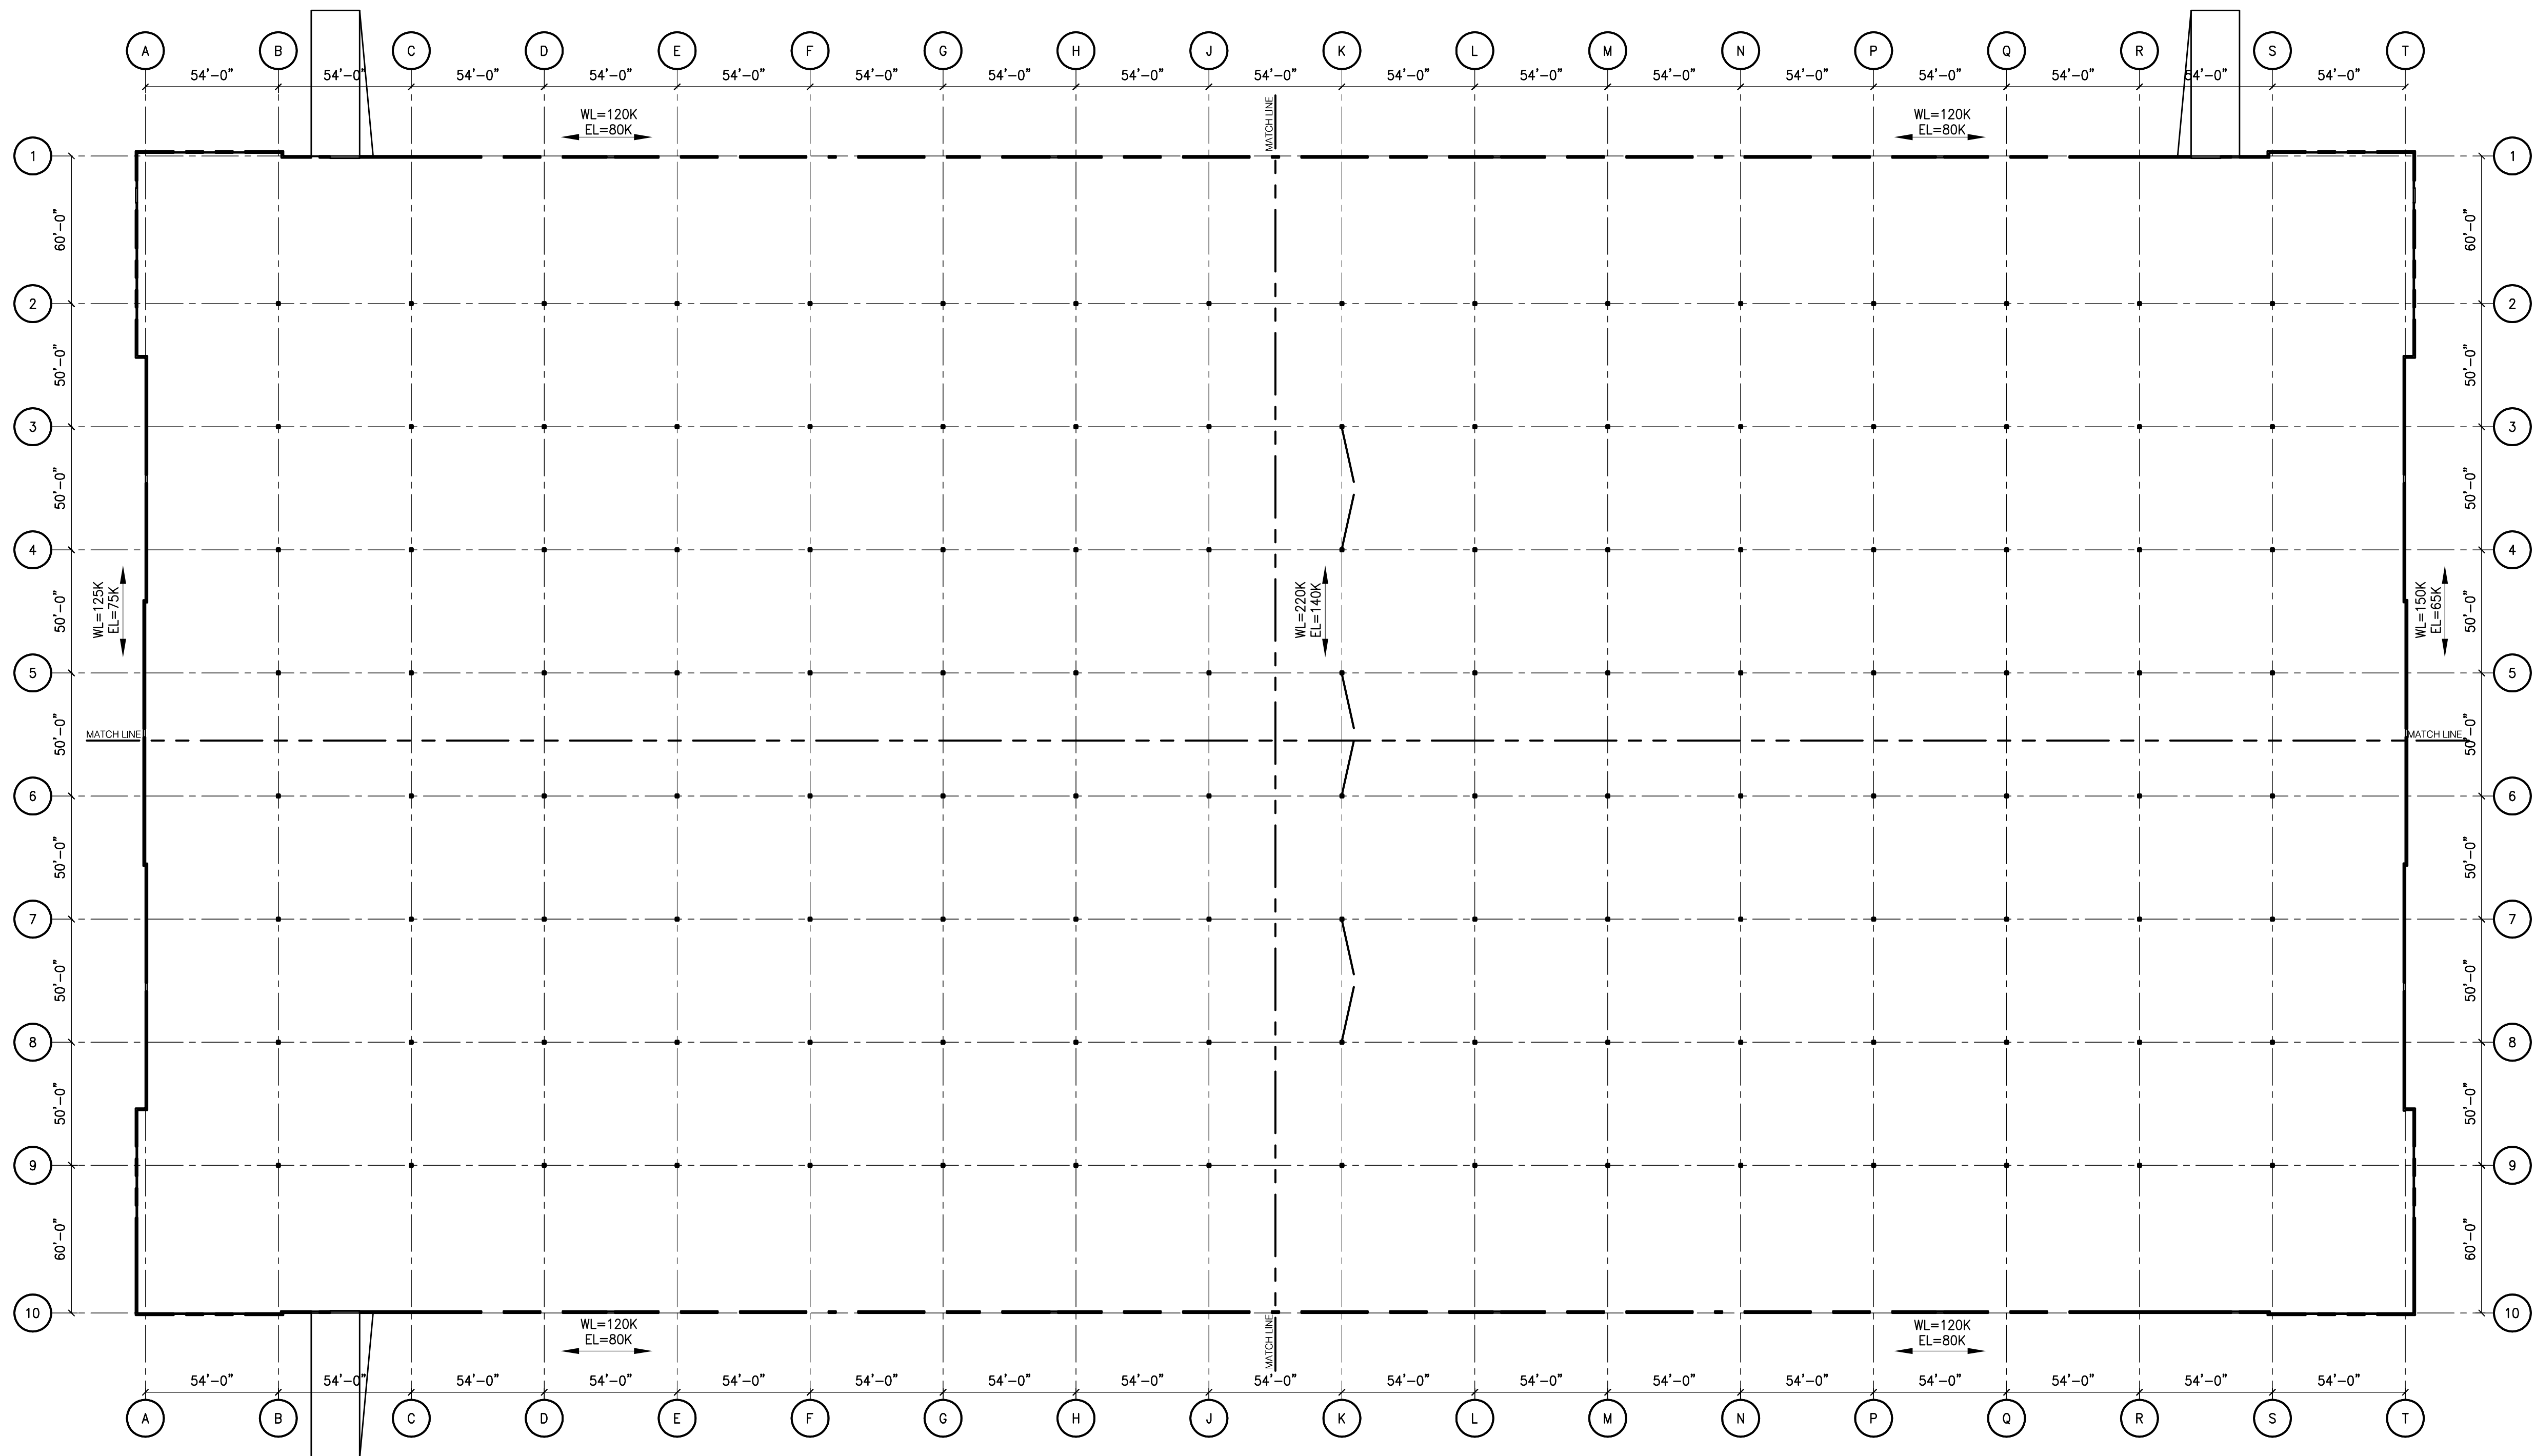


1 LATERAL LOAD PLAN
SCALE: 1/32"=1'-0"



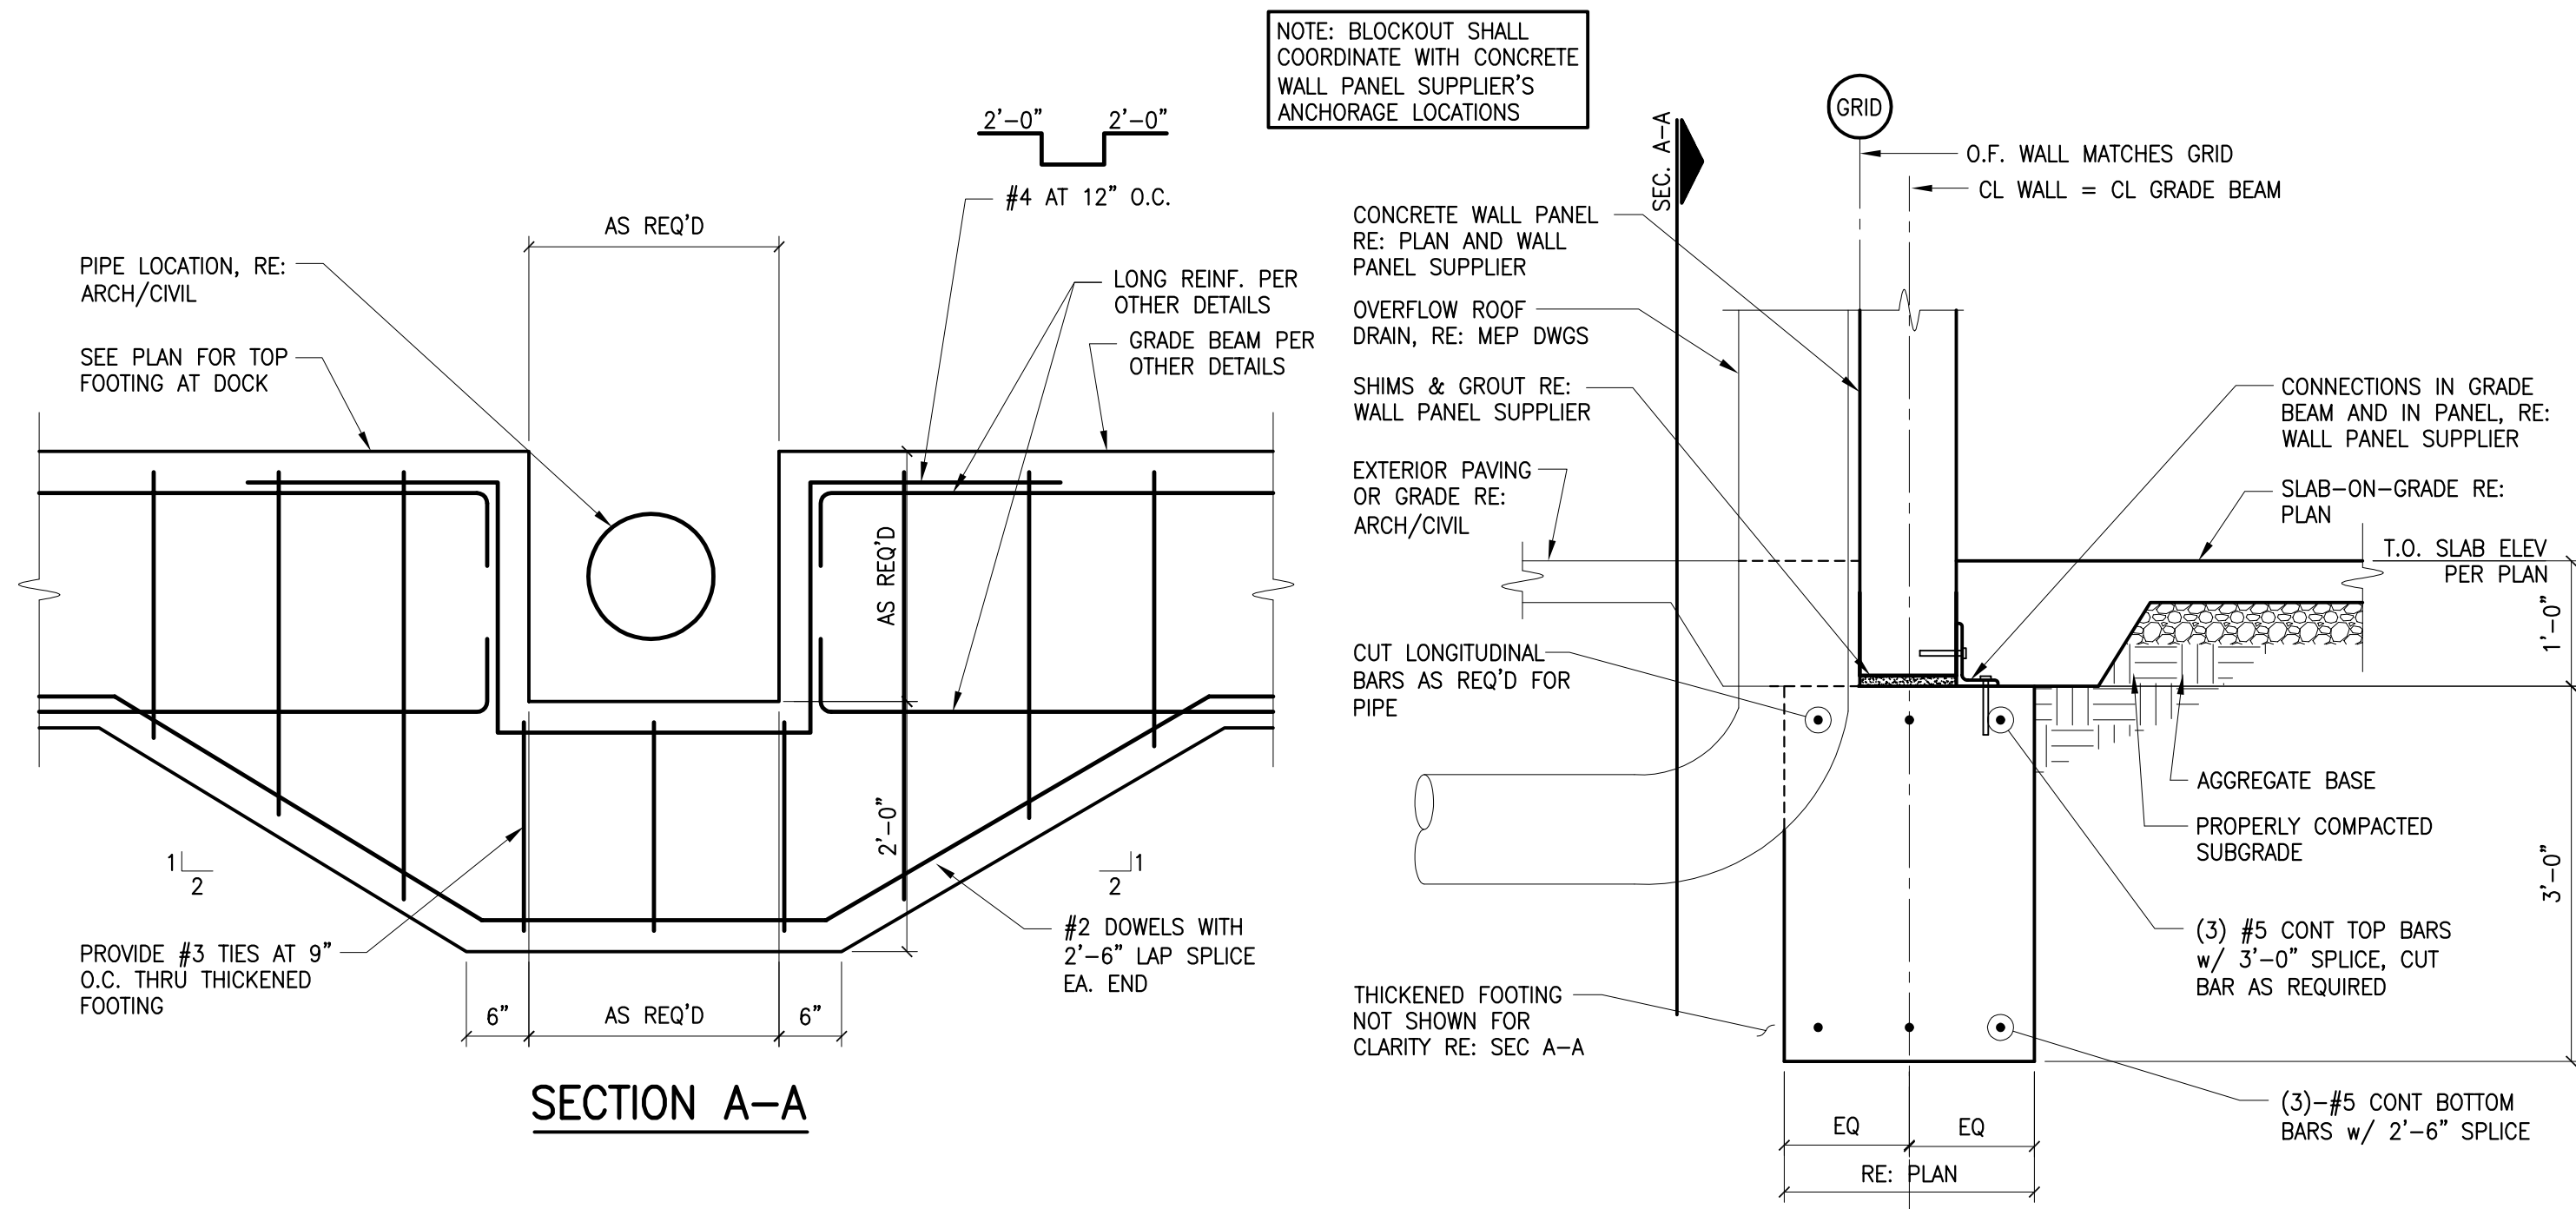


10 EXTERIOR FOOTING AT OVERFLOW DRAIN
3/4" = 1'-0"

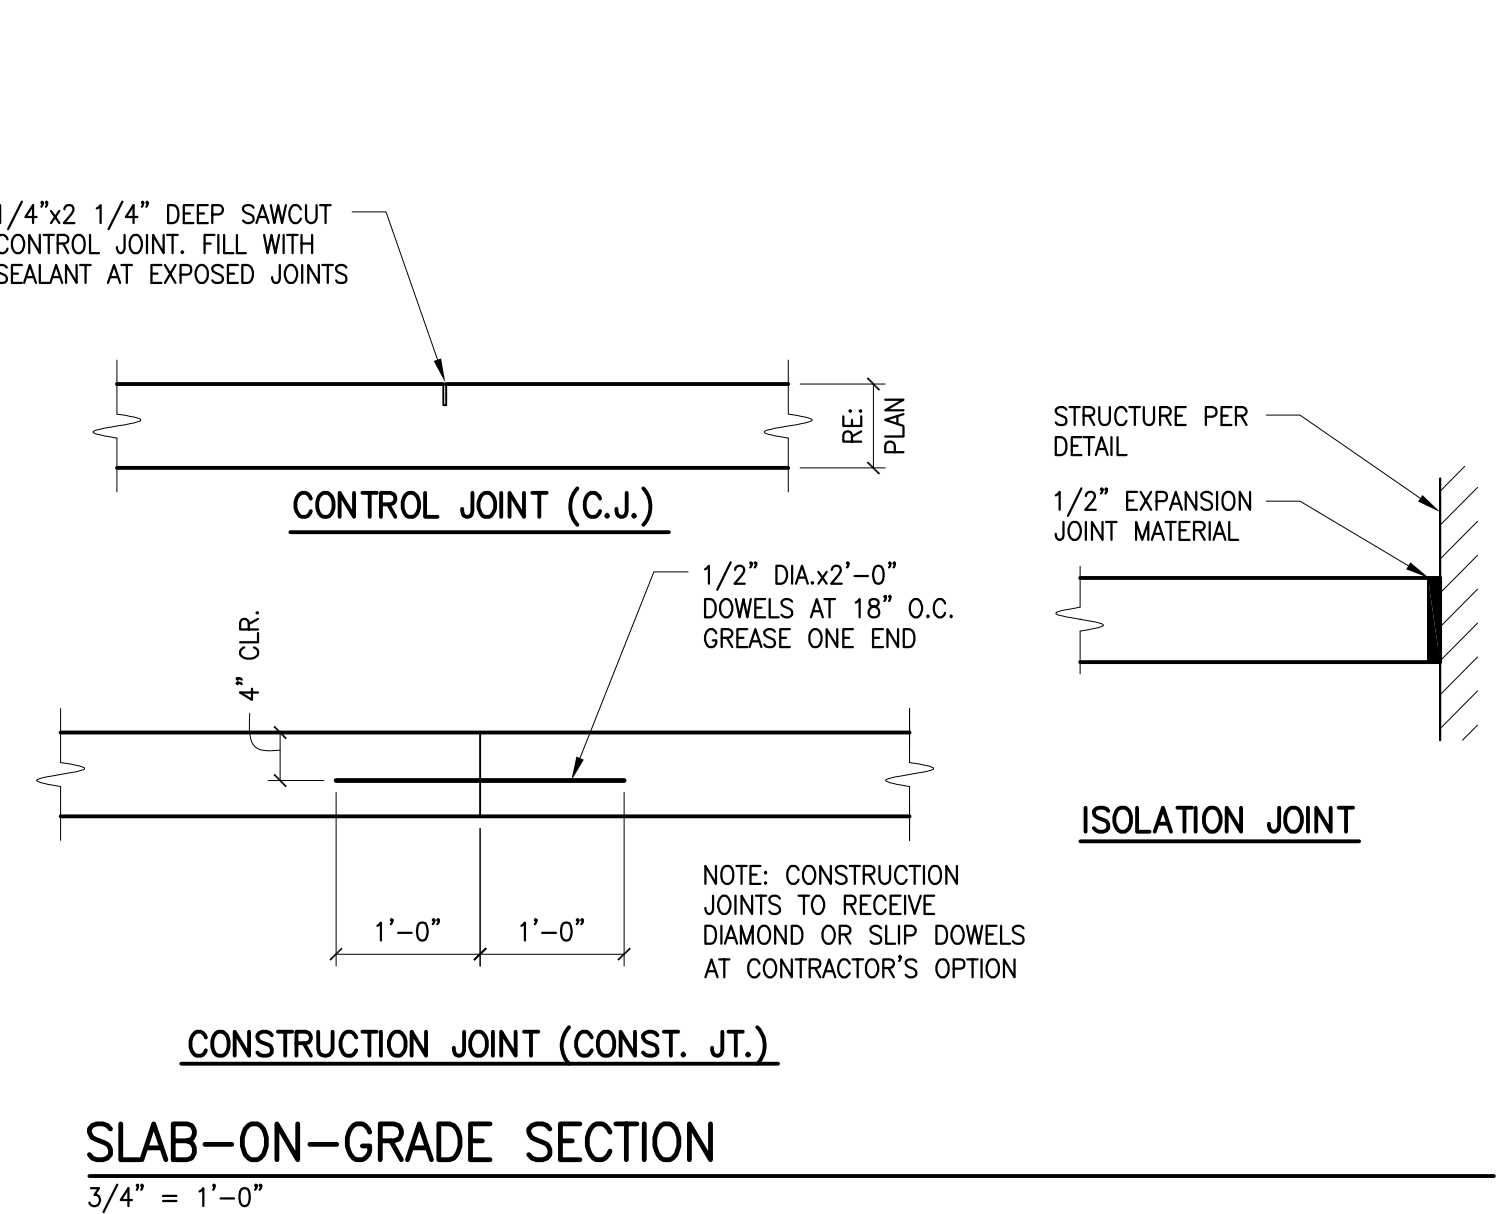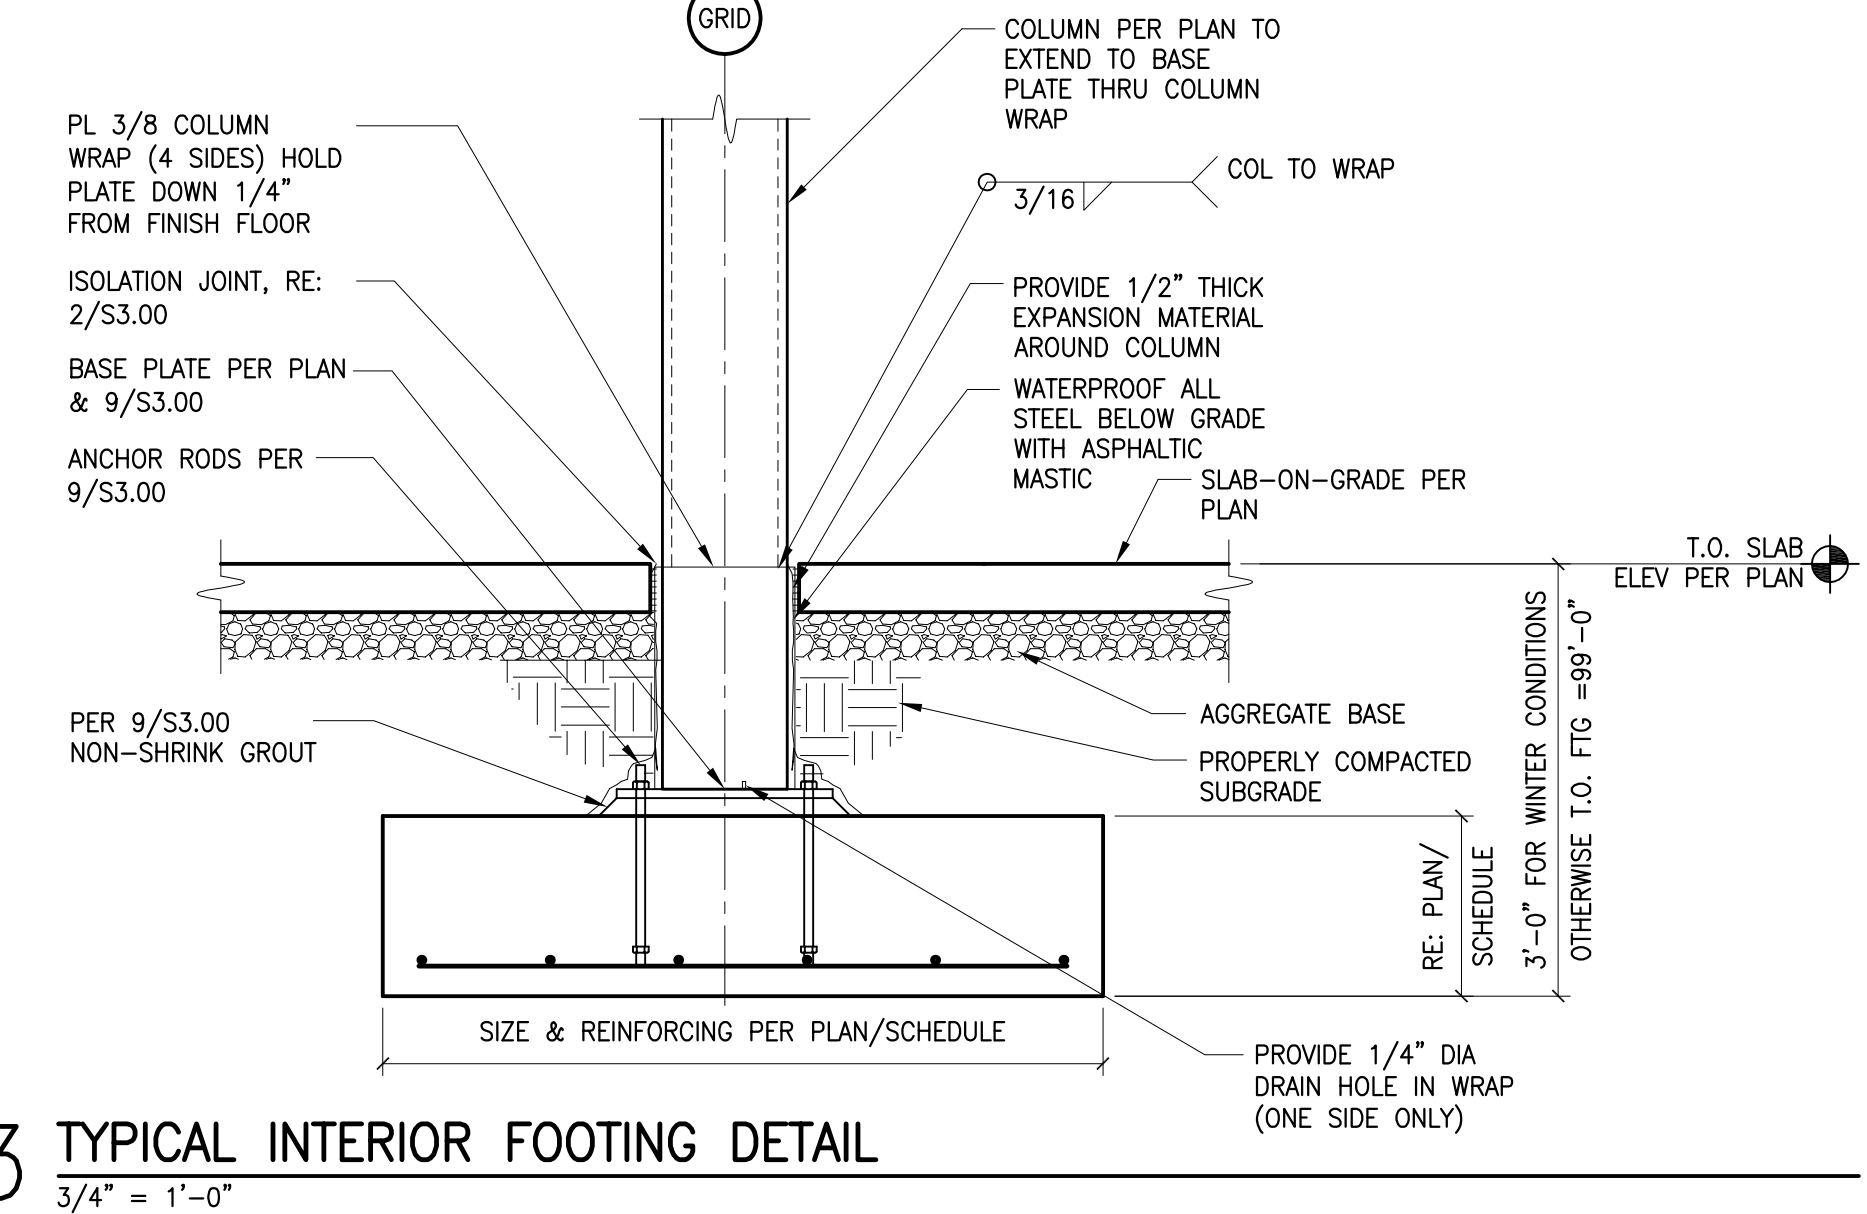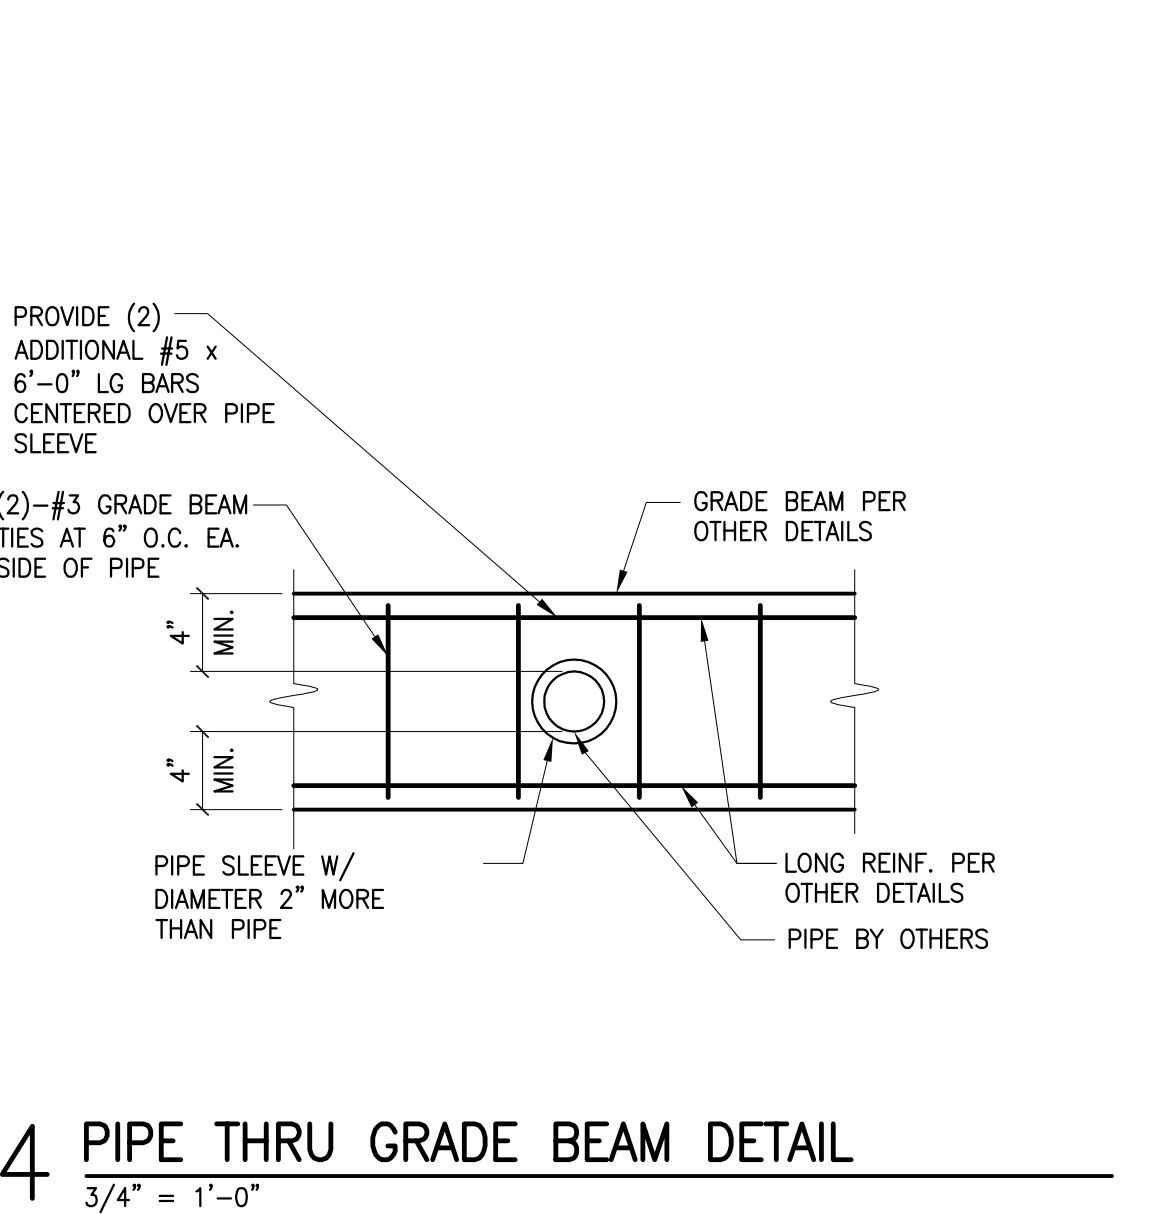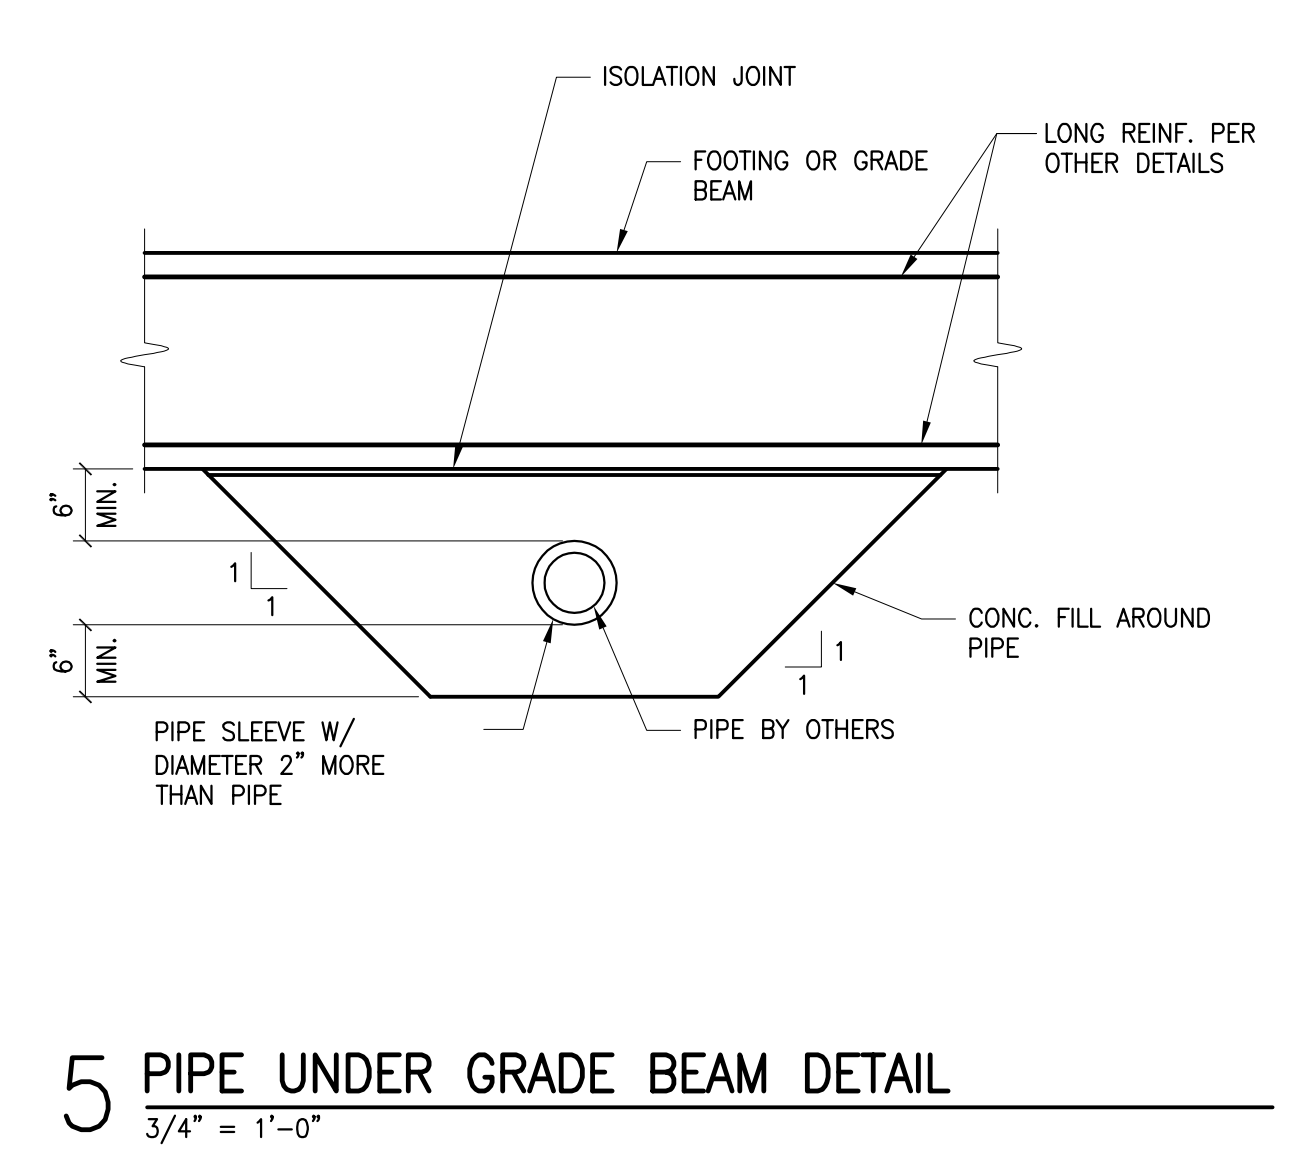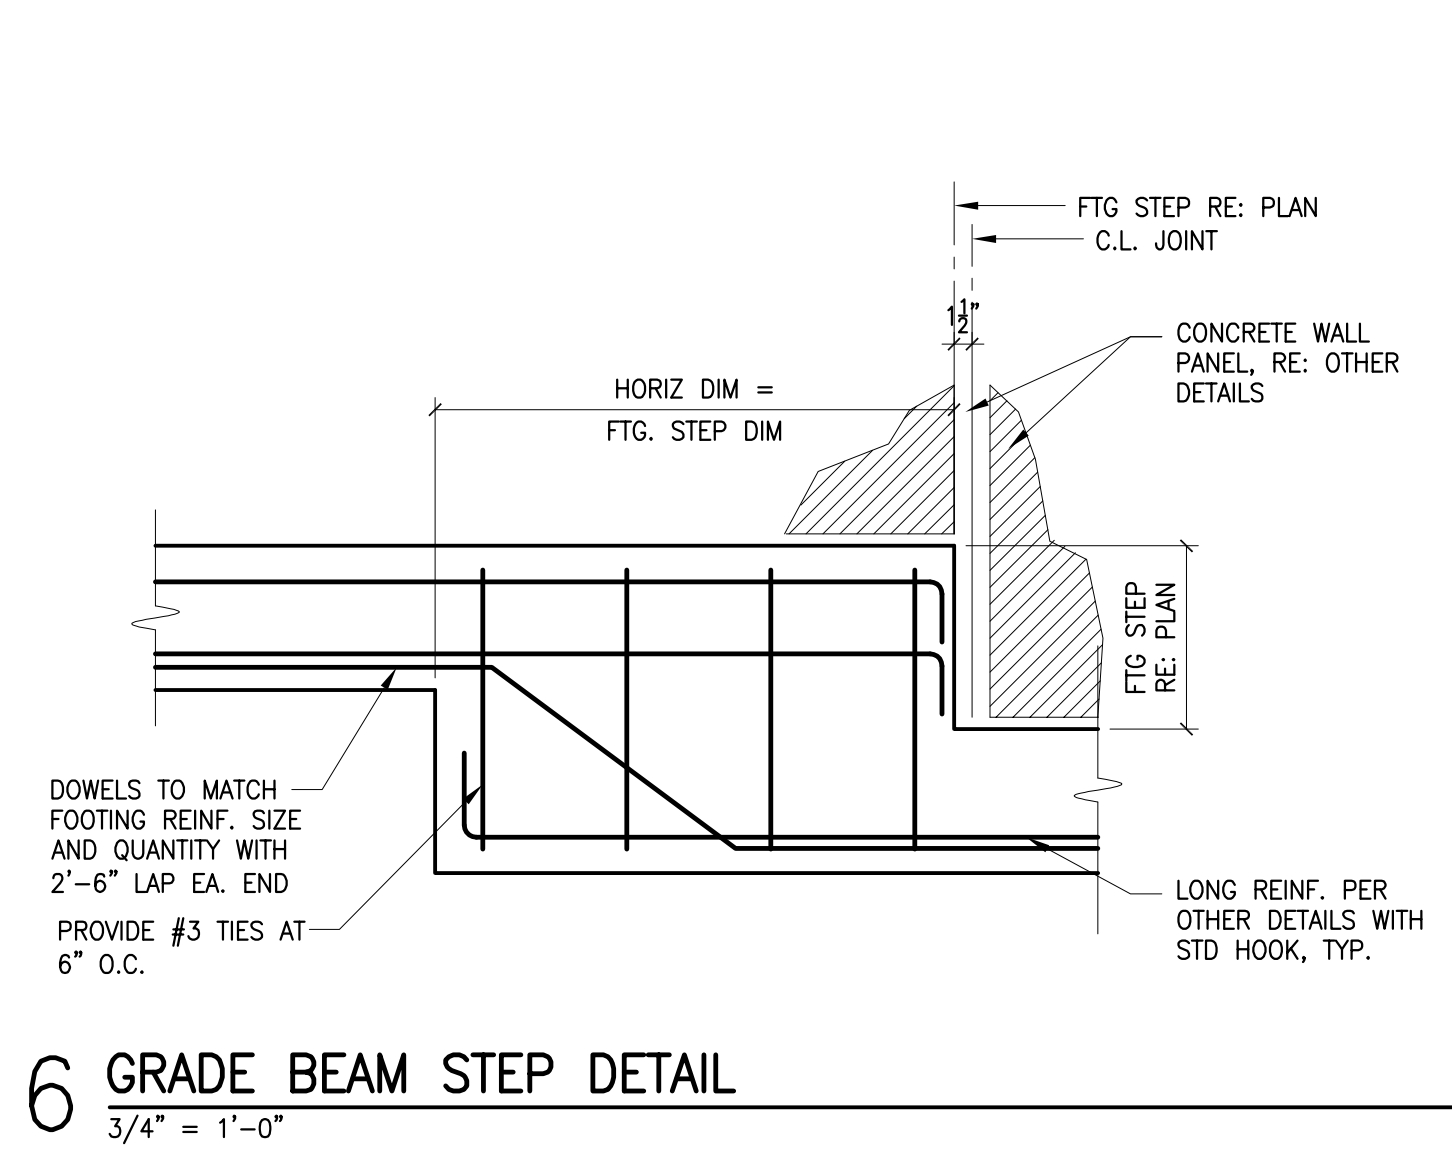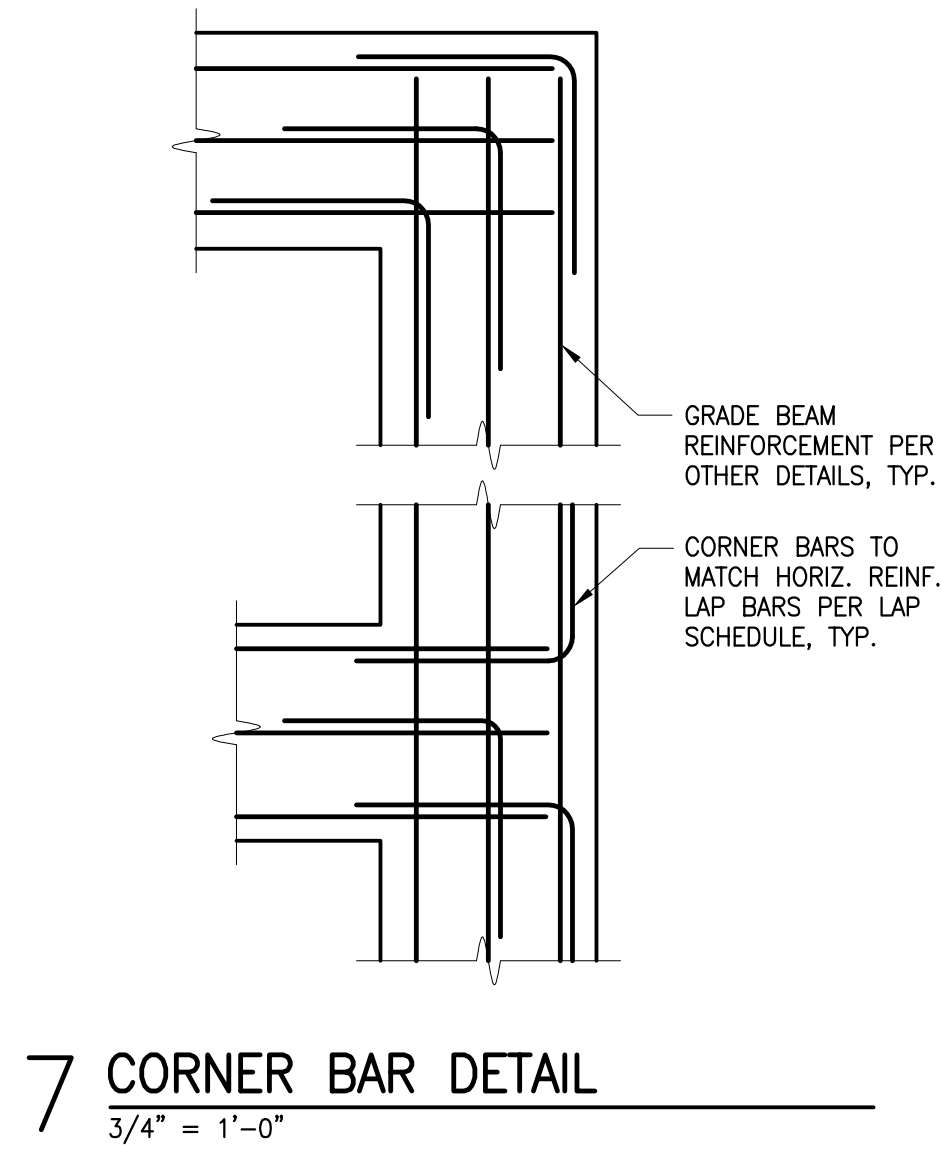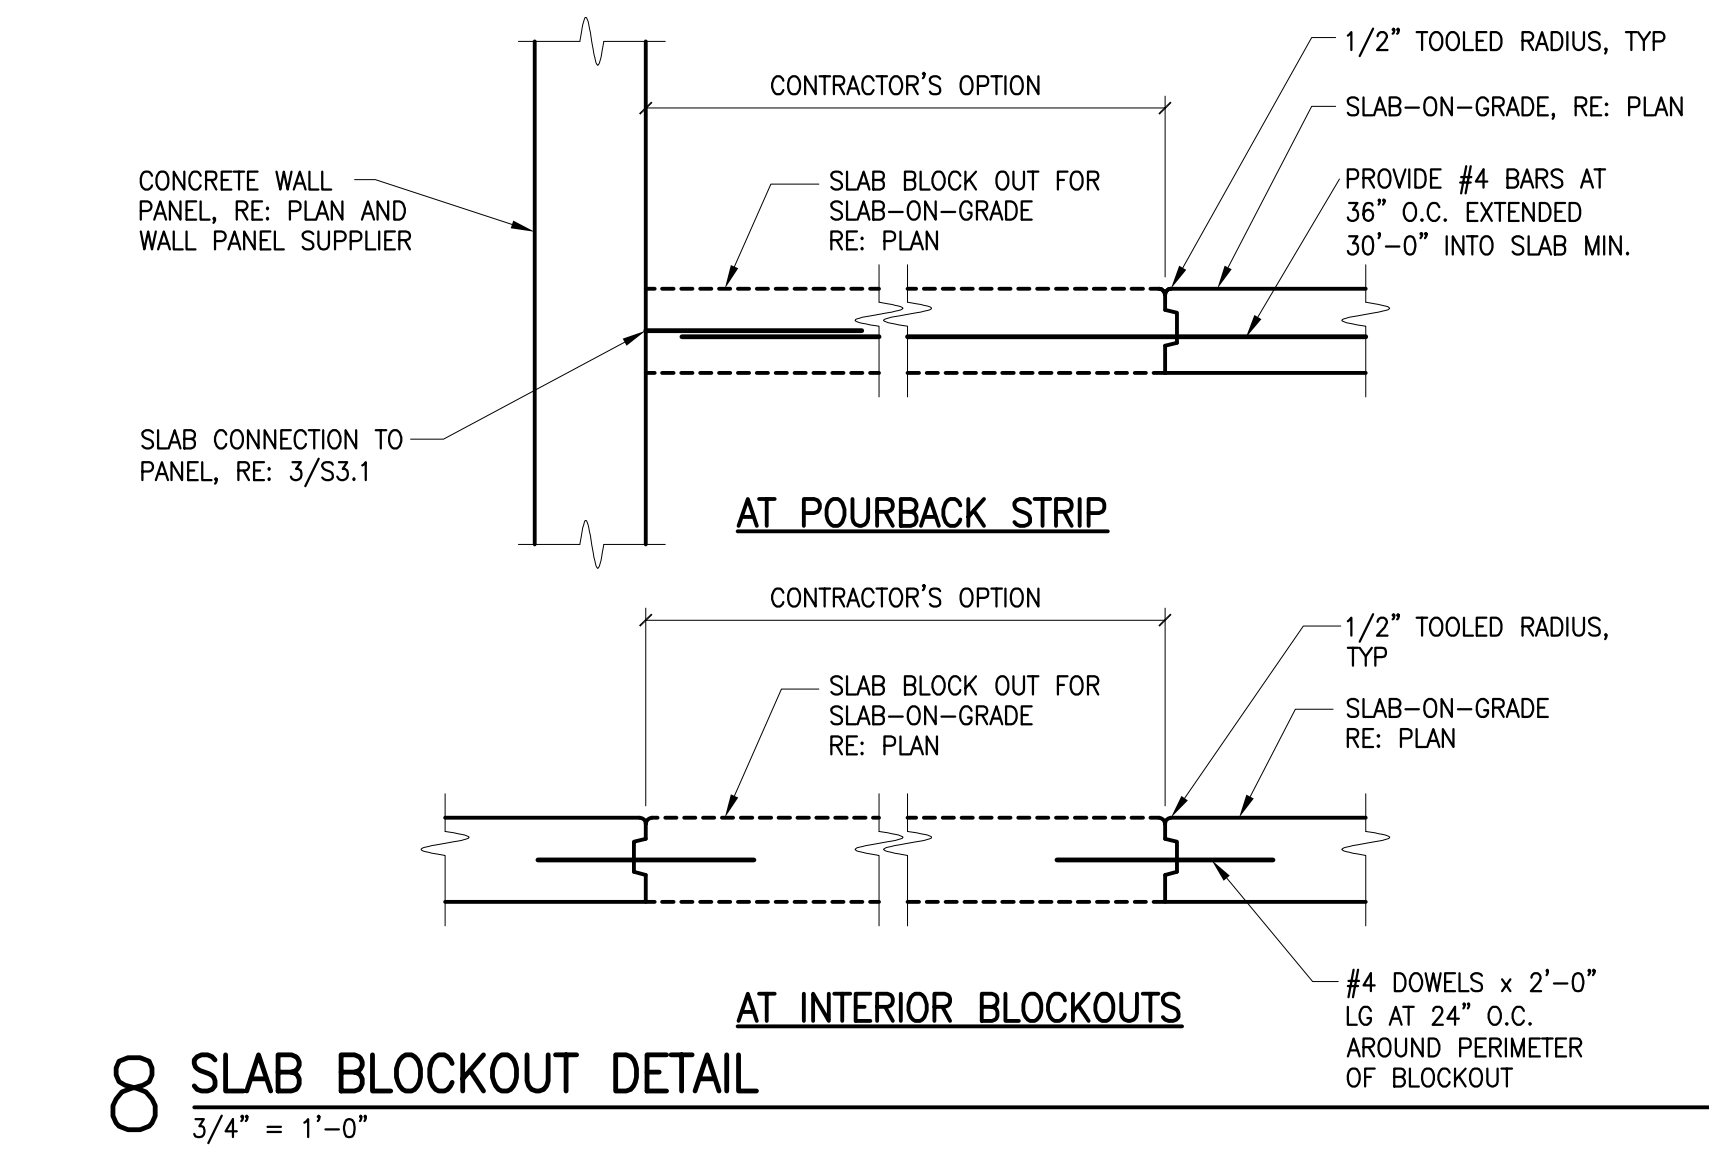

STEEL REINF. LAP SCHEDULE (INCHES)						
BAR SIZE	CONCRETE					
	f'c = 3000 PSI		f'c = 4000 PSI		f'c = 5000 PSI	
	TOP	OTHER	TOP	OTHER	TOP	OTHER
#3	22	17	20	16	17	13
#4	29	22	27	21	23	17
#5	36	28	33	26	28	22
#6	43	33	40	31	34	26
#7	63	48	58	45	49	38
#8	72	55	66	51	56	43
#9	91	70	79	61	71	54

1 CONC. LAP SCHEDULE
3/4" = 1'-0"

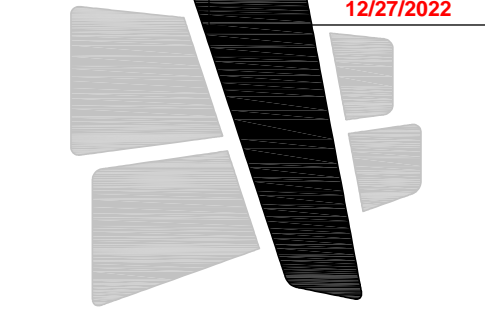

CURRAN
ARCHITECTURE

5719 LAWTON LOOP E. DR. #212
INDIANAPOLIS, IN 46216
O :: 317 . 288 . 0681
F :: 317 . 288 . 0753

SCANNELL
PROPERTIES



Wallace Engineering
Structural Consultants, Inc.
Structural and Civil Consultants
1741 McGee Street
Kansas City, Missouri 64108
816.421.8282, Fax 816.421.8338

CERTIFICATION



12/13/2022
Missouri COA #001268

THIS DRAWING AND THE IDEAS, DESIGNS AND CONCEPTS CONTAINED HEREIN ARE THE EXCLUSIVE INTELLECTUAL PROPERTY OF CURRAN ARCHITECTURE, AND ARE NOT TO BE USED OR REPRODUCED, WHOLE OR IN PART, WITHOUT THE WRITTEN CONSENT OF CURRAN ARCHITECTURE.
© COPYRIGHT 2021, CURRAN ARCHITECTURE

PROJECT INFORMATION

LEE'S SUMMIT LOGISTICS
BUILDING A LOT I


NW CORNER TUDOR RD & MAINST
LEE'S SUMMIT, MO

ISSUE DATES


ISSUE	DATE
ISSUE FOR PERMIT	02.18.2022
ISSUE FOR PERMIT	04.15.2022

210300


S3.1
FOUNDATION DETAILS

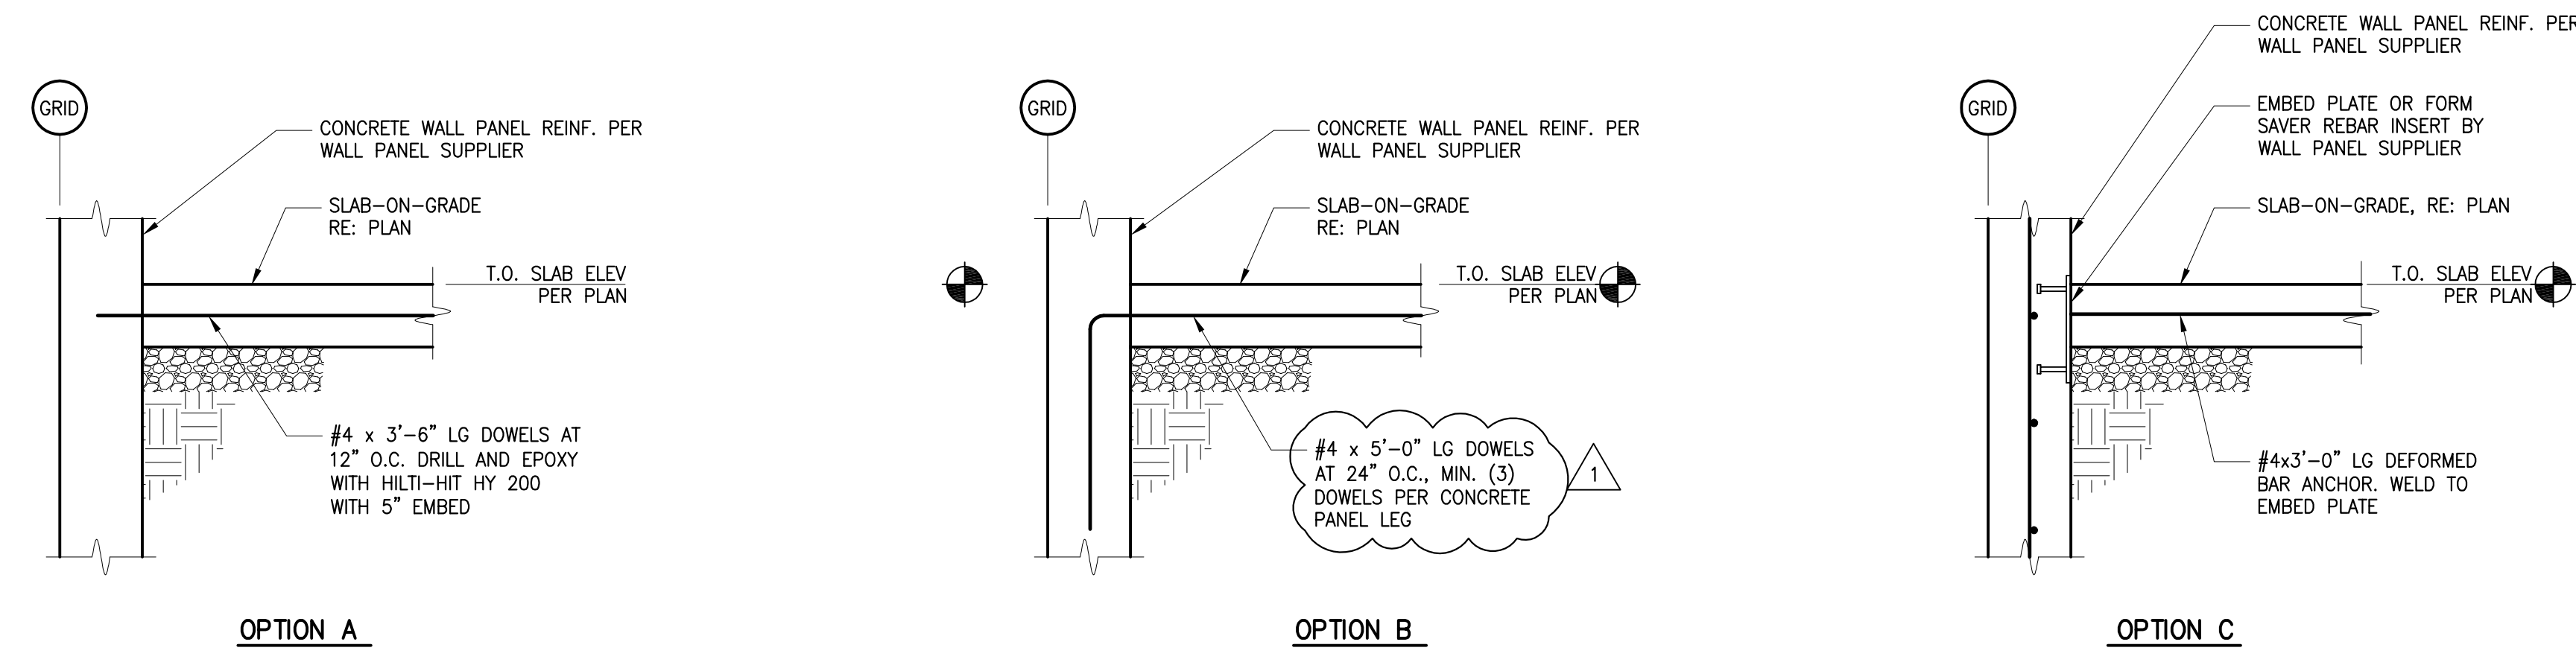


5 SLAB CONNECTION TO CONCRETE WALL PANEL OPTIONS
3/4" = 1'-0"

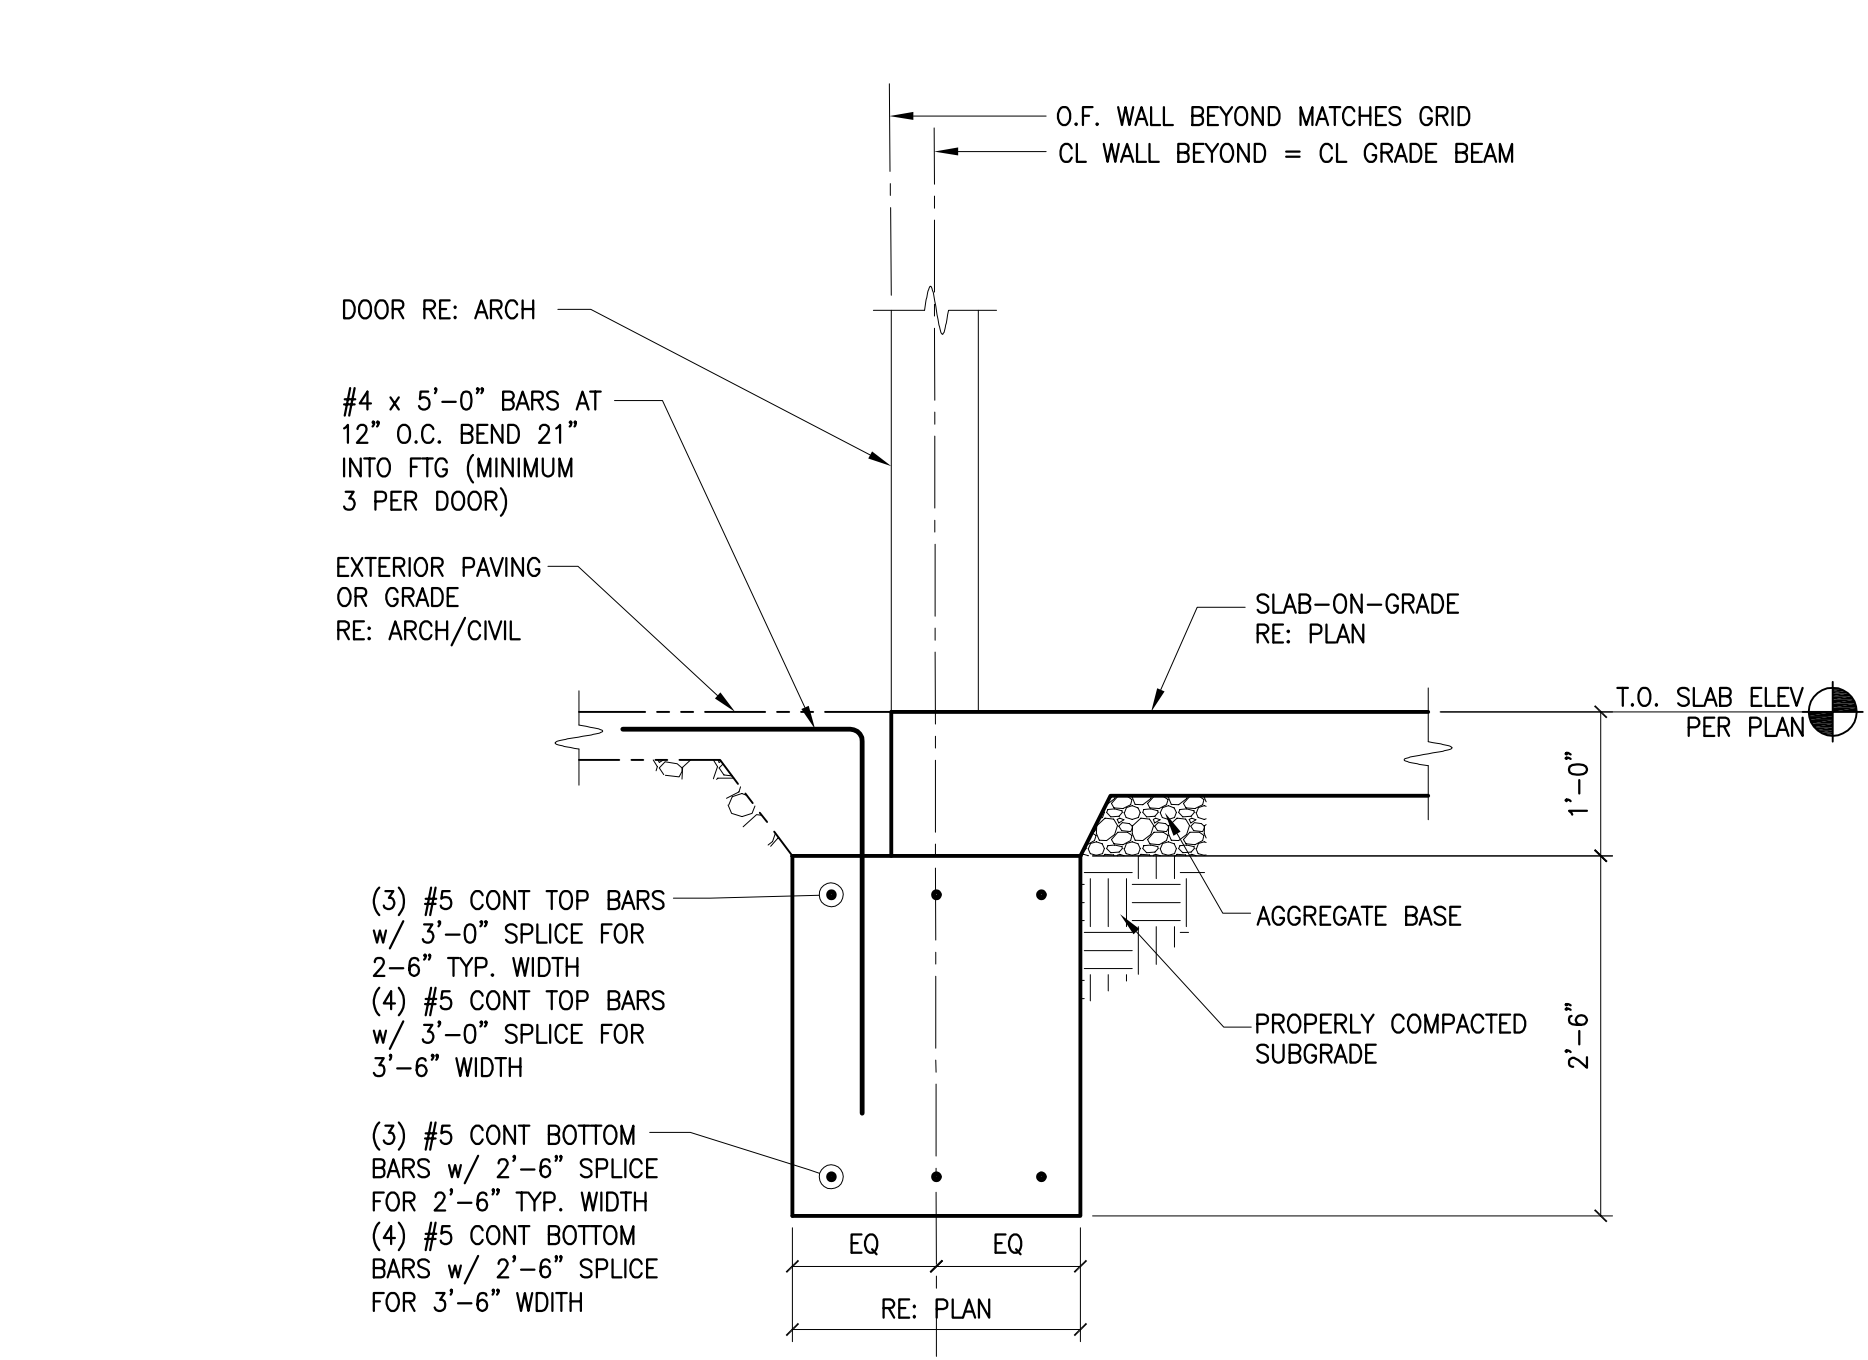

4 FOUNDATION SECTION
3/4" = 1'-0"

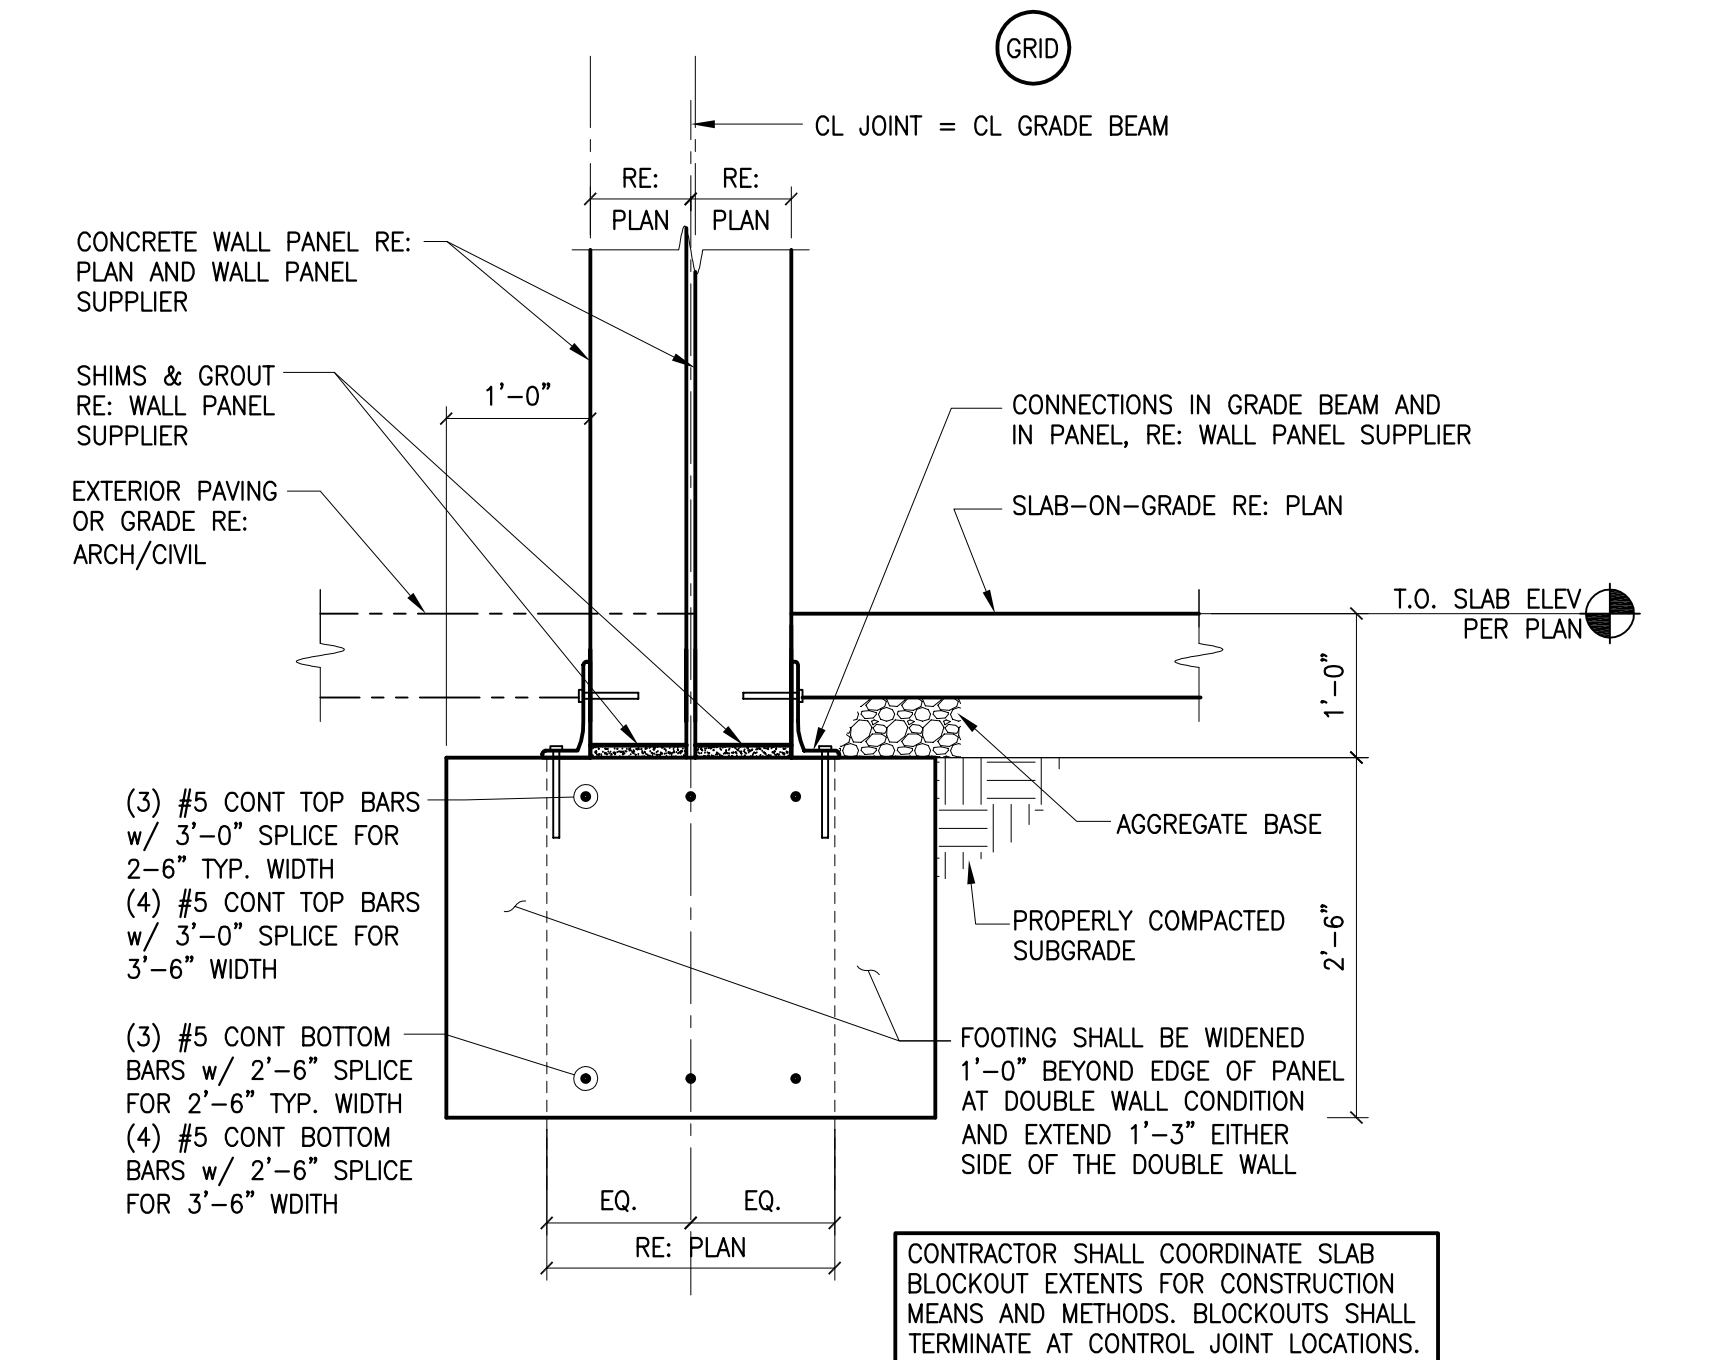

3 FOUNDATION SECTION
3/4" = 1'-0"

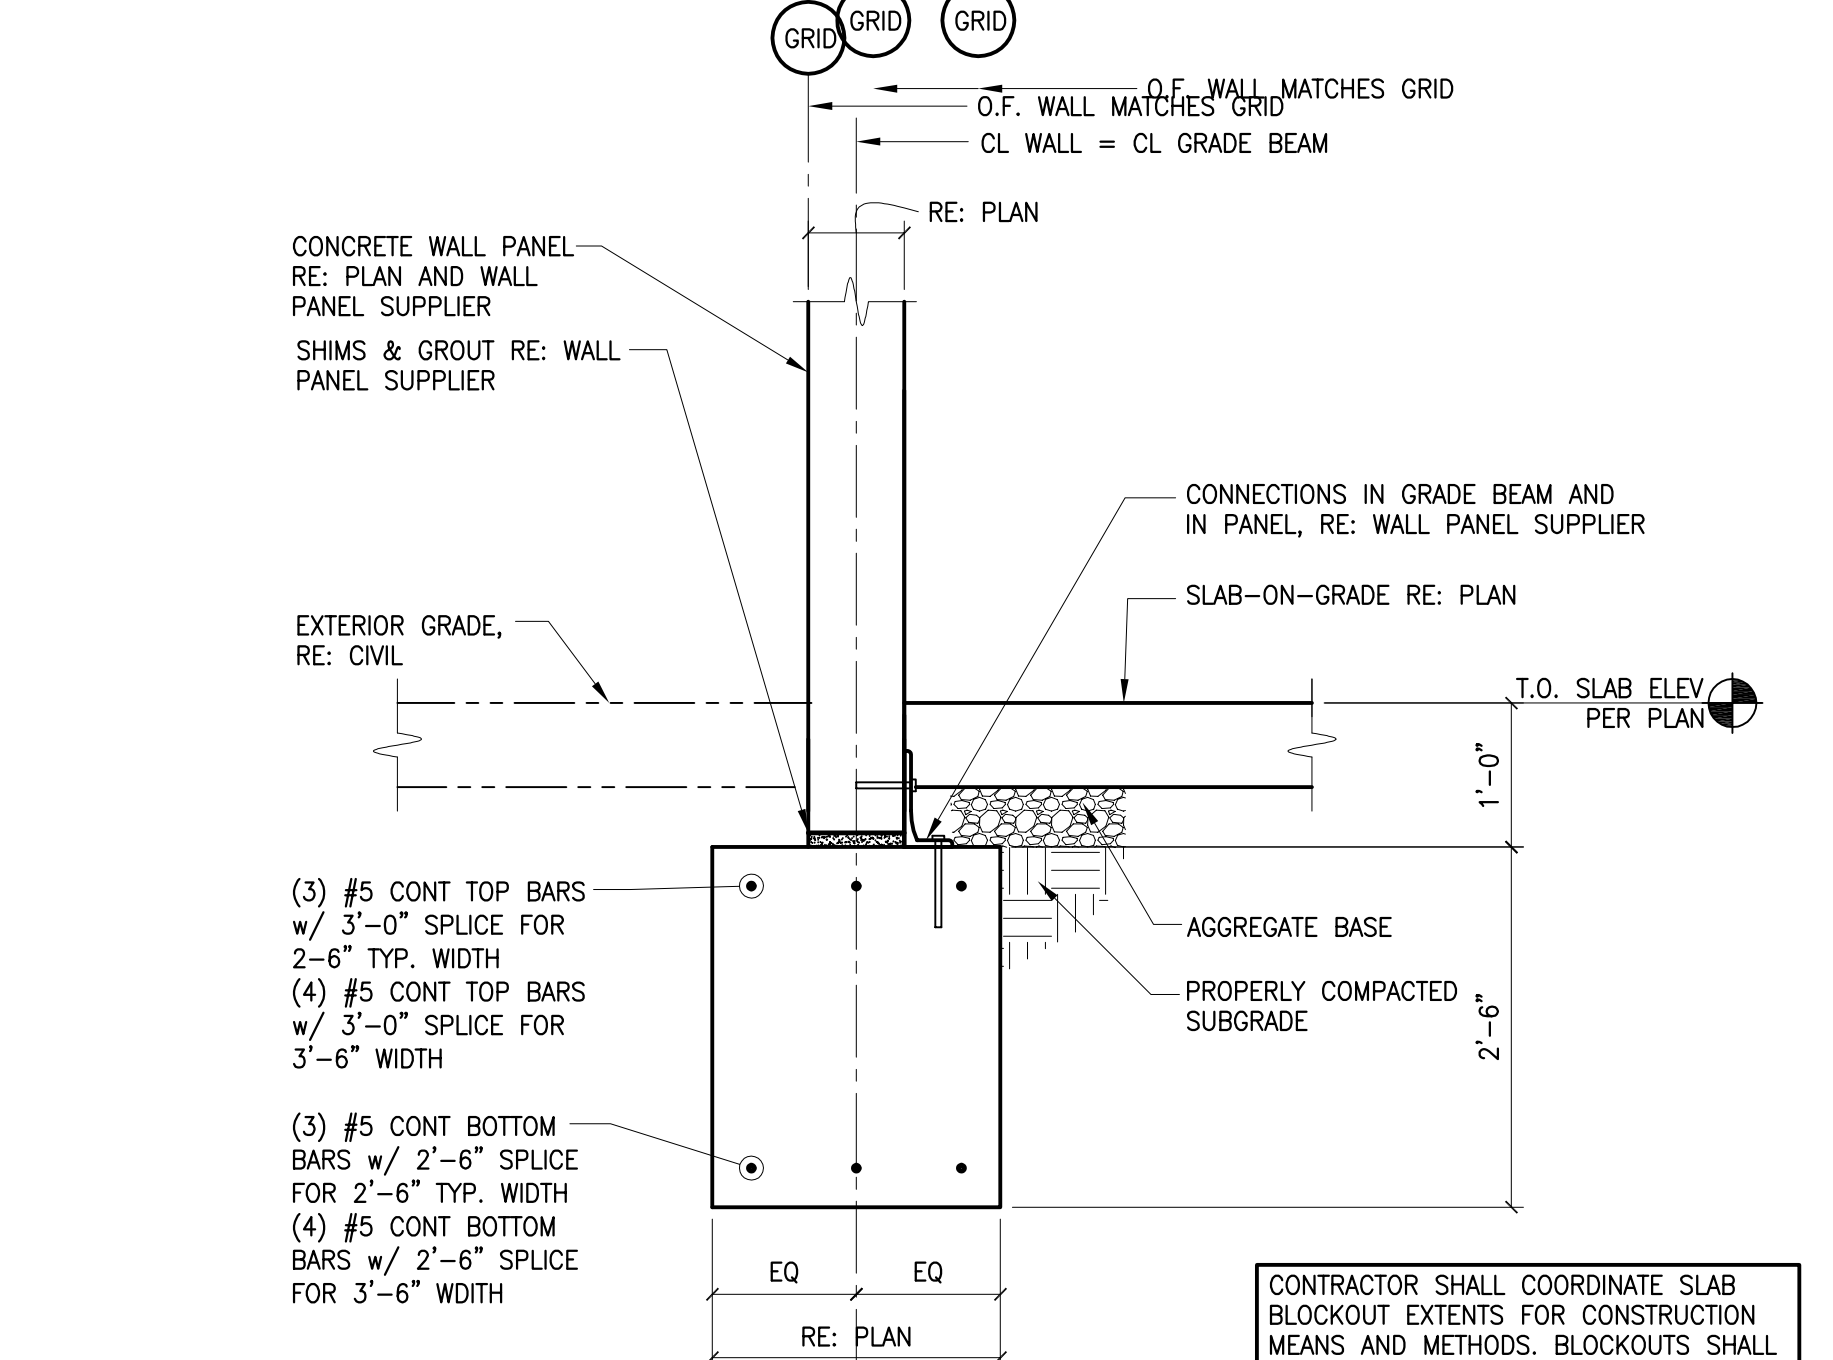

2 FOUNDATION SECTION
3/4" = 1'-0"


NOTE:

STAIR FRAMING IS FOR GRAPHICAL PURPOSES ONLY. STEEL FABRICATOR SHALL COORDINATE DIMENSIONS AND LOCATION OF STAIR WITH THE ENTIRE CONSTRUCTION DOCUMENTS AND NOT SOLELY THE STRUCTURAL PORTION ONLY.


STAIR FRAMING, STRINGERS, TREADS, HANDRAILS, LANDINGS AND CONNECTION DETAILING AND DESIGN SHALL BE THE RESPONSIBILITY OF THE STEEL FABRICATOR. STEEL FABRICATOR SHALL INCLUDE THE DESIGN FOR ANY ATTACHMENTS TO THE BUILDINGS, FOUNDATIONS OR DIAPHRAGMS. DESIGN LOADS SHALL BE COORDINATED WITH THE ENGINEER OF RECORD. IF ADDITIONAL COLUMNS OR POSTS ARE REQUIRED WHERE NOT EXPLICITLY SHOWN, STEEL FABRICATOR SHALL COORDINATE ADDITIONAL FOOTINGS OR ATTACHMENT TO BEAMS WITH GENERAL CONTRACTOR AND ENGINEER OF RECORD. THE DESIGN IS A DEFERRED SUBMITTAL AND SHALL BE SUBMITTED FOR REVIEW AS SET FORTH IN THE STRUCTURAL GENERAL NOTES.

MINIMUM MEMBER SIZES ARE AS NOTED BELOW:

STRINGER:	GALV. C12x20.7
HEADER:	GALV. C12x20.7
TREADS:	1 1/4" DEEP BAR GRATING
LANDING DECK:	1 1/4" DEEP BAR GRATING

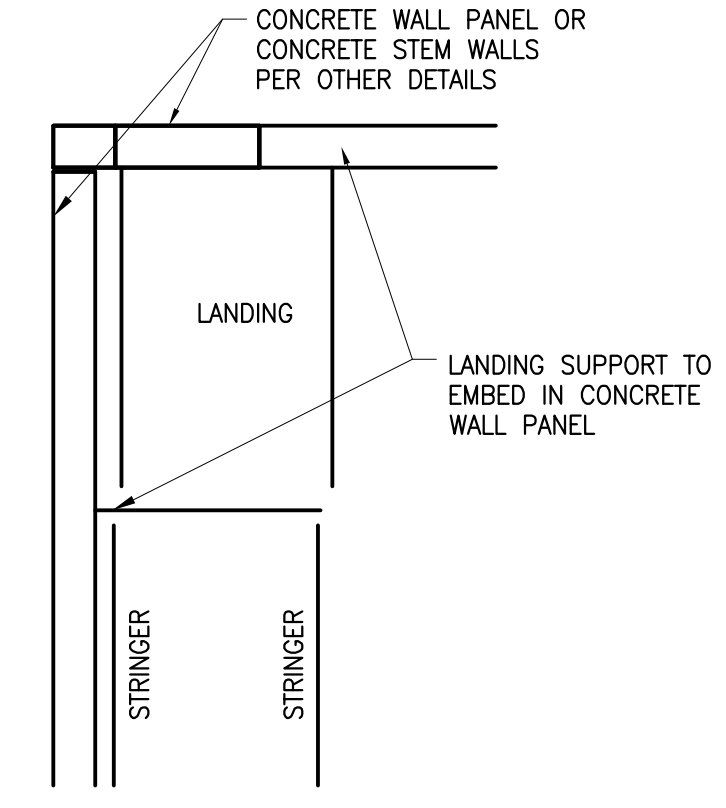

STEEL STAIR

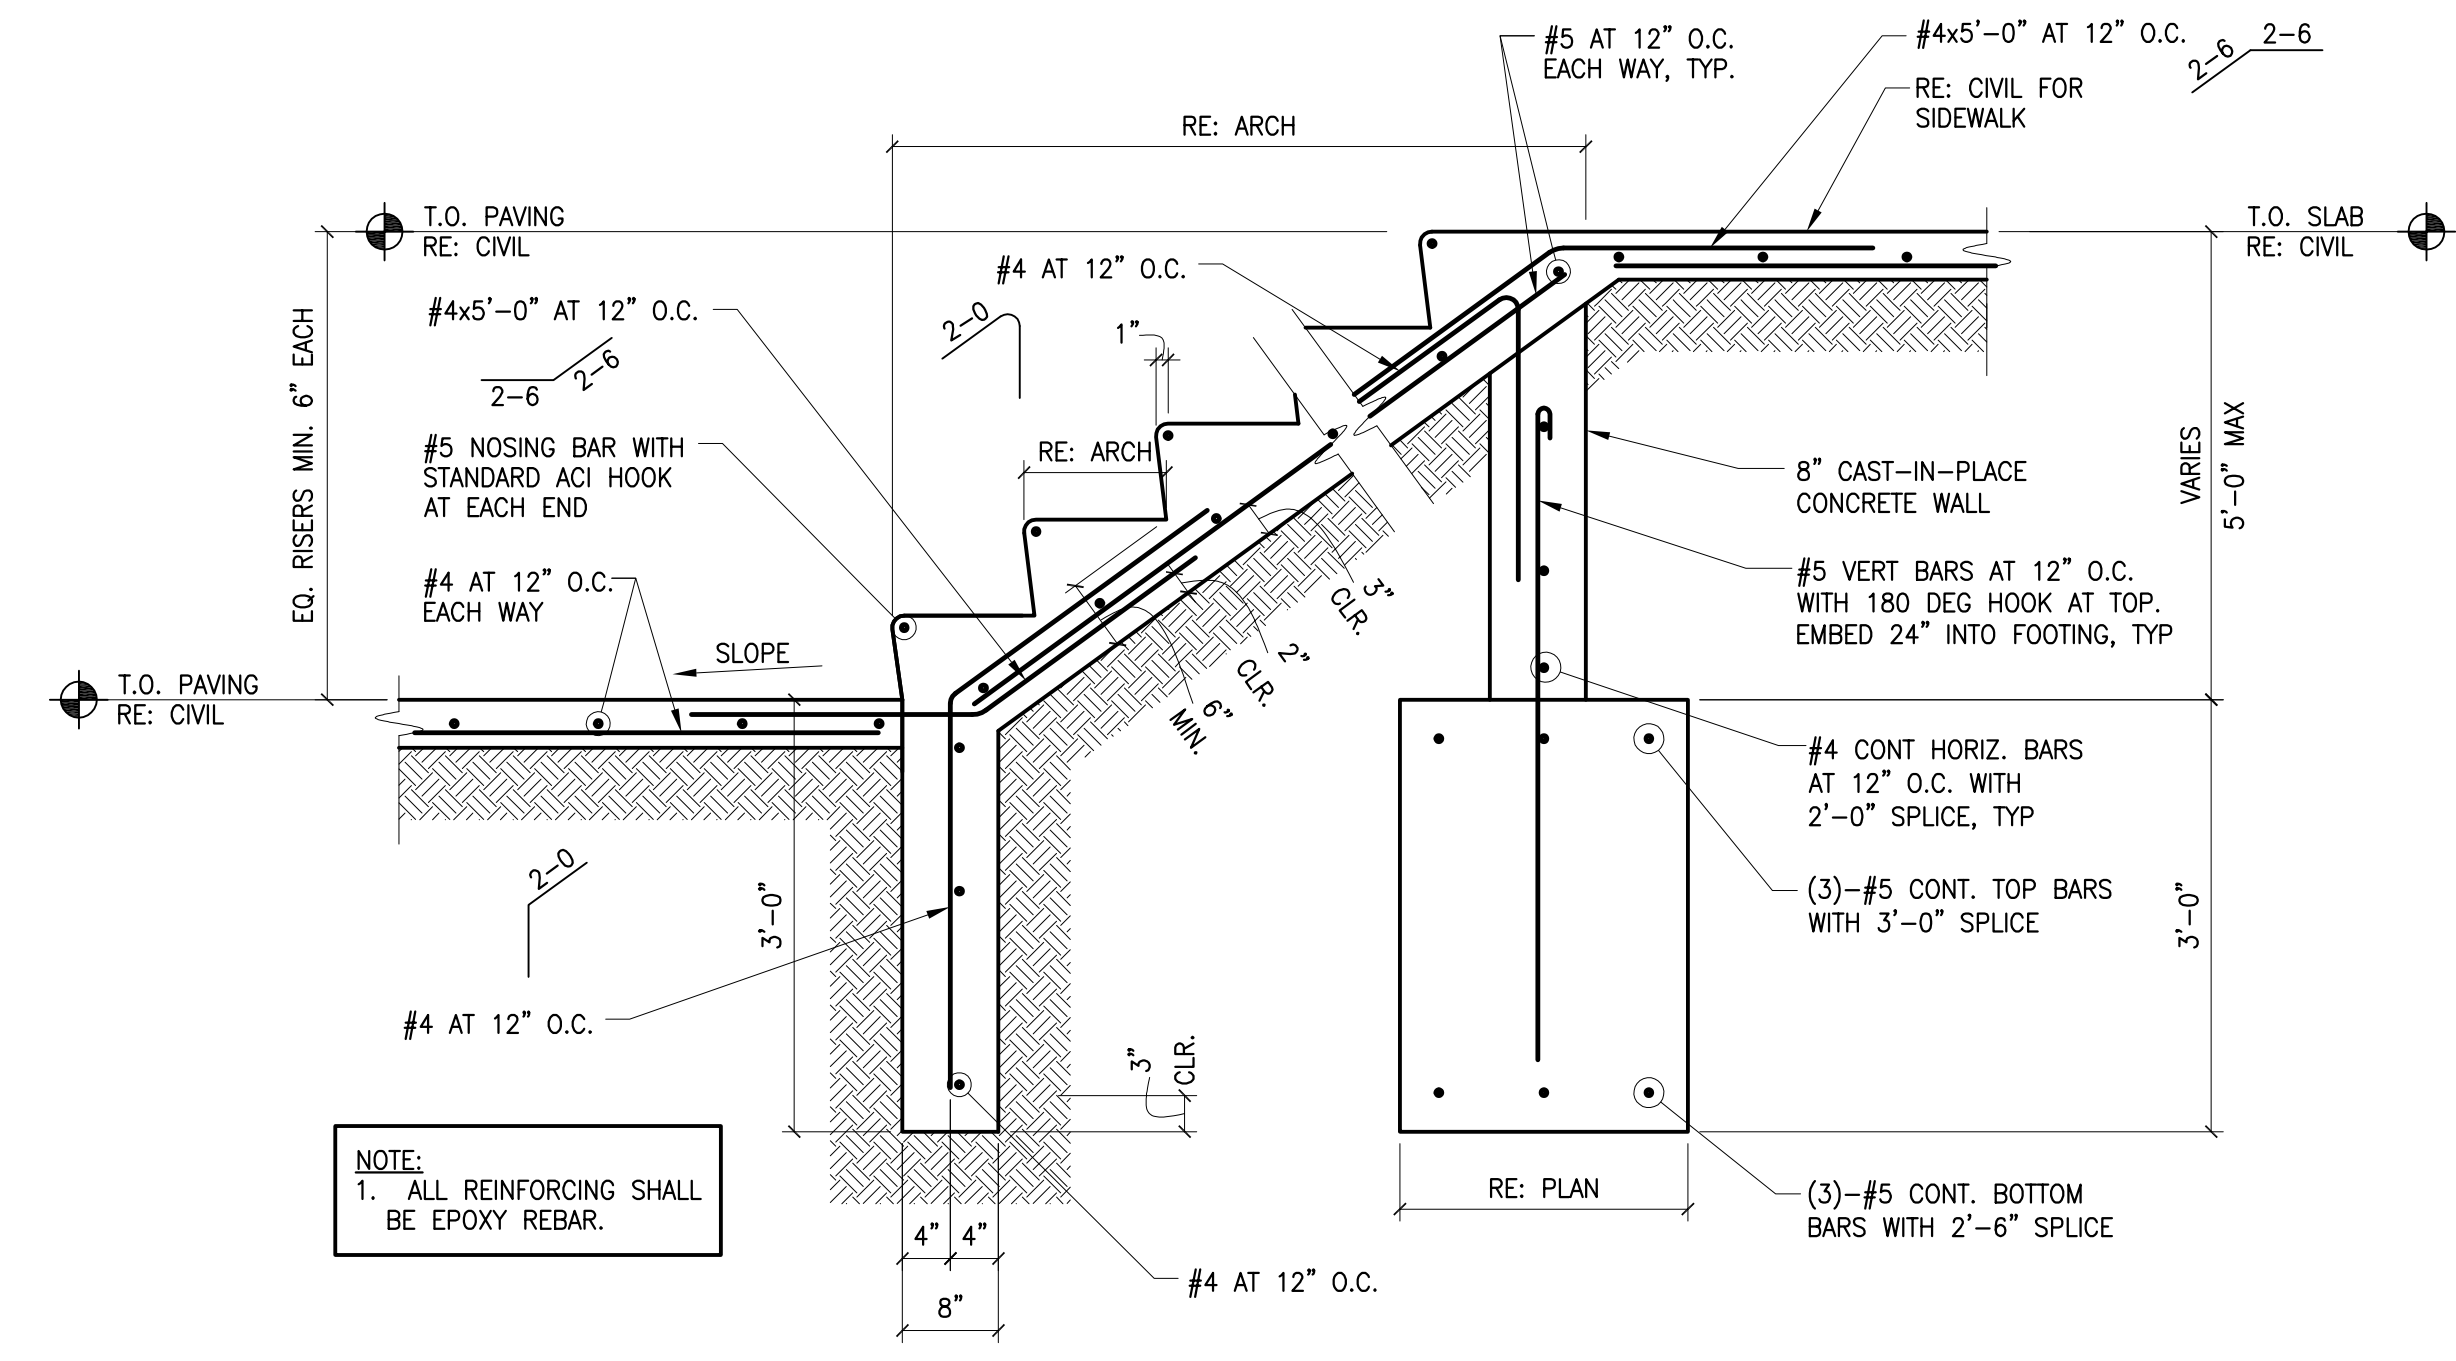

CONCRETE STAIRS-ON-GRADE

1 STAIR DETAILS
3/4" = 1'-0"



CURRAN
ARCHITECTURE

5719 LAWTON LOOP E. DR. #212
INDIANAPOLIS, IN 46216
O :: 317 . 288 . 0681
F :: 317 . 288 . 0753



SCANNELL
PROPERTIES


wallace



Wallace Engineering
Structural Consultants, Inc.

Structural and Civil Consultants
1741 McGee Street
Kansas City, Missouri 64108
816.421.8282, Fax 816.421.8338

CERTIFICATION

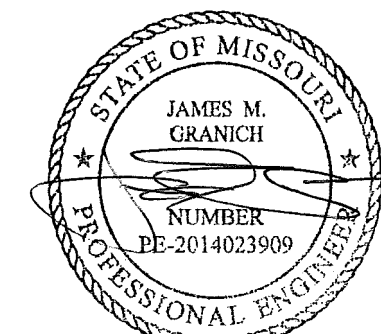

12/13/2022
Missouri COA #001268

THIS DRAWING AND THE IDEAS, DESIGNS
AND CONCEPTS CONTAINED HEREIN ARE
THE EXCLUSIVE INTELLECTUAL PROPERTY
OF CURRAN ARCHITECTURE, AND ARE NOT
TO BE USED OR REPRODUCED, WHOLE OR
IN PART, WITHOUT THE WRITTEN
CONSENT OF CURRAN ARCHITECTURE.
© COPYRIGHT 2021, CURRAN ARCHITECTURE

PROJECT INFORMATION

LEE'S SUMMIT LOGISTICS
BUILDING A LOT I

NW CORNER TUDOR RD & MAINST
LEE'S SUMMIT, MO


ISSUE DATES

ISSUE	DATE
ISSUE FOR PERMIT	02.18.2022
ISSUE FOR PERMIT	04.15.2022

210300

S3.2

FOUNDATION DETAILS

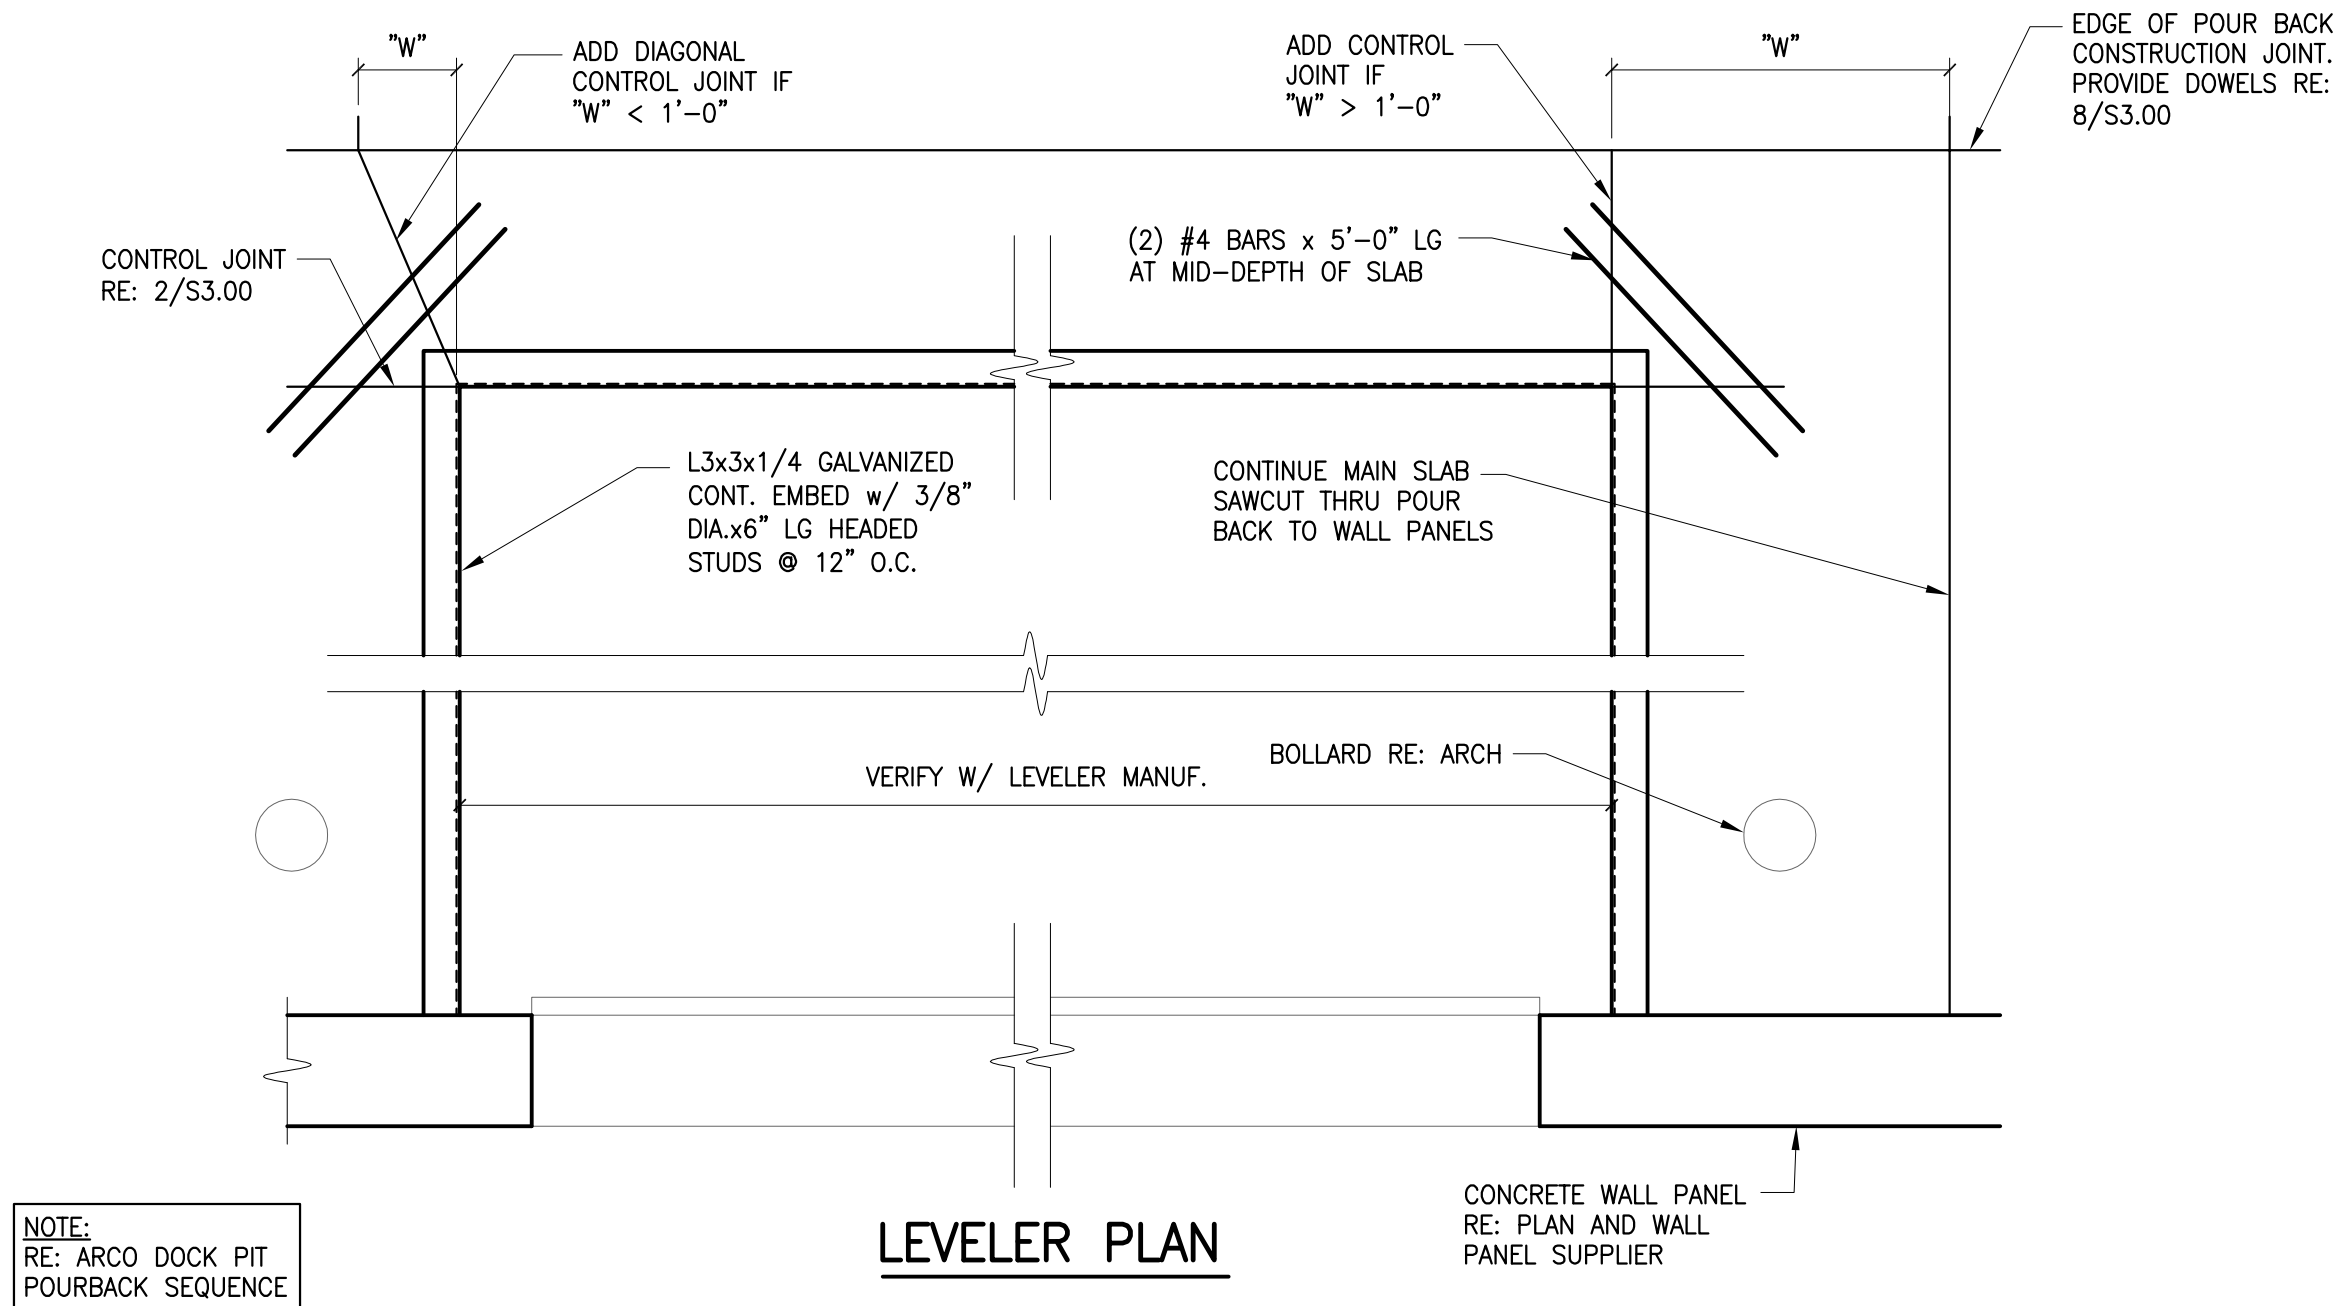

LEVELER PLAN


LEVELER ELEVATION

T.O. SLAB ELEV
PER PLAN

1'-3 1/2"
VERIFY W/
LEVELER MANUF.


5 DOCK PIT SECTION

3/4" = 1'-0"

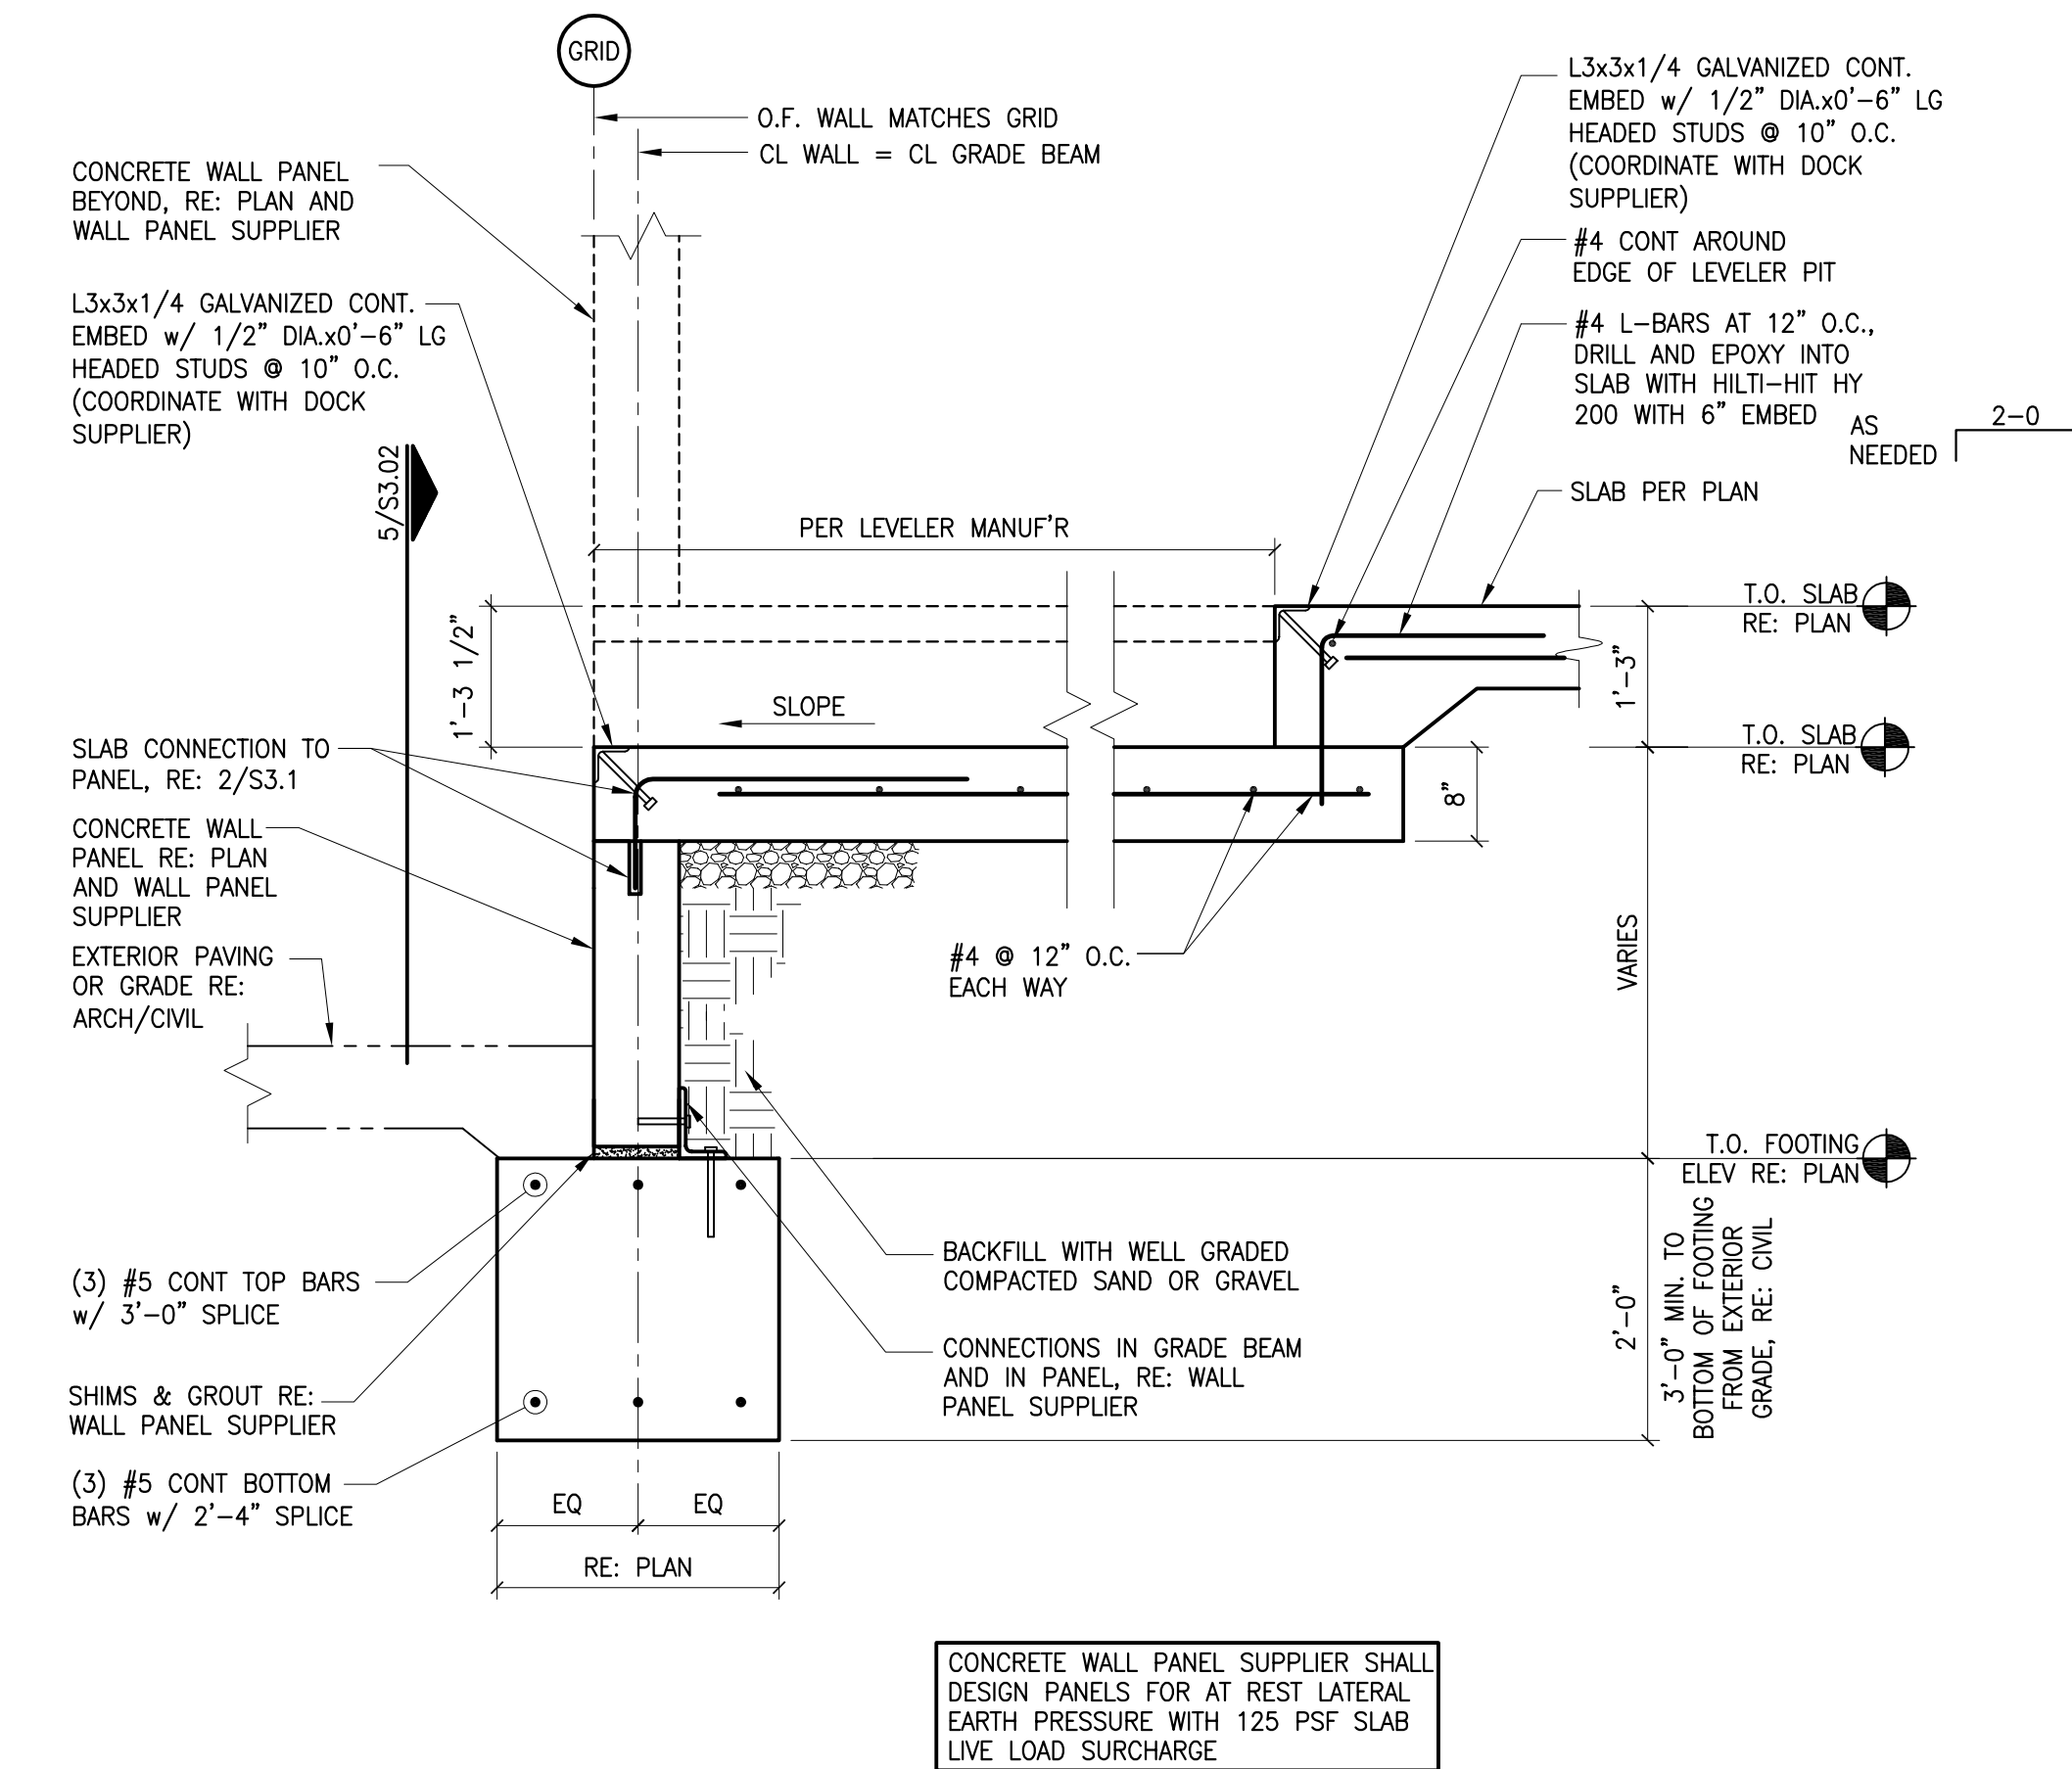


4 FOUNDATION SECTION

3/4" = 1'-0"

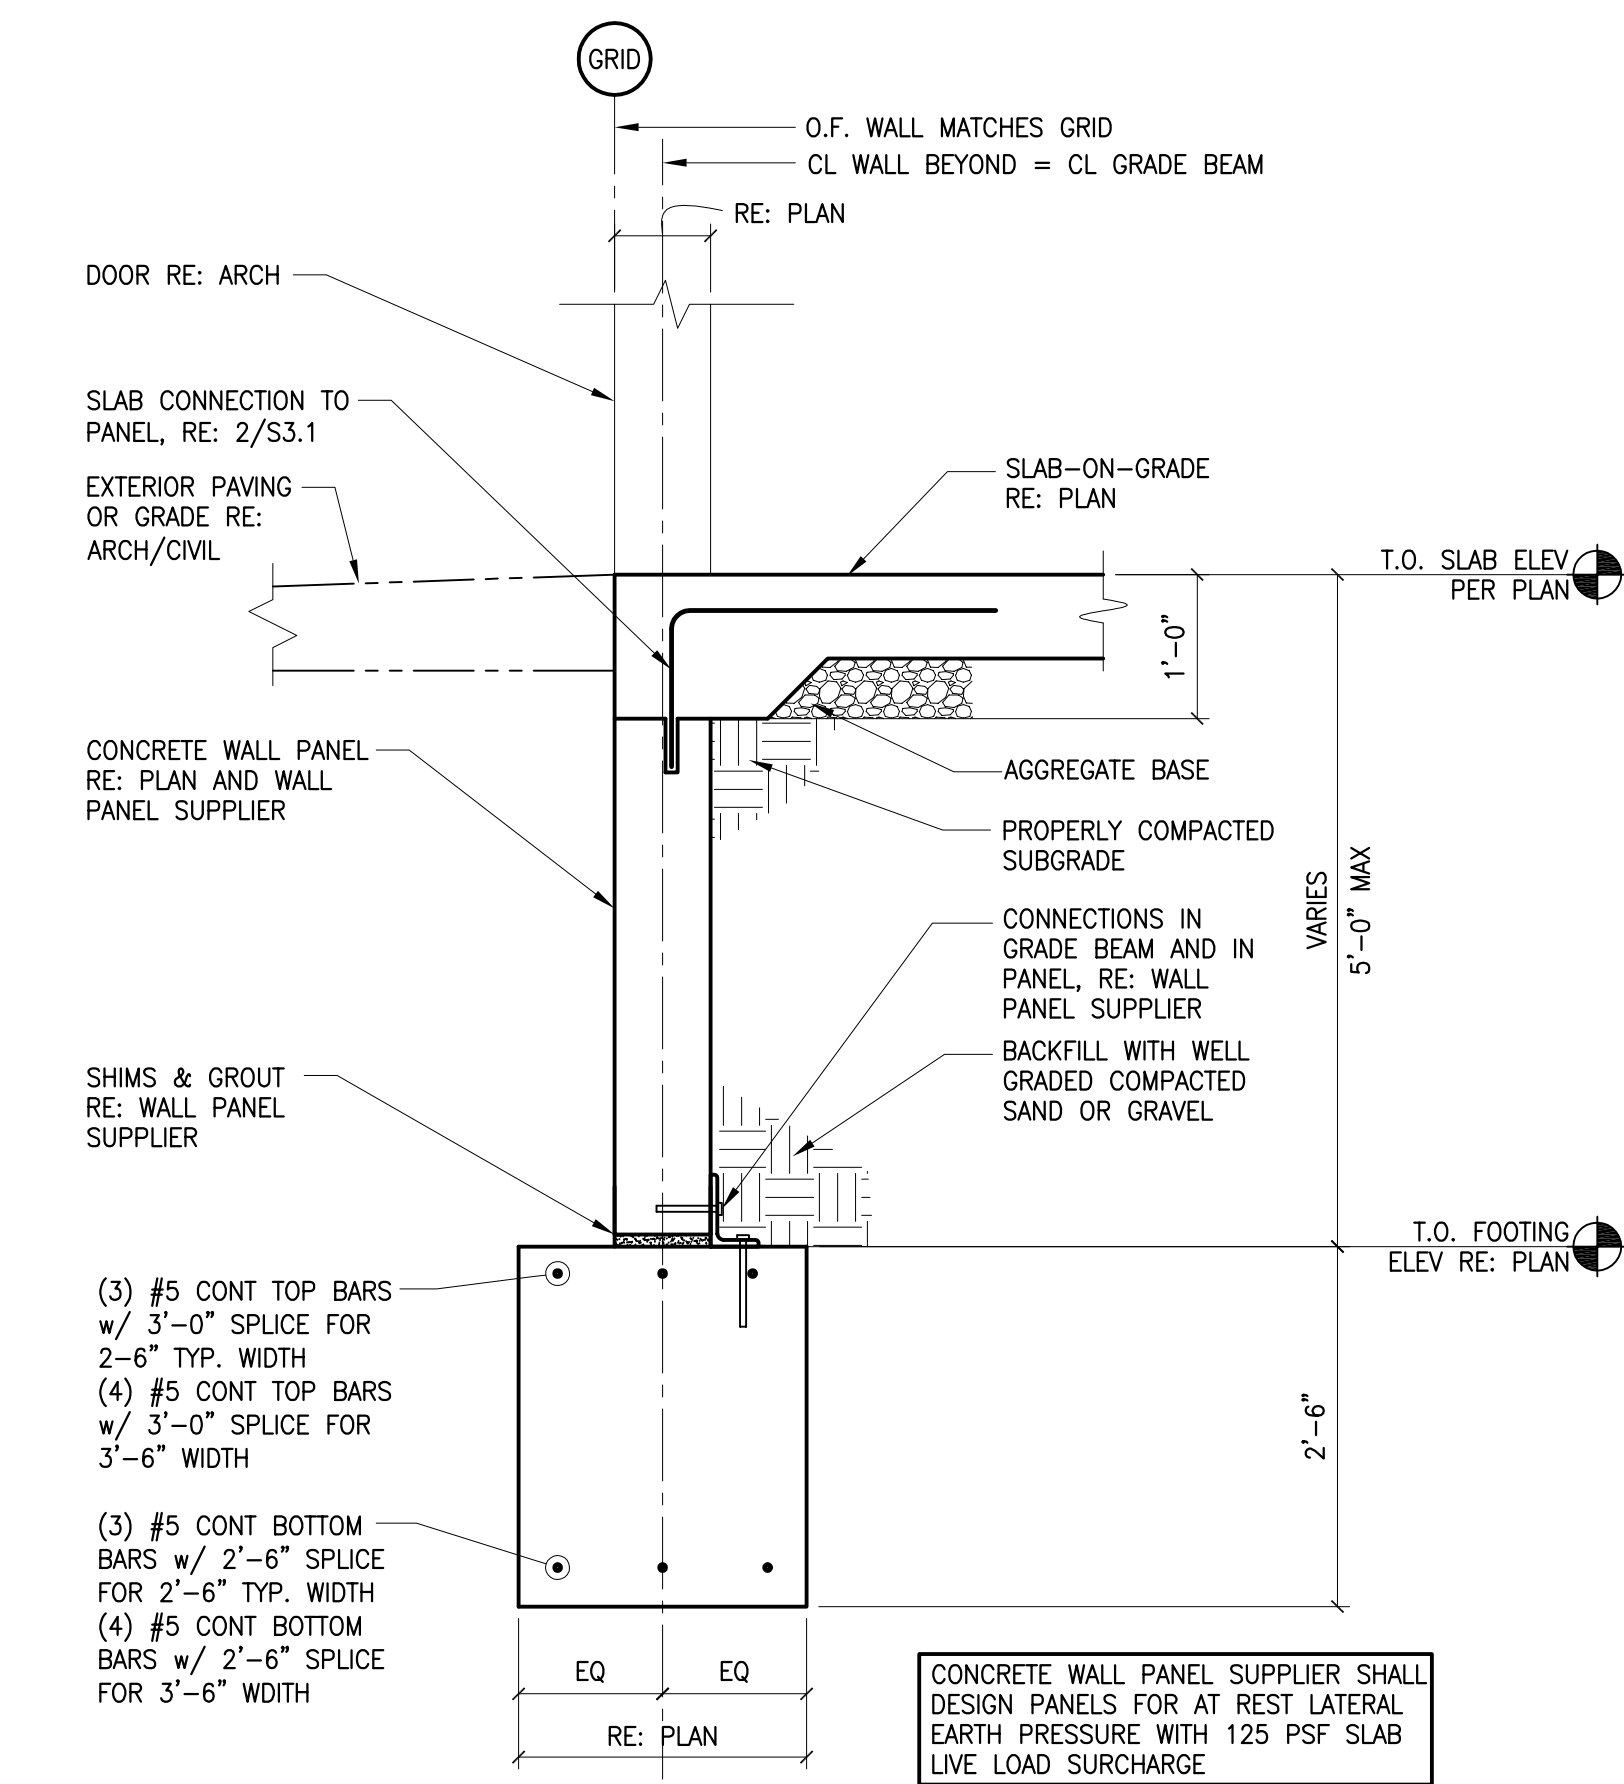


3 FOUNDATION SECTION

3/4" = 1'-0"

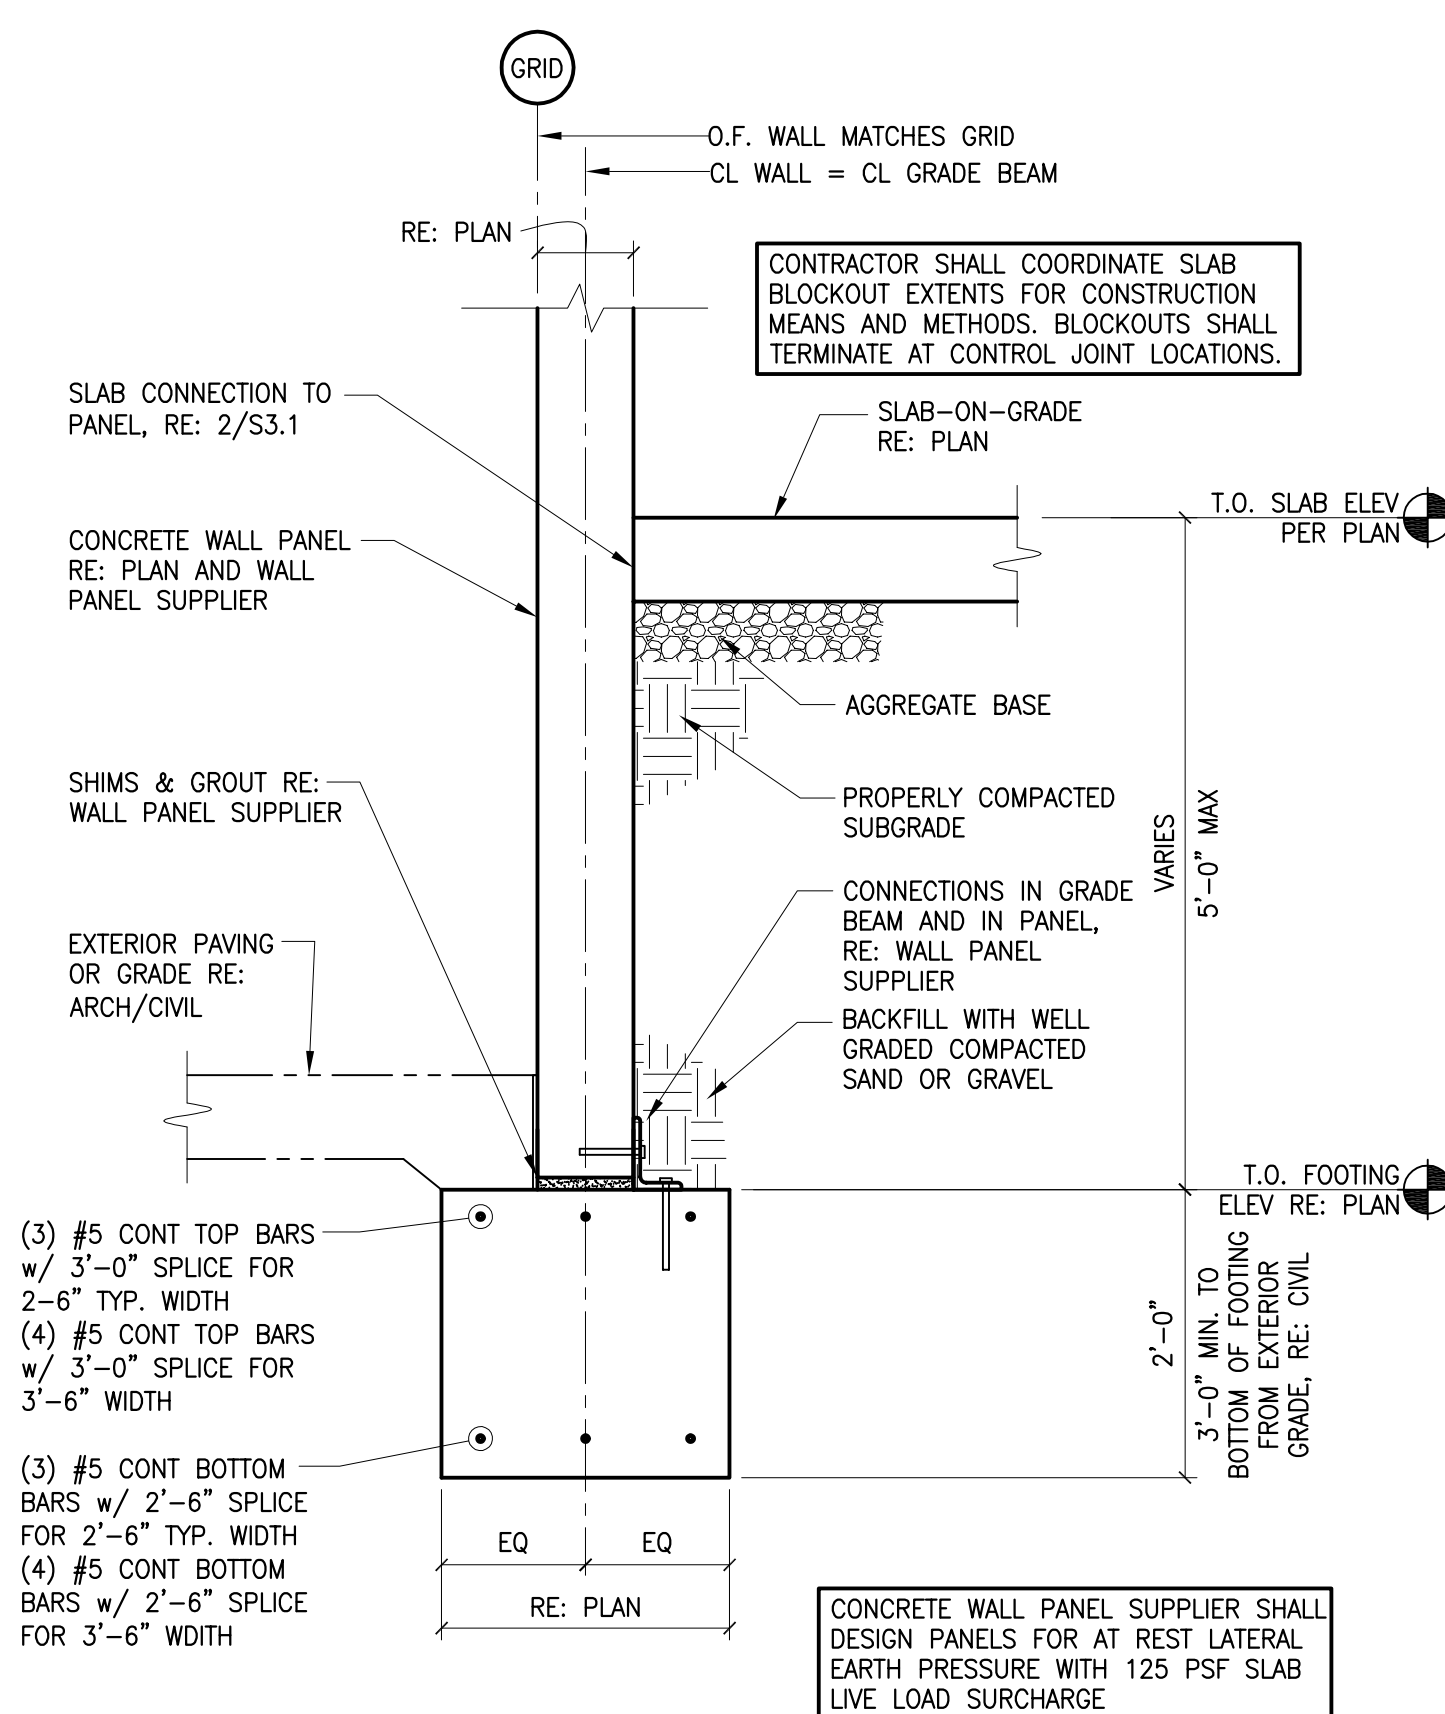


2 FOUNDATION SECTION AT DOCK WALL

3/4" = 1'-0"

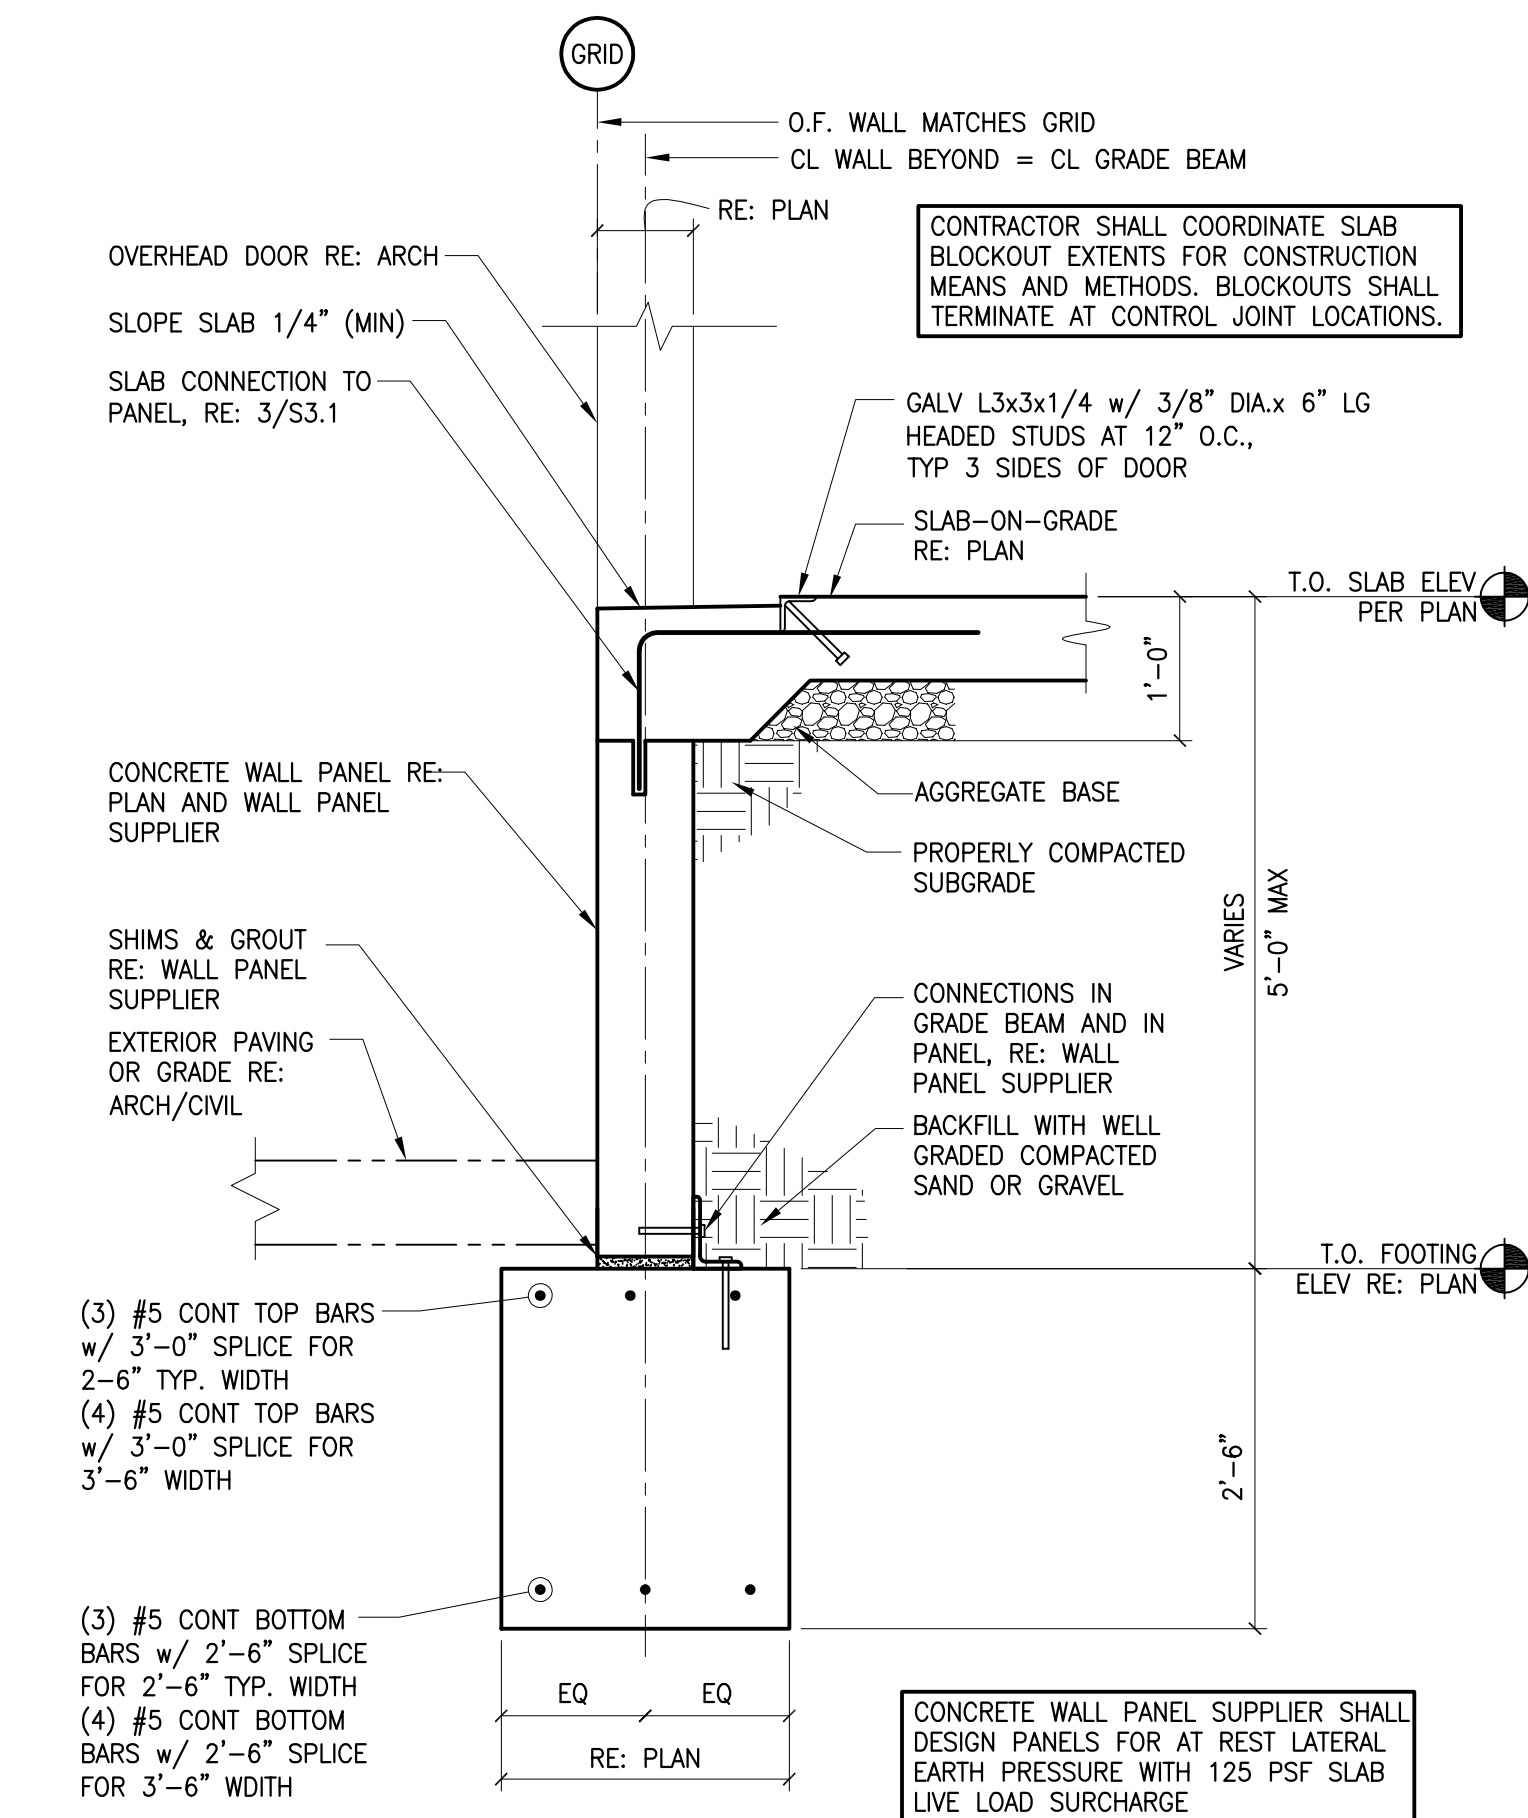

1 FOUNDATION SECTION AT OVERHEAD DOOR

3/4" = 1'-0"

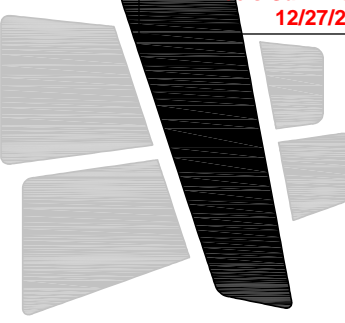

CURRAN ARCHITECTURE

5719 LAWTON LOOP E. DR. #212
INDIANAPOLIS, IN 46216
O :: 317 . 288 . 0681
F :: 317 . 288 . 0753



SCANNELL
PROPERTIES

wallace



Wallace Engineering
Structural Consultants, Inc.

Structural and Civil Consultants
1741 McGee Street
Kansas City, Missouri 64108
816.421.8282, Fax 816.421.8338

CERTIFICATION



12/13/2022
Missouri COA #001268

THIS DRAWING AND THE IDEAS, DESIGNS
AND CONCEPTS CONTAINED HEREIN ARE
THE EXCLUSIVE INTELLECTUAL PROPERTY OF
CURRAN ARCHITECTURE, AND ARE NOT
TO BE USED OR REPRODUCED, WHOLE OR
IN PART, WITHOUT THE WRITTEN
CONSENT OF CURRAN ARCHITECTURE.
© COPYRIGHT 2021, CURRAN ARCHITECTURE

PROJECT INFORMATION

LEE'S SUMMIT LOGISTICS
BUILDING A LOT I

NW CORNER TUDOR RD & MAINST
LEE'S SUMMIT, MO


ISSUE DATES

ISSUE	DATE
ISSUE FOR PERMIT	02.18.2022
ISSUE FOR PERMIT	04.15.2022


210300

S3.3


FOUNDATION DETAILS

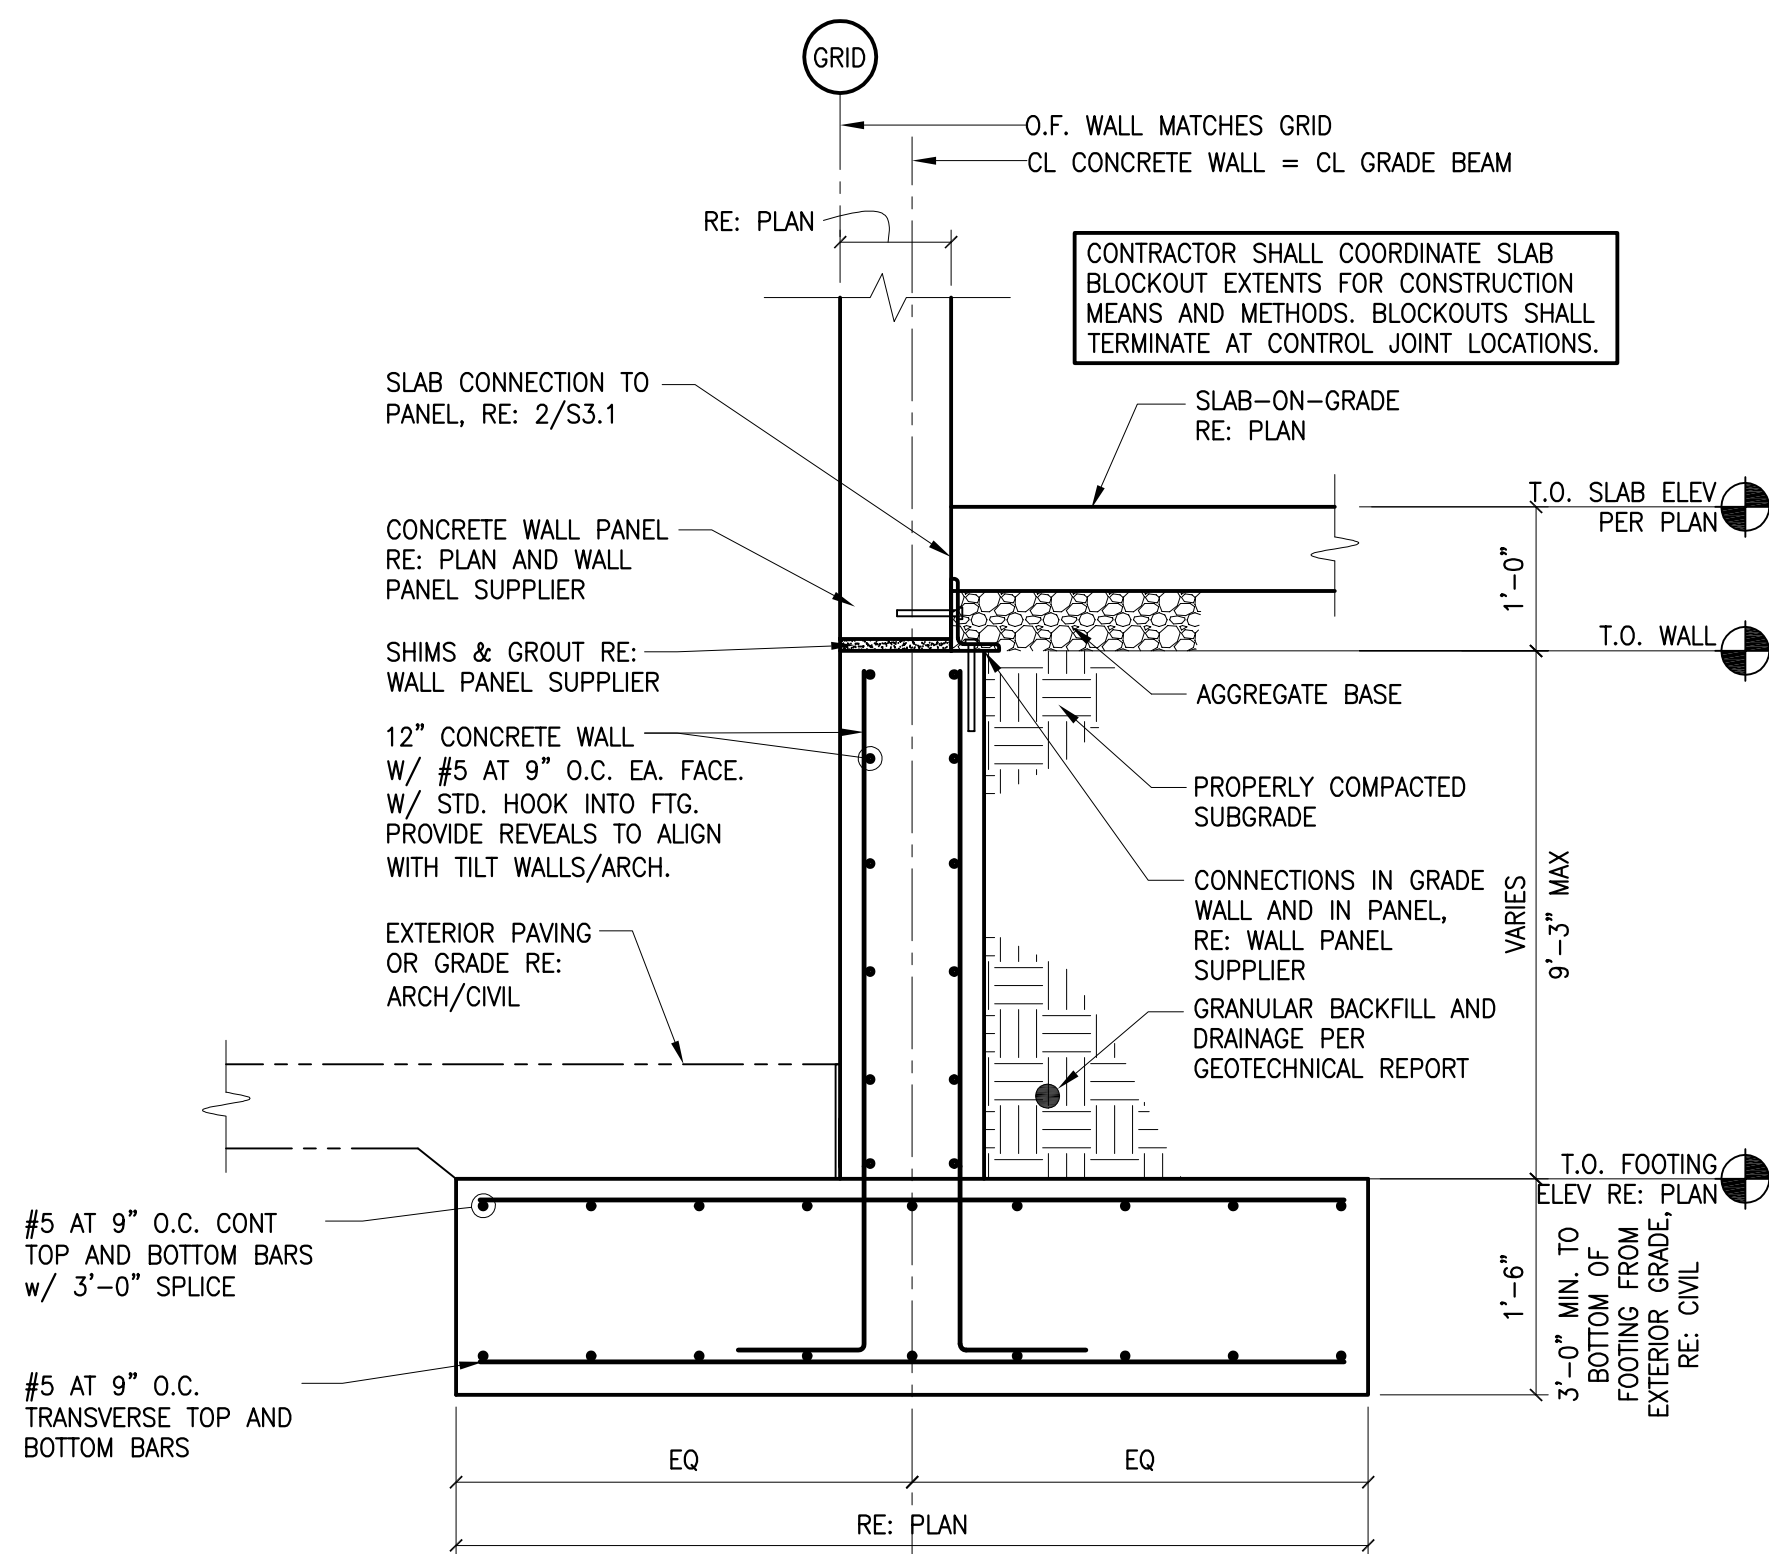


6 FOUNDATION SECTION
3/4" = 1'-0"

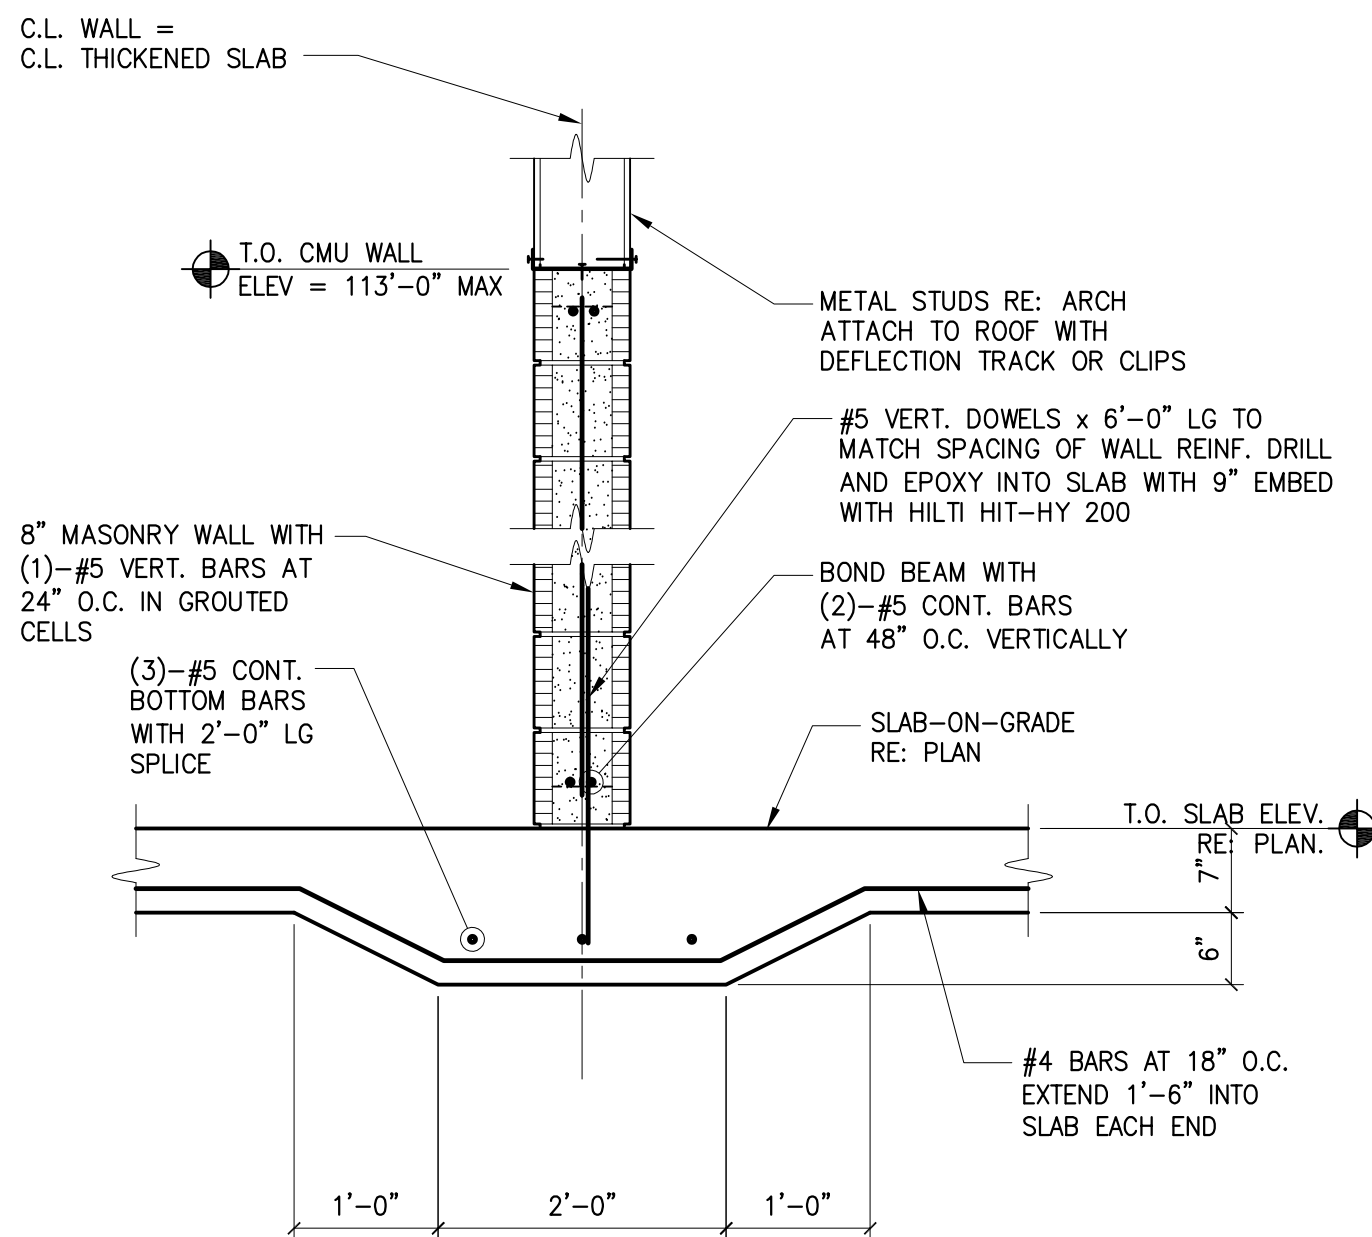


5 FOUNDATION SECTION
3/4" = 1'-0"

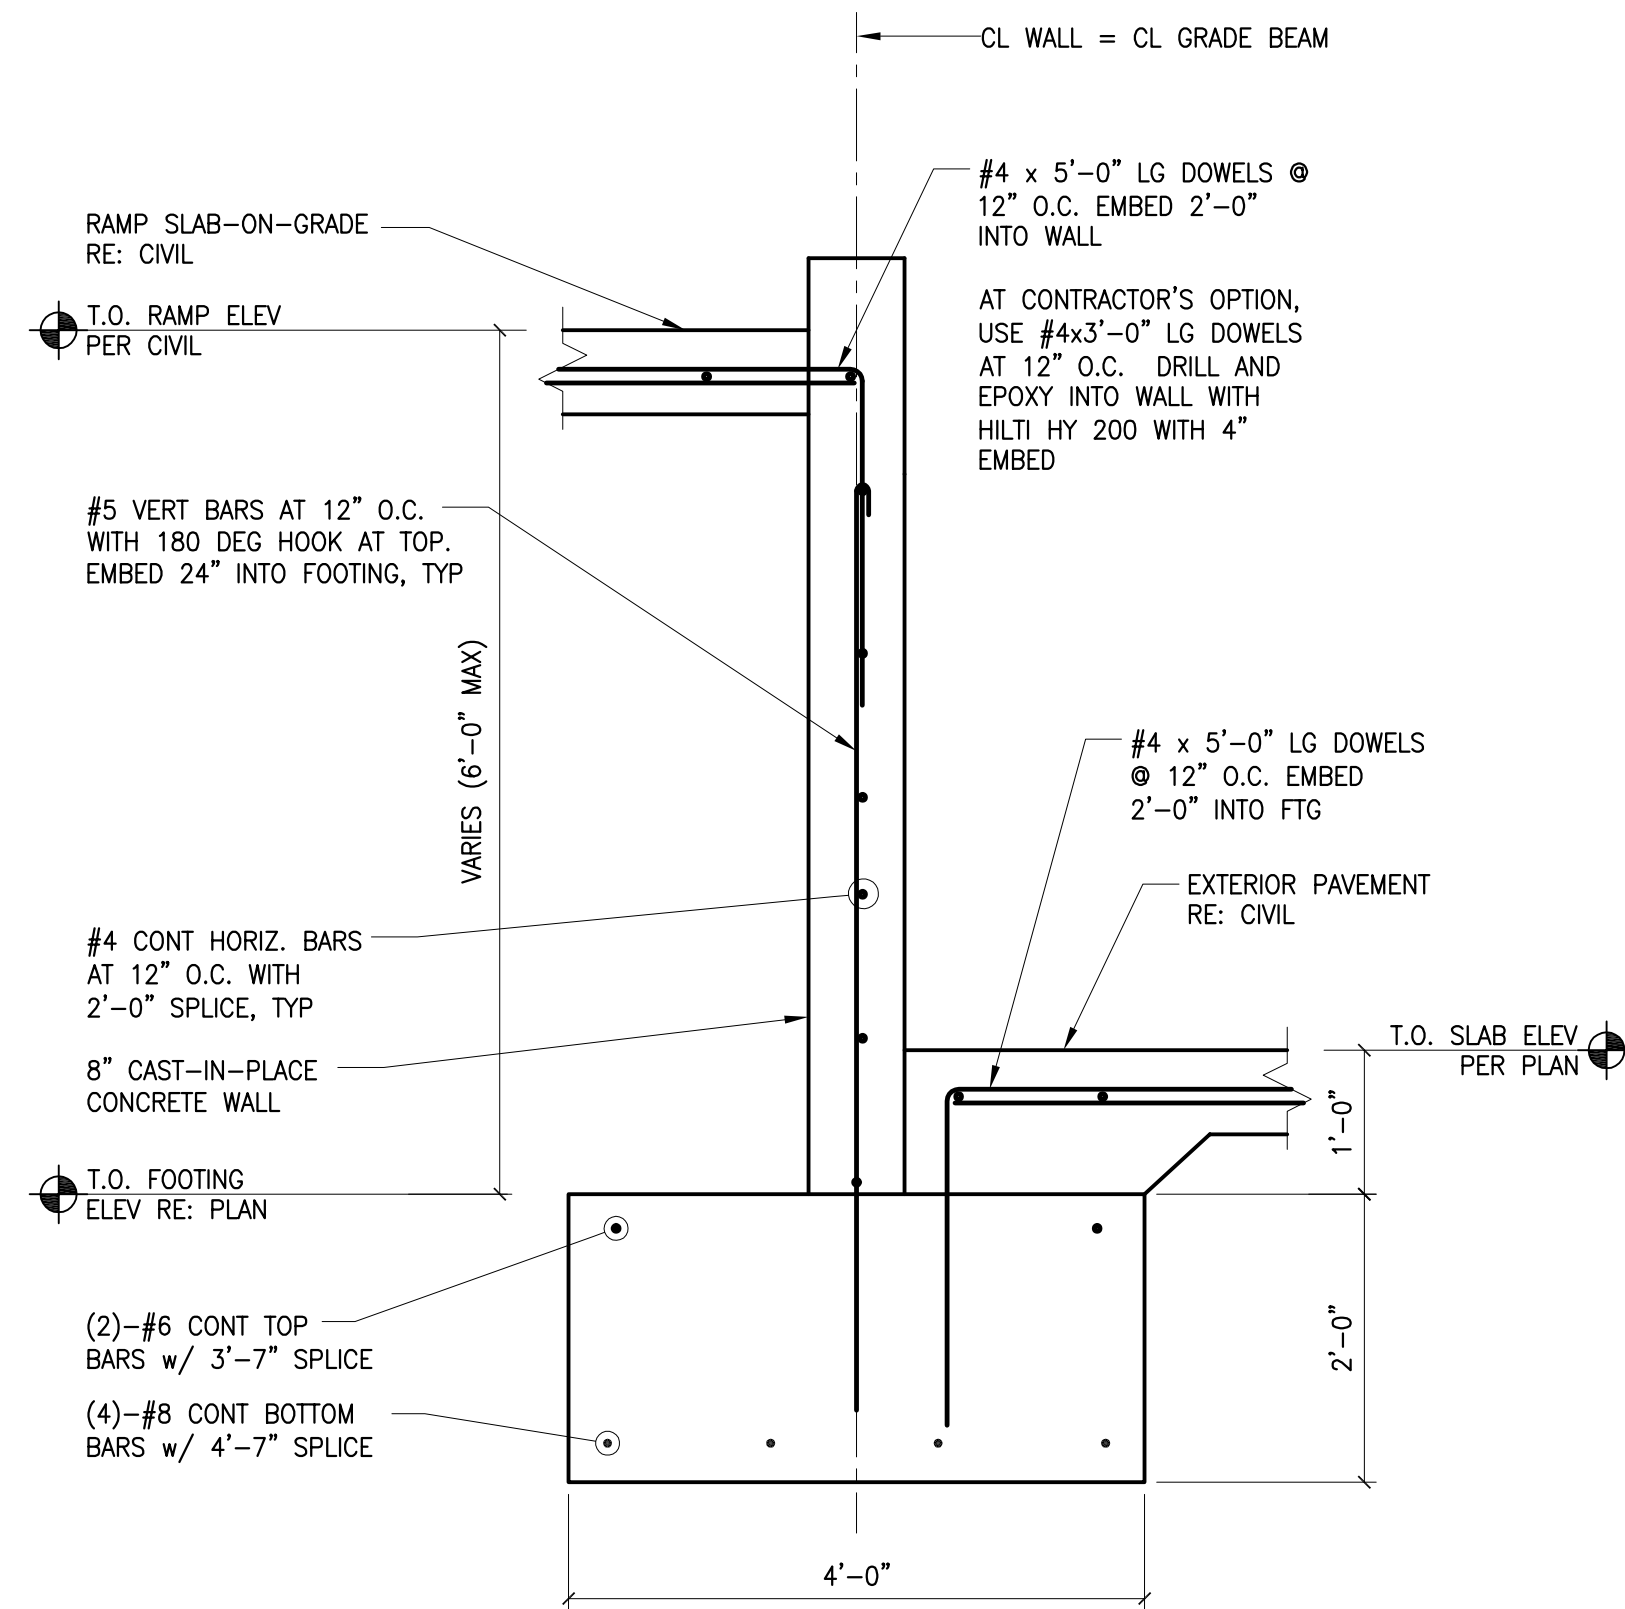


4 FOUNDATION SECTION
3/4" = 1'-0"

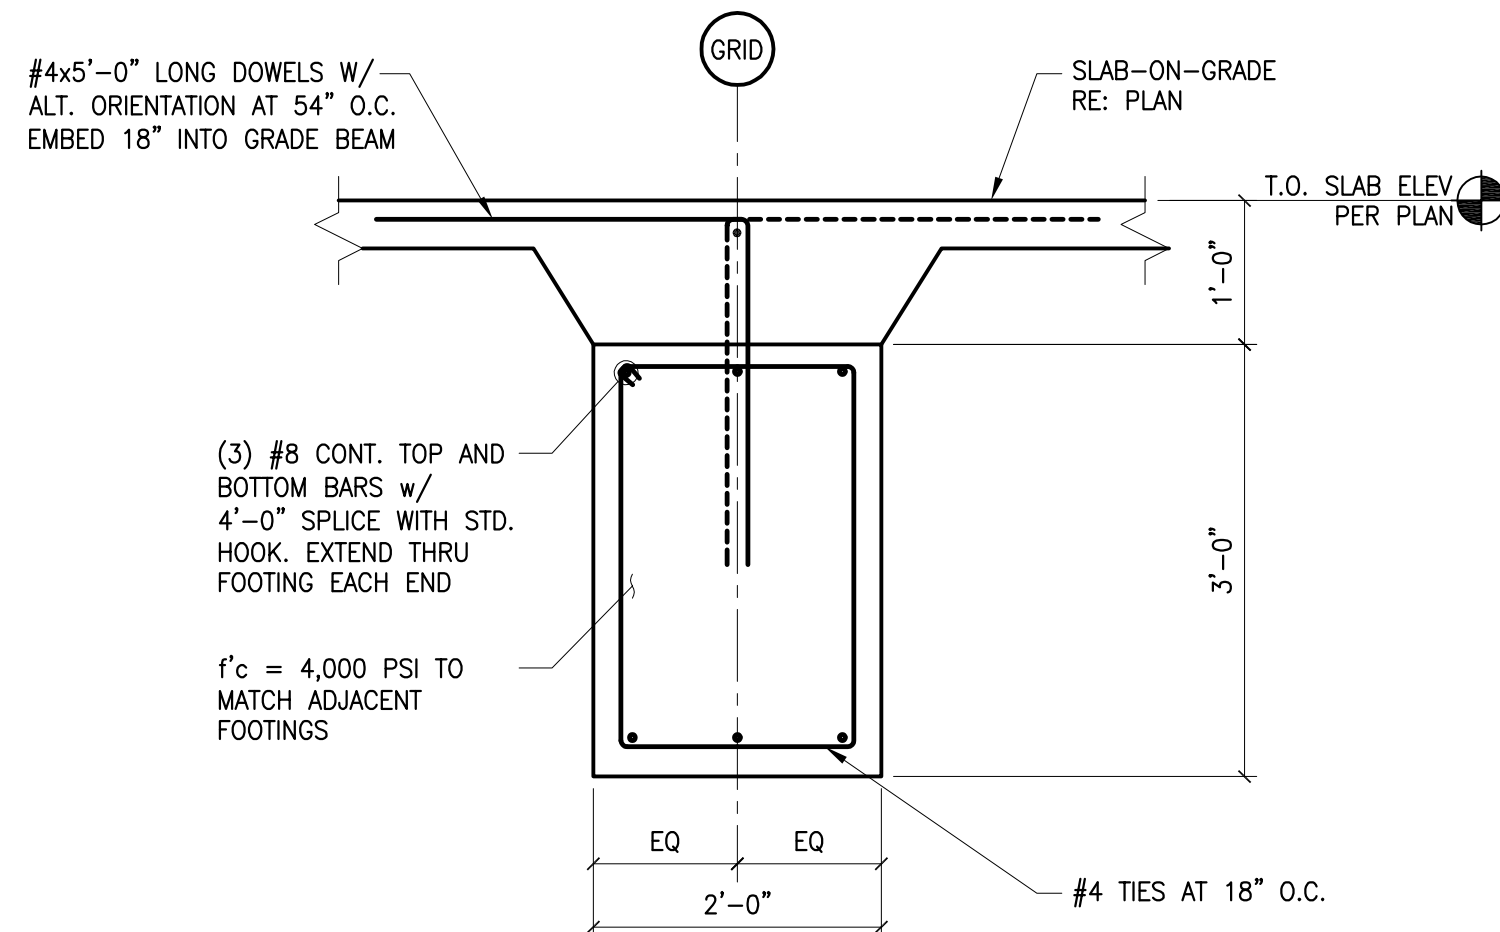

3 FOUNDATION SECTION
3/4" = 1'-0"

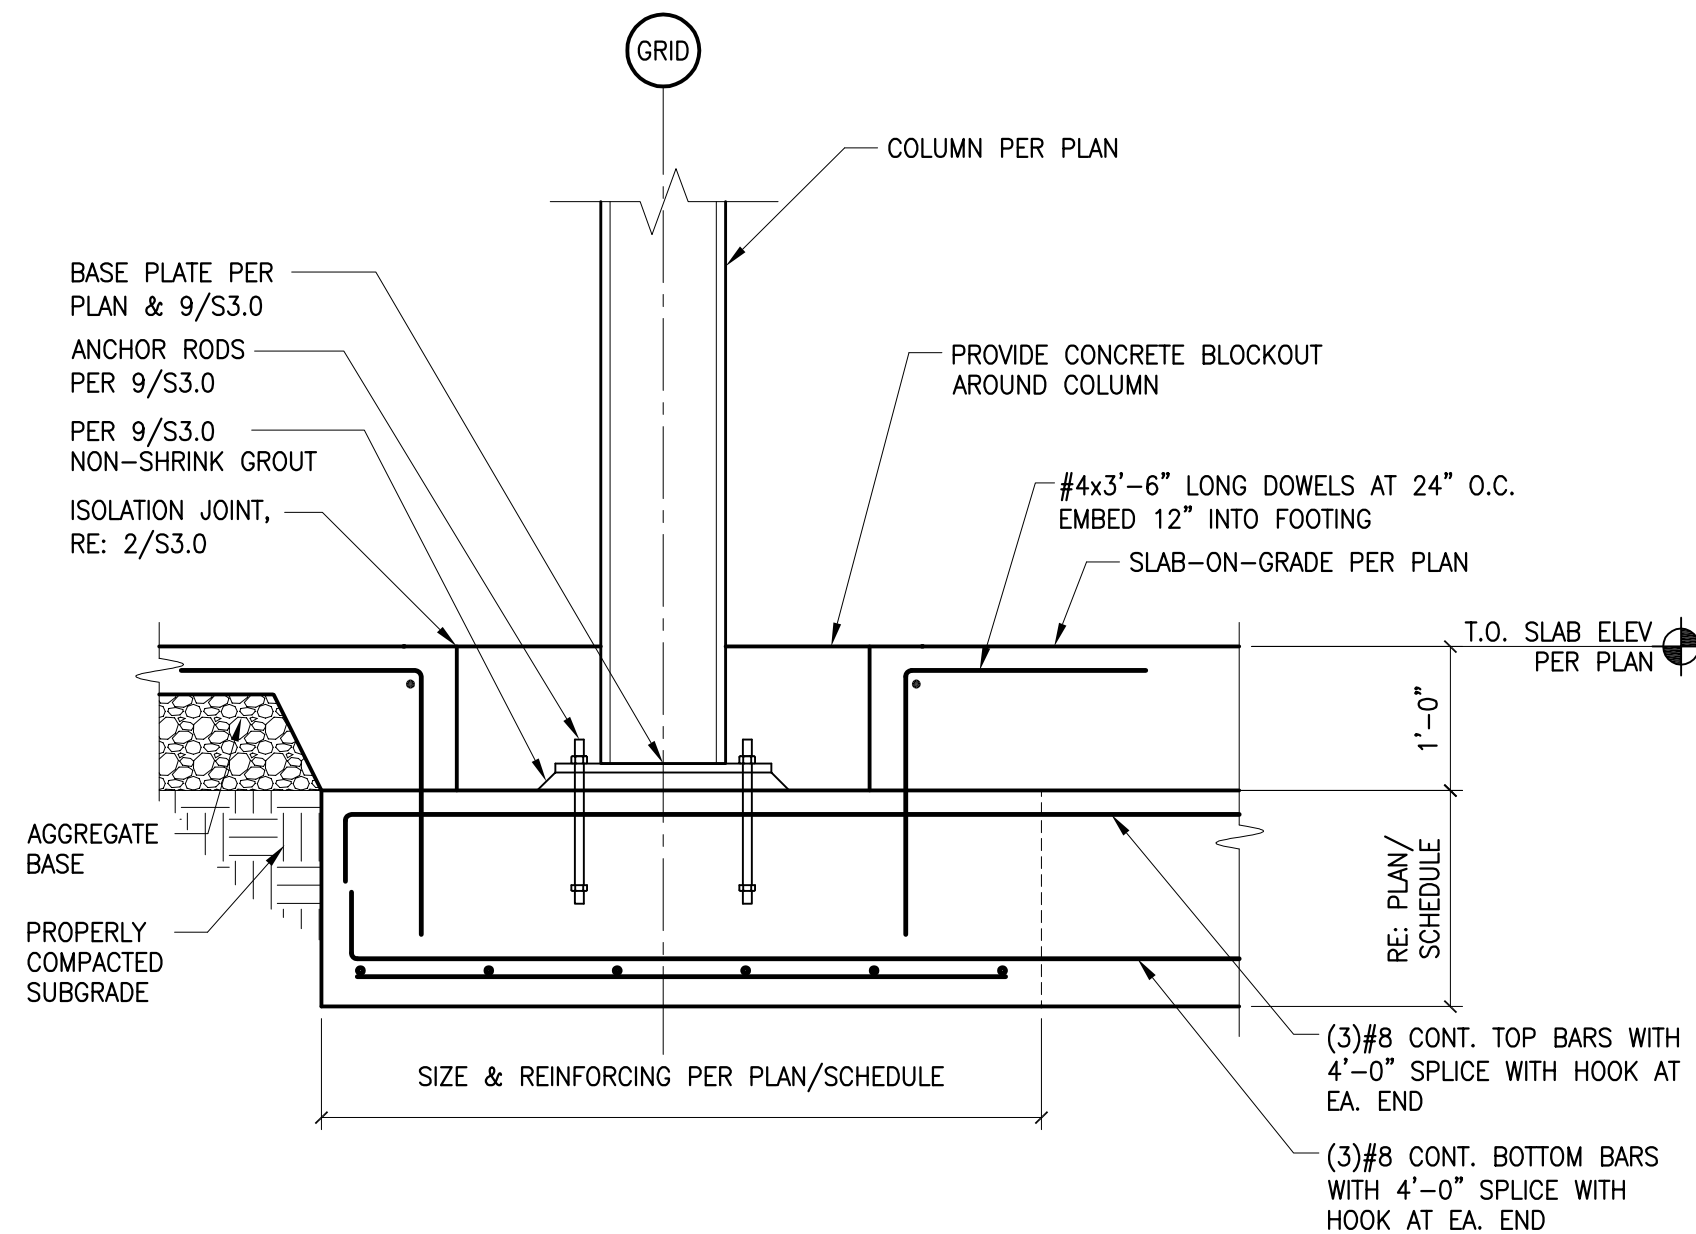

2 TYPICAL BRACED FRAME FOOTING DETAIL
3/4" = 1'-0"

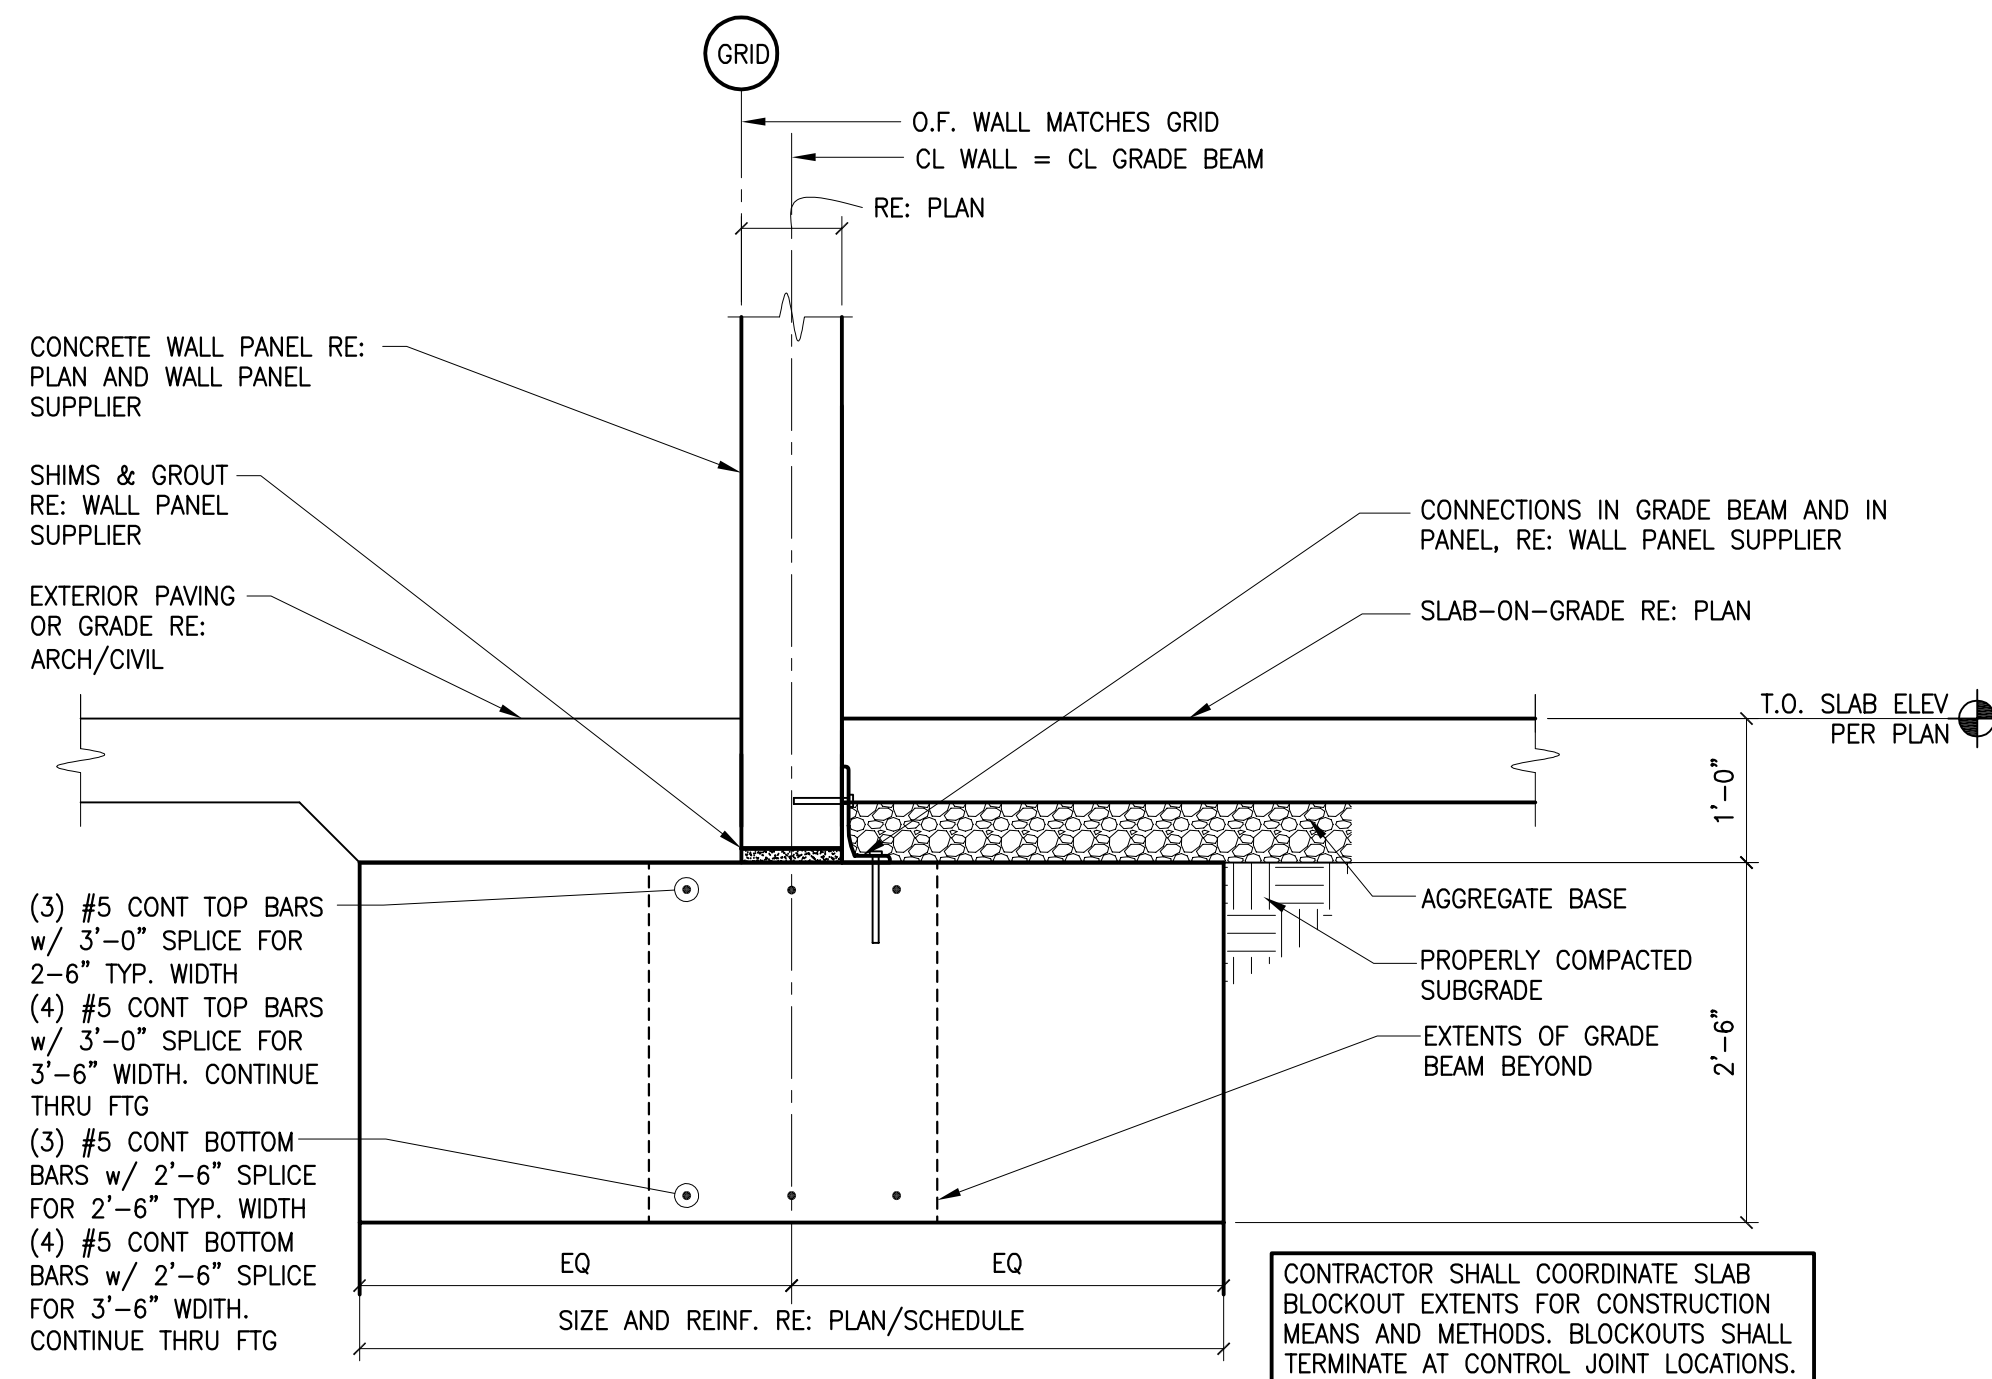

1 FOUNDATION SECTION
3/4" = 1'-0"



CURRAN
ARCHITECTURE

5719 LAWTON LOOP E. DR. #212
INDIANAPOLIS, IN 46216
O :: 317 . 288 . 0681
F :: 317 . 288 . 0753



SCANNELL
PROPERTIES


wallace



Wallace Engineering
Structural Consultants, Inc.

Structural and Civil Consultants
1741 McGee Street
Kansas City, Missouri 64108
816.421.8282, Fax 816.421.8338

CERTIFICATION

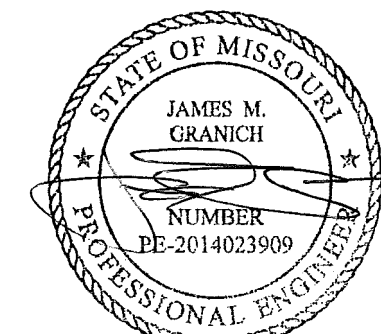

12/13/2022
Missouri COA #001268

THIS DRAWING AND THE IDEAS, DESIGNS AND CONCEPTS CONTAINED HEREIN ARE THE EXCLUSIVE INTELLECTUAL PROPERTY OF CURRAN ARCHITECTURE, AND ARE NOT TO BE USED OR REPRODUCED, WHOLE OR IN PART, WITHOUT THE WRITTEN CONSENT OF CURRAN ARCHITECTURE.
© COPYRIGHT 2021, CURRAN ARCHITECTURE

PROJECT INFORMATION

LEE'S SUMMIT LOGISTICS
BUILDING A LOT I

NW CORNER TUDOR RD & MAINST
LEE'S SUMMIT, MO












ISSUE DATES

ISSUE	DATE
ISSUE FOR PERMIT	02.18.2022
ISSUE FOR PERMIT	04.15.2022

210300

S4.0






FRAMING DETAILS

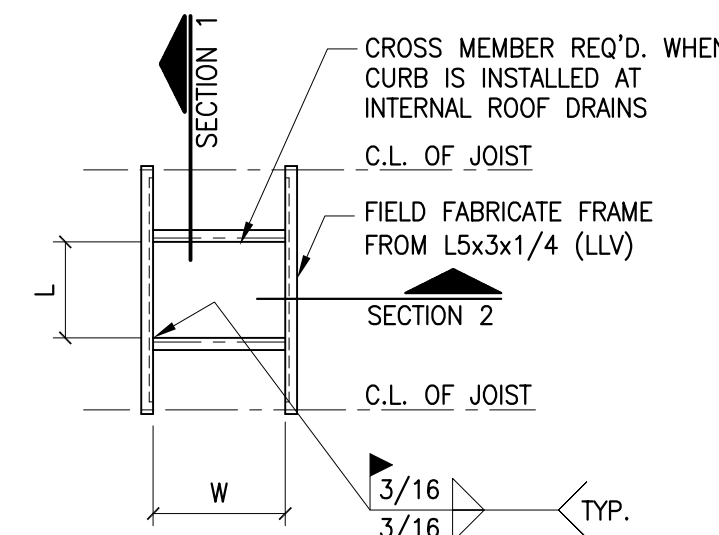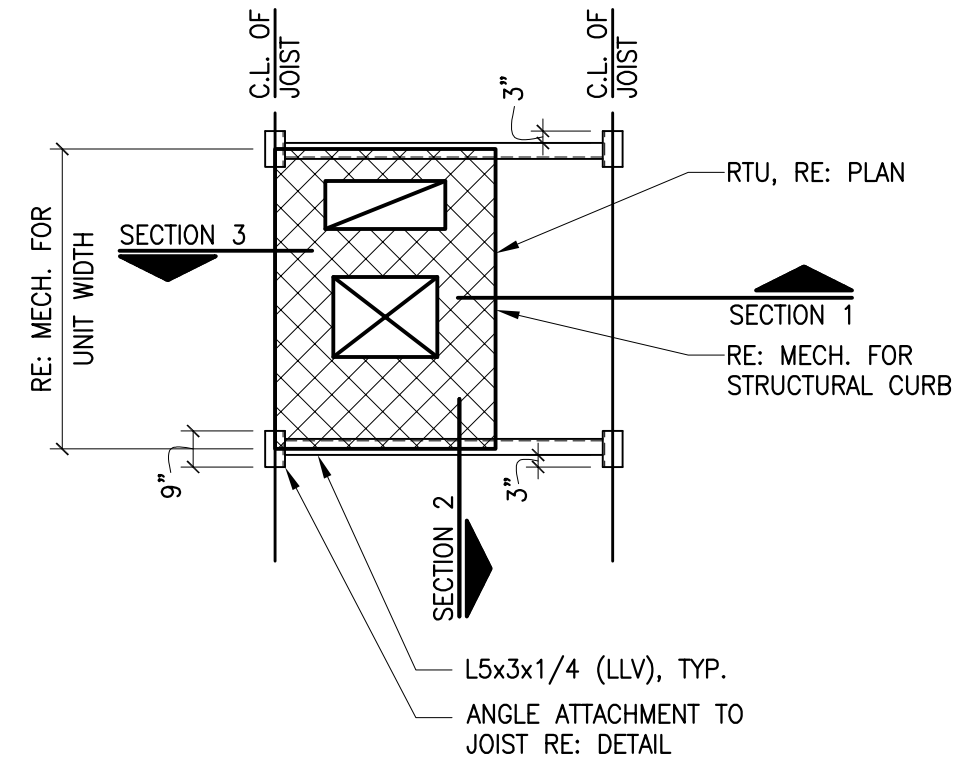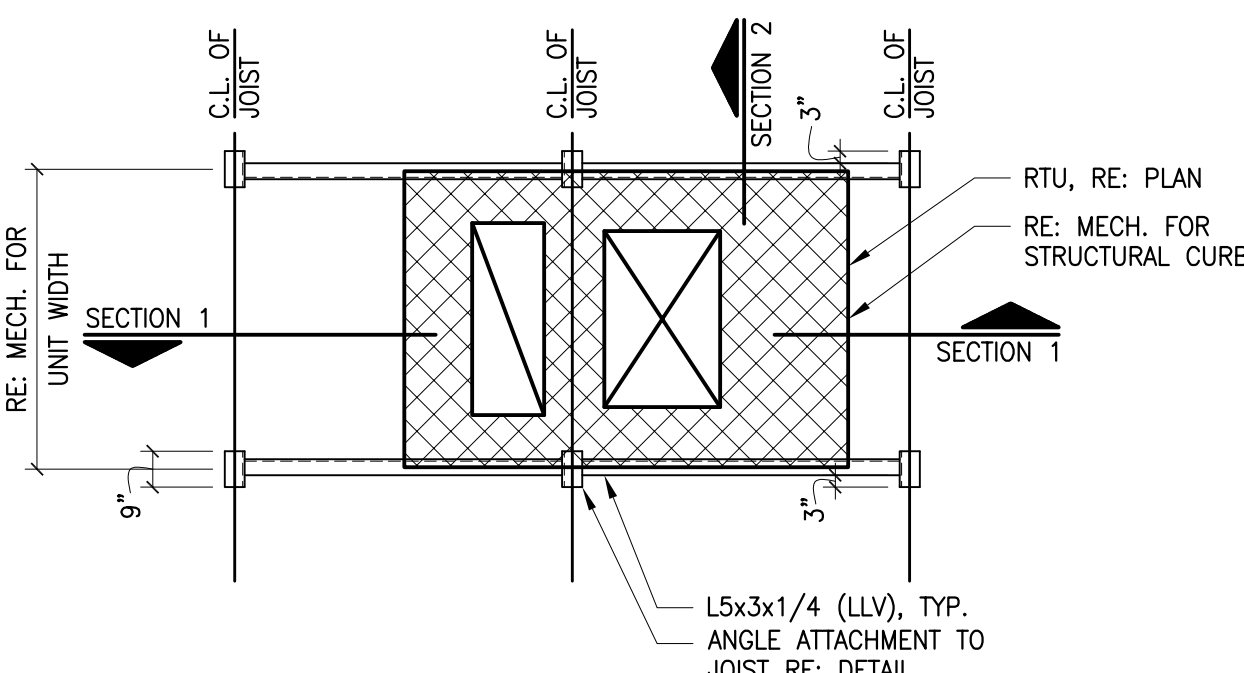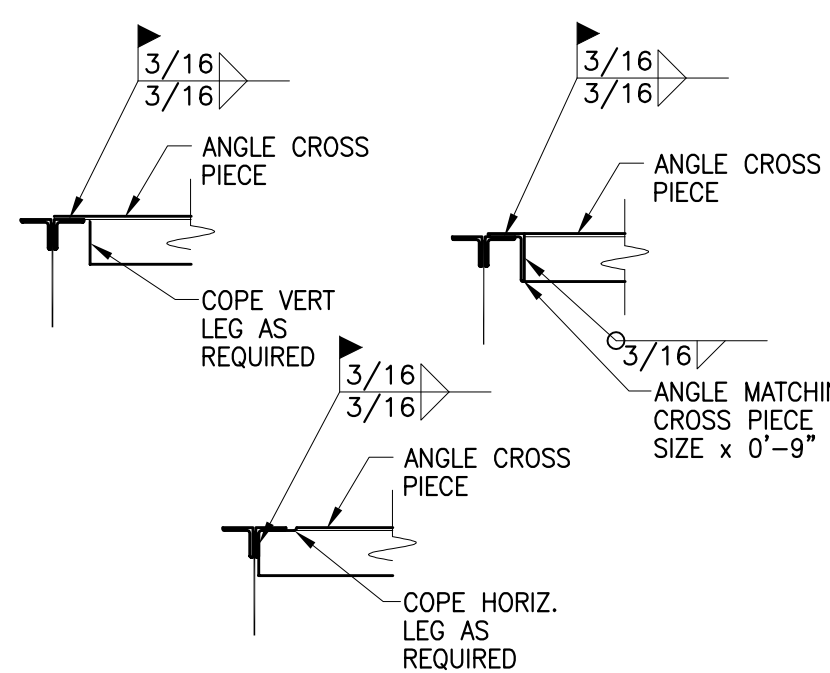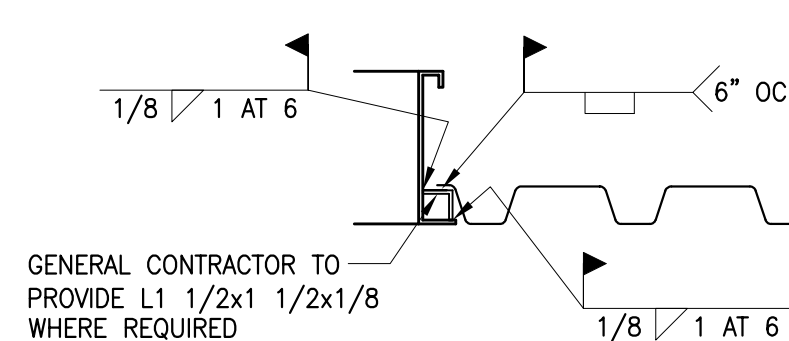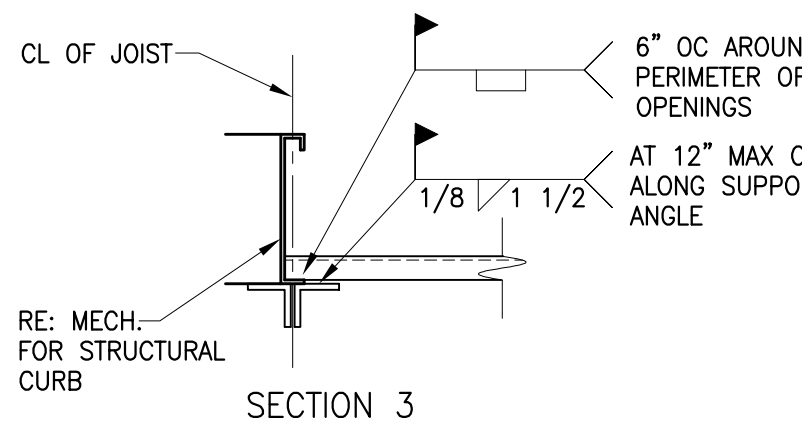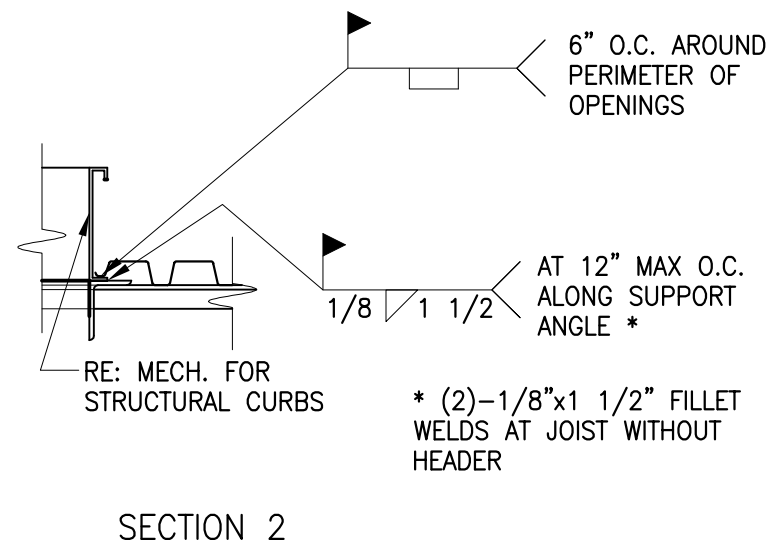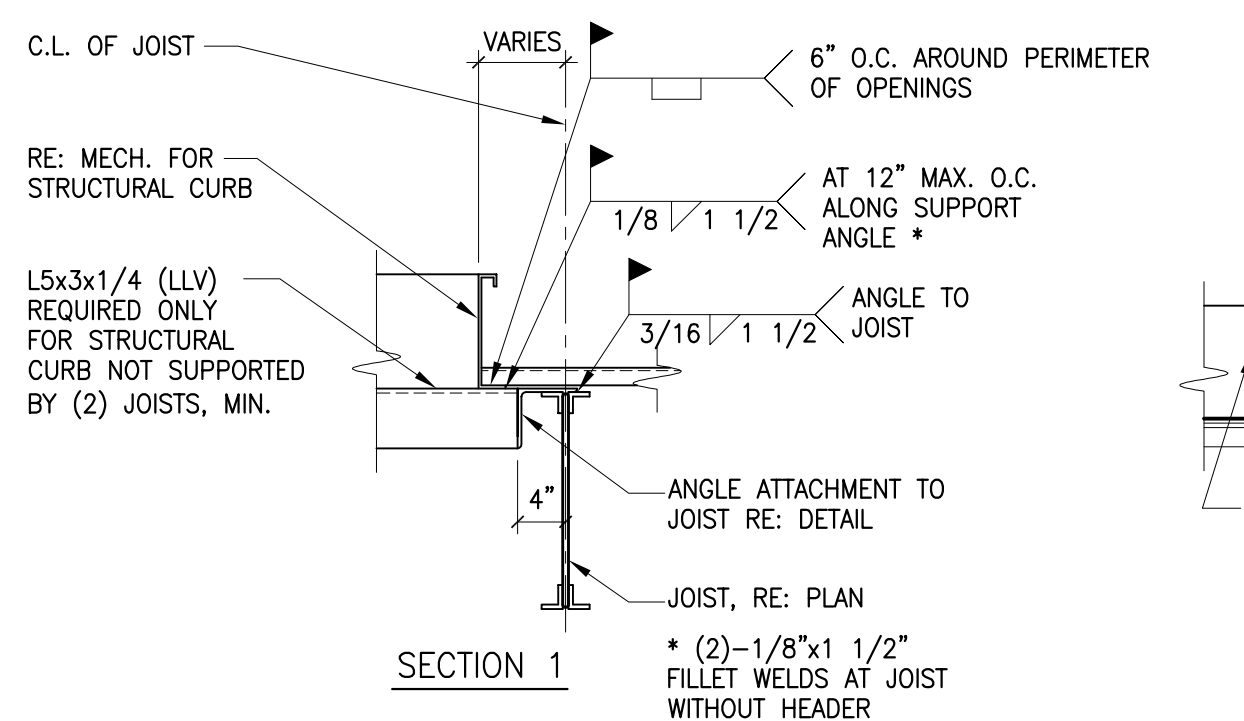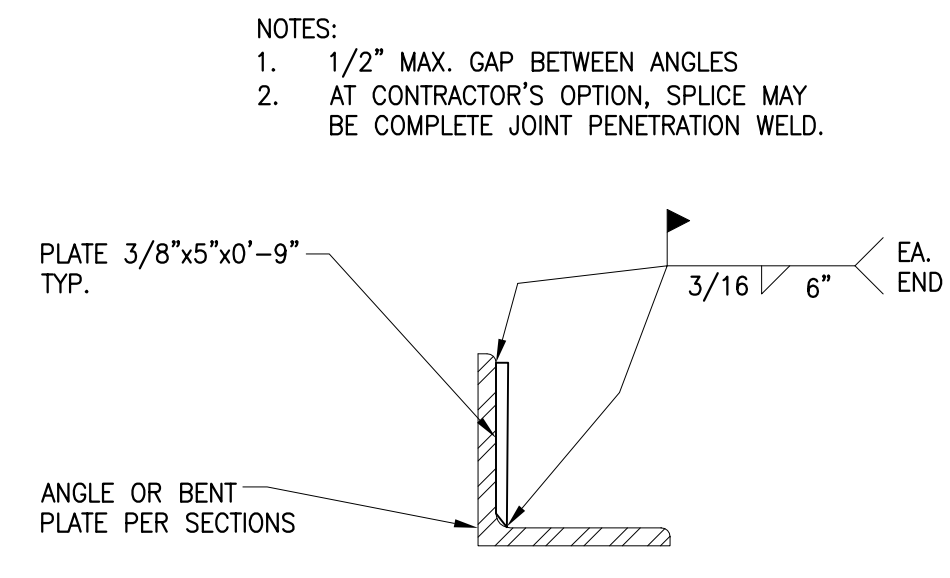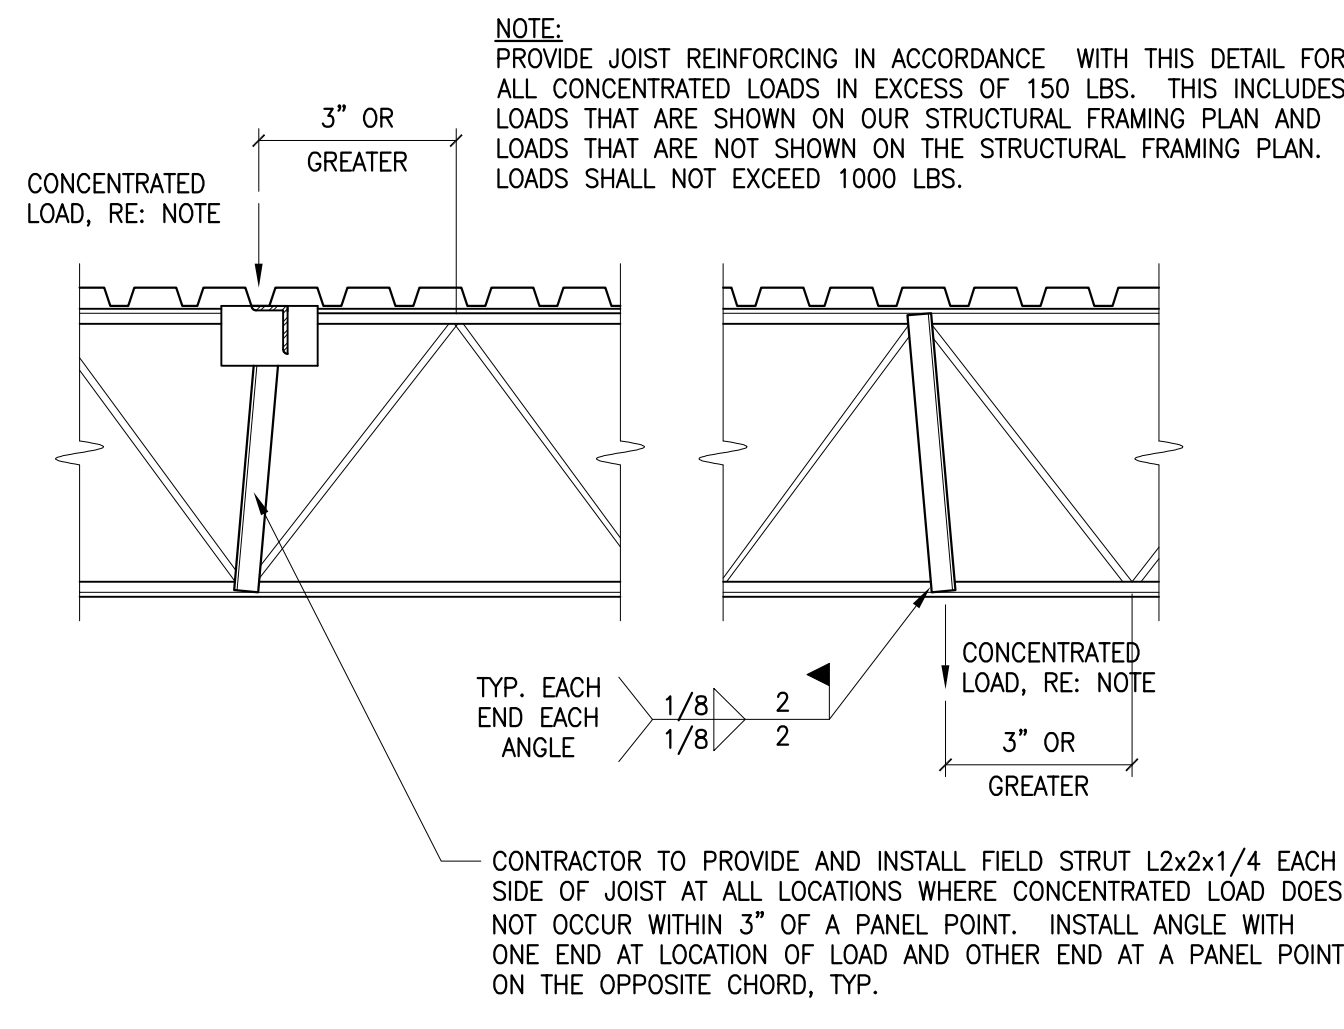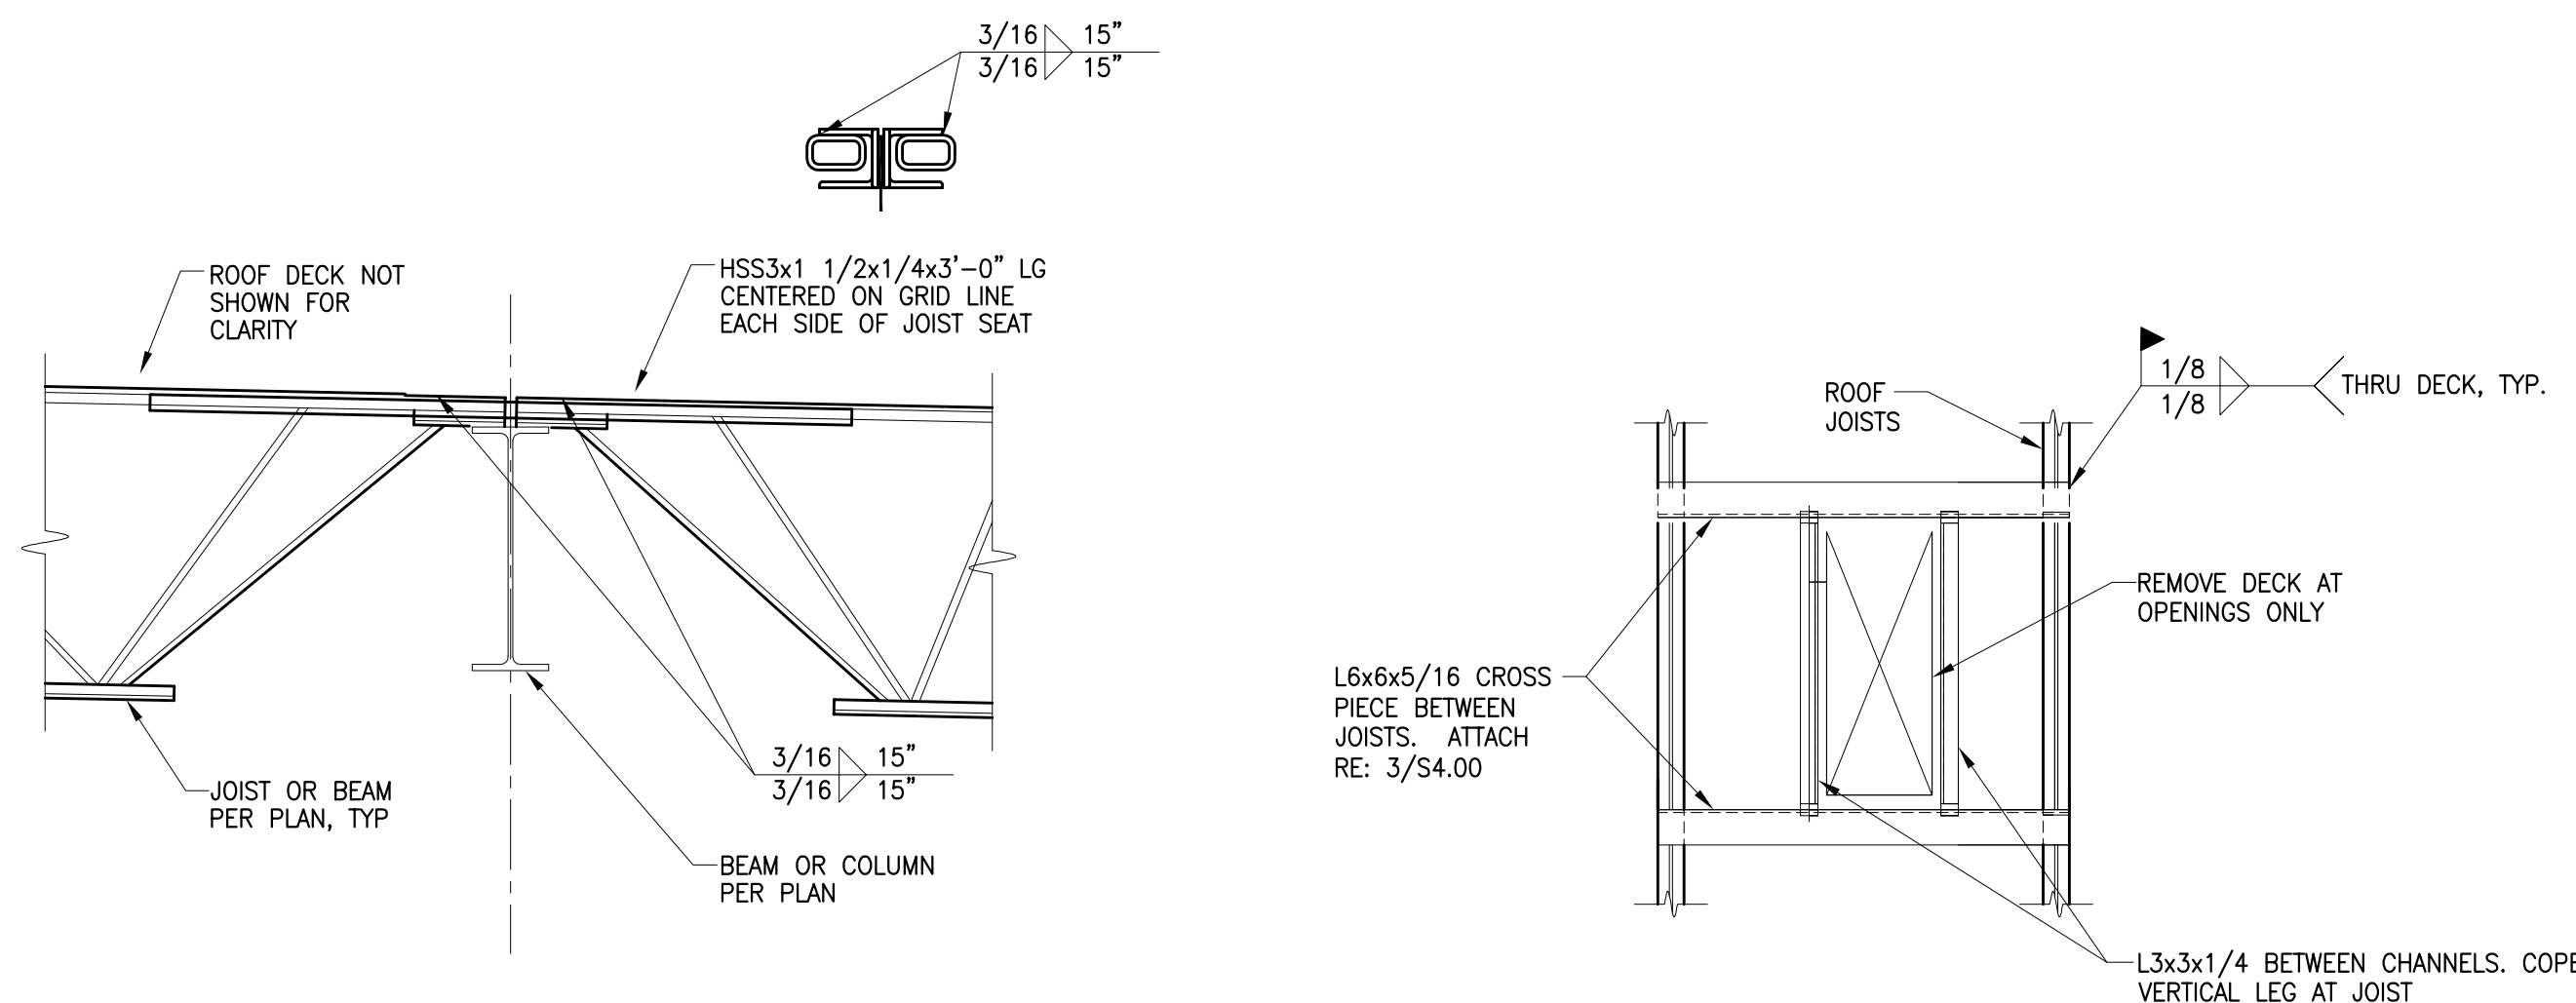

- NOTES:
1. INSTALL CURBS, HEADERS, AND FRAMES AND WELD TO SUPPORT STEEL BEFORE DECK IS PLACED.
 2. DESIGN JOISTS SUPPORTING RTU'S FOR TWO POINT LOADS. THE LOCATION OF THE LOADS AND THE SPACING BETWEEN THEM VARY. RE: RTU JOIST DIAGRAM THIS DETAIL AND ROOF FRAMING PLAN FOR POINT LOADS AND LOCATIONS.
 3. RTU CURBS SHALL BE STRUCTURAL, DESIGNED TO SPAN BETWEEN JOISTS AND SUPPORT EDGES OF DECK. CURBS TO BE FABRICATED WITH LEDGE ANGLES (L2x2x1/4) AT MECHANICAL OPENINGS TO SUPPORT METAL DECK INSIDE OPENING NOT USED BY SUPPLY OR RETURN DUCT WORK. HEADERS ARE NOT REQUIRED FOR STRUCTURAL CURBS EXCEPT WHEN THE CURB DOES NOT SPAN BETWEEN TWO JOISTS OR THE CURB CANTILEVERS MORE THAN TWO FEET PAST JOIST.
 4. ATTACH DECK AROUND OPENING PER ROOF DIAPHRAGM CONNECTION DETAIL.
 5. IF CURB IS NOT PLACED WITHIN 3" OF A JOIST PANEL POINT, RE: JOIST REINFORCING DETAIL RE: 7/S4.00.
 6. GENERAL CONTRACTOR SHALL COORDINATE RTU DIMENSIONS AND FRAMING LOCATIONS WITH THE STEEL FABRICATOR, MECHANICAL, AND ERECTION SUBCONTRACTORS.
 7. STEEL SUPPLIER TO FURNISH STOCK ANGLE FOR FIELD FABRICATED SUPPORT FRAMES.
 8. RE: DETAIL 1 FOR CONN. OF DECK PARALLEL TO CURB (WHERE REQ'D.).
 9. RE: MECH. FOR ROOF TOP UNIT ANCHORAGE TO CURBS.


5 MECHANICAL UNIT SUPPORT DETAIL
3/4" = 1'-0"

NOTE:
AT CONTRACTOR'S OPTION, WELDS MAY BE FIELD WELDS.

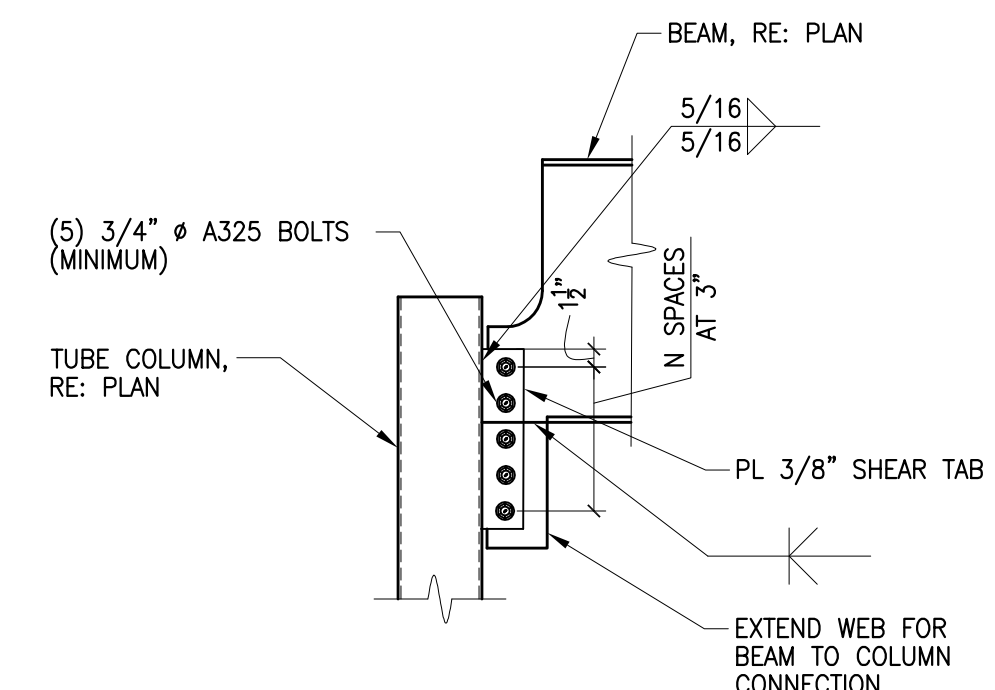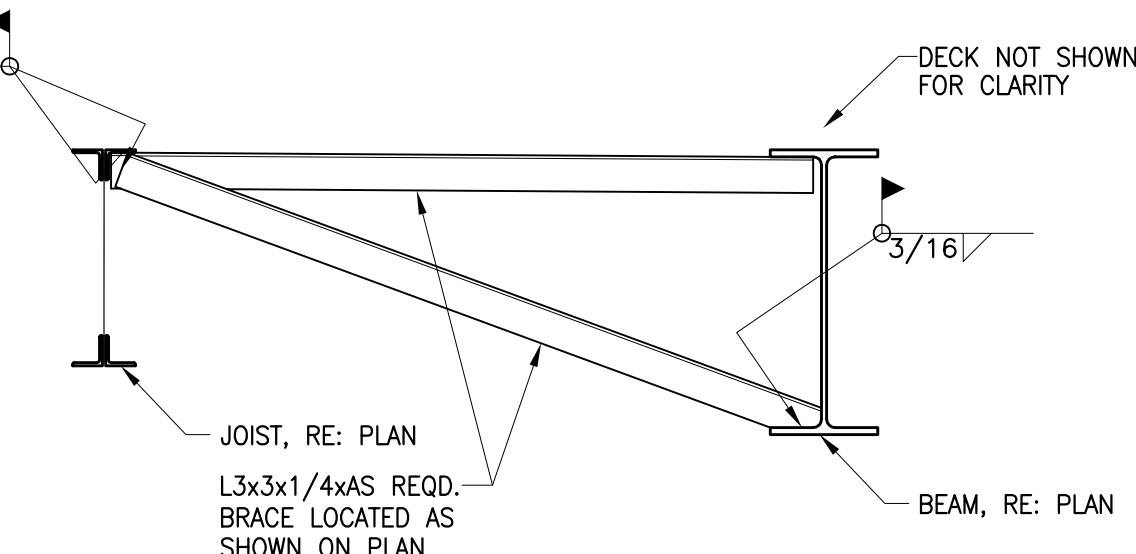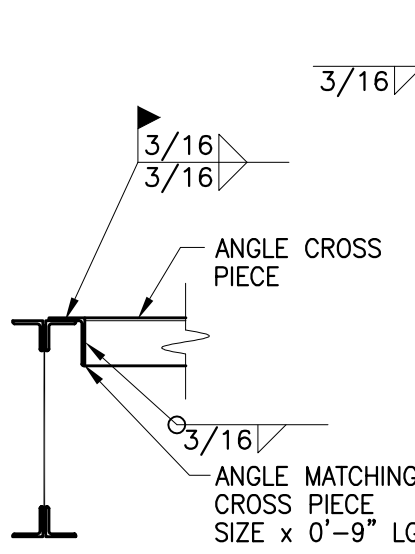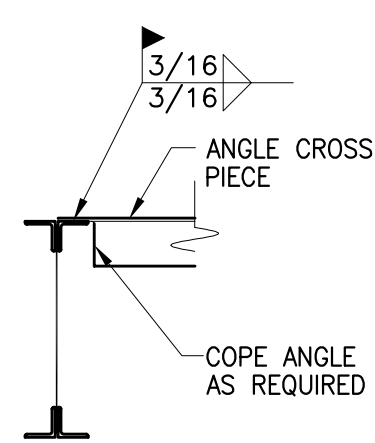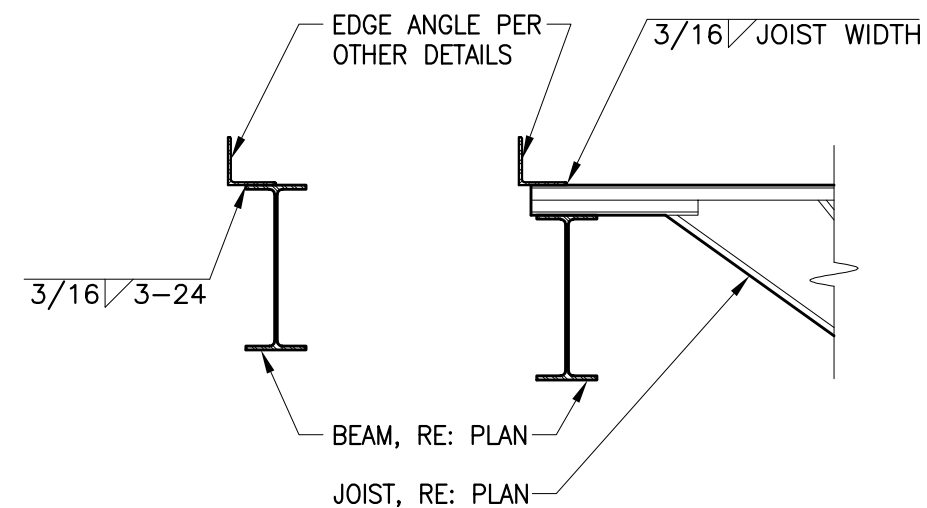

NOTES:

1. ALL CONNECTIONS ON THE STRUCTURAL DRAWINGS, UNLESS NOTED OTHERWISE, SHALL BE DESIGNED AND DETAILED BY A PROFESSIONAL ENGINEER LICENSED IN THE STATE WHERE THE PROJECT IS LOCATED, EMPLOYED OR RETAINED BY THE STEEL FABRICATOR. THE DESIGN AND DETAILED SHALL COMPLY WITH ALL APPLICABLE CODES AND SPECIFICATION SECTIONS.
2. CONNECTIONS SHOWN ARE FOR REFERENCE ONLY. FABRICATOR MAY USE OTHER AISC APPROVED CONNECTIONS.
3. ALL BOLTS SHALL BE 3/4" DIAMETER A325 w/ HEAVY HEX NUTS, UNLESS NOTED OTHERWISE.
4. ALL CONNECTIONS SHALL BE BEARING TYPE CONNECTIONS AND SHALL BE SNUG TIGHTENED UNLESS NOTED OTHERWISE.
5. FOR BEAMS WITH AXIAL REACTIONS PER PLAN, CONNECTIONS SHALL BE DESIGNED AS FULLY TENSIONED SLIP CRITICAL PER AISC SPECIFICATIONS.

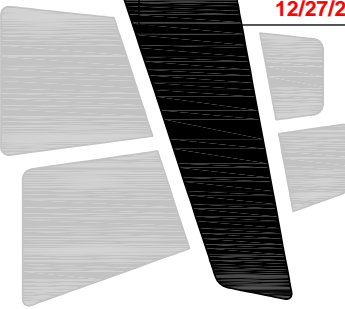

CURRAN
ARCHITECTURE

5719 LAWTON LOOP E. DR. #212
INDIANAPOLIS, IN 46216
O :: 317 . 288 . 0681
F :: 317 . 288 . 0753



SCANNELL
PROPERTIES


wallace



Wallace Engineering
Structural Consultants, Inc.

Structural and Civil Consultants
1741 McGee Street
Kansas City, Missouri 64108
816.421.8282, Fax 816.421.8338

CERTIFICATION

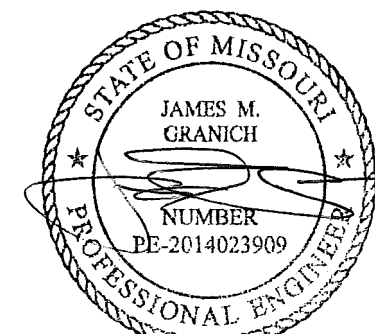

12/13/2022
Missouri COA #001268

THIS DRAWING AND THE IDEAS, DESIGNS
AND CONCEPTS CONTAINED HEREIN ARE
THE EXCLUSIVE INTELLECTUAL PROPERTY
OF CURRAN ARCHITECTURE, AND ARE NOT
TO BE USED OR REPRODUCED, WHOLE OR
IN PART, WITHOUT THE WRITTEN
CONSENT OF CURRAN ARCHITECTURE.
© COPYRIGHT 2021, CURRAN ARCHITECTURE

PROJECT INFORMATION

**LEE'S SUMMIT LOGISTICS
BUILDING A LOT I**

NW CORNER TUDOR RD & MAINST
LEE'S SUMMIT, MO


ISSUE DATES

ISSUE	DATE
ISSUE FOR PERMIT	02.18.2022
ISSUE FOR PERMIT	04.15.2022


210300

S4.1


FRAMING DETAILS

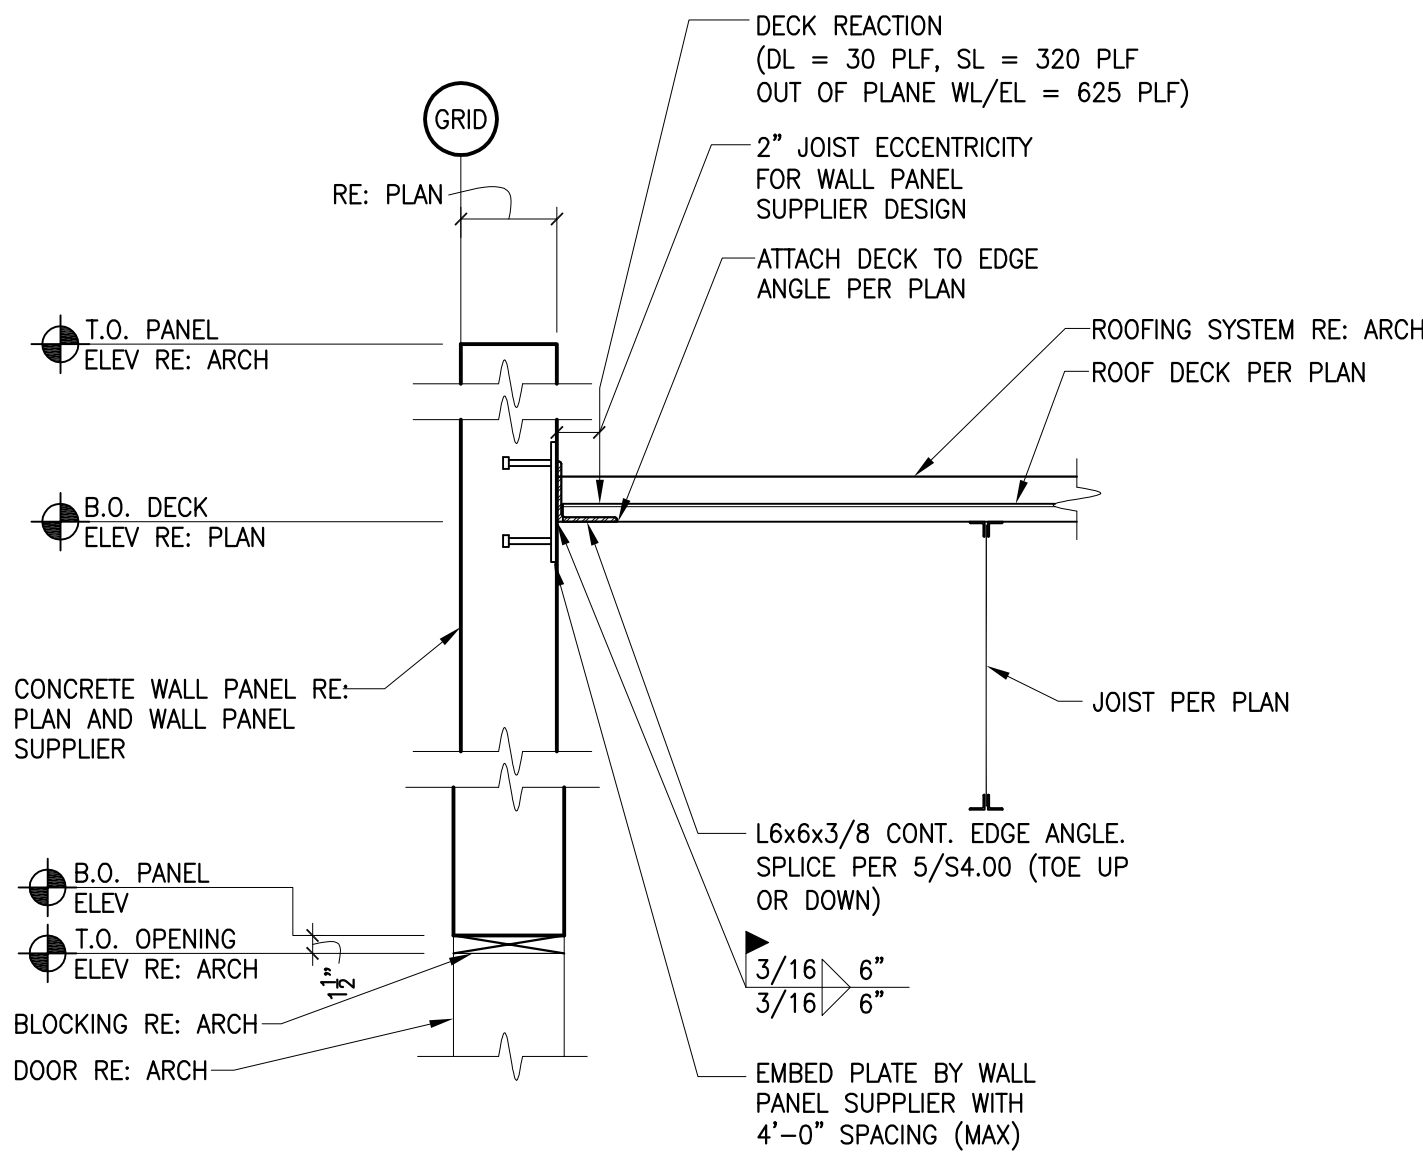


8 FRAMING DETAIL AT OPENING
3/4" = 1'-0"

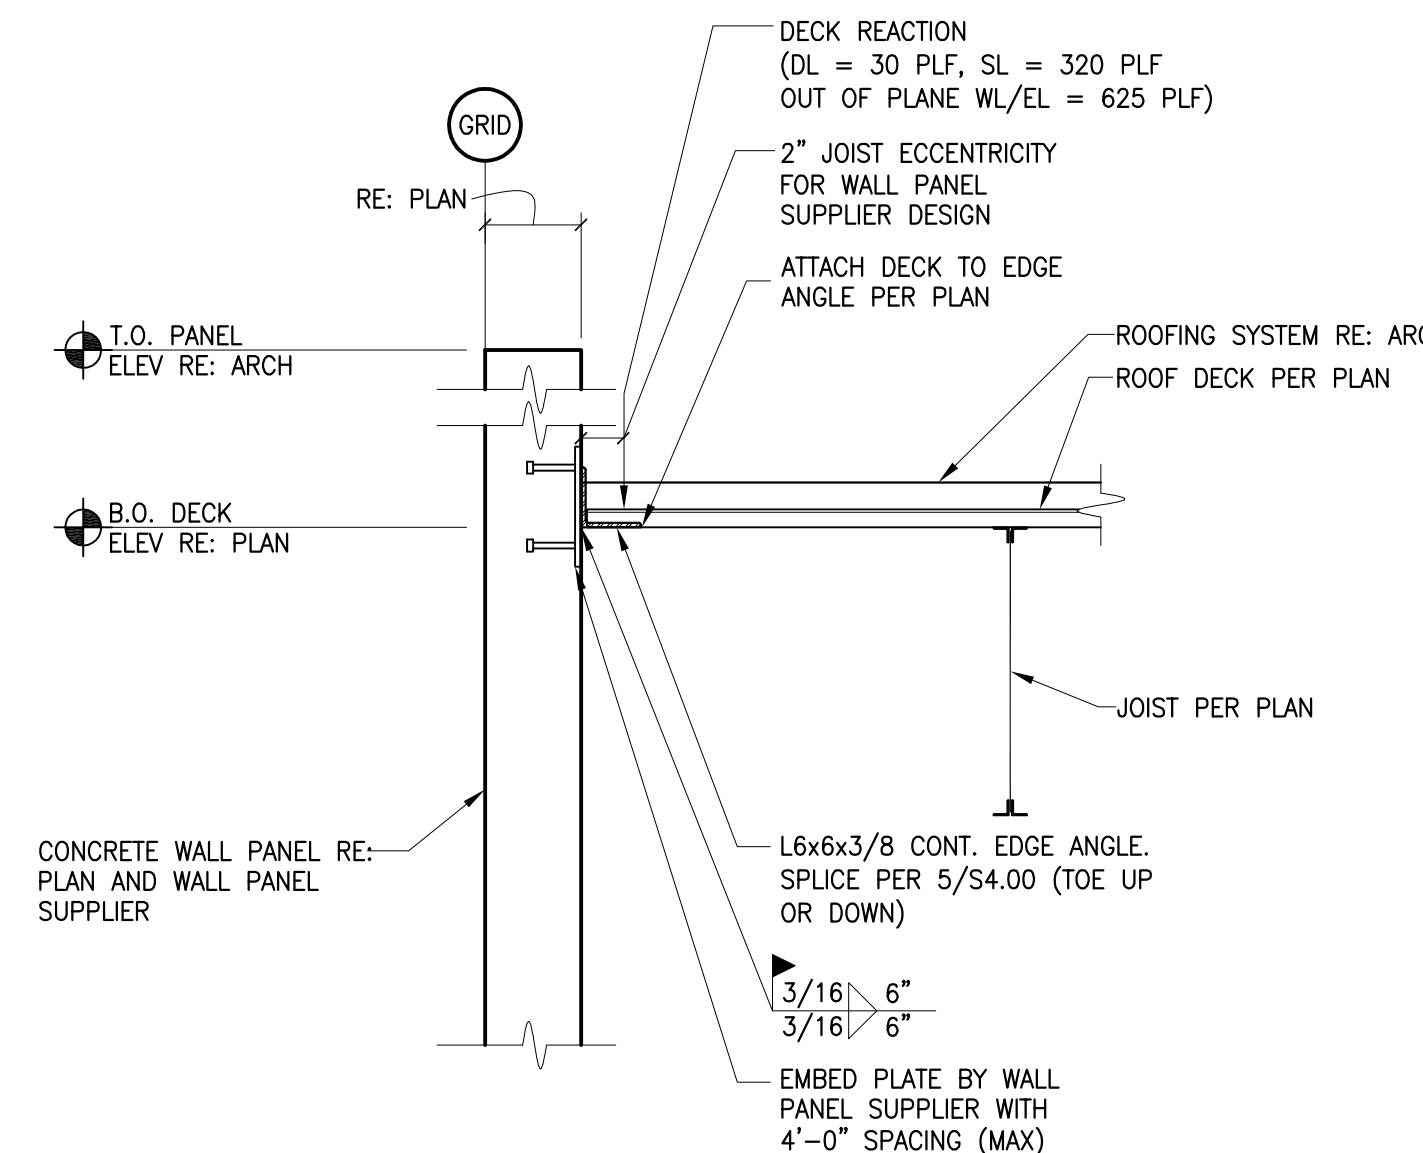

7 FRAMING DETAIL
3/4" = 1'-0"

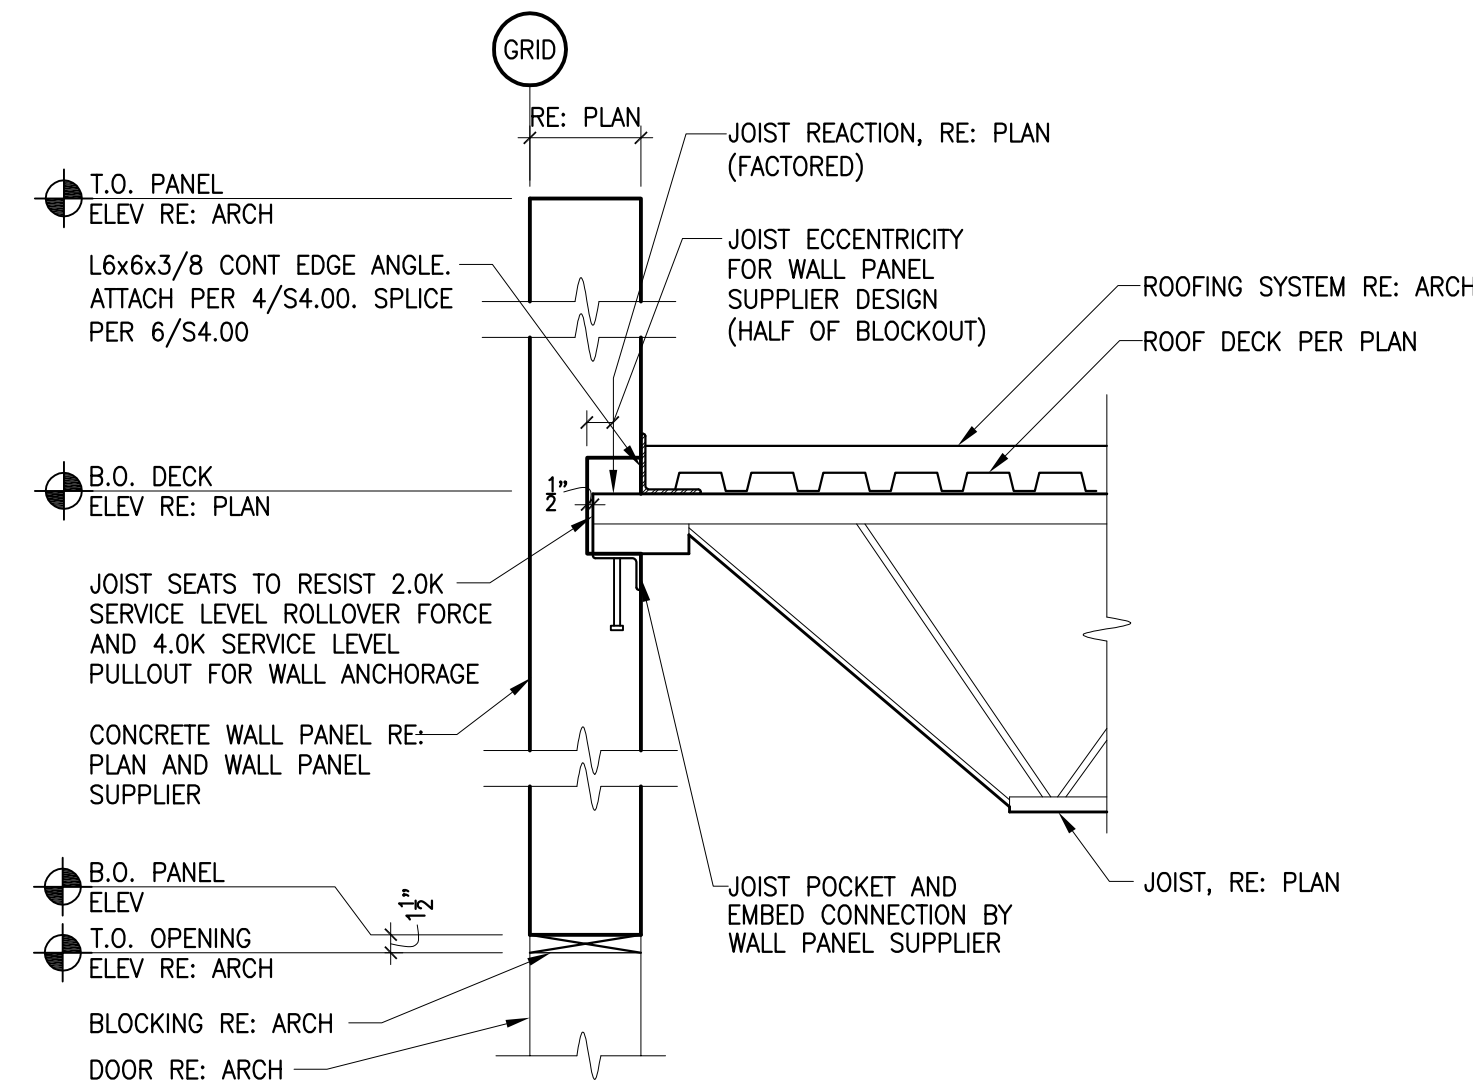


OPTION #2

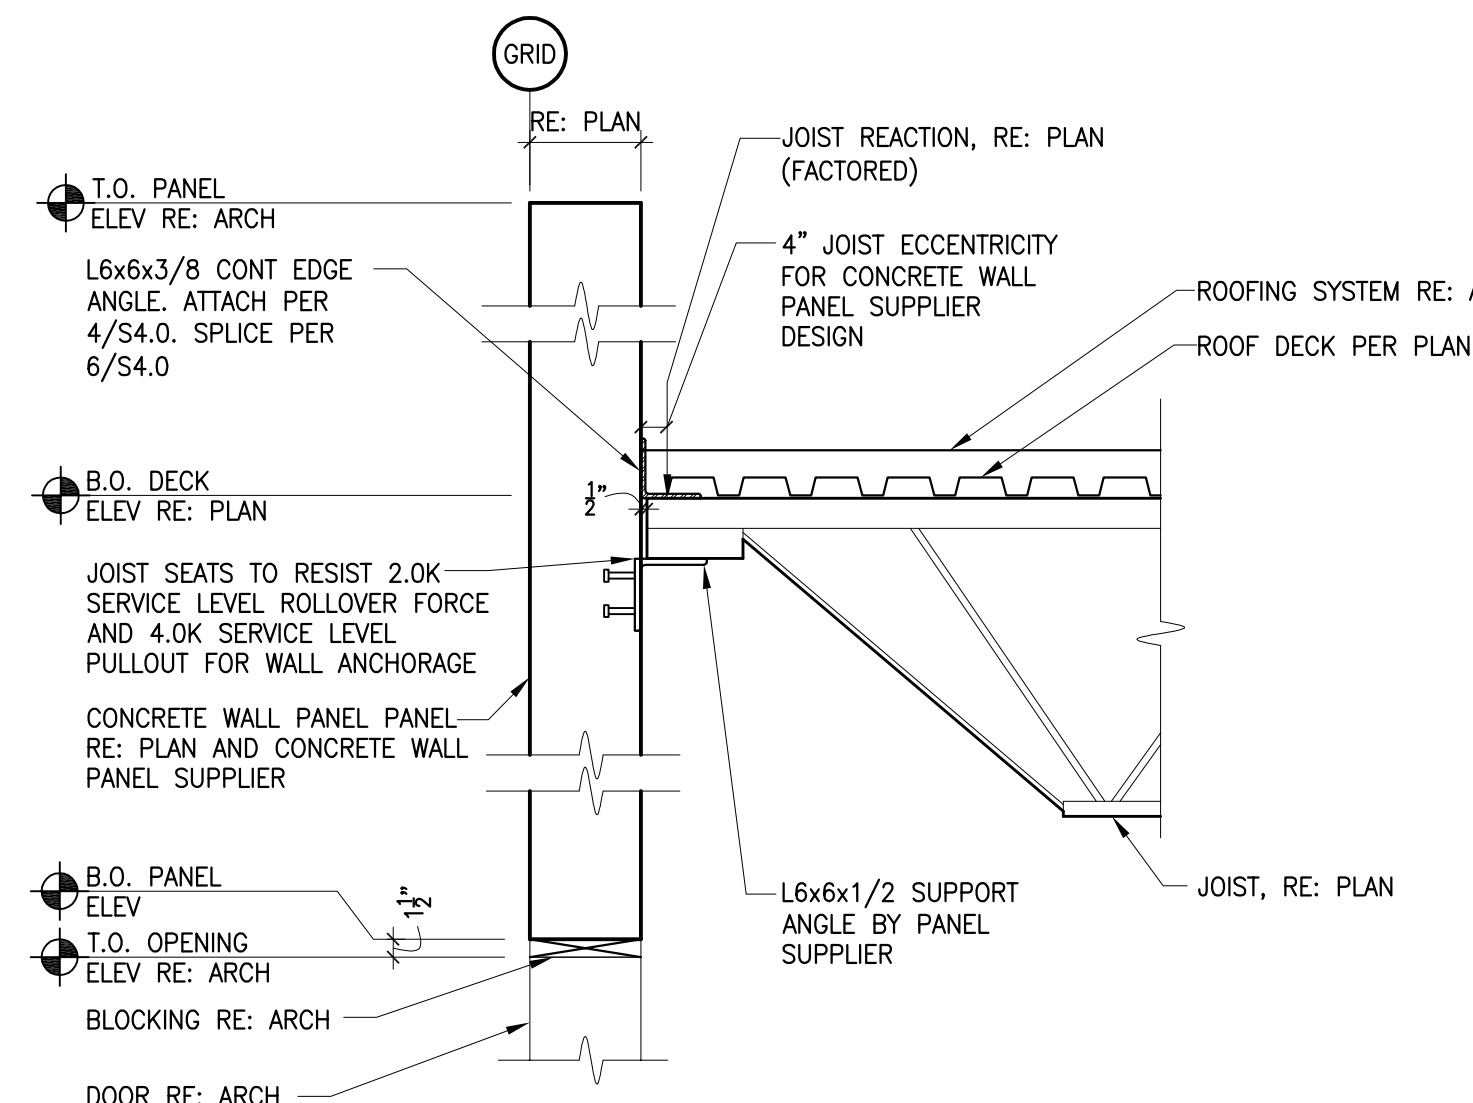


OPTION #1

6 FRAMING DETAIL
3/4" = 1'-0"

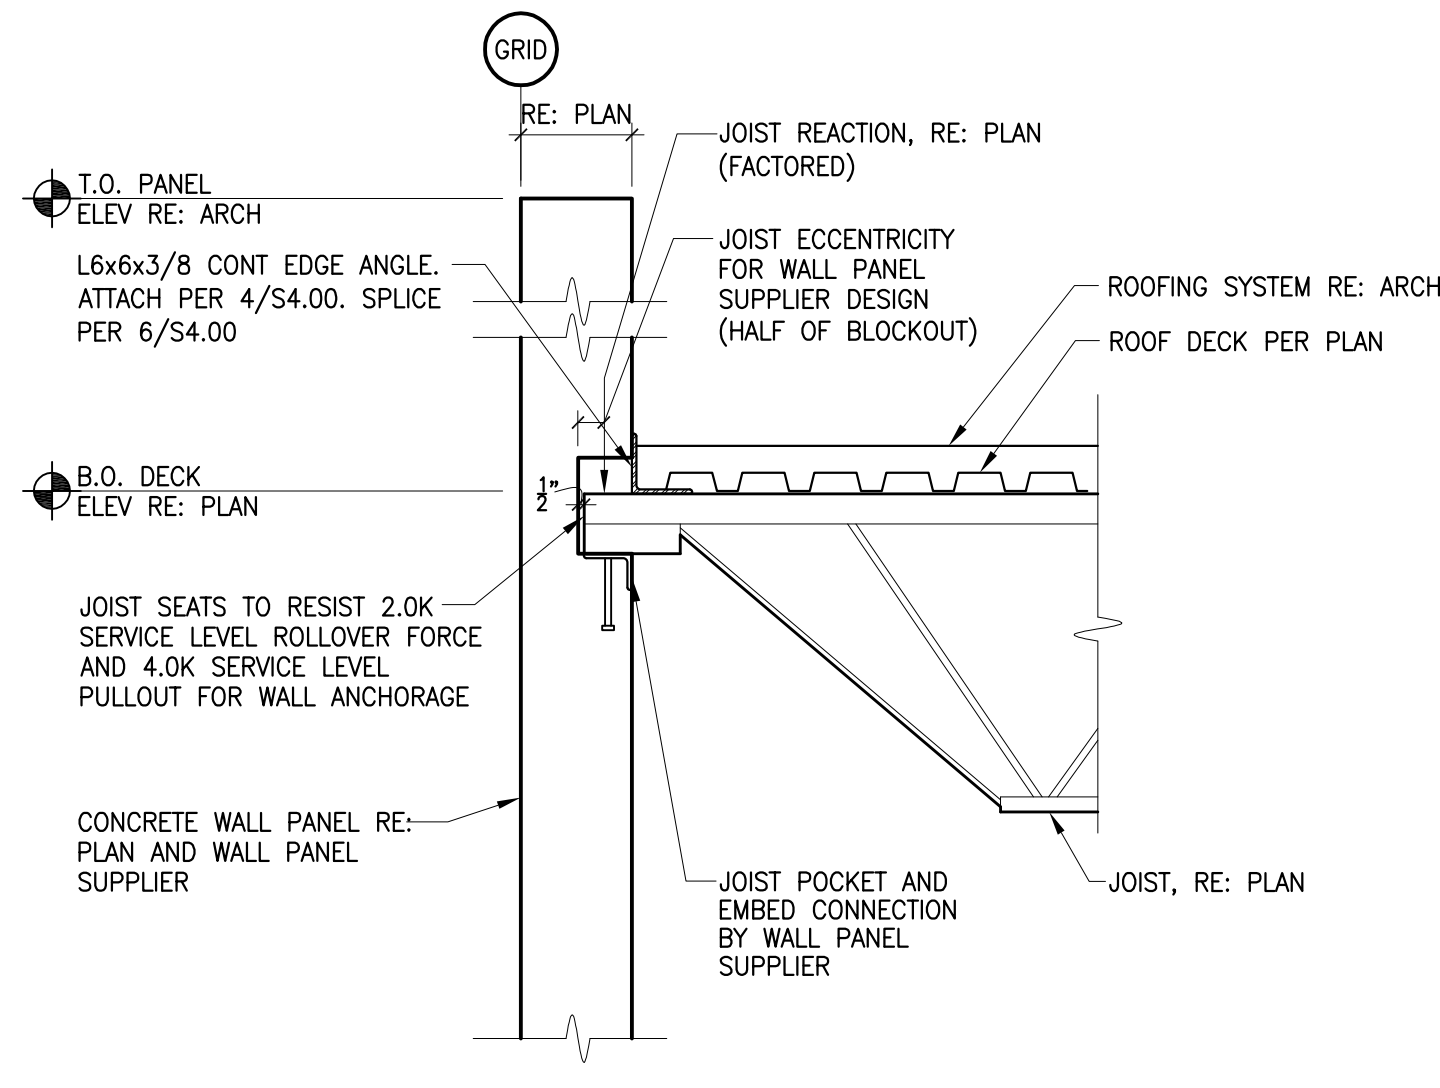


OPTION #2

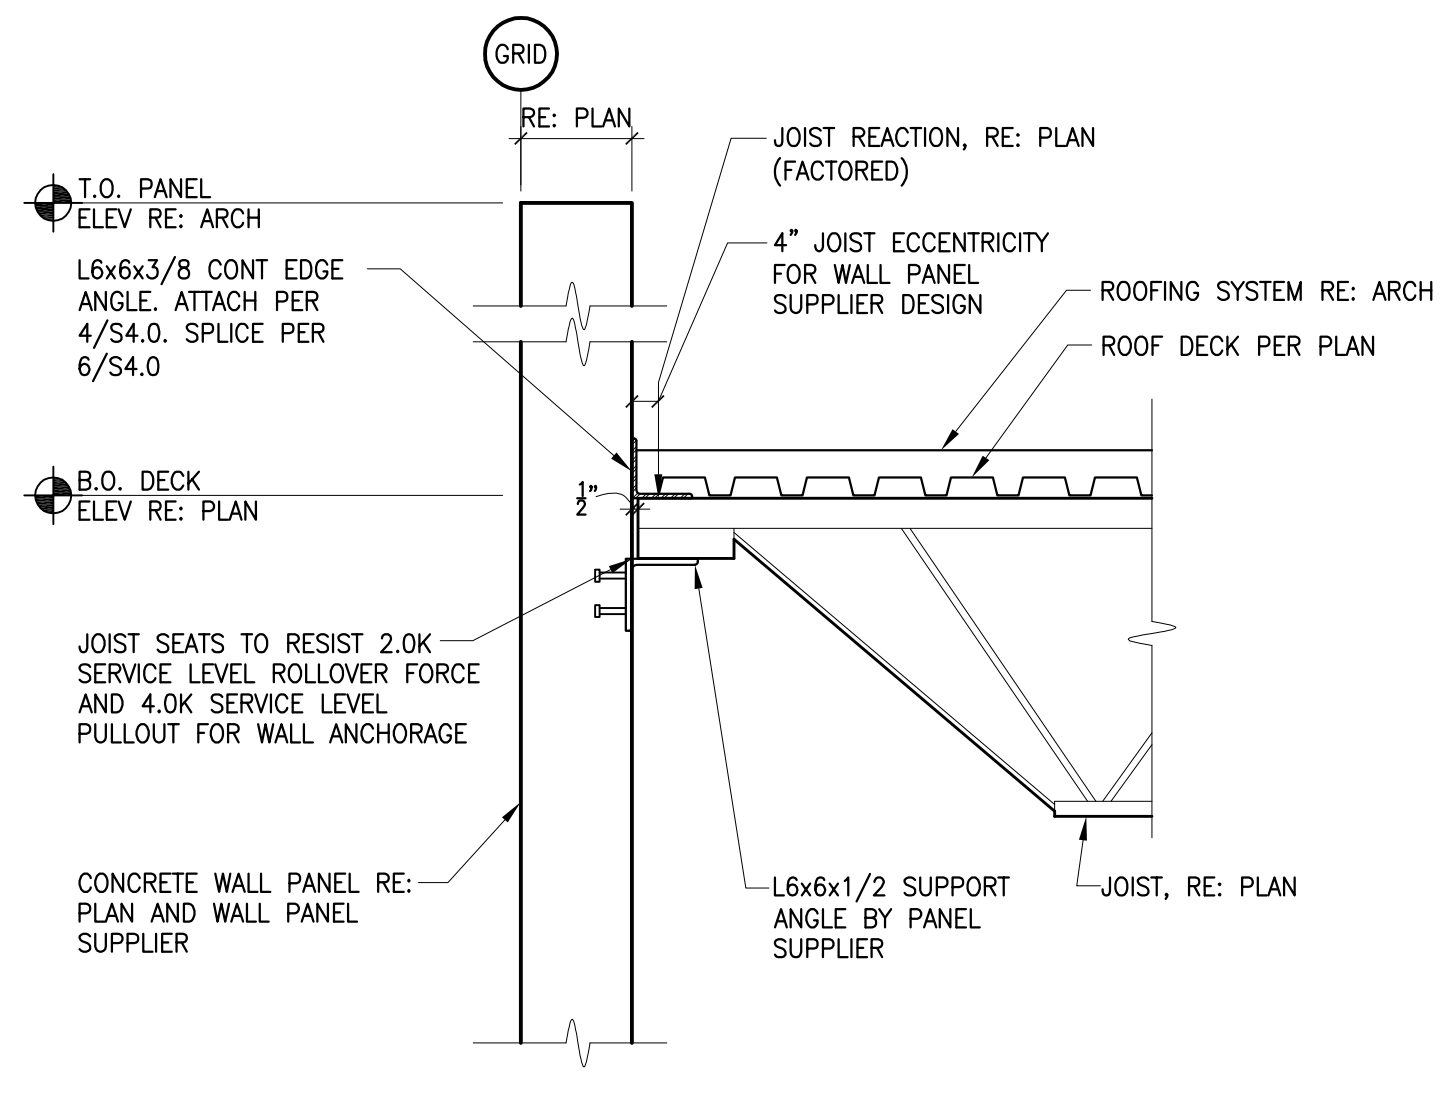


OPTION #1



5 FRAMING DETAIL
3/4" = 1'-0"

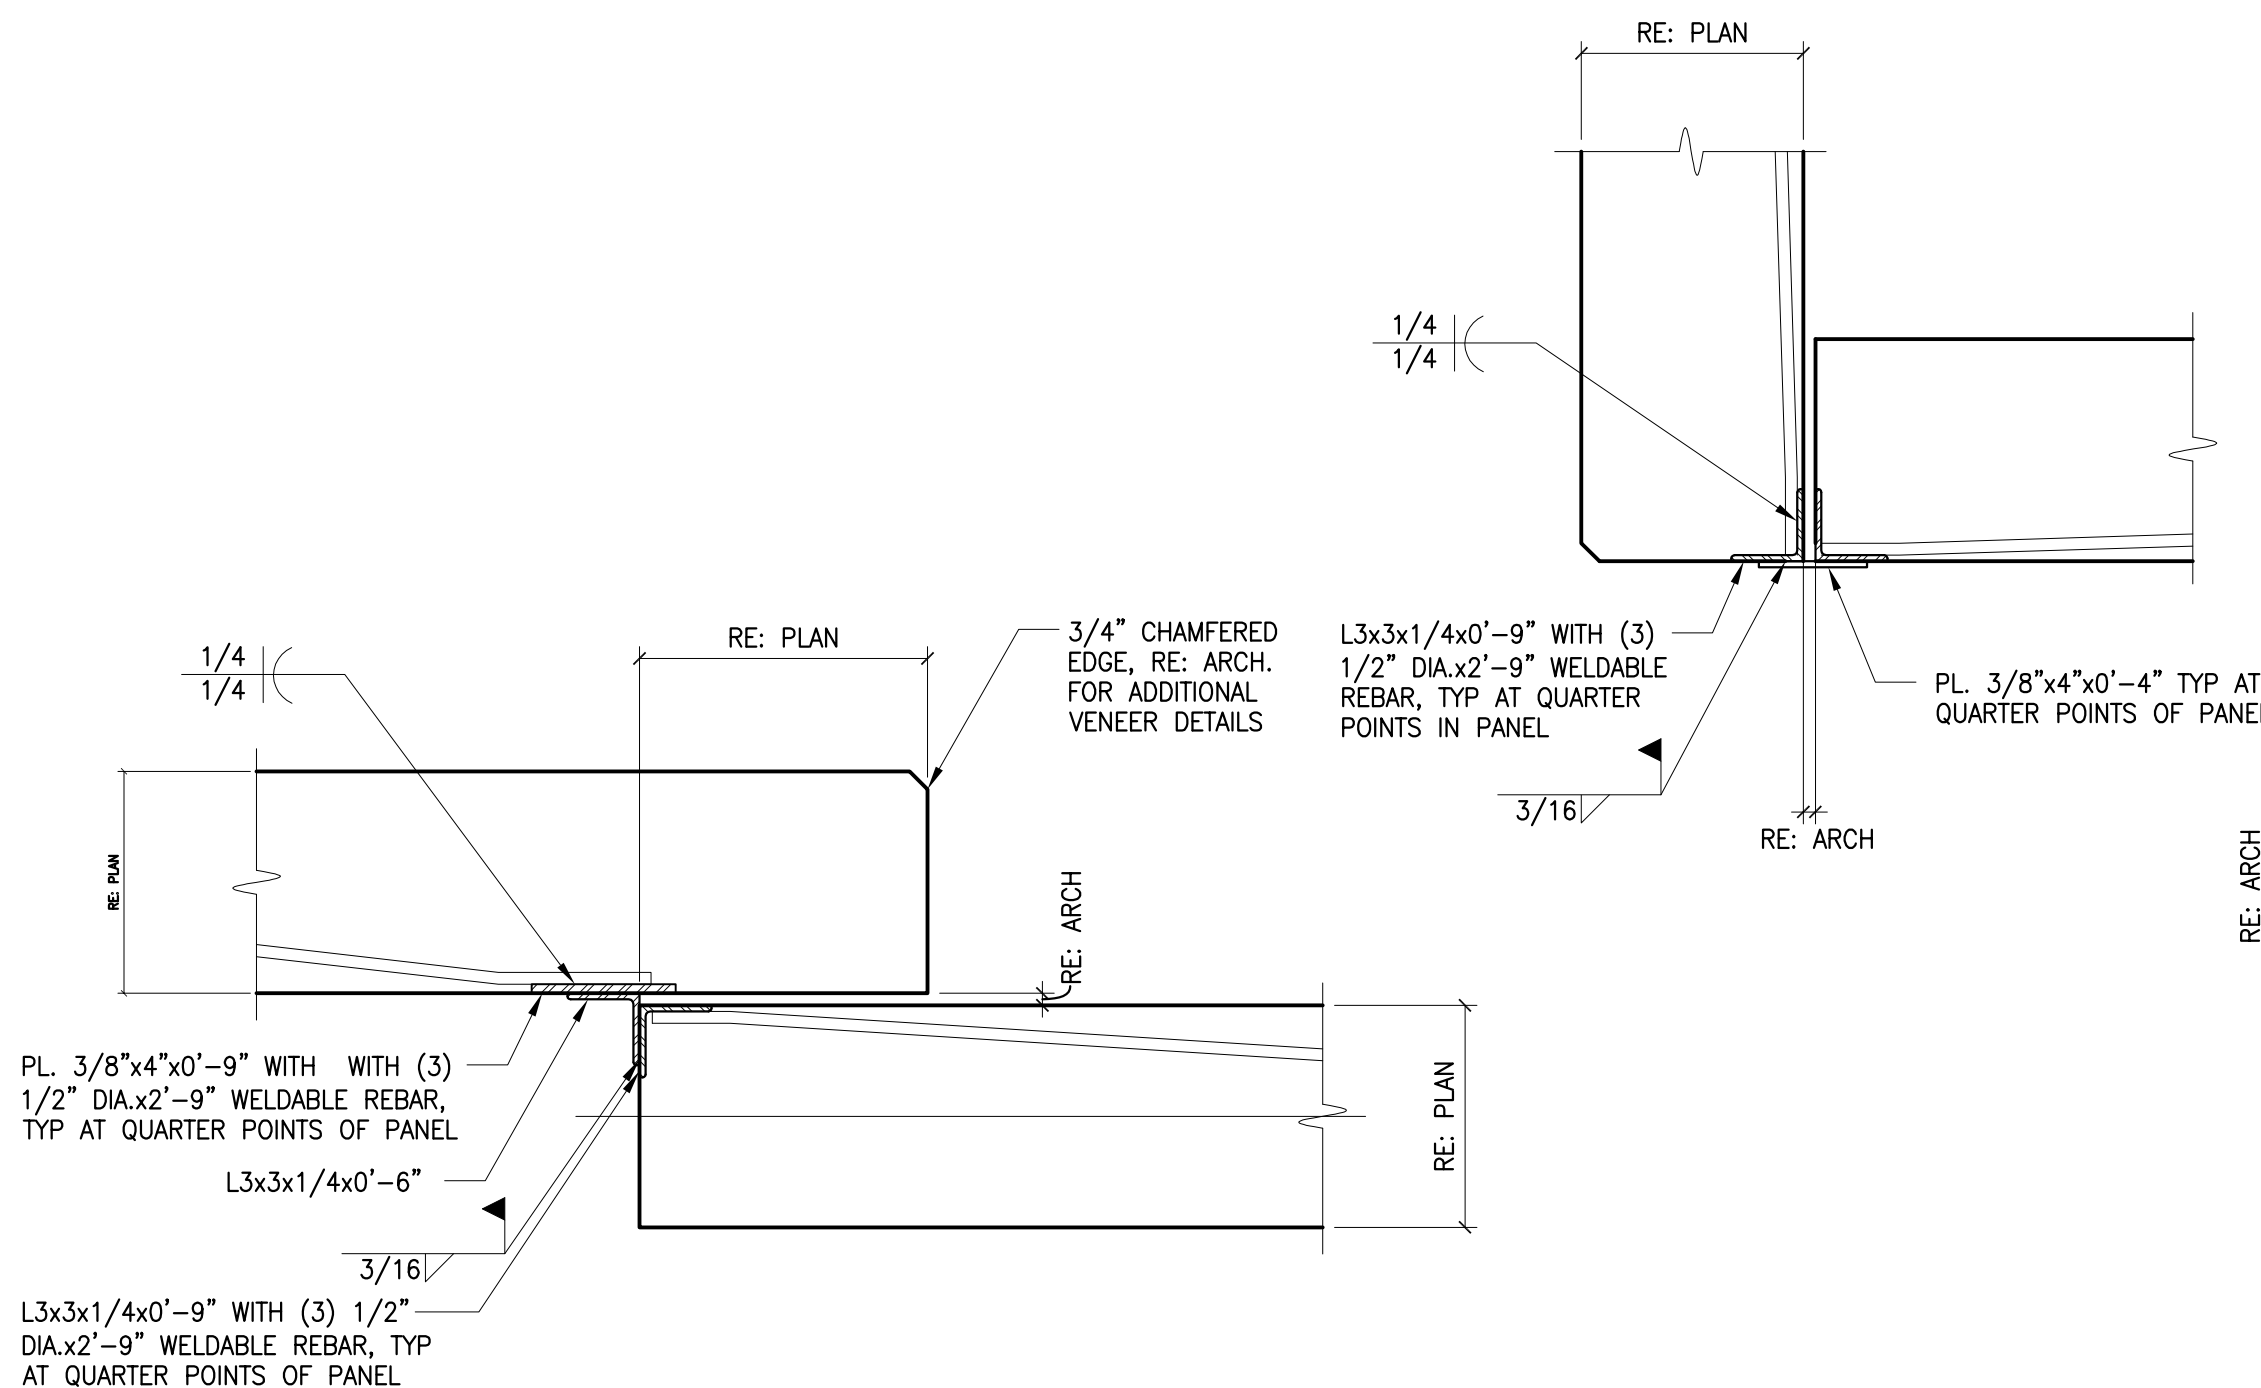


4 TYPICAL PANEL TO PANEL CONNECTION DETAILS
1 1/2" = 1'-0"

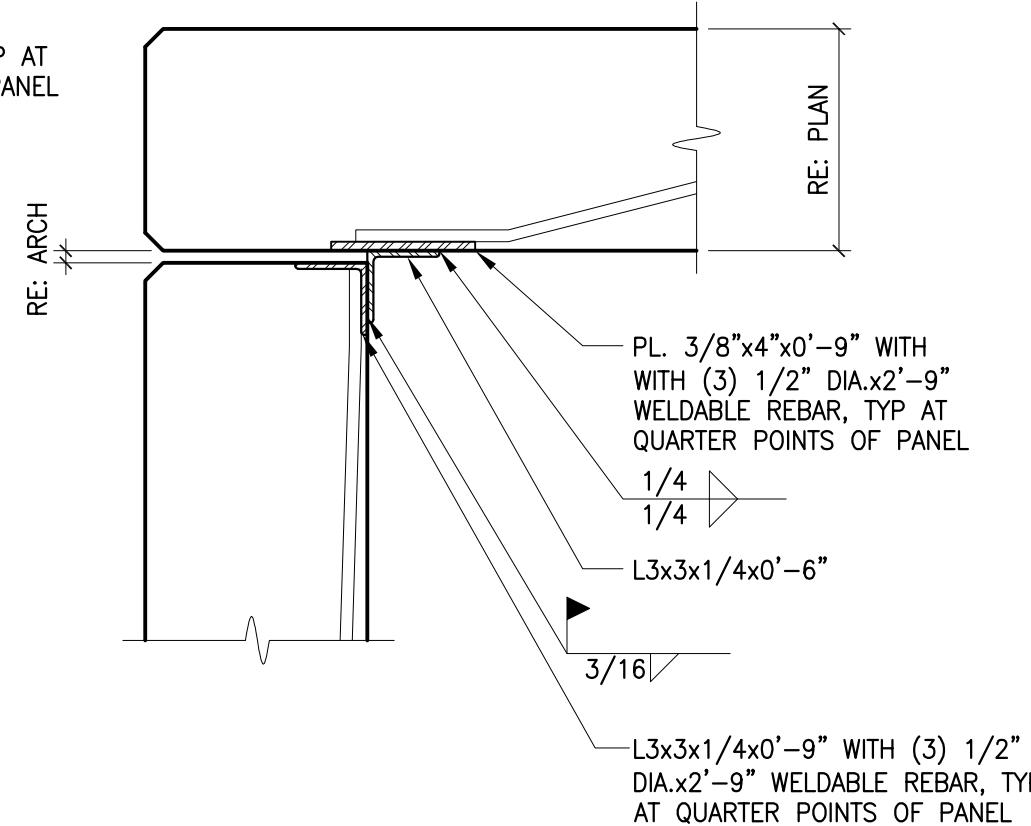

3 DECK CORNER DETAIL
3/4" = 1'-0"

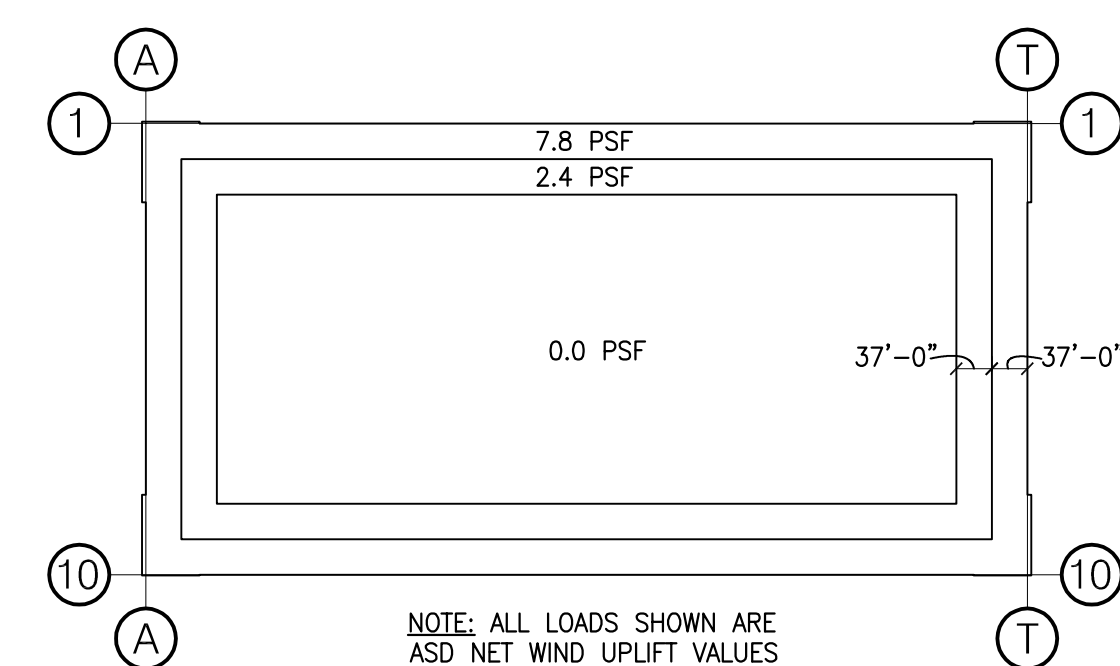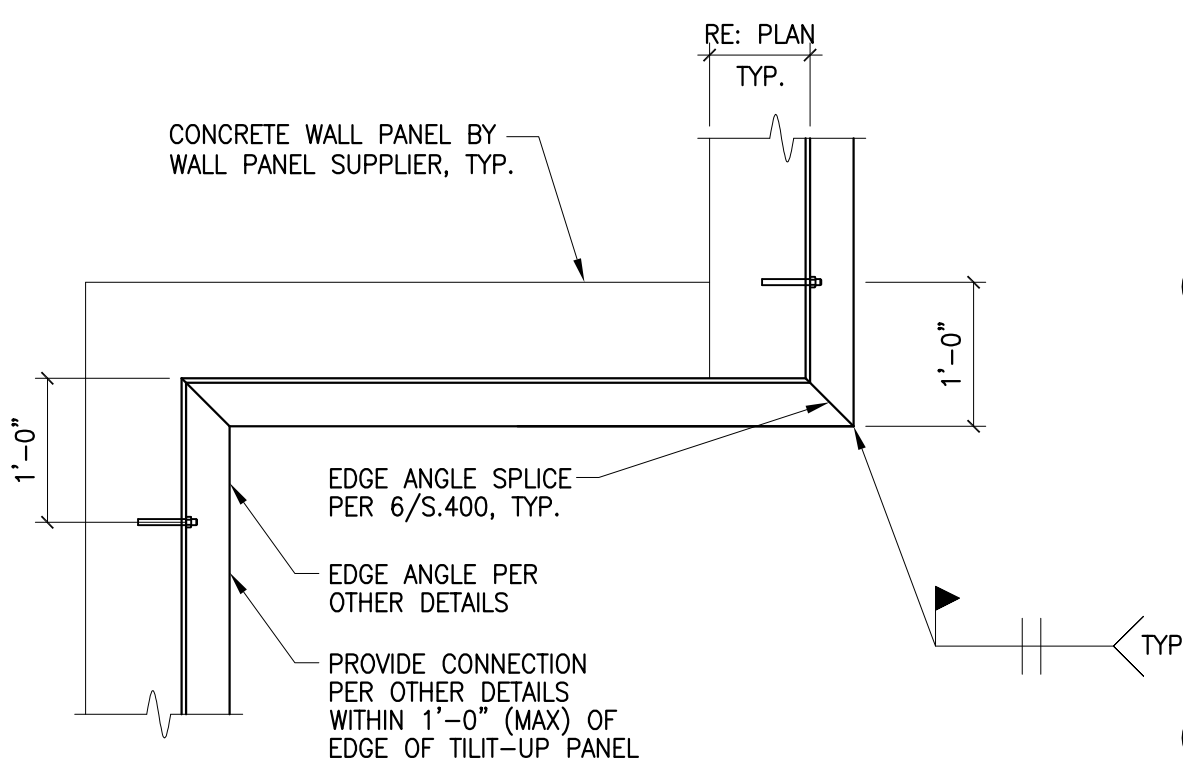

2 GIRDER NET WIND UPLIFT DIAGRAM
NO SCALE

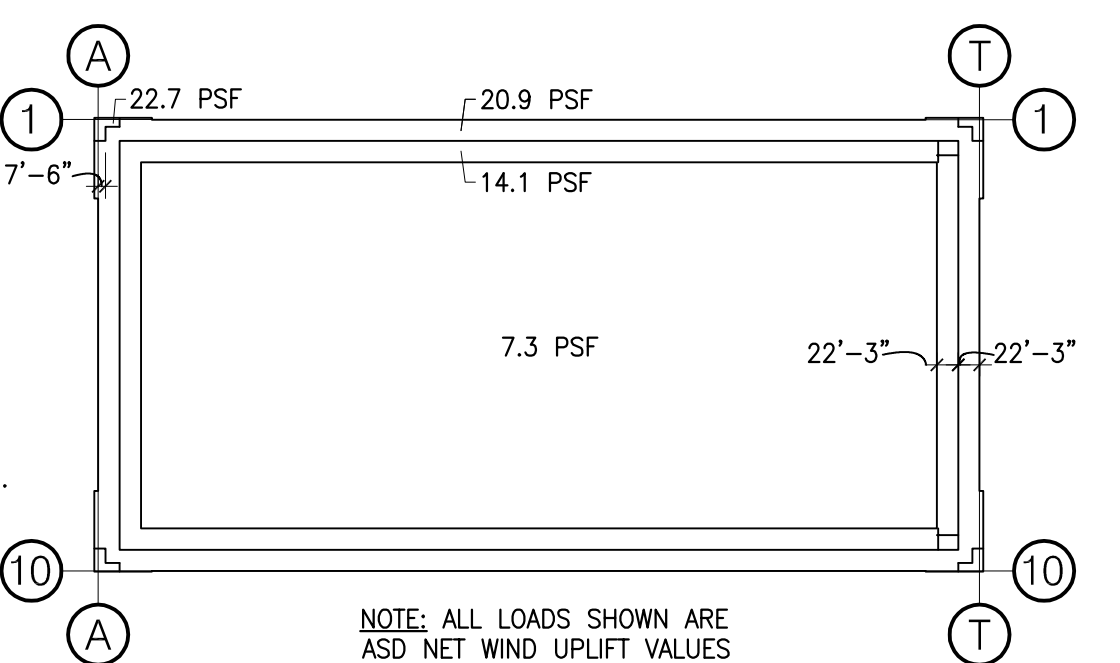

1 JOIST NET WIND UPLIFT DIAGRAM
NO SCALE

CURRAN
ARCHITECTURE

5719 LAWTON LOOP E. DR. #212
INDIANAPOLIS, IN 46216
O :: 317 . 288 . 0681
F :: 317 . 288 . 0753

SCANNELL
PROPERTIES

wallace

Wallace Engineering
Structural Consultants, Inc.
Structural and Civil Consultants
1741 McGee Street
Kansas City, Missouri 64108
816.421.8282, Fax 816.421.8338

CERTIFICATION

12/13/2022
Missouri COA #001268

THIS DRAWING AND THE IDEAS, DESIGNS
AND CONCEPTS CONTAINED HEREIN ARE
THE EXCLUSIVE INTELLECTUAL PROPERTY
OF CURRAN ARCHITECTURE, AND ARE NOT
TO BE USED OR REPRODUCED, WHOLE OR
IN PART, WITHOUT THE WRITTEN
CONSENT OF CURRAN ARCHITECTURE.
© COPYRIGHT 2021, CURRAN ARCHITECTURE

PROJECT INFORMATION





LEE'S SUMMIT LOGISTICS
BUILDING A LOT I


NW CORNER TUDOR RD & MAINST
LEE'S SUMMIT, MO

ISSUE DATES

ISSUE	DATE
ISSUE FOR PERMIT	02.18.2022
ISSUE FOR PERMIT	04.15.2022
210300	


S4.3
FRAMING DETAILS

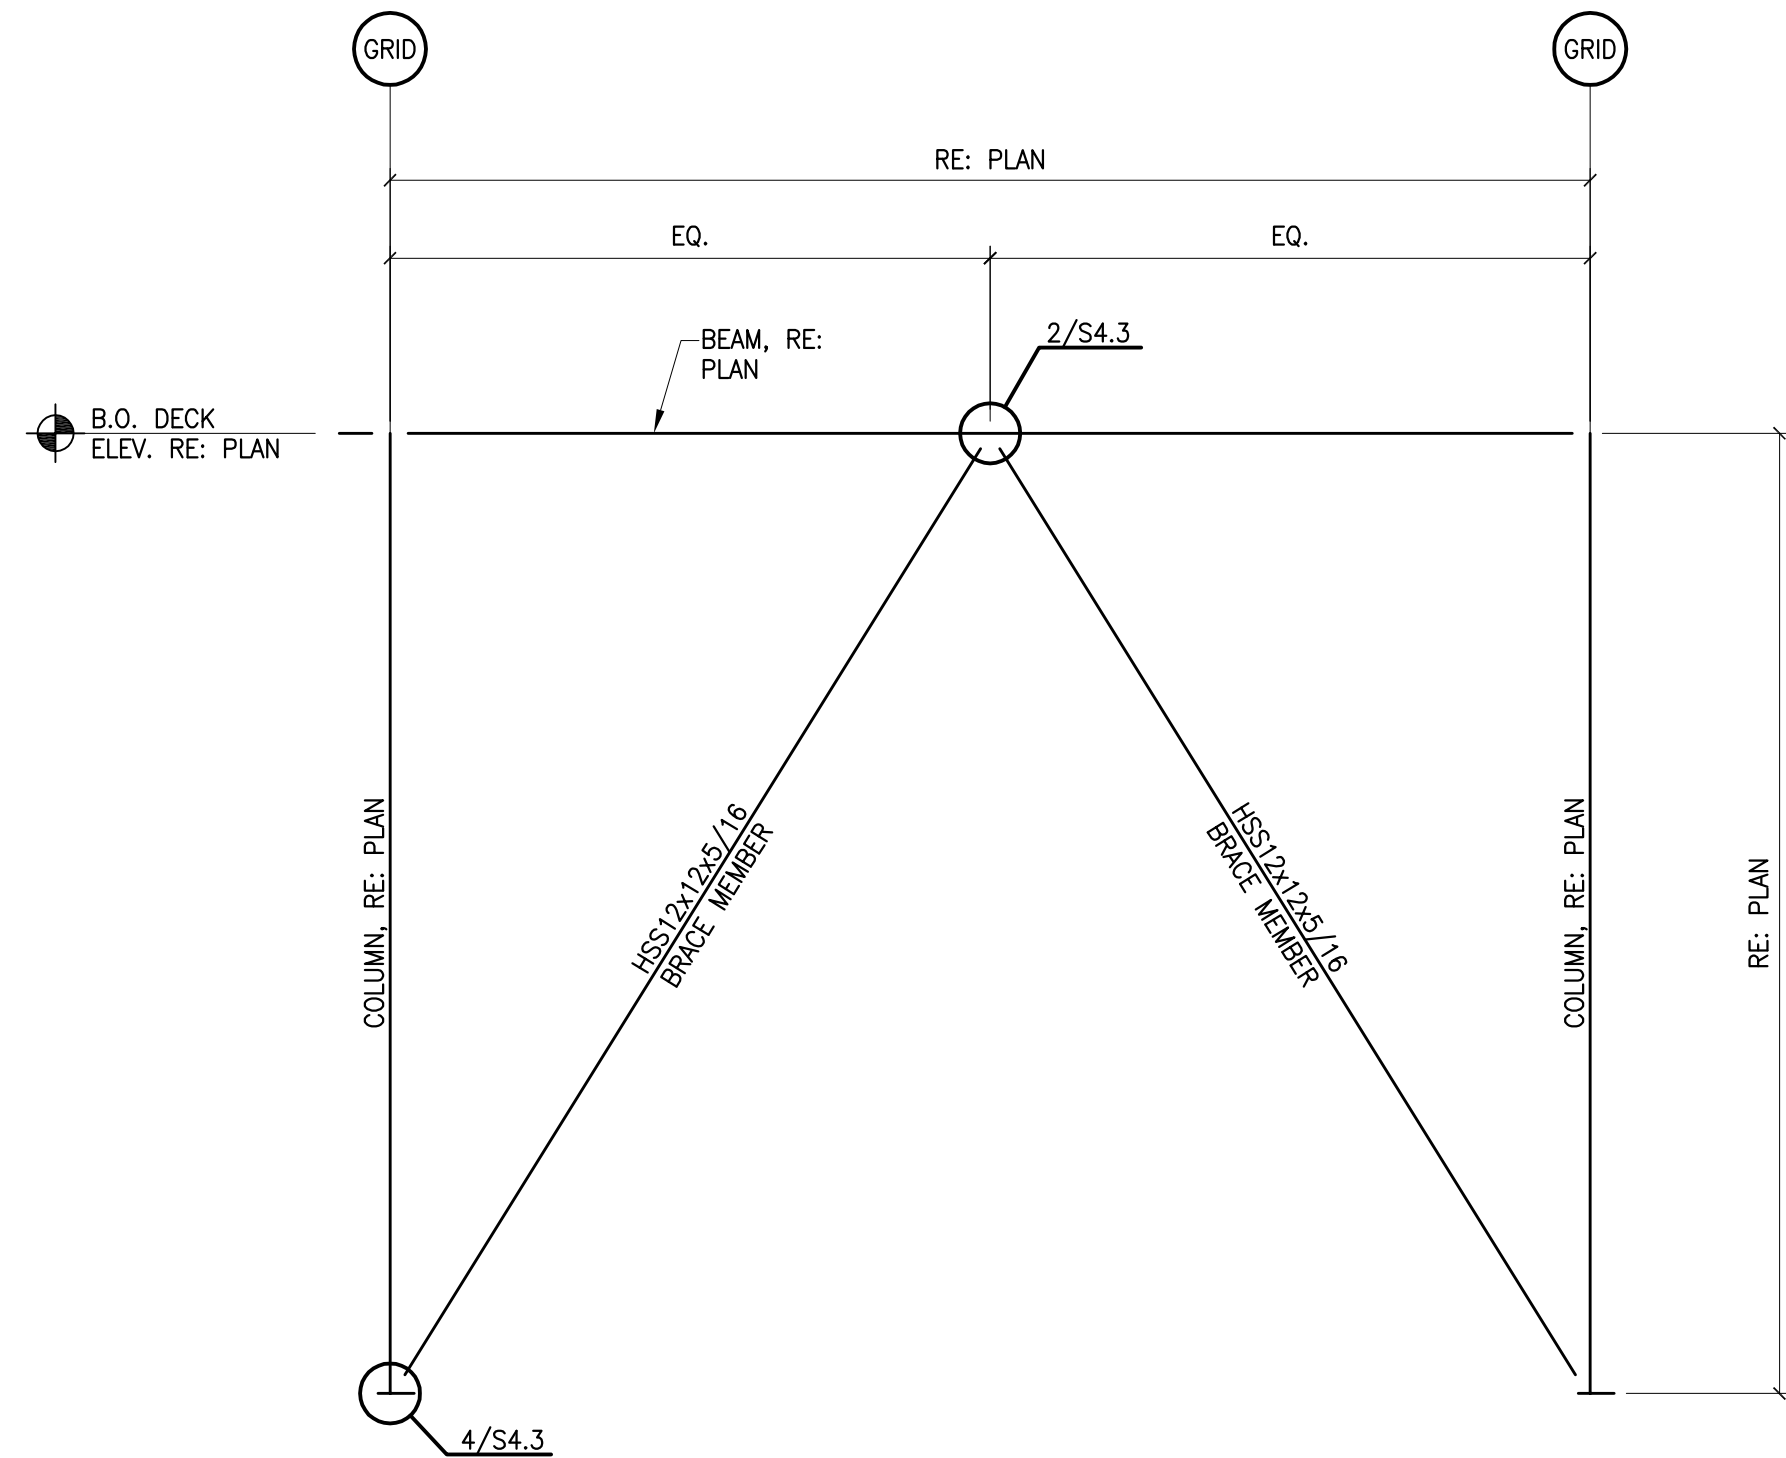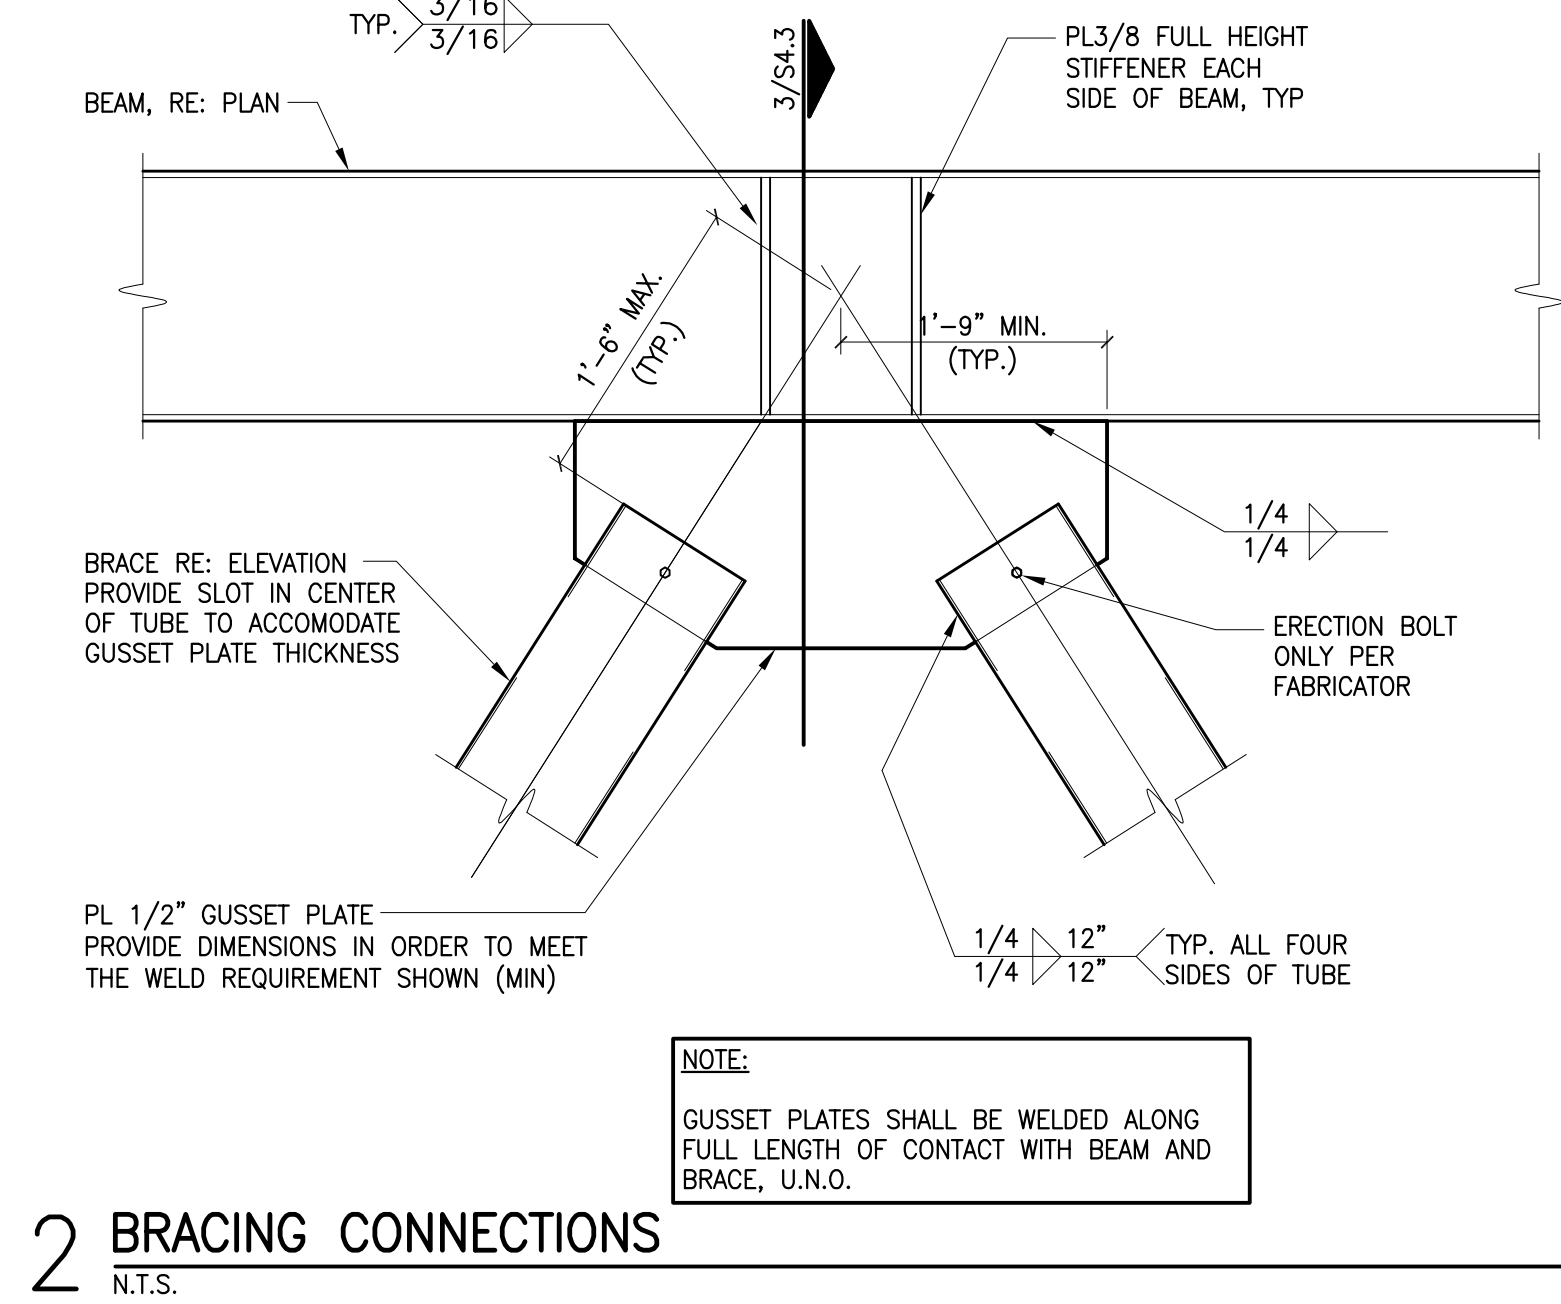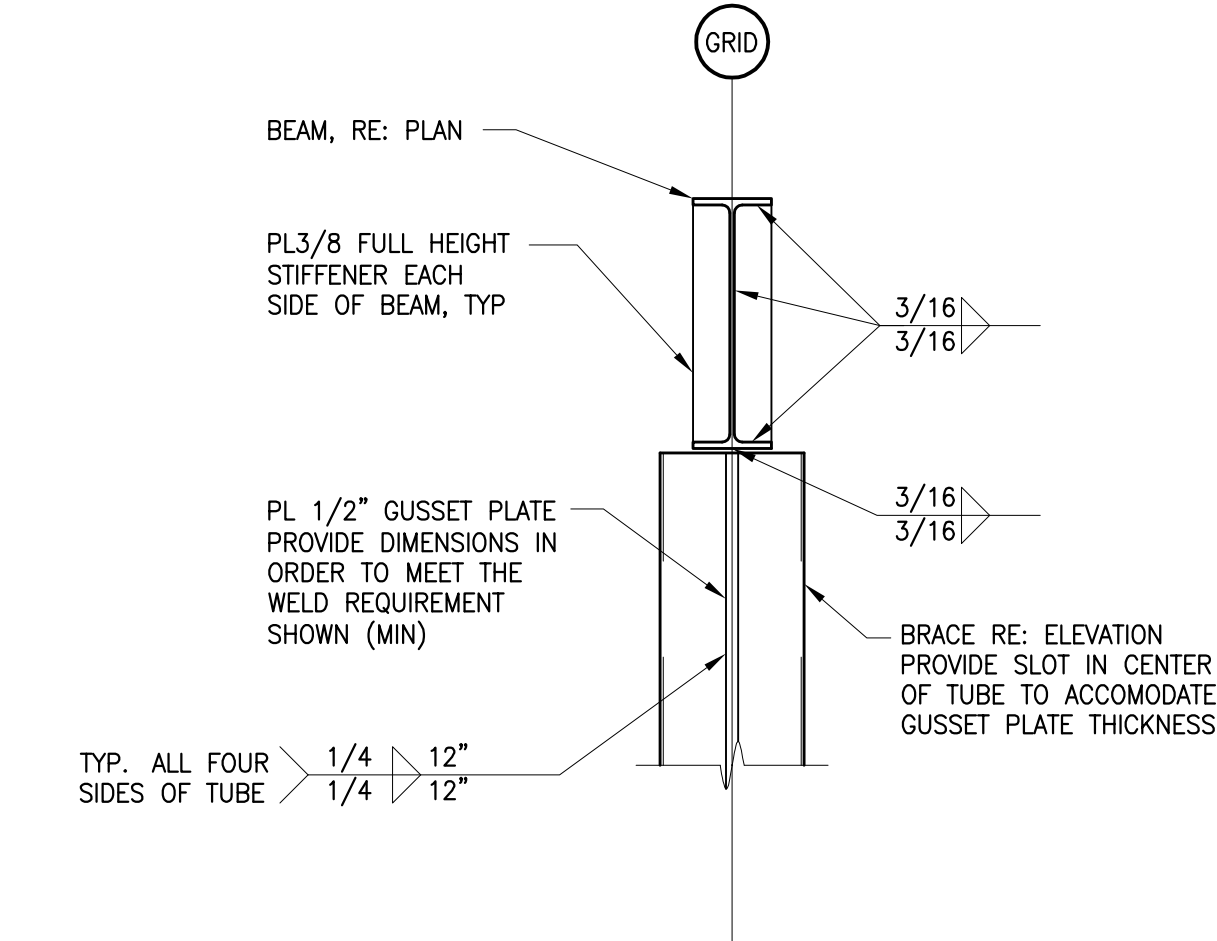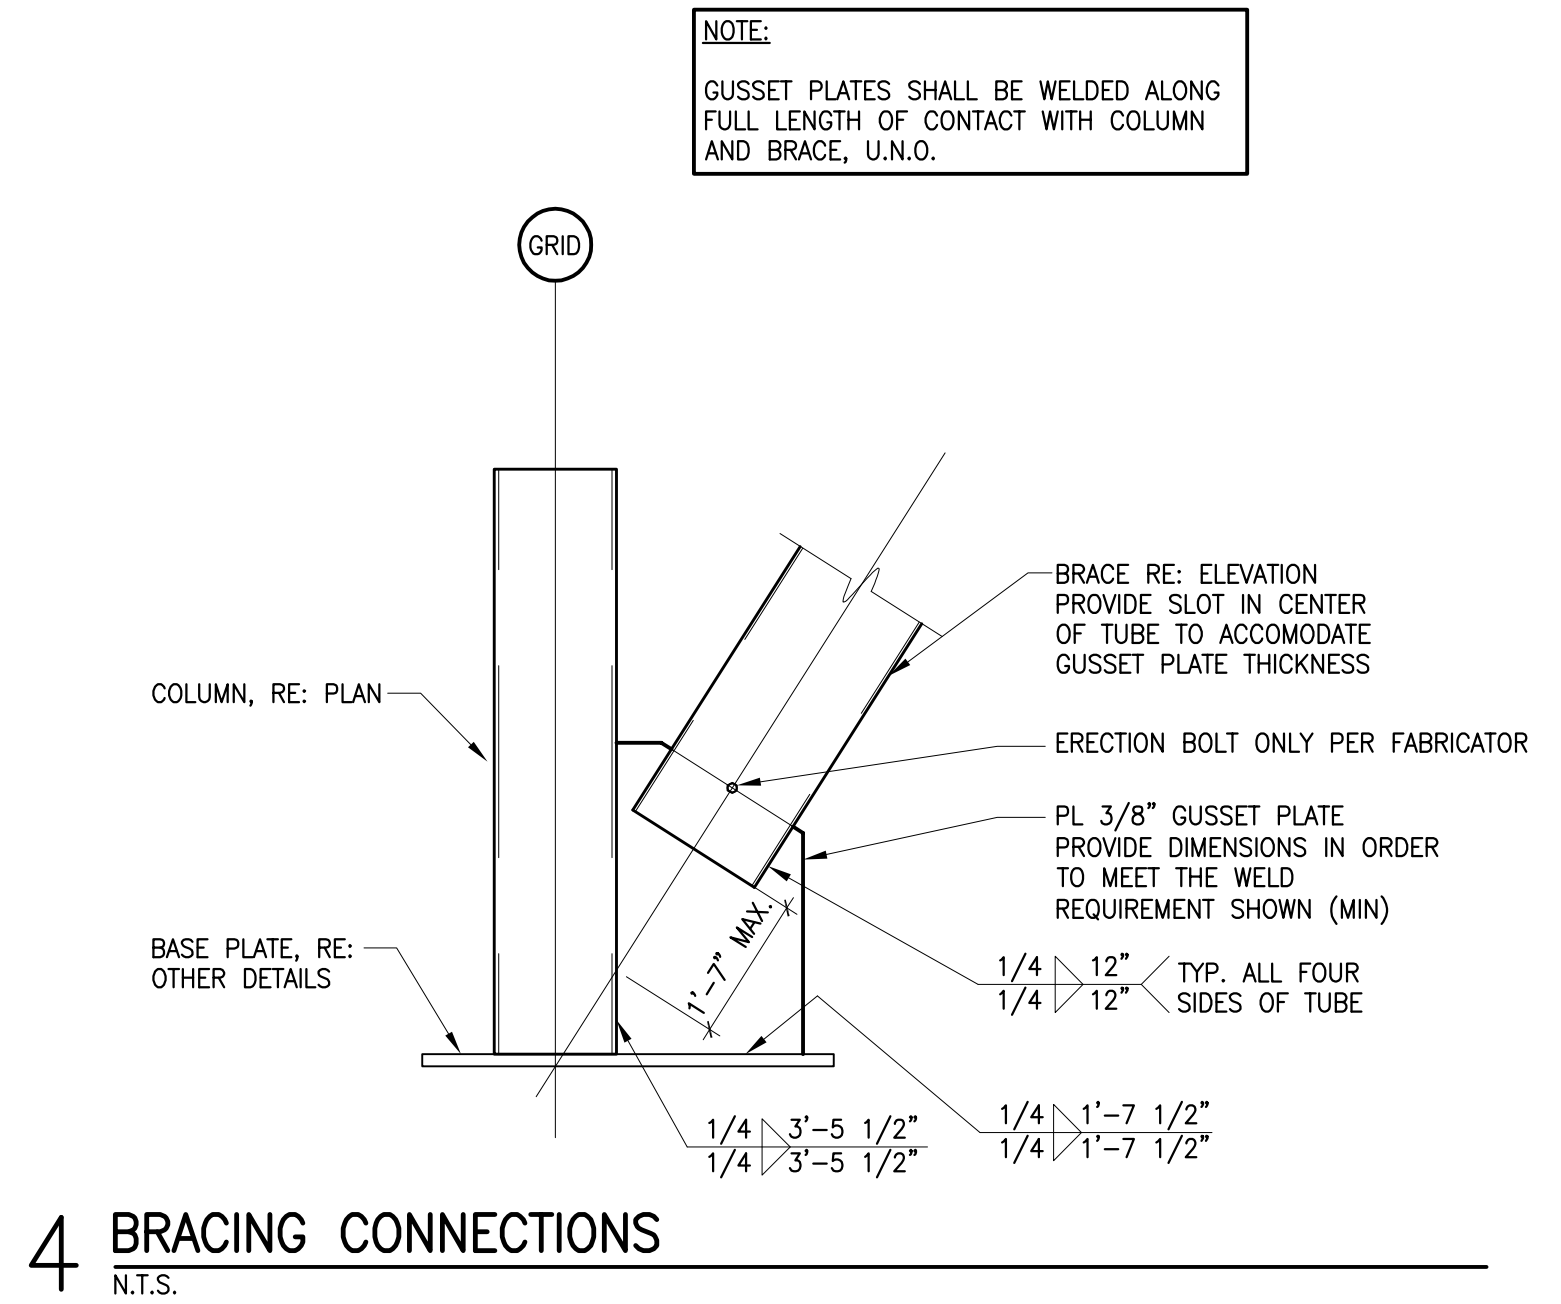

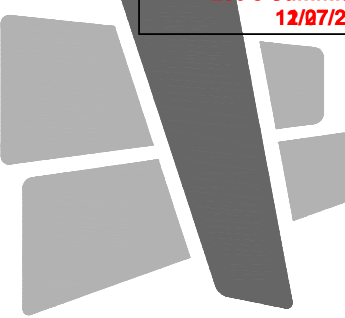

CURRAN
ARCHITECTURE

5719 LAWTON LOOP E. DR. #212
INDIANAPOLIS, IN 46216
O :: 317 . 288 . 0681
F :: 317 . 288 . 0753

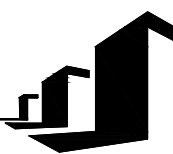

SCANNELL
PROPERTIES

CERTIFICATION

THIS DRAWING AND THE IDEAS, DESIGNS
AND CONCEPTS CONTAINED HEREIN ARE
THE EXCLUSIVE INTELLECTUAL PROPERTY
OF CURRAN ARCHITECTURE, AND ARE NOT
TO BE USED OR REPRODUCED, WHOLE OR
IN PART, WITHOUT THE WRITTEN
CONSENT OF CURRAN ARCHITECTURE.
© COPYRIGHT 2021, CURRAN ARCHITECTURE

PROJECT INFORMATION

LEE'S SUMMIT LOGISTICS
BUILDING A LOT I

NW CORNER OF
NE TUDOR RD & MAIN ST
LEE'S SUMMIT, MO 64086




ISSUE DATES

PERMIT SET 04.21.22

210300

M1.1

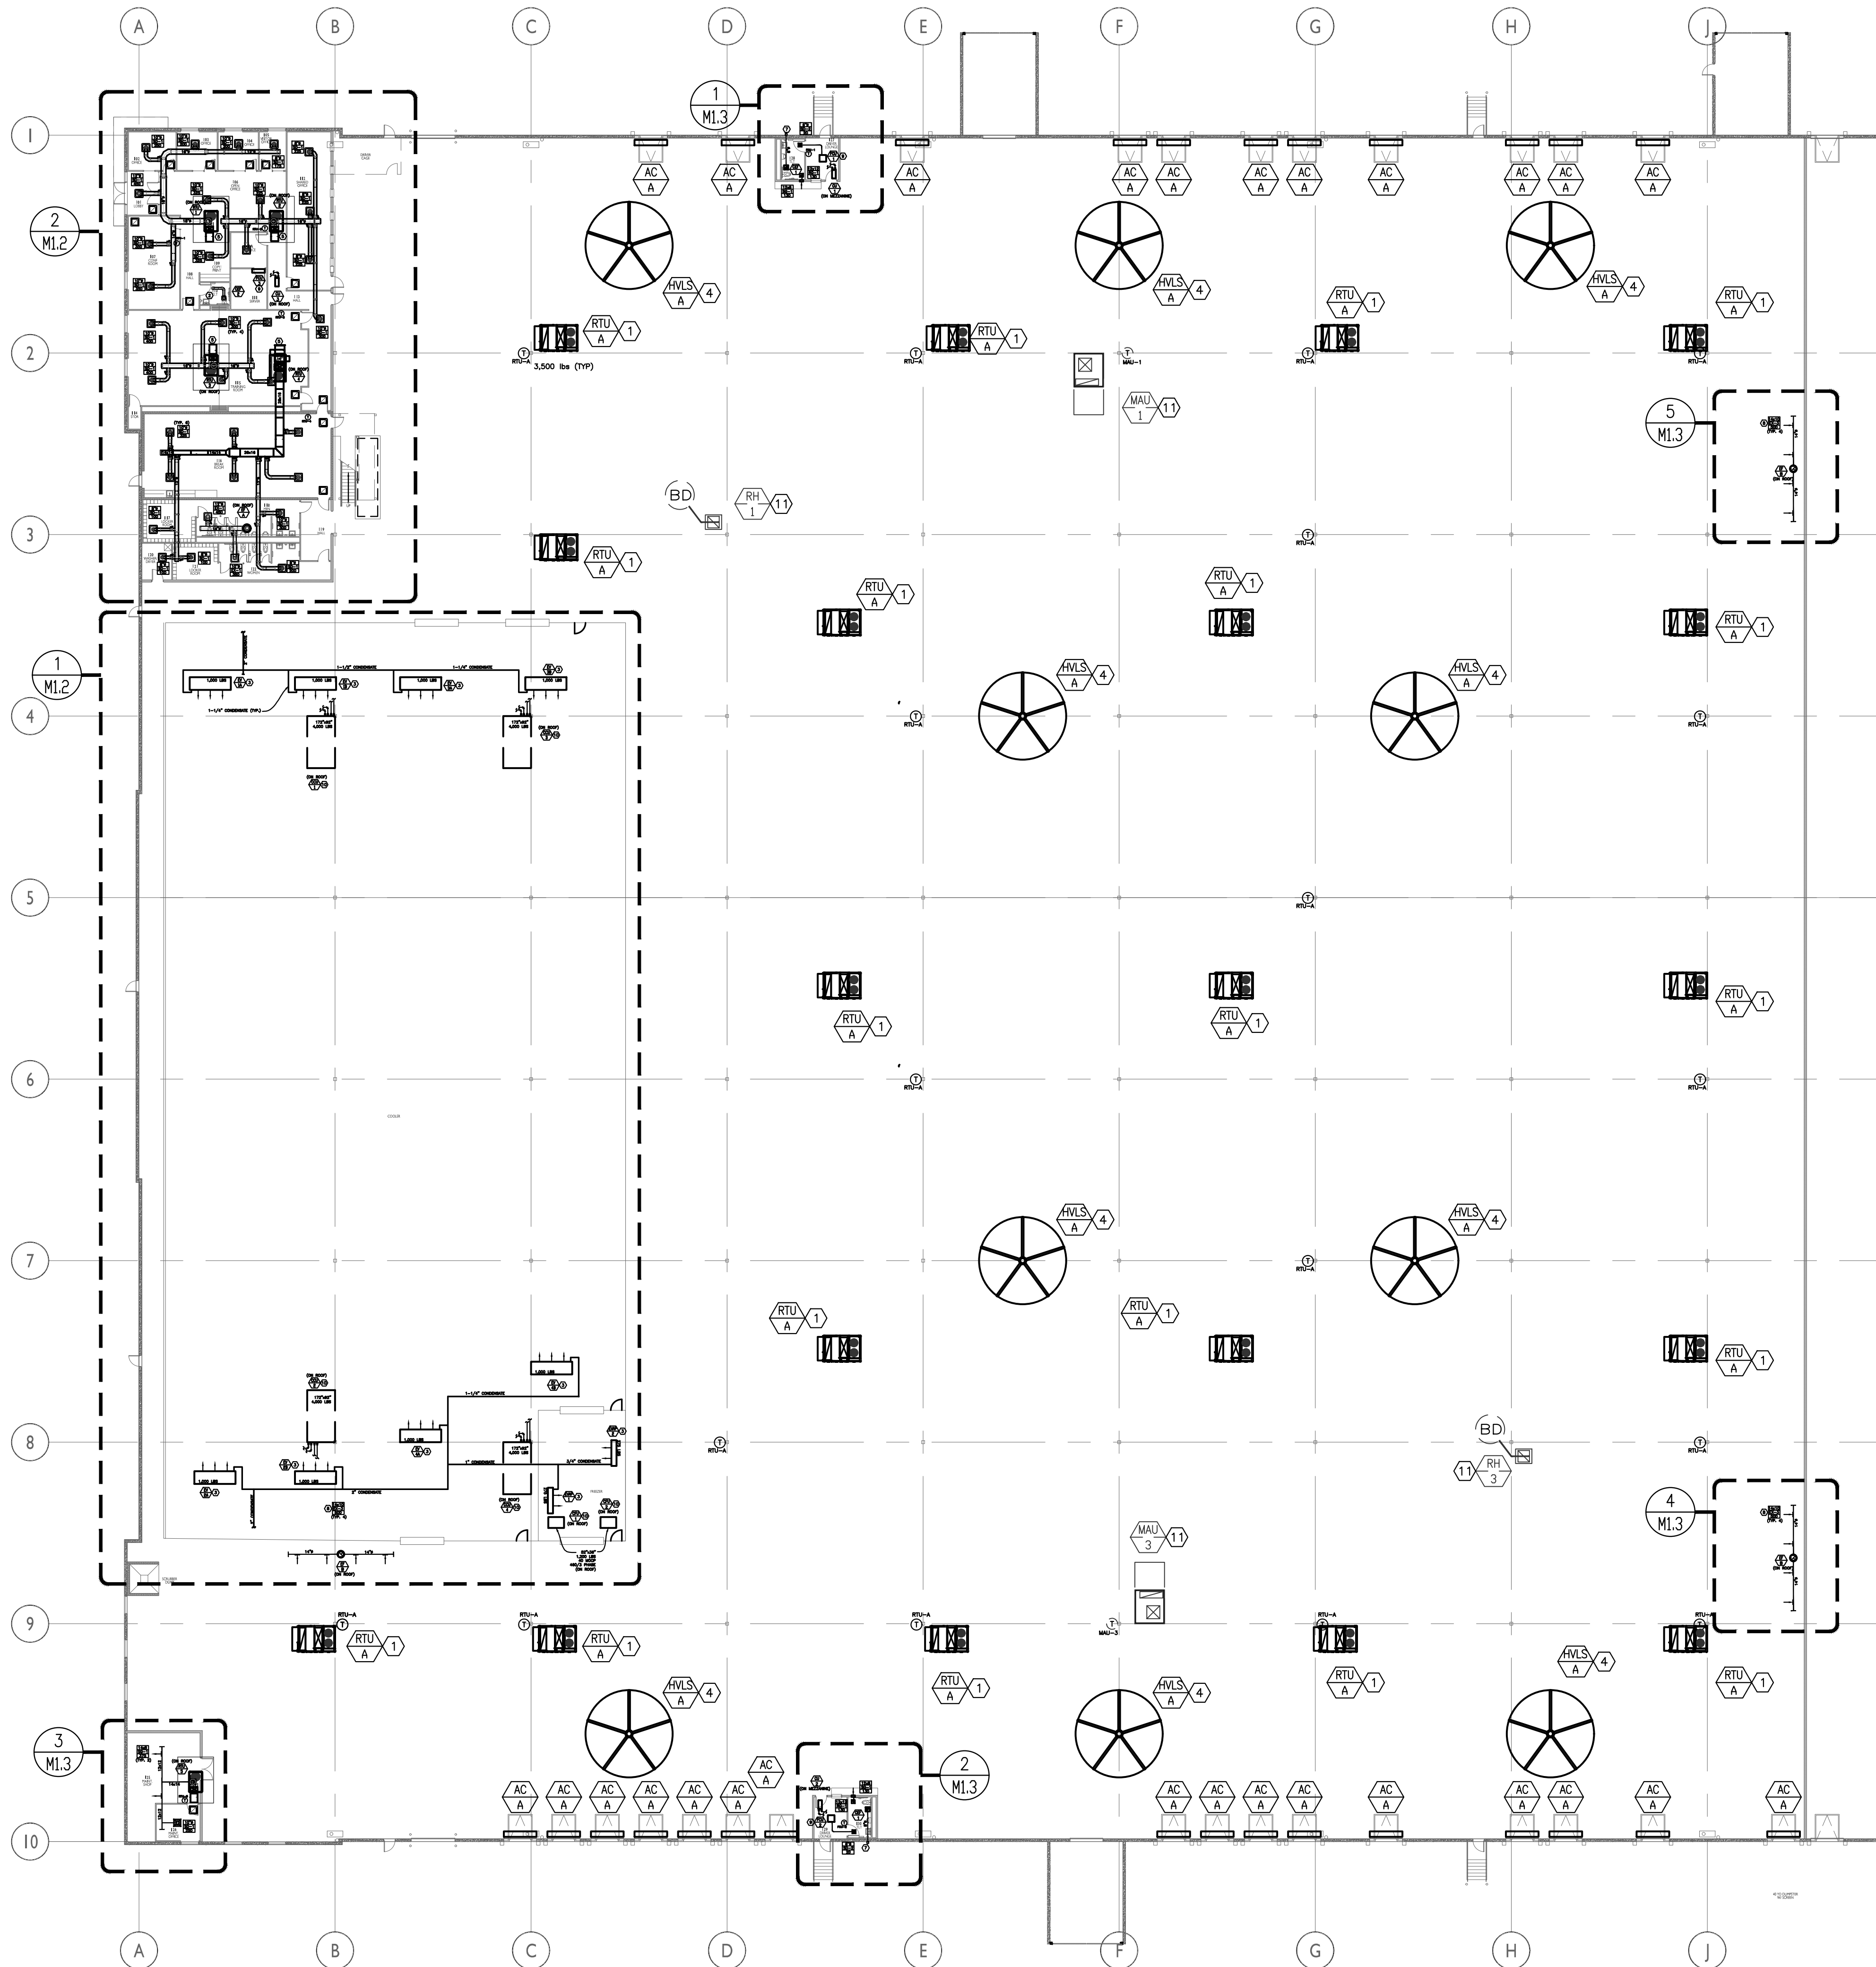

MECHANICAL GENERAL NOTES:

1. ALL MECHANICAL DUCTWORK SHALL BE GALVANIZED STEEL, CONSTRUCTED ACCORDING TO SMACNA STANDARDS.
2. ALL CONCEALED SUPPLY AIR AND RETURN AIR DUCTWORK SHALL BE EXTERNALLY INSULATED WITH 2" THICK, 3/4 LB DENSITY FIBERGLASS DUCT WRAP.
ALL EXPOSED (WAREHOUSE) SUPPLY AIR DUCTWORK AND RETURN AIR DUCTWORK SHALL BE INTERNALLY INSULATED WITH 1" THICK, 2 LB DENSITY FIBERGLASS DUCT LINER.
3. HVAC CONTRACTOR WILL CHECK EACH SYSTEM FOR PROPER OPERATION.
4. HVAC CONTRACTOR SHALL HAVE AN INDEPENDENT CONTRACTOR TO TEST & BALANCE HVAC SYSTEM TO THE PROPER AIRFLOWS AND STATIC PRESSURES. A COPY OF THE BALANCING REPORT WILL BE SUBMITTED TO THE OWNER UPON COMPLETION. AIR TO (+/-) 10%, WATER TO (+/-) 5%.
5. FLEXIBLE RUN-OUTS TO BE U.L. LISTED AND HAVE A MAXIMUM LENGTH OF 8'-0". DUCT RUNS TO BE SAME SIZE AS DIFFUSER NECK SIZE SHOWN.
6. AIR HANDLING UNITS SUPPLYING 2,000 CFM OR MORE SHALL HAVE A SMOKE DETECTOR INSTALLED IN THE RETURN AIR DUCTWORK. THE SMOKE DETECTOR SHALL BE INTERLOCKED TO SHUT DOWN ALL SUPPLY FANS UPON ALARM.
7. MAINTAIN MINIMUM 10'-0" FROM ALL PLUMBING VENTS AND EXHAUST VENTS TO ALL OUTSIDE AIR INTAKES.
8. DO NOT INSTALL PIPING OR DUCTWORK OVER ELECTRICAL PANELS.
9. ALL COOLER/FREEZER REFRIGERANT PIPING TO BE INSULATED WITH 1" ARMAFLEX. ALL CONDENSATE PIPING TO BE INSULATED WITH 1" ARMAFLEX. CPVC CAN BE USED FOR ALL NON-HEAT TRACED CONDENSATE PIPING. COPPER TO BE USED FOR ALL HEAT-TRACED CONDENSATE. PROVIDE HEAT TRACING ON ALL CONDENSATE PIPING IN FREEZER PER MANUFACTURER'S RECOMMENDATIONS. PROVIDE UV PAINT ON ALL EXTERIOR INSULATION.

MECHANICAL PLAN NOTES:

- 1) COORDINATE LOCATION OF RTU WITH FIRE SUPPRESSION PIPING AND STRUCTURE. PROVIDE INTERNALLY LINED RETURN AIR DUCT DROP WITH MESH SCREEN AND PROVIDE SUPPLY AIR DISCHARGE DROP BOX DIFFUSER SIMILAR TO CURBS PLUS DLPD 40'±-30'. NG TO BE UNDER 35 AT 9,000 CFM. PROVIDE SUPPLY AIR TRANSITION FROM RTU OPENING TO DROPBOX DIFFUSER AS REQUIRED. MOUNT THERMOSTAT ON ADJACENT COLUMN.
- 2) PROVIDE 6" EXHAUST VENT UP THROUGH ROOF. PROVIDE WITH WEATHERCAP.
- 3) ROUTE CONDENSATE AS DIRECTED TO FLOOR DRAIN. PROVIDE HEAT TRACE ON ALL FREEZER CONDENSATE PIPING.
- 4) COORDINATE EXACT LOCATION OF HVL'S FAN. PROVIDE ASSOCIATED FAN CONTROLLER ON ADJACENT COLUMN.
- 5) ROUTE FULL SIZE RETURN AIR DUCT DOWN TO 36" ABOVE FINISH CEILING AND PROVIDE WITH SCREENED MESH OPENING.
- 7) PROVIDE 6" EXHAUST VENT OUT THROUGH WALL. PROVIDE WITH WEATHERCAP.
- 8) INSTALL BATTERY CHARGING EXHAUST DUCTWORK TIGHT TO BOTTOM OF STRUCTURE. PROVIDE EXHAUST GRILLES AS NOTED AT 30" FROM BOTTOM OF DUCT. EXHAUST FAN TO RUN CONTINUOUSLY.
- 9) ROUTE CONDENSATE PIPING TO SINK TAILPIECE OR HUB DRAIN ABOVE CEILING FURNISHED BY PLUMBER
- 10) INSTALL CONDENSING UNIT ON ROOF RAILS.
- 11) EXISTING SHELL BUILDING EQUIPMENT TO REMAIN AS CURRENTLY INSTALLED.


LEGEND

- HVL 1** GREENHECK HVL/CIRCULATION FAN 24'-0" DIAMETER MODEL DS-6-24-170HV - 2HP, 460/3 PHASE, 250 LBS AND 6 BLADES. PROVIDE WITH MOUNTING ACCESSORIES AND CENTRAL CONTROL PANEL WITH BACKET INTERFACE FOR ALL (10) FANS. CONDUIT AND CONTROL WIRING BY OTHERS. (TYP. 10)
- AC A** AIR CURTAIN - POWERED AIR MODEL ETD-2-108E. UNIT TO BE 108" LONG WITH 10 KW ELECTRIC HEATING. 16 MCA @ 460/3 PHASE, 220 LBS. PROVIDE WITH MAGNETIC DOOR SWITCH, WHITE INTAKE SUPPLY GRILLE, WALL MOUNTED THERMOSTAT AND WASHABLE ALUMINUM FILTER (TYP. 27)
- EW 1** ELECTRIC WALL HEATER - RAYWALL OR EQUAL. 2KW @ 277/1 PHASE. PROVIDE WITH RECESS MOUNTING FRAME, DISCONNECT, INTEGRAL THERMOSTAT.
- SD-1** SUPPLY AIR DIFFUSER - AS SCHEDULED
- RG-1** RETURN AIR GRILLE - AS SCHEDULED
- RG-2** RETURN AIR GRILLE - AS SCHEDULED
- EX-1** EXHAUST AIR GRILLE - AS SCHEDULED
- EX-2** EXHAUST AIR GRILLE - AS SCHEDULED
- SG-1** SUPPLY AIR GRILLE - AS SCHEDULED
- SG-2** SUPPLY AIR GRILLE - AS SCHEDULED
- RETURN AIR GRILLE - AS SCHEDULED
- T** THERMOSTAT WITH ZONE/UNIT DESIGNATION. MOUNT AT 48" A.F.F.
- VAV 1-3**
- CO2** CARBON DIOXIDE SENSOR - MOUNT IN RETURN OR WALL AS SHOWN

THIS PRINT IS CONFIDENTIAL TO METRO AIR CONDITIONING CO.
REPRODUCTION OR DISCLOSURE TO OUTSIDE PARTIES IS
PROHIBITED WITHOUT OUR WRITTEN CONSENT.
© 2022 METRO AIR CONDITIONING CO.



LSCC BLDG. #1 - TI		
LEE'S SUMMIT, MO		
SCALE: AS NOTED	DATE: 9/6/22	DRAWN BY: M.D.K.
APPROVED BY: JDG	DWG #	M1
PERMIT DWGS.		of 5

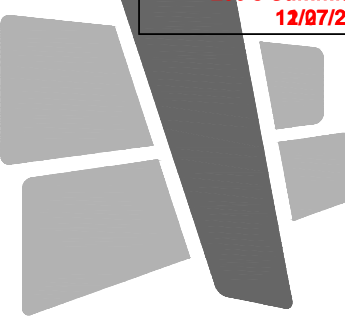

CURRAN
ARCHITECTURE

5719 LAWTON LOOP E. DR. #212
INDIANAPOLIS, IN 46216
O :: 317 . 288 . 0681
F :: 317 . 288 . 0753



SCANNELL
PROPERTIES

CERTIFICATION

THIS DRAWING AND THE IDEAS, DESIGNS
AND CONCEPTS CONTAINED HEREIN ARE
THE EXCLUSIVE INTELLECTUAL PROPERTY
OF CURRAN ARCHITECTURE, AND ARE NOT
TO BE USED OR REPRODUCED, WHOLE OR
IN PART, WITHOUT THE WRITTEN
CONSENT OF CURRAN ARCHITECTURE.
© COPYRIGHT 2021, CURRAN ARCHITECTURE

PROJECT INFORMATION

LEE'S SUMMIT LOGISTICS
BUILDING A LOT I

NW CORNER OF
NE TUDOR RD & MAIN ST
LEE'S SUMMIT, MO 64086



ISSUE DATES

PERMIT SET 04.21.22

210300

M2.1

SECTION 1500 - MECHANICAL GENERAL PROVISIONS

1.1 DESCRIPTION:

- A. Division 15 shall be governed by all applicable provisions of the Contract Documents. The Mechanical Contractor shall furnish, install and connect all materials, equipment, apparatus, mechanical systems and incidentals required for complete and working installation. The Contractor shall supply all necessary labor, equipment, tools, insurance, taxes services, and The Contractor shall assume full responsibility for all obligations associated with completion of mechanical work as provided by the Contract Documents.

1.2 STANDARDS, REGULATIONS AND CODES:

- A. The work shall comply with the edition of the applicable standards, regulations and codes currently in force of all State and local authorities having jurisdiction. Where quantities, sizes, or other requirements indicated on the drawings or herein specified are in excess of the standard or code requirements, the specifications and/or drawings shall govern. In the absence of other applicable local codes, acceptable to the Architect/Engineer, the Uniform Plumbing and Mechanical Codes shall apply to this work.
- B. The Contractor shall comply with rules and regulations of public utilities and municipal departments affected by connections of services. The Contractor shall pay all fees associated there with.
- C. The Mechanical Contractor shall be licensed to perform mechanical work in the municipality in which the project is located.
- D. All products and types of construction shall meet or exceed the latest edition of applicable standards of manufacturer, testing, performance and installation.

1.3 LOCAL CONDITIONS:

- A. The Contractor shall carefully examine the local conditions and existing installations and shall thoroughly familiarize himself with all existing conditions which may affect his work. The Contractor shall locate all existing utilities and protect them during the execution of the work.
- B. The Contractor shall examine the Architectural, Mechanical and Electrical Drawings and Specifications to familiarize himself with the type of construction, materials, and equipment to be used for all work and how it will affect the installation of his contract.

1.4 CUTTING AND PATCHING:

- A. All necessary cutting, drilling and patching shall be provided by this Contractor. Structural members shall not be disturbed without prior approval of the Architect. All areas disturbed by work performed under this Contract shall be neatly repaired and refinished to the condition of adjoining surfaces in a manner suitable to the Architect.

1.5 OPERATION DURING CONSTRUCTION:

- A. Mechanical equipment shall not be used during construction unless instructed by the General Contractor. The mechanical contractor is responsible for the installation and operation, service and maintenance of all new equipment during construction and prior to acceptance by the Owner of the completed project at additional costs to the GC and/or owner.
- B. Warranty periods shall not commence until final acceptance by the Owner/Substantial Completion.

1.6 SAFETY REGULATIONS:

- A. All Mechanical work shall be performed in compliance with all applicable governing safety regulations, including OSHA regulations. Provide safety lights, guards and signs required.

1.7 HOUSEKEEPING:

- A. The Contractor shall be responsible for keeping stocks of material and equipment stored on the premises in a neat and orderly manner.
- B. The Contractor shall clean and maintain his portion of the work as specified in the General Conditions.
- C. The Contractor shall remove from the premises all waste material present as a result of his work.

1.8 GRAPHIC REPRESENTATION AND JOB CONDITIONS:

- A. The drawings shall serve as working drawings for the general layout of the various items of equipment, are diagrammatic unless specifically dimensioned, and do not necessarily indicate every required item.
- B. The Architectural drawings take precedence over the mechanical drawings in the representation of the general construction work.
- C. Arrange work in a neat, well organized manner. Coordinate work with other trades involved.

1.9 GUARANTEES:

- A. The Contractor shall guarantee all work performed and materials and equipment furnished under this contract, against defects in materials and workmanship for a period of one year from the Date of the Owner's Final Acceptance of the Work, or as noted in each section.

1.10 MOTORS AND CONTROLS:

- A. All motors furnished under this specification shall be recognized manufacturer, of adequate capacity for the loads involved. All motors shall conform to the standards of manufacturer and performance of the National Electrical Manufacturers Association as shown in their latest publications.

1.11 PIPING IN ELECTRICAL ROOMS:

- A. No piping except specifically noted otherwise will be permitted in electrical rooms. In rooms, where piping is indicated over electrical equipment, a suitable galvanized sheetmetal pan or gutter piped to the drainage system shall be provided.

END OF SECTION
SECTION 15100 - HEATING, VENTILATION AND AIR CONDITIONING

1.1 SCOPE:

- A. The work included under this contract consists of providing all labor, materials, tools, transportation, services, etc., necessary to complete the installation of the heating, ventilating, and air conditioning systems and other items herein listed and as described in these specifications, as illustrated in the accompanying drawings or as directed by the Architect.

1.2 SHEET METAL:

- A. Provide ductwork shown with necessary dampers. Construction of new galvanized prime grade steel sheets per ASHRAE and SMACNA Standards. Provide round or rectangular duct as indicated. Fabricate for the pressure and SMACNA seal class required.
- B. Flexible duct shall be Wiremold WCK or acceptable equal maximum length shall be 8'-0" or as noted/detailed.
- C. All duct sizes shown are actual size and include liner, where required.

1.3 GRILLES, REGISTERS, INLETS AND OUTLETS:

- A. All supply grilles, registers and diffusers shall be as scheduled on the drawings and shall be ADC rated.

1.4 DUCTWORK ACCESSORIES:

- A. Provide single thickness turning vanes in all supply duct turns.
- B. Provide duct access doors for all internal mounted equipment.
- C. Provide 45° take-off fittings with volume damper for all round takeoffs to diffusers.
- D. Provide dampers where shown and required. Balance and control dampers shall be opposed blade except air mixing dampers shall be parallel blade.

1.5 AIR CONDITIONING UNITS:

- A. Air conditioning units shall be as scheduled. Units shall be standard catalogued products with the appropriate approval or certification by AGA, ARI and UL. Efficiencies shall conform to ASHRAE 90.1 standards.

1.6 FANS:

- A. Fans with accessories shall be as scheduled and shall be AMCA rated.

1.7 VIBRATION ISOLATION:

- A. Duct flexible connection shall be non-combustible, 16 ounce canvas. Piping flexible connection shall be Flexicon 401H or acceptable equal.

1.8 MISCELLANEOUS MECHANICAL EQUIPMENT:

- A. Provide constant, variable volume and/or fan powered boxes and accessories as scheduled. Acceptable manufacturers are E.H. Price or acceptable equal.


1.9 CLEANING:

- A. Clean system by operating at least three hours prior to final acceptance with temporary filters. Remove all filters and replace with clean.
- B. Use precleaned precharged refrigerant tube. Clean per manufacturers recommendations.

1.10 TESTING AND ADJUSTING:


- A. Contractor shall operate and test the air conditioning and ventilation systems and instruct the Owner in its operation. Perform a series of general capacity and operating tests. The tests shall demonstrate the specified capacities of various pieces of equipment.

END OF SECTION

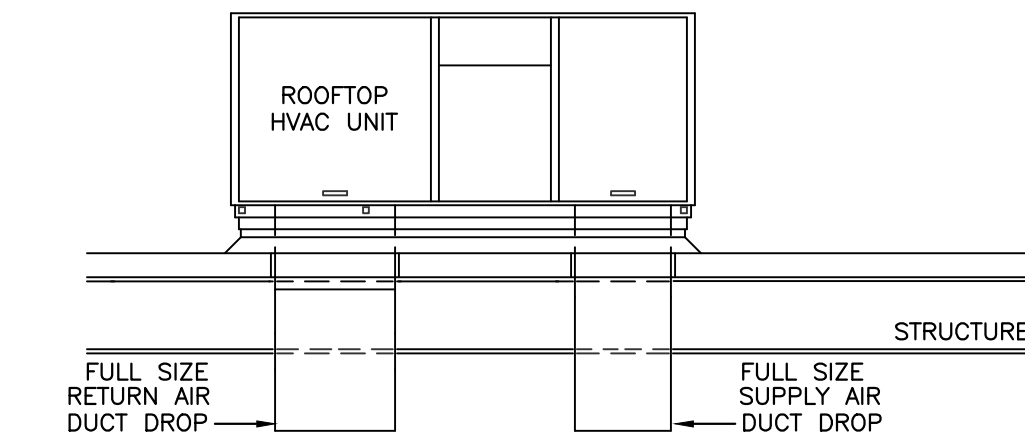

NOTES:
1. PROVIDE OPENING THROUGH ROOF AND ROOF DECK INSULATION NO LARGER THAN REQUIRED TO ALLOW DUCTS TO PASS THROUGH. REFER TO PLANS FOR DUCT SIZES. FUTURE TI DUCTWORK CONNECTION BY OTHERS.

1 ROOFTOP UNIT DETAIL
NO SCALE

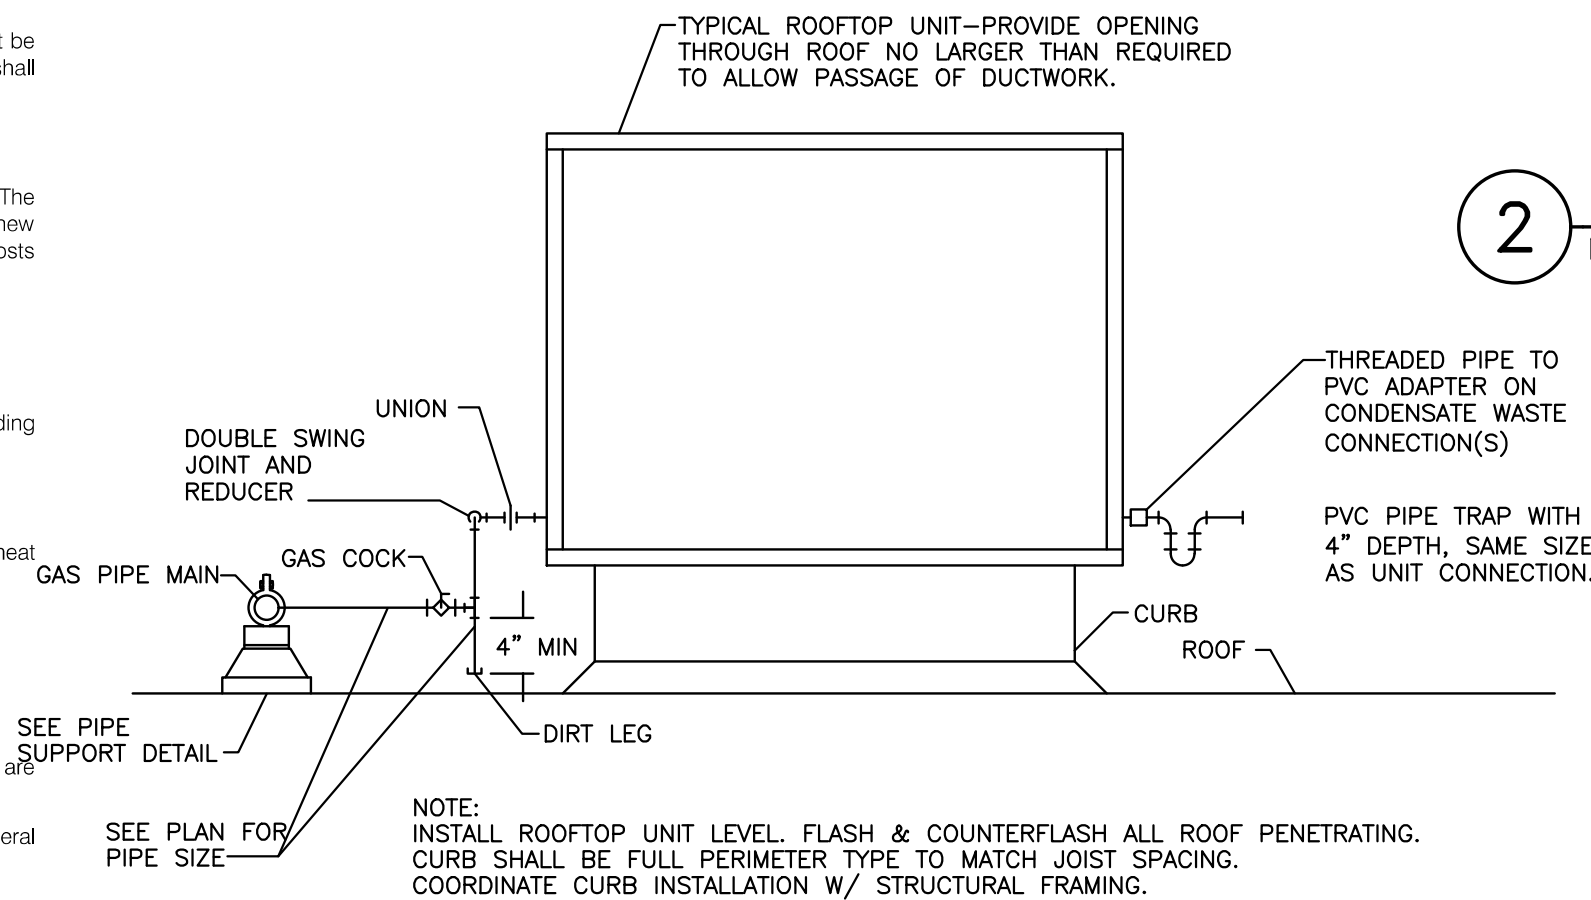

2 DOWNBLAST EXHAUST FAN DETAIL
NO SCALE

ROOFTOP UNIT - CONSTANT VOLUME WITH SINGLE SETPOINT CONTROL (ALL RTU'S)

1. DESCRIPTION:
EACH SINGLE-ZONE PACKAGED ROOFTOP UNIT (RTU) WILL BE PROVIDED AS IDENTIFIED ON THE EQUIPMENT SCHEDULES, WITH DIRECT EXPANSION COOLING COIL, GAS HEAT, SINGLE-SPEED SUPPLY FAN, 2" FILTERS, ECONOMIZER, BAROMETRIC RELIEF, AND FIELD POWERED GFCI CONVENIENCE OUTLET. ECONOMIZERS SHALL BE 0-100% FULLY MODULATING WITH ENTHALPY CONTROL, LOW LEAK DAMPERS.
2. CONTROL:
EACH UNIT SHALL BE FURNISHED WITH A THERMOSTAT TO BE INSTALLED IN THE SPACE. THE OCCUPANCY MODE SHALL BE DETERMINED THROUGH A USER-ADJUSTABLE PROGRAMMABLE SCHEDULE WITH OR WITHOUT USER OVERRIDE BUTTON ON THE THERMOSTAT.
3. SUPPLY AIR FAN:
THE FAN MODE SHALL BE SELECTABLE FOR AUTO OR ON. WHEN AUTO IS SELECTED, THE FAN SHALL CYCLE ON AND OFF WITH HEATING OR COOLING. WHEN ON IS SELECTED, THE FAN SHALL OPERATE CONTINUOUS.
4. MECHANICAL COOLING:
EACH RTU SHALL CYCLE COOLING COMPRESSOR STAGES IN RESPONSE TO COOLING DEMAND FROM THE THERMOSTAT. THE SUPPLY FAN WILL BE ENERGIZED (AUTO MODE) AND STAGE COOLING CAPACITY TO MAINTAIN SPACE TEMPERATURE SETPOINT BASED ON FACTORY CONTROL SEQUENCES. THE SPACE COOLING TEMPERATURE SETPOINT SHALL BE ADJUSTABLE THRU THE PROGRAMMABLE THERMOSTAT AND WILL BE SET-UP TO MAINTAIN TEMPERATURES PER TABLE 2.
5. GAS HEATING:
THE RTU SHALL CYCLE GAS HEATING STAGES IN RESPONSE TO HEATING DEMAND FROM THE THERMOSTAT. ON A CALL FOR HEATING FROM THE ZONE SENSOR, THE SUPPLY FAN WILL BE ENERGIZED AND THE BURNER SHALL BE ENERGIZED TO MAINTAIN SPACE TEMPERATURE. THE SPACE HEATING TEMPERATURE SETPOINT SHALL BE ADJUSTABLE THRU THE PROGRAMMABLE THERMOSTAT AND WILL BE SET-UP TO MAINTAIN TEMPERATURES PER TABLE 2.
6. DEMAND CONTROL VENTILATION (BREAK ROOM RTU'S ONLY):
THE SPACE MOUNTED CO2 SENSOR SHALL MONITOR THE SPACE AIR QUALITY. AS THE CO2 RISES ABOVE THE CO2 SETPOINT (700 PPM, ADJ.) THE OUTSIDE AIR DAMPER INCREASES ABOVE MINIMUM SETPOINT TO A MAXIMUM POSITION SET DURING BALANCING. AS CO2 LEVELS DECREASE, THE DAMPER MODULATES CLOSED. ONCE THE CO2 LEVEL IS BELOW THE CO2 SETPOINT, THE OUTSIDE AIR DAMPER SHALL RETURN TO THE MINIMUM POSITION.
7. ECONOMIZER - ENTHALPY:
THE FACTORY RTU CONTROLLER WILL INDEX THE UNIT INTO ECONOMIZER MODE IF THE OUTDOOR AIR DRY BULB IS BELOW THE SETPOINT. WHEN ECONOMIZER MODE IS ENABLED, THE RETURN AND OUTSIDE AIR DAMPERS WILL MODULATE BETWEEN MINIMUM POSITION AND FULL OPEN AS NECESSARY TO MAINTAIN DISCHARGE AIR TEMPERATURE. THE RTU START-UP TECHNICIAN SHALL SET THE UNIT ECONOMIZER.
8. UNOCCUPIED MODE:
DURING UNOCCUPIED MODE, THE UNIT SHALL CONTROL TO THE UNOCCUPIED MODE SETBACK TEMPERATURE. IF THE UNOCCUPIED SETPOINT IS EXCEEDED, THE RTU SHALL HEAT OR COOL UNTIL THE ZONE TEMPERATURE IS WITHIN THE UNOCCUPIED SETPOINTS, PLUS OR MINUS AN OFFSET OF 5°F (ADJ.).
9. BAROMETRIC RELIEF DAMPER:
THE BAROMETRIC RELIEF DAMPER CONSISTS OF A GRAVITY DAMPER THAT WILL OPEN TO RELIEVE EXCESS AIR AS BUILDING PRESSURE INCREASES.
10. OUTSIDE AIR DAMPER:
WHEN UNIT IS NOT IN ECONOMIZER MODE AND THE SUPPLY FAN IS IN OPERATION, THE OUTDOOR AIR DAMPER SHALL MODULATE TO THE MINIMUM PER THE UNIT SCHEDULE DURING THE OCCUPIED MODE. THE OUTDOOR AIR DAMPER SHALL BE CLOSED WHEN THE SUPPLY FAN IS OFF.
11. BALANCING WAREHOUSE RTU WITH 4-WAY DIFFUSER:
BALANCING CONTRACTOR TO BALANCE WAREHOUSE RTU UTILIZING RPM AND MANUFACTURER'S FAN CURVE. INDIVIDUAL GRILLE AIRFLOW IS NOT REQUIRED. THE BALANCING CONTRACTOR SHALL ASSIST IN SETTING OUTDOOR AIR DAMPER POSITIONS.
12. SMOKE DETECTION CONTROL:
UPON DETECTION OF SMOKE FROM THE RETURN DUCT SMOKE DETECTOR (BY OTHERS), THE FANS WILL CYCLE OFF AND OUTDOOR AIR DAMPERS SHALL CLOSE. ONCE THE DETECTORS ARE RESET, THE UNIT WILL RETURN TO NORMAL CONTROL. SMOKE DETECTOR INSTALLATION BY OTHERS, AS NECESSARY. THE RESPONSIBILITY OF THE FIRE ALARM CONTRACTOR TO WIRE THE SMOKE DETECTOR TO THE EMERGENCY SHUT DOWN OF THE RTU CONTROLLER.

IT / DATA / MDF ROOM DUCTLESS COOLING-ONLY SPLIT SYSTEM, WALL-MOUNTED (FCU-3)

1. DESCRIPTION:
THE SYSTEM SHALL CONSIST OF A SINGLE-ZONE SPLIT SYSTEM WITH INDOOR FAN-COILHANDLING UNIT (FCU) AND COOLING-ONLY OUTDOOR CONDENSING UNIT (CU).
2. CONTROL:
THE SPACE TEMPERATURE SHALL BE CONTROLLED IN A STAND-ALONE MODE BY MANUFACTURER SUPPLIED THERMOSTAT MOUNTED IN ROOM
3. COOLING:
THE AHU SHALL OPERATE CONTINUOUSLY. THE CU SHALL CYCLE CAPACITY AS NEEDED TO MAINTAIN THE SPACE TEMPERATURE OF 74°F (ADJ.).

SHIPPING/RECEIVING (FCU-1/2)

1. DESCRIPTION:
THE SYSTEM SHALL CONSIST OF A SINGLE-ZONE SPLIT SYSTEM WITH INDOOR FAN-COILHANDLING UNIT (FCU) AND COOLING-ONLY OUTDOOR CONDENSING UNIT (CU).
2. CONTROL:
THE SPACE TEMPERATURE SHALL BE CONTROLLED IN A STAND-ALONE MODE BY MANUFACTURER SUPPLIED THERMOSTAT MOUNTED IN ROOM
3. COOLING:
THE AHU SHALL OPERATE CONTINUOUSLY. THE CU SHALL CYCLE CAPACITY AS NEEDED TO MAINTAIN THE SPACE TEMPERATURE OF 74°F (ADJ.).

EXHAUST FAN (EF-1/2/3)


1. CONTROL:
THE EXHAUST FAN SHALL OPERATE CONTINUOUSLY AS INDICATED ON THE EXHAUST FAN EQUIPMENT SCHEDULE.
2. CONTINUOUS:
THE EXHAUST FAN SHALL OPERATE CONTINUOUSLY (24/7). THE FAN MAY BE DE-ENERGIZED USING THE DISCONNECT SWITCH.

EXHAUST FAN (CEF-1) (TYP.)

1. CONTROL:
THE EXHAUST FAN SHALL BE INTERLOCKED WITH THE RESTROOM LIGHT SWITCH, AS INDICATED ON THE EXHAUST FAN EQUIPMENT SCHEDULE.
2. ROOM LIGHT SWITCH:
THE EXHAUST FAN SHALL BE INTERLOCKED WITH THE ROOM LIGHT CONTROL OR WALL SWITCH AND SHALL BE ENERGIZED ANY TIME THE LIGHTS ARE ON IN THE ROOM. (WIRING BY OTHERS)

AIR CURTAIN (AC-A)

1. DESCRIPTION:
EACH UNIT SHALL CONSIST OF A HEATED ELECTRIC AIR CURTAIN FOR ENVIRONMENTAL SEPARATION. UNIT SHALL BE PROVIDED WITH FACTORY-INSTALLED 24V TRANSFORMER, MAGNETIC DOOR LIMIT SWITCH, HEAT-OFF-FAN SWITCH, AND THERMOSTAT.
2. DOOR LIMIT CONTROL:
AIR CURTAIN SHALL ENERGIZE AS DOOR BEGINS TO OPEN AS INDICATED BY THE MAGNETIC DOOR LIMIT SWITCHES. UNIT SHALL DE-ENERGIZE WHEN THE DOOR HAS CLOSED.
3. HEAT-OFF-FAN CONTROL:
WHEN THE SWITCH IS IN THE OFF POSITION THE AIR CURTAIN IS INOPERABLE. IN THE HEAT POSITION, THE AIR CURTAIN WILL RUN WITH HEAT BASED ON THE LIMIT SWITCH OR THERMOSTAT. IN THE FAN POSITION, THE AIR CURTAIN WILL RUN WITHOUT HEAT BASED ON THE LIMIT SWITCH.
4. HEATING:
AIR CURTAINS HAVING SINGLE (ONE-STAGE) HEATING ELEMENTS, ARE CONTROLLED BY A SINGLE STAGE THERMOSTAT. WHEN THE AIR CURTAIN CONTROL CIRCUIT CLOSSES, THE AIR CURTAIN FAN WILL RUN AND THROUGH INTERLOCKING, WILL ENABLE THE HEATER CIRCUIT ON A CALL FOR HEAT. THE THERMOSTAT WILL ENERGIZE THE HEATER CONTROL CONTACTOR. THE THERMOSTAT WILL THEN CYCLE THE HEATER AS NEEDED. AS LONG AS THE AIR CURTAIN CONTROL CIRCUIT IS CLOSED (FAN IS RUNNING), WHEN THE AIR CURTAIN CONTROL CIRCUIT OPENS, THE HEATER CIRCUIT IS DISABLED. THE HEATER WILL DE-ENERGIZE AND THE FAN WILL SHUT OFF.

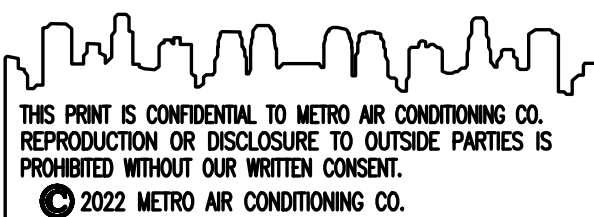

LSCC BLDG. #1 - TI

LEE'S SUMMIT, MO


SCALE: AS NOTED DATE: 9/6/22 DRAWN BY: M.D.K.

APPROVED BY: JDG

DWG #

M4

of 5

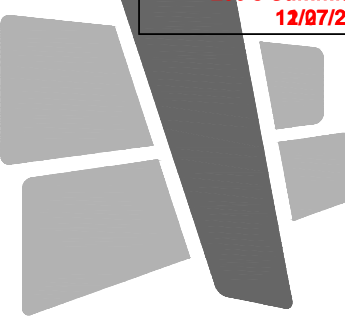

CURRAN
ARCHITECTURE

5719 LAWTON LOOP E. DR. #212
INDIANAPOLIS, IN 46216
O :: 317 . 288 . 0681
F :: 317 . 288 . 0753



SCANNELL
PROPERTIES

CERTIFICATION

THIS DRAWING AND THE IDEAS, DESIGNS
AND CONCEPTS CONTAINED HEREIN ARE
THE EXCLUSIVE INTELLECTUAL PROPERTY
OF CURRAN ARCHITECTURE, AND ARE NOT
TO BE USED OR REPRODUCED, WHOLE OR
IN PART, WITHOUT THE WRITTEN
CONSENT OF CURRAN ARCHITECTURE.
© COPYRIGHT 2021, CURRAN ARCHITECTURE

PROJECT INFORMATION

LEE'S SUMMIT LOGISTICS
BUILDING A LOT I

NW CORNER OF
NE TUDOR RD & MAIN ST
LEE'S SUMMIT, MO 64086



ISSUE DATES

PERMIT SET 04.21.22

210300

M3.1

ROOFTOP UNIT SCHEDULE (NATURAL GAS HEAT)

MARK	MANUFACTURER	MODEL	SERVICE	QUANTITY	NOMINAL TONNAGE	SUPPLY FAN			COOLING COIL		GAS HEATING COIL		ELECTRIC HEATING		ELECTRICAL			WEIGHT (LBS) W/ CURB	MIN. OUTSIDE AIR (CFM)	MAX. OUTSIDE AIR (CFM)	MIN. EER	NOTES		
						CFM	ESP (IN)	MODE	HP	TH (MBH)	SH (MBH)	INPUT (MBH)	OUTPUT (MBH)	STAGES	INPUT (KW)	STAGES	MCA						MOCP	V/PH
RTU-A	TRANE	YSD300G4RHC	WAREHOUSE	19	25	9,000	0.50	CV	7.5	300	234	480	320	2	---	---	56	70	460/3	3,200	800	800	10.0	A - H
RTU-1	TRANE	YSC060	MAIN OFFICE	1	5	1,975	0.75	CV	1.0	58	48	100	81	2	---	---	15	20	460/3	1,000	200	200	12.0	A - H
RTU-2	TRANE	YSC060	MAIN OFFICE	1	5	1,950	0.75	CV	1.0	58	48	100	81	2	---	---	15	20	460/3	1,000	175	175	12.0	A - H
RTU-3	TRANE	YSC060	MAIN OFFICE	1	5	2,000	0.75	CV	1.0	58	48	100	81	2	---	---	15	20	460/3	1,000	300	300	12.0	A - H
RTU-4	TRANE	YSC092F	MAIN OFFICE	1	7.5	2,750	0.75	CV	2.0	90	68	150	120	2	---	---	18	20	460/3	1,500	450	450	11.0	A - H
RTU-5	TRANE	YSC036	MAINTENANCE	1	3	1,000	0.50	CV	0.5	35	26	80	60	2	---	---	10	15	460/3	1,000	70	70	12.0	A - H

NOTES:

- A. STARTERS FOR ALL MOTORS SHALL BE FURNISHED INTEGRAL WITH UNIT.
B. EQUIPMENT SIZED FOR 100 DEGREE F AMBIENT TEMPERATURE.
C. PROVIDE 2", 30% EFFICIENT PLEATED THROWAWAY AIR FILTERS.
D. PROVIDE MANUFACTURER'S STANDARD SPRING VIBRATION ISOLATION ROOF CURB WITH MINIMUM HEIGHT OF 14".
E. PROVIDE FACTORY MOUNTED DISCONNECT SWITCH, FIELD POWERED GFI OUTLET AND HAIL GUARDS.
F. PROVIDE WITH TRANE AIR/FI CONTROLS TO INTEGRATE INTO BAS.
G. PROVIDE ENTHALPY ECONOMIZER WITH BAROMETRIC RELIEF DAMPER.
H. ELECTRICAL/FIRE ALARM CONTRACTOR TO FURNISH AND INSTALL SMOKE DETECTOR IN RETURN AIR DUCT.
J. PROVIDE WITH HOT-GAS REHEAT COIL, DEHUMIDIFICATION CONTROLS AND WALL MOUNTED CO2 SENSOR. CO2 SENSOR TO MODULATE OA FROM MINIMUM TO MAXIMUM AIRFLOWS.
K. PROVIDE WITH VARIABLE FREQUENCY DRIVE FOR SINGLE ZONE VAV OPERATION.
L. UNIT SHALL BE VVT. PROVIDE WITH BYPASS DAMPER AND REQUIRED CONTROLS FOR PROPER OPERATION.
M. PROVIDE WITH CO2 SENSOR MOUNTED AS SHOWN ON PLANS (WALL OR DUCT MOUNT) AND MODULATE VENTILATION FROM MINIMUM TO MAXIMUM SCHEDULED VALUES.

COOLER/FREEZER EQUIPMENT SCHEDULE

MARK	MANUFACTURER	MODEL	SERVICE	QUANTITY	TYPE	SUPPLY FAN(S)			PIPING CONNECTIONS			ELECTRICAL			WEIGHT	HEIGHT W/ O RAILS	NOTES
						CFM	HP	QTY.	LIQUID	SUCTION	CONDENSATE	MCA	MOCP	V/PH			
CFU-1	HEATCRAFT/BOHN	BCH0075LDACD	(-) 10 F FREEZER	1	CONDENSING UNIT	---	7.5	---	7/8"	1-5/8"	---	38	40	460/3	1,000	40"	A - D
EVAP-1	HEATCRAFT/LARKIN	BEM0325MS4EMA		1	EVAPORATOR	7,100	1/4	3	1-1/8"	1-5/8"	3/4"	18	---	460/1	300	30"	A - B
CFU-2	HEATCRAFT/BOHN	BCH0075LDACD	(-) 10 F FREEZER	1	CONDENSING UNIT	---	7.5	---	7/8"	1-5/8"	---	38	40	460/3	1,000	40"	A - D
EVAP-2	HEATCRAFT/LARKIN	BEM0325MS4EMA		1	EVAPORATOR	7,100	1/4	3	1-1/8"	1-5/8"	3/4"	18	---	460/1	300	30"	A - B
CCU-1	HEATCRAFT/BOHN	BCD0400MDACD	(+) 38 F COOLER	1	CONDENSING UNIT	---	40	---	1-5/8" x (2)	2-1/8" x (2)	---	142	150	460/3	4,500	56"	A - D
EV-1A	HEATCRAFT/BOHN	BHA1400SA		1	EVAPORATOR	20,700	1	3	1-5/8"	2-1/8"	1-1/4"	7	---	460/3	800	51"	A - B, E
EV-1B	HEATCRAFT/BOHN	BHA1400SA		1	EVAPORATOR	20,700	1	3	1-5/8"	2-1/8"	1-1/4"	7	---	460/3	800	51"	A - B, E
CCU-2	HEATCRAFT/BOHN	BCD0400MDACD	(+) 38 F COOLER	1	CONDENSING UNIT	---	40	---	1-5/8" x (2)	2-1/8" x (2)	---	142	150	460/3	4,500	56"	A - D
EV-2A	HEATCRAFT/BOHN	BHA1400SA		1	EVAPORATOR	20,700	1	3	1-5/8"	2-1/8"	1-1/4"	7	---	460/3	800	51"	A - B, E
EV-2B	HEATCRAFT/BOHN	BHA1400SA		1	EVAPORATOR	20,700	1	3	1-5/8"	2-1/8"	1-1/4"	7	---	460/3	800	51"	A - B, E
CCU-3	HEATCRAFT/BOHN	BCD0400MDACD	(+) 38 F COOLER	1	CONDENSING UNIT	---	40	---	1-5/8" x (2)	2-1/8" x (2)	---	142	150	460/3	4,500	56"	A - D
EV-3A	HEATCRAFT/BOHN	BHA1400SA		1	EVAPORATOR	20,700	1	3	1-5/8"	2-1/8"	1-1/4"	7	---	460/3	800	51"	A - B, E
EV-3B	HEATCRAFT/BOHN	BHA1400SA		1	EVAPORATOR	20,700	1	3	1-5/8"	2-1/8"	1-1/4"	7	---	460/3	800	51"	A - B, E
CCU-4	HEATCRAFT/BOHN	BCD0400MDACD	(+) 38 F COOLER	1	CONDENSING UNIT	---	40	---	1-5/8" x (2)	2-1/8" x (2)	---	142	150	460/3	4,500	56"	A - D
EV-4A	HEATCRAFT/BOHN	BHA1400SA		1	EVAPORATOR	20,700	1	3	1-5/8"	2-1/8"	1-1/4"	7	---	460/3	800	51"	A - B, E
EV-4B	HEATCRAFT/BOHN	BHA1400SA		1	EVAPORATOR	20,700	1	3	1-5/8"	2-1/8"	1-1/4"	7	---	460/3	800	51"	A - B, E

NOTES:

- A. PROVIDE LOW AMBIENT CONTROL AND R448A REFRIGERANT AND 5YR COMPRESSOR WARRANTY.
B. EQUIPMENT SIZED FOR 100 DEGREE F AMBIENT TEMPERATURE.
C. PROVIDE WITH HEATCRAFT VANTAGE AUTO-ROTATE THERMOSTAT CONTROLLER FOR REFRIGERATION SYSTEM. PROVIDE WITH TEMPERATURE SENSORS FOR MOUNTING IN COOLER/FREEZER UNIT SHALL BE PROGRAMMED TO CALL OUT DURING TEMPERATURE ALARMS.
D. ADD 16" EQUIPMENT SUPPORT RAILS TO CALCULATE OVERALL EQUIPMENT HEIGHT ON ROOF.
E. PROVIDE WITH HIGH AIRFLOW COLLAR.

OUTSIDE AIR CALCULATIONS

UNIT SERVED	OCCUPANCY CLASSIFICATION	AREA (SQ. FT.)	PEOPLE PER 1,000	FIXED SEATING QUANTITY	QUANTITY OF PEOPLE	REQUIRED OUTSIDE AIR PER PERSON	REQUIRED OUTSIDE AIR PER SF	TOTAL REQUIRED AIRFLOW	NOTES
RTU-1	OFFICE	470	7	---	3	5	0.06	45	A
	CORRIDOR	105	---	---	---	---	0.05	6	A
	CONFERENCE	385	50	---	19	5	0.06	119	A
REQUIRED VENTILATION								170 CFM	C
RTU-2	OFFICE	1,390	7	---	10	5	0.06	132	A
	CORRIDOR	340	---	---	---	---	0.05	20	A
REQUIRED VENTILATION								152 CFM	C
RTU-3	CONFERENCE	1,280	50	43	64	5	0.06	282	A
REQUIRED VENTILATION								292 CFM	C
RTU-4	BREAK ROOM	1,250	25	60	31	5	0.06	375	A
	RESTROOMS	950	---	---	---	---	0.06	57	A
REQUIRED VENTILATION								432 CFM	C
FCU-1	OFFICE	105	7	---	1	5	0.06	10	A
	RESTROOMS	70	---	---	---	---	0.06	4	A
REQUIRED VENTILATION								14 CFM	D
FCU-2	OFFICE	105	7	---	1	5	0.06	10	A
	RESTROOMS	70	---	---	---	---	0.06	4	A
REQUIRED VENTILATION								14 CFM	D
FCU-4	OFFICE	600	7	---	4	5	0.06	57	A
REQUIRED VENTILATION								57 CFM	C

NOTES:

- A. VENTILATION RATES ARE TAKEN FROM ASHRAE 62.1-2010 - VENTILATION FOR ACCEPTABLE INDOOR AIR QUALITY.
B. VENTILATION IS BASED ON TOTAL QUANTITY OF PEOPLE TAKEN FROM NUMBER OF ACTUAL SEATING SHOWN ON ARCHITECTURAL FLOOR PLAN.
C. REFER TO RTU SCHEDULE FOR ACTUAL VENTILATION AIRFLOWS.
D. VENTILATION PROVIDED BY OPERABLE DOORS.

OUTSIDE AIR CALCULATIONS

UNIT SERVED	OCCUPANCY CLASSIFICATION	AREA (SQ. FT.)	PEOPLE PER 1,000 SQ. FT.	FIXED SEATING QUANTITY	QUANTITY OF PEOPLE	REQUIRED OUTSIDE AIR PER PERSON	REQUIRED OUTSIDE AIR PER SQ. FT.	TOTAL REQUIRED (CFM)	NOTES
RTU-A	WAREHOUSE	180,000	---	---	---	---	0.06	14,400	A
REQUIRED VENTILATION								14,400 CFM	B

NOTES:

- A. VALUES TAKEN FROM ASHRAE 62.1-2010 - VENTILATION FOR ACCEPTABLE INDOOR AIR QUALITY.
B. TOTAL VENTILATION FOR WAREHOUSE TO BE DIVIDED AMONG ALL RTU-A. REFER TO EQUIPMENT SCHEDULE FOR ACTUAL AMOUNT.

DUCTLESS SPLIT SYSTEM EQUIPMENT SCHEDULE

MARK	MANUFACTURER	MODEL	TYPE	SUPPLY FAN		COOLING COIL		ELECTRICAL			VENTILATION (CFM)	WEIGHT (LBS)	NOTES
				CFM	ESP (IN)	TH (MBH)	SH (MBH)	MCA	MOCP	V/PH			
FCU-1	LENNOX	M22A012S4-2P	CEILING MOUNT CASSETTE	400	---	12	8	1	---	---	---	45	F, G
CU-1	LENNOX	MPB012S4S-1P	CONDENSING UNIT	---	---	---	---	12	15	208/1	---	150	A - E
FCU-2	LENNOX	M22A012S4-2P	CEILING MOUNT CASSETTE	400	---	12	8	1	---	---	---	45	F, G
CU-2	LENNOX	MPB012S4S-1P	CONDENSING UNIT	---	---	---	---	12	15	208/1	---	150	A - E
FCU-3	LENNOX	MWMA036S4	WALL MOUNT FAN-COIL	1,000	---	36	28	1	---	---	---	45	F
CU-3	LENNOX	MPB036S4S	CONDENSING UNIT	---	---	---	---	35	50	208/1	---	250	A - E

NOTES:

- A. PROVIDE WITH WIRELESS TEMPERATURE CONTROLLER AND LOW-AMBIENT WIND BAFFLE KIT.
B. FAN-COIL TO BE POWERED FROM CONDENSING UNIT POWER CIRCUIT. REFER TO INSTALLATION INSTRUCTIONS.
C. INSTALL CONDENSING UNIT ON TREATED 4X4 WOOD BLOCKING.
D. PROVIDE WITH 50'-0" PRE-INSULATED LINESET AS REQUIRED.
E. ELECTRICAL CONTRACTOR TO PROVIDE ASSOCIATED POWER WIRING BETWEEN CU AND FCU.
F. PROVIDE WITH CONDENSATE PUMP AND DISCHARGE CONDENSATE PER PLANS AS REQUIRED.
G. VENTILATION PROVIDED BY OPERABLE DOORS.

GRILLE, REGISTER & DIFFUSER SCHEDULE

MARK	MANUFACTURER	MODEL	TYPE	SIZE	MOUNTING	FINISH	MATERIAL	NOTES
SD-1	PRICE	SPD	SQUARE PLAQUE	24" x 24"	LAY-IN	WHITE	STEEL	
SD-2	PRICE	SPD	SQUARE PLAQUE	24" x 24"	SURFACE	WHITE	STEEL	B
SD-3	PRICE	SPD	SQUARE PLAQUE	12" x 12"	LAY-IN	WHITE	STEEL	
SD-4	PRICE	SPD	SQUARE PLAQUE	12" x 12"	SURFACE	WHITE	STEEL	B
VAV-1	PRICE	VARTHERM	VAV	24" x 24"	LAY-IN	WHITE	STEEL	
LSD-1	PRICE	TBD	LINEAR SLOT	4'-0" X (4) 1" SLOT	LAY-IN	WHITE	STEEL	H
SG-1	PRICE	520DL	WALL MOUNT	AS NOTED	WALL/DUCT	WHITE	STEEL	A
SG-2	PRICE	SDGE	SPIRAL MOUNT	AS NOTED	DUCT	MILL	STEEL	A, C
RG-1	PRICE	PDDR	PERFORATED	24" x 24"	LAY-IN	WHITE	STEEL	
RG-2	PRICE	PDDR	PERFORATED	12" x 24"	LAY-IN	WHITE	STEEL	
RG-3	PRICE	530DL	WALL MOUNT	AS NOTED	WALL/DUCT	WHITE	STEEL	
EX-1	PRICE	APDDR	PERFORATED	24" x 24"	SURFACE	WHITE	ALUMINUM	A, B
EX-2	PRICE	APDDR	PERFORATED	24" x 24"	LAY-IN	WHITE	ALUMINUM	
EX-3	PRICE	APDDR	PERFORATED	12" x 12"	LAY-IN	WHITE	ALUMINUM	

NOTES:

- A. PROVIDE WITH DAMPER OPERABLE FROM FACE OF DEVICE.
B. PROVIDE WITH SURFACE MOUNT FRAME KIT FOR MOUNTING IN HARD CEILING/WALL.
C. PROVIDE WITH OPPOSED BLADE DAMPER AND MILL FINISH.
D. PERFORATED SUPPLY AIR GRILLE TO BE INSTALLED WITHOUT DEFLECTORS.
E. PROVIDE WITH 2KW ELECTRIC HEAT, WALL MOUNTED WIRELESS THERMOSTAT.
F. PROVIDE WITH RETURN AIR LIGHT SHIELD.
G. PROVIDE WITH INSULATED BACKING
H. PROVIDE WITH FACTORY INSULATED SUPPLY PLENUM.

EXHAUST FAN SCHEDULE

MARK	MANUFACTURER	QUANTITY	MODEL	LOCATION/ MOUNTING	SERVICE	FAN				ELECTRICAL (V/PH)	WEIGHT (LBS)	NOTES
						CFM	ESP (IN)	RPM	HP/WATTS			
EF-A	GREENHECK	1	G-099	ROOF	RESTROOM EXHAUST	800	0.5	1435	1/4	120/1	100	A, B, E
EF-B	GREENHECK	3	GB-130	ROOF	BATTERY EXHAUST	2,000	0.5	1600	3/4	120/1	120	A, B, C, J
CEF-1	GREENHECK	2	SPA-190	CEILING	RESTROOM EXHAUST	150	0.25	800	50	120/1	25	A, E, H
CEF-2	GREENHECK	1	SPA-090	CEILING	RESTROOM EXHAUST	75	0.25	800	50	120/1	25	A, E, H

NOTES:

5719 LAWTON LOOP E. DR. #212
INDIANAPOLIS, IN 46216
O :: 317.288.0681
F :: 317.288.0753



NW CORNER OF
NE TUDOR RD & MAIN ST
LEE'S SUMMIT, MO 64086

NW CORNER OF
NE TUDOR RD & MAIN ST
LEE'S SUMMIT, MO 64086

210300

P0.0

C. FLOW-CONTROL, ELECTRIC, TANKLESS, DOMESTIC-WATER HEATERS:

1. STANDARD, UL 499 FOR ELECTRIC, TANKLESS, (DOMESTIC-WATER-HEATER) HEATING APPLIANCE.
2. CONSTRUCTION: COPPER FINING OR TUBING COMPLYING WITH NSF 61 AND NSF 372 BARRIER MATERIALS FOR POTABLE WATER, WITHOUT STORAGE CAPACITY.
- a. CAST: ALUMINUM OR STEEL WITH ENAMELED FINISH OR PLASTIC.
- b. PRESSURE RATING: 150 PSIG
- c. HEATING ELEMENT RESISTANCE HEATING SYSTEM.
- d. TEMPERATURE CONTROL, FLOW-CONTROL, FINISH.
- e. SAFETY CONTROL: HIGH-TEMPERATURE-LIMIT CUTOFF DEVICE OR SYSTEM.

3. SUPPORT, BRACKET FOR WALL MOUNTING.

- A. PROVIDE ALL LABOR, MATERIALS, EQUIPMENT, NECESSARY FOR THE COMPLETE INSTALLATION OF THE FUMING AND MECHANICAL SYSTEMS LISTED.
- B. OBTAIN ALL PERMITS, LICENSES, INSPECTIONS, AND CERTIFICATES OF COMPLIANCE OR APPROVAL AS REQUIRED BY THE AUTHORITIES.
- C. ALL WORK SHALL BE PERFORMED IN ACCORDANCE WITH ALL APPLICABLE LAWS, CODES AND REGULATIONS OF THE GOVERNMENTAL BODIES HAVING JURISDICTION OVER THE SITE.
- D. ALL TESTING REQUIRED BY AUTHORITIES SHALL BE CONSIDERED PART OF THIS WORK.
- E. DURING CONSTRUCTION, ALL FIXTURES, EQUIPMENT, PIPE, DUCT, ETC. SHALL BE COVERED, PLUGGED, OR CAPED AS REQUIRED TO KEEP CLEAN AND UNDAMAGED. ALL DAMAGED ITEMS SHALL BE RESTORED TO ORIGINAL CONDITION OR REPLACED. ALL PROTECTIVE COVERING SHALL BE REMOVED BEFORE FINAL ACCEPTANCE.
- F. PROVIDE ALL NECESSARY CUTTINGS AND PATCHING OF WALLS, FLOORS, CEILING, AND ROOFS AS NECESSARY. PATCH AROUND ALL OPENINGS SHALL MATCH ADJACENT AREA. COORDINATE ALL ROOFING WORK WITH OWNER OR RESPONSIBLE PARTY, SO THAT THE EXISTING ROOFING WARRANTY WILL BE MAINTAINED.
- G. CONTRACTOR SHALL GUARANTEE ALL WORK AND MATERIALS AGAINST DEFECTS FOR A PERIOD OF ONE YEAR FROM FINAL ACCEPTANCE.

2. OPERATION AND MAINTENANCE MANUALS:

- A. DURING THE COURSE OF CONSTRUCTION, COLLECT AND COMPILE OPERATING INSTRUCTIONS, WIRING DIAGRAMS, CATALOG CUTS, LUBRICATION AND PREVENTIVE MAINTENANCE INSTRUCTIONS, PARTS LISTS, ETC. FOR ALL EQUIPMENT, AND PROVIDE TO THE OWNER UPON COMPLETION OF THE CONTRACT.
- B. ALL LITERATURE AND INSTRUCTIONS SHIPPED WITH THE EQUIPMENT SHALL BE SAVED FOR INCLUSION IN THE OPERATION AND MAINTENANCE MANUALS.
- C. ALL LITERATURE LISTED ABOVE AND ALL PAPERS LISTING WARRANTIES, ETC., SHALL BE BOUND IN A 3-RING BINDER AND LABELLED WITH THE PROJECT NAME, ADDRESS, ARCHITECT, ENGINEER, CONTRACTORS, ETC.

A. MANUFACTURERS, MODEL NUMBERS, ETC. INDICATED OR SCHEDULED ON THE DRAWINGS SHALL BE INTERPRETED AS HAVING ESTABLISHED A STANDARD OF QUALITY AND SHALL NOT BE CONSTRUED AS LIMITING COMPETITION. ARTICLES, FIXTURES, ETC. OF EQUAL QUALITY BY MANUFACTURERS SHALL BE ACCEPTABLE, SUBJECT TO STRUCTURAL AND ELECTRICAL CONSTRAINTS OF THE PROJECT DESIGN, UNLESS NOTED OTHERWISE.

- A. ALL PIPING SHALL BE TESTED FOR LEAKS BEFORE BEING CONCEALED IN WALL CONSTRUCTION OR COVERED WITH INSULATION.
- B. SEWER AND VENT PIPING SHALL BE HYDROSTATICALLY TESTED WITH NO LESS THAN 10 FEET OF HEAD FOR A PERIOD OF NOT LESS THAN 15 MINUTES, PER THE LOCAL PLUMBING CODE, WITH NO LEAKS.
- C. DOMESTIC WATER PIPING SHALL BE HYDROSTATICALLY TESTED AT A PRESSURE OF NOT LESS THAN 1-1/2 TIMES THE OPERATING PRESSURE, BUT NOT LESS THAN 60 PSI, FOR A PERIOD OF NOT LESS THAN 2 HOURS, WITH NO LEAKS.
- D. NATURAL GAS PIPING SHALL BE PNEUMATICALLY TESTED AT A PRESSURE OF NOT LESS THAN 1-1/2 TIMES THE OPERATING PRESSURE, BUT NOT LESS THAN 50 PSI, FOR A PERIOD OF NOT LESS THAN 2 HOURS, WITH NO LEAKS.

SYSTEMS, INCLUDING THOSE FOR COLD WATER AND HOT WATER SYSTEMS, SHALL BE FLUSHED, STERILIZED AND CHLORINATED IN ACCORDANCE WITH HEALTH DEPARTMENT REGULATIONS. THE SYSTEM SHALL BE THOROUGHLY FLUSHED OF ALL DIRT AND FOREIGN MATTER, THEN FILLED WITH WATER TREATED WITH 50 PPM OF CHLORINE. DURING THE FILLING PROCESS, VALVES AND FAUCETS SHALL BE OPENED SEVERAL TIMES TO ASSURE TREATMENT OF THE ENTIRE SYSTEM. THE TREATED WATER SHALL BE LEFT IN THE SYSTEM FOR 24 HOURS AFTER WHICH TIME THE SYSTEM SHALL BE FLUSHED; IF THE RESIDUAL CHLORINE IS NOT LESS THAN 10 PPM, THE FLUSHING SHALL BE REPEATED. AFTER STERILIZATION, SAMPLES OF WATER IN THE SYSTEM SHALL BE APPROVED BY THE BOARD OF HEALTH.

- A. PROVIDE AN APPROVED WATER HAMMER ARRESTOR FOR EACH PLUMBING FIXTURE SUPPLY AS REQUIRED BY FIXTURE MANUFACTURER.
- B. ALL EXPOSED WASTE PIPE SHALL BE CHROME PLATED BRASS PIPE, NO FERROUS PIPE.
- C. PROVIDE CLEANOUTS AT EACH CHANGE OF DIRECTION AND AT 100 FOOT INTERVALS IN STRAIGHT RUNS.
- D. PROVIDE ACCESS PANELS FOR ALL CONCEALED VALVES AND TRAPS.
- E. CLEANOUTS:

- 1) VINYL TILE FLOOR: JR. SMITH #4140, OR EQUAL.
 - 2) QUARRY TILE FLOOR: JR. SMITH #4200, OR EQUAL.
 - 3) CARPETTED FLOOR: JR. SMITH #4020-Y, OR EQUAL.
 - 4) CAST IN PLACE CONCRETE FLOOR: JR. SMITH #4020, OR EQUAL.
 - 5) WALL: JR. SMITH #4412, OR EQUAL, 2" ABOVE THE FLOOR.
 - 6) WAREHOUSE FLOORS/FORK TRUCK AREAS: JR. SMITH #4100, OR EQUAL, WITH HEAVY CAST IRON BODIES TO TOP OF GRADE.
 - 7) GRADE: JR. SMITH #4256, OR EQUAL, WITH HEAVY DUTY CAST IRON BODY AND COVER.
- PROVIDE DIELECTRIC UNIONS WITH APPROPRIATE END CONNECTIONS TO MATCH THE PIPE SYSTEM IN ALL INSTANTANEOUSLY SOLIDIFIED OR EXPANDED. PROVIDE DIELECTRIC UNIONS ON ALL FIFTH INCH DIAMETERS TO 10" DIA. AND EXPANDED.

- 1) EVERY WATER HEATER SHALL HAVE AN APPROVED MEANS INSTALLED ON THE COLD WATER SUPPLY LINE ABOVE THE EQUIPMENT TO PREVENT SIPHONING OF A STORAGE WATER HEATER OR TANK.
- 2) BOTTOM FED WATER HEATERS AND TANKS CONNECT TO WATER HEATERS SHALL HAVE A VACUUM RELIEF VALVE INSTALLED. ANSI Z21.22.
- 3) STORAGE HEATERS OPERATING ABOVE ATMOSPHERIC PRESSURE SHALL HAVE AN APPROVED PRESSURE RELIEF VALVE AND/OR TEMPERATURE RELIEF VALVE.

- 1) INSTALL 2-1/2" AND SMALLER PIPE AT 1/4" PER FOOT FALL.
- 2) INSTALL 3" - 6" PIPE AT 1/8" PER FOOT FALL.
- 3) INSTALL 8" AND LARGER PIPE AT 1/16" PER FOOT FALL.

A. DOMESTIC COLD, HOT, AND HOT WATER REGULATOR (ABOVEGROUND).

1. TYPE I HARD DRAWN COPPER TUBING, ASTM B-88.

2. ANSUGRUP COPPER SOLDERED FITTINGS, ASTM B76 ALLOY C12200; ANS B16.21, MSS SP-104.

3. MECHANICAL, FREQUENCY-INDUCED STRESS IN FITTINGS FOR FLOWING OR MECHANICAL APPLICATIONS, ASME B16.21, ASME B16.51, or ASME B16.10. MECHANICAL PRESSURE FITTINGS MUST CONFORM TO API P-111 OR ASME B16.51.

4. FROM PLASTIC DENSITY CROSS-LINKED POLYETHYLENE TUBING SHALL BE MANUFACTURED TO THE REQUIREMENTS OF ANSI F616 AND MEET THE STANDARD GRADE HYDROSTATIC PRESSURE RATING OF THE PLASTIC PIPE SUBSTITUTE IN ACCORDANCE WITH THE FOLLOWING:

(MUST BE INSTALLED PER THE MANUFACTURERS REQUIREMENTS FOR FLENUM USE)

a. PE-XA AND PE-XB MEETINGS ANSI/FNSF61 AND ANSI/FNSP32 STANDARDS FOR POTABLE WATER SAFETY AND LEAK-FREE JOINTS AND MUST BE MARKED "PE-XA NSF-61" OR OTHER NSF-APPROVED MARKING. ASTM F2923 FOR USE WITH CHLORINATED WATER.

b. MUST BE INSTALLED PER THE MANUFACTURERS REQUIREMENTS FOR FLENUM USE)

5. MECHANICAL, FREQUENCY-INDUCED STRESS IN FITTINGS FOR FLOWING OR MECHANICAL APPLICATIONS INSTRUCTIONS: PIPE SIZES GIVEN ON THE DRAWINGS ARE NOMINAL COPPER PIPE SIZE. INCREASE PIPE FITTING SIZE TO EQUAL OR EXCEED COPPER PIPE INSIDE DIAMETER FOR SUPPLY MAINS. MUST BE INSTALLED PER THE MANUFACTURERS REQUIREMENTS FOR FLENUM USE

a) TO BE INSTALLED ON THE FIXTURE SUPPLY TO EACH PLUMBING FIXTURE.
b) TO BE INSTALLED ON THE WATER SUPPLY SIDE TO EACH APPLIANCE OR MECHANICAL EQUIPMENT.
c) TYPES:
1. GATE VALVE: JOMAR T/5-30" OR EQUAL LEAD-FREE NSF 61, ANSI B1.20.1.
2. GLOBE VALVE: JOMAR TGG OR EQUAL.
3. BALL VALVE: JOMAR JPI00XP OR EQUAL COMPACT LEAD FREE BRASS BALL VALVE.
UL842, CSA 3371-12 & 3371-42, FM, CALIFORNIA CODE AB1193, NSF61 ANNEX G APPROVED.
4. BALL VALVE: JOMAR T-100NE OR EQUAL. UL842, FM, CSA, NSF 61-8, MSS SP-110

1) TYPE I HARD DRAWN COPPER TUBING, ASTM B-88
a) WROUGHT COPPER SOLDERED FITTINGS, ASTM B75 ALLOY C12200, ANSI B16.22, M56 SP-104.
b) MECHANICAL PRESS COPPER FITTINGS FOR USE IN PLUMBING OR MECHANICAL APPLICATIONS, ASME B16.22, ASME B16.51, or ASME B16.18. MECHANICAL PRESS COPPER FITTINGS SHALL CONFORM TO NIPRO PS-117 OR ASME B16.51.
2) HIGH DENSITY CROSS-LINKED POLYETHYLENE TUBING SHALL BE MANUFACTURED TO THE REQUIREMENTS OF ASTM F796 AND MEET THE STANDARD REQUIREMENTS FOR HYDROSTATIC PRESSURE RATINGS FROM PLASTIC PIPE INSTITUTE IN ACCORDANCE WITH TR-0023.
a) PE-XA AND PE-XB MEETINGS ANSI/NSF61 AND ANSI/NSF312 STANDARDS FOR POTABLE WATER SAFETY AND LEAD-FREE STANDARDS AND MUST BE MARKED WITH "PVL-6", "NSF-61-6" OR OTHER NSF-APPROVED MARKING, ASTM F796, FOR CHLORINE RESISTANCE.
b) PE MECHANICAL CRIMP/INSERT OR EXPANSION FITTINGS INSTALLED IN ACCORDANCE WITH MANUFACTURER'S INSTRUCTIONS. PIPE SIZES GIVEN ON THE DRAWINGS ARE NOMINAL COPPER PIPE SIZE.
c) MECHANICAL PRESS FITTING, SOLDERED FITTING, OR EXCEED COPPER PIPE INSIDE DIAMETER FOR SUPPLY MAINS.
d) HDPE, PIGMENTED BLUE THROUGHOUT, GTS SIZES 11-2" AWWA C900, 4710 DR19 PC250
PS SIZES 2-3", AWWA C900, 4710 DR11 PC200.

- 1) TYPE K SOFT DRAWN COPPER TUBING, ASTM B-88.
 - a) Cast Copper Alloy Fittings for Flared Copper Tube, ASME/ANSI B16.26:
- 2) HDPE, PIGMENTED BLUE THROUGHOUT, CTS SIZES 1"-2" ANNA C901 4710 DR9 PC250 IPS SIZES 2'-3", ANNA C901 4710 DR11 PC200

MATERIAL AND INSTALLATION SHALL CONFORM TO WATER DEPARTMENT REQUIREMENTS.

- 1) PIPE AND PIPE FITTINGS, INCLUDING VALVES AND FAUCETS, UTILIZED IN THE WATER SUPPLY SYSTEM SHALL NOT HAVE MORE THAN 8% LEAD CONTENT.
- 2) PIPE, PIPE FITTINGS, JOINTS, VALVES, FAUCETS, AND FIXTURE FITTINGS UTILIZED TO SUPPLY WATER FOR DRINKING OR COOKING PURPOSES SHALL COMPLY WITH NSF 372 AND SHALL HAVE A WEIGHTED AVERAGE LEAD CONTENT OF 0.25% OR LESS.

- 1) ABS SCHEDULE 40 CELLULAR CORE (FOAM CORE) PIPE AND DWTY FITTING SYSTEM(ASTM F1488)
PIPE AND FITTINGS SHALL BE MANUFACTURED FROM ABS COMPOUND WITH A GELL CLASS OF 42222 FOR
PCV E AND 32222 FOR FITTINGS AS PER ASTM D 2665 AND CONFORM WITH NATIONAL SANITATION
FOUNDATION (NSF) STANDARD 14. PIPE SHALL BE IRON PIPE SIZE (IPS) CONFORMING TO ASTM D 2235.
FITTINGS SHALL CONFORM TO ASTM D 2661. SOLVENT CEMENTS SHALL CONFORM TO ASTM D 2235.
2) PVC SCHEDULE 40 CELLULAR CORE (FOAM CORE) PIPE AND DWTY FITTING SYSTEM(ASTM F1488)
PIPE AND FITTINGS SHALL BE MANUFACTURED FROM PVC COMPOUND WITH A GELL CLASS OF 12454 FOR
PCV D 4536 FOR PIPE AND 12454 PER ASTM D 1784 FOR FITTINGS AND CONFORM WITH NATIONAL
SANITATION FOUNDATION (NSF) STANDARD 14. PIPE SHALL BE IRON PIPE SIZE (IPS) CONFORMING TO
ASTM F 941. INJECTION MOLDED FITTINGS SHALL CONFORM TO ASTM D 2665. FABRICATED FITTINGS
SHALL CONFORM TO ASTM D 1866. SOLVENT CEMENTS SHALL CONFORM TO ASTM D 2564.
3) PVC SCHEDULE 40 SOLID WALL PIPE AND DWTY FITTING SYSTEM(ASTM D2665)
PIPE AND FITTINGS SHALL BE MANUFACTURED FROM PVC COMPOUND WITH A GELL CLASS OF 12454 PER
ASTM D 1866 AND 12454 PER ASTM D 1784 FOR FITTINGS AND CONFORM WITH NATIONAL
SANITATION FOUNDATION (NSF) STANDARD 14. PIPE SHALL BE IRON PIPE SIZE (IPS) CONFORMING TO
ASTM D 1785 AND ASTM D 2665. INJECTION
MOLDED FITTINGS SHALL CONFORM TO ASTM D 2665. FABRICATED FITTINGS SHALL CONFORM TO
ASTM F 1866. SOLVENT CEMENTS SHALL CONFORM TO ASTM D 2564.
4) GRAY CAST IRON RIGID JOINT PIPE AND FITTINGS:
PIPE AND FITTINGS SHALL BE MANUFACTURED FROM GRAY CAST IRON PIPE AND FITTINGS SHALL BE
MANUFACTURED FROM GRAY CAST IRON AND SHALL CONFORM TO ASTM A 880 AND CISPI STANDARD 310,
HUBLESS COUPLINGS SHALL CONFORM TO CISPI STANDARD 310 AND BE CERTIFIED BY NSF6 INTERNATIONAL.
HUB-ON END COUPLERS SHALL CONFORM TO CISPI STANDARDS, HUB-ON END COUPLERS AND FITTINGS
SHALL BE MANUFACTURED FROM GRAY CAST IRON AND SHALL CONFORM TO ASTM A 14.

- 1) ABS SCHEDULE 40 CULAR CORE (FOAM CORE) PIPE AND DIVY FITTING SYSTEM(ASTM F1486)
PIPE AND FITTINGS SHALL BE MANUFACTURED FROM ABS COMPOUND WITH A CELL CLASS OF 42222 FOR
42222 FITTING SHALL CONFORM TO ASTM D 2961.
FOUNDATION (NSP) STANDARD 14. PIPE SHALL BE IRON PIPE SIZE (IPS) CONFORMING TO ASTM F 628.
FITTINGS SHALL CONFORM TO ASTM D 2961.
SOLENT CEMENTS SHALL CONFORM TO ASTM D 220.
- 2) PVC SCHEDULE 40 CELLULAR CORE (FOAM CORE) PIPE AND DIVY FITTING SYSTEM(ASTM F1486)
PIPE AND FITTINGS SHALL BE MANUFACTURED FROM PVC COMPOUND WITH A CELL CLASS OF 11432 PER
ASTM D 2961.
FOUNDATION (NSP) STANDARD 14. PIPE SHALL BE IRON PIPE SIZE (IPS) CONFORMING TO
ASTM F 628.
FITTINGS SHALL CONFORM TO ASTM F 1866.
SOLENT CEMENTS SHALL CONFORM TO ASTM D 2264.

- (NOT FOR USE IN A RETURN AIR PLenum)
- 3) HUB AND SPIGOT CAST IRON PIPE AND FITTINGS: FIBERGLASS SYSTEM (ASTM D 2665).
- 4) HUB AND SPIGOT CAST IRON PIPE AND FITTINGS: HUB AND SPIGOT CAST IRON PIPE AND FITTINGS SHALL BE MANUFACTURED FROM PVC COMPOUND WITH A GELL CLASS OF 12454 PEE ASTM D 1184 AND CONFORM WITH NATIONAL SANITATION FOUNDATION (NSF) STANDARD 14. FITTINGS SHALL CONFORM TO NSF STANDARD 12.5. HUB AND SPIGOT CAST IRON PIPE AND FITTINGS SHALL CONFORM TO ASTM F 136. MOLDED FITTINGS SHALL CONFORM TO ASTM D 2665. FABRICATED FITTINGS SHALL CONFORM TO ASTM F 136. HUB AND SPIGOT CAST IRON PIPE AND FITTINGS SHALL BE CERTIFIED BY LOCAL JURISDICTIONS TO CONFORM TO ASTM D 2564. (WHERE APPROVED BY LOCAL JURISDICTIONS).
- (NOT FOR USE IN A RETURN AIR PLenum)
- 4) HUBLESS CAST IRON SOIL PIPE AND FITTINGS: HUBLESS CAST IRON PIPE AND FITTINGS SHALL BE MANUFACTURED FROM PVC COMPOUND WITH A GELL CLASS OF 12454 PEE ASTM D 1184 AND CONFORM WITH NATIONAL SANITATION FOUNDATION (NSF) STANDARD 301. HUBLESS COUPLINGS SHALL CONFORM TO GSI# STANDARD 310 AND BE CERTIFIED BY NSF# INTERNATIONAL. HUB AND SPIGOT CAST IRON SOIL PIPE AND FITTINGS: HUB AND SPIGOT CAST IRON PIPE AND FITTINGS SHALL BE MANUFACTURED FROM PVC COMPOUND WITH A GELL CLASS OF 12454 PEE ASTM D 1184 AND CONFORM WITH NATIONAL SANITATION FOUNDATION (NSF) STANDARD 301. HUBLESS COUPLINGS SHALL CONFORM TO GSI# STANDARD 310 AND BE CERTIFIED BY NSF# INTERNATIONAL.

1. ABS SCHEDULE 40 CELLULAR CORE (FOAM CORE) PIPE AND DWV FITTING SYSTEM: (ASTM F1488)
PIPE AND FITTINGS SHALL BE MANUFACTURED FROM ABS COMPOUND WITH A CELL GLOSS OF 42222 FOR PIPE AND 32222 FOR FITTINGS AS PER ASTM D 2465 AND CONFORM WITH NATIONAL SANITATION FOUNDATION (NSF) STANDARD 141. PIPE SHALL BE IRON PIPE SIZE (IPS) CONFORMING TO ASTM D 2554. FITTINGS SHALL CONFORM TO ASTM D 2554.
2. PVC SCHEDULE 40 CELLULAR CORE (FOAM CORE) PIPE AND DWV FITTING SYSTEM: (ASTM F1488)
PIPE AND FITTINGS SHALL BE MANUFACTURED FROM PVC COMPOUND WITH A CELL GLOSS OF 11452 PER ASTM D 4536 FOR PIPE AND 12454 PER ASTM D 1734 FOR FITTINGS AND CONFORM WITH NATIONAL SANITATION FOUNDATION (NSF) STANDARD 141. PIPE SHALL BE IRON PIPE SIZE (IPS) CONFORMING TO ASTM F 341. INJECTION MOLDED FITTINGS SHALL CONFORM TO ASTM F 734. FABRICATED FITTINGS SHALL CONFORM TO ASTM F 734. SOLVENT CEMENT SHALL CONFORM TO ASTM D 2554.
3. PVC SCHEDULE 40 SOLID WALL PIPE AND DWV FITTING SYSTEM: (ASTM D 2665)
PIPE AND FITTINGS SHALL BE MANUFACTURED FROM PVC COMPOUND WITH A CELL GLOSS OF 12454 PER ASTM D 4536 AND 12454 PER ASTM D 1734 FOR FITTINGS AND CONFORM WITH NATIONAL SANITATION FOUNDATION (NSF) STANDARD 141. PIPE SHALL BE IRON PIPE SIZE (IPS) CONFORMING TO ASTM F 341. FITTINGS SHALL CONFORM TO ASTM F 734. SOLVENT CEMENT SHALL CONFORM TO ASTM D 2554.
4. HUBLESS CAST IRON SOL. PIPE AND FITTINGS: HUBLESS CAST IRON PIPE AND FITTINGS SHALL BE MANUFACTURED FROM CAST IRON CONFORMING TO ASTM A 153 AND GISE STANDARD 301. HUBLESS COUPLINGS SHALL CONFORM TO GISE STANDARD 310 AND BE CERTIFIED BY NSF6 INTERNATIONAL. HUB AND SPIGOT CAST IRON SOL. PIPE AND FITTINGS: HUB AND SPIGOT CAST IRON PIPE AND FITTINGS SHALL BE MANUFACTURED FROM CAST IRON CONFORMING TO ASTM A 153 AND GISE STANDARD 301.
5. COPPER DWV, DRAINAGE TUBE SHALL CONFORM TO ASTM B306, BROUGHT COPPER FITTINGS, ANSI B-16.24.
6. GALVANIZED STEEL PIPE, WITH MALLEABLE IRON, THREADED FITTINGS, DRAINAGE PATTERN FOR SEWERS SHALL CONFORM TO ASTM A 53.

- 1) BLACK STEEL PIPE, SCHEDULE 40, ASTM A53.
- a) PIPE 3" AND SMALLER: 150 LB. MALLEABLE IRON, THREADED FITTINGS.
- b) PIPE 4" & SMALLER: VIEGA MESA PRESS G. FOR WATER AND GAS, CSA LC4, TSSA/ASME B31 FOR USE WITH ASTM A53 SCHEDULE 40 BLACK IRON PIPE.
- c) PIPE 5-1/2" AND LARGER: WELDED.
- d) PLUG VALVE: ROCKWELL NORDSTROM FIGURE NO. 142 OR 143.
- e) BALL VALVE: JOMAR T-100NE, APPROVALS: UL842, FM, CSA NSF-61, MSS SP-110

- 2) GAS PIPING LABELING:
 - a) ALL ELEVATED PRESSURE GAS PIPING SHALL BE LABELED EVERY 40 FEET WITH SIGNS INDICATING "ELEVATED PRESSURE".
- 3) GAS PIPING PAINTING:
 - a) ALL BLACK STEEL GAS PIPING LOCATED EXTERIOR TO THE BUILDING SHALL BE PRIMED AND PAINTED TO EITHER MATCH ADJACENT EXTERIOR WHERE LOCATED ON OR NEAR EXTERIOR WALL AND PAINTED SAFETY YELLOW WHERE LOCATED ON THE ROOF.

ALL FILE HANGERS AND SUPPORTS SHALL BE STANDARD PRODUCTS OF CRINELL, FILE AND PAPER, OR ELGEN. HANGER SPACING SHALL BE IN ACCORDANCE WITH MSS-SP-69.

1. PROVIDE BENT, AND PROPERLY LOCATED PIPE SLEEVES AS REQUIRED FOR THIS WORK. ALL SLEEVES SHALL BE SIZED TO ALLOW SUFFICIENT PIPE MOVEMENT DUE TO EXPANSION AND CONTRACTION AND TO ACCOMMODATE PIPE INSULATION.
2. INTERIOR PARTITIONS: 16 GAUGE GALVANIZED STEEL, PACK BETWEEN PIPE AND SLEEVE WITH FIRE RESISTANT GROUT. SLEEVES SHALL BE SIZED TO ALLOW SUFFICIENT PIPE MOVEMENT.
3. ROOF, ROOFLET OR EQUAL MANUFACTURED PIPE SCHEDULE 40 PIPE SLEEVE WITH WATERPROOF SEAL. COORDINATE WITH ROOFING CONTRACTOR AND FLASH AS REQUIRED TO MAINTAIN ROOF WARRANTY.
4. PROTECTION AGAINST CONTACT: METALLIC FLASH, EXCEPT FOR CAST IRON, DUCTILE IRON AND GALVA STEEL SHALL NOT BE PLACED IN DIRECT CONTACT WITH STEEL FRAMING MEMBERS, CONCRETE, OR GROUND SURFACES OR OTHER MATERIALS. SHEATHINGS SHALL BE PLACED OVER ALL SURFACES OF WALL, FLOOR OR SOIL. SHEATHINGS USED TO PREVENT DIRECT CONTACT SHALL HAVE A THICKNESS OF GREATER THAN .01". SHEATHINGS SHALL BE MADE OF PLASTIC, ANY PIPE THAT PASSES THROUGH A FOUNDATION WALL OR FLOOR SHALL BE SIZED WITH THE PIPE PASSING THROUGH THE FOUNDATION WALL OR FLOOR. THE PIPE SHALL BE TWO SIZES GREATER THAN THE PIPE PASSING THROUGH THE WALL OR FOOTING.
5. PLUMBING VENTS: FLASH ROOF VENT INTO ROOFING SYSTEM AS REQUIRED BY THE ROOFING CONTRACTOR TO MAINTAIN EXISTING ROOF WARRANTY. ALL PLUMBING VENT TERMINALS SHALL BE SIZED TO MAINTAIN A MINIMUM OF 12" CLEARANCE FROM ALL SURFACES. ALL SLEEVES GREATER

- 1) PARKER TRANSAIR PIPING, EXTRUDED ALUMINUM PIPE, CONFORMS TO ASTM B241.
 - a) PARKER TRANSAIR FITTINGS CONFORMING TO UL94HB
 - b) PARKER TRANSAIR MOUNTING CLIPS, CONFORMING TO UL94V-2
- 2) TYPE L HARD DRAWN COPPER TUBING, ASTM B-88.
 - a) WROUGHT BRONZE SOLDERED FITTINGS,

A. COMMERCIAL, LIGHT-DUTY, STORAGE, ELECTRIC, DOMESTIC-WATER HEATERS
1. STANDARD: UL 174

2. STORAGE-TANK CONSTRUCTION: STEEL, VERTICAL ARRANGEMENT.
- a. PRESSURE RATING: 150 PSIG.
 - b. INTERIOR FINISH: COMPLY WITH NSF 61 AND NSF 372 BARRIER MATERIALS FOR POTABLE-WATER TANK LINNINGS, INCLUDING EXTENDING LINING MATERIAL INTO TAPPINGS.
3. FACTORY-INSTALLED, STORAGE-TANK APPURTENANCES:
- a. ANODE ROD: REPLACEABLE MAGNESIUM.
 - b. DIP TUBE: REQUIRED UNLESS COLD-WATER INLET IS NEAR BOTTOM OF TANK.
 - c. DRAIN VALVE: CORROSION-RESISTANT METAL WITH HOSE-END CONNECTION.
 - d. INSULATION: COMPLY WITH ASHRAE'S 90.1.
 - e. JACKET, STEEL WITH ENAMELED FINISH OR HIGH-IMPACT COMPOSITE MATERIAL.
 - f. HEAT-TRAP FITTINGS: INLET TYPE IN COLD-WATER INLET AND OUTLET TYPE IN HOT-WATER OUTLET.
 - g. HEATING ELEMENTS: ELECTRIC, SCREW-IN IMMERSION TYPE.
 - h. TEMPERATURE CONTROL: ADJUSTABLE THERMOSTAT.
 - i. SAFETY CONTROL: HIGH-TEMPERATURE-LIMIT CUTOFF DEVICE OR SYSTEM.
 - j. RELIEF VALVE: ASME RATED AND STAMPED FOR COMBINATION TEMPERATURE-AND-PRESSURE RELIEF VALVES INCLUDE RELIEVING CAPACITY AT LEAST AS GREAT AS HEAT INPUT, AND INCLUDE PRESSURE RATING LESS THAN THE DESIGN PRESSURE RATING OF DRIFT-STOP HEAT INPUT. SELECT RELIEF VALVE WITH SENSING ELEMENT THAT EXTENDS INTO STORAGE TANK.

- ### 3. DOMESTIC-WATER EXPANSION TANKS:

1. DESCRIPTION: STEEL, PRESSURE-RATING TANK CONSTRUCTED WITH WELDED JOINTS AND FACTORY-INSTALLED BUTYL-RUBBER DIAPHRAGM. INCLUDE AIR PRECHARGE TO MINIMUM SYSTEM-OPERATING PRESSURE AT TANK.
2. CONSTRUCTION:
 - a. TAPPINGS: FACTORY-FABRICATED STEEL, WELDED TO TANK BEFORE TESTING AND LABELING, INCLUDE ASME B120.1 PIPES THREAD.
 - b. INTERCOMPARTMENT COMPARTMENT: 61 AND NSF 372 BARRIER MATERIALS FOR POTABLE-WATER TANK LININGS, INCLUDING EXTENDING FINISH INTO AND THROUGH TANK FITTINGS AND OUTLETS.
 - c. AIR-CHARGING VALVE: FACTORY-INSTALLED.
3. CAPACITY AND CHARACTERISTICS:
 - a. WORKING-PRESSURE RATING: 150 PSIG.


PLUMBING, HEATING & AIR CONDITIONING, INC

201 East Walnut
Cleveland, MO 64734
816-942-6355

This drawing has been prepared by the Engineer, or under his supervision. This drawing is provided as an instrument of service by the Designer/Engineer and is intended for use on this project only. Pursuant to the Architectural Works Copyright Protection Act of 1990, all drawings, specifications, ideas and designs, including the overall form, arrangement and composition of spaces and elements appearing herein, constitute the original, copyrighted work of the Designer/Engineer. Any reproduction, use, or disclosure of information contained herein without prior written consent of the Engineer is strictly prohibited. © 2022 CC Engineers, Inc.


BC ENGINEERS
INCORPORATED

5720 Reeder Shawnee, KS 66203 (913)262-1772

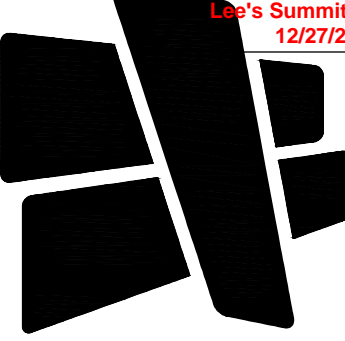

CURRAN
ARCHITECTURE

5719 LAWTON LOOP E. DR. #212
INDIANAPOLIS, IN 46216
O :: 317 . 288 . 0681
F :: 317 . 288 . 0753

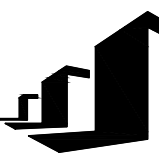

SCANNELL
PROPERTIES

4/26/2022



LEE'S SUMMIT LOGISTICS
BUILDING A LOT I

NW CORNER OF
NE TUDOR RD & MAIN ST
LEE'S SUMMIT, MO 64086

PERMIT SET 02.18.22

210300

PLUMBING PLAN
AREA A


P100

PLUMBING GENERAL NOTES:

1. INSTALL ALL PIPE, ETC., AS HIGH AS POSSIBLE.
2. COORDINATE ALL WORK WITH OTHER TRADES AND EXISTING CONDITIONS AS REQUIRED TO PROPERLY INSTALL ALL SYSTEMS AS INTENDED, WITHIN THE CONFINES OF THE SPACES AVAILABLE, AND WITHOUT INTERFERENCES.
3. REFER TO ARCHITECTURAL DRAWINGS FOR EXACT LOCATIONS AND MOUNTING HEIGHTS OF FIXTURES.
4. REFER TO ARCHITECTURAL & STRUCTURAL DRAWINGS FOR REQUIREMENTS FOR SUPPORTING PIPING, EQUIPMENT, ETC., FROM THE STRUCTURE. PROVIDE ADDITIONAL STEEL AS REQUIRED TO PROPERLY SUPPORT SYSTEMS FROM THE STRUCTURE.
5. NO PIPING SHALL BE ROUTED OVER THE TOP OF ELECTRICAL PANELS.


PLUMBING SYMBOLS:

- SOIL AND WASTE PIPING BELOW FLOOR/GRADE
- SOIL AND WASTE PIPING ABOVE FLOOR/GRADE
- SANITARY VENT PIPING ABOVE GRADE
- SANITARY VENT PIPING BELOW GRADE
- DOMESTIC COLD WATER PIPING
- GAS PIPING
- FORCE MAIN PIPING BELOW FLOOR/GRADE
- PIPING TURNING DOWN
- PIPING TURNING UP
- TEE TOP CONNECTION
- UNION
- FLOOR CLEAN OUT
- WALL CLEAN OUT
- GRADE CLEAN OUT
- VALVE
- PRESSURE REGULATOR
- CONNECT TO EXISTING
- I.E. INVERT ELEVATION OF PIPE
- MATCH MARKS ON PLUMBING RISER DIAGRAM

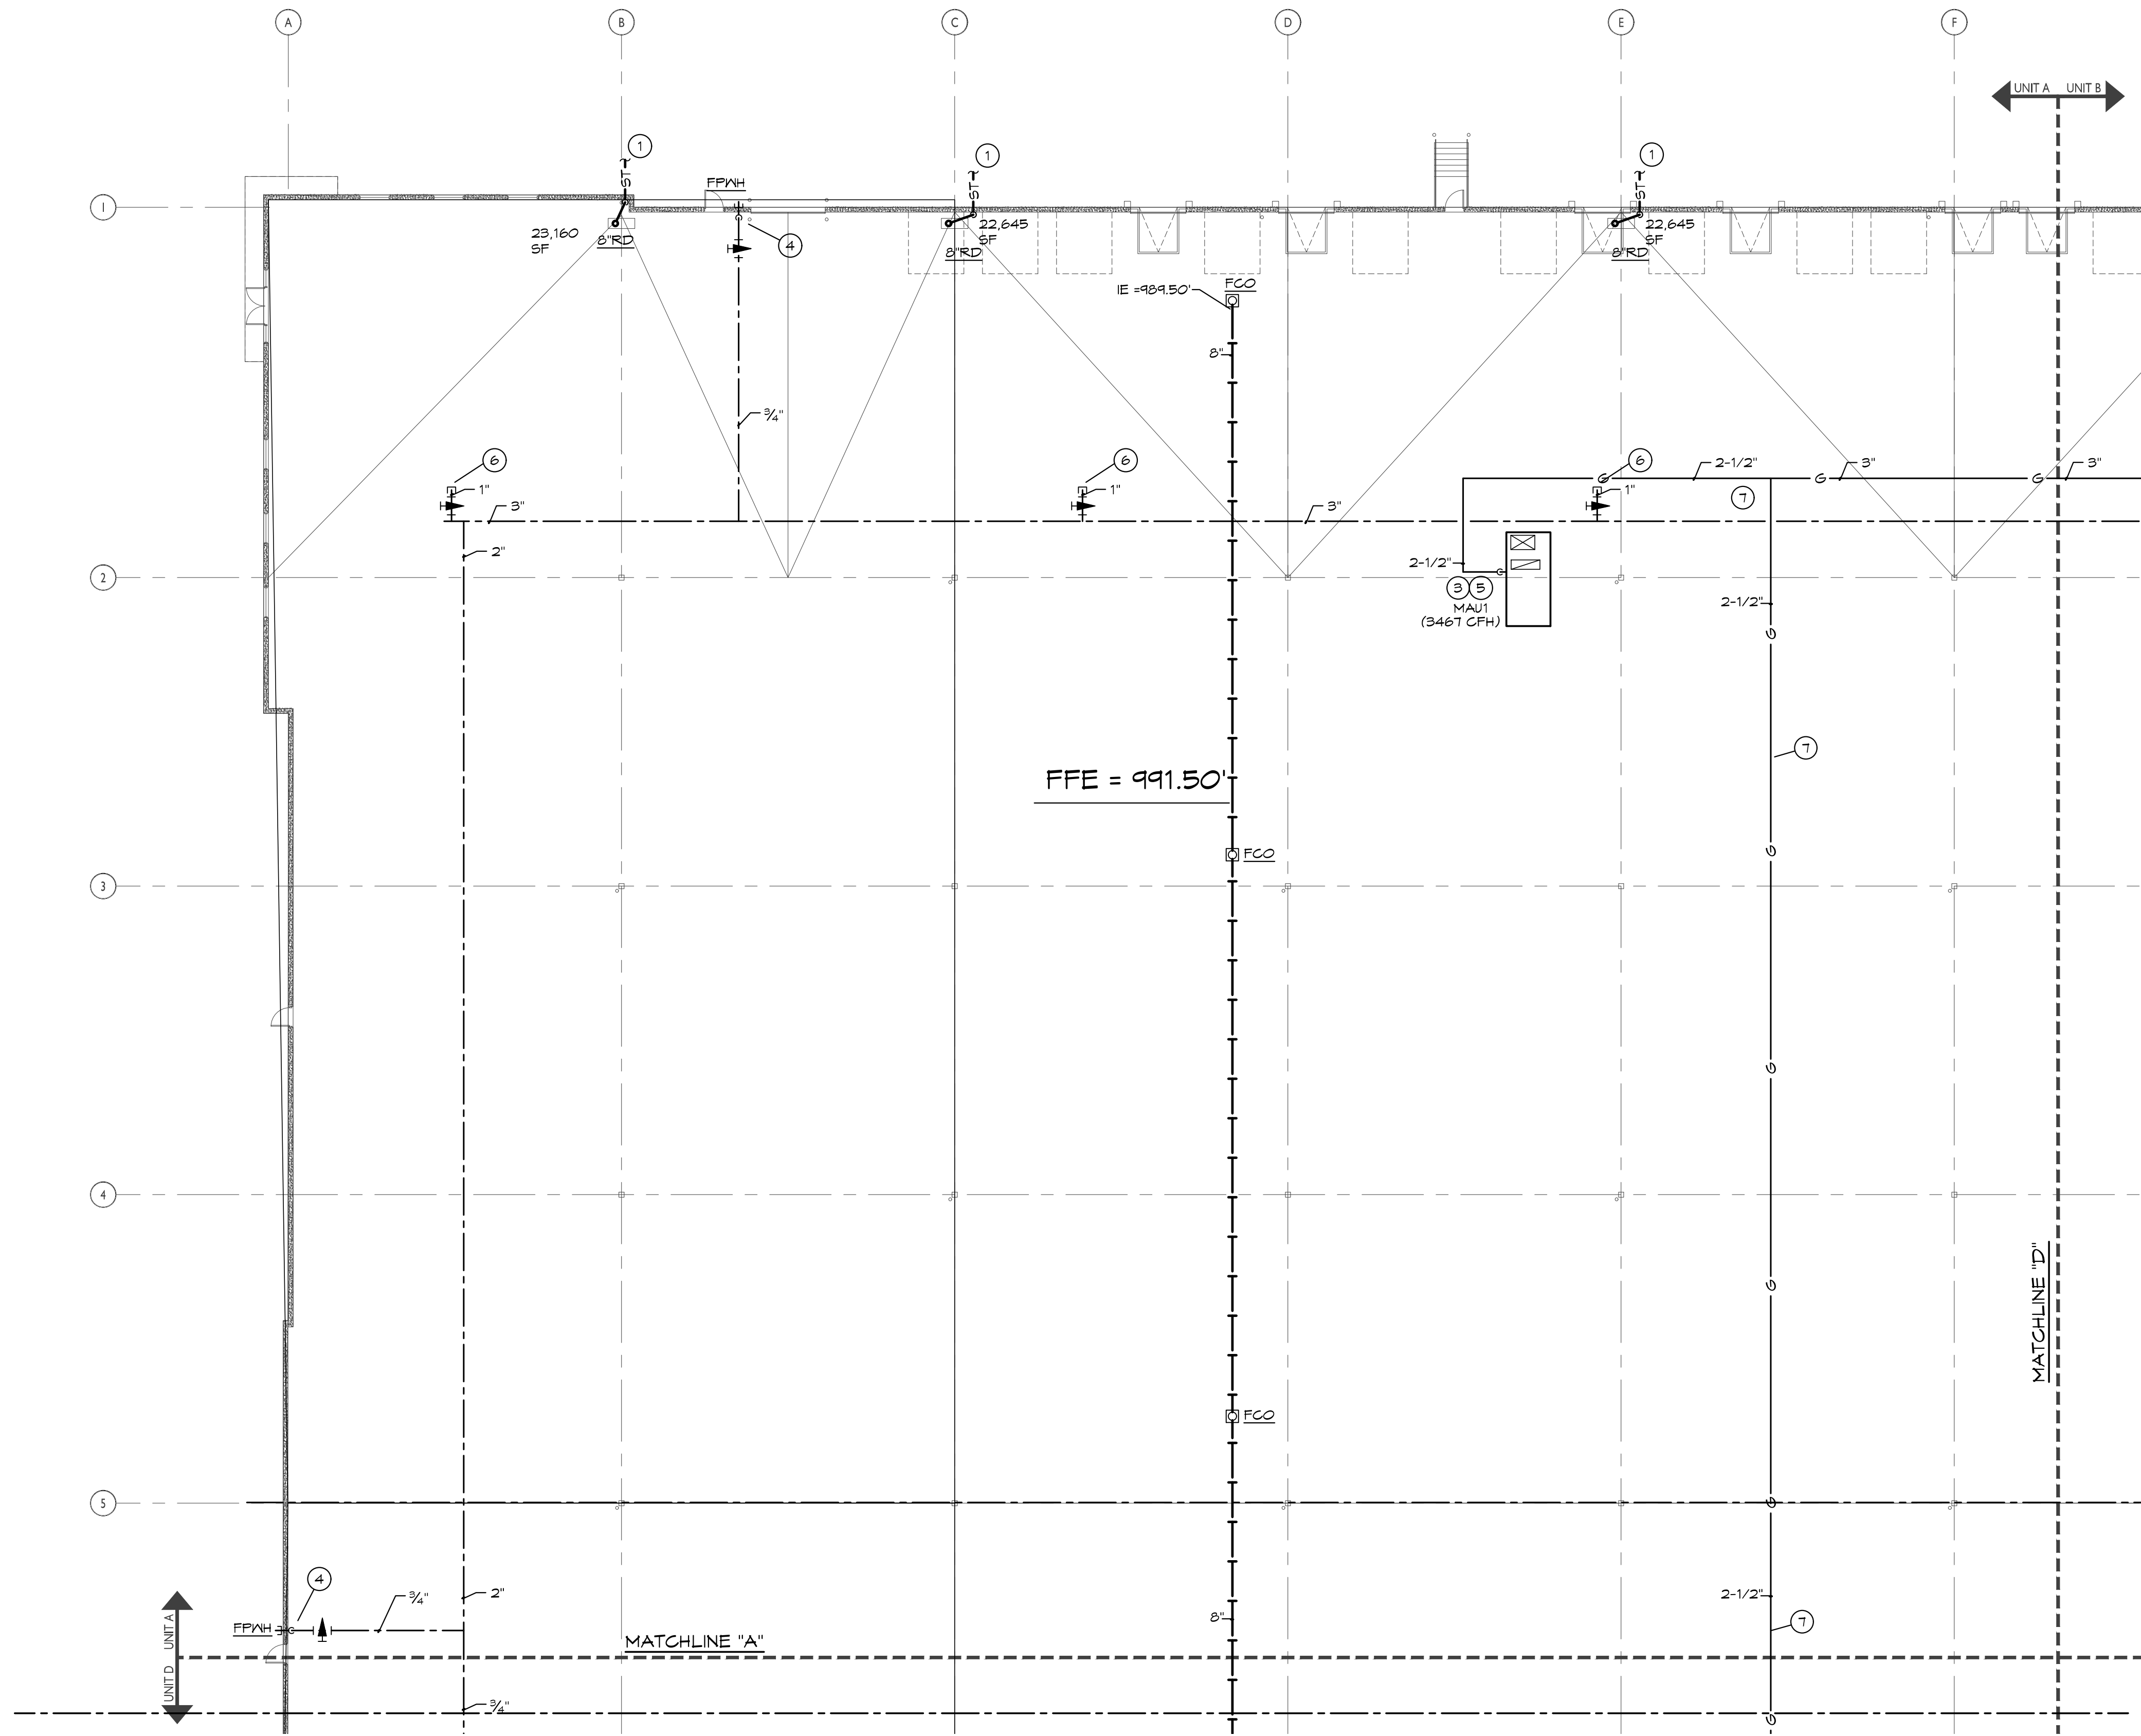


PLUMBING PLAN NOTES:

1. REFER TO CIVIL FOR 8" STORM PIPE. MAINTAIN A MIN. OF 24" COVER.
2. REFER TO CIVIL FOR 8" WASTE PIPE. MAINTAIN A MIN. OF 30" COVER.
3. GAS PIPE UP THROUGH ROOF TO MAU CONNECTION. SEAL PENETRATION WEATHER TIGHT.
4. INSTALL FREEZE PROOF WALL HYDRANT 18" ABOVE GRADE.
5. CONNECT GAS PIPING TO EQUIPMENT AS DETAILED.
6. CAP 1" WATER PIPE WITH SHUT-OFF VALVE FOR FUTURE CONNECTION.
7. GAS PIPING BELOW ROOF SUPPORT AS REQUIRED.
8. GAS PIPING ON ROOF. SUPPORT AS REQUIRED AND DETAILED.

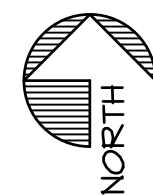

PARTIAL PLUMBING FLOOR PLAN "UNIT A"
SCALE: 1/16" = 1'-0"
FFE = 991.50'

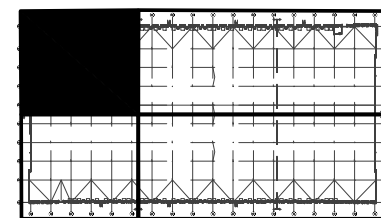

KEY PLAN
SCALE: NTS

CENTRAL
PLUMBING, HEATING & AIR CONDITIONING, INC.
201 East Walnut
Cleveland, MO 64734
816-942-6355


BC PROJECT #22208
MISSOURI PE COA #2009003629
This drawing has been prepared by the Engineer, or under his supervision. This drawing is provided as an instrument of service by the Designer/Engineer and is intended for use on the project only. Pursuant to the Architectural Works Copyright Protection Act of 1990, all drawings, specifications, ideas and designs, including the serial form, arrangement and composition of spaces and elements appearing herein, constitute the original, copyrighted work of the Designer/Engineer. Any reproduction, use, or disclosure of information contained herein without prior written consent of the Engineer is strictly prohibited. © 2022 BC Engineers, Inc.

BC ENGINEERS
INCORPORATED

5720 Reeder Shawnee, KS 66203 (913)262-1772



CURRAN
ARCHITECTURE
5719 LAWTON LOOP E. DR. #212
INDIANAPOLIS, IN 46216
O :: 317 . 288 . 0681
F :: 317 . 288 . 0753

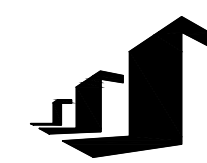

SCANNELL
PROPERTIES

4/26/2022




LEE'S SUMMIT LOGISTICS
BUILDING A LOT 1
NW CORNER OF
NE TUDOR RD & MAIN ST
LEE'S SUMMIT, MO 64086


PERMIT SET 02.18.22

210300
PLUMBING PLAN
AREA B


P101

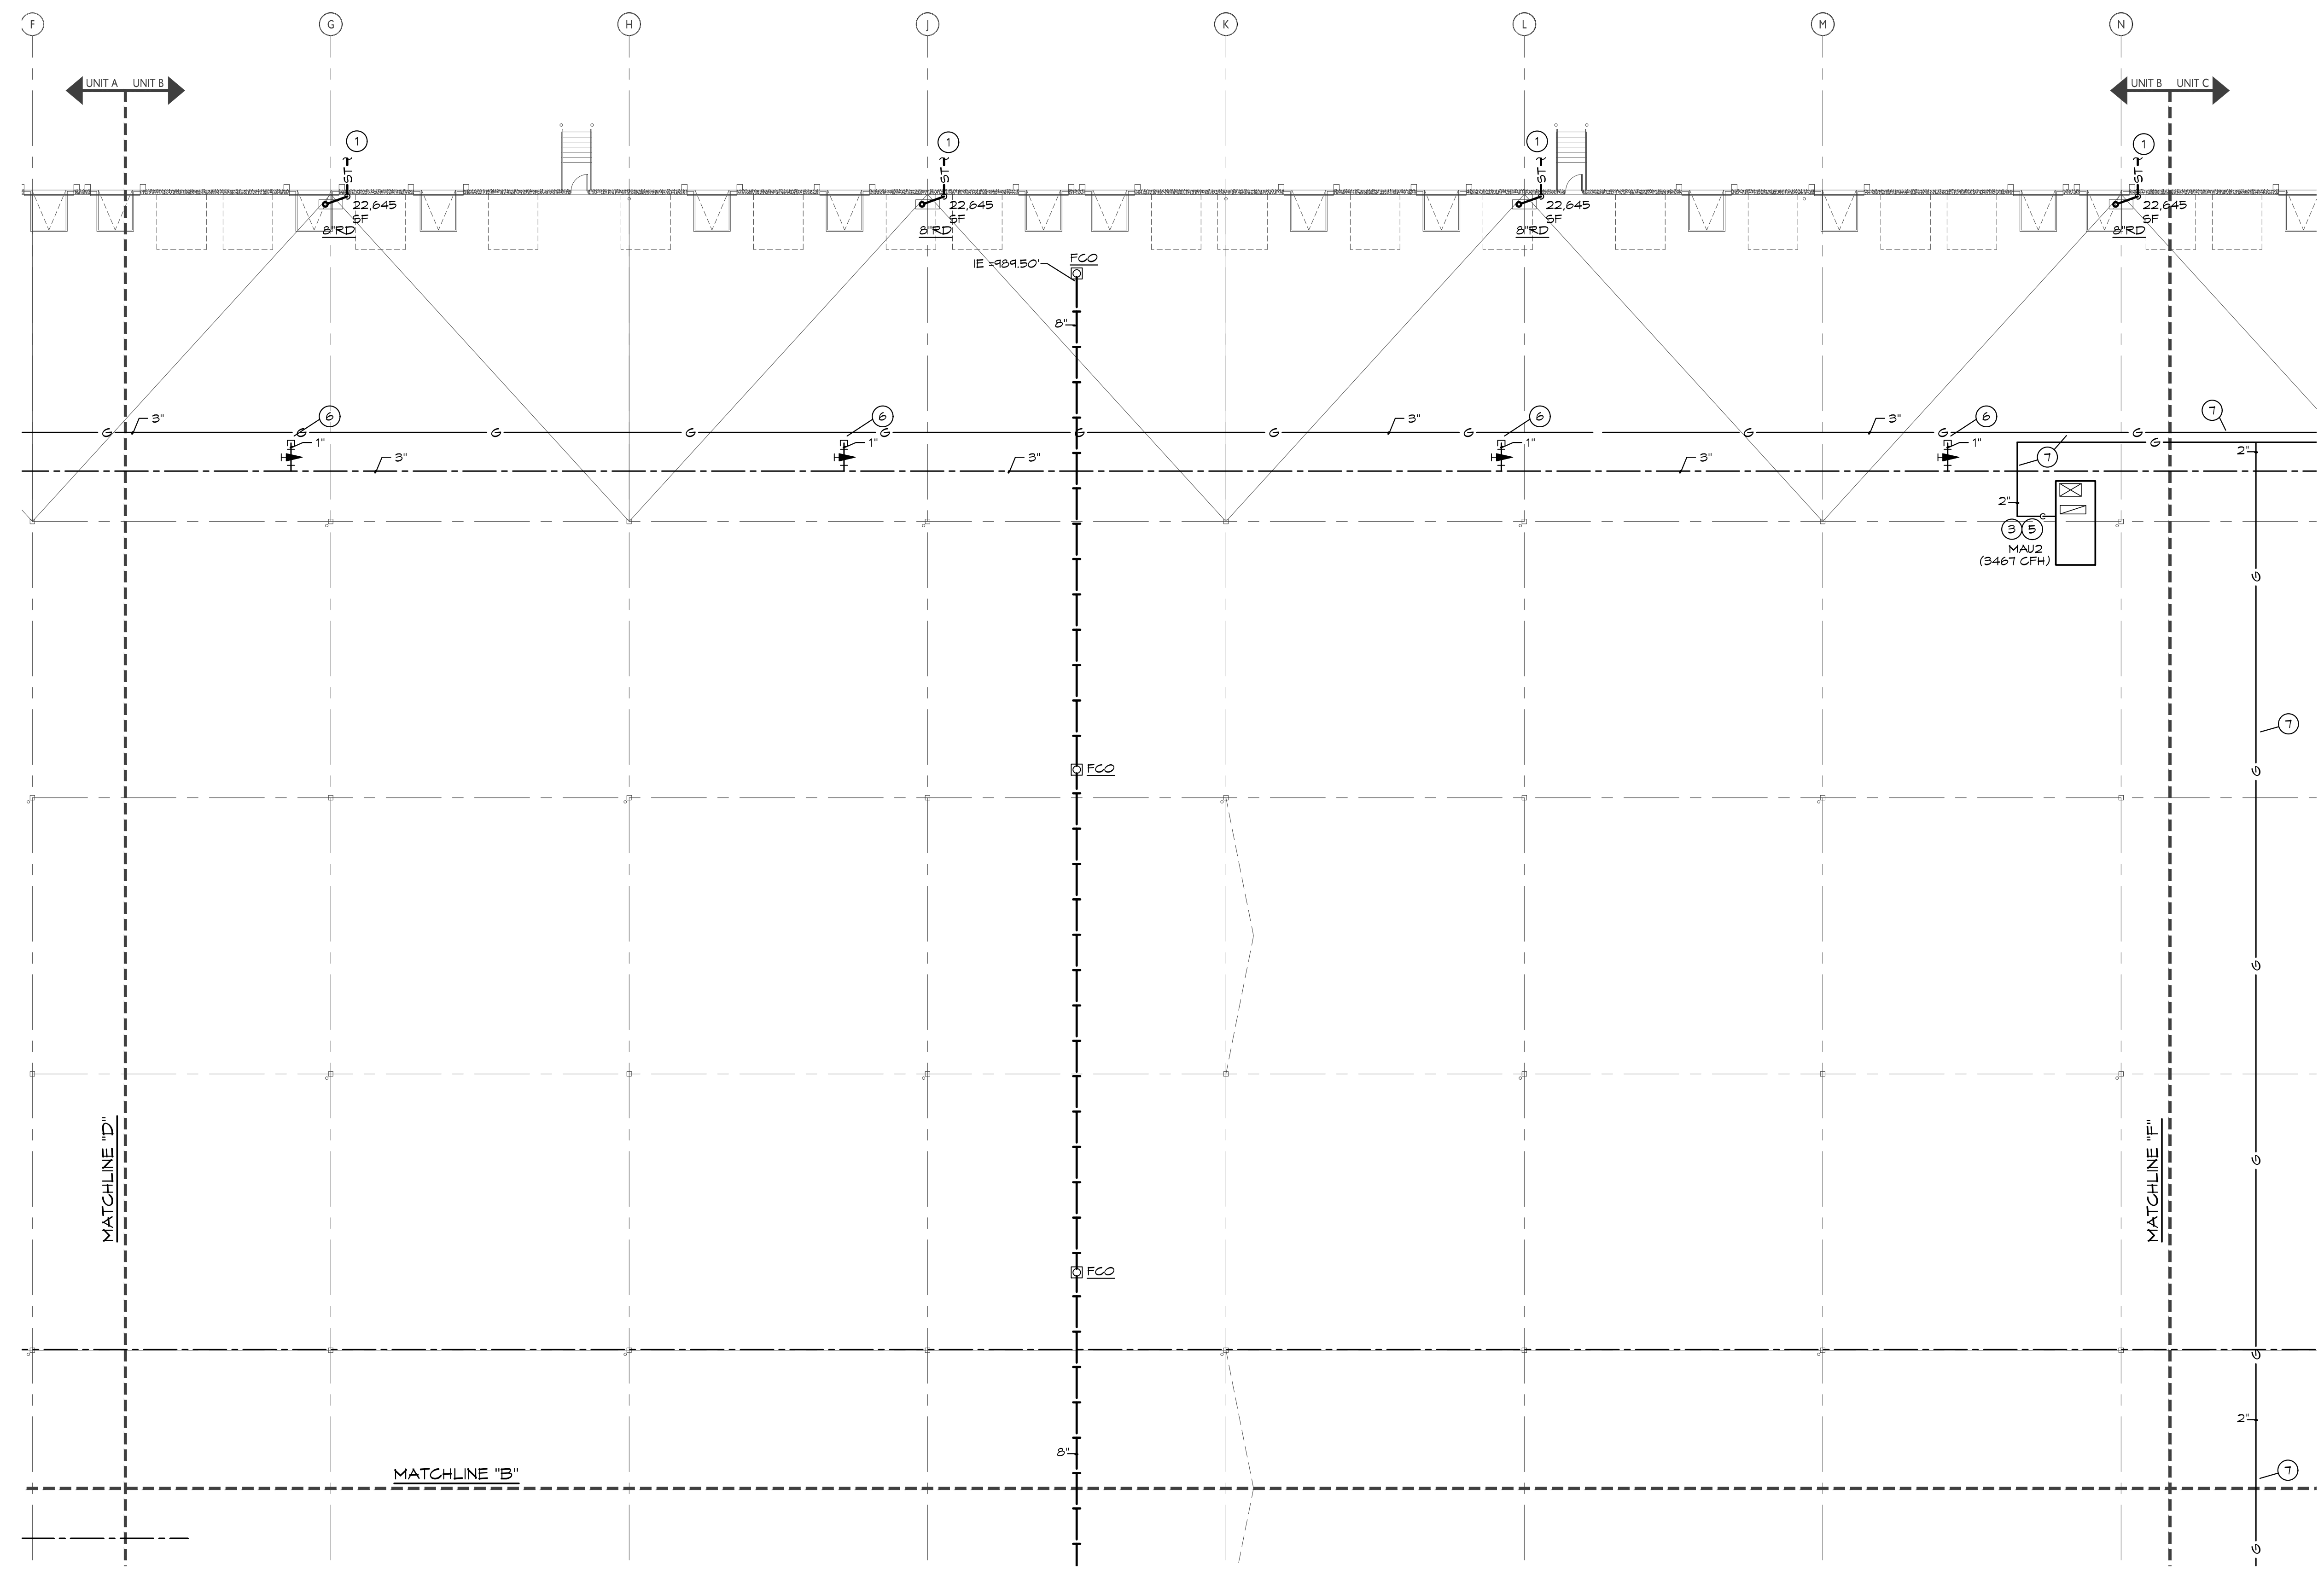

- PLUMBING PLAN NOTES:**
- 1 REFER TO CIVIL FOR 8" STORM PIPE. MAINTAIN A MIN. OF 24" COVER.
 - 2 REFER TO CIVIL FOR 8" WASTE PIPE. MAINTAIN A MIN OF 30" COVER.
 - 3 GAS PIPE UP THROUGH ROOF TO MAU CONNECTION. SEAL PENETRATION WEATHER TIGHT.
 - 4 INSTALL FREEZE PROOF WALL HYDRANT 18" ABOVE GRADE.
 - 5 CONNECT GAS PIPING TO EQUIPMENT AS DETAILED.
 - 6 CAP 1" WATER PIPE WITH SHUT-OFF VALVE FOR FUTURE CONNECTION.
 - 7 GAS PIPING BELOW ROOF SUPPORT AS REQUIRED.
 - 8 GAS PIPING ON ROOF. SUPPORT AS REQUIRED AND DETAILED.

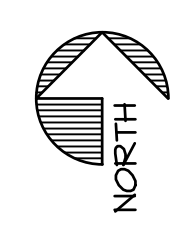

PARTIAL PLUMBING FLOOR PLAN "UNIT B"
SCALE: 1/16" = 1'-0"
FFE = 991.50'

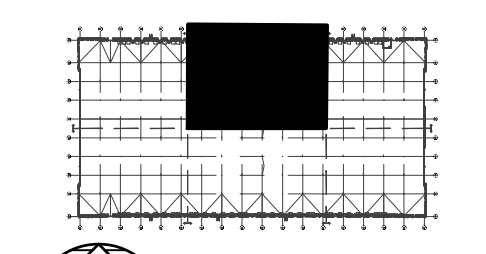

KEY PLAN
SCALE: NTS

CENTRAL
PLUMBING, HEATING & AIR CONDITIONING, INC.
201 East Walnut
Cleveland, MO 64734
816-942-6355

BC PROJECT #22208
MISSOURI PE COA #2009003629

This drawing has been prepared by the Engineer, or under his supervision. This drawing is intended as an instrument of service by the Designer/Engineer and is intended for use on the project only. Pursuant to the Architectural Notice Copyright Protection Act of 1980, all drawings, specifications, ideas and designs, including the serial form, arrangement and composition of spaces and elements appearing herein, constitute the original, copyrighted work of the Designer/Engineer. Any reproduction, use, or disclosure of information contained herein without prior written consent of the Engineer is strictly prohibited. © 2022 BC Engineers, Inc.

BC ENGINEERS
INCORPORATED
5720 Reeder Shawnee, KS 66203 (913)262-1772



CURRAN
ARCHITECTURE

5719 LAWTON LOOP E. DR. #212
INDIANAPOLIS, IN 46216
O :: 317 . 288 . 0681
F :: 317 . 288 . 0753



SCANNELL
PROPERTIES

4/26/2022



LEE'S SUMMIT LOGISTICS
BUILDING A LOT I


NW CORNER OF
NE TUDOR RD & MAIN ST
LEE'S SUMMIT, MO 64086

PERMIT SET 02.18.22

210300

PLUMBING PLAN
AREA C

P102

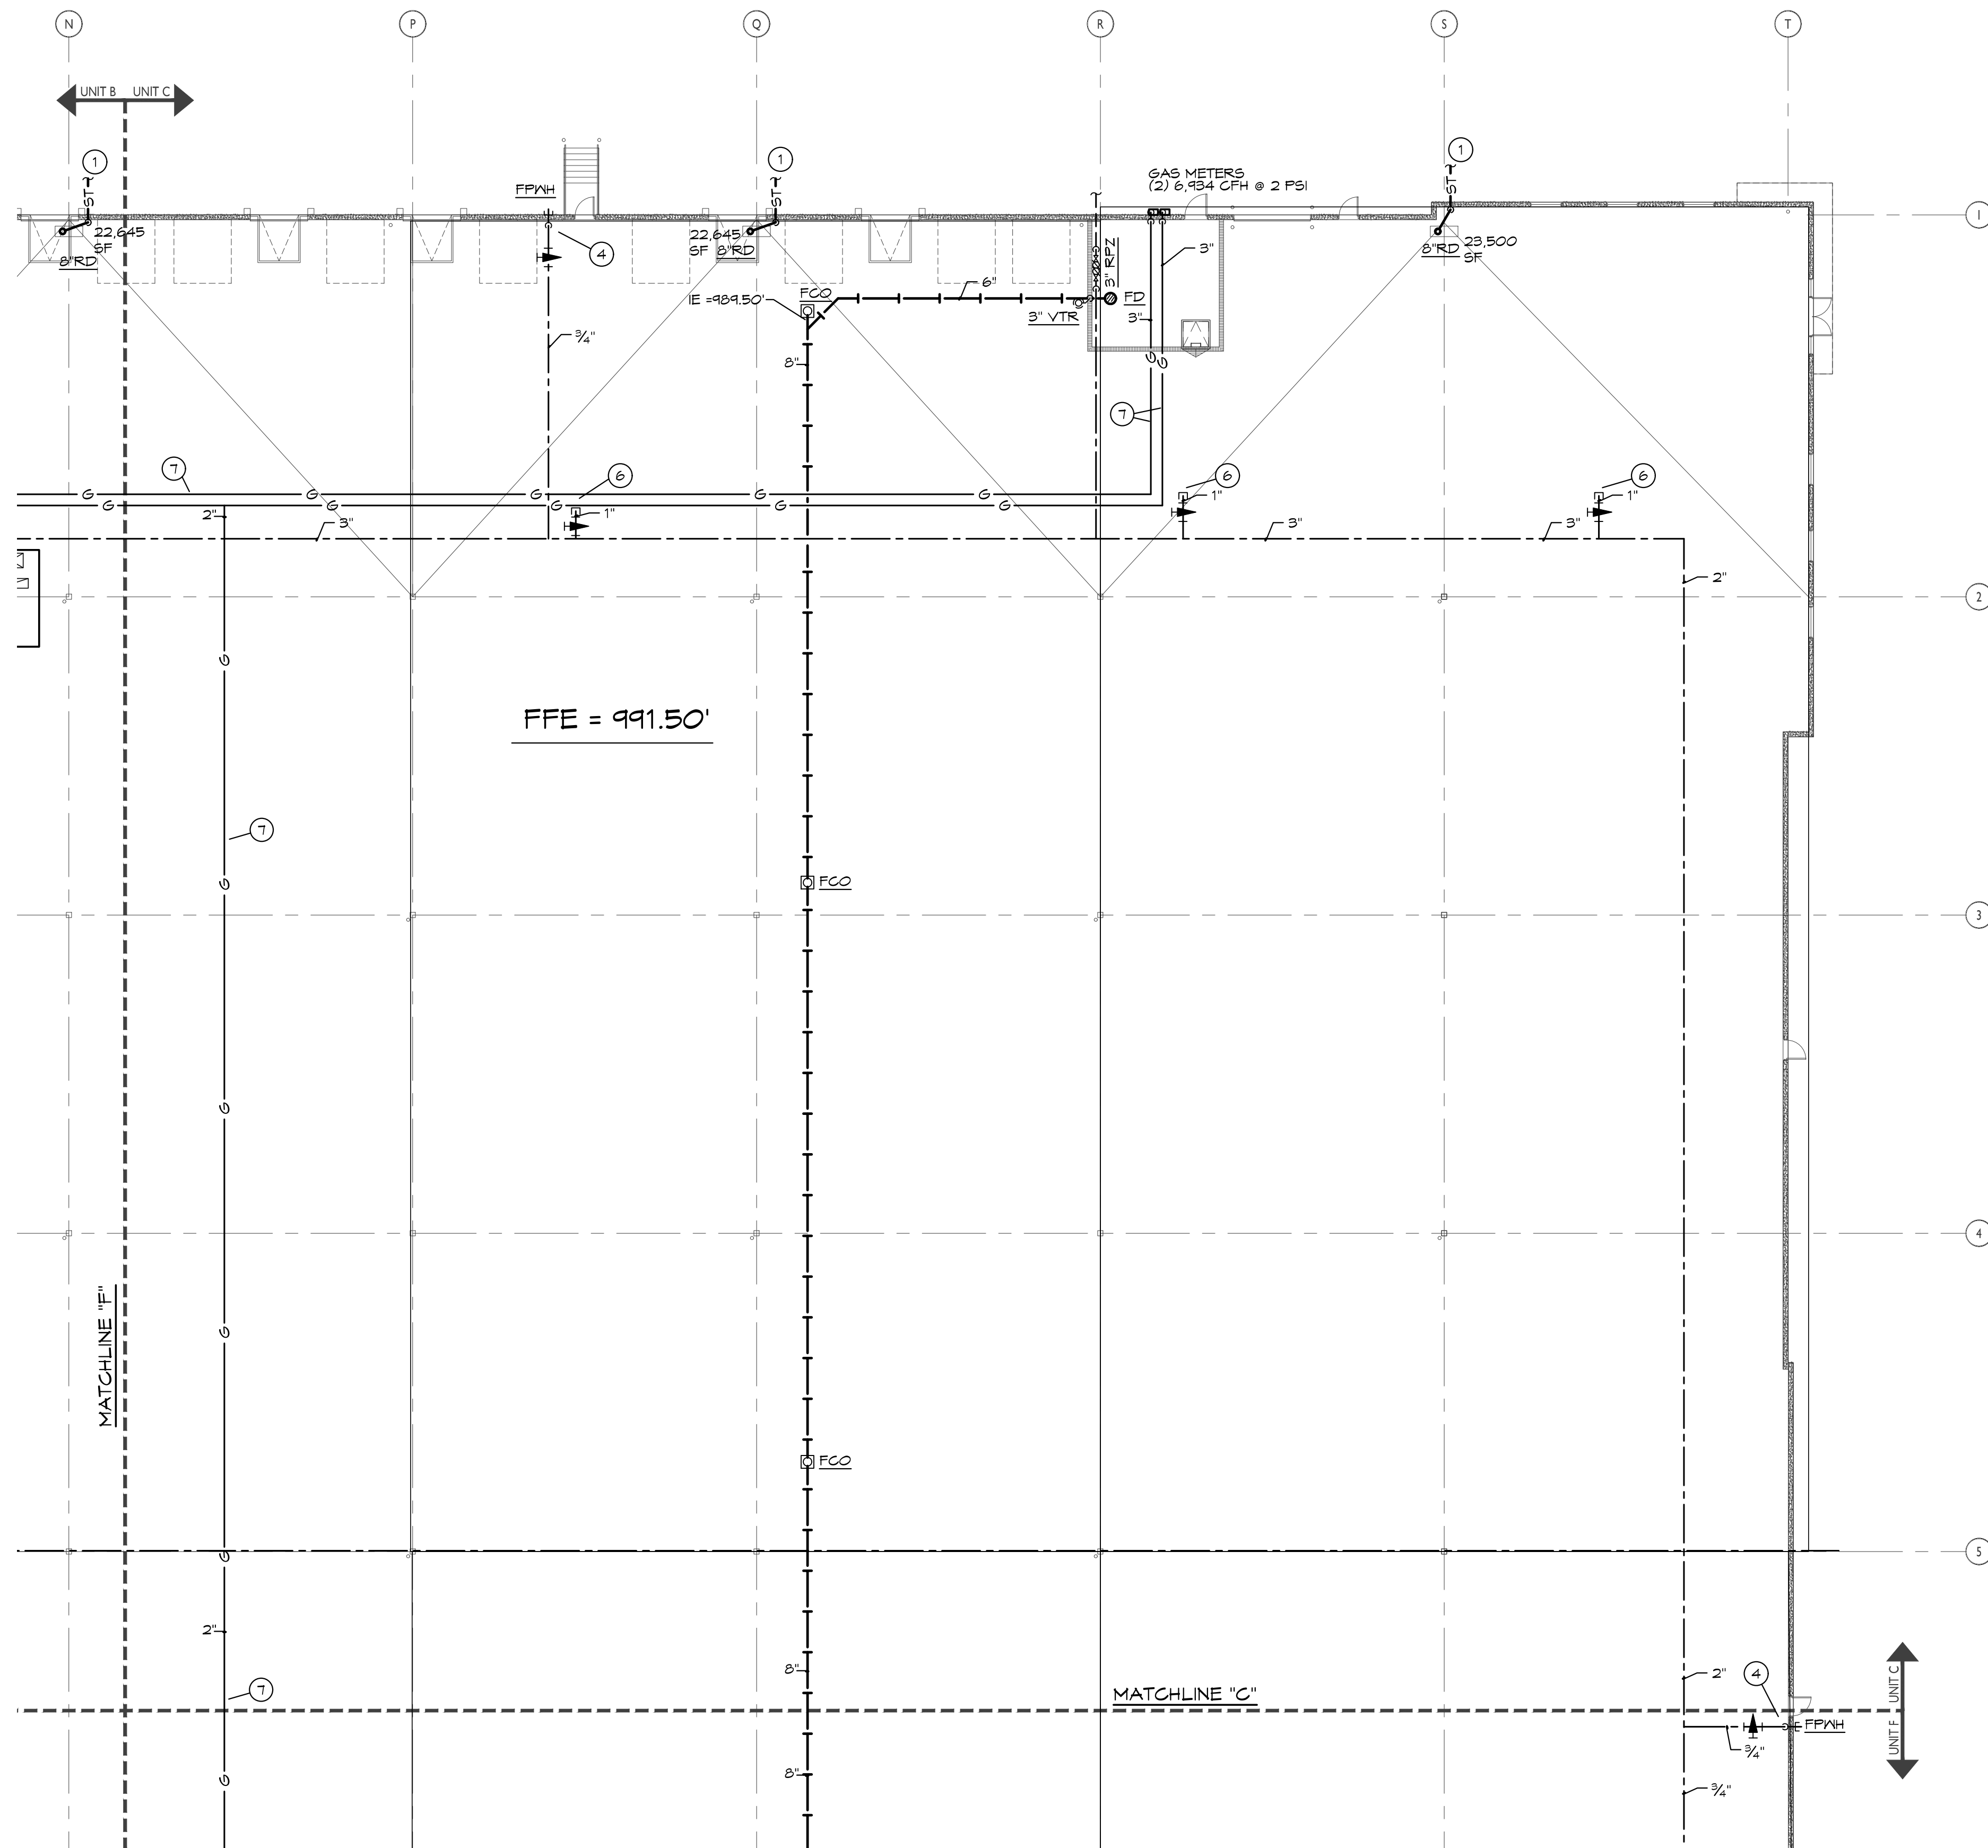

PLUMBING PLAN NOTES:


- 1 REFER TO CIVIL FOR 8" STORM PIPE. MAINTAIN A MIN. OF 24" COVER.
- 2 REFER TO CIVIL FOR 8" WASTE PIPE. MAINTAIN A MIN OF 30" COVER.
- 3 GAS PIPE UP THROUGH ROOF TO MAU CONNECTION. SEAL PENETRATION WEATHER TIGHT.
- 4 INSTALL FREEZE PROOF WALL HYDRANT 18" ABOVE GRADE.
- 5 CONNECT GAS PIPING TO EQUIPMENT AS DETAILED.
- 6 CAP 1" WATER PIPE WITH SHUT-OFF VALVE FOR FUTURE CONNECTION.
- 7 GAS PIPING BELOW ROOF SUPPORT AS REQUIRED.
- 8 GAS PIPING ON ROOF. SUPPORT AS REQUIRED AND DETAILED.



PARTIAL PLUMBING FLOOR PLAN "UNIT C"

SCALE: 1/16" = 1'-0"

FFE = 991.50'

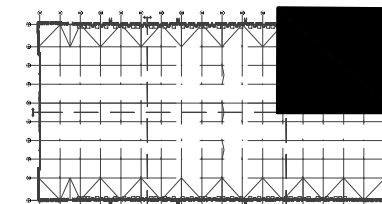

KEY PLAN
SCALE: NTS

CENTRAL
PLUMBING, HEATING & AIR CONDITIONING, INC.
201 East Walnut
Cleveland, MO 64734
816-942-6355


BC PROJECT #22208
MISSOURI PE COA #2009003629

This drawing has been prepared by the Engineer, or under his supervision. This drawing is provided as an instrument of service by the Designer/Engineer and is intended for use on the project only. Pursuant to the Architectural Notice Copyright Protection Act of 1980, all drawings, specifications, ideas and designs, including the overall form, arrangement and composition of spaces and elements appearing herein, constitute the original, copyrighted work of the Designer/Engineer. Any reproduction, use, or disclosure of information contained herein without prior written consent of the Engineer is strictly prohibited. © 2022 BC Engineers, Inc.

BC ENGINEERS
INCORPORATED

5720 Reeder Shawnee, KS 66203 (913)262-1772

5719 LAWTON LOOP E. DR. #212
INDIANAPOLIS, IN 46216
O :: 317.288.0681
F :: 317.288.0753

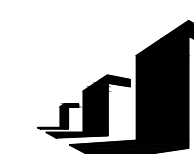

SCANNELL
PROPERTIES

NW CORNER OF
NE TUDOR RD & MAIN ST
LEE'S SUMMIT, MO 64086

210300
PLUMBING PLAN
AREA D

PLUMBING PLAN
AREA D

P103




- ① REFER TO CIVIL FOR 8" STORM PIPE. MAINTAIN A MIN. OF 24" COVER.
- ② REFER TO CIVIL FOR 8" WASTE PIPE. MAINTAIN A MIN OF 30" COVER.
- ③ GAS PIPE UP THROUGH ROOF TO MAU CONNECTION. SEAL PENETRATION WEATHER TIGHT.
- ④ INSTALL FREEZE PROOF WALL HYDRANT 18" ABOVE GRADE.
- ⑤ CONNECT GAS PIPING TO EQUIPMENT AS DETAILED.
- ⑥ CAP 1" WATER PIPE WITH SHUT-OFF VALVE FOR FUTURE CONNECTION.
- ⑦ GAS PIPING BELOW ROOF SUPPORT AS REQUIRED.
- ⑧ GAS PIPING ON ROOF. SUPPORT AS REQUIRED AND DETAILED.



SCALE: 1/16" = 1'-0"

FFE = 991.50'

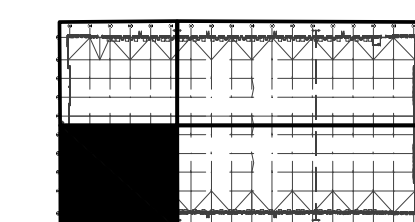

SCALE: NTS

This drawing has been prepared by the Engineer, or under his supervision. This drawing is provided as an instrument of service by the Designer/Engineer and is intended for use on this project only. Pursuant to the Architectural Works Copyright Protection Act of 1990, all drawings, specifications, ideas and designs, including the overall form, arrangement and composition of spaces and elements appearing herein, constitute the original, copyrighted work of the Designer/Engineer. Any reproduction, use, or disclosure of information contained herein without prior written consent of the Engineer is strictly prohibited. © 2022 BC Engineers, Inc.

CENTRAL
PLUMBING, HEATING & AIR CONDITIONING, INC.
201 East Walnut
Cleveland, MO 64734
816-942-6355

BC ENGINEERS
INCORPORATED

5720 Reeder Shawnee, KS 66203 (913)262-1772