


RELEASE FOR CONSTRUCTION
AS NOTED ON PLANS REVIEW
DEVELOPMENT SERVICES
LEE'S SUMMIT, MISSOURI
01/03/2023 4:36:10

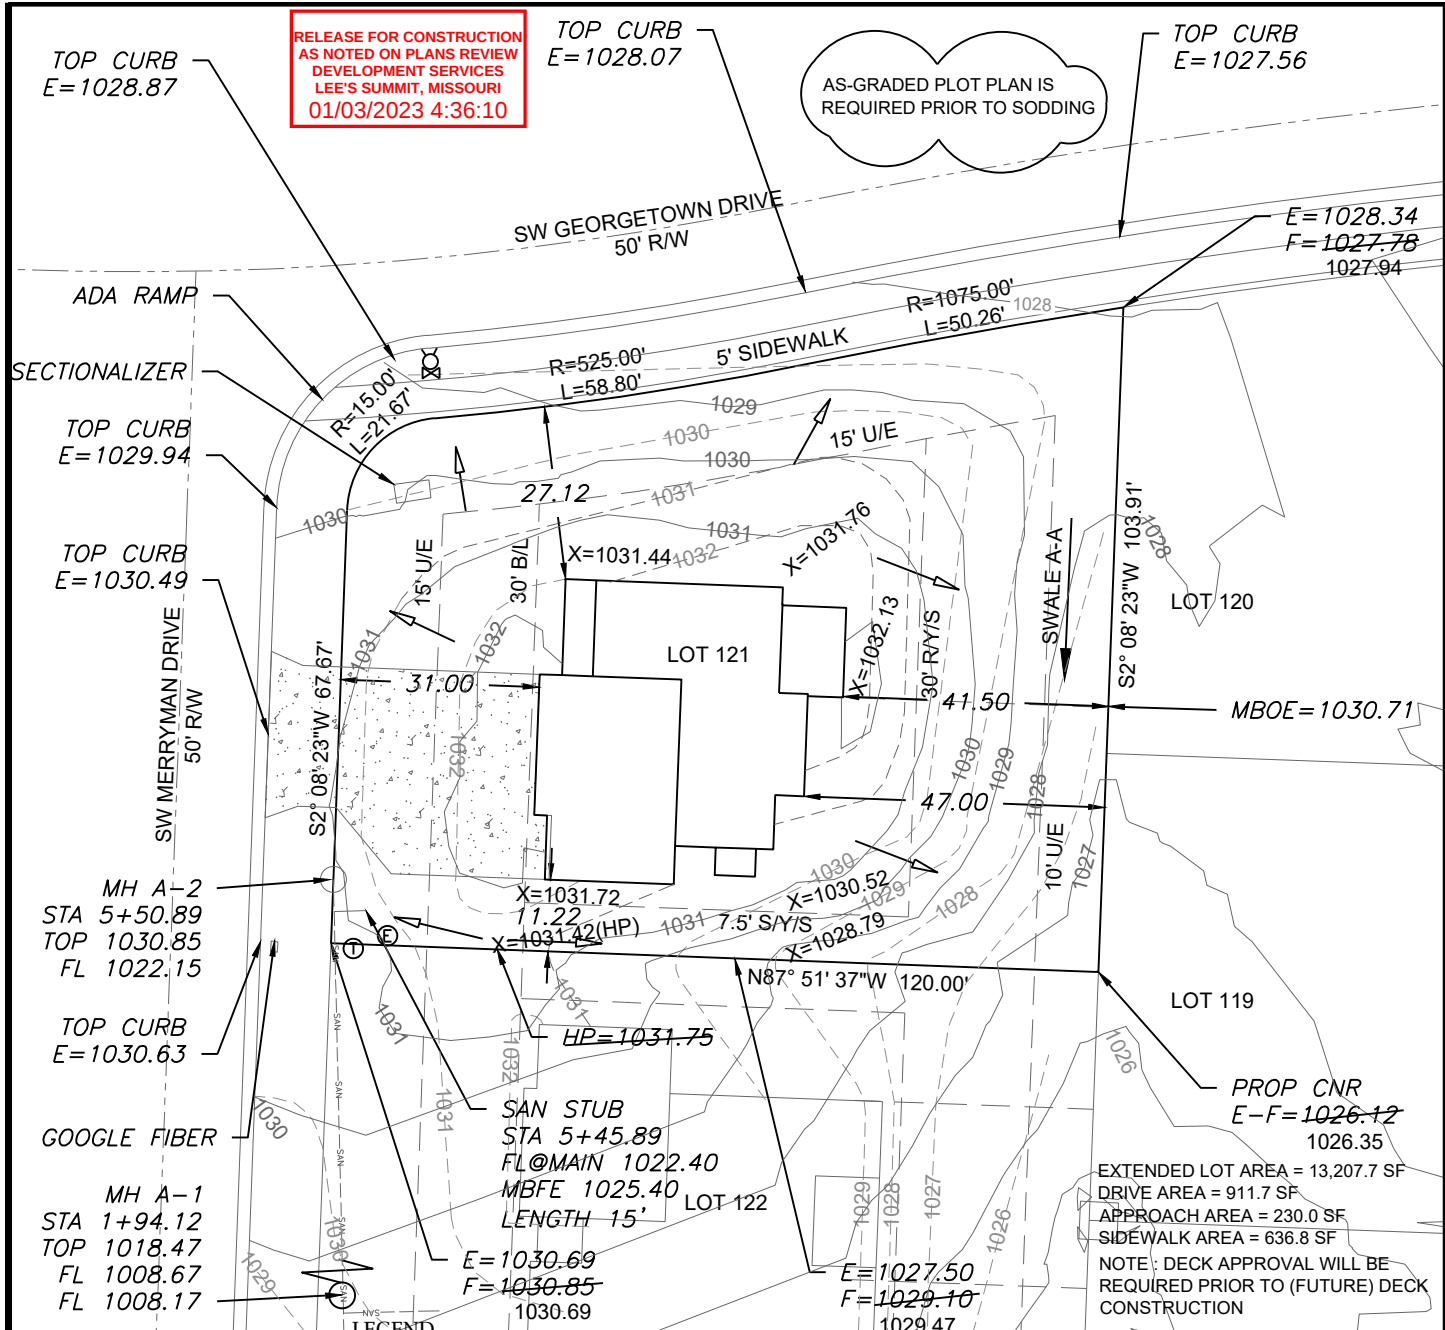

--- PROPOSED CONTOURS
--- AS-GRADED CONTOURS
X=###.## = Actual asbuilt ground shots taken on December 22, 2022.
Contours shown are asbuilt.

- LEGEND**
- Gas Meter
 - Telephone or Fiber-Optic Pedestal
 - Cable TV Pedestal
 - Electric Pedestal
 - Light Pole
 - Mailbox
 - Fire Hydrant
 - Water Valve


PROPOSED HOUSE
TOP FOUNDATION = 1033.25
GARAGE FLOOR = 1032.25
TOP FOOTING = 1024.25
BASEMENT FLOOR = 1024.58
DRIVE SLOPE = 5.0%

E = EXISTING ELEVATION
F = PROPOSED FINAL ELEVATION
G = ADJACENT GRADE AT EGRESS
U/E = UTILITY EASEMENT
B/L = BUILDING LINE
S/Y/S = SIDE YARD SETBACK
R/Y/S = REAR YARD SETBACK

- NOTES**
- BUILDER TO VERIFY ALL BUILDING ELEVATIONS AND DIMENSIONS.
 - THIS PLOT PLAN DOES NOT CONSTITUTE A BOUNDARY SURVEY.
 - THE EASEMENTS SHOWN ON THIS PLOT PLAN ARE TAKEN FROM THE FINAL PLAT. EASEMENTS MAY EXIST.

SWALE SECTION A-A


100 YR.	1.49 CFS
10 YR	0.96 CFS
BED SLOPE	3.48%
BASE WIDTH	8'
SIDE SLOPE(1:V)	8'
100 YR WSE	0.10'

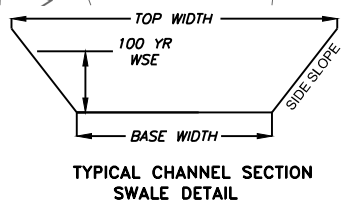

NOTE: THIS LOT MAY REQUIRE A GRINDER PUMP.


Scale 1"=30'
LOT INFORMATION

10,930.22 SQ. FT.
LEFT MBOE = 1032.21
RIGHT MBOE = 1029.70
MBFE = 1025.40
ADDRESS
1936 SW MERRYMAN DR
LEGAL DESCRIPTION
LOT 121, THE MANOR AT STONEY CREEK 4TH PLAT, A SUBDIVISION AS RECORDED IN LEE'S SUMMIT, JACKSON COUNTY, MISSOURI.

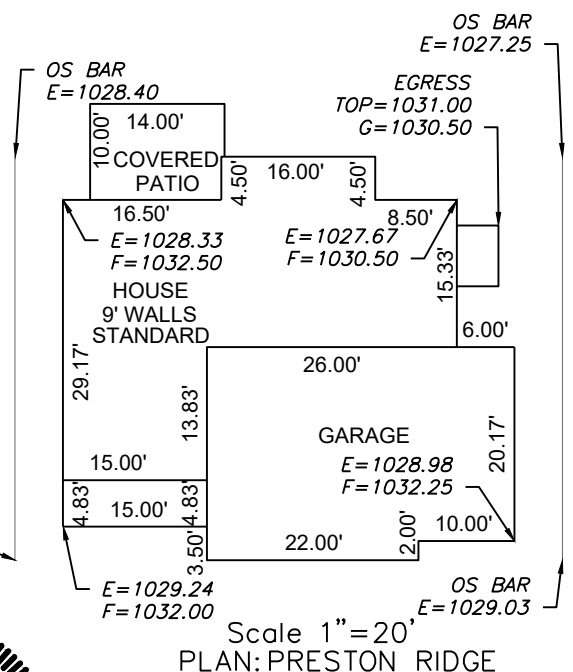

Scale 1"=20'
PLAN: PRESTON RIDGE

ENGINEERING SOLUTIONS
ENGINEERING & SURVEYING
50 SE 30TH STREET
LEE'S SUMMIT, MO 64082
P:(816) 623-9888 F:(816) 623-9849
WWW.ENGINEERINGSOLUTIONKCC.COM

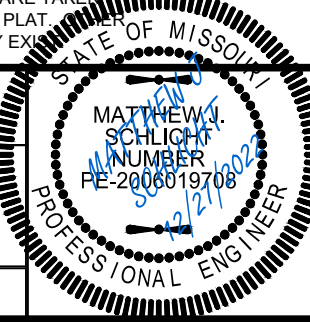

AS-GRADED PLOT PLAN - LOT 121

THE MANOR AT STONEY CREEK 4TH PLAT
LEE'S SUMMIT, JACKSON COUNTY, MISSOURI

SUMMIT HOMES
120 SE 30TH STREET
LEE'S SUMMIT, MO 64082

PROJECT NO.	FILE NAME	DATE	SHEET	OF
1	LOT 121, 122, MANOR AT STONEY CREEK	12/29/21	1	1

Rev: