


# CONSTRUCTION STAKE PLOT PLAN

ORDERED BY: NEW MARK HOMES

DESCRIPTION: LOT 1 WHISPERING WOODS 1ST PLAT  
LOTS 1-33 & TRACTS A,B,C, & D  
LEE'S SUMMIT, JACKSON COUNTY, MISSOURI  
1928 SW RIVER RUN DRIVE  
NO DECK CONSTRUCTION WITHOUT A PERMIT

WALKOUT  
BASEMENT AS BUILT PLOT PLAN DONE ON 12/26/2022  
MBOE 958.70  
LAG IS ~~961.23~~ ACROSS BACK OF HOUSE

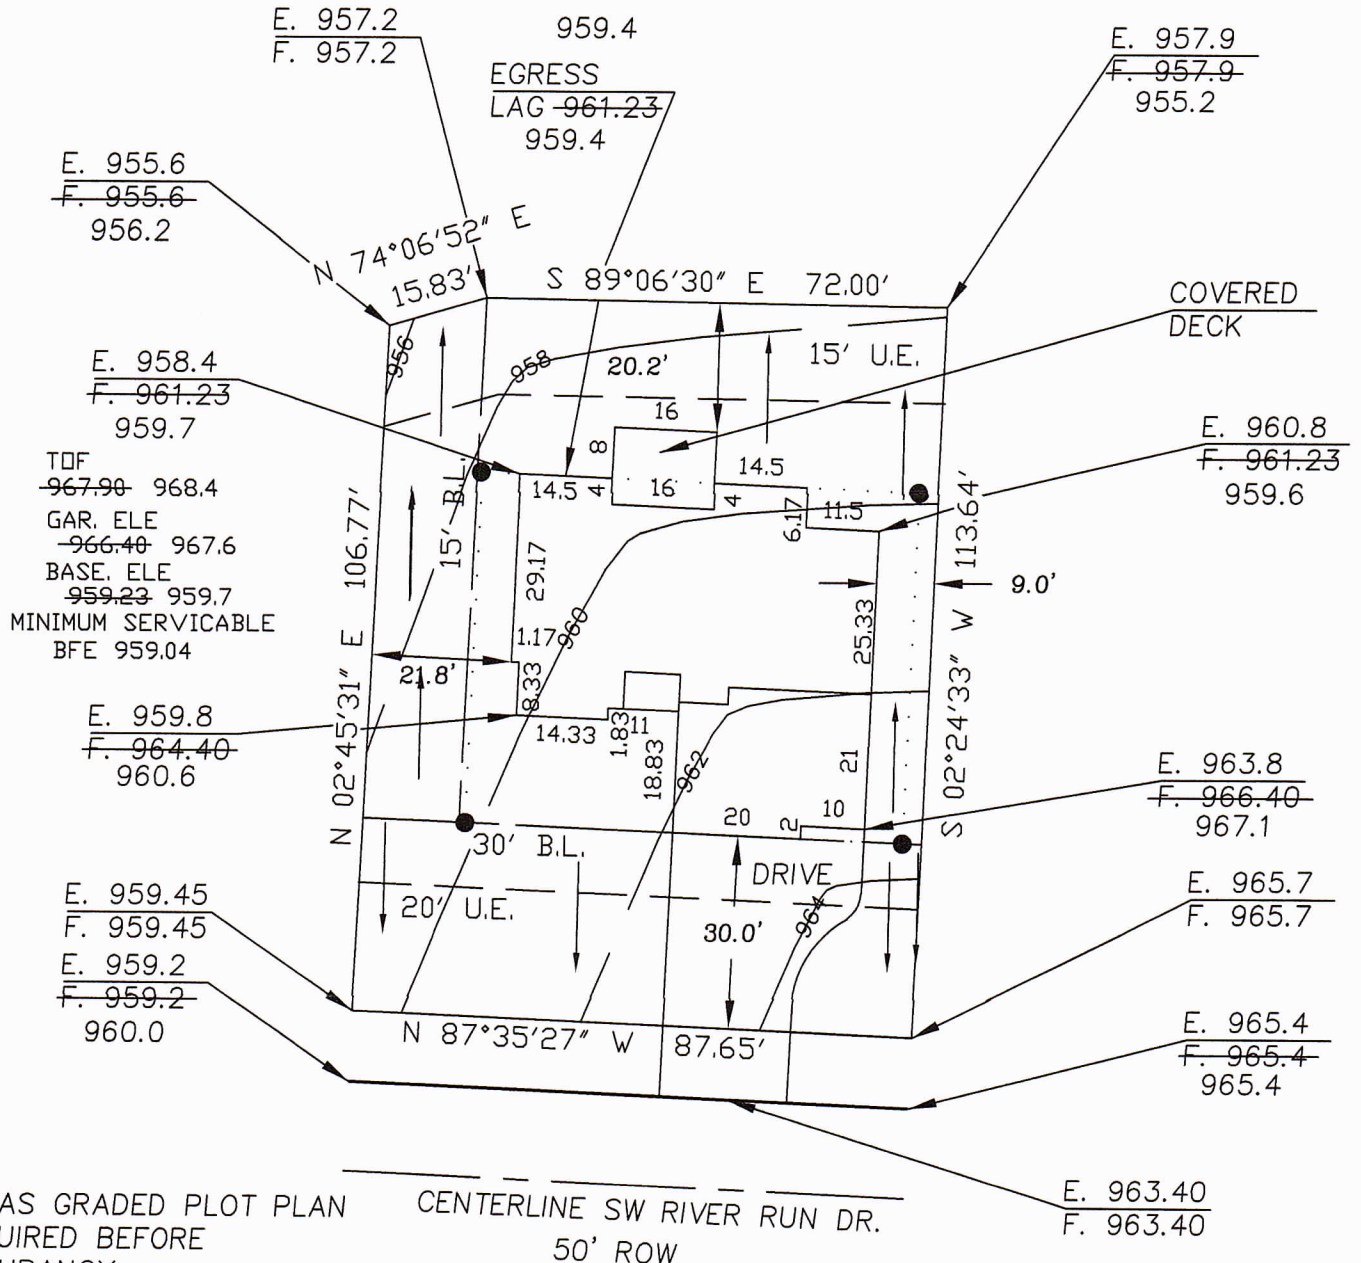

AN AS GRADED PLOT PLAN  
REQUIRED BEFORE  
OCCUPANCY

CENTERLINE SW RIVER RUN DR.  
50' ROW

• = 6' O/S BAR (TYP)

## HENLEY SURVEY CO.

PHONE: (816) 716-3254



1" = 30' DATE: 6/08/21

DIRECTION OF DRAINAGE →

This plot plan was prepared for use before and during foundation construction only. House staked as shown on plot plan. Contractor to check and verify house dimensions and elevations at job site. We are not responsible for unknown or platted easements of any kind unless we are furnished the description of said easements before the field work is performed. NOTE: Cuts shown hereon for excavation are a guide only. Final decision as to cuts and foundation height are to be made by builder on job site.