



January 10, 2023

Dwayne Lewis  
MSE Hardscapes  
PO Box 942  
Raymore, MO 64083


RE: Stacked Stone Retaining Wall  
146 Ambersham

Per your request, Hart Creek Engineering has reviewed the construction of the retaining wall at the residence location at 146 Ambersham in Lee's Summit, MO. The wall construction appears to be in conformance with the attached wall details and built per industry standards.

If you have any questions or I may be of any further assistance, do not hesitate to contact me.

Sincerely,

Charley Farris, PE

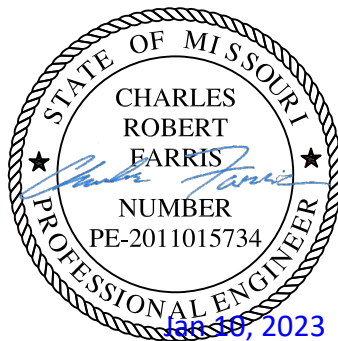


1. MATERIALS

- a. DRAINAGE FILL BEHIND BACK FACE SHALL CONSIST OF CLEAN CRUSHED STONE OR CRUSHED GRAVEL MEETING THE REQUIREMENTS OF ASTM C33 #57 OR #67.
- b. LEVELING PAD SHALL BE WELL GRADED CRUSHED STONE MEETING ALL OF THE REQUIREMENTS OF KDOT AB-3 OR 2000 PSI LEAN CONCRETE.
- c. DRAIN PIPE SHALL BE 4" Ø PERFORATED OR SLOTTED PVC, OR CORRUGATED HDPE PIPE. THE DRAINAGE PIPE MAY BE WRAPPED WITH A GEOTEXTILE TO FUNCTION AS A FILTER.

2. TECHNICAL REQUIREMENTS

- a. PRIOR TO CONSTRUCTION OF THE WALLS, THE GRADING CONTRACTOR SHALL CLEAR AND GRUB THE REINFORCED BACKFILL ZONE AREA, REMOVING TOP SOILS, BRUSH, SOD OR OTHER ORGANIC MATERIALS. ANY UNSUITABLE SOILS SHALL BE OVER-EXCAVATED, REPLACED AND COMPACTED WITH REINFORCED BACKFILL MATERIAL TO PROJECT SPECIFICATIONS OR OTHERWISE DIRECTED BY THE OWNER'S GEOTECHNICAL ENGINEER.
- b. THE GEOTECHNICAL ENGINEER SHALL CONFIRM THAT THE SITE HAS BEEN PROPERLY PREPARED AND THE DESIGN PARAMETERS IN SECTION 5 ARE APPROPRIATE PRIOR TO FILL PLACEMENT. A WRITTEN CONFIRMATION SHALL BE PROVIDED TO HART CREEK ENGINEERING PRIOR TO FILL PLACEMENT.
- c. FILL SHALL BE PLACED IN HORIZONTAL LAYERS NOT EXCEEDING 10" IN UNCOMPACTED THICKNESS FOR HEAVY COMPACTION EQUIPMENT. FOR ZONES WHERE COMPACTION IS ACCOMPLISHED WITH HAND OPERATED EQUIPMENT, FILL SHALL BE PLACED IN HORIZONTAL LAYERS NOT EXCEEDING 6" IN UNCOMPACTED THICKNESS. ONLY HAND OPERATED EQUIPMENT SHALL BE ALLOWED WITHIN 3' OF THE BACK FACE OF THE WALL.
- d. FILL MATERIALS SHALL BE PLACED FROM THE BACK OF THE FACING UNITS TOWARDS THE ENDS OF THE GEOGRID TO ENSURE PROPER TENSIONING.
- e. FILL SHALL BE COMPACTED AS SPECIFIED BY PROJECT SPECIFICATIONS OR TO A MINIMUM OF 95% OF THE MAXIMUM DRY DENSITY AS DETERMINED IN ACCORDANCE WITH ASTM D-698.

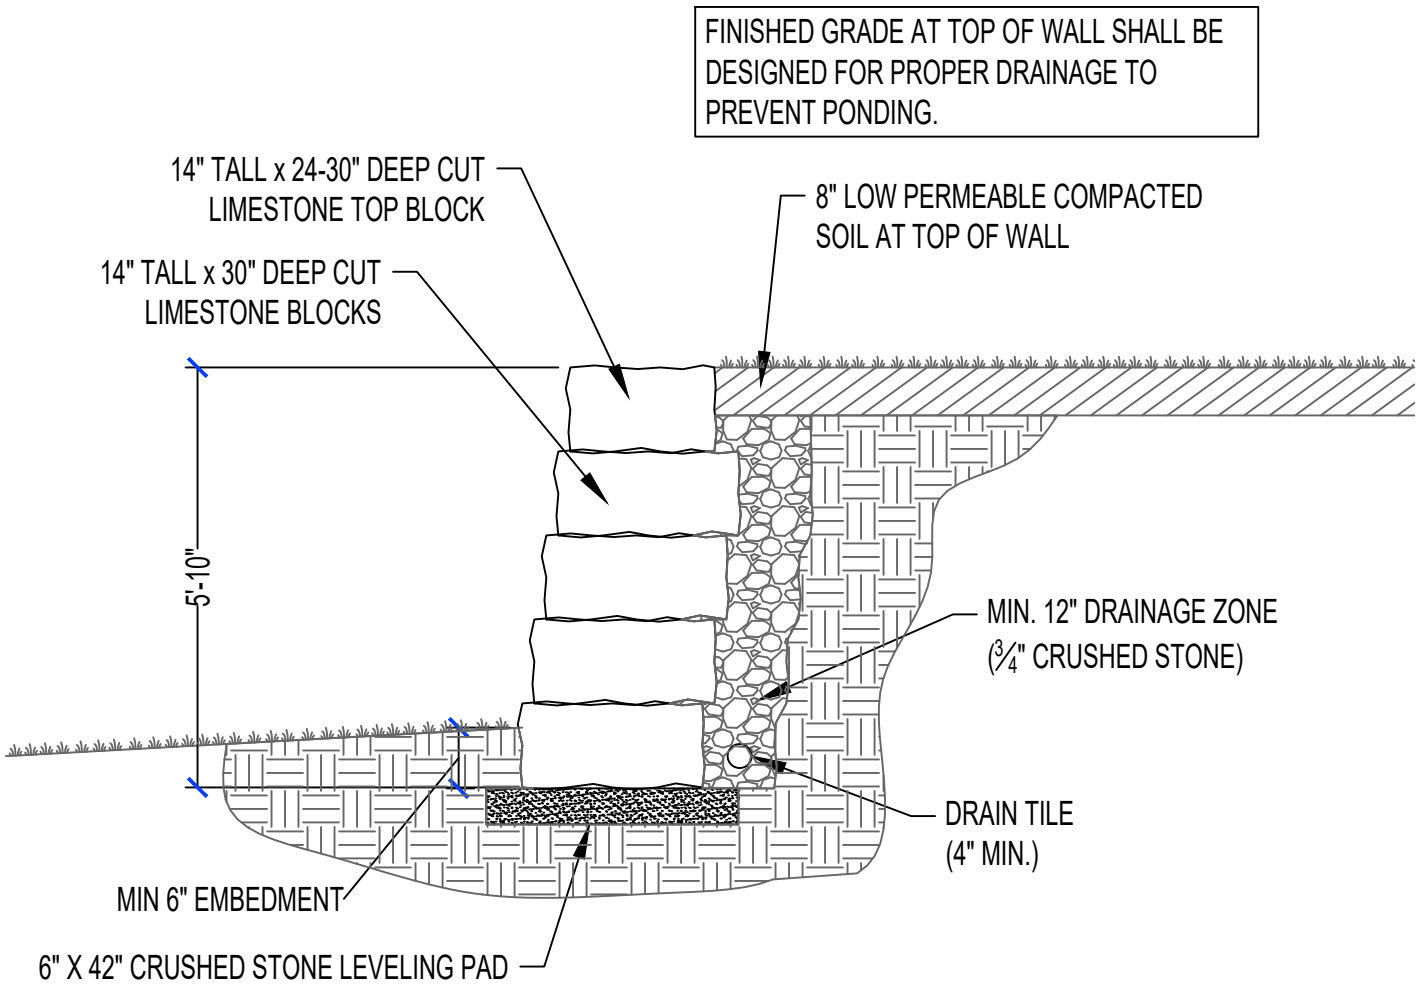

1 WALL SECTION  
3/8" = 1'-0"



**HART CREEK**  
HARTCREEKENGINEERING.COM  
HARTSBURG, MO 65039  
573-289-8520  
MO LICENSE E-2022018980

PROJECT NO:	23002	PROJECT <b>146 AMBERSHAM</b>
DRAWN BY:	CRF	
REVIEWED BY:	CRF	
DATE:	01/10/2023	
		SHEET <b>RW1</b>

RELEASE FOR CONSTRUCTION  
AS NOTED FOR PLAN REVIEW  
DEVELOPMENT SERVICES  
LEE'S SUMMIT, MISSOURI  
**01/13/2023**