HANGER NAILING FOR UNIFORMLY LOADED BEAMS Joist & Beam Hanger Face Nailing Requirements\* for 3 & 4 Ply Supporting Members For IUS or THF Hangers - Use 10d (0.148") x 3" nails. For U, MIU, HU, HHUS, HGUS or HD, THD, THDH Hangers - Use 16d (0.162") x 3 \*For hangers that have joist fasteners/connections, fill all holes with the MULTIPLE PLY CONNECTION NAILING FOR UNIFORMLY LOADED BEAMS PLY BEAMS NAILED CONNECTION
- 11%" Depth (3) Rows of 10d (0.128") x 3" Box Nails at 12" o.6 14" - 24" Depth (4) Rows of 10d (0.128") x 3" Box Nails at 12" o.c. 16d (0.131") pneumatic nails may be substituted for 10d (0.128") Box nails. Stagger nails by 6" per ply All plies must be same material, grade, and 1¾" thickness. -Joist Hanger's connecting into the side of the beam must be installed with MULTIPLE PLY CONNECTION NAILING FOR POINT LOADS Hanger shown for reference. Install screws from side opposite of hanger. Install ½ the required screws on each side of hanger EQUAL SPACING (4) ROWS 14" & DEEPER (3) ROWS 11 %" & LESS USP HANGERS -TIE® HANGERS HU HHUS HGUS | HD | THD | THDH OTAL # OF 3 % 6 8 14 6 TRUSSLOK® SCREWS TOTAL # OF 3 SIMPSON SDS SCREWS 4 PLY SUPPOR HU HHUS HGUS HD TOTAL # OF 6 3 TRUSSLOK® TOTAL # OF 6 SIMPSON SDS - Connections based on FastenMaster TrussLok® and Simpson Strong-Tie® code - All plies assumed to be the same material, grade, and 1 ¾" in thickness Connections based on given hangers maximum capacity at 100% Load Duration Factor. Adequate for 115% and 125% Load Duration Factor as well. Connection assumes the use of 16d nails and max nailing in hangers. -See TB-300 for alternate connector types and loading. Plate nail, 16d (0.135" x 3 ½")

Blocking panel: 1½" TJ® Rim Board, 1½" or 1½" TimberStrand® LSL or TJI® joist Web stiffener required on both sides at A1W ONLY Attach blocking per Rim Board Details and Installation in Weyerhaeuser When sheathing thickness exceeds 7/8 trim sheathing tongue at rim board / Plate nail - 16d (0.135" x 3½") Floor panel nail 8d (0.131" x 2½") at 6" on-center\* each side at A3.\_W 11/8" TJ® Rim Board. (A3.1/A3.1W only) 11/4" or 1 1/2" TimberStrand® LSL. Toe nail - 10d (0.131" x 3") A3 A3.1 A3.2 A3.3 \* For A3.1-A3.3 installation specifications see Rim Board A3W A3.1 W W W W W Guide for Floor and Roof Framing, TJ-9001. Load bearing or braced/shear wall Blocking panel: 11/8" TJ® Rim Board, 11/4" or 11/2" TimberStrand® LSL or TJI® joist. Web stiffeners required on both sides at B1W and B2W ONLY B2 Blocking panels may be required with braced/shear walls above or below — see detail B1 No load bearing wall above

Web stiffeners required

each side at B3W ONLY

Web stiffeners

required on both

sides at E1W ONLY

E1 E1W

8" diameter maximum hole for  $11\frac{7}{8}$ "

16" deep blocking panels; 6" diameter

maximum for blocking panels 91/2"

deep or shorter than 12" long.

11/8" TJ® Rim Board or

Do not cut flanges

1<sup>1</sup>/<sub>4</sub>" or 1<sup>1</sup>/<sub>2</sub>" TimberStrand<sup>®</sup> LSL.

Nail with 10d (0.131" x 3")

nails, one each at top and

Adjust joist up to 3" to allow for

Max clear span at L/480 and max

24" o.c. spacing.

9 1/2" 210 16" o.c. 15'9"

11 7/8" 210 16" o.c. 18'8"

Plumbing and Mechanical installation.

B3 Blocking panels may be required with braced/shear walls above or below — see detail B1

2x4 minimum

squash blocks

SCAN WITH YOUR SMARTPHONE
INSTALLATION GUIDE FOR
FLOOR AND ROOF FRAMING

Use 2x4 minimum squash blocks to

**FLOOR AND ROOF FRAMING** 

SCAN WITH YOUR SMARTPHONE

DAMAGE REPORTING

transfer load around TJI® joist

Load from above

**RELEASE FOR CONSTRUCTION** 

**AS NOTED FOR PLAN REVIEW** 

**DEVELOPMENT SERVICES** 

LEE'S SUMMIT, MISSOURI

01/25/2023

Actual materials and quantities may vary due to jobsite conditions, design changes and installation variations. It is the responsibility of the Builder for this Layout to be reviewed and Approved by an appropriate Design Professional as required by the permitting authority.

ALL ROOF LOADS ASSUMED TO BE SUPPORTED AT EXTERIOR WALLS AND BEAMS BY OTHERS, IF APPLICABLE, UNLESS OTHERWISE NOTED. NO ROOF LOADS APPLIED TO


210'S 16" O.C.

UNLESS OTHERWISE NOTED

FLOOR MEMBERS.

Framing Connector Summary Product ITS2.06/11.88 Designed 2- 10dx1.5 4- 10dx1.5 2- Strong-Grip 4- 10dx1.5 4- 10dx1.5 2- 10dx1.5

STCa1

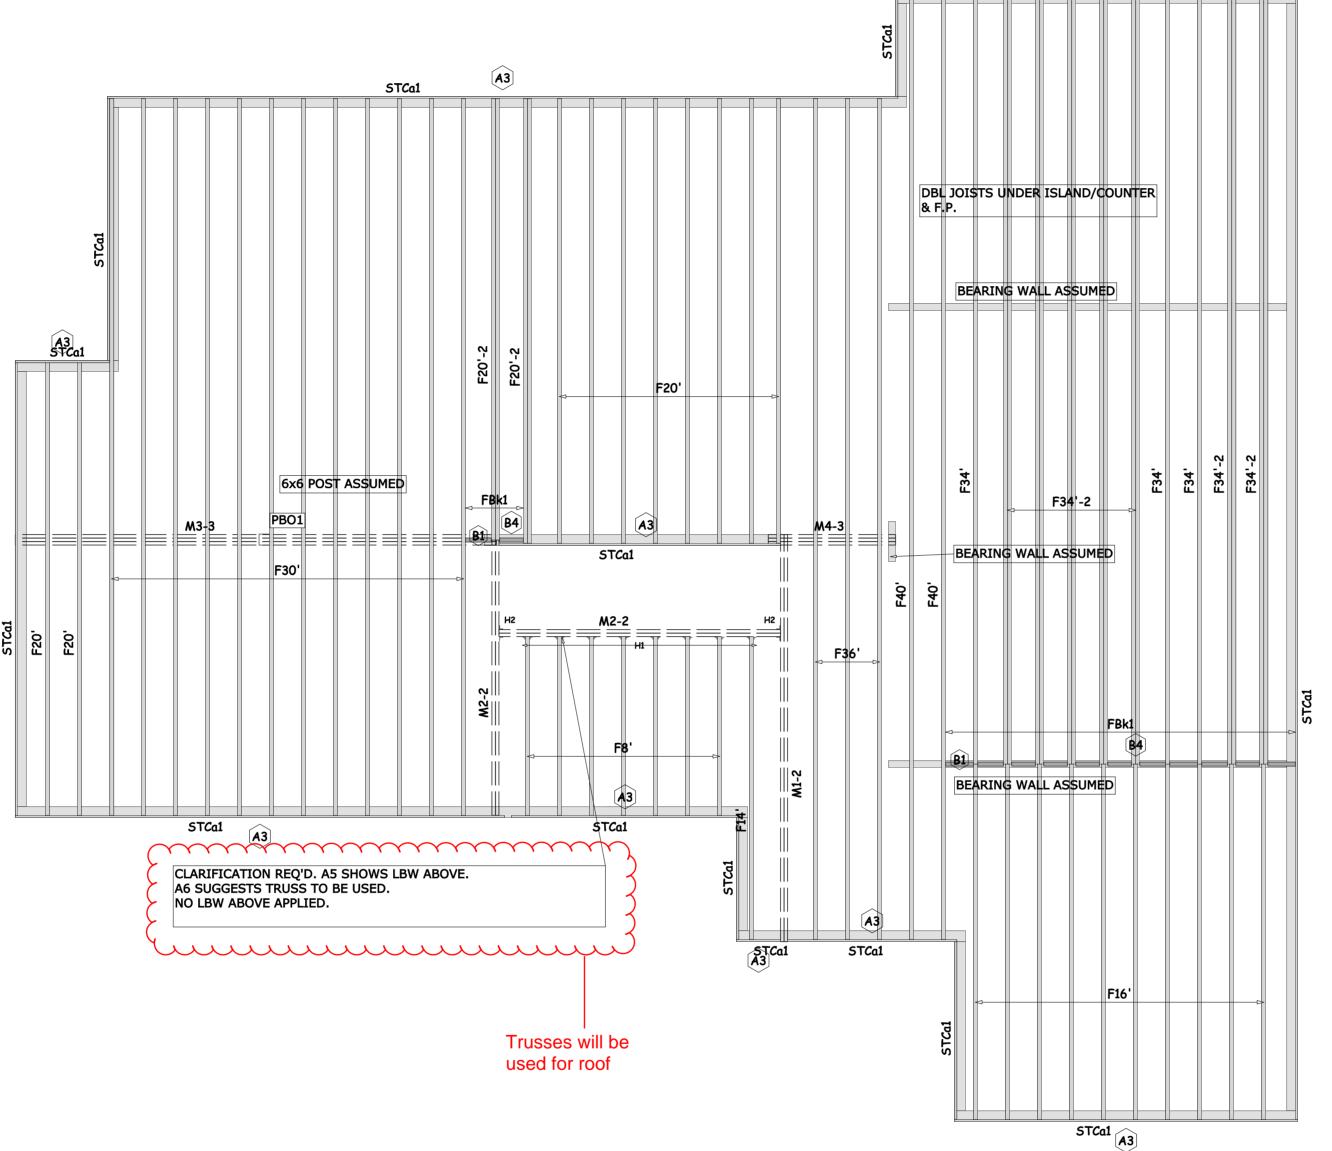

		Blocking		
PlotID	Length	Product	Plies	Net Qty
FBk1	2' 0"	11 7/8" TJI 210 joist	1	7
FBk1	1' 0"	11 7/8" TJI 210 joist	1	6
	Т	otal Lengths		
Length	Product			
1656' 0"	11 7/8" TJI 210 joist			
84' 0"	1 3/4" x 11 7/8" 2.0E Microllam LVL			
84' 0"	1 3/4" × 9 1/2" 2.0E Microllam LVL			
224' 0"	1 1/8" × 11 7/8" TJ Rim Board			

PlotID Length Product




☐ Comments Attached Note Markings Resubmit Rejected

By: AEG Date: <u>January 24, 2023</u>

Plies Net Qty

## SUBMITTAL REVIEW

This review is for general conformance with the design contract and contract documents. Markings or comments shall not be construed as relieving the Contractor from compliance with the project plans and specifications, nor departures therefrom. The Contractor remains responsible for details and accuracy, for confirming and correlating all quantities and dimensions, for selecting fabrication processes, for techniques of assembly and for performing his work in a safe manner.

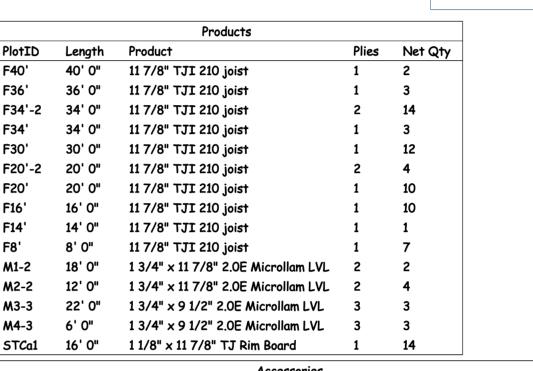

	LEVEL NOTES
Current Date:	1/23/2023
File Name:	fps22-1062_st marys lumber_rudman.jvl
Level Name:	Foundation
Building Code - Design Methodology:	IBC 2018
Members with Design Overridden:	
TJ-Pro Rating (Weighted Average):	49
Minimum Level TJ - Pro Rating & Joist:	TJ-Pro rating = 42, joist = F20'(i1189)
Maximum Level TJ - Pro Rating & Joist:	TJ-Pro rating = 69, joist = F8'(i1079)
FLOOR	
Floor Container:	FC1
Use/Occupancy:	ResidentialLivingAreas
Floor Area Loading is:	40.0 lb/ft² Live Load & 12.0 lb/ft² Dead Load
Maximum Allowed Deflection:	L/480 Live Load & L/240 Total Load
TJ-Pro Rating Information:	
Weighted Average:	49
Directly Applied Ceiling:	Gypsum 1/2"
Decking Attachment:	Glue and Nail
Decking Material:	23/32"x48"x96" Weyerhaeuser Edge Panel (0/24) T&G FF
Perpendicular Partition:	No
Strapping at max 8' o.c.:	None
Blocking at max 8' o.c.:	No
Poured Flooring:	No

11/8" TJ® Rim Board or

11/4" or 1 1/2" TimberStrand® LSL

∩ One 8d (0.113" x 2½")

nail each side. Drive nails at an angle at

least 1½" from end.

23/32"x48"x96" Weyerhaeuser Edge Panel (0/24) T&G FF 1











3½" minimum Also see detail B 13/4" minimum end bearing 51/4" may be required Shear transfer: Connections eq to floor panel nailing schedule Rim to TJI® Joist  $1\frac{1}{4}$ " or  $1\frac{1}{2}$ " TimberStrand® LSL. nail with 10d (0.128" x 3") or TJI<sup>®</sup> 110 rim joist: nails, one each side of One 10d (0.131" x 3") nail into TJI® 560 floor joist each flange TJI<sup>®</sup> 210, 230, and 360 rim joist: One 16d (0.135" x 31/3") nail into each flange.

13/4" minimum bearing With depths > 16", use TJI® 360 rim joist.

NAILING AT BEARING (FLOOR)

Squash Blocks to TJI® Jois


(Load bearing wall above)

One 10d (0.128" x 3")

This layout is intended for product application assurance and is not intended to circumvent the need for a design professional as determined by the Building Codes. The designer of record and/ or builder/ framer is responsible to assure these drawings are compatible with the overall project.

Weyerhaeuser Symbol Legend User Defined Point Load

User Defined Line Load User Defined Area Load BBO Beam By Others PBO Post By Others **♦** Layout Start Location **Construction Detail Callout** (See Framer's Pocket Guide) 12K (WARNING: Member design did not include this load. Special consideration is required by the designer of record.) Required Bearing Length (Only placed at insufficient bearing

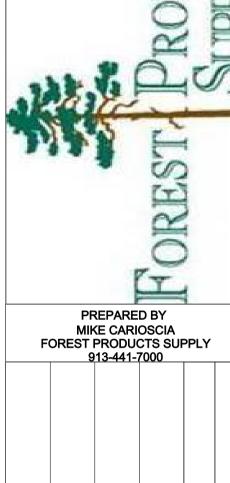

MARYS

**SCALE** 

1/4"=1'-0" PROJECT #: FPS 22-1062

1/23/2023

DO NOT walk on joists

that are lying flat. **WARNING NOTES:** Lack of proper bracing during construction can result in serious accidents. Observe the following guidelines: 1. All blocking, hangers, rim boards and rim joists at the end supports of the TJI® joists must be completely installed and properly nailed.

2. Laterial strength, like braced end wall or an existing deck, must be established at the ends of the bay. This can also be accomplished by a temporary or permanent deck (sheathing) fastened to the first 4 feet of joists at the end of the bay. 3. Safety bracing of 1x4 (minimum) must be nailed to a braced end wall or sheathed area (as in note 2) and to each joist. Without this bracing, buckling sideways or rollover is highly probable under light construction loads - such as a worker or one layer of unnailed sheathing.

4. Sheathing must be completely attached to each TJI® joist before additional loads can be placed on the system. 5. Ends of cantilevers require safety bracing on both the top and bottom flanges.6. The flanges must remain straight within 1/2" from true alignment.

A Weyerhaeuser, Microllam, Parallam, TimberStrand, TJI, TJ, and Trus Joist are registered trademarks of Weyerhaeuser NR. © 2014 Weyerhaeuser NR Company. All rights reserved