


AS GRADED PLOT PLAN

Ordered by: TRUMARK HOMES

Description: LOT 148 MONTICELLO - 4TH PLAT, LEES SUMMIT, MO.


Address: 4732 NE FREEHOLD DR.

RELEASE FOR CONSTRUCTION
AS NOTED FOR PLAN REVIEW
DEVELOPMENT SERVICES
LEE'S SUMMIT, MISSOURI
02/09/2023

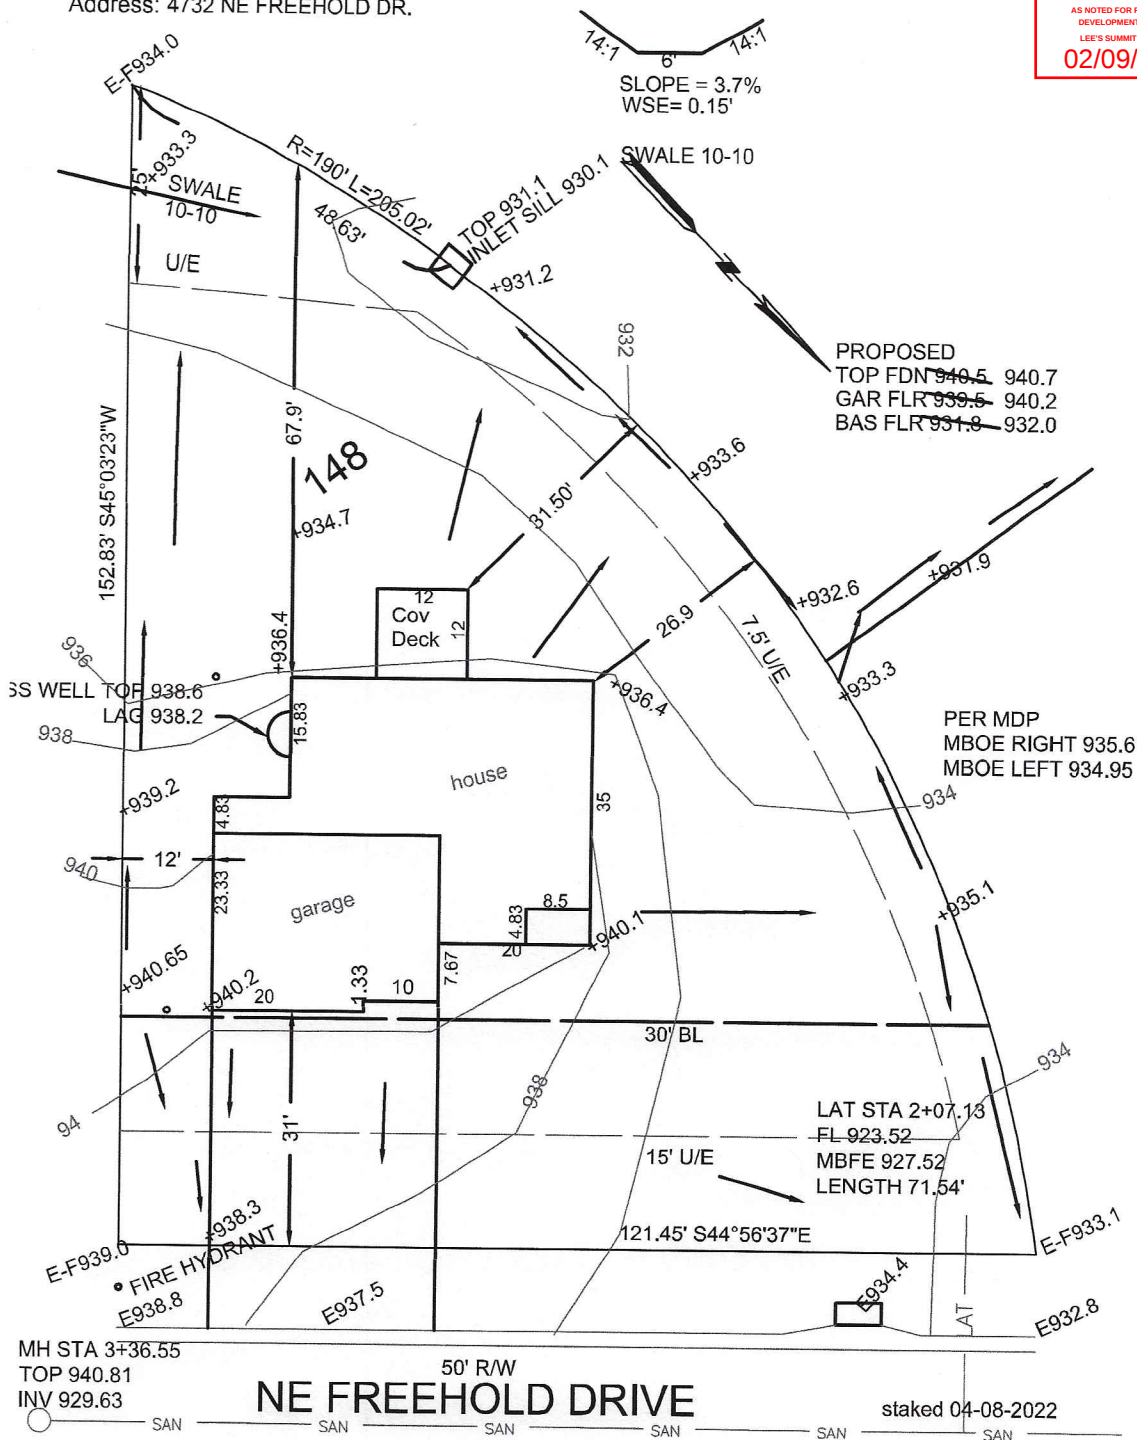

+9xx.x
=As graded Elevation as of 10-31-2022

→ = DRAINAGE PATTERN

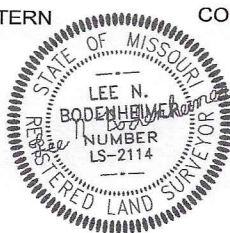

CONSTRUCTION ENGINEERING SERVICES, INC.

16810-C East 40 Highway
Independence, MO 64055
(816)478-2323

lee@engineeringkc.com

SCALE: 1"=20'

DATE: 3/29/2022 & 10-31-2022

JOB NO:18282

18554

LEE BODENHEIMER, L.S.
Land Surveyor