



LOT AREA 10901 SF

RELEASE FOR CONSTRUCTION
AS NOTED FOR PLAN REVIEW
DEVELOPMENT SERVICES
LEE'S SUMMIT, MISSOURI

04/11/2023

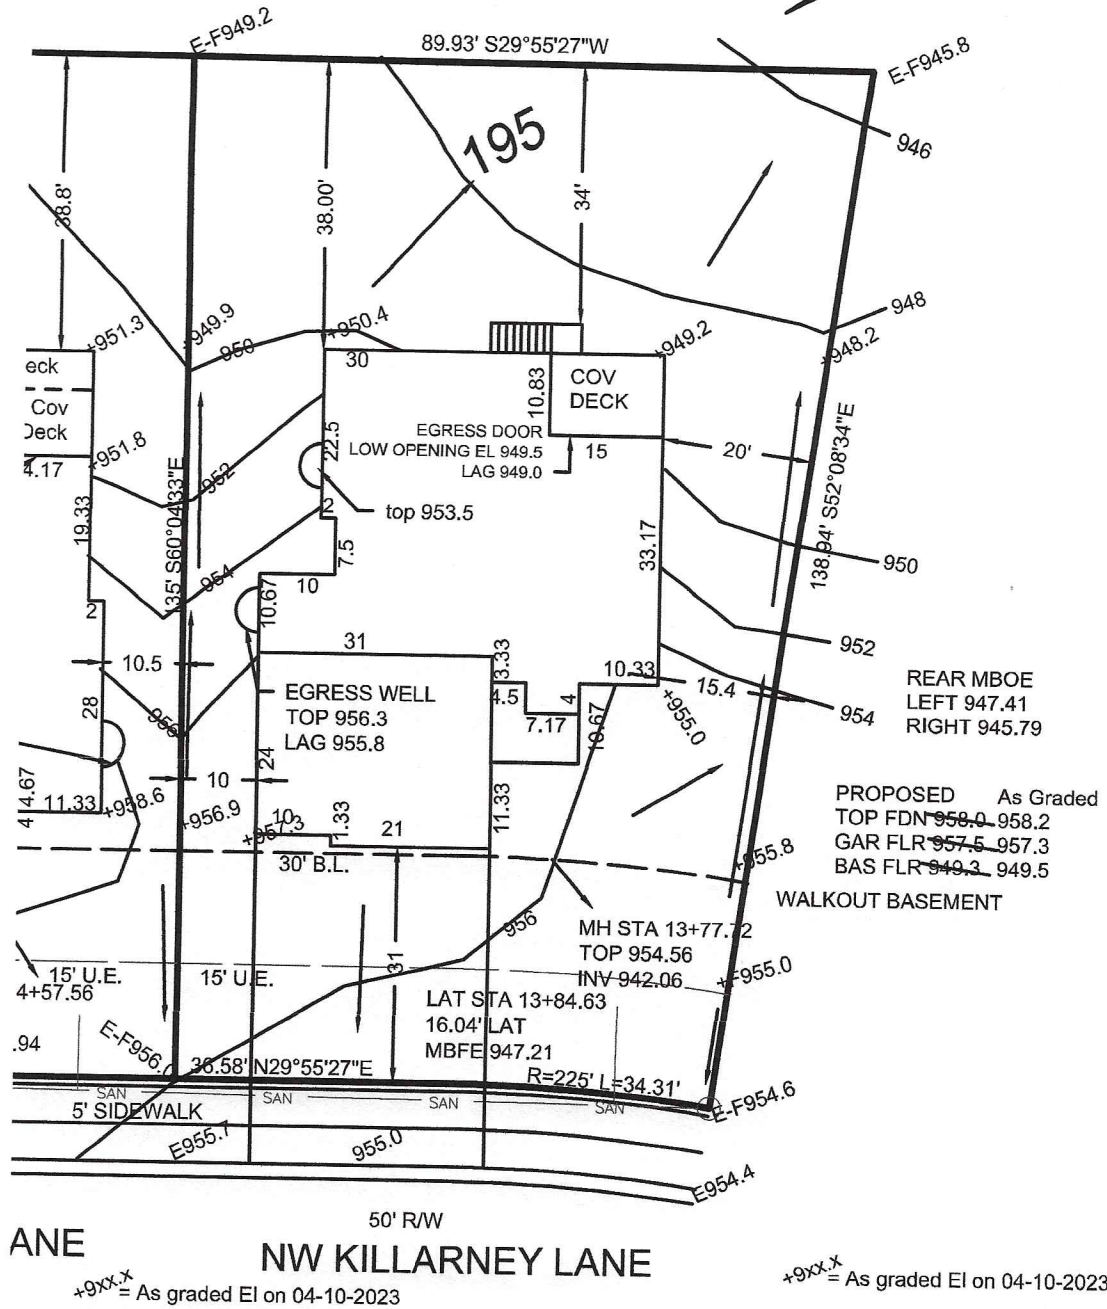

→ = DRAINAGE PATTERN

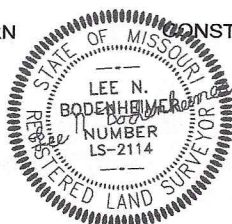

CONSTRUCTION ENGINEERING SERVICES, INC.
16810-C East 40 Highway
Independence, MO 64055
(816)478-2323
lee@engineeringkc.com
SCALE: 1" = 20'
DATE: 05-16-2022 & 04-10-2023
JOB NO: 18368 & 18709

LEE BODENHEIMER, L.S.
Land Surveyor