


AS GRADED PLOT PLAN

Ordered by: SPELLERBERG ENT.
Description: Lot 65A Summit View Farms Lots 64A & 65A, Lees Summit, Mo.
Address: 3106 SW BLUE RIBBON ST.

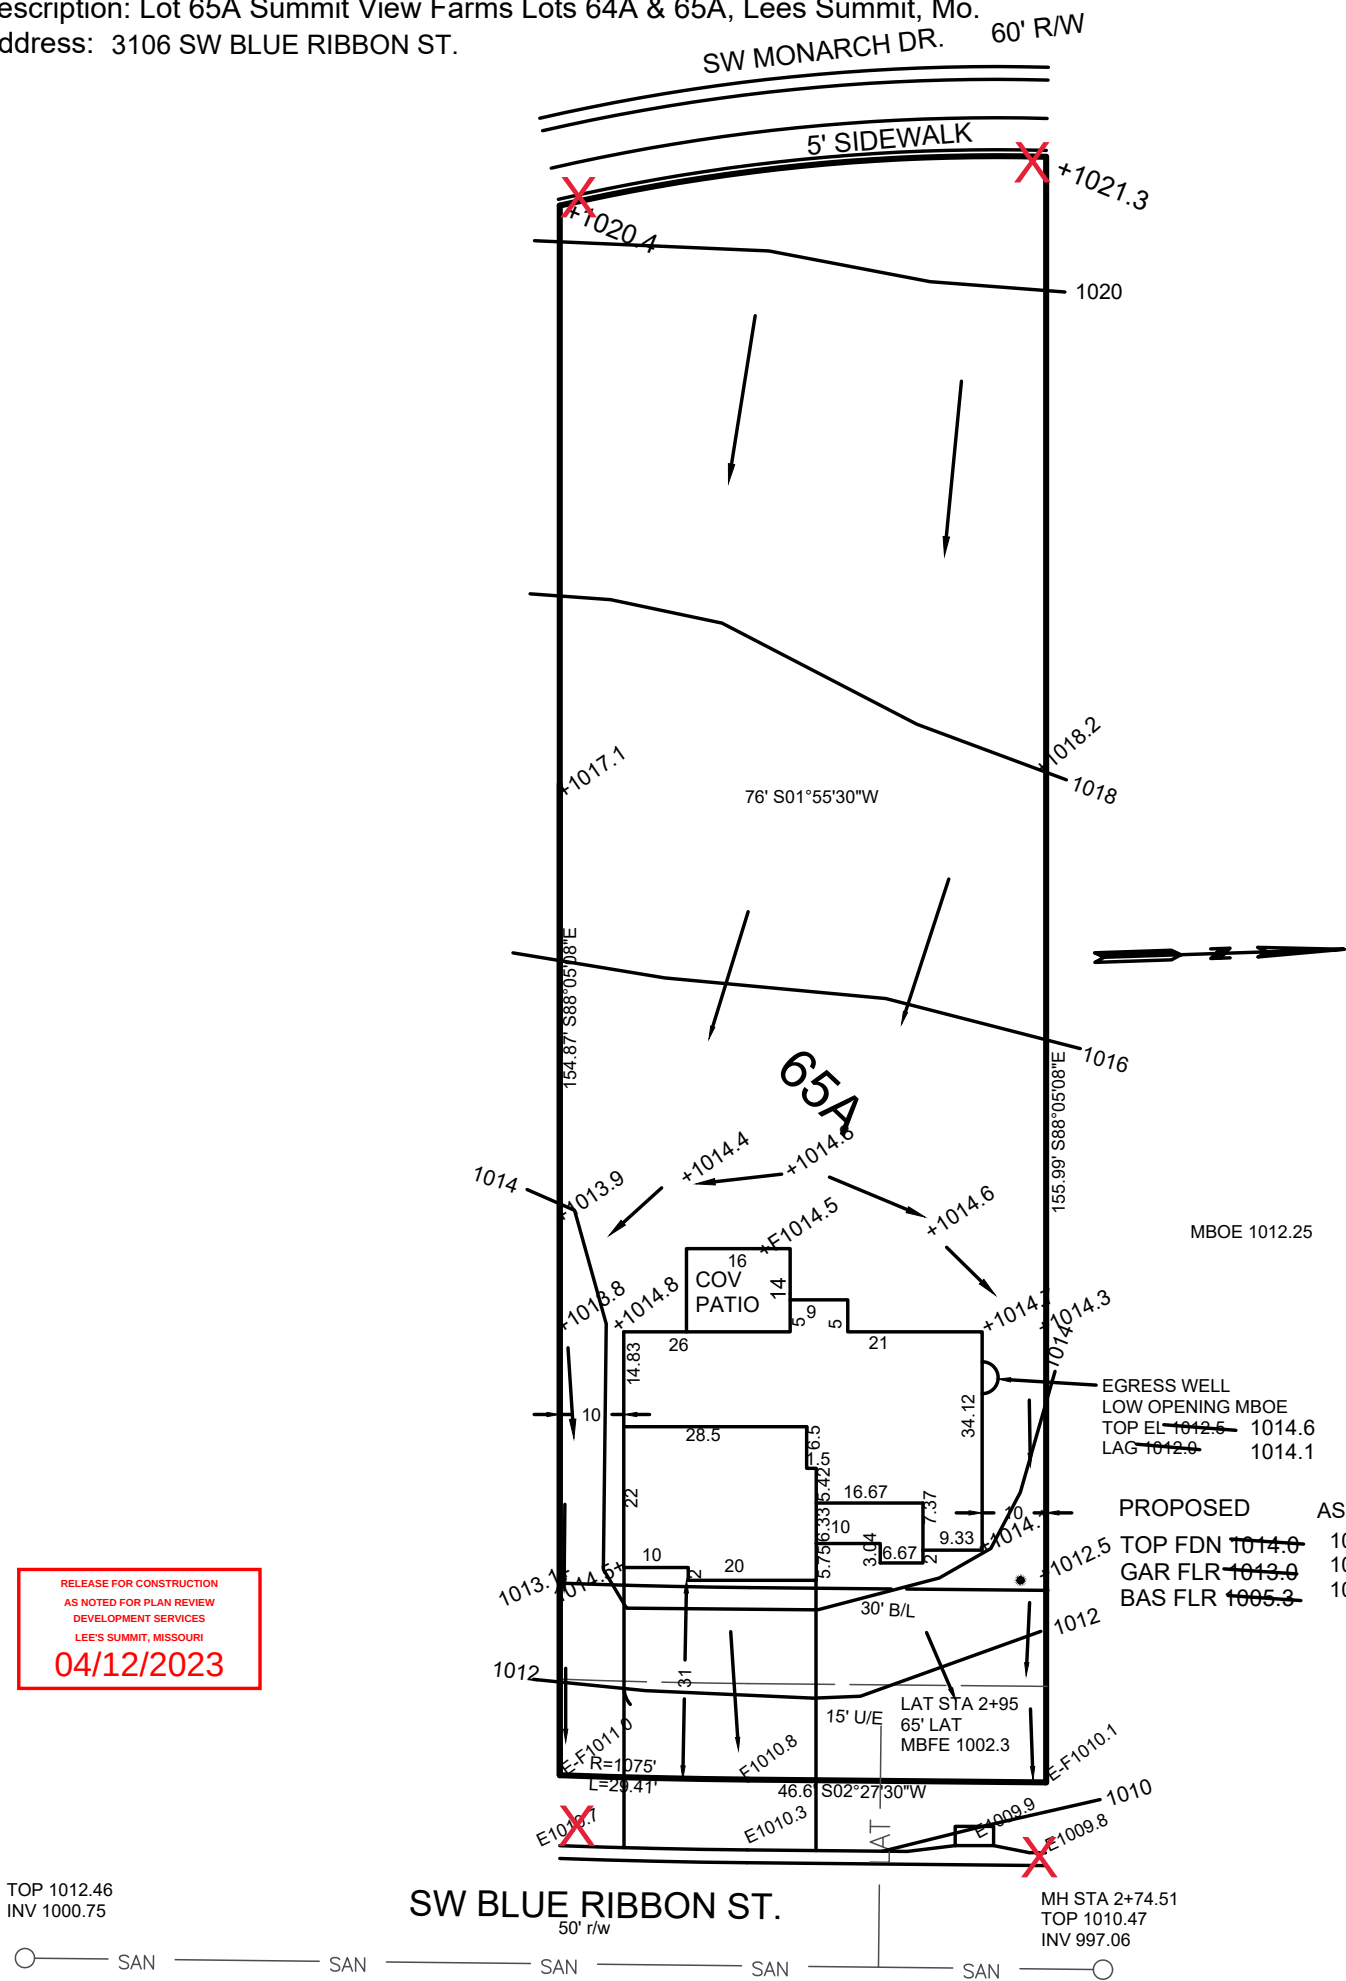

RELEASE FOR CONSTRUCTION
AS NOTED FOR PLAN REVIEW
DEVELOPMENT SERVICES
LEE'S SUMMIT, MISSOURI
04/12/2023

CONSTRUCTION ENGINEERING SERVICES, INC.

16810-C East 40 Highway
Independence, MO 64055
(816)478-2323
lee@engineeringkc.com

SCALE: 1"=30'
DATE: 08-13-2021 & 10-31-2022
JOB NO: 17887 18553

LEE BODENHEIMER, L.S.
Land Surveyor

