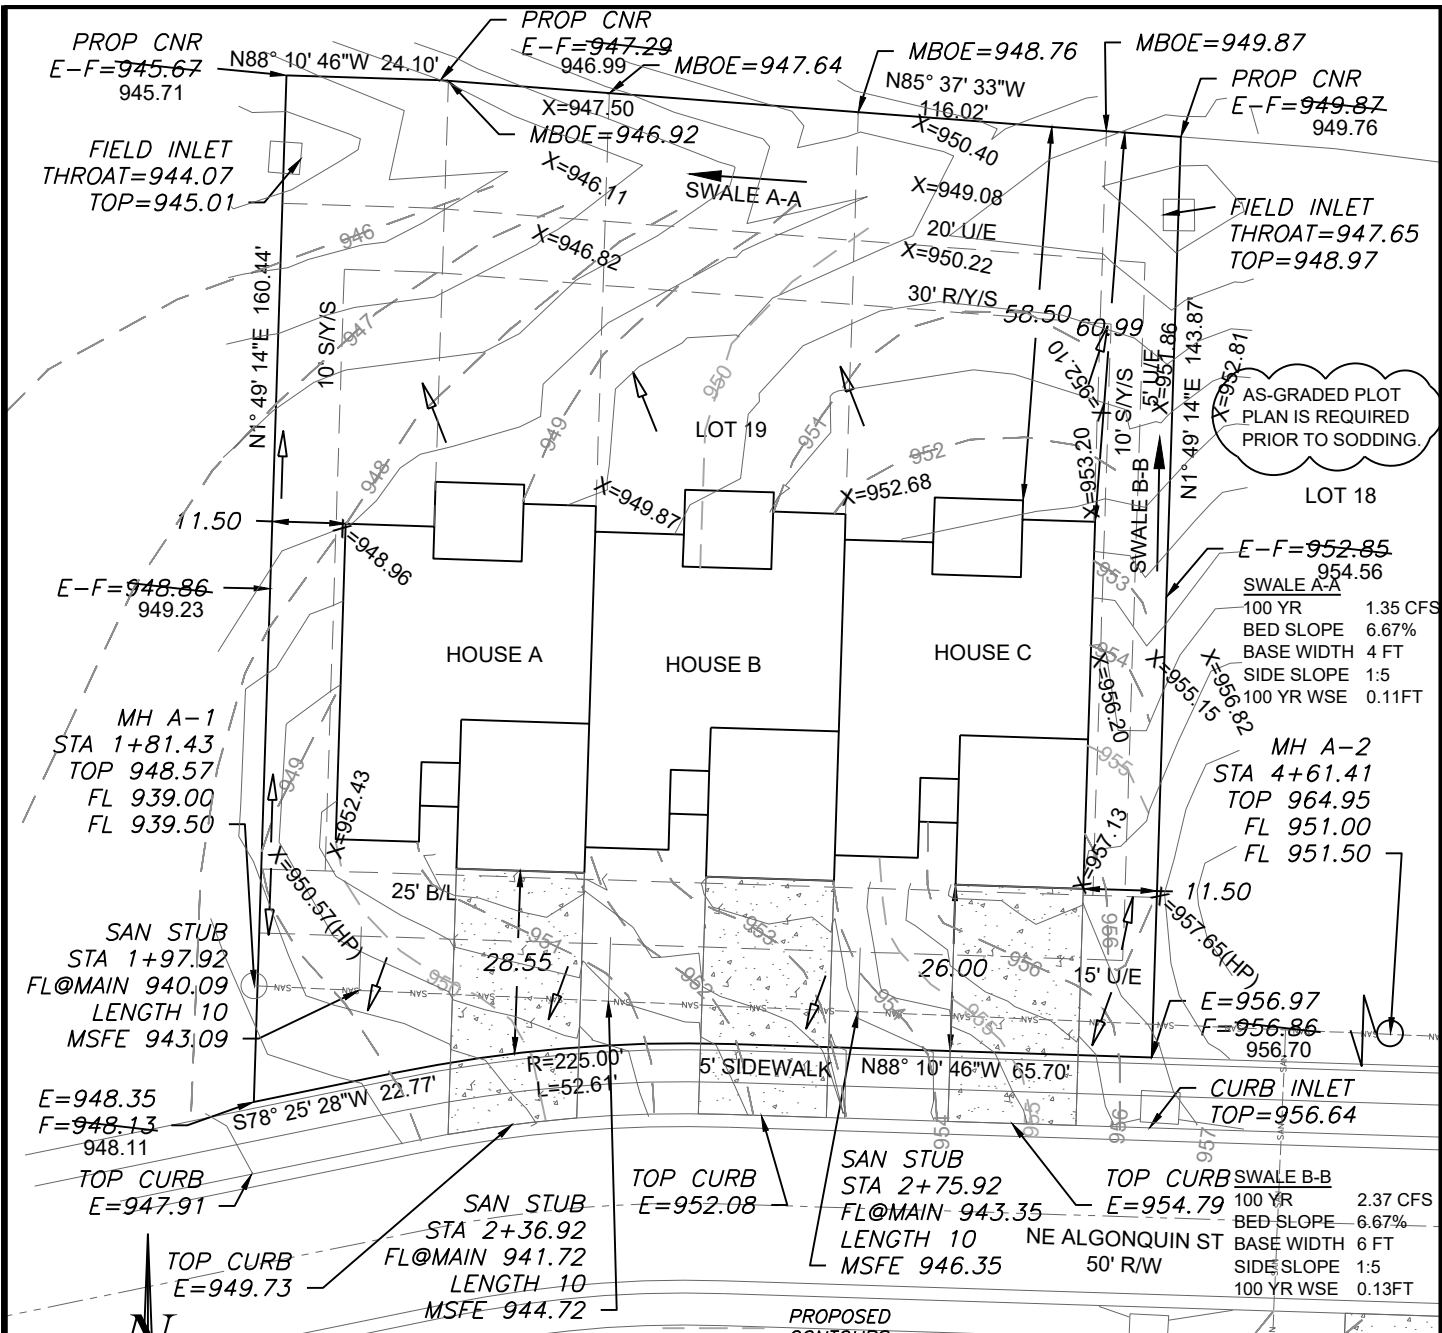


Scale 1"=30'

LOT INFORMATION

20,864.15 SQ. FT.
MBFE (A)=943.09
MBFE (B)=944.72
MBFE (C)=946.35
MBOE (LEFT)= 946.2
MBOE (RIGHT)= 950.2
ADDRESS
HOUSE A: 790 NE ALGONQUIN ST
HOUSE B: 792 NE ALGONQUIN ST
HOUSE C: 794 NE ALGONQUIN ST

LEGAL DESCRIPTION

LOT 19, THE TOWNHOMES OF CHAPEL RIDGE - 2ND PLAT, A SUBDIVISION AS RECORDED IN LEE'S SUMMIT, JACKSON COUNTY, MISSOURI.

NOTES

1. BUILDER TO VERIFY ALL BUILDING ELEVATIONS AND DIMENSIONS.
2. THIS PLOT PLAN DOES NOT CONSTITUTE A BOUNDARY SURVEY.
3. THE EASEMENTS SHOWN ON THIS PLOT PLAN ARE TAKEN FROM THE FINAL PLAT. OTHER EASEMENTS MAY EXIST.


LEGEND

- Gas Meter
- Telephone or Fiber-Optic Pedestal
- Cable TV Pedestal
- Electric Pedestal
- Light Pole
- Mailbox
- Fire Hydrant
- Water Valve

X=###.## = Actual asbuilt ground shots taken on April 24, 2023.
Contours shown are asbuilt.

PROPOSED CONTOURS
AS-GRADED CONTOURS

NOTE: Swale sections extend the entire length between upstream and downstream structures with the exception of a transition at each structure.

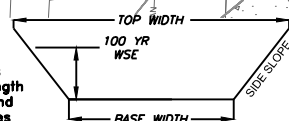

TYPICAL CHANNEL SECTION SWALE DETAIL

Not To Scale

WINDOW

G=952.25 OS BAR

E=952.36

COVERED DECK

E=952.74

F=952.25

6' WALL

11.33'

13.83'

8' WALL

20'

DAYLIGHT

20'

DAYLIGHT

